

Project No. 2022\_110

## Midlothian ISD Baxter ES Kitchen Upgrades

### ADDENDUM NO. 2

March 20, 2023

GENERAL: The following changes, additions or deletions for the above project shall be made to the Contract Documents; all other Conditions shall remain the same. Note: the additions, deletions or changes listed in this Addendum may affect more than the specific instance(s) mentioned. Coordination may be necessary to fully revise cases of duplicate information. The Addendum supersedes current conditions shown. Acknowledge receipt of this Addendum. This addendum forms a part of the Contract Documents and modifies them as follows:

### NOTICE

A pre-proposal walk-thru was held February 28, 2023, the sign in sheet is attached here for reference.

### BIDDER'S QUESTIONS

1. *Will a food service spec be provided for the Division 11 food Service?*

No Food Service specification for Division 11 shall be provided.

2. *Could a plan be provided for the slab saw cuts, for all trades, on one plan page?*

Please refer to attached Sheet AD101 DELTA 2 ADDENDUM#2

3. *Should the subs project material cost to start Summer 2024 due to Food Svc lead times?*

Notice To Proceed will be issued in April 2023, please use this schedule to plan procurement accordingly.

4. *Is there a contractor that provides the replacement fiber flooring product?*

No.

5. *Does the existing terrazzo flooring need to come out during the demo phase?*

No

222 w las colinas blvd  
suite 749e  
irving tx 75039  
214 396 2090 t

6. *Will the replacement flooring install directly over the top of the terrazzo?*

Yes, the plasticized Vinyl Aluminum Oxide Grains and Silicon Carbide Grains with a glass Fiber reinforced will be able to go over existing terrazzo flooring.

7. *Are there any specifics for prepping the new flooring going in over the terrazzo?*

Yes, provided that they are dry, well bounded, smooth, and free of wax, polishes and/or any other forging materials. When going over existing flooring, moisture testing must be performed per application ASTM standards. Partial removal of the existing flooring may be required to facilitate moisture testing. Please consult with your local Altro distributor.

8. *Will the Aluminum double doors have a hardware provision for them to lock down?*

Yes

9. *You might want to correct the conflicted project location address on the cover page?*

This correction was completed, and new cover page was issued in Addendum No. 1

10. *Is the CMU Masonry wall on the kitchen demo note 12, a structural wall supporting roof?*

No

11. *Some talk at the pre-bid about removing the CMU wall in the kitchen in its entirety?*

Yes, remove the wall entirely. Please refer to attached sheet 1/AD101 DELTA 2 ADDENDUM#2

12. *FS Equipment noted to be moved to Cafetorium has no notes to be moved back?*

Done, notes have been added. Please refer to attached sheet 1/AD101 DELTA 2 ADDENDUM#2

13. *Confirm Plan A701 note to provide new wall tile on all 4 walls of Serving line area?*

Yes, New ceramic wall tile goes over existing wall tile.

14. *Demo Plan AD101 has no Demo of Tile Noted on Existing Serving line area?*

We are not removing any wall tile. Install new ceramic wall tile over existing wall tile.

15. *Confirm Plan A701 note to provide new wall tile on pass thru wall full height?*

Yes, new ceramic wall tile will go up 8" above ceiling tile. See detail 5/A-101M, sheet attached

16. *The Scale on A101 Detail 1 & 2 appears to be incorrect. Maybe it should be ¼ Inch?*

No, scales are correct.

17. *Can the mixed scale page items be put on separate pages.*

No, we show floor plans together for to share information and clarity.

18. *Can a food service equipment profile be provided for the new serving line?*

No, we did not hire a food kitchen consultant. They produce these types of drawings.

19. *What structural members support each end of the box beam on Page A103 Detail 3?*

New 6" metal stud will be installed now.

20. *Is there a CCTV contractor with the District who will be available for reconnects?*

Midlothian ISD will answer this question. Please contact Shana at 469-856-5032

#### DRAWINGS

##### ITEM NO. 01 G-001 - TITLE SHEET

Replace this sheet in its entirety.

##### ITEM NO. 02 AD101 - DEMOLITION PLANS

Replace this sheet in its entirety. The sheet shows saw cuts locations for existing concrete floor all in one location per the request in bidder question no. 2.

ITEM NO. 03 E100 – FLOOR PLAN – LEVEL 1 - ELECTRICAL

- A. Revised power / receptacle location for new double oven layout.
- B. Added power and switch for booster pump (CP-1) and added keyed note 6 under 'NOTES BY SYMBOL' for the same.

ITEM NO. 04 E700 – LIGHT FIXTURE & PANEL SCHEDULES

- A. Revised panel schedule for panel 'K'.

ITEM NO. 05 P000 – PLUMBING SPECIFICATIONS, LEGENDS, & NOTES

- A. Refer to attached plan for revisions.

ITEM NO. 06 P100 – FLOOR PLAN – LEVEL 1 – PLUMBING

- A. Refer to attached plan for revisions.

ATTACHMENTS:

Pre-Proposal Walk Thru Sign In Sheet, Dated 02/28/2023

G001, Title Sheet, dated 03/15/2023


AD101, Demolition Plans, dated 03/15/2023

P000, Plumbing Specifications, Legends, & Notes, dated 03/15/2023

P001, Floor Plan – Level 1 – Plumbing, dated 03/15/2023

E001, Floor Plan – Level 1 – Electrical, dated 03/15/2023

E700, Light Fixture & Panel Schedules, dated 03/15/2023

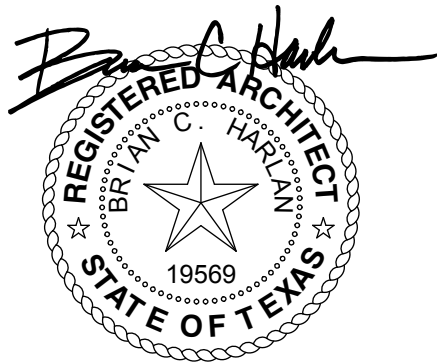

03-03-2023

2929 n central ave  
eleventh floor  
phoenix az 85012

602 257 1764 t  
602 257 9029 f

www.owp.com

## CSP 2223-01 BAXTER KITCHEN RENOVATION PROJECT

	PRE-PROPOSAL MEETING/WALKTHROUGH	BAXTER ELEMENTARY	FEBRUARY 28, 2023

Name	Title	Company	Phone	Fax	E-Mail
John Elkins	SR Estimator	Reeder General	817-711-9734		BIDMASTER@ReederGeneral.com
MARK BURDEN	Proj Mgr	STIFFORD SMITH	972-800-5269		MBURDEN@STIFFORDSMITH.COM
Jimmy Reyes	Estimator	Shepherd Food	972-926-4544		JReyes@ShepherdFood.com
Jeff Massey	Estimator	The Maillon	469-709-2609		JMassey@PromasterElectric.com
Mark Wyatt	Superintendent	Joe's Jr Construction	817-319-8545		MWyatt@Joessjr-Construction.COM
Adrian/Carol	Owner	DCA Commercial	817-808-3426		
A. Wilson	President	A-D Global Infrastructure	469-4061		awilson@adglobalinfra.com
Justin Jones	Manager	JS SQUARED	469-255-5234		JSQUAREDConstruction55@gmail.com
BRIAN HARLAN	Architect	Orcutt Winslow	817-235-8364		




# T E BAXTER ELEMENTARY SCHOOL KITCHEN EQUIPMENT REPLACEMENT

## CONSULTANT INFO

**MEP - RWB CONSULTING ENGINEERS**  
12001 N. Central Expressway, Suite 1100  
DALLAS, TX 75243  
Nathan Hart  
nhart@rwb.net  
Office: (972) 788-4222  
Fax: (972) 788-0002

## VICINITY MAP

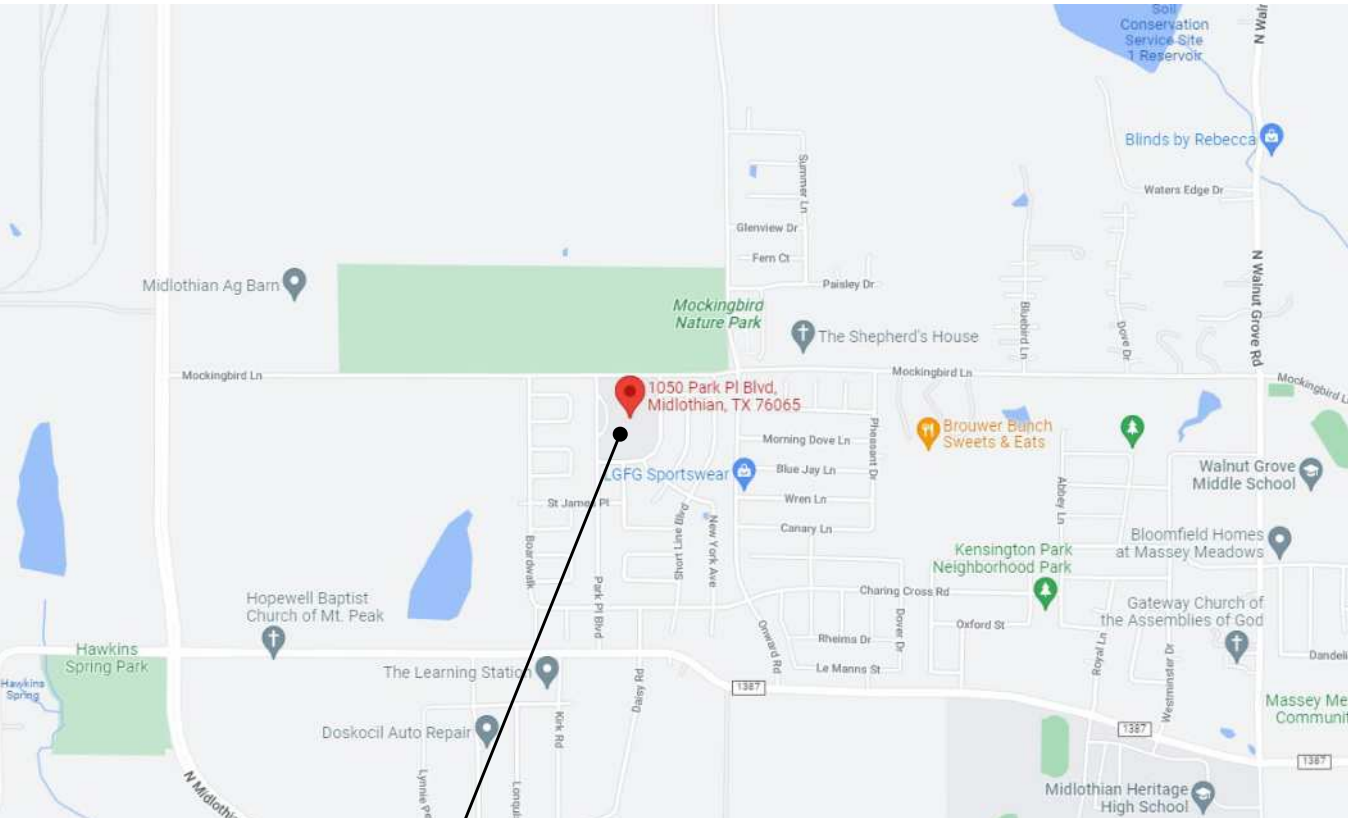

PROJECT LOCATION:  
1050 PARK PLACE BLVD.  
MIDLOTHIAN, TX 76065

## SHEET INDEX

general				
SHEET #	DESCRIPTION	ORIG. ISSUE	REV. DELTA #	REV. DATE
G-001	TITLE SHEET	03/09/2023	2	03-15-2023
G-002	WALL TYPES/PROJECT INFORMATION	03/09/2023	1	03-09-2023

architectural				
SHEET #	DESCRIPTION	ORIG. ISSUE	REV. DELTA #	REV. DATE
A-101	DEMOLITION PLANS	03/09/2023	2	03-15-2023
A-101	FIRST FLOOR PLAN	03/09/2023	1	03-09-2023
A-103	FIRST FLOOR RCP	03/09/2023	1	03-09-2023
A-601	DOOR SCHED./ELEV.	03/09/2023	1	03-09-2023
A-701	FLOOR FINISH PLAN	03/09/2023	1	03-09-2023
A-702	SPECIFICATIONS	03/09/2023	1	03-09-2023
A-703	DOOR HARDWARE SPECIFICATIONS	03/09/2023	1	03-09-2023

mechanical				
SHEET #	DESCRIPTION	ORIG. ISSUE	REV. DELTA #	REV. DATE
M001	SPECIFICATIONS - MECHANICAL	03/09/2023		
M100	FLOOR PLAN - LEVEL 1 - KITCHEN - HVAC	03/09/2023		

plumbing				
SHEET #	DESCRIPTION	ORIG. ISSUE	REV. DELTA #	REV. DATE
P000	PLUMBING SPECIFICATIONS, LEGENDS & NOTES	03/09/2023	2	03-15-2023
P100	FLOOR PLAN - LEVEL 1 - PLUMBING	03/09/2023	2	03-15-2023

electrical				
SHEET #	DESCRIPTION	ORIG. ISSUE	REV. DELTA #	REV. DATE
E000	ELECTRICAL NOTES & LEGENDS	03/09/2023		
E001	SPECIFICATIONS-ELECTRICAL	03/09/2023	2	03-15-2023
E100	FLOOR PLAN - LEVEL 1 - ELECTRICAL	03/09/2023		
E200	FLOOR PLAN - LEVEL 1 - LIGHTING	03/09/2023		
E300	ELECTRICAL DETAILS	03/09/2023		
E700	LIGHT FIXTURE & PANEL SCHEDULES	03/09/2023	2	03-15-2023

## T E BAXTER ELEMENTARY SCHOOL KITCHEN EQUIPMENT REPLACEMENT 1050 PARK PLACE BLVD. MIDLOTHIAN, TX 76065

CLIENT CONTACT  
Midlothian ISD  
100 Walter Stephenson Rd.  
Midlothian, TX 76065

468-856-5000 T jose.martinez1@msid.gs  
000-000-0001 F  
OWP PROJECT NO. DATE OF ISSUE  
2022-110-00 03.09.2023

DELTA	DESCRIPTION	DATE
1	ADDENDUM	03-09-2023
2	ADDENDUM	03-15-2023

PROJECT TEAM  
ED TEXAS

DRAWN BY  
EA

PROJECT PHASE  
CONSTRUCTION DOCUMENTS

SHEET CONTENTS  
TITLE SHEET

SHEET NO.

G-001

orcutt | winslow

222 w las colinas blvd  
suite 749e  
irving, tx 75039  
mail@owp.com  
214.396.2090 t  
www.owp.com

03-15-2023

© 2023 This hard copy or electronic drawing is an instrument of service and the property of Orcutt Winslow and shall remain their property. The design professional shall not be responsible for any alterations, modifications or additions made to this drawing in any way after the design professional. Use of this drawing shall be limited to the original and for which it was prepared and no reproduction shall be made without the express written consent of the design professional. Use of this drawing for any other purpose without the design professional's written consent is prohibited. Publication in any medium without the design professional's written consent is prohibited. Any information obtained or conclusions derived from this drawing shall be at the user's sole risk.



3/20/2023 11:53:03 AM Orcutt | Winslow / 2022-11-00 / KITCHEN EQUIPMENT REPLACEMENT - T E BAXTER ELEMENTARY SCHOOL / SCHEMATIC DESIGN / AD101 - DEMOLITION PLANS / EA  
C:\Users\lavina.e\Documents\2022\_110MBEK\_R22\_avina.e.rvt

GENERAL SHEET NOTES

- A. Sawcut and remove existing concrete floor slab to accommodate new utility work. Compact trench backfill and patch floor slab to match existing.
- B. Coordinate demolition with new construction. All demolition and repair necessary to accomplish new construction shall be included. Contractor shall remove all existing improvements whether or not specifically indicated on the drawings to facilitate the completion of all required work. Contractors shall visit the site and verify all quantities and items required to be removed.
- C. Where gypsum board is to remain, patch, tape and float portion of wall to match adjacent new finish.
- D. Contractor to coordinate demolition so all wiring, conduit, equipment, etc. to remain is not damaged. Certain items may be temporarily removed and replaced later during course of restoration. General Contractor will be required to incorporate this work into their schedule. The systems may include, but are not limited to the following: EMS/controls, electrical power and lighting, data, audiovisual, security, intercom, CATV, etc. Contractor to tag and loop wire to remain back to control panels, typical.
- E. Any plumbing to be demolished shall have piping terminated above finished ceiling, below finished floor, and behind finished walls. All drain/waste/vent piping to be capped and sealed at all openings per requirements of AHJ.
- F. Remove existing ceiling grid, suspension wires, lighting fixtures, conduits, exit signs, speakers, smoke detectors, curtain tracks, HVAC diffusers and return grilles, and any other ceiling mounted apparatus in all areas of demolition, UNO.
- G. Remove floor and wall covering typical throughout areas of demolition (UNO) and any other areas as affected by demolition/new construction. Parge, float and/or prepare floor and wall surfaces to receive new finishes.
- H. Contractor shall remove and replace any fireproofing or firestopping damage during demolition or new construction to conform to proper rating.
- I. Contractor shall provide full height temporary partitions with UL rating as needed to separate the construction activity, noise, and dirt from adjacent areas (refer to proposed Phasing Plan).
- J. Contractor shall coordinate any shutdown required during demolition with Owner.
- K. Contractor to maintain or repair fire and smoke ratings of existing floor, roof and wall assemblies throughout.

SHEET KEYNOTES

- 001 REMOVE SERVING LINE RETURN TO OWNER
- 002 REMOVE DOOR AND FRAME CAREFULLY AND DO NOT DAMAGE EXISTING CONDITIONS TYP.
- 003 REMOVE SMALL TRAY RETURN STEEL ROLL-UP DOOR
- 004 REMOVE DISH WASHER MACHINE AND HOOD RETURN DISH WASHER MACHINE TO OWNER
- 005 MOVE EXISTING ICE MACHINE TO CAFETORIUM FOR NEW FLOOR INSTALLATION TYP.
- 006 REMOVE BRAISING PAN RETURN TO OWNER
- 007 REMOVE COMBI OVEN STACKED RETURN TO OWNER
- 008 REMOVE STACKED OVENS RETURN TO OWNER
- 009 REMOVE SMALL TABLE WARMER AND TWO BURNER TOP RETURN TO OWNER
- 010 REMOVE 3 COMPARTMENT SINK CAP ALL WATER LINES RETURN TO OWNER
- 011 ALL STAINLESS STEEL TABLES AND RACKS ARE NOT IN CONTRACT. MOVE TO CAFETORIUM FOR NEW FLOOR INSTALLATION TYP.
- 012 REMOVE CMU WALL FULL HEIGHT
- 013 REMOVE SINGLE PASS-THRU COOLER REFRIGERATOR RETURN TO OWNER
- 014 REMOVE DOUBLE PASS-THRU WARMER CABINET RETURN TO OWNER
- 015 RELOCATE HANDSINK AND WATER/ELECTRICAL LINES. REFERENCE PLUMBING AND ELECTRICAL DRAWINGS
- 016 REMOVE EXISTING CONCRETE SLAB. REFERENCE PLUMBING AND ELECTRICAL DRAWINGS
- 017 PLACE ALL EXISTING EQUIPMENT IN CAFETORIUM FOR NEW FLOOR INSTALLATION (TYP) RETURN EXISTING EQUIPMENT FROM CAFETORIUM TO KITCHEN AFTER NEW FLOOR INSTALLATION (TYP)
- 018 PROTECT STAINLESS STEEL OPENING DURING DEMOLITION EXISTING WALL FINISH TO REMAIN. PROTECT DURING CONSTRUCTION

DEMOLITION LEGEND

- EXISTING WALLS, STRUCTURE, WINDOWS, ETC. TO REMAIN
- EXISTING WALL TO BE REMOVED
- EXISTING DOOR & FRAME TO BE REMOVED
- LINE OF EXISTING WALK, STAIR, FURNITURE OR OTHER SIMILAR ITEM TO BE REMOVED
- REMOVE EXISTING CONCRETE SLAB
- NO WORK AREA

orcutt | winslow

222 w las colinas blvd  
suite 749e  
irving, tx 75039  
mail@owp.com  
214.396.2090 t  
www.owp.com

03-15-2023

© 2023 This hard copy or electronic drawing is an instrument of service and the property of Orcutt | Winslow and shall remain their property. The design professional shall not be responsible for any alterations, modifications or additions made to this drawing by any party other than the design professional. Use of this drawing shall be limited to the original use for which it was prepared and no reproduction, whether in whole or in part, shall be made without the written consent of the design professional. Any reproduction, whether in whole or in part, shall be prohibited without the written permission of the design professional. Any information obtained or conclusions derived from this drawing shall be at the user's sole risk.

T E BAXTER ELEMENTARY SCHOOL  
KITCHEN EQUIPMENT REPLACEMENT  
1050 PARK PLACE BLVD.  
MIDLOTHIAN, TX 76065

CLIENT CONTACT  
Midlothian ISD  
100 Walter Stephenson Rd.  
Midlothian, TX 76065  
468-856-5000 T jose.martinez1@msd.gs  
000-000-0001 F  
OWP PROJECT NO. DATE OF ISSUE  
2022-110-00 03.09.2023

REVISIONS		
DELTA	DESCRIPTION	DATE
2	ADDENDUM	03-15-2023

PROJECT TEAM  
ED TEXAS


DRAWN BY  
EA

PROJECT PHASE  
CONSTRUCTION DOCUMENTS


SHEET CONTENTS  
DEMOLITION PLANS

SHEET NO.


AD101

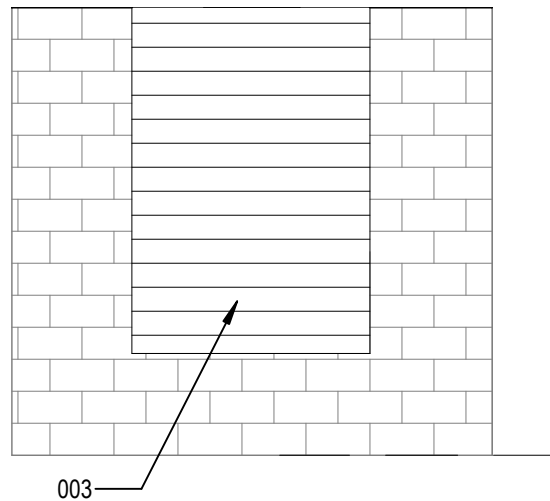


4 DEMO ELEVATION SCULLERY  
1/4" = 1'-0" REF 1 / AD101

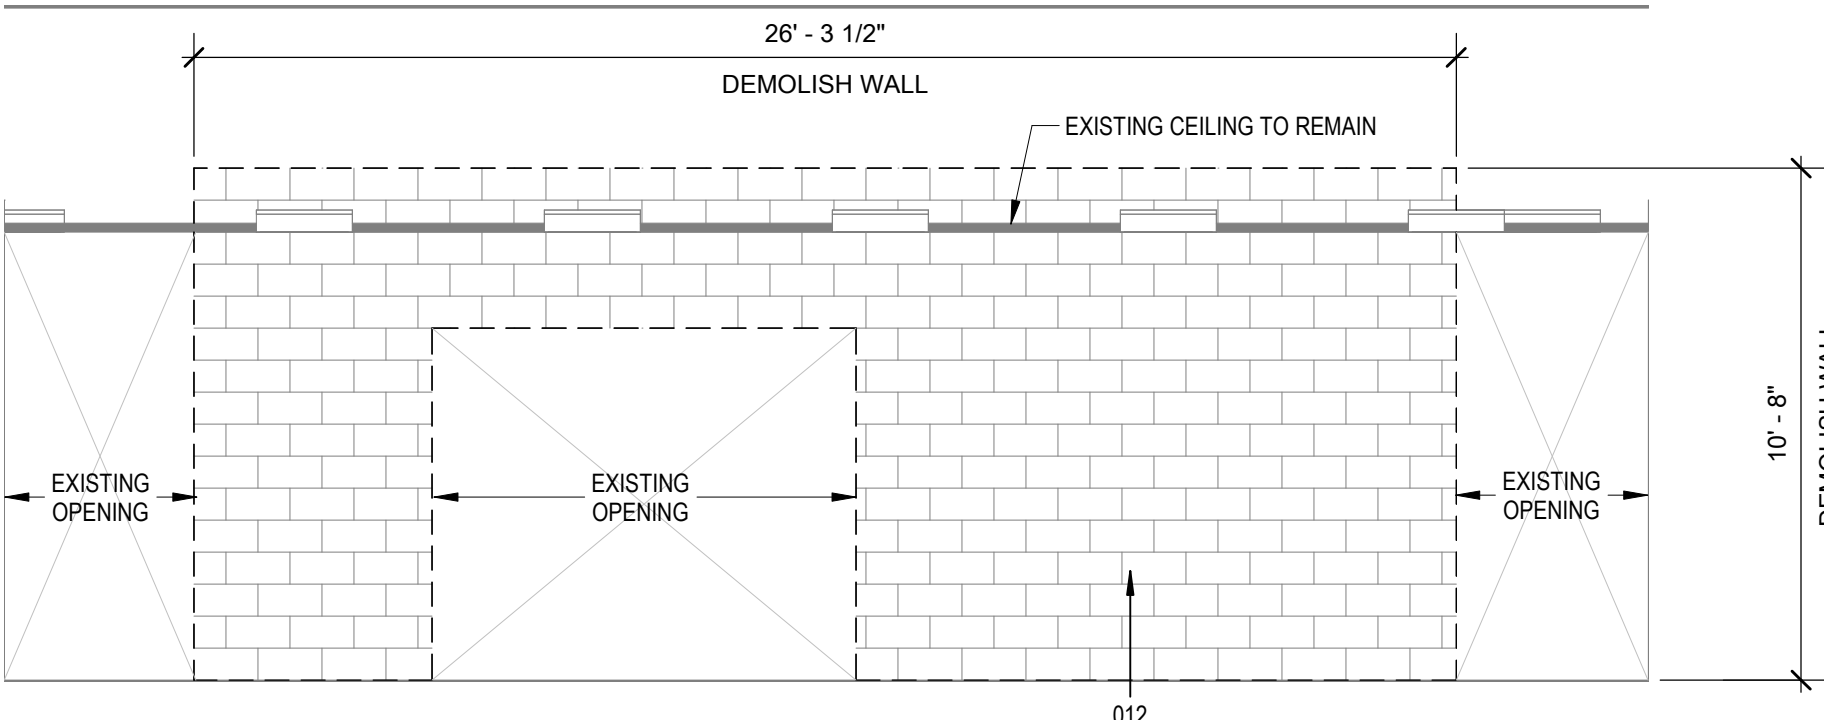


3 DEMO ELEVATION KITCHEN  
1/4" = 1'-0" REF 1 / AD101

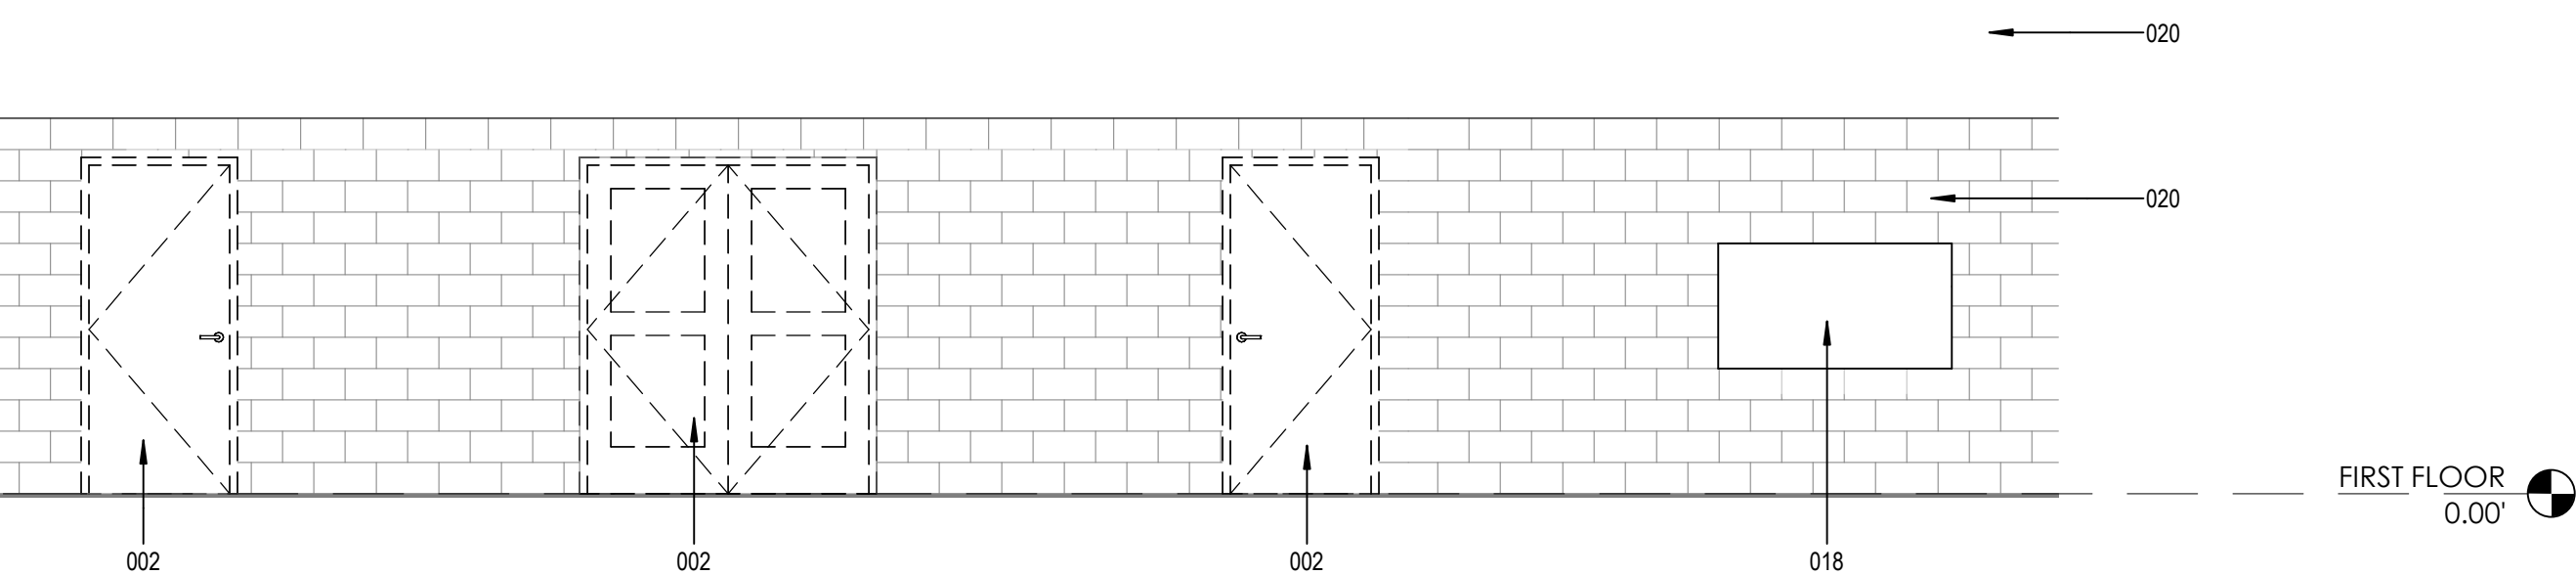

2 DEMO ELEVATION WALL CAFETORIUM  
1/4" = 1'-0" REF 1 / AD101

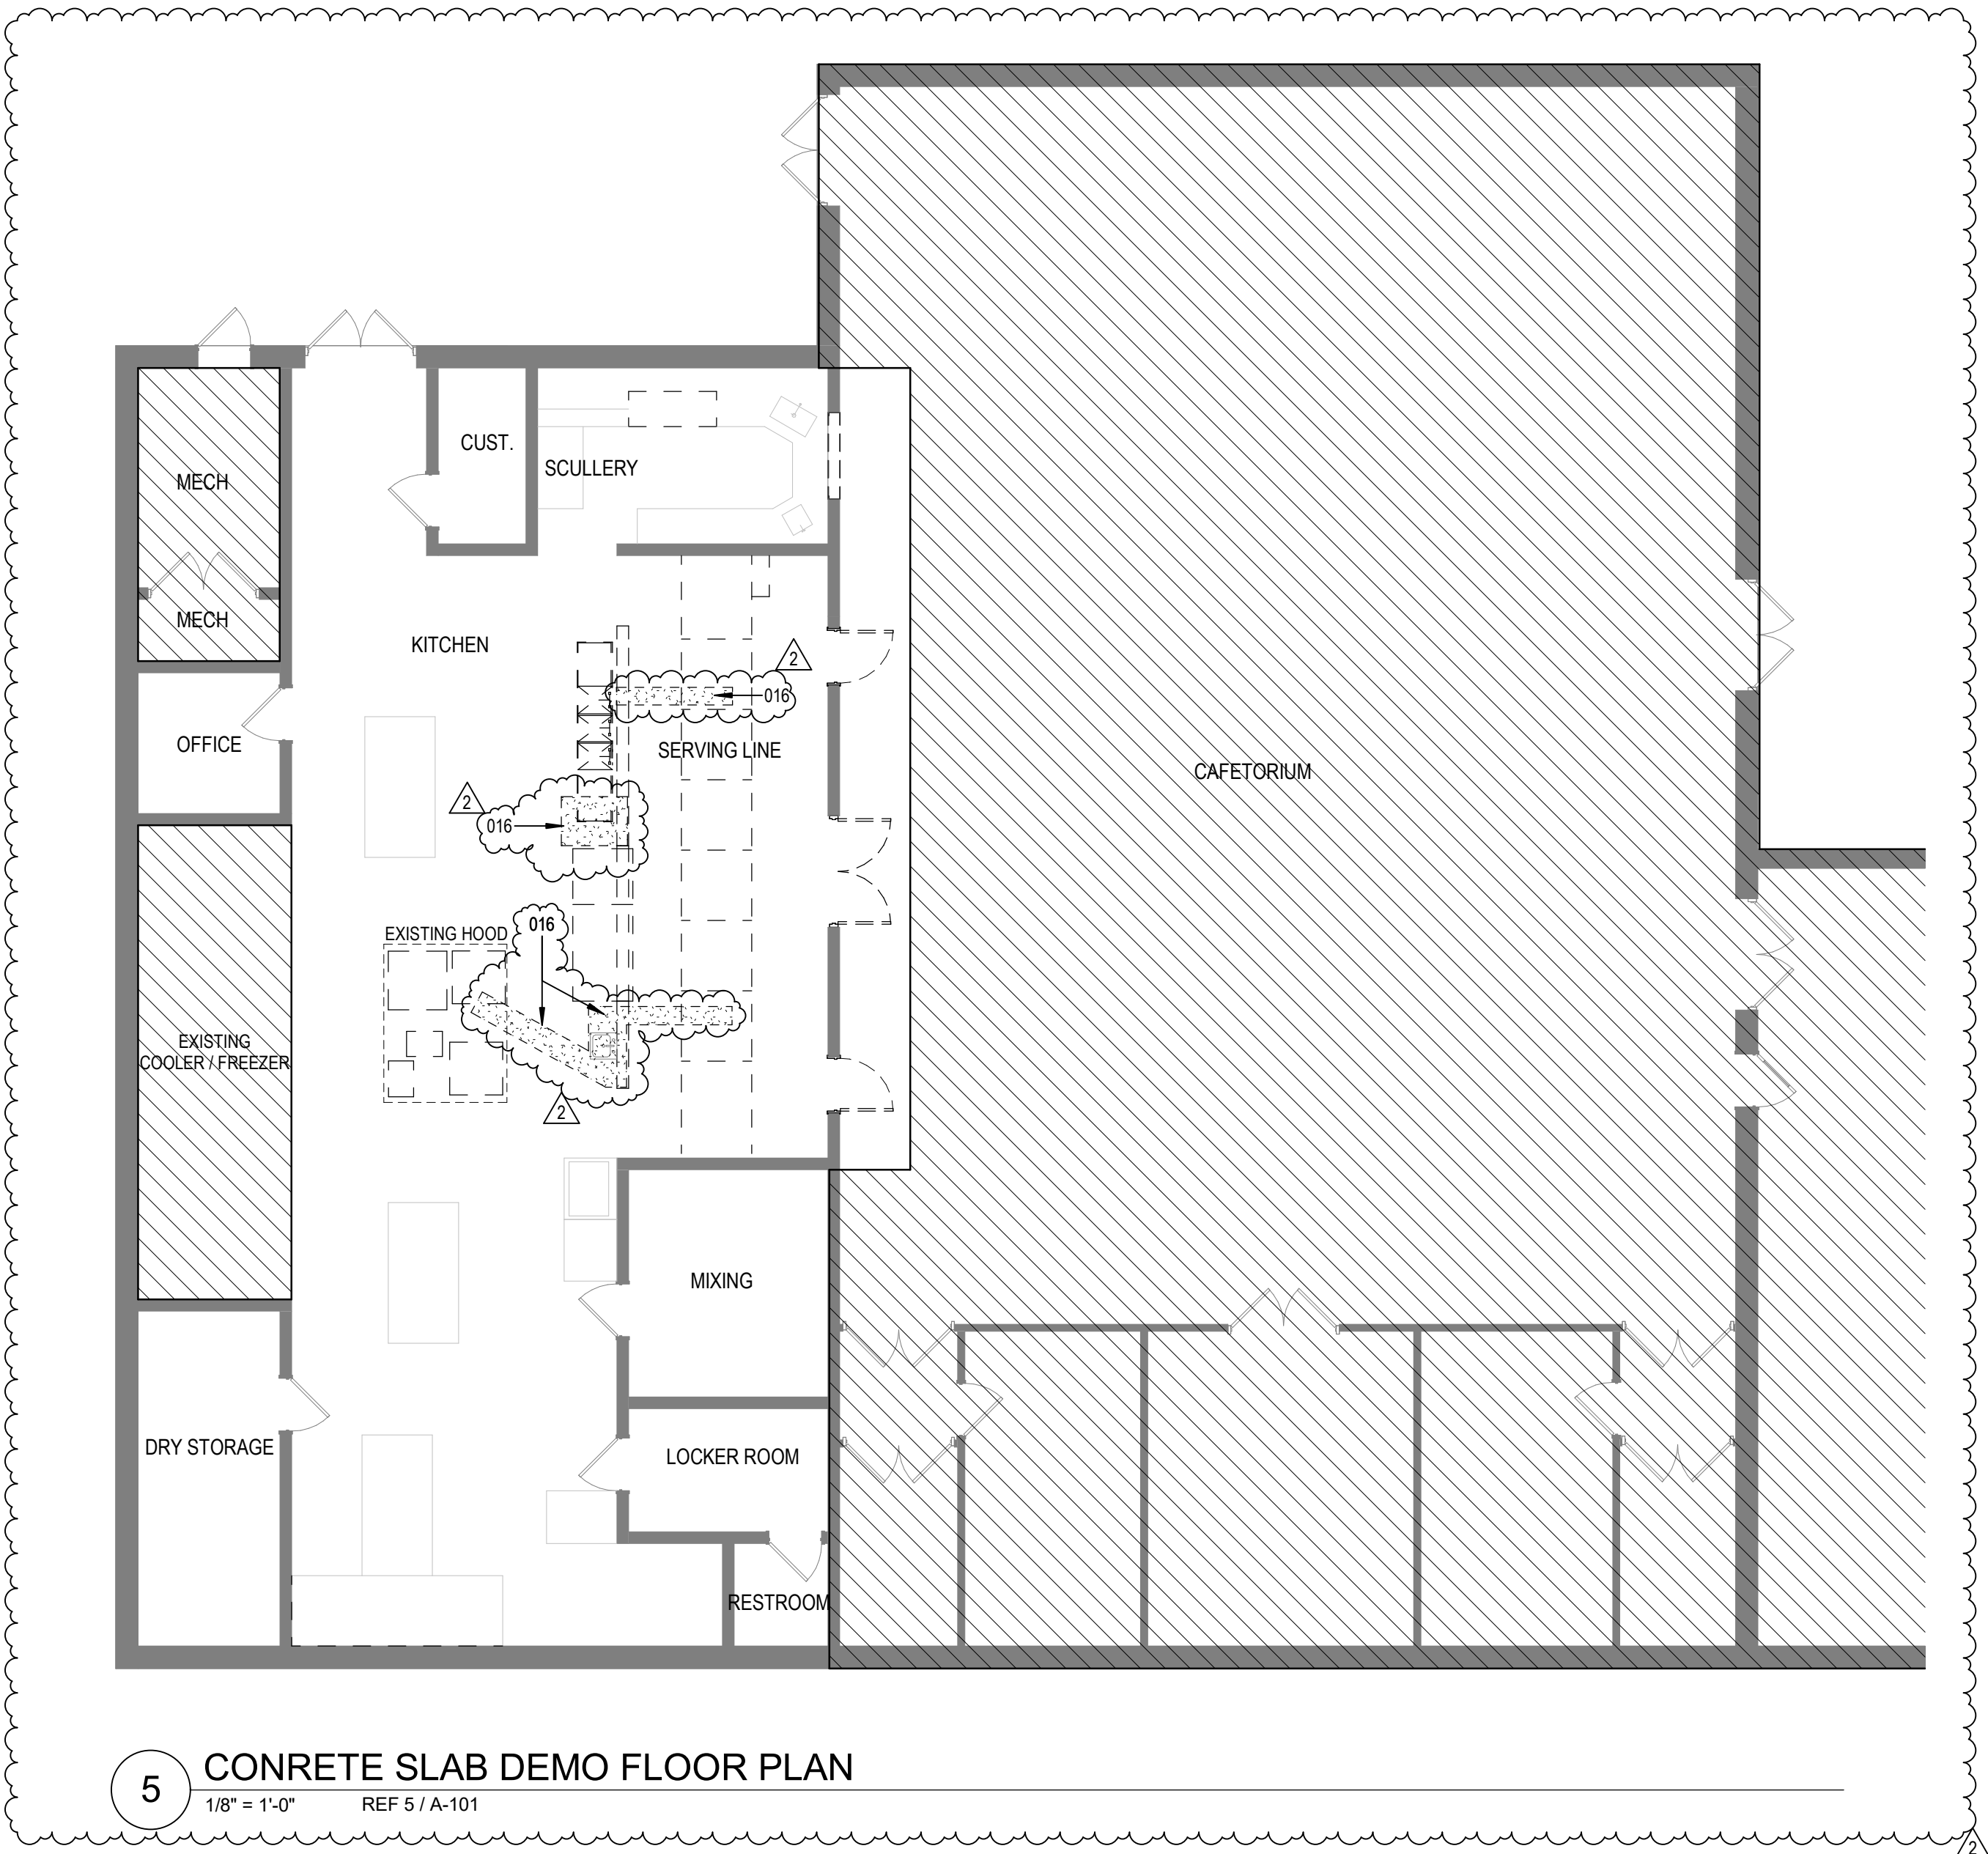

5 CONCRETE SLAB DEMO FLOOR PLAN  
1/8" = 1'-0" REF 5 / A-101

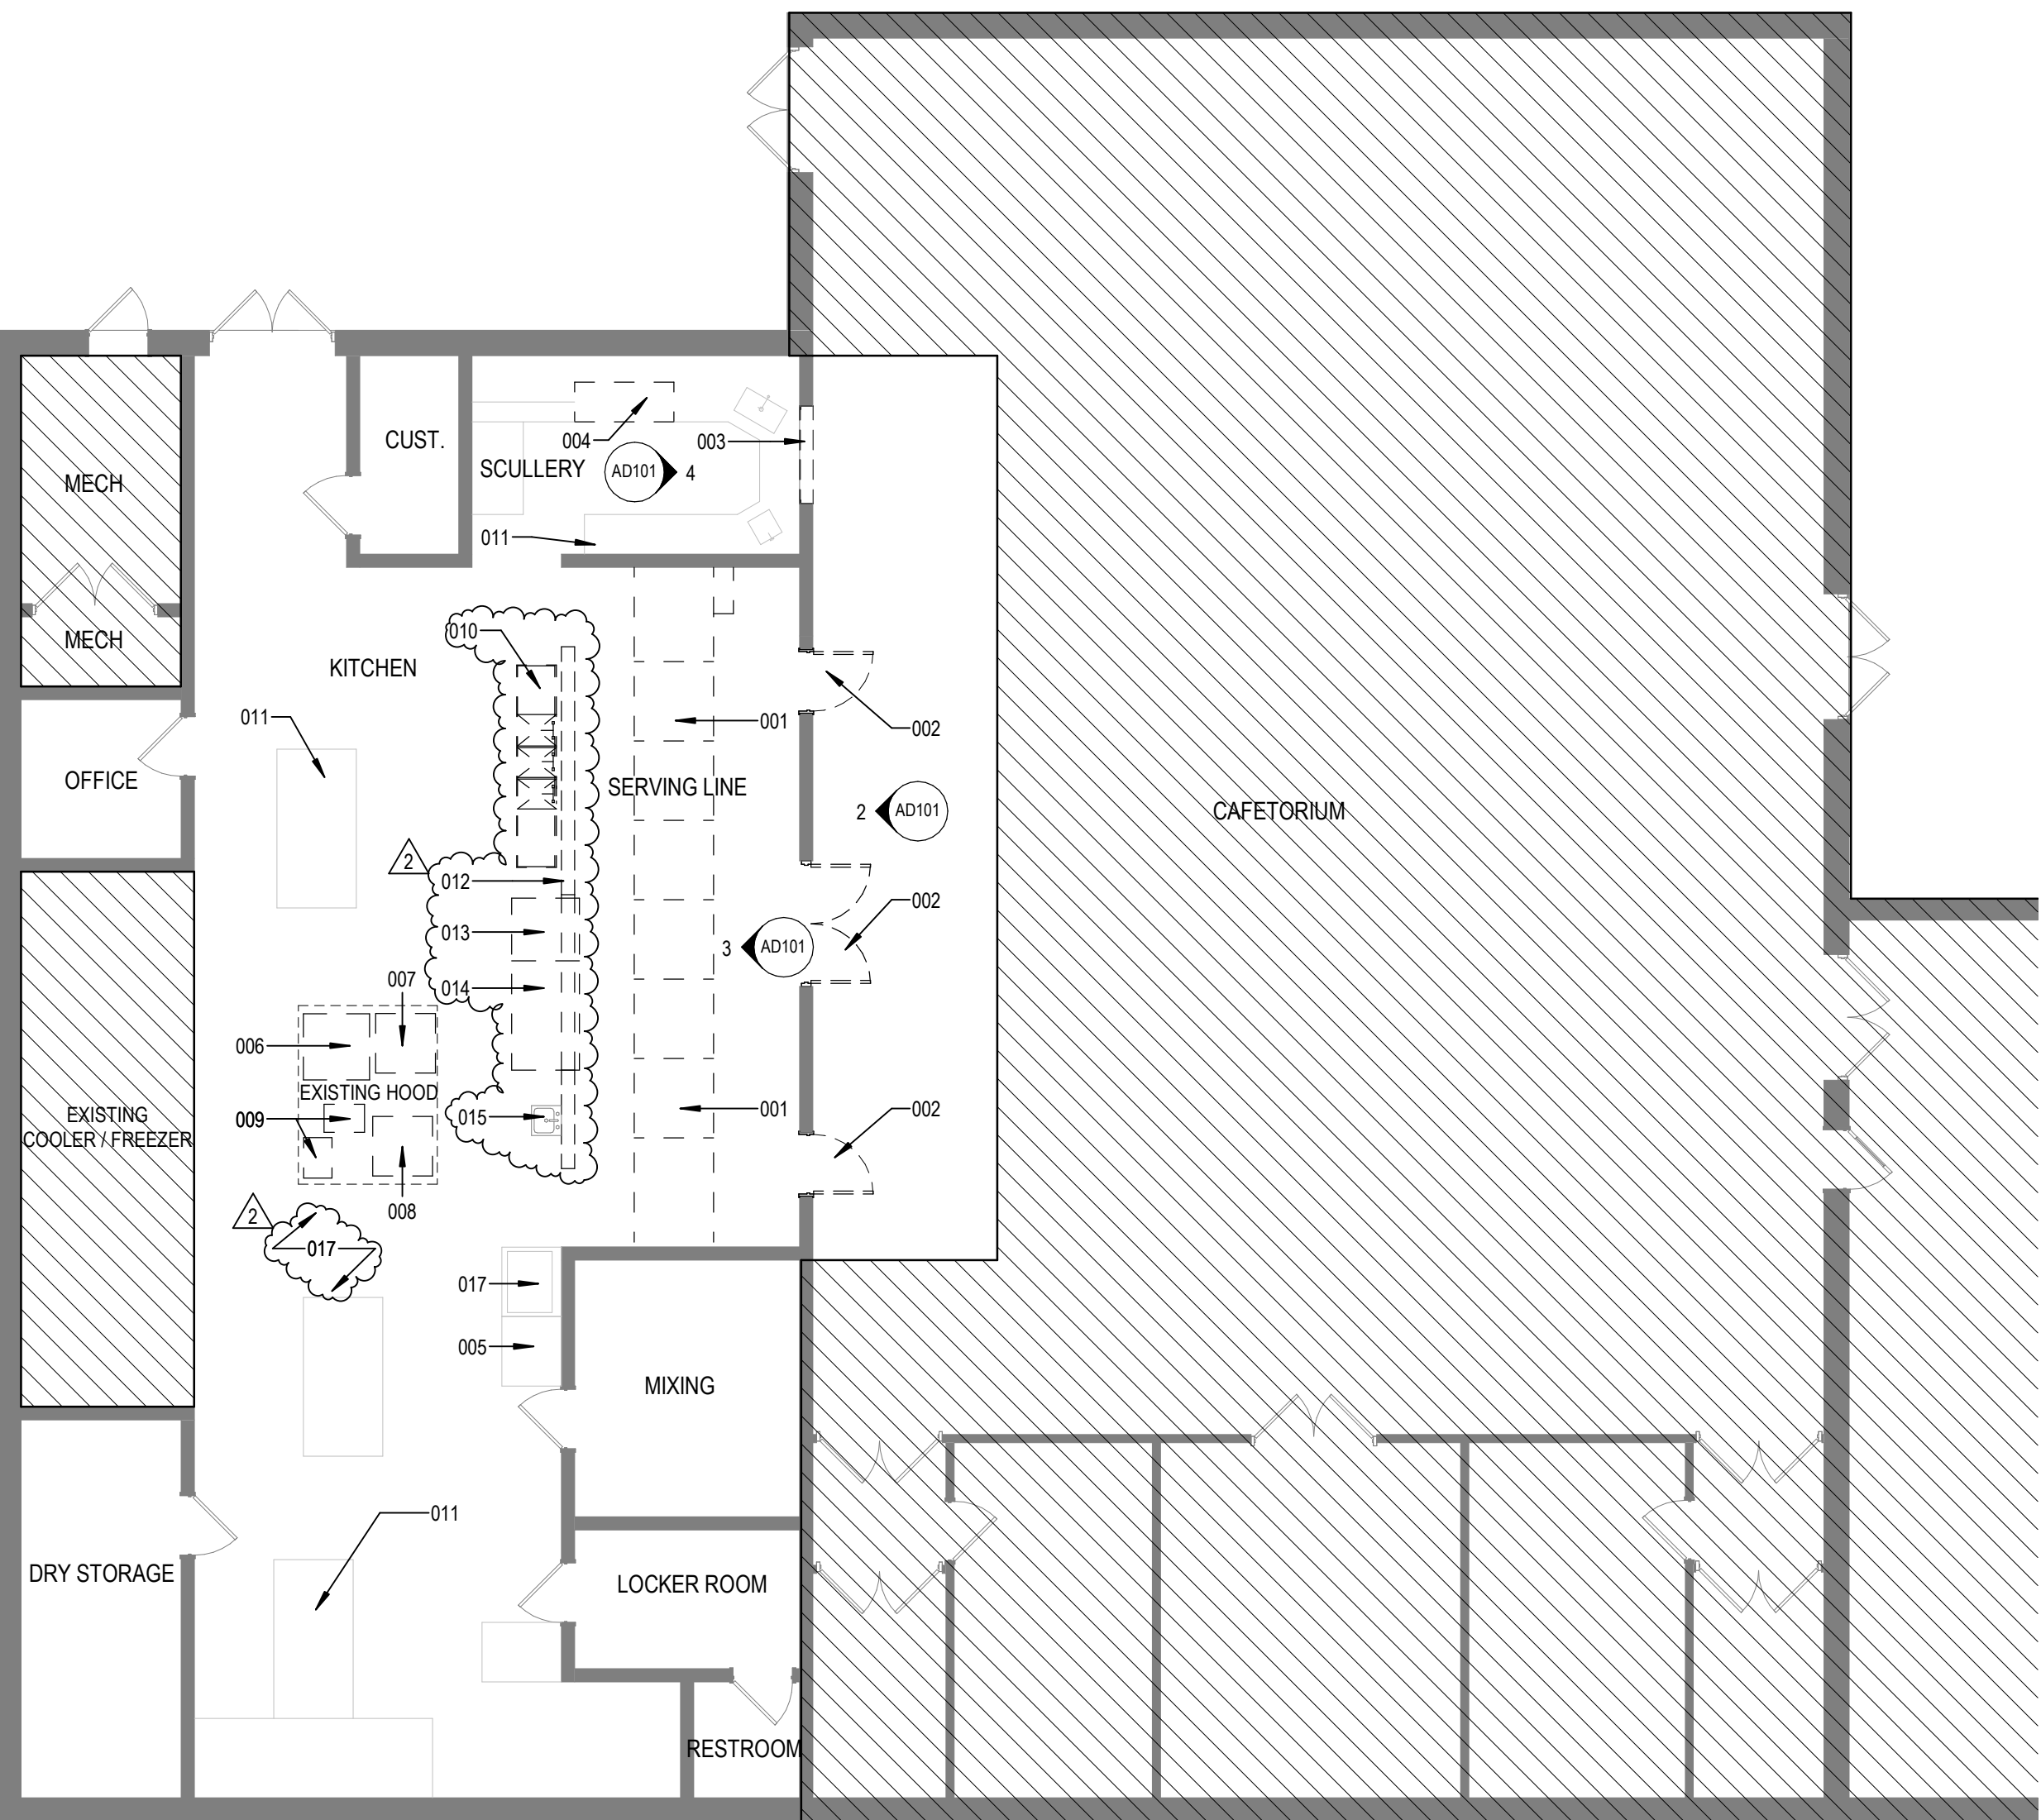

1 FIRST FLOOR DEMO PLAN  
1/8" = 1'-0" REF 5 / A-101



DIVISION 22 PLUMBING SPECIFICATIONS

A. GENERAL

- THESE DRAWINGS AND ACCOMPANYING SPECIFICATIONS ARE INTENDED TO DESCRIBE AND ILLUSTRATE SYSTEMS THAT WILL NOT INTERFERE WITH THE ARCHITECTURAL AND STRUCTURAL CONDITIONS OF THE BUILDING, AND WILL FIT INTO AVAILABLE SPACES.
- CAREFULLY LAY OUT ALL WORK TO CONFORM TO THE ARCHITECTURAL, STRUCTURAL, AND FINISH CONDITIONS, AND WITH OTHER TRADES PRIOR TO STARTING ANY WORK, TO AVOID OBSTRUCTIONS AND TO ALLOW THE PROPER INSTALLATION OF EACH ITEM. CONTRACTOR SHALL BECOME FAMILIAR WITH WALL AND PARTITION LOCATIONS, CEILING HEIGHTS, FINISHES, AND OTHER PERTINENT DATA FROM ARCHITECTURAL DRAWINGS. CONTRACTOR SHALL FURTHER BECOME FAMILIAR WITH LOCATIONS OF PIERS, BEAMS, COLUMNS, JOISTS, AND OTHER PERTINENT DATA FROM STRUCTURAL DRAWINGS.
- CONTRACTOR SHALL SECURE AND PAY FOR ALL PERMITS AND INSPECTIONS. CONTRACTOR SHALL GIVE ALL NOTICES, FILE ALL NECESSARY DRAWINGS, AND OBTAIN ALL PERMITS AND CERTIFICATES FOR APPROVAL FROM THE LOCAL AUTHORITIES HAVING JURISDICTION AS REQUIRED FOR THE PARTICULAR CLASS OF WORK INVOLVED.
- EXECUTE ALL WORK IN ACCORDANCE WITH (BASE BUILDING STANDARDS SET FORTH BY THE BUILDING OWNER) AND LOCAL, STATE, NATIONAL, CODES, ORDINANCES, AND OTHER APPLICABLE REGULATIONS GOVERNING THE PARTICULAR CLASS OF WORK INVOLVED. THE GOVERNING CODES ARE MINIMUM REQUIREMENTS AND WHERE THE CONTRACT DOCUMENTS EXCEED CODE REQUIREMENTS, THESE DOCUMENTS SHALL PREVAIL.
- UNLESS SPECIFICALLY DIRECTED OTHERWISE, FURNISH AND INSTALL EACH AND EVERY ITEM CONTAINED IN, AND ASSOCIATED WITH, THE PARTICULAR CLASS OF WORK INVOLVED AS SHOWN ON THE DRAWINGS AND FURTHER DESCRIBED IN THESE SPECIFICATIONS, TOGETHER WITH ALL APPURTENANCES AND INCIDENTALS NECESSARY TO COMPLETE THE WORK. THIS SHALL INCLUDE, BUT NOT NECESSARILY BE LIMITED TO, LABOR, TRANSPORTATION, TOOLS, STORAGE, CUTTING, PATCHING AND CLEAN-UP.
- LOCATE ALL EQUIPMENT, FIXTURES, DUCTWORK, PIPING, AND OTHER ITEMS IN APPROXIMATE LOCATIONS SHOWN. PROVIDE ANY ADDITIONAL SUPPORTS, HANGERS, AND OPENINGS, AS REQUIRED FOR A COMPLETE AND SATISFACTORILY OPERATING INSTALLATION. COORDINATE ALL WORK TO PROVIDE FOR ALL SERVICE AND ACCESS CLEARANCES AS RECOMMENDED BY THE EQUIPMENT MANUFACTURER. ALL EQUIPMENT AND INSTALLATIONS SHALL BE INSTALLED PER MANUFACTURER'S RECOMMENDATIONS.
- THE LOCATIONS, POINTS OF CONNECTION, DIMENSIONAL DATA AND OTHER MEASUREMENTS SHOWN ARE OFFERED AS A GENERAL GUIDE ONLY AND WITHOUT GUARANTEE OF COMPLETE ACCURACY. ALL EXISTING ITEMS SHOWN ARE NOT TAKEN FROM EXISTING "AS-BUILT" DRAWINGS AND LIMITED FIELD SURVEY. CONTRACTOR SHALL VISIT THE SITE, AND REASONABLY FIELD VERIFY THE WORKING CONDITIONS REQUIRED TO INSTALL THE PARTICULAR CLASS OF WORK INVOLVED. MAKE PROVISIONS IN BID FOR SAME TO ASSURE THAT THE RESULTING INSTALLATION WILL BE COMPLETE, COORDINATED, AND RESULT IN A PROPERLY OPERATING SYSTEM.
- CONTRACTOR SHALL PROVIDE THE OWNER WITH ONE COPY OF THESE DRAWINGS, MARKED WITH ANY ADDITIONS TO, OR DEVIATIONS FROM, THE WORK ILLUSTRATED, TO REPRESENT "AS-BUILT" CONDITIONS.
- CONTRACTOR SHALL GUARANTEE THE ENTIRE INSTALLATION AGAINST DEFECTS IN MATERIALS AND WORKMANSHIP FOR A PERIOD OF ONE (1) YEAR AFTER SUBSTANTIAL COMPLETION.
- COOPERATE WITH OTHER TRADES TO KEEP THE WORK AREA CLEAN AND FREE OF UNNECESSARY MATERIALS OR DEBRIS ON A DAILY BASIS. WHEN WORK IS COMPLETE, REMOVE ALL TOOLS, SCAFFOLDING, MACHINERY, AND DEBRIS. CLEAN ALL DIRT AND DUST FROM ITEMS OF WORK AND BROOM SWEEP THE WORK AREA DAILY.
- COOPERATE WITH THE OWNER'S REPRESENTATIVE AND OTHER TRADES TO MEET THE ESTABLISHED CONSTRUCTION SCHEDULE. SCHEDULE WORK SO AS TO AVOID DELAYING OTHER TRADES.
- PROVIDE PIPING MARKERS FOR THE PIPING SYSTEMS, TO INCLUDE FLOW ARROWS, EVERY 30' ON CENTER AND 3'-0" BEFORE AND AFTER ELBOWS OR TEES.
- SUBMIT ON ALL EQUIPMENT AND MATERIALS SPECIFIED HEREIN PRIOR TO COMMENCING WITH ANY WORK. FAILURE TO COMPLY WILL RESULT IN REPLACEMENT OF ALL ITEMS FOUND NOT IN COMPLIANCE WITH THESE REQUIREMENTS.
- PROTECT ALL BUILDING COMPONENTS, WALLS, ROOFS, FLOORS, ADJACENT EQUIPMENT, LIGHTING, ETC. ANY ITEMS DAMAGED, OR WHERE FINISHES HAVE BEEN MARRED, SHALL BE REPAIRED TO THEIR ORIGINAL CONDITION AT NO COST TO THE OWNER. ALL ITEMS SOILED IN THE PROGRESS OF WORK SHALL BE CLEANED TO A "LIKE NEW," OR PRE-EXISTING, CONDITION.
- AT TIME OF FINAL INSTALLATION OBSERVATIONS, THE OPERATION OF ALL SYSTEMS OR EQUIPMENT SHALL HAVE BEEN DEMONSTRATED TO PERFORM PROPERLY.
- ANY DISCREPANCIES DISCOVERED BY THE CONTRACTOR DURING BIDDING SHALL BE BROUGHT TO THE ATTENTION OF THE ARCHITECT OR ENGINEER SO THAT AN ADDENDUM MAY BE ISSUED TO ADDRESS THOSE ITEMS PRIOR TO BIDDING. ANY DISCREPANCIES DISCOVERED AFTER BIDDING, THAT WERE REASONABLE TO HAVE BEEN DISCOVERED, SHALL BE CORRECTED AT THE EXPENSE OF THE CONTRACTOR.
- FOR RENOVATION AND REMODEL WORK, CAREFULLY REMOVE AND PROTECT ALL UNUSED EXISTING FIXTURES/EQUIPMENT, PIPING, DUCTWORK, ELECTRICAL SERVICES, AND ALL OTHER ITEMS ASSOCIATED THEREWITH WHERE INDICATED. COORDINATE WITH OWNERS REPRESENTATIVE PRIOR TO REMOVAL AND DISPOSAL. TO VERIFY WHETHER OWNER DESIRES TO KEEP ANY EXISTING ITEMS AND THE DESIRED MANNER OF DISPOSITION THEREOF. STORE ALL REMOVED ITEMS ON SITE FOR A MINIMUM OF TWO (2) WEEKS, UNLESS INDICATED OTHERWISE BY THE OWNER'S REPRESENTATIVE. TO ALLOW FOR INSPECTION BY THE OWNER. ALL ITEMS NOT RETAINED BY THE OWNER SHALL BE REMOVED FROM THE SITE BY THE CONTRACTOR AT THE CONTRACTOR'S EXPENSE. REFER TO ARCHITECTURAL, MECHANICAL, AND ELECTRICAL DEMOLITION DRAWINGS.
- EXISTING BUILDING OPERATIONS MUST REMAIN ACTIVATED AT ALL TIMES DURING NORMAL OPERATING HOURS. OBTAIN PERMISSION FROM OWNERS REPRESENTATIVE PRIOR TO SHUTTING-DOWN ANY BUILDING SYSTEM. PROVIDE TEMPORARY CONNECTIONS OF UTILITIES AND AIR CONDITIONING AS NECESSARY TO FACILITATE THE PHASES OF CONSTRUCTION. MAINTAIN AIR DISTRIBUTION AND PIPING SYSTEMS TO OTHER FLOORS OF THE BUILDING OUTSIDE OF THE DEMOLITION AREA. SHUT DOWN OF EXISTING SYSTEMS SHALL OCCUR DURING UNOCCUPIED PERIODS WHERE POSSIBLE.
- PENETRATIONS OF THE CEILINGS, WALLS, OR FLOORS SHALL BE PATCHED, SLEEVED, SEALED, ESCUTCHEONED, AND RESTORED TO THE ORIGINAL FINISH CONDITIONS AND FIRE RATINGS. COORDINATE ALL PENETRATIONS WITH OTHER TRADES.

B. PLUMBING SCOPE OF WORK:

- PROVIDE ALL MATERIALS, EQUIPMENT, AND PAY ALL COSTS CONNECTED WITH THE MODIFICATIONS OF EXISTING PLUMBING SYSTEMS AS SHOWN ON THE DRAWINGS, AND AS HEREINAFTER SPECIFIED.
- IT SHALL BE THE CONTRACTOR'S RESPONSIBILITY TO FURNISH ALL ITEMS OF MATERIAL AND LABOR, AND ALL OTHER COSTS, TO COMPLETE THE WORK WITHIN THE INTENT OF THESE DRAWINGS, EVEN THOUGH EACH AND EVERY ITEM NECESSARY IS NOT SPECIFICALLY MENTIONED OR SHOWN.
- SUBMIT MANUFACTURER'S BROCHURES ON BASIC MATERIALS AND PLUMBING FIXTURES TO THE ARCHITECT AND ENGINEER FOR REVIEW AND APPROVAL.
- ALL WORK SHALL BE AS INDICATED ON THE DRAWINGS AND SHALL INCLUDE, BUT NOT BE LIMITED TO:
  - DOMESTIC COLD WATER SYSTEM, INCLUDING DISTRIBUTION AND BACKFLOW PREVENTION, AS REQUIRED BY CODE AND CONNECTION TO EXISTING WATER SUPPLIES.
  - DOMESTIC HOT WATER SYSTEM, INCLUDING EXTENDING AND CONNECTION TO DISTRIBUTION PIPING.
  - TRIM FOR PLUMBING FIXTURES, INCLUDING SETTING, AND FINAL CONNECTIONS.
  - THERMAL INSULATION OF ALL PIPING SYSTEMS.
  - ROUGH-IN AND FINAL CONNECTIONS FOR OWNER FURNISHED EQUIPMENT AND EQUIPMENT FURNISHED BY OTHER TRADES.
  - ALL PERMITS AND FEES.
  - INSPECTION AND TESTING.

C. PLUMBING MATERIALS AND WORKMANSHIP:

1. UTILITY CONNECTIONS:

- CONTRACTOR SHALL, BEFORE COMMENCEMENT OF THE PROJECT, VERIFY THE LOCATION, DEPTH, SIZE, AND PRESSURE OR GRADE OF ALL EXISTING BUILDING UTILITY LINES TO WHICH CONNECTIONS FOR SERVICE ARE TO BE MADE. IF, FOR ANY REASON, CONDITIONS APPEAR TO AFFECT THE LOCATION, DEPTH, SIZE, AND PRESSURE OR GRADE, AND OPERATION OF THESE SYSTEMS, SUCH CONDITIONS SHALL BE REPORTED TO THE PROJECT COORDINATOR IN WRITING FOR RESOLUTION THEREBY.
- ALL CHARGES FOR CUTTING AND PATCHING OF CONCRETE SLAB, WALLS, ETC., REQUIRED FOR THESE SERVICES, SHALL BE INCLUDED IN THE BID.

2. SANITARY SEWER/VENT SYSTEM:

- FURNISH AND INSTALL A COMPLETE SANITARY SYSTEM OF SOIL, WASTE, AND VENT PIPING FOR ALL NEW AND RELOCATED FIXTURES, DRAINS, EQUIPMENT DISCHARGES, ETC., AS SHOWN ON THE DRAWINGS AND HEREINAFTER SPECIFIED. ALL PIPING SHALL RUN STRAIGHT AS POSSIBLE AND BE INSTALLED TO GRADE A MINIMUM OF 1/4" PER FOOT FOR PIPING 3" AND SMALLER, AND 1/8" PER FOOT FOR PIPING 4" AND LARGER, UNLESS NOTED OTHERWISE. INSTALL THE SYSTEM IN ACCORDANCE WITH ALL LOCAL CODES.
- SANITARY SYSTEM WASTE AND VENT PIPING SHALL BE CISPI 301, OR ASTM B898 SERVICE WEIGHT ASPHALTUM COATED CAST IRON SOIL PIPE AND ASTM A74 SERVICE WEIGHT CAST IRON FITTINGS. JOINTS SHALL BE MADE WITH A STAINLESS STEEL CORRUGATED SHIELD AND CLAMP ASSEMBLY OVER ONE PIECE NEOPRENE SEALING SLEEVE. CLAMP-ALL "HI-TORQ 80" OR HUSKY SD-2000. CONTRACTOR SHALL INSTALL ALL UNDERGROUND SANITARY PIPING WITH POLY VINYL CHLORIDE (PVC) SCHEDULE 40, 60 DRAIN WASTE VENT (DWV) PIPE, ASTM D2466, (ASTM D 2321, ASTM D2665 AND ASTM 1785, NSF STAMPED AND APPROVED. SYSTEM SHALL BE RATED FOR 200 PSI MINIMUM PRESSURE. FITTING SHALL BE POLY VINYL CHLORIDE (PVC) SCHEDULE 40, DWV PATTERNED FITTINGS, ASTM D2466 AND ASTM 1784, NSF STAMPED AND APPROVED. SOLVENT CEMENT: SHALL COMPLY WITH PIPE AND FITTING MANUFACTURER'S RECOMMENDATIONS AND SHALL BE A TWO (2) STEP PROCESS WITH PREPARED MANUFACTURED FOR THERMOPLASTIC PIPING SYSTEMS AND SOLVENT CEMENT PER MANUFACTURER AND SHALL CONFORM TO ASTM D264 AND ASTM F656.
- PVC PIPE MATERIAL SHALL NOT BE ALLOWED TO SERVE FIXTURES, DRAINS, OR EQUIPMENT SUBJECT TO RECEIVING FLUIDS WITH TEMPERATURES OF 140 DEG.F. OR HIGHER. PROVIDE CAST IRON SERVICE WEIGHT AND FITTINGS AS SPECIFIED UNLESS OTHERWISE EXTEND A MINIMUM OF 20' (TWENTY FEET) OR TO MAIN WASTE LINE TO ASSURE HIGH TEMPERATURE COOLING IN CAST IRON PIPE BEFORE ENTERING PVC PIPING MATERIAL. WHERE PVC IS REQUIRED, EXTEND BELOW GRADE PROVIDE CAST IRON PIPE WITH BELL AND SPIGOT JOINTS, AND USE NEOPRENE COMPRESSION GASKET SEALS, ASTM C564. PIPES AND JOINTS SHALL BE MARKED WITH THE APPLICABLE CISPI STANDARD COMPLIANCE COLLECTIVE TRADEMARK.

3. FLOOR DRAINS/FLOOR SINKS:

- CURRENTLY THERE ARE NO NEW FLOOR DRAINS OR FLOOR SINKS. ALL NEW FIXTURES AND EQUIPMENT WILL DISCHARGE OPEN SITE AT EXISTING FLOOR DRAINS AND FLOOR SINKS.

4. FIELD QUALITY CONTROL

- FURNISH INSTRUMENTS, EQUIPMENT, AND LABOR NECESSARY TO CONDUCT TESTS.
- TEST DRAINAGE, WASTE, AND VENTING PIPING WITH WATER BEFORE FIXTURES ARE INSTALLED.
- AFTER PLUMBING FIXTURES HAVE BEEN SET AND TRAPS FILLED WITH WATER, SUBMIT ENTIRE DRAINAGE, WASTE, AND VENTING SYSTEM TO FINAL TEST WITH SMOKE.

5. DOMESTIC WATER SYSTEM:

- FURNISH AND INSTALL A COMPLETE WATER SUPPLY SYSTEM WITH BRANCH LINES AND SERVICING ALL NEW AND EXISTING SINKS, SINKS, FIXTURES, FAUCETS, EQUIPMENT, ETC., AS INDICATED ON THE DRAWINGS, AND AS SPECIFIED HEREIN.
- PIPE MATERIALS: WATER PIPING LOCATED ABOVE GRADE 2-1/2" AND SMALLER SHALL BE, ASTM E88 TYPE "L" HARD COPPER TUBING WITH ANSI B16.22 WROUGHT COPPER FITTINGS. JOINTS SHALL BE MADE WITH 95% SOLDER. WATER PIPING LOCATED BELOW GRADE SHALL BE, ASTM B88 TYPE "K", SOFT COPPER. THERE SHALL BE NO JOINTS IN TUBING LOCATED UNDER THE SLAB.
- VALVES: PROVIDE BRONZE LEAD FREE BALL VALVES WITH STAINLESS STEEL BALL AND STEMS FOR PIPE SIZES 2 1/2" AND SMALLER. VALVES SHALL BE EQUAL TO THAT AS MANUFACTURED BY HAMMOND - ULTRAPURE.
- RO WATER PIPING: ALL REVERSE OSMOSIS PIPING SHALL BE SCH. 40 SOCKET FUSED, UNIMPREGNATED TYPE 2 VIRGIN NATURAL POLYPROPYLENE CONFORMING TO ASTM D4101. FITTINGS SHALL BE BY SAME MANUFACTURER AS THE PIPING AND SHALL BE SOCKET FUSION UNIMPREGNATED TYPE 2 VIRGIN COPOLYMER POLYPROPYLENE. BALL VALVES SHALL BE DOUBLE-BLOCKING TYPE WITH O-RING CUSHIONS UNDER THE PTFE SEATS, VIRGIN, UNIMPREGNATED TYPE 1 HOMOPOLYMER POLYPROPYLENE. ACCEPTABLE MANUFACTURER: IPEX - ENPURE HIGH-PURITY POLYPROPYLENE OR EQUAL BY ORION.
- PIPING SHALL BE INSTALLED WITH A GRADE FOR DRAINAGE TOWARD MAIN SUPPLY RISERS AND TO FIXTURE CONNECTIONS TO ALLOW COMPLETE DRAINAGE OF THE SYSTEM.
- WATER SYSTEM SHALL BE STERILIZED WITH A SOLUTION OF HTH IN ACCORDANCE WITH THE REQUIREMENTS OF THE STATE PUBLIC HEALTH DEPARTMENT. PUMP THE HTH SOLUTION INTO THE WATER SYSTEM AND FILL THE COMPLETE SYSTEM, INCLUDING BRANCH PIPES. EACH OUTLET SHALL BE FLUSHED FOR AIR DURING THE STERILIZATION PROCESS. SYSTEM SHALL BE COMPLETELY FLUSHED AFTER STERILIZATION.
- AT EACH FIXTURE FAUCET, PROVIDE A STOP VALVE IN EACH SUPPLY. STOP VALVES SHALL BE IN ACCORDANCE WITH PLUMBING CODE. PROVIDE IN-LINE CHECKS ON WATER SUPPLIES AT FAUCET WHERE REQUIRED TO PREVENT CROSS-CONNECTIONS. INSTALL AIR CHAMBERS 1'-6" MINIMUM HEIGHT AT ALL CONNECTIONS AND ASSE 1010 APPROVED & PDI CERTIFIED SHOCK ARRESTERS EQUAL TO "HYDRA-RESTER", SIOUX CHIEF MANUFACTURING CO.

- VACUUM BREAKERS:
  - ACCEPTABLE MANUFACTURER:
    - WATTS.
    - FEBCO.
    - BECCO.
  - ATMOSPHERIC CHECK VALVE TYPE.
  - BRONZE BODY CONSTRUCTION WITH POLISHED CHROME FINISH.

- SPILL-RESISTANT VACUUM BREAKERS:
  - ACCEPTABLE MANUFACTURER:
    - WATTS.
    - FEBCO.
    - BECCO.
  - ANTI-SIPHON
  - TESTABLE CHECK VALVE TYPE
  - LEAD FREE BRONZE BODY CONSTRUCTION WITH POLISHED CHROME FINISH.
  - EQUAL TO WATTS LF08PCQT

- REDUCED PRESSURE TYPE BACKFLOW PREVENTER ASSEMBLY (FOR NON-RO WATER):
  - ACCEPTABLE MANUFACTURERS:
    - WATTS.
    - AMES.
    - BECCO.
  - DOUBLE CHECK VALVE TYPE WITH SHUTOFF VALVES
    - QUARTER TURN BALL SHUT-OFF VALVES UP TO 2-1/2 INCHES.
    - OUTSIDE STEM AND YOKE GATE SHUT-OFF VALVES 3 INCHES AND OVER
  - DIFFERENTIAL PRESSURE TYPE RELIEF VALVE WITH AIR GAP FITTING
  - LEAD-FREE BRONZE BODY CONSTRUCTION UP TO 2-1/2 INCHES.
  - CAST IRON BODY CONSTRUCTION 3 INCHES AND OVER.
  - PROVIDE IN-LINE UPSTREAM Y-TYPE STRAINER.
    - 20 MESH STRAINER 2 INCHES AND BELOW.
    - 0.125 PERFORATED SCREEN MESH 2-1/2 INCHES AND OVER.
  - ACCEPTABLE PRODUCT: WATTS NO. 909S (FDA)-QT.


- REDUCED PRESSURE TYPE BACKFLOW PREVENTER ASSEMBLY - STAINLESS STEEL (FOR CONNECTION TO COMMERCIAL DISHWASHERS):
  - ACCEPTABLE MANUFACTURERS:
    - WATTS.

- APOLLO.
- WILKINS.
- DOUBLE CHECK VALVE TYPE WITH SHUTOFF VALVES
  - QUARTER TURN BALL SHUT-OFF VALVES UP TO 1 INCHES.
- DIFFERENTIAL PRESSURE TYPE RELIEF VALVE WITH AIR GAP FITTING
- LEAD-FREE STAINLESS STEEL BODY CONSTRUCTION UP TO 1 INCHES.
- PROVIDE IN-LINE UPSTREAM Y-TYPE STRAINER.
  - 20 MESH STRAINER 1 INCHES AND BELOW.
  - ACCEPTABLE PRODUCT: WATTS NO. 009SS-QT.


- PROVIDE STAINLESS STEEL, 16 INCH BY 16 INCH ACCESS DOORS WITH CAM LOCKS EQUAL TO MILCOR STYLE "K, M OR DW" AS REQUIRED FOR ACCESS TO ALL VALVES BEHIND GYPSUM BOARD CEILINGS AND WALLS, PAINT TO MATCH ADJACENT FINISHES.
- INSTALL BRONZE LEAD FREE CHECK VALVES IN THE HOT AND COLD WATER BRANCHES TO MIXING TYPE FAUCETS OR MIXING VALVES, AS REQUIRED TO PREVENT CROSS-CONNECTIONS.
- INSULATION: INSULATION OF ALL DOMESTIC HOT AND COLD WATER PIPING WITHIN THE BUILDING AND ALL CONDENSATE DRAIN PIPING.
    - DOMESTIC COLD AND HOT WATER: ONE INCH (1") THICK, 4 POUND OR HEAVIER DENSITY, MOLDED SECTIONAL GLASS FIBER PIPE COVERING WITH FACTORY APPLIED, WHITE FRG, FIRE RESISTANT, VAPOR BARRIER JACKET. USE 7 PSF DENSITY INSULATION INSERTS WITH 16 GAUGE MOLDED FIBERGLASS WITH FIRE RESISTANT JACKET. ELBOWS AND FITTINGS WILL BE THE SAME THICKNESS.
    - CONDENSATE DRAIN: 1/2" ARMAFLEX OR APPROVED EQUAL.
    - COPPER TUBING BELOW SLAB OR CAST IN CONCRETE: 1/2" ARMAFLEX OR APPROVED EQUAL.

6. TESTS AND INSPECTIONS

- WASTE AND VENT PIPING SHALL BE TESTED ON COMPLETION OF THE ROUGH WORK AND BEFORE FIXTURES AND TRAPS ARE CONNECTED. ALL OPENINGS, EXCEPT HIGHEST VENTS, ARE TO BE PLUGGED AND THE SYSTEM COMPLETELY FILLED WITH WATER. SYSTEM SHALL STAND WITHOUT LEAK OR LOSS OF WATER FOR A PERIOD OF NOT LESS THAN FOUR (4) HOURS.
- ALL WATER PIPING SHALL BE PRESSURIZED HYDRAULICALLY AT 150 POUNDS PER SQUARE INCH AND THIS PRESSURE SHALL BE HELD WITHOUT ADDITIONAL PRESSURIZATION FOR NOT LESS THAN ONE (1) HOUR. EQUIPMENT, ETC., IN THE SYSTEM THAT MAY BE DAMAGED BY THIS PRESSURE SHALL BE ISOLATED OR DISCONNECTED FROM THE SYSTEM.

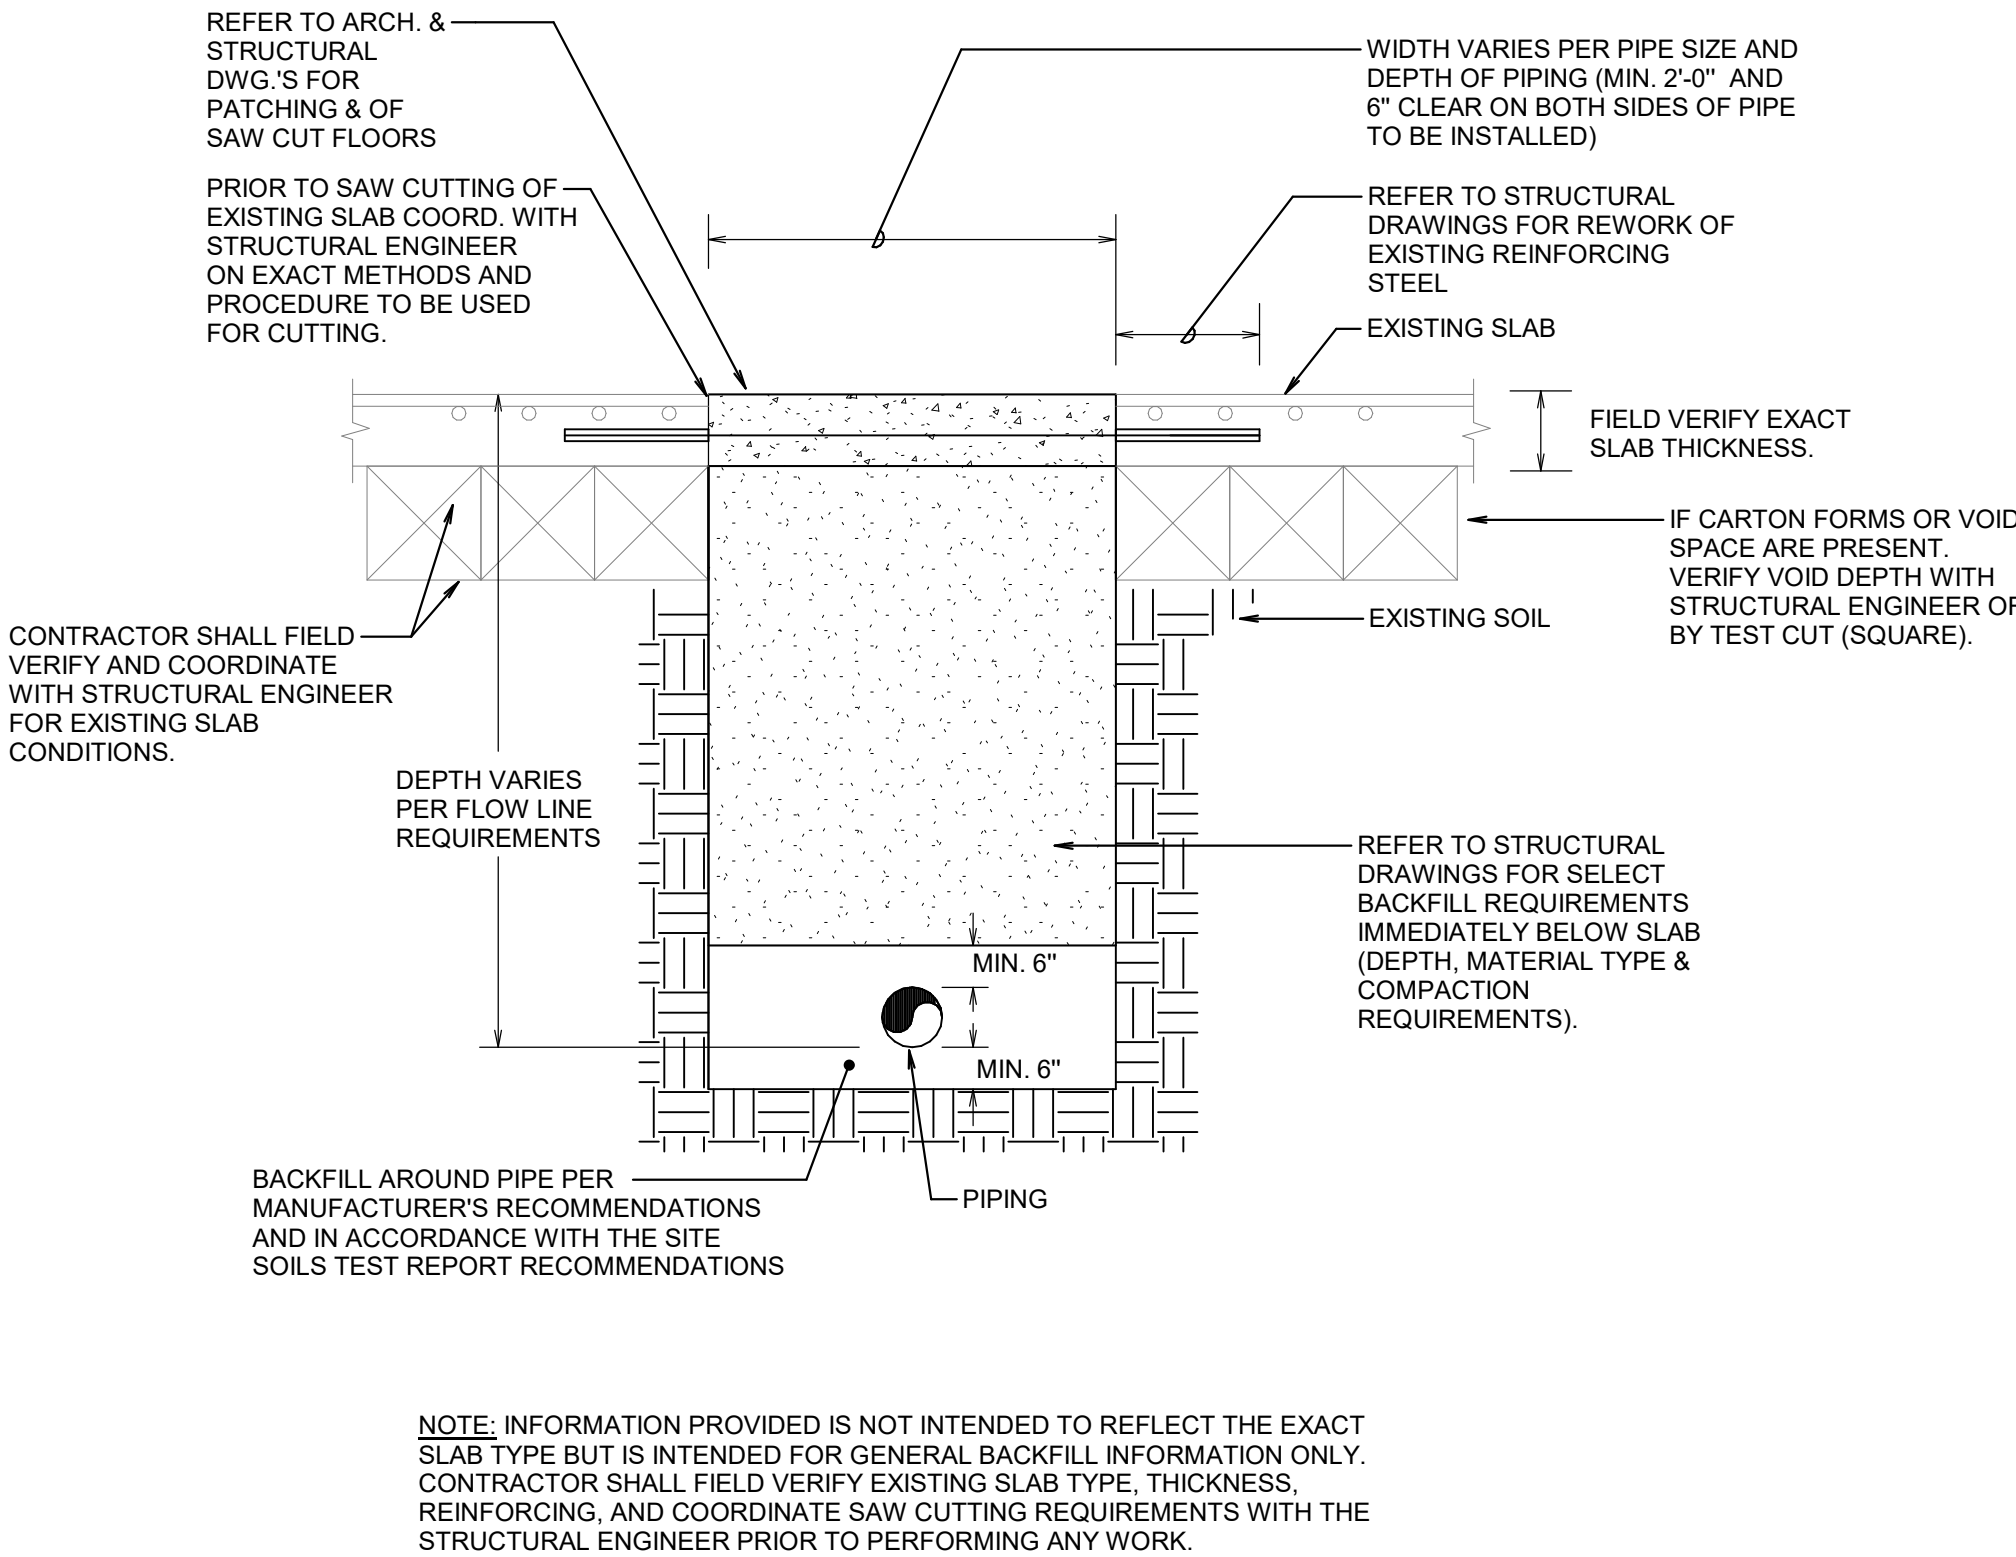

1 EXISTING FOUNDATION UNDERFLOOR PIPING DETAIL  
NO SCALE

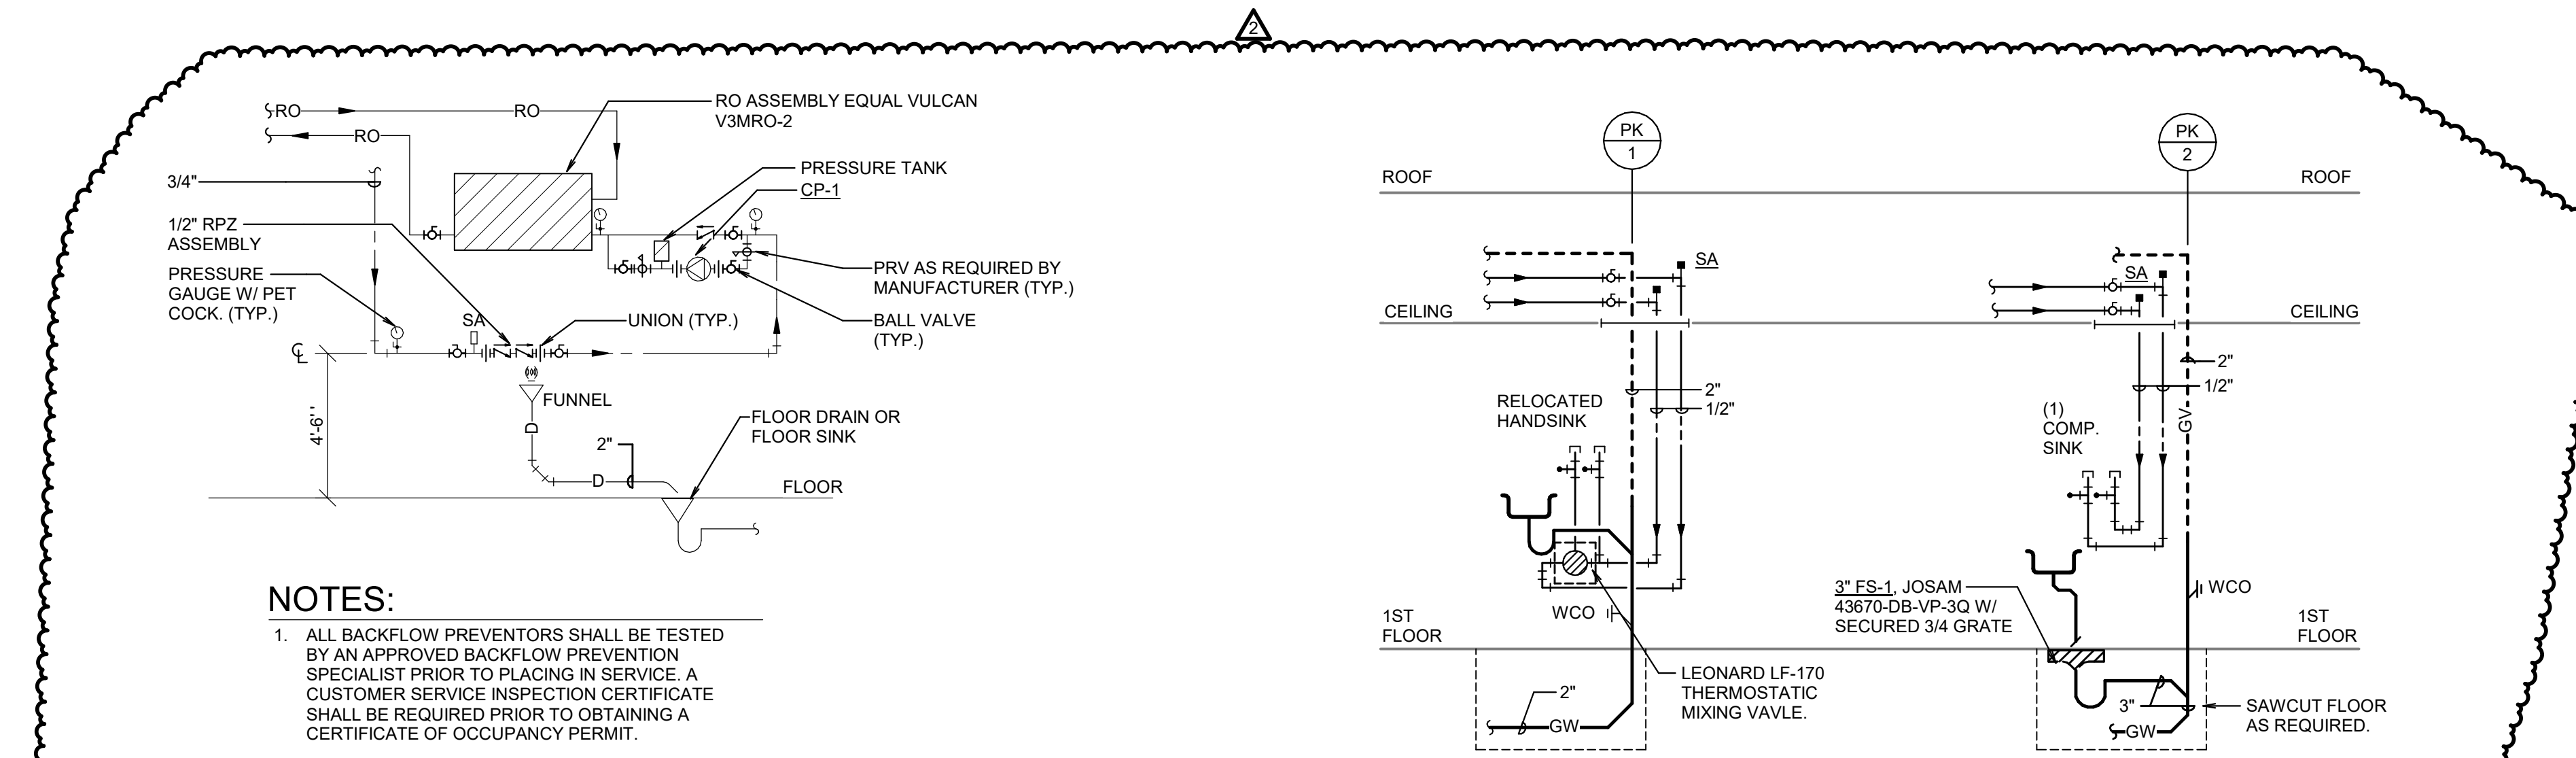

2 REDUCED PRESSURE BACKFLOW PREVENTER DETAIL  
NO SCALE

PLUMBING LEGEND									
SYMBOL	DESCRIPTION								
---	DOMESTIC COLD WATER (CW)								
---	DOMESTIC HOT WATER (HW)								
---	DOMESTIC HOT WATER RETURN (HWR)								
---	SANITARY WASTE (SS)								
---	SANITARY VENT (V)								
---	REVERSE OSMOSIS WATER (RO)								
---	EXISTING TO REMAIN								
---	FLOOR DRAIN								
---	FLOOR SINK								
---	GAS METER								
---	ROOF PIPE SUPPORT								
---	PLUG VALVE								
---	GAS PRESSURE REGULATOR								
---	RISE & DROP IN PIPING								
---	CLEANOUT								
---	BALL VALVE								
---	CHECK VALVE								
---	UNION								
---	GAS COCK								
---	PRESSURE REDUCING VALVE								
---	PRESSURE RELIEF VALVE								
---	HOSE BIBB								
---	NEW CONNECTION TO EXISTING								
O.F.C.I.	OWNER FURNISHED CONTRACTOR INSTALLED								
B.T.C.	BRANCH TO CONNECTION								
A.F.F.	ABOVE FINISHED FLOOR								
B.F.F.	BELOW FINISHED FLOOR								
B.F.G.	BELOW FINISHED GRADE								
EXT. GB.	EXTERIOR GRADE BEAM								
ℓ	FLOWLINE ELEVATION								
CO	CLEAN OUT								
FCO	FLOOR CLEAN OUT								
GCO	GRADE CLEAN OUT								
DCO	DOUBLE CLEAN OUT								
WCO	WALL CLEAN OUT								
VTR	VENT THROUGH ROOF								
(E)	EXISTING UTILITIES								

NOTE: NOT ALL SYMBOLS SHOWN ARE NECESSARILY USED


GENERAL PLUMBING NOTES:

- ALL DIMENSIONS AND FIELD CONDITIONS SHALL BE CHECKED AND VERIFIED BY CONTRACTOR AT THE SITE. THE LOCATION OF ALL NEW PIPING, FIXTURES, EQUIPMENT, LOCATIONS, SIZES, SCALES, AND DIMENSIONS SHALL BE CHECKED AND VERIFIED ON SITE.
- CONTRACTOR SHALL LAY OUT THEIR WORK BASED ON ACTUAL FIELD MEASUREMENTS AND ACTUAL DIMENSIONS OF EQUIPMENT AND FIXTURES INSTALLED. ALL PIPING AND EQUIPMENT OF ALL TRADES SHALL BE PROPERLY COORDINATED AND SET IN PLACE TO MAINTAIN REQUIRED SERVICE CLEARANCES. ALL INSTALLATIONS SHALL BE SUBJECT TO THE APPROVAL OF THE ARCHITECT.
- CONTRACTOR SHALL CHANGE THE LOCATION OF NEW PIPING, WHERE REQUIRED, TO MEET FIELD CONDITIONS.
- CONTRACTOR SHALL SUBMIT COMPLETE PRODUCT DATA ALONG WITH SHOP DRAWINGS. PREPARE AND SUBMIT 1/4" = 1'-0" SCALE PLUMBING PIPING SHOP DRAWINGS. CONTRACTOR SHALL FULLY COORDINATE ALL PIPING SHOP DRAWINGS WITH SHEET METAL SHOP DRAWINGS AND WITH THE WORK OF ALL OTHER TRADES. PRIOR TO SUBMITTAL SHOP DRAWINGS SHALL BE CHECKED FOR OBSTRUCTIONS AND INTERFERENCES. ETC. FAILURE TO SUBMIT SHOP DRAWINGS IN A TIMELY MANNER AS REQUIRED TO KEEP PACE WITH THE CONSTRUCTION SCHEDULE MAY RESULT IN DELAYS, AND POSSIBLE STOPPAGE OF PAYMENT TO THE CONTRACTOR. ADDITIONALLY, NO WORK MAY PROCEED UNTIL SUCH SHOP DRAWINGS ARE SUBMITTED, REVIEWED, AND FOUND TO BE ACCEPTABLE BY THE ARCHITECT AND ENGINEER.
- REFER TO AVAILABLE STRUCTURAL PLANS FOR EXACT LOCATION OF STRUCTURAL PIERS, BEAMS, JOISTS AND OTHER STRUCTURAL ELEMENTS. MODIFY PIPE ROUTING AS REQUIRED TO AVOID CONFLICTS WHERE SUCH OCCURS.
- REFER TO ARCHITECTURAL DRAWINGS FOR THE EXACT LOCATIONS OF ALL WALLS, PARTITIONS, CEILINGS, CEILING HEIGHTS, AND EQUIPMENT/FIXTURES.
- CONTRACTOR SHALL CONFIRM SCALE OF PLUMBING DRAWINGS BY COMPARISON WITH ARCHITECTURAL DRAWINGS TO VERIFY THE ACCURACY OF ALL TAKE-OFFS MADE DURING THE BIDDING PERIOD.
- ANY PIPE PENETRATIONS OF CEILINGS, WALLS OR FLOORS SHALL BE RESTORED TO THE FIRE RATINGS INDICATED ON THE ARCHITECTURAL DRAWINGS. FLOOR, WALL AND CEILING PIPING PENETRATIONS SHALL BE PATCHED, SLEEVED, SEALED, AND BE PROVIDED WITH APPROPRIATE ESCUTCHEONS WHERE LOCATED IN FINISHED/EXPOSED SPACES.
- REFER TO ARCHITECTURAL DRAWINGS FOR EXACT LOCATION OF FLOOR DRAINS, PLUMBING FIXTURES, & KITCHEN EQUIPMENT.
- ALL GREASE WASTE AND SANITARY SEWER PIPING THAT RECEIVES A DISCHARGE OF WASTE OR WATER THAT IS 140 DEGREE F. OR GREATER IN TEMPERATURE SHALL BE STANDARD WEIGHT CAST IRON PIPE WITH HUB AND SPIGOT FITTINGS FOR BURIED PIPING UNDER DIRT EVEN IF IN A CRAWL SPACE. INSTALLATIONS AND NO-HUB FOR ABOVE SLAB INSTALLATIONS OR SUSPENDED ABOVE GROUND IN A CRAWL SPACE, WITHOUT EXCEPTION, EXTEND CAST IRON PIPE TO BE A MINIMUM OF 20' TWENTY LINEAR FEET IN LENGTH BEFORE ALLOWING TRANSITION BACK TO ANOTHER PIPE MATERIAL, OR AFTER CONNECTING TO A MAIN DRAIN LINE.
- CONTRACTOR SHALL NOT DEVIATE FROM THE CONSTRUCTION DOCUMENTS. ANY DEVIATION SHALL RECEIVE WRITTEN ACCEPTANCE AND APPROVAL FROM THE OWNER AND ARCHITECT IN ADVANCE OF SUCH WORK BEING PERFORMED. SUBMIT SUCH REQUESTS TO THE ARCHITECT AND ENGINEER ALONG WITH THE MONETARY CREDIT, AS APPLICABLE. ANY DEVIATIONS FROM THE CONTRACT DOCUMENTS FOUND ON THE PROJECT THAT DID NOT RECEIVE A LETTER OF ACCEPTANCE AND APPROVAL FROM THE OWNER OR ARCHITECT SHALL BE FULLY REPLACED AND SHALL BE MADE TO BE IN FULL COMPLIANCE WITH THE CONSTRUCTION DOCUMENTS AT THE EXPENSE OF THE CONTRACTOR.

GENERAL DEMOLITION NOTES:

- THE INFORMATION SHOWN ON THE DEMOLITION DRAWINGS IS NOT TAKEN FROM "AS BUILT" DRAWINGS. CONTRACTOR SHALL BE RESPONSIBLE FOR VISITING THE SITE PRIOR TO SUBMITTING A BID TO DETERMINE THE GENERAL AMOUNT OF WORK THAT WILL BE REQUIRED. CONTRACTOR SHALL EXAMINE THE EXISTING BUILDING, VERIFY THE GENERAL LOCATION OF ALL EXISTING WORK, AND BECOME INFORMED AS TO THE RELATION TO AND IMPACT ON THE WORK REQUIRED. SUBMISSION OF A BID WILL CONSTITUTE EVIDENCE THAT THE CONTRACTOR HAS INSPECTED THE SITE IN THE FASHION NOTED ABOVE.
- COORDINATE DEMOLITION WORK WITH BUILDING MAINTENANCE PERSONNEL AND OTHER TRADES PERFORMING WORK IN THE BUILDING PRIOR TO THE REMOVAL OF ANY ITEMS OF EQUIPMENT OR SYSTEMS THAT SHALL AFFECT OTHER SYSTEMS WITHIN THE LIMITS OF NEW CONSTRUCTION OR OTHER AREAS OF THE EXISTING BUILDING.
- WORK SHOWN ON THE DEMOLITION DRAWINGS DOES NOT NECESSARILY REFLECT ALL OF THE EXISTING CONDITIONS OR THE COMPLETE SCOPE OF THE DEMOLITION WORK. THIS WORK SHALL BE BASED ON THE DEMOLITION DRAWINGS, EXISTING DRAWINGS MADE AVAILABLE TO THE CONTRACTOR AND FIELD.
- THE DRAWINGS ONLY REFLECT KNOWN AREAS OF DEMOLITION. CONTRACTOR SHALL BE RESPONSIBLE FOR FIELD VERIFICATION OF THE COMPLETE SCOPE OF THE DEMOLITION WORK.
- CONTRACTOR SHALL TRACE ALL PIPING BACK TO MAIN RISERS AND/OR SUPPLIES, AND VERIFY THAT PIPING DOES NOT SERVE ANY OTHER FIXTURES TO REMAIN. CONTRACTOR SHALL OBTAIN APPROVAL FROM OWNER'S REPRESENTATIVE PRIOR TO REMOVAL OF PIPING TO BE DEMOLISHED.
- FLUSH AND CLEAN ALL EXISTING FLOOR DRAINS, AREAWAY DRAINS, AND RELATED DRAIN PIPING AS NEEDED DURING CONSTRUCTION, AND AT THE COMPLETION OF THE PROJECT, TO PREVENT BLOCKAGE OF THE DRAINS WITH CONSTRUCTION DIRT, TRASH AND DEBRIS.
- CONTRACTOR SHALL PATCH AND REPAIR ALL WALLS, FLOORS AND CEILINGS TO MATCH EXISTING FINISHES OR PROPOSED NEW FINISHES, AS APPLICABLE, AND AS NECESSARY WHICH ARE AFFECTED BY THE REMOVAL AND/OR REWORK OF PLUMBING FIXTURES AND PIPING.

This third copy or electronic drawing is an instrument of service and the property of Orcutt Winslow and shall remain their property. The design professional and not be responsible for any alterations, modifications or additions made to the drawing by any party other than the design professional. Use of this drawing and its contents in the original and for which was prepared and published herein is expressly limited to such use, no reuse or reproduction. Unless otherwise agreed in writing, design professional reserves all copyright and other proprietary rights in this drawing, and it may not be used for any other purpose without the design professional's written consent. Violation of any method or use of this information obtained or constructed derived from this drawing shall be at the user's sole risk.

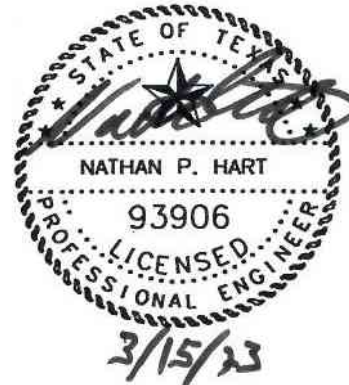

KITCHEN RENOVATION  
1050 PARK PLACE BLVD.  
MIDLOTHIAN, TX 76065  
THE BAXTER ELEMENTARY SCHOOL

CLIENT CONTACT  
Midlothian ISD  
100 Walter Stephenson Rd.  
Midlothian, TX 76065

jose.martinez1@misd.g


OWP PROJECT NO. DATE OF ISSUE  
2022-1110-00 01.18.2023

REVISIONS	DATE
DELTA	DESCRIPTION
2	Addendum 2 03



1. CONTRACTOR SHALL REMOVE EXISTING WET SPRINKLER SYSTEM AS REQUIRED TO ACCOMMODATE AREAS OF NEW CONSTRUCTION, INCLUDING ALL AREAS OF RENOVATION. AREAS OF THE EXISTING BUILDING NOT CURRENTLY SPRINKLERED AND ADDITIONS. CONTRACTOR SHALL REMOVE THE EXISTING FIRE RISER, FIRE MAIN, FIRE MAIN DISTRIBUTION SYSTEMS AND BRANCH PIPING AS REQUIRED IN ORDER TO ACCOMMODATE THE RENOVATED AREAS, AREAS OF NEW CONSTRUCTION AND AREAS OF THE BUILDING NOT CURRENTLY SPRINKLERED. RELOCATE AND/ OR REPLACE EXISTING SPRINKLER MAINS, BRANCH PIPING AND SPRINKLERS AS REQUIRED TO ACCOMMODATE CONSTRUCTION. PROVIDE NEW SPRINKLERS AS REQUIRED TO SPRINKLERED AREAS OF NEW CONSTRUCTION. PIPING IS REMOVED DISCONNECT & CAP ABOVE CEILING. CONTRACTOR SHALL VERIFY SCOPE OF WORK PRIOR TO BID SUBMITTAL.

- 1 SAWCUT EXISTING PIPING TO ACCOMMODATE NEW RO SYSTEM PIPING BELOW GRADE. ROUTE RO PIPING IN 3" PVC SLEEVE BELOW FLOOR. REFER TO DETAIL "01" ON SHEET P000.
- 2 RO ASSEMBLY AND RPZ. MOUNT RO ASSEMBLY ABOVE RPZ MAX 6'-0" AFF. REFER TO DETAIL "02" ON SHEET P000 FOR RPZ DETAIL. COORDINATE FINAL APPROVED LOCATION WITH ARCHITECT.
- 3 EXISTING BRAISING PAN AND STEAMER TO BE REPLACED. REWORK EXISTING DOMESTIC WATER AND DRAIN PIPING TO ACCOMMODATE NEW EQUIPMENT.
- 4 EXISTING COMBI OVEN TO BE REPLACED. REWORK EXISTING DOMESTIC WATER AND DRAIN PIPING TO ACCOMMODATE NEW EQUIPMENT.
- 5 EXISTING THREE COMPARTMENT SINK TO BE REMOVED AND RETURNED TO OWNER. REMOVE ASSOCIATED EXISTING SANITARY SEWER PIPING AND CAP BELOW FLOOR. REMOVE ASSOCIATED EXISTING VENT AND DOMESTIC WATER PIPING AND CAP ABOVE CEILING AT WATER MAIN.
- 6 CONTRACTOR SHALL INSTALL LOSS IN LINE FILTER AT ALL EQUIPMENT AS REQUIRED. REFER TO ARCHITECTURAL DRAWINGS AND EQUIPMENT CUTSHEETS FOR SPEC OF WORK.

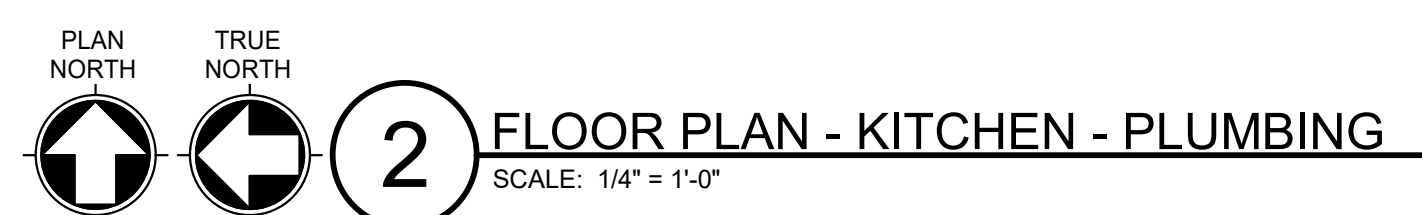

© This (hard copy or electronic) drawing is an instrument of service and the property of our office and shall remain their property. The design professional shall not be responsible for any alterations, modifications or additions made to this drawing by any party other than the design professional. Use of this drawing shall be limited to the original site for which it was prepared and publication thereof is expressly limited to such use, re-use or reproduction. Without otherwise designating, design professional reserves all copyright or other property interest in this drawing, and it may not be re-used for any other purpose without the design professional's written consent. Publication by any method in whole or part is prohibited without the written permission of the design professional. Any information obtained or conclusions derived from this drawing shall be at the user's sole risk.



THE BAXTER ELEMENTARY SCHOOL

# KITCHEN RENOVATION

1050 PARK PLACE BLVD.  
MIDLOTHIAN, TX 76065

CLIENT CONTACT  
Midlothian ISD  
100 Walter Stephenson Rd.  
Midlothian, TX 76065

jose.martinez1@misd.g

OWP PROJECT NO. DATE OF ISSUE  
2022-110-00 01.18.2022

REVISIONS		
DELTA	DESCRIPTION	DATE
2	Addendum 2	03/15/2023

PROJECT TEAM	DRAWN BY
ED TEXAS	Author

PROJECT PHASE  
CONSTRUCTION DOCUMENTS

SHEET CONTENTS

---

FLOOR PLAN - LEVEL 1 -  
PLUMBING

SHEET NO. \_\_\_\_\_

# P100



GENERAL DEMOLITION NOTES:

1. REFER TO GENERAL DEMOLITION NOTES ON SHEET E000.

DEMOLITION NOTES BY SYMBOL '○':

1. DISCONNECT AND REMOVE POWER FOR BOOSTER HEATER ALONG WITH ASSOCIATED WIRE AND CONDUIT BACK TO SOURCE.
2. DISCONNECT AND REMOVE POWER FOR EXISTING DISHWASHER ALONG WITH ASSOCIATED WIRE AND CONDUIT BACK TO SOURCE.
3. DISCONNECT AND REMOVE POWER FOR EXISTING DISPOSER ALONG WITH ASSOCIATED WIRE AND CONDUIT BACK TO SOURCE.
4. DISCONNECT AND REMOVE POWER FOR EXISTING SINK HEATER ALONG WITH ASSOCIATED WIRE AND CONDUIT BACK TO SOURCE.
5. DISCONNECT AND REMOVE POWER FOR EXISTING PASS THRU HEATED CABINET ALONG WITH ASSOCIATED WIRE AND CONDUIT BACK TO SOURCE.
6. DISCONNECT AND REMOVE POWER FOR EXISTING PASS THRU REFRIGERATED CABINET ALONG WITH ASSOCIATED WIRE AND CONDUIT BACK TO SOURCE.
7. DISCONNECT AND REMOVE POWER FOR EXISTING BRAISING PAN ALONG WITH ASSOCIATED WIRE AND CONDUIT BACK TO SOURCE.

DEMOLITION NOTES BY SYMBOL '○':

8. DISCONNECT AND REMOVE POWER FOR EXISTING COMBI DOUBLE OVEN ALONG WITH ASSOCIATED WIRE BACK TO SOURCE.
9. DISCONNECT AND REMOVE POWER FOR EXISTING CONVECTION OVEN ALONG WITH ASSOCIATED WIRE BACK TO SOURCE.
10. DISCONNECT AND REMOVE POWER FOR EXISTING CONVECTION STEAMER ALONG WITH ASSOCIATED WIRE BACK TO SOURCE.
11. DISCONNECT AND REMOVE POWER FOR EXISTING SERVING LINE ALONG WITH ASSOCIATED WIRE BACK TO SOURCE.
12. TEMPORARILY SUPPORT ALL CEILING MOUNTED FIRE ALARM DEVICES AND OTHER LOW VOLTAGE DEVICES DURING THE REPLACEMENT OF EXISTING CEILING. PROTECT DEVICES FROM DEBRIS AND DAMAGE DURING RENOVATION. REINSTALL ON NEW CEILING.



GENERAL POWER NOTES:

1. REFER TO GENERAL POWER NOTES ON SHEET E000.



NOTES BY SYMBOL '○':

1. PROVIDE NEW STAINLESS STEEL DISCONNECT SWITCHES.
2. REUSE EXISING FLOOR STUB-UP CONDUIT FOR NEW KITCHEN EQUIPMENT.
3. TEMPORARILY SUPPORT ALL CEILING MOUNTED FIRE ALARM DEVICES AND OTHER LOW VOLTAGE DEVICES DURING THE REMOVAL AND REPLACEMENT OF EXISTING CEILING. PROTECT DEVICES FROM DEBRIS AND DAMAGE DURING RENOVATION. REINSTALL ON NEW CEILING.
4. POWER FOR NEW 50A/3P MAIN CIRCUIT BREAKER LOAD CENTER FOR NEW SERVING LINE POWER. SERVING LINE LOAD CENTER SHALL BE SUPPLIED WITH SERVING LINE EQUIPMENT. COORDINATE EXACT LOCATION OF SERVING LINE LOAD CENTER WITH KITCHEN EQUIPMENT SUPPLIER.
5. SAW CUT EXISTING CONCRETE SLAB FOR NEW SERVING LINE POWER CONTRACTOR SHALL XRAY CONCRETE SLAB AND COORDINATE WITH EXISTING UTILITIES.


6. PROVIDE 120V POWER AND TOGGLE SWITCH FOR CIRCULATION PUMP. COORDINATE EXACT ELECTRICAL REQUIREMENTS WITH EQUIPMENT PROVIDER. REFER TO PLUMBING DRAWINGS FOR MORE INFORMATION.

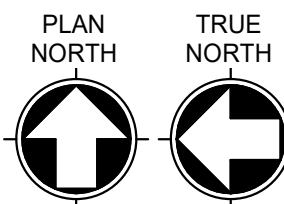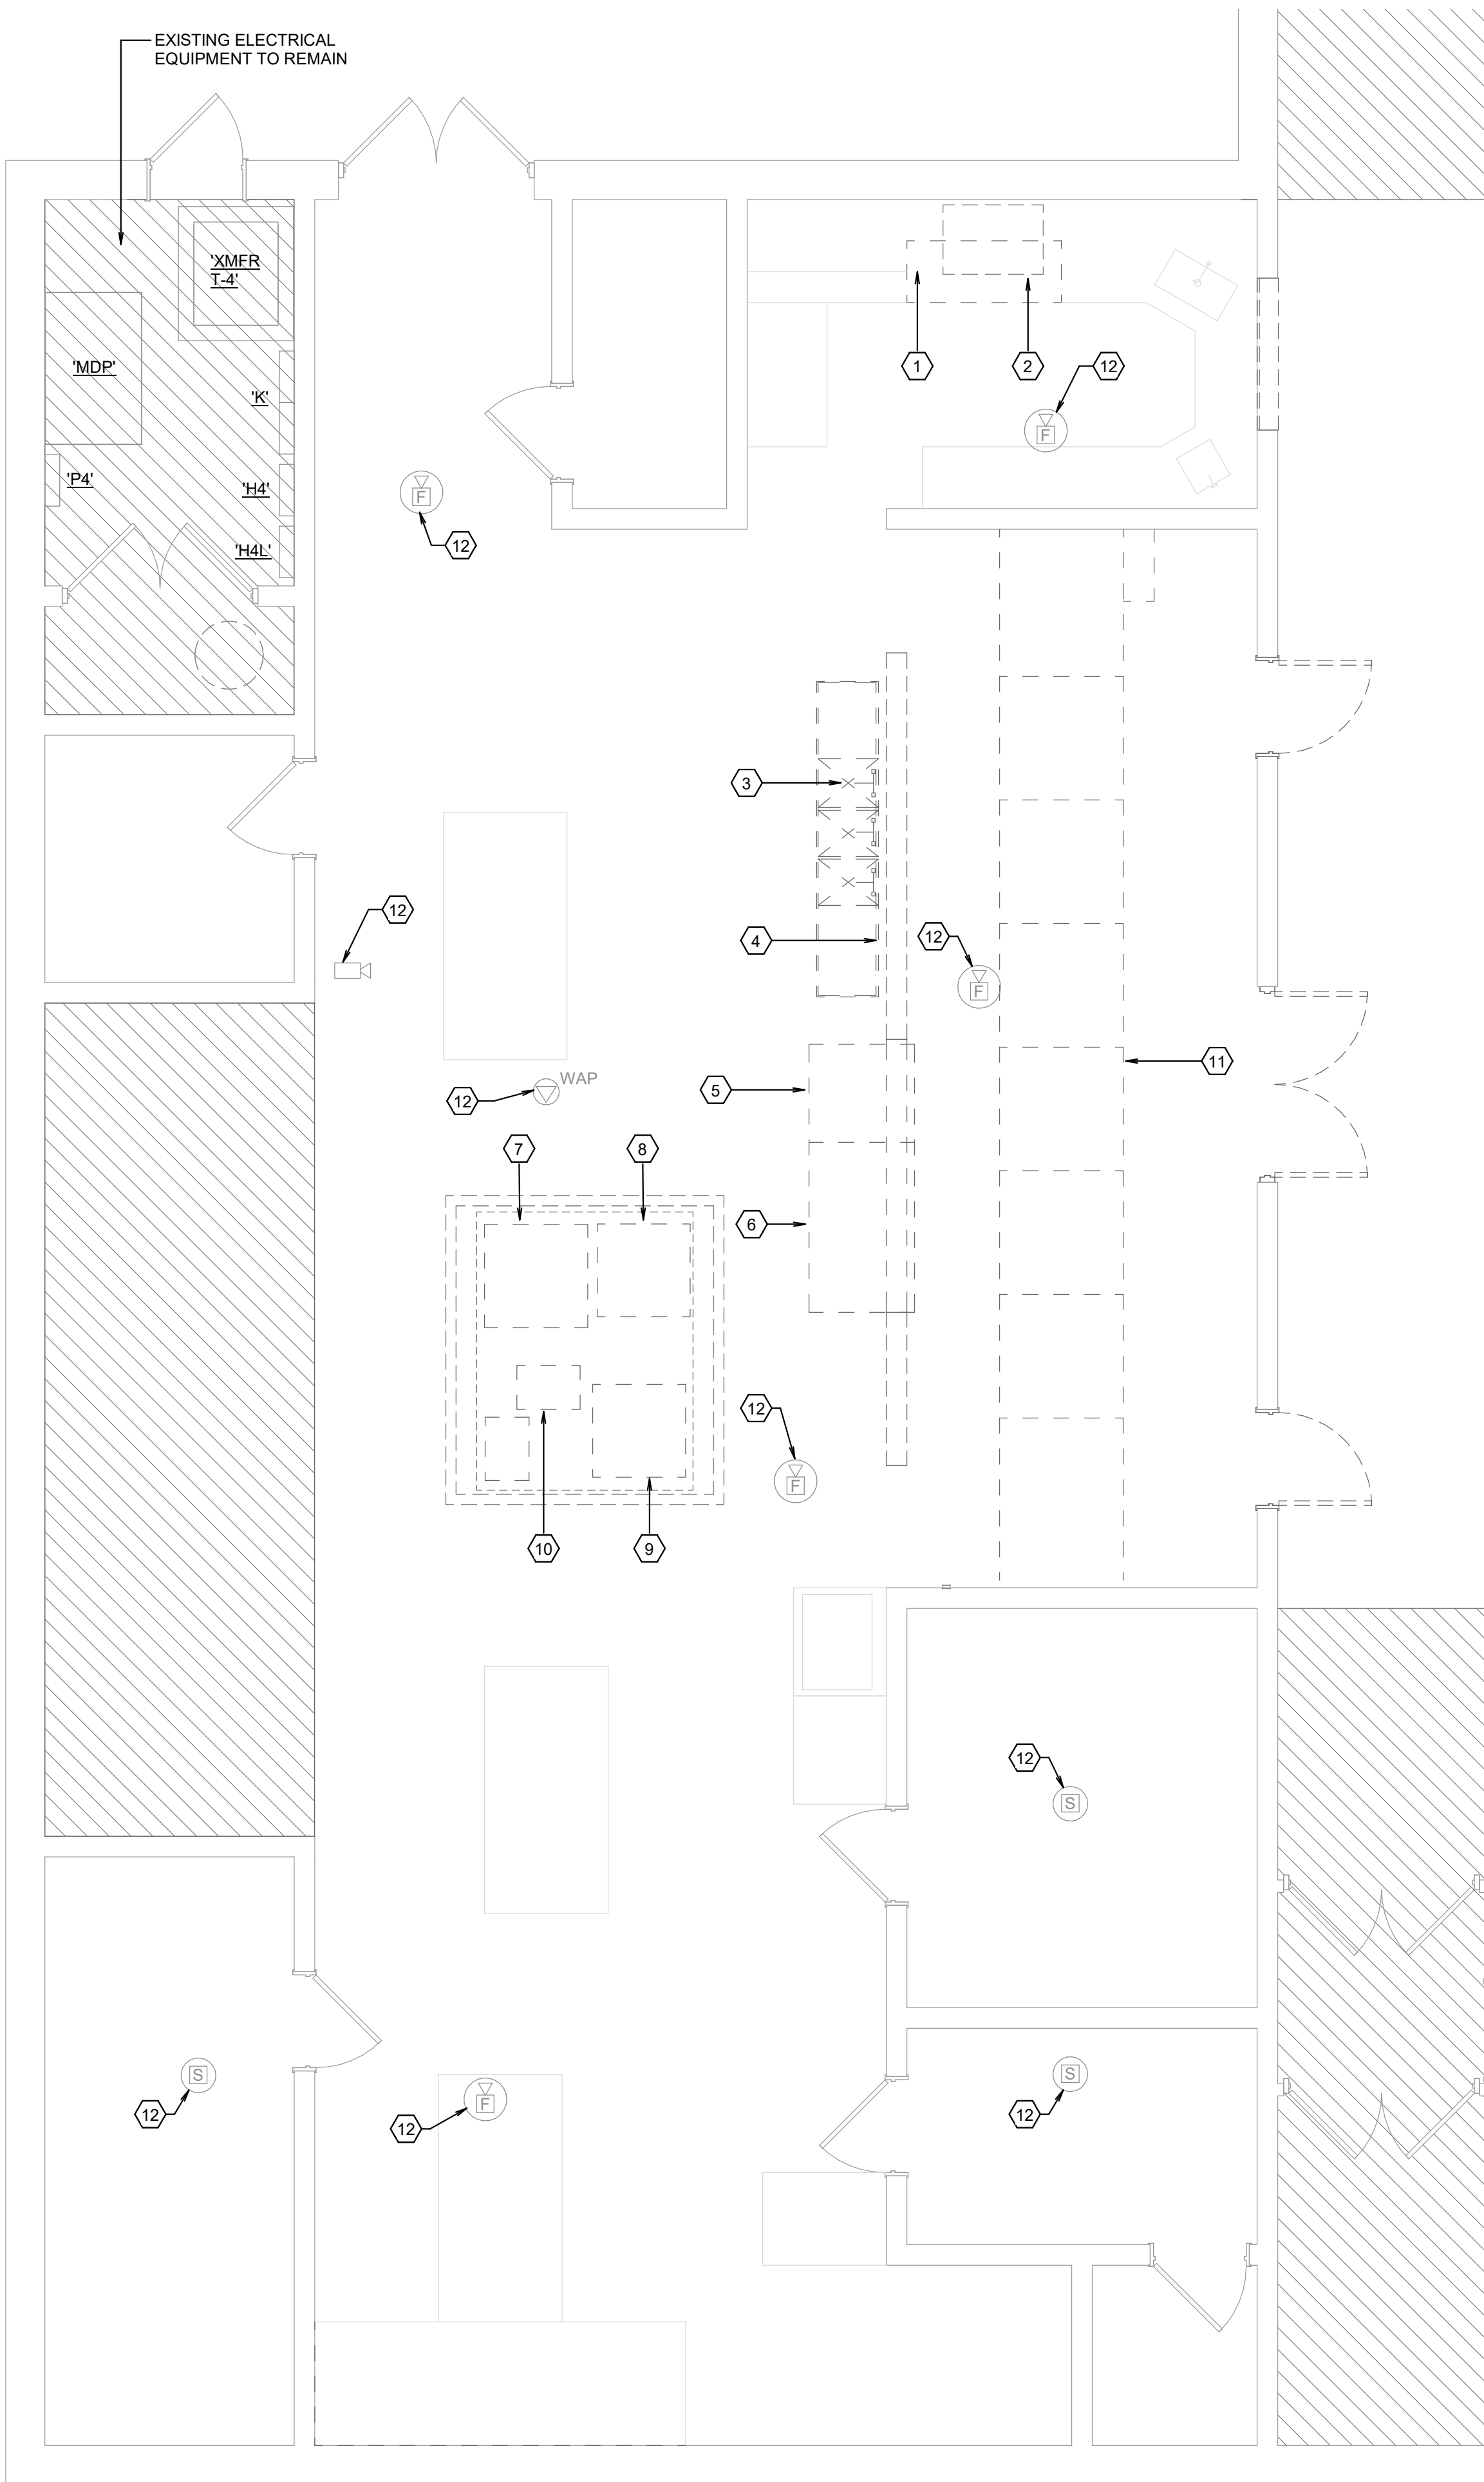

DEMOLITION FLOOR PLAN - LEVEL 1 - OVERALL - ELECTRICAL  
SCALE: 1/4" = 1'-0"

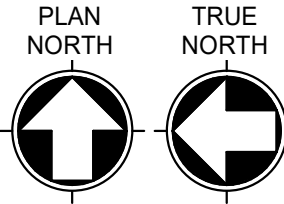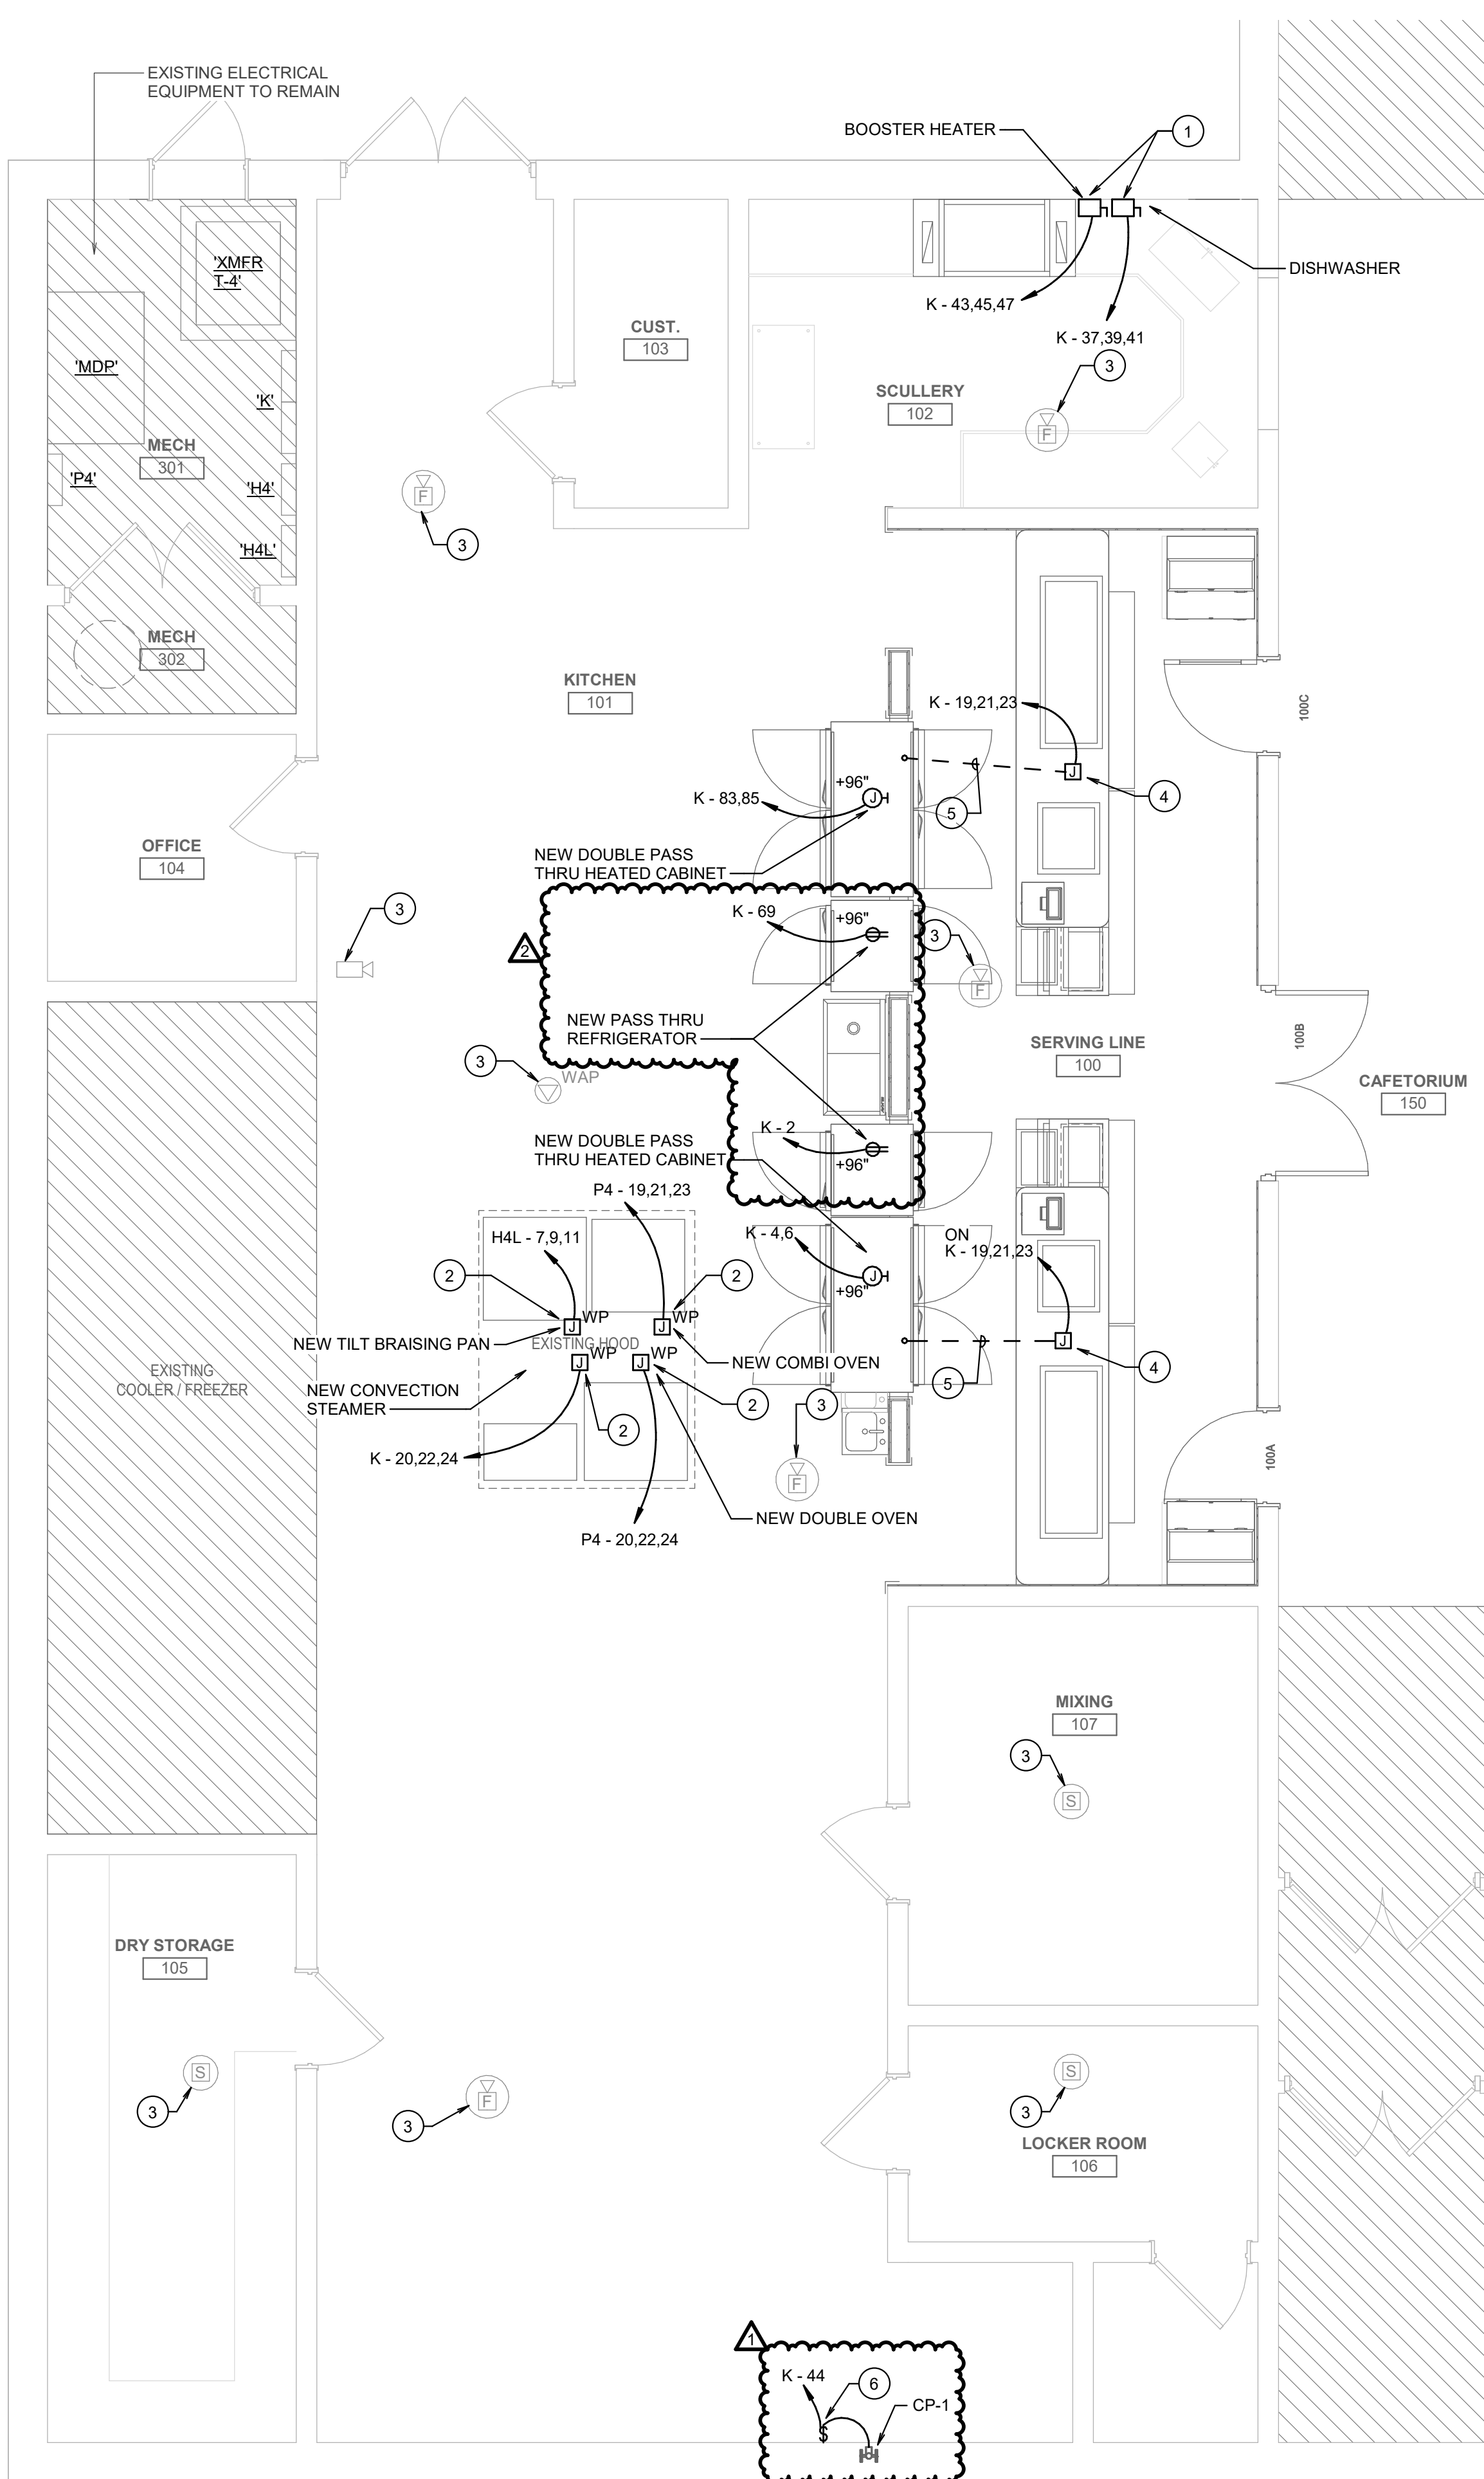

FLOOR PLAN - LEVEL 1 - OVERALL - ELECTRICAL  
SCALE: 1/4" = 1'-0"

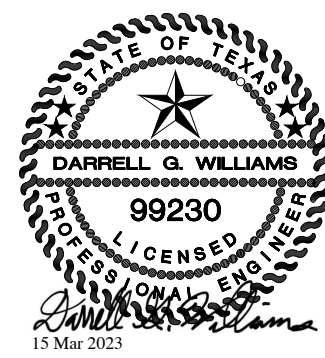

**KITCHEN RENOVATION**  
1050 PARK PLACE BLVD.  
MIDLOTHIAN, TX 76065

CLIENT CONTACT  
Midlothian ISD  
100 Walter Stephenson Rd.  
Midlothian, TX 76065  
jose.martinez1@mid.gis

OWP PROJECT NO. DATE OF ISSUE  
2022-110-00 01.18.2023

REVISIONS		
DELTA	DESCRIPTION	DATE
2	Addendum 2	03/15/2023

PROJECT TEAM  
ED TEXAS  
RWB

PROJECT PHASE  
CONSTRUCTION DOCUMENTS

SHEET CONTENTS  
FLOOR PLAN - LEVEL 1 - ELECTRICAL

SHEET NO.

E100





Consulting Engineers  
15001 N. Central Expressway  
Suite 1100  
Dallas, TX 75243

TX Permit #P-21278  
(972) 788-4222  
Project 2023-010

222 w las colinas blvd

suite 749e

irving, tx 75039


mail@owp.com

214.396.2090 t

www.owp.com

orcutt | winslow

© This third copy or electronic drawing is an instrument of service and the property of Orcutt Winslow and shall remain their property. The design professional and not be responsible for any alterations, modifications or additions made to this drawing by any party other than the design professional. Use of this drawing shall be limited to the original scale for which it was prepared and publication thereof is expressly limited to such use, reuse or reproduction. Unless otherwise agreed in writing, design professional reserves all copyright or other property whenever this drawing and it may not be used for any other purpose without the design professional's written consent. Violation by any method is subject to legal action and prosecution without the written permission of the design professional. Any information obtained or conclusions derived from this drawing shall be at the user's sole risk.

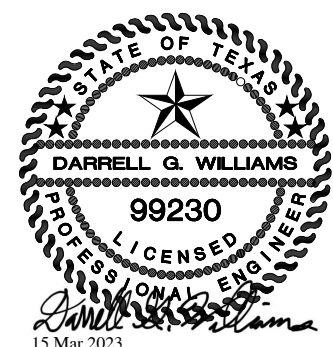

KITCHEN RENOVATION  
1050 PARK PLACE BLVD.  
MIDLOTHIAN, TX 76065

T E BAXTER ELEMENTARY SCHOOL

CLIENT CONTACT  
Midlothian ISD  
100 Walter Stephenson Rd.  
Midlothian, TX 76065

jose.martinez1@msisd.g

OWP PROJECT NO. DATE OF ISSUE  
2022-11-10-00 01.18.2023

REVISIONS  
DELTA DESCRIPTION DATE  
2 Addendum 2 03/15/2023

PROJECT TEAM DRAWN BY  
ED TEXAS RWB

PROJECT PHASE  
CONSTRUCTION DOCUMENTS

SHEET CONTENTS  
LIGHT FIXTURE &  
PANEL SCHEDULES

SHEET NO.

E700

### PANEL: K (EXISTING)

Location: MECH 301  
Supply From:  
Mounting: SURFACE  
Enclosure: NEMA 1

Volts: 120/208 Wye  
Phases: 3  
Wires: 4  
Sections: 2

A.I.C. Rating: 10,000 A.I.C.  
Mains Type: MLO  
Mains Rating: 600.0 A

CKT	REM	Load Name	BKR	Poles	Wire Size	A	B	C	Wire Size	Poles	BKR	Load Name	REM	CKT		
1	--	EXISTING LOAD	100	2	--	0	840	0	1643	--	1	20 NEW PASS THRU...	--	2		
3	--	SPACE	--	1	--					2	25 NEW DOUBLE ROLL THRU HEATED....	--	4			
5	--	SPACE	--	1	--							--	6			
7	--	EXISTING LOAD	15	3	--	0	0	0	0	--	3	40 EXISTING LOAD	--	8		
9	--	EXISTING LOAD	15	3	--	0	0	0	0	--	3	40 EXISTING LOAD	--	10		
11	--	EXISTING LOAD	15	3	--	0	0	0	0	--	1	20 EXISTING LOAD	--	12		
13	--	EXISTING LOAD	15	3	--	0	0	0	0	--	2	60 EXISTING LOAD	--	14		
15	--	EXISTING LOAD	15	3	--	0	0	0	0	--	2	60 EXISTING LOAD	--	16		
17	--	EXISTING LOAD	15	3	--	0	0	0	0	--	2	60 EXISTING LOAD	--	18		
19	2	Power to (2) New Kitchen Serving Lines	100	3	4#2, 1#6G-1 1/4".	4080	2667	4080	2667			3#8, 1#10G-EXISTING CONDUIT	3	40 CONVECTION STEAMER	2,5	20
21	--	EXISTING LOAD	40	3	--	0	0	0	0	--	1	20 EXISTING LOAD	--	22		
23	--	EXISTING LOAD	40	3	--	0	0	0	0	--	1	20 EXISTING LOAD	--	24		
25	--	EXISTING LOAD	20	1	--	0	0	0	0	--	1	20 EXISTING LOAD	--	26		
27	--	EXISTING LOAD	20	1	--	0	0	0	0	--	1	20 EXISTING LOAD	--	28		
29	--	EXISTING LOAD	20	1	--	0	0	0	0	--	1	20 EXISTING LOAD	--	30		
31	--	EXISTING LOAD	20	1	--	0	0	0	0	--	3	20 EXISTING LOAD	--	32		
33	--	EXISTING LOAD	20	1	--	0	0	0	0	--	3	20 EXISTING LOAD	--	34		
35	--	EXISTING LOAD	20	1	--	0	0	0	0	--	3	20 EXISTING LOAD	--	36		
37	2	NEW DISHWASHER	60	3	REUSE EXISTING	5000	0	5000	0			3	15 EXISTING LOAD	--	38	
39	--	EXISTING LOAD	50	2	--	0	0	0	0	--	1	20 EXISTING LOAD	--	40		
41	2	NEW 30KW BOOSTER HEATER	90	3	3#3, 1#6G-1 1/4"	10064	828	10064	0			1	20 CP-1	3	42	
43	--	EXISTING LOAD	50	2	--	0	0	0	0	--	2	60 EXISTING LOAD	--	44		
45	--	EXISTING LOAD	50	2	--	0	0	0	0	--	1	20 EXISTING LOAD	--	46		
47	--	EXISTING LOAD	20	1	--	0	0	0	0	--	1	20 EXISTING LOAD	--	48		
49	--	EXISTING LOAD	20	1	--	0	0	0	0	--	1	20 EXISTING LOAD	--	50		
51	--	EXISTING LOAD	20	1	--	0	0	0	0	--	1	20 EXISTING LOAD	--	52		
53	--	EXISTING LOAD	20	1	--	0	0	0	0	--	1	20 EXISTING LOAD	--	54		
55	--	EXISTING LOAD	20	1	--	0	0	0	0	--	1	20 EXISTING LOAD	--	56		
57	--	EXISTING LOAD	20	1	--	0	0	0	0	--	1	20 EXISTING LOAD	--	58		
59	--	EXISTING LOAD	20	1	--	0	0	0	0	--	1	20 EXISTING LOAD	--	60		
61	--	EXISTING LOAD	20	1	--	0	0	0	0	--	1	20 EXISTING LOAD	--	62		
63	--	EXISTING LOAD	20	1	--	0	0	0	0	--	1	20 EXISTING LOAD	--	64		
65	--	EXISTING LOAD	20	1	--	0	0	0	0	--	1	40 EXISTING LOAD	--	66		
67	--	EXISTING LOAD	20	1	--	0	0	0	0	--	1	20 EXISTING LOAD	--	68		
69	--	NEW PASS THRU...	20	1	--	0	840	0	0			1	20 EXISTING LOAD	--	70	
71	--	EXISTING LOAD	20	1	--	0	0	0	0	--	1	20 EXISTING LOAD	--	72		
73	--	EXISTING LOAD	20	1	--	0	0	0	0	--	1	20 EXISTING LOAD	--	74		
75	--	EXISTING LOAD	40	1	--	0	0	0	0	--	1	20 EXISTING LOAD	--	76		
77	--	EXISTING LOAD	20	1	--	0	0	0	0	--	1	20 EXISTING LOAD	--	78		
79	--	EXISTING LOAD	50	2	--	0	0	0	0	--	1	20 EXISTING LOAD	--	80		
81	--	EXISTING LOAD	50	2	--	0	0	0	0	--	1	20 EXISTING LOAD	--	82		
83	2	NEW DOUBLE ROLL THRU HEATED.	25	2	2#10, 1#1-G-3/4".	1643	0	1643	0			2	20 EXISTING LOAD	--	84	
85	--	EXISTING LOAD	30	3	--	0	0	0	0	--	3	60 EXISTING LOAD	--	86		
87	--	EXISTING LOAD	30	3	--	0	0	0	0	--	3	60 EXISTING LOAD	--	88		
89	--	EXISTING LOAD	30	3	--	0	0	0	0	--	3	60 EXISTING LOAD	--	90		
91	--	EXISTING LOAD	30	3	--	0	0	0	0	--	3	60 EXISTING LOAD	--	92		
Total Load:						25,121 VA	24,293 VA	25,096 VA								
Total Amps:						210.4 A	202.4 A	210.2 A								

Load Classification	Connected Load	Demand Factor	Estimated Demand	Panel Totals
Kitchen Equipment	72,843 VA	65.00%	47,348 VA	Total Conn. Load: 74,511 VA
Other	828 VA	100.00%	828 VA	Total Est. Demand: 49,016 VA
Receptacle	840 VA	100.00%	840 VA	Total Conn. Current: 206.8 A
				Total Est. Demand Current: 136.1 A

#### General Notes:

- A. PROVIDE FEED-THROUGH LUGS FOR FUTURE EXPANSION.  
B. PROVIDE FULL SIZED PHASE, NEUTRAL AND GROUND BUSSES.  
C. THE CONTRACTOR SHALL UPDATE ROOM NAMES AND ROOM NUMBERS ON FINAL PANEL SCHEDULE TO REFLECT FINAL BUILDING CONDITIONS.

#### Remarks:

1. PROVIDE GFCI CIRCUIT BREAKER.  
2. PROVIDE CIRCUIT BREAKER AND / OR FUSES PER EQUIPMENT MANUFACTURER'S SPECIFICATIONS.  
3. BRANCH CIRCUIT SHALL BE 2 #12 & #12 GROUND IN 3/4" CONDUIT.  
4. BRANCH CIRCUIT ROUTED THROUGH AND CONTROLLED BY SECONDARY CONTACTOR.  
5. PROVIDE WITH SHUNT TRIP BREAKER.  
6. PROVIDE CIRCUIT BREAKER CAPABLE OF BEING LOCKED IN THE OFF POSITION.

### PANEL: P4 (EXISTING)

Location: MECH 301  
Supply From:  
Mounting: SURFACE  
Enclosure: NEMA 1

Volts: 480/277 Wye  
Phases: 3  
Wires: 4  
Sections: 1

A.I.C. Rating: 14,000 A.I.C.  
Mains Type: MCB  
Mains Rating: 400.0 A

CKT	REM	Load Name	BKR	Poles	Wire Size	A			B			C			Wire Size	Poles	BKR	Load Name	REM	CKT
1	--	EXISTING LOAD	20	3	--	0	0							--	3	20	EXISTING LOAD	--	2	
3	--	EXISTING LOAD	20	3	--				0	0				--	3	20	EXISTING LOAD	--	4	
5	--	EXISTING LOAD	20	3	--	0	0				0	0		--	3	20	EXISTING LOAD	--	6	
7	--	EXISTING LOAD	20	3	--				0	0			0	--	3	20	EXISTING LOAD	--	8	
9	--	EXISTING LOAD	20	3	--								0	--	3	20	EXISTING LOAD	--	10	
11	--	EXISTING LOAD	30	3	--	0	0						0	--	3	30	EXISTING LOAD	--	12	
13	--	EXISTING LOAD	30	3	--				0	0				--	3	30	EXISTING LOAD	--	14	
15	--	EXISTING LOAD	30	3	--						0	0		--	3	30	EXISTING LOAD	--	16	
17	--	EXISTING LOAD	30	3	--								0	--	3	30	EXISTING LOAD	--	18	
19	--	EXISTING LOAD	30	3	--	10388	8333							--	3	40	NEW DOUBLE CONV OVEN	2.5	20	
21	2.5	NEW COMBI OVEN	50	3	3#6,1#10G-1" C			10388	8333			10388	8333	3#8,1#10G-3/4" C	3	40	NEW DOUBLE CONV OVEN	2.5	22	
23	--	SPACE	--	1	--	--	--	--	--	--	--	--	--	--	1	--	SPACE	--	24	
25	--	SPACE	--	1	--	--	--	--	--	--	--	--	--	--	1	--	SPACE	--	26	
27	--	SPACE	--	1	--	--	--	--	--	--	--	--	--	--	1	--	SPACE	--	28	
Total Load:						18,721 VA		18,721 VA		18,721 VA										
Total Amps:						67.6 A		67.6 A		67.6 A										

Load Classification	Connected Load	Demand Factor	Estimated Demand	Panel Totals
Kitchen Equipment	56,163 VA	100.00%	56,163 VA	Total Conn. Load: 56,163 VA
				Total Est. Demand: 56,163 VA
				Total Conn. Current: 67.6 A
				Total Est. Demand Current: 67.6 A

#### General Notes:

- A. PROVIDE FEED-THROUGH LUGS FOR FUTURE EXPANSION.  
B. PROVIDE FULL SIZED PHASE, NEUTRAL AND GROUND BUSSES.  
C. THE CONTRACTOR SHALL UPDATE ROOM NAMES AND ROOM NUMBERS ON FINAL PANEL SCHEDULE TO REFLECT FINAL BUILDING CONDITIONS.

#### Remarks:

1. PROVIDE GFCI CIRCUIT BREAKER.  
2. PROVIDE CIRCUIT BREAKER AND / OR FUSES PER EQUIPMENT MANUFACTURER'S SPECIFICATIONS.  
3. BRANCH CIRCUIT SHALL BE 2 #12 & #12 GROUND IN 3/4" CONDUIT.  
4. BRANCH CIRCUIT ROUTED THROUGH AND CONTROLLED BY SECONDARY CONTACTOR.  
5. PROVIDE WITH SHUNT TRIP BREAKER.  
6. PROVIDE CIRCUIT BREAKER CAPABLE OF BEING LOCKED IN THE OFF POSITION.

### PANEL: H4 (EXISTING)

Location: MECH 301  
Supply From:  
Mounting: SURFACE  
Enclosure: NEMA 1

Volts: 480/277 Wye  
Phases: 3  
Wires: 4  
Sections: 1

A.I.C. Rating: 14,000 A.I.C.  
Mains Type: MLO  
Mains Rating: 100.0 A

CKT	REM	Load Name	BKR	Poles	Wire Size	A			B			C			Wire Size	Poles	BKR	Load Name	REM	CKT
1	--	SPACE	--	3	--	--	0	--	--	0	--	--	0	--	3	70	EXISTING LOAD	--	4	
3	--	SPACE	--	3	--	--	0	--	--	0	--	--	0	--	3	70	EXISTING LOAD	--	6	
5	--	SPACE	--	3	--	--	0	--	--	0	--	--	0	--	3	70	EXISTING LOAD	--	8	
7	--	EXISTING LOAD	40	3	--	0	0	0	0	0	0	0	0	--	1	20	EXISTING LOAD	--	10	
9	--	EXISTING LOAD	40	3	--	0	0	0	0	0	0	0	0	--	1	20	EXISTING LOAD	--	12	
11	--	EXISTING LOAD	20	1	--	0	0	0	0	0	0	0	0	--	1	20	EXISTING LOAD	--	14	
13	--	EXISTING LOAD	20	1	--	0	0	0	0	0	0	0	0	--	1	20	EXISTING LOAD	--	16	
15	--	EXISTING LOAD	20	1	--	0	0	0	0	0	0	0	0	--	1	20	EXISTING LOAD	--	18	
17	--	EXISTING LOAD	20	1	--	0	0	0	0	0	0	0	0	--	1	20	EXISTING LOAD	--	20	
19	--	EXISTING LOAD	20	1	--	0	0	0	0	0	0	0	0	--	1	20	EXISTING LOAD	--	22	
21	--	EXISTING LOAD	20	1	--	0	0	0	0	0	0	0	0	--	1	20	EXISTING LOAD	--	24	
23	--	EXISTING LOAD	20	1	--	0	0	0	0	0	0	0	0	--	1	20	EXISTING LOAD	--	24	
Total Load:						0 VA	0 VA	0 VA												
Total Amps:						0.0 A	0.0 A	0.0 A												

Load Classification	Connected Load	Demand Factor	Estimated Demand	Panel Totals
				Total Conn. Load: 0 VA
				Total Est. Demand: 0 VA
				Total Conn. Current: 0.0 A
				Total Est. Demand Current: 0.0 A

#### General Notes:

- A. PROVIDE FEED-THROUGH LUGS FOR FUTURE EXPANSION.  
B. PROVIDE FULL SIZED PHASE, NEUTRAL AND GROUND BUSSES.  
C. THE CONTRACTOR SHALL UPDATE ROOM NAMES AND ROOM NUMBERS ON FINAL PANEL SCHEDULE TO REFLECT FINAL BUILDING CONDITIONS.

#### Remarks:

1. PROVIDE GFCI CIRCUIT BREAKER.  
2. PROVIDE CIRCUIT BREAKER AND / OR FUSES PER EQUIPMENT MANUFACTURER'S SPECIFICATIONS.  
3. BRANCH CIRCUIT SHALL BE 2 #12 & #12 GROUND IN 3/4" CONDUIT.  
4. BRANCH CIRCUIT ROUTED THROUGH AND CONTROLLED BY SECONDARY CONTACTOR.  
5. BRANCH CIRCUIT ROUTED THROUGH AND CONTROLLED BY UTILITY LAB CONTROLLER.  
6. PROVIDE CIRCUIT BREAKER CAPABLE OF BEING LOCKED IN THE OFF POSITION.

### PANEL: H4L (EXISTING)

Location: MECH 301  
Supply From:  
Mounting: SURFACE  
Enclosure: NEMA 1

Volts: 480/2