

ADDRESS: 8651 MEADOWBROOK WAY SE, SNOQUALMIE, WA 98065  
 PROJECT NAME: ADMIN TO MT SI HS DIVERSITY - MT SI ISP PLANS



## SITE LOCATION

### BILL OF MATERIALS

ITEMS	QUANTITY	UNITS	FURNISHED BY	PLACED BY	COMMENTS
FIBER STORAGE (24F)	75	FT.	SVSD	CONTRACTOR	
FIBER	629	FT.	SVSD	CONTRACTOR	
2" 3-CELL MAXCELL INNERDUCT	190	FT.	CONTRACTOR	CONTRACTOR	
1" INNERDUCT	435	FT.	CONTRACTOR	CONTRACTOR	

### CONTACTS

SNOQUALMIE VALLEY SCHOOL DISTRICT:  
 RYAN VANNATTA  
 PO BOX 400  
 SNOQUALMIE, WA 98065  
 T. 425.831.4216  
 VANNATTAR@SVSD410.ORG

JOHN SHAFER  
 MGC TECHNICAL CONSULTING, INC.  
 15635 NE 90TH ST, #210 NE  
 REDMOND, WA 98052  
 C.206.307.4834  
 JSHAF@MGCTECHNICAL.COM

### SHEET INDEX

- COVER SHEET / SITE LOCATION
- LEGEND
- GENERAL NOTES
- SITE PLAN
- ENLARGED MDF PLAN
- TYPICAL DETAILS / MATERIALS
- SITE PHOTOS

### SCOPE OF WORK:

- INSTALL 3-CELL MAXCELL EDGE INNERDUCT THROUGH EXISTING 2" CONDUIT FROM COMM VAULT IN PARKING LOT TO IDF 7149.
- INSTALL (1) 1" INNERDUCT THROUGH EXISTING 4" CONDUIT FROM IDF 7149 TO MDF ROOM.
- INSTALL (1) 24F CABLE FROM COMM VAULT IN PARKING LOT TO FIBER TERMINATION CABINET IN MDF ROOM.
- INSTALL CORNING CCH-01U PANEL IN FIBER TERMINATION CABINET & INSTALL 24 PORT LC/APC CORNING CASSETTE. TERMINATE (1) 24F CABLE.



Know what's below.  
 Call before you dig.



0 250' 500'  
 SCALE: 1"=500'

3				AS-BUILT
2	4/7/23	JLS	JLS	REVISION # 1
1	12/19/22	JLS	JLS	ORIGINAL
NO.	DATE	ENGINEER	DRAFTER	COMMENT



SNOQUALMIE SCHOOL DISTRICT ENGINEER: RYAN VANNATTA  
 ENGINEERING FIRM: MGC TECHNICAL CONSULTING INC.  
 PROJECT NAME: ADMIN TO MT SI HS DIVERSITY - MT SI ISP  
 LOCATION: 8651 MEADOWBROOK WAY SE  
 SNOQUALMIE, WA 98065  
 PERMIT NUMBER:  
 DRAWING NAME: SNOQUALMIE SCHOOL DISTRICT - ADMIN TO MT SI HS DIVERSITY - ISP PLANS - I  
**CONFIDENTIAL/PROPRIETARY** SHEET: 1 OF 7

# LEGEND

## LINETYPES

	AERIAL FIBER - EXISTING
	AERIAL FIBER - ATTACH
	AERIAL FIBER - OVERLASH
	STRAND - EXISTING
	STRAND - PROPOSED
	CONDUIT - EXISTING
	CONDUIT - PROPOSED
	INNERDUCT - EXISTING
	INNERDUCT - PROPOSED
	GAS
	WATER
	TELEPHONE
	FIBER OPTIC
	ELECTRIC
	SANITARY SEWER (SEW)
	STORM DRAIN
	CABLE TV
	STEAM
	OIL
	UNKNOWN UTILITY
	FENCE
	RIGHT OF WAY
	EDGE OF PAVEMENT

## ABBREVIATIONS

ASW	ASPHALT SIDEWALK
BIP	BLACK IRON PIPE
BSP	BLACK STEEL PIPE
CSW	CONCRETE SIDEWALK
ELECT.	ELECTRIC
EOP	EDGE OF PAVEMENT
EOTW	EDGE OF TRAVEL WAY
FOC	FACE OF CURB
F/O	FIBER OPTIC
HDPE	HIGH DENSITY POLYETHYLENE
HH	HANDHOLE
JB	JUNCTION BOX
MH	MANHOLE
MP	MILE POST
O/S	OFFSET
PR	PR
PVC	POLY VINYL CHLORIDE
RGS	RIGID GALVANIZED STEEL CONDUIT
ROW	RIGHT OF WAY
SEW	SANITARY SEWER
SD	STORM DRAIN
STA.	STATION
STM	STEAM
TEL	TELECOM

## SYMBOLS

	RISER - EXISTING		TRANSMISSION/DISTRIBUTION POLE
	RISER - PROPOSED		TRANSMISSION POLE
	CATCH BASIN/INLET (RECTANGULAR)		DISTRIBUTION POLE
	CATCH BASIN/INLET (ROUND)		GROUND/BOND
	FIRE HYDRANT		AERIAL STORAGE - EXISTING
	WATER/GAS VALVE		AERIAL STORAGE - PROPOSED
	LIGHT POST		VAULT/BUILDING STORAGE - EXISTING
	STREET LIGHT		VAULT/BUILDING STORAGE - PROPOSED
	TRAFFIC LIGHT ARM		POLE ANCHOR/DOWN GUY - EXISTING
	TREE		POLE ANCHOR/DOWN GUY - PROPOSED
	CULVERT		DOWN GUY TO EXISTING ANCHOR - PROPOSED
	WING WALL		SPLICE POINT - EXISTING
	BRIDGE		SPLICE POINT - PROPOSED
	STREET SIGN		TERMINATION - EXISTING
	ADA RAMP		TERMINATION - PROPOSED
	UTILITY POLE - EXISTING		PULLBOX - EXISTING
	UTILITY POLE - PROPOSED		PULLBOX - PROPOSED
	TRAFFIC RATED VAULT - EXISTING (SIZE AND UTILITY TYPE MAY VARY)		CONSTRUCTION NOTE / RESTORATION CALLOUT
	TRAFFIC RATED VAULT - PROPOSED (SIZE MAY VARY)		PHOTO-MARKER
	HANDHOLE - EXISTING (SIZE AND UTILITY TYPE MAY VARY)		NORTH ARROW
	HANDHOLE - PROPOSED (SIZE MAY VARY)		
	PEDESTAL - EXISTING (SIZE AND UTILITY TYPE MAY VARY)		
	PEDESTAL - PROPOSED (SIZE MAY VARY)		
	WET UTILITY MANHOLE - EXISTING (SIZE AND UTILITY TYPE MAY VARY)		
	BORE PIT - PROPOSED (SIZE MAY VARY)		
	UTILITY POTHOLE		

## INFORMATION TABLES




POLE NUMBER	#	UTILITY POLE INFORMATION TABLE (NUMBER OF ATTACHMENTS MAY VARY)
EXISTING UTILITY	0'-0"	
PROPOSED ATTACH	0'-0"	

#F	IN:	SEQUENTIAL IN/OUT CALLOUT
	OUT:	

#F	IN:	SEQUENTIAL IN/TAILOUT CALLOUT
	TAIL:	

#F	TAIL:	SEQUENTIAL TAIL/OUT CALLOUT
	OUT:	

## HATCH PATTERNS

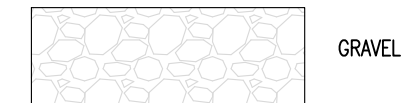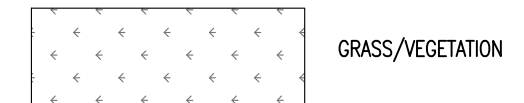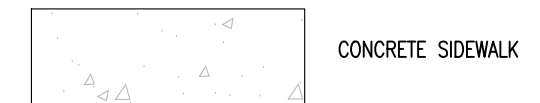

Know what's below.  
Call before you dig.

3				AS-BUILT
2	4/7/23	JLS	JLS	REVISION # 1
1	12/19/22	JLS	JLS	ORIGINAL
NO.	DATE	ENGINEER	DRAFTER	COMMENT

SNOQUALMIE SCHOOL DISTRICT ENGINEER: RYAN VANNATTA  
 ENGINEERING FIRM: MGC TECHNICAL CONSULTING INC.  
 PROJECT NAME: ADMIN TO MT SI HS DIVERSITY - MT SI ISP  
 LOCATION: 8651 MEADOWBROOK WAY SE  
 SNOQUALMIE, WA 98065  
 PERMIT NUMBER:  
 DRAWING NAME: SNOQUALMIE SCHOOL DISTRICT - ADMIN TO MT SI HS DIVERSITY - ISP PLANS - I  
**CONFIDENTIAL/PROPRIETARY** SHEET: 2 OF 7

# GENERAL NOTES

GENERAL NOTES / CONSTRUCTION STANDARDS:

1. EACH FIBER CABLE SHALL BE TAGGED AT EACH ENDPOINT (NEAR TERMINATION PANEL), AND IN EACH VAULT / PULLBOX WITH AN OUTDOOR RATED FIBER TAG DENOTING THE FIBER TYPE AND ENDPOINTS OF THE CABLE. (EG. "12CT SMF - MDF TO IDF-300").
2. FIBER IN/OUT SEQUENTIALS SHALL BE RECORDED AT EACH PULLBOX / HANDHOLE , AT EACH TERMINATION LOCATION, AND AT EACH STORAGE LOOP. THIS SHALL BE INCLUDED IN CONTRACTOR PROVIDED AS-BUILT AT PROJECT COMPLETION
3. ALL FIBER SHALL BE TERMINATED USING A CORE ALIGNMENT FUSION SPLICER.
4. ALL FIBER STRANDS SHALL BE BI-DIRECTIONALLY OTDR TESTED AT BOTH 1310 NM & 1550 NM PER TIA-526-7. ALL NEW SPLICES & CONNECTORS SHALL BE IN COMPLIANCE WITH THE INSERTION LOSS AND RETURN LOSS VALUES SET FORTH IN ANSI/TIA-568-3.D-1 FOR REFERENCE GRADE CONNECTORS. TESTS SHALL BE PERFORMED ACCORDING TO THE MANUFACTURER'S INSTRUCTIONS FOR THE TEST SET BEING UTILIZED. OTDR TRACE RESULTS SHALL BE SUBMITTED TO SVSD IN PDF FORMAT FOR ACCEPTANCE. ANY SPLICES OR TERMINATIONS NOT MEETING SPECIFICATIONS WILL BE REQUIRED TO BE RE-SPLICED AND RE-TESTED UNTIL REQUIRED TEST VALUES ARE ACHIEVED.
5. MULE TAPE SHALL BE LEFT BEHIND IN ALL CONDUIT PATHWAYS THAT ARE PULLED THROUGH.
6. ALL NEW SLEEVES PLACED THROUGH FIRE RATED BARRIERS (WALLS/ FLOORS) SHALL BE FIRE-STOPPED WITH A TESTED/QUALIFIED FIRESTOP SYSTEM.
7. 36" MINIMUM SERVICE LOOP SHALL BE LEFT ON ALL NEW CAT6/CAT6A CABLES AT IDF / MDF. 12" MINIMUM SERVICE LOOP SHALL BE LEFT WITHIN THE OUTLET BOX AT THE STATION END OF EACH CAT6/CAT6A CABLE.
8. ALL NEW COPPER CABLING INSTALLED ABOVE DROP CEILINGS IN OPEN PATHWAY: J-HOOKS MAY NOT BE INSTALLED ON EXISTING GRID CEILING SUPPORT WIRES. EXISTING J-HOOKS THAT ARE ATTACHED TO GRID CEILING SUPPORTS SHALL NOT BE USED FOR NEW CABLE INSTALLATION. NEW J-HOOKS SHALL BE SPACED A MAXIMUM OF 48" APART.
9. ALL NEW CABLING PASSING THROUGH UNDERGROUND CONDUITS MUST BE RATED FOR WET ENVIRONMENTS (OSP).
10. ALL NEW METALLIC PATHWAY (EMT, RMC, ETC) & METALLIC JUNCTION BOXES SHALL BE BONDED TO COMMON BUILDING ELECTRICAL SYSTEM GROUND.



Know what's below.  
Call before you dig.



3				AS-BUILT
2	4/7/23	JLS	JLS	REVISION # 1
1	12/19/22	JLS	JLS	ORIGINAL
NO.	DATE	ENGINEER	DRAFTER	COMMENT




SNOQUALMIE SCHOOL DISTRICT ENGINEER: RYAN VANNATTA  
 ENGINEERING FIRM: MGC TECHNICAL CONSULTING INC.  
 PROJECT NAME: ADMIN TO MT SI HS DIVERSITY - MT SI ISP  
 LOCATION: 8651 MEADOWBROOK WAY SE  
 SNOQUALMIE, WA 98065  
 PERMIT NUMBER:  
 DRAWING NAME: SNOQUALMIE SCHOOL DISTRICT - ADMIN TO MT SI HS DIVERSITY - ISP PLANS - I  
**CONFIDENTIAL/PROPRIETARY** SHEET: 3 OF 7

**CONSTRUCTION NOTES**

- 1 EXISTING VACANT 2" CONDUIT TO IDF 7149. INSTALL (1) 2" DETECTABLE 3-CELL MAXCELL EDGE INNERDUCT. PULL (1) 24F CABLE THROUGH TO MDF ROOM VIA IDF 7149.
- 2 EXISTING 4" CONDUIT FROM IDF 7149 TO MDF ROOM. INSTALL (1) 1" INNERDUCT. PULL (1) 24F CABLE THROUGH.

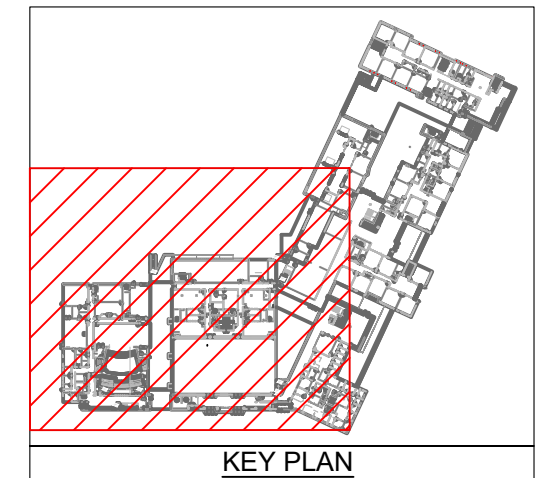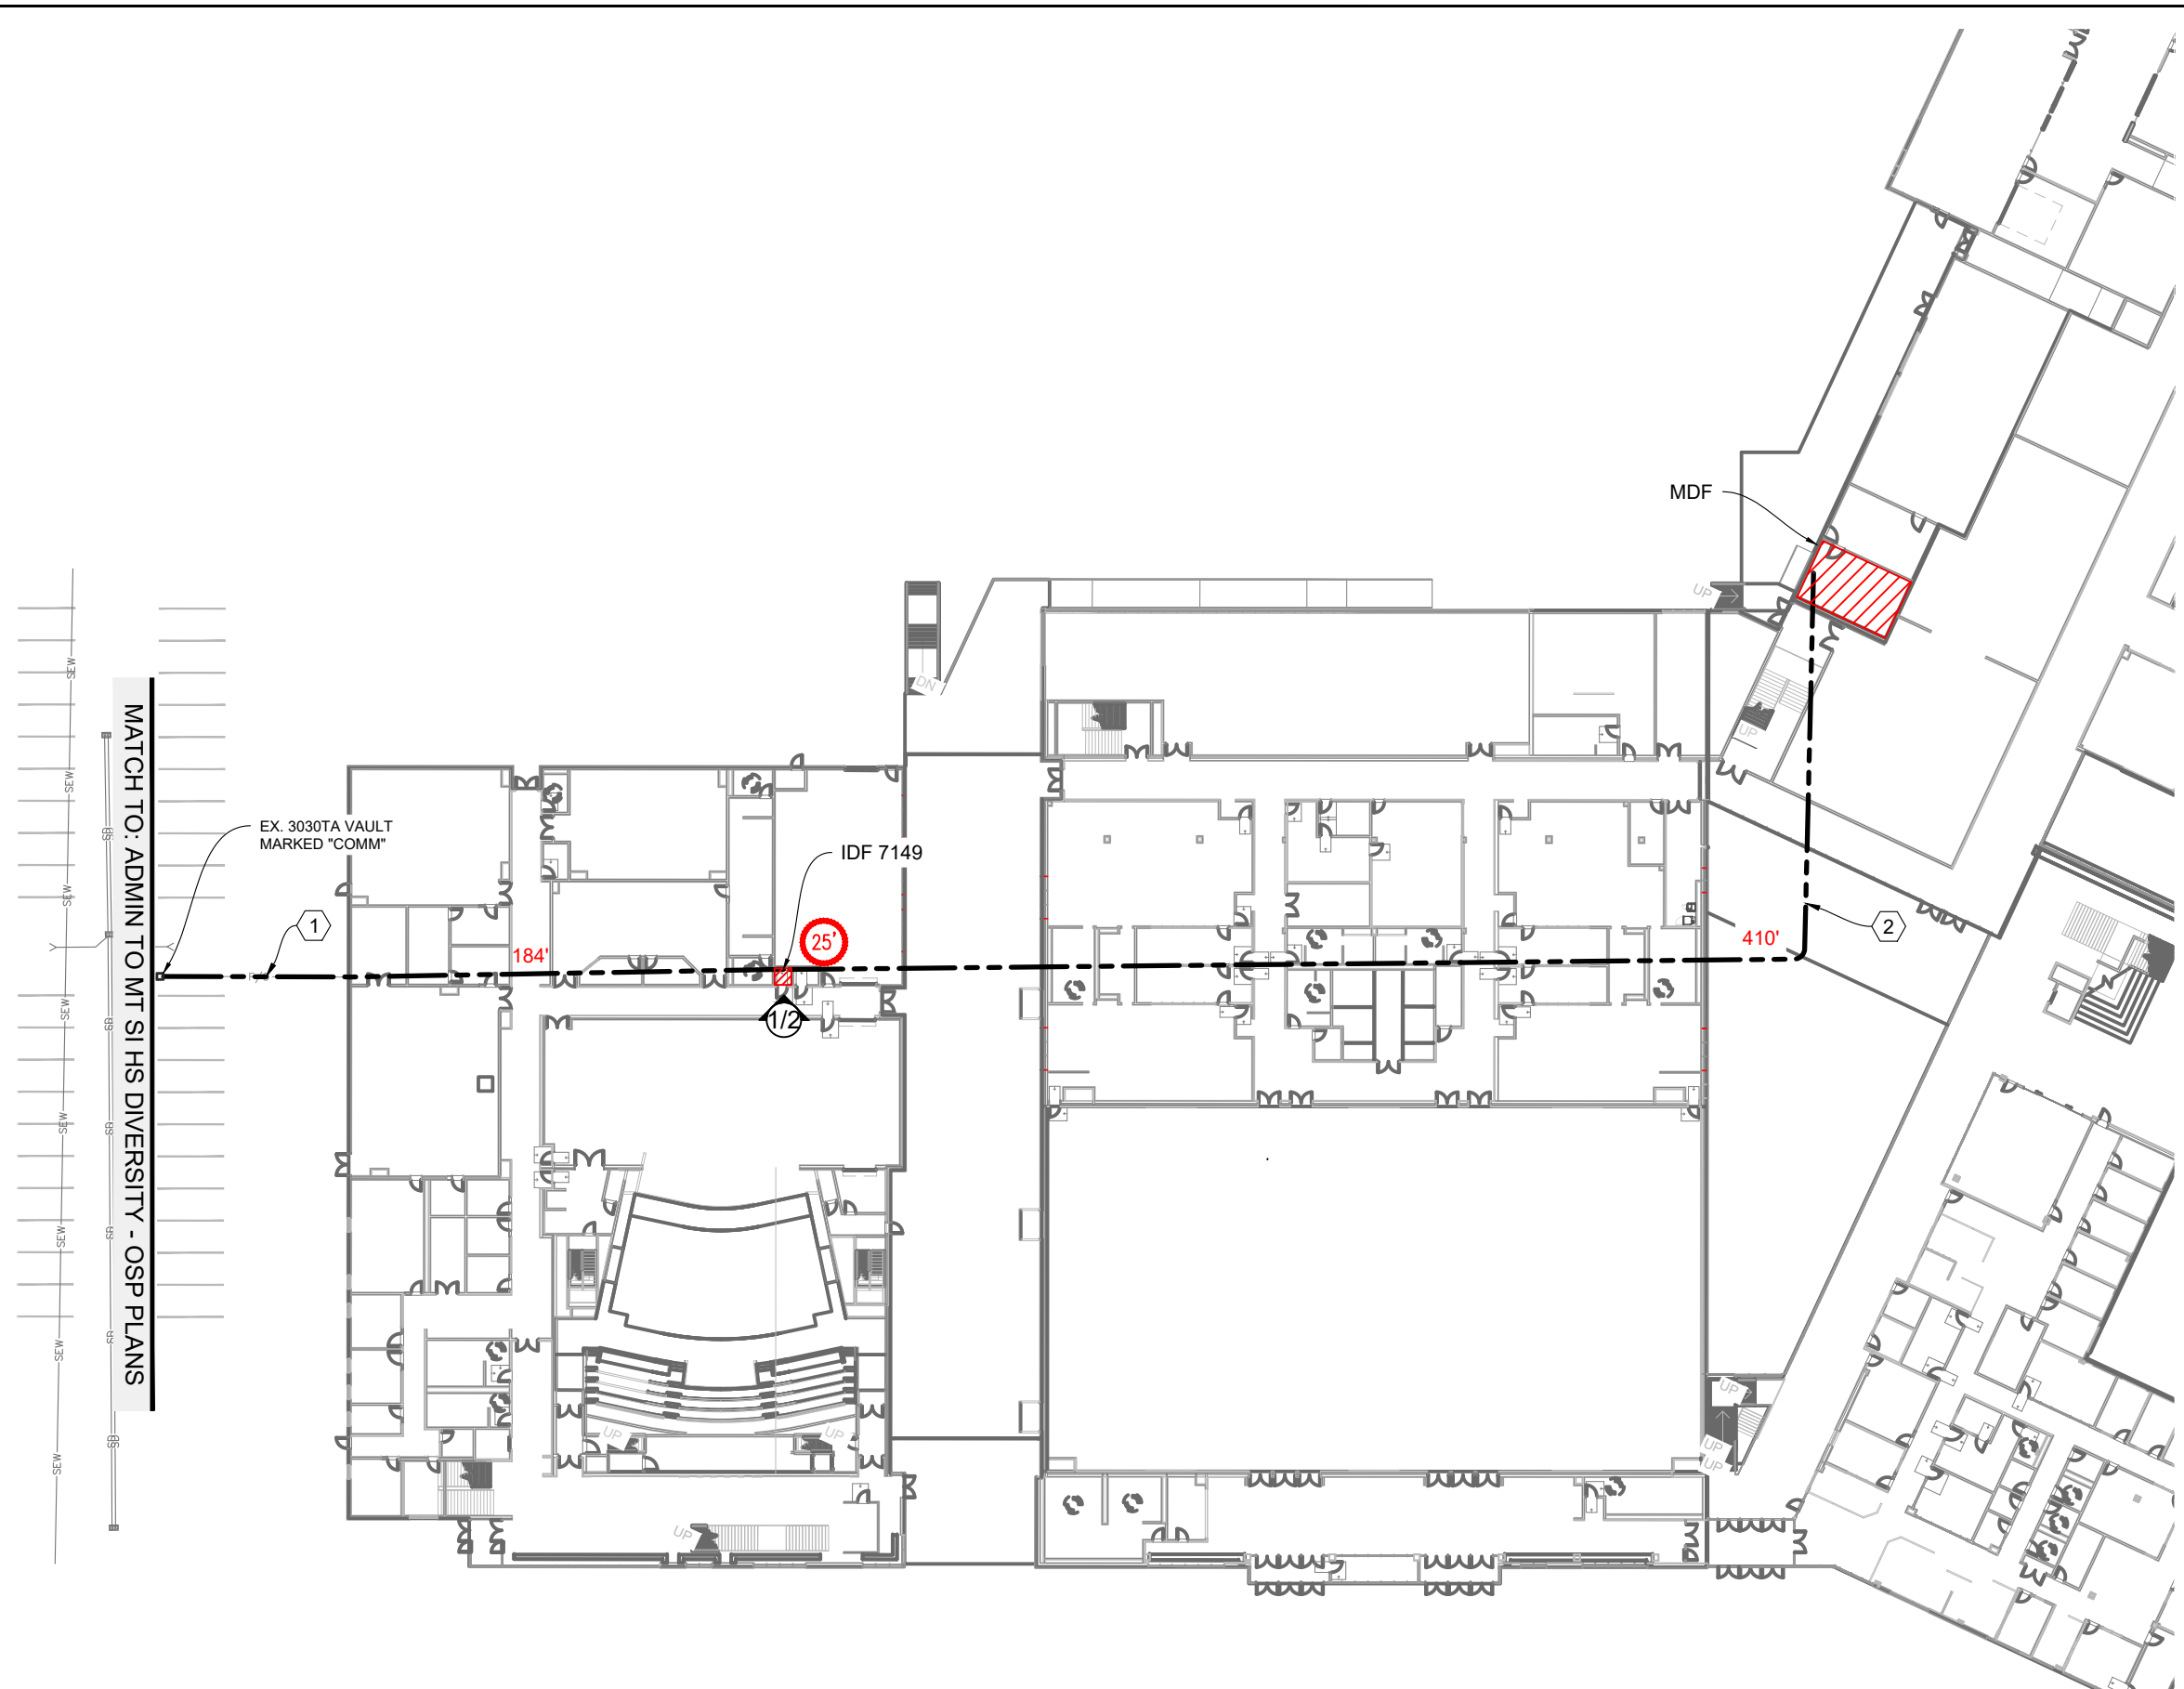

**KEY PLAN**

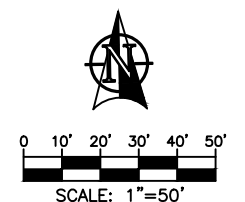

# SYMBOL CORRESPONDS TO PHOTO LOCATIONS AND ORIENTATION. SEE SHEET #7 FOR SITE PHOTOGRAPHS.

3				AS-BUILT
2	4/7/23	JLS	JLS	REVISION # 1
1	12/19/22	JLS	JLS	ORIGINAL
NO.	DATE	ENGINEER	DRAFTER	COMMENT





SNOQUALMIE SCHOOL DISTRICT ENGINEER: RYAN VANNATTA  
 ENGINEERING FIRM: MGC TECHNICAL CONSULTING INC.  
 PROJECT NAME: ADMIN TO MT SI HS DIVERSITY - MT SI ISP  
 LOCATION: 8651 MEADOWBROOK WAY SE  
 SNOQUALMIE, WA 98065

PERMIT NUMBER:  
 DRAWING NAME: SNOQUALMIE SCHOOL DISTRICT - ADMIN TO MT SI HS DIVERSITY - ISP PLANS - L  
**CONFIDENTIAL/PROPRIETARY** SHEET: 4 OF 7

**MT SI HIGH SCHOOL - LEVEL 1**

**CONSTRUCTION NOTES**

- 1 EXISTING VACANT 2" CONDUIT TO IDF 7149. INSTALL (1) 2" DETECTABLE 3-CELL MAXCELL EDGE INNERDUCT. PULL (1) 24F CABLE THROUGH TO MDF ROOM VIA IDF 7149.
- 2 EXISTING 4" CONDUIT FROM IDF 7149 TO MDF ROOM. INSTALL (1) 1" INNERDUCT. PULL (1) 24F CABLE THROUGH.
- 3 INSTALL (1) 1" INNERDUCT FROM CONDUIT ENTRY TO FIBER TERMINATION CABINET ALONG EXISTING CABLE TRAY. PULL (1) 24F CABLE THROUGH.
- 4 COORDINATE WITH SVSD TO SHIFT (2) EXISTING LEVITON 1U FIBER TERMINATION PANELS (FIBER TO IDFS) TO OCCUPY RU 36 & 37.
- 5 INSTALL (1) CORNING CCH-01U FIBER DISTRIBUTION PANEL IN CABINET AT RU 29. INSTALL (1) 24F CORNING LC-APC CASSETTE (CCH-CS24-B3-P00RE) IN SLOT "A" & TERMINATE (1) 24F CABLE WITH CORE ALIGNMENT FUSION SPLICER.

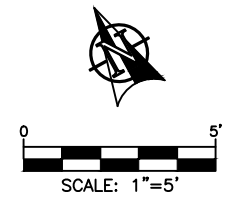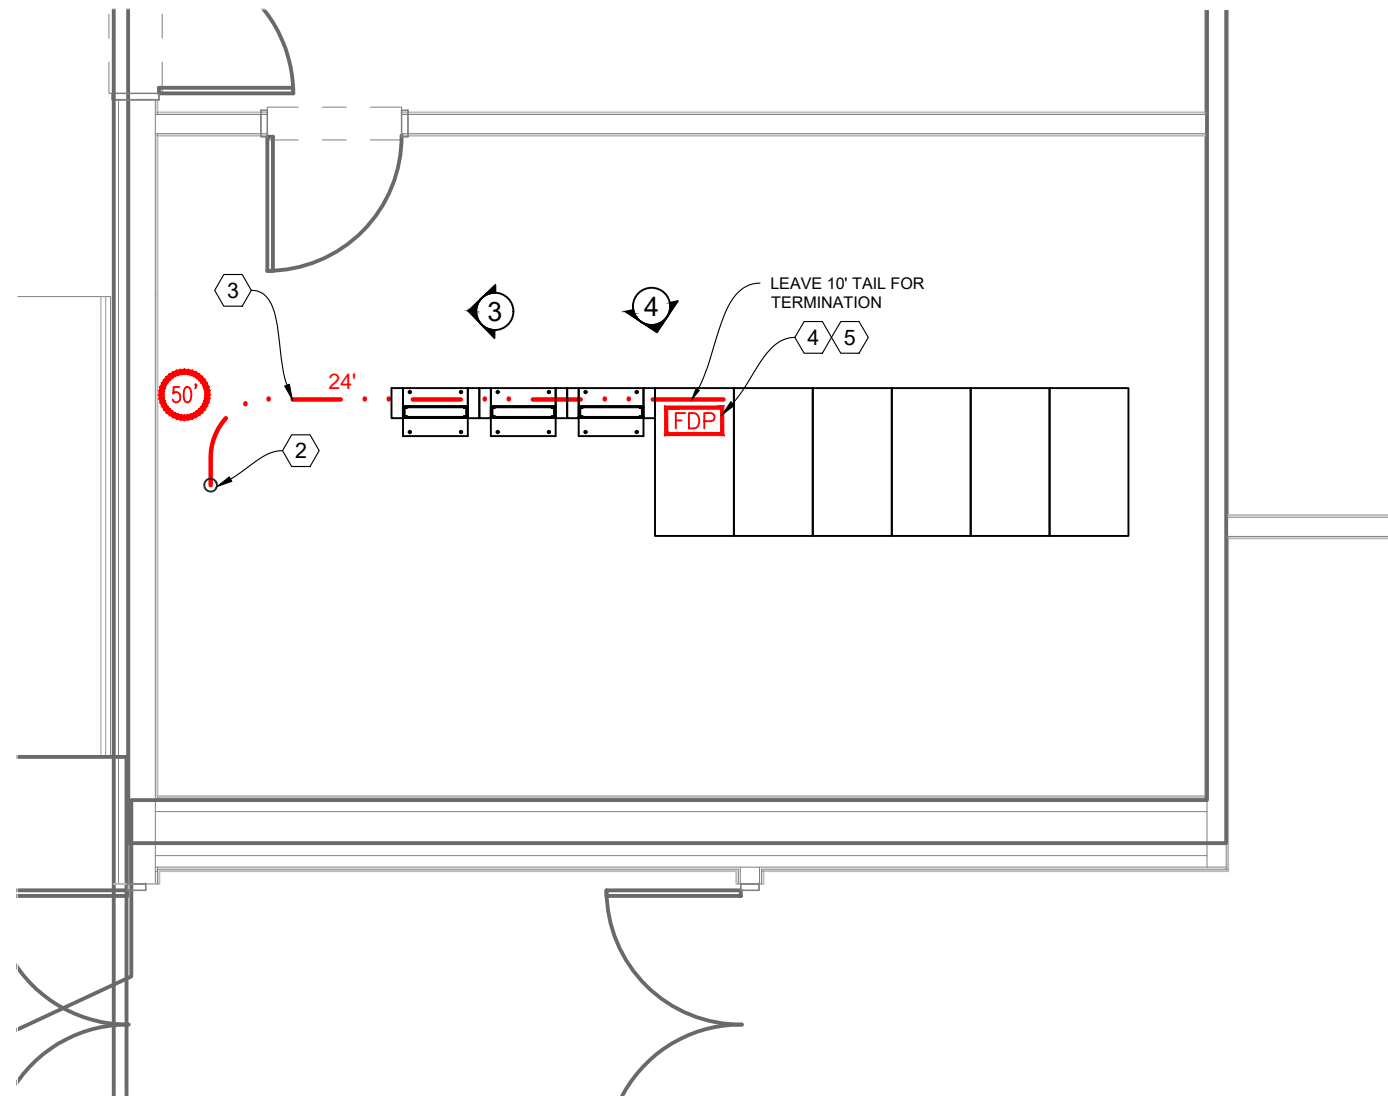

# SYMBOL CORRESPONDS TO PHOTO LOCATIONS AND ORIENTATION. SEE SHEET #7 FOR SITE PHOTOGRAPHS.

3				AS-BUILT
2	4/7/23	JLS	JLS	REVISION # 1
1	12/19/22	JLS	JLS	ORIGINAL
NO.	DATE	ENGINEER	DRAFTER	COMMENT



SNOQUALMIE SCHOOL DISTRICT ENGINEER: RYAN VANNATTA  
 ENGINEERING FIRM: MGC TECHNICAL CONSULTING INC.  
 PROJECT NAME: ADMIN TO MT SI HS DIVERSITY - MT SI ISP  
 LOCATION: 8651 MEADOWBROOK WAY SE  
 SNOQUALMIE, WA 98065  
 PERMIT NUMBER:  
 DRAWING NAME: SNOQUALMIE SCHOOL DISTRICT - ADMIN TO MT SI HS DIVERSITY - ISP PLANS - I  
**CONFIDENTIAL/PROPRIETARY** SHEET: 5 OF 7

**MDF ROOM - ENLARGED PLAN**

# TYPICAL DETAILS / MATERIALS

**CCH Pigtailed Splice Cassette 24 F, LC APC duplex, Single-mode (OS2), single-fiber (250 μm)**



## Specifications

General Specifications	
Fiber Category	Single-mode (OS2)
Cable Type	250 μm
Mounting Type	CCH Housings, Wall-Mountable
Product Type	Rack-Mountable Hardware
Technology	Fusion Splice
Application	Data Center, Enterprise Networks

Standards	
RoHS	Free of hazardous substances according to RoHS 2011/65/EU
Approvals and Listings	Meets ANSI/TIA/EIA-568A and 606, Tested in accordance with Telecordia GR-3125, UL1863 - Communication Circuit Accessories


Environmental Conditions	
Temperature Range, Operation	-40 °C to 65 °C (-40 F to 149 F )

Design	
Fiber Count	24
Connector Configuration	LC duplex
Polish	APC
Panel or Module Type	CCH
Splice Protectors Type	Heat Shrink, single fiber
Number of Splice Protectors	24

Design - Adapter	
Adapter Type	LC duplex

Product Specification CCH-CS24-B3-P00RE\_NAFTA\_AEN

Page 2 | Revision Date 2022-12-08

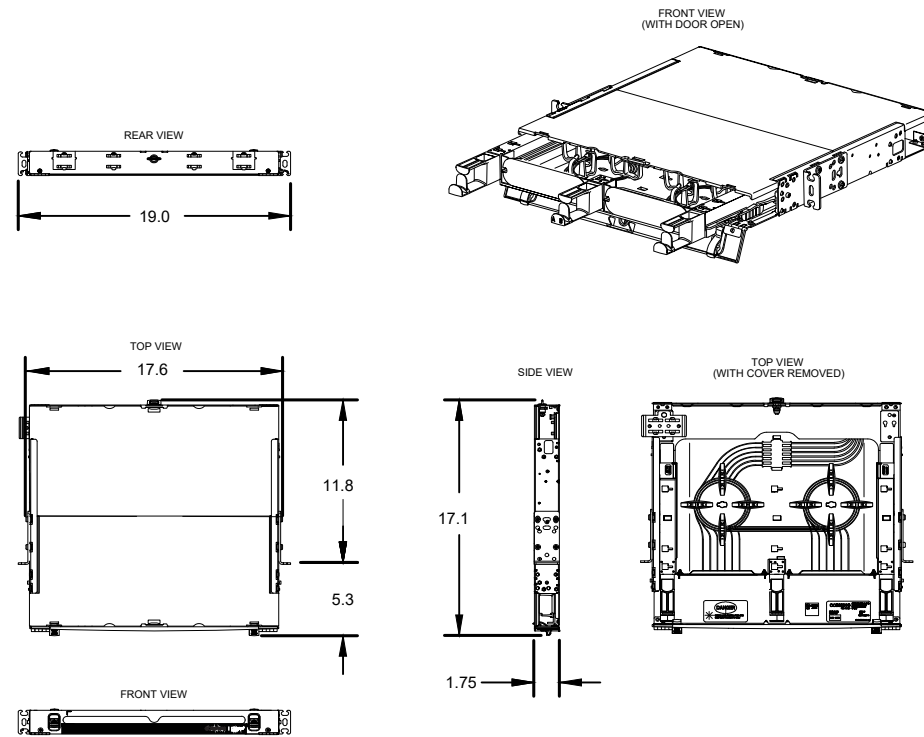

**CORNING - CCH-01U - FIBER TERMINATION PANEL**  
SCALE: NTS

**CORNING - CCH-CS24-B3-P00RE - FIBER CASSETTE**  
SCALE: NTS

3				AS-BUILT
2	4/7/23	JLS	JLS	REVISION # 1
1	12/19/22	JLS	JLS	ORIGINAL
NO.	DATE	ENGINEER	DRAFTER	COMMENT



SNOQUALMIE SCHOOL DISTRICT ENGINEER: RYAN VANNATTA  
 ENGINEERING FIRM: MGC TECHNICAL CONSULTING INC.  
 PROJECT NAME: ADMIN TO MT SI HS DIVERSITY - MT SI ISP  
 LOCATION: 8651 MEADOWBROOK WAY SE  
 SNOQUALMIE, WA 98065  
 PERMIT NUMBER:  
 DRAWING NAME: SNOQUALMIE SCHOOL DISTRICT - ADMIN TO MT SI HS DIVERSITY - ISP PLANS - I  
**CONFIDENTIAL/PROPRIETARY** SHEET: 6 OF 7

# SITE PHOTOGRAPHS

PHOTO #1: IDF 7149 FACING NORTH



PHOTO #2: IDF 7149 FACING NORTH

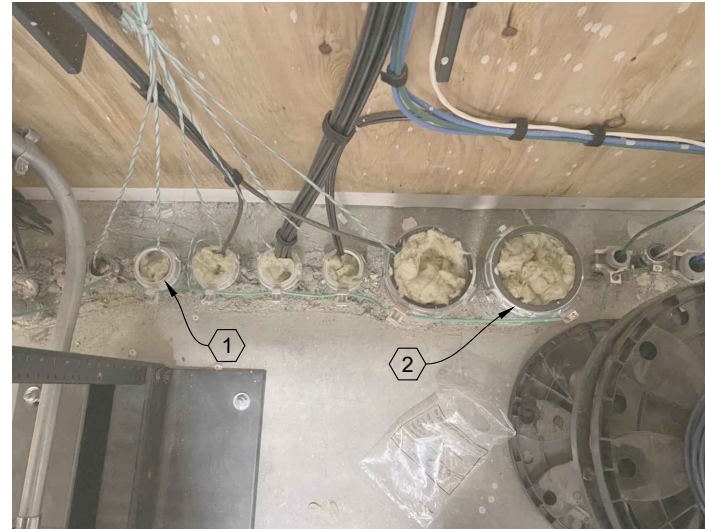


PHOTO #3: FACING SOUTHEAST IN ADMIN WAREHOUSE MEZZANINE


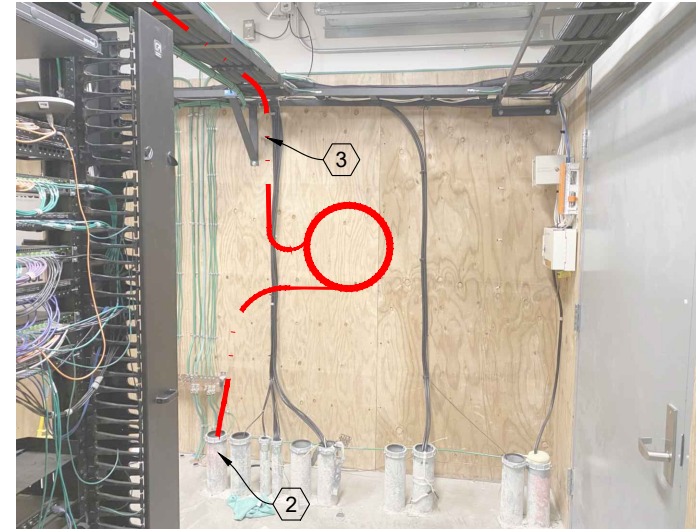


PHOTO #4: MDF ROOM FACING SOUTH



## CONSTRUCTION NOTES

- 1 EXISTING VACANT 2" CONDUIT TO IDF 7149. INSTALL (1) 2" DETECTABLE 3-CELL MAXCELL EDGE INNERDUCT. PULL (1) 24F CABLE THROUGH TO MDF ROOM VIA IDF 7149.
- 2 EXISTING 4" CONDUIT FROM IDF 7149 TO MDF ROOM. INSTALL (1) 1" INNERDUCT. PULL (1) 24F CABLE THROUGH.
- 3 INSTALL (1) 1" INNERDUCT FROM CONDUIT ENTRY TO FIBER TERMINATION CABINET ALONG EXISTING CABLE TRAY. PULL (1) 24F CABLE THROUGH.
- 4 COORDINATE WITH SVSD TO SHIFT (2) EXISTING LEVITON 1U FIBER TERMINATION PANELS (FIBER TO IDFS) TO OCCUPY RU 36 & 37.
- 5 INSTALL (1) CORNING CCH-01U FIBER DISTRIBUTION PANEL IN CABINET AT RU 29. INSTALL (1) 24F CORNING LC-APC CASSETTE (CCH-CS24-B3-P00RE) IN SLOT "A" & TERMINATE (1) 24F CABLE WITH CORE ALIGNMENT FUSION SPLICER.

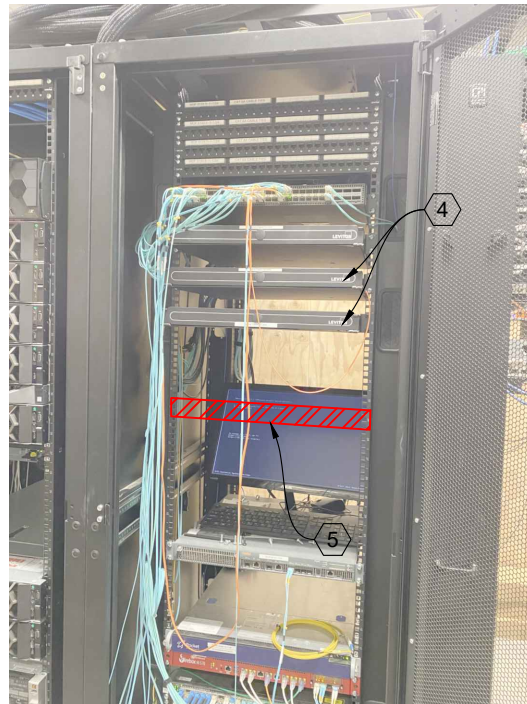

3				AS-BUILT
2	4/7/23	JLS	JLS	REVISION # 1
1	12/19/22	JLS	JLS	ORIGINAL
NO.	DATE	ENGINEER	DRAFTER	COMMENT



SNOQUALMIE SCHOOL DISTRICT ENGINEER: RYAN VANNATTA  
 ENGINEERING FIRM: MGC TECHNICAL CONSULTING INC.  
 PROJECT NAME: ADMIN TO MT SI HS DIVERSITY - MT SI ISP  
 LOCATION: 8651 MEADOWBROOK WAY SE  
 SNOQUALMIE, WA 98065  
 PERMIT NUMBER:  
 DRAWING NAME: SNOQUALMIE SCHOOL DISTRICT - ADMIN TO MT SI HS DIVERSITY - ISP PLANS - I  
**CONFIDENTIAL/PROPRIETARY** SHEET: 7 OF 7