



1 REVISED DIMMING SYSTEM RISER DIAGRAM - PERFORMANCE  
 ESO NO SCALE

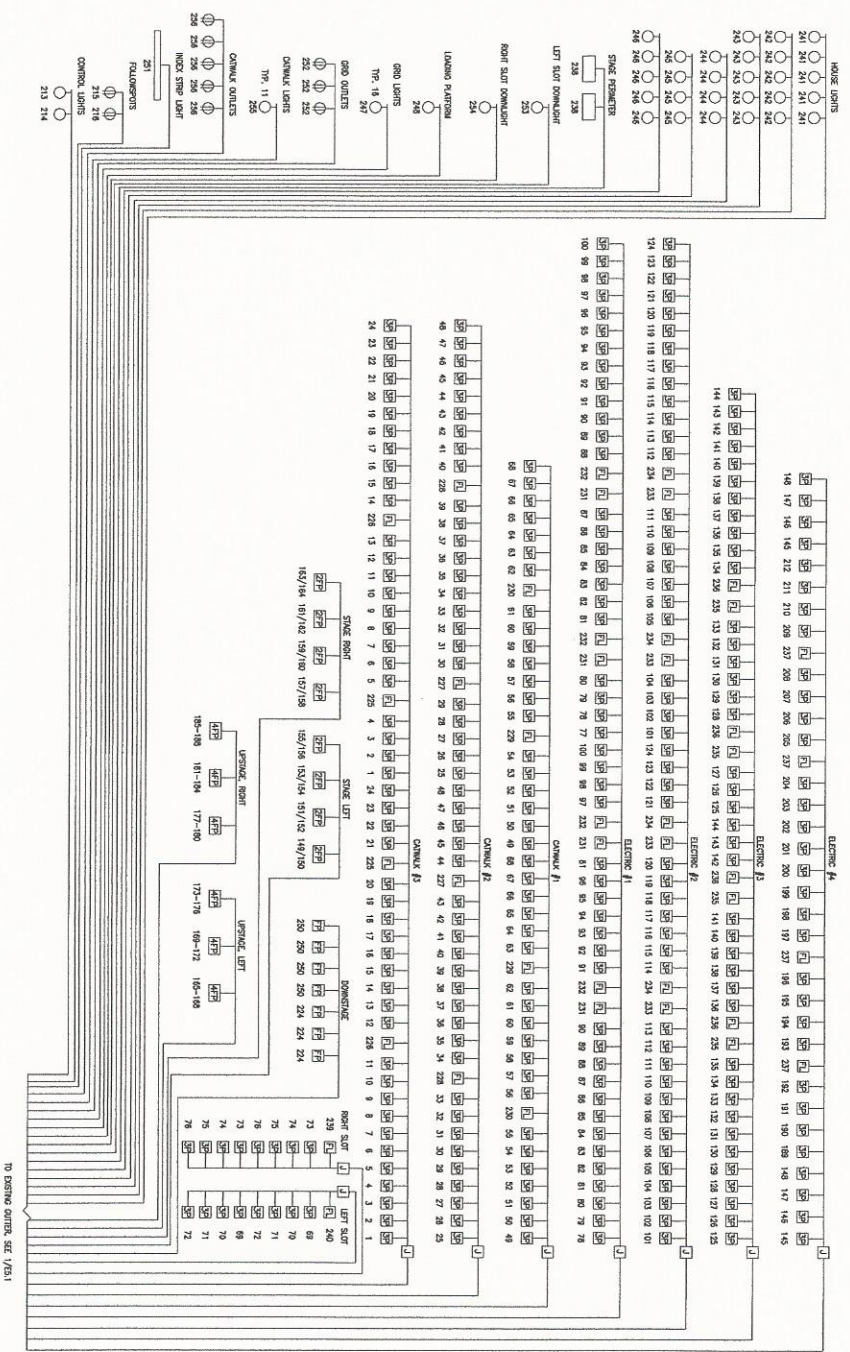

**AS-BUILT DRAWING**  
 This drawing has been modified to reflect the actual construction. It is provided by the contractor. **RYAN CONSTRUCTION, INC.**  
 11-BEP-2012

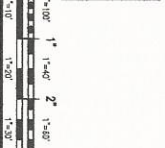

Date: 06 FEB 2012  
 In Charge: RSB  
 Drawn by: JMK  
 Checked by: [blank]  
 Comm. No. 101108  
**ESO**

Revision: \_\_\_\_\_ Date: \_\_\_\_\_  
 NORTH POLE HIGH SCHOOL  
 LIGHTING UPGRADES  
 Proj. No. 11-NPHPRJ-01  
 IFB No. 12029  
**Position Alaska**  
 Architects Engineers Surveyors  
 601 College Road  
 Fairbanks, Alaska 99701  
 Telephone: 907 452 1241

**PERFORMANCE DIMMER SYSTEM RISER**