


Midwest
Environmental
Consulting, L.L.C.

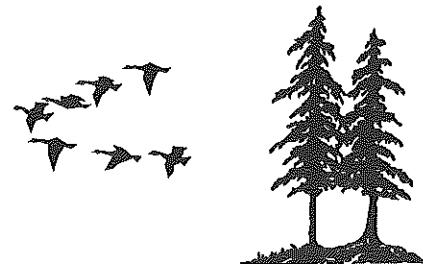

Printed on Recycled Paper

**Webster Enrichment School
Saint Paul Public Schools**

Lead-Based Paint Inspection

**Inspection Dates: 12/2/97, 12/3/97, 12/4/97, 12/10/97,
12/11/97, 12/16/97, 12/24/97, 1/2/98, 1/6/98, 1/7/98,
1/8/98, 1/9/98, 1/15/98, 1/20/98, 1/21/98**

submitted to:

Saint Paul Public Schools

MEC Project # 62/0197BE

INTRODUCTION

At the request of Saint Paul Public Schools Environmental Safety Department, Midwest Environmental Consulting, L.L.C. (MEC), conducted a lead-based paint inspection at Webster Enrichment School, 707 Holly Avenue, St. Paul, MN. The purpose of this inspection was to identify lead-based painted, varnished, or otherwise coated building components on the interior and exterior of the school building.

The inspection protocol incorporated applicable portions of the U.S. Department of Housing and Urban Development (HUD) *Guidelines for the Evaluation and Control of Lead-based Paint Hazards in Housing* (HUD Guidelines, June 1995) and OSHA 1926.62 requirements (Lead in Construction). The HUD guidelines are formulated to guide agencies in conducting random sampling of the interiors and exteriors of dwellings and common areas in public housing. The OSHA requirement is designed to minimize worker exposure when working with material containing lead.

The United States Environmental Protection Agency defines "lead-based paint" as a paint or other surface coating that contains lead equal to or in excess of 1.0 milligrams per square centimeter when analyzed by XRF or more than 0.5% by weight (5000 parts per million) by laboratory analysis of a bulk sample.

Minnesota Department of Labor and Industry (MN OSHA) adopted the EPA lead levels for the purpose of enforcing OSHA 1926.62 federal regulations. Detection of lead in dried paint film by XRF is a dependable indicator of levels of lead and is accepted by MN OSHA.

No paint chip samples were collected from this school for laboratory analysis.

For this Saint Paul Public Schools Lead Inspection, all building components were tested on site using a Niton XL® X-ray Fluorescence Spectrum Analyzer⁽¹⁾. Building components included walls, ceilings, floors, moldings, window and door components, door surfaces, and miscellaneous features such as shelves or bookcases. Only painted or glazed surfaces or surfaces which were varnished were tested. Suspended ceilings, structural steel, and corrugated decking were not included in the inspection. Neither anodized (e.g., window sashes) nor plastic (e.g., vinyl baseboard and vinyl mini-blinds) were included in the scope of this inspection.

Each building was divided into unique sites based on the year of construction or renovation. Portable classrooms, playgrounds, and other detached buildings were automatically designated as a unique site. Each site was inspected independently assuming differences in painting history and construction characteristics.

⁽¹⁾ This is a portable hand held machine that can analyze building components instantly for lead concentrations.

SITE DESCRIPTION AND BUILDING HISTORY

According to information provided to MEC by Saint Paul Public Schools, Cleveland Quality Middle School was constructed in essentially three phases. The initial phase includes the 43,806 square-foot older section of the building and dates from 1925. The second phase is a 92,798 square foot addition dating from 1926. The third phase is a 24,257 square foot addition from 1975.

All room and area designations used in this report are depicted on sampling maps found in Appendix A.

XRF SAMPLE RESULTS TABLE

The results of all samples analyzed are listed in the table at the end of this section. The following is a description of the column headings:

Site	Each school is divided into sites based on their unique construction characteristics. Each site has a unique date of construction or major renovation.
Sample #	Each sample taken was given a unique number to identify the type and location of the sample. The sampling date is an integral part of the sample number.
Analysis	This defines the type of analysis which can be categorized into two types: 1) XRF: This is an on-site analysis using a hand held Niton XL® X-ray Fluorescence Spectrum Analyzer; 2) Bulk or Chip: This is a bulk sample where paint is removed from the substrate and sent to a laboratory for analysis;
Floor	This is the level of the building in which the area tested was found, example, 1 (first floor), 0 (basement), etc.
Area	This further defines the specific functional space inspected such as a classroom, exterior, playground, gym, kitchen, etc.
Room #	This is typically the actual number on the room as identified at the building.
Component	Building "components" included walls, ceilings, floors, moldings, window and door components, door surfaces, and miscellaneous features such as shelves or bookcases.

Feature	Identifies more detailed information of the component.
Condition	This describes condition of the surface, whether it is intact, cracked, peeling, or chalking.
Substrate	This refers to the material the building component is made of (wood, concrete, drywall, metal, etc.).
Result	This is the analysis results for lead. Less than 1.0 mg/cm ² or less than 0.5% by weight is considered to be non-lead and these building components are below the action levels of EPA and HUD. (All results are in mg/cm ² except where noted.)

The table of results is designed for quick information on lead concentrations of tested building components. Generally, all repetitions of a test combination within a given room or area, may be assumed to contain similar concentrations of lead to that of the tested sample. For instance, the lead concentration of a tested wooden window sash was found to be above the action level of 1.0 mg/cm² in a given classroom. The classroom has five windows, all of wood, the same color and appearing to be of the same era. It can be assumed that the remaining four wooden window sashes each contain lead above the action limit.

Other columns identify the component and the component feature tested, condition of the component, type of substrate and the result of the analytical test.

As an example, the following illustration shows that the wooden door jamb in Room 123, first floor in the 1923 building section was in good, solid condition, and had an XRF test result of 0.3 mg/cm², which is below the action level.

Illustration Only

Site	Sample #	Date	Analysis	Floor	Area	Room #	Component	Feature	Condition	Substrate	Results
1923 Bldg.	52		XRF	1	Room	123	Door	Jamb	Solid	Wood	0.3

In a similar manner, the table shows that the plaster walls in room 23, on the second floor has peeling paint with more than 1.0 mg/cm² (shaded).

ILLUSTRATION ONLY

Site	Sample #	Date	Analysis	Floor	Area	Room #	Component	Feature	Condition	Substrate	Results
1910 Bldg.	16		XRF	2	Room	23	Door	Jamb	Peeling	Wood	0.25
1910 Bldg.	17		XRF	2	Room	23	Wall	Wall	Peeling	Plaster	1.2
1910 Bldg.	18		XRF	2	Room	23	Ceiling	Peeling	Plaster		0.25
1910 Bldg.	19		XRF	2	Room	23	Wall	Baseboard	Peeling	Wood	0.002

APPLICABLE REGULATIONS


When building components test above 1.0 mg/cm² of lead by XRF or 0.5% lead by weight from laboratory analysis all employees and contractors who will be working with these components in a construction related activity must be notified. The requirements of OSHA 1926.62, Lead in Construction are enforceable. This regulation defines construction work as "work for construction, alteration and/or repair, including painting and decorating." This regulation further defines monitoring requirements to minimize employee exposure to lead during construction activities.

When work is performed on external painted building structures (i.e. flashing, fire escapes, playground equipment, handrails, etc.), regulations of the Minnesota Pollution Control Agency (MPCA) may also be applicable. For removal of lead based paint from steel structures, MN Rules 7025.0200 - 7025.0380 apply to steel materials on the exterior of a building, or on the property when levels exceed 0.5 mg/cm² based on the average of three XRF spectrum results of the sample tested, or 5,000 ppm by laboratory analysis. If it is other than a steel surface, then MPCA regulates the painted surfaces under MN Rules 7025.010 - 7025.0080, when surfaces are to be disturbed using abrasive blasting methods.

Please contact MEC directly if you have questions about any portion of this report or the lead-based paint inspection itself.

APPENDIX A

XRF TESTING DATA WITH LOCATION MAPS

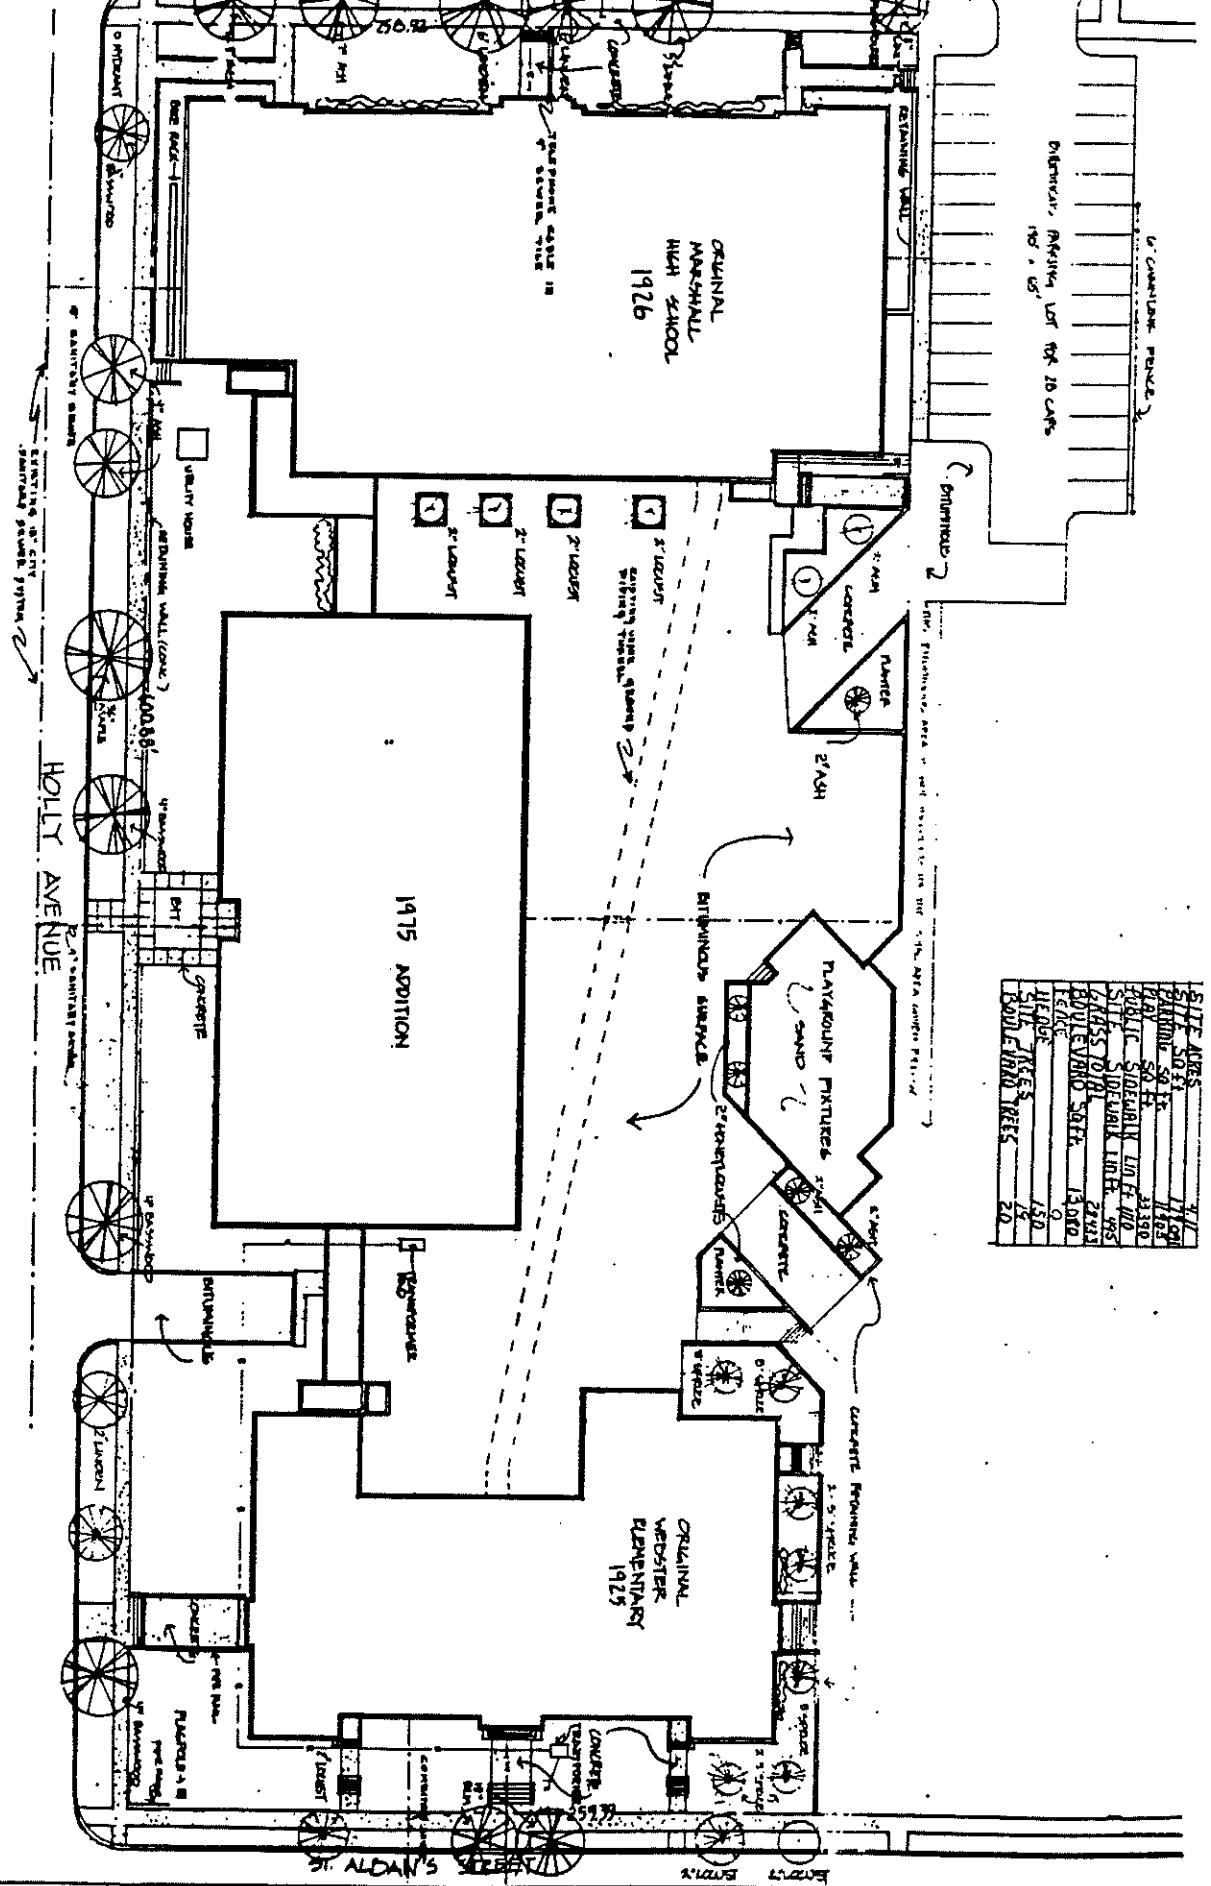

INDEPENDENT SCHOOL DIST. #625

360 COLBORNE ST.

ST. PAUL, MINNESOTA 55102

WEBSTER MAGNET

ST. ALBANS ST & ASHLAND AVE


ST. PAUL, MINNESOTA


CONSTRUCTED: 1925 26-75

ARCHITECT: PLAGENS, McGEE 1975

DRAWN: ~~27-OF-80~~ BY OSPPM.

SHEET
1
10

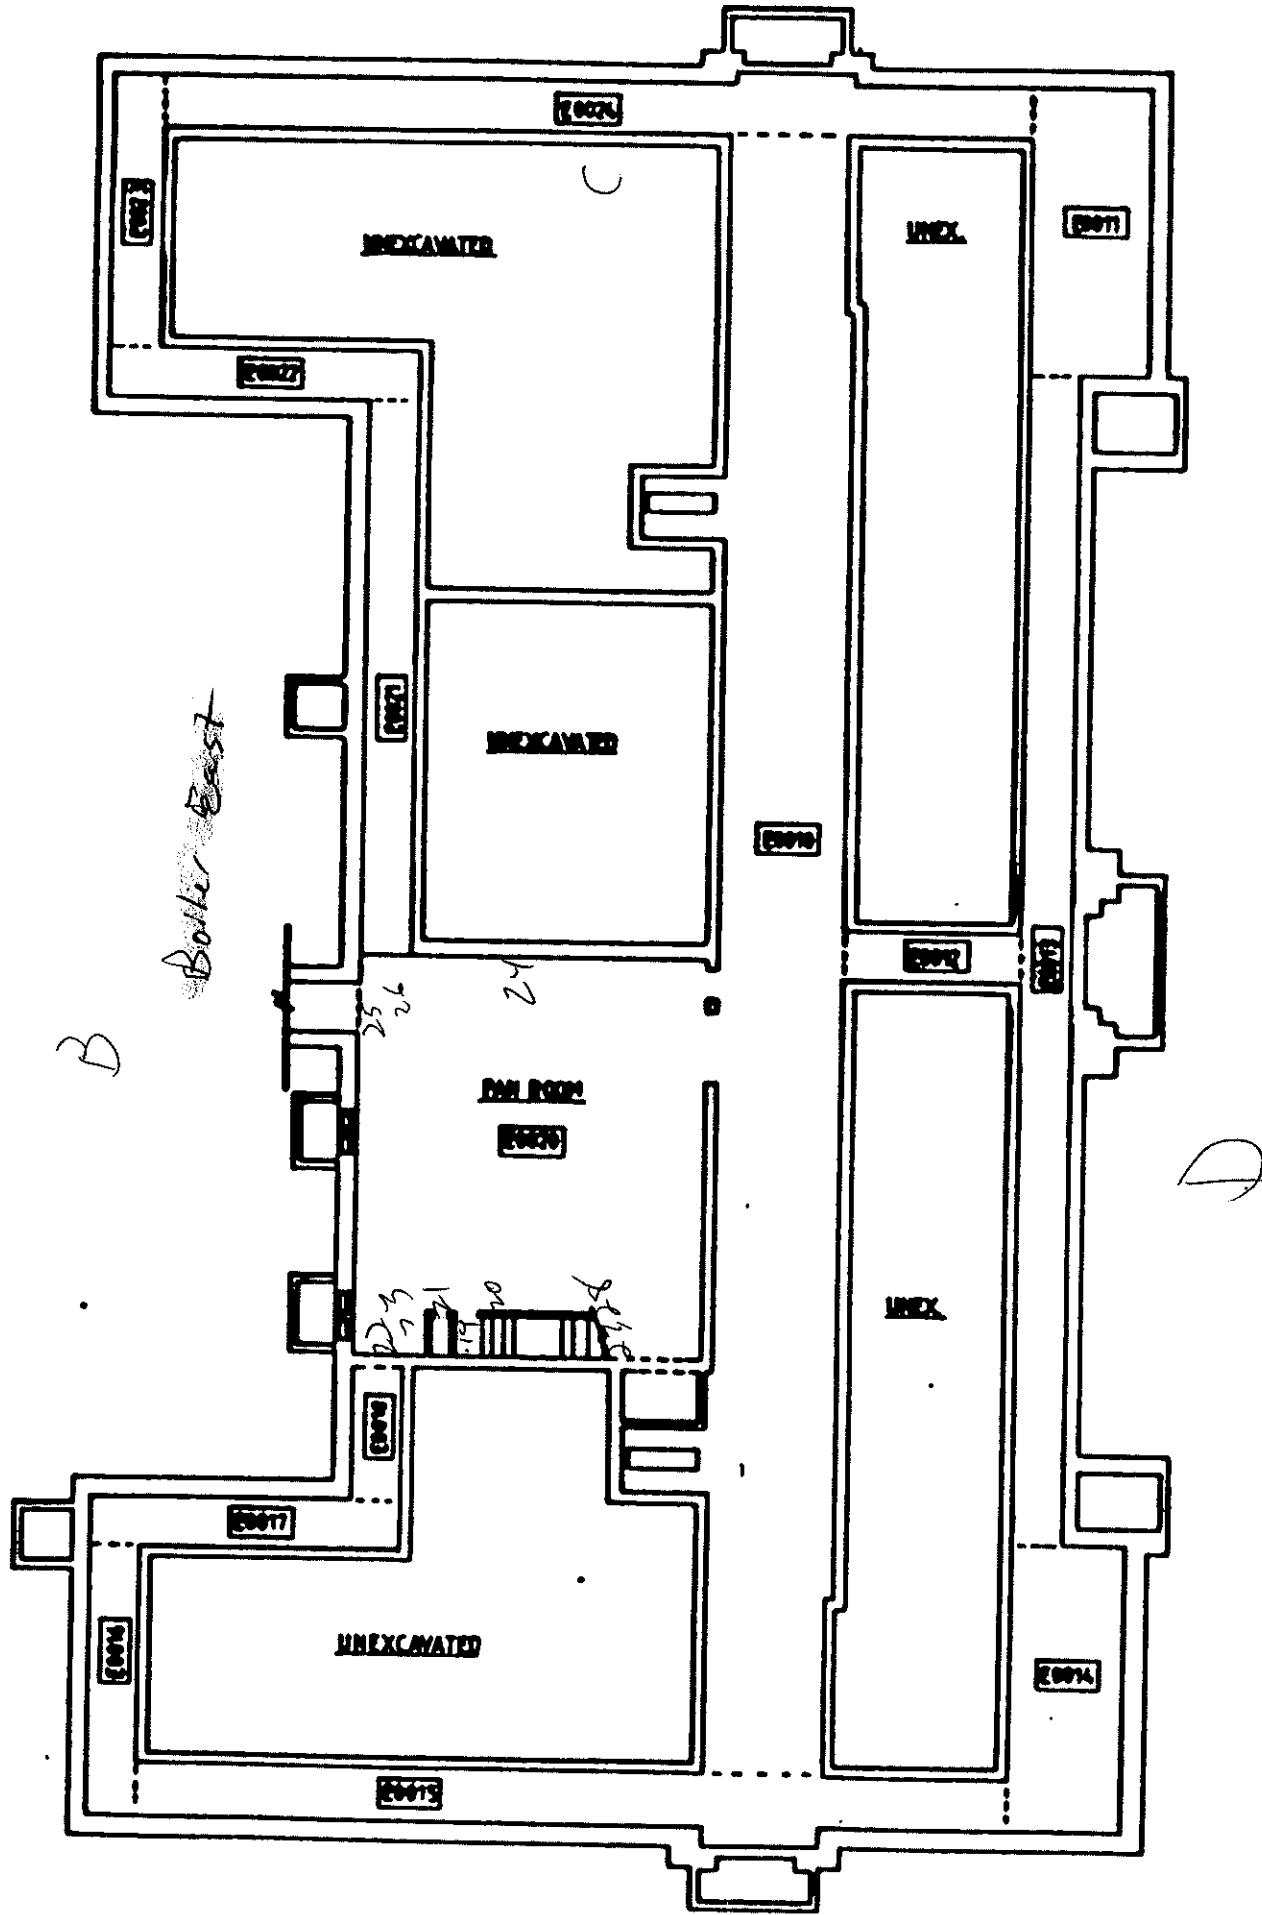


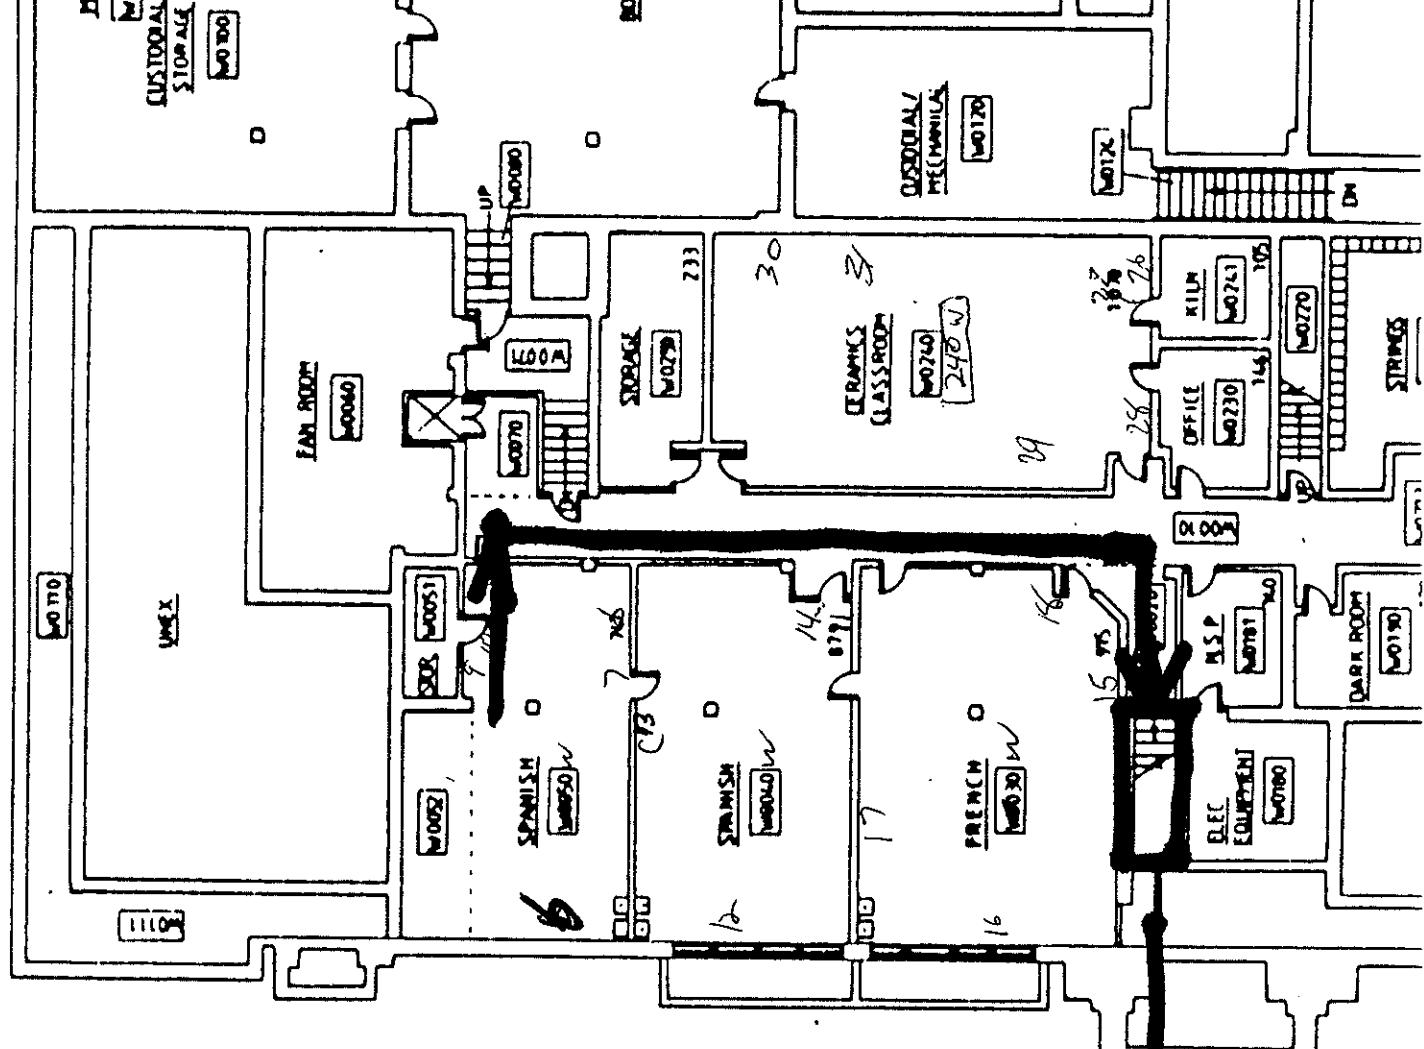


Basement West


Floor 0
Size 2
Ceiling

**GO ACROSS
GROTTO. STAY
ON GROTTO.**

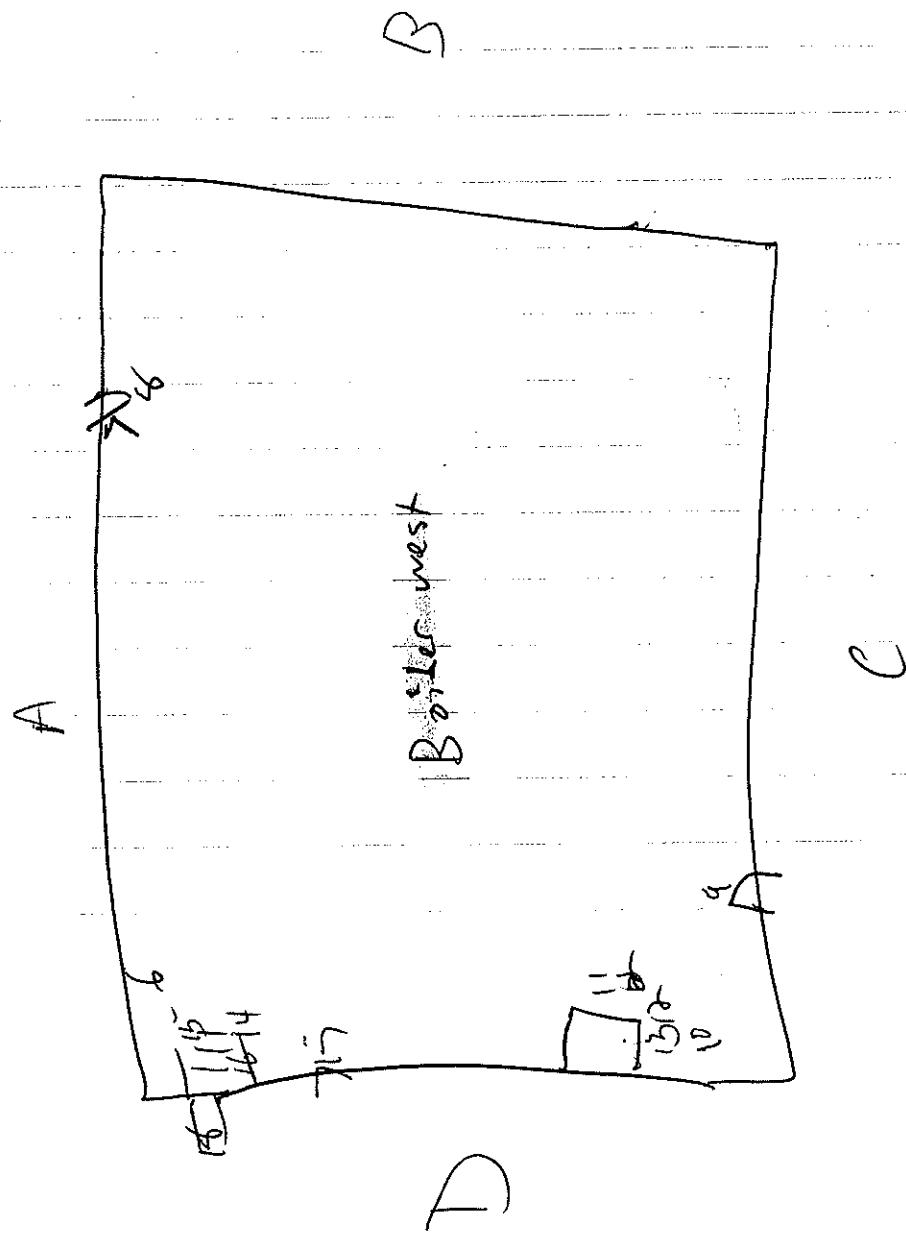

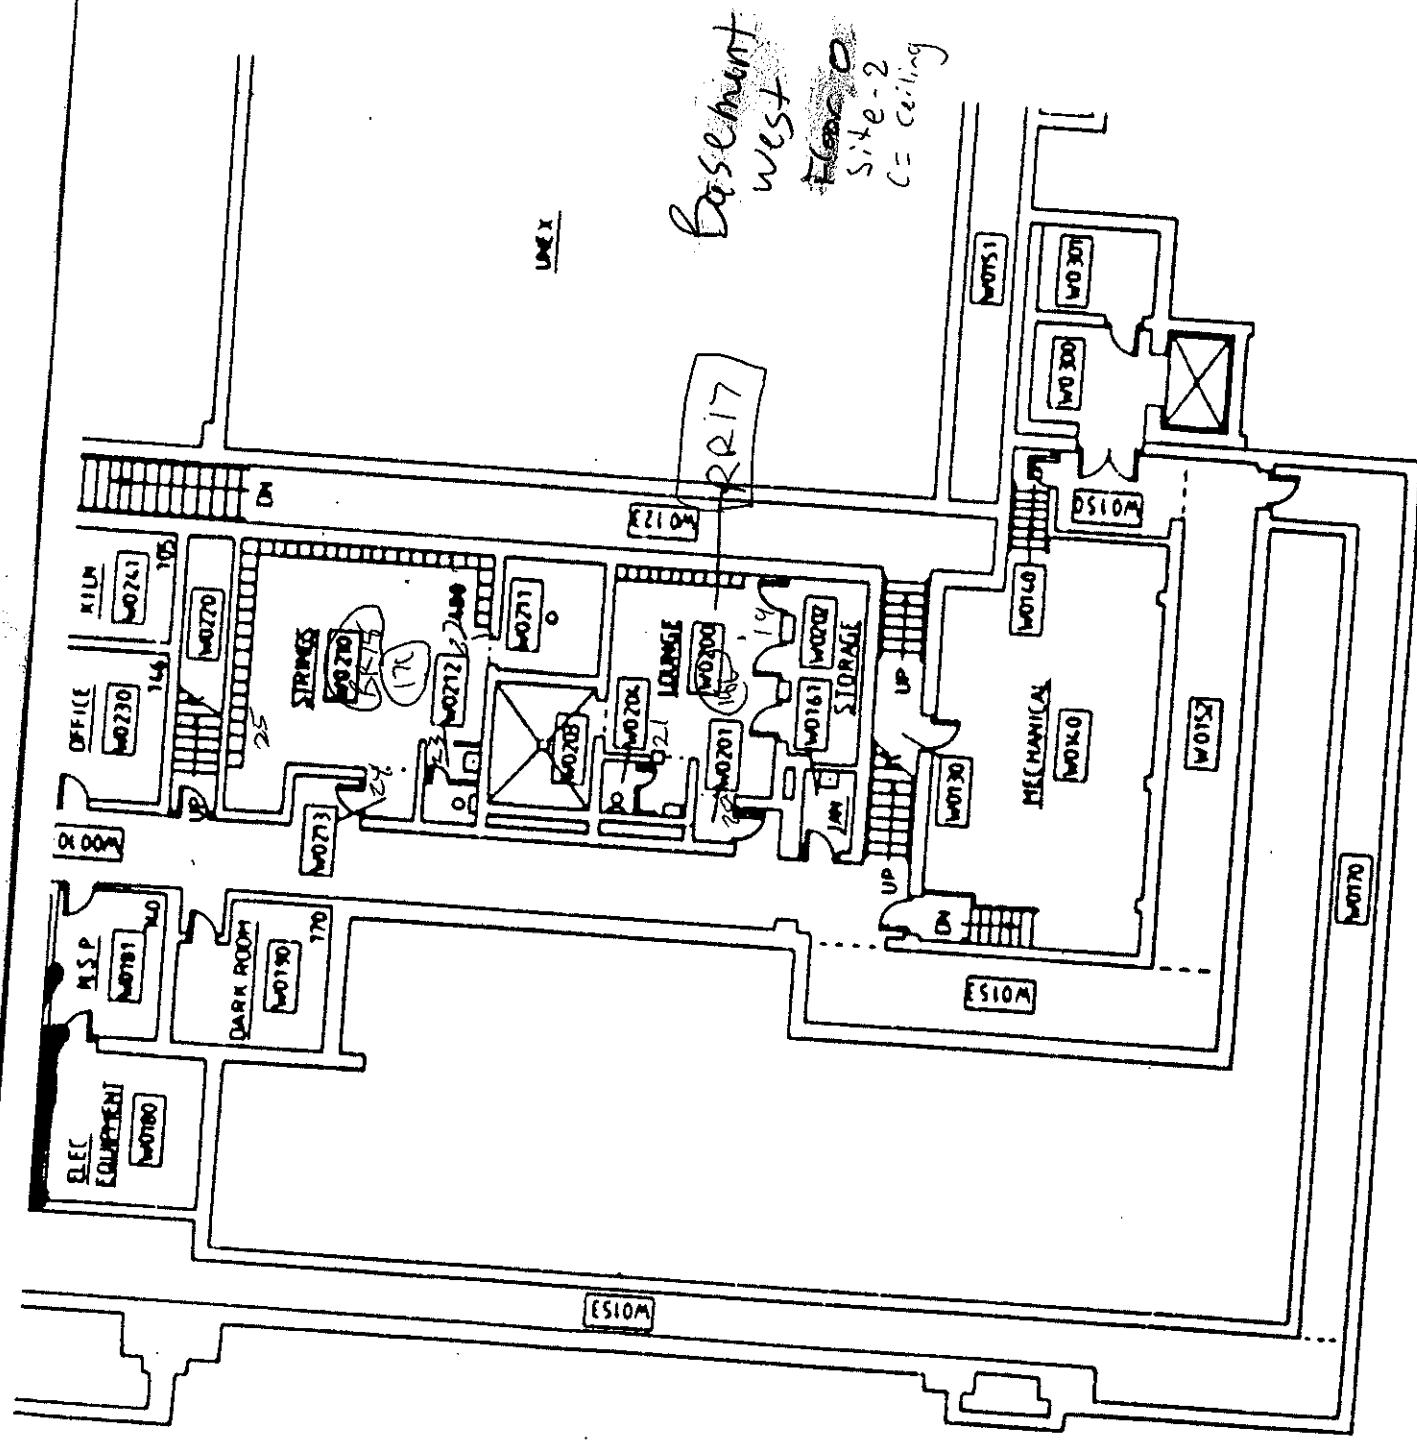


三

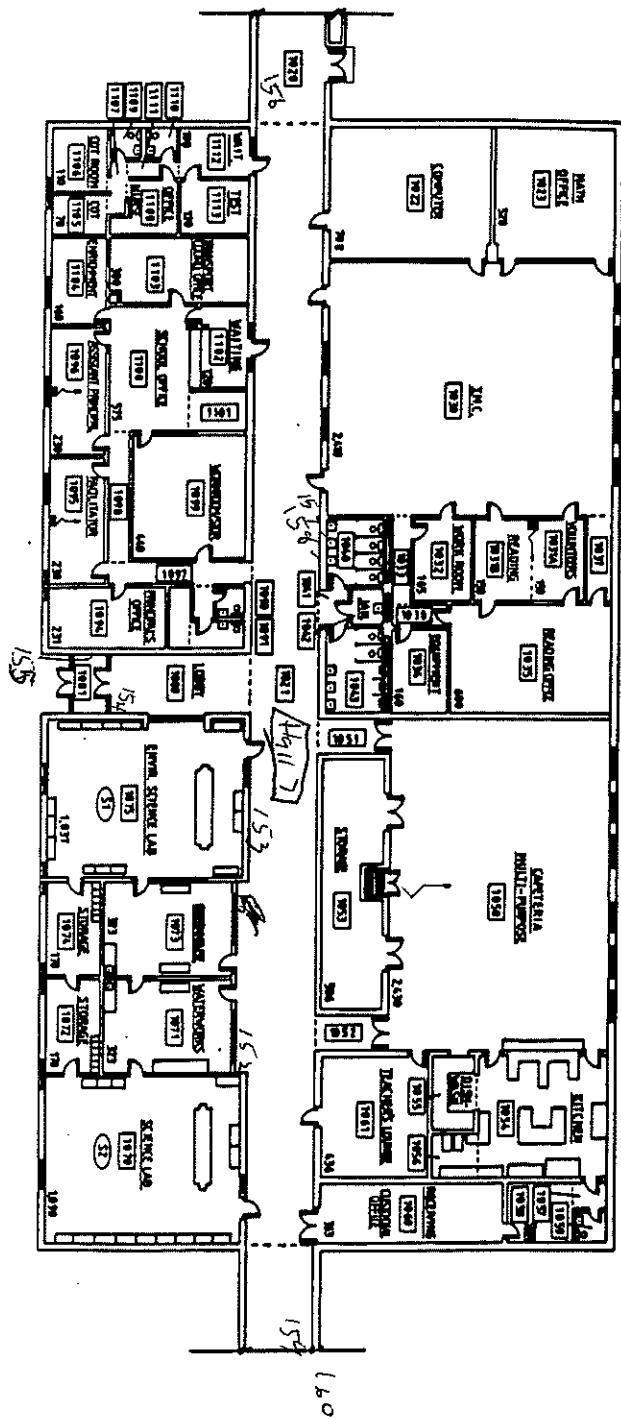

New
Edition

S. 14
3

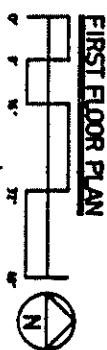


INDEPENDENT SCHOOL DIST. #625
360 COLBORNE STREET
ST. PAUL, MINNESOTA 55102

WEBSTER MAGNET
ST. ALBANS ST. & ASHLAND AVE.
ST. PAUL, MN

CONSTRUCTED: 1925, 26, 75

seit
6
•
13

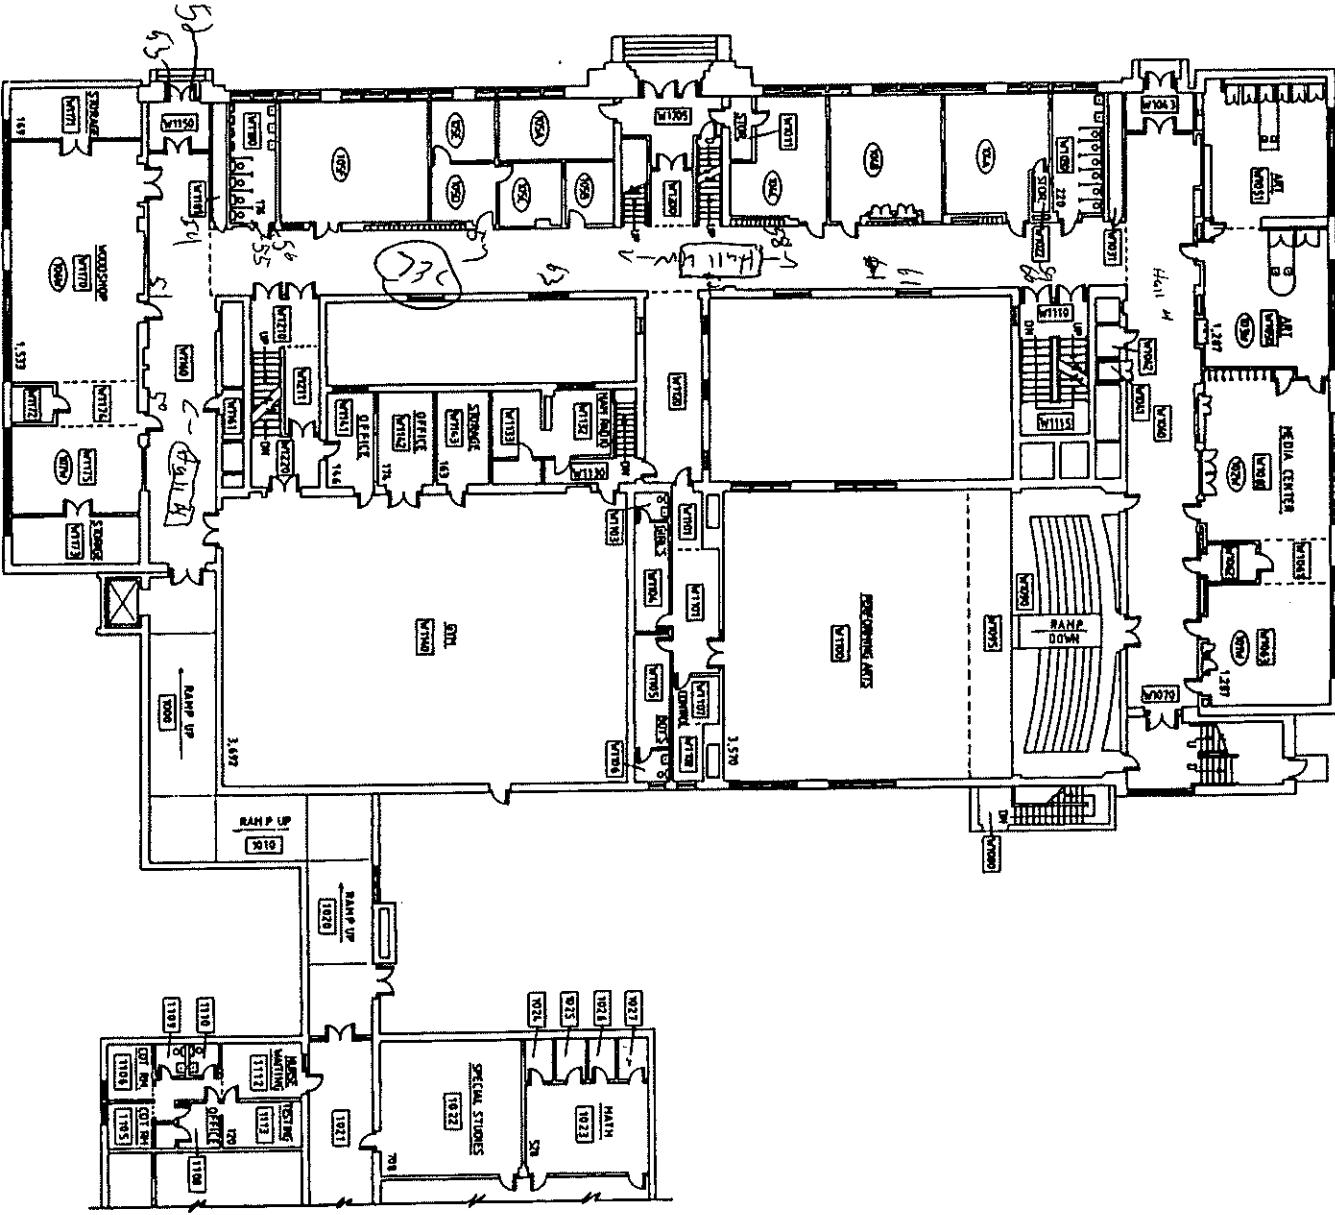

FIRST FLOOR PLAN - WEST


INDEPENDANT SCHOOL DIST. #625
360 COLBORNE STREET
ST. PAUL, MN 55102

WEBSTER MAGNET
ST. ALBANS ST. & ASHLAND AVE.
ST. PAUL, MN


CONSTRUCTED 1929, 76, 75



SHEET
3 OF
13

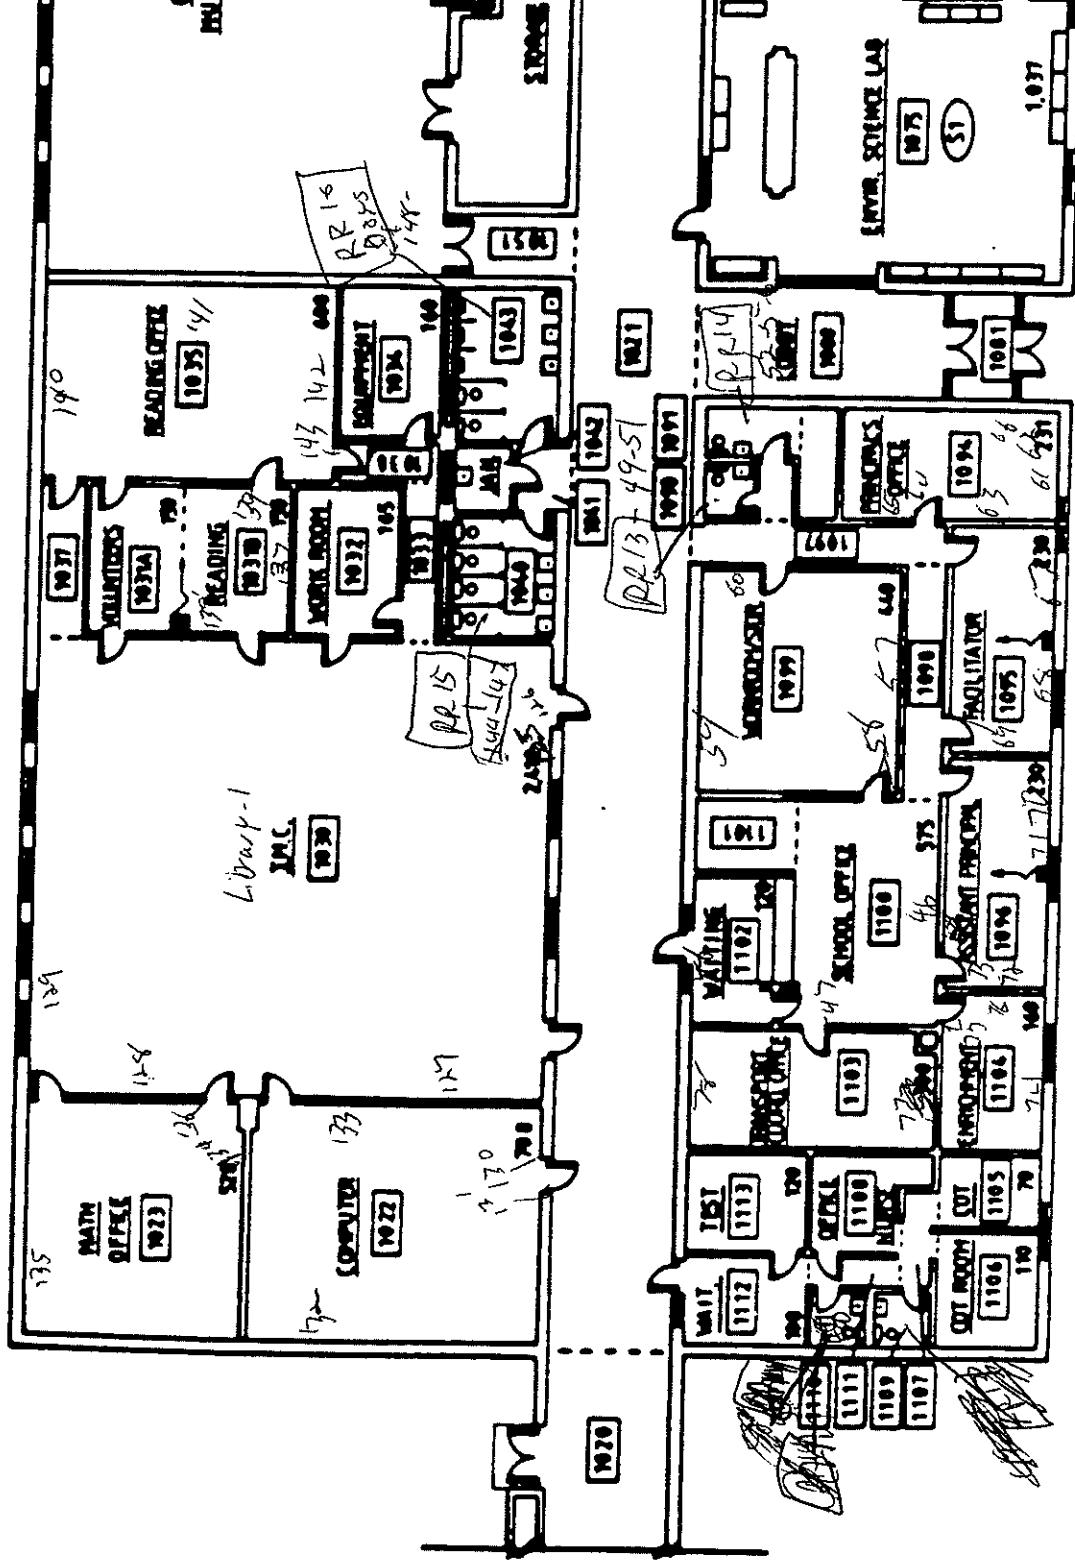


1st Floor
New Edition

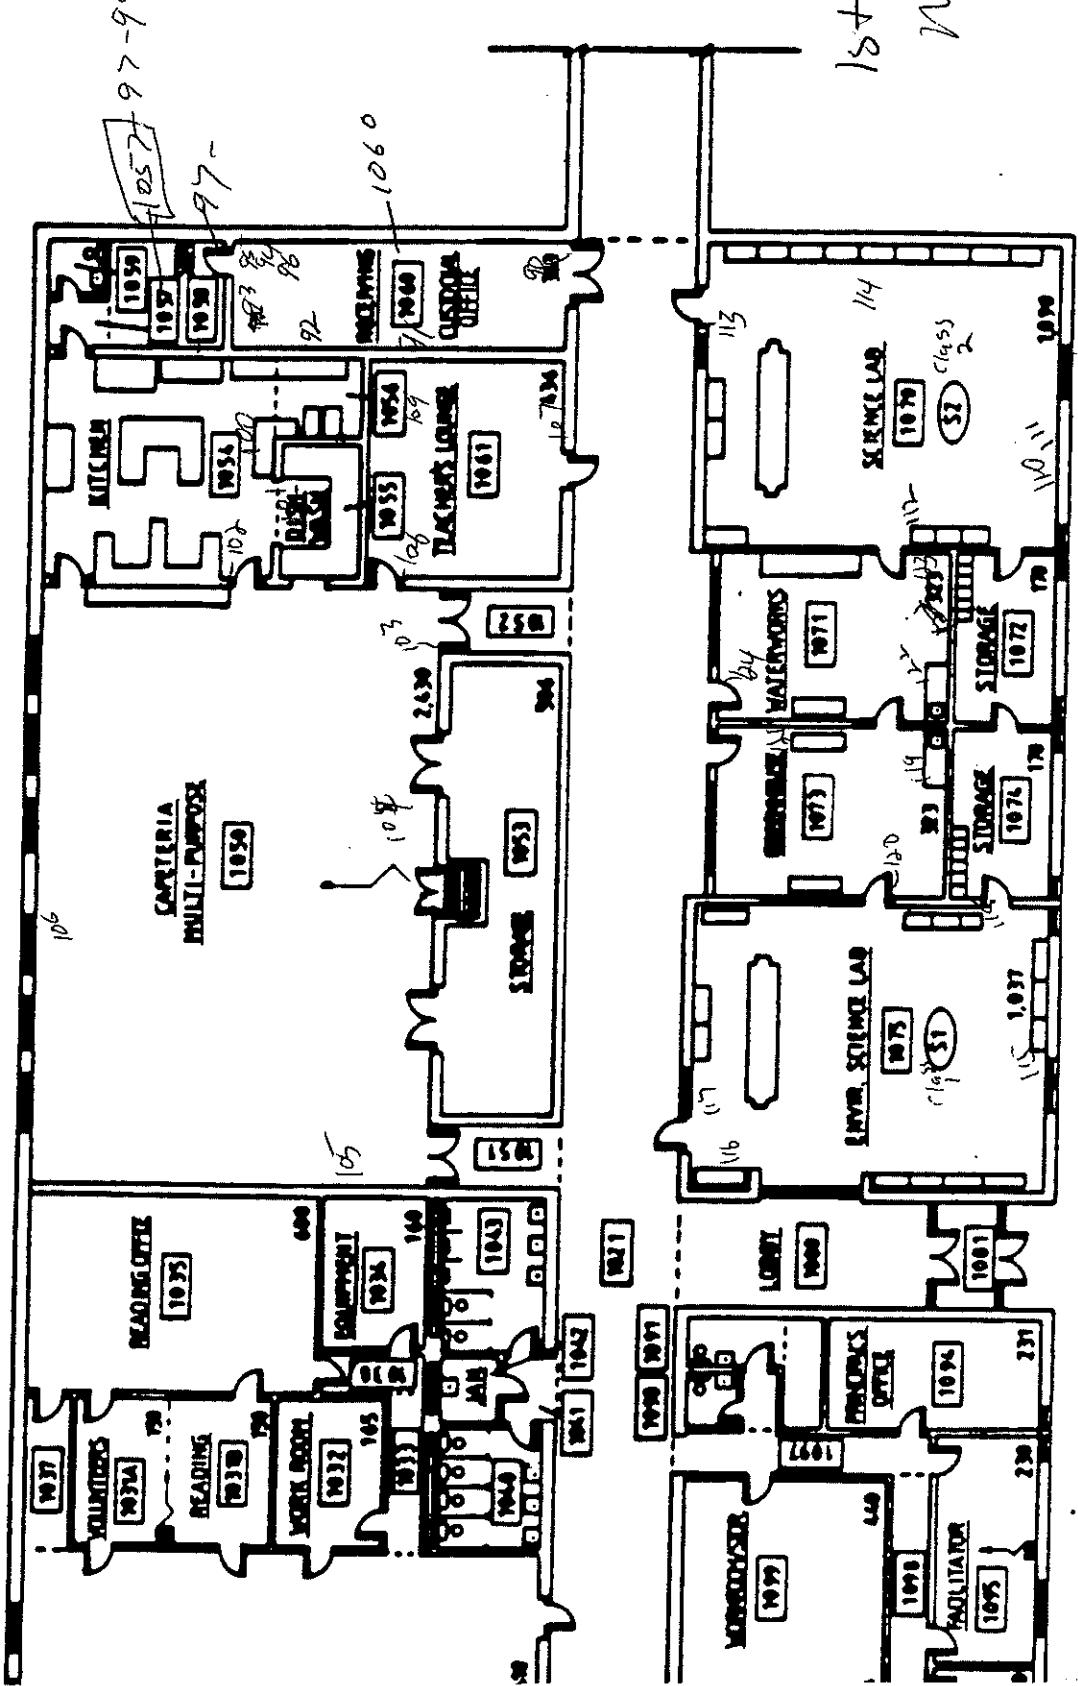


1st Floor west
Site 2
C = Ceiling



$$C = \text{Ceiling}$$

2

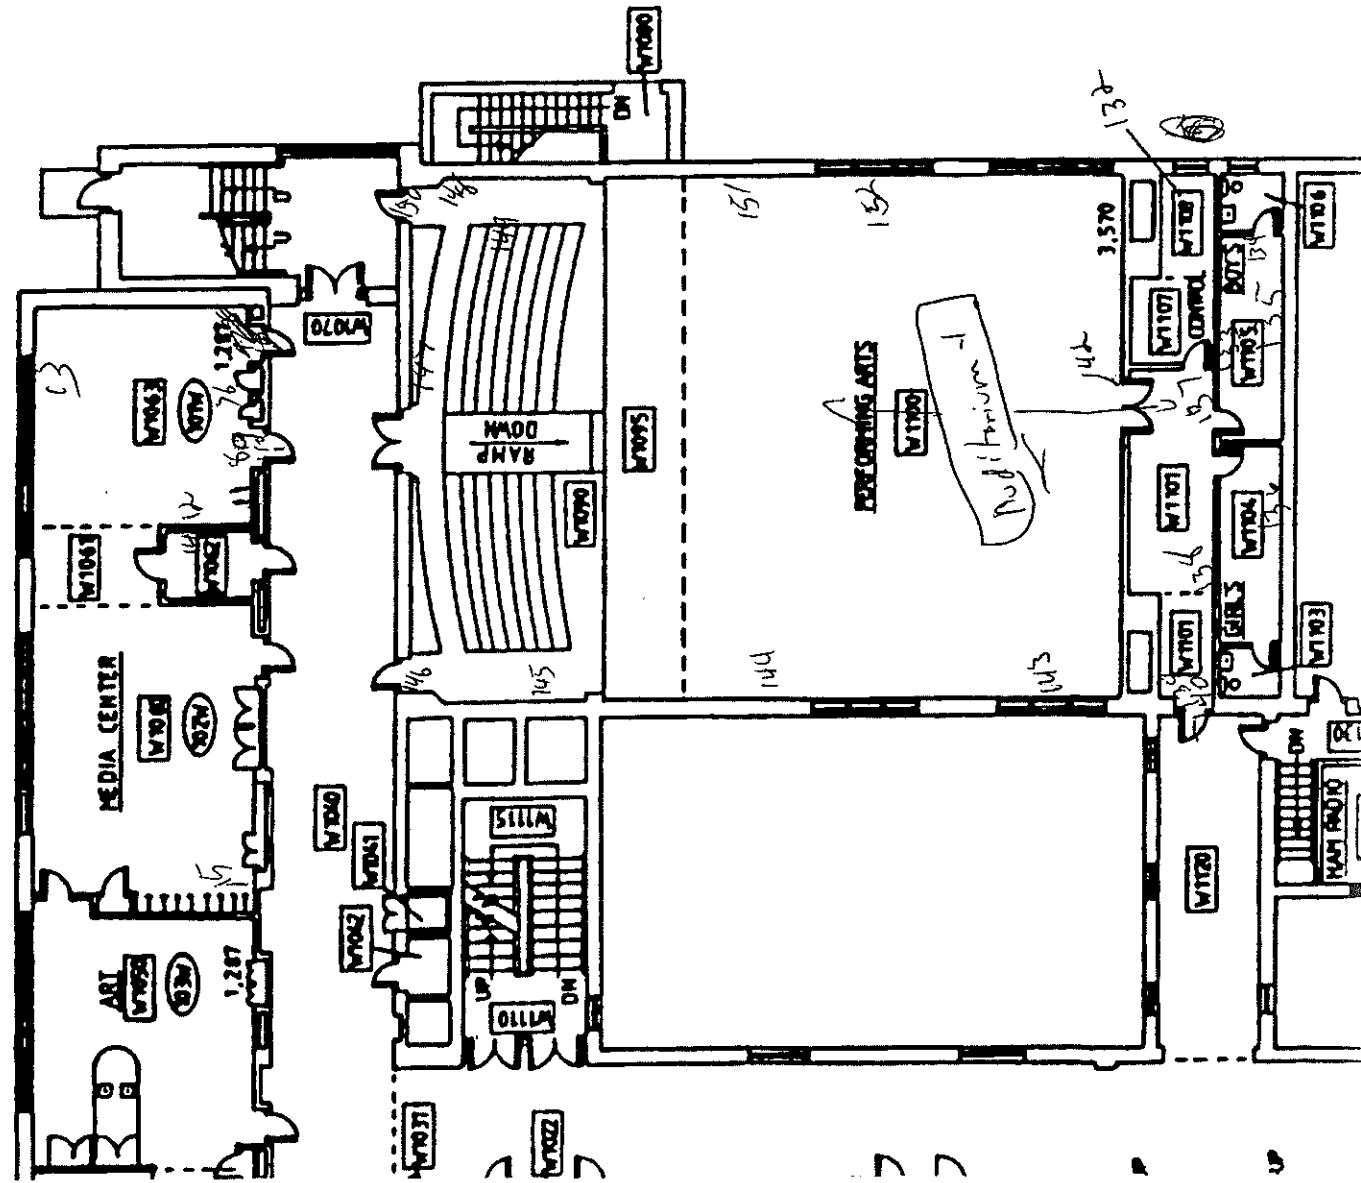

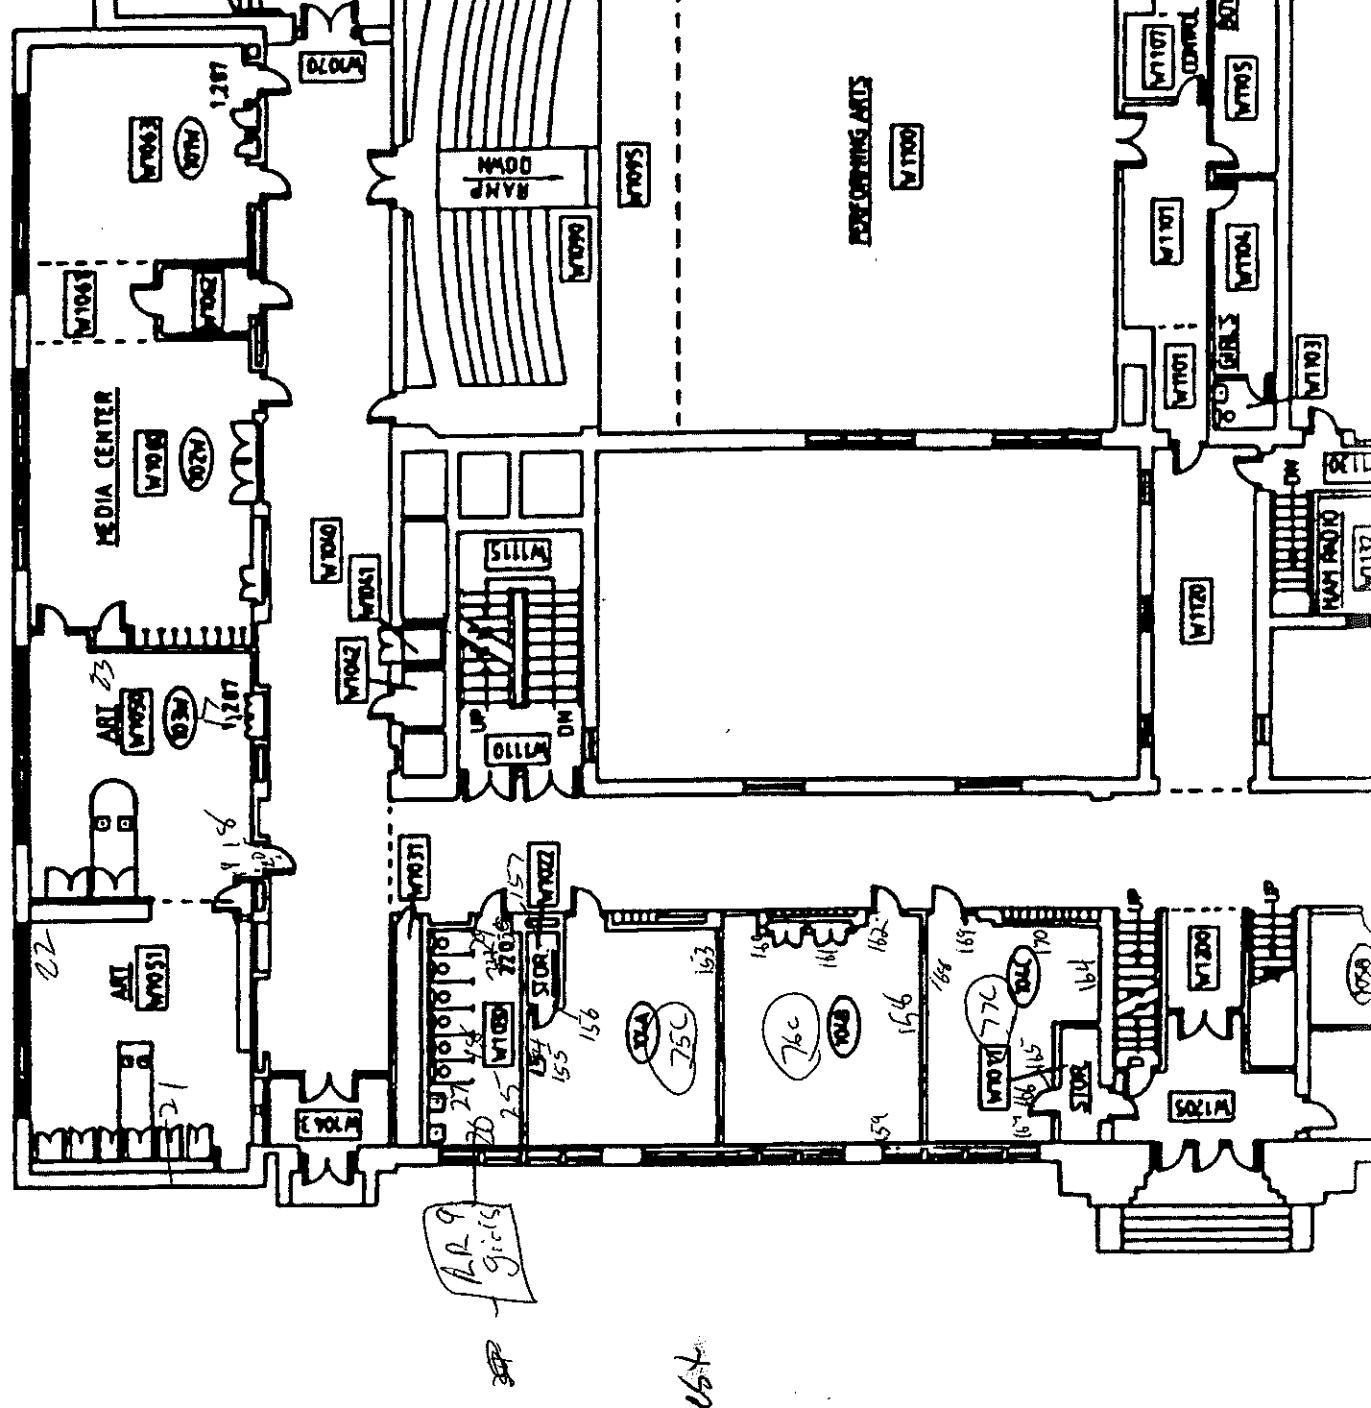

First Floor West
Site 2
C = ceiling

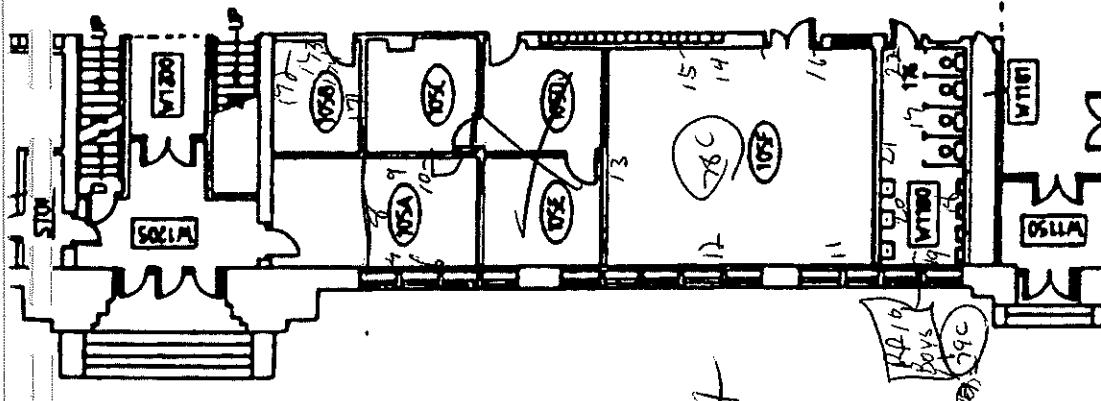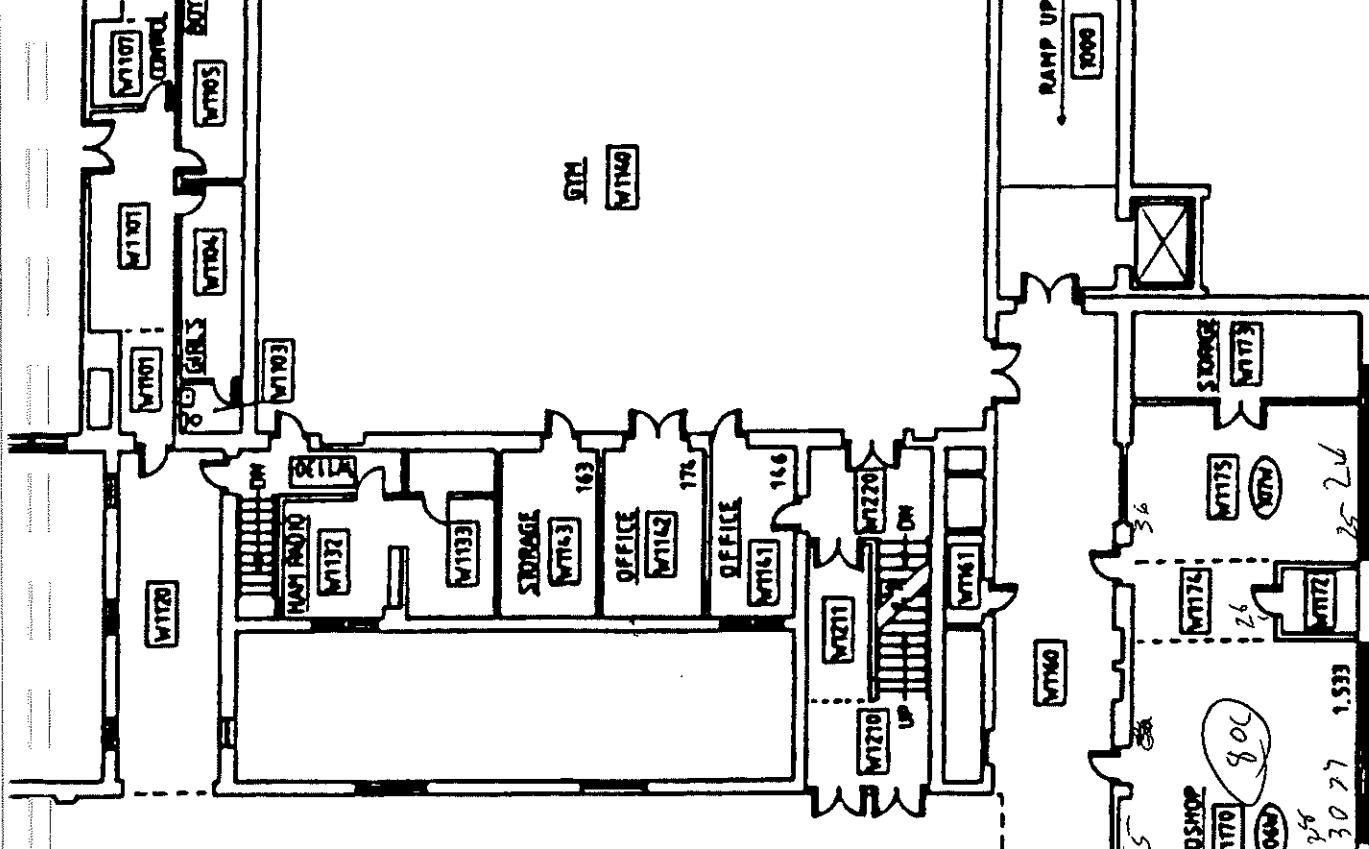



154 *Flossie West*

Site 2
C = ceiling

FIRST

1st Floor West
Side 2
C = ceiling

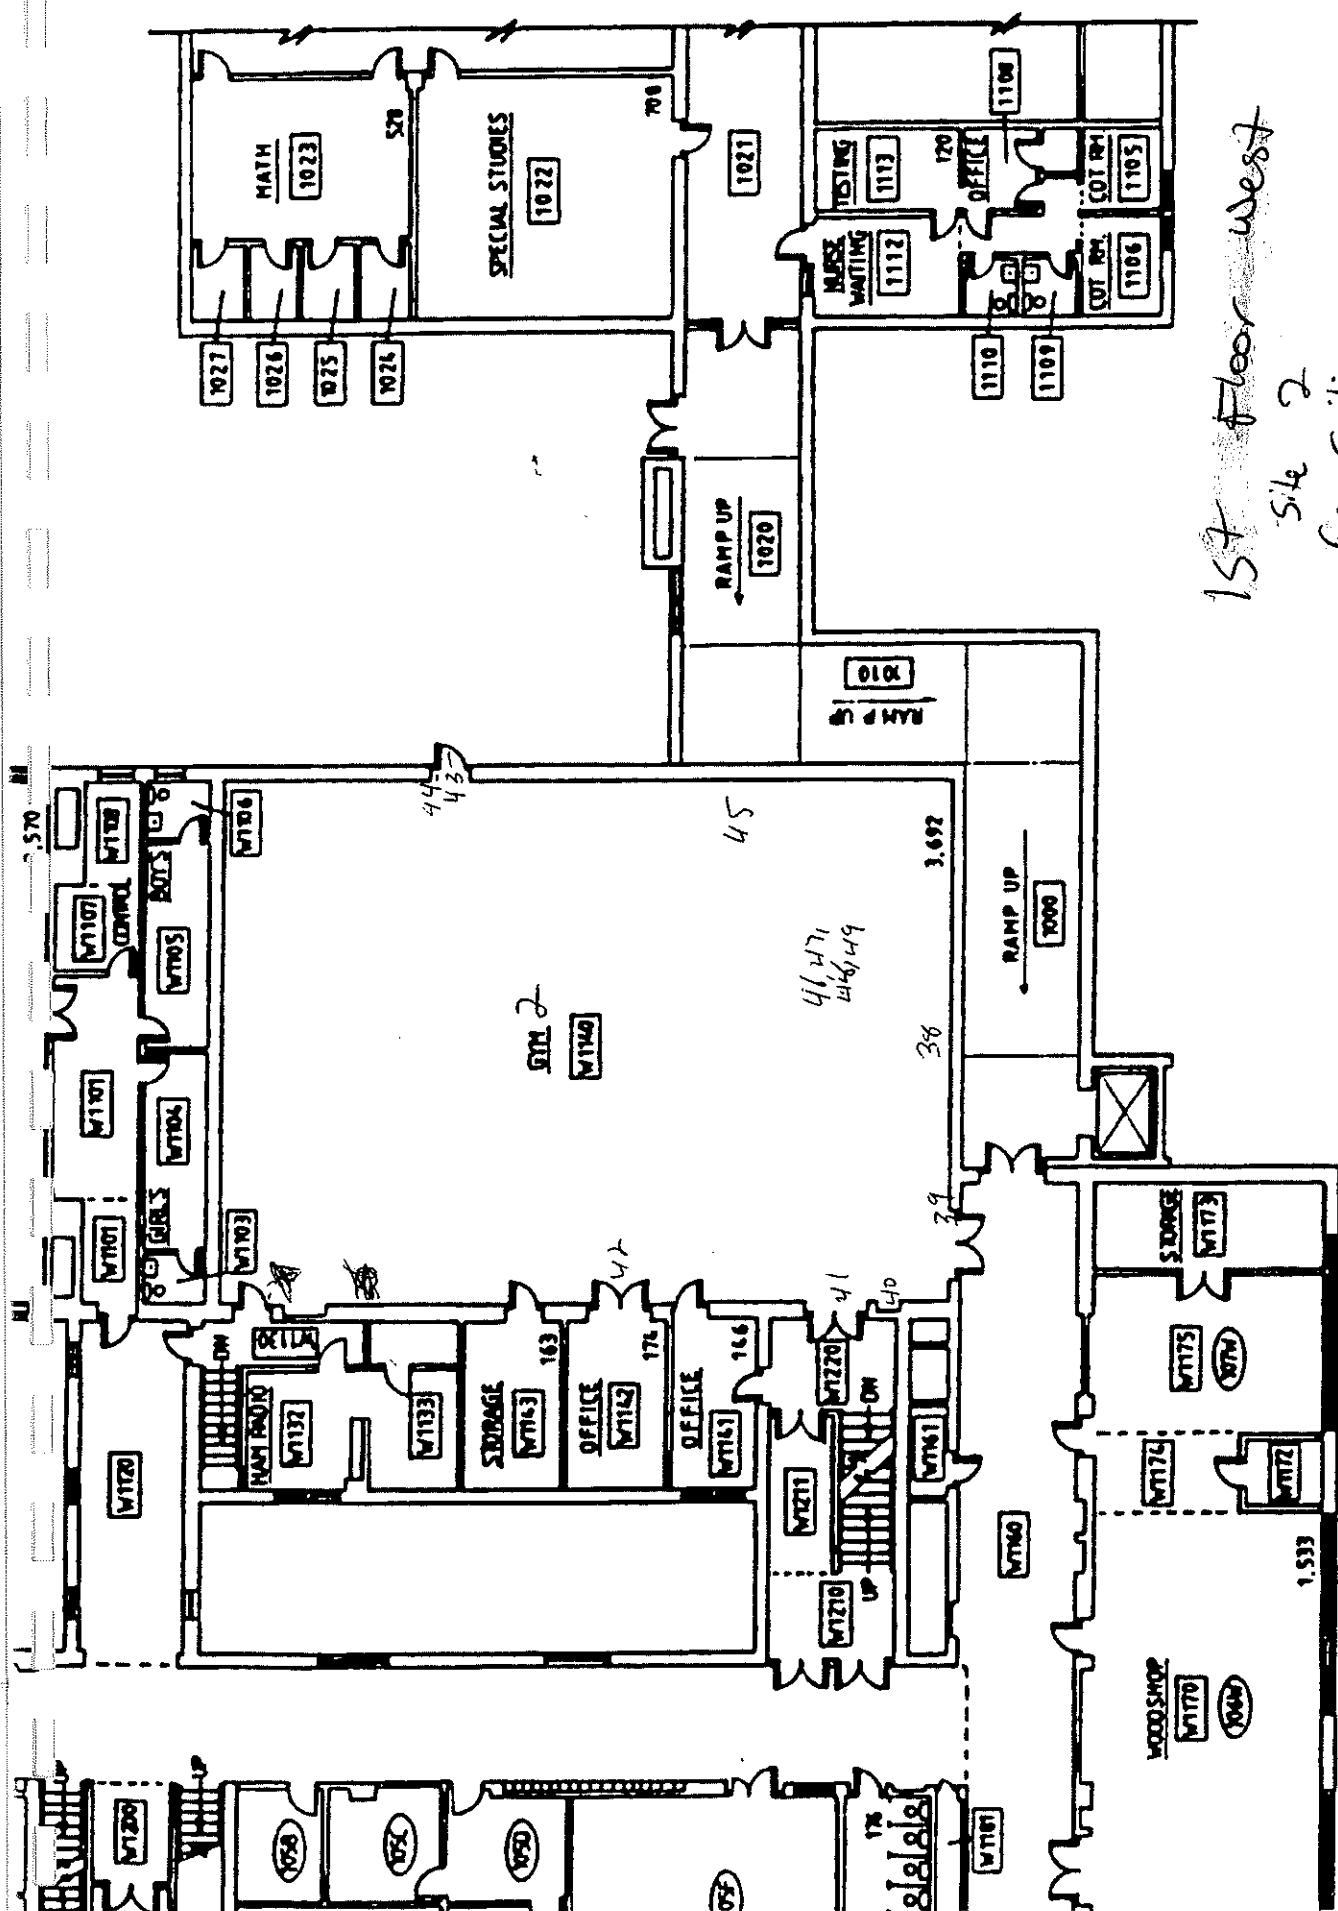

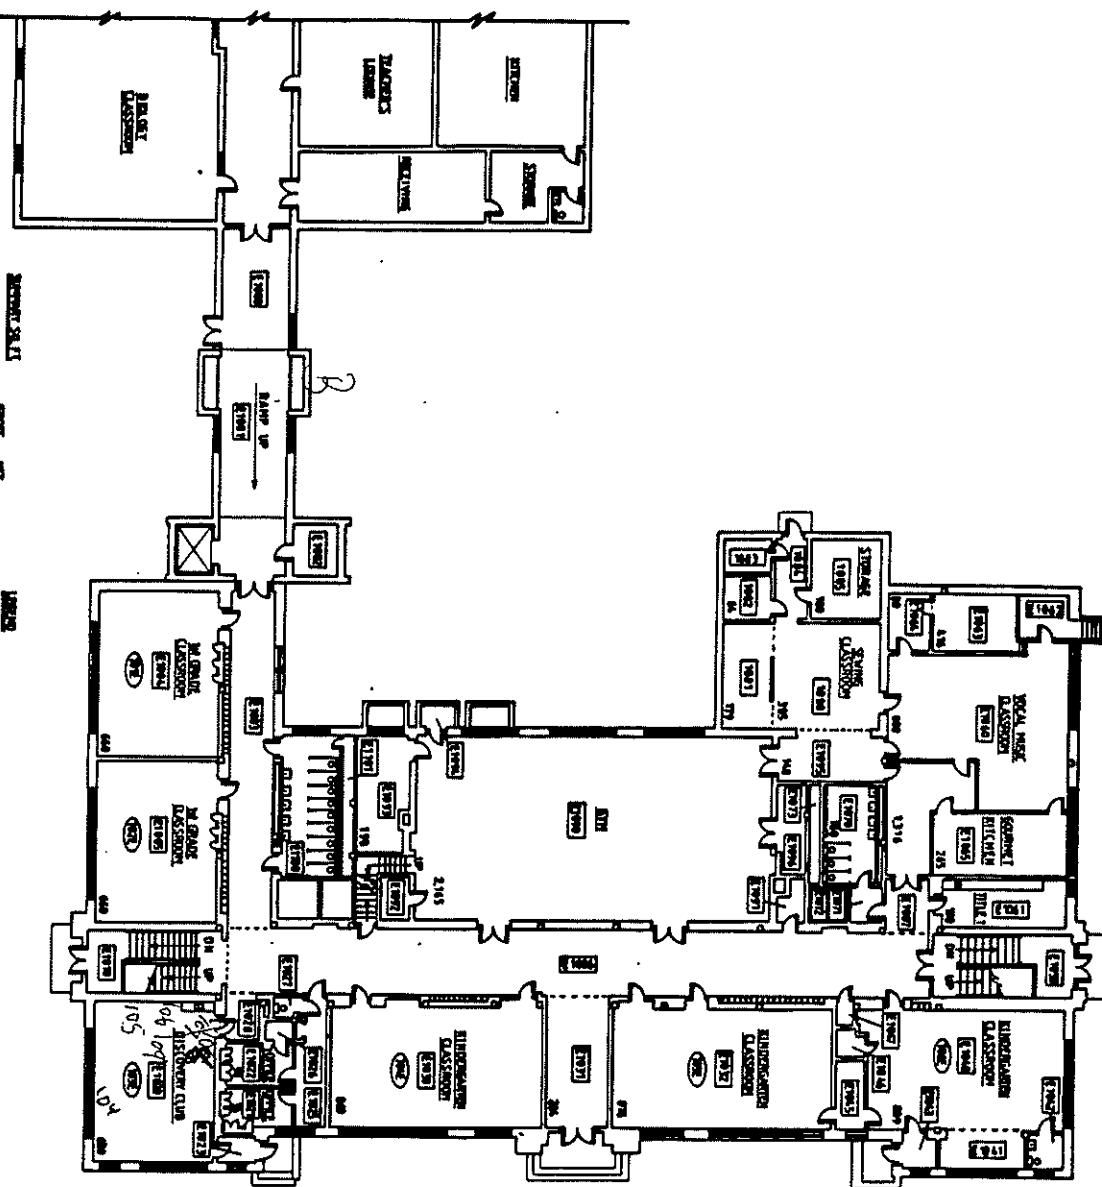

BASMENT
FIRST FLOOR
SECOND FLOOR
THIRD FLOOR
FOURTH FLOOR

NET	NET
7,459	7,459
9,494	9,494
3,697	3,697
3,611	3,611
34,647	34,647
21,195	21,195

153 — INDICATES APTH. ROOM NUMBER
153 — INDICATES CLASSROOM NUMBER
795 — INDICATES ROOM #2. PORTAL.

FIRST FLOOR EAST




INDEPENDENT SCHOOL DIST. #625
360 COLBORNE STREET
ST. PAUL, MINNESOTA 55102

**WEBSTER MAGNET
ST. ALBANS ST. & ASHLAND AVE.
ST. PAUL, MN**

CONSTRUCTED: 1925, 26, 75

10

12

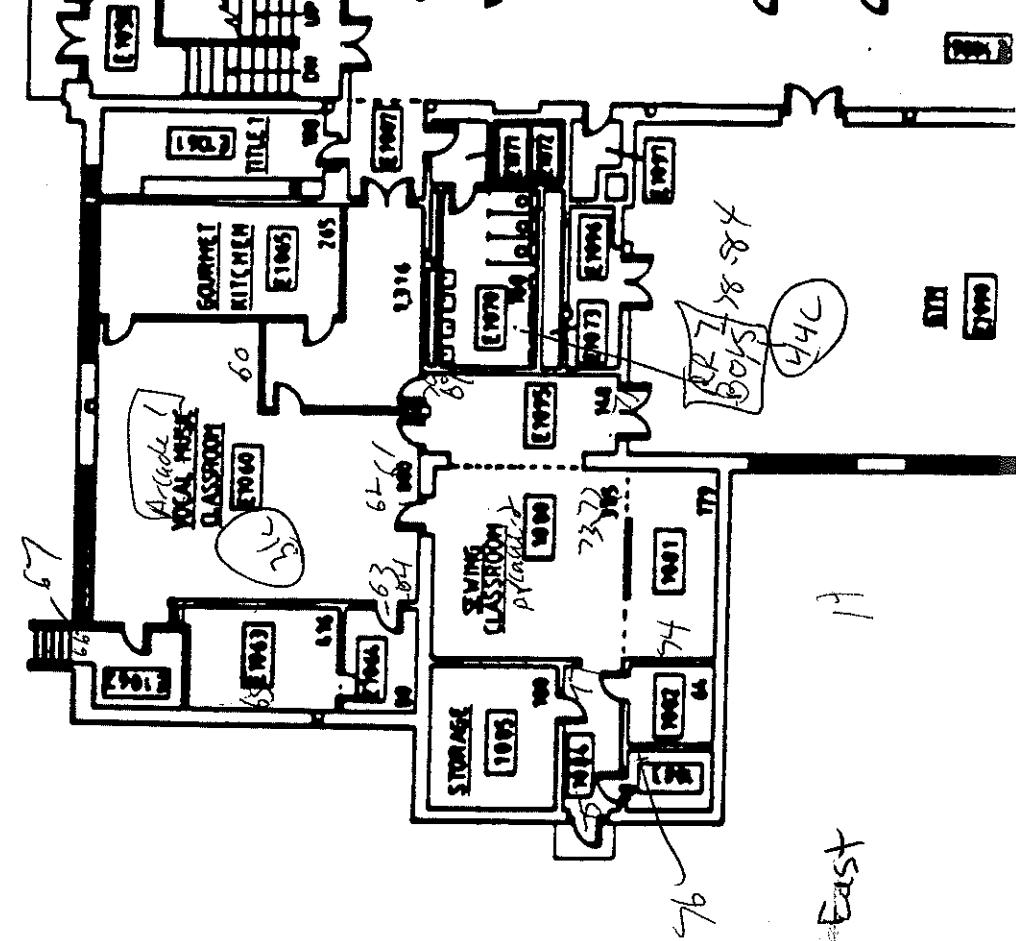

Sile


正月十五日

$$C = \text{ceil}(n)$$

卷之三

卷之三

S. 114

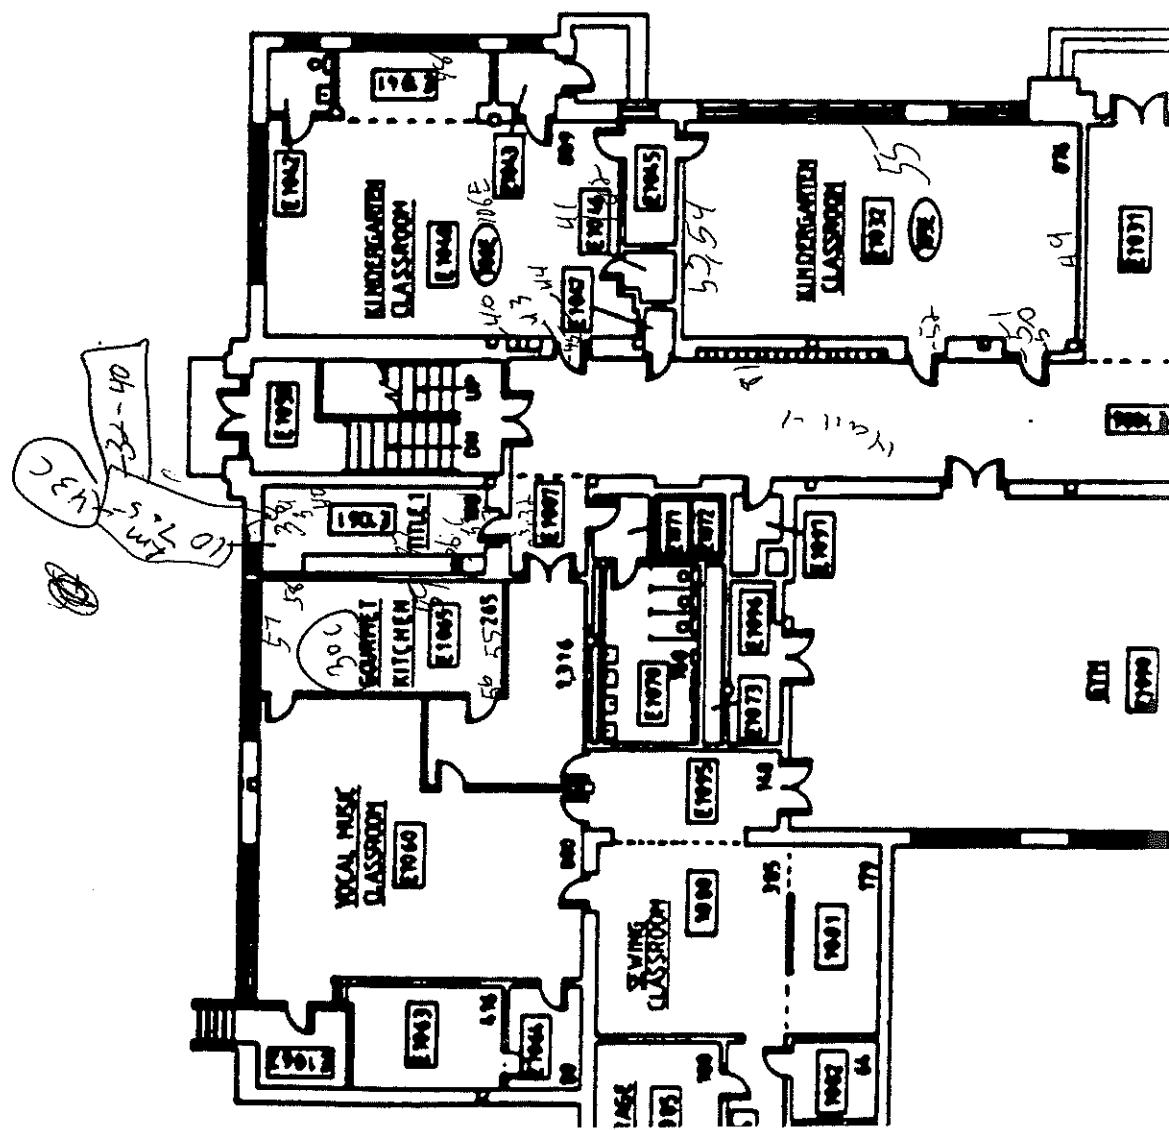


FIRST FLOOR EAST


C = Corridors

Side 1

- 1007** — INDICATES ARCH. ROOM NUMBER
- 1135** — INDICATES CLASSROOM NUMBER
- 105** — INDICATES ROOM #. PORTAGE

EX
1005
1007
104
104

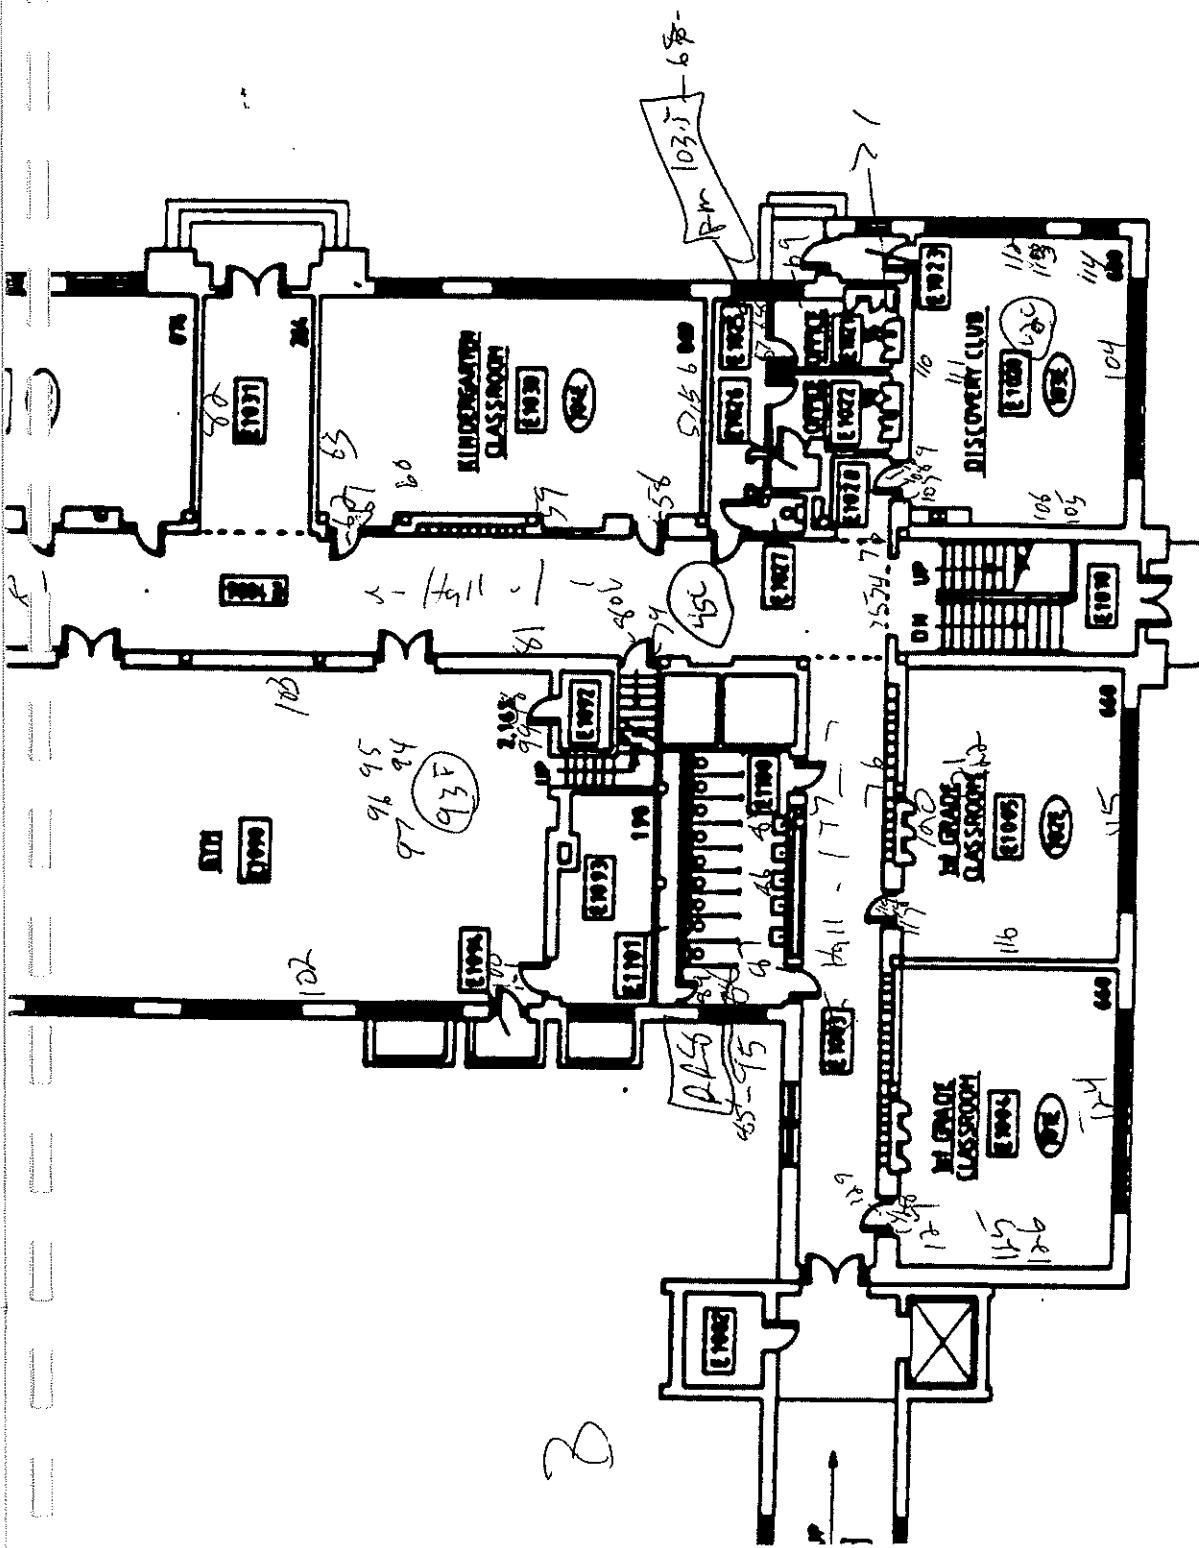

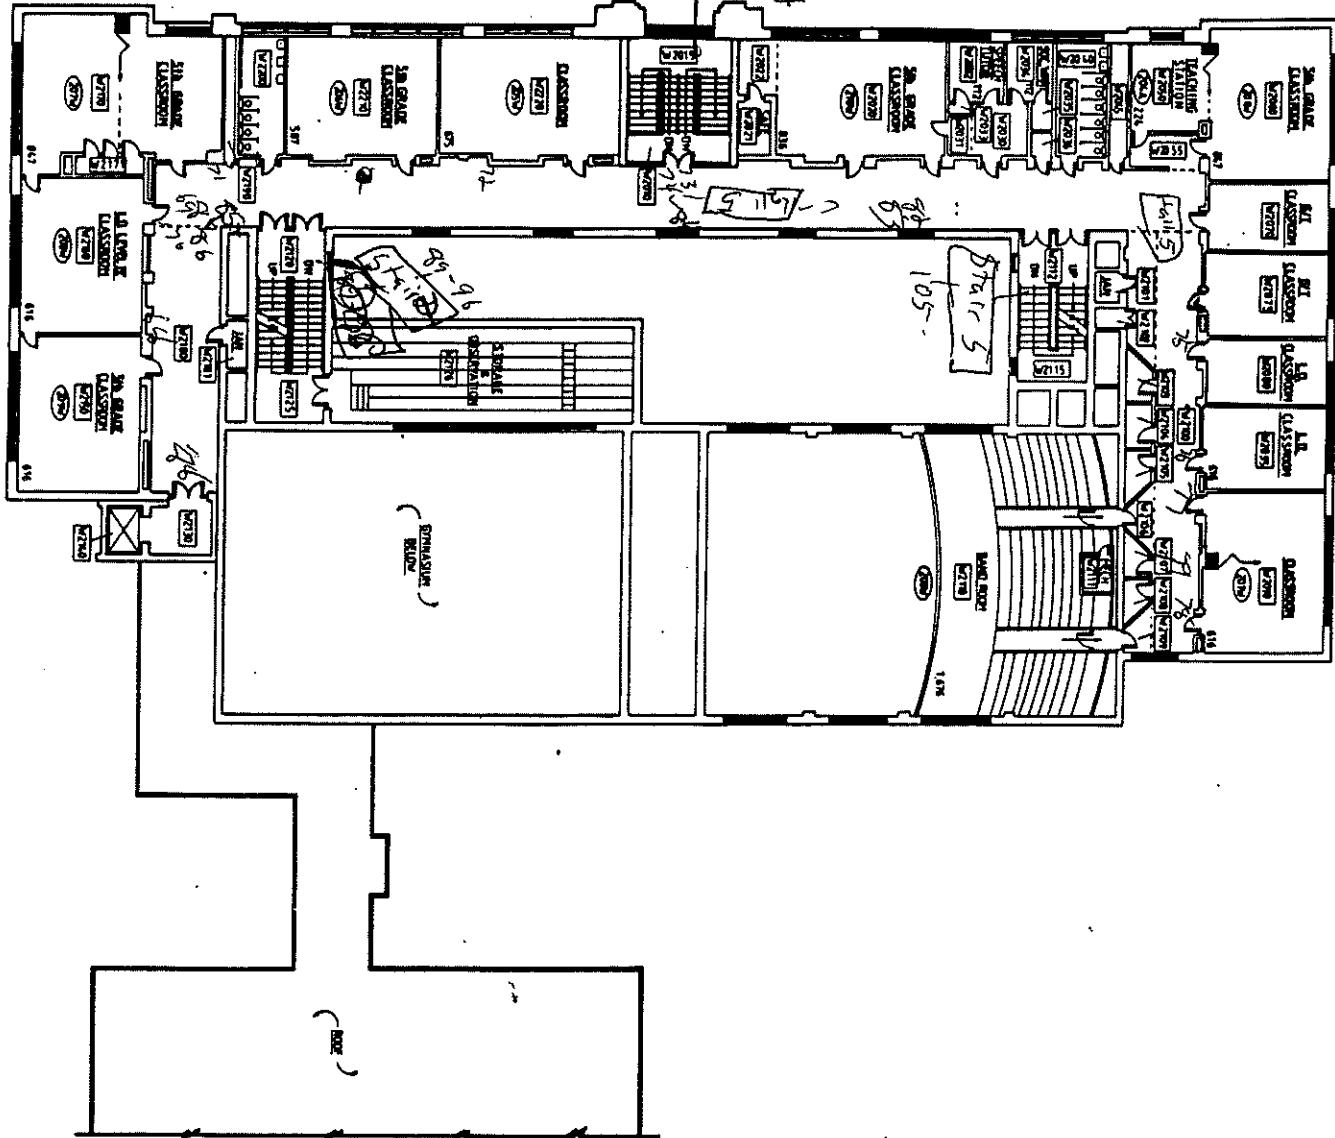

SECOND FLOOR PLAN - WEST


۲۰۷


INDEPENDENT SCHOOL DIST. • 625
360 COLBORNE STREET
ST. PAUL, MINNESOTA 55102

WEBSTER MAGNET
ST. ALBANS ST. & ASHLAND AVE.
ST. PAUL, MN


CONSTRUCTED: 1925, 26, 75


12

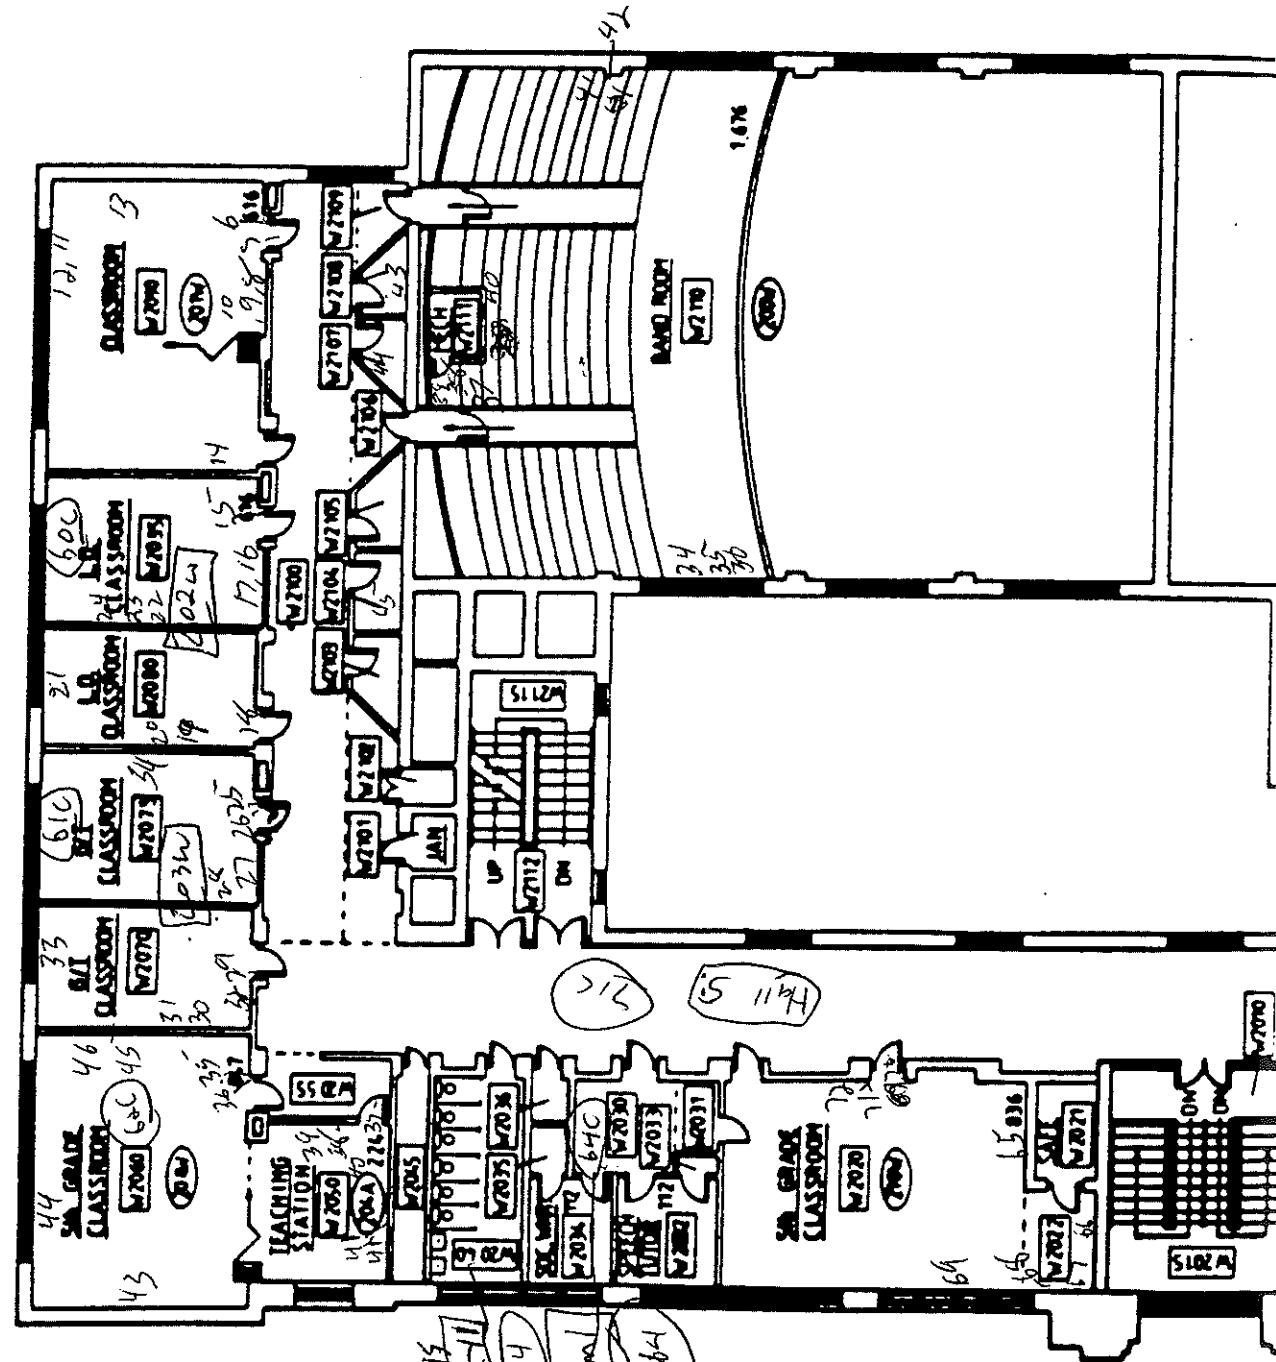


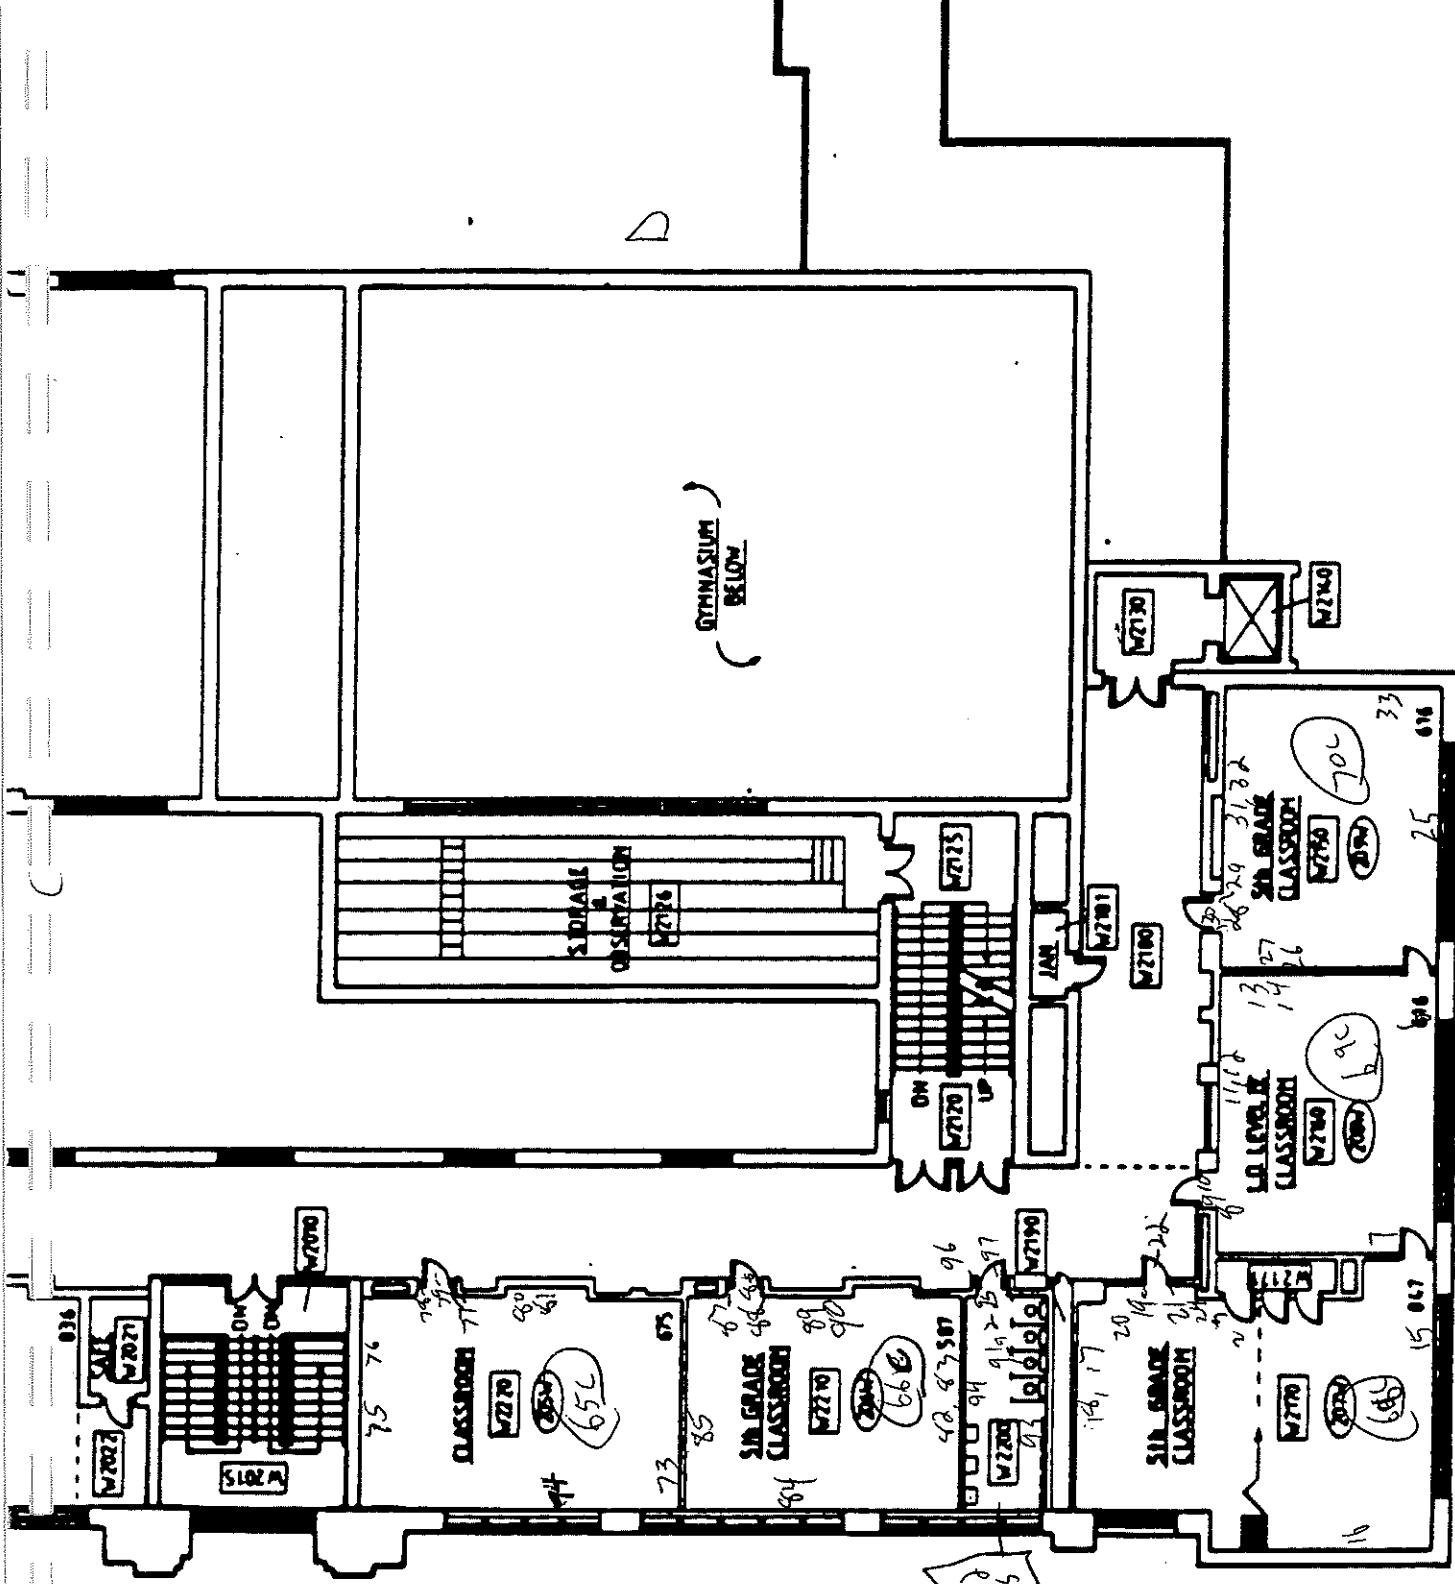



2nd Floor West Site 2 C = ceiling B

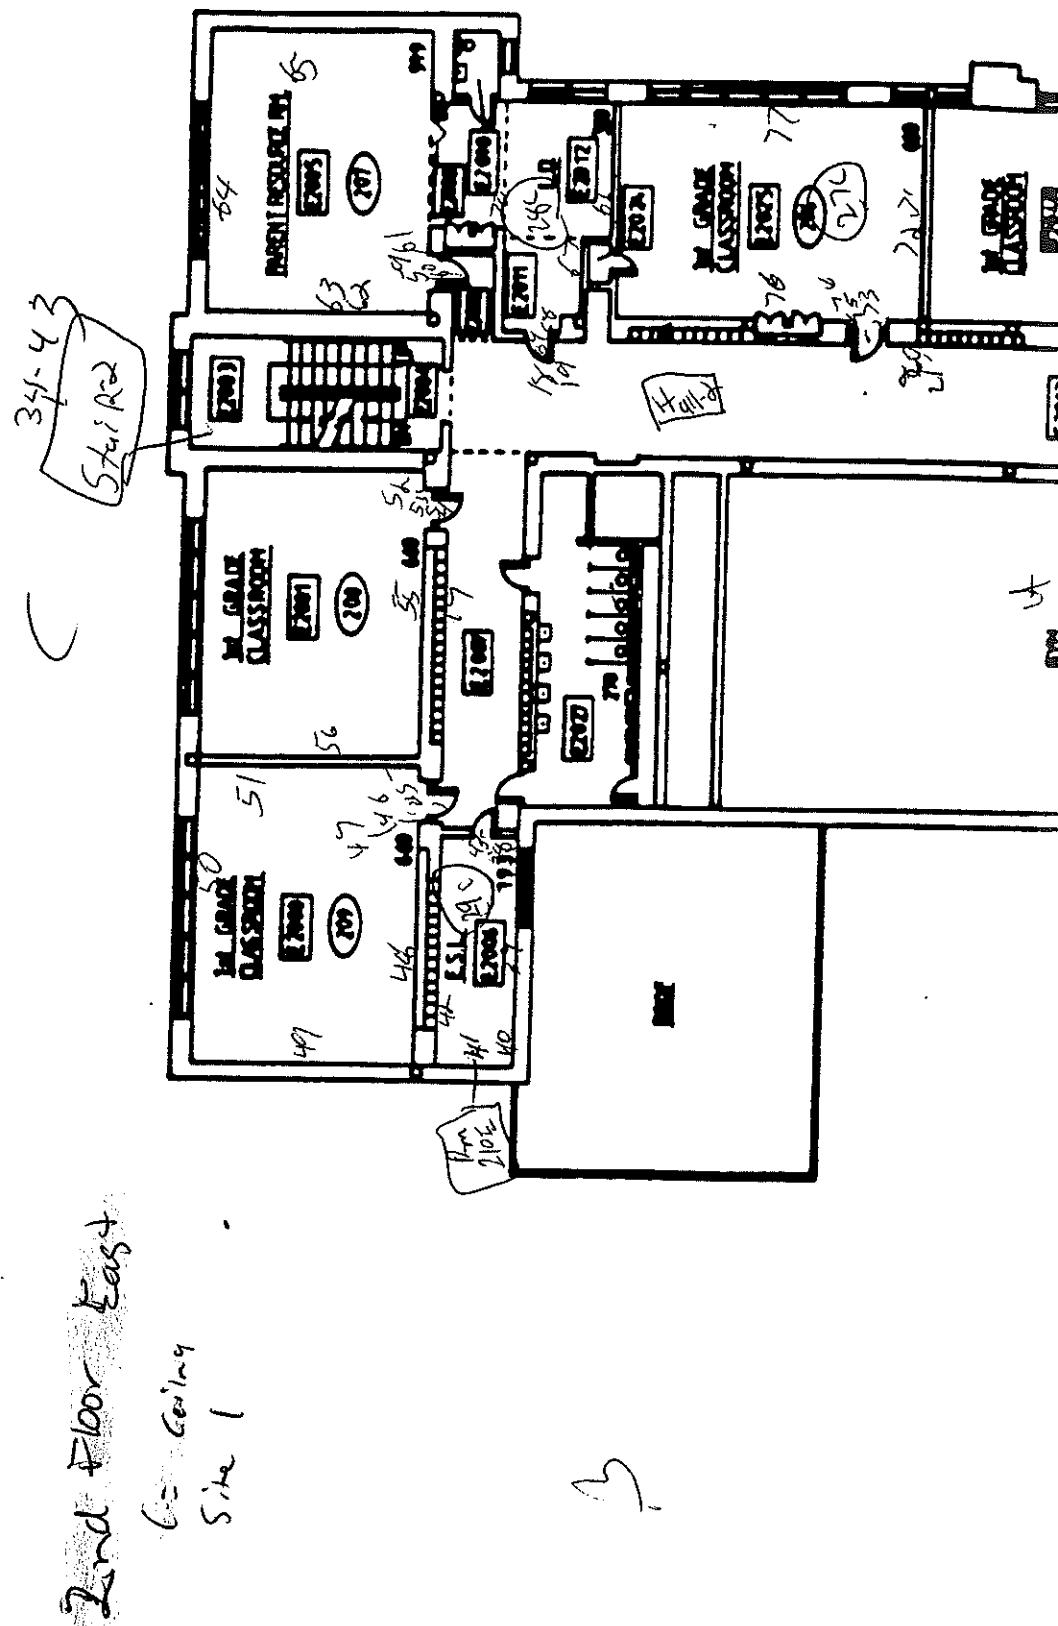

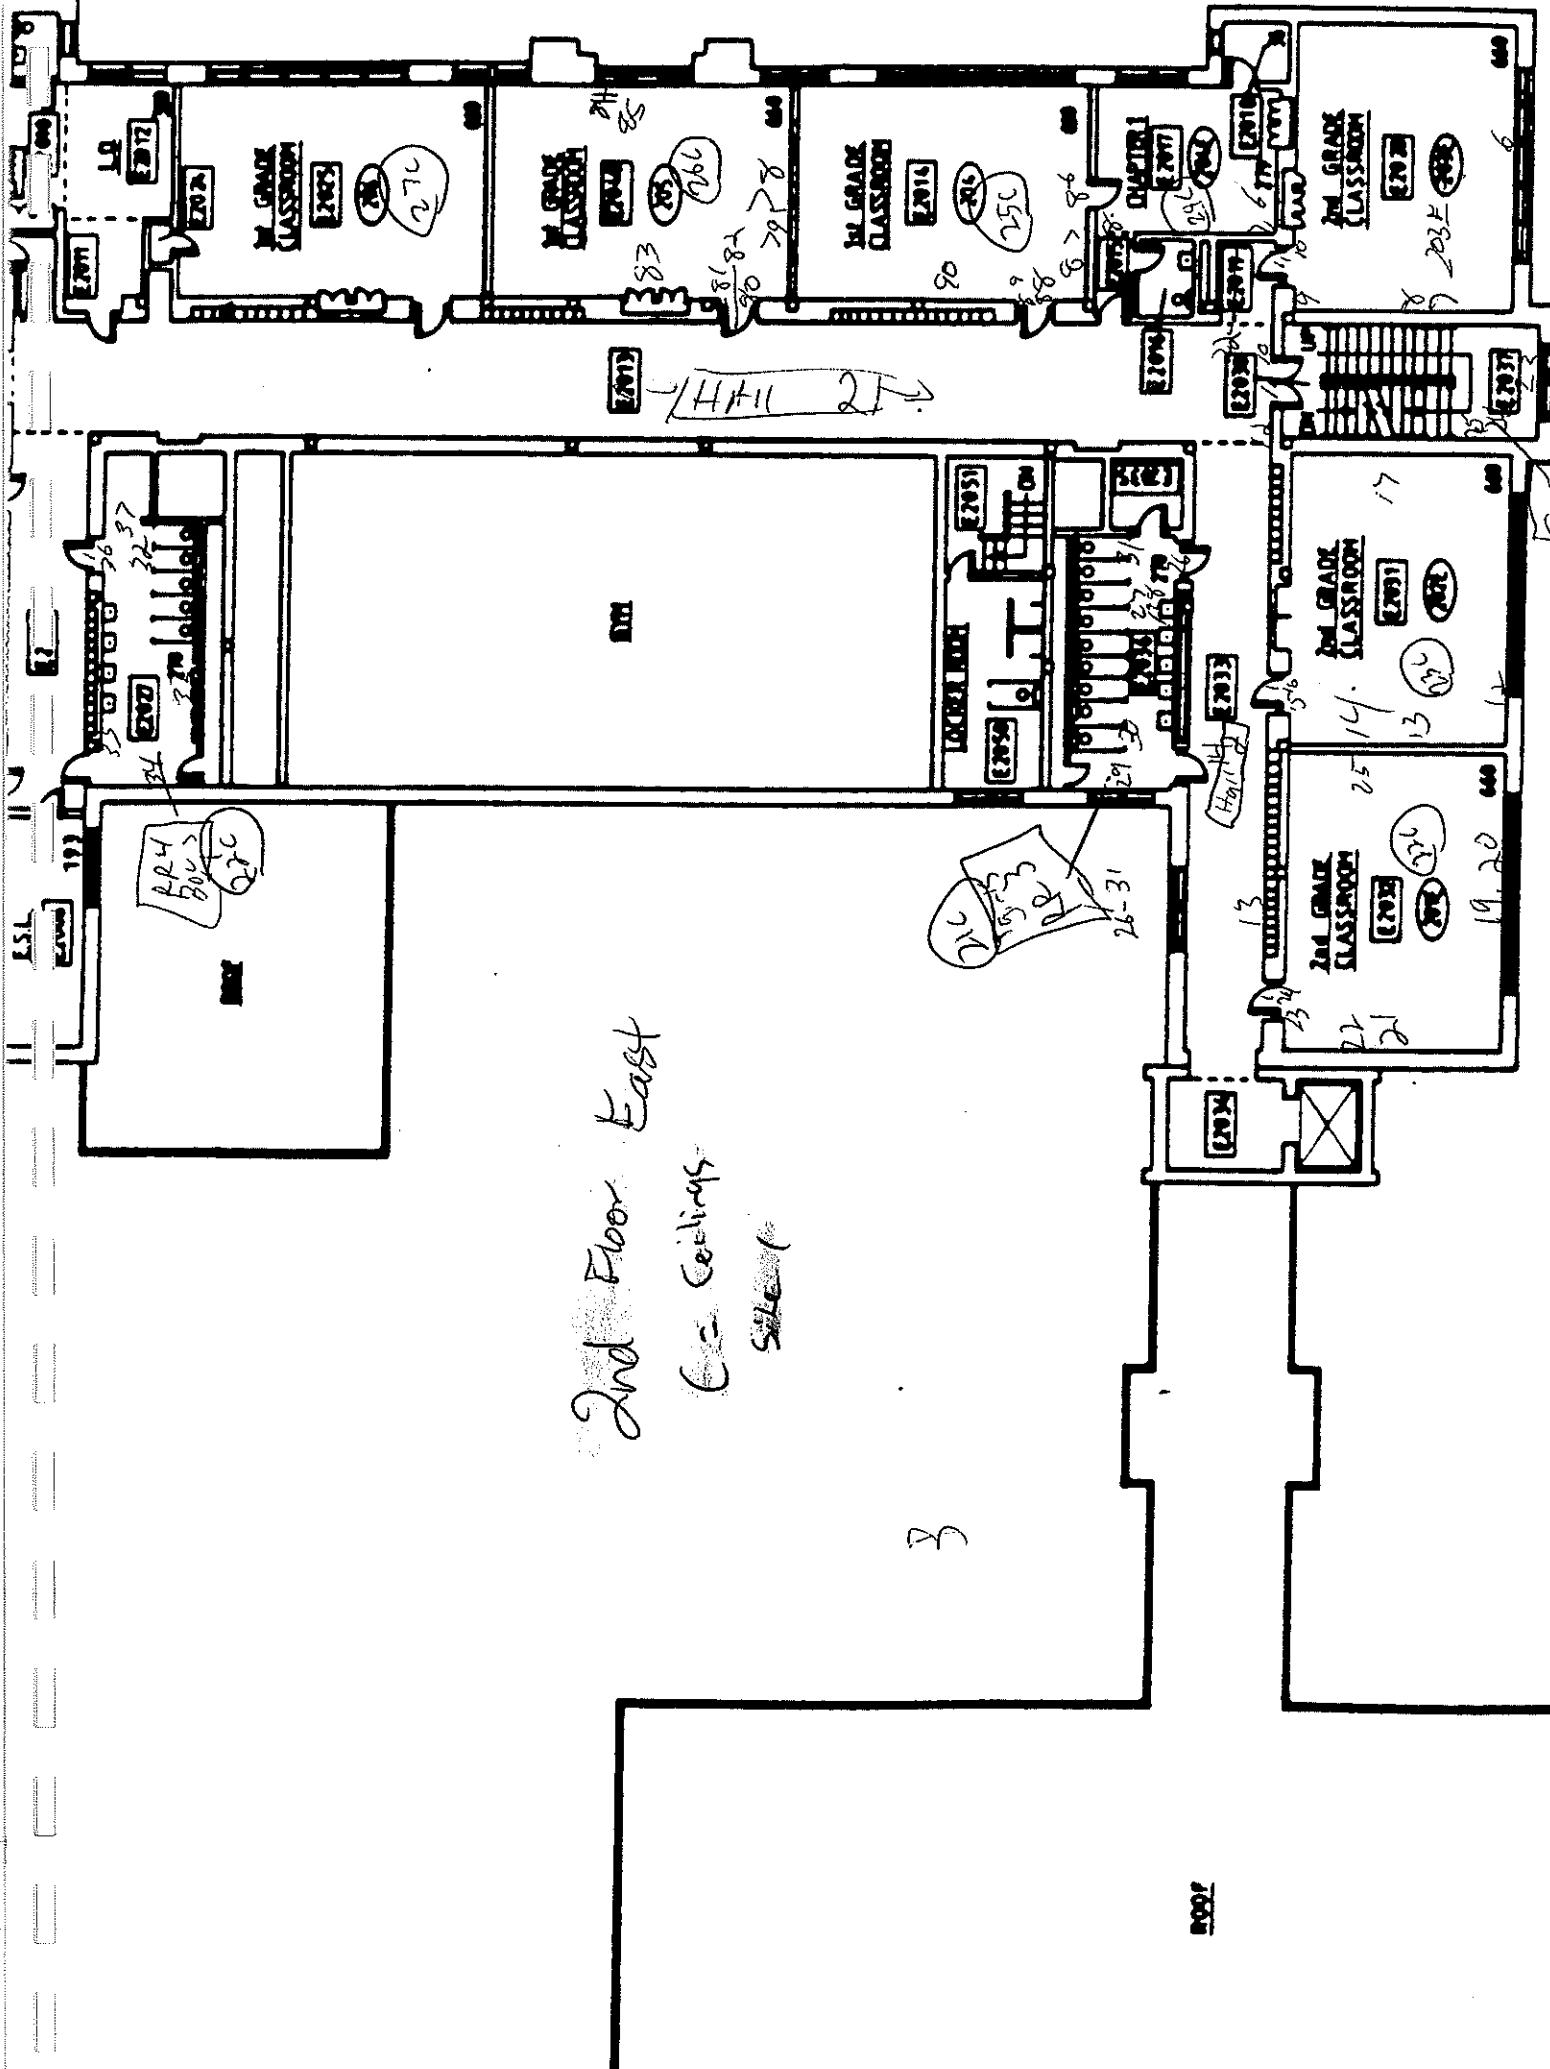

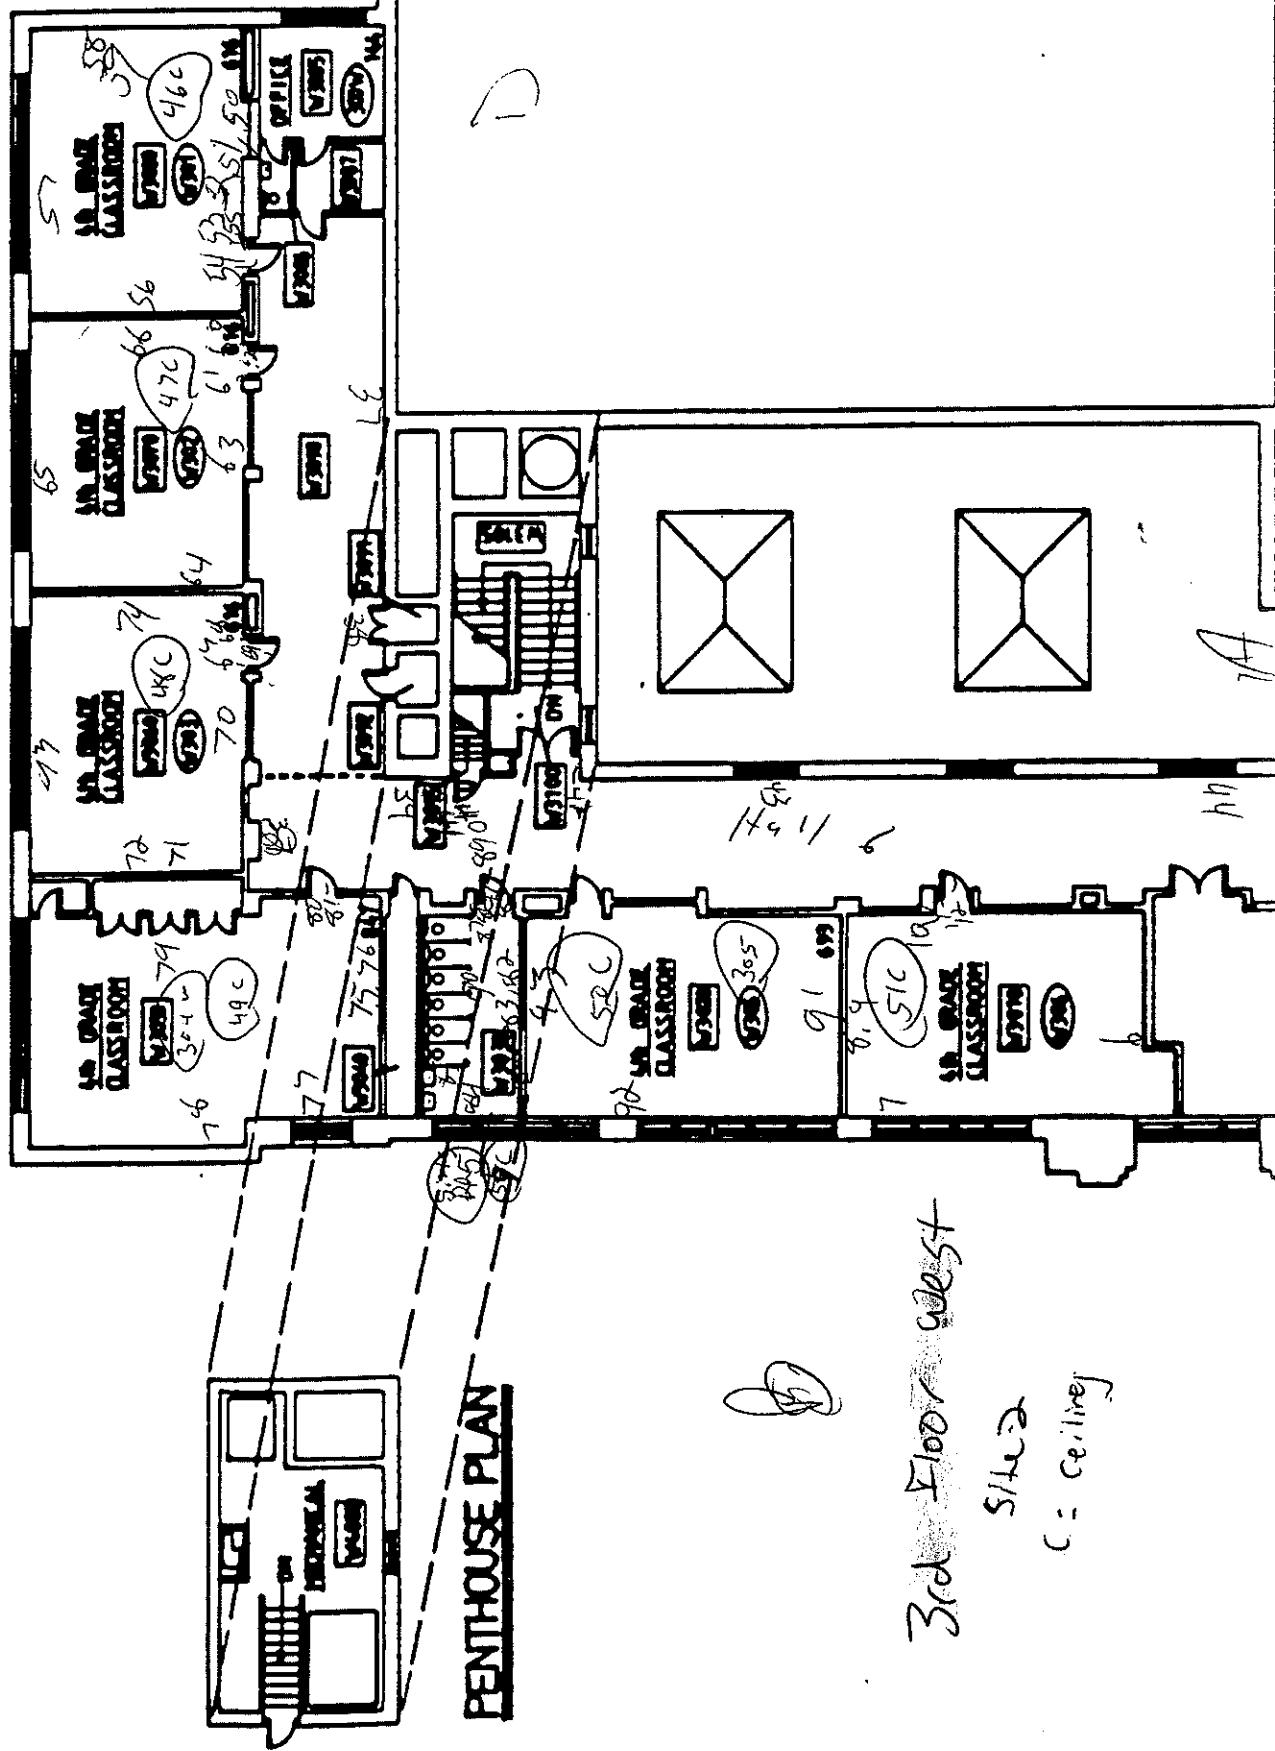

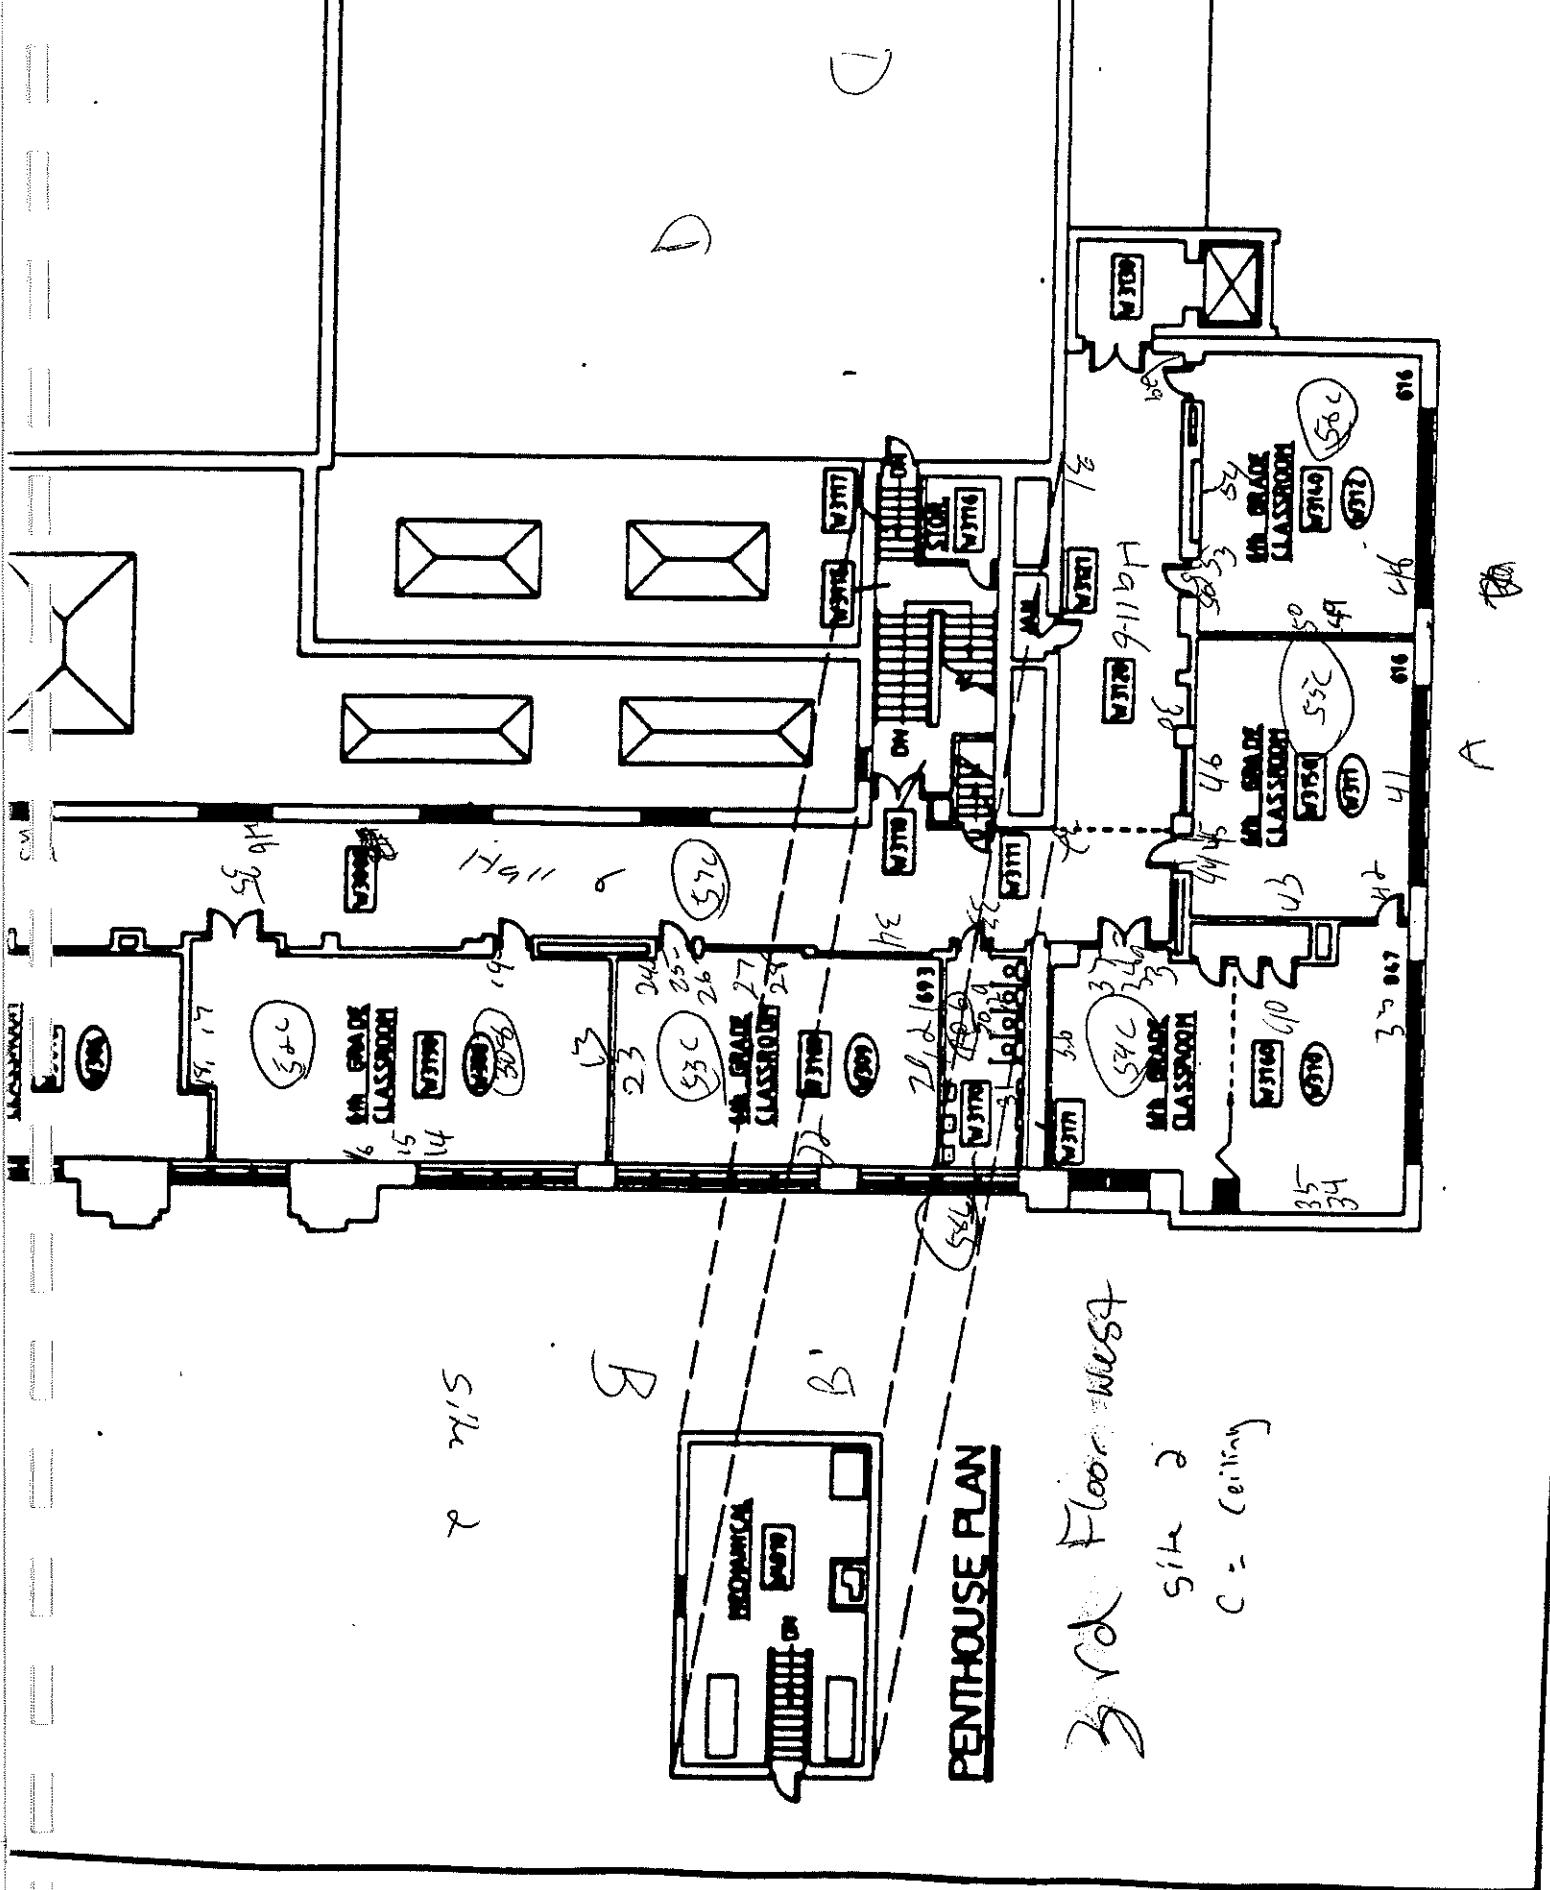

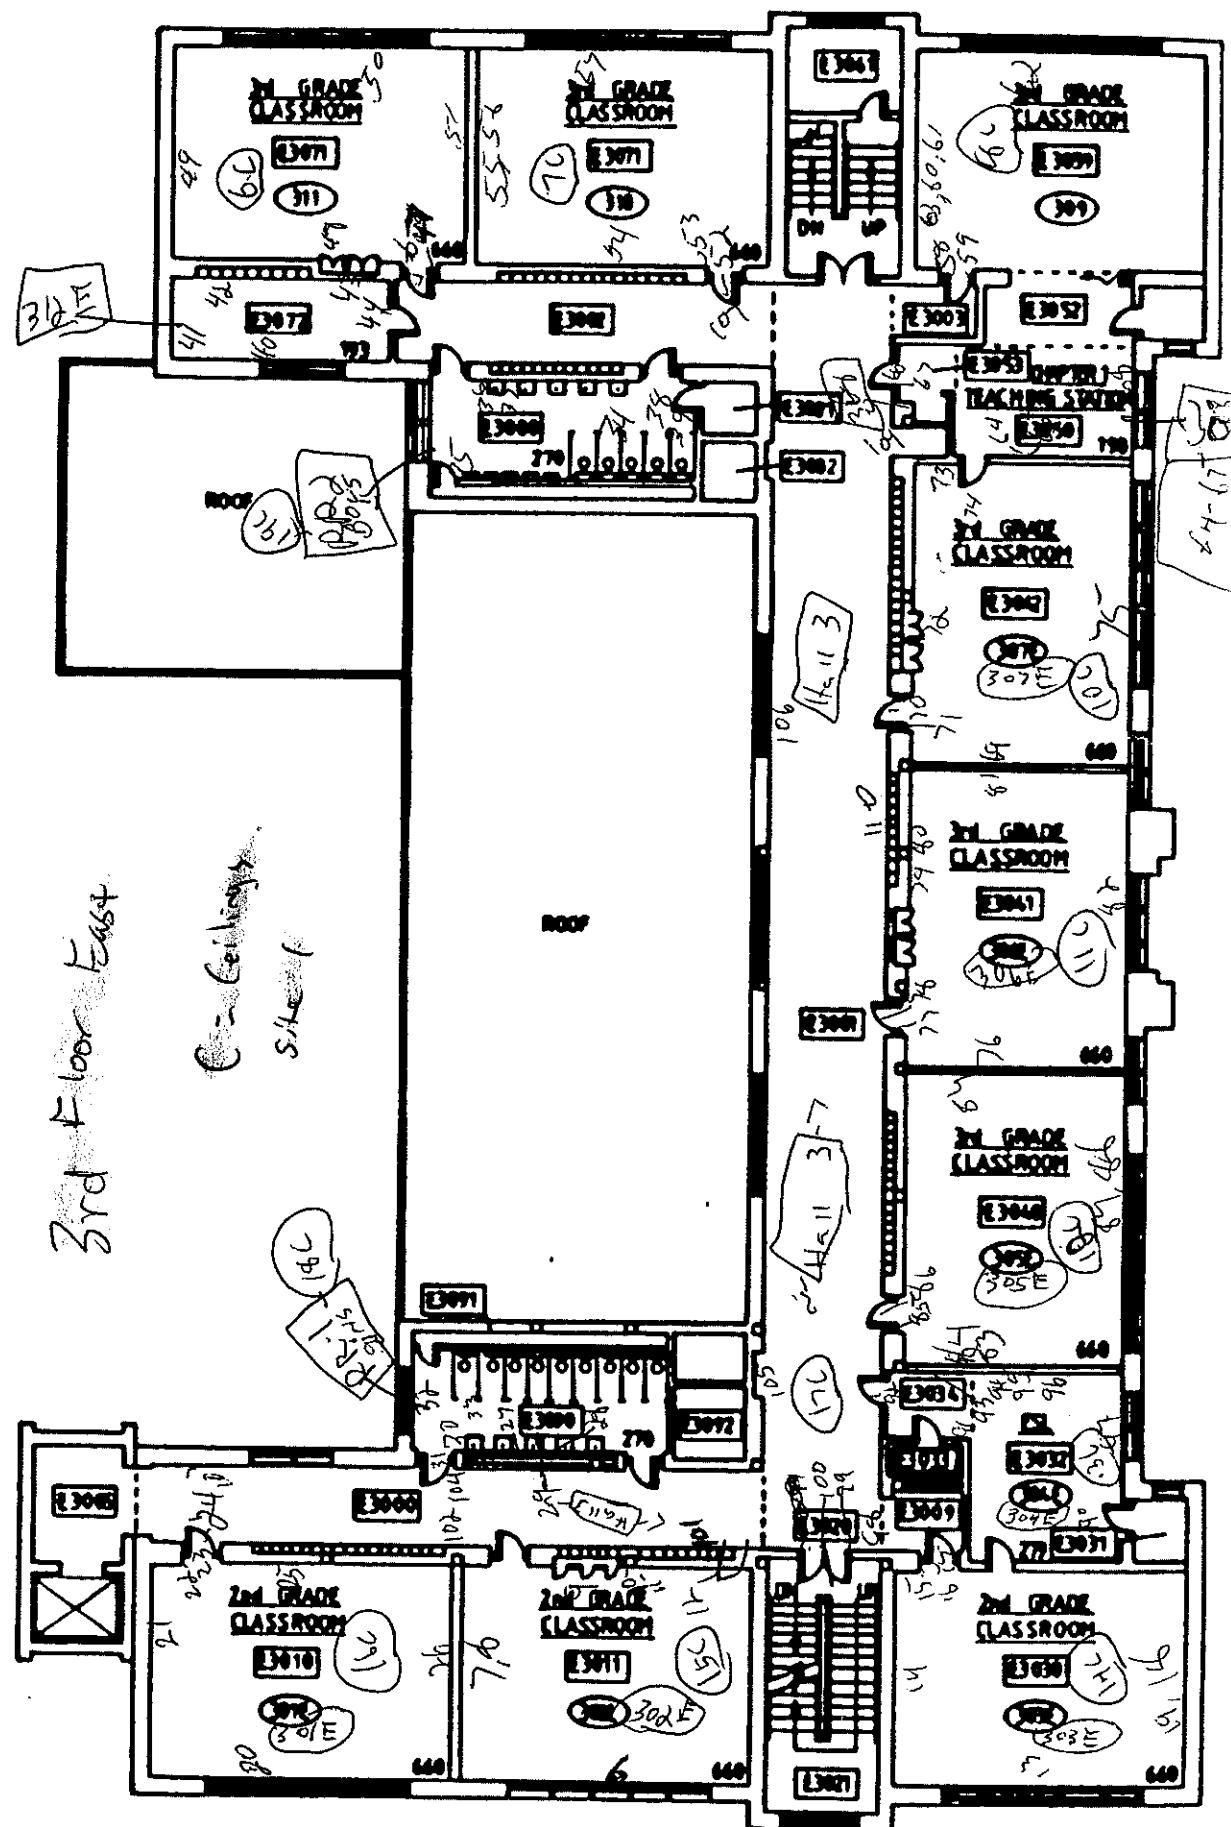

Saint Paul Public Schools
 Webster Enrichment School
 Lead-Based Paint Inspection

	A	B	C	D	E	F	G	H	I	J
1	Webster Enrichment School									
2										
3	Site	Sample#	Analysis	Date	Floor	Area	Component	Condition	Substrate	Result
4	1925 Bldg.	65	XRF	12/11/97	1	Arcade-1E	Bookcase	Solid	Wood	0.76
5	1925 Bldg.	62	XRF	12/11/97	1	Arcade-1E	Door	Solid	Metal	0.03
6	1925 Bldg.	63	XRF	12/11/97	1	Arcade-1E	Door	Solid	Wood	0.03
7	1925 Bldg.	64	XRF	12/11/97	1	Arcade-1E	Door	Solid	Wood	0.03
8	1925 Bldg.	66	XRF	12/11/97	1	Arcade-1E	Door	Peeling	Wood	0
9	1925 Bldg.	67	XRF	12/11/97	1	Arcade-1E	Door	Solid	Wood	1.03
10	1925 Bldg.	60	XRF	12/11/97	1	Arcade-1E	Wall	Solid	Drywall	0
11	1925 Bldg.	61	XRF	12/11/97	1	Arcade-1E	Wall	Solid	Plaster	4.4
12	1925 Bldg.	68	XRF	12/11/97	1	Arcade-1E		Peeling	Metal	>>5.0
13	1925 Bldg.	70	XRF	12/11/97	1	Arcade-2E	Door	Solid	Metal	0.06
14	1925 Bldg.	71	XRF	12/11/97	1	Arcade-2E	Door	Solid	Wood	0
15	1925 Bldg.	75	XRF	12/11/97	1	Arcade-2E	Door	Peeling	Metal	0.06
16	1925 Bldg.	69	XRF	12/11/97	1	Arcade-2E	Wall	Peeling	Plaster	>0.19
17	1925 Bldg.	76	XRF	12/11/97	1	Arcade-2E	Wall	Solid	Concrete	0
18	1925 Bldg.	72	XRF	12/11/97	1	Arcade-2E		Peeling	Metal	0.72
19	1925 Bldg.	73	XRF	12/11/97	1	Arcade-2E		Solid	Metal	0.74
20	1925 Bldg.	74	XRF	12/11/97	1	Arcade-2E		Solid	Metal	0.19
21	1925 Bldg.	77	XRF	12/11/97	1	Arcade-2E		Peeling	Metal	0
22	1925 Bldg.	7	XRF	12/10/97	0	Boiler Room	Door	Peeling	Metal	2.31
23	1925 Bldg.	8	XRF	12/10/97	0	Boiler Room	Door	Solid	Wood	0.21
24	1925 Bldg.	9	XRF	12/10/97	0	Boiler Room	Door	Cracked	Wood	1.38
25	1925 Bldg.	17	XRF	12/10/97	0	Boiler Room	Door	Solid	Metal	0
26	1925 Bldg.	18	XRF	12/10/97	0	Boiler Room	Door	Peeling	Metal	0.43
27	1925 Bldg.	10	XRF	12/10/97	0	Boiler Room	Floor	Cracked	Concrete	0.05
28	1925 Bldg.	13	XRF	12/10/97	0	Boiler Room	Furnace Door	Peeling	Metal	0.04
29	1925 Bldg.	14	XRF	12/10/97	0	Boiler Room	Stairs	Peeling	Wood	0.91
30	1925 Bldg.	15	XRF	12/10/97	0	Boiler Room	Stairs	Peeling	Wood	2.49
31	1925 Bldg.	16	XRF	12/10/97	0	Boiler Room	Stairs	Peeling	Wood	>>5.0
32	1925 Bldg.	6	XRF	12/10/97	0	Boiler Room	Wall	Solid	Concrete	0.01
33	1925 Bldg.	11	XRF	12/10/97	0	Boiler Room	Wall	Solid	Brick	0
34	1925 Bldg.	12	XRF	12/10/97	0	Boiler Room	Wall	Peeling	Brick	0.07
35	1925 Bldg.	131	XRF	12/24/97	1	Classroom-101E	Cabinet	Solid	Wood	0.03
36	1925 Bldg.	130	XRF	12/24/97	1	Classroom-101E	Chalkboard	Peeling	Wood	0.01
37	1925 Bldg.	128	XRF	12/24/97	1	Classroom-101E	Door	Solid	Wood	0.01
38	1925 Bldg.	129	XRF	12/24/97	1	Classroom-101E	Door	Cracked	Wood	0.03
39	1925 Bldg.	125	XRF	12/24/97	1	Classroom-101E	Wall	Solid	Wood	0.02
40	1925 Bldg.	126	XRF	12/24/97	1	Classroom-101E	Wall	Solid	Plaster	>>5.0
41	1925 Bldg.	127	XRF	12/24/97	1	Classroom-101E	Wall	Cracked	Plaster	>>5.0
42	1925 Bldg.	124	XRF	12/24/97	1	Classroom-101E		Peeling	Metal	>4.45
43	1925 Bldg.	120	XRF	12/24/97	1	Classroom-102E	Cabinet	Solid	Wood	0.02
44	1925 Bldg.	116	XRF	12/24/97	1	Classroom-102E	Chalkboard	Peeling	Wood	0.02
45	1925 Bldg.	118	XRF	12/24/97	1	Classroom-102E	Door	Cracked	Wood	0.01
46	1925 Bldg.	119	XRF	12/24/97	1	Classroom-102E	Door	Solid	Wood	0.02
47	1925 Bldg.	121	XRF	12/24/97	1	Classroom-102E	Toy Refridger	Cracked	Wood	0.01
48	1925 Bldg.	122	XRF	12/24/97	1	Classroom-102E	Toy Refridger	Cracked	Wood	0.01
49	1925 Bldg.	117	XRF	12/24/97	1	Classroom-102E	Wall	Cracked	Plaster	>>5.0
50	1925 Bldg.	123	XRF	12/24/97	1	Classroom-102E	Wall	Solid	Plaster	>>5.0
51	1925 Bldg.	115	XRF	12/24/97	1	Classroom-102E		Peeling	Metal	3.88
52	1925 Bldg.	42	XRF	1/20/98	1	Classroom-103	Ceiling	Solid	Plaster	0.09
53	1925 Bldg.	105	XRF	12/24/97	1	Classroom-103E	Cabinet	Solid	Wood	0.01
54	1925 Bldg.	110	XRF	12/24/97	1	Classroom-103E	Chalkboard	Peeling	Wood	0.05

Saint Paul Public Schools
 Webster Enrichment School
 Lead-Based Paint Inspection

	A	B	C	D	E	F	G	H	I	J
3	Site	Sample#	Analysis	Date	Floor	Area	Component	Condition	Substrate	Result
55	1925 Bldg.	108	XRF	12/24/97	1	Classroom-103E	Door	Solid	Wood	0.03
56	1925 Bldg.	109	XRF	12/24/97	1	Classroom-103E	Door	Peeling	Wood	0.01
57	1925 Bldg.	111	XRF	12/24/97	1	Classroom-103E	Table	Cracked	Wood	0
58	1925 Bldg.	114	XRF	12/24/97	1	Classroom-103E	Toy Bed	Peeling	Wood	0
59	1925 Bldg.	113	XRF	12/24/97	1	Classroom-103E	Toy Box	Solid	Wood	0
60	1925 Bldg.	106	XRF	12/24/97	1	Classroom-103E	Wall	Solid	Wood	0.01
61	1925 Bldg.	107	XRF	12/24/97	1	Classroom-103E	Wall	Cracked	Plaster	>>5.0
62	1925 Bldg.	112	XRF	12/24/97	1	Classroom-103E	Wall	Solid	Plaster	0.31
63	1925 Bldg.	104	XRF	12/24/97	1	Classroom-103E		Peeling	Metal	3.17
64	1925 Bldg.	63	XRF	12/16/97	1	Classroom-104E	Bench	Peeling	Wood	0
65	1925 Bldg.	60	XRF	12/16/97	1	Classroom-104E	Bookcase	Peeling	Wood	1.02
66	1925 Bldg.	59	XRF	12/16/97	1	Classroom-104E	Cabinet	Solid	Wood	0.01
67	1925 Bldg.	64	XRF	12/16/97	1	Classroom-104E	Cabinet	Cracked	Wood	0
68	1925 Bldg.	61	XRF	12/16/97	1	Classroom-104E	Door	Solid	Wood	0.97
69	1925 Bldg.	62	XRF	12/16/97	1	Classroom-104E	Door	Peeling	Wood	0.89
70	1925 Bldg.	57	XRF	12/16/97	1	Classroom-104E	Mirror	Peeling	Wood	0.22
71	1925 Bldg.	66	XRF	12/16/97	1	Classroom-104E	Toy Box	Cracked	Wood	0
72	1925 Bldg.	56	XRF	12/16/97	1	Classroom-104E	Wall	Solid	Drywall	0
73	1925 Bldg.	58	XRF	12/16/97	1	Classroom-104E	Wall	Solid	Plaster	>>5.0
74	1925 Bldg.	65	XRF	12/16/97	1	Classroom-104E		Peeling	Metal	>>5.0
75	1925 Bldg.	49	XRF	12/16/97	1	Classroom-105E	Cabinet	Peeling	Wood	0
76	1925 Bldg.	54	XRF	12/16/97	1	Classroom-105E	Chalkboard	Solid	Wood	0.02
77	1925 Bldg.	50	XRF	12/16/97	1	Classroom-105E	Door	Peeling	Wood	0
78	1925 Bldg.	51	XRF	12/16/97	1	Classroom-105E	Door	Solid	Wood	0.04
79	1925 Bldg.	52	XRF	12/16/97	1	Classroom-105E	Wall	Solid	Plaster	>>5.0
80	1925 Bldg.	53	XRF	12/16/97	1	Classroom-105E	Wall	Solid	Plaster	>>5.0
81	1925 Bldg.	55	XRF	12/16/97	1	Classroom-105E		Solid	Metal	>>5.0
82	1925 Bldg.	48	XRF	12/16/97	1	Classroom-106E	Bench	Cracked	Wood	0
83	1925 Bldg.	46	XRF	12/16/97	1	Classroom-106E	Bookcase	Solid	Wood	0.65
84	1925 Bldg.	42	XRF	12/16/97	1	Classroom-106E	Chalkboard	Peeling	Wood	0.03
85	1925 Bldg.	44	XRF	12/16/97	1	Classroom-106E	Door	Solid	Wood	0.02
86	1925 Bldg.	45	XRF	12/16/97	1	Classroom-106E	Door	Solid	Wood	0.03
87	1925 Bldg.	41	XRF	12/16/97	1	Classroom-106E	Wall	Solid	Plaster	>>5.0
88	1925 Bldg.	43	XRF	12/16/97	1	Classroom-106E	Wall	Peeling	Plaster	>>5.0
89	1925 Bldg.	47	XRF	12/16/97	1	Classroom-106E		Peeling	Metal	3.35
90	1925 Bldg.	43	XRF	1/20/98	1	Classroom-107.5	Ceiling	Solid	Plaster	0.08
91	1925 Bldg.	39	XRF	12/16/97	1	Classroom-1075E	Bookcase	Peeling	Wood	0
92	1925 Bldg.	37	XRF	12/16/97	1	Classroom-1075E	Cabinet	Solid	Wood	0
93	1925 Bldg.	34	XRF	12/16/97	1	Classroom-1075E	Door	Solid	Wood	0.01
94	1925 Bldg.	35	XRF	12/16/97	1	Classroom-1075E	Door	Solid	Wood	0.02
95	1925 Bldg.	32	XRF	12/16/97	1	Classroom-1075E	Wall	Solid	Plaster	3.28
96	1925 Bldg.	33	XRF	12/16/97	1	Classroom-1075E	Wall	Solid	Wood	0.09
97	1925 Bldg.	36	XRF	12/16/97	1	Classroom-1075E	Wall	Solid	Wood	0.06
98	1925 Bldg.	40	XRF	12/16/97	1	Classroom-1075E	Wall	Solid	Plaster	>>5.0
99	1925 Bldg.	38	XRF	12/16/97	1	Classroom-1075E		Solid	Metal	2.03
100	1925 Bldg.	22	XRF	1/15/98	3	Classroom-201	Ceiling	Solid	Plaster	0.09
101	1925 Bldg.	20	XRF	12/3/97	2	Classroom-201E	Bookcase	Solid	Wood	0.03
102	1925 Bldg.	22	XRF	12/3/97	2	Classroom-201E	Chalkboard	Peeling	Wood	0.03
103	1925 Bldg.	24	XRF	12/3/97	2	Classroom-201E	Door	Solid	Wood	0.02
104	1925 Bldg.	21	XRF	12/3/97	2	Classroom-201E	Wall	Solid	Wood	0.01
105	1925 Bldg.	23	XRF	12/3/97	2	Classroom-201E	Wall	Solid	Plaster	>>5.0
106	1925 Bldg.	25	XRF	12/3/97	2	Classroom-201E	Wall	Solid	Plaster	>>5.0
107	1925 Bldg.	19	XRF	12/3/97	2	Classroom-201E		Peeling	Metal	3.36

Saint Paul Public Schools
 Webster Enrichment School
 Lead-Based Paint Inspection

	A	B	C	D	E	F	G	H	I	J
3	Site	Sample#	Analysis	Date	Floor	Area	Component	Condition	Substrate	Result
108	1925 Bldg.	23	XRF	1/15/98	3	Classroom-202	Ceiling	Solid	Plaster	0.06
109	1925 Bldg.	14	XRF	12/3/97	2	Classroom-202E	Chalkboard	Peeling	Wood	0.03
110	1925 Bldg.	16	XRF	12/3/97	2	Classroom-202E	Door	Solid	Wood	0.02
111	1925 Bldg.	13	XRF	12/3/97	2	Classroom-202E	Wall	Solid	Plaster	>>5.0
112	1925 Bldg.	15	XRF	12/3/97	2	Classroom-202E	Wall	Peeling	Plaster	>>5.0
113	1925 Bldg.	17	XRF	12/3/97	2	Classroom-202E	Wall	Cracked	Wood	>>5.0
114	1925 Bldg.	18	XRF	12/3/97	2	Classroom-202E	Wall	Cracked	Wood	0.03
115	1925 Bldg.	12	XRF	12/3/97	2	Classroom-202E	Water	Peeling	Metal	0
116	1925 Bldg.	24	XRF	1/15/98	3	Classroom-203.5	Ceiling	Solid	Plaster	0.03
117	1925 Bldg.	8	XRF	12/3/97	2	Classroom-203E	Chalkboard	Peeling	Wood	0.03
118	1925 Bldg.	11	XRF	12/3/97	2	Classroom-203E	Door	Solid	Wood	0.02
119	1925 Bldg.	7	XRF	12/3/97	2	Classroom-203E	Wall	Solid	Plaster	>>5.0
120	1925 Bldg.	9	XRF	12/3/97	2	Classroom-203E	Wall	Solid	Plaster	>>5.0
121	1925 Bldg.	10	XRF	12/3/97	2	Classroom-203E	Wall	Solid	Plaster	>>5.0
122	1925 Bldg.	6	XRF	12/3/97	2	Classroom-203E		Peeling	Metal	4.01
123	1925 Bldg.	25	XRF	1/15/98	3	Classroom-204	Ceiling	Solid	Plaster	0.03
124	1925 Bldg.	90	XRF	12/3/97	2	Classroom-204E	Cabinet	Solid	Wood	0.03
125	1925 Bldg.	91	XRF	12/3/97	2	Classroom-204E	Chalkboard	Cracked	Wood	0.05
126	1925 Bldg.	86	XRF	12/3/97	2	Classroom-204E	Door	Solid	Wood	0.01
127	1925 Bldg.	89	XRF	12/3/97	2	Classroom-204E	Door	Cracked	Wood	0.02
128	1925 Bldg.	87	XRF	12/3/97	2	Classroom-204E	Wall	Solid	Plaster	>>5.0
129	1925 Bldg.	88	XRF	12/3/97	2	Classroom-204E	Wall	Peeling	Plaster	>>5.0
130	1925 Bldg.	92	XRF	12/3/97	2	Classroom-204E		Peeling	Metal	>2.50
131	1925 Bldg.	26	XRF	1/15/98	3	Classroom-205	Ceiling	Solid	Plaster	0.01
132	1925 Bldg.	84	XRF	12/3/97	2	Classroom-205E	Bookcase	Peeling	Wood	0.03
133	1925 Bldg.	83	XRF	12/3/97	2	Classroom-205E	Cabinet	Solid	Wood	0.02
134	1925 Bldg.	79	XRF	12/3/97	2	Classroom-205E	Chalkboard	Peeling	Wood	0.04
135	1925 Bldg.	81	XRF	12/3/97	2	Classroom-205E	Door	Solid	Wood	0.01
136	1925 Bldg.	82	XRF	12/3/97	2	Classroom-205E	Door	Solid	Wood	0.02
137	1925 Bldg.	78	XRF	12/3/97	2	Classroom-205E	Wall	Solid	Plaster	0.02
138	1925 Bldg.	80	XRF	12/3/97	2	Classroom-205E	Wall	Peeling	Plaster	4.31
139	1925 Bldg.	85	XRF	12/3/97	2	Classroom-205E		Solid	Metal	>>5.0
140	1925 Bldg.	27	XRF	1/15/98	3	Classroom-206	Ceiling	Solid	Plaster	0.05
141	1925 Bldg.	76	XRF	12/3/97	2	Classroom-206E	Cabinet	Solid	Wood	0.01
142	1925 Bldg.	72	XRF	12/3/97	2	Classroom-206E	Chalkboard	Peeling	Wood	0.01
143	1925 Bldg.	74	XRF	12/3/97	2	Classroom-206E	Door	Cracked	Wood	0.04
144	1925 Bldg.	75	XRF	12/3/97	2	Classroom-206E	Door	Solid	Wood	0.01
145	1925 Bldg.	71	XRF	12/3/97	2	Classroom-206E	Wall	Solid	Plaster	0
146	1925 Bldg.	73	XRF	12/3/97	2	Classroom-206E	Wall	Peeling	Plaster	>>5.0
147	1925 Bldg.	77	XRF	12/3/97	2	Classroom-206E		Solid	Metal	>>5.0
148	1925 Bldg.	28	XRF	1/15/98	3	Classroom-207.5	Ceiling	Solid	Plaster	0.02
149	1925 Bldg.	67	XRF	12/3/97	2	Classroom-207.5	Bench	Solid	Wood	>>5.0
150	1925 Bldg.	68	XRF	12/3/97	2	Classroom-207.5	Door	Cracked	Wood	>>5.0
151	1925 Bldg.	69	XRF	12/3/97	2	Classroom-207.5	Door	Solid	Wood	>>5.0
152	1925 Bldg.	66	XRF	12/3/97	2	Classroom-207.5	Wall	Solid	Plaster	0.27
153	1925 Bldg.	70	XRF	12/3/97	2	Classroom-207.5	Wall	Peeling	Wood	0
154	1925 Bldg.	65	XRF	12/3/97	2	Classroom-207E	Cabinet	Cracked	Wood	0.02
155	1925 Bldg.	62	XRF	12/3/97	2	Classroom-207E	Chalkboard	Peeling	Wood	0.01
156	1925 Bldg.	59	XRF	12/3/97	2	Classroom-207E	Door	Solid	Wood	0.02
157	1925 Bldg.	60	XRF	12/3/97	2	Classroom-207E	Door	Solid	Wood	0.02
158	1925 Bldg.	61	XRF	12/3/97	2	Classroom-207E	Wall	Solid	Plaster	>>5.0
159	1925 Bldg.	63	XRF	12/3/97	2	Classroom-207E	Wall	Solid	Plaster	>>5.0
160	1925 Bldg.	64	XRF	12/3/97	2	Classroom-207E		Peeling	Metal	0.19

Saint Paul Public Schools
 Webster Enrichment School
 Lead-Based Paint Inspection

	A	B	C	D	E	F	G	H	I	J
3	Site	Sample#	Analysis	Date	Floor	Area	Component	Condition	Substrate	Result
161	1925 Bldg.	55	XRF	12/3/97	2	Classroom-208E	Cabinet	Solid	Wood	0.03
162	1925 Bldg.	56	XRF	12/3/97	2	Classroom-208E	Chalkboard	Solid	Wood	0.06
163	1925 Bldg.	53	XRF	12/3/97	2	Classroom-208E	Door	Solid	Wood	0.02
164	1925 Bldg.	54	XRF	12/3/97	2	Classroom-208E	Door	Solid	Wood	0.03
165	1925 Bldg.	52	XRF	12/3/97	2	Classroom-208E	Wall	Solid	Plaster	>>5.0
166	1925 Bldg.	58	XRF	12/3/97	2	Classroom-208E	Wall	Solid	Plaster	>>5.0
167	1925 Bldg.	57	XRF	12/3/97	2	Classroom-208E		Peeling	Metal	3.68
168	1925 Bldg.	48	XRF	12/3/97	2	Classroom-209E	Cabinet	Solid	Wood	0.02
169	1925 Bldg.	49	XRF	12/3/97	2	Classroom-209E	Chalkboard	Cracked	Wood	0.02
170	1925 Bldg.	45	XRF	12/3/97	2	Classroom-209E	Door	Solid	Wood	0.02
171	1925 Bldg.	46	XRF	12/3/97	2	Classroom-209E	Door	Solid	Wood	0.01
172	1925 Bldg.	47	XRF	12/3/97	2	Classroom-209E	Wall	Solid	Plaster	>>5.0
173	1925 Bldg.	51	XRF	12/3/97	2	Classroom-209E	Wall	Solid	Plaster	>>5.0
174	1925 Bldg.	50	XRF	12/3/97	2	Classroom-209E		Peeling	Metal	>3.80
175	1925 Bldg.	29	XRF	1/15/98	3	Classroom-210	Ceiling	Peeling	Plaster	>0.19
176	1925 Bldg.	41	XRF	12/3/97	2	Classroom-210E	Cabinet	Solid	Wood	0
177	1925 Bldg.	43	XRF	12/3/97	2	Classroom-210E	Door	Solid	Wood	0
178	1925 Bldg.	44	XRF	12/3/97	2	Classroom-210E	Door	Solid	Wood	0
179	1925 Bldg.	38	XRF	12/3/97	2	Classroom-210E	Wall	Solid	Plaster	3.94
180	1925 Bldg.	40	XRF	12/3/97	2	Classroom-210E	Wall	Solid	Wood	0
181	1925 Bldg.	39	XRF	12/3/97	2	Classroom-210E		Solid	Metal	>2.47
182	1925 Bldg.	42	XRF	12/3/97	2	Classroom-210E		Solid	Metal	0.14
183	1925 Bldg.	16	XRF	1/15/98	3	Classroom-301	Ceiling	Solid	Plaster	0.22
184	1925 Bldg.	25	XRF	12/2/97	3	Classroom-301E	Cabinet	Solid	Wood	0.02
185	1925 Bldg.	26	XRF	12/2/97	3	Classroom-301E	Chalkboard	Peeling	Wood	0.03
186	1925 Bldg.	23	XRF	12/2/97	3	Classroom-301E	Door	Solid	Wood	0.03
187	1925 Bldg.	24	XRF	12/2/97	3	Classroom-301E	Door	Solid	Wood	0.03
188	1925 Bldg.	21	XRF	12/2/97	3	Classroom-301E	Wall	Solid	Plaster	>>5.0
189	1925 Bldg.	22	XRF	12/2/97	3	Classroom-301E	Wall	Solid	Plaster	>>5.0
190	1925 Bldg.	20	XRF	12/2/97	3	Classroom-301E		Peeling	Metal	3.44
191	1925 Bldg.	15	XRF	1/15/98	3	Classroom-302	Ceiling	Solid	Plaster	0.27
192	1925 Bldg.	9	XRF	12/2/97	3	Classroom-302E	Cabinet	Solid	Wood	0.03
193	1925 Bldg.	8	XRF	12/2/97	3	Classroom-302E	Chalkboard	Solid	Wood	0.01
194	1925 Bldg.	12	XRF	12/2/97	3	Classroom-302E	Door-Ctr	Solid	Wood	0.02
195	1925 Bldg.	7	XRF	12/2/97	3	Classroom-302E	Wall	Solid	Plaster	>>5.0
196	1925 Bldg.	10	XRF	12/2/97	3	Classroom-302E	Wall	Solid	Plaster	0.2
197	1925 Bldg.	11	XRF	12/2/97	3	Classroom-302E	Wall	Solid	Plaster	0.14
198	1925 Bldg.	6	XRF	12/2/97	3	Classroom-302E		Solid	Metal	>>5.0
199	1925 Bldg.	14	XRF	1/15/98	3	Classroom-303	Ceiling	Solid	Plaster	0.07
200	1925 Bldg.	19	XRF	12/2/97	3	Classroom-303E	Chalkboard	Peeling	Wood	0.03
201	1925 Bldg.	16	XRF	12/2/97	3	Classroom-303E	Door	Cracked	Wood	0.03
202	1925 Bldg.	17	XRF	12/2/97	3	Classroom-303E	Door	Solid	Wood	0.03
203	1925 Bldg.	14	XRF	12/2/97	3	Classroom-303E	Wall	Solid	Plaster	>>5.0
204	1925 Bldg.	15	XRF	12/2/97	3	Classroom-303E	Wall	Solid	Plaster	>>5.0
205	1925 Bldg.	18	XRF	12/2/97	3	Classroom-303E	Wall	Solid	Wood	0.02
206	1925 Bldg.	13	XRF	12/2/97	3	Classroom-303E		Peeling	Metal	2.77
207	1925 Bldg.	13	XRF	1/15/98	3	Classroom-304	Ceiling	Solid	Plaster	0.31
208	1925 Bldg.	94	XRF	12/2/97	3	Classroom-304E	Bookcase	Peeling	Metal	0
209	1925 Bldg.	90	XRF	12/2/97	3	Classroom-304E	Cabinet	Solid	Wood	0.01
210	1925 Bldg.	93	XRF	12/2/97	3	Classroom-304E	Chalkboard	Cracked	Wood	0.02
211	1925 Bldg.	91	XRF	12/2/97	3	Classroom-304E	Desk	Cracked	Wood	0
212	1925 Bldg.	92	XRF	12/2/97	3	Classroom-304E	Door	Solid	Wood	0.02
213	1925 Bldg.	95	XRF	12/2/97	3	Classroom-304E	Wall	Solid	Plaster	>>5.0

Saint Paul Public Schools
 Webster Enrichment School
 Lead-Based Paint Inspection

	A	B	C	D	E	F	G	H	I	J
3	Site	Sample#	Analysis	Date	Floor	Area	Component	Condition	Substrate	Result
214	1925 Bldg.	96	XRF	12/2/97	3	Classroom-304E	Wall	Solid	Plaster	0.14
215	1925 Bldg.	97	XRF	12/2/97	3	Classroom-304E		Solid	Metal	1.92
216	1925 Bldg.	12	XRF	1/15/98	3	Classroom-305	Ceiling	Solid	Plaster	0.26
217	1925 Bldg.	89	XRF	12/2/97	3	Classroom-305E	Bookcase	Solid	Wood	0
218	1925 Bldg.	87	XRF	12/2/97	3	Classroom-305E	Chalkboard	Peeling	Wood	0
219	1925 Bldg.	86	XRF	12/2/97	3	Classroom-305E	Door	Solid	Wood	0.04
220	1925 Bldg.	83	XRF	12/2/97	3	Classroom-305E	Wall	Solid	Plaster	>>5.0
221	1925 Bldg.	84	XRF	12/2/97	3	Classroom-305E	Wall	Cracked	Wood	0.01
222	1925 Bldg.	85	XRF	12/2/97	3	Classroom-305E	Wall	Peeling	Plaster	>>5.0
223	1925 Bldg.	88	XRF	12/2/97	3	Classroom-305E		Peeling	Metal	4.48
224	1925 Bldg.	11	XRF	1/15/98	3	Classroom-306	Ceiling	Solid	Plaster	0.32
225	1925 Bldg.	80	XRF	12/2/97	3	Classroom-306E	Bookcase	Solid	Wood	0
226	1925 Bldg.	76	XRF	12/2/97	3	Classroom-306E	Chalkboard	Cracked	Wood	0.01
227	1925 Bldg.	79	XRF	12/2/97	3	Classroom-306E	Chalkboard	Cracked	Wood	0.01
228	1925 Bldg.	78	XRF	12/2/97	3	Classroom-306E	Door	Solid	Wood	0.01
229	1925 Bldg.	77	XRF	12/2/97	3	Classroom-306E	Wall	Solid	Plaster	>>5.0
230	1925 Bldg.	81	XRF	12/2/97	3	Classroom-306E	Wall	Solid	Plaster	>>5.0
231	1925 Bldg.	82	XRF	12/2/97	3	Classroom-306E		Peeling	Metal	2.88
232	1925 Bldg.	10	XRF	1/15/98	3	Classroom-307	Ceiling	Solid	Plaster	0.4
233	1925 Bldg.	72	XRF	12/2/97	3	Classroom-307E	Cabinet	Solid	Wood	0.02
234	1925 Bldg.	73	XRF	12/2/97	3	Classroom-307E	Chalkboard	Cracked	Wood	0
235	1925 Bldg.	70	XRF	12/2/97	3	Classroom-307E	Door	Solid	Wood	0.04
236	1925 Bldg.	74	XRF	12/2/97	3	Classroom-307E	Stool	Cracked	Metal	0.01
237	1925 Bldg.	69	XRF	12/2/97	3	Classroom-307E	Wall	Solid	Plaster	>>5.0
238	1925 Bldg.	71	XRF	12/2/97	3	Classroom-307E	Wall	Cracked	Plaster	>>5.0
239	1925 Bldg.	75	XRF	12/2/97	3	Classroom-307E		Peeling	Metal	4.22
240	1925 Bldg.	9	XRF	1/15/98	3	Classroom-308	Ceiling	Solid	Plaster	0.29
241	1925 Bldg.	65	XRF	12/2/97	3	Classroom-308E	Chalkboard	Solid	Wood	0.01
242	1925 Bldg.	66	XRF	12/2/97	3	Classroom-308E	Door	Solid	Wood	0.02
243	1925 Bldg.	67	XRF	12/2/97	3	Classroom-308E	Door	Solid	Wood	0.03
244	1925 Bldg.	64	XRF	12/2/97	3	Classroom-308E	Wall	Solid	Plaster	>>5.0
245	1925 Bldg.	68	XRF	12/2/97	3	Classroom-308E		Peeling	Metal	>>5.0
246	1925 Bldg.	8	XRF	1/15/98	3	Classroom-309	Ceiling	Solid	Plaster	0.22
247	1925 Bldg.	63	XRF	12/2/97	3	Classroom-309E	Chalkboard	Peeling	Wood	0.01
248	1925 Bldg.	58	XRF	12/2/97	3	Classroom-309E	Door	Solid	Wood	0.03
249	1925 Bldg.	59	XRF	12/2/97	3	Classroom-309E	Wall	Solid	Plaster	>>5.0
250	1925 Bldg.	60	XRF	12/2/97	3	Classroom-309E	Wall	Solid	Plaster	>>5.0
251	1925 Bldg.	61	XRF	12/2/97	3	Classroom-309E	Wall	Cracked	Wood	0.06
252	1925 Bldg.	62	XRF	12/2/97	3	Classroom-309E		Peeling	Metal	2.68
253	1925 Bldg.	7	XRF	1/15/98	3	Classroom-310	Ceiling	Solid	Plaster	0.16
254	1925 Bldg.	54	XRF	12/2/97	3	Classroom-310E	Chalkboard	Cracked	Wood	0.03
255	1925 Bldg.	52	XRF	12/2/97	3	Classroom-310E	Door	Solid	Wood	0.01
256	1925 Bldg.	53	XRF	12/2/97	3	Classroom-310E	Wall	Solid	Plaster	>>5.0
257	1925 Bldg.	55	XRF	12/2/97	3	Classroom-310E	Wall	Solid	Wood	0.04
258	1925 Bldg.	56	XRF	12/2/97	3	Classroom-310E	Wall	Solid	Plaster	4.34
259	1925 Bldg.	57	XRF	12/2/97	3	Classroom-310E		Peeling	Metal	3.14
260	1925 Bldg.	6	XRF	1/15/98	3	Classroom-311	Ceiling	Solid	Plaster	0.09
261	1925 Bldg.	48	XRF	12/2/97	3	Classroom-311E	Cabinet	Cracked	Wood	0.01
262	1925 Bldg.	49	XRF	12/2/97	3	Classroom-311E	Chalkboard	Peeling	Wood	0.02
263	1925 Bldg.	46	XRF	12/2/97	3	Classroom-311E	Door	Solid	Wood	0.02
264	1925 Bldg.	47	XRF	12/2/97	3	Classroom-311E	Wall	Solid	Plaster	>>5.0
265	1925 Bldg.	51	XRF	12/2/97	3	Classroom-311E	Wall	Solid	Plaster	>>5.0
266	1925 Bldg.	50	XRF	12/2/97	3	Classroom-311E		Peeling	Metal	>>5.0

Saint Paul Public Schools
 Webster Enrichment School
 Lead-Based Paint Inspection

	A	B	C	D	E	F	G	H	I	J
3	Site	Sample#	Analysis	Date	Floor	Area	Component	Condition	Substrate	Result
267	1925 Bldg.	41	XRF	12/2/97	3	Classroom-312E	Cabinet	Solid	Wood	0
268	1925 Bldg.	44	XRF	12/2/97	3	Classroom-312E	Door	Solid	Wood	0
269	1925 Bldg.	45	XRF	12/2/97	3	Classroom-312E	Door	Solid	Wood	0
270	1925 Bldg.	43	XRF	12/2/97	3	Classroom-312E	Wall	Solid	Plaster	0.29
271	1925 Bldg.	40	XRF	12/2/97	3	Classroom-312E		Peeling	Metal	2.59
272	1925 Bldg.	42	XRF	12/2/97	3	Classroom-312E		Solid	Metal	0.15
273	1925 Bldg.	21	XRF	12/10/97	0	Fan Room	Door	Peeling	Wood	0.1
274	1925 Bldg.	27	XRF	12/10/97	0	Fan Room	Door	Peeling	Metal	0.23
275	1925 Bldg.	28	XRF	12/10/97	0	Fan Room	Door	Peeling	Metal	0.08
276	1925 Bldg.	20	XRF	12/10/97	0	Fan Room	Stairs	Peeling	Metal	2.47
277	1925 Bldg.	22	XRF	12/10/97	0	Fan Room	Stairs	Peeling	Metal	0.03
278	1925 Bldg.	23	XRF	12/10/97	0	Fan Room	Stairs	Peeling	Metal	0.15
279	1925 Bldg.	26	XRF	12/10/97	0	Fan Room	Stairs	Cracked	Wood	1.2
280	1925 Bldg.	19	XRF	12/10/97	0	Fan Room	Wall	Solid	Concrete	0
281	1925 Bldg.	24	XRF	12/10/97	0	Fan Room		Solid	Metal	0
282	1925 Bldg.	25	XRF	12/10/97	0	Fan Room		Solid	Metal	0.17
283	1925 Bldg.	98	XRF	12/24/97	1	Gym-1	Door	Solid	Wood	0.02
284	1925 Bldg.	99	XRF	12/24/97	1	Gym-1	Door	Solid	Wood	0.01
285	1925 Bldg.	100	XRF	12/24/97	1	Gym-1	Door	Peeling	Wood	0
286	1925 Bldg.	101	XRF	12/24/97	1	Gym-1	Door	Peeling	Metal	0.07
287	1925 Bldg.	93	XRF	12/24/97	1	Gym-1	Floor	Solid	Wood	0
288	1925 Bldg.	94	XRF	12/24/97	1	Gym-1	Floor	Solid	Wood	0
289	1925 Bldg.	95	XRF	12/24/97	1	Gym-1	Floor	Solid	Wood	0
290	1925 Bldg.	96	XRF	12/24/97	1	Gym-1	Floor	Solid	Wood	0.14
291	1925 Bldg.	97	XRF	12/24/97	1	Gym-1	Floor	Solid	Wood	0
292	1925 Bldg.	102	XRF	12/24/97	1	Gym-1	Pipe	Peeling	Metal	>0.50
293	1925 Bldg.	103	XRF	12/24/97	1	Gym-1	Wall	Solid	Plaster	>>5.0
294	1925 Bldg.	45	XRF	1/20/98	1	Hall-1	Ceiling	Peeling	Plaster	0.1
295	1925 Bldg.	80	XRF	12/16/97	1	Hall-1	Chalkboard	Peeling	Wood	0.04
296	1925 Bldg.	74	XRF	12/16/97	1	Hall-1	Door	Solid	Metal	0.29
297	1925 Bldg.	75	XRF	12/16/97	1	Hall-1	Door	Peeling	Metal	0.24
298	1925 Bldg.	78	XRF	12/16/97	1	Hall-1	Door	Solid	Wood	0.02
299	1925 Bldg.	79	XRF	12/16/97	1	Hall-1	Door	Peeling	Metal	0.24
300	1925 Bldg.	81	XRF	12/16/97	1	Hall-1	Door	Solid	Wood	0
301	1925 Bldg.	73	XRF	12/16/97	1	Hall-1	Wall	Peeling	Plaster	2.35
302	1925 Bldg.	77	XRF	12/16/97	1	Hall-1	Wall	Solid	Wood	0
303	1925 Bldg.	76	XRF	12/16/97	1	Hall-1		Peeling	Metal	0.32
304	1925 Bldg.	82	XRF	12/16/97	1	Hall-1		Solid	Metal	>>5.0
305	1925 Bldg.	16	XRF	12/4/97	1	Hall-2	Cabinet	Solid	Wood	0
306	1925 Bldg.	10	XRF	12/4/97	1	Hall-2	Door	Solid	Metal	0.2
307	1925 Bldg.	11	XRF	12/4/97	1	Hall-2	Door	Peeling	Metal	0.25
308	1925 Bldg.	14	XRF	12/4/97	1	Hall-2	Door	Solid	Wood	0.01
309	1925 Bldg.	18	XRF	12/4/97	1	Hall-2	Door	Solid	Wood	0.03
310	1925 Bldg.	19	XRF	12/4/97	1	Hall-2	Door	Solid	Wood	0.03
311	1925 Bldg.	20	XRF	12/4/97	1	Hall-2	Door	Solid	Metal	0
312	1925 Bldg.	12	XRF	12/4/97	1	Hall-2	Wall	Solid	Wood	0
313	1925 Bldg.	13	XRF	12/4/97	1	Hall-2	Wall	Solid	Plaster	0.38
314	1925 Bldg.	15	XRF	12/4/97	1	Hall-2	Wall	Solid	Plaster	>>5.0
315	1925 Bldg.	17	XRF	12/4/97	1	Hall-2	Wall	Solid	Metal	0.33
316	1925 Bldg.	21	XRF	12/4/97	1	Hall-2	Wall	Solid	Metal	0
317	1925 Bldg.	22	XRF	12/4/97	1	Hall-2	Window	Solid	Wood	0
318	1925 Bldg.	17	XRF	1/15/98	3	Hall-3	Ceiling	Solid	Plaster	0.33
319	1925 Bldg.	99	XRF	12/2/97	3	Hall-3	Door	Solid	Metal	0.21

Saint Paul Public Schools
 Webster Enrichment School
 Lead-Based Paint Inspection

	A	B	C	D	E	F	G	H	I	J
3	Site	Sample#	Analysis	Date	Floor	Area	Component	Condition	Substrate	Result
320	1925 Bldg.	100	XRF	12/2/97	3	Hall-3	Door	Cracked	Metal	0.3
321	1925 Bldg.	104	XRF	12/2/97	3	Hall-3	Door	Peeling	Wood	0.01
322	1925 Bldg.	107	XRF	12/2/97	3	Hall-3	Door	Solid	Wood	0.03
323	1925 Bldg.	108	XRF	12/2/97	3	Hall-3	Door	Solid	Wood	0.02
324	1925 Bldg.	109	XRF	12/2/97	3	Hall-3	Door	Solid	Wood	0
325	1925 Bldg.	98	XRF	12/2/97	3	Hall-3	Wall	Solid	Plaster	3.71
326	1925 Bldg.	102	XRF	12/2/97	3	Hall-3	Wall	Solid	Wood	0
327	1925 Bldg.	103	XRF	12/2/97	3	Hall-3	Wall	Solid	Plaster	0.33
328	1925 Bldg.	105	XRF	12/2/97	3	Hall-3	Wall	Solid	Plaster	4.05
329	1925 Bldg.	110	XRF	12/2/97	3	Hall-3	Wall	Solid	Plaster	0.13
330	1925 Bldg.	101	XRF	12/2/97	3	Hall-3		Solid	Metal	0.15
331	1925 Bldg.	106	XRF	12/2/97	3	Hall-3		Peeling	Metal	1.52
332	1925 Bldg.	59	XRF	12/11/97	1	Kitchen-1E	Cabinet	Solid	Wood	0
333	1925 Bldg.	56	XRF	12/11/97	1	Kitchen-1E	Door	Peeling	Metal	0.06
334	1925 Bldg.	55	XRF	12/11/97	1	Kitchen-1E	Wall	Solid	Drywall	0
335	1925 Bldg.	58	XRF	12/11/97	1	Kitchen-1E	Wall	Cracked	Plaster	0.21
336	1925 Bldg.	57	XRF	12/11/97	1	Kitchen-1E		Peeling	Metal	>3.71
337	1925 Bldg.	18	XRF	1/15/98	3	Restroom-1	Ceiling	Solid	Plaster	>2.47
338	1925 Bldg.	31	XRF	12/2/97	3	Restroom-1	Door	Solid	Wood	0.04
339	1925 Bldg.	33	XRF	12/2/97	3	Restroom-1	Door	Solid	Wood	0
340	1925 Bldg.	30	XRF	12/2/97	3	Restroom-1	Mirror	Solid	Wood	0.23
341	1925 Bldg.	27	XRF	12/2/97	3	Restroom-1	Wall	Solid	Plaster	>>5.0
342	1925 Bldg.	28	XRF	12/2/97	3	Restroom-1	Wall	Solid	Wood	0.02
343	1925 Bldg.	29	XRF	12/2/97	3	Restroom-1	Wall	Solid	Plaster	>2.12
344	1925 Bldg.	32	XRF	12/2/97	3	Restroom-1		Peeling	Metal	>>5.0
345	1925 Bldg.	19	XRF	1/15/98	3	Restroom-2	Ceiling	Solid	Plaster	>1.35
346	1925 Bldg.	34	XRF	12/2/97	3	Restroom-2	Door	Solid	Wood	0
347	1925 Bldg.	35	XRF	12/2/97	3	Restroom-2	Door	Solid	Wood	0.01
348	1925 Bldg.	38	XRF	12/2/97	3	Restroom-2	Door	Solid	Wood	0.02
349	1925 Bldg.	39	XRF	12/2/97	3	Restroom-2	Door	Solid	Wood	0.03
350	1925 Bldg.	36	XRF	12/2/97	3	Restroom-2	Wall	Solid	Plaster	>>5.0
351	1925 Bldg.	37	XRF	12/2/97	3	Restroom-2	Wall	Solid	Plaster	1.43
352	1925 Bldg.	21	XRF	1/15/98	3	Restroom-3	Ceiling	Solid	Plaster	>2.27
353	1925 Bldg.	26	XRF	12/3/97	2	Restroom-3	Door	Solid	Wood	0.02
354	1925 Bldg.	30	XRF	12/3/97	2	Restroom-3	Door	Solid	Wood	0.03
355	1925 Bldg.	27	XRF	12/3/97	2	Restroom-3	Wall	Solid	Plaster	4.44
356	1925 Bldg.	28	XRF	12/3/97	2	Restroom-3	Wall	Cracked	Plaster	>2.47
357	1925 Bldg.	31	XRF	12/3/97	2	Restroom-3	Wall	Solid	Wood	0.03
358	1925 Bldg.	29	XRF	12/3/97	2	Restroom-3		Peeling	Metal	0.13
359	1925 Bldg.	20	XRF	1/15/98	3	Restroom-4	Ceiling	Solid	Plaster	1.57
360	1925 Bldg.	32	XRF	12/3/97	2	Restroom-4	Door	Solid	Wood	0
361	1925 Bldg.	36	XRF	12/3/97	2	Restroom-4	Door	Solid	Wood	0.01
362	1925 Bldg.	37	XRF	12/3/97	2	Restroom-4	Door	Solid	Wood	0.01
363	1925 Bldg.	33	XRF	12/3/97	2	Restroom-4	Wall	Cracked	Plaster	>0.20
364	1925 Bldg.	34	XRF	12/3/97	2	Restroom-4	Wall	Solid	Wood	0.01
365	1925 Bldg.	35	XRF	12/3/97	2	Restroom-4	Wall	Solid	Plaster	3.39
366	1925 Bldg.	44	XRF	1/20/98	1	Restroom-7	Ceiling	Solid	Plaster	>0.74
367	1925 Bldg.	80	XRF	12/11/97	1	Restroom-7	Door	Solid	Wood	0
368	1925 Bldg.	83	XRF	12/11/97	1	Restroom-7	Door	Solid	Wood	0.01
369	1925 Bldg.	84	XRF	12/11/97	1	Restroom-7	Door	Solid	Wood	0.03
370	1925 Bldg.	78	XRF	12/11/97	1	Restroom-7	Wall	Solid	Wood	0
371	1925 Bldg.	79	XRF	12/11/97	1	Restroom-7	Wall	Solid	Wood	0
372	1925 Bldg.	81	XRF	12/11/97	1	Restroom-7	Wall	Solid	Plaster	>1.16

Saint Paul Public Schools
 Webster Enrichment School
 Lead-Based Paint Inspection

	A	B	C	D	E	F	G	H	I	J
3	Site	Sample#	Analysis	Date	Floor	Area	Component	Condition	Substrate	Result
373	1925 Bldg.	82	XRF	12/11/97	1	Restroom-7	Wall	Solid	Plaster	>>5.0
374	1925 Bldg.	85	XRF	12/11/97	1	Restroom-7	Wall	Solid	Wood	0
375	1925 Bldg.	88	XRF	12/11/97	1	Restroom-8	Door	Solid	Wood	0.03
376	1925 Bldg.	90	XRF	12/11/97	1	Restroom-8	Door	Solid	Wood	0.02
377	1925 Bldg.	91	XRF	12/11/97	1	Restroom-8	Door	Solid	Wood	0.02
378	1925 Bldg.	92	XRF	12/11/97	1	Restroom-8	Door	Solid	Wood	0.02
379	1925 Bldg.	86	XRF	12/11/97	1	Restroom-8	Wall	Solid	Plaster	4.47
380	1925 Bldg.	87	XRF	12/11/97	1	Restroom-8	Wall	Cracked	Plaster	1.38
381	1925 Bldg.	93	XRF	12/11/97	1	Restroom-8	Wall	Solid	Wood	>0.07
382	1925 Bldg.	94	XRF	12/11/97	1	Restroom-8	Wall	Solid	Plaster	0.14
383	1925 Bldg.	95	XRF	12/11/97	1	Restroom-8	Wall	Solid	Metal	>0.08
384	1925 Bldg.	89	XRF	12/11/97	1	Restroom-8		Peeling	Metal	>>5.0
385	1925 Bldg.	30	XRF	1/15/98	1	Room-0	Ceiling	Solid	Plaster	0.16
386	1925 Bldg.	31	XRF	1/15/98	1	Room-0	Ceiling	Solid	Plaster	0.13
387	1925 Bldg.	67	XRF	12/16/97	1	Room-1035	Door	Solid	Wood	0
388	1925 Bldg.	68	XRF	12/16/97	1	Room-1035	Window	Solid	Wood	0
389	1925 Bldg.	70	XRF	12/16/97	1	Room-1035E	Wall	Cracked	Plaster	>>5.0
390	1925 Bldg.	71	XRF	12/16/97	1	Room-1035E	Wall	Peeling	Wood	0.25
391	1925 Bldg.	69	XRF	12/16/97	1	Room-1035E		Peeling	Metal	>1.74
392	1925 Bldg.	72	XRF	12/16/97	1	Room-1035E		Peeling	Metal	0.19
393	1925 Bldg.	6	XRF	12/4/97	1	Room-2035	Cabinet	Solid	Wood	0.03
394	1925 Bldg.	8	XRF	12/4/97	1	Room-2035	Door	Solid	Wood	0
395	1925 Bldg.	7	XRF	12/4/97	1	Room-2035	Wall	Solid	Plaster	>>5.0
396	1925 Bldg.	9	XRF	12/4/97	1	Room-2035		Peeling	Metal	1.1
397	1925 Bldg.	29	XRF	12/4/97	1	Stairwell-1	Door	Solid	Metal	0.16
398	1925 Bldg.	30	XRF	12/4/97	1	Stairwell-1	Door	Cracked	Metal	0.17
399	1925 Bldg.	33	XRF	12/4/97	1	Stairwell-1	Door	Solid	Metal	0.01
400	1925 Bldg.	27	XRF	12/4/97	1	Stairwell-1	Stairs	Solid	Wood	0
401	1925 Bldg.	28	XRF	12/4/97	1	Stairwell-1	Stairs	Peeling	Concrete	0.07
402	1925 Bldg.	31	XRF	12/4/97	1	Stairwell-1	Stairs	Peeling	Metal	>>5.0
403	1925 Bldg.	25	XRF	12/4/97	1	Stairwell-1	Wall	Solid	Wood	0
404	1925 Bldg.	26	XRF	12/4/97	1	Stairwell-1	Wall	Solid	Plaster	2.57
405	1925 Bldg.	23	XRF	12/4/97	1	Stairwell-1	Window	Solid	Metal	0
406	1925 Bldg.	32	XRF	12/4/97	1	Stairwell-1	Window	Solid	Wood	0.03
407	1925 Bldg.	24	XRF	12/4/97	1	Stairwell-1		Peeling	Metal	2.37
408	1925 Bldg.	34	XRF	12/4/97	1	Stairwell-2	Door	Solid	Metal	0
409	1925 Bldg.	35	XRF	12/4/97	1	Stairwell-2	Door	Solid	Wood	0.14
410	1925 Bldg.	37	XRF	12/4/97	1	Stairwell-2	Door	Cracked	Metal	0.24
411	1925 Bldg.	38	XRF	12/4/97	1	Stairwell-2	Door	Solid	Metal	0.24
412	1925 Bldg.	39	XRF	12/4/97	1	Stairwell-2	Stairs	Peeling	Wood	0
413	1925 Bldg.	40	XRF	12/4/97	1	Stairwell-2	Stairs	Solid	Plaster	0.05
414	1925 Bldg.	41	XRF	12/4/97	1	Stairwell-2	Stairs	Peeling	Concrete	0.02
415	1925 Bldg.	43	XRF	12/4/97	1	Stairwell-2	Stairs	Solid	Metal	>>5.0
416	1925 Bldg.	36	XRF	12/4/97	1	Stairwell-2	Wall	Solid	Plaster	1.25
417	1925 Bldg.	42	XRF	12/4/97	1	Stairwell-2	Wall	Solid	Wood	0.01
418	1925 Bldg.	44	XRF	12/4/97	1	Stairwell-2		Cracked	Metal	2.28
419	1926 Bldg.	149	XRF	12/24/97	1	Auditorium-1	Chair	Solid	Wood	0
420	1926 Bldg.	137	XRF	12/24/97	1	Auditorium-1	Door	Solid	Metal	0.44
421	1926 Bldg.	139	XRF	12/24/97	1	Auditorium-1	Door	Cracked	Metal	0.13
422	1926 Bldg.	140	XRF	12/24/97	1	Auditorium-1	Door	Cracked	Metal	0.06
423	1926 Bldg.	142	XRF	12/24/97	1	Auditorium-1	Door	Solid	Metal	0.34
424	1926 Bldg.	146	XRF	12/24/97	1	Auditorium-1	Door	Solid	Wood	0.03
425	1926 Bldg.	150	XRF	12/24/97	1	Auditorium-1	Door	Solid	Metal	0

Saint Paul Public Schools
 Webster Enrichment School
 Lead-Based Paint Inspection

	A	B	C	D	E	F	G	H	I	J
3	Site	Sample#	Analysis	Date	Floor	Area	Component	Condition	Substrate	Result
426	1926 Bldg.	141	XRF	12/24/97	1	Auditorium-1	Floor	Solid	Wood	0
427	1926 Bldg.	132	XRF	12/24/97	1	Auditorium-1	Wall	Solid	Plaster	4.03
428	1926 Bldg.	133	XRF	12/24/97	1	Auditorium-1	Wall	Solid	Drywall	0.01
429	1926 Bldg.	135	XRF	12/24/97	1	Auditorium-1	Wall	Solid	Concrete	0.01
430	1926 Bldg.	136	XRF	12/24/97	1	Auditorium-1	Wall	Peeling	Wood	0.05
431	1926 Bldg.	138	XRF	12/24/97	1	Auditorium-1	Wall	Solid	Drywall	0
432	1926 Bldg.	144	XRF	12/24/97	1	Auditorium-1	Wall	Peeling	Wood	0.02
433	1926 Bldg.	145	XRF	12/24/97	1	Auditorium-1	Wall	Solid	Plaster	>>5.0
434	1926 Bldg.	147	XRF	12/24/97	1	Auditorium-1	Wall	Solid	Wood	0.08
435	1926 Bldg.	148	XRF	12/24/97	1	Auditorium-1	Wall	Solid	Plaster	>>5.0
436	1926 Bldg.	152	XRF	12/24/97	1	Auditorium-1	Wall	Solid	Plaster	>4.08
437	1926 Bldg.	143	XRF	12/24/97	1	Auditorium-1	Window	Cracked	Wood	0.06
438	1926 Bldg.	134	XRF	12/24/97	1	Auditorium-1		Peeling	Metal	>0.05
439	1926 Bldg.	151	XRF	12/24/97	1	Auditorium-1		Peeling	Metal	>3.68
440	1926 Bldg.	7	XRF	12/16/97	1	Classroom-101W	Bookcase	Solid	Wood	0.09
441	1926 Bldg.	6	XRF	12/16/97	1	Classroom-101W	Cabinet	Solid	Wood	0
442	1926 Bldg.	11	XRF	12/16/97	1	Classroom-101W	Chalkboard	Peeling	Wood	0.03
443	1926 Bldg.	9	XRF	12/16/97	1	Classroom-101W	Door	Solid	Wood	0.01
444	1926 Bldg.	10	XRF	12/16/97	1	Classroom-101W	Door	Solid	Wood	0.02
445	1926 Bldg.	8	XRF	12/16/97	1	Classroom-101W	Wall	Cracked	Plaster	>>5.0
446	1926 Bldg.	12	XRF	12/16/97	1	Classroom-101W	Window	Solid	Metal	0.42
447	1926 Bldg.	14	XRF	12/16/97	1	Classroom-101W	Window	Solid	Tile	0.69
448	1926 Bldg.	13	XRF	12/16/97	1	Classroom-101W		Peeling	Metal	>1.41
449	1926 Bldg.	15	XRF	12/16/97	1	Classroom-102	Wall	Cracked	Plaster	>>5.0
450	1926 Bldg.	16	XRF	12/16/97	1	Classroom-102	Wall	Solid	Plaster	0.12
451	1926 Bldg.	17	XRF	12/16/97	1	Classroom-103	Cabinet	Solid	Wood	0.01
452	1926 Bldg.	72	XRF	1/20/98	1	Classroom-103	Ceiling	Solid	Plaster	0.09
453	1926 Bldg.	19	XRF	12/16/97	1	Classroom-103	Door	Solid	Wood	0.02
454	1926 Bldg.	20	XRF	12/16/97	1	Classroom-103	Door	Solid	Wood	0.01
455	1926 Bldg.	18	XRF	12/16/97	1	Classroom-103	Wall	Solid	Plaster	>>5.0
456	1926 Bldg.	21	XRF	12/16/97	1	Classroom-103	Wall	Solid	Plaster	0.26
457	1926 Bldg.	23	XRF	12/16/97	1	Classroom-103	Wall	Solid	Plaster	3.54
458	1926 Bldg.	22	XRF	12/16/97	1	Classroom-103		Peeling	Metal	0.01
459	1926 Bldg.	75	XRF	1/20/98	1	Classroom-104A	Ceiling	Solid	Plaster	0.04
460	1926 Bldg.	156	XRF	12/24/97	1	Classroom-104A	Door	Solid	Metal	0.12
461	1926 Bldg.	153	XRF	12/24/97	1	Classroom-104A	Wall	Solid	Drywall	0
462	1926 Bldg.	154	XRF	12/24/97	1	Classroom-104A	Wall	Solid	Plaster	>>5.0
463	1926 Bldg.	155	XRF	12/24/97	1	Classroom-104A	Wall	Solid	Wood	0.02
464	1926 Bldg.	157	XRF	12/24/97	1	Classroom-104A	Wall	Solid	Tile	>>5.0
465	1926 Bldg.	161	XRF	12/24/97	1	Classroom-104B	Cabinet	Solid	Wood	0.02
466	1926 Bldg.	76	XRF	1/20/98	1	Classroom-104B	Ceiling	Solid	Plaster	0.02
467	1926 Bldg.	162	XRF	12/24/97	1	Classroom-104B	Door	Solid	Wood	0
468	1926 Bldg.	163	XRF	12/24/97	1	Classroom-104B	Door	Solid	Wood	0
469	1926 Bldg.	158	XRF	12/24/97	1	Classroom-104B	Wall	Solid	Drywall	>0.02
470	1926 Bldg.	160	XRF	12/24/97	1	Classroom-104B	Wall	Solid	Plaster	>3.33
471	1926 Bldg.	159	XRF	12/24/97	1	Classroom-104B	Water Pipe	Peeling	Metal	0.27
472	1926 Bldg.	77	XRF	1/20/98	1	Classroom-104C	Ceiling	Solid	Plaster	0.05
473	1926 Bldg.	170	XRF	12/24/97	1	Classroom-104C	Chalkboard	Peeling	Wood	0.02
474	1926 Bldg.	165	XRF	12/24/97	1	Classroom-104C	Door	Solid	Wood	0
475	1926 Bldg.	166	XRF	12/24/97	1	Classroom-104C	Door	Solid	Wood	0.01
476	1926 Bldg.	169	XRF	12/24/97	1	Classroom-104C	Door	Solid	Metal	0
477	1926 Bldg.	164	XRF	12/24/97	1	Classroom-104C	Wall	Solid	Plaster	0.61
478	1926 Bldg.	168	XRF	12/24/97	1	Classroom-104C	Wall	Solid	Drywall	0

Saint Paul Public Schools
 Webster Enrichment School
 Lead-Based Paint Inspection

	A	B	C	D	E	F	G	H	I	J
3	Site	Sample#	Analysis	Date	Floor	Area	Component	Condition	Substrate	Result
479	1926 Bldg.	167	XRF	12/24/97	1	Classroom-104C	Water Pipe	Peeling	Metal	0.02
480	1926 Bldg.	78	XRF	1/20/98	1	Classroom-105F	Ceiling	Peeling	Plaster	0.03
481	1926 Bldg.	16	XRF	1/2/98	1	Classroom-105F	Door	Solid	Metal	0.01
482	1926 Bldg.	11	XRF	1/2/98	1	Classroom-105F	Wall	Peeling	Plaster	0.12
483	1926 Bldg.	13	XRF	1/2/98	1	Classroom-105F	Wall	Solid	Drywall	0
484	1926 Bldg.	15	XRF	1/2/98	1	Classroom-105F	Wall	Solid	Plaster	0.27
485	1926 Bldg.	12	XRF	1/2/98	1	Classroom-105F		Peeling	Metal	2.43
486	1926 Bldg.	14	XRF	1/2/98	1	Classroom-105F		Solid	Metal	0
487	1926 Bldg.	80	XRF	1/20/98	1	Classroom-106	Ceiling	Solid	Plaster	0.03
488	1926 Bldg.	37	XRF	1/2/98	1	Classroom-106W	Cabinet	Solid	Wood	0.04
489	1926 Bldg.	36	XRF	1/2/98	1	Classroom-106W	Chalkboard	Cracked	Wood	0.03
490	1926 Bldg.	26	XRF	1/2/98	1	Classroom-106W	Door	Solid	Metal	0.34
491	1926 Bldg.	33	XRF	1/2/98	1	Classroom-106W	Door	Solid	Wood	0.07
492	1926 Bldg.	34	XRF	1/2/98	1	Classroom-106W	Door	Peeling	Wood	0.06
493	1926 Bldg.	28	XRF	1/2/98	1	Classroom-106W	Lathe	Peeling	Metal	1.81
494	1926 Bldg.	27	XRF	1/2/98	1	Classroom-106W	Saber Sun	Peeling	Metal	0.68
495	1926 Bldg.	25	XRF	1/2/98	1	Classroom-106W	Wall	Peeling	Plaster	0
496	1926 Bldg.	32	XRF	1/2/98	1	Classroom-106W	Wall	Solid	Plaster	>>5.0
497	1926 Bldg.	35	XRF	1/2/98	1	Classroom-106W	Wall	Cracked	Wood	0
498	1926 Bldg.	29	XRF	1/2/98	1	Classroom-106W	Water Pipe	Peeling	Metal	1.44
499	1926 Bldg.	30	XRF	1/2/98	1	Classroom-106W	Water Pipe	Peeling	Metal	1.76
500	1926 Bldg.	24	XRF	1/2/98	1	Classroom-106W		Peeling	Metal	1.98
501	1926 Bldg.	31	XRF	1/2/98	1	Classroom-106W		Solid	Metal	0.06
502	1926 Bldg.	38	XRF	1/7/98	2	Classroom-200W	Door	Solid	Metal	0.9
503	1926 Bldg.	39	XRF	1/7/98	2	Classroom-200W	Door	Solid	Metal	0.73
504	1926 Bldg.	45	XRF	1/7/98	2	Classroom-200W	Door	Solid	Metal	0.41
505	1926 Bldg.	36	XRF	1/7/98	2	Classroom-200W	Wall	Solid	Wood	>>5.0
506	1926 Bldg.	37	XRF	1/7/98	2	Classroom-200W	Wall	Solid	Drywall	0.01
507	1926 Bldg.	40	XRF	1/7/98	2	Classroom-200W	Wall	Solid	Plaster	>>5.0
508	1926 Bldg.	41	XRF	1/7/98	2	Classroom-200W	Wall	Cracked	Plaster	0.11
509	1926 Bldg.	42	XRF	1/7/98	2	Classroom-200W	Wall	Solid	Plaster	>>5.0
510	1926 Bldg.	43	XRF	1/7/98	2	Classroom-200W	Wall	Solid	Plaster	>0.25
511	1926 Bldg.	44	XRF	1/7/98	2	Classroom-200W	Wall	Solid	Drywall	0
512	1926 Bldg.	34	XRF	1/7/98	2	Classroom-200W	Window	Cracked	Wood	0.06
513	1926 Bldg.	35	XRF	1/7/98	2	Classroom-200W	Window	Cracked	Wood	0.04
514	1926 Bldg.	10	XRF	1/6/98	2	Classroom-201W	Cabinet	Solid	Wood	0.03
515	1926 Bldg.	12	XRF	1/6/98	2	Classroom-201W	Cabinet	Solid	Tile	0.03
516	1926 Bldg.	8	XRF	1/6/98	2	Classroom-201W	Chalkboard	Peeling	Wood	0
517	1926 Bldg.	6	XRF	1/6/98	2	Classroom-201W	Door	Solid	Wood	0
518	1926 Bldg.	7	XRF	1/6/98	2	Classroom-201W	Door	Solid	Wood	0.01
519	1926 Bldg.	9	XRF	1/6/98	2	Classroom-201W	File cabinet	Solid	Metal	0.01
520	1926 Bldg.	13	XRF	1/6/98	2	Classroom-201W	Wall	Solid	Plaster	>3.56
521	1926 Bldg.	14	XRF	1/6/98	2	Classroom-201W	Wall	Solid	Plaster	0.07
522	1926 Bldg.	11	XRF	1/6/98	2	Classroom-201W		Peeling	Metal	1.05
523	1926 Bldg.	60	XRF	1/20/98	1	Classroom-202	Ceiling	Solid	Plaster	0.22
524	1926 Bldg.	20	XRF	1/6/98	2	Classroom-202W	Bookcase	Solid	Wood	0
525	1926 Bldg.	16	XRF	1/6/98	2	Classroom-202W	Cabinet	Solid	Wood	0.01
526	1926 Bldg.	17	XRF	1/6/98	2	Classroom-202W	Cabinet	Solid	Wood	0.07
527	1926 Bldg.	24	XRF	1/6/98	2	Classroom-202W	Chalkboard	Cracked	Wood	0.06
528	1926 Bldg.	15	XRF	1/6/98	2	Classroom-202W	Door	Solid	Wood	0
529	1926 Bldg.	18	XRF	1/6/98	2	Classroom-202W	Door	Solid	Wood	0
530	1926 Bldg.	19	XRF	1/6/98	2	Classroom-202W	Wall	Solid	Plaster	0.13
531	1926 Bldg.	22	XRF	1/6/98	2	Classroom-202W	Wall	Solid	Plaster	>3.33

Saint Paul Public Schools
 Webster Enrichment School
 Lead-Based Paint Inspection

	A	B	C	D	E	F	G	H	I	J
3	Site	Sample#	Analysis	Date	Floor	Area	Component	Condition	Substrate	Result
532	1926 Bldg.	23	XRF	1/6/98	2	Classroom-202W	Wall	Solid	Plaster	0.14
533	1926 Bldg.	21	XRF	1/6/98	2	Classroom-202W		Peeling	Metal	1.64
534	1926 Bldg.	61	XRF	1/20/98	1	Classroom-203	Ceiling	Solid	Plaster	0.11
535	1926 Bldg.	27	XRF	1/6/98	2	Classroom-203W	Cabinet	Solid	Wood	0.03
536	1926 Bldg.	28	XRF	1/6/98	2	Classroom-203W	Cabinet	Solid	Wood	0
537	1926 Bldg.	32	XRF	1/6/98	2	Classroom-203W	Cabinet	Peeling	Wood	0
538	1926 Bldg.	30	XRF	1/6/98	2	Classroom-203W	Chalkboard	Solid	Wood	0.01
539	1926 Bldg.	25	XRF	1/6/98	2	Classroom-203W	Door	Solid	Wood	0.01
540	1926 Bldg.	29	XRF	1/6/98	2	Classroom-203W	Door	Solid	Wood	0
541	1926 Bldg.	26	XRF	1/6/98	2	Classroom-203W	Wall	Solid	Plaster	2.96
542	1926 Bldg.	31	XRF	1/6/98	2	Classroom-203W	Wall	Solid	Plaster	0.2
543	1926 Bldg.	34	XRF	1/6/98	2	Classroom-203W	Wall	Solid	Plaster	3.16
544	1926 Bldg.	33	XRF	1/6/98	2	Classroom-203W		Peeling	Metal	0.59
545	1926 Bldg.	62	XRF	1/20/98	1	Classroom-204	Ceiling	Solid	Plaster	0.07
546	1926 Bldg.	43	XRF	1/6/98	2	Classroom-204W	Cabinet	Solid	Wood	0
547	1926 Bldg.	46	XRF	1/6/98	2	Classroom-204W	Chalkboard	Peeling	Wood	0.04
548	1926 Bldg.	36	XRF	1/6/98	2	Classroom-204W	Door	Solid	Wood	0.03
549	1926 Bldg.	37	XRF	1/6/98	2	Classroom-204W	Door	Solid	Wood	0.02
550	1926 Bldg.	40	XRF	1/6/98	2	Classroom-204W	Floor	Solid	Wood	0
551	1926 Bldg.	35	XRF	1/6/98	2	Classroom-204W	Wall	Solid	Plaster	2.85
552	1926 Bldg.	38	XRF	1/6/98	2	Classroom-204W	Wall	Solid	Plaster	0.17
553	1926 Bldg.	41	XRF	1/6/98	2	Classroom-204W	Wall	Solid	Plaster	0.27
554	1926 Bldg.	42	XRF	1/6/98	2	Classroom-204W	Wall	Solid	Plaster	0.29
555	1926 Bldg.	45	XRF	1/6/98	2	Classroom-204W	Wall	Solid	Plaster	0.03
556	1926 Bldg.	39	XRF	1/6/98	2	Classroom-204W	Window	Solid	Wood	0.02
557	1926 Bldg.	44	XRF	1/6/98	2	Classroom-204W		Peeling	Metal	0.52
558	1926 Bldg.	65	XRF	1/20/98	1	Classroom-205	Ceiling	Solid	Plaster	0.02
559	1926 Bldg.	80	XRF	1/6/98	2	Classroom-205W	Cabinet	Solid	Wood	0.02
560	1926 Bldg.	81	XRF	1/6/98	2	Classroom-205W	Cabinet	Solid	Wood	0.09
561	1926 Bldg.	73	XRF	1/6/98	2	Classroom-205W	Chalkboard	Cracked	Wood	0.04
562	1926 Bldg.	78	XRF	1/6/98	2	Classroom-205W	Door	Cracked	Wood	0.04
563	1926 Bldg.	79	XRF	1/6/98	2	Classroom-205W	Door	Solid	Wood	0.03
564	1926 Bldg.	75	XRF	1/6/98	2	Classroom-205W	Wall	Solid	Plaster	3.93
565	1926 Bldg.	76	XRF	1/6/98	2	Classroom-205W	Wall	Solid	Plaster	0.14
566	1926 Bldg.	77	XRF	1/6/98	2	Classroom-205W	Wall	Solid	Plaster	>>5.0
567	1926 Bldg.	74	XRF	1/6/98	2	Classroom-205W		Peeling	Metal	0.22
568	1926 Bldg.	66	XRF	1/20/98	1	Classroom-206	Ceiling	Solid	Plaster	0.05
569	1926 Bldg.	89	XRF	1/6/98	2	Classroom-206W	Cabinet	Solid	Wood	0.03
570	1926 Bldg.	90	XRF	1/6/98	2	Classroom-206W	Cabinet	Solid	Wood	0.02
571	1926 Bldg.	85	XRF	1/6/98	2	Classroom-206W	Chalkboard	Cracked	Wood	0.07
572	1926 Bldg.	86	XRF	1/6/98	2	Classroom-206W	Door	Solid	Wood	0.02
573	1926 Bldg.	87	XRF	1/6/98	2	Classroom-206W	Door	Solid	Wood	0.01
574	1926 Bldg.	82	XRF	1/6/98	2	Classroom-206W	Wall	Solid	Plaster	>0.10
575	1926 Bldg.	83	XRF	1/6/98	2	Classroom-206W	Wall	Solid	Plaster	0.26
576	1926 Bldg.	88	XRF	1/6/98	2	Classroom-206W	Wall	Solid	Plaster	4.29
577	1926 Bldg.	84	XRF	1/6/98	2	Classroom-206W		Peeling	Metal	0.52
578	1926 Bldg.	68	XRF	1/20/98	1	Classroom-207	Ceiling	Solid	Plaster	0.07
579	1926 Bldg.	17	XRF	1/7/98	2	Classroom-207W	Cabinet	Solid	Wood	0.02
580	1926 Bldg.	18	XRF	1/7/98	2	Classroom-207W	Cabinet	Cracked	Wood	0.03
581	1926 Bldg.	23	XRF	1/7/98	2	Classroom-207W	Cabinet	Solid	Metal	0.33
582	1926 Bldg.	24	XRF	1/7/98	2	Classroom-207W	Chalkboard	Peeling	Wood	0.05
583	1926 Bldg.	21	XRF	1/7/98	2	Classroom-207W	Door	Cracked	Wood	0.01
584	1926 Bldg.	22	XRF	1/7/98	2	Classroom-207W	Door	Cracked	Wood	0.02

Saint Paul Public Schools
 Webster Enrichment School
 Lead-Based Paint Inspection

	A	B	C	D	E	F	G	H	I	J
3	Site	Sample#	Analysis	Date	Floor	Area	Component	Condition	Substrate	Result
585	1926 Bldg.	20	XRF	1/7/98	2	Classroom-207W	End Table	Peeling	Plastic	3.67
586	1926 Bldg.	16	XRF	1/7/98	2	Classroom-207W	Wall	Solid	Plaster	>>5.0
587	1926 Bldg.	19	XRF	1/7/98	2	Classroom-207W	Wall	Peeling	Plaster	>>5.0
588	1926 Bldg.	15	XRF	1/7/98	2	Classroom-207W		Peeling	Metal	>0.59
589	1926 Bldg.	69	XRF	1/20/98	1	Classroom-208	Ceiling	Solid	Plaster	0.02
590	1926 Bldg.	11	XRF	1/7/98	2	Classroom-208W	Cabinet	Solid	Wood	0.02
591	1926 Bldg.	12	XRF	1/7/98	2	Classroom-208W	Cabinet	Solid	Wood	0.03
592	1926 Bldg.	9	XRF	1/7/98	2	Classroom-208W	Door	Cracked	Wood	0
593	1926 Bldg.	10	XRF	1/7/98	2	Classroom-208W	Door	Solid	Wood	0.01
594	1926 Bldg.	7	XRF	1/7/98	2	Classroom-208W	Wall	Solid	Plaster	0.07
595	1926 Bldg.	8	XRF	1/7/98	2	Classroom-208W	Wall	Solid	Plaster	4.28
596	1926 Bldg.	13	XRF	1/7/98	2	Classroom-208W	Wall	Solid	Plaster	0.07
597	1926 Bldg.	14	XRF	1/7/98	2	Classroom-208W	Wall	Solid	Wood	0
598	1926 Bldg.	6	XRF	1/7/98	2	Classroom-208W		Peeling	Metal	0.6
599	1926 Bldg.	70	XRF	1/20/98	1	Classroom-209	Ceiling	Solid	Plaster	0.08
600	1926 Bldg.	31	XRF	1/7/98	2	Classroom-209W	Cabinet	Solid	Wood	0.02
601	1926 Bldg.	32	XRF	1/7/98	2	Classroom-209W	Cabinet	Peeling	Wood	0.03
602	1926 Bldg.	29	XRF	1/7/98	2	Classroom-209W	Door	Solid	Wood	0
603	1926 Bldg.	30	XRF	1/7/98	2	Classroom-209W	Door	Solid	Wood	0.01
604	1926 Bldg.	26	XRF	1/7/98	2	Classroom-209W	Wall	Solid	Wood	0
605	1926 Bldg.	27	XRF	1/7/98	2	Classroom-209W	Wall	Solid	Plaster	0.01
606	1926 Bldg.	28	XRF	1/7/98	2	Classroom-209W	Wall	Solid	Plaster	>>5.0
607	1926 Bldg.	33	XRF	1/7/98	2	Classroom-209W	Wall	Peeling	Plaster	0.04
608	1926 Bldg.	25	XRF	1/7/98	2	Classroom-209W		Peeling	Metal	0.54
609	1926 Bldg.	67	XRF	1/6/98	2	Classroom-210W	Cabinet	Solid	Wood	0.01
610	1926 Bldg.	70	XRF	1/6/98	2	Classroom-210W	Door	Solid	Wood	0.01
611	1926 Bldg.	71	XRF	1/6/98	2	Classroom-210W	Door	Solid	Wood	0.02
612	1926 Bldg.	65	XRF	1/6/98	2	Classroom-210W	Wall	Solid	Plaster	0.21
613	1926 Bldg.	66	XRF	1/6/98	2	Classroom-210W	Wall	Solid	Plaster	>3.86
614	1926 Bldg.	68	XRF	1/6/98	2	Classroom-210W	Wall	Cracked	Wood	0.04
615	1926 Bldg.	72	XRF	1/6/98	2	Classroom-210W	Wall	Cracked	Plaster	>>5.0
616	1926 Bldg.	69	XRF	1/6/98	2	Classroom-210W		Peeling	Metal	1.97
617	1926 Bldg.	26	XRF	1/9/98	1	Classroom-240	Wall	Solid	Plaster	0.03
618	1926 Bldg.	27	XRF	1/9/98	1	Classroom-240	Wall	Solid	Plaster	0.06
619	1926 Bldg.	28	XRF	1/9/98	1	Classroom-240	Wall	Solid	Drywall	0
620	1926 Bldg.	29	XRF	1/9/98	1	Classroom-240	Wall	Solid	Metal	0.26
621	1926 Bldg.	31	XRF	1/9/98	1	Classroom-240	Wall	Solid	Wood	0.01
622	1926 Bldg.	30	XRF	1/9/98	1	Classroom-240		Peeling	Metal	3.16
623	1926 Bldg.	18	XRF	1/9/98	0	Classroom-30	Door	Peeling	Metal	0.37
624	1926 Bldg.	15	XRF	1/9/98	0	Classroom-30	Wall	Solid	Drywall	0
625	1926 Bldg.	16	XRF	1/9/98	0	Classroom-30	Wall	Solid	Plaster	>1.85
626	1926 Bldg.	17	XRF	1/9/98	0	Classroom-30	Wall	Solid	Drywall	0
627	1926 Bldg.	46	XRF	1/20/98	1	Classroom-301	Ceiling	Solid	Plaster	0.1
628	1926 Bldg.	52	XRF	12/10/97	3	Classroom-301W	Bookcase	Peeling	Wood	0.08
629	1926 Bldg.	58	XRF	12/10/97	3	Classroom-301W	Bookcase	Peeling	Wood	0
630	1926 Bldg.	59	XRF	12/10/97	3	Classroom-301W	Bookcase	Solid	Wood	0
631	1926 Bldg.	51	XRF	12/10/97	3	Classroom-301W	Cabinet	Solid	Wood	0.01
632	1926 Bldg.	56	XRF	12/10/97	3	Classroom-301W	Chalkboard	Peeling	Wood	0.04
633	1926 Bldg.	53	XRF	12/10/97	3	Classroom-301W	Door	Solid	Wood	0.02
634	1926 Bldg.	54	XRF	12/10/97	3	Classroom-301W	Door	Solid	Wood	0.01
635	1926 Bldg.	50	XRF	12/10/97	3	Classroom-301W	Wall	Solid	Plaster	3.64
636	1926 Bldg.	55	XRF	12/10/97	3	Classroom-301W	Wall	Cracked	Plaster	3.14
637	1926 Bldg.	57	XRF	12/10/97	3	Classroom-301W		Peeling	Metal	0.03

Saint Paul Public Schools
 Webster Enrichment School
 Lead-Based Paint Inspection

	A	B	C	D	E	F	G	H	I	J
3	Site	Sample#	Analysis	Date	Floor	Area	Component	Condition	Substrate	Result
638	1926 Bldg.	47	XRF	1/20/98	1	Classroom-302	Ceiling	Solid	Plaster	0.25
639	1926 Bldg.	63	XRF	12/10/97	3	Classroom-302W	Cabinet	Solid	Wood	0.01
640	1926 Bldg.	64	XRF	12/10/97	3	Classroom-302W	Chalkboard	Cracked	Wood	0.06
641	1926 Bldg.	61	XRF	12/10/97	3	Classroom-302W	Door	Solid	Wood	0
642	1926 Bldg.	62	XRF	12/10/97	3	Classroom-302W	Door	Solid	Wood	0.02
643	1926 Bldg.	60	XRF	12/10/97	3	Classroom-302W	Wall	Solid	Plaster	4.49
644	1926 Bldg.	66	XRF	12/10/97	3	Classroom-302W	Wall	Solid	Plaster	2.94
645	1926 Bldg.	65	XRF	12/10/97	3	Classroom-302W		Peeling	Metal	>0.72
646	1926 Bldg.	48	XRF	1/20/98	1	Classroom-303	Ceiling	Solid	Plaster	0.14
647	1926 Bldg.	70	XRF	12/10/97	3	Classroom-303W	Bookcase	Peeling	Wood	0.04
648	1926 Bldg.	74	XRF	12/10/97	3	Classroom-303W	Chalkboard	Peeling	Wood	0.05
649	1926 Bldg.	68	XRF	12/10/97	3	Classroom-303W	Door	Solid	Wood	0.01
650	1926 Bldg.	69	XRF	12/10/97	3	Classroom-303W	Door	Solid	Wood	0.01
651	1926 Bldg.	67	XRF	12/10/97	3	Classroom-303W	Wall	Solid	Plaster	>>5.0
652	1926 Bldg.	71	XRF	12/10/97	3	Classroom-303W	Wall	Solid	Plaster	3
653	1926 Bldg.	72	XRF	12/10/97	3	Classroom-303W	Wall	Solid	Wood	0.02
654	1926 Bldg.	73	XRF	12/10/97	3	Classroom-303W		Peeling	Metal	0.57
655	1926 Bldg.	49	XRF	1/20/98	1	Classroom-304	Ceiling	Solid	Plaster	0.13
656	1926 Bldg.	79	XRF	12/10/97	3	Classroom-304W	Cabinet	Peeling	Wood	0.01
657	1926 Bldg.	78	XRF	12/10/97	3	Classroom-304W	Chalkboard	Peeling	Wood	0.03
658	1926 Bldg.	80	XRF	12/10/97	3	Classroom-304W	Door	Cracked	Wood	0.02
659	1926 Bldg.	81	XRF	12/10/97	3	Classroom-304W	Door	Solid	Wood	0.02
660	1926 Bldg.	75	XRF	12/10/97	3	Classroom-304W	Wall	Solid	Plaster	3.58
661	1926 Bldg.	76	XRF	12/10/97	3	Classroom-304W	Wall	Peeling	Wood	0.01
662	1926 Bldg.	77	XRF	12/10/97	3	Classroom-304W		Peeling	Metal	>2.79
663	1926 Bldg.	50	XRF	1/20/98	1	Classroom-305	Ceiling	Solid	Plaster	0.23
664	1926 Bldg.	93	XRF	12/10/97	3	Classroom-305W	Chalkboard	Solid	Wood	0.07
665	1926 Bldg.	95	XRF	12/10/97	3	Classroom-305W	Door	Cracked	Wood	0.04
666	1926 Bldg.	96	XRF	12/10/97	3	Classroom-305W	Door	Solid	Wood	0.01
667	1926 Bldg.	91	XRF	12/10/97	3	Classroom-305W	Wall	Solid	Plaster	4.14
668	1926 Bldg.	94	XRF	12/10/97	3	Classroom-305W	Wall	Solid	Plaster	3.19
669	1926 Bldg.	92	XRF	12/10/97	3	Classroom-305W		Peeling	Metal	0.03
670	1926 Bldg.	51	XRF	1/20/98	1	Classroom-306	Ceiling	Solid	Plaster	0.31
671	1926 Bldg.	11	XRF	12/11/97	3	Classroom-306W	Door	Cracked	Wood	0.03
672	1926 Bldg.	12	XRF	12/11/97	3	Classroom-306W	Door	Solid	Wood	0.02
673	1926 Bldg.	6	XRF	12/11/97	3	Classroom-306W	Wall	Solid	Drywall	0
674	1926 Bldg.	8	XRF	12/11/97	3	Classroom-306W	Wall	Solid	Plaster	0.11
675	1926 Bldg.	9	XRF	12/11/97	3	Classroom-306W	Wall	Solid	Wood	0
676	1926 Bldg.	10	XRF	12/11/97	3	Classroom-306W	Wall	Peeling	Plaster	3.42
677	1926 Bldg.	7	XRF	12/11/97	3	Classroom-306W		Peeling	Metal	0.47
678	1926 Bldg.	52	XRF	1/20/98	1	Classroom-308	Ceiling	Cracked	Plaster	0.27
679	1926 Bldg.	15	XRF	12/11/97	3	Classroom-308W	Cabinet	Solid	Metal	0.42
680	1926 Bldg.	13	XRF	12/11/97	3	Classroom-308W	Wall	Solid	Wood	0
681	1926 Bldg.	16	XRF	12/11/97	3	Classroom-308W	Wall	Cracked	Plaster	0
682	1926 Bldg.	17	XRF	12/11/97	3	Classroom-308W	Wall	Solid	Drywall	0
683	1926 Bldg.	18	XRF	12/11/97	3	Classroom-308W	Wall	Solid	Drywall	0
684	1926 Bldg.	19	XRF	12/11/97	3	Classroom-308W	Wall	Solid	Plaster	0.03
685	1926 Bldg.	14	XRF	12/11/97	3	Classroom-308W		Peeling	Metal	4.22
686	1926 Bldg.	53	XRF	1/20/98	1	Classroom-309	Ceiling	Solid	Plaster	0.05
687	1926 Bldg.	27	XRF	12/11/97	3	Classroom-309W	Bookcase	Peeling	Wood	0.44
688	1926 Bldg.	28	XRF	12/11/97	3	Classroom-309W	Cabinet	Solid	Wood	0.02
689	1926 Bldg.	23	XRF	12/11/97	3	Classroom-309W	Chalkboard	Peeling	Wood	0.05
690	1926 Bldg.	25	XRF	12/11/97	3	Classroom-309W	Door	Cracked	Wood	0.02

Saint Paul Public Schools
 Webster Enrichment School
 Lead-Based Paint Inspection

	A	B	C	D	E	F	G	H	I	J
3	Site	Sample#	Analysis	Date	Floor	Area	Component	Condition	Substrate	Result
691	1926 Bldg.	26	XRF	12/11/97	3	Classroom-309W	Door	Solid	Wood	0.02
692	1926 Bldg.	20	XRF	12/11/97	3	Classroom-309W	Wall	Solid	Plaster	0.01
693	1926 Bldg.	21	XRF	12/11/97	3	Classroom-309W	Wall	Cracked	Wood	0.01
694	1926 Bldg.	24	XRF	12/11/97	3	Classroom-309W	Wall	Solid	Plaster	1.99
695	1926 Bldg.	22	XRF	12/11/97	3	Classroom-309W		Peeling	Metal	0.01
696	1926 Bldg.	54	XRF	1/20/98	1	Classroom-310	Ceiling	Solid	Plaster	0.19
697	1926 Bldg.	40	XRF	12/11/97	3	Classroom-310W	Bookcase	Peeling	Metal	0.02
698	1926 Bldg.	36	XRF	12/11/97	3	Classroom-310W	Chalkboard	Cracked	Wood	0.05
699	1926 Bldg.	37	XRF	12/11/97	3	Classroom-310W	Door	Cracked	Wood	0.01
700	1926 Bldg.	38	XRF	12/11/97	3	Classroom-310W	Door	Solid	Wood	0.01
701	1926 Bldg.	34	XRF	12/11/97	3	Classroom-310W	Wall	Peeling	Plaster	0.74
702	1926 Bldg.	35	XRF	12/11/97	3	Classroom-310W	Wall	Cracked	Plaster	0.13
703	1926 Bldg.	39	XRF	12/11/97	3	Classroom-310W	Window	Solid	Wood	0.01
704	1926 Bldg.	33	XRF	12/11/97	3	Classroom-310W		Peeling	Metal	>1.55
705	1926 Bldg.	55	XRF	1/20/98	1	Classroom-311	Ceiling	Peeling	Plaster	0.14
706	1926 Bldg.	46	XRF	12/11/97	3	Classroom-311W	Bookcase	Peeling	Wood	0.02
707	1926 Bldg.	43	XRF	12/11/97	3	Classroom-311W	Chalkboard	Cracked	Wood	0.06
708	1926 Bldg.	42	XRF	12/11/97	3	Classroom-311W	Door	Solid	Wood	0
709	1926 Bldg.	45	XRF	12/11/97	3	Classroom-311W	Door	Cracked	Wood	0.03
710	1926 Bldg.	44	XRF	12/11/97	3	Classroom-311W	Wall	Solid	Plaster	3.78
711	1926 Bldg.	47	XRF	12/11/97	3	Classroom-311W	Wall	Solid	Plaster	2.85
712	1926 Bldg.	41	XRF	12/11/97	3	Classroom-311W		Peeling	Metal	1.58
713	1926 Bldg.	56	XRF	1/20/98	1	Classroom-312	Ceiling	Cracked	Plaster	0.1
714	1926 Bldg.	54	XRF	12/11/97	3	Classroom-312W	Bookcase	Peeling	Wood	0.01
715	1926 Bldg.	49	XRF	12/11/97	3	Classroom-312W	Chalkboard	Peeling	Wood	0.03
716	1926 Bldg.	52	XRF	12/11/97	3	Classroom-312W	Door	Cracked	Wood	0.03
717	1926 Bldg.	53	XRF	12/11/97	3	Classroom-312W	Door	Solid	Wood	0.02
718	1926 Bldg.	50	XRF	12/11/97	3	Classroom-312W	Wall	Solid	Plaster	3.61
719	1926 Bldg.	51	XRF	12/11/97	3	Classroom-312W	Wall	Solid	Plaster	2.27
720	1926 Bldg.	48	XRF	12/11/97	3	Classroom-312W		Peeling	Metal	>1.73
721	1926 Bldg.	14	XRF	1/9/98	0	Classroom-40	Door	Peeling	Metal	0.38
722	1926 Bldg.	11	XRF	1/9/98	0	Classroom-40	Wall	Solid	Drywall	>0.06
723	1926 Bldg.	12	XRF	1/9/98	0	Classroom-40	Wall	Solid	Plaster	0.29
724	1926 Bldg.	13	XRF	1/9/98	0	Classroom-40	Wall	Solid	Drywall	0
725	1926 Bldg.	7	XRF	1/9/98	0	Classroom-50	Door	Solid	Metal	0.34
726	1926 Bldg.	9	XRF	1/9/98	0	Classroom-50	Door	Solid	Wood	0.01
727	1926 Bldg.	10	XRF	1/9/98	0	Classroom-50	Door	Solid	Wood	0.02
728	1926 Bldg.	6	XRF	1/9/98	0	Classroom-50	Wall	Solid	Drywall	0
729	1926 Bldg.	8	XRF	1/9/98	0	Classroom-50	Wall	Solid	Plaster	0
730	1926 Bldg.	39	XRF	1/2/98	1	Gym-2	Door	Peeling	Wood	0.02
731	1926 Bldg.	41	XRF	1/2/98	1	Gym-2	Door	Solid	Metal	0.17
732	1926 Bldg.	42	XRF	1/2/98	1	Gym-2	Door	Peeling	Wood	0.08
733	1926 Bldg.	43	XRF	1/2/98	1	Gym-2	Door	Solid	Wood	0.01
734	1926 Bldg.	44	XRF	1/2/98	1	Gym-2	Door	Cracked	Wood	0
735	1926 Bldg.	46	XRF	1/2/98	1	Gym-2	Floor	Solid	Wood	0
736	1926 Bldg.	47	XRF	1/2/98	1	Gym-2	Floor	Solid	Wood	0
737	1926 Bldg.	48	XRF	1/2/98	1	Gym-2	Floor	Solid	Wood	0
738	1926 Bldg.	49	XRF	1/2/98	1	Gym-2	Floor	Solid	Wood	0.2
739	1926 Bldg.	38	XRF	1/2/98	1	Gym-2	Wall	Solid	Plaster	0.03
740	1926 Bldg.	40	XRF	1/2/98	1	Gym-2	Wall	Peeling	Metal	0.28
741	1926 Bldg.	45	XRF	1/2/98	1	Gym-2	Wall	Solid	Concrete	0.02
742	1926 Bldg.	73	XRF	1/20/98	1	Hall-4	Ceiling	Peeling	Plaster	0.05
743	1926 Bldg.	62	XRF	1/2/98	1	Hall-4	Chalkboard	Solid	Wood	0.03

Saint Paul Public Schools
 Webster Enrichment School
 Lead-Based Paint Inspection

	A	B	C	D	E	F	G	H	I	J
3	Site	Sample#	Analysis	Date	Floor	Area	Component	Condition	Substrate	Result
744	1926 Bldg.	52	XRF	1/2/98	1	Hall-4	Door	Solid	Wood	0.81
745	1926 Bldg.	53	XRF	1/2/98	1	Hall-4	Door	Solid	Wood	0.11
746	1926 Bldg.	55	XRF	1/2/98	1	Hall-4	Door	Solid	Wood	0.03
747	1926 Bldg.	56	XRF	1/2/98	1	Hall-4	Door	Solid	Wood	0.04
748	1926 Bldg.	57	XRF	1/2/98	1	Hall-4	Door	Solid	Metal	0.01
749	1926 Bldg.	59	XRF	1/2/98	1	Hall-4	Door	Solid	Metal	0.16
750	1926 Bldg.	60	XRF	1/2/98	1	Hall-4	Door	Solid	Metal	0.15
751	1926 Bldg.	51	XRF	1/2/98	1	Hall-4	Wall	Solid	Plaster	0.14
752	1926 Bldg.	54	XRF	1/2/98	1	Hall-4	Wall	Peeling	Plaster	1.44
753	1926 Bldg.	58	XRF	1/2/98	1	Hall-4	Wall	Solid	Wood	0.02
754	1926 Bldg.	63	XRF	1/2/98	1	Hall-4	Window	Peeling	Metal	0.12
755	1926 Bldg.	64	XRF	1/2/98	1	Hall-4	Window	Solid	Metal	0.02
756	1926 Bldg.	50	XRF	1/2/98	1	Hall-4		Solid	Metal	0.26
757	1926 Bldg.	61	XRF	1/2/98	1	Hall-4		Solid	Metal	0.26
758	1926 Bldg.	71	XRF	1/20/98	1	Hall-5	Ceiling	Solid	Plaster	0.08
759	1926 Bldg.	69	XRF	1/2/98	2	Hall-5	Door	Solid	Wood	0.02
760	1926 Bldg.	70	XRF	1/2/98	2	Hall-5	Door	Solid	Wood	0.02
761	1926 Bldg.	73	XRF	1/2/98	2	Hall-5	Door	Cracked	Metal	0.27
762	1926 Bldg.	74	XRF	1/2/98	2	Hall-5	Door	Peeling	Metal	0.12
763	1926 Bldg.	79	XRF	1/2/98	2	Hall-5	Door	Solid	Metal	0.41
764	1926 Bldg.	80	XRF	1/2/98	2	Hall-5	Door	Solid	Wood	0
765	1926 Bldg.	85	XRF	1/2/98	2	Hall-5	Door	Solid	Metal	0.01
766	1926 Bldg.	86	XRF	1/2/98	2	Hall-5	Door	Solid	Metal	0
767	1926 Bldg.	88	XRF	1/2/98	2	Hall-5	Door	Solid	Metal	0.05
768	1926 Bldg.	71	XRF	1/2/98	2	Hall-5	Wall	Solid	Plaster	2.91
769	1926 Bldg.	72	XRF	1/2/98	2	Hall-5	Wall	Solid	Plaster	0.16
770	1926 Bldg.	75	XRF	1/2/98	2	Hall-5	Wall	Solid	Plaster	0.08
771	1926 Bldg.	76	XRF	1/2/98	2	Hall-5	Wall	Solid	Plaster	0.05
772	1926 Bldg.	77	XRF	1/2/98	2	Hall-5	Wall	Solid	Plaster	0.24
773	1926 Bldg.	78	XRF	1/2/98	2	Hall-5	Wall	Solid	Plaster	0.27
774	1926 Bldg.	81	XRF	1/2/98	2	Hall-5	Wall	Solid	Wood	0.03
775	1926 Bldg.	87	XRF	1/2/98	2	Hall-5	Wall	Solid	Drywall	0.01
776	1926 Bldg.	82	XRF	1/2/98	2	Hall-5	Window	Solid	Wood	0.05
777	1926 Bldg.	83	XRF	1/2/98	2	Hall-5	Window	Solid	Wood	0.03
778	1926 Bldg.	68	XRF	1/2/98	2	Hall-5		Peeling	Metal	0.24
779	1926 Bldg.	84	XRF	1/2/98	2	Hall-5		Solid	Metal	2.97
780	1926 Bldg.	57	XRF	1/20/98	1	Hall-6	Ceiling	Solid	Plaster	>1.65
781	1926 Bldg.	31	XRF	12/10/97	3	Hall-6	Chalkboard	Solid	Wood	0
782	1926 Bldg.	33	XRF	12/10/97	3	Hall-6	Door	Solid	Wood	0.04
783	1926 Bldg.	35	XRF	12/10/97	3	Hall-6	Door	Solid	Wood	0.02
784	1926 Bldg.	38	XRF	12/10/97	3	Hall-6	Door	Peeling	Wood	0
785	1926 Bldg.	40	XRF	12/10/97	3	Hall-6	Door	Peeling	Metal	0.54
786	1926 Bldg.	41	XRF	12/10/97	3	Hall-6	Door	Peeling	Metal	0.52
787	1926 Bldg.	29	XRF	12/10/97	3	Hall-6	Wall	Solid	Plaster	0.54
788	1926 Bldg.	30	XRF	12/10/97	3	Hall-6	Wall	Peeling	Metal	1.33
789	1926 Bldg.	34	XRF	12/10/97	3	Hall-6	Wall	Solid	Plaster	0.18
790	1926 Bldg.	36	XRF	12/10/97	3	Hall-6	Wall	Solid	Wood	0.03
791	1926 Bldg.	39	XRF	12/10/97	3	Hall-6	Wall	Solid	Plaster	2.28
792	1926 Bldg.	42	XRF	12/10/97	3	Hall-6	Wall	Peeling	Plaster	>2.08
793	1926 Bldg.	44	XRF	12/10/97	3	Hall-6	Wall	Solid	Wood	0.04
794	1926 Bldg.	43	XRF	12/10/97	3	Hall-6	Window	Solid	Wood	0
795	1926 Bldg.	45	XRF	12/10/97	3	Hall-6	Window	Solid	Wood	0.04
796	1926 Bldg.	32	XRF	12/10/97	3	Hall-6		Solid	Metal	0.22

Saint Paul Public Schools
 Webster Enrichment School
 Lead-Based Paint Inspection

	A	B	C	D	E	F	G	H	I	J
3	Site	Sample#	Analysis	Date	Floor	Area	Component	Condition	Substrate	Result
797	1926 Bldg.	37	XRF	12/10/97	3	Hall-6		Peeling	Metal	>2.09
798	1926 Bldg.	46	XRF	12/10/97	3	Hall-6		Peeling	Metal	0.02
799	1926 Bldg.	9	XRF	1/21/98	0	Hall-8	Door	Solid	Wood	0.02
800	1926 Bldg.	10	XRF	1/21/98	0	Hall-8	Door	Cracked	Wood	0.01
801	1926 Bldg.	11	XRF	1/21/98	0	Hall-8	Door	Solid	Metal	0.47
802	1926 Bldg.	15	XRF	1/21/98	0	Hall-8	Door	Peeling	Metal	>1.92
803	1926 Bldg.	16	XRF	1/21/98	0	Hall-8	Door	Peeling	Metal	>1.07
804	1926 Bldg.	6	XRF	1/21/98	0	Hall-8	Wall	Solid	Drywall	>0.02
805	1926 Bldg.	7	XRF	1/21/98	0	Hall-8	Wall	Solid	Plaster	0.22
806	1926 Bldg.	8	XRF	1/21/98	0	Hall-8	Wall	Solid	Wood	0.01
807	1926 Bldg.	12	XRF	1/21/98	0	Hall-8	Wall	Solid	Plaster	>0.17
808	1926 Bldg.	13	XRF	1/21/98	0	Hall-8	Wall	Cracked	Plaster	0.07
809	1926 Bldg.	14	XRF	1/21/98	0	Hall-8	Wall	Solid	Plaster	0.07
810	1926 Bldg.	79	XRF	1/20/98	1	Restroom-10	Ceiling	Solid	Plaster	>0.34
811	1926 Bldg.	17	XRF	1/2/98	1	Restroom-10F	Door	Solid	Wood	0.01
812	1926 Bldg.	22	XRF	1/2/98	1	Restroom-10F	Door	Solid	Wood	0.01
813	1926 Bldg.	23	XRF	1/2/98	1	Restroom-10F	Door	Solid	Wood	0.02
814	1926 Bldg.	20	XRF	1/2/98	1	Restroom-10F	Mirror Casing	Solid	Wood	0.03
815	1926 Bldg.	18	XRF	1/2/98	1	Restroom-10F	Wall	Solid	Wood	0.01
816	1926 Bldg.	19	XRF	1/2/98	1	Restroom-10F	Wall	Solid	Plaster	3.74
817	1926 Bldg.	21	XRF	1/2/98	1	Restroom-10F	Wall	Solid	Plaster	0.21
818	1926 Bldg.	63	XRF	1/20/98	1	Restroom-11	Ceiling	Solid	Plaster	0.07
819	1926 Bldg.	53	XRF	1/6/98	2	Restroom-11W	Door	Solid	Wood	0.01
820	1926 Bldg.	54	XRF	1/6/98	2	Restroom-11W	Door	Solid	Wood	0.02
821	1926 Bldg.	49	XRF	1/6/98	2	Restroom-11W	Mirror Casing	Solid	Wood	0.03
822	1926 Bldg.	47	XRF	1/6/98	2	Restroom-11W	Wall	Solid	Plaster	>2.57
823	1926 Bldg.	48	XRF	1/6/98	2	Restroom-11W	Wall	Solid	Plaster	>>5.0
824	1926 Bldg.	51	XRF	1/6/98	2	Restroom-11W	Wall	Solid	Wood	0
825	1926 Bldg.	52	XRF	1/6/98	2	Restroom-11W	Wall	Cracked	Wood	0.02
826	1926 Bldg.	50	XRF	1/6/98	2	Restroom-11W		Peeling	Metal	>4.08
827	1926 Bldg.	67	XRF	1/20/98	1	Restroom-12	Ceiling	Solid	Plaster	>1.05
828	1926 Bldg.	92	XRF	1/6/98	2	Restroom-12W	Door	Cracked	Wood	0.02
829	1926 Bldg.	96	XRF	1/6/98	2	Restroom-12W	Door	Cracked	Wood	0.02
830	1926 Bldg.	97	XRF	1/6/98	2	Restroom-12W	Door	Cracked	Wood	0.03
831	1926 Bldg.	91	XRF	1/6/98	2	Restroom-12W	Wall	Solid	Plaster	>0.66
832	1926 Bldg.	93	XRF	1/6/98	2	Restroom-12W	Wall	Solid	Wood	0.09
833	1926 Bldg.	94	XRF	1/6/98	2	Restroom-12W	Wall	Solid	Plaster	>>5.0
834	1926 Bldg.	95	XRF	1/6/98	2	Restroom-12W	Wall	Solid	Plaster	>>5.0
835	1926 Bldg.	19	XRF	1/9/98	1	Restroom-17	Door	Solid	Metal	0.1
836	1926 Bldg.	20	XRF	1/9/98	1	Restroom-17	Door	Solid	Metal	0.28
837	1926 Bldg.	21	XRF	1/9/98	1	Restroom-17	Wall	Solid	Plaster	0.07
838	1926 Bldg.	24	XRF	1/9/98	1	Restroom-18	Door	Solid	Metal	0.38
839	1926 Bldg.	25	XRF	1/9/98	1	Restroom-18	Door	Solid	Metal	0.05
840	1926 Bldg.	22	XRF	1/9/98	1	Restroom-18	Wall	Solid	Plaster	0
841	1926 Bldg.	23	XRF	1/9/98	1	Restroom-18	Wall	Solid	Metal	0.14
842	1926 Bldg.	59	XRF	1/20/98	1	Restroom-5	Ceiling	Solid	Plaster	>0.74
843	1926 Bldg.	88	XRF	12/10/97	3	Restroom-5W	Door	Cracked	Wood	0.03
844	1926 Bldg.	89	XRF	12/10/97	3	Restroom-5W	Door	Solid	Wood	0.04
845	1926 Bldg.	90	XRF	12/10/97	3	Restroom-5W	Door	Peeling	Wood	0.01
846	1926 Bldg.	82	XRF	12/10/97	3	Restroom-5W	Wall	Solid	Plaster	>>5.0
847	1926 Bldg.	83	XRF	12/10/97	3	Restroom-5W	Wall	Solid	Wood	0.17
848	1926 Bldg.	85	XRF	12/10/97	3	Restroom-5W	Wall	Solid	Plaster	0.07
849	1926 Bldg.	86	XRF	12/10/97	3	Restroom-5W	Wall	Solid	Plaster	3.86

Saint Paul Public Schools
 Webster Enrichment School
 Lead-Based Paint Inspection

A	B	C	D	E	F	G	H	I	J	
3	Site	Sample#	Analysis	Date	Floor	Area	Component	Condition	Substrate	Result
850	1926 Bldg.	87	XRF	12/10/97	3	Restroom-5W	Wall	Solid	Wood	0.02
851	1926 Bldg.	84	XRF	12/10/97	3	Restroom-5W		Peeling	Metal	0.07
852	1926 Bldg.	58	XRF	1/20/98	1	Restroom-6	Ceiling	Solid	Plaster	>1.31
853	1926 Bldg.	29	XRF	12/11/97	3	Restroom-6W	Wall	Cracked	Plaster	>2.13
854	1926 Bldg.	30	XRF	12/11/97	3	Restroom-6W	Wall	Solid	Wood	0
855	1926 Bldg.	31	XRF	12/11/97	3	Restroom-6W	Wall	Solid	Wood	0
856	1926 Bldg.	32	XRF	12/11/97	3	Restroom-6W	Wall	Solid	Plaster	>2.44
857	1926 Bldg.	74	XRF	1/20/98	1	Restroom-9	Ceiling	Solid	Plaster	0.36
858	1926 Bldg.	30	XRF	12/16/97	1	Restroom-9	Door	Solid	Wood	0.01
859	1926 Bldg.	31	XRF	12/16/97	1	Restroom-9	Door	Solid	Wood	0.03
860	1926 Bldg.	25	XRF	12/16/97	1	Restroom-9	Mirror	Solid	Wood	0.03
861	1926 Bldg.	24	XRF	12/16/97	1	Restroom-9	Wall	Solid	Wood	0.01
862	1926 Bldg.	27	XRF	12/16/97	1	Restroom-9	Wall	Solid	Plaster	0.1
863	1926 Bldg.	28	XRF	12/16/97	1	Restroom-9	Wall	Cracked	Wood	0.01
864	1926 Bldg.	29	XRF	12/16/97	1	Restroom-9	Wall	Solid	Plaster	>>5.0
865	1926 Bldg.	26	XRF	12/16/97	1	Restroom-9		Peeling	Metal	>>5.0
866	1926 Bldg.	17	XRF	1/21/98	0	Restroom - 18	Ceiling	Peeling	Plaster	0.56
867	1926 Bldg.	18	XRF	1/21/98	0	Restroom - 19	Ceiling	Peeling	Plaster	0.25
868	1926 Bldg.	63	XRF	1/6/98	2	Room-1	Bench	Solid	Wood	0.2
869	1926 Bldg.	61	XRF	1/6/98	2	Room-1	Bookcase	Peeling	Metal	0.01
870	1926 Bldg.	64	XRF	1/20/98	1	Room-1	Ceiling	Solid	Plaster	>0.47
871	1926 Bldg.	56	XRF	1/6/98	2	Room-1	Door	Solid	Wood	0
872	1926 Bldg.	57	XRF	1/6/98	2	Room-1	Door	Solid	Wood	0.02
873	1926 Bldg.	59	XRF	1/6/98	2	Room-1	Door	Solid	Wood	>>5.0
874	1926 Bldg.	60	XRF	1/6/98	2	Room-1	Door	Solid	Wood	>>5.0
875	1926 Bldg.	55	XRF	1/6/98	2	Room-1	Wall	Solid	Wood	0
876	1926 Bldg.	58	XRF	1/6/98	2	Room-1	Wall	Solid	Plaster	>1.57
877	1926 Bldg.	64	XRF	1/6/98	2	Room-1	Wall	Solid	Plaster	>>5.0
878	1926 Bldg.	62	XRF	1/6/98	2	Room-1		Solid	Metal	2.04
879	1926 Bldg.	9	XRF	1/2/98	1	Room-105A	Doll House	Solid	Wood	0
880	1926 Bldg.	10	XRF	1/2/98	1	Room-105A	Door	Solid	Metal	0.07
881	1926 Bldg.	7	XRF	1/2/98	1	Room-105A	Wall	Solid	Plaster	0.53
882	1926 Bldg.	8	XRF	1/2/98	1	Room-105A	Wall	Solid	Drywall	0
883	1926 Bldg.	6	XRF	1/2/98	1	Room-105A		Solid	Metal	0.01
884	1926 Bldg.	173	XRF	12/24/97	1	Room-105B	Door	Solid	Metal	>0.01
885	1926 Bldg.	174	XRF	12/24/97	1	Room-105B	Door	Solid	Wood	0
886	1926 Bldg.	171	XRF	12/24/97	1	Room-105B	Wall	Solid	Drywall	0
887	1926 Bldg.	172	XRF	12/24/97	1	Room-105B	Wall	Solid	Plaster	0.25
888	1926 Bldg.	89	XRF	1/2/98	1	Stairwell-3	Door	Solid	Wood	0.09
889	1926 Bldg.	90	XRF	1/2/98	1	Stairwell-3	Door	Solid	Wood	0
890	1926 Bldg.	93	XRF	1/2/98	1	Stairwell-3	Door	Peeling	Metal	0.16
891	1926 Bldg.	94	XRF	1/2/98	1	Stairwell-3	Door	Solid	Metal	0.13
892	1926 Bldg.	91	XRF	1/2/98	1	Stairwell-3	Stairs	Solid	Plaster	1.75
893	1926 Bldg.	92	XRF	1/2/98	1	Stairwell-3	Stairs	Solid	Wood	0
894	1926 Bldg.	96	XRF	1/2/98	1	Stairwell-3	Wall	Solid	Wood	0.02
895	1926 Bldg.	95	XRF	1/2/98	1	Stairwell-3		Peeling	Metal	>>5.0
896	1926 Bldg.	103	XRF	1/2/98	1	Stairwell-4	Door	Peeling	Metal	0.34
897	1926 Bldg.	104	XRF	1/2/98	1	Stairwell-4	Door	Solid	Metal	0.17
898	1926 Bldg.	97	XRF	1/2/98	1	Stairwell-4	Stairs	Solid	Wood	0
899	1926 Bldg.	98	XRF	1/2/98	1	Stairwell-4	Stairs	Solid	Plaster	2.99
900	1926 Bldg.	102	XRF	1/2/98	1	Stairwell-4	Stairs	Peeling	Metal	3.03
901	1926 Bldg.	99	XRF	1/2/98	1	Stairwell-4	Wall	Solid	Wood	0.04
902	1926 Bldg.	101	XRF	1/2/98	1	Stairwell-4	Wall	Solid	Plaster	0.17

Saint Paul Public Schools
 Webster Enrichment School
 Lead-Based Paint Inspection

	A	B	C	D	E	F	G	H	I	J
3	Site	Sample#	Analysis	Date	Floor	Area	Component	Condition	Substrate	Result
903	1926 Bldg.	100	XRF	1/2/98	1	Stairwell-4		Solid	Metal	3.36
904	1926 Bldg.	107	XRF	1/2/98	1	Stairwell-5	Door	Peeling	Metal	0.17
905	1926 Bldg.	108	XRF	1/2/98	1	Stairwell-5	Door	Solid	Metal	0.13
906	1926 Bldg.	109	XRF	1/2/98	1	Stairwell-5	Stairs	Solid	Wood	0
907	1926 Bldg.	110	XRF	1/2/98	1	Stairwell-5	Stairs	Peeling	Plaster	0.78
908	1926 Bldg.	106	XRF	1/2/98	1	Stairwell-5	Wall	Solid	Wood	0
909	1926 Bldg.	112	XRF	1/2/98	1	Stairwell-5	Wall	Solid	Plaster	0.16
910	1926 Bldg.	111	XRF	1/2/98	1	Stairwell-5	Window	Cracked	Metal	0.33
911	1926 Bldg.	105	XRF	1/2/98	1	Stairwell-5		Peeling	Metal	4.12
912	1975 Bldg.	103	XRF	1/8/98	1	Cafeteria-1	Door	Solid	Metal	0
913	1975 Bldg.	104	XRF	1/8/98	1	Cafeteria-1	Refridgerator	Peeling	Metal	>0.18
914	1975 Bldg.	105	XRF	1/8/98	1	Cafeteria-1	Wall	Solid	Concrte	>0.03
915	1975 Bldg.	106	XRF	1/8/98	1	Cafeteria-1		Solid	Metal	0.01
916	1975 Bldg.	116	XRF	1/8/98	1	Classroom-1	Cabinet	Solid	Wood	0
917	1975 Bldg.	118	XRF	1/8/98	1	Classroom-1	Door	Solid	Metal	>0.08
918	1975 Bldg.	117	XRF	1/8/98	1	Classroom-1	Wall	Solid	Concrte	0.06
919	1975 Bldg.	115	XRF	1/8/98	1	Classroom-1		Solid	Metal	0.02
920	1975 Bldg.	130	XRF	1/8/98	1	Classroom-1022	Door	Solid	Metal	0.01
921	1975 Bldg.	131	XRF	1/8/98	1	Classroom-1022	Wall	Solid	Concrte	0
922	1975 Bldg.	132	XRF	1/8/98	1	Classroom-1022	Wall	Solid	Metal	0.02
923	1975 Bldg.	133	XRF	1/8/98	1	Classroom-1022	Wall	Solid	Concrte	0
924	1975 Bldg.	136	XRF	1/8/98	1	Classroom-1023	Door	Solid	Metal	>0.05
925	1975 Bldg.	134	XRF	1/8/98	1	Classroom-1023	Wall	Solid	Concrte	0
926	1975 Bldg.	135	XRF	1/8/98	1	Classroom-1023		Solid	Metal	0
927	1975 Bldg.	124	XRF	1/8/98	1	Classroom-1071	Door	Solid	Metal	0.01
928	1975 Bldg.	122	XRF	1/8/98	1	Classroom-1071	Wall	Solid	Concrte	>0.02
929	1975 Bldg.	123	XRF	1/8/98	1	Classroom-1071	Wall	Solid	Concrte	0
930	1975 Bldg.	120	XRF	1/8/98	1	Classroom-1073	Door	Solid	Metal	0
931	1975 Bldg.	119	XRF	1/8/98	1	Classroom-1073	Wall	Solid	Concrte	>0.02
932	1975 Bldg.	121	XRF	1/8/98	1	Classroom-1073	Wall	Solid	Concrte	0.1
933	1975 Bldg.	114	XRF	1/8/98	1	Classroom-2	Cabinet	Solid	Wood	0
934	1975 Bldg.	113	XRF	1/8/98	1	Classroom-2	Door	Solid	Metal	0
935	1975 Bldg.	111	XRF	1/8/98	1	Classroom-2	Wall	Solid	Concrte	0
936	1975 Bldg.	112	XRF	1/8/98	1	Classroom-2	Wall	Solid	Concrte	0
937	1975 Bldg.	110	XRF	1/8/98	1	Classroom-2		Solid	Metal	0.03
938	1975 Bldg.	154	XRF	1/8/98	1	Hall-7	Door	Solid	Metal	0
939	1975 Bldg.	160	XRF	1/8/98	1	Hall-7	Door	Cracked	Metal	0.19
940	1975 Bldg.	156	XRF	1/8/98	1	Hall-7	Stairs	Peeling	Wood	0
941	1975 Bldg.	152	XRF	1/8/98	1	Hall-7	Wall	Solid	Concrte	0
942	1975 Bldg.	153	XRF	1/8/98	1	Hall-7	Wall	Solid	Concrte	0
943	1975 Bldg.	157	XRF	1/8/98	1	Hall-7	Wall	Solid	Concrte	0.02
944	1975 Bldg.	158	XRF	1/8/98	1	Hall-7	Wall	Solid	Concrte	0
945	1975 Bldg.	155	XRF	1/8/98	1	Hall-7		Peeling	Metal	0.02
946	1975 Bldg.	159	XRF	1/8/98	1	Hall-7		Cracked	Metal	0
947	1975 Bldg.	102	XRF	1/8/98	1	Kitchen-1	Door	Peeling	Metal	>0.10
948	1975 Bldg.	100	XRF	1/8/98	1	Kitchen-1	Wall	Solid	Concrte	0
949	1975 Bldg.	101	XRF	1/8/98	1	Kitchen-1	Wall	Solid	Concrte	0
950	1975 Bldg.	126	XRF	1/8/98	1	Library-1	Door	Solid	Metal	>0.08
951	1975 Bldg.	125	XRF	1/8/98	1	Library-1	Wall	Solid	Concrte	0
952	1975 Bldg.	127	XRF	1/8/98	1	Library-1	Wall	Solid	Concrte	0
953	1975 Bldg.	128	XRF	1/8/98	1	Library-1	Wall	Solid	Concrte	0
954	1975 Bldg.	129	XRF	1/8/98	1	Library-1		Solid	Metal	0
955	1975 Bldg.	109	XRF	1/8/98	1	Lounge-1	Cabinet	Solid	Wood	0

Saint Paul Public Schools
 Webster Enrichment School
 Lead-Based Paint Inspection

	A	B	C	D	E	F	G	H	I	J
3	Site	Sample#	Analysis	Date	Floor	Area	Component	Condition	Substrate	Result
956	1975 Bldg.	108	XRF	1/8/98	1	Lounge-1	Door	Solid	Metal	0
957	1975 Bldg.	107	XRF	1/8/98	1	Lounge-1	Wall	Solid	Concrte	0.03
958	1975 Bldg.	65	XRF	1/7/98	1	Main-1094	Cabinet	Solid	Metal	0.36
959	1975 Bldg.	64	XRF	1/7/98	1	Main-1094	Door	Solid	Metal	0.01
960	1975 Bldg.	61	XRF	1/7/98	1	Main-1094	Wall	Solid	Concrte	0
961	1975 Bldg.	63	XRF	1/7/98	1	Main-1094	Wall	Solid	Drywall	>0.03
962	1975 Bldg.	66	XRF	1/7/98	1	Main-1094	Wall	Solid	Concrte	0
963	1975 Bldg.	62	XRF	1/7/98	1	Main-1094		Solid	Metal	0.02
964	1975 Bldg.	69	XRF	1/7/98	1	Main-1095	Door	Solid	Metal	>0.09
965	1975 Bldg.	67	XRF	1/7/98	1	Main-1095	Wall	Solid	Concrte	0
966	1975 Bldg.	68	XRF	1/7/98	1	Main-1095	Wall	Peeling	Drywall	0
967	1975 Bldg.	73	XRF	1/7/98	1	Main-1096	Door	Solid	Metal	>0.06
968	1975 Bldg.	70	XRF	1/7/98	1	Main-1096	Wall	Solid	Concrte	0.01
969	1975 Bldg.	72	XRF	1/7/98	1	Main-1096	Wall	Solid	Drywall	0
970	1975 Bldg.	71	XRF	1/7/98	1	Main-1096		Solid	Metal	0.03
971	1975 Bldg.	58	XRF	1/7/98	1	Main-1099	Door	Solid	Metal	>0.05
972	1975 Bldg.	57	XRF	1/7/98	1	Main-1099	Wall	Peeling	Drywall	>0.03
973	1975 Bldg.	59	XRF	1/7/98	1	Main-1099	Wall	Solid	Concrte	0
974	1975 Bldg.	60	XRF	1/7/98	1	Main-1099	Wall	Solid	Drywall	0
975	1975 Bldg.	47	XRF	1/7/98	1	Main-1100	Door	Solid	Metal	>0.08
976	1975 Bldg.	46	XRF	1/7/98	1	Main-1100	Wall	Peeling	Drywall	0
977	1975 Bldg.	48	XRF	1/7/98	1	Main-1100	Wall	Solid	Concrte	0
978	1975 Bldg.	79	XRF	1/7/98	1	Main-1103	Door	Solid	Metal	>0.08
979	1975 Bldg.	77	XRF	1/7/98	1	Main-1103	Wall	Solid	Drywall	0.02
980	1975 Bldg.	78	XRF	1/7/98	1	Main-1103	Wall	Solid	Concrte	0
981	1975 Bldg.	75	XRF	1/7/98	1	Main-1104	Door	Solid	Metal	0.02
982	1975 Bldg.	74	XRF	1/7/98	1	Main-1104	Wall	Solid	Concrte	0
983	1975 Bldg.	76	XRF	1/7/98	1	Main-1104	Wall	Solid	Drywall	0
984	1975 Bldg.	49	XRF	1/7/98	1	Restroom-13	Wall	Solid	Drywall	>0.02
985	1975 Bldg.	50	XRF	1/7/98	1	Restroom-13	Wall	Solid	Concrte	0.01
986	1975 Bldg.	51	XRF	1/7/98	1	Restroom-13	Wall	Solid	Concrte	0
987	1975 Bldg.	53	XRF	1/7/98	1	Restroom-14	Door	Solid	Metal	0.01
988	1975 Bldg.	54	XRF	1/7/98	1	Restroom-14	Door	Solid	Metal	0.19
989	1975 Bldg.	52	XRF	1/7/98	1	Restroom-14	Wall	Solid	Drywall	0
990	1975 Bldg.	55	XRF	1/7/98	1	Restroom-14	Wall	Solid	Concrte	0
991	1975 Bldg.	56	XRF	1/7/98	1	Restroom-14	Wall	Solid	Concrte	0
992	1975 Bldg.	147	XRF	1/8/98	1	Restroom-15	Door	Solid	Metal	0
993	1975 Bldg.	144	XRF	1/8/98	1	Restroom-15	Wall	Solid	Concrte	0
994	1975 Bldg.	145	XRF	1/8/98	1	Restroom-15	Wall	Solid	Concrte	0
995	1975 Bldg.	146	XRF	1/8/98	1	Restroom-15	Wall	Solid	Metal	0.58
996	1975 Bldg.	149	XRF	1/8/98	1	Restroom-16	Door	Solid	Metal	0.01
997	1975 Bldg.	150	XRF	1/8/98	1	Restroom-16	Door	Solid	Metal	>0.19
998	1975 Bldg.	148	XRF	1/8/98	1	Restroom-16	Wall	Solid	Concrte	0
999	1975 Bldg.	151	XRF	1/8/98	1	Restroom-16	Wall	Solid	Concrte	0
1000	1975 Bldg.	139	XRF	1/8/98	1	Room-1031	Door	Solid	Metal	0.03
1001	1975 Bldg.	137	XRF	1/8/98	1	Room-1031	Wall	Solid	Drywall	0
1002	1975 Bldg.	138	XRF	1/8/98	1	Room-1031	Wall	Solid	Concrte	0
1003	1975 Bldg.	143	XRF	1/8/98	1	Room-1035	Door	Solid	Metal	0.03
1004	1975 Bldg.	141	XRF	1/8/98	1	Room-1035	Wall	Solid	Concrte	0
1005	1975 Bldg.	142	XRF	1/8/98	1	Room-1035	Wall	Peeling	Drywall	0
1006	1975 Bldg.	140	XRF	1/8/98	1	Room-1035		Solid	Metal	0.01
1007	1975 Bldg.	97	XRF	1/8/98	1	Room-1057	Door	Solid	Metal	0
1008	1975 Bldg.	98	XRF	1/8/98	1	Room-1057	Wall	Solid	Concrte	>0.04

Saint Paul Public Schools
 Webster Enrichment School
 Lead-Based Paint Inspection

	A	B	C	D	E	F	G	H	I	J
3	Site	Sample#	Analysis	Date	Floor	Area	Component	Condition	Substrate	Result
1009	1975 Bldg.	99	XRF	1/8/98	1	Room-1057	Wall	Peeling	Drywall	0
1010	1975 Bldg.	90	XRF	1/8/98	1	Room-1060	Door	Solid	Metal	0.01
1011	1975 Bldg.	92	XRF	1/8/98	1	Room-1060	Stairs	Peeling	Metal	0.02
1012	1975 Bldg.	93	XRF	1/8/98	1	Room-1060	Wall	Solid	Concrete	0
1013	1975 Bldg.	91	XRF	1/8/98	1	Room-1060		Cracked	Wood	0
1014	1975 Bldg.	94	XRF	1/8/98	1	Room-1060		Solid	Metal	0.33
1015	1975 Bldg.	95	XRF	1/8/98	1	Room-1060		Peeling	Metal	0.43
1016	1975 Bldg.	96	XRF	1/8/98	1	Room-1060		Peeling	Metal	0.28

APPENDIX B

INSPECTOR

Bob Hargrove
MDH Lead Inspector # 416