

SAN MATEO FOSTER CITY SCHOOL DISTRICT FACILITIES DEVELOPMENT

1410 South Amphlett Blvd., San Mateo, CA 94402
Office (650) 312-7690 FAX (650) 312-7696

PARKSIDE MONTESSORI MPR AND SITE PROJECT

ADDENDUM NO. 4

Date: November 21, 2023

Project: Parkside Montessori MPR & Site Project
DSA #: 01-120306 41-26

Owner: San Mateo Foster City School District
1170 Chess Drive
Foster City, CA 94404

Notice is hereby given to all prospective bidders that plans and specifications on the subject project are modified as hereinafter set forth. This addendum shall be attached to and form a part of the plans and specifications. All bidders must acknowledge receipt of this addendum on the Bid Form. In case of difference with previous addenda or communications, this addendum takes precedence.

It is the responsibility of all bidders to notify all subcontractors from whom they request bids and from whom they accept bids of all changes contained in this addendum.

1.1 SPECIFICATIONS

1. SPECIFICATION TABLE OF CONTENTS

The following specification section is hereby revised.

A. Revised specifications list to include section "08 16 13 FIBERGLASS DOORS".

2. SPECIFICATION SECTION 08 16 13 – FIBERGLASS DOORS

The following specification section is hereby issued.

A. Added missing section.

1.2 DRAWINGS

1. SHEET 'G0.3 SHEET INDEX'

The following drawing is hereby revised with these changes:

A. Added 'E1.1A - LUNCH SHELTER ELECTRICAL SITE PLAN & PHOTOMETRIC PLAN' to sheet index.

B. Added 'T24.5 TITLE 24 COMPLIANCE – LUNCH SHELTER' to sheet index.

C. Revised Total drawing count to '166 DWGS'

2. **SHEET ‘C1.1 EXISTING SITE & DEMOLITION PLAN’**

The following drawing is hereby reissued with these changes:

- A. Added existing concrete to be remove in front of existing classrooms and LGI building
- B. Added existing gate in front of administration office to be removed
- C. Added Demolition Note #51
- D. Revised Over-Excavation & Recompaction Notes #2 and #4
- E. Added note #8 to Project Description.

3. **SHEET ‘C2.1 SITE IMPROVEMENT PLAN’**

The following drawing is hereby reissued with these changes:

- A. Added notes #61 & #62
- B. Added new concrete to be installed in front of existing classrooms and LGI building
- C. Added new concrete to be installed in front of Administration Office.

4. **SHEET ‘C3.1 GRADING PLAN’**

The following drawing is hereby reissued with these changes:

- A. Added elevations and slopes to the added concrete outside the existing classrooms and LGI building.

5. **SHEET ‘C3.2 ENLARGED GRADING PLAN’**

The following drawing is hereby reissued with these changes:

- A. Added elevations and slopes to the added concrete outside the existing classrooms and LGI building

6. **SHEET ‘C6.1 EROSION CONTROL PLAN’**

The following drawing is hereby reissued with these changes:

- A. Added soil and boulder stockpile locations A & B

7. **SHEET ‘L1.1 LAYOUT PLAN’**

The following drawing is hereby reissued with these changes:

- B. Removed a reference to a Bid Alternate that was made part of the base bid in a previous addendum.
- C. Changed location for 4th Salvaged Bench.

8. **SHEET ‘L2.1 MATERIAL AND DETAIL REFERENCE PLAN’**

The following drawing is hereby reissued with these changes:

- A. Added new layout of ornamental fence between LGI and Admin.
- B. Changed location of 4th Salvaged Bench.
- C. Added additional flatwork around LGI.
- D. Added additional flatwork by Admin.
- E. Added additional flatwork by existing Classroom Wings.
- F. Added additional flatwork north of new MU Building.

9. SHEET ‘L2.2 MATERIAL AND DETAIL REFERENCE PLAN’

The following drawing is hereby reissued with these changes:

- A. Added entry into Material and Detail Reference Legend for the ornamental fence.

10. SHEET ‘A1.1 CAMPUS SITE PLAN’

The following drawing is hereby reissued with these changes:

- A. Delete KEYNOTE 04.03 “CMU BALL WALL, S.L.D.” and added Keynote 3.23 “CONCRETE BALL WALL, S.L.D.”.
- B. Deleted Keynote 12.01 on the site plan between existing modular classrooms 24 and 27.
- C. Added 4’-high black vinyl-coated Chain link Fence between parking lot and EVA drop-off lane.

11. SHEET ‘A1.2 ENLARGED SITE PLAN’

The following drawing is hereby revised with these changes:

- A. Added 4’-high black vinyl-coated Chain link Fence between parking lot and EVA drop-off lane in lieu of “decorative fence”; location as indicated in Landscape Drawing L2.1.

12. SHEET ‘A5.1 EXTERIOR ELEVATIONS’

The following drawing is hereby revised with these changes:

- A. Added Cement Plaster pattern to exterior wall between gridlines C & D.

13. SHEET ‘A9.1 DOOR & WINDOW SCHEDULE’

The following drawing is hereby reissued with these changes:

- A. Revise Door Schedule, doors 01A, 01B, 12A, & 12B – add “FRP-FACED SMOOTH TEXTURE” to COMMENTS column.

14. SHEET ‘E0.1 ELECTRICAL ABBREVIATIONS, NOTES, & SHEET INDEX’

The following drawing is hereby reissued with these changes:

- A. Revised ELECTRICAL SHEET INDEX to include new sheet E1.1A.

15. SHEET ‘E1.1 ELECTRICAL SITE PLAN’

The following drawing is hereby reissued with these changes:

- A. Updated plan to show location of N.I.C. lunch shelter.
- B. Added callout 1/E1.1A.

16. SHEET ‘E1.1A - LUNCH SHELTER ELECTRICAL SITE PLAN & PHOTOMETRIC PLAN’

The following new drawing sheet is hereby issued:

- A. Added photometrics and electrical plan.
- B. Contractor shall coordinate the electrical and lighting scope with lunch shelter installer and its location and foundations.

17. SHEET 'E7.1 ELECTRICAL PANEL AND LIGHTING SCHEDULES'

The following drawing is hereby reissued with these changes:

- A. Updated lighting fixture and panel schedules associated with lunch shelter lighting.

18. SHEET 'E7.2 ELECTRICAL PANEL SCHEDULES'

The following drawing is hereby reissued with these changes:

- A. Updated panel schedules associated with lunch shelter electrical.

19. SHEET 'T24.5 TITLE 24 COMPLIANCE – LUNCH SHELTER'

The following drawing is hereby issued:

- A. Added Title 24 Calcs to include Lunch Shelter.

1.3 PRE-BID RFIS

1. PB 06 PREQUAL LIST UPDATE

Q: Preliminary courtesy pre-qual lists were uploaded to Plan Room and sent to all plan holders November 9, 2023.

- A: Additional Preliminary courtesy pre-qual lists were uploaded to Plan Room and sent to all plan holders November 17, 2023. The final official MEP pre-qual lists will be sent in the final Addendum.

2. PB 26 OVER-EXCAVATION AT BUILDING PAD

Q: Plan sheet C1.1 Site Demolition, states "OVER-EXCAVATION & RECOMPACTION NOTES - #2. THE BUILDING PAD SHALL BE EXCAVATED TO A MINIMUM DEPTH OF 12-INCHES BELOW FINISH FLOOR AND THE UPPER 12-INCHES OF SUBGRADE SHALL BE COMPACTED PER GEOTECHNICAL REPORT RECOMMENDATIONS." Since the building foundation is a 12" PCC Mat slab, and the finished floor is 12" above the pad, there would be nothing to over-excavate. Shall we bid to over-excavate the pad grade by 12", compact that over-ex sub grade, and backfill the 12" up to pad grade, while compacting?

- A: Response has been included in Addendum 4 Sheet C1.1.

3. PB 27 OVER-EXCAVATION AT FLATWORK

Q: Plan sheet C1.1 Site Demolition, states "OVER-EXCAVATION & RECOMPACTION NOTES - #4. AREAS TO RECEIVE FLATWORK SHALL BE OVER-EXCAVATED TO A MINIMUM DEPTH OF 12-INCHES BELOW FINISH GRADE..." Since all concrete flatwork will be either 4" PCC/12" AB (SG is 1.33' below FG), or 6" PCC/12" AB (SG is 1.5' below FG), there is nothing to over-excavate. Shall we bid to over-excavate the concrete flatwork sub-grade areas by 12", compact that over-ex sub-grade, and backfill the 12" up to the concrete flatwork sub-grade, while compacting?

- A: Response has been included in Addendum 4 Sheet C1.1.

4. **PB 28 AC PAVING REPLACEMENT**

Q: Plan sheet C1.1 Site Demolition, states "DEMOLITION KEY NOTES - #35 REMOVE ONLY THE AC PAVEMENT. EXISTING BASEROCK SHALL REMAIN... PRIOR TO REMOVAL CONTRACTOR SHALL VERIFY EXACT AC DEPTH FOR NEW AC PAVEMENT INSTALLATION" The new asphalt section must be the same as the existing asphalt section, which is not specified. The boring logs in the soils report states 2 areas have 1.5" of AC and one area has 2" of AC. For bidding purposes, to keep all competing bids comparable, may we bid on removing 2" of AC and replacing 2" of AC at area #35?

A: Existing AC pavement shall be an assumed 2" remove and replace due to the varying AC pavement section across the site.

5. **PB 29 BALL WALL**

Q: Drawing A1.1 calls out the ball wall to be CMU however landscape sheet D / L2.4 calls for it to be concrete. Please confirm which is correct.

A: Ball Wall shall be cast-in-place concrete per Landscape drawing.

6. **PB 30 KEYNOTE 12.01**

Q: Sheet A1.1 calls out for "12.01 - Basketball Hoop, S.L.D" between modular classrooms 24-27 and main campus in the decomposed granite area but no court is shown. Please confirm this is not correct.

A: Refer to Landscape Drawings for all playground equipment and play courts identification, location, and configuration.

7. **PB 31 FRP DOORS SPECIFICATION**

Q: Addendum 3, item 1.2C changes the "PNL-F-HM" door to "PNL-F-FRP" and item 1.2D changes the "PNL-N-HM" door to "PNL-N-FRP". The project manual doesn't have a spec section for FRP doors, please provide specifications for the FRP(fiberglass plastic reinforced) doors.

A: Specification is issued in this Addendum 4.

8. **PB 32 CHAIN LINK FENCE**

Q: Sheet L2.1 calls out for "Decorative Fence, See Architectural Drawings" in the landscaping area between the parking lot and EVA Drop Off Lane. Architectural sheet A1.2 which has all other fences called out does not mention any fencing in parking lot. Please confirm which is to be correct and update accordingly.

A: Refer to Landscape Drawings and add 4' high black vinyl-coated chain link fence in lieu of "decorative fence". Sheet A1.2 correction is issued in this Addendum 4.

9. **PB 33 BUILDERS EXCHANGE**

Q: Specification Section 00 11 16 - Invitation to Bid, #11, states that the contract documents will be available from 3 builders exchanges and ARC - San Carlos. However, the documents provided on these sites do not match. The project manual provided on ARC - San Carlos website is 1,642 pages in length, however the project manual provided on the builders exchange website is 1,542 pages in length. Additionally, Addendum 3 was sent out via email by ARC - San Carlos

however it is not posted to ARC Plan Room. Please confirm where bidders should procure the accurate bid and contract set of documents.

A: The version provided to the Builders Exchange is the original file. The file posted to the Website is a print ready version that is set up to print with slip sheets added for the pagination.

10. PB 33 DOOR 17A

Q: After revised door materials are taken into account per Addendum 3 there are only two wood door openings 09B and 17A. 09B has comment COLOR -P4, bidding as MDO primed per 08 14 16 2.02 A. 2. a. Shall 17A Custodial room also be bid as MDO primed?

A: Yes.

11. PB 34 HARDWARE GROUPS

Q: Hardware groups list Schlage locks with "R" FSIC core, should these be bid as "T" FSIC construction core (08 71 00 2.03 E.)? Permanent cores are listed in each group as Primus 20-740.

A: No per 08710, 2.04, 3, E, construction cores are to be Schlage E keyway.

12. PB 35 DOORS 01A & 01B AT CURTAIN WALL SYSTEM

Q: Openings 01A and 01B per A9.1 door schedule are door type PNL-G-AL in curtain wall frame system. A9.1 elevations for C-01 and C-02 show doors as flush door with half lite. Same is shown on A5.1 exterior elevations. Clarify if these doors are AL or if doors are to be FRP aluminum.

A: Doors 01A and 01B are specified per 08 44 00 2.05 referencing 08 Section "Aluminum-Framed Entrances". 08 41 13 2.04B specifies Kawneer Flushline. Revise 08 41 13 2.04B.3 Door Face Sheet to be "FRP-faced doors, smooth finish".

13. PB 36 DOORS 12A & 12B AT CURTAIN WALL SYSTEM

Q: Openings 12A and 12B per A9.1 door schedule are door type PNL-F-AL in curtain wall frame system. A9.1 elevations for S-01 and S-02 show doors as flush. Same is shown on A5.1 exterior elevations. Clarify if these doors are to be AL, or if doors are to be FRP.

A: Doors 12A and 12B are specified per 08 44 00 2.05 referencing 08 Section "Aluminum-Framed Entrances". 08 41 13 2.04B specifies Kawneer Flushline. Revise 08 41 13 2.04B.3 Door Face Sheet to be "FRP-faced doors, smooth finish".

14. PB 37 HOLLOW METAL DOORS AT INTERIOR LOCATIONS

Q: Shall interior doors changed to hollow metal per Addendum 3 be bid following the exterior specifications per 08 13 13? If different please clarify how doors should be bid.

A: Refer to specification section 08 13 13 for hollow metal interior doors.

15. PB 38 DOOR FRAMES AT FRP DOORS

Q: Openings 03A, 06A, 13A, 15A, 09A are clarified as door material FRP per Addendum 3 1.2 Drawings 1. C. & D. Please provide specifications for FRP openings. May Special Lite manufacturer be bid?

a. For these openings (other than 06A) confirm that frame is to be hollow metal per door schedule, or if frame is to be FRP by manufacturer.

A: FRP door specification is issued in this Addendum 4. Door frames shall remain as hollow metal. General contractor shall decide which subcontractor provides frames.

16. PB 39 DOOR FRAMES AT FRP DOORS

Q: The 6" X 15" X 3/8" Angle called out on 3 / A10.32 cannot be supplied. Would an ADC wall bracket model 1483UNI (see next page for data sheet.) be acceptable? If not, please provide alternative attachment method with common shape/size materials.

A: Any steel fabricator should be able to bend 3/8 PL into the size shown in detail 3/A10.32. Substitution is not accepted.

17. PB 40 CEMENT PLASTER VS ACM REVEAL

Q: The exterior elevations on (01/A5.1) has an area between gridlines C and D with the keynote (09.05 CEMENT PLASTER REVEAL, SEE DETAIL 04/A10.13) at an exterior wall. The area where this keynote is shown looks to be (ACM - ALUMINUM COMPOSITE MATERIAL PANELS) and is not drawn with the same texture as the other cement plaster walls. Please confirm this is meant to be plaster and not (ACM - ALUMINUM COMPOSITE MATERIAL PANELS).

A: Exterior Elevation – North, 01/A5.1 – wall between gridlines C & D is cement plaster. Note 09.05 for cement plaster reveal is correct.

18. PB 41 SOFFIT METAL PANELS

Q: Per Morin Representative; It may be wise to quote the MP-1 perforated wall panels with an option of Kynar mica standard color, otherwise it will be too costly.

A: Kynar mica (70% PVDF coating required) standard color warm gray is an acceptable finish for MP-1. Color will be selected upon review of color chip samples.

19. PB 42 SOLAR PANEL SCOPE

Q: Please confirm there are no solar panels for the project. Solar Panels are shown at the playground L2.1 and on the structure's roof, ref A4.1 and E2.2. But the one of the roof appears to indicate that is just a "SOLAR READY" system. No spec appears to exist. Summary of Work 01 11 00 section 1.6 indicates work by others.

A: Confirmed. There are no solar panels for this project.

20. PB 43 BID ALTERNATES

Q: Please list all desired alternates and or allowances.

A: All bid alternates were deleted and added to the base bid. Include all scope under the base bid. Allowances are listed in the Bid Form 00 41 13 - \$500K allowance for unforeseen site conditions.

21. PB 44 BOULDER SIZES

Q: Please confirm that all [52] the owner-provided boulders are about the same size and require the use of equipment to install. None can be installed without the use of equipment. No dimensions are provided on L2.3.

A: Quantity of boulders reduced to (30) in Addendum #2. The boulders will range in size from 24"x24"x24" to 48"x48"x48".

22. PB 45 EXISTING SYSTEMS

Q: Please provide the brands of all existing systems for connectivity: security, fire alarm, controls, etc.

A: See Pre-Bid Conference Agenda #5 single-source items list.

23. PB 46 CRANE SETUP

Q: For the logistics part of the job; Where would the area be for construction parking, Crane set up location?

A: See Temporary fencing and phasing diagrams for areas available to the contractor. Construction parking is not allowed on school parking lots. Construction staff parking can be on construction site per contractor discretion and in the neighborhood streets.

24. PB 47 BIKE RACKS

Q: Ref A/L2.4 Please confirm the bike racks are square tubing. The model number SG does not exist. It might be SQ?

A: Rack to have square tubing. Model number to be "SQ" instead of "SG".

25. PB 48 RAISED PLANTERS

Q: A) Confirm raised wood planters are not to be irrigated.

B) Provide detail for the 3 wood planters on structure at modular classrooms

A: A) Wood planters are not to be irrigated. Students will use nearby hose bibs to hand-water.

B) Wood planters are all to be built per detail E/L4.3 regardless of adjacent ground plane material.

26. PB 49 BOULDER STOCKPILE

Q: Please provide logistics plan indicating soil and boulder stockpiles, laydown, parking, etc...

A: See Temporary fencing and phasing diagrams for areas available to the contractor. Construction parking is not allowed on school parking lots. Construction staff parking can be on construction site per contractor discretion and in the neighborhood streets. The field and southeast corner is within the temporary fencing. Contractor to coordinate logistics of stockpiles and laydown within available area. Proposed additional/potential area is identified on C6.1, however,

would need District approval. Coordinate with District and secure area with temporary fencing for student safety.

27. PB 50 BIORETENTION FILL

Q: Please add specific fill details for the raised (Tournesol) Flow Through Planters. Specifications describe bioretention on grade

A: Bioretention media is still to be L.H. Voss "Lennox Blend" bioretention soil as per the specification.

28. PB 51 LIME TREATED SOIL

Q: Please confirm the intent is for all lime treated soil to be removed and replaced with topsoil as part of demolition and rough grading operations

A: Lime treated soils should be removed from all planting areas before the soil can be used for planting. Means & Methods will dictate which sub-contractor removes it at what time.

29. PB 52 SUBGRADE ELEVATIONS

Q: Confirm landscaper will receive site at subgrade elevations (-12") of finish grade

A: General contractor shall coordinate and determine what the landscaper will receive. Note: specification 32 90 00 does allow the re-installation of on-site topsoil (such as in the existing field) if it is stripped and stockpiled. Not all planting areas must use imported topsoil.

30. PB 54 ON-SITE TOPSOIL STOCKPILE

Q: Please provide quantities for bid purposes per 32 90 00, 2.5

A) Quantity of on-site topsoil stockpiled

B) Import planting soil required when quantities of stockpiled on-site topsoil are insufficient.

A: Contractor to coordinate logistics of stockpiles and laydown within available area. Proposed additional/potential area is identified on C6.1, however, would need District approval. Coordinate with District and secure area with temporary fencing for student safety.

31. PB 55 FOLDING DOORS

Q: Regarding Folding Doors Along Wall C-01, Floorplan Page A2.1 & Door Schedule A9.1 DETAIL 9: - Please verify that outswing is correct orientation, with no egress door panel . (all 8 folded panels stacked to left/ protruding to outside of structure, not inside)

A: No egress door panel; outswing vs. inswing will be reviewed in submittal.

32. PB 56 PAVING COORDINATION OUTSIDE MPR KITCHEN

Q: On Sheet C2.1 and on sheet L2.1 at the area in front of the new MPR Building kitchen, the pattern for Decomposed Granite is shown however the keynote callouts on both of these sheets are for concrete paving at this location. Please confirm which paving will be required for this area and update accordingly.

A: The "cross" hatch shown in front of the new MPR Building kitchen on sheet L2.1 should be keyed to the legend on sheet L2.2. The "cross" hatch shown on sheet L4.1 should be keyed to the legend on sheet L4.2. On sheets L2.1 and L2.2 it denotes "Concrete Paving Type 'C'" but on sheets L4.1 and 4.2 that hatch denotes "Decomposed Granite Paving". The hatch for the "Decomposed Granite Paving" has been removed from sheet L2.1 for graphic clarity.

33. PB 57 FUTURE SHADE STRUCTURE

- Q: Please confirm the shade structure (including foundation) marked future will be a separate project.
- A: Coordination with the shade structure and foundation (separate) contractor will be required. Site prep, concrete flatwork under the new shade structure, and electrical/lighting will be required by the MPR contractor.

1.4 SUBSTITUTION REQUESTS

1. 07 42 93 SOFFIT PANELS

- A. Morin Primo PSR-12 is an acceptable substitution for the MBCI metal panels.

2. 07 54 19.20 SINGLE-PLY PVC ROOFING – FULLY ADHERED

- A. Carlisle Sure-Flex PVC FRS FleeceBack is an acceptable substitution for the specified PVC roofing.

3. 11 61 43 STAGE CURTAINS

- A. Requested consideration and re-review of the curtain track components: iWeiss is an acceptable substitution for the specified hardware, rigging, and curtain tracks.

Attachments:

Spec Sections 08 16 13

Drawing sheets C1.1, C2.1, C3.1, C3.2, C6.1, L1.1, L2.1, L2.2, A1.1, A9.1, E0.1, E1.1, E1.1A, E7.1, E7.2, T24.5

End of Addendum

SECTION 08 16 13 - FIBERGLASS DOORS

PART 1 - GENERAL

1.01 SUMMARY

- A. Section includes fiberglass doors.
- B. Related Sections:
 - 1. Section 08 12 13 "Hollow Metal Frames" for fiberglass doors scheduled for installation in hollow metal frames.

1.02 ACTION SUBMITTALS

- A. Product Data: For each type of product.
 - 1. Include construction details, material descriptions, and fabrication methods, dimensions of individual components and profiles, hardware, and finishes for fiberglass doors .
- B. Shop Drawings: For fiberglass doors .
 - 1. Include plans, elevations, sections, operational clearances, and details of installation, including anchor, flashing, and sealant installation.
- C. Samples: For each exposed product and for each color specified, 2 by 4 inches in size.
- D. Samples for Initial Selection: For units with factory-applied finishes.
 - 1. Exposed Finishes: 2 by 4 inches.
- E. Product Schedule: For fiberglass doors. Use same designations indicated on Drawings.

1.03 INFORMATIONAL SUBMITTALS

- A. Sample Warranties: For manufacturer's warranties.

1.04 QUALITY ASSURANCE

- A. Manufacturer Qualifications: A manufacturer capable of fabricating fiberglass doors that meet or exceed performance requirements indicated and of documenting this performance by test reports and calculations.

1.05 WARRANTY

- A. Manufacturer's Warranty: Manufacturer agrees to repair or replace fiberglass doors that fail in materials or workmanship within specified warranty period.
 - 1. Failures include, but are not limited to, the following:
 - a. Failure to meet performance requirements.
 - b. Structural failures including excessive deflection, water leakage, and air infiltration.
 - c. Facer delamination.

- d. Deterioration of materials and finishes beyond normal weathering.
- 2. Warranty Period:
 - a. Doors: Life-of-Original-Installation.
 - b. Finish: 3 years from date of Substantial Completion.

PART 2 - PRODUCTS

2.01 MANUFACTURERS

- A. Source Limitations: Obtain fiberglass doors from single source from single manufacturer.

2.02 FIBERGLASS DOORS

- A. Basis-of-Design Product: Subject to compliance with requirements, provide Model AF-200 by Special-Lite; or a comparable product by an approved manufacturer.
- B. Doors : Fiberglass skins bonded to fiberglass stiles and rails , finished with manufacturer's standard polyurethane coating.
 - 1. Doors:
 - a. Thickness: 1-3/4 inches.
 - b. Stiles and Rails: 1-1/2-inch pultruded fiberglass tubes.
 - c. Edge Bevel: Provide manufacturer's standard beveled or square edges.
 - d. Core: Manufacturer's standard.
 - e. Facer: Fiberglass sheet, minimum thickness of 0.090 inch.
 - f. Edge Construction: Seamless and watertight.
 - g. Reinforcement: Solid fiberglass block.
 - 2. Exposed Finish:
 - a. Exterior Color: Custom color as directed by Architect.
 - b. Interior Finish: Matching exterior color and finish.
 - c. Sheen: As selected by Architect.
- C. Glazing System: Manufacturer's standard factory-glazing system that produces weathertight seal.

2.03 FABRICATION

- A. Fabricate fiberglass doors in sizes indicated.
- B. Complete fabrication, assembly, finishing, hardware application, and other work in the factory to greatest extent possible. Disassemble components only as necessary for shipment and installation. Allow for scribing, trimming, and fitting at Project site.

PART 3 - EXECUTION

3.01 INSTALLATION

- A. Install doors plumb, rigid, properly aligned, and securely fastened in place. Comply with manufacturer's written instructions.

HMC Architects

- B. Fiberglass Doors: Fit and adjust doors accurately in frames, within clearances specified below.
 - 1. Non-Fire-Rated Doors: Comply with manufacturer's instructions.

3.02 REPAIR

- A. Factory-Finish Touchup: Clean abraded areas and repair with same material used for factory finish according to manufacturer's written instructions.

END OF SECTION

OVER-EXCAVATION & RECOMPACTION NOTES

1. THE SITE SHOULD BE CLEARED OF THE EXISTING STRUCTURE, VEGETATION, ORGANIC TOPSOIL, DEBRIS, UNDOCUMENTED LOOSE OR SOFT FILL, AND OTHER DESTRUCTIVE MATERIALS. CONSTRUCTION AREAS SHALL BE EXCAVATED TO SUBGRADE ELEVATION.
2. THE UPPER 12-INCHES OF SUBGRADE BELOW THE BUILDING PAD SECTION SHALL BE OVER-EXCAVATED, MOISTURE CONDITIONED, AND COMPACTED PER GEOTECHNICAL REPORT RECOMMENDATIONS.
3. ALL EXISTING ASPHALT CONCRETE PAVEMENTS WITHIN THE SITE IMPROVEMENT AREA SHALL BE REMOVED AND DISPOSED OF OFF-SITE AND NOT MIXED WITH ON-SITE SOILS TO BE REUSED AS ENGINEERED FILL BELOW THE BUILDING.
4. AREAS TO RECEIVE FLATWORK SHALL BE EXCAVATED TO THE REQUIRED SUBGRADE ELEVATION. THE UPPER 12-INCHES OF SUBGRADE SHALL BE OVER-EXCAVATED AND PROCESSED SUCH THAT THE MOISTURE CONTENT MEETS THE REQUIREMENTS OF THE GEOTECHNICAL REPORT AND COMPACTED TO AT LEAST 90% RELATIVE COMPACTION. SUBGRADE SHALL BE PROOF ROLLED TO PROVIDE A SMOOTH, FIRM NON-YIELDING SURFACE. ANY LOOSE SOIL SHALL BE REMOVED AND REPLACED WITH ENGINEERED FILL. BAY MUD SHALL NOT BE USED AS FILL.
5. THE GEOTECHNICAL ENGINEER'S REPRESENT SHOULD OBSERVE AND CONFIRM THE ADEQUACY OF SITE CLEARING OPERATIONS DURING CONSTRUCTION PRIOR TO ENGINEERED FILL PLACEMENT.
6. ON-SITE SOILS HAVING AN ORGANIC CONTENT OF LESS THAN 3-PERCENT BY WEIGHT AND FREE OF ROCKS OR LIMBS GREATER THAN 6-INCHES IN GREATEST DIMENSION WITH NO MORE THAN 15-PERCENT LARGER THAN 2.5-INCHES CAN BE REUSED AS GENERAL BACKFILL AND STOCK PILED ON-SITE AS APPROVED BY THE GEOTECHNICAL ENGINEER. BAY MUD SHALL NOT BE USED AS FILL.
7. LOCAL DEWATERING OF THE FOUNDATION AND UTILITY TRENCH EXCAVATIONS MAY BE REQUIRED DUE TO SHALLOW GROUNDWATER CONDITIONS. CONTRACTOR SHALL PROVIDE ALL NECESSARY TOOLS, EQUIPMENT, AND LABOR FOR DEWATERING NO MATTER THE SOURCE. DEWATERING SHALL BE CONTINUOUS UNTIL ALL SITE UTILITIES ARE INSTALLED AND BACKFILLED. CONTRACTOR SHALL PROVIDE DEWATERING AS NECESSARY NO MATTER THE SOURCE AND AT NO COST TO THE OWNER. CONTRACTOR SHALL VERIFY WITH REGIONAL WATER CONTROL BOARD IF DEWATERING IS REQUIRED BEFORE THE START OF CONSTRUCTION.
8. UTILITY TRENCH EXCAVATIONS WHICH BOTTOM IN BAY MUD SHOULD BE OVEREXCAVATED AT LEAST 12 INCHES. THE BOTTOM OF THE OVEREXCAVATION SHOULD BE LINED WITH STABILIZING FABRIC (MIRAFI 500X OR EQUIVALENT) AND SHOULD BE BACKFILLED WITH ¾-INCH CLEAN CRUSHED ROCK IN ORDER TO PROVIDE A STABLE TRENCH BOTTOM PRIOR TO PIPE PLACEMENT. REFER TO GEOTECHNICAL REPORT FOR ADDITIONAL INFORMATION.

ABBREVIATIONS

AB	AGGREGATE BASE	INV	INVERT ELEVATION
AC	ASPHALT CONCRETE	LIP	LIP OF GUTTER
AD	AREA DRAIN	LP	LOW POINT
B/	BOTTOM OF ...	ME	MATCH EXISTING
BFC	BOTTOM FACE OF CURB	PL	PROPERTY LINE
BFS	BOTTOM FACE OF STEP	PLNT	PLANTER
BFW	BOTTOM FACE OF WALL	POC	POINT OF CONNECTION
BLDG	BUILDING	RL	RAIL
BR	BOTTOM OF RAMP	SD	STORM DRAIN
CONC/CNC/C	CONCRETE	SDAD	STORM DRAIN AREA DRAIN
EB	ELECTRICAL BOX	SDDI	STORM DRAIN DROP INLET
EC	EDGE OF CONCRETE	SDMH	STORM DRAIN MANHOLE
EG	EXISTING GRADE	SS	SANITARY SEWER
EL	ELEVATION	SSCO	SANITARY SEWER CLEAN OUT
EP	EDGE OF PAVEMENT	TC	TOP OF CURB
EV	ELECTRICAL VAULT	TG	TOP OF GRATE
EX	EXISTING	TR	TOP OF RAMP
FF	FINISH FLOOR	TS	TOP OF STEP
FG	FINISH GRADE	TW	TOP OF WALL
FNC	FENCE	UG	UNDERGROUND
G	GROUND	W	WATER
GRD	GUARD	W-T	TOP OF WALL
HP	HIGH POINT	WV	WATER VALVE

LEGEND

	(E) AC PAVEMENT
	(E) CONCRETE
	AC PAVEMENT AND BASE ROCK TO BE REMOVED
	AC PAVEMENT TO BE REMOVED AND BASE ROCK TO REMAIN
	AC PAVEMENT AND 12" OF BASE ROCK/SUBGRADE TO BE REMOVED
	CONCRETE SIDEWALK TO BE REMOVED
	LIMITS OF AC PAVEMENT AND BASE ROCK REMOVAL

PROJECT DESCRIPTION

1. CONSTRUCTION OF A MULTIPURPOSE BUILDING WITH SERVERY, WARMING KITCHEN, RESTROOMS, SUPPORT SPACES.
2. DEMOLISH EXISTING LUNCH SHELTER.
3. DEMOLISH, SALVAGE AND REINSTALL EXISTING PLAY STRUCTURE WITH FALL PROTECTION MATS.
4. DEMOLISH AND RECONFIGURE BOTH PARKING LOTS AND DROP-OFF AREA ON WEST SIDE OF CAMPUS.
5. DEMOLISH AND RE-PAVE HARDSCAPE SURFACE AT CAMPUS INTERIOR - EAST SIDE.
6. ADD (2) FIRE HYDRANTS TO CAMPUS.
7. DEMOLISH AND INSTALL SYNTHETIC TURF PLAY FIELD AND TRACK AREA.
8. DEMOLISH AND REMOVE ALL FOUNDATIONS FROM SITE EQUIPMENT (EXPOSED & BURIED). ASSUME MINIMUM OF 75



AGENCY
APPROVAL:
DSA # 01-120306
FILE # 41-26



SAN MATEO-FOSTER CITY
SCHOOL DISTRICT
1170 CHESS DR.,
FOSTER CITY, CA 94404

HMC Architects

3542005-000

833 W. SAN CARLOS STREET
STUDIO 750, SAN JOSE, CA 95110
917.807.0020 | www.hmcarchitects.com

ISSUE

DESCRIPTION	DATE
ADDENDUM #1	08.11.2023
ADDENDUM #2	11.03.2023
ADDENDUM #4	11.21.2023

KEYNOTES

DEMOLITION KEY NOTES

1. SAWCUT EX. AC PAVEMENT
2. SAWCUT EX. CONCRETE
3. REMOVE EX. CONCRETE
4. REMOVE EX. AC PAVEMENT AND BASE ROCK
5. REMOVE EX. FENCE, GATE, AND ASSOCIATED FOOTINGS
6. REMOVE EX. CONCRETE CURB & GUTTER
7. REMOVE EX. CONCRETE VERTICAL CURB
8. REMOVE EX. FLUSH CURB
9. REMOVE EX. CONCRETE CURB RAMP
10. REMOVE EX. TRUNCATED DOMES
11. REMOVE EX. PLAY MAT AND STRUCTURE. REFER TO LANDSCAPE PLANS FOR EXISTING PLAY STRUCTURE RELOCATION
12. REMOVE EX. SIGN
13. REMOVE EXISTING STORM DRAIN INLET
14. REMOVE EXISTING STORM DRAIN PIPE
15. REMOVE PORTION OF EXISTING UNKNOWN UTILITY
16. EXISTING CONCRETE SIDEWALK TO REMAIN IN PLACE
17. REMOVE EXISTING CONCRETE DRIVEWAY
18. REMOVE EXISTING TREE - TOTAL OF 11
19. REMOVE EXISTING FLAG POLE AND FOOTING
20. REMOVE EXISTING PLAY SURFACING, AC PAVEMENT, AND 12-INCHES OF BASE ROCK/SUBGRADE BELOW AC PAVEMENT. EXISTING PLAY STRUCTURE IS TO BE PROTECTED AND REMAIN IN PLACE.
21. REMOVE EXISTING SHADE STRUCTURE AND ASSOCIATED FOUNDATION
22. RELOCATE EXISTING STORAGE CONTAINER WITHIN SITE COORDINATE LOCATION WITH OWNER
23. REMOVE PORTION OF EXISTING COLLAPSED STORM DRAIN PIPE. CONTRACTOR SHALL POT HOLE TO VERIFY EXACT AMOUNT OF PIPE THAT NEEDS TO BE REPLACED
24. REMOVE EXISTING TURF
25. REMOVE AND SALVAGE EXISTING RAMP FOR REINSTALLATION
26. REMOVE EXISTING WOOD STAIRS
27. REMOVE EXISTING SCHOOL SIGNAGE AND FOUNDATION
28. REMOVE EXISTING CHAINLINK BACKSTOP
29. REMOVE EXISTING BASEBALL HOP POLE, AND FOOTING
30. REMOVE EXISTING BALL WALL AND ASSOCIATED FOUNDATION
31. REMOVE EXISTING POSTS AND ASSOCIATED FOOTING
32. EXISTING STORM DRAIN RIM ELEVATION TO BE RAISED 6-INCHES
33. EXISTING FENCE AND GATE TO REMAIN IN PLACE
34. ADJUST EXISTING STORM DRAIN RIM ELEVATION. SEE SHEET C3.1 FOR NEW RIM ELEVATION
35. REMOVE ONLY THE AC PAVEMENT. EXISTING BASE ROCK SHALL REMAIN, BUT BE PROOF ROLLED TO 90% RELATIVE COMPACTION. PRIOR TO REMOVAL CONTRACTOR SHALL VERIFY EXACT AC DEPTH FOR NEW AC PAVEMENT INSTALLATION
36. EXISTING PLANTER TO REMAIN IN PLACE
37. REMOVE EXISTING LANDSCAPING AND ASSOCIATED IRRIGATION SYSTEM
38. REMOVE EXISTING WOOD POST AND RAIL FENCE AND ASSOCIATED FOOTINGS
39. EXISTING TRENCH DRAIN TO REMAIN IN PLACE
40. REMOVE EXISTING RAMP
41. REMOVE EXISTING BENCH
42. REMOVE EXISTING BIKE RACK
43. REMOVE EXISTING UTILITY POLE. CONTRACTOR SHALL COORDINATE WITH UTILITY PROVIDER FOR REMOVAL
44. REMOVE EXISTING BACKSTOP AND FOOTING
45. REMOVE EXISTING PLANTER AREA AND ASSOCIATED WALLS
46. REMOVE EXISTING PLAY STRUCTURE AND SAFETY MAT
47. EXISTING UTILITY BOX RIM TO BE ADJUSTED TO FINISH GRADE
48. REMOVE EXISTING SHED. COORDINATE WITH DISTRICT ON RELOCATION
49. REMOVE AC PAVEMENT AND BASE ROCK FOR INSTALLATION OF PLANTER BOX
50. REMOVE EXISTING AC PAVEMENT AND A MINIMUM OF 12-INCHES OF BASE ROCK/SUBGRADE BELOW AC PAVEMENT
51. REMOVE EXISTING DOOR THRESHOLD



& * & 9 / & 2168 / S 176 * 5283
Engineers/Planners
4444 Scotts Valley Drive / Ste 6
Scotts Valley, CA 95066
T (831) 438-4420 F (831) 438-5829




FACILITY:
PARKSIDE MONTESSORI SCHOOL
1685 EISENHOWER ST., SAN MATEO, CA 94403

PROJECT:
PARKSIDE MONTESSORI MULTIPURPOSE BLDG AND SITE WORK

SHEET NAME:
EXISTING SITE & DEMOLITION PLAN

ADDENDUM 4

FILE NO.: 41-26	A NO.: 01-120306
DATE: 06/10/2022	CLIENT PROJ NO.: 1002.02
SHEET:	

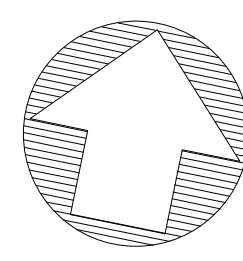


SCALE: 1"=20'



C1.1

GENERAL GRADING NOTES

1. SURFACE VEGETATION PRESENT AT THE TIME OF CONSTRUCTION SHOULD BE STRIPPED TOGETHER WITH ORGANIC LADEN TOPSOIL. THE ACTUAL DEPTH SHOULD BE DETERMINED BY THE GEOTECHNICAL ENGINEER AT THE TIME OF CONSTRUCTION. FOR PLANNING PURPOSES THE AVERAGE DEPTH MAY BE ASSUMED TO BE 3-INCHES IN VEGETATED AREAS.
2. ALL MATERIAL TO BE USED AS FILL WITHIN BUILDING PAD AREA & PARKING OR DRIVEWAY AREAS TO BE FREE OF ALL VEGETATION & FOREIGN MATTER AND SHALL BE APPROVED BY THE SOILS ENGINEER.
3. THESE SOILS WILL NEED TO BE PROCESSED; MOISTURE CONDITIONED AND RECOMPACTED AS ENGINEERED FILL. AT A MINIMUM, SUBGRADE SHOULD BE SACRIFICED TO A DEPTH OF 12-INCHES; MOISTURE CONDITIONED AND RECOMPACTED AS RECOMMENDED IN THE GEOTECHNICAL REPORT.
4. BUILDING PAD TO BE LEVEL SIDE-TO-SIDE, FRONT-TO-REAR, UNLESS OTHERWISE SHOWN.
5. STRIPPINGS MAY BE PLACED IN PLANTING AREAS. ALL EXCESS STRIPPING SHALL BE HAULED OFF. PAVING DEBRIS SHALL BE HAULED OFF TO AN APPROVED DISPOSAL SITE.
6. ALL WORK SHOWN OR NOTED IN THESE PLANS SHALL BE IN STRICT ACCORDANCE WITH THE RECOMMENDATIONS OF THE GEOTECHNICAL ENGINEER. ALL LOCAL, STATE AND FEDERAL MINIMUM STANDARDS AND THE LATEST EDITION OF THE UNIFORM BUILDING CODE.
7. CONTRACTOR SHALL PROTECT ALL EXISTING SITE IMPROVEMENTS NOT IDENTIFIED FOR REMOVAL DURING CONSTRUCTION. THEY SHALL REPAIR ANY DAMAGE TO NEW CONDITION AT THEIR EXPENSE.
8. VERIFY ALL EXISTING SITE CONDITIONS, SITE DIMENSIONS AND GRADES PRIOR TO THE START OF CONSTRUCTION.
9. ALL GRADING AND RELATED WORK SHALL BE PERFORMED IN ACCORDANCE WITH THE GEOTECHNICAL REPORT FOR THE PROJECT.
10. GRADING SLOPES FOR BOTH CUT AND FILL SHALL NOT EXCEED 2(H):1(V) UNLESS OTHERWISE DIRECTED BY THE GEOTECHNICAL ENGINEER.
11. ALL SOFTSCAPE GRADES ADJACENT TO NEW BUILDINGS SHALL BE 8" (MIN.) BELOW FINISH FLOOR.
12. CONTRACTOR SHALL GRADE TO ENSURE DRAINAGE FLOWS AWAY FROM (N) BUILDINGS.
13. AFTER THE NEW CONSTRUCTION AREAS HAVE BEEN CLEARED, STRIPPED AND EXCAVATED TO THE REQUIRED GRADE, THE EXPOSED SOIL SHALL BE MOISTURE CONDITIONED AND RECOMPACTED. THE UPPER 12-INCHES OF THE EXPOSED SUBGRADE SHOULD BE PROCESSED SUCH THAT THE MOISTURE REACHES THE APPROXIMATE LABORATORY ESTABLISHED OPTIMUM MOISTURE CONTENT, AND THEN COMPACTED TO AT LEAST 90-PERCENT RELATIVE COMPACTION AS DETERMINED BY ASTM TEST DESIGNATION D1557. THE MOISTURE CONDITIONING PROCESS SHOULD BE OBSERVED BY THE GEOTECH REPRESENTATIVE.
14. ANY LOOSE SOIL SHALL BE REMOVED AND REPLACED AS PROPERLY ENGINEERED FILL.
15. PRIOR TO SLAB-ON-GRADE FINAL PREPARATION, THE SLAB SUBGRADE SHALL BE CHECKED TO DETERMINE THAT THE UPPER 12-INCHES OF SUBGRADE SOIL IS AT OPTIMUM MOISTURE CONTENT OR ABOVE AND PROOF-ROLLED TO PROVIDE FIRM, UNIFORM SUPPORT.
16. IN ORDER TO PROVIDE SUITABLE SUPPORT FOR LIGHTLY LOADED CONVENTIONAL SPREAD FOOTING FOUNDATIONS SUPPORTING THE PLANNED SITE FURNISHINGS, THE EXISTING SOILS BENEATH THE FOOTINGS SHALL BE OVEREXCAVATED TO A DEPTH OF 18-INCHES BELOW THE BOTTOMS OF FOOTINGS AND REPLACED WITH VIRGIN (NON-RECYCLED) CLASS 2 AGGREGATE BASE/ROCK COMPACTED TO AT LEAST 90-PERCENT RELATIVE COMPACTION.
17. EXTERIOR CONCRETE FLATWORK, SIDEWALKS AND CURB AND GUTTERS SHOULD BE UNDERLAIN BY AT LEAST 12 INCHES OF CLASS 2 AGGREGATE BASE/ROCK PLACED ON THE PREPARED SUBGRADE.
18. REINFORCEMENT OF SLABS SHOULD BE PROVIDED IN ACCORDANCE WITH THEIR ANTICIPATED USE AND LOADING, BUT AS A MINIMUM, SLABS SHOULD BE REINFORCED WITH NO. 3 BARS AT 18 INCHES ON CENTER, BOTH WAYS, OR NO. 4 BARS AT 24 INCHES ON CENTER, BOTH WAYS. CONCRETE SLABS SHOULD BE ARTICULATED WITH A MAXIMUM JOINT SPACING OF TEN FEET IN BOTH DIRECTIONS.
19. PRIOR TO FINAL CONSTRUCTION OF SLABS, THE SUBGRADE SURFACE SHOULD BE PROOF ROLLED TO PROVIDE A SMOOTH, FIRM NON-YIELDING SURFACE. THE BASE/ROCK AND UPPER 12 INCHES OF UNDERLYING SUBGRADE SHOULD BE COMPACTED TO AT LEAST 90 PERCENT RELATIVE COMPACTION, OR 95 PERCENT IN AREAS OF VEHICULAR TRAFFIC.
20. THE MOISTURE CONTENT OF THE COMPACTED SUBGRADE SHOULD BE MAINTAINED AT, OR SLIGHTLY ABOVE, OPTIMUM MOISTURE PRIOR TO PLACING NON-EXPANSIVE FILL MATERIALS.
21. NEW HARDSCAPE AREAS REQUIRED FOR THE PROJECT SHOULD CONSIST OF TWO INCHES AC OVER 12 INCHES OF CLASS 2 AGGREGATE BASE/ROCK.
22. THE UPPER SIX INCHES OF NEW PAVEMENT AREA SUBGRADE SHOULD BE COMPACTED TO AT LEAST 95 PERCENT RELATIVE COMPACTION. ANY FILL REQUIRED BELOW THE UPPER SIX INCHES OF SUBGRADE SHOULD BE COMPACTED TO AT LEAST 90 PERCENT.

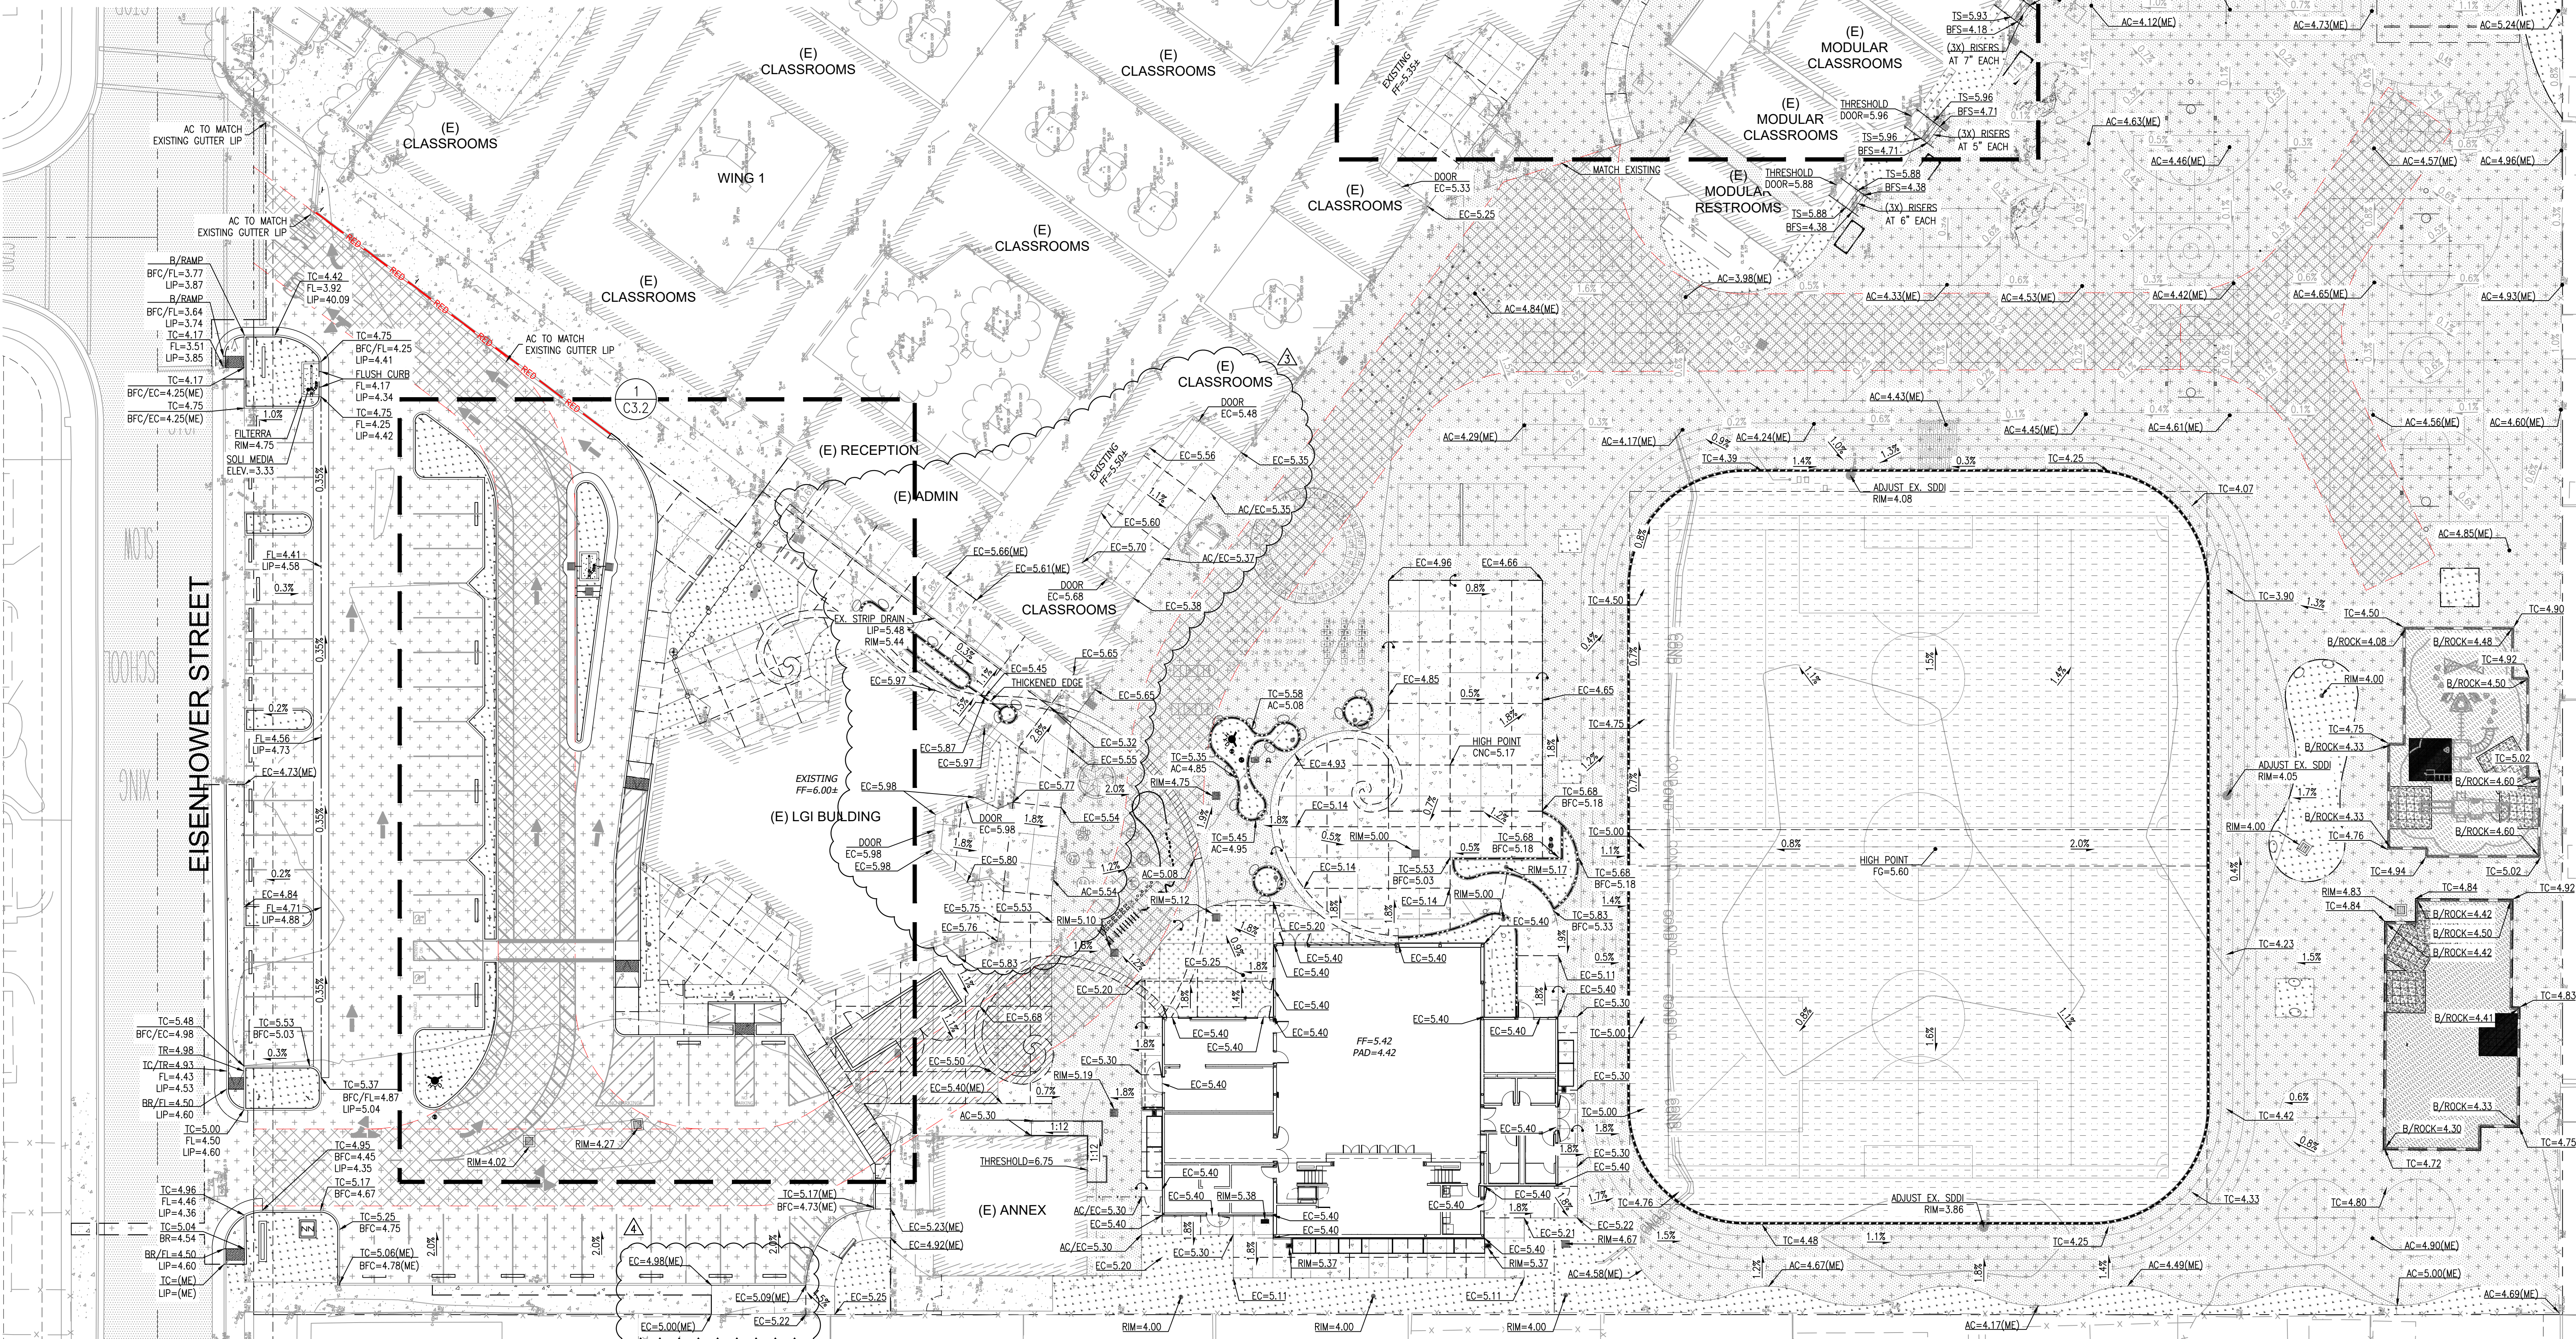

AGENCY
APPROVAL:
DSA # 01-120306
FILE # 41-26



SAN MATEO-FOSTER CITY
SCHOOL DISTRICT
1170 CHESS DR.,
FOSTER CITY, CA 94404

HMC Architects

3542005-000

833 W. SAN CARLOS STREET,
STUDIO 750, SAN JOSE, CA 95110
(408) 950-0070 | www.hmcarchitects.com

ISSUE

DESCRIPTION	DATE
ADDENDUM #1	08.11.2023
ADDENDUM #2	11.03.2023
ADDENDUM #4	11.21.2023

KEYNOTES

LEGEND


- (E) AC PAVEMENT
- (E) CONCRETE
- STANDARD AC PAVEMENT
- HEAVY DUTY AC PAVEMENT
- SYNTHETIC TURF (SEE LANDSCAPE PLANS)
- SAFETY SURFACING (SEE LANDSCAPE PLANS)
- FIRE HYDRANT
- FIRE DEPARTMENT CONNECTION (FDC)
- POST INDICATOR VALVE (PIV)
- STORM DRAIN DROP INLET
- STORM DRAIN AREA DRAIN
- SIGN
- FLUSH CONDITION BETWEEN HARDSCAPE

CURBING AND MISC ITEMS

- MATCHLINE
- EVA LANE
- CONCRETE VERTICAL CURB
- CONCRETE FLUSH CURB
- CONCRETE CURB & GUTTER



& • & 9 / & 2168 / 7 \$ 176 • 5283
Engineers/Planners
4444 Scotts Valley Drive / Ste 6
Scotts Valley, CA 95066
T (831) 438-4420 F (831) 438-5829

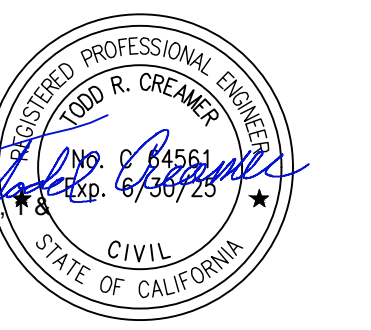


FACILITY:
PARKSIDE MONTESSORI SCHOOL
1685 EISENHOWER ST., SAN MATEO, CA 94403

PROJECT:
PARKSIDE MONTESSORI MULTIPURPOSE BLDG AND
SITE WORK

SHEET NAME:
GRADING PLAN

ADDENDUM 4

FILE NO.: 41-26	A NO.: 01-120306
DATE: 06/10/2022	CLIENT PROJ NO.: 1002.02
SHEET:	

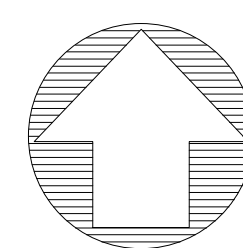

NORTH


SCALE: 1"=20'

20 40 60




PLEASE RECYCLE

C3.1

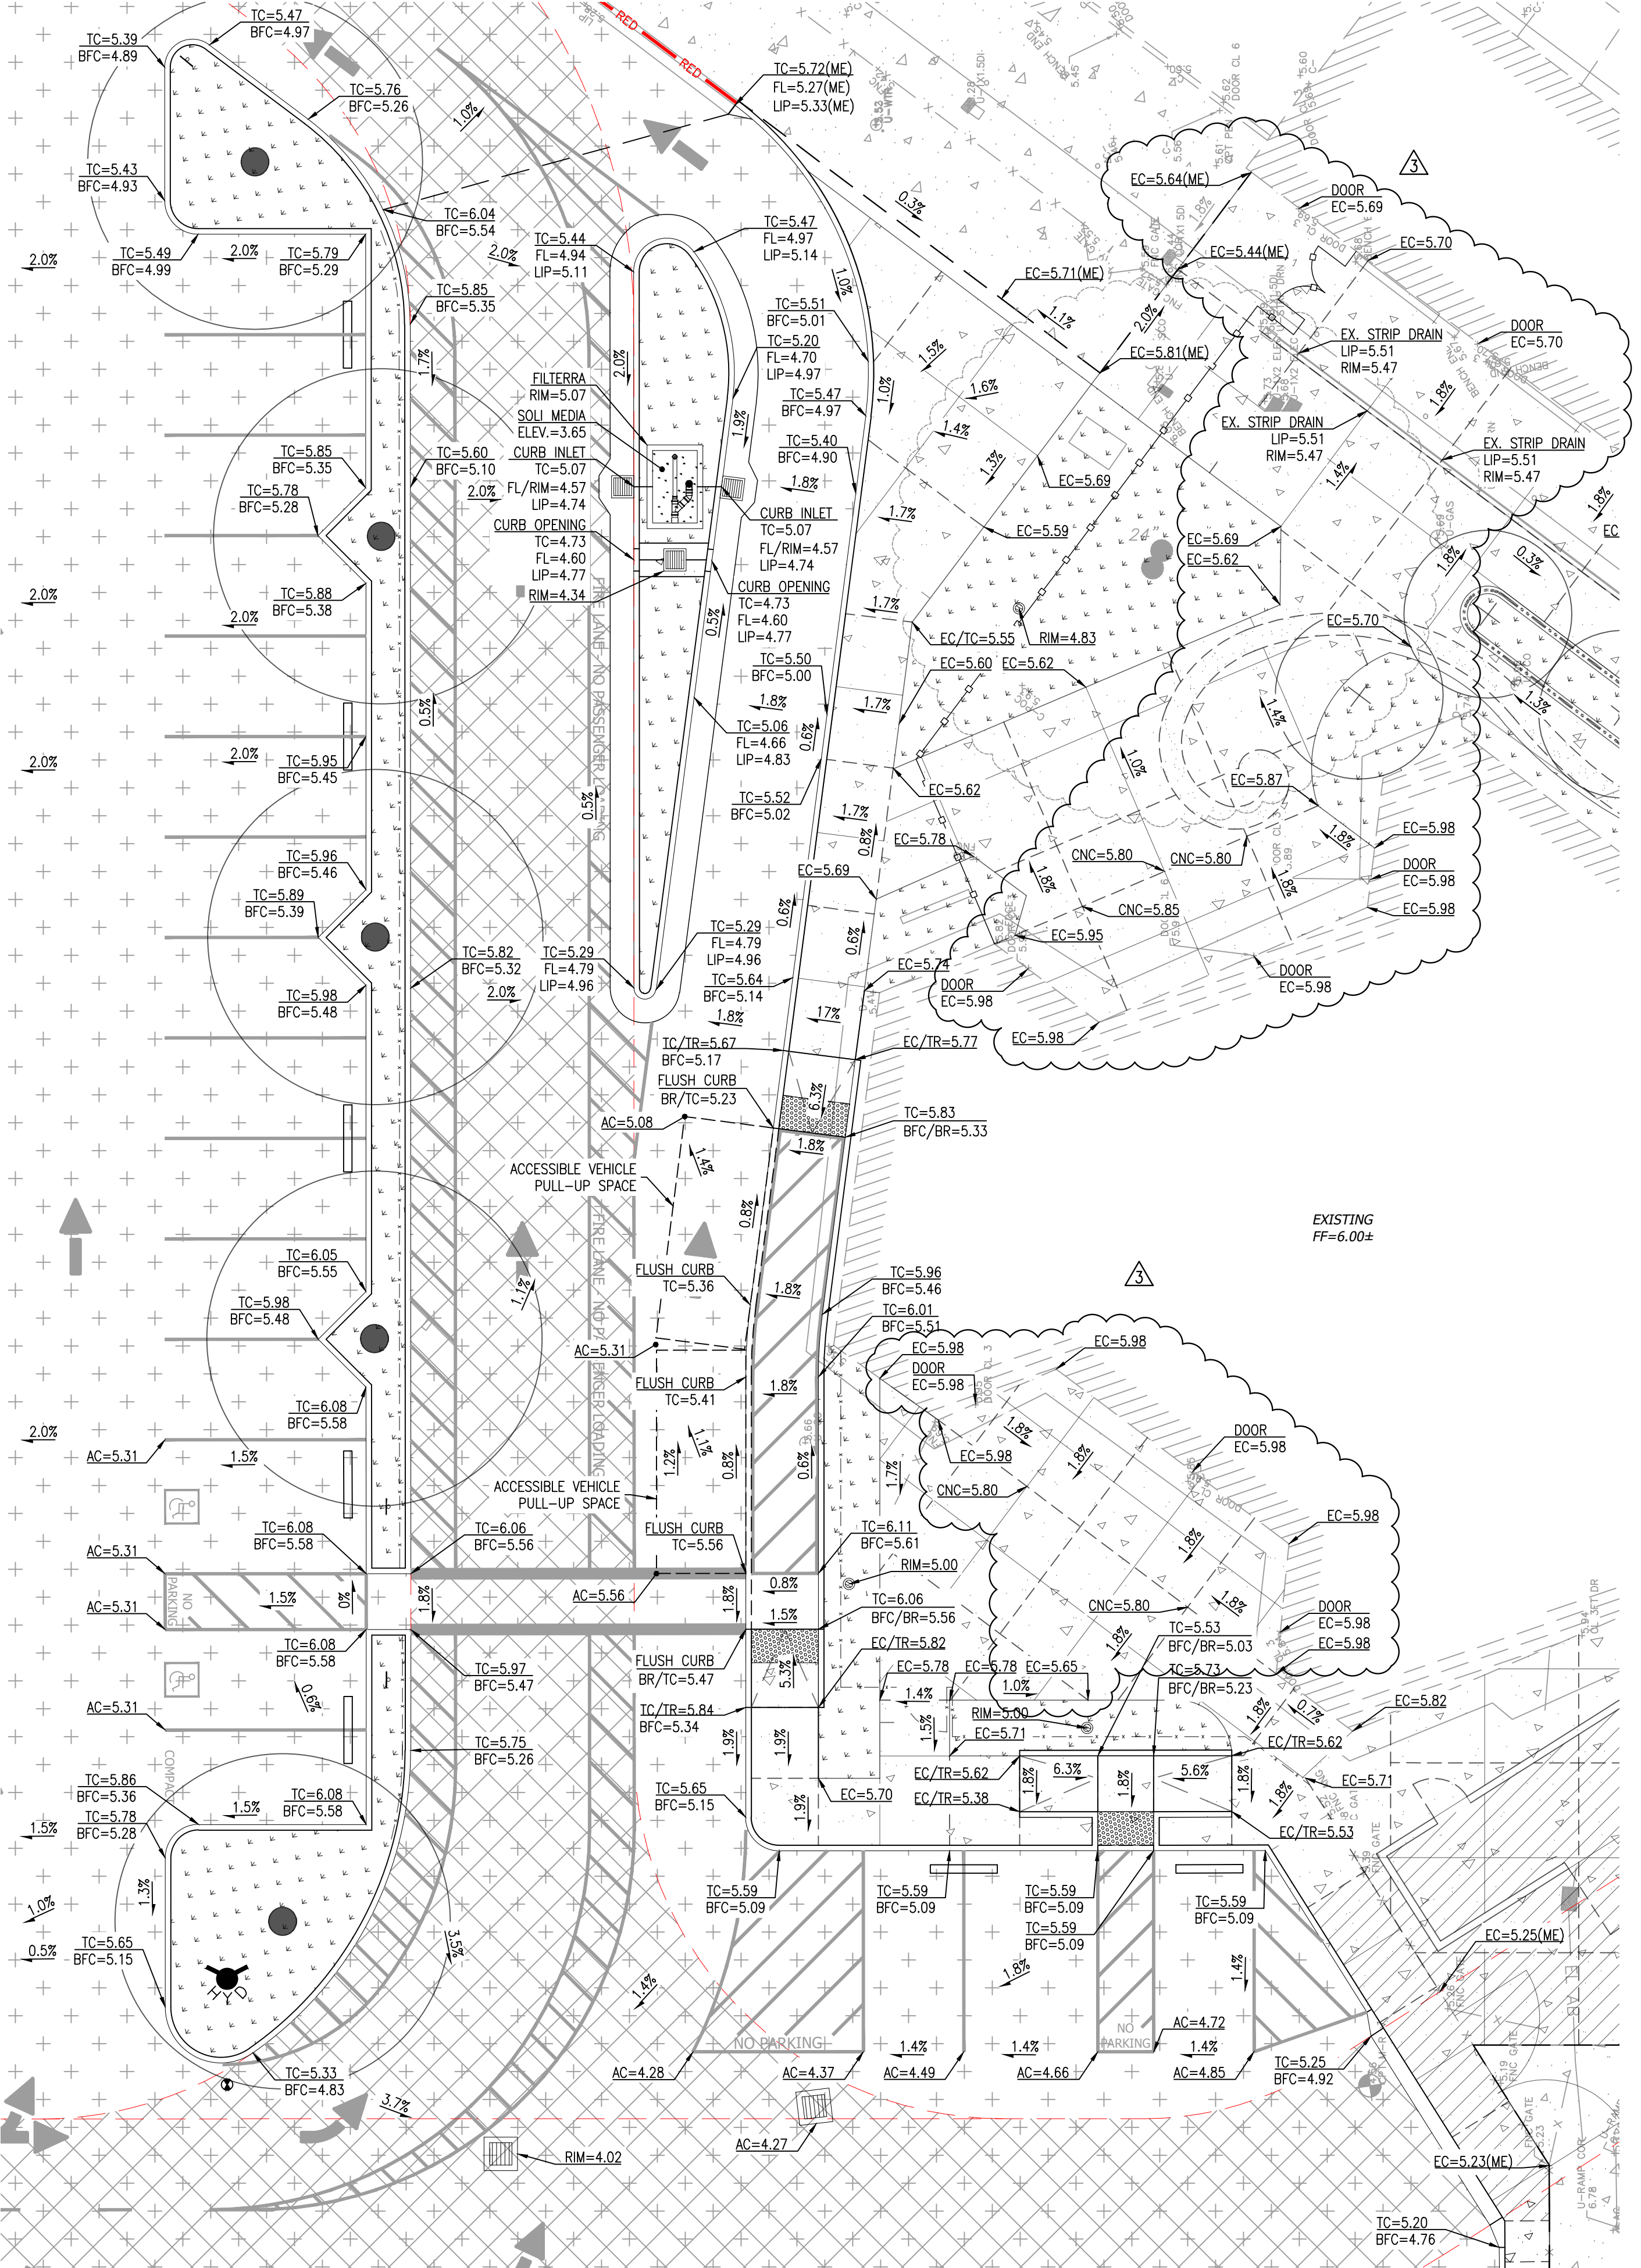

Scale: 1" = 10'

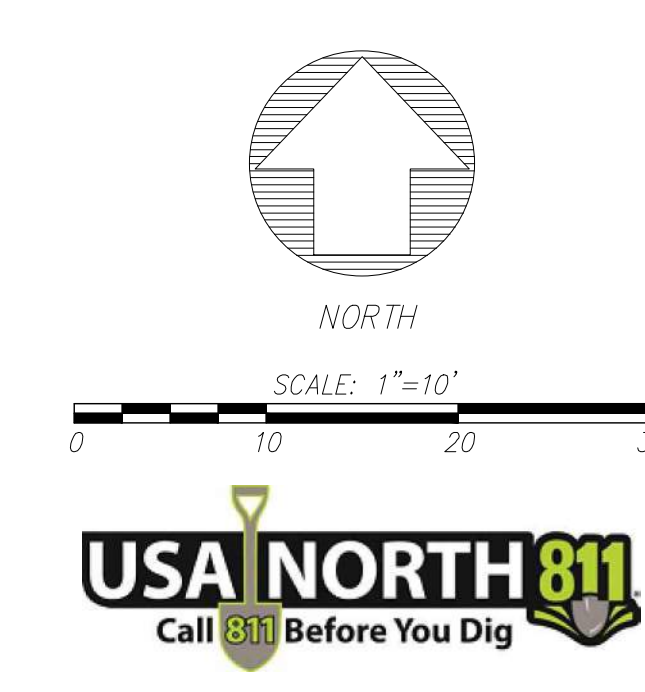

KEYNOTES

GENERAL GRADING NOTES

1. SURFACE VEGETATION PRESENT AT THE TIME OF CONSTRUCTION SHOULD BE STRIPPED TOGETHER WITH ORGANIC LAIDEN TOPSOIL. THE ACTUAL DEPTH SHOULD BE DETERMINED BY THE GEOTECHNICAL ENGINEER AT THE TIME OF CONSTRUCTION. FOR PLANNING PURPOSES THE AVERAGE DEPTH MAY BE ASSUMED TO BE 3-INCHES IN VEGETATED AREAS.
2. ALL MATERIAL TO BE USED AS FILL WITHIN BUILDING PAD AREA & PARKING OR DRIVEWAY AREAS TO BE FREE OF ALL VEGETATION & FOREIGN MATTER AND SHALL BE APPROVED BY THE SOILS ENGINEER.
3. THESE SOILS WILL HAVE TO BE PROCESSED; MOISTURE CONDITIONED AND RECOMPACT AS ENGINEERED FILL. AT A MINIMUM, SUBGRADE SHOULD BE SACRIFICED TO A DEPTH OF 12-INCHES; MOISTURE CONDITIONED AND RECOMPACT AS RECOMMENDED IN THE GEOTECHNICAL REPORT.
4. BUILDING PAD TO BE LEVEL SIDE-TO-SIDE, FRONT-TO-REAR, UNLESS OTHERWISE SHOWN.
5. STRIPPINGS MAY BE PLACED IN PLANTING AREAS; ALL EXCESS STRIPPING SHALL BE HAULED OFF. PAVING DEBRIS SHALL BE HAULED OFF TO AN APPROVED DISPOSAL SITE.
6. ALL WORK SHOWN OR NOTED IN THESE PLANS SHALL BE IN STRICT ACCORDANCE WITH THE RECOMMENDATIONS OF THE GEOTECHNICAL ENGINEER, ALL LOCAL, STATE AND FEDERAL WINDUIM STANDARDS AND THE LATEST EDITION OF THE UNIFORM BUILDING CODE.
7. CONTRACTOR SHALL PROTECT ALL EXISTING SITE IMPROVEMENTS NOT IDENTIFIED FOR REMOVAL DURING CONSTRUCTION. THEY SHALL REPAIR ANY DAMAGE TO NEW CONDITION AT THEIR EXPENSE.
8. VERIFY ALL EXISTING SITE CONDITIONS, SITE DIMENSIONS AND GRADES PRIOR TO THE START OF CONSTRUCTION.
9. ALL GRADING AND RELATED WORK SHALL BE PERFORMED IN ACCORDANCE WITH THE GEOTECHNICAL REPORT FOR THE PROJECT.
10. GRADING SLOPES FOR BOTH CUT AND FILL SHALL NOT EXCEED 2(H):1(V) UNLESS OTHERWISE DIRECTED BY THE GEOTECHNICAL ENGINEER.
11. ALL SOFTSPADE GRADES ADJACENT TO NEW BUILDINGS SHALL BE 8" (MIN.) BELOW FINISH FLOOR.
12. CONTRACTOR SHALL GRADE TO ENSURE DRAINAGE FLOWS AWAY FROM (N) BUILDINGS.

C2G

* & * 9 / & 2168/75176 * 5283

Engineers/Planners
4444 Scotts Valley Drive / Ste 6
Scotts Valley, CA 95066
T (831) 438-4420 F (831) 438-5829

REGISTERED PROFESSIONAL ENGINEER
TODD R. CREMER
No. 0 64561
Exp. 6/30/25
CIVIL
STATE OF CALIFORNIA

FACILITY:
PARKSIDE MONTESSORI SCHOOL
1685 EISENHOWER ST., SAN MATEO, CA 94403

PROJECT:
**PARKSIDE MONTESSORI MULTIPURPOSE BLDG AND
SITE WORK**

SHEET NAME:
ENLARGED GRADING PLAN

ADDENDUM 4

FILE NO.: 41-26	A NO.: 01-120306
DATE: 06/10/2022	CLIENT PROJ NO: 1002.02

SHEET: _____

C3.2

EROSION CONTROL BMP'S

- ALL CONSTRUCTION SITES
DELINEATE CLEARING LIMITS, SENSITIVE OR CRITICAL AREAS, TREES, DRAINAGE COURSES, AND BUFFER ZONES TO PREVENT EXCESSIVE OR UNNECESSARY DISTURBANCE AND EXPOSURE OF SOIL.
1. IDENTIFY ALL STORM DRAINS, DRAINAGE SWALES AND CREEKS LOCATED NEAR THE CONSTRUCTION SITE AND MAKE SURE ALL SUBCONTRACTORS ARE AWARE OF THEIR LOCATIONS TO PREVENT POLLUTANTS FROM ENTERING THEM.
 2. PRESERVE EXISTING VEGETATION, WHERE REQUIRED AND WHEN FEASIBLE, TO THE MAXIMUM EXTENT PRACTICABLE.
 3. PHASE GRADING OPERATIONS, TO THE EXTENT POSSIBLE, TO LIMIT AREAS OF DISTURBANCE AND TIME OF EXPOSURE.
 4. AVOID AND/OR MINIMIZE IMPACTS OF EXCAVATION AND GRADING DURING WET WEATHER AND IMMEDIATELY PRECEDING EXPECTED WET WEATHER. EXTRA BMP MATERIALS WILL BE KEPT ON-SITE FOR PRE-RAIN INSTALL BETWEEN OCTOBER 15 AND APRIL 15.
 5. MINIMIZE CUTS AND FILLS.
 6. IMPLEMENT MEASURES TO MINIMIZE EROSION, MANAGE STORM WATER RUNOFF, AND PREVENT POLLUTANTS FROM CONSTRUCTION ACTIVITIES FROM ENTERING STORM DRAINS.
 7. ALIGN TEMPORARY AND PERMANENT ROADS AND DRIVEWAYS ALONG SLOPE CONTOURS.
 8. WASH VEHICLES AT AN APPROPRIATE OFF-SITE FACILITY. IF EQUIPMENT MUST BE WASHED ON-SITE, USE WASH DOWN AREAS DEVELOPED FOR SPECIFIC SITE REQUIREMENTS AND APPROVED BY THE CITY REPRESENTATIVE. DO NOT USE SOAPS, SOLVENTS, DEGREASERS, OR STEAM CLEANING EQUIPMENT, AND PREVENT WASH WATER FROM ENTERING STORM DRAINS.

- GOOD HOUSEKEEPING PRACTICES
1. DO NOT WASH DOWN PAVEMENT OR SURFACES WHERE SILT HAS BEEN DEPOSITED OR MATERIALS HAVE SPILLED. USE DRY CLEANUP METHODS.
 2. AVOID CONTAMINATING CLEAN RUNOFF FROM AREAS ADJACENT TO YOUR SITE BY USING BERMS AND/OR TEMPORARY OR PERMANENT DRAINAGE DITCHES TO DIVERT WATER FLOW AROUND THE SITE.
 3. COVER EXPOSED PILES OF SOIL, CONSTRUCTION MATERIALS AND WASTES WITH PLASTIC SHEETING OR TEMPORARY ROOFS. BEFORE IT RAINS, SWEEP AND REMOVE MATERIALS FROM SURFACES THAT DRAIN TO STORM DRAINS, CREEKS, OR CHANNELS.
 4. PLACE TRASH CANS AROUND THE SITE TO REDUCE POTENTIAL LITTER. DISPOSE OF NON-HAZARDOUS CONSTRUCTION WASTES IN COVERED DUMPSTERS OR RECYCLING RECEPTACLES. RECYCLE LEFTOVER MATERIALS WHENEVER POSSIBLE.
 5. DISPOSE OF ALL WASTES PROPERLY. MATERIALS THAT CAN NOT BE REUSED OR RECYCLED MUST BE TAKEN TO AN APPROPRIATE LANDFILL OR DISPOSED OF AS HAZARDOUS WASTE, AS APPROPRIATE.
 6. COVER OPEN DUMPSTERS WITH PLASTIC SHEETING OR A TARP DURING RAINY WEATHER. SECURE THE SHEETING OR TARP AROUND THE OUTSIDE OF THE DUMPSTER. IF THE DUMPSTER HAS A COVER, CLOSE IT.
 7. ANY DETERIORATING MUST FIRST BE APPROVED BY THE CITY AND APPROPRIATE REGULATORY AGENCIES.
 8. TRAIN YOUR EMPLOYEES AND INFORM CONTRACTORS AND SUBCONTRACTORS ABOUT STORM WATER MANAGEMENT REQUIREMENTS AND THEIR RESPONSIBILITIES FOR COMPLIANCE.

- MINIMIZE SOIL MOVEMENT
1. STOCKPILED SOIL AND MATERIALS SHOULD BE COVERED AND STABILIZED WITH TARPS, GEOTEXTILE FABRIC, HYDROSEEDING AND/OR EROSION CONTROL BLANKETS.
 2. CREATE A BERM AND/OR INSTALL SILT FENCING AROUND STOCKPILED MATERIALS TO PREVENT STORM WATER RUNOFF FROM TRANSPORTING SEDIMENT OFFSITE.

3. USE STANDARD EROSION CONTROL SEEDING, PLANTING, MULCHING, GEOTEXTILE FABRIC AND/OR EROSION CONTROL BLANKETS TO STABILIZE DISTURBED SOIL AND REDUCE THE POTENTIAL FOR EROSION.
4. USE OTHER SOIL STABILIZERS AS APPROVED BY THE CITY OF SAN MATEO.

STRUCTURES TO CONTROL AND CONVEY RUNOFF

1. CONVEY RUNOFF BY USE OF EARTH DIKES, DRAINAGE SWALES AND/OR DITCHES WHEN FEASIBLE.
2. USE SLOPE DRAINS TO COLLECT AND CONVEY WATER FOR DISCHARGE BELOW SLOPES WHEN FEASIBLE.
3. USE VELOCITY DISSIPATION DEVICES, FLARED CULVERT END SECTIONS AND/OR CHECK DAMS TO REDUCE RUNOFF VELOCITY AND MITIGATE EROSION WHEN FEASIBLE.

CAPTURE SEDIMENT

1. USE TERRACING, RIPRAP, SAND BAGS, ROCKS, APPROVED TEMPORARY VEGETATION AND/OR OTHER APPROVED BMPs ON SLOPES TO REDUCE RUNOFF VELOCITY AND TRAP SEDIMENTS. DO NOT USE ASPHALT RUBBLE OR OTHER DEMOLITION DEBRIS FOR THIS PURPOSE.
2. PROTECT STORM DRAIN INLETS FROM SEDIMENT-LOADED RUNOFF. STORM DRAIN INLET PROTECTION DEVICES INCLUDE FILTEREX 8" SOXX W/ FILTER FABRIC, FILTER FABRIC FENCES AND BLOCKS AND GRAVEL FILTERS.
3. SAND BAGS, GRAVEL BAGS AND STRAW WATTLES AROUND STORM DRAIN INLETS THAT ARE EXPOSED TO VEHICULAR TRAFFIC ARE NOT ALLOWED.

OTHER RUNOFF CONTROLS

1. TEMPORARY SEDIMENT BASIN
2. SEDIMENT TRAP
3. BRUSH OR ROCK FILTER
4. SILT FENCE
5. SAND OR GRAVEL BAG BARRIER (NOT IN TRAFFIC AREAS)

TRACKING CONTROL

1. IMPLEMENT MEASURES AS NECESSARY TO MINIMIZE TRACKING OF SOIL OFF SITE
2. USE DRY SWEEPING METHODS WHEN CLEANING SEDIMENTS FROM STREETS, DRIVEWAYS AND PAVED AREAS BY HAND. WHEN USING MECHANICAL STREET SWEEPERS, USE FINE WATER SPRAY TO REDUCE DUST AND IMPROVE SEDIMENT REMOVAL WHILE MINIMIZING RUNOFF.

PAINT WORK

1. DO NOT CLEAN PAINT BRUSHES OR RINSE PAINT CONTAINERS INTO A STREET, GUTTER, STORM DRAIN, OR CREEK.
2. FOR WATER-BASED PAINTS, PAINT OUT BRUSHES TO THE EXTENT POSSIBLE AND RINSE TO A DRAIN LEADING TO THE SANITARY SEWER (I.E., INDOOR PLUMBING).
3. FOR OIL-BASED PAINTS, PAINT OUT BRUSHES TO THE EXTENT POSSIBLE, AND FILTER AND REUSE THINNERS AND SOLVENTS. DISPOSE OF UNUSABLE THINNERS, OIL-BASED PAINT, SLUDGES AND RESIDUE AS HAZARDOUS WASTE.
4. NON-HAZARDOUS PAINT CHIPS AND DUST FROM DRY STRIPPING AND SAND BLASTING MAY BE SWEEPED UP OR COLLECTED IN PLASTIC DROP CLOTHS AND DISPOSED OF AS TRASH. CHEMICAL PAINT STRIPPING RESIDUE AND CHIPS AND DUST FROM MARINE PAINTS OR PAINTS CONTAINING LEAD OR TRIBUTYL TIN MUST BE DISPOSED OF AS A HAZARDOUS WASTE.
5. WHEN STRIPPING OR CLEANING BUILDING EXTERIORS WITH HIGH-PRESSURE WATER, COVER OR BERM STORM DRAIN INLETS. COLLECT (MOP OR VACUUM) BUILDING CLEANING WATER FOR DISPOSAL IN A PRE-AUTHORIZED MANNER. RECYCLE, RETURN TO SUPPLIER OR DONATE UNWANTED WATER-BASED (LATEX) PAINT.
6. DRIED LATEX PAINT MAY BE DISPOSED OF IN THE TRASH.

CEMENT AND CONCRETE WORK

1. AVOID MIXING EXCESS AMOUNTS OF FRESH CONCRETE OR CEMENT MORTAR ON-SITE.
2. STORE DRY AND WET CONCRETE AND CEMENT UNDER COVER, PROTECTED FROM RAINFALL AND RUNOFF.
3. WASH OUT CONCRETE TRANSIT MIXERS ONLY IN DESIGNATED WASH-OUT AREAS. WHENEVER POSSIBLE, RECYCLE WASHOUT BY PUMPING BACK INTO MIXERS FOR REUSE. DO NOT DISPOSE OF WASHOUT INTO THE STREET. STORM DRAINS, DRAINAGE DITCHES, OR CREEKS. DESIGNATED WASH-OUT AREAS MUST BE MAINTAINED TO PREVENT OVER FLOW.
4. WHENEVER POSSIBLE, RETURN CONTENTS OF MIXER BARREL TO THE OFF-SITE YARD FOR RECYCLING. DISPOSE OF SMALL AMOUNTS OF EXCESS CONCRETE, GROUT, AND MORTAR IN THE TRASH.


ROADWORK/PAVEMENT

5. APPLY CONCRETE, ASPHALT, AND SEAL COAT DURING DRY WEATHER TO PREVENT CONTAMINANTS FROM CONTACTING STORMWATER RUNOFF.
6. COVER STORM DRAIN INLETS AND MANHOLES WHEN PAVING OR APPLYING SEAL COAT, SLURRY SEAL, FOG SEAL, AND SIMILAR MATERIALS.
7. ALWAYS PARK PAVING MACHINES OVER DRIP PANS OR ABSORBENT MATERIALS, SINCE THEY TEND TO DRIP CONTINUOUSLY.
8. WHEN MAKING SAW-CUTS IN PAVEMENT, USE AS LITTLE WATER AS POSSIBLE. COVER POTENTIALLY AFFECTED STORM DRAIN INLETS COMPLETELY WITH FILTER FABRIC DURING THE SAWING OPERATION AND CONTAIN THE SLURRY BY WET-VACUUMING, OR BY PLACING STRAW BALES, SANDBAGS, OR GRAVEL DAMS AROUND THE CATCH BASINS. AFTER THE LIQUID DRAINS OR EVAPORATES, SHOVEL OR VACUUM THE SLURRY RESIDUE FROM THE PAVEMENT OR GUTTER AND REMOVE FROM SITE.
9. WASH DOWN EXPOSED AGGREGATE CONCRETE ONLY WHEN THE WASH WATER CAN: (1) FLOW ONTO A DIRT AREA; (2) DRAIN ONTO A BERMED SURFACE FROM WHICH IT CAN BE PUMPED AND DISPOSED OF PROPERLY; OR (3) BE VACUUMED FROM THE AREA ALONG THE CURB WHERE SEDIMENT HAS ACCUMULATED BY BLOCKING A STORM DRAIN INLET.
10. ALLOW AGGREGATE RINSE TO SETTLE, AND PUMP THE WATER TO THE SANITARY SEWER IF ALLOWED BY YOUR LOCAL WASTEWATER AUTHORITY.
11. DO NOT WASH SWEEPINGS FROM EXPOSED AGGREGATE CONCRETE INTO A STREET OR STORM DRAIN. COLLECT AND RETURN TO AGGREGATE BASE STOCKPILE, OR DISPOSE WITH TRASH.
12. RECYCLE BROKEN CONCRETE AND ASPHALT.

HAZARDOUS MATERIAL SPILL PREVENTION, SPILL REPORTING AND RESPONSE

1. ALL HAZARDOUS MATERIALS SHALL BE STORED SO THAT THEY ARE PROTECTED FROM INCLEMENT WEATHER AND VANDALISM.
2. MOTOR VEHICLES SHALL NOT BE FUELED ON THE PROJECT SITE.
3. SPILL CONTAINMENT MEASURES MUST BE MADE PRIOR TO FUELING WHEN FUELING EQUIPMENT OTHER THAN MOTOR VEHICLES.
4. VEHICLE MAINTENANCE, OTHER THAN EMERGENCY REPAIRS, SHALL NOT BE PERFORMED ON THE PROJECT SITE.
5. ALL INACTIVE VEHICLES/EQUIPMENT SHALL USE COVERS AND/OR DRIP PANS.
6. APPROPRIATE EMERGENCY SPILL CONTAINMENT SUPPLIES SHALL BE MAINTAINED ON SITE BY THE CONTRACTOR.
7. SPILLS GREATER THAN ONE QUART SHALL BE IMMEDIATELY REPORTED TO THE CITY'S REPRESENTATIVE.
8. SPILLS SHALL BE OILED OR CONTAINED BY TRAINED PERSONNEL TO PREVENT THE SPILLED HAZARDOUS MATERIAL FROM ENTERING THE STORM WATER SYSTEM OR LEAVING THE PROJECT SITE.
9. SPILLS OF LESS THAN FIVE (5) GALLONS SHALL BE ABSORBED USING AN

- APPROPRIATE MATERIAL. ALL CONTAMINATED MATERIALS SHALL BE CONTAINERIZED, REMOVED FROM THE JOBSITE AND DISPOSED IN ACCORDANCE WITH FEDERAL, STATE AND LOCAL REGULATIONS.
10. SPILLS IN EXCESS OF FIVE (5) GALLONS SHALL BE ABSORBED USING AN APPROPRIATE MATERIAL AND PLACED IN CONTAINERS UNDER THE DIRECTION OF THE CITY OFFICE OF ENVIRONMENTAL HEALTH AND SAFETY.
 11. ANY CONTAMINATED SOIL SHALL BE REMOVED BY THE CONTRACTOR AND REPLACED WITH ACCEPTABLE FRESH SOIL.
 12. ANY CONTAMINATED STORMWATER WILL BE MANAGED AS NON-STORMWATER.
 13. RESPONSE SHALL BE CARRIED OUT BY APPROPRIATELY TRAINED PERSONNEL UTILIZING SAFE PRACTICES.

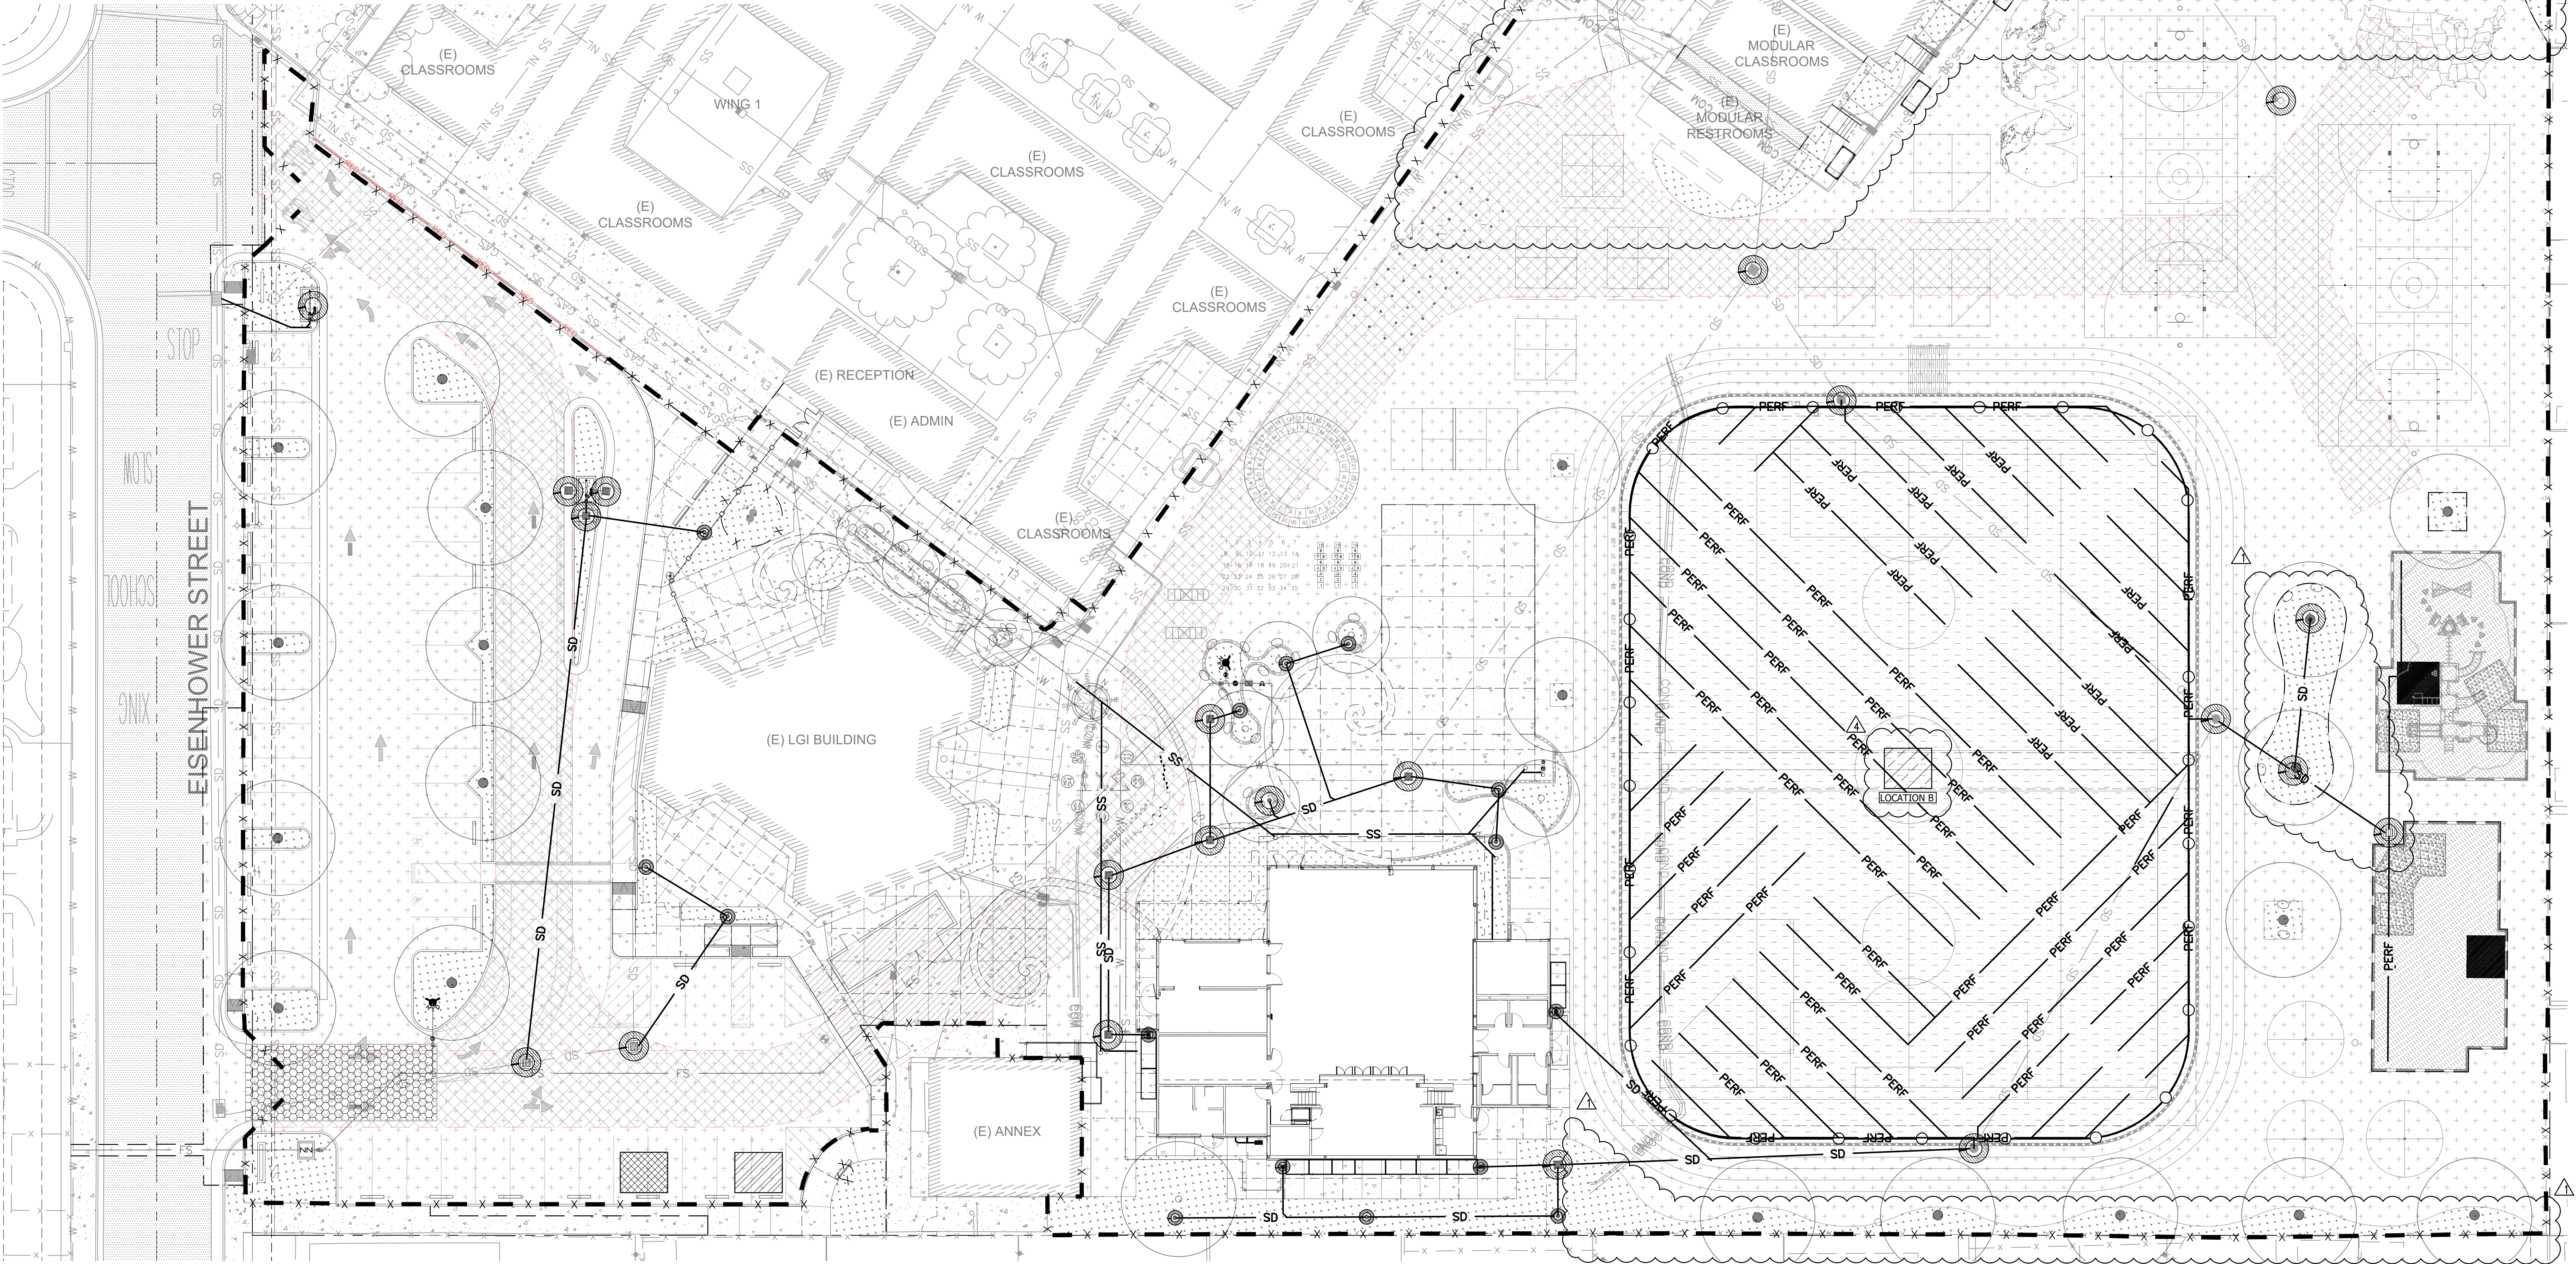

AGENCY
APPROVAL:
DSA # 01-120306
FILE # 41-26



SAN MATEO-FOSTER CITY
SCHOOL DISTRICT
1170 CHESS DR.,
FOSTER CITY, CA 94404

HMC Architects

3542005-000

633 W. SAN CARLOS STREET,
STUDIO 750, SAN JOSE, CA 95110
950.989.9070 / www.hmcarchitects.com

ISSUE

DESCRIPTION	DATE
ADDENDUM #1	08.11.2023
ADDENDUM #2	11.03.2023
ADDENDUM #4	11.21.2023

KEYNOTES

LEGEND


- X — X — TREE PROTECTION (6 C6.2)
- - - X - - - SILT FENCE (1 C6.2)
- FILTEREX 8" SOXX W/ MIRAFI 140N FABRIC (4 C6.2)
- FIBER ROLL (2 C6.2)
- DIRECTION OF FLOW WITH STORM DRAIN INSTALLED
- STABILIZED CONSTRUCTION ENTRANCE/EXIT (3 C6.2)

SWPPP MANAGER TO MARK KNOWN LOCATIONS

- MATERIALS & EQUIPMENT STORAGE AREA
- SANITARY FACILITY
- CONCRETE/WASTE WASHOUT (5 C6.2)
- PROPOSED SOIL AND BOULDER STOCKPILE LOCATION



& * & 9 / & 2168 / 75176 * 5283
Engineers/Planners
4444 Scotts Valley Drive / Ste 6
Scotts Valley, CA 95066
T (831) 438-4420 F (831) 438-5829

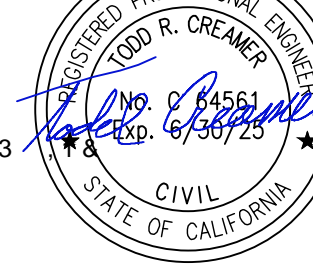


FACILITY:
PARKSIDE MONTESSORI SCHOOL
1685 EISENHOWER ST., SAN MATEO, CA 94403

PROJECT:
PARKSIDE MONTESSORI MULTIPURPOSE BLDG AND SITE WORK

SHEET NAME:
EROSION CONTROL PLAN

ADDENDUM 4

FILE NO.: 41-26	A NO.: 01-120306
DATE: 06/10/2022	CLIENT PROJ NO.: 1002.02
SHEET:	

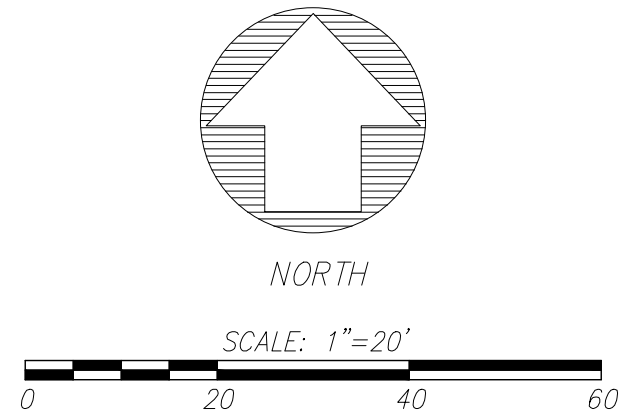

C6.1

PLEASE RECYCLE

DATE: 06/10/2022
DRAWN BY: J. L. L. L.
CHECKED BY: J. L. L. L.
SCALE: 1" = 20'-0"

LAYOUT LEGEND

SYMBOL	DESCRIPTION OF SYMBOL
ALN	ALIGN
BCR	BEGINNING OF CURVE RETURN
BOC	BACK OF CURB
BS	BOTTOM OF STAIRS / STEPS
BOW	BACK OF WALL
C	CENTERLINE
CLR	CLEAR
DIA	DIAMETER
ECR	END OF CURVE RETURN
R	END OF RADIUS
EJ	EXPANSION JOINT, TYPICAL
EQ	EQUAL
EW	EACH WAY
FOB	FACE OF BUILDING
FOC	FACE OF CURB
FOW	FACE OF WALL
MAX	MAXIMUM
MIN	MINIMUM
OC	ON CENTER
PA	PLANTING AREA
POB	POINT OF BEGINNING
PT	POINT OF TANGENCY
R	RADIUS
SJ	SCORE JOINT, TYPICAL
TS	TOP OF STAIRS / STEPS
TYP	TYPICAL

LAYOUT NOTES

- THESE NOTES ARE FOR GENERAL REFERENCE IN CONJUNCTION WITH AND AS A SUPPLEMENT TO THE WRITTEN SPECIFICATIONS, DETAILS, ADDENDA AND CHANGE ORDERS ASSOCIATED WITH THE CONTRACT DOCUMENTS.
- DRAWINGS SHALL NOT BE SCALED. WRITTEN DIMENSIONS TAKE PRECEDENCE. IF CONTRACTOR FINDS A DISCREPANCY WITH WRITTEN DIMENSIONS, NOTIFY OWNER'S REPRESENTATIVE BEFORE PROCEEDING WITH WORK.
- THE CONTRACTOR SHALL BE RESPONSIBLE FOR VERIFYING THE EXISTENCE OF AND LOCATIONS OF EXISTING AND PROPOSED UNDERGROUND SERVICES AND IMPROVEMENTS WHICH MAY CONFLICT WITH THE WORK. CONTACT THE OWNER'S REPRESENTATIVE AND UNDERGROUND SERVICE ALERT (USA) AT (800) 642-2444 PRIOR TO INITIATING CONSTRUCTION FOR ASSISTANCE.
- COORDINATE CONSTRUCTION ELEMENTS PRIOR TO INSTALLATION. VERIFY WALLS, CURBS, FENCES, ETC. AND CRITICAL DIMENSIONS, REFERENCE AND COORDINATE POINT LOCATIONS, AND CONSTRUCTION CONDITIONS PRIOR TO INITIATING CONSTRUCTION. NOTIFY THE OWNER'S REPRESENTATIVE IMMEDIATELY SHOULD DISCREPANCIES ARISE.
- CONTRACTOR SHALL LAYOUT PROJECT ELEMENTS IN FIELD AS SHOWN ON THESE PLANS AND HAVE THEM APPROVED BY THE OWNER'S REPRESENTATIVE PRIOR TO CONSTRUCTION.
- MINOR ADJUSTMENTS MADE TO ACCOMMODATE EXISTING SITE CONDITIONS SHALL MAINTAIN THE OVERALL DESIGN LAYOUT. ADJUSTMENTS SHALL BE APPROVED BY THE OWNER'S REPRESENTATIVE PRIOR TO CONSTRUCTION.
- NEW PAVED SURFACES SHALL CONFORM TO EXISTING PAVED SURFACES, FLUSH AND SMOOTH. CONTRACTOR SHALL CONSTRUCT SMOOTH TRANSITIONS OF PAVING AND WALKS WHILE MAINTAINING POSITIVE DRAINAGE.
- COORDINATE SLEEVING AND UTILITY LOCATIONS AS SHOWN ON THE PLANS AND DETAILS CONTAINED WITHIN THESE CONTRACT DOCUMENTS AND THE REQUIREMENTS OF NFPA 24, SECTION 8.1, "MINIMUM DEPTH OF COVER" (36 INCHES) FOR PIPE BENEATH FIRE LANE ACCESS ROUTES.
- CONDITIONS NOT SPECIFICALLY NOTED OR DETAILED ON THESE PLANS SHALL BE CALLED TO THE ATTENTION OF THE OWNER'S REPRESENTATIVE FOR REVIEW PRIOR TO IMPLEMENTATION.
- THE CONTRACTOR SHALL BE RESPONSIBLE UNDER THIS CONTRACT FOR REPAIRING OR REPLACING, AT THEIR OWN EXPENSE, ANY STRUCTURES, FENCES, WALLS, PLANT MATERIAL OR TREES DAMAGED OR DESTROYED, BOTH ON THIS PROPERTY OR THOSE PROPERTIES ADJACENT TO THIS SITE. THE DAMAGED ITEM(S) WILL BE RESTORED TO THEIR ORIGINAL CONDITION OR REPLACED TO THE SATISFACTION OF THE OWNER'S REPRESENTATIVE.
- ANGLES FOR LAYOUT TO BE 90 DEGREES UNLESS OTHERWISE NOTED.



AGENCY
APPROVAL:
DSA # 01-120306
FILE # 41-26

REVIEWING AGENCIES
STAMP HERE



SAN MATEO-FOSTER CITY
SCHOOL DISTRICT
1170 CHESS DR.
FOSTER CITY, CA 94404

HMC Architects

3542005-000

533 W. SAN CARLOS STREET,
STUDIO 750, SAN JOSE, CA 95110
909 989 9979 / www.hmcarchitects.com

ISSUE


DESCRIPTION	DATE
ADDENDUM 1	8/11/2023
ADDENDUM 2	11/6/2023
ADDENDUM 4	11/21/2023

KEYNOTES

NOTES

Consultant:

ANLA
1723 Hamilton Ave, Ste 101
San Jose, CA 95125
T. 408.292.2196
www.anla-associates.com

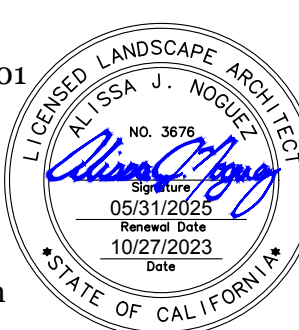

Consultant's Project No. ANLA 2145

FACILITY:

PARKSIDE MONTESSORI SCHOOL
1685 EISENHOWER ST.
SAN MATEO, CA 94403

PROJECT:

PARKSIDE MONTESSORI MULTIPURPOSE BLDG AND
SITE WORK

SHEET NAME:

LAYOUT PLAN

ADDENDUM 4

FILE NO.: 41-26

A NO.: 01-120306

DATE: 06/10/2022


CLIENT PROJ NO.:

SHEET:

ANLA 2145



SCALE: 1" = 20'-0"

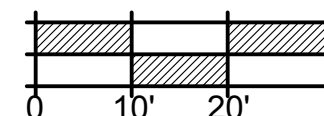

PLEASE RECYCLE

L1.1

DATE: 06/10/2022
DRAWN BY: ANLA
CHECKED BY: ANLA
SHEET: 01-120306-000

NOTE
SEE SHEET L2.2 FOR MATERIAL AND DETAIL REFERENCE NOTES AND LEGEND

REFER TO SHEET L2.2 FOR MATERIAL AND
DETAIL REFERENCE NOTES AND LEGEND

AGENCY
APPROVAL:
DSA # 01-120306
FILE # 41-26

REVIEWING AGENCIES
STAMP HERE



SAN MATEO-FOSTER CITY
SCHOOL DISTRICT
1170 CHESS DR.
FOSTER CITY, CA 94404

HMC Architects

3542005-000

533 W. SAN CARLOS STREET,
STUDIO 750, SAN JOSE, CA 95110
909 989 9979 / www.hmcarchitects.com

ISSUE


DESCRIPTION	DATE
ADDENDUM 1	8/11/2023
ADDENDUM 2	11/6/2023
ADDENDUM 4	11/21/2023

KEYNOTES

NOTES

Consultant:

ANLA
1723 Hamilton Ave, Ste 101
San Jose, CA 95125
T. 408.292.2196
www.anla-associates.com

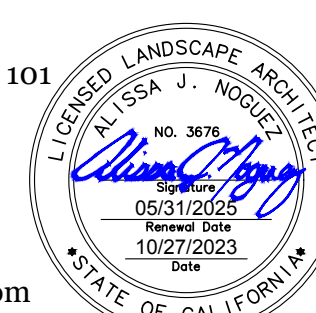

Consultant's Project No. ANLA 2145

FACILITY:
PARKSIDE MONTESSORI SCHOOL
1685 EISENHOWER ST.
SAN MATEO, CA 94403

PROJECT:
PARKSIDE MONTESSORI MULTIPURPOSE BLDG AND
SITE WORK

SHEET NAME:
MATERIALS AND CONSTRUCTION
DETAIL REFERENCE PLAN

ADDENDUM 4


FILE NO.: 41-26 A NO.: 01-120306

DATE: 06/10/2022 CLIENT PROJ NO.: ANLA 2145

SHEET:

L2.1

EISENHOWER STREET

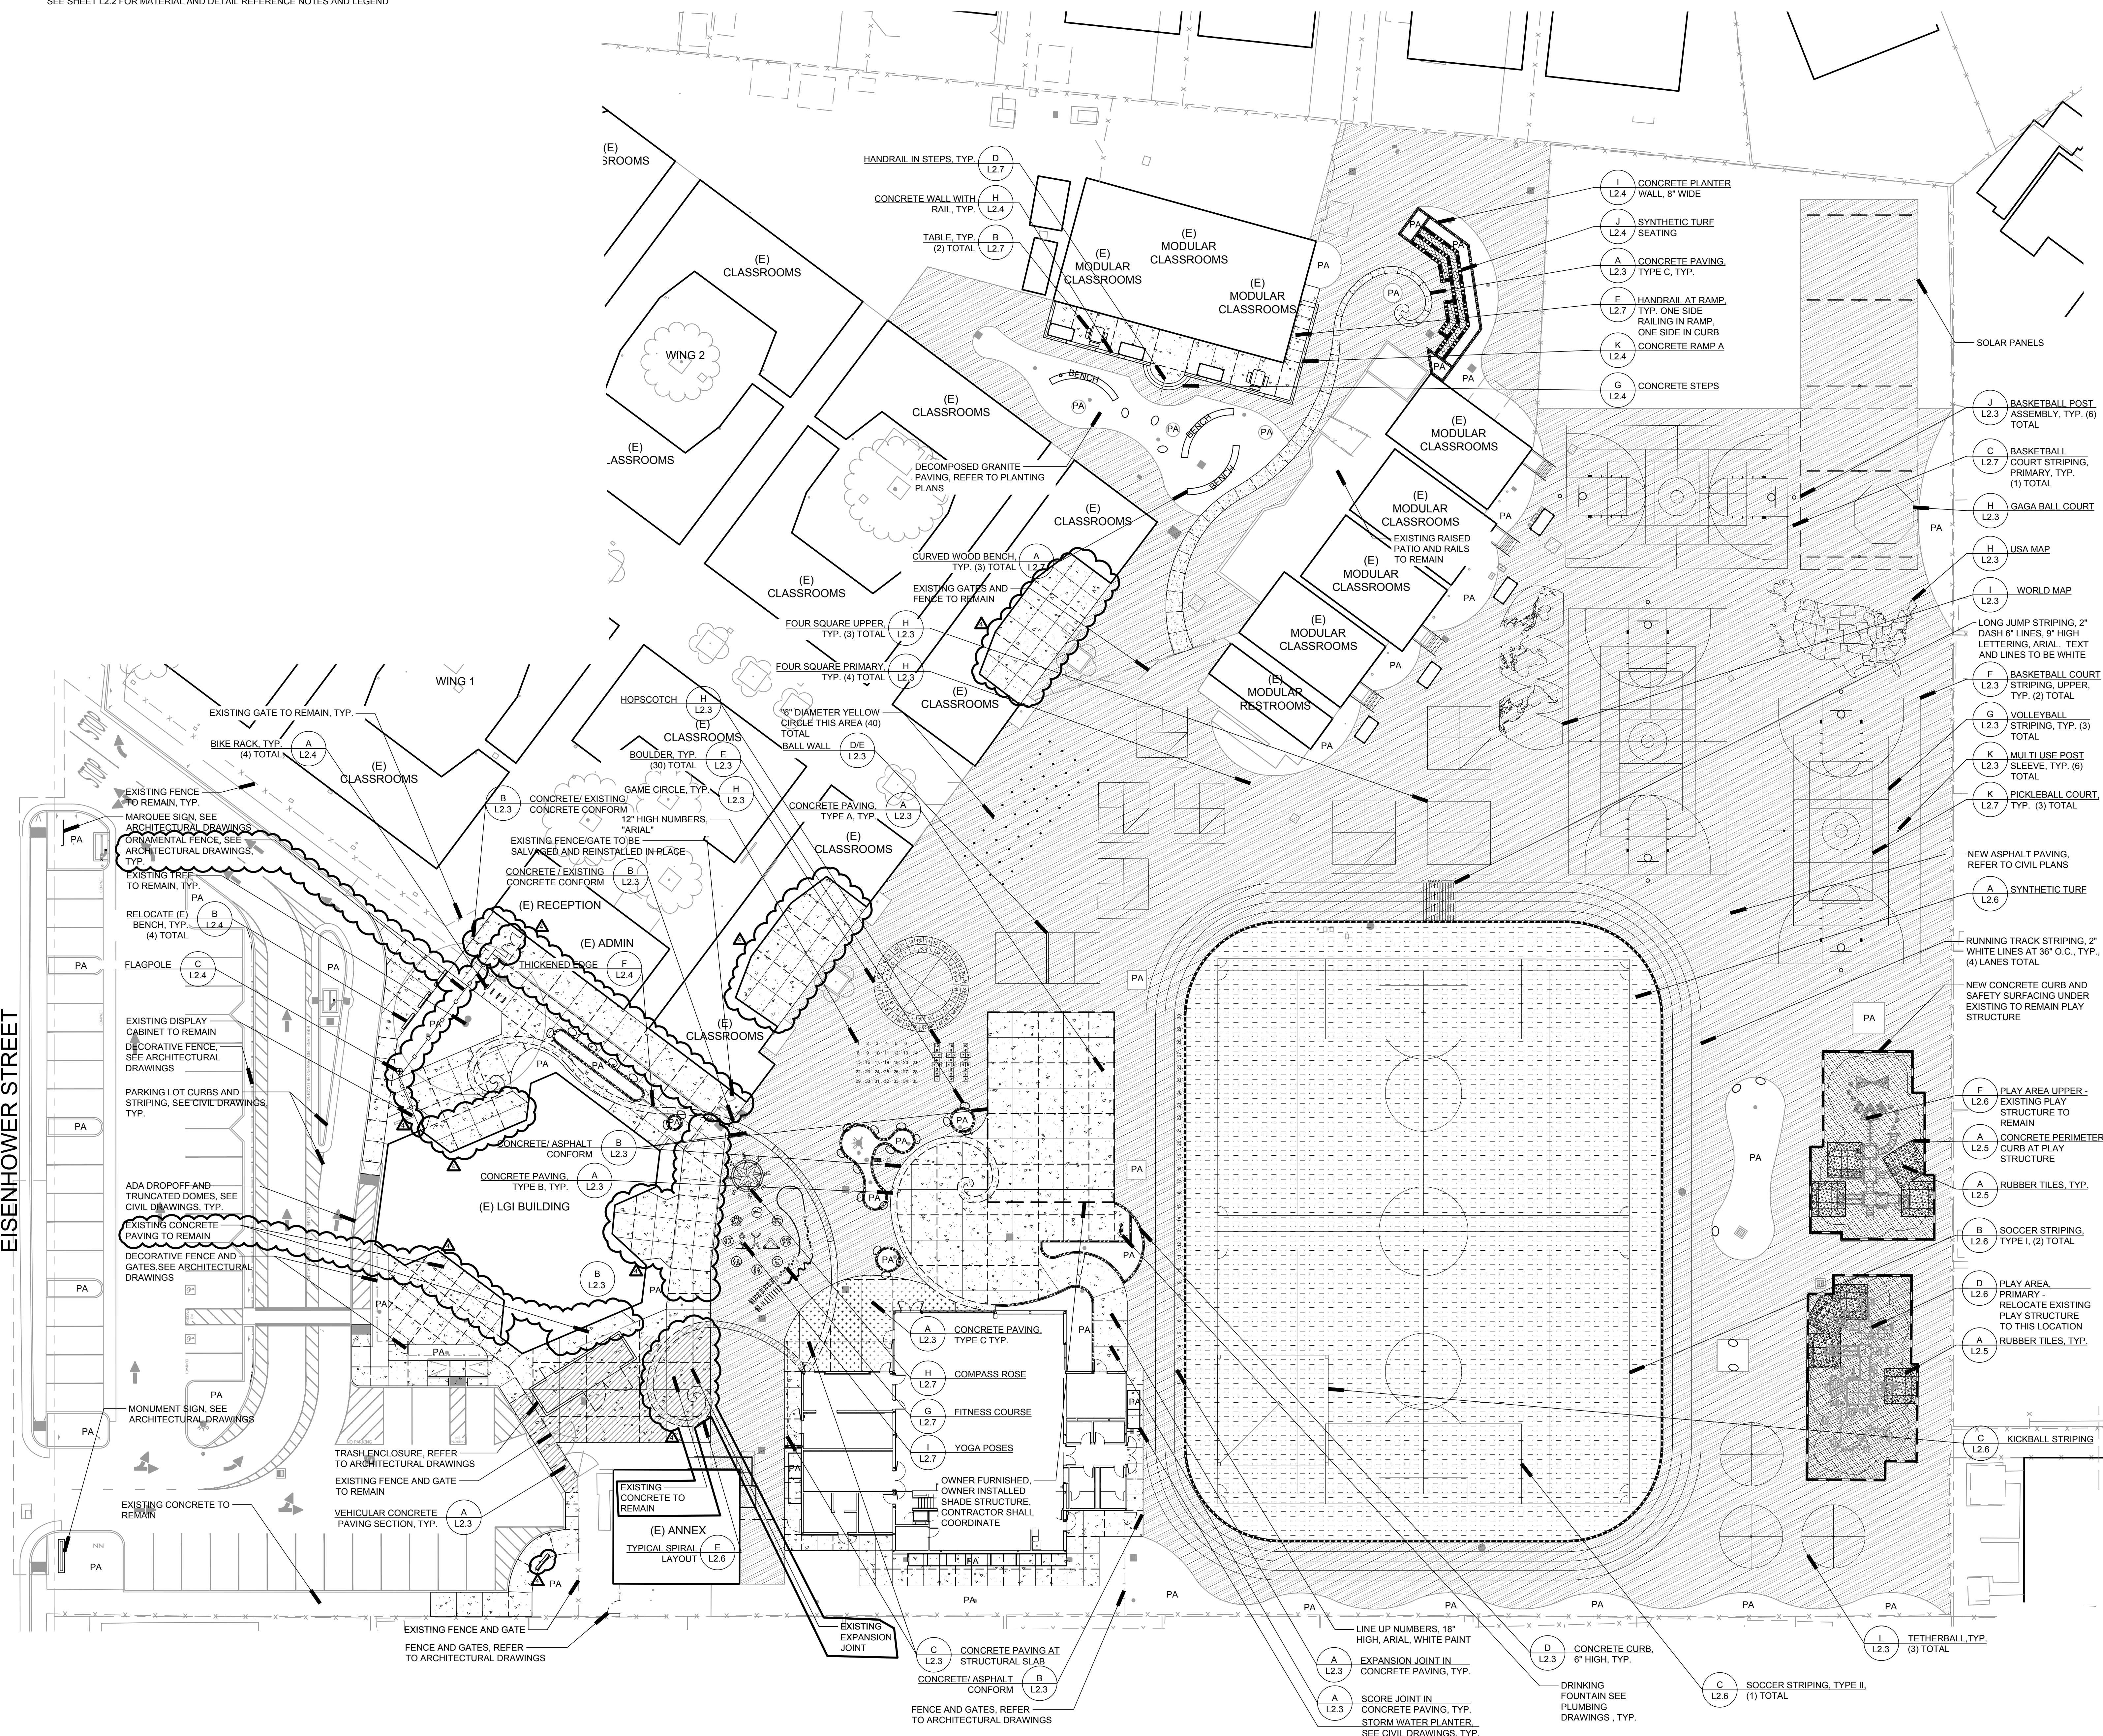

PLEASE RECYCLE

MATERIALS AND DETAIL REFERENCE LEGEND


SYMBOL	DESCRIPTION	DETAIL
	CONCRETE PAVING TYPE A, MEDIUM BROOM FINISH, NATURAL COLOR	A, L2.3
	CONCRETE PAVING TYPE B, MEDIUM SALT FINISH, COLORED CONCRETE DAVIS COLORS, #3685 GREEN SLATE	A, L2.3
	CONCRETE PAVING TYPE C, MEDIUM BROOM FINISH, COLORED CONCRETE DAVIS COLORS, #3685 GREEN SLATE	A, L2.3
	VEHICULAR CONCRETE PAVING SECTION TYPE A	A, L2.3
	VEHICULAR CONCRETE PAVING SECTION TYPE B	A, L2.3
	EXPANSION JOINT IN CONCRETE PAVING	A, L2.3
	SCORE JOINT IN CONCRETE PAVING	A, L2.3
	CONCRETE PAVING AT STRUCTURAL SLAB	C, L2.3
	HEADERBOARD AT ASPHALT	REFER TO CIVIL ENGINEER'S DRAWINGS
	SYNTHETIC TURF REFER TO SPECIFICATION SECTION 32 18 13	A, L2.6
	SAFETY SURFACING REFER TO SPECIFICATION SECTION 32 18 16	A, L2.5
	SYNTHETIC TURF AT SYNTHETIC TURF SEATING REFER TO SPECIFICATION SECTION 32 18 13	J, L2.4
	RUBBER TILES REFER TO SPECIFICATION SECTION 32 16 13	A, L2.5
	THICKENED EDGE	F, L2.4
	CONCRETE CURB, 6" HIGH	D, L2.3
	CONCRETE CURB AT SYNTHETIC TURF	A, L2.6
	EDGE OF RAMP	F, L2.4
	CONCRETE PERIMETER CURB AT PLAY STRUCTURE	A, L2.5
	CONCRETE PLANTER WALL, 8" WIDE	I, L2.4
	CONCRETE WALL WITH RAIL	H AND E, L2.7
	SYNTHETIC TURF SEATING	J, L2.4
	EX. FENCE VERIFY IN FIELD	REFER TO ARCHITECTURAL PLANS
	HANDRAIL AT STEPS	D, L2.7
	HANDRAIL AT RAMP	E, L2.7
	BIKE RACK (4) TOTAL	A, L2.4
	BOULDER (30) TOTAL	E, L2.3
	RELOCATE (E) BENCH (4) TOTAL	B, L2.4
	FLAG POLE (1) TOTAL	C, L2.4
	TABLE (2) TOTAL	B, L2.7
	CURVED WOOD BENCH (3) TOTAL	A, L2.7
	PLANTING AREA, REFER TO PLANTING AND IRRIGATION PLANS	-
	ORNAMENTAL FENCE, SEE ARCHITECTURAL DRAWINGS	-

MATERIAL AND DETAIL REFERENCE NOTES

- THESE NOTES ARE FOR GENERAL REFERENCE IN CONJUNCTION WITH AND AS A SUPPLEMENT TO THE WRITTEN SPECIFICATIONS, DETAILS, ADDENDA AND CHANGE ORDERS ASSOCIATED WITH THE CONTRACT DOCUMENTS.
- CONTRACTOR SHALL BECOME FAMILIAR WITH THE LOCATION OF EXISTING AND PROPOSED UNDERGROUND SERVICES. CONTACT UNDERGROUND SERVICE ALERT (USA) AT (800) 642-2444 PRIOR TO BEGINNING WORK. CONTACT OWNER'S REPRESENTATIVE SHOULD ANY CONFLICTS ARISE.
- SCORE AND EXPANSION JOINTS SHALL BE LOCATED AS INDICATED ON THIS PLAN. CONTRACTOR SHALL MAKE MINOR ADJUSTMENTS WHEN NECESSARY TO ALIGN SCORE AND EXPANSION JOINTS WITH RELATIVE ELEMENTS AS SHOWN ON THE PLAN.
- DETAIL CALLOUTS ON PLAN ARE PROVIDED FOR CONVENIENCE AND GENERAL REFERENCE ONLY. CONTRACTOR SHALL PROVIDE QUANTITY OF PRODUCTS, ELEMENTS AND MATERIALS AS SYMBOLIZED ON PLANS, ASSOCIATED DETAILS, AND SPECIFICATIONS.
- FOR EACH CONCRETE COLOR AND FINISH SPECIFIED, CONTRACTOR SHALL POUR A 2'x2' SAMPLE FOR APPROVAL BY OWNER'S REPRESENTATIVE PRIOR TO INSTALLING CONCRETE PAVING.
- LANDSCAPE ARCHITECT IS NOT RESPONSIBLE FOR MEANS AND METHODS OF CONSTRUCTION. IF WORK WITHIN THIS SCOPE REQUIRES REMOVAL, RELOCATION, OR DEMOLITION OF EXISTING TO REMAIN IMPROVEMENTS, BOTH SURFACE AND KNOWN SUBSURFACE CONDITIONS, CONTRACTOR SHALL INCLUDE IN THE BID SUFFICIENT LABOR AND MATERIALS TO RESTORE EXISTING TO REMAIN IMPROVEMENTS IN KIND AND AS ACCEPTABLE TO OWNER'S REPRESENTATIVE.
- CONTRACTOR SHALL COORDINATE ROUGH GRADING AND FINE GRADING TO ENSURE EXISTING SUITABLE TOPSOIL IS REMOVED, STOCKPILED AND REINSTALLED INTO ALL PROPOSED LANDSCAPE AREAS PER LANDSCAPE SPECIFICATION SECTION 32 90 00. IN THE EVENT THERE IS NOT ENOUGH EXISTING TOPSOIL, OR NO PLACE TO STOCKPILE TOPSOIL, CONTRACTOR SHALL IMPORT AND INSTALL TOPSOIL PER LANDSCAPE SPECIFICATION SECTION 32 90 00.
- THE CONTRACTOR SHALL BE RESPONSIBLE UNDER THIS CONTRACT FOR REPAIRING OR REPLACING, AT THEIR OWN EXPENSE, SURFACE AND SUBSURFACE SITE FEATURES TO REMAIN, INCLUDING BUT NOT LIMITED TO ANY STRUCTURES, FENCES, WALLS, PAVING SURFACES, PLANT MATERIAL AND/OR TREES DAMAGED OR DESTROYED, BOTH ON THIS PROPERTY OR THOSE PROPERTIES ADJACENT TO THIS SITE. THE DAMAGED ITEM(S) WILL BE RESTORED TO THEIR ORIGINAL CONDITION OR REPLACED TO THE SATISFACTION OF THE OWNER'S REPRESENTATIVE.
- LANDSCAPE ARCHITECT IS NOT RESPONSIBLE FOR ROOFTOP GARDEN LINER, BUILDING WATERPROOFING, DRAINAGE FROM ROOF, WEIGHT LOAD BEARING ISSUES, MAINTENANCE, SAFETY, AND MEANS AND/OR METHODS OF INSTALLATION.
- CONTRACTOR SHALL ADJUST EXISTING UTILITY BOXES TO BE FLUSH WITH PROPOSED GRADES.
- REFER TO THE FOLLOWING SPECIFICATION SECTIONS:
01 56 39 TEMPORARY TREE AND PLANT PROTECTION
05 52 00 HANDRAILS AND RAILINGS
11 68 16 PLAY STRUCTURES
12 93 00 SITE FURNISHINGS
32 12 33 PAVING COLORED SURFACING
32 18 13 SYNTHETIC GRASS SURFACING
32 18 13.1 SYNTHETIC GRASS SURFACING (SEATING)
32 18 16 SYNTHETIC RESILIENT SURFACING
32 18 16.13 DUAL COMPONENT PLAYGROUND TILE SYSTEM
- REFER TO CONSTRUCTION DETAILS ON SHEET L2.3 - L2.7.

AGENCY APPROVAL:
DSA # 01-120306
FILE # 41-26

REVIEWING AGENCIES
STAMP HERE

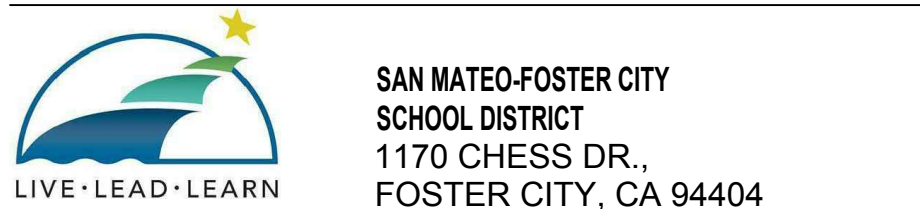

HMC Architects

3542005-000

633 W. SAN CARLOS STREET,
STUDIO 750, SAN JOSE, CA, 95110
909 989 9979 / www.hmcarchitects.com

ISSUE	
Δ	DESCRIPTION
Δ	DATE
Δ	ADDENDUM 1
Δ	ADDENDUM 2
Δ	ADDENDUM 4

KEYNOTES

NOTES

Consultant:

1723 Hamilton Ave, Ste 101
San Jose, CA 95125
T. 408.292.2196
www.anla-associates.com

Consultant's Project No. ANLA 2145

FACILITY:
PARKSIDE MONTESSORI SCHOOL
1685 EISENHOWER ST.
SAN MATEO, CA 94403


PROJECT:
PARKSIDE MONTESSORI MULTIPURPOSE BLDG AND SITE WORK

SHEET NAME:
**MATERIALS AND CONSTRUCTION
DETAIL REFERENCE PLAN**

ADDENDUM 4	
FILE NO.: 41-26	A NO.: 01-120306
DATE: 06/10/2022	CLIENT PROJ NO: ANLA 2145
SHEET:	

L2.2

11/21/2023 8:27:54 PM

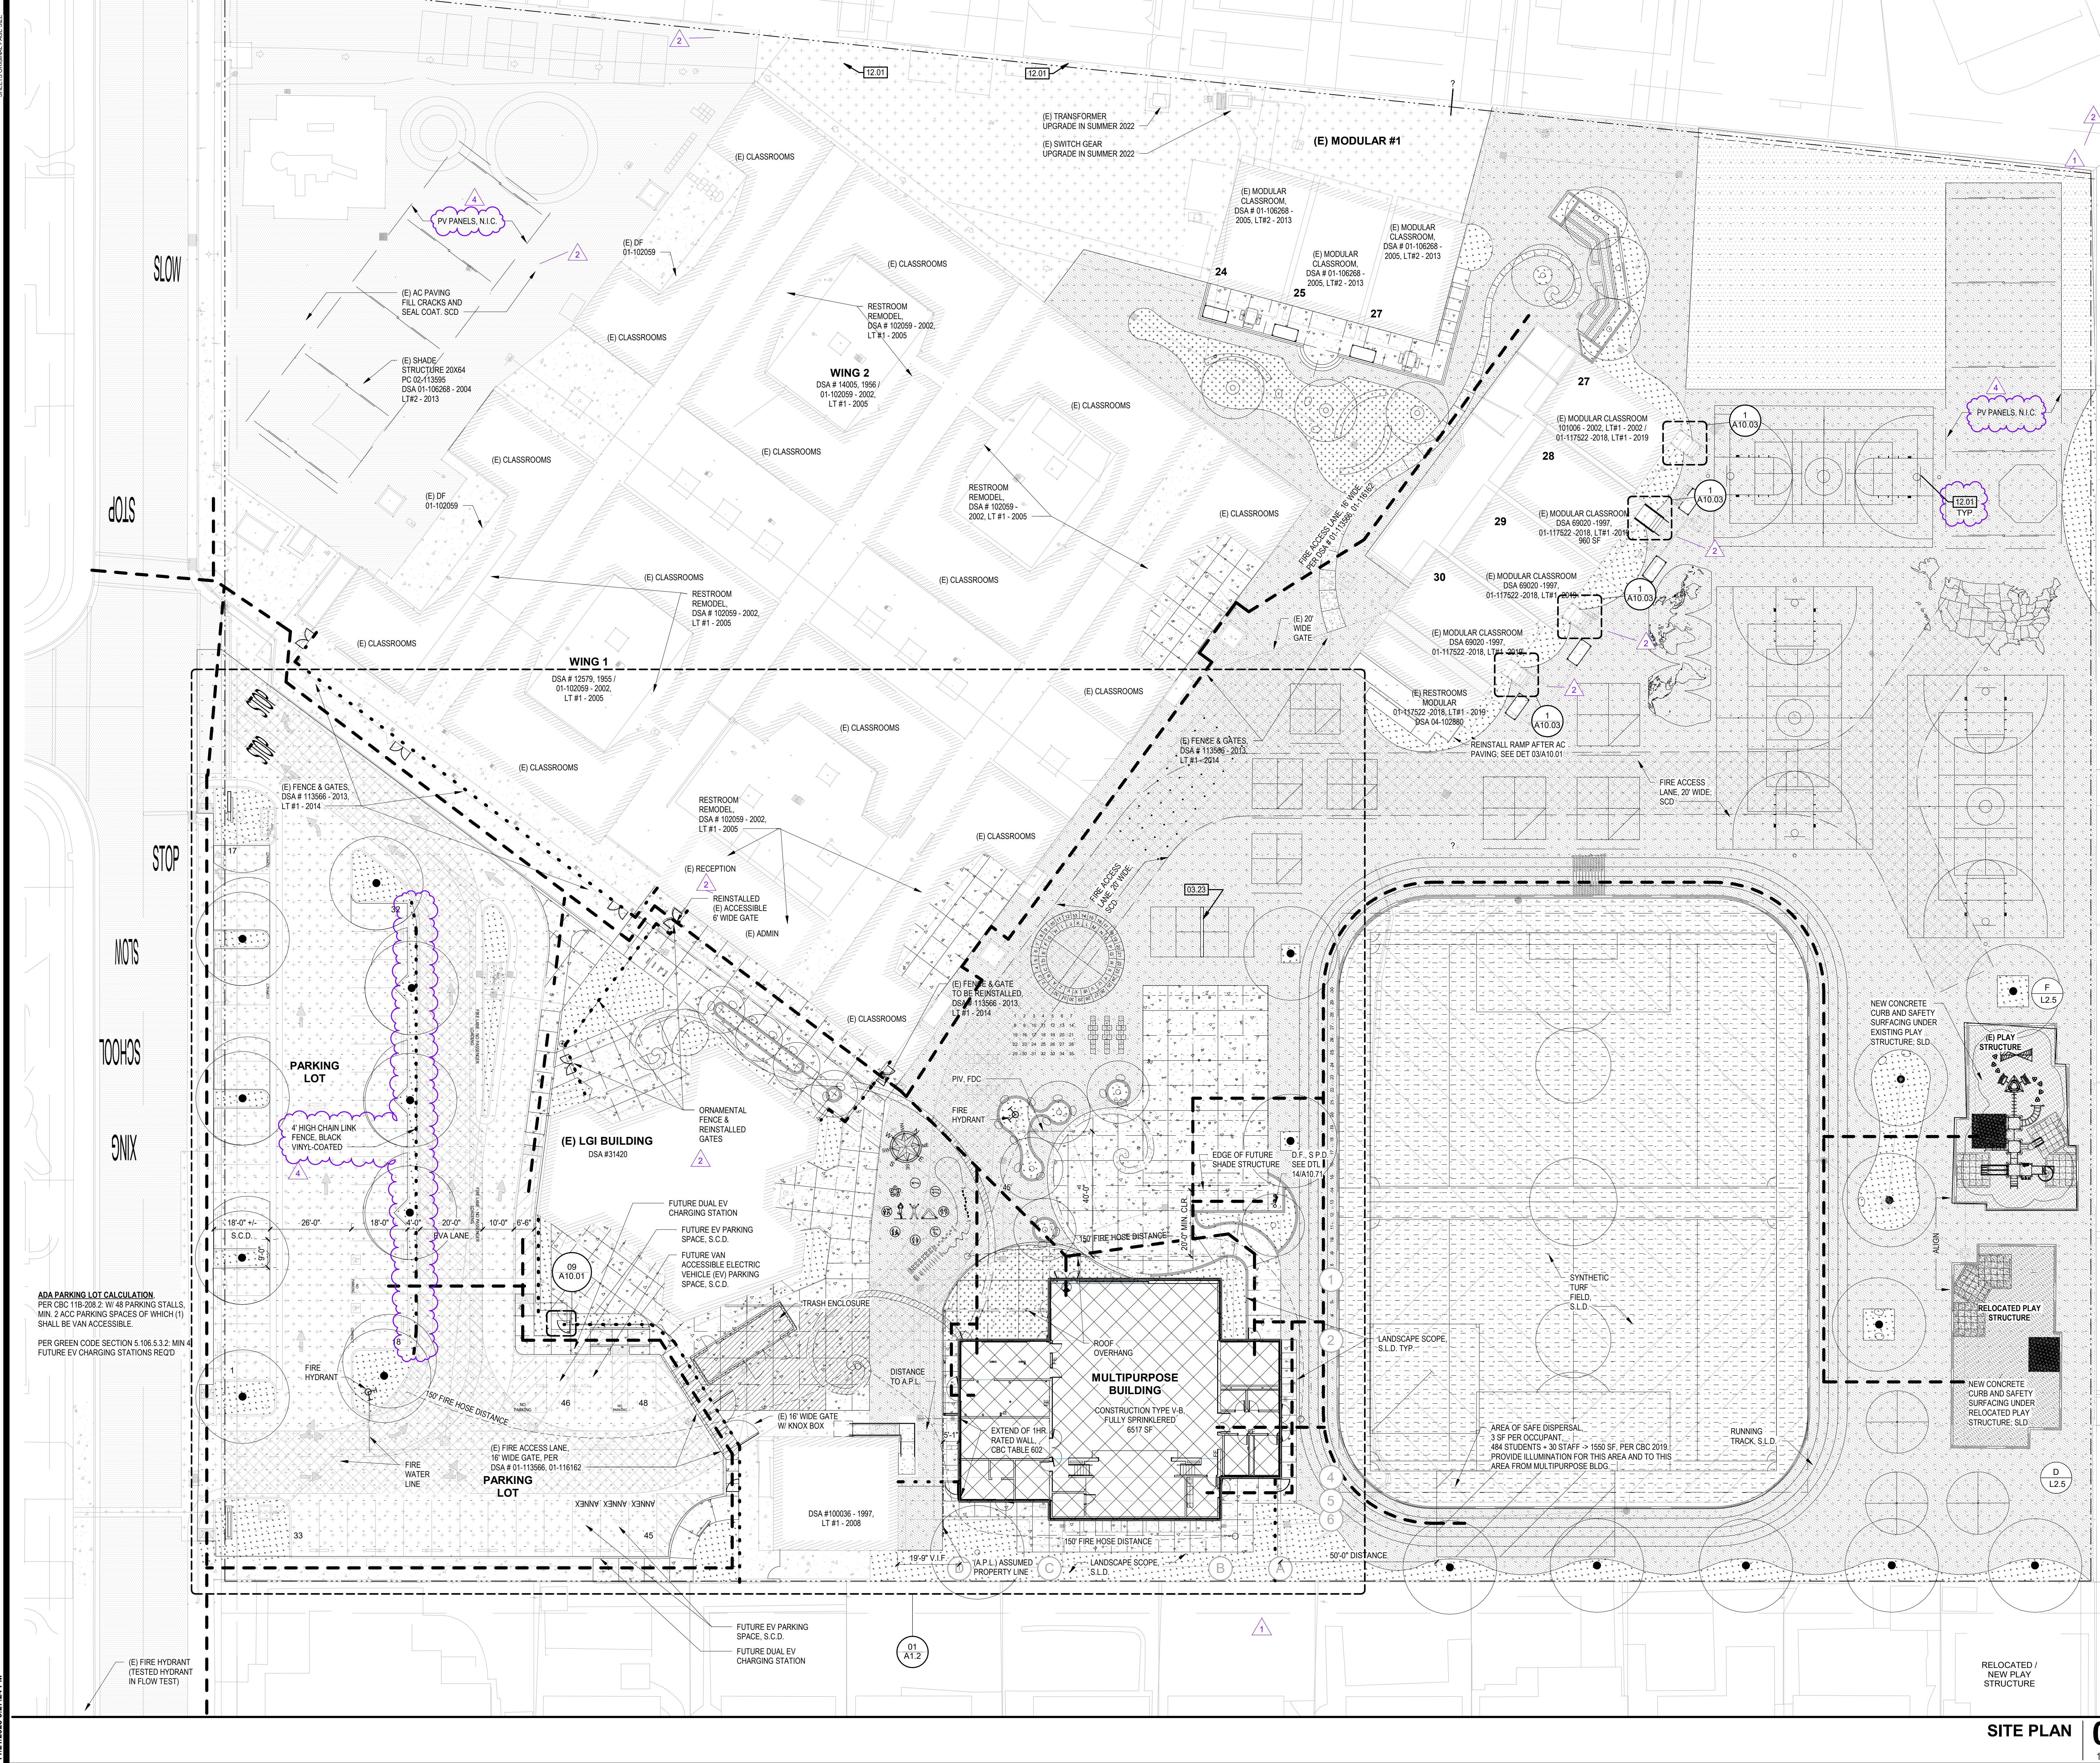

AGENCY
APPROVAL:
DSA # 01-120306
FILE # 41-26

REVIEWING AGENCIES
STAMP HERE

SAN MATEO-FOSTER CITY
SCHOOL DISTRICT
1170 CHESS DR.
FOSTER CITY, CA 94404

HMC Architects

3542005-000

333 W. SAN CARLOS STREET,
STUDIO 750, SAN JOSE, CA 95110
909 989 9979 / www.hmcarchitects.com

ISSUE

Δ	DESCRIPTION	DATE
1	ADDENDUM 1	06/11/2023
2	ADDENDUM 2	11/03/2023
4	ADDENDUM 4	11/21/2023

KEYNOTES

03.23

CONCRETE BALL WALL, S.L.D.

12.01

BASKETBALL HOOP, S.L.D.

PATH OF TRAVEL - P.O.T. (DSA PR 15-01)

THE P.O.T. IDENTIFIED IN THESE CONSTRUCTION DOCUMENTS MEETS THE REQUIREMENTS OF THE CURRENT APPLICABLE CALIFORNIA BUILDING CODE (CBC) ACCESSIBILITY PROVISIONS FOR PATH OF TRAVEL REQUIREMENTS FOR ALTERATIONS, ADDITIONS & STRUCTURAL REPAIRS, AS PART OF THE DESIGN OF THIS PROJECT, THE P.O.T. WAS EXAMINED & ANY ELEMENTS, COMPONENTS OR PORTIONS OF THE P.O.T. THAT WERE DETERMINED TO BE NON-COMPLIANT WITH THE CBC HAVE BEEN IDENTIFIED & THE CORRECTIVE WORK NECESSARY TO BRING THEM INTO COMPLIANCE HAS BEEN INCLUDED WITH THE SCOPE OF THIS PROJECT'S DOCUMENTS. ANY NON-COMPLIANT ELEMENTS, COMPONENTS OR PORTIONS OF THE P.O.T. THAT WILL NOT BE CORRECTED BY THIS PROJECT BASED ON VALUATION THRESHOLD LIMITATIONS OR FINDINGS OF UNREASONABLE HARDSHIP ARE INDICATED IN THESE CONSTRUCTION DOCUMENTS. DURING CONSTRUCTION, IF P.O.T. ITEMS WITHIN THE SCOPE OF THE PROJECTS REPRESENTED AS CBC COMPLIANT ARE FOUND TO BE NON-COMPLYING BEYOND REASONABLE CONSTRUCTION TOLERANCES, THE ITEMS SHALL BE BROUGHT INTO COMPLIANCE WITH THE CBC AS PART OF THIS PROJECT BY MEANS OF A CONSTRUCTION CHANGE DOCUMENT.

P.O.T. - TECHNICAL REQUIREMENTS FOR ACC. ROUTE

ACCESSIBLE PATH OF TRAVEL AS INDICATED ON PLAN IS A BARRIER-FREE ACCESS ROUTE WITHOUT ABRUPT LEVEL CHANGES EXCEEDING 1/2" BEVELED AT 1:2 MAX. SLOPE OR VERTICAL LEVEL CHANGES NOT EXCEEDING 1/4" MAXIMUM AND AT LEAST 48" IN WIDTH. SURFACE IS STABLE, FIRM AND SLIP RESISTANT. CROSS SLOPE SHALL NOT BE STEEPER THAN 1:48 AND SLOPE IN DIRECTION OF TRAVEL SHALL NOT BE STEEPER THAN 1:20. ACCESSIBLE PATH OF TRAVEL SHALL BE MAINTAINED FREE OF OVERHANGING OBSTRUCTIONS TO 80" MINIMUM AND DREE OF OBJECTS PROTRUDING MORE THAN 4" FROM THE WALL, ABOVE 27" AND LESS THAN 80" ABOVE THE FLOOR. MAXIMUM DROP BETWEEN FINISHED GRADES AND THE TOP OF THE P.O.T. SHALL NOT EXCEED 4". ARCHITECT SHALL VERIFY THAT THERE ARE NO BARRIERS IN THE PATH OF TRAVEL.

SHEET NOTES

1. SEE OTHER DISCIPLINE DWGS FOR ADDITIONAL SCOPE.
2. SEE ENLARGED SITE PLAN FOR ADDITIONAL SCOPE INFORMATION.
3. CONTRACTOR IS RESPONSIBLE FOR REPAIR/REPLACEMENT OF ALL HARDSCAPE/PLANTINGS OUTSIDE OF LIMIT OF WORK LINE FOR CONNECTION OF UNDERGROUND UTILITIES.
4. AREAS OF PLANTING MAY REQUIRE SOIL AMMENDMENT. SEE LANDSCAPE DWGS.
5. THE CONTRACTOR IS RESPONSIBLE TO MAINTAIN FIRE/EMERGENCY ACCESS TO THE SITE THROUGHOUT CONSTRUCTION.

LEGEND

BUILDING

CONCRETE PAVING - S.L.D. FOR TYPE AND FINISH

AC PAVING

ADDED BUILDING / ADDED STRUCTURE

AREA OF SAFE DISPERSAL

FIRE TRUCK ACCESS, 20' WIDE, 33' INSIDE RADIUS, 53' OUTSIDE RADIUS

P.O.T.

FENCE (CHAINLINK OR ORNAMENTAL) / (E) FENCE

○ FH / (E) FH FIRE HYDRANT, SEE CIVIL DWGS. / (E) FIRE HYDRANT

FACILITY:
PARKSIDE MONTESSORI SCHOOL
1685 EISENHOWER ST., SAN MATEO, CA 94403

PROJECT:
PARKSIDE MONTESSORI MULTIPURPOSE BLDG AND SITE WORK

SHEET NAME:
CAMPUS SITE PLAN

ADDENDUM 4

FILE NO.: 41-26
DATE: 06/10/2022

A NO.: 01-120306
CLIENT PROJ NO:

SHEET:
SITE PLAN 01
1" = 20'-0"

PLEASE RECYCLE

DSA REQUIRED ANCHORAGE NOTES

MEP COMPONENT ANCHORAGE NOTE:

ALL MECHANICAL, PLUMBING, AND ELECTRICAL COMPONENTS SHALL BE ANCHORED AND INSTALLED PER THE DETAILS ON THE DSA APPROVED CONSTRUCTION DOCUMENTS. WHERE NO DETAIL IS INDICATED, THE FOLLOWING COMPONENTS SHALL BE ANCHORED OR BRACED TO MEET THE FORCE AND DISPLACEMENT REQUIREMENTS PRESCRIBED IN THE 2019 CBC, SECTIONS 1617A.1.18 THROUGH 1617A.1.28 AND ASCE 7-16 CHAPTERS 13, 26 AND 30.

- ALL PERMANENT EQUIPMENT AND COMPONENTS.
- TEMPORARY OR MOVABLE EQUIPMENT THAT IS PERMANENTLY ATTACHED (E.G. HARD WIRED) TO THE BUILDING UTILITY SERVICES SUCH AS ELECTRICITY, GAS OR WATER.
- TEMPORARY, MOVABLE OR MOBILE EQUIPMENT WHICH IS HEAVIER THAN 400 POUNDS OR HAS A CENTER OF MASS LOCATED 4 FEET OR MORE ABOVE THE ADJACENT FLOOR OR ROOF LEVEL THAT DIRECTLY SUPPORT THE COMPONENT IS REQUIRED TO BE RESTRAINED IN A MANNER APPROVED BY DSA.

THE ATTACHMENT OF THE FOLLOWING MECHANICAL AND ELECTRICAL COMPONENTS SHALL BE POSITIVELY ATTACHED TO THE STRUCTURE, BUT NEED NOT BE DETAILED ON THE PLANS. THESE COMPONENTS SHALL HAVE FLEXIBLE CONNECTIONS PROVIDED BETWEEN THE COMPONENT AND ASSOCIATED DUCTWORK, PIPING, AND CONDUIT.

- COMPONENTS WEIGHING LESS THAN 400 POUNDS AND HAVE A CENTER OF MASS LOCATED 4 FEET OR LESS ABOVE THE ADJACENT FLOOR OR ROOF LEVEL THAT DIRECTLY SUPPORT THE COMPONENT.
- COMPONENTS WEIGHING LESS THAN 20 POUNDS, OR IN THE CASE OF DISTRIBUTED SYSTEMS, LESS THAN 5 POUNDS PER FOOT, WHICH ARE SUSPENDED FROM A ROOF OR FLOOR OR HUNG FROM A WALL.

FOR THOSE ELEMENTS THAT DO NOT REQUIRE DETAILS ON THE APPROVED DRAWINGS, THE INSTALLATION SHALL BE SUBJECT TO THE APPROVAL OF THE STRUCTURAL ENGINEER OF RECORD AND THE DSA DISTRICT STRUCTURAL ENGINEER. THE PROJECT INSPECTOR WILL VERIFY THAT ALL COMPONENTS AND EQUIPMENT HAVE BEEN ANCHORED IN ACCORDANCE WITH ABOVE REQUIREMENTS.

PIPING, DUCTWORK, AND ELECTRICAL DISTRIBUTION SYSTEM BRACING NOTE:

PIPING, DUCTWORK, AND ELECTRICAL DISTRIBUTION SYSTEMS SHALL BE BRACED TO COMPLY WITH THE FORCES AND DISPLACEMENTS PRESCRIBED IN ASCE 7-16 SECTION 13.3 AS DEFINED IN ASCE 7-16 SECTION 13.6.5, 13.6.6, 13.6.5.7, 13.6.5.8, AND 2019 CBC, SECTIONS 1617A.1.24, 1617A.1.25, 1617A.1.26

THE METHOD OF SHOWING BRACING AND ATTACHMENT TO THE STRUCTURE FOR THE IDENTIFIED DISTRIBUTION SYSTEM ARE AS NOTED BELOW. WHEN BRACING AND ATTACHMENTS ARE BASED ON A PRE-APPROVED INSTALLATION GUIDE (E.G. SMACNA OR OSHPO OPM), COPIES OF THE BRACING SYSTEM INSTALLATION GUIDE OR MANUAL SHALL BE AVAILABLE ON THE JOBSITE PRIOR TO THE START OF AND DURING THE HANGING AND BRACING OF THE DISTRIBUTION SYSTEMS. THE STRUCTURAL ENGINEER OF RECORD SHALL VERIFY THE ADEQUACY OF THE STRUCTURE TO SUPPORT THE HANGER AND BRAC LOADS.

MECHANICAL PIPING (MP), MECHANICAL DUCTS (MD), PLUMBING PIPING (PP), ELECTRICAL DISTRIBUTION SYSTEMS (E).

MP MD PP E OPTION 1: DETAILED ON THE APPROVED DRAWINGS WITH PROJECT SPECIFIC NOTES AND DETAILS.

MP MD PP E OPTION 2: SHALL COMPLY WITH THE APPLICABLE OSHPO PRE-APPROVAL (OPM) #0643-13.

UTILITIES SERVICE AND UNDERGROUND TRENCHING NOTES

- THESE PLANS HAVE BEEN PREPARED WITHOUT UTILITY COMPANIES COMMITMENTS (PENDING), LP CONSULTING ENGINEERS, INC. ACCEPTS NO RESPONSIBILITY AND SHALL NOT INCUR ANY COSTS DUE TO CHANGES IN SERVICE REQUIREMENTS BY THE UTILITY COMPANIES.
- CONTRACTOR SHALL COORDINATE SPECIFIC REQUIREMENTS WITH THE UTILITY COMPANIES AS FOLLOW:
 - POWER COMPANY.
 - PACIFIC GAS & ELECTRIC (PG&E)
 - TELEPHONE COMPANY.
 - AT&T
 - CABLE TELEVISION.
 - COMCAST CABLE TELEVISION
- CONTRACTOR SHALL CALL THE UTILITY COMPANIES REPRESENTATIVE TO ATTEND PRE-CONSTRUCTION MEETING.
- CONTRACTOR SHALL PROTECT ANY APPLICABLE EXISTING STREET LIGHTING, UTILITY POLES, OVERHEAD LINES, UNDERGROUND WIRING, AND UTILITY PULLBOXES DURING CONSTRUCTION.
- CONTRACTOR IS RESPONSIBLE FOR SITE AND OFF-SITE IMPROVEMENTS AND TO COORDINATE UTILITY CONNECTIONS WITH THE UTILITY COMPANIES.
- POWER SERVICE:
 - THE CONTRACTOR IS RESPONSIBLE FOR COORDINATING WITH PG&E FOR ALL ASPECTS OF THIS PROJECT INCLUDING ARRANGING FOR TEMPORARY CONSTRUCTION POWER, SCHEDULING INSPECTIONS AND OBTAINING SIGN-OFFS, SCHEDULING RELOCATION AND REMOVAL OF UTILITY EQUIPMENT, INSTALLING UTILITY EQUIPMENT AND INFRASTRUCTURE, AND SCHEDULING FINAL CONNECTION SERVICES. CONTRACTOR SHALL BE AWARE THAT POWER COMPANY REQUIRES EXTENSIVE ADVANCE NOTIFICATION AND SHOULD SCHEDULE ALL WORK ACCORDINGLY. CONTRACTOR SHALL NOT MAKE ANY CLAIMS FOR TIME DELAY DUE TO ANY POWER COMPANY WORK ASSOCIATED WITH THIS PROJECT.
 - CONTRACTOR SHALL CONTACT PG&E TO ARRANGE CONSTRUCTION TEMPORARY ELECTRICAL SERVICE. CONTRACTOR SHALL PAY ALL REQUIRED FEES AND INSTALLATION COSTS.
 - PG&E POWER SERVICE LINES SHALL NOT BE INSTALLED IN THE SAME TRENCH AS ANY WET UTILITIES.
- TELEPHONE SERVICE:
 - CONTRACTOR SHALL COORDINATE WITH AT&T FOR ALL REQUIRED INSPECTIONS OF INFRASTRUCTURE WORK, PULLBOXES, AND TELECOM ROOM.
 - ALL AT&T COMPANY STRUCTURES MUST BE IN PLACE AND READY 30-45 DAYS PRIOR TO ANY REQUEST FOR NEW SERVICE.
- UNDERGROUND TRENCHING:
 - USE EXTREME CAUTION WHEN DIGGING TO AVOID BURIED ELECTRICAL CABLES. CALL UNDERGROUND SERVICE ALERT (U.S.A.) 800-277-2600, 48 HOURS BEFORE DIGGING.
 - BEFORE START OF ANY UNDERGROUND TRENCHING FOR CONDUIT RUNS, THE CONTRACTOR SHALL BE RESPONSIBLE TO COORDINATE WITH ALL PLANS OF OTHER TRADES (ARCHITECTURAL, CIVIL, LANDSCAPE), AND SITE CONDITIONS TO AVOID CONFLICT.
 - TRENCHING AND BACKFILLING SHALL BE IN ACCORDANCE WITH THE SPECIFICATIONS. COORDINATE WITH CIVIL, LANDSCAPE AND ARCHITECTURAL SITE PLAN PRIOR TO THE TRENCHING, ETC. AND THE INSTALLATION OF THE ELECTRICAL SYSTEM.
 - D. ALL UNDERGROUND CONDUITS SHALL BE SCHEDULE 40 PVC, UL LISTED FOR DIRECT BURIAL, AND TERMINATED WITH FACTORY ENO BELL FITTINGS. ALL ELBOWS, BENDS AND TURNS TRANSITIONING TO GRADE SHALL BE INSTALLED USING PER MANUFACTURED 40-MIL PVC COATED GALVANIZED STEEL ELBOWS AND OFFSETS.
 - E. ALL UNDERGROUND SERVICE CONDUITS SHALL BE SEALED TO COMPLY WITH CEC 230.8.
 - F. PROVIDE 24" MINIMUM COVERAGE FOR UNDERGROUND CONDUITS, UNLESS OTHERWISE NOTED. THE EXCEPTION IS FOR PG&E SERVICE CONDUITS WHICH SHALL HAVE A 36" MINIMUM SEPARATION BETWEEN THE POWER AND LOW VOLTAGE SYSTEM UNDERGROUND CONDUITS. TRENCHES SHALL ALL BE INSTALLED WITH A RED POLYETHYLENE WARNING RIBBON LABELED "ELECTRICAL," LOCATED IF BELOW GRADE IN THE TRENCH.
 - G. PROVIDE UNDERGROUND TRACER WHERE NON-METAL CONDUITS ARE INSTALLED.
 - H. PROVIDE PART-EX IDENTIFICATION TAGS TO IDENTIFY UNDERGROUND CIRCUITS.

I. ALL UNDERGROUND SPLICES SHALL BE MADE WATERPROOF BY PROVIDING WITH "SPlice-KOTE" SPLICE KITS OR OTHER ACCEPTED METHODS. ALL FUSEHOLDERS SHALL BE WATER-TIGHT.

J. ALL UNDERGROUND RACEWAYS SHALL BE PROVIDED WITH A #8 AWG MINIMUM SIZE COPPER EQUIPMENT GROUNDING CONDUCTOR, WHETHER SHOWN ON PLAN OR NOT, UNLESS OTHERWISE NOTED.

K. THE CONTRACTOR SHALL BE RESPONSIBLE UNDER THIS CONTRACT TO REPAIR AND REPLACE ANY AND ALL DAMAGES TO EXISTING POC WALKS, AC PAVING, UTILITIES, TREES, PLANT, PLANTED AREAS AND OTHER FACILITIES RESULTING FROM THIS PROJECT, WHETHER CUTTING OR TRENCHING THROUGH EXISTING CONCRETE SIDEWALKS, DRIVEWAYS, AND WALKWAYS. THE CONTRACTOR SHALL BE REQUIRED TO COMPLETELY REPLACE ENTIRE SECTIONS OF CONCRETE PANELS FROM SPOCKMARK TO SPOCKMARK AFFECTED BY THE CONSTRUCTION WORK. ALL SIDEWALKS, DRIVEWAYS, AND WALKWAYS SHALL BE REPLACED TO MATCH ADJACENT CONDITION AND AS DIRECTED BY THE ARCHITECT.

OCCUPANCY & DAYLIGHT SENSOR NOTES

1. OCCUPANCY SENSORS AND DAYLIGHTING SENSORS SYSTEMS OPERATION:

A. IT SHALL BE THE CONTRACTOR'S RESPONSIBILITY TO LOCATE AND AIM SENSORS IN THE CORRECT LOCATION REQUIRED FOR COMPLETE AND PROPER VOLUMETRIC COVERAGE WITHIN THE RANGE OF COVERAGE(S) OF CONTROLLED AREAS PER THE MANUFACTURER'S RECOMMENDATIONS. ROOMS SHALL HAVE NINETY (90) TO ONE HUNDRED (100) PERCENT COVERAGE TO COMPLETELY COVER THE CONTROLLED AREA TO ACCOMMODATE OCCUPANCY HABITS OF SINGLE OR MULTIPLE OCCUPANTS AT ANY LOCATION WITHIN THE ROOMS. THE LOCATIONS AND QUANTITIES OF SENSORS SHOWN ON THE DRAWINGS ARE DIAGRAMMATIC AND INDICATE ONLY THE ROOMS THAT ARE TO BE PROVIDED WITH SENSORS. THE CONTRACTOR SHALL PROVIDE ADDITIONAL SENSORS IF REQUIRED TO PROPERLY AND COMPLETELY COVER THE RESPECTIVE ROOM.

B. IT IS THE CONTRACTOR'S RESPONSIBILITY TO ARRANGE A PRE-INSTALLATION MEETING WITH MANUFACTURER'S FACTORY AUTHORIZED REPRESENTATIVE, AT THE OWNER'S FACILITY, TO VERIFY PLACEMENT OF SENSORS AND INSTALLATION CRITERIA.

C. IT SHALL BE THE CONTRACTOR'S RESPONSIBILITY TO MAKE PROPER ADJUSTMENTS TO ASSURE OWNER'S SATISFACTION WITH THE OCCUPANCY SYSTEM. IF THE CONTRACTOR IS INCAPABLE TO MAKE PROPER ADJUSTMENTS, THE CONTRACTOR SHALL PROVIDE THE FACTORY STARTUP IN THAT THE MANUFACTURER'S RESPONSIBILITY TO VERIFY PROPER ADJUSTMENTS AND TRAIN OWNER'S PERSONNEL TO ENSURE OWNER'S SATISFACTION WITH THE OCCUPANCY SYSTEM.

D. PROPER JUDGMENT MUST BE EXERCISED IN EXECUTING THE INSTALLATION SO AS TO ENSURE THE BEST POSSIBLE INSTALLATION IN THE AVAILABLE SPACE AND TO OVERCOME LOCAL DIFFICULTIES DUE TO SPACE LIMITATIONS OR INTERFERENCE OF STRUCTURAL COMPONENTS. THE CONTRACTOR SHALL ALSO PROVIDE, AT THE OWNER'S FACILITY, THE TRAINING NECESSARY TO FAMILIARIZE THE OWNER'S PERSONNEL WITH THE OPERATION, USE, ADJUSTMENT, AND PROBLEM SOLVING DIAGNOSIS OF THE OCCUPANCY SENSING DEVICES AND SYSTEMS.

2. OCCUPANCY SENSORS AND DAYLIGHTING SENSORS COMMISSIONING:

A. UPON COMPLETION OF THE INSTALLATION, CONTRACTOR SHALL PROVIDE A COMPLETE SYSTEM COMMISSIONED BY THE MANUFACTURER'S FACTORY AUTHORIZED TECHNICIAN WHO WILL VERIFY ADJUSTMENTS AND SENSOR PLACEMENT TO ENSURE A TROUBLE-FREE OCCUPANCY-BASED LIGHTING CONTROL SYSTEM.

B. UPON COMPLETION OF THE SYSTEM FINE TUNING, THE CONTRACTOR SHALL ARRANGE FOR THE FACTORY AUTHORIZED TECHNICIAN TO PROVIDE THE PROPER TRAINING TO THE OWNER'S PERSONNEL IN THE ADJUSTMENT AND MAINTENANCE OF THE SENSORS.

C. LIGHTING CONTROLS COMMISSIONING, INSPECTIONS (INCLUDING STATE OF CALIFORNIA ENERGY COMMISSION INSPECTION FORMS AND APPLICATIONS), TESTING, PROGRAMMING AND TUNING OF LIGHTING CONTROL SENSORS, DEVICES AND COMPONENTS, ETC. SHALL BE INCLUDED IN THE LIGHTING CONTROL PACKAGE AND PRICE. ANY LABOR, TOOLS AND MATERIALS REQUIRED TO PROVIDE A COMPLETE LIGHTING CONTROL SYSTEM SHALL BE AT NO EXTRA COST TO THE OWNERS OR END-USERS.

GENERAL NOTES

ALL GENERAL NOTES SHOWN BELOW ARE NOT NECESSARILY USED ON PLANS IF NOT REQUIRED.

- THESE GENERAL NOTES ARE INTENDED TO ASSIST THE CONTRACTOR IN THE EXECUTION OF THE ELECTRICAL WORK AND TO BE INCLUDED IN CONJUNCTION WITH THE CONTRACT DOCUMENT DRAWINGS AND SPECIFICATION REQUIREMENTS. SOME OF THE GENERAL NOTES ARE EXCEPTED FROM THE SPECIFICATION.
- PROCURE PERMITS AND LICENSES REQUIRED. PAY ALL NECESSARY FEES AND ARRANGE FOR INSPECTIONS REQUIRED BY LOCAL CODES AND ORDINANCES AND UTILITY COMPANIES.
- COORDINATE ALL ELECTRICAL SERVICES WITH THE RESPECTIVE UTILITY COMPANIES AND PROVIDE ALL TRENCHING, CONDUITS, WIRING, METER FACILITIES AND OUTLETS REQUIRED BY THEM.
- WORKMANSHIP SHALL BE OF THE HIGHEST GRADE. DEFECTIVE EQUIPMENT OR EQUIPMENT DAMAGED IN THE COURSE OF INSTALLATION OR TEST SHALL BE REPLACED OR REPAIRED IN A MANNER MEETING WITH THE ACCEPTANCE OF THE ARCHITECT.
- INSTALL ALL EQUIPMENT, CONDUITS, OUTLETS, AND FIXTURES IN STRICT ACCORDANCE WITH THE CURRENT EDITION OF ALL APPLICABLE CODES (CEC, STATE, COUNTY AND CITY).
- DO NOT SCALE PLANS FOR FIXTURES, DEVICES, OR APPLIANCE LOCATIONS. USE FIGURED DIMENSIONS IF GIVEN OR CHECK MECHANICAL AND ARCHITECTURAL PLANS. ALSO REFER TO ACTUAL ON-SITE CONDITIONS.
- ALL MATERIAL AND EQUIPMENT IS TO BE LISTED AND INSTALLED PER MANUFACTURER'S SPECIFICATIONS AND CEC 110.3.
- ALL ELECTRICAL DEVICES AND EQUIPMENT, FIXTURES, CONDUITS AND WIRING SHOWN ON THESE PLANS ARE NEW, UNLESS OTHERWISE NOTED.
- OUTLET BOXES INSTALLED IN FIRE WALLS SHALL BE ONE-PIECE STEEL AND INSTALLED IN SEPARATE (STAGGERED) STUD PENETRATIONS, MINIMUM 24 INCHES HORIZONTAL SEPARATION. FIRE WALLS SHALL BE MADE IN ACCORDANCE WITH CBC AND ELECTRICAL CODES.
- THE FINAL LOCATION OF ALL OUTLETS SHALL BE VERIFIED WITH THE ARCHITECT AND/OR OWNER AT TIME OF CONSTRUCTION.
- ALL OUTDOOR ELECTRICAL EQUIPMENT SHALL BE WEATHER-PROTECTED.
- CONTRACTOR SHALL VERIFY THAT ALL LIGHTING FIXTURES, CEILING TRIMS, AND FRAMES ARE COMPATIBLE WITH CEILING SYSTEM INSTALLED.
- CONTRACTOR SHALL COORDINATE LIGHT FIXTURE LOCATIONS AND INSTALLATIONS WITH THE MECHANICAL CONTRACTOR. MAINTAIN REQUIRED CLEARANCES (MINIMUM 3 INCHES) BETWEEN THE LIGHT FIXTURES AND MECHANICAL DUCTS OR EQUIPMENT FOR PROPER OPERATION, INSTALLATION AND/OR REMOVAL OF FIXTURES.
- BEFORE SUBMITTING FOR ARCHITECT'S REVIEW AND PLACING ORDER FOR THE LIGHT FIXTURES, THE CONTRACTOR SHALL VERIFY THE VOLTAGE OF ALL THE LIGHTING FIXTURES TO MATCH THE VOLTAGE OF THE SERVICE PANEL. WHETHER THE VOLTAGE FOR THE LIGHT FIXTURES ARE SHOWN ON THE PLAN OR NOT.
- PLACEMENT AND CIRCUITING OF EXIT SIGNS AND EGRESS LIGHTING COMPLY WITH CBC REQUIREMENTS.
- ALL CONDUIT SHALL BE ROUTED CONCEALED UNLESS NOTED ON PLAN OR ACCEPTED BY THE ARCHITECT.
- PROVIDE ALL NECESSARY SLEEVES AND INSERTS FOR ALL WORK PASSING THROUGH OR ATTACHING TO WALLS, FLOORS, OR CEILINGS.
- ALL WIRING SHALL BE INSTALLED IN RIGID METALLIC CONDUIT, UNLESS OTHERWISE NOTED. CONDUITS INSTALLED CONCEALED IN WALL AND CEILING MAY BE EMT WITH STEEL COMPRESSION TYPE FITTINGS. PVC WHERE INSTALLED UNDERGROUND AND/OR UNDER SLAB. ALL EXPOSED CONDUITS SHALL BE RIGID STEEL CONDUITS WITH THREADED TYPE FITTINGS. INSTALL ALL CONDUITS IN ACCORDANCE WITH CECA STANDARDS OF INSTALLATION.
- ELECTRICAL NON-METALLIC TUBING (ENT) AND MC CABLE ARE NOT PERMITTED TO BE USED FOR THIS PROJECT. NO EXCEPTIONS.
- WHERE EXISTING CONDUITS, CONCEALED OR EXPOSED, AND (WIREMOLD) SURFACE RACEWAY IS NOT IN PLACE AS SHOWN ON PLANS, PROVIDE NEW CONDUITS AND (WIREMOLD) SURFACE RACEWAY FOR THE NEW WORK. VERIFY EXISTING CONDITION ON SITE AND PROVIDE ALL NECESSARY NEW MATERIAL, APPARATUS, AND WORK THAT ARE REQUIRED TO BE INCLUDED IN THE BID PACKAGE.
- CONDUCTORS, #8 AND LARGER, SHALL BE STRANDED COPPER WITH THINNYHM INSULATION, UNLESS OTHERWISE NOTED.
- PROVIDE WORKING CLEARANCE PER CEC 110.28 FOR SERVICE PANEL, SUBPANELS, MOTOR DISCONNECT SWITCHES, CONTROL SECTIONS, HVAC EQUIPMENT, APPLIANCES, ETC.
- PROVIDE A WARNING LABEL (SIGN) CLEARLY VISIBLE TO QUALIFIED PERSONS TO COMPLY WITH NEC AND CEC 116.16 OF POTENTIAL ELECTRIC ARC FLASH HAZARDS AT SWITCHBOARDS, PANELBOARDS, INDUSTRIAL CONTROL PANELS AND MOTOR CONTROL CENTERS THAT ARE LIKELY TO REQUIRE EXAMINATION, ADJUSTMENT, SERVICING, OR MAINTENANCE WHILE ENERGIZED. SERVICE EQUIPMENT SHALL BE LEGIBLY MARKED WITH THE MAXIMUM AVAILABLE FAULT CURRENT PER CEC SECTION 110.24(A).
- BUILDING SERVICE AND SUBPANELS TO COMPLY WITH CEC 110.3 AND 110.10 INTERRUPTING RATING AND BRACING. PROVIDE A I.C. CALCULATIONS FOR SUBPANELS IF INTERRUPTING RATING TO BE USED IS LOWER THAN MAIN SERVICE RATING.
- ALL APPLIANCES SHALL COMPLY WITH CEC ARTICLE 422. APPLIANCE CONTROL AND PROTECTION PER CEC 422-III. BRANCH CIRCUITS PER 422-II.
- BUILDING EXPANSION JOINTS MAY OR MAY NOT BE INDICATED ON THE ELECTRICAL DRAWINGS. VERIFY THE LOCATIONS OF ALL APPLICABLE BUILDING EXPANSION JOINTS WITH THE ARCHITECTURAL DRAWINGS. WIRING METHODS ACROSS EXPANSIONS JOINTS SHALL INCLUDE USE OF FLEXIBLE FITTINGS OR OTHER DEVICES AS APPROPRIATE TO EACH APPLICATION. IN NO CASE SHALL CONDUIT CROSS SUCH A JOINT IN BUILDING CONSTRUCTION WITHOUT USE OF THE APPROPRIATE WIRING METHODS.
- CONTRACTOR SHALL SIZE ALL THE INTERIOR AND EXTERIOR BUILDING PULL BOXES AND UNDERGROUND PULL BOXES PER CEC 314.16 AND COMPLY WITH CEC 314.28 FOR INSTALLATION OF RACEWAYS AND WIRING AS REQUIRED BY CODE, UNLESS OTHERWISE NOTED.
- WHERE ACCESSIBILITY IS NOT AVAILABLE TO ELECTRICAL OUTLETS, DEVICES AND/OR EQUIPMENT, COORDINATE WITH THE ARCHITECT FOR PROVISIONS TO PROVIDE ACCESSIBILITY TO THEM.
- CONTRACTOR IS RESPONSIBLE FOR REVIEWING THE MECHANICAL DRAWINGS AND PROVIDES ALL CONDUITS AND CONTROL WIRING AND POWER WIRING SHOWN ON THE MECHANICAL DRAWINGS THAT IS NOT SHOWN ON THE ELECTRICAL PLANS.
- CONTRACTOR SHALL REFER TO THE MECHANICAL DRAWINGS AND COORDINATE FOR THE EQUIPMENT LOCATIONS. COORDINATE ROOF PENETRATION WITH THE MECHANICAL CONTRACTOR FOR MECHANICAL CONNECTIONS. ENTER ROOF MOUNTED UNITS THROUGH EQUIPMENT MOUNTING CURVES WHERE POSSIBLE. VERIFY ON-SITE.
- PROVIDE CONVENIENCE OUTLET WITHIN 25 FEET OF MECHANICAL EQUIPMENT PER U.M.C. WHERE LOCATED OUTSIDE. PROVIDE WEATHERPROOF AND GFCI CONVENIENCE OUTLET. SECURE ROOF MOUNTED OUTLET TO THE MECHANICAL EQUIPMENT. VERIFY LOCATION IN FIELD WITH THE MECHANICAL CONTRACTOR.
- VERIFY SINGLE POINT CONNECTIONS TO ROOF MOUNTED HVAC UNITS WITH MECHANICAL. CONTRACTOR ON-SITE PRIOR TO ELECTRICAL ROUGH-IN. PROVIDE DUAL DISCONNECTS IF TWO-POINT CONNECTIONS IS REQUIRED, WHETHER SHOWN ON PLANS OR NOT.
- COORDINATE THE HVAC EQUIPMENT FOR FUSES REQUIRE. WHERE FUSES ARE REQUIRED, VERIFY FUSE SIZE ON-SITE AND PROVIDE FOR HVAC EQUIPMENT PER UNIT NAMEPLATE SPECIFICATIONS.
- MOTOR DISCONNECT SWITCHES SHALL COMPLY WITH CEC 430-IX AND 440.11.
- MOTOR STARTERS FOR HVAC EQUIPMENT ARE PROVIDED BY MECHANICAL CONTRACTOR AND CONNECTED BY ELECTRICAL CONTRACTOR, UNLESS NOTED OTHERWISE.
- ALL CONNECTIONS FROM THE DISCONNECT SWITCHES TO HVAC UNITS SHALL BE COPPER CONDUCTORS. MOTOR DISCONNECT SWITCHES SHALL COMPLY WITH CEC 430-VII, 430-VIII, AND 440-II.
- VERIFY LOCATION AND HEIGHT OF ALL MECHANICAL OR FIXTURE EQUIPMENT OUTLETS WITH SUPPLIER PRIOR TO ANY ROUGH-IN WORK. PROVIDE ALL RUNS AND CONNECTIONS TO EQUIPMENT.
- ALL TERMINATION PROVISIONS OF EQUIPMENT, INCLUDING CIRCUITS RATED 100 AMPERES OR LESS SHALL BE RATED AT 60 DEGREE. CERTIFICATE PER CEC 110.14(6).
- ALL LIGHT FIXTURES INSTALLED OVER FOOD HANDLING OR FOOD PREPARATION AREAS, OPEN FOOD STORAGE, AND UTENSIL WASHING AREAS SHALL BE OF SHATTERPROOF CONSTRUCTION OR SHALL BE PROTECTED WITH SHATTERPROOF SHIELDS AND SHALL BE READILY CLEANABLE.

ELECTRICAL ABBREVIATIONS

SYMBOL	DESCRIPTION	SYMBOL	DESCRIPTION
A/AMP	AMPERES	MCA	MINIMUM CIRCUIT AMPACITY
AC	ALTERNATING CURRENT	MCB	MAIN CIRCUIT BREAKER
AFF	ABOVE FINISHED FLOOR	MLO	MAIN LUGS ONLY
AFC	ABOVE FINISHED CEILING	MTD	MOUNTED
AFG	ABOVE FINISHED GRADE	(N)	NEW
AIC	AMPERES INTERRUPTING CAPACITY (SYMMETRICAL)	N	NEUTRAL CONDUCTOR (GROUNDED CKT CONDUCTOR)
C	CONDUIT	N.I.E.S.	NOT IN ELECTRICAL SCOPE OR SPECIFICATIONS
CCT	CIRCUIT	NL	NIGHT LIGHT
CKT	CIRCUIT	PHP	PHASE OR POLE
DC	DIRECT CURRENT	PNL	PANELBOARD
(E)	EXISTING TO REMAIN	PVC	POLYVINYL CHLORIDE CONDUIT (SCHEDULE 40)
EC	EMPTY CONDUIT	(R)	RELOCATED/RELOCATED
EM	EMERGENCY	RECEP	RECEPTACLE
EMT	ELECTRICAL METALLIC TUBING	RGSC	RIGID GALVANIZED STEEL CONDUIT
FACP	FIRE ALARM CONTROL PANEL	U	UNSWITCHED
FLA	FULL LOAD AMPS	UNO	UNLESS NOTED OTHERWISE
FLEX	FLEXIBLE METALLIC CONDUIT	V	VOLTAGE OR VOLTS
GFCI	GROUND FAULT CIRCUIT INTERRUPTER	W	WATTS
GND/G	GROUND	WP	WEATHERPROOF
HP	HORSEPOWER	WPU	WEATHERPROOF WHILE IN USE
IG	ISOLATED GROUND	(X)	REMOVE
J-BOX	JUNCTION BOX	T. XFMR	TRANSFORMER
KVA	KILOVOLT-AMPS		
KW	KILOWATTS		
LTG	LIGHTING		

ELECTRICAL SHEET INDEX

SHEET NUMBER	SHEET NAME
E0.1	ELECTRICAL ABBREVIATIONS, NOTES & SHEET INDEX
E0.2	ELECTRICAL SYMBOL LEGEND
E1.1	ELECTRICAL SITE PLAN
A/E1.1A	LUNCH SHELTER ELECTRICAL SITE PLAN & PHOTOMETRIC PLAN
E1.2	PHOTOMETRIC PLANS
E2.1	ELECTRICAL FLOOR PLAN
E2.2	ELECTRICAL ROOF PLAN
E3.1	ELECTRICAL LIGHTING FLOOR PLAN
E5.1	ELECTRICAL DETAILS
E5.2	ELECTRICAL DETAILS
E6.1	ELECTRICAL ONE-LINE DIAGRAM
E7.1	ELECTRICAL PANEL AND LIGHTING SCHEDULES
E7.2	ELECTRICAL PANEL SCHEDULES
E7.3	ELECTRICAL PANEL SCHEDULES

AGENCY APPROVAL:

DSA # 119574
FILE # 41-26



SAN MATEO-FOSTER CITY
SCHOOL DISTRICT
1170 CHESS DR.,
FOSTER CITY, CA 94404


HMC Architects

3542005-000

333 W. SAN CARLOS STREET
STUDIO 750, SAN JOSE, CA, 95110
909 989 9379 | www.hmcarchitects.com


DESCRIPTION DATE

4 Addendum 4 11-21-2023

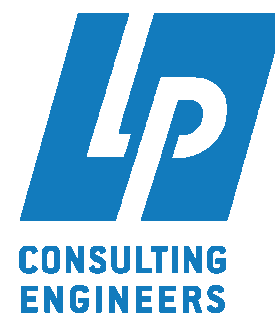

1209 Pleasant Grove Blvd.
Rosville, CA 95778
p 916-771-0778

www.lpeengineers.com
Job #: 21-2082

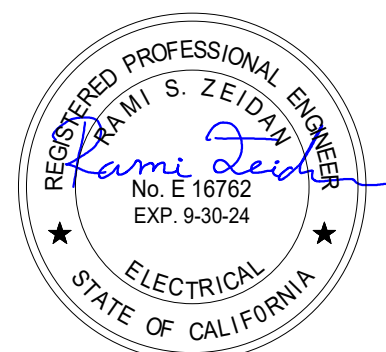

FACILITY:

PARKSIDE MONTESSORI SCHOOL
1685 EISENHOWER ST.
SAN MATEO, CA 94403

PROJECT:

PARKSIDE MONTESSORI MULTIPURPOSE BLDG AND
SITE WORK

SHEET NAME:

ELECTRICAL ABBREVIATIONS, NOTES, & SHEET
INDEX

ADDENDUM 4

FILE NO.: 41-26

A NO.: 01-120306

DATE: 10/20/2022

PROJ NO.: 3542-004

SHEET:

E0.1

11/17/2023 10:12:28 AM

THE LINE SHOWN ABOVE LIES EXACTLY WHERE THE SHEET ORIGINALLY WAS

GENERAL NOTES

- FIELD VERIFY EXISTING CONDITIONS PRIOR TO PERFORMING WORK AND NOTIFY ARCHITECT/ENGINEER OF ANY CONFLICTS OR DISCREPANCIES.
- ALL ELECTRICAL DEVICE PROVIDED SHALL BE RATED FOR THE TYPE OF ENVIRONMENT IT IS BEING SUBJECTED TO.
- REFER TO E0.1 FOR ADDITIONAL GENERAL NOTES.
- ALL EXTERIOR LIGHTING SHALL BE CONTROLLED PER TITLE 24.
 - SECTION 130.2(b), LUMINAIRE CUTOFF REQUIREMENTS.
 - SECTION 130.2(c), CONTROLS FOR OUTDOOR LIGHTING.
 - DAYLIGHTING AVAILABILITY.
 - AUTOMATED SCHEDULING CONTROLS.
 - MOTION SENSING CONTROLS.

AGENCY APPROVAL:

DSA # 119574
FILE # 41-26



SAN MATEO-FOSTER CITY
SCHOOL DISTRICT
1170 CHESS DR.,
FOSTER CITY, CA 94404


HMC Architects

3542005-000


333 W. SAN CARLOS STREET
STUDIO 750, SAN JOSE, CA 95110
909 989 9579 / www.hmcarchitects.com

DESCRIPTION	DATE
-------------	------

4 Addendum 4	11-21-2023
--------------	------------

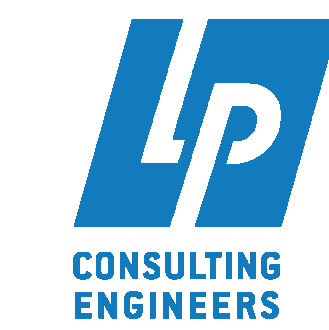

1209 Pleasant Grove Blvd.
Roslindale, CA 95078
P 916-771-0778
www.lpengines.com
Job #: 21-2082

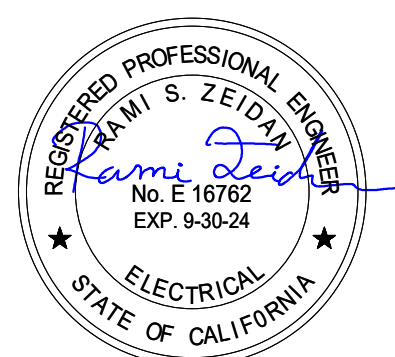

KEYNOTES

- (E) UNDERGROUND PULL BOX FOR POWER. SEE SHEET E0.1 FOR CONDUIT AND WIRE SIZE AND QUANTITY.
- PROVIDE CHRISTY BOX AND (4) 1" CONDUIT FOR POWER AND (1) 1" CONDUIT SPARE WITH PULL STRING FROM THE ELECTRICAL ROOM FOR (F) EVCS.
- PROVIDE FULL BOX FOR (F) PV SYSTEM.
- PROVIDE (3) 4" CONDUIT WITH PULL STRING FOR (F) PV SYSTEM.
- PROVIDE 120V, 2#10 CU + 1#10 CU GND CONNECTION FOR MARQUEE SIGNAGE. REFER TO FLOOR PLAN FOR UG PVC CONDUIT SIZE AND QUANTITY. ELECTRICAL CONTRACTOR SHALL REVIEW DRAWING T1.1 FOR THE INSTALLATION OF CONDUITS AS PATHWAY FROM THE MARQUEE SIGNAGE AND THE IDF ROOM AND ANY ADDITIONAL POWER REQUIREMENTS AND POINT OF CONNECTIONS INDICATED ON THE TECHNOLOGY DRAWINGS.
- PROVIDE CHRISTY BOX B09 OR SIMILAR TYPE TO CONNECT LIGHT POLE. SEE DETAIL 1/E5.2.
- EMERGENCY LIGHT FIXTURE DEDICATED FOR MEANS OF AGGRESS SHALL ONLY TURN ON IN THE EVENT ANY EMERGENCY AND TRAINING.
- 480V, 3-PHASE, 4-WIRE CONNECTION. CONTRACTOR SHALL COORDINATE CONDUIT PATH AND TERMINATION AT THE (E) ELECTRICAL PULL BOX. REFER TO SHEET E0.1 FOR WIRE SIZE AND QUANTITY AND BREAKER SIZE.
- PROVIDE 277V, 2#10 CU + 1#10 CU GND IN CONDUIT INDICATED ON THE SITE PLAN FOR LIGHT POLE. SEE DETAIL 1/E5.2.
- 208V, 1-PHASE, (2) 40A DEDICATED CIRCUIT FOR (F) DUAL EVCS FROM PANEL "EV". PROVIDE (2) 1" CU WITH 2#6 CU + 1#10 CU GND (EACH) FOR POWER FROM (N) BUILDING MAIN ELECTRICAL ROOM AND (1) 1" CO FOR DATA FROM THE IDF ROOM.
- PROVIDE CHRISTY PULL BOX, B09, (1) 1" CU WITH 2#10 CU + 1#10 CU GND FROM PANEL "HL". CIRCUIT #23 FOR LIGHTING AT THE FUTURE LUNCH AREA.

FACILITY:
PARKSIDE MONTESSORI SCHOOL
1685 EISENHOWER ST.
SAN MATEO, CA 94403

PROJECT:
PARKSIDE MONTESSORI MULTIPURPOSE BLDG AND SITE WORK


SHEET NAME:
ELECTRICAL SITE PLAN

ADDENDUM 4

FILE NO.: 41-26 A NO.: 01-120306

DATE: 10/20/2022 PROJ NO.: 3542-004

SHEET:

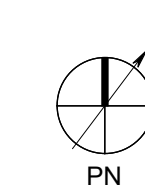

1 ELECTRICAL - SITE PLAN


SCALE: 1" = 20'-0"

E1.1


PLEASE RECYCLE

11/17/2023 10:12:30 AM

THE LINE SHOWN ABOVE IS THE EXACT LOCATION OF THE SHEET ORIGIN PAGE SIZE

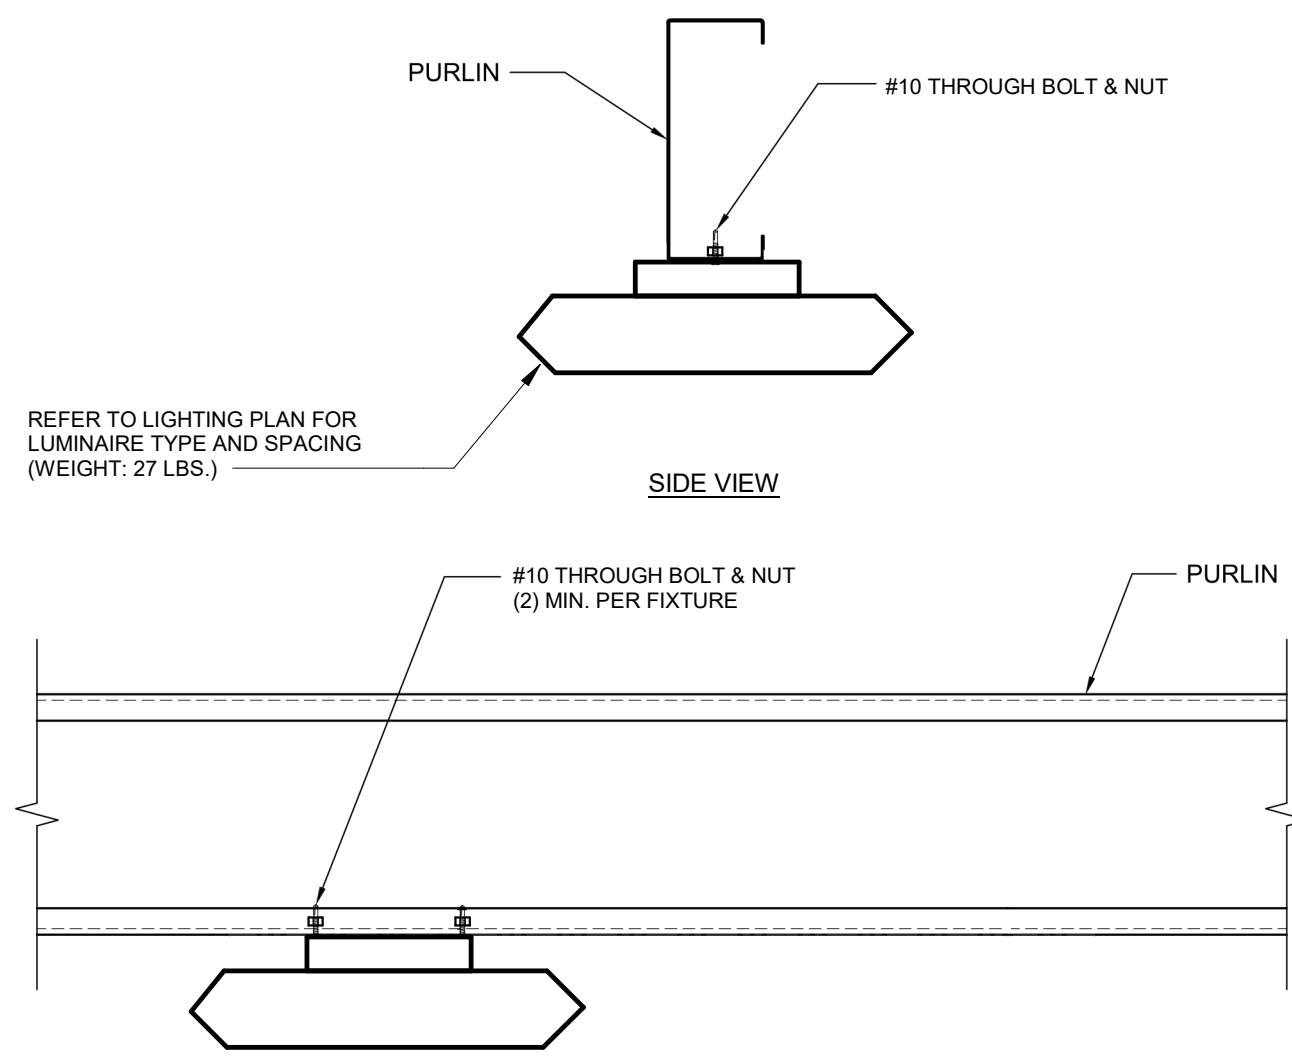

3 LUMINAIRE MOUNTING ON PURLIN DETAIL
SCALE: 1/4" = 1'-0"

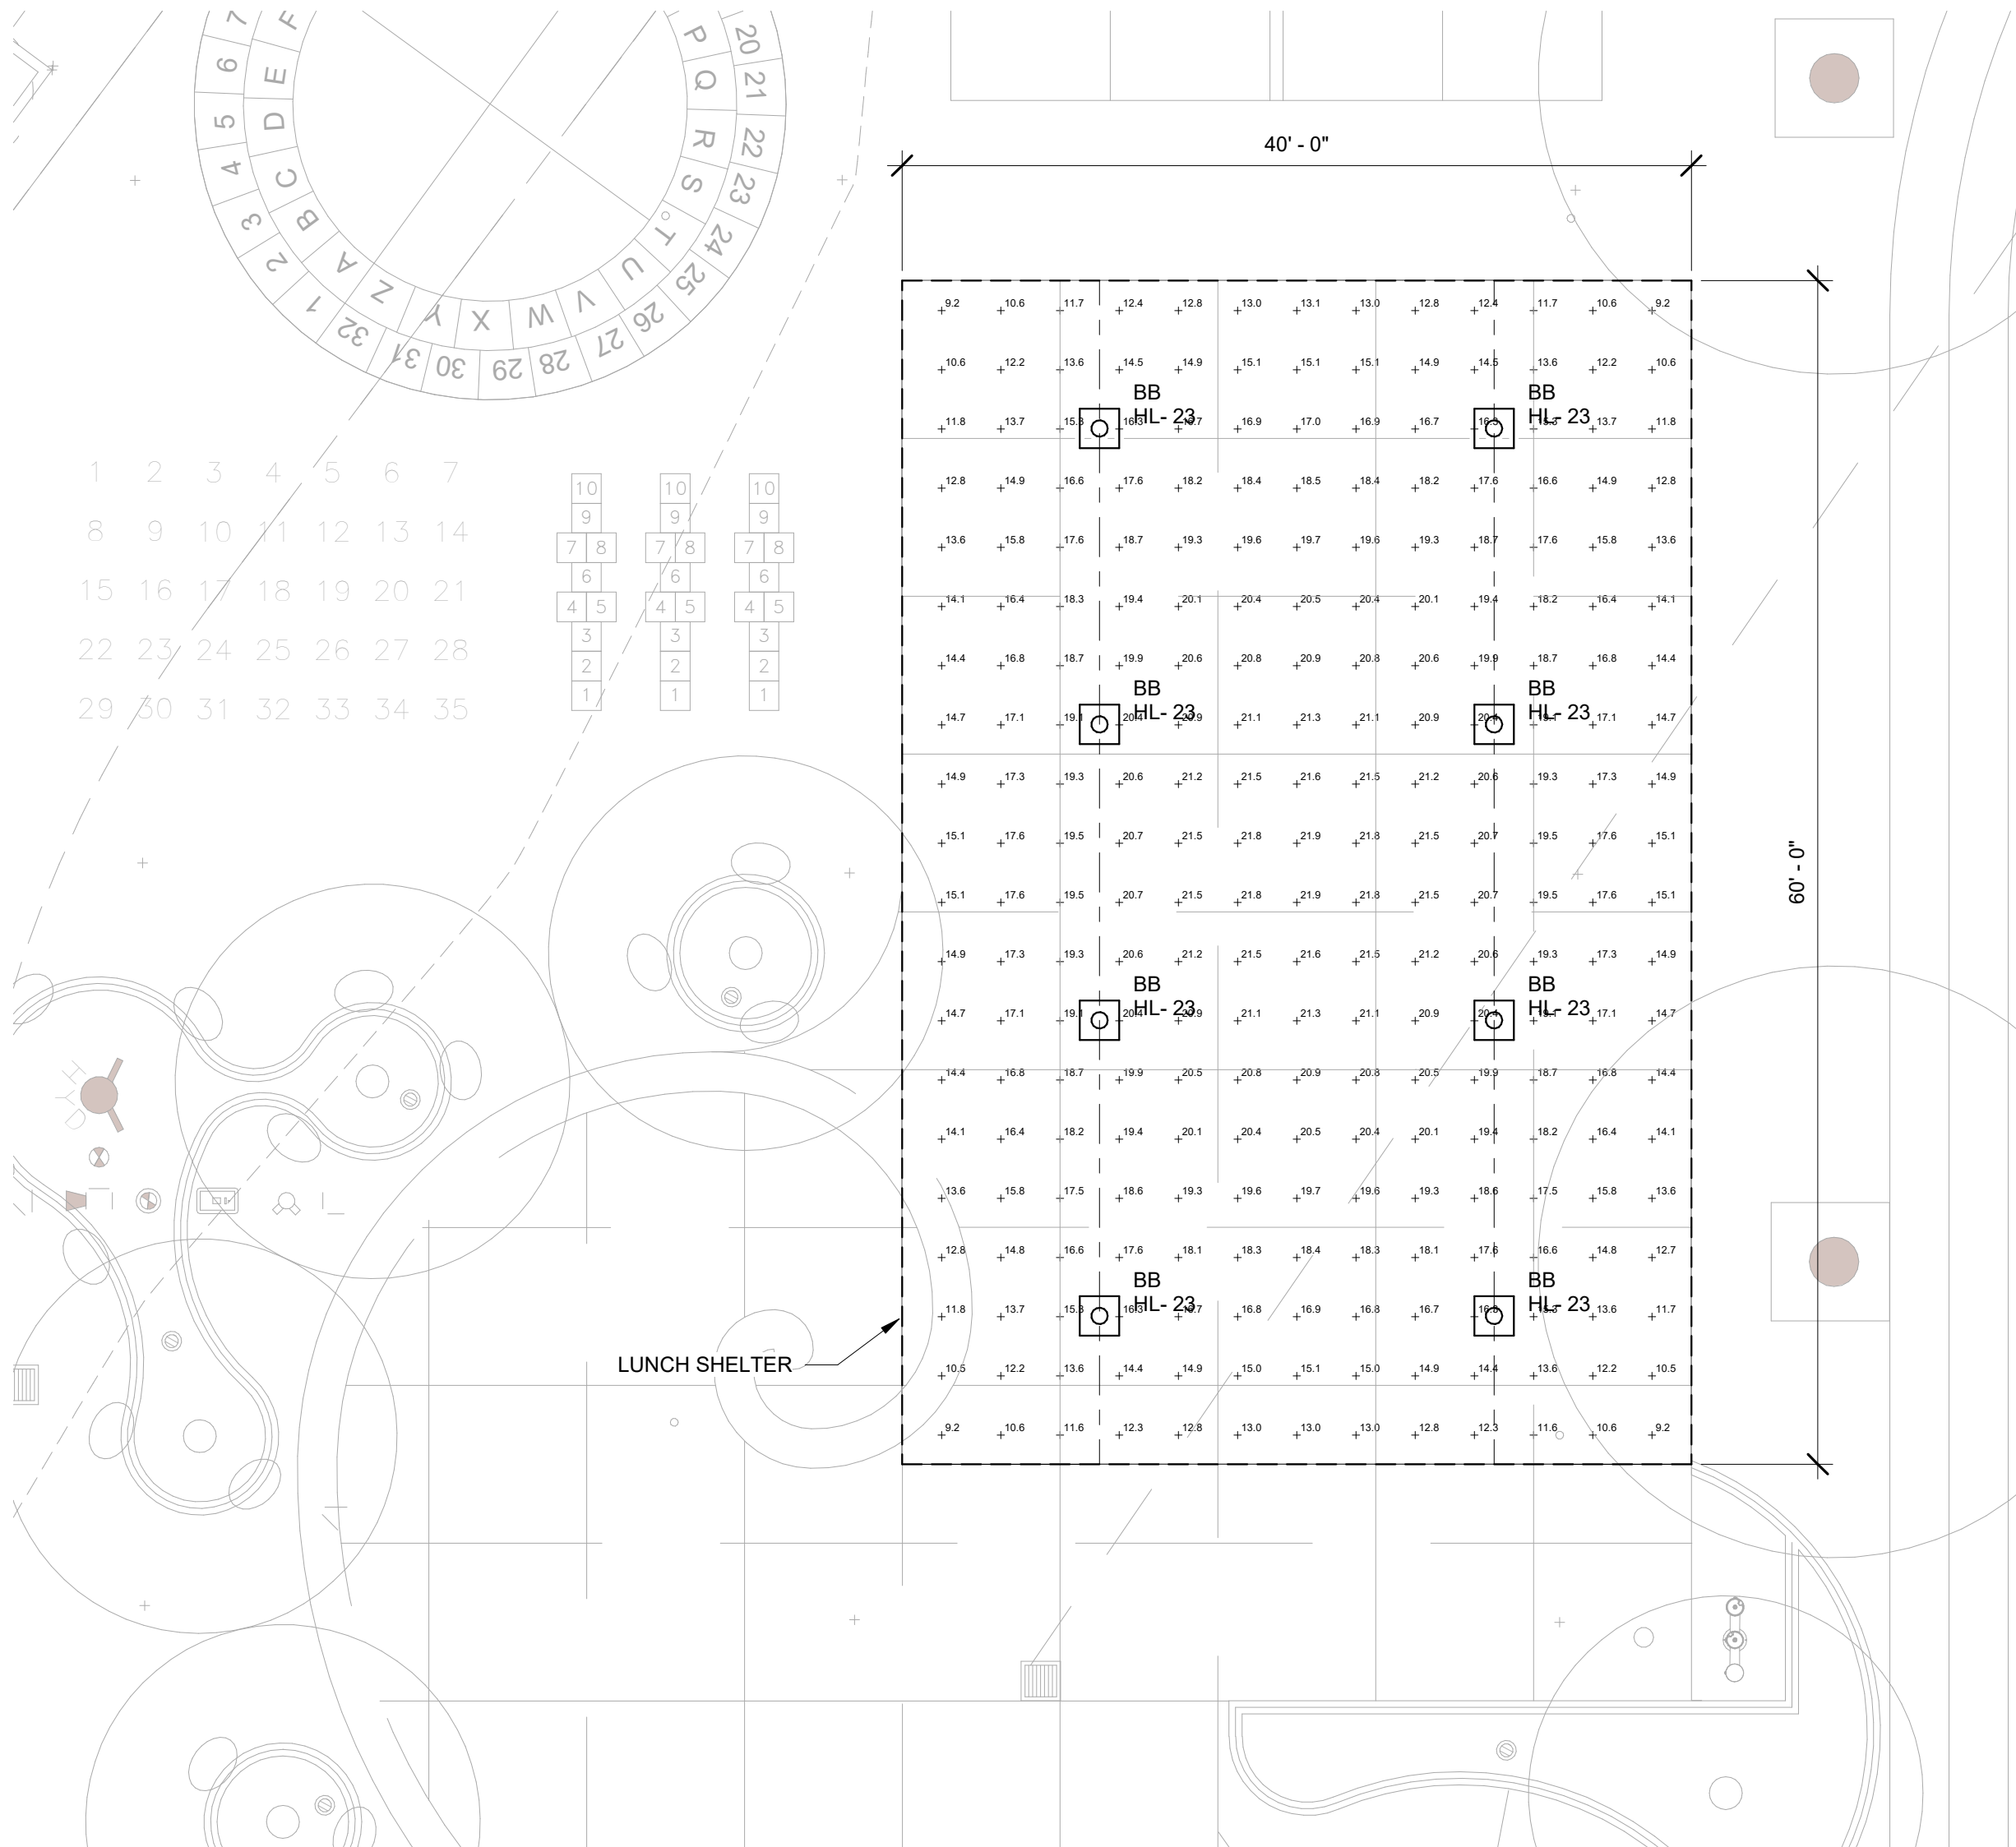

2 LUNCH SHELTER ELECTRICAL PHOTOMETRIC PLAN
SCALE: 1/8" = 1'-0"
N.I.C. - LUNCH SHELTER STRUCTURE WILL BE UNDER SEPARATE PROJECT

LUMINAIRE SCHEDULE							
Symbol	Qty	Label	Arrangement	Description	Lum.Lumens	LLF	Filename
	8	BB	SINGLE	LUNCH SHELTER LIGHTING GRDCO-SFC-3-48L-250-NW-G2	4636	1	FC-3-48L-250-NW-G2.IES
Calculation Summary							
Scene: GENERAL							
Label	CalcType	Units	Avg	Max	Min	Avg/Min	Max/Min
BB	Illuminance	FC	17.0	21.9	9.2	1.8:1	2.4:1

- GENERAL NOTES**
- FIELD VERIFY EXISTING CONDITIONS PRIOR TO PERFORMING WORK AND NOTIFY ARCHITECT/ENGINEER OF ANY CONFLICTS OR DISCREPANCIES.
 - ALL ELECTRICAL DEVICE PROVIDED SHALL BE RATED FOR THE TYPE OF ENVIRONMENT IT IS BEING SUBJECTED TO.
 - REFER TO E0.1 FOR ADDITIONAL GENERAL NOTES.
 - ALL EXTERIOR LIGHTING SHALL BE CONTROLLED PER TITLE 24.
 - SECTION 130.2(b), LUMINAIRE CUTOFF REQUIREMENTS.
 - SECTION 130.2(c), CONTROLS FOR OUTDOOR LIGHTING.
 - DAYLIGHTING AVAILABILITY.
 - AUTOMATAC SCHEDULING CONTROLS.
 - MOTION SENSING CONTROLS.
 - FOR EGRESS PATHWAY TO AREA OF SAFE DISPERSAL REFER TO SHEET E1.2

AGENCY APPROVAL:

DSA # 119574
FILE # 41-26

SAN MATEO-FOSTER CITY SCHOOL DISTRICT
1170 CHESS DR.,
FOSTER CITY, CA 94404

HMC Architects

3542005-000


333 W. SAN CARLOS STREET
STUDIO 750, SAN JOSE, CA 95110
909.989.9379 / www.hmcarchitects.com

DESCRIPTION	DATE
4 Addendum 4	11-21-2023

LP CONSULTING ENGINEERS


1209 Pleasant Grove Blvd.
Roseville, CA 95678
P 916-771-0778
www.lpenginers.com
Job #: 21-2082

- KEYNOTES**
- PROVIDE CHRISTY PULL BOX, B09, (1)1" C WITH 2#10 CU + 1#10 CU GND FROM PANEL "HL", CIRCUIT #23 FOR LIGHTING AT THE LUNCH AREA.
 - PROVIDE WEATHER PROOF LOCABLE WHILE IN USE RECEPTACLE, MOUNTED AT +18" AFF ON THE LUNCH SHELTER COLUMN, PROVIDE 2#10 CU + 1#10 CU GND, 1" C FROM PANEL "LR1", CIRCUIT #30.
 - PROVIDE KEY-SWITCH IN A WEATHERPROOF GANGBOX WITH WEATHERPROOF COVER OVER TO CONTROL THE LUNCH SHELTER. LIGHTING AT THE SHELTER TO BE VIA LCP.
 - PHOTOCELL TO BE MOUNTED ON THE UNDERSIDE OF PURLIN. PROVIDE MOUNTING HARDWARE AND SUPPORT AS REQUIRED.

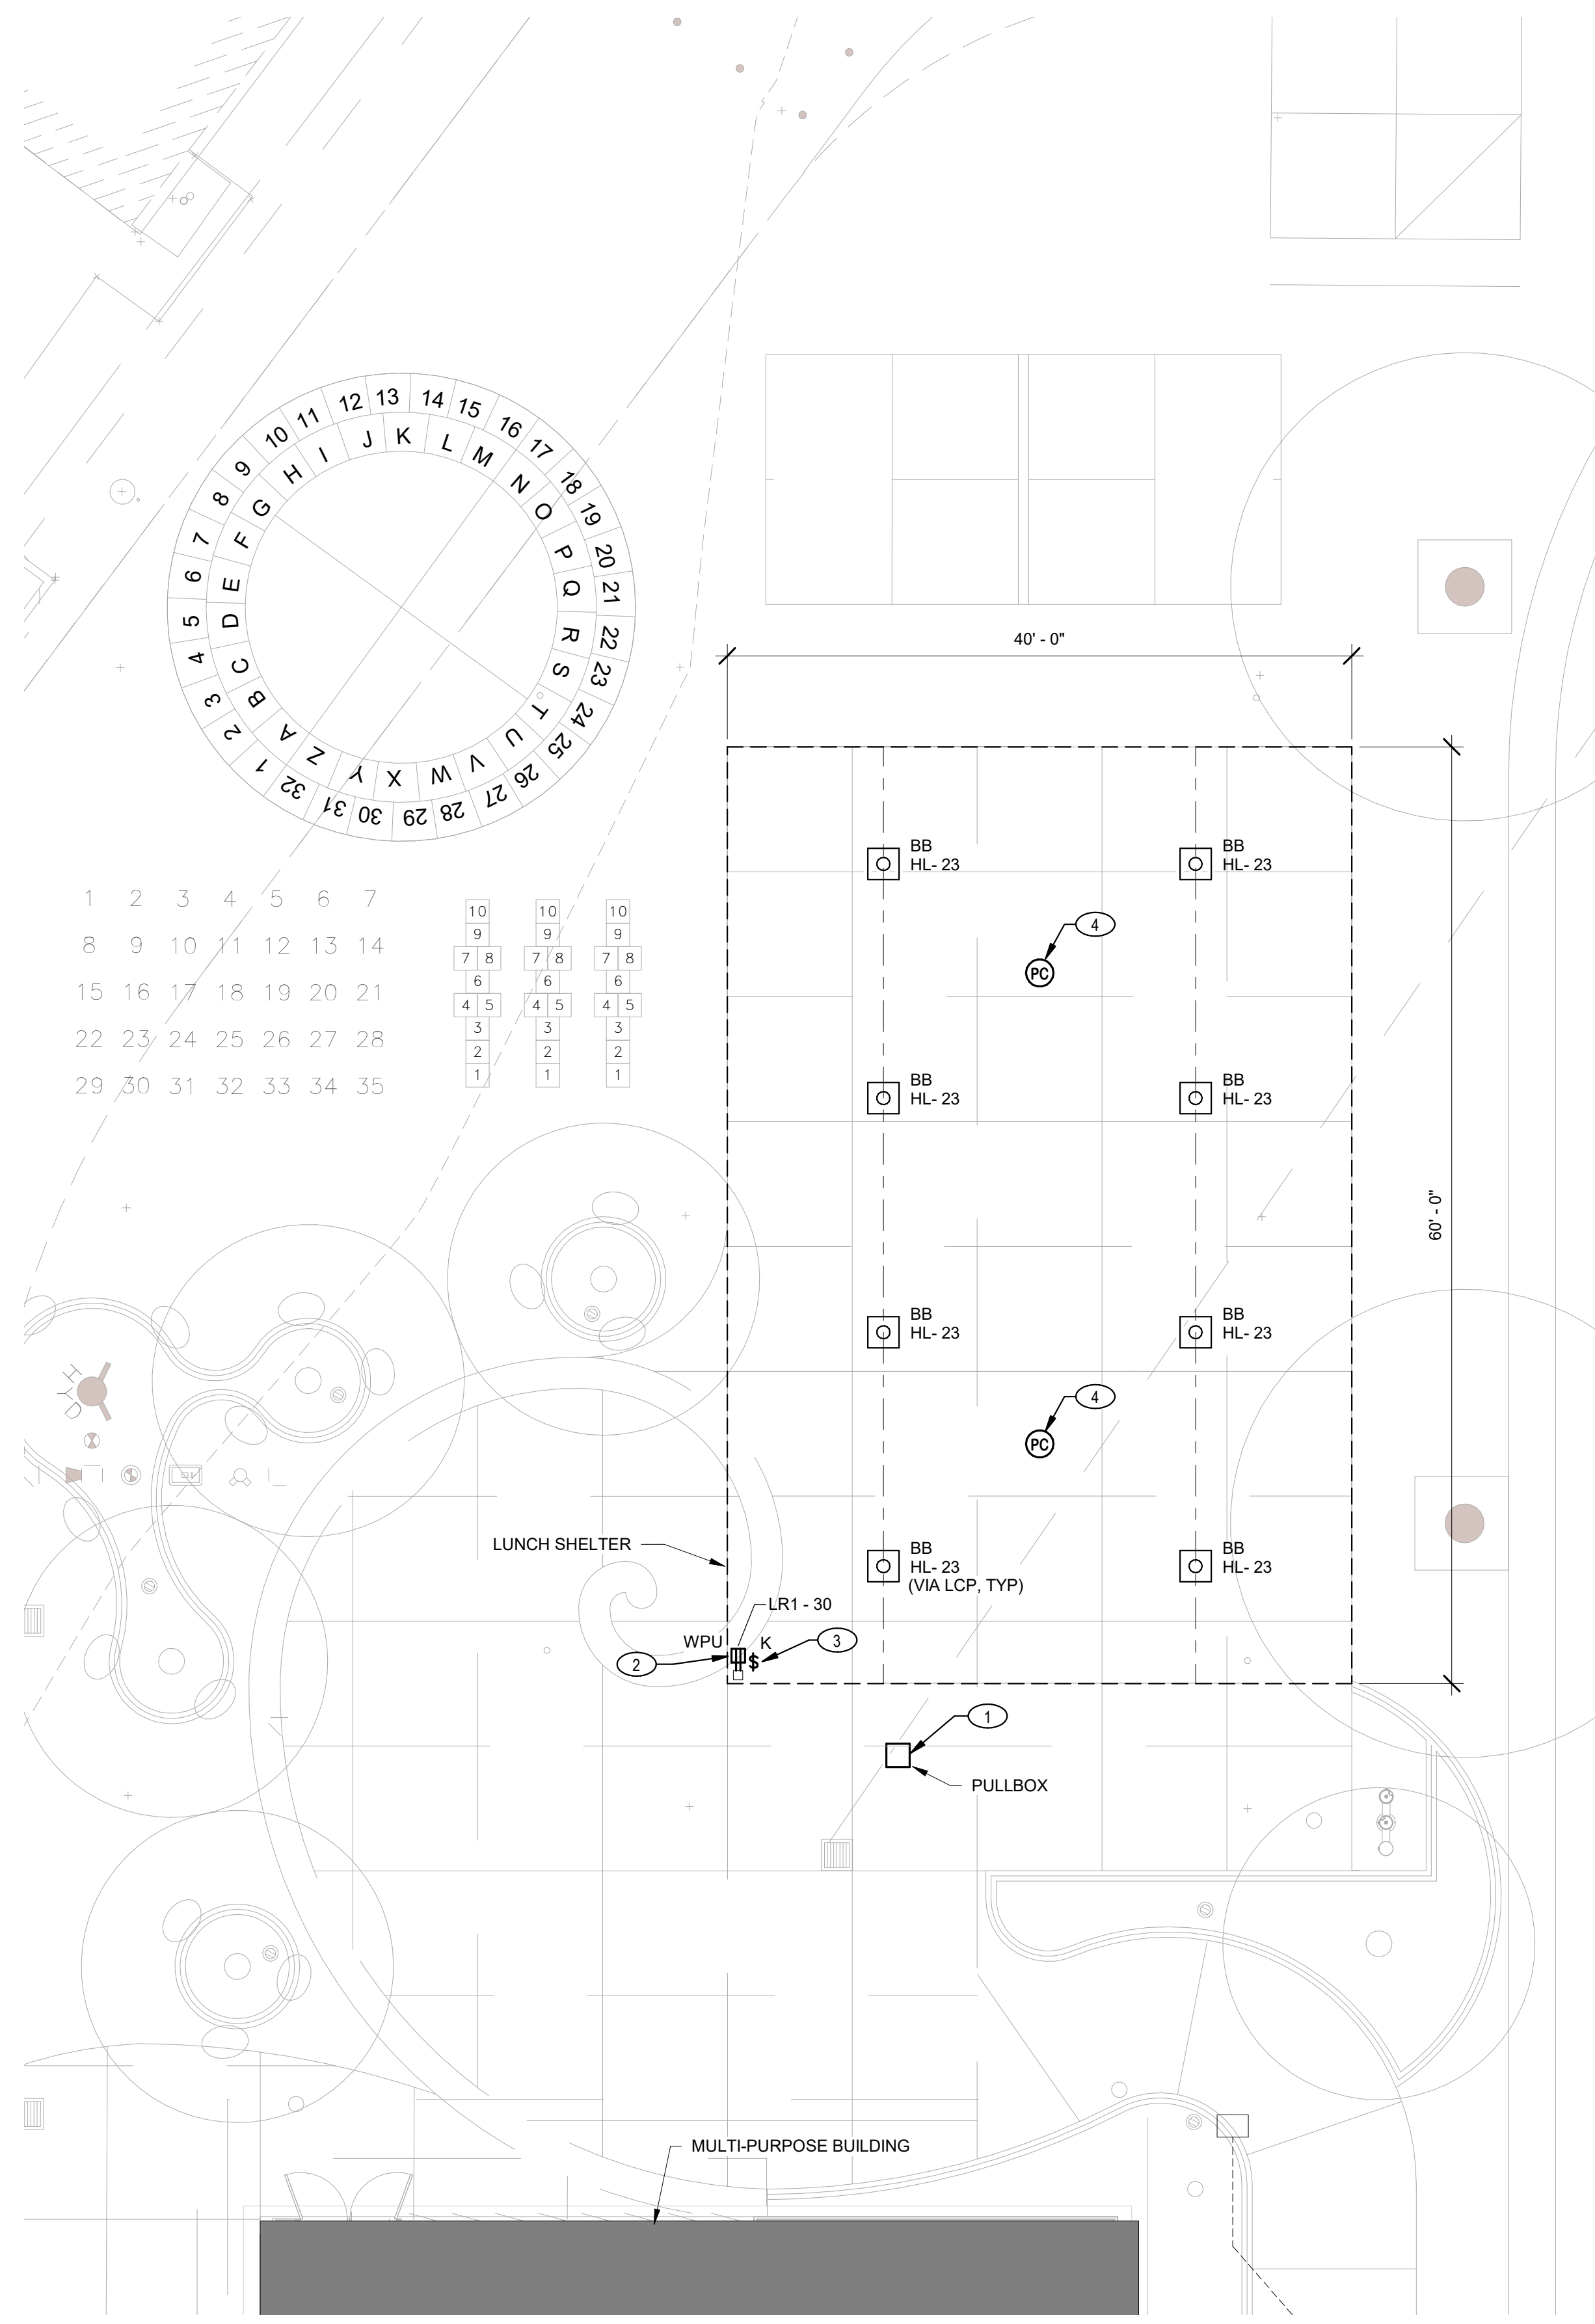

1 FUTURE LUNCH SHELTER ELECTRICAL SITE PLAN
SCALE: 1/8" = 1'-0"
N.I.C. - LUNCH SHELTER STRUCTURE WILL BE UNDER SEPARATE PROJECT

LIGHTING FIXTURE SCHEDULE - LS									
TYPE	MANUFACTURER	MODEL	LAMP	LUMENS	COLOR TEMPERATURE	VOLTS	WATTS	MOUNTING	DESCRIPTION
BB	GARDCO	SFC-DD-3-48L-250-NW-G2-UNV-MGY-F1	LED	4636 lm	4000 K	277 V	38.0 W	SURFACE MTD ON BEAM	SLENDER LED LUMINAIRE, BUG: B1-U0-G1

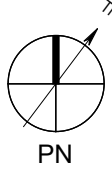

PLEASE RECYCLE

FACILITY:

PARKSIDE MONTESSORI SCHOOL
1685 EISENHOWER ST.
SAN MATEO, CA 94403

PROJECT:

PARKSIDE MONTESSORI MULTIPURPOSE BLDG AND SITE WORK

SHEET NAME:

LUNCH SHELTER ELECTRICAL SITE PLAN & PHOTOMETRIC PLAN

ADDENDUM 4

FILE NO.: 41-26 A NO.: 01-120306

DATE: 10/20/2022 PROJ NO.: 3542-004

SHEET:

E1.1A

LIGHTING FIXTURE NOTES:

1. ALL DRIVERS SHALL BE CEC CERTIFIED
2. COORDINATE LUMINAIRE FINISH WITH ARCHITECT (TYPICAL)
3. COORDINATE LUMINAIRE LOCATIONS WITH ARCHITECT PRIOR TO ROUGH IN (TYPICAL)
4. POLE LIGHTS: PROVIDE GARCOPO POLE/BRACKET STREIGHT ROUND STEEL "SR5" REFER TO LIGHT TYPE "S1", "S3" AND "S4" DEDICATED FOR AREA OF SAFE DISPERSAL AT 14' AFG SHALL BE 4" DIA POLE. REFER TO LIGHT SCHEDULE FOR POLE HEIGHT REQUIREMENTS. FOR CONCRETE BASE, REFER TO DETAIL 1/E5.2
5. POLE LIGHTS: PROVIDE GARCOPO POLE/BRACKET STREIGHT ROUND STEEL "SR9" REFER TO LIGHT TYPE "S2" AND "S3" DEDICATED AT THE PARKING AND SIDE WALK AT 25' AFG SHALL BE 5" DIA POLE. REFER TO LIGHT SCHEDULE FOR POLE HEIGHT REQUIREMENTS. FOR CONCRETE BASE, REFER TO DETAIL 1/E5.2
6. LIGHT FIXTURE TYPE "W" SHOWN ON THE LIGHT FIXTURE SCHEDULE IS SHOWN FOR REFERENCE ONLY AND IT WILL BE FURNISHED AND INSTALLED UNDER FUTURE PACKAGE.

4

2

Notes


Notes

DSA # 119574
FILE # 41-26



Δ	DESCRIPTION	DATE
---	-------------	------

	DSA Backcheck	8-15-2022
2	Addendum 2	10-22-2023
4	Addendum 4	11-21-2023

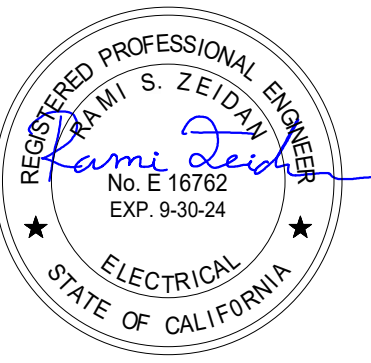

**1209 Pleasant Grove Blvd
Roseville, CA 95678
p 916-771-0778
www.lpengineers.com
Job #: 21-2082**

PARKSIDE MONTESSORI SCHOOL
1685 EISENHOWER ST.
SAN MATEO, CA 94403

SHEET NAME:

ELECTRICAL PANEL AND LIGHTING SCHEDULES

FILE NO.: 41-26 A NO.: 01-120306

DATE: 10/20/2022 PROJ NO: 3542-004

SHEET

ALL LINE SHOWN ABOVE LINES
DO NOT EXCEED SHEET ORIGINAL PAGE SIZE

Branch Panel: LM														
Location: Electrical RM				Volts: 120/208 Wye				A.I.C. Rating: 10,000						
Supply From: LDP				Phases: 3				Mains Type: MLO						
Mounting: Surface				Wires: 4				Mains Rating: 100 A						
Enclosure: Type 1								MCB Rating: 100 A						
Notes:														
CKT	Load Name	Trip	Poles	A	B	C	A	B	C	Poles	Trip	Load Name	CKT	
1	HP-1 & FC-1	25 A	2	1,660				180		1	20 A	DUCT SMOKE DETECTOR PHP-1	2	
3	--	--	--		1,660				720	1	20 A	RECEPT - ROOF	4	
5	HP-2 & FC-2	30 A	2			1,996				180	1	20 A	RECEPT - ROOF	6
7	--	--	--	1,996				8		1	20 A	CEF-1	8	
9	ODU-1 & IDU-1	30 A	2		3,030				8	1	20 A	CEF-2	10	
11	--	--	--			1,830				15	1	20 A	CEF-3	12
13	ODU-2 & IDU-2	30 A	2	3,030				15		1	20 A	CEF-4	14	
15	--	--	--			1,830			22	1	20 A	CEF-5	16	
17	CP-1	20 A	1				41			93	1	20 A	CONDENSATE PUMP FOR FC-2	18
19	CP-2	20 A	1		41				93	1	20 A	CONDENSATE PUMP FOR FC-1	20	
21	KEF-1 - ROOF	20 A	1			50				93	1	20 A	CONDENSATE PUMP FOR IDU-1	22
23	ODU-3 & IDU-3	30 A	2				3,030			93	1	20 A	CONDENSATE PUMP FOR IDU-2	24
25	--	--	--			1,830				93	1	20 A	CONDENSATE PUMP FOR IDU-3	26
27	SPARE	20 A	1			0			200	1	20 A	JUNCTION BOX PANEL EMS	28	
29	SPARE	20 A	1				0			0	1	20 A	SPARE	30
31	SPARE	20 A	1		0			0		0	1	20 A	SPARE	32
33	SPARE	20 A	1			0				0	1	20 A	SPARE	34
35	SPARE	20 A	1				0			0	--	--	PFB	36
37	SPARE	20 A	1		0			0			--	--	PFB	38
39	SPARE	20 A	1			0			0		--	--	PFB	40
41	SPARE	20 A	1				0			0	--	--	PFB	42
Total Load:				8,946 VA		7,613 VA		7,278 VA						
Total Amps:				75 A		64 A		61 A						
Legend:														
Load Classification		Connected Load		Demand Factor		Estimated Demand		Panel Totals						
Motor		150 VA		106.83%		160 VA								
HVAC		21892 VA		104.56%		22890 VA		Total Conn. Load: 23,837 VA						
Power		50 VA		100.00%		50 VA		Total Est. Demand: 24,845 VA						
RECEPT		1745 VA		100.00%		1745 VA		Total Conn. Current: 66 A						
								Total Est. Demand Current: 69 A						
Notes:														

Branch Panel: LR1														
Location: Electrical RM				Volts: 120/208 Wye				A.I.C. Rating: 10,000						
Supply From: LDP				Phases: 3				Mains Type: MLO						
Mounting: Surface				Wires: 4				Mains Rating: 225 A						
Enclosure: Type 1								MCB Rating: 225 A						
Notes:														
CKT	Load Name	Trip	Poles	A	B	C	A	B	C	Poles	Trip	Load Name	CKT	
1	RECEPT - OFF/PE STORAGE	20 A	1	1,080				180			1	20 A	RECEPT - ELEC ROOM	2
3	RECEPT - OFF/PE STORAGE	20 A	1		360				1,250	1	20 A	RECEPT - REFRIGERATOR, PTA ROOM	4	
5	RECEPT - OFF/PE STORAGE	20 A	1			720				180	1	20 A	RECEPT - ABOVE COUNTER	6
7	RECEPT - RESTROOMS	20 A	1	720				180			1	20 A	RECEPT - ABOVE COUNTER	8
9	RESTROOMS PROIS/LAVATORIES/FLUSH...	20 A	1		260				180		1	20 A	RECEPT - WATER FOUNTAIN	10
11	RECEPT - OFIC EXTERIOR	20 A	1			720				180	1	20 A	RECEPT - IDF ROOM	12
13	RECEPT - OFIC EXTERIOR	20 A	1	540				360			1	20 A	RECEPT - IDF AMP	14
15	RECEPT - PTA ROOM	20 A	1		900				360		1	20 A	RECEPT - IDF RACK	16
17	RECEPT - PLATFORM	20 A	1			720				360	1	20 A	RECEPT - IDF INTR	18
19	RECEPT CUSTORIAL/TABLE STORAGE	20 A	1	1,080				360			1	20 A	RECEPT - IDF EMS	20
21	RECEPT - MULTI PURPOSE ROOM	20 A	1		720				360		1	20 A	RECEPT - AV CABINET	22
23	RECEPT - MULTI PURPOSE ROOM	20 A	1			720				360	1	20 A	RECEPT - AV CABINET	24
25	RECEPT - MULTI PURPOSE ROOM	20 A	1	360				700			2	30 A	RECEPT - IDF RACK	26
27	ELECTRIC SHADES	20 A	1		1,200				700					28
29	ELECTRIC SHADES	20 A	1			1,200				180	1	20 A	RECEPT - LUNCH SHELTER	30
31	ELECTRIC SHADES	20 A	1	1,200				0			1	20 A	SPARE	32
33	ELECTRIC SHADES	20 A	1		1,200				0		1	20 A	SPARE	34
35	PROJECTOR SCREEN	20 A	1			1,000				250	1	20 A	EXTERIOR MARQUEE SIGN	36
37	RECEPT - CEILING MOUNTED PROJECTOR	20 A	1	180				180			1	20 A	IRRIGATION CONTROLLER	38
39	SPARE	20 A	1		0				1,200		1	20 A	[2]FIRE RISER FLOW SWITCH, STROBE/HORN	40
41	ADA LIFT	20 A	1				1,200			350	1	20 A	[2]FIRE ALARM POWER SUPPLY	42
Total Load:				7,120 VA			8,690 VA							
Total Amps:				59 A			74 A							
Legend:														
Load Classification		Connected Load		Demand Factor		Estimated Demand		Panel Totals						
Motor		180 VA		125.00%		225 VA								
Power		2200 VA		100.00%		2200 VA		Total Conn. Load: 23,950 VA						
RECEPT		21570 VA		73.18%		15785 VA		Total Est. Demand: 18,210 VA						
								Total Conn. Current: 66 A						
								Total Est. Demand Current: 51 A						
Notes:														
1 - MULTIPLE CIRCUITS SHARING THE SAME CONDUIT AND NEUTRAL SHALL HAVE HANDLE TIES AT BREAKERS AND WIRE IN PANEL TIES PER CEC 210.4. 2 - BREAKER ASSIGNED FOR FIRE ALARM SYSTEM SHALL BE PAINTED RED/MARKED WITH RED AND BE PROVIDED WITH A LOCK-ON DEVICE.														

DIST. Panel: LDP													
Location: Electrical RM				Volts: 120/208 Wye				A.I.C. Rating: 10,000					
Supply From: XFMR "X1"				Phases: 3				Mains Type: MCB					
Mounting: Surface				Wires: 4				Mains Rating: 400 A					
Enclosure: Type 1								MCB Rating: 400 A					
Notes:													
CKT	Circuit Description			Trip	Poles	A	B	C					
1,2,3	LR1	3			150 A		7120 VA	8690 VA	8140 VA				
4,5,6	LM	100 A			3	8946 VA	7613 VA	7278 VA					
7,8,9	LK	175 A			3	17811 VA	17845 VA	16505 VA					
10,11,12	SPARE	100 A			3	0 VA	0 VA	0 VA					
13	SPACE	--			--	0 VA							
14	SPACE	--			--		0 VA						
15	SPACE	--			--			0 VA					
16	SPACE	--			--	0 VA							
17	SPACE	--			--		0 VA						
18	SPACE	--			--			0 VA					
19	SPACE	--			--	0 VA							
20	SPACE	--			--		0 VA						
21	SPACE	--			--			0 VA					
Total Load:						33877 VA	34148 VA	33923 VA					
Total Amps:						282 A	285 A	283 A					
Legend:													
Load Classification		Connected Load	Demand Factor	Estimated Demand	Panel Totals								
Motor		1350 VA	122.22%	1650 VA									
RECEPT		33831 VA	64.78%	21916 VA	Total Conn. Load: 101947 VA								
					Total Est. Demand: 82805 VA								
					Total Conn. Current: 283 A								
					Total Est. Demand Current: 230 A								
Notes:													

11/17/2023 10:12:34 AM

STATE OF CALIFORNIA
CALIFORNIA ENERGY COMMISSION

Outdoor Lighting

CERTIFICATE OF COMPLIANCE
Project Name: Parkside Montessori MPR
Report Page: (Page 3 of 7)
Date Prepared: 11/16/2023

NRCC-LTO-E

F. OUTDOOR LIGHTING FIXTURE SCHEDULE

For new or altered lighting systems demonstrating compliance with 140.7 / 170.2(e)6 all new luminaires being installed and any existing luminaires remaining or being moved within the spaces covered by the permit application are included in the Table below. For altered lighting systems using the Existing Power method per 141.0(b)2L only new luminaires being installed and replacement luminaires being installed as part of the project scope are included (ie, existing luminaires remaining or existing luminaires being moved are not included). Outdoor lighting attached to multifamily buildings and controlled from the inside of a dwelling unit are included in Table H, and are not included here. All other multifamily outdoor lighting is included here.

Designed Wattage:

01	02	03	04	05	06	07	08	09	10
Name or Item Tag	Complete Luminaire Description	Watts per luminaire ^{1,2}	How is Wattage determined	Total Number Luminaires ³	Luminaire Status ³	Excluded per 140.7(a) / 170.2(e)6A	Design Watts	Cutoff Req. > 6,200 initial lumen output 130.2(b) / 160.5(c) ^{1,4}	Field Inspector Pass Fail
BB	GARDCO-SFC-DD-3-48L-250-NW-G2	Linear	38	Mfr. Spec	8	New	304	NA: < 6200 lumens	Pass Fail
Total Design Watts:								304	

* NOTES: Selections with a * require a note in the space below explaining how compliance is achieved.
EX: Luminaire is lighting a statue; EXCEPTION 2 to 130.2(b)
¹FOOTNOTES: Authority Having Jurisdiction may ask for Luminaire cut sheets to confirm wattage used for compliance per 130.0(c) / 160.5(b)
²For linear luminaires, wattage should be indicated as W/lf instead of Watts/luminaire. Total linear feet should be indicated in column 05 instead of number of luminaires.
³Select "New" for new luminaires in a new outdoor lighting project, or for added luminaires in an alteration. Select "Altered" for replacement luminaires in an alteration. Select "Existing to Remain" for existing luminaires within the project scope that are not being altered and are remaining. Select "Existing Reinstalled" for existing luminaires which are being removed and reinstalled as part of the project scope.
⁴Compliance with mandatory shielding requirements is required for luminaires with initial lumen output >= 6,200 unless exempted by 130.2(b) / 160.5(c)

G. SHIELDING REQUIREMENTS (BUG)

This section does not apply to this project.

Generated Date/Time: Documentation Software: EnergyPro
Report Version: 2022.0.000 Schema Version: rev 20220101
Compliance ID: EnergyPro-4955-1123-1498 Report Generated: 2023-11-16 17:06:16

CA Building Energy Efficiency Standards - 2022 Nonresidential Compliance

STATE OF CALIFORNIA
CALIFORNIA ENERGY COMMISSION

Outdoor Lighting

CERTIFICATE OF COMPLIANCE
Project Name: Parkside Montessori MPR
Report Page: (Page 2 of 7)
Date Prepared: 11/16/2023

NRCC-LTO-E

C. COMPLIANCE RESULTS

Results in this table are automatically calculated from data input and calculations in Tables F through N. Note: If any cell on this table says "COMPLIES with Exceptional Conditions" refer to Table D. Exceptional Conditions for guidance or see applicable Table referenced below.

Calculations of Total Allowed Lighting Power (Watts) 140.7 / 170.2(e)6 or 141.0(b)2L / 180.2(b)4Bv										Compliance Results			
01	02	03	04	05	06	07	08	09					
General Hardscape Allowance 140.7(d)1 / 170.2(e)6 (See Table I)	Per Application 140.7(d)2 / 170.2(e)6 (See Table J)	Sales Frontage 140.7(d)2 (See Table K)	Ornamental 140.7(d)2 / 170.2(e)6 (See Table L)	Per Specific Area 140.7(d)2 / 170.2(e)6 (See Table M)	Existing Power Allowance 141.0(b)2L / 180.2(b)4Bv (See Table N)								
0	+	---	+	---	+	304	OR	---	=	304	≥	304	COMPLIES
Shielding Compliance (See Table G for Details)										N/A			
Controls Compliance (See Table H for Details)										COMPLIES			

D. EXCEPTIONAL CONDITIONS

This table is auto-filled with uneditable comments because of selections made or data entered in tables throughout the form.

E. ADDITIONAL REMARKS

This table includes remarks made by the permit applicant to the Authority Having Jurisdiction.

Generated Date/Time: Documentation Software: EnergyPro
Report Version: 2022.0.000 Schema Version: rev 20220101
Compliance ID: EnergyPro-4955-1123-1498 Report Generated: 2023-11-16 17:06:16

CA Building Energy Efficiency Standards - 2022 Nonresidential Compliance

STATE OF CALIFORNIA
CALIFORNIA ENERGY COMMISSION

Outdoor Lighting

CERTIFICATE OF COMPLIANCE
Project Name: Parkside Montessori MPR
Report Page: (Page 1 of 7)
Date Prepared: 11/16/2023

NRCC-LTO-E

A. GENERAL INFORMATION

01 Project Location (city)	San Mateo	04 Total Illuminated Hardscape Area (ft ²)	0
02 Climate Zone	3	03 Outdoor Lighting Zone per Title 24 Part 1 110.114 or as designated by Authority Having Jurisdiction (AHJ):	
<input type="checkbox"/> LZ-0: Very Low - Undeveloped Parkland		<input type="checkbox"/> LZ-2: Moderate - Urban Clusters	<input type="checkbox"/> LZ-4: High - Must be reviewed by CA Energy Commission for Approval
<input type="checkbox"/> LZ-1: Low - Rural Areas		<input checked="" type="checkbox"/> LZ-3: Moderately High - Urban Areas	
05 Occupancy Types within Project			
• All Other Occupancies			

B. PROJECT SCOPE

This table includes outdoor lighting systems that are within the scope of the permit application and are demonstrating compliance using the prescriptive path outlined in 140.7 / 170.2(e)6 or 141.0(b)2L / 180.2(b)4Bv for alterations.

My Project Consists of:

01	02	
<input checked="" type="checkbox"/> New Lighting System	Must Comply with Allowances from 140.7 / 170.2(e)6	
<input type="checkbox"/> Altered Lighting System	Is your alteration increasing the connected lighting load (Watts)?	
	Yes No	
03	04	05
% of Existing Luminaires Being Altered ¹	Sum Total of Luminaires Being Added or Altered	Calculation Method
<input type="checkbox"/> < 10% <input type="checkbox"/> >= 10% and < 50% <input type="checkbox"/> >= 50%		

Please proceed to Table F. Outdoor Lighting Fixture Schedule to define the project's luminaires.

¹FOOTNOTES: % of Existing Luminaires Being Altered = (Sum Total of Luminaires Being Added or Altered / Existing Luminaires within the Scope of the Permit Application) x 100.

Generated Date/Time: Documentation Software: EnergyPro
Report Version: 2022.0.000 Schema Version: rev 20220101
Compliance ID: EnergyPro-4955-1123-1498 Report Generated: 2023-11-16 17:06:16

CA Building Energy Efficiency Standards - 2022 Nonresidential Compliance

STATE OF CALIFORNIA
CALIFORNIA ENERGY COMMISSION

Outdoor Lighting

CERTIFICATE OF COMPLIANCE
Project Name: Parkside Montessori MPR
Report Page: (Page 4 of 7)
Date Prepared: 11/16/2023

NRCC-LTO-E

H. OUTDOOR LIGHTING CONTROLS

This table demonstrates compliance with controls requirements for all new or altered luminaires installed as part of the permit application. For alteration projects, luminaires which are existing to remain (ie untouched) and luminaires which are removed and reinstalled (wiring only) do not need to be included in this table even if they are within the spaces covered by the permit application.

Outdoor lighting for nonresidential buildings, parking garages and common service areas in multifamily buildings must be documented separately from outdoor lighting attached to multifamily buildings and controlled from the inside of a dwelling unit.

Mandatory Controls for Nonresidential Occupancies, Parking Garages & Common Areas in Multifamily Buildings

01	02	03	04	05
Area Description	Shut-Off 130.2(c)1 / 160.5(c)	Auto-Schedule 130.2(c)2 / 160.5(c)	Motion Sensor 130.2(c)3 / 160.5(c)	Field Inspector
Lunch Shelter	Photocontrol	Provided	NA: Each Luminaire <= 40 Watts	Pass Fail
Lunch Shelter	Astronomical Timer	Provided	NA: Each Luminaire <= 40 Watts	Pass Fail

¹FOOTNOTE: Text has been abbreviated, please refer to Table 160.5-A to confirm compliance with the specific light source technologies listed.
²Authority having jurisdiction may ask for cut sheets or other documentation to confirm compliance of light source.
³Recessed luminaires marked for use in pre-rated installations, and recessed luminaires installed in non-insulated ceilings are exempted from II and III.

I. LIGHTING POWER ALLOWANCE (per 140.7 / 170.2(e))

This table includes areas using allowance calculations per 140.7 / 170.2(e). General Hardscape Allowance is per Table 140.7-A / Table 170.2-R while "Use it or lose it" Allowances are per Table 140.7-B / Table 170.2-S. Indicate which allowances are being used to expand sections for user input. Luminaires that qualify for one of the "Use it or lose it" allowances shall not qualify for another "Use it or lose it" allowance.

Outdoor lighting attached to multifamily buildings and controlled from the inside of a dwelling unit are included in Table H, and are not included here. All other multifamily outdoor lighting is included here.

01	
<input type="checkbox"/> General Hardscape Allowance Table I (below)	"Use it or lose it" Allowance (select all that apply) (select all that apply)
<input type="checkbox"/> Per Application Table J	<input type="checkbox"/> Sales Frontage Table K
<input type="checkbox"/> Ornamental Table L	<input checked="" type="checkbox"/> Per Specific Area Table M

J. LIGHTING ALLOWANCE: PER APPLICATION

This section does not apply to this project.

Generated Date/Time: Documentation Software: EnergyPro
Report Version: 2022.0.000 Schema Version: rev 20220101
Compliance ID: EnergyPro-4955-1123-1498 Report Generated: 2023-11-16 17:06:16

CA Building Energy Efficiency Standards - 2022 Nonresidential Compliance

STATE OF CALIFORNIA
CALIFORNIA ENERGY COMMISSION

Outdoor Lighting

CERTIFICATE OF COMPLIANCE
Project Name: Parkside Montessori MPR
Report Page: (Page 7 of 7)
Date Prepared: 11/16/2023

NRCC-LTO-E

DOCUMENTATION AUTHOR'S DECLARATION STATEMENT

I certify that this Certificate of Compliance documentation is accurate and complete.

Documentation Author Name: Juan Hidalgo
Company: 777 Grand Ave
City/State/Zip: San Rafael CA 94901
Documentation Author Signature: [Signature]
Signature Date: 2023-11-16
CEA / HERS Certification Identification (if applicable):
Phone: 415-843-5329

RESPONSIBLE PERSON'S DECLARATION STATEMENT

1. I certify the following under penalty of perjury, under the laws of the State of California:
2. The information provided on this Certificate of Compliance is true and correct.
3. I am eligible under Division 3 of the Business and Professions Code to accept responsibility for the building design or system design identified on this Certificate of Compliance (responsible designer).
4. The energy features and performance specifications, materials, components, and manufactured devices for the building design or system design identified on this Certificate of Compliance conform to the requirements of Title 24, Part 1 and Part 6 of the California Code of Regulations.
5. The building design features or system design features identified on this Certificate of Compliance are consistent with the information provided on other applicable compliance documents, worksheets, calculations, plans and specifications submitted to the enforcement agency for approval with this building permit application.
6. I will ensure that a completed signed copy of this Certificate of Compliance shall be made available with the building permit(s) issued for the building, and made available to the enforcement agency for all applicable inspections. I understand that a completed signed copy of this Certificate of Compliance is required to be included with the documentation the builder provides to the building owner at occupancy.


Responsible Designer Name: Rami S Zeidan
Company: LP Consulting Engineers
Address: 1209 Pleasant Grove Blvd
City/State/Zip: Roseville CA 95678
Responsible Designer Signature: [Signature]
Date Signed: 2023-11-16
License: E 16762
Phone: 916-771-0778

Generated Date/Time: Documentation Software: EnergyPro
Report Version: 2022.0.000 Schema Version: rev 20220101
Compliance ID: EnergyPro-4955-1123-1498 Report Generated: 2023-11-16 17:06:16

CA Building Energy Efficiency Standards - 2022 Nonresidential Compliance

AGENCY APPROVAL:

DSA # 119574
FILE # 41-26

 SAN MATEO-FOSTER CITY SCHOOL DISTRICT
1170 CHESS DR., FOSTER CITY, CA 94404

HMC Architects

3542005-000

333 W. SAN CARLOS STREET
STUDIO 750, SAN JOSE, CA 95110
909 989 9379 / www.hmcarchitects.com

DESCRIPTION DATE

4 Addendum 4 11-21-2023

 1209 Pleasant Grove Blvd.
Roseville, CA 95678
P 916-771-0778
www.lpengr.com
Job #: 21-2082



FACILITY:

PARKSIDE MONTESSORI SCHOOL

1685 EISENHOWER ST.

SAN MATEO, CA 94403

PROJECT:

PARKSIDE MONTESSORI MULTIPURPOSE BLDG AND SITE WORK

SHEET NAME:

TITLE 24 COMPLIANCE - LUNCH SHELTER

ADDENDUM 4

FILE NO.: 41-26 A NO.: 01-120306

DATE: 10/20/2022 PROJ NO.: 3542-004

SHEET:

T24.5