



Troy Schools District

**RFP #2324-22
BP#3B Smith Middle School - ARCH & MEP & Civil -
Addendum #2
July 15th, 2024**

Content Included in this Addendum:

**Cover Page (1 Page)
Barton Malow Write Up (6 Pages)
TMP Addendum Write Up (139 Pages)
BP#3B Pre-Bid Meeting Agenda (3 Pages)
BP#3B Pre-Bid Sign-In Sheet (2 Pages)**

TOTAL PAGES: 151 Pages



July 15th, 2024

Troy Schools District – BP#3B Smith Middle School – ARCH & MEP & Civil – Addendum #2

Addendum #2 Bidder Clarifications

A. General Clarifications

- BID DUE DATE CHANGED TO JULY 25TH @ 2PM FOR THE FOLLOW CATEGORIES:
 - Bid Category: Carpentry
 - Bid Category: Roofing
 - Bid Category: Metal Wall Panels
 - Bid Category: Glass and Glazing
 - Bid Category: Paint and Wall Coverings
 - Bid Category: Flooring
 - Bid Category: Hard Tile
 - Bid Category: Gym Flooring
 - Bid Category: General Trades
 - Bid Category: Acoustical Wall Units
 - Bid Category: Signage
 - Bid Category: Casework
 - Bid Category: Food Service Equipment
 - Bid Category: Gym Equipment
 - Bid Category: Elevator
 - Bid Category: Fire Suppression
 - Bid Category: Mechanical
 - Bid Category: Electrical
 - Bid Category: Fire Alarm
- THE FOLLOWING CATEGORIES' DUE DATES STAY THE SAME @ 2PM:
 - Bid Category: Masonry – July 23rd
 - Bid Category: Plumbing – July 23rd
 - Bid Category: Structured Cabling - July 30th
 - Bid Category: Earthwork – July 30th
 - Bid Category: Landscape – July 30th
 - Bid Category: Asphalt Paving – July 30th
- Geotechnical Report Supplied (provided on Building Connected under files 'Additional Documents')
- Project Manual Updates for work scopes shown below
- Submittals for pre-purchase Electrical Equipment (provided on Building Connected under files 'Additional Documents')

B. Clarifications and Additions to Work Scopes

- **Masonry**
 - Removed erroneous scope notes
- **Carpentry**
 - Removed decorative metal railings section
- **Flooring**
 - Clarified scope notes in Project Manual
- **Hard Tile**

- Clarified scope notes in Project Manual
- **General Trades**
 - Added theatrical rigging and drapery
 - Clarified scope notes in Project Manual
- **Theatre Equipment**
 - Deleted scope of work
- **Food Service Equipment**
 - Clarified scope notes in Project Manual
- **Casework**
 - Clarified and added scope notes in Project Manual
- **Plumbing**
 - Added electrical heat trace specification section
 - Added heat tracing for plumbing
 - Added scope notes for kitchen hook-up
- **Electrical**
 - Theatrical fixture package
 - Theatrical lighting distribution and control

C. RFI Responses

Q: On page E2.1A corridor A127 shows L13 fixtures but are scaled off at 6' fixtures. Please confirm which one is correct. On the same page, corridor A108 shows L13 fixtures but it is scaled at 2'

A: The fixture lengths are as indicated on the plan. Per the lighting schedule, these fixtures come in multiple lengths.

Q: There is a Note 5 on sheet E5.1 which represents that those items have been pre-purchased.

- Did they go Square D? Square D doesn't have any record of any orders

A: Eaton was ordered for the Gear based on voluntary alternate, Generator is Cummins, and transformer is Eaton.

- The primary switch and generator also have the same hashed border as the other Note 5 items. Are these also part of the pre-purchased items?

A: That is correct

- If the above are indeed all pre-purchased then we are to propose to Supply and Install all of the Panel Boards, DP-1, DP-Gen, and the smaller Transformers 75KVA thru 150KVA?

A: That is correct. Only larger equipment was included in the pre-purchased package.

Q: Glass and Glazing Summary of Work note #5, Specific Scope notes #12-m and #13-g conflict with Carpentry Specific Scope note #6-l. Please clarify. Casework Specific Scope notes #8 and #9 conflict with Carpentry Specific Scope note #6-n. Please clarify. Plumbing Specific Scope note #17-j conflicts with Carpentry Specific Scope note #6-l. Please clarify. Mechanical Specific Scope note #11-jjj conflicts with Carpentry Specific Scope note 6-l. Please clarify.

A: All blocking shown on the drawings is the responsibility of the carpenter. Any additional blocking required, but not shown is the responsibility of the contractor installing said scope of work that requires the additional blocking.

Q: There is no mention of the polished concrete in any work scopes. What Bid Division is responsible for the polished concrete?

A: We have already bid out concrete and will be handled by current contractor.

Q: On Page 7 of the Bid Category work scope for the Flooring Division, note 14 states to provide and install a moisture mitigation system at all flooring locations over concrete. Are they wanting us to include a moisture mitigation system in our base bid before we even moisture test the concrete to see if it in fact does need a moisture mitigation system? Some of these systems can run from \$100,000-\$300,000. Also in the Concrete Specification 033003 on page 1-2 it shows

that vapor lock will be added to the concrete. If this is the case we will not need to moisture test. See attached. Please advise as to if we should include a moisture mitigation system in to our base bid, or if we should provide a unit SF price for this work.

A: We will remove this note from the scope of work, and add a SF unit cost for moisture mitigation.

Q: On page 7 of the Bid Category work scope for the Flooring Division, note 17. H. shows floor patching up to 3/8" as required to prep concrete to receive floor finishes for the carpet and resilient flooring. See attached work scope. Typically we do an 1/8" skim coat for a smooth surface to install. I do not see on the plans where they are requiring us to provide extra heavy prep for a new build. Please advise as to what locations will require us to provide 3/8" floor prep? See attached. Please advise.

A: This note will be removed.

Q: On page 7 of the Bid Category work scope for the Flooring Division, note 17. I. states that the flooring contractor is to "Remediate and fill all cracks in the slab that exceeds 1/32" wide per requirements of the product manufacturers and specifications." See attached work scope. Are they anticipating the new concrete to crack? If so I am not sure what we should include in our base bid for this work since the concrete will be new and has not been installed yet. See attached. Please advise.

A: This note will be removed.

Q: On page 7 of the Bid Category work scope for the Flooring Division, note 17. J. states that the flooring contractor to include cost for priming, Ardex skim coating and floor leveling for all carpet areas and resilient areas. Specifications for the Carpeting and Resilient Flooring does not indicate for us to use Ardex products, but states to use what the manufacturer recommends. That being said are they requiring us to use Ardex products for the Carpeting and Resilient Flooring? Or can we use what the manufacturer recommends. See attached. Please advise.

A: Ardex or approved manufacturer is acceptable.

Q: On page 8 of the Bid Category work scope for the Hard Tile Bid Division Note 17. F. states to provide minor repair, leveling and patching (+3/8") of substrate for walls and floors. We typically apply our standard layer of thinset for the hard tile work. Are they anticipated that the new walls and floors will not be acceptable where they will require a 3/8" pour on the floors and walls? Please advise.

A: This will be corrected in the scope. Intent is that all masonry walls will have at least 3/8" prep to ensure level surface for tile installation.

Q: Please confirm that in-wall blocking is by the Carpentry Bid Package.

A: In wall blocking shown on the drawings is the responsibility of the carpentry contractor. Any additional blocking required is the responsibility of the contractor installing the scope of work that requires said blocking.

Q: It is understood that General Trades is responsible for the 100100 Misc. Specialties items which include the metal table bases and solid surface countertops at the Dining Commons Booths and the metal stools and foot rests at the second-floor bar height counter. Does the solid surface counter at the bar height second floor counter below to the casework/millwork provider?

A: Correct, we are clarifying if the dining commons booths SS comes from the manufacturer of the base or if it is intended to be separate. If it is separate, that SS will be the casework contractors responsibility. All other bases, I.E. Art bench are to be installed by this contractor.

Q: Please verify that the plywood will be furnished and installed by the carpentry bid package and 8" plywood reveal painting will be provided by others in regards to the plastic laminate panels all as shown on Millwork Detail Plan A8.5. The only responsibility of the casework bid package is the plastic laminate panel, mounting hardware and installation.

A: This is correct. The plywood is the responsibility of the carpentry contractor, painting is the responsibility of the painter, and the laminate panels and mounting hardware is the responsibility of the Casework contractor. All contractors responsible for coordinating.

Q: Viewing Detail 15/A8.15, there are laminated panels that are installed on 6" metal stud framing at a slope, one at 8" one at 6" and the last at 2', please verify that the 6" framing is by contractors other than the casework bid package.

A: Framing is by the carpentry scope of work.

Q: The music casework spec lists grille doors to be welded steel construction. In the elevations, there are waterfall grille doors on 2/A7.4 and straight grille doors on 5/A7.5. Can straight grille doors by Case Systems (or equal) be acceptable at both locations?

A: Please submit a voluntary alternate and substitution request for all deviations from bid specifications.

Q: In Section G. Specific Scope, Item #7 Section c. notes that the FSE Contractor is responsible for all Plumbing Fixtures. This work is typically handled by the plumbing contractor. We can install the Garbage Disposal, but Plumbing to and from that unit is to be done by others. Also, the Soap and Rinse Systems are generally handled by the Owners Vendor and is not something usually handled by the FSE Contractor. Hand Sinks will be handed over to the Plumber for their install. Can you please confirm that we will not be responsible for this work?

A: All fixtures indicated as FSE are to be provided and installed by the food service contractor. All plumbing connections and final hook ups are to be the responsibility of the plumbing contractor.

Q: In Section G. Specific Scope, Item #7 Section e. notes that All Mechanical hook ups for Food Service Equipment and Mechanical are to be provided by the Food Service Contractor. We typically don't do final connections for Mechanical, Plumbing, or Electrical. Connecting of Ductwork to our Exhaust Hoods should be handled by the Mechanical Contractor and not by us. Can you please confirm that we will not be responsible for this work?

A: Mechanical contractor will be responsible for all ductwork connections and mechanical tie in.

Q: In Section G. Specific Scope, Item #7 Section g. notes that All low voltage connections are to be provided by the FSE Contractor. This work is typically handled by the Electrical Contractor. Can you please confirm that we will not be responsible for this work. If the wiring is integral to our equipment we will handle.

A: This contractor is responsible for all integral low voltage work (I.E. refrigerator thermostats) any control of mechanical equipment not installed by this contractor is the responsibility of the mechanical contractor. Fire alarm contractor is responsible for connections to hood controllers for appropriate shut down procedure.

Q: The scope of work mentions "temp roofing"; is this project being installed in (2) phases: Phase 1 being substrate and vapor barrier and Phase 2 being the permanent roof over top; or are we to install the entirety of the roof right away and not figuring this as a phased project?

A: This is not intended to be done in two phases.

Q: The scope of work mentioned flood testing; the specifications don't mention this, is flood testing of the entire roof surface required?

A: Yes.

Q: The scope of work mentions installing pavers; there is no specification or area I noted on the drawings that show pavers; please clarify whether pavers are being installed on this project?

A: Removed from scope.

Q: The scope of work mentions installing snow guards, please clarify where snow guards are located.

A: Removed from scope.

Q: Is there any work on the existing building or does this contract only pertain to this "NEW" construction middle school?

A: Only work is on New construction.

Q: Looking over the plans it appears that the whole masonry wall legend is missing. The masonry walls appear to start in the "4"s and the legend ends in the "3"s. Do we know what the different wall types indicate? Is it safe to assume that all walls go to deck?

A: To be updated in Addendum #3.

Q: On page A 7.6 - interior elevation 1 shows suspended wood grill. What specification is this under?

A: See Spec Section 09 5426.

Q: Spec 05-7000 Decorative metal - specific note 10 mentions Beam and Column Covers. Can you please clarify where these occur?

A: Sheet A1.1D will add column covers in Addendum #3.

Q: Page A1.1B in room B104. Wall type 1A is called out which is 7/8 furring. The detail called out is 12 on A5.1, this calls out 2 1/2 " track. Which is the correct wall type?

A: Type 1A is correct.

Q: I see different wall types called out on the floor plan that aren't listed on the partition legend. I cannot find them, could you please point me in the right direction.

A: To be updated in Addendum #3.

Q: If insulation isn't noted in the partition legend, I'm assuming the plan is to leave it out. Correct?

A: To be updated in Addendum #3.

Q: Drawing A 3.7 is missing.

A: There is no sheet A3.7.

Q: There are no corner guards indicated on A9.1A and A9.1C. Please confirm.

A: All walls in these areas are masonry, no corner guards needed.

Q: Where wall protection (WP) is listed on the room tags on the Floor Finish Plans, but not indicated on the drawings. Are we to assume this is for all walls? Example: Passage E101 has WP1A listed on the room tag but is not given a location, where AWP1D is also listed and marked at certain locations.

A: Refer to pattern details on finish plans, dash line indicates WP locations.

Q: The spec lists 120" extra drop at the top of the motorized projection screens. The max drip that Draper can do is 72". Please clarify what is correct.

A: Provide 72" drop and increase screen height by 48"

Q: The power plans and the specs call for a BDA/Area of Refuge System but does not indicate on the plans where the devices are to be installed. Please advise.

A: Area of refuge system is not required, provide 2 ways communication at elevator.

Q: Please verify that there is no wood science casework on this project as Casework Notes 17 & 20 on the Casework & Equipment Plans suggests.

A: No, all casework is P-Lam.

Q: Plan A9.2D, the custom countertop at Level 2 Bar-height Counter in Commons D201 is said to be quartz. Millwork details on Plan A8.3 indicates that top as being SS1 and SS3 solid surface. Please confirm the material type.

A: Refer to A8.3 for solid surface call-out, A9.2D to be revised in Addendum #3.

Q: Casework Plan A9.1B indicates SS2. There is no listing for SS2 in either the 064023 or 123600 specifications. If SS2 is required, please provide color for SS2.

A: SS2 will change to QT21 in Addendum #3.

Q: What specification are the metal pipe supports under for the casework contractor?

A: Means and Method.

Q: Are the countertops in Rooms B135 and B144 where the L-bracket shelving systems occur to be quartz (QTZ1) or solid surface. Both QTZ1 and SS1 surfaces occur at countertops in Room B135.

A: Neither, the L-Bracket shelving system is pre-fab – see spec 06 4023/2.11/C.

Q: In the specifications for roofing it mentions the roofing insulation to be a Minimum of R-30; but then it also mentions that insulation thickness to be 2". Please clarify whether we can figure the roofing as (2) layers of 2.6" ISO or if we need to figure (3) layers of 2" ISO?

A: Provide 2 layers of 2.6"

Q: A1.1- Corridor 127 has a callout for "Solid Surface seating bench on CMU knee wall"- no detail is available for wall height- assumed height to be 2'? Please advise

A: 1'-4" CMU with 2 layers 3/4" F.R.T. plywood and solid surface 1'-6" final height.

Q: A1.1a - A1.1f , A1.2C-1.2F floor plans do not show any wall/partition legend descriptions for wall types 4,5,6 CMU walls. Will this be provided in an addendum?

A: To be updated in Addendum #3.



Addendum

Date July 12, 2024
Project Name Troy School District - New Smith Middle School
TMP Project No(s). 22102
Bid Package No. Bid Package 03B
Addendum No. Two (2)

ADDENDUM NO. 1 WAS PREVIOUSLY ISSUED ON JULY 10, 2024.

The Bidding Documents are modified, supplemented, or augmented as follows and the Addendum is hereby made a part of the proposed Contract Documents.

The following Drawing(s) and Attachment(s) are issued with this Addendum:

Drawing No(s): C-2.0, C-2.1, C-3.0, C-3.1, C-3.2, C-4.1, C-4.2, C-5.0, C-5.1, C-5.2, C-5.3, C-6.0, C-6.1, C-6.2 C-6.4, C-7.1, C-7.2, C-7.3, C-7.4, S1.0B, S1.0D, S1.0E, S1.0F, AD.1, A1.3A, A1.3E, A4.3, A9.1A, M2.0E, M2.1A, M2.1B, M2.1C, M2.1D, M2.1E, M2.1F, M2.2C, M2.2E, M4.1A, M4.1B, M4.1D, M4.1F, M4.2D, M4.2E, M5.1, M6.1, M6.6, M7.1, M7.3, M7.4, M7.5, M7.6, M7.7, E0.2, E0.3, E0.6, E2.1A, E2.1B, E2.1C, E2.1D, E2.1E, E2.1F, E2.2C, E2.2D, E2.2E, E3.1A, E3.1B, E3.1C, E3.1D, E3.1E, E3.1F, E3.2D, E3.2E, E5.1, E5.2, E5.3, E5.4, E5.5, E6.1, E6.2, E7.1, E7.2

Attachment(s): Specification Sections: 08 3323, 20 0533, 22 0533, 22 1119, 22 1319

Item No. Specification Changes

- SC-1 Refer to Section No. 00 0110 – TABLE OF CONTENTS (not reissued):
- A. Marked section 11 4000 FOODSERVICE EQUIPMENT as issued with Addendum No. 1.
 - B. Deleted section 11 6143 STAGE CURTAINS.
 - C. Marked sections reissued in Addendum No. 2.
 - D. Added sections: 20 0533 ELECTRIC HEAT TRACE and 22 0533 HEAT TRACING FOR PLUMBING to Table of Contents.
- SC-2 Refer to Section No. 08 3323 - OVERHEAD COILING DOORS (reissued):
- A. Deleted paragraph 2.02.C.9 and 2.02.C.9.a as indicated. Reference Pre-Bid RFI#2.
 - B. Deleted paragraph 2.02.D.7 and 2.02.D.7.a as indicated. Reference Pre-Bid RFI#2.

July 12, 2024
New Smith Middle School
TMP Project No. 22102
Bid Package No. 03B
Addendum No. 2

Page 2 of 13

- SC-3 Refer to Section No. 11 6143 – STAGE CURTAINS (deleted):
A. Deleted section, complete.
- SC-4 Refer to Section 20 0533 ELECTRIC HEAT TRACE (new):
A. Added specification section.
- SC-5 Refer to Section 22 0533 HEAT TRACING FOR PLUMBING (new):
A. Added new heat tracing for plumbing specification.
- SC-6 Refer to Section 22 1119 DOMESTIC WATER PIPING SPECIALTIES (reissued):
A. Added specification section 2.12 Domestic Water Cartridge Filters.
B. Added specification section 3.02 Domestic Water Cartridge Filter Installation.
- SC-7 Refer to Section 22 1319 DRAINAGE PIPING SPECIALTIES (reissued):
A. Revised specification section 2.10 Grease Interceptors to reflect all stainless steel manufacturers.

Item No. Civil Drawing Changes

- CD-1 Refer to Drawing No. C-2.0 – Demolition and SESC Plan – Phase 1 (reissued):
A. Revised limits of pavement removal at the entrance to Cotswold Road as indicated.
B. Revised Demolition and Erosion Control Legends as indicated.
- CD-2 Refer to Drawing No. C-2.1 – Demolition and SESC Plan – Phase 2 (reissued):
A. Revised limits of utility and pavement removal at the north end of the site as indicated.
B. Revised Demolition and Erosion Control Legends as indicated.
- CD-3 Refer to Drawing No. C-3.0 – Overall Dimension & Paving Plan (reissued):
A. Added culverts beneath the entry drives as indicated.
B. Added concrete pads at utility structures as indicated.
C. Revised paving limits at the entrance to Cotswold Road as indicated.
D. Added school sign and message board as indicated.

July 12, 2024
New Smith Middle School
TMP Project No. 22102
Bid Package No. 03B
Addendum No. 2

Page 3 of 13

- CD-4 Refer to Drawing No. C-3.1 – Dimension & Paving Plan – West (reissued):
- A. Added culverts beneath the entry drives as indicated.
 - B. Added concrete pads at utility structures as indicated.
 - C. Added note indicating the curb taper at the ADA parking spaces as indicated.
 - D. Added note indicating the flush concrete sidewalk at the east side of the parking lot as indicated.
 - E. Added notes indicating the light poles as indicated.
 - F. Added school sign and message board as indicated.
 - G. Added notes indicating the color of the detectable warning surface for all ramps to the Sidewalk Ramp Legend as indicated.
- CD-5 Refer to Drawing No. C-3.2 – Dimension & Paving Plan - East (reissued):
- A. Added concrete pads at utility structures as indicated.
 - B. Added notes indicating the light poles as indicated.
 - C. Added note indicating the required coordination at the point where the new building encroaches on the existing building as indicated.
 - D. Added notes clarifying the work at the entrance to Cotswold Road as indicated.
 - E. Added notes indicating the color of the detectable warning surface for all ramps to the Sidewalk Ramp Legend as indicated.
- CD-6 Refer to Drawing No. C-4.1 – Grading Plan - West (reissued):
- A. Added dashed lines indicating reverse slope curb and gutter as indicated.
 - B. Added ridge lines as indicated.
 - C. Added additional spot elevations at the ADA parking area as indicated.
 - D. Added notes referring to the geotechnical investigation and the ground improvement bid package as indicated.
 - E. Revised proposed grading at the message board as indicated.
- CD-7 Refer to Drawing No. C-4.2 – Grading Plan - East (reissued):
- A. Added additional spot elevations at the ADA parking area as indicated.
 - B. Added/Revised spot elevations at the entrance to Cotswold Road as indicated.
 - C. Added notes referring to the geotechnical investigation and the ground improvement bid package as indicated.
- CD-8 Refer to Drawing No. C-5.0 – Overall Utility Plan (reissued):
- A. Revised utilities within the south entry drive corridor as indicated.
 - B. Revised utilities within the north existing parking lot as indicated.

July 12, 2024
New Smith Middle School
TMP Project No. 22102
Bid Package No. 03B
Addendum No. 2

Page 4 of 13

- CD-9 Refer to Drawing No. C-5.1 – Utility Plan - West (reissued):
- A. Revised sanitary sewer invert elevations as indicated.
 - B. Revised water main alignment through the south entry drive as indicated.
 - C. Added electrical and fiber conduit and hand holes to the school sign and message board as indicated.
- CD-10 Refer to Drawing No. C-5.2 – Utility Plan - East (reissued):
- A. Revised sanitary sewer invert elevations as indicated.
 - B. Revised sanitary sewer alignment and connection to existing as indicated.
 - C. Revised water main alignment and connection to existing as indicated.
- CD-11 Refer to Drawing No. C-5.3 – Utility Plan - Livernois (reissued):
- A. Revised water main alignment and connection to existing as indicated.
- CD-12 Refer to Drawing No. C-6.0 – Sanitary Sewer and Water Main Profiles (reissued):
- A. Revised sheet title to include water main.
 - B. Revised sanitary sewer profile as indicated.
 - C. Added water main profile as indicated.
- CD-13 Refer to Drawing No. C-6.1 – Storm Sewer Profiles, C-6.2 – Storm Sewer Profiles, and C-6.4 – Storm Sewer Profiles (reissued):
- A. Revised structure labels to include sump depth where appropriate as indicated.
 - B. Revised limits of compacted sand backfill as indicated.
 - C. Revised utility crossings as indicated.
- CD-14 Refer to Drawing No. C-7.1 – Paving Details (reissued):
- A. Deleted: Aggregate Base Note in the Heavy Duty ROW Asphalt Detail, the Standard Duty Asphalt Detail, and the Heavy Duty Asphalt Detail as indicated.
 - B. Revised Asphalt Material Note in the Heavy Duty ROW Asphalt Detail, the Standard Duty Asphalt Detail, and the Heavy Duty Asphalt Detail as indicated.
 - C. Revised leveling course mix type and the Asphalt Mix Design Chart in the Heavy Duty Asphalt Detail and the Heavy Duty ROW Asphalt Detail as indicated.

July 12, 2024
New Smith Middle School
TMP Project No. 22102
Bid Package No. 03B
Addendum No. 2

Page 5 of 13

- CD-15 Refer to Drawing No. C-7.2 – Utility Details (reissued):
A. Added Bar Grate for Outlet Control Structure detail as indicated.
- CD-16 Refer to Drawing No. C-7.3 – Culvert Details (reissued):
A. Added Wingwall with Footing detail as indicated.
B. Added backfill and finish materials to the culvert sections as indicated.
C. Added crossing utilities for the South Entry Drive Culvert Section as indicated.
- CD-17 Refer to Drawing No. C-7.4 – Site Details (reissued):
A. Revised footing notes as indicated.

Item No. Structural Drawing Changes

- SD-1 Refer to Drawing No. S1.0B (reissued):
A. Revised MCJ location as indicated.
- SD-2 Refer to Drawing No. S1.0D (reissued):
A. Added MCJs as indicated.
- SD-3 Refer to Drawing No. S1.0E (reissued):
A. Added MCJs as indicated.
- SD-4 Refer to Drawing No. S1.0F (reissued):
A. Added MCJs as indicated.

Item No. Architectural Drawing Changes

- AD-1 Refer to Drawing No. TS.1-03B (not reissued):
A. At CIVIL List of Drawings: Revised sheet C-6.0 title to: Sanitary Sewer and Water Main Profiles.
- AD-2 Refer to Drawing No. AD.1 (reissued):
A. At DOOR & FRAME SCHEDULE: Revised door A135B to be STL rather than AL. Refer to PreBid RF12.

July 12, 2024
New Smith Middle School
TMP Project No. 22102
Bid Package No. 03B
Addendum No. 2

Page 6 of 13

- AD-3 Refer to Drawing No. A1.3A (reissued):
- A. Revised bottom elevation of roof top screen wall for ERU-1 and ERU-7 as indicated. Revision coordinates with steel shop drawing revision.
- AD-4 Refer to Drawing No. A1.3E (reissued):
- A. Revised location of roof drain notations and coordinate locations of roof drains as indicated.
 - B. Deleted erroneous notations of items at second level on roof plan as indicated.
- AD-5 Refer to Drawing No. A4.3 (reissued):
- A. Deleted duplicate steel and erroneous note as indicated.
- AD-6 Refer to Drawing No. A9.1A (reissued):
- A. Added agility workout dot stations as indicated. Note: This revision applies to A1.1A and A10.1A as well, sheets NOT reissued.

Item No. Mechanical Drawing Changes

- MD-1 Refer to Drawing No. M2.0E (reissued):
- A. Removed hub outlet notation and piping as indicated.
- MD-2 Refer to Drawing No. M2.1A (reissued):
- A. Revised heat trace note as indicated.
- MD-3 Refer to Drawing No. M2.1B (reissued):
- A. Revised grease interceptor notation as indicated.
 - B. Removed note for “hand washing only” signs at sinks as indicated.
- MD-4 Refer to Drawing No. M2.1C (reissued):
- A. Added heat tracing at Vestibule C101 as indicated.
 - B. Revised hot water return piping routing as indicated.
- MD-5 Refer to Drawing No. M2.1D (reissued):
- A. Removed note for “hand washing only” signs at sinks as indicated.
 - B. Revised hub outlet note as indicated.

July 12, 2024
New Smith Middle School
TMP Project No. 22102
Bid Package No. 03B
Addendum No. 2

Page 7 of 13

- MD-6 Refer to Drawing No. M2.1E (reissued):
- A. Removed hub outlet notation and piping as indicated.
 - B. Added chemical neutralization note for E122 as indicated.
- MD-7 Refer to Drawing No. M2.1F (reissued):
- A. Added heat tracing to canopy drains as indicated.
 - B. Added chemical neutralization note for Storage F122 as indicated.
 - C. Revised fixture tag in F133 as indicated.
- MD-8 Refer to Drawing No. M2.2C (reissued):
- A. Revised vent through roof location as indicated.
- MD-9 Refer to Drawing No. M2.2E (reissued):
- A. Removed note for “hand washing only” signs at sinks as indicated.
 - B. Revised rain conductor and overflow piping location out of Stair E231 and into E233 as indicated.
 - C. Revised rain conductor and overflow piping location out of Stair E212 and into E214 as indicated.
 - D. Added chemical neutralization note for Storage E222 as indicated.
- MD-10 Refer to Drawing No. M4.1A (reissued):
- A. Added manual balance damper as indicated.
 - B. Added smoke damper as indicated.
 - C. Added fire dampers as indicated.
- MD-11 Refer to Drawing No. M4.1B (reissued):
- A. Added manual balance dampers as indicated.
 - A. Added smoke damper as indicated.
- MD-12 Refer to Drawing No. M4.1D (reissued):
- A. Added manual balance dampers as indicated.
- MD-13 Refer to Drawing No. M4.1F (reissued):
- A. Added manual balance dampers as indicated.

July 12, 2024
New Smith Middle School
TMP Project No. 22102
Bid Package No. 03B
Addendum No. 2

Page 8 of 13

- MD-14 Refer to Drawing No. M4.2D (reissued):
- A. Added manual balance dampers as indicated.
- MD-15 Refer to Drawing No. M4.2E (reissued):
- A. Added manual balance dampers as indicated.
- MD-16 Refer to Drawing No. M5.1 (reissued):
- A. Removed floating rain conductor tags by ERU-1 as indicated.
 - B. Revised heat trace note as indicated.
 - C. Revised roof drain locations as indicated.
 - D. Removed roof drains on stair well and added note to provide scuppers as indicated.
- MD-17 Refer to Drawing No. M6.1 (reissued):
- A. Moved detail for printing clarification as indicated.
- MD-18 Refer to Drawing No. M6.6 (reissued):
- A. Revised details for printing clarification as indicated.
- MD-19 Refer to Drawing No. M7.1 (reissued):
- A. Revised duct system insulation application schedule for printing clarification as indicated.
- MD-20 Refer to Drawing No. M7.3 (reissued):
- A. Revised voltage and phase on sewage pump and sump pump schedule as indicated.
 - B. Revised SCCR for fuel fired domestic water heater schedule as indicated.
 - C. Revised SCCR for fuel fired water source heat pump schedule as indicated.
 - D. Revised SCCR for fuel fired packaged booster pump schedule as indicated.
- MD-21 Refer to Drawing No. M7.4 (reissued):
- A. Revised SCCR for energy recovery unit with heat pump schedule as indicated.
 - B. Revised SCCR for electric propeller fan unit heater schedule as indicated.

July 12, 2024
New Smith Middle School
TMP Project No. 22102
Bid Package No. 03B
Addendum No. 2

Page 9 of 13

- C. Revised SCCR for electric centrifugal fan cabinet unit heater schedule as indicated.

- MD-22 Refer to Drawing No. M7.5 (reissued):
- A. Revised SCCR for condensing boiler schedule as indicated.
 - B. Revised SCCR for pump schedule as indicated.
 - C. Revised SCCR for direct fired make-up air unit schedule as indicated.
 - D. Revised SCCR for electric coil schedule as indicated.
 - E. Revised SCCR for closed circuit cooling tower schedule as indicated.
 - F. Revised SCCR for fan powered air terminal unit with electric coil schedule as indicated.

- MD-23 Refer to Drawing No. M7.6 (reissued):
- A. Revised SCCR for electric radiant wall panel schedule as indicated.
 - B. Revised SCCR for air terminal unit with electric coil schedule as indicated.

- MD-24 Refer to Drawing No. M7.7 (reissued):
- A. Revised SCCR for power ventilator schedule as indicated.
 - B. Revised SCCR for fan schedule as indicated.

Item No. Electrical Drawing Changes

- ED-1 Refer to Drawing No. E0.2 (reissued):
- A. Revised "Raceway/Conductor/Cable Application Schedule."
 - B. Revised "Floor service fitting schedule."

- ED-2 Refer to Drawing No. E0.3 (reissued):
- A. Added branch circuits for site lighting.
 - B. Revised incoming primary feed routing.
 - C. Added exterior signs and associated branch circuits.
 - D. Added construction key notes 1 and 2, and associated tags.

- ED-3 Refer to Drawing No. E0.6 (reissued):
- A. Revised circuiting to MAU-2.

July 12, 2024
New Smith Middle School
TMP Project No. 22102
Bid Package No. 03B
Addendum No. 2

Page 10 of 13

- ED-4 Refer to Drawing No. E2.1A (reissued):
- A. Added emergency branch circuits.
 - B. Added lighting control device.
 - C. Added light fixture mounting height.
- ED-5 Refer to Drawing No. E2.1B (reissued):
- A. Added emergency branch circuits.
 - B. Added light fixture mounting height.
- ED-6 Refer to Drawing No. E2.1C (reissued):
- A. Added lighting control device.
- ED-7 Refer to Drawing No. E2.1D (reissued):
- A. Added lighting control devices.
 - B. Added lighting branch circuit.
- ED-8 Refer to Drawing No. E2.1E (reissued):
- A. Revised daylight harvesting zones as indicated.
 - B. Added light fixture mounting height as indicated.
 - C. Added room control designation tags as indicated.
 - D. Revised exit sign as indicated.
 - E. Added construction keynote 7 and associated tags as indicated.
- ED-9 Refer to Drawing No. E2.1F (reissued):
- A. Revised to show only scope related to zone F.
 - B. Added room control designation tags.
 - C. Revised daylight harvesting zones.
- ED-10 Refer to Drawing No. E2.2C (reissued):
- A. Added lighting branch circuit as indicated.
- ED-11 Refer to Drawing No. E2.2D (reissued):
- A. Added lighting branch circuit as indicated.
 - B. Added light fixture mounting height as indicated.

July 12, 2024
New Smith Middle School
TMP Project No. 22102
Bid Package No. 03B
Addendum No. 2

Page 11 of 13

- ED-12 Refer to Drawing No. E2.2E (reissued):
- A. Revised lighting branch circuit.
 - B. Added lighting control designation tags.
 - C. Revised daylight harvesting zones.
 - D. Added lighting control devices.
 - E. Added construction key note 7 and associated tags.
- ED-13 Refer to Drawing No. E3.1A (reissued):
- A. Added branch circuits.
 - B. Added heat trace and associated branch circuit.
 - C. Added primary switch heater and associated branch circuit.
 - D. Revised construction key note 10.
 - E. Relocated clock.
 - F. Added telecommunication outlet and power for technology.
 - G. Revised construction key note 17.
- ED-14 Refer to Drawing No. E3.1B (reissued):
- A. Added branch circuits.
 - B. Added clock location.
 - C. Added monitor and associated branch circuit.
 - D. Added duct detector and associated branch circuit.
- ED-15 Refer to Drawing No. E3.1C (reissued):
- A. Added branch circuits as indicated.
 - B. Revised clock locations as indicated.
- ED-16 Refer to Drawing No. E3.1D (reissued):
- A. Added branch circuits.
 - B. Added sump pump and associated branch circuit.
 - C. Added telecommunications outlet.
 - D. Relocated receptacle.
- ED-17 Refer to Drawing No. E3.1E (reissued):
- A. Added branch circuits.
 - B. Added two-way communication devices.
 - C. Added sump pump and associated branch circuit.

July 12, 2024
New Smith Middle School
TMP Project No. 22102
Bid Package No. 03B
Addendum No. 2

Page 12 of 13

- ED-18 Refer to Drawing No. E3.1F (reissued):
- A. Added branch circuits.
 - B. Added construction key note 15 tag.
 - C. Added heat trace and associated branch circuit.
- ED-19 Refer to Drawing No. E3.2D (reissued):
- A. Added branch circuit for powered desk.
 - B. Added branch circuits for elevator.
- ED-20 Refer to Drawing No. E3.2E (reissued):
- A. Added branch circuits as indicated.
- ED-21 Refer to Drawing No. E5.1 (reissued):
- A. Revised breaker positions in MSB.
 - B. Revised panelboard names.
 - C. Revised transformer T-5.
 - D. Added SPD and associated breaker.
 - E. Revised breaker in DP-1.
 - F. Revised load summaries.
 - G. Revised "Diagram General Notes."
- ED-22 Refer to Drawing No. E5.2 (reissued):
- A. Revised panelboard schedules as indicated.
- ED-23 Refer to Drawing No. E5.3 (reissued):
- A. Revised panelboard schedules as indicated.
- ED-24 Refer to Drawing No. E5.4 (reissued):
- A. Revised panelboard schedules as indicated.
- ED-25 Refer to Drawing No. E5.5 (reissued):
- A. Revised panelboard schedules as indicated.
- ED-26 Refer to Drawing No. E6.1 (reissued):
- A. Added branch circuits as indicated.
 - B. Removed construction key notes as indicated.

July 12, 2024
New Smith Middle School
TMP Project No. 22102
Bid Package No. 03B
Addendum No. 2

Page 13 of 13

- ED-27 Refer to Drawing No. E6.2 (reissued):
 A. Removed CP-5 as indicated.
- ED-28 Refer to Drawing No. E7.1 (reissued):
 A. Revised "Concrete Encased Duct Bank Detail" as indicated.
 B. Deleted detail as indicated.
 C. Added "Generator and ATS Control Wiring Detail" as indicated.
- ED-29 Refer to Drawing No. E7.2 (reissued):
 A. Revised "Exterior Lighting Control" Contractor Details as indicated.

END OF ADDENDUM NO. 2 - BID PACKAGE NO. 03B

SECTION 08 3323 - OVERHEAD COILING DOORS**PART 1 GENERAL****1.01 SECTION INCLUDES**

- A. Exterior coiling doors.
- B. Interior non-fire-rated coiling doors.
- C. Fire-rated coiling doors.
- D. Electric operators and control stations.

1.02 REFERENCE STANDARDS

- A. ASTM A653/A653M - Standard Specification for Steel Sheet, Zinc-Coated (Galvanized) or Zinc-Iron Alloy-Coated (Galvannealed) by the Hot-Dip Process; 2023.
- B. ASTM A666 - Standard Specification for Annealed or Cold-Worked Austenitic Stainless Steel Sheet, Strip, Plate, and Flat Bar; 2023.
- C. ITS (DIR) - Directory of Listed Products; Current Edition.
- D. NEMA 250 - Enclosures for Electrical Equipment (1000 Volts Maximum); 2020.
- E. NEMA ICS 2 - Industrial Control and Systems Controllers, Contactors and Overload Relays Rated 600 Volts; 2008 (Reaffirmed 2020).
- F. NEMA MG 1 - Motors and Generators; 2017.
- G. NFPA 70 - National Electrical Code; Most Recent Edition Adopted by Authority Having Jurisdiction, Including All Applicable Amendments and Supplements.
- H. NFPA 80 - Standard for Fire Doors and Other Opening Protectives; 2022.
- I. UL (DIR) - Online Certifications Directory; Current Edition.
- J. UL 325 - Standard for Door, Drapery, Gate, Louver, and Window Operators and Systems; Current Edition, Including All Revisions.

1.03 SUBMITTALS

- A. See Section 01 3000 - Administrative Requirements, for submittal procedures.
- B. Product Data: Provide general construction, electrical equipment, and component connections and details.
- C. Shop Drawings: Indicate pertinent dimensioning, anchorage methods, hardware locations, and installation details.
 - 1. Include plans, elevations, sections, and mounting details.
 - 2. Include diagrams for power, signal, and control wiring.
- D. Samples: Submit three slats, 6 inches long in size illustrating shape, color and finish texture.
- E. Manufacturer's qualification statement.
- F. Installer's qualification statement.
- G. Field Quality Control: Submit field inspection reports.
- H. Maintenance Data: Indicate lubrication requirements and frequency and periodic adjustments required.

1.04 QUALITY ASSURANCE

- A. Manufacturer Qualifications: Company specializing in manufacturing the products specified in this section with minimum 5 years of documented experience.
- B. Installer Qualifications: Company specializing in performing work of type specified and with at least 5 years documented experience and approved by manufacturer.
- C. Products Requiring Electrical Connection: Listed and classified by ITS (DIR), UL (DIR), or testing firm acceptable to authorities having jurisdiction as suitable for purpose specified.

1.05 WARRANTY

- A. See Section 01 7800 - Closeout Submittals, for additional warranty requirements.

- B. Provide two year manufacturer warranty for defects in workmanship and materials from date of Substantial Completion.

PART 2 PRODUCTS

2.01 MANUFACTURERS

- A. Overhead Coiling Doors - Basis of Design: The design for each coiling door specified is based on the product named. Provide either the named product or a comparable product by one of the following:
1. C.H.I. Overhead Doors; www.chiohd.com.
 2. Clopay Building Products: www.clopaydoor.com.
 3. CornellCookson, Inc.; www.cornelliron.com.
 4. McKeon Door Company; www.mckeondo.com.
 5. Overhead Door Corp.; www.overheaddoor.com.
 6. Raynor Door: www.raynor.com.
 7. Wayne-Dalton; www.wayne-dalton.com.
 8. Substitutions: See Section 01 6000 - Product Requirements.

2.02 COILING DOORS

- A. Exterior Coiling Doors: Galvanized steel slat curtain.
1. Basis of Design Product: Overhead Door Corp.; Model 625; www.overheaddoor.com.
 2. Capable of withstanding positive and negative wind loads of 20 psf without undue deflection or damage to components.
 3. Operation Cycles: Door components and operators capable of operating for not less than 20,000 cycles.
 - a. One operation cycle is complete when a door is opened from the closed position to the fully open position and returned to the closed position.
 4. Sandwich slat construction with insulated core of foamed-in-place polyurethane insulation; minimum R-value of 7.5. Galvanized steel.
 5. Nominal Slat Size: 2-1/2 inches wide x required length.
 6. Finish: Manufacturer's standard powder coat finish; standard color as selected by Architect. Design Intent: Overhead Door Corporation Gray.
 - a. Includes slats, hood enclosure, bottom bar, and guides.
 7. Guide, Angles: Galvanized steel.
 8. Bottom Bar or Angles: Galvanized steel.
 9. Hood Enclosure: Manufacturer's standard; galvanized steel.
 10. Electric operation.
 11. Mounting: Surface mounted unless otherwise indicated on Drawings.
- B. Non-Fire-Rated Interior Coiling Doors: Stainless steel slat curtain.
1. Basis of Design Product: Overhead Door Corp.; Model 610; www.overheaddoor.com.
 2. Capable of withstanding positive and negative wind loads of 20 psf, without undue deflection or damage to components.
 3. Operation Cycles: Door components and operators capable of operating for not less than 20,000 cycles.
 - a. One operation cycle is complete when a door is opened from the closed position to the fully open position and returned to the closed position.
 4. Single Thickness Slats: Manufacturer's standard.
 5. Nominal Slat Size: 2-1/2 inches wide x required length.
 6. Finish: No. 4 - Brushed.
 - a. Includes slats and hood enclosure.
 7. Finish: Manufacturer's standard powder coat finish; color to match Architect's sample.
 - a. Includes bottom bar and guides.
 8. Guides, Angles: Primed steel.
 9. Bottom Bar or Angles: Primed steel.
 10. Hood Enclosure: Manufacturer's standard; stainless steel.
 11. Electric operation.

12. Mounting: Surface mounted, unless otherwise indicated on Drawings.
- C. Fire-Rated Coiling Doors with Integral Egress Door: Steel slat curtain; conform to NFPA 80.
 1. Basis of Design Product: McKeon; Model Safescape T2000-PC; www.mckeondoer.com.
 2. Operation Cycles: Door components and operators capable of operating for not less than 20,000 cycles.
 - a. One operation cycle is complete when a door is opened from the closed position to the fully open position and returned to the closed position.
 3. Fire-Rating: As indicated on Drawings.
 4. Provide products listed and labeled by ITS (DIR) or UL (DIR) as suitable for purpose specified and indicated on drawings.
 5. Oversized Openings: Provide certificate of compliance from authorities having jurisdiction indicating approval of fire rated units and operating hardware assembly.
 6. Single thickness slats.
 7. Nominal Slat Size: 3 inches wide by required length.
 8. Swinging Egress Door: Incorporated within the curtain shall be a swinging type steel door designed and built as an integral part of the fire door's assembly.
 - a. Door Frame: Shall be an all-steel unit type ASTM A366 hot rolled steel, 14 gauge with the same labeled fire resistance rating as specified for door.
 - b. Door Assembly: Complete with door, hinge, and locking channel mechanism. 20 gauge stretcher leveled, electro galvanized and bonderized steel faces.
 - c. Hardware:
 - 1) Fire Exit Device: Flush mounted integral type fire exit device on one face and with pull handle on opposite face of the swinging door.
 - 2) Closer: Shall be surface mounted 90 degree pocketed application.
 - 3) Electro Magnetic Door Holder: Shall be surface mounted with proper projection to hold swinging door in the fully open position.
 9. ~~Finish: No. 4 – Brushed. **ADD2**~~
 - a. ~~Includes slats and hood enclosure.~~
 10. Finish: Manufacturer's standard powder coat finish; color to match Architect's sample.
 - a. Includes bottom bar and guides.
 11. Guides, Angles: Primed steel.
 - a. Provide internal, fully concealed UL Classified smoke seals located within each guide assembly. Externally mounted smoke seals shall not be acceptable.
 12. Bottom Bar or Angles: Primed steel.
 13. Hood Enclosure: Manufacturer's standard; stainless steel.
 14. Fire Alarm Release Mechanism: Electric-motor operated from fire alarm system and local heat or smoke detectors.
 15. Electric operation.
 16. Mounting: As indicated.
- D. Fire-Rated Coiling Doors: Steel slat curtain; conform to NFPA 80. (Indicated as SMOKE rated on door schedule)
 1. Basis of Design Product: Overhead Door Corp.; Model 630; www.overheaddoor.com.
 2. Operation Cycles: Door components and operators capable of operating for not less than 20,000 cycles.
 - a. One operation cycle is complete when a door is opened from the closed position to the fully open position and returned to the closed position.
 3. 1/3 hour fire rating.
 4. Single thickness slats.
 5. Nominal Slat Size: 3 inches wide by required length.
 6. Swinging Egress Door: Incorporated within the curtain shall be a swinging type steel door designed and built as an integral part of the fire door's assembly
 7. ~~Finish: No. 4 – Brushed. **ADD2**~~
 - a. ~~Includes slats and hood enclosure.~~
 8. Finish: Manufacturer's standard powder coat finish; color to match Architect's sample.

- a. Includes bottom bar and guides.
- 9. Guides, Angles: Primed steel.
- 10. Bottom Bar or Angles: Primed steel.
- 11. Hood Enclosure: Manufacturer's standard; stainless steel.
- 12. Fire Alarm Release Mechanism: Electric-motor operated from fire alarm system and local heat or smoke detectors.
- 13. Electric operation.
- 14. Mounting: As indicated.

2.03 MATERIALS AND COMPONENTS

- A. Metal Curtain Construction: Interlocking slats.
 - 1. Curtain Bottom for Slat Curtains: Fitted with angles to provide reinforcement and positive contact in closed position.
 - a. Counter Doors: Optionally a tube may be used.
 - 2. Weatherstripping for Exterior Doors: Moisture and rot proof, resilient type, located at jamb edges, bottom of curtain, and where curtain enters hood enclosure of exterior doors.
- B. Hood Enclosure and Trim: Internally reinforced to maintain rigidity and shape.
 - 1. Formed Steel Sheet: ASTM A653/A653M galvanized steel sheet.
 - a. Thickness: As recommended by overhead door manufacturer.
 - b. Galvanizing: Minimum G90 coating.
 - 2. Formed Stainless Steel: ASTM A 666, Type 304, rollable temper.
 - a. Thickness: As recommended by overhead door manufacturer.

2.04 ELECTRIC OPERATION

- A. Operator, Controls, Actuators, and Safeties: Comply with UL 325; provide products listed by ITS (DIR), UL (DIR), or testing agency acceptable to authorities having jurisdiction.
 - 1. Provide interlock switches on motor operated units.
- B. Electric Operators:
 - 1. Mounting: Side mounted.
 - 2. Motor Enclosure:
 - a. Exterior Coiling Doors: NEMA MG 1, Type 4; open drip proof.
 - b. Interior Coiling Doors: NEMA MG 1, Type 1; open drip proof.
 - 3. Motor Rating: 1/2 hp; continuous duty, unless otherwise recommended by overhead door manufacturer.
 - 4. Motor Voltage: 120 volts, single phase, 60 Hz.
 - 5. Motor Controller: NEMA ICS 2, full voltage, reversing magnetic motor starter.
 - 6. Controller Enclosure: NEMA 250, Type 4.
 - 7. Opening Speed: 12 inches per second.
 - 8. Brake: Manufacturer's standard type, activated by motor controller.
 - 9. Manual override in case of power failure.
 - 10. Refer to Division 26 for electrical connections.
- C. Automatic-Closing Device:
 - 1. Equip each fire-rated door with an automatic-closing device and governor unit complying with NFPA 80, and an easily tested and reset release mechanism.
 - 2. Release mechanism for motor-operated doors shall allow testing without mechanical release of the door.
 - 3. Automatic-closing device shall be designed for activation by the following:
 - a. Building fire-detection, smoke-detection, and alarm systems.
- D. Wiring Terminations: Provide terminal lugs to match branch circuit conductor quantities, sizes, and materials indicated; enclose terminal lugs in terminal box sized to comply with NFPA 70.
- E. Control Station: Provide standard key-operated (Open-Close-Stop) momentary-contact control device for each operator conforming to UL 325.
 - 1. 24 volt circuit.
 - 2. Recess mounted, at location indicated on Drawings.

3. Entrapment Protection Devices: Provide sensing devices and safety mechanisms complying with UL 325.
 - a. Primary Device: Provide electric sensing edge as required with momentary-contact control device.
- F. Safety Edge: Located at bottom of coiling door, full width, electro-mechanical sensitized type, wired to stop and reverse door direction upon striking object, hollow neoprene covered.

PART 3 EXECUTION

3.01 EXAMINATION

- A. Verify that opening sizes, tolerances and conditions are acceptable.

3.02 INSTALLATION

- A. Install units in accordance with manufacturer's instructions.
- B. Install fire-rated doors in accordance with NFPA 80.
- C. Use anchorage devices to securely fasten assembly to wall construction and building framing without distortion or stress.
- D. Securely and rigidly brace components suspended from structure. Secure guides to structural members only.
- E. Fit and align assembly including hardware; level and plumb, to provide smooth operation.
- F. Coordinate installation of electrical service with Division 26.
- G. Complete wiring from disconnect to unit components.
- H. Complete wiring from fire alarm system.
- I. Install enclosure and perimeter trim.
- J. Test and adjust controls and safety devices.

3.03 TOLERANCES

- A. Maintain dimensional tolerances and alignment with adjacent work.
- B. Maximum Variation From Plumb: 1/16 inch.
- C. Maximum Variation From Level: 1/16 inch.
- D. Longitudinal or Diagonal Warp: Plus or minus 1/8 inch per 10 feet straight edge.

3.04 FIELD QUALITY CONTROL

- A. See Section 01 4000 - Quality Requirements, for general requirements for field quality control and inspection.
- B. Perform the following tests and inspections with the assistance of a factory-authorized service representative:
 1. Operate doors to confirm proper operation and door performance.
 2. Test controls and safety devices.
 3. Test door release, closing, and alarm operations when activated by smoke detector or building's fire-alarm system. Test manual operation of closed door. Reset door-closing mechanism after successful test.
 4. Fire-Rated Door Inspections: Inspect each fire-rated door in accordance with NFPA 80.
 5. Prepare field inspection reports.
- C. Repair or replace installations where inspections indicate that they do not comply with specified requirements.
- D. Reinspect repaired or replaced installations to determine if replaced or repaired door assembly installations comply with specified requirements.

3.05 ADJUSTING

- A. Adjust operating assemblies for smooth and noiseless operation.

3.06 CLEANING

- A. Clean installed components.
- B. Remove labels and visible markings.

3.07 DEMONSTRATION AND TRAINING

- A. Engage a factory-authorized service representative to train Owner's maintenance personnel to adjust, operate, and maintain overhead coiling doors.

END OF SECTION

This page intentionally left blank

SECTION 20 0533 - ELECTRIC HEAT TRACING

****ADD2****

PART 1 GENERAL	1
1.01 RELATED DOCUMENTS	1
1.02 SUMMARY	1
1.03 PERFORMANCE REQUIREMENTS	1
1.04 ACTION SUBMITTALS	1
1.05 INFORMATIONAL SUBMITTALS	1
1.06 CLOSEOUT SUBMITTALS	2
1.07 COORDINATION	2
PART 2 PRODUCTS	2
2.01 SELF-REGULATING, PARALLEL-RESISTANCE HEATING CABLES	2
2.02 CONTROLS	2
2.03 ACCESSORIES	3
PART 3 EXECUTION	3
3.01 EXAMINATION	3
3.02 INSTALLATION	3
3.03 CONNECTIONS	4
3.04 FIELD QUALITY CONTROL	4
3.05 PROTECTION	4

PART 1 GENERAL

1.01 RELATED DOCUMENTS

- A. Drawings and general provisions of the Contract, including General and Supplementary Conditions and Division 01 Specification Sections, apply to this Section.
- B. Related Sections:
 - 1. Division 20 Section "Mechanical General Requirements."
 - 2. Division 22 Section "Heat Tracing for Plumbing Piping" for domestic hot-water-temperature maintenance, and snow and ice melting on roofs, in gutters and downspouts, and rain conductors.

1.02 SUMMARY

- A. Section includes electric heat tracing for piping freeze prevention and flow control.

1.03 PERFORMANCE REQUIREMENTS

- A. Pipe Heat Tracing: Select electric heat tracing cable capable of providing freeze protection and flow control with outside temperature at minus 10 deg F.

1.04 ACTION SUBMITTALS

- A. Product Data: For each type of product.
 - 1. Include rated capacities, operating characteristics, and furnished specialties and accessories.

1.05 INFORMATIONAL SUBMITTALS

- A. Delegated-Design Submittal:
 - 1. Schedule heating capacity, length of cable, spacing, and electrical power requirement for each electric heating cable required.
- B. Shop Drawings: For electric heating cable.
 - 1. Include plans, elevations, sections, and attachment details.

2. Accurately record actual locations of heating cable, thermostats, and branch circuit connections.
3. Include diagrams for power, signal, and control wiring.

1.06 **CLOSEOUT SUBMITTALS**

- A. Field quality-control reports.
- B. Operation and Maintenance Data: For electric heating cables to include in operation and maintenance manuals.
 1. Include description of operating controls.
 2. Include repair methods and parts list of components.

1.07 **COORDINATION**

- A. Coordinate with installation of piping insulation.

PART 2 PRODUCTS

2.01 **SELF-REGULATING, PARALLEL-RESISTANCE HEATING CABLES**

- A. Manufacturers: Subject to compliance with requirements, provide products by one of the following:
 1. Thermon Americas Inc.; FLX Self-Regulating Heating Cable.
 2. Raychem; nVent Electric plc; XLTrace.
 3. Delta-Therm Corporation; IN Series.
 4. Chromalox Advanced Thermal Technologies; a business of Spirax-Sarco Engineering PLC.
- B. Comply with IEEE 515.1.
- C. Heating Element: Pair of No. 16 AWG, parallel, nickel-coated copper bus wires embedded in crosslinked conductive polymer core, which varies heat output in response to temperature along its length. Terminate with waterproof, factory-assembled, non-heating leads with connectors at one end, and seal the opposite end watertight. Cable shall be capable of crossing over itself once without overheating.
- D. Electrical Insulating Jacket: Flame-retardant polyolefin.
- E. Cable Cover: Tinned-copper braid and polyolefin outer jacket.
- F. Maximum Operating Temperature (Power On): 150 deg F.
- G. Electrical Components, Devices, and Accessories: Listed and labeled as defined in NFPA 70, by an NRTL acceptable to authorities having jurisdiction, and marked for intended location and application.
- H. Capacities and Characteristics:
 1. Maximum Heat Output: W/ft as recommended by manufacturer.
 2. Piping Diameter: As indicated on the Drawings.
 3. Number of Parallel Cables: As recommended by manufacturer.
 4. Electrical Characteristics for Single-Circuit Connection: Coordinate electrical system requirements with Division 26.
- I. Electrical Power System Characteristics: As scheduled on the Drawings.

2.02 **CONTROLS**

- A. Manufacturers: Subject to compliance with requirements, provide products by one of the following:

1. Thermon Americas Inc.
 2. Raychem; nVent Electric plc.
 3. Delta-Therm Corporation.
 4. Chromalox Advanced Thermal Technologies; a business of Spirax-Sarco Engineering PLC.
- B. Pipe-Mounted Thermostats for Freeze Protection:
1. Remote bulb unit with adjustable temperature range from 30 to 50 deg F.
 2. Snap action; open-on-rise, single-pole switch with minimum current rating adequate for connected cable.
 3. Remote bulb on capillary, resistance temperature device, or thermistor for directly sensing pipe-wall temperature.
 4. Corrosion-resistant, waterproof control enclosure.

2.03 ACCESSORIES

- A. Cable Installation Accessories: Fiberglass tape, heat-conductive putty, cable ties, end seals and splice kits, and installation clips all furnished by manufacturer, or as recommended in writing by manufacturer.
- B. Warning Labels: Self-adhesive labels with legend "ELECTRIC HEAT TRACING." Refer to Division 20 Section "Mechanical Identification" for additional requirements
- C. Warning Tape: Continuously printed "Electrical Tracing"; vinyl, at least 3 mils thick, and with pressure-sensitive, permanent, waterproof, self-adhesive back.
1. Width for Markers on Pipes with OD, Including Insulation, Less Than 6 Inches: 3/4 inch minimum.
 2. Width for Markers on Pipes with OD, Including Insulation, 6 Inches or Larger: 1-1/2 inches minimum.

PART 3 EXECUTION

3.01 EXAMINATION

- A. Examine surfaces and substrates to receive electric heating cables for compliance with requirements for installation tolerances and other conditions affecting performance.
1. Ensure surfaces and pipes in contact with electric heating cables are free of burrs and sharp protrusions.
- B. Proceed with installation only after unsatisfactory conditions have been corrected.

3.02 INSTALLATION

- A. Install electric heating cable across expansion, construction, and control joints according to manufacturer's written instructions; use cable-protection conduit and slack cable to allow movement without damage to cable.
- B. Electric Heating-Cable Installation for Freeze Protection for Piping:
1. Install electric heating cables after piping has been tested and before insulation is installed.
 2. Install electric heating cables according to IEEE 515.1.
 3. Install insulation over piping with electric cables according to Division 20 Section "Mechanical Insulation."
 4. Install warning labels at 10 foot intervals, or install continuous warning tape on piping insulation where piping is equipped with electric heating cables.
- C. Set field-adjustable switches and circuit-breaker trip ranges.

3.03 **CONNECTIONS**

- A. Ground equipment according to Division 26 Section "Grounding and Bonding."
- B. Connect wiring according to Division 26 Section "Conductors and Cables."

3.04 **FIELD QUALITY CONTROL**

- A. Manufacturer's Field Service: Engage a factory-authorized service representative to test and inspect components, assemblies, and equipment installations, including connections.
 - 1. Perform tests after cable installation but before application of coverings such as insulation, wall or ceiling construction, or concrete.
 - 2. Test cables for electrical continuity and insulation integrity before energizing using 2500 Vdc megohmmeter (megger).
 - 3. Test cables to verify rating and power input. Energize and measure voltage and current simultaneously.
- B. Repeat tests for continuity, insulation resistance, and input power after applying thermal insulation on pipe-mounted cables.
- C. Cables will be considered defective if they do not pass tests and inspections.
- D. Remove and replace damaged heat-tracing cables.
- E. Prepare test and inspection reports.

3.05 **PROTECTION**

- A. Protect installed heating cables, including non-heating leads, from damage during construction.

END OF SECTION

SECTION 22 0533 - HEAT TRACING FOR PLUMBING

****ADD2****

PART 1 GENERAL	1
1.01 RELATED DOCUMENTS	1
1.02 SUMMARY	1
1.03 DEFINITIONS	1
1.04 ACTION SUBMITTALS	1
1.05 INFORMATIONAL SUBMITTALS	1
1.06 CLOSEOUT SUBMITTALS	2
1.07 QUALITY ASSURANCE	2
1.08 COORDINATION	2
1.09 SELF-REGULATING, PARALLEL-RESISTANCE HEATING CABLES FOR SNOW AND ICE MELTING	2
1.10 CONTROLS	3
PART 2 PRODUCTS (NOT APPLICABLE)	3
PART 3 EXECUTION	3
3.01 EXAMINATION	3
3.02 INSTALLATION	3
3.03 CONNECTIONS	4
3.04 FIELD QUALITY CONTROL	4
3.05 PROTECTION	4

PART 1 GENERAL

1.01 RELATED DOCUMENTS

- A. Drawings and general provisions of the Contract, including General and Supplementary Conditions and Division 01 Specification Sections, apply to this Section.
- B. Related Sections:
 - 1. Division 20 Section "Mechanical General Requirements."

1.02 SUMMARY

- A. Section includes plumbing piping heat tracing for snow and ice melting in roof drains and rain conductors with the following electric heating cables:
 - 1. Self-regulating, parallel resistance.

1.03 DEFINITIONS

- A. BAS: Building Automation System.

1.04 ACTION SUBMITTALS

- A. Product Data: For each type of product.
 - 1. Include rated capacities, operating characteristics, and furnished specialties and accessories.

1.05 INFORMATIONAL SUBMITTALS

- A. Delegated-Design Submittal:
 - 1. Schedule heating capacity, length of cable, spacing, and electrical power requirement for each electric heating cable required.
- B. Shop Drawings: For electric heating cable.
 - 1. Include plans, elevations, sections, and attachment details.

2. Include diagrams for power, signal, and control wiring.

1.06 **CLOSEOUT SUBMITTALS**

- A. Field quality-control reports.
- B. Operation and Maintenance Data: For electric heating cables to include in operation and maintenance manuals.

1.07 **QUALITY ASSURANCE**

- A. Electrical Components, Devices, and Accessories: Listed and labeled as defined in NFPA 70, by an NRTL acceptable to authorities having jurisdiction, and marked for intended location and application.

1.08 **COORDINATION**

- A. Coordinate with installation of piping insulation.

1.09 **SELF-REGULATING, PARALLEL-RESISTANCE HEATING CABLES FOR SNOW AND ICE MELTING**

- A. Manufacturers: Subject to compliance with requirements, provide products by one of the following:
 1. Thermon Americas Inc.; SnoTrace RGS.
 2. Raychem; nVent Electric plc; IceStop.
 3. Delta-Therm Corporation, IN Series CBT Cables.
- B. Comply with IEEE 515.1.
- C. Performance Requirements: Select electric heat tracing cable capable of maintaining flow in roof drains and rain conductors with outside temperature at minus 10 deg F.
- D. Heating Element: Pair of parallel No. 16 AWG, nickel-coated, copper bus wires embedded in crosslinked conductive polymer core, which varies heat output in response to temperature along its length. Terminate with waterproof, factory-assembled, non-heating leads with connectors at one end, and seal the opposite end watertight. Cable shall be capable of crossing over itself once without overheating.
- E. Electrical Insulating Jacket: Flame-retardant polyolefin.
- F. Cable Cover: Tinned-copper braid and polyolefin outer jacket with ultraviolet inhibitor.
- G. Maximum Operating Temperature (Power On): 150 deg F.
- H. Maximum Exposure Temperature (Power Off): 185 deg F.
- I. Capacities and Characteristics:
 1. Voltage: As recommended by manufacturer.
 2. Number of Cables: As recommended by manufacturer.
 3. Electrical Characteristics for Single-Circuit Connection: Coordinate electrical system requirements with Division 26.
- J. Electrical Power System Characteristics: As scheduled on the Drawings.
- K. Installation Accessories:
 1. Circuit Fabrication Kit: Designed to terminate one circuit for both power connection and end termination.
 2. Labels: Self-adhesive labels with legend "ELECTRIC HEAT TRACING." Refer to Division 20 Section "Mechanical Identification" for additional requirements
 3. Cable Mounting Clips: Secures cable to roof.

4. Cable Roof Fasteners: Attaches cable to roof or fascia material.
5. Downspout Cable Hangers: Secures cable at downspouts to remove strain.
6. Aluminum Tape: Attaches cable to bottom of clean gutter to keep cable in place during rain.

1.10 **CONTROLS**

- A. Precipitation and Temperature Sensor for Snow Melting on Roofs and in Gutters:
 1. Manufacturers: Subject to compliance with requirements, provide products by one of the following:
 - a. Thermon Americas Inc.
 - b. Raychem; nVent Electric plc.
 - c. Delta-Therm Corporation.
 2. Automatic control with manual on, automatic, and standby/reset switch.
 3. Precipitation and temperature sensors shall sense the surface conditions of roof and gutters and shall be programmed to energize the cable as follows:
 - a. Temperature Span: 34 to 44 deg F.
 - b. Adjustable Delay-Off Span: 30 to 90 minutes.
 - c. Energize Cables: Following two-minute delay if ambient temperature is below set point and precipitation is detected.
 - d. De-Energize Cables: On detection of a dry surface plus time delay.
 4. Corrosion-proof and waterproof enclosure suitable for outdoor mounting, for controls and precipitation and temperature sensors.
 5. Minimum 30-A contactor to energize cable or close other contactors.
 6. Precipitation sensor shall be freestanding.
 7. Provide relay with contacts to indicate operational status, on or off, for interface with central BAS workstation.

PART 2 PRODUCTS (NOT APPLICABLE)

PART 3 EXECUTION

3.01 **EXAMINATION**

- A. Examine surfaces and substrates to receive electric heating cables for compliance with requirements for installation tolerances and other conditions affecting performance.
 1. Ensure surfaces and pipes in contact with electric heating cables are free of burrs and sharp protrusions.
- B. Proceed with installation only after unsatisfactory conditions have been corrected.

3.02 **INSTALLATION**

- A. Install electric heating cable across expansion, construction, and control joints according to manufacturer's written instructions; use cable-protection conduit and slack cable to allow movement without damage to cable.
- B. Electric Heating-Cable Installation for Snow and Ice Melting: Install on roof and in gutters and downspouts with clips and other hardware furnished by manufacturer that are compatible with roof, gutters, and downspouts.
- C. Set field-adjustable switches and circuit-breaker trip ranges.

3.03 CONNECTIONS

- A. Ground equipment according to Division 26 Section "Grounding and Bonding."
- B. Connect wiring according to Division 26 Section "Conductors and Cables."

3.04 FIELD QUALITY CONTROL

- A. Manufacturer's Field Service: Engage a factory-authorized service representative to test and inspect components, assemblies, and equipment installations, including connections.
 - 1. Perform tests after cable installation but before application of coverings such as insulation, wall or ceiling construction, or concrete.
 - 2. Test cables for electrical continuity and insulation integrity before energizing using 2500 Vdc megohmmeter (megger).
 - 3. Test cables to verify rating and power input. Energize and measure voltage and current simultaneously.
- B. Cables will be considered defective if they do not pass tests and inspections.
- C. Remove and replace damaged heat-tracing cables.
- D. Prepare test and inspection reports.

3.05 PROTECTION

- A. Protect installed heating cables, including non-heating leads, from damage during construction.

END OF SECTION

SECTION 22 1119 - DOMESTIC WATER PIPING SPECIALTIES

PART 1 GENERAL	1
1.01 RELATED DOCUMENTS.....	1
1.02 PERFORMANCE REQUIREMENTS	1
1.03 ACTION SUBMITTALS	1
1.04 INFORMATIONAL SUBMITTALS	2
1.05 CLOSEOUT SUBMITTALS.....	2
1.06 QUALITY ASSURANCE.....	2
PART 2 PRODUCTS	2
2.01 VACUUM BREAKERS	2
2.02 BACKFLOW PREVENTERS.....	3
2.03 BALANCING VALVES.....	5
2.04 TEMPERATURE-ACTUATED WATER MIXING VALVES.....	6
2.05 PREPIPED TEMPERED WATER MIXING SYSTEM.....	7
2.06 STRAINERS FOR DOMESTIC WATER PIPING	7
2.07 OUTLET BOXES.....	8
2.08 HOSE BIBBS.....	9
2.09 WALL HYDRANTS.....	9
2.10 WATER HAMMER ARRESTERS	10
2.11 AIR VENTS	10
2.12 DOMESTIC WATER CARTRIDGE FILTERS.....	11
PART 3 EXECUTION	11
3.01 INSTALLATION.....	11
3.02 DOMESTIC WATER CARTRIDGE-FILTER INSTALLATION.....	12
3.03 CONNECTIONS.....	12
3.04 LABELING AND IDENTIFYING	12
3.05 FIELD QUALITY CONTROL	13
3.06 ADJUSTING	13

PART 1 GENERAL

1.01 RELATED DOCUMENTS

- A. Drawings and general provisions of the Contract, including General and Supplementary Conditions and Division 01 Specification Sections, apply to this Section.
- B. Related Sections include the following:
 - 1. Division 20 Section "Mechanical General Requirements."
 - 2. Division 20 Section "Basic Mechanical Materials and Methods."
 - 3. Division 20 Section "Meters and Gages" for thermometers, pressure gages, and flow meters in domestic water piping.
 - 4. Division 22 Section "Domestic Water Piping " for water meters.
 - 5. Division 22 Section "Emergency Plumbing Fixtures" for water tempering equipment.
 - 6. Division 22 Section "Drinking Fountains, Water Coolers and Cuspidors" for water filters for water coolers.

1.02 PERFORMANCE REQUIREMENTS

- A. Minimum Working Pressure for Domestic Water Piping Specialties: 125 psig, unless otherwise indicated.

1.03 ACTION SUBMITTALS

- A. Product Data: For each type of product indicated.

1.04 **INFORMATIONAL SUBMITTALS**

- A. Shop Drawings: Diagram power, signal, and control wiring.

1.05 **CLOSEOUT SUBMITTALS**

- A. Field quality-control test reports.
- B. Flow Reports and Settings: For calibrated balancing valves.
- C. Operation and Maintenance Data: For domestic water piping specialties to include in emergency, operation, and maintenance manuals.

1.06 **QUALITY ASSURANCE**

- A. Electrical Components, Devices, and Accessories: Listed and labeled as defined in NFPA 70, Article 100, by an NRTL acceptable to authorities having jurisdiction, and marked for intended use.
- B. Regulatory Requirements: Comply with requirements in Public Law 111-380, "Reduction of Lead in Drinking Water Act," about lead content in materials that will be in contact with potable water for human consumption.
- C. NSF Compliance:
1. Comply with NSF 14, "Plastics Piping Components and Related Materials," for plastic domestic water piping components.
 2. Comply with NSF 61, "Drinking Water System Components - Health Effects; Sections 1 through 9."
 3. Comply with NSF 372, "Drinking Water System Components – Lead Content" for components with wetted surfaces in contact with potable water.

PART 2 PRODUCTS

2.01 **VACUUM BREAKERS**

- A. Pipe-Applied, Atmospheric-Type Vacuum Breakers:
1. Manufacturers: Subject to compliance with requirements, provide products by one of the following:
 - a. Apollo Valves; Conbraco Industries, Inc.
 - b. FEBCO; a Division of Watts Water Technologies, Inc.
 - c. Watts Water Technologies, Inc.; Watts Regulator Co.
 - d. Zurn Plumbing Products Group; Wilkins Div.
 2. Standard: ASSE 1001.
 3. Size: NPS 1/4 to NPS 3, as required to match connected piping.
 4. Body: Bronze.
 5. Inlet and Outlet Connections: Threaded.
 6. Finish: Chrome plated.
- B. Hose-Connection Vacuum Breakers:
1. Manufacturers: Subject to compliance with requirements, provide products by one of the following:
 - a. Apollo Valves; Conbraco Industries, Inc.
 - b. MIFAB, Inc.
 - c. Watts Water Technologies, Inc.; Watts Regulator Co.

- d. Woodford Manufacturing Company.
 2. Standard: ASSE 1011.
 3. Body: Bronze or brass, nonremovable, with manual drain.
 4. Outlet Connection: Garden-hose threaded complying with ASME B1.20.7.
 5. Finish: Chrome or nickel plated.
- C. Pressure Vacuum Breakers:
1. Manufacturers: Subject to compliance with requirements, provide products by one of the following:
 - a. Apollo Valves; Conbraco Industries, Inc.
 - b. FEBCO; a Division of Watts Water Technologies, Inc.
 - c. Watts Water Technologies, Inc.; Ames Fire & Waterworks.
 - d. Watts Water Technologies, Inc.; Watts Regulator Co.
 - e. Zurn Plumbing Products Group; Wilkins Div.
 2. Standard: ASSE 1020.
 3. Operation: Continuous-pressure applications.
 4. Pressure Loss: 5 psig maximum, through middle 1/3 of flow range.
 5. Size and Capacity: As indicated on the drawings.
 6. Accessories:
 - a. Valves: Ball type, on inlet and outlet.

2.02 **BACKFLOW PREVENTERS**

- A. Intermediate Atmospheric-Vent Backflow Preventers:
1. Manufacturers: Subject to compliance with requirements, provide products by one of the following:
 - a. Apollo Valves; Conbraco Industries, Inc.
 - b. FEBCO; a Division of Watts Water Technologies, Inc.
 - c. Watts Water Technologies, Inc.; Watts Regulator Co.
 - d. Zurn Plumbing Products Group; Wilkins Div.
 2. Standard: ASSE 1012.
 3. Operation: Continuous-pressure applications.
 4. Size: NPS 1/2 or NPS 3/4.
 5. Body: Bronze.
 6. End Connections: Union, solder joint.
 7. Finish: Chrome plated.
- B. Reduced-Pressure-Principle Backflow Preventers:
1. Manufacturers: Subject to compliance with requirements, provide products by one of the following:
 - a. Apollo Valves; Conbraco Industries, Inc.
 - b. FEBCO; a Division of Watts Water Technologies, Inc.
 - c. Watts Water Technologies, Inc.; Ames Fire & Waterworks.

- d. Watts Water Technologies, Inc.; Watts Regulator Co.
 - e. Zurn Plumbing Products Group; Wilkins Div.
 2. Standard: ASSE 1013.
 3. Operation: Continuous-pressure applications.
 4. Pressure Loss: 12 psig maximum, through middle 1/3 of flow range.
 5. Size and Capacities: As scheduled on the drawings.
 6. Body: Bronze for NPS 2 and smaller; cast-iron or ductile-iron, with interior lining complying with AWWA C550 or that is FDA approved for NPS 2-1/2 and larger.
 7. End Connections: Threaded for NPS 2 and smaller; flanged for NPS 2-1/2 and larger.
 8. Configuration: Designed for horizontal, straight through flow.
 9. Accessories:
 - a. Valves: Ball type with threaded ends on inlet and outlet of NPS 2 and smaller; gate-type with flanged ends on inlet and outlet of NPS 2-1/2 and larger.
 - b. Air-Gap Fitting: ASME A112.1.2, matching backflow-preventer connection.
 - c. Y-Pattern strainer and soft-seated check valve.
- C. Double-Check Backflow-Prevention Assemblies:
1. Manufacturers: Subject to compliance with requirements, provide products by one of the following:
 - a. Apollo Valves; Conbraco Industries, Inc.
 - b. FEBCO; a Division of Watts Water Technologies, Inc.
 - c. Watts Water Technologies, Inc.; Ames Fire & Waterworks.
 - d. Watts Water Technologies, Inc.; Watts Regulator Co.
 - e. Zurn Plumbing Products Group; Wilkins Div.
 2. Standard: ASSE 1015.
 3. Operation: Continuous-pressure applications, unless otherwise indicated.
 4. Pressure Loss: 5 psig maximum, through middle 1/3 of flow range.
 5. Size and Capacities: As scheduled on the drawings.
 6. Body: Bronze for NPS 2 and smaller; cast-iron or ductile-iron, with interior lining complying with AWWA C550 or that is FDA approved for NPS 2-1/2 and larger.
 7. End Connections: Threaded for NPS 2 and smaller; flanged for NPS 2-1/2 and larger.
 8. Configuration: Designed for horizontal, straight through flow.
 9. Accessories:
 - a. Valves: Ball type with threaded ends on inlet and outlet of NPS 2 and smaller; gate-type with flanged ends on inlet and outlet of NPS 2-1/2 and larger.
- D. Beverage-Dispensing-Equipment Backflow Preventers:
1. Manufacturers: Subject to compliance with requirements, provide products by one of the following:
 - a. Apollo Valves; Conbraco Industries, Inc.
 - b. Watts Water Technologies, Inc.; Watts Regulator Co.
 - c. Zurn Plumbing Products Group; Wilkins Div.

2. Standard: ASSE 1022.
3. Operation: Continuous-pressure applications.
4. Size: NPS 1/4 or NPS 3/8.
5. Body: Stainless steel or Acetal plastic.
6. End Connections: Threaded.

E. Hose-Connection Backflow Preventers:

1. Manufacturers: Subject to compliance with requirements, provide products by one of the following:
 - a. Apollo Valves; Conbraco Industries, Inc.
 - b. Watts Water Technologies, Inc.; Watts Regulator Co.
 - c. Woodford Manufacturing Company.
2. Standard: ASSE 1052.
3. Operation: Up to 10-foot head of water back pressure.
4. Inlet Size: NPS 1/2 or NPS 3/4.
5. Outlet Size: Garden-hose thread complying with ASME B1.20.7.
6. Capacity: At least 3-gpm flow.

2.03 **BALANCING VALVES**

A. Calibrated Balancing Valves NPS 1/2:

1. Manufacturers: Subject to compliance with requirements, provide products by one of the following:
 - a. Armstrong International, Inc.
 - b. Armstrong Pumps, Inc.
 - c. Apollo Valves; by Conbraco Industries, Inc.
 - d. Bell & Gossett; Xylem Inc.
 - e. Flo Fab Inc.
 - f. Flow Design Inc.
 - g. Griswold Controls.
 - h. NIBCO INC.
 - i. IMI Indoor Climate; Tour & Andersson.
 - j. Taco, Inc.
 - k. Watts Water Technologies, Inc.; Watts Regulator Co.
2. Type: Ball or Y-pattern globe valve with two readout ports and memory setting indicator.
3. Body: Dezincification resistant brass, or bronze.
4. Minimum Flow Rate: 0.3 gpm.
5. Accessories: Meter hoses, fittings, valves, differential pressure meter, and carrying case.

B. Calibrated Balancing Valves NPS 3/4 to NPS 2:

1. Manufacturers: Subject to compliance with requirements, provide products by one of the following:
 - a. Armstrong International, Inc.

- b. Armstrong Pumps, Inc.
 - c. Apollo Valves; by Conbraco Industries, Inc.
 - d. Bell & Gossett; Xylem Inc.
 - e. Flo Fab Inc.
 - f. Flow Design Inc.
 - g. Griswold Controls.
 - h. NIBCO INC.
 - i. IMI Indoor Climate; Tour & Andersson.
 - j. Taco, Inc.
 - k. Watts Water Technologies, Inc.; Watts Regulator Co.
2. Type: Ball or Y-pattern globe valve with two readout ports and memory setting indicator.
 3. Body: Dezincification resistant brass, or bronze.
 4. Size: Same as connected piping, but not larger than NPS 2.
 5. Accessories: Meter hoses, fittings, valves, differential pressure meter, and carrying case.
- C. Calibrated Balancing Valves NPS 2-1/2 to NPS 4:
1. Manufacturers: Subject to compliance with requirements, provide products by one of the following:
 - a. Armstrong International, Inc.
 - b. Bell & Gossett; Xylem Inc.
 - c. Flo Fab Inc.
 - d. Flow Design Inc.
 - e. Griswold Controls.
 - f. NIBCO INC.
 - g. IMI Indoor Climate; Tour & Andersson.
 - h. Watts Water Technologies, Inc.; Watts Regulator Co.
 2. Type: Adjustable with Y-pattern globe valve, two readout ports, and memory-setting indicator.
 3. Size: Same as connected piping, but not smaller than NPS 2-1/2.
 4. Accessories: Meter hoses, fittings, valves, differential pressure meter, and carrying case.

2.04 **TEMPERATURE-ACTUATED WATER MIXING VALVES**

- A. Water-Temperature Limiting Devices:
1. Manufacturers: Subject to compliance with requirements, provide products by one of the following:
 - a. Acorn Controls; Morris Group International; ST70.
 - b. Apollo Valves; Conbraco Industries, Inc.; Model MVD (34D Series).
 - c. Bradley Corporation.
 - d. Lawler Manufacturing Company, Inc.
 - e. Leonard Valve Company; Series 170-LF and 270-LF.

- f. Watts Water Technologies, Inc.; Powers Division; Hydroguard Series LFe480, LFG480, and LFLM495.
 - g. Watts Water Technologies, Inc.; Watts Regulator Co.
 - h. Zurn Plumbing Products Group; Wilkins Div.
2. Standard: ASSE 1070.
 3. Pressure Rating: 125 psig.
 4. Type: Thermostatically controlled water mixing valve.
 5. Material: Bronze body with corrosion-resistant interior components.
 6. Connections: 1/2-inch union or 3/8-inch compression; with integral check valves.
 7. Accessories: Adjustable temperature-control knob.
 8. Outlet Temperature Range: Adjustable from 85 deg F to 120 deg F. Set at 105 deg F.
 9. Minimum Flow Rate: 0.5 gpm.
 10. Valve Finish: Chrome plated

2.05 PREPIPED TEMPERED WATER MIXING SYSTEM

1. Manufacturers: Subject to compliance with requirements, provide products by one of the following:
 - a. Acorn Controls; Morris Group International.
 - b. Armstrong International, Inc. (RADA).
 - c. Bradley Corporation.
 - d. Lawler Manufacturing Company, Inc.; Prepipd 802 Hi-Low Tempered water Mixing System.
 - e. Leonard Valve Company.
 - f. Symmons Industries, Inc.
 - g. Watts Water Technologies, Inc.; Powers Division.
 - h. Watts Water Technologies, Inc.; Watts Regulator Co.
2. Description: Completely assembled and tested prepipd manifold system including mixing valve(s), recirculation pump, circuit setting balancing valve, aquastat, circulator switch box, thermometers, isolation valves, mounting strut, and test connection.
3. Standard: ASSE 1017.
4. Mixing Valve: Exposed-mounting, thermostatically controlled water mixing valve.
 - a. Material: Bronze body with corrosion-resistant interior components.
 - b. Connections: Threaded union inlets and outlet.
 - c. Accessories: Manual temperature control, check stops and strainers on hot- and cold-water supplies, and adjustable, temperature-control handle.
 - d. Valve Pressure Rating: 125 psig minimum, unless otherwise indicated.
 - e. Size, Settings, and Capacities: As scheduled on the drawings.
 - f. Valve Finish: Rough bronze.

2.06 STRAINERS FOR DOMESTIC WATER PIPING

- A. Y-Pattern Strainers:
 1. Manufacturers:

- a. Apollo Valves; Conbraco Industries, Inc.
- b. Keckley Company.
- c. Metraflex Company.
- d. Mueller Steam Specialty; a Watts Brand.
- e. NIBCO, Inc.
- f. Titan Flow Control, Inc.
- g. Watts.
- h. Yarway; Emerson Automation Solutions.
2. CWP: 200 psig minimum, unless otherwise indicated.
3. SWP: 125 psig minimum, unless otherwise indicated.
4. Body: Bronze for NPS 2 and smaller; cast iron with interior lining complying with AWWA C550 or FDA-approved, epoxy coating and for NPS 2-1/2 and larger.
5. End Connections: Threaded or soldered for NPS 2 and smaller; flanged for NPS 2-1/2 and larger.
6. Screen: Stainless steel with round perforations, unless otherwise indicated.
7. Perforation Size:
 - a. Strainers NPS 2 and Smaller: 0.033 inch.
 - b. Strainers NPS 2-1/2 to NPS 4: 0.045 inch.
 - c. Strainers NPS 5 and Larger: 0.045 inch.
8. Drain: Pipe plug.

2.07 **OUTLET BOXES**

A. Clothes Washer Outlet Boxes:

1. Manufacturers: Subject to compliance with requirements, provide products by one of the following:
 - a. Sioux Chief Manufacturing Company, Inc.; Ox Box.
 - b. Oatey SCS.
 - c. Guy Gray Manufacturing Co., Inc.
2. Mounting: Recessed.
3. Material and Finish: Enameled- or epoxy-painted-steel or Stainless-steel box and faceplate.
4. Faucet: Combination, valved fitting or separate hot- and cold-water, valved fittings complying with ASME A112.18.1. Include garden-hose thread complying with ASME B1.20.7 on outlets.
5. Supply Shutoff Fittings: NPS 1/2 gate, globe, or ball valves and NPS 1/2 copper, water tubing.
6. Drain: NPS 2 standpipe and P-trap for direct waste connection to drainage piping.
7. Inlet Hoses: Two 60-inch- long, rubber household clothes washer inlet hoses with female, garden-hose-thread couplings. Include rubber washers.
8. Drain Hose: One 48-inch- long, rubber household clothes washer drain hose with hooked end.

B. Ice maker Outlet Boxes:

1. Manufacturers: Subject to compliance with requirements, provide products by one of the following:
 - a. Sioux Chief Manufacturing Company, Inc.; Ox Box.
 - b. Oatey SCS.
 - c. LSP Products Group, Inc.
 - d. Acorn Engineering Company.
2. Mounting: Recessed.
3. Material and Finish: Enameled- or epoxy-painted-steel or Stainless-steel box and faceplate.
4. Faucet: Valved fitting complying with ASME A112.18.1. Include NPS 1/2 or smaller copper tube outlet.
5. Supply Shutoff Fitting: NPS 1/2 gate, globe, or ball valve and NPS 1/2 copper, water tubing.

2.08 HOSE BIBBS

A. Hose Bibbs:

1. Standard: ASME A112.18.1 for sediment faucets.
2. Body Material: Bronze.
3. Seat: Bronze, replaceable.
4. Supply Connections: NPS 1/2 or NPS 3/4 threaded or solder-joint inlet.
5. Outlet Connection: Garden-hose thread complying with ASME B1.20.7.
6. Pressure Rating: 125 psig.
7. Vacuum Breaker: Integral nonremovable, drainable, hose-connection vacuum breaker complying with ASSE 1011.
8. Finish for Equipment Rooms: Chrome or nickel plated.
9. Finish for Service Areas: Chrome or nickel plated.
10. Finish for Finished Rooms: Chrome or nickel plated.
11. Operation for Equipment Rooms: Wheel handle or operating key.
12. Operation for Service Areas: Operating key.
13. Operation for Finished Rooms: Operating key.
14. Include operating key with each operating-key hose bibb.
15. Include integral wall flange with each chrome- or nickel-plated hose bibb.

2.09 WALL HYDRANTS

A. Nonfreeze Wall Hydrants:

1. Manufacturers: Subject to compliance with requirements, provide products by one of the following:
 - a. Josam Company.
 - b. MIFAB, Inc.
 - c. Smith, Jay R. Mfg. Co.; Division of Smith Industries, Inc.
 - d. Tyler Pipe; Wade Div.
 - e. Watts Water Technologies, Inc.; Watts Regulator co.

- f. Woodford Manufacturing Company.
- g. Zurn Plumbing Products Group; Specification Drainage Operation.
2. Standard: ASME A112.21.3M for self-draining wall hydrants.
3. Pressure Rating: 125 psig.
4. Operation: Loose key.
5. Casing and Operating Rod: Of length required to match wall thickness. Include wall clamp.
6. Inlet: NPS 3/4 or NPS 1.
7. Outlet: Concealed, with integral vacuum breaker and garden-hose thread complying with ASME B1.20.7.
8. Box: Deep, flush mounting with cover.
9. Box and Cover Finish: Polished nickel bronze or chrome plated.
10. Outlet: Exposed, with integral vacuum breaker and garden-hose thread complying with ASME B1.20.7.
11. Nozzle and Wall-Plate Finish: Polished nickel bronze.
12. Operating Keys(s): Two with each wall hydrant.

2.10 WATER HAMMER ARRESTERS

A. Water Hammer Arresters (Copper Tube Type):

1. Manufacturers: Subject to compliance with requirements, provide products by one of the following:
 - a. MIFAB, Inc.
 - b. PPP Inc.
 - c. Sioux Chief Manufacturing Company, Inc.
 - d. Smith, Jay R. Mfg. Co.; Division of Smith Industries, Inc.
 - e. Tyler Pipe; Wade Div.
 - f. Watts Drainage Products Inc.
 - g. Watts Water Technologies, Inc.; Watts Regulator Co.
2. Standard: ASSE 1010 or PDI-WH 201.
3. Type: Copper tube with piston.
4. Size: ASSE 1010, Sizes AA and A through F or PDI-WH 201, Sizes A through F.

B. Water Hammer Arresters (Metal Bellows Type):

1. Manufacturers: Subject to compliance with requirements, provide products by one of the following:
 - a. AMTROL, Inc.
 - b. Josam Company.
 - c. MIFAB, Inc.
 - d. Smith, Jay R. Mfg. Co.; Division of Smith Industries, Inc.
 - e. Tyler Pipe; Wade Div.
 - f. Watts Drainage Products Inc.
 - g. Zurn Plumbing Products Group; Specification Drainage Operation.

2. Standard: ASSE 1010 or PDI-WH 201.
3. Type: Precharged stainless steel bellows.
4. Size: ASSE 1010, Sizes AA and A through F or PDI-WH 201, Sizes A through F.

2.11 **AIR VENTS**

- A. Bolted-Construction Automatic Air Vents:
1. Body: Bronze.
 2. Pressure Rating: 125-psig minimum pressure rating at 140 deg F.
 3. Float: Replaceable, corrosion-resistant metal.
 4. Mechanism and Seat: Stainless steel.
 5. Size: NPS 3/8 minimum inlet.
 6. Inlet and Vent Outlet End Connections: Threaded.
- B. Welded-Construction Automatic Air Vents:
1. Body: Stainless steel.
 2. Pressure Rating: 150-psig minimum pressure rating.
 3. Float: Replaceable, corrosion-resistant metal.
 4. Mechanism and Seat: Stainless steel.
 5. Size: NPS 3/8 minimum inlet.
 6. Inlet and Vent Outlet End Connections: Threaded.

2.12 **DOMESTIC WATER CARTRIDGE FILTERS**

A. **Off-Floor Cartridge Filters:**

1. **Manufacturers:**
 - a. **Culligan International Company.**
 - b. **Harmsco Filtration Products.**
 - c. **Osmonics, Inc.; Hytrex Filters Div.**
 - d. **Parker Hannifin Corporation; Process Filtration Div.**
 - e. **Water Equipment Technologies (WET); Xylem Inc.**
 - f. **Watts Premier.**
2. **Description: Simplex, in-line housing with replaceable element for removing suspended particles from water.**
 - a. **Housing: Corrosion resistant; designed to separate feedwater from filtrate and to direct feedwater through water filter element; with element support.**
 - 1) **Pipe Connections: Threaded according to ASME B1.20.1.**
 - 2) **Support: Wall bracket.**
 - b. **Element: Replaceable; of shape to fit housing.**
3. **Capacity and Characteristics:**
 - a. **Refer to locations specified on Drawings. **ADD2****

PART 3 EXECUTION

3.01 INSTALLATION

- A. Refer to Division 20 Section "Basic Mechanical Materials and Methods" for piping joining materials, joint construction, and basic installation requirements.
- B. Install backflow preventers in each water supply to mechanical equipment and systems and to other equipment and water systems that may be sources of contamination. Comply with authorities having jurisdiction.
 - 1. Locate backflow preventers in same room as connected equipment or system.
 - 2. Install drain for backflow preventers with atmospheric-vent drain connection with air-gap fitting, fixed air-gap fitting, or equivalent positive pipe separation of at least two pipe diameters in drain piping and pipe to floor drain. Locate air-gap device attached to or under backflow preventer. Simple air breaks are not acceptable for this application.
 - 3. Do not install bypass piping around backflow preventers.
 - 4. Install strainer and soft-seated check valve upstream of backflow preventer. Exception: Fire protection backflow preventers.
- C. Install water control valves with inlet and outlet shutoff valves. Install pressure gages on inlet and outlet.
- D. Install balancing valves in locations where they can easily be adjusted.
- E. Install temperature-actuated water mixing valves with strainers, and check stops or shutoff valves on inlets and with shutoff valve on outlet.
 - 1. Install thermometers and water regulators if specified.
 - 2. Install cabinet-type units recessed in or surface mounted on wall as specified.
- F. Install Y-pattern strainers for water on supply side of pump.
- G. Install outlet boxes recessed in wall. Install 2-by-4-inch fire-retardant-treated-wood blocking wall reinforcement between studs. Fire-retardant-treated-wood blocking is specified in Division 06 Section "Rough Carpentry."
- H. Install water hammer arresters in water piping according to PDI-WH 201.
- I. Install air vents at high points of water piping.

3.02 DOMESTIC WATER CARTRIDGE-FILTER INSTALLATION

- A. **Install cartridge filters level and plumb, according to layout drawings, original design, and referenced standards. Maintain manufacturer's recommended clearances. Arrange units so controls and devices needing service are accessible.**
- B. **Attach wall brackets for off-floor, wall-mounting, cartridge filter to vertical surface. Attach housing(s), and base if any, to wall bracket.**
- C. **Install housings for off-floor, in-line, cartridge filters in piping.**
- D. **Install isolation valves on inlet and outlet piping of each water filter.**
- E. **Install filter elements in cartridges after completion of flushing and cleaning. **ADD2****

3.03 CONNECTIONS

- A. Piping installation requirements are specified in other Division 20 and 22 Sections. Drawings indicate general arrangement of piping and specialties.
- B. Ground equipment according to Division 26 Section "Grounding and Bonding."
- C. Connect wiring according to Division 26 Section "Conductors and Cables."

3.04 LABELING AND IDENTIFYING

- A. Equipment Nameplates and Signs: Install engraved plastic-laminate equipment nameplate or sign on or near each of the following:
 - 1. Pressure vacuum breakers.
 - 2. Intermediate atmospheric-vent backflow preventers.
 - 3. Reduced-pressure-principle backflow preventers.
 - 4. Carbonated-beverage-machine backflow preventers.
 - 5. Dual-check-valve backflow preventers.
 - 6. Calibrated balancing valves.
 - 7. Primary, thermostatic, water mixing valves.
 - 8. Outlet boxes.
- B. Distinguish among multiple units, inform operator of operational requirements, indicate safety and emergency precautions, and warn of hazards and improper operations, in addition to identifying unit. Nameplates and signs are specified in Division 20 Section "Mechanical Identification."

3.05 FIELD QUALITY CONTROL

- A. Perform the following tests and prepare test reports:
 - 1. Test each backflow prevention device according to authorities having jurisdiction and the device's reference standard.
- B. Remove and replace malfunctioning domestic water piping specialties and retest as specified above.

3.06 ADJUSTING

- A. Set field-adjustable pressure set points of water pressure-reducing valves.
- B. Set field-adjustable flow set points of balancing valves as follows:
 - 1. Set calibrated balancing valves at calculated presettings.
 - 2. Measure flow each station and adjust where necessary.
 - 3. Record settings and mark balancing devices.
- C. Set field-adjustable temperature set points of temperature-actuated water mixing valves.

END OF SECTION

TMP Architecture, Inc.
Peter Basso Associates, Inc.

TMP22102
PBA2023.0154.00

SECTION 22 1319 - DRAINAGE PIPING SPECIALTIES

PART 1 GENERAL	1
1.01 RELATED DOCUMENTS.....	1
1.02 DEFINITIONS.....	1
1.03 ACTION SUBMITTALS	2
1.04 CLOSEOUT SUBMITTALS.....	2
1.05 QUALITY ASSURANCE.....	2
1.06 COORDINATION	2
PART 2 PRODUCTS	2
2.01 CAST-IRON CLEANOUTS.....	2
2.02 FLOOR DRAINS	4
2.03 FLOOR SINKS	6
2.04 AIR-ADMITTANCE VALVES.....	7
2.05 ROOF FLASHING ASSEMBLIES	7
2.06 TRAP SEAL PROTECTION DEVICES	7
2.07 ROOF DRAINS	8
2.08 MISCELLANEOUS DRAINAGE PIPING SPECIALTIES.....	9
2.09 FLASHING MATERIALS	10
2.10 GREASE INTERCEPTORS	11
2.11 SOLIDS INTERCEPTORS	11
PART 3 EXECUTION	12
3.01 CONCRETE BASES	12
3.02 INSTALLATION.....	12
3.03 CONNECTIONS.....	14
3.04 FLASHING INSTALLATION.....	14
3.05 LABELING AND IDENTIFYING	15
3.06 FIELD QUALITY CONTROL	15
3.07 PROTECTION.....	15
3.08 DEMONSTRATION.....	15

PART 1 GENERAL

1.01 RELATED DOCUMENTS

- A. Drawings and general provisions of the Contract, including General and Supplementary Conditions and Division 01 Specification Sections, apply to this Section.
- B. Related Sections include the following:
 - 1. Division 20 Section "Mechanical General Requirements."
 - 2. Division 20 Section "Basic Mechanical Materials and Methods."

1.02 DEFINITIONS

- A. ABS: Acrylonitrile-butadiene-styrene plastic.
- B. FOG: Fats, oils, and greases.
- C. FRP: Fiberglass-reinforced plastic.
- D. HDPE: High-density polyethylene plastic.
- E. PE: Polyethylene plastic.
- F. PP: Polypropylene plastic.
- G. PUR: Polyurethane plastic.

- H. PVC: Polyvinyl chloride plastic.

1.03 ACTION SUBMITTALS

- A. Product Data: For each type of product indicated. Include rated capacities, operating characteristics, and accessories.

1.04 CLOSEOUT SUBMITTALS

- A. Field quality-control test reports.
- B. Operation and Maintenance Data: For drainage piping specialties to include in operation and maintenance manuals.

1.05 QUALITY ASSURANCE

- A. Drainage piping specialties shall bear label, stamp, or other markings of specified testing agency.
- B. Electrical Components, Devices, and Accessories: Listed and labeled as defined in NFPA 70, Article 100, by an NRTL acceptable to authorities having jurisdiction, and marked for intended use.
- C. Comply with NSF 14, "Plastics Piping Components and Related Materials," for plastic sanitary and storm piping specialty components.
- D. Comply with ASPE/ANSI 45-2013 "Siphonic Roof Drainage" for siphonic roof drainage systems.

1.06 COORDINATION

- A. Coordinate size and location of concrete bases. Cast anchor-bolt inserts into bases. Concrete, reinforcement, and formwork requirements are specified in Division 03.
- B. Coordinate size and location of roof penetrations.

PART 2 PRODUCTS

2.01 CAST-IRON CLEANOUTS

- A. Size: Cleanouts shall be same nominal size as the pipe they serve up to 4 inches. For pipes larger than 4 inches nominal size, minimum size of cleanout shall be 4 inches.
- B. Exposed Cast-Iron Cleanouts:
 - 1. Manufacturers: Subject to compliance with requirements, provide products by one of the following:
 - a. Josam Company; Josam Div.; Series 58910.
 - b. MIFAB, Inc.; C1460.
 - c. Smith, Jay R. Mfg. Co.; Division of Smith Industries, Inc.; 4510 Series.
 - d. Tyler Pipe; Wade Div.
 - e. Watts Drainage Products Inc.
 - f. Zurn Plumbing Products Group; Specification Drainage Operation.
 - 2. Standard: ASME A112.36.2M for cast iron for cleanout test tee.
 - 3. Body Material: Hub-and-spigot, cast-iron soil pipe T-branch or hubless, cast-iron soil pipe test tee as required to match connected piping.
 - 4. Closure: Countersunk or raised-head, brass or bronze plug with tapered threads.
- C. Cast-Iron Floor Cleanouts (On-Grade Interior Floor Areas):

1. Manufacturers: Subject to compliance with requirements, provide products by one of the following:
 - a. Josam Company; Josam Div.
 - b. MIFAB, Inc.; C1220-R.
 - c. Sioux Chief Manufacturing Company, Inc.
 - d. Smith, Jay R. Mfg. Co.; Division of Smith Industries, Inc.; Model 4023S-F.
 - e. Tyler Pipe; Wade Div.
 - f. Watts Drainage Products Inc.
 - g. Zurn Plumbing Products Group; Specification Drainage Operation.
 2. Standard: ASME A112.36.2M.
 3. Type: Adjustable housing.
 4. Body or Ferrule: Cast iron.
 5. Clamping Device: Not required.
 6. Outlet Connection: Spigot.
 7. Closure: Brass, bronze, or plastic plug with tapered threads.
 8. Adjustable Housing Material: Cast iron with threads, set-screws or other device.
 9. Frame and Cover Material and Finish: Nickel-bronze, copper alloy with scoriated cover in service areas, and recessed cover to accept floor finish material in finished floor areas.
 10. Frame and Cover Shape: Round.
 11. Top Loading Classification: Medium Duty.
 12. Riser: ASTM A 74, Service class, cast-iron drainage pipe fitting and riser to cleanout.
- D. Cast-Iron Floor Cleanouts (Not-On-Grade Interior Floor Areas):
1. Manufacturers: Subject to compliance with requirements, provide products by one of the following:
 - a. Josam Company; Josam Div.
 - b. MIFAB, Inc.; C-1100-C-R-34.
 - c. Sioux Chief Manufacturing Company, Inc.
 - d. Smith, Jay R. Mfg. Co.; Division of Smith Industries, Inc.; Model 4333C.
 - e. Tyler Pipe; Wade Div.
 - f. Watts Drainage Products Inc.
 - g. Zurn Plumbing Products Group; Specification Drainage Operation.
 2. Standard: ASME A112.36.2M.
 3. Type: Adjustable housing.
 4. Body or Ferrule: Cast iron.
 5. Clamping Device: Required.
 6. Outlet Connection: Spigot.
 7. Closure: Brass, bronze, or plastic plug with tapered threads.
 8. Adjustable Housing Material: Cast iron with threads, set-screws or other device.

9. Frame and Cover Material and Finish: Nickel-bronze, copper alloy with scoriated cover in service areas, and recessed cover to accept floor finish material in finished floor areas.
 10. Frame and Cover Shape: Round.
 11. Top Loading Classification: Medium Duty.
 12. Riser: ASTM A 74, Service class, cast-iron drainage pipe fitting and riser to cleanout.
- E. Cast-Iron Wall Cleanouts (Finished Wall Areas):
1. Manufacturers: Subject to compliance with requirements, provide products by one of the following:
 - a. Josam Company; Josam Div.; Model 58790-20.
 - b. MIFAB, Inc.; C1460-RD.
 - c. Smith, Jay R. Mfg. Co.; Division of Smith Industries, Inc.
 - d. Tyler Pipe; Wade Div.
 - e. Watts Drainage Products Inc.
 - f. Zurn Plumbing Products Group; Specification Drainage Operation.
 2. Standard: ASME A112.36.2M. Include wall access.
 3. Body: Hub-and-spigot, cast-iron soil pipe T-branch or hubless, cast-iron soil pipe test tee as required to match connected piping.
 4. Closure: Countersunk or raised-head, drilled-and-threaded bronze or brass plug with tapered threads.
 5. Wall Access: Round, flat, chrome-plated brass or stainless-steel cover plate with screw.
 6. Wall Access: Round, nickel-bronze, copper-alloy, or stainless-steel wall-installation frame and cover.

2.02 FLOOR DRAINS

- A. Cast-Iron Floor Drains (Toilet Rooms, Labs, and Janitor's Closet) FD-1:
1. Manufacturers: Subject to compliance with requirements, provide products by one of the following:
 - a. Josam Company; Josam Div.
 - b. MIFAB, Inc.
 - c. Sioux Chief Manufacturing Company, Inc.; Finish Line Adjustable Drainage System.
 - d. Smith, Jay R. Mfg. Co.; Division of Smith Industries, Inc.; Model 2005Y-B.
 - e. Tyler Pipe; Wade Div.
 - f. Watts Drainage Products Inc.
 - g. Zurn Plumbing Products Group; Specification Drainage Operation.
 2. Standard: ASME A112.6.7.
 3. Pattern: Floor drain.
 4. Body Material: Gray iron.
 5. Seepage Flange: Required.
 6. Clamping Device: Required.
 7. Outlet: Bottom unless otherwise noted.

8. Coating on Interior and Exposed Exterior Surfaces: Enamel.
 9. Top or Strainer Material: Nickel bronze.
 10. Top of Body and Strainer Finish: Nickel bronze.
 11. Top Shape: Square, with vandal proof screws.
 12. Dimensions of Top or Strainer: 7 inch square.
 13. Top Loading Classification: Light Duty.
 14. Inlet Fitting: Gray iron, with spigot outlet.
 15. Trap-Seal Primer Valve Fitting:
 - a. Description: Cast iron, with spigot inlet and spigot outlet, and trap-seal primer valve connection.
 - b. Size: Same as floor drain outlet with NPS 1/2 side inlet.
- B. Cast-Iron Floor Drains (Showers) FD-2:
1. Manufacturers: Subject to compliance with requirements, provide products by one of the following:
 - a. Josam Company; Josam Div.
 - b. MIFAB, Inc.
 - c. Sioux Chief Manufacturing Company, Inc.; Finish Line Adjustable Drainage System.
 - d. Smith, Jay R. Mfg. Co.; Division of Smith Industries, Inc.; Model 2005Y-B.
 - e. Tyler Pipe; Wade Div.
 - f. Watts Drainage Products Inc.
 - g. Zurn Plumbing Products Group; Specification Drainage Operation.
 2. Standard: ASME A112.6.7.
 3. Pattern: Floor drain.
 4. Body Material: Gray iron.
 5. Seepage Flange: Required.
 6. Clamping Device: Required.
 7. Outlet: Bottom unless otherwise noted.
 8. Coating on Interior and Exposed Exterior Surfaces: Enamel.
 9. Top or Strainer Material: Nickel bronze.
 10. Top of Body and Strainer Finish: Nickel bronze.
 11. Top Shape: Square, with vandal proof screws.
 12. Dimensions of Top or Strainer: 5 inch square.
 13. Top Loading Classification: Light Duty.
 14. Inlet Fitting: Gray iron, with spigot outlet.
 15. Trap-Seal Primer Valve Fitting:
 - a. Description: Cast iron, with spigot inlet and spigot outlet, and trap-seal primer valve connection.
 - b. Size: Same as floor drain outlet with NPS 1/2 side inlet.
- C. Cast-Iron Floor Drains (Mechanical Rooms, Electrical Rooms, and Penthouses) FD-3:

1. Manufacturers: Subject to compliance with requirements, provide products by one of the following:
 - a. Josam Company; Josam Div.
 - b. MIFAB, Inc.
 - c. Smith, Jay R. Mfg. Co.; Division of Smith Industries, Inc.; Model 2142.
 - d. Tyler Pipe; Wade Div.
 - e. Watts Drainage Products Inc.
 - f. Zurn Plumbing Products Group; Specification Drainage Operation.
2. Standard: ASME A112.6.7.
3. Pattern: Floor drain.
4. Body Material: Gray iron.
5. Seepage Flange: Required.
6. Clamping Device: Required.
7. Outlet: Bottom unless otherwise noted.
8. Coating on Interior and Exposed Exterior Surfaces: Enamel.
9. Sediment Bucket: 3-3/4 inches deep, slotted sediment bucket with lift bar.
10. Top or Strainer Material: Cast-iron.
11. Top Shape: Round.
12. Dimensions of Top or Strainer: 11-1/2 inch diameter tractor grate, 29 square inches of free area. Provide partial grate where required to accept equipment drains.
13. Top Loading Classification: Heavy Duty.
14. Outlet Fitting: Gray iron, with spigot outlet.
15. Trap-Seal Primer Valve Fitting:
 - a. Description: Cast iron, with spigot inlet and spigot outlet, and trap-seal primer valve connection.
 - b. Size: Same as floor drain outlet with NPS 1/2 side inlet.

2.03 FLOOR SINKS

A. Stainless-Steel Floor Sink Drains FS-1:

1. Manufacturers: Subject to compliance with requirements, provide products by one of the following:
 - a. Josam Company; Josam Div.
 - b. MIFAB, Inc.
 - c. Smith, Jay R. Mfg. Co.; Division of Smith Industries, Inc.; Model 3006-12.
 - d. Tyler Pipe; Wade Div.
 - e. Zurn Plumbing Products Group; Specification Drainage Operation.
2. Standard: ASME A112.6.7.
3. Outlet: Bottom unless otherwise noted.
4. Top or Strainer Material: Stainless steel.
5. Top Shape: Square.

6. Dimensions of Top or Strainer: 12 inch by 12 inch, 14 gage, Type 304 stainless steel ribbed, non-tilt loose set half grate with 1/2 inch square holes and perforated stainless steel sediment bucket.
7. Seepage Flange: Required.
8. Clamping Device: Required.
9. Trap-Seal Primer Valve Fitting:
 - a. Description: Cast iron, with spigot inlet and spigot outlet, and trap-seal primer valve connection.
 - b. Size: Same as floor drain outlet with NPS 1/2 side inlet.

2.04 **AIR-ADMITTANCE VALVES**

A. Fixture Air-Admittance Valves:

1. Manufacturers: Subject to compliance with requirements, provide products by one of the following:
 - a. Ayrlett, LLC.
 - b. Durgo, Inc.
 - c. Oatey.
 - d. ProSet Systems Inc.
 - e. RectorSeal.
 - f. Studor, Inc.
2. Standard: ASSE 1051, Type A for single fixture or Type B for branch piping.
3. Housing: Plastic.
4. Operation: Mechanical sealing diaphragm.
5. Size: Same as connected fixture or branch vent piping.

2.05 **ROOF FLASHING ASSEMBLIES**

A. Roof Flashing Assemblies:

1. Manufacturers: Subject to compliance with requirements, provide products by one of the following:
 - a. Acorn Engineering Company; Elmdor/Stoneman Div.
 - b. Thaler Metal Industries Ltd.
- B. Description: Manufactured assembly consisting of metal flashing collar and skirt extending at least 6 inches from pipe, with boot reinforcement and counterflashing fitting.
 1. Open-Top Vent Cap: Without cap.
 2. Low-Silhouette Vent Cap: With vandal-proof vent cap.
 3. Extended Vent Cap: With field-installed, vandal-proof vent cap.

2.06 **TRAP SEAL PROTECTION DEVICES**

A. Barrier Type Trap Seal Protection Devices:

1. Manufacturers: Subject to compliance with requirements, provide products by one of the following:
 - a. Smith, Jay R. Mfg. Co.; Quad Close Trap Seal Device Fig. 2692.

- b. Rectorseal; a CSW Industrials Company; SureSeal Plus Inline Floor Drain Trap Sealer.
2. Standard: ASSE 1072-2007.
3. Sealing Element: Neoprene rubber or chemically resistant elastomer.
4. Size: 2 inch, 3 inch, 3-1/2 inch, or 4 inch.
5. Gravity Drain Outlet Connection: Compression fit sealing gasket 80 durometer.

2.07 ROOF DRAINS

A. Metal Roof Drains RD-1:

1. Manufacturers: Subject to compliance with requirements, provide products by one of the following:
 - a. Josam Company; Josam Div.
 - b. MIFAB, Inc.
 - c. Smith, Jay R. Mfg. Co.; Division of Smith Industries, Inc.; Model 1015/1074.
 - d. Tyler Pipe; Wade Div.
 - e. Watts Drainage Products Inc.
 - f. Zurn Plumbing Products Group; Specification Drainage Operation.
2. Standard: ASME A112.6.4
3. Pattern: Roof drain.
4. Body Material: Cast iron.
5. Dimensions of Body: Minimum 10 inch diameter body.
6. Combination Flashing Ring and Gravel Stop: Required.
7. Flow-Control Weirs: Not required.
8. Outlet: Bottom unless otherwise noted.
9. Dome Material: Cast iron, or ductile iron.
10. Extension Collars: Required.
11. Underdeck Clamp: Required.
12. Sump Receiver: Required.

B. Metal Secondary Roof Drains ORD-1:

1. Manufacturers: Subject to compliance with requirements, provide products by one of the following:
 - a. Josam Company; Josam Div.
 - b. MIFAB, Inc.
 - c. Smith, Jay R. Mfg. Co.; Division of Smith Industries, Inc.; Model 1015/1074.
 - d. Tyler Pipe; Wade Div.
 - e. Watts Drainage Products Inc.
 - f. Zurn Plumbing Products Group; Specification Drainage Operation.
2. Standard: ASME A112.6.4
3. Pattern: Roof drain.
4. Body Material: Cast iron.

5. Dimensions of Body: Minimum 10 inch diameter body.
6. Combination Flashing Ring and Gravel Stop: Required.
7. Flow-Control Weirs: Not required.
8. Outlet: Bottom unless otherwise noted.
9. Dome Material: Cast iron, or ductile iron.
10. Extension Collars: Required.
11. Underdeck Clamp: Required.
12. Sump Receiver: Required.
13. Standpipe: Cast iron. 2 inches high where overflow drains are indicated.

2.08 MISCELLANEOUS DRAINAGE PIPING SPECIALTIES

A. Hub Outlets:

1. Description: Shop or field fabricate from ASTM A 74, Service class, hub-and-spigot, cast-iron, soil-pipe fittings. Include P-trap, hub-and-spigot riser section; and where required, increaser fitting joined with ASTM C 564, rubber gaskets.
2. Size: Same as connected waste piping.

B. Deep-Seal Traps:

1. Description: Cast-iron or bronze casting, with inlet and outlet matching connected piping and cleanout trap-seal primer valve connection.
2. Size: Same as connected waste piping.
 - a. NPS 2: 4-inch- minimum water seal.
 - b. NPS 2-1/2 and Larger: 5-inch- minimum water seal.

C. Air-Gap Fittings:

1. Standard: ASME A112.1.2, for fitting designed to ensure fixed, positive air gap between installed inlet and outlet piping.
2. Body: Bronze or cast iron.
3. Inlet: Opening in top of body.
4. Outlet: Larger than inlet.
5. Size: Same as connected waste piping and with inlet large enough for associated indirect waste piping.

D. Sleeve Flashing Device:

1. Description: Manufactured, cast-iron fitting, with clamping device, that forms sleeve for pipe floor penetrations of floor membrane. Include galvanized-steel pipe extension in top of fitting that will extend 1 inch above finished floor and galvanized-steel pipe extension in bottom of fitting that will extend through floor slab.
2. Size: As required for close fit to riser or stack piping.

E. Stack Flashing Fittings:

1. Description: Counterflashing-type, cast-iron fitting, with bottom recess for terminating roof membrane, and with threaded or hub top for extending vent pipe.
2. Size: Same as connected stack vent or vent stack.

F. Vent Caps:

1. Description: Cast-iron body with threaded or hub inlet and vandal-proof design. Include vented hood and setscrews to secure to vent pipe.
2. Size: Same as connected stack vent or vent stack.

G. Expansion Joints:

1. Standard: ASME A112.21.2M.
2. Body: Cast iron with bronze sleeve, packing, and gland.
3. End Connections: Matching connected piping.
4. Size: Same as connected soil, waste, or vent piping.

H. Conductor Nozzles DNZ-1:

1. Manufacturers: Subject to compliance with requirements, provide products by one of the following:
 - a. Josam Company; Josam Div.
 - b. MIFAB, Inc.
 - c. Smith, Jay R. Mfg. Co.; Division of Smith Industries, Inc.; Model 1770-NB-BS.
 - d. Tyler Pipe; Wade Div.
 - e. Watts Drainage Products Inc.; RD-940-83.
 - f. Zurn Plumbing Products Group; Specification Drainage Operation.
2. Description: Bronze body with threaded inlet, bronze wall flange with mounting holes, and bird screen.
3. Size: Same as connected conductor.

2.09 **FLASHING MATERIALS**

- A. Lead Sheet: ASTM B 749, Type L51121, copper bearing, with the following minimum weights and thicknesses, unless otherwise indicated:
 1. General Use: 4.0-lb/sq. ft., 0.0625-inch thickness.
 2. Vent Pipe Flashing: 3.0-lb/sq. ft., 0.0469-inch thickness.
 3. Burning: 6-lb/sq. ft., 0.0938-inch thickness.
- B. Copper Sheet: ASTM B 152/B 152M, of the following minimum weights and thicknesses, unless otherwise indicated:
 1. General Applications: 12 oz./sq. ft.
 2. Vent Pipe Flashing: 8 oz./sq. ft.
- C. Zinc-Coated Steel Sheet: ASTM A 653/A 653M, with 0.20 percent copper content and 0.04-inch minimum thickness, unless otherwise indicated. Include G90 hot-dip galvanized, mill-phosphatized finish for painting if indicated.
- D. Elastic Membrane Sheet: ASTM D 4068, flexible, chlorinated polyethylene, 40-mil minimum thickness.
- E. Fasteners: Metal compatible with material and substrate being fastened.
- F. Metal Accessories: Sheet metal strips, clamps, anchoring devices, and similar accessory units required for installation; matching or compatible with material being installed.
- G. Solder: ASTM B 32, lead-free alloy.

- H. Bituminous Coating: SSPC-Paint 12, solvent-type, bituminous mastic.

2.10 GREASE INTERCEPTORS

A. Grease Interceptors:

1. Manufacturers: Subject to compliance with requirements, provide products by one of the following:
 - a. ~~Josam Company; Josam Div.~~
 - b. Lowe Engineering; a div. of Highland Tank & Manufacturing Co., Inc.
 - c. MIFAB, Inc.
 - d. ~~Schier Products Company.~~
 - e. Smith, Jay R. Mfg. Co.; Division of Smith Industries, Inc.
 - f. Tyler Pipe; Wade Div.
 - g. ~~Watts Drainage Products Inc.~~
 - h. ~~Zurn Plumbing Products Group.~~ ****ADD2****
2. Standard: ASME A112.14.3, for intercepting and retaining fats, oils, and greases from food-preparation or -processing wastewater.
3. Plumbing and Drainage Institute Seal: Required.
4. Body Material: Stainless steel.
5. Interior Lining: Corrosion-resistant enamel for cast iron or steel bodies. Not required for polypropylene bodies.
6. Exterior Coating: Corrosion-resistant enamel for cast iron or steel bodies. Not required for polypropylene bodies.
7. Body Extension: As required.
8. Size and Capacities: As indicated on the drawings.
9. Cleanout: Integral or field installed on outlet. Mounting: Recessed, flush with floor.
11. Flow-Control Fitting: Required.
12. Operation: Manual cleaning.

2.11 SOLIDS INTERCEPTORS

A. Solids Interceptors:

1. Manufacturers: Subject to compliance with requirements, provide products by one of the following:
 - a. Josam Company; Josam Div.
 - b. MIFAB, Inc.
 - c. Smith, Jay R. Mfg. Co.; Division of Smith Industries, Inc.
 - d. Striem.
 - e. Tyler Pipe; Wade Div.
 - f. Watts Drainage Products Inc.
 - g. Zurn Plumbing Products Group; Specification Drainage Operation.
2. Type: Factory-fabricated interceptor made for removing and retaining sediment from wastewater.

3. Body Material: Cast iron, steel, or polypropylene.
4. Interior Separation Device: Screens.
5. Interior Lining: Corrosion-resistant enamel for cast iron or steel bodies. Not required for polypropylene bodies.
6. Exterior Coating: Corrosion-resistant enamel for cast iron or steel bodies. Not required for polypropylene bodies.
7. Size and Capacities: As indicated on the drawings.
8. Mounting: Above floor.

PART 3 EXECUTION

3.01 CONCRETE BASES

- A. Anchor interceptors to concrete bases.
 1. Install dowel rods to connect concrete base to concrete floor. Unless otherwise indicated, install dowel rods on 19-inch centers around full perimeter of base.
 2. For installed equipment, install epoxy-coated anchor bolts that extend through concrete base and anchor into structural concrete floor.
 3. Place and secure anchorage devices. Use setting drawings, templates, diagrams, instructions, and directions furnished with items to be imbedded.
 4. Install anchor bolts to elevations required for proper attachment to supported equipment.
 5. Concrete base construction requirements are specified in Division 20 Section "Basic Mechanical Materials and Methods."
 6. Cast-in-place concrete materials and placement requirements are specified in Division 03.

3.02 INSTALLATION

- A. Refer to Division 20 Section "Basic Mechanical Materials and Methods" for piping joining materials, joint construction, and basic installation requirements.
- B. Install cleanouts in aboveground piping and building drain piping according to the following, unless otherwise indicated:
 1. Size same as drainage piping up to NPS 4. Use NPS 4 for larger drainage piping unless larger cleanout is indicated.
 2. Locate at each change in direction of piping greater than 45 degrees.
 3. Locate at minimum intervals of 50 feet for piping NPS 4 and smaller and 100 feet for larger piping.
 4. Locate at base of each vertical soil and waste stack.
- C. For floor cleanouts for piping below floors, install cleanout deck plates with top flush with finished floor.
- D. For cleanouts located in concealed piping, install cleanout wall access covers, of types indicated, with frame and cover flush with finished wall.
- E. Install floor drains at low points of surface areas to be drained. Set grates of drains flush with finished floor, unless otherwise indicated.
 1. Position floor drains for easy access and maintenance.
 2. Set floor drains below elevation of surrounding finished floor to allow floor drainage. Set with grates depressed according to the following drainage area radii:

- a. Radius, 30 Inches or Less: Equivalent to 1 percent slope, but not less than 1/4-inch total depression.
 - b. Radius, 30 to 60 Inches: Equivalent to 1 percent slope.
 - c. Radius, 60 Inches or Larger: Equivalent to 1 percent slope, but not greater than 1-inch total depression.
3. Install floor-drain flashing collar or flange so no leakage occurs between drain and adjoining flooring. Maintain integrity of waterproof membranes where penetrated.
 4. Install individual traps for floor drains connected to sanitary building drain, unless otherwise indicated.
- F. Install fixture air-admittance valves on fixture drain piping.
- G. Install flashing fittings on sanitary stack vents and vent stacks that extend through roof.
- H. Install roof drains at low points of roof areas according to roof membrane manufacturer's written installation instructions. Roofing materials are specified in Division 07.
1. Install roof-drain flashing collar or flange so that there will be no leakage between drain and adjoining roofing. Maintain integrity of waterproof membranes where penetrated.
 2. Position roof drains for easy access and maintenance.
- I. Assemble open drain fittings and install with top of hub 2 inches above floor.
- J. Install deep-seal traps on floor drains and other waste outlets, if indicated.
- K. Install floor-drain, trap-seal primer fittings on floor drains that require trap-seal primer connection.
- L. Install air-gap fittings on draining-type backflow preventers and on indirect-waste piping discharge into sanitary drainage system.
- M. Install sleeve flashing device with each riser and stack passing through floors with waterproof membrane.
- N. Install vent caps on each vent pipe passing through roof.
- O. Install expansion joints on vertical stacks and conductors. Position expansion joints for easy access and maintenance.
- P. Install conductor nozzles at exposed bottom of conductors where they spill onto grade.
- Q. Install grease interceptors, including trapping, venting, and flow-control fitting, according to authorities having jurisdiction and with clear space for servicing.
1. Recessed Floor Installation: Set unit in receiver housing having bottom or cradle supports, with receiver housing cover flush with finished floor.
 2. Install cleanout immediately downstream from interceptors not having integral cleanout on outlet.
- R. Install grease removal devices on floor. Install trap, vent, and flow-control fitting according to authorities having jurisdiction. Install control panel adjacent to unit, unless otherwise indicated.
- S. Install solids interceptors with cleanout immediately downstream from interceptors that do not have integral cleanout on outlet. Install trap on interceptors that do not have integral trap and are connected to sanitary drainage and vent systems.
- T. Install wood-blocking reinforcement for wall-mounting-type specialties.

- U. Install traps on plumbing specialty drain outlets. Omit traps on indirect wastes unless trap is indicated.
- V. Install escutcheons at wall, floor, and ceiling penetrations in exposed finished locations and within cabinets and millwork. Use deep-pattern escutcheons if required to conceal protruding pipe fittings.
- W. Install through-penetration firestop assemblies for penetrations of fire- and smoke-rated assemblies.
 - 1. Comply with requirements in Division 07 Section "Penetration Firestopping."

3.03 CONNECTIONS

- A. Piping installation requirements are specified in other Division 20 and 22 Sections. Drawings indicate general arrangement of piping, fittings, and specialties.
- B. Install piping adjacent to equipment to allow service and maintenance.
- C. Grease Interceptors: Connect inlet and outlet to unit, and connect flow-control fitting and vent to unit inlet piping. Install valve on outlet of automatic drawoff-type unit.

3.04 FLASHING INSTALLATION

- A. Fabricate flashing from single piece unless large pans, sumps, or other drainage shapes are required. Join flashing according to the following if required:
 - 1. Lead Sheets: Burn joints of lead sheets 6.0-lb/sq. ft., 0.0938-inch thickness or thicker. Solder joints of lead sheets 4.0-lb/sq. ft., 0.0625-inch thickness or thinner.
 - 2. Copper Sheets: Solder joints of copper sheets.
- B. Install sheet flashing on pipes, sleeves, and specialties passing through or embedded in floors and roofs with waterproof membrane.
 - 1. Pipe Flashing: Sleeve type, matching pipe size, with minimum length of 10 inches, and skirt or flange extending at least 8 inches around pipe.
 - 2. Sleeve Flashing: Flat sheet, with skirt or flange extending at least 8 inches around sleeve.
 - 3. Embedded Specialty Flashing: Flat sheet, with skirt or flange extending at least 8 inches around specialty.
- C. Set flashing on floors and roofs in solid coating of bituminous cement.
- D. Secure flashing into sleeve and specialty clamping ring or device.
- E. Install flashing for piping passing through roofs with counterflashing or commercially made flashing fittings, according to Division 07 Section "Sheet Metal Flashing and Trim."
- F. Extend flashing up vent pipe passing through roofs and turn down into pipe, or secure flashing into cast-iron sleeve having calking recess.
- G. Fabricate and install flashing and pans, sumps, and other drainage shapes.

3.05 LABELING AND IDENTIFYING

- A. Equipment Nameplates and Signs: Install engraved plastic-laminate equipment nameplate or sign on or near each of the following:
 - 1. Solids interceptors.
 - 2. Grease interceptors.
- B. Distinguish among multiple units, inform operator of operational requirements, indicate safety and emergency precautions, and warn of hazards and improper operations, in addition to identifying unit. Nameplates and signs are specified in Division 20 Section "Mechanical Identification."

3.06 FIELD QUALITY CONTROL

- A. Perform tests and inspections and prepare test reports.
 - 1. Manufacturer's Field Service: Engage a factory-authorized service representative to inspect field-assembled grease removal devices and their installation, including piping and electrical connections, and to assist in testing.
- B. Tests and Inspections:
 - 1. Leak Test: After installation, charge system and test for leaks. Repair leaks and retest until no leaks exist.
 - 2. Test and adjust controls and safeties. Replace damaged and malfunctioning controls and equipment.

3.07 PROTECTION

- A. Protect drains during remainder of construction period to avoid clogging with dirt or debris and to prevent damage from traffic or construction work.
- B. Place plugs in ends of uncompleted piping at end of each day or when work stops.

3.08 DEMONSTRATION

- A. Engage a factory-authorized service representative to train Owner's maintenance personnel to adjust, operate, and maintain grease removal devices.

END OF SECTION

TMP Architecture, Inc.
Peter Basso Associates, Inc.

TMP22102
PBA2023.0154.00



TMP ARCHITECTURE INC

191 WEST SQUARE LAKE ROAD
BLOOMFIELD HILLS - MICHIGAN - 48303
PH - 248.338.4545 FX - 248.338.0333
EM - INFO@TMP-ARCHITECTURE.COM

REGISTRATION SEAL

CONSULTANT



1 844.813.2949
www.peagroup.com

PROJECT TITLE

**New Smith Middle School
Bid Package No. 03C**

Troy School District
Troy, Michigan

DRAWING TITLE
**DEMOLITION AND
SESC PLAN - PHASE 2**

ISSUE DATES

DATE ISSUED FOR:

DRAWN JW

CHECKED TD


APPROVED TD

PROJECT NO.

22102

DRAWING NO.

C-2.1

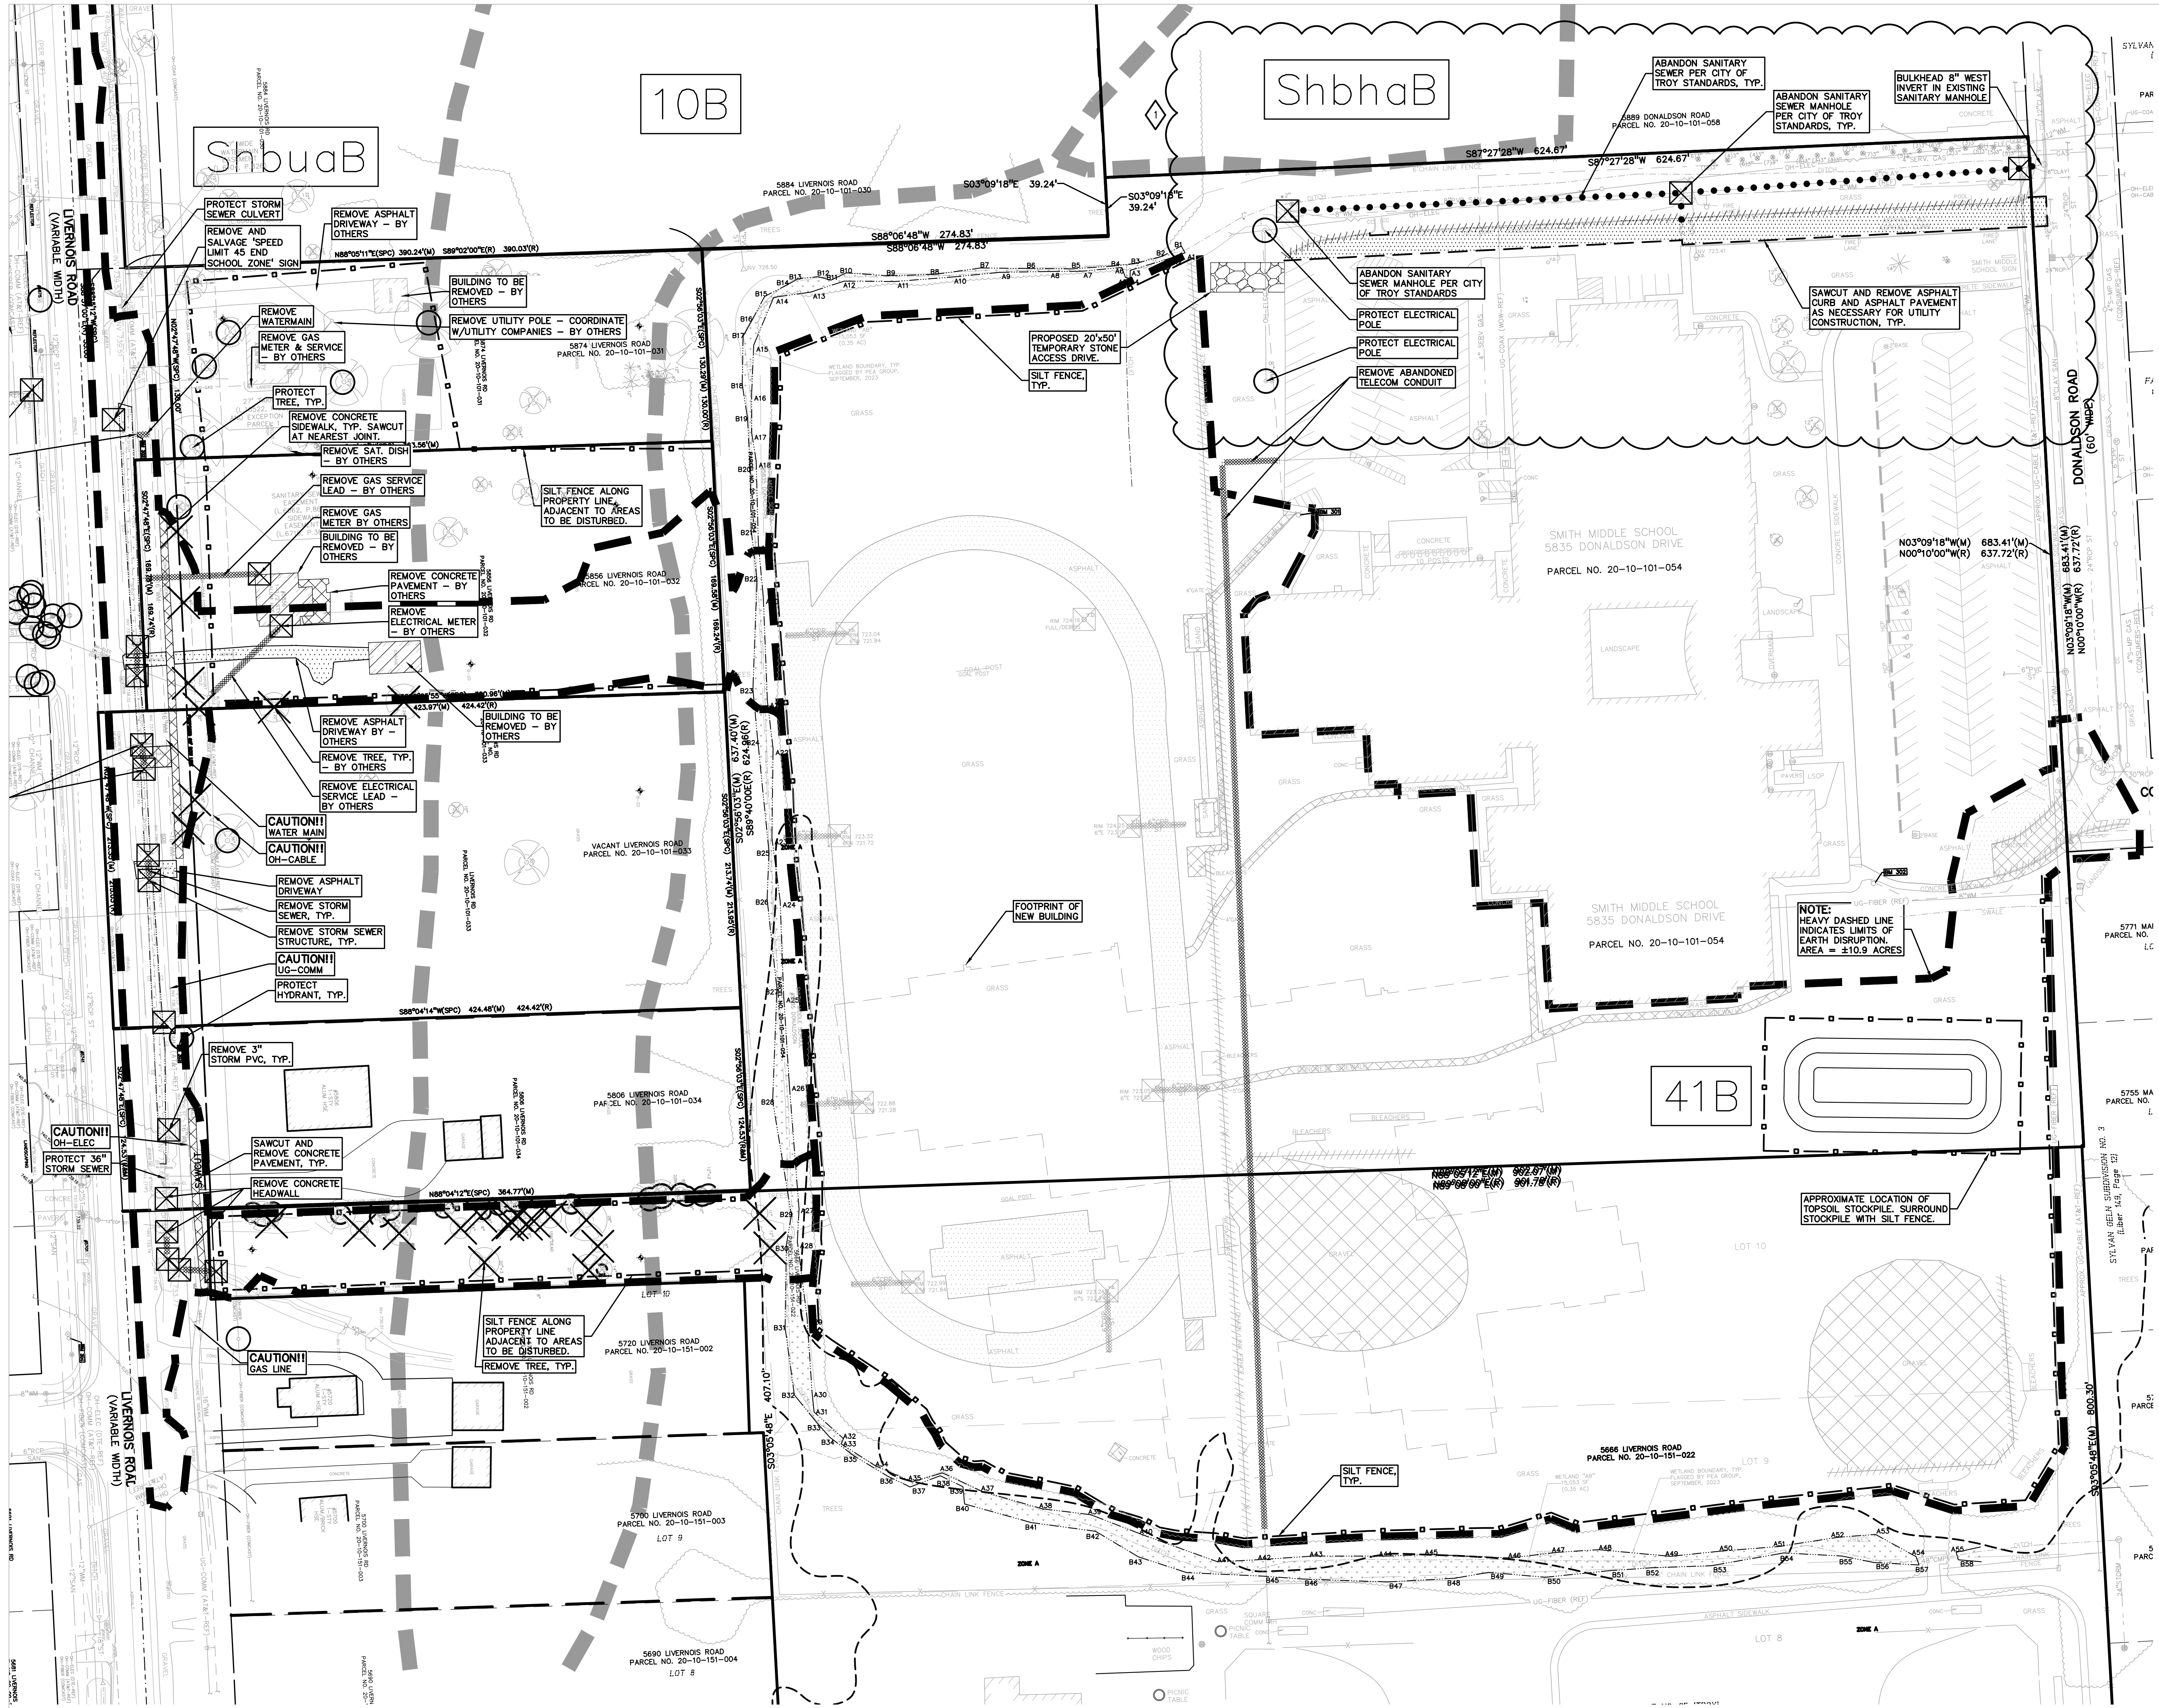

FLOODPLAIN:
PER FLOOD INSURANCE RATE MAP NUMBER 26125C0327, DATED SEPTEMBER 29, 2006
BY GRAPHICAL PLOTTING, THE SITE LIES WITHIN:
SPECIAL FLOOD HAZARD AREAS SUBJECT TO INUNDATION BY THE 1% ANNUAL CHANCE FLOOD
THE 1% ANNUAL CHANCE FLOOD (100 YEAR FLOOD), ALSO KNOWN AS THE BASE FLOOD, IS THE FLOOD THAT HAS A 1% CHANCE OF BEING EQUALED OR EXCEEDED IN ANY GIVEN YEAR. THE SPECIAL FLOOD HAZARD AREA IS THE AREA SUBJECT TO FLOODING BY THE 1% ANNUAL CHANCE FLOOD. AREAS OF SPECIAL FLOOD HAZARD INCLUDE ZONES A, AE, AH, AO, AR, A99, V AND VE. THE BASE FLOOD ELEVATION IS THE WATER-SURFACE ELEVATION OF THE 1% ANNUAL CHANCE FLOOD.
OTHER AREAS
ZONE X
AREA TO BE DETERMINED OUTSIDE OF THE 0.2% ANNUAL CHANCE FLOODPLAIN.

LEGAL DESCRIPTION:
PARCEL ID 20-10-101-024
Land in the City of Troy, Oakland County, Michigan, described as follows:
T2N, R11E, SEC 10 PART OF NW 1/4 BEG AT PT DIST S 571.05 FT & S 89.57 FT & S 87.50 FT & S 80.10-00 FT & 189.24 FT FROM NW SEC COR, TH S 89-40-00 E 624.96 FT, TH S 00-10-00 E 608.20 FT, TH N 89-08-00 W 901.78 FT, TH N 00-10-00 W 637.72 FT, TH S 89-02-00 E 275.00 FT, TH N 00-10-00 W 39.24 FT TO BEG 13.79 A.
PARCEL ID 20-10-101-022
Land in the City of Troy, Oakland County, Michigan, described as follows:
T2N, R11E, SEC 10 SUPERVISOR'S PLAT NO 25 LOTS 5, 6 & 7, ALSO E 900 FT OF LOTS 8 & 9, ALSO LOT 10 BEG W 397.62 FT OF S 194.29 FT


BENCHMARKS:
(GPS DERIVED - NAVD83)
BM #301
ASYRON ON A HYDRANT LOCATED AT THE SOUTHWEST CORNER OF THE FRONT PARKING LOT.
ELEV. = 724.13
BM #301
ASYRON ON A HYDRANT LOCATED ON THE SOUTHWEST CORNER OF THE BACK PARKING LOT.
ELEV. = 728.34

GENERAL DEMOLITION NOTES:
REFER TO SHEET C-2.0 FOR GENERAL DEMOLITION NOTES.


SEQUENCE OF CONSTRUCTION:
REFER TO SHEET C-2.0 FOR SEQUENCE OF CONSTRUCTION.

SOIL EROSION AND SEDIMENTATION CONTROL SEQUENCE OF CONSTRUCTION:
REFER TO SHEET C-2.0 FOR SOIL EROSION AND SEDIMENTATION CONTROL SEQUENCE OF CONSTRUCTION.


SOIL EROSION MAINTENANCE SCHEDULE AND NOTES:
REFER TO SHEET C-2.0 FOR SOIL EROSION MAINTENANCE SCHEDULE AND NOTES.

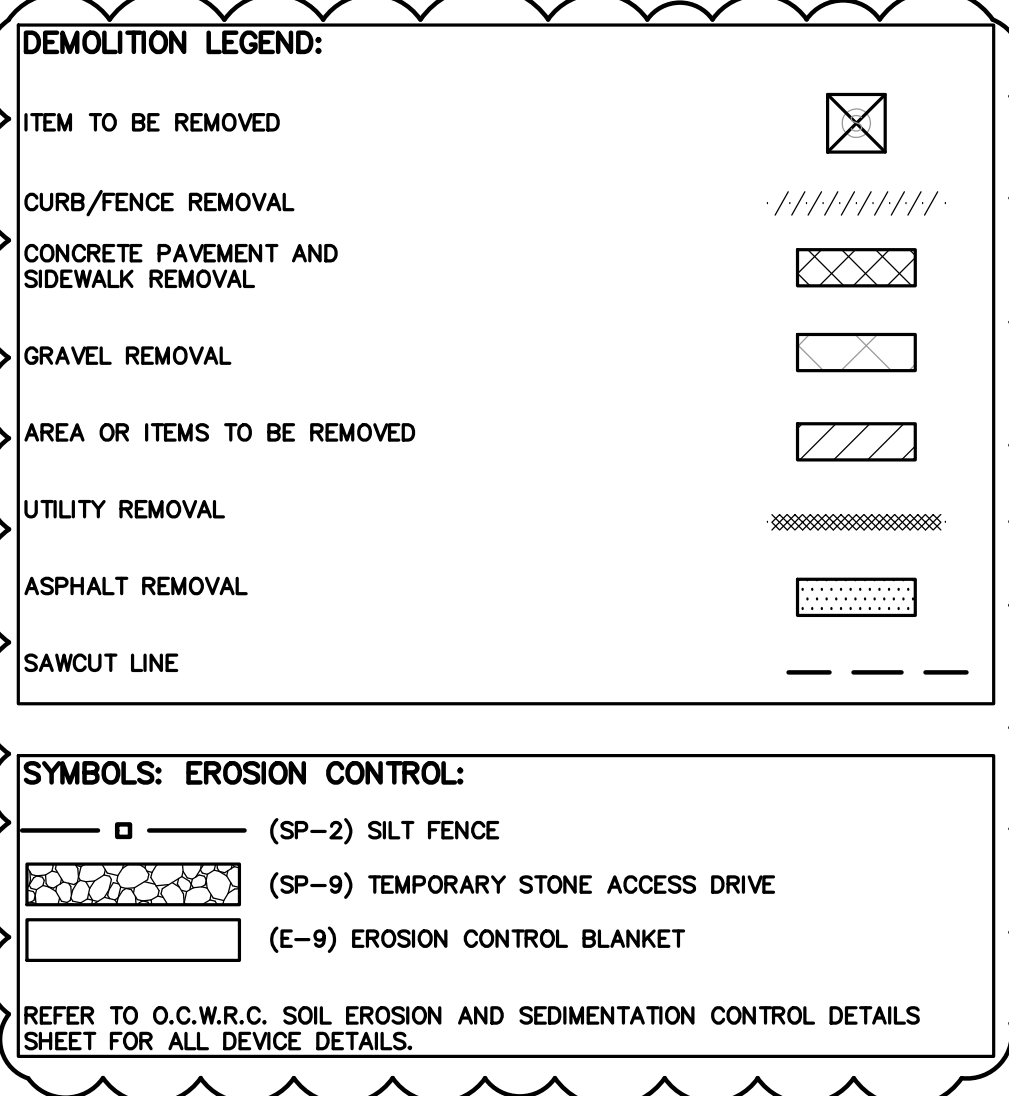

EROSION CONTROL QUANTITIES:
SILT FENCE 3,875 LF
TEMPORARY CONSTRUCTION ACCESS DRIVE 1 EA.

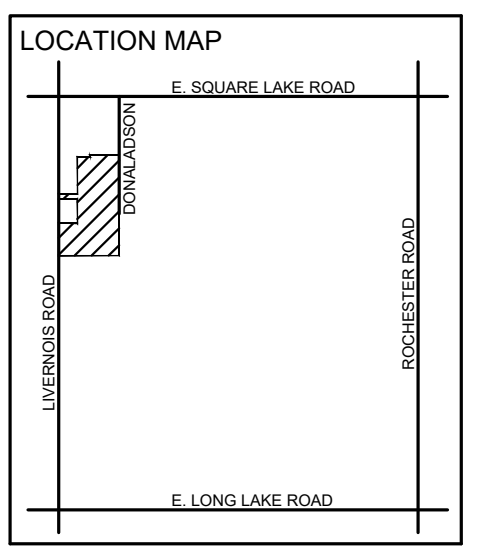

GENERAL SITE CONDITIONS:
1. ACCORDING TO THE SOIL SURVEY INFORMATION SUPPLIED BY THE USDA NRCS, THE SITE CONSISTS OF THE FOLLOWING SOIL TYPES:
• 10B MARLETTE SANDY LOAM, 1 TO 6 PERCENT SLOPES
• 41B AQUEOUS SANDY LOAMY UNULATIVE
• ShbuaB SHEBEON SANDY LOAM, 0 TO 4 PERCENT SLOPES
• ShbuaB SHEBEON-URBAN LAND COMPLEX, 0 TO 4 PERCENT SLOPES
2. TOTAL DISTURBED AREA = ±10.9 ACRES
3. N.P.D.E.S. NOTICE OF COVERAGE IS REQUIRED
4. THE NEAREST LAKE/STREAM/WETLAND IS THE ON-SITE WETLAND THAT STARTS NORTH OF THE PROPOSED CONSTRUCTION, RUNS THROUGH THE MIDDLE OF THE SITE AND THEN ALONG THE SOUTHERN BOUNDARY. CONSEQUENTLY, THE DISTANCE TO THE NEAREST LAKE/STREAM/WETLAND IS 0 FEET.

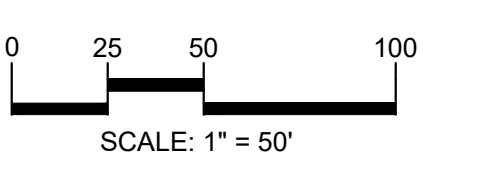

811 Know what's below. Call before you dig.
CAUTION!
THE LOCATION AND DEPTH OF UTILITIES IS NOT GUARANTEED. ANY UTILITIES NOT SHOWN ON THIS DRAWING ARE ONLY APPROXIMATIONS. NO QUANTITIES OR OTHER INFORMATION IS INTENDED TO BE RELIED UPON. THE CONTRACTOR SHALL BE SOLELY RESPONSIBLE FOR OBTAINING THE TRACING UTILITIES AND TELEPHONE PRIOR TO THE START OF CONSTRUCTION.

Drawing File: S:\PROJECTS\2024\22102\22102_C-2.1_CONSTRUCTION\22102_C-2.1_CONSTRUCTION.dwg, User: SMITH, Middle: [C-2.1], Date: 24-03-2024, App: AutoCAD 2024

REGISTRATION SEAL

CONSULTANT



PROJECT TITLE
**New Smith Middle School
Bld Package No. 03C**

**Troy School District
Troy, Michigan**

DRAWING TITLE
**OVERALL DIMENSION &
PAVING PLAN**

ISSUE DATES

DATE	ISSUED FOR:
07-12-2024	ADDENDUM NO. 2
06-18-2024	CONSTRUCTION DOCUMENTS

DATE	ISSUED FOR:
DRAWN	JW
CHECKED	TD
APPROVED	TD

PROJECT NO.
22102
DRAWING NO.
C-3.0



LEGEND:

[Pattern]	CONCRETE PAVEMENT
[Pattern]	ASPHALT PAVEMENT
[Pattern]	GRAVEL
[Symbol]	WETLAND
[Symbol]	CONCRETE CURB AND GUTTER
[Symbol]	REVERSE GUTTER PAN
[Symbol]	SETBACK LINE
[Symbol]	SIGN
[Symbol]	LIGHTPOLE
[Symbol]	FENCE
[Symbol]	GUARD RAIL

GENERAL NOTES:
THESE NOTES APPLY TO ALL CONSTRUCTION ACTIVITIES ON THIS PROJECT.


1. ALL DIMENSIONS SHOWN ARE TO BACK OF CURB, FACE OF SIDEWALK, OUTSIDE FACE OF BUILDING, PROPERTY LINE, CENTER OF MANHOLE/CATCH BASIN OR CENTERLINE OF PIPE UNLESS OTHERWISE NOTED.
2. "NO PARKING FIRE LANE" SIGNS SHALL BE POSTED ALONG ALL FIRE LANES AT XXX FOOT INTERVALS OR AS DIRECTED BY THE FIRE OFFICIAL.
3. REFER TO NOTES & DETAILS SHEET FOR ON-SITE PAVING DETAILS.
4. REFER TO NOTES & DETAILS SHEET FOR ON-SITE SIDEWALK RAMP DETAILS.

PARKING:
EXISTING PARKING SPACES: 168 SPACES (INCLUDING 5 ADA SPACES)
PROPOSED PARKING SPACES: 131 SPACES

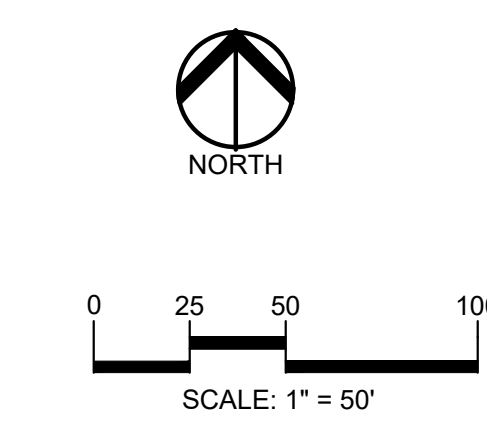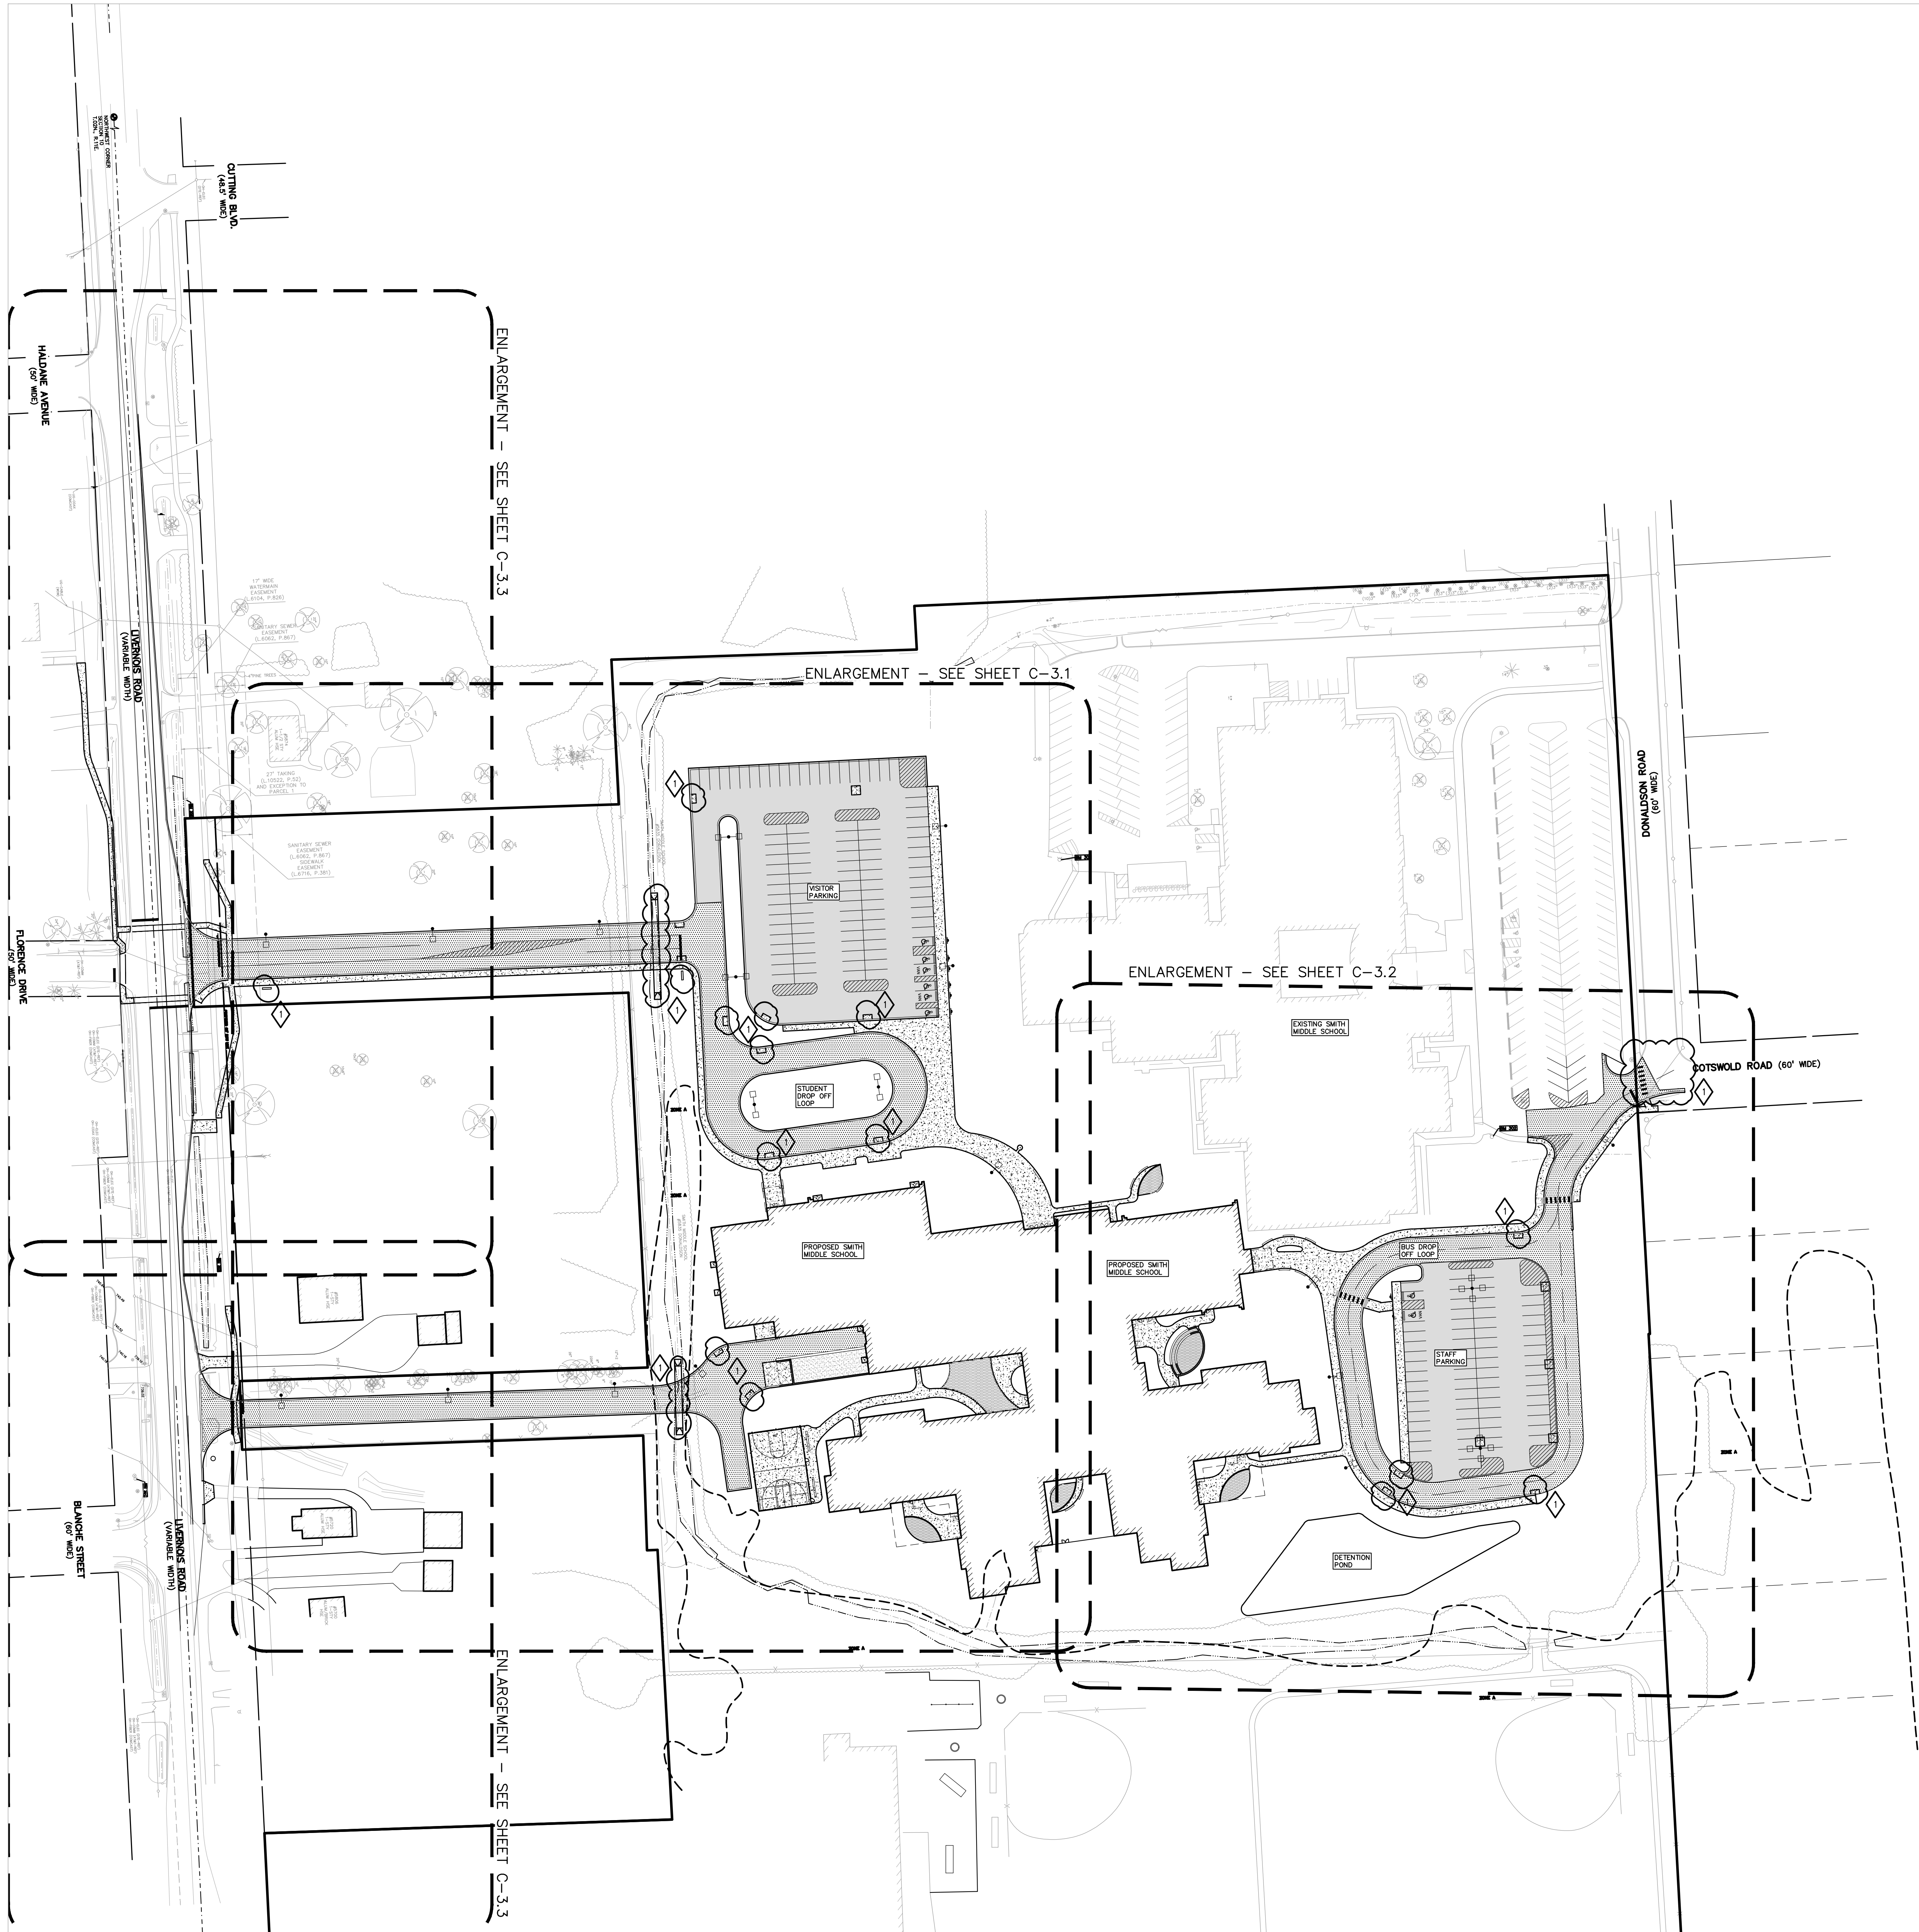

CAUTION!
THE LOCATION AND DEPTH OF EXISTING UNDERGROUND UTILITIES AND RECORDS ON THIS DRAWING ARE ONLY APPROXIMATE. NO GUARANTEE IS EXTENDED OR IMPLIED BY THE CONSULTANT AS TO THE ACCURACY OF THESE UTILITIES. THE CONTRACTOR SHALL BE EXCLUSIVELY RESPONSIBLE FOR DETERMINING THE EXACT LOCATION AND DEPTHS PRIOR TO THE START OF CONSTRUCTION.

Drawing File: S:\PROJECTS\2024\22102\22102-03C\22102-03C-TMP-ARCHITECTURE\DWG\C-3.03-03C-03C-TMP-ARCHITECTURE.dwg
 Date: 11/15/2024 4:16:58pm

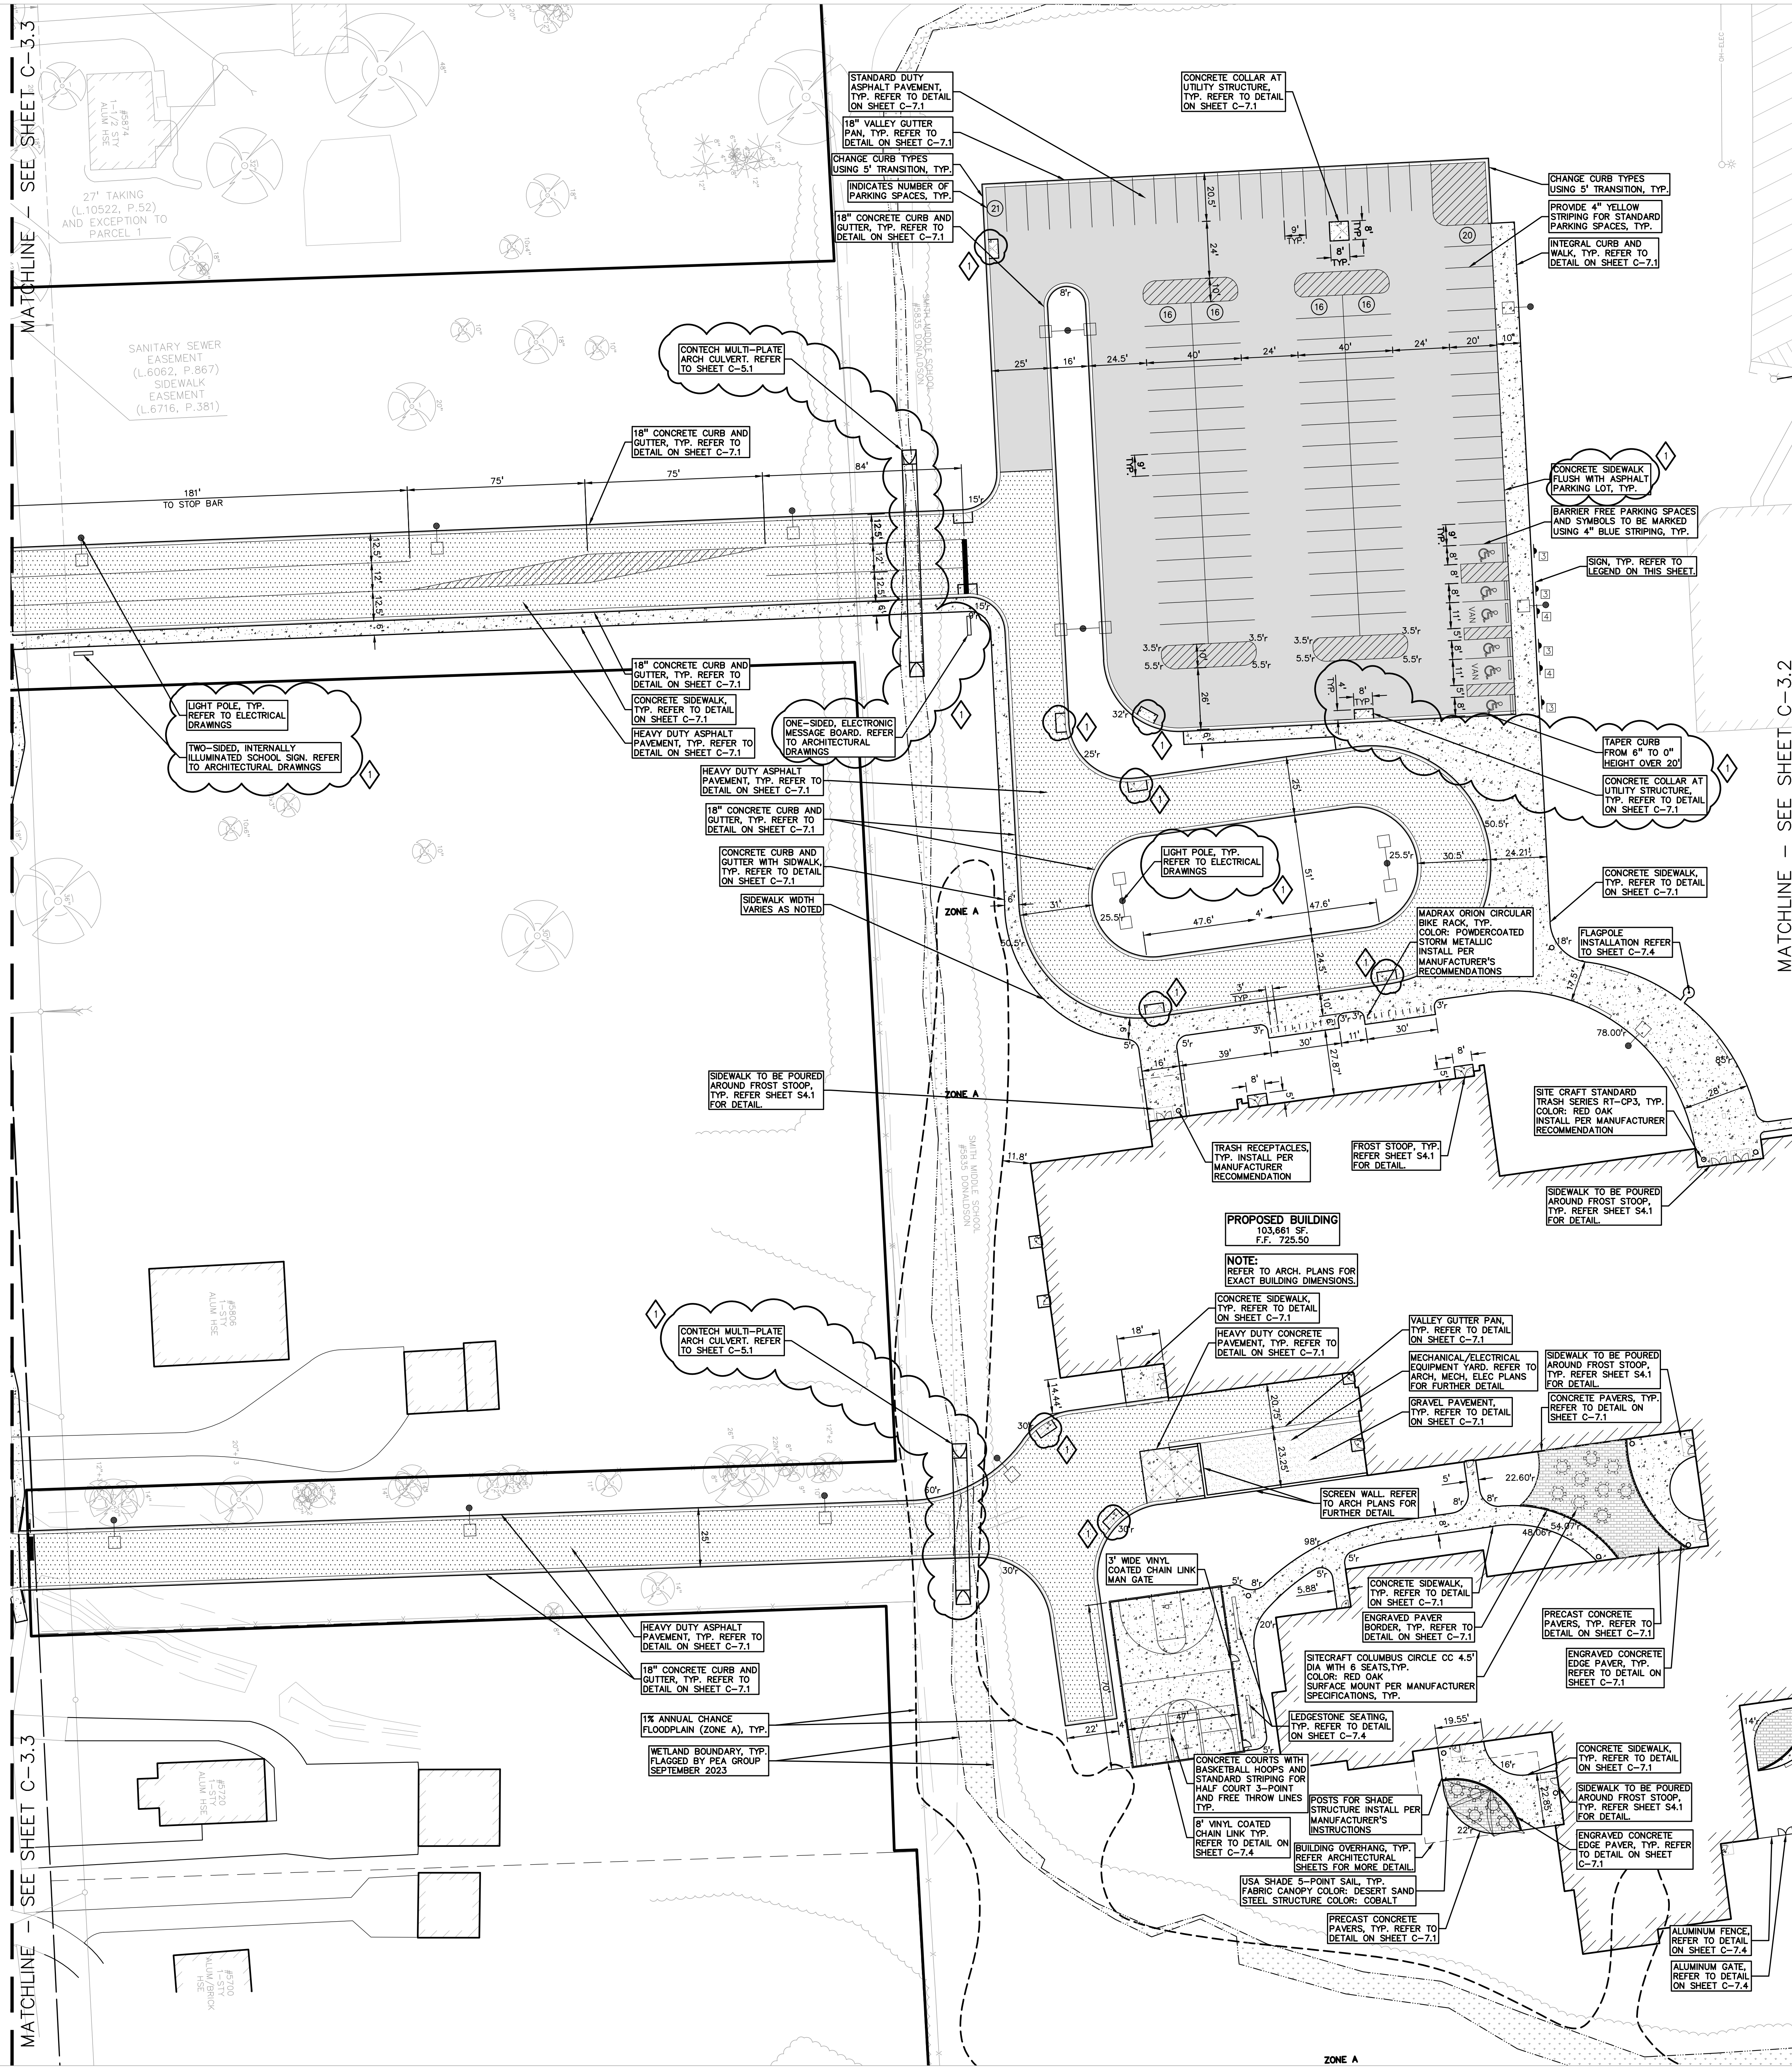

LEGEND:

- CONCRETE PAVEMENT
- ASPHALT PAVEMENT
- GRAVEL
- WETLAND
- CONCRETE CURB AND GUTTER
- REVERSE GUTTER PAN
- SETBACK LINE
- SIGN LIGHTPOLE
- GUARD RAIL

GENERAL NOTES:

THESE NOTES APPLY TO ALL CONSTRUCTION ACTIVITIES ON THIS PROJECT.

- ALL DIMENSIONS SHOWN ARE TO BACK OF CURB, FACE OF SIDEWALK, OUTSIDE FACE OF BUILDING, PROPERTY LINE, CENTER OF MANHOLE/CATCH BASIN OR CENTERLINE OF PIPE UNLESS OTHERWISE NOTED.
- NO PARKING FIRE LANE SIGNS SHALL BE POSTED ALONG ALL FIRE LANES AT XXX FOOT INTERVALS OR AS DIRECTED BY THE FIRE OFFICIAL.
- REFER TO NOTES & DETAILS SHEET FOR ON-SITE PAVING DETAILS.
- REFER TO NOTES & DETAILS SHEET FOR ON-SITE SIDEWALK RAMP DETAILS.

PARKING:

EXISTING PARKING SPACES: 168 SPACES (INCLUDING 5 ADA SPACES)
 PROPOSED PARKING SPACES: 154 SPACES (INCLUDING 8 ADA SPACES)

SIDEWALK RAMP LEGEND:

- SIDEWALK RAMP 'TYPE R'
- SIDEWALK RAMP 'TYPE F'
- SIDEWALK RAMP 'TYPE P'
- SIDEWALK RAMP 'TYPE C'
- SIDEWALK RAMP 'TYPE D'
- CURB DROP ONLY

REFER TO LATEST MDOT R-28 STANDARD RAMP AND DETECTABLE WARNING DETAILS
 NOTE: DETECTABLE WARNING SURFACE TO BE YELLOW FOR ALL RAMPS.

SIGN LEGEND:

- 'NO PARKING FIRE LANE' SIGN
- 'STOP' SIGN
- 'BARRIER FREE PARKING' SIGN
- 'VAN ACCESSIBLE' SIGN
- 'CROSSWALK' SIGN
- 'DO NOT ENTER' SIGN
- 'SIDEWALK ENDS' SIGN
- 'NO PARKING LOADING ZONE' SIGN

REFER TO DETAIL SHEET FOR SIGN DETAILS



TMP ARCHITECTURE INC
 191 WEST SQUARE LAKE ROAD
 BLOOMFIELD HILLS - MICHIGAN - 48302
 PH - 248.338.4545 FX - 248.338.0233
 EM - INFO@TMP-ARCHITECTURE.COM

REGISTRATION SEAL

CONSULTANT



PEA GROUP
 t 844.813.2949
 www.peagroup.com

PROJECT TITLE
New Smith Middle School Bld Package No. 03C

Troy School District
Troy, Michigan


DRAWING TITLE
DIMENSION & PAVING PLAN - WEST

ISSUE DATES

DATE ISSUED FOR:
 07-12-2024 ADDENDUM NO. 2
 06-18-2024 CONSTRUCTION DOCUMENTS

DRAWN JW
 CHECKED TD
 APPROVED TD


PROJECT NO.
22102
DRAWING NO.
C-3.1

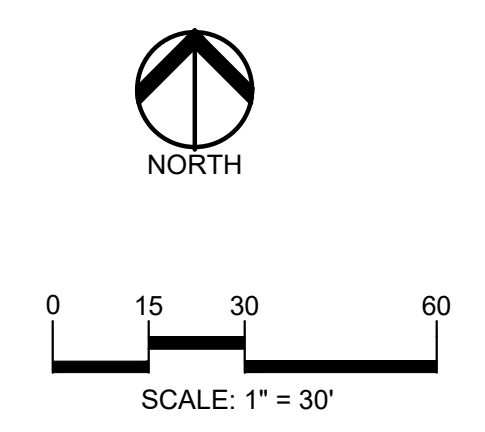

811 Know what's below. Call before you dig.
 CAUTION!
 THE EXISTENCE AND DEPTH OF UTILITIES UNDERGROUND UTILITIES ARE SHOWN ON THIS DRAWING ARE ONLY APPROXIMATE. NO GUARANTEE IS THEREFOR. THE CONTRACTOR SHALL BE EXCLUSIVELY RESPONSIBLE FOR DETERMINING THE EXACT LOCATION AND DEPTHS PRIOR TO THE START OF CONSTRUCTION.

Drawing File: S:\PROJECTS\2023\22102\22102_03C\22102_03C_3.1.dwg - 23-03-03.dwg
 Job #: 22102 - 03-03

MATCHLINE - SEE SHEET C-3.1

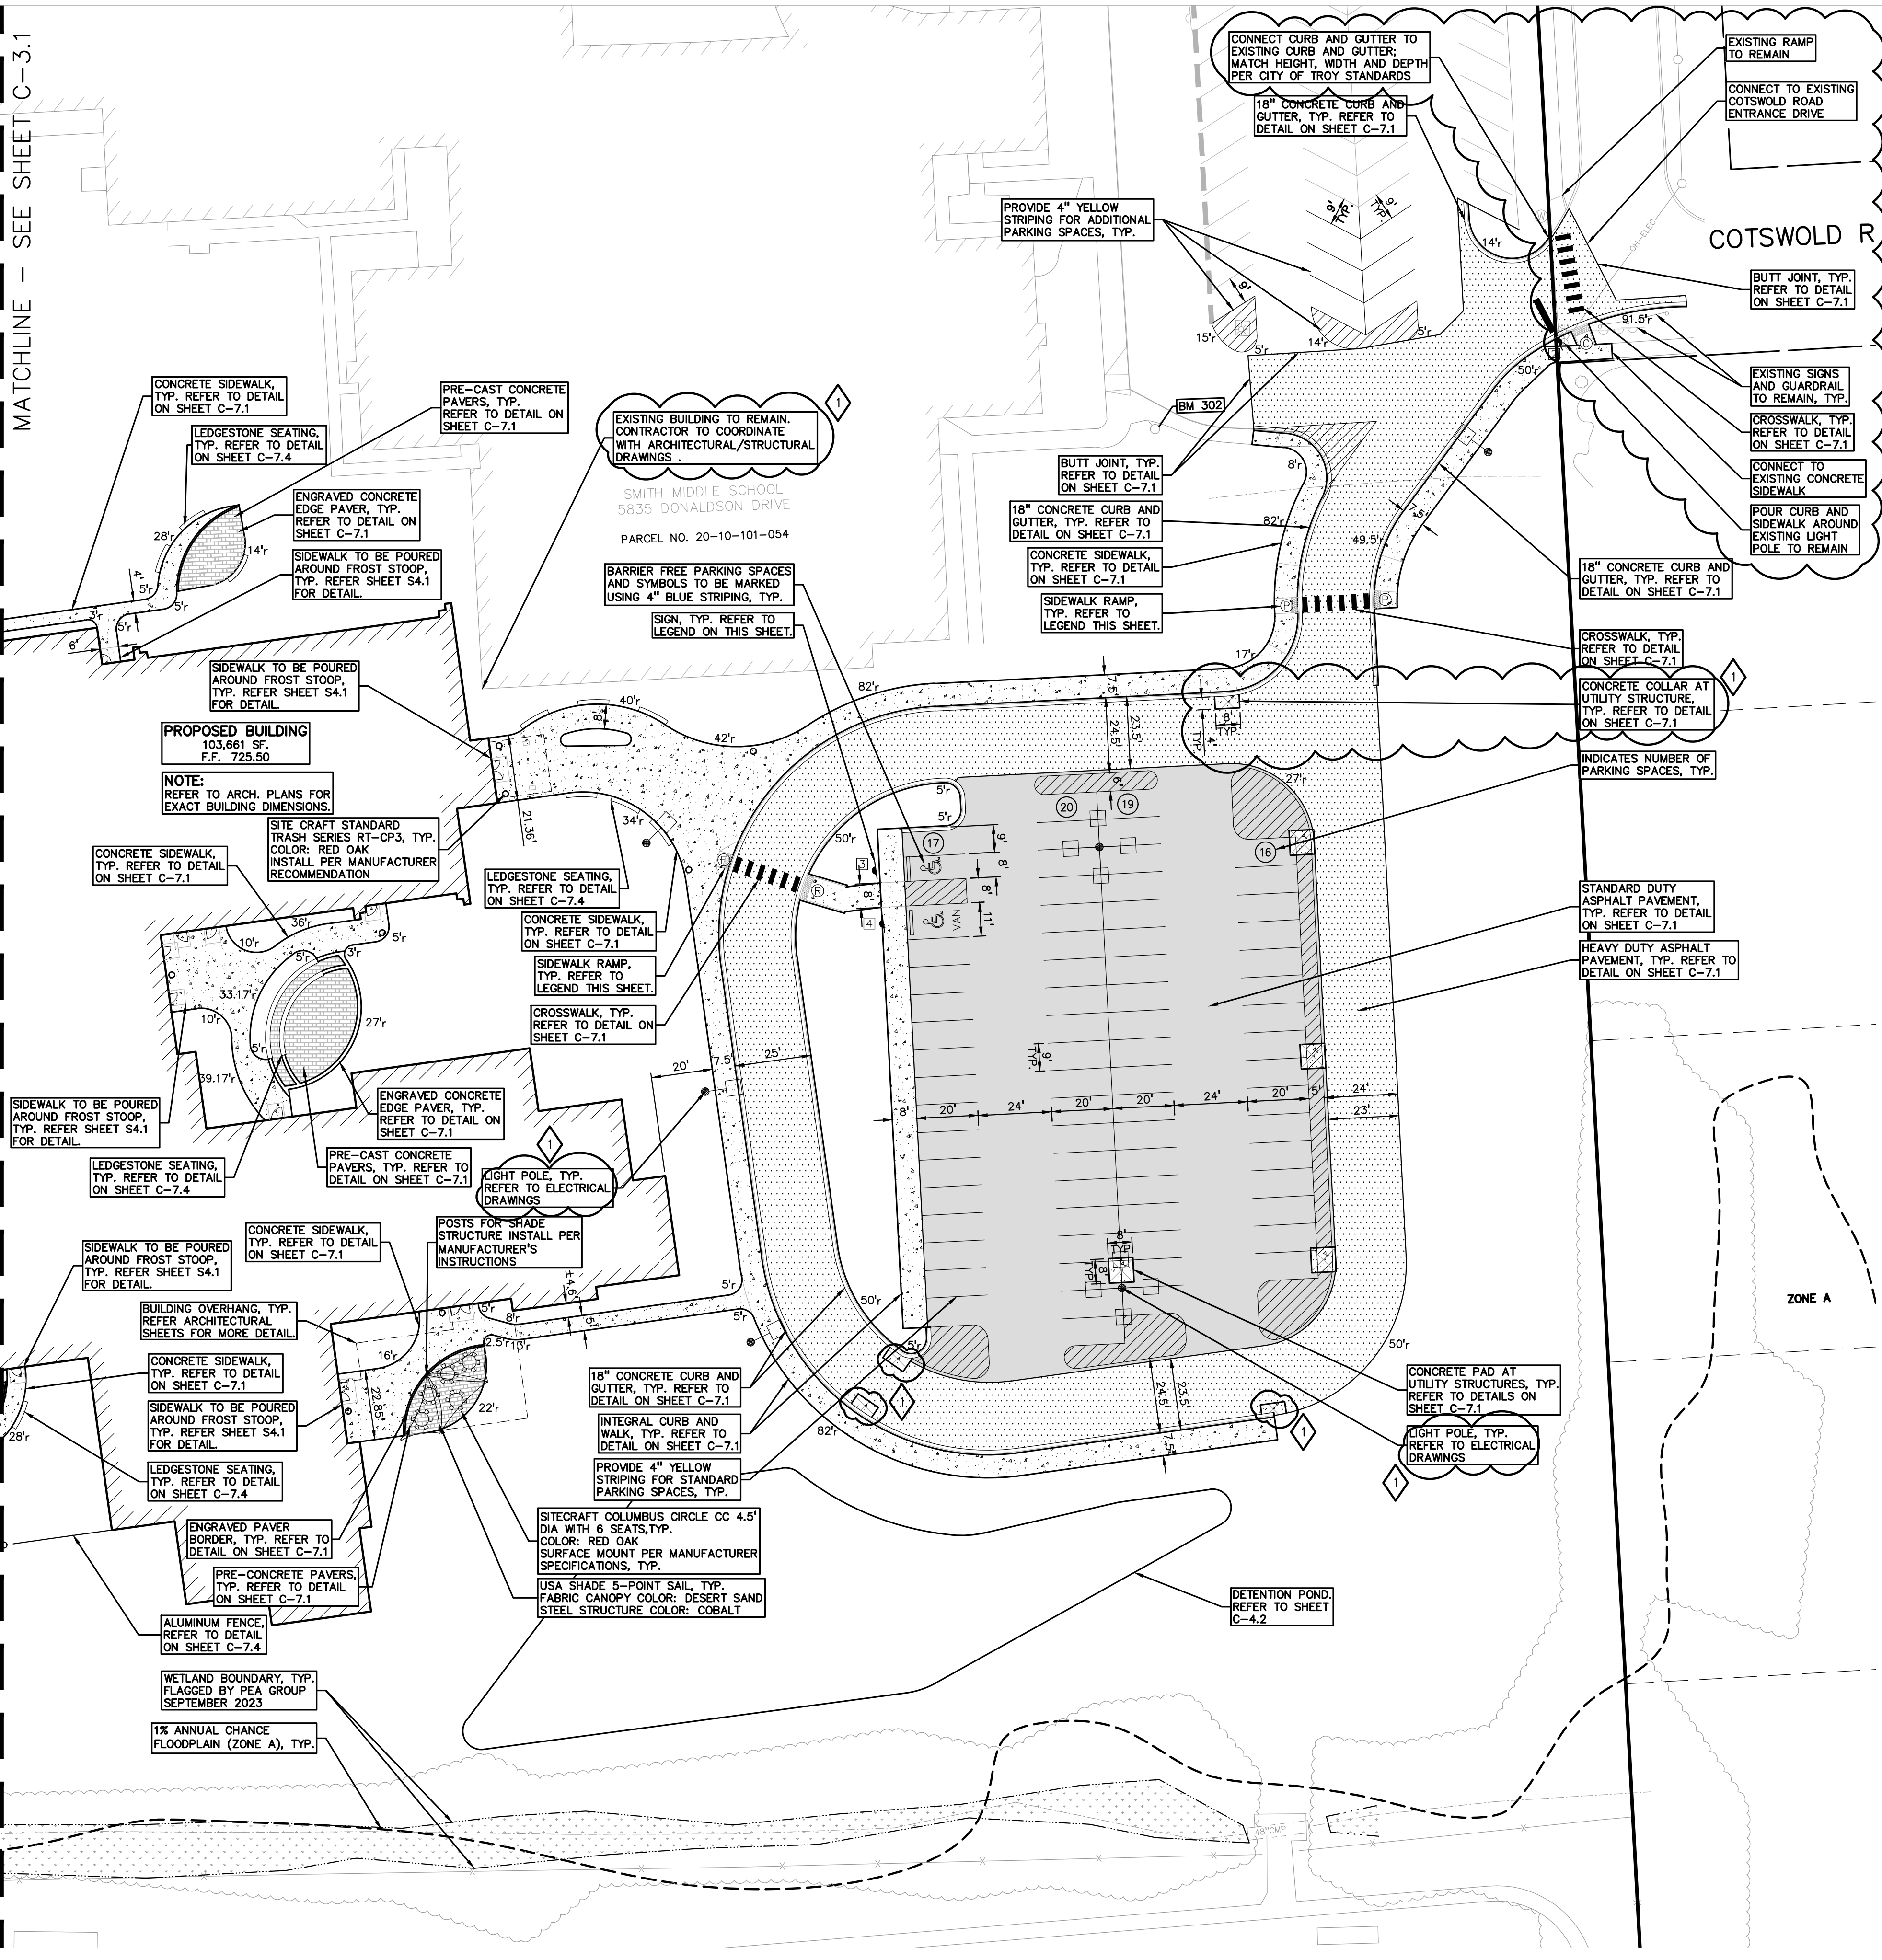

LEGEND:

- CONCRETE PAVEMENT
- ASPHALT PAVEMENT
- GRAVEL
- WETLAND
- CONCRETE CURB AND GUTTER
- REVERSE GUTTER PAN
- SETBACK LINE
- SIGN LIGHTPOLE
- GUARD RAIL

GENERAL NOTES:

THESE NOTES APPLY TO ALL CONSTRUCTION ACTIVITIES ON THIS PROJECT.

- ALL DIMENSIONS SHOWN ARE TO BACK OF CURB, FACE OF SIDEWALK, OUTSIDE FACE OF BUILDING, PROPERTY LINE, CENTER OF MANHOLE/CATCH BASIN OR CENTERLINE OF PIPE UNLESS OTHERWISE NOTED.
- 'NO PARKING FIRE LANE' SIGNS SHALL BE POSTED ALONG ALL FIRE LANES AT XXX FOOT INTERVALS OR AS DIRECTED BY THE FIRE OFFICIAL.
- REFER TO NOTES & DETAILS SHEET FOR ON-SITE PAVING DETAILS.
- REFER TO NOTES & DETAILS SHEET FOR ON-SITE SIDEWALK RAMP DETAILS.

PARKING:

EXISTING PARKING SPACES: 168 SPACES (INCLUDING 5 ADA SPACES)

PROPOSED PARKING SPACES: 131 SPACES

SIDEWALK RAMP LEGEND:

- SIDEWALK RAMP 'TYPE R'
- SIDEWALK RAMP 'TYPE F'
- SIDEWALK RAMP 'TYPE P'
- SIDEWALK RAMP 'TYPE C'
- SIDEWALK RAMP 'TYPE D'
- CURB DROP ONLY

REFER TO LATEST MDT R-28 STANDARD RAMP AND DETECTABLE WARNING DETAILS

NOTE: DETECTABLE WARNING SURFACE TO BE YELLOW FOR ALL RAMPS.

SIGN LEGEND:

- 'NO PARKING FIRE LANE' SIGN
- 'STOP' SIGN
- 'BARRIER FREE PARKING' SIGN
- 'VAN ACCESSIBLE' SIGN
- 'CROSSWALK' SIGN
- 'DO NOT ENTER' SIGN
- 'SIDEWALK ENDS' SIGN
- 'NO PARKING LOADING ZONE' SIGN

REFER TO DETAIL SHEET FOR SIGN DETAILS



TMP ARCHITECTURE INC
191 WEST SQUARE LAKE ROAD
BLOOMFIELD HILLS - MICHIGAN - 48302
PH - 248.338.6565 FX - 248.338.0233
EM - INFO@TMP-ARCHITECTURE.COM

REGISTRATION SEAL

CONSULTANT



PEA GROUP
t 844.813.2949
www.peagroup.com

PROJECT TITLE
New Smith Middle School
Bld Package No. 03C

Troy School District
Troy, Michigan

DRAWING TITLE
DIMENSION & PAVING
PLAN - EAST

ISSUE DATES

DATE	ISSUED FOR:
07-12-2024	ADDENDUM NO. 2
06-18-2024	CONSTRUCTION DOCUMENTS

DRAWN	CHKD
JW	TD
TD	TD

PROJECT NO.
22102

DRAWING NO.
C-3.2




0 15 30 60
SCALE: 1" = 30'



CAUTION!
THE LOCATION AND DEPTH OF UTILITIES SHOWN ON THESE DRAWINGS ARE ONLY APPROXIMATE. NO GUARANTEE IS MADE BY THE CONTRACTOR FOR THE ACCURACY OF THE INFORMATION PROVIDED. THE CONTRACTOR SHALL BE EXCLUSIVELY RESPONSIBLE FOR DETERMINING THE EXACT LOCATION AND DEPTHS OF UTILITIES PRIOR TO THE START OF CONSTRUCTION.

Drawing File: S:\PROJECTS\2023\24-001_TROY_SCHOOL_2022_BLDG_PACKAGE_03C\CONSTRUCTION\NEW_SMITH_MIDDLE\C-3.1_DIM-24-001.dwg
Date: 11/15/2024 10:56:00am

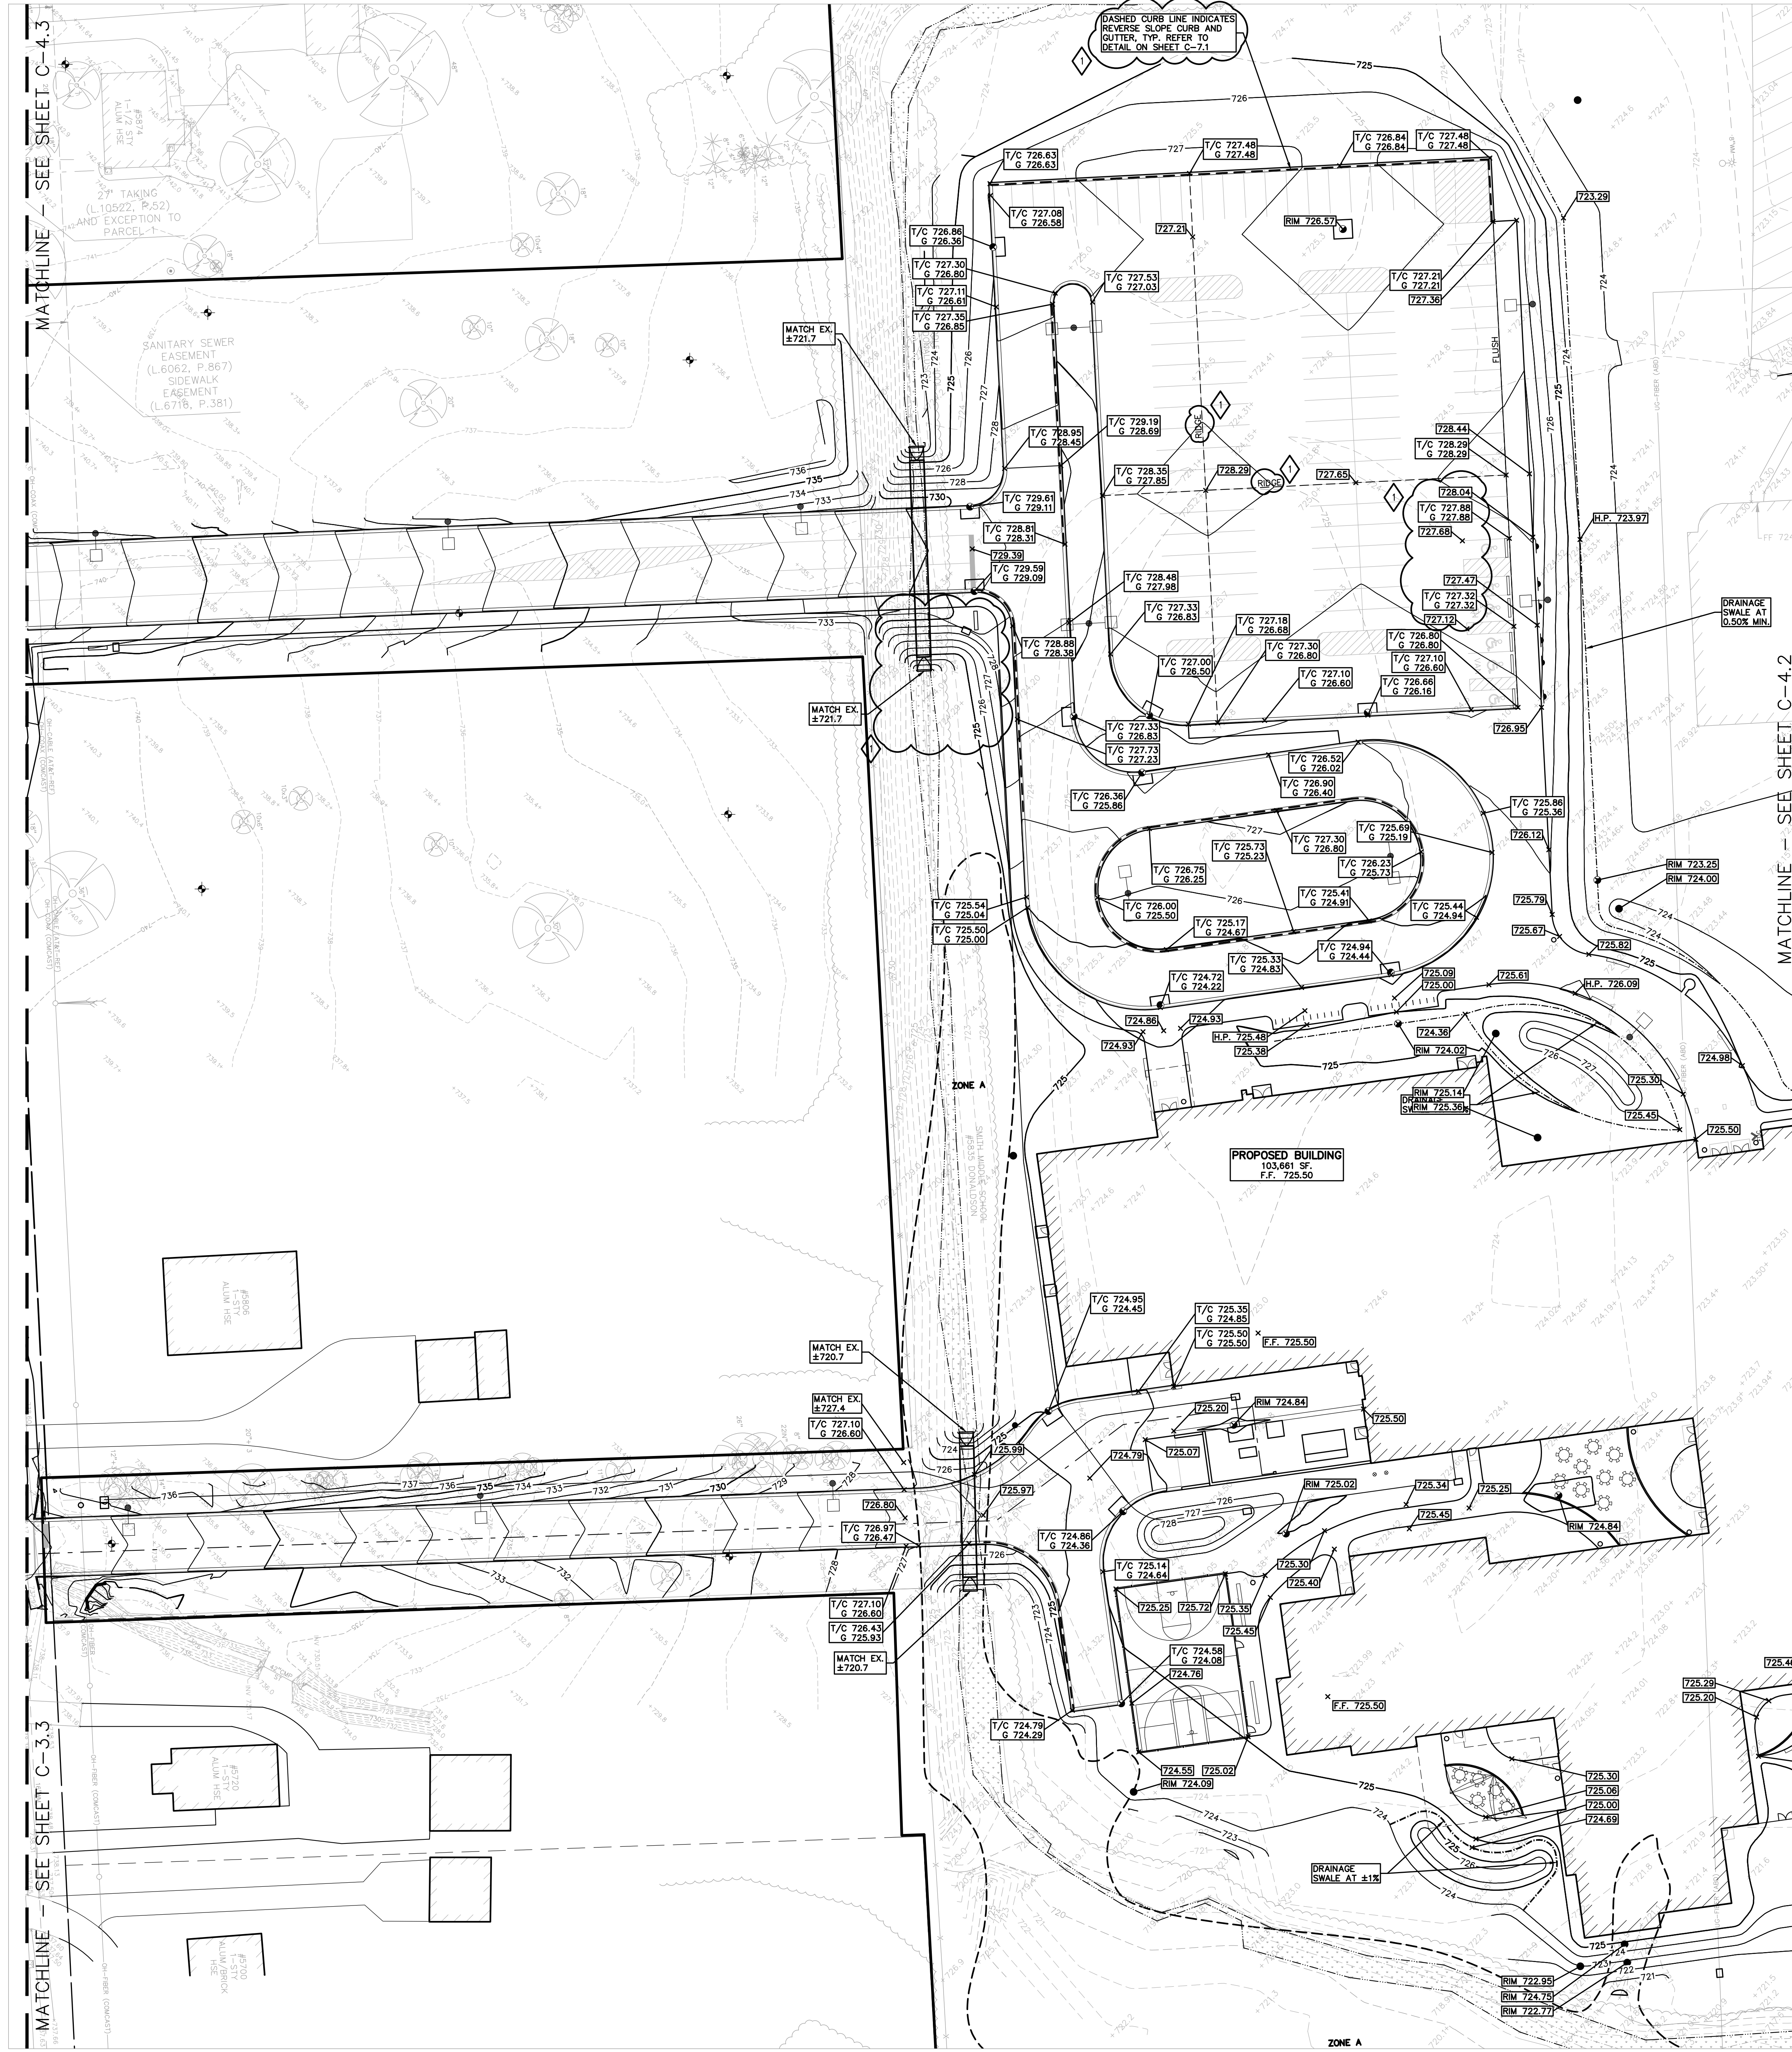

FLOODPLAIN:
 PER FLOOD INSURANCE RATE MAP NUMBER 26125C0532F, DATED SEPTEMBER 29, 2008
 BY GRAPHICAL PLOTTING, THE SITE LIES WITHIN:
 SPECIAL FLOOD HAZARD AREAS SUBJECT TO INUNDATION BY THE 1% ANNUAL CHANCE FLOOD
 THE 1% ANNUAL CHANCE FLOOD (100 YEAR FLOOD), ALSO KNOWN AS THE BASE FLOOD, IS THE FLOOD THAT HAS A 1% CHANCE OF BEING EQUALED OR EXCEEDED IN ANY GIVEN YEAR. THE SPECIAL FLOOD HAZARD AREA IS THE AREA SUBJECT TO FLOODING BY THE 1% ANNUAL CHANCE FLOOD. AREAS OF SPECIAL FLOOD HAZARD INCLUDE ZONES A, AE, AH, AO, AR, A99, V AND VE. THE BASE FLOOD ELEVATION IS THE WATER-SURFACE ELEVATION OF THE 1% ANNUAL CHANCE FLOOD.

LEGAL DESCRIPTION:
 PARCEL ID 25-10-101-05A
 Land in the City of Troy, Oakland County, Michigan, described as follows:
 T2N, R11E, SEC 10 PART OF NW 1/4 BEG AT PT DST S 571.06 FT & S 89.57-00 E 697.50 FT & S 30.10-00 E 189.24 FT FROM NW SEC COR, TH S 89-40-00 E 624.96 FT, TH S 00-10-00 E 683.20 FT, TH N 89-00-00 W 901.78 FT, TH N 00-10-00 W 637.72 FT, TH S 89-02-00 E 275.00 FT, TH N 00-10-00 W 39.24 FT TO BEG 13.79 A

PARCEL ID 25-10-151-022
 Land in the City of Troy, Oakland County, Michigan, described as follows:
 T2N, R11E, SEC 10 SUPERVISOR'S PLAT NO 25 LOTS 5, 6 & 7, ALSO E 900 FT OF LOTS 8 & 9, ALSO LOT 10 EXC W 397.82 FT OF S 104.29 FT

BENCHMARKS:
 (GPS DERIVED - NAVD83)
 BM #303
 ARROW ON A HYDRANT LOCATED AT THE SOUTHWEST CORNER OF THE FRONT PARKING LOT.
 ELEV. = 724.13
 BM #302
 ARROW ON A HYDRANT LOCATED ON THE SOUTHWEST CORNER OF THE BACK PARKING LOT.
 ELEV. = 728.34

GRADING LEGEND:

	EXISTING SPOT ELEVATION
	PROPOSED SPOT ELEVATION, TYPICALLY TOP OF PAVEMENT IN PAVED AREAS, GUTTER GRADE IN CURB LINES
	EXISTING CONTOUR
	PROPOSED CONTOUR
	PROPOSED REVERSE GUTTER PAN
	PROPOSED RIDGE LINE
	PROPOSED SWALEDITCH

ABBREVIATIONS

T/C	= TOP OF CURB	G	= GUTTER GRADE
T/P	= TOP OF PAVEMENT	F.G.	= FINISH GRADE
T/S	= TOP OF SIDEWALK	RIM	= RIM ELEVATION
T/W	= TOP OF WALL	B/W	= BOTTOM OF WALL
F.F.	= FINISH FLOOR		

REFER TO GRADING NOTES ON SHEET C-7.0

EARTHWORK BALANCING NOTE:
 THE CONTRACTOR SHALL BE RESPONSIBLE FOR IMPORTING OR EXPORTING ALL MATERIALS AS REQUIRED TO PROPERLY GRADE THIS PROJECT TO THE FINISHED ELEVATIONS SHOWN ON THE APPROVED PLANS. THE CONTRACTOR SHALL MAKE THEIR OWN DETERMINATION OF CUT AND FILL QUANTITIES AND ALLOW FOR REMOVAL OF EXCESS OR IMPORTATION OF ADDITIONAL MATERIAL AT NO ADDITIONAL COST TO THE OWNER.

EARTHWORK NOTES:

1. A REPORT ON GEOLOGICAL INVESTIGATION DATED DECEMBER 29, 2023, WAS PREPARED BY THE G2 CONSULTING GROUP.
2. BID PACKAGE NO. 032 WAS PREVIOUSLY RELEASED TO COVER THE GROUND IMPROVEMENT FOR THE SITE.

REGISTRATION SEAL

CONSULTANT

PEA GROUP
 t 844.813.2949
 www.peagroup.com

PROJECT TITLE
New Smith Middle School Bid Package No. 03C

Troy School District Troy, Michigan

DRAWING TITLE
GRADING PLAN - WEST

ISSUE DATES

DATE	ISSUED FOR:
07-12-2024	ADDENDUM NO. 2
06-18-2024	CONSTRUCTION DOCUMENTS


DRAWN JW
CHECKED TD
APPROVED TD

PROJECT NO.
22102

DRAWING NO.
C-4.1

811 Know what's below. Call before you dig.
 CAUTION! THE LOCATION AND DEPTH OF UTILITIES IS UNDETERMINED. UTILITIES AS SHOWN ON THIS DRAWING ARE ONLY APPROXIMATE. NO QUANTITIES OR OTHER DIMENSIONS ARE TO BE CONSIDERED AS ACCURATE. BEFORE THE CONTRACTOR SHALL BE EXCLUSIVELY RESPONSIBLE FOR DETERMINING THE LOCATION, DEPTH, AND CONDITION OF UTILITIES PRIOR TO THE START OF CONSTRUCTION.

MATCHLINE - SEE SHEET C-4.1

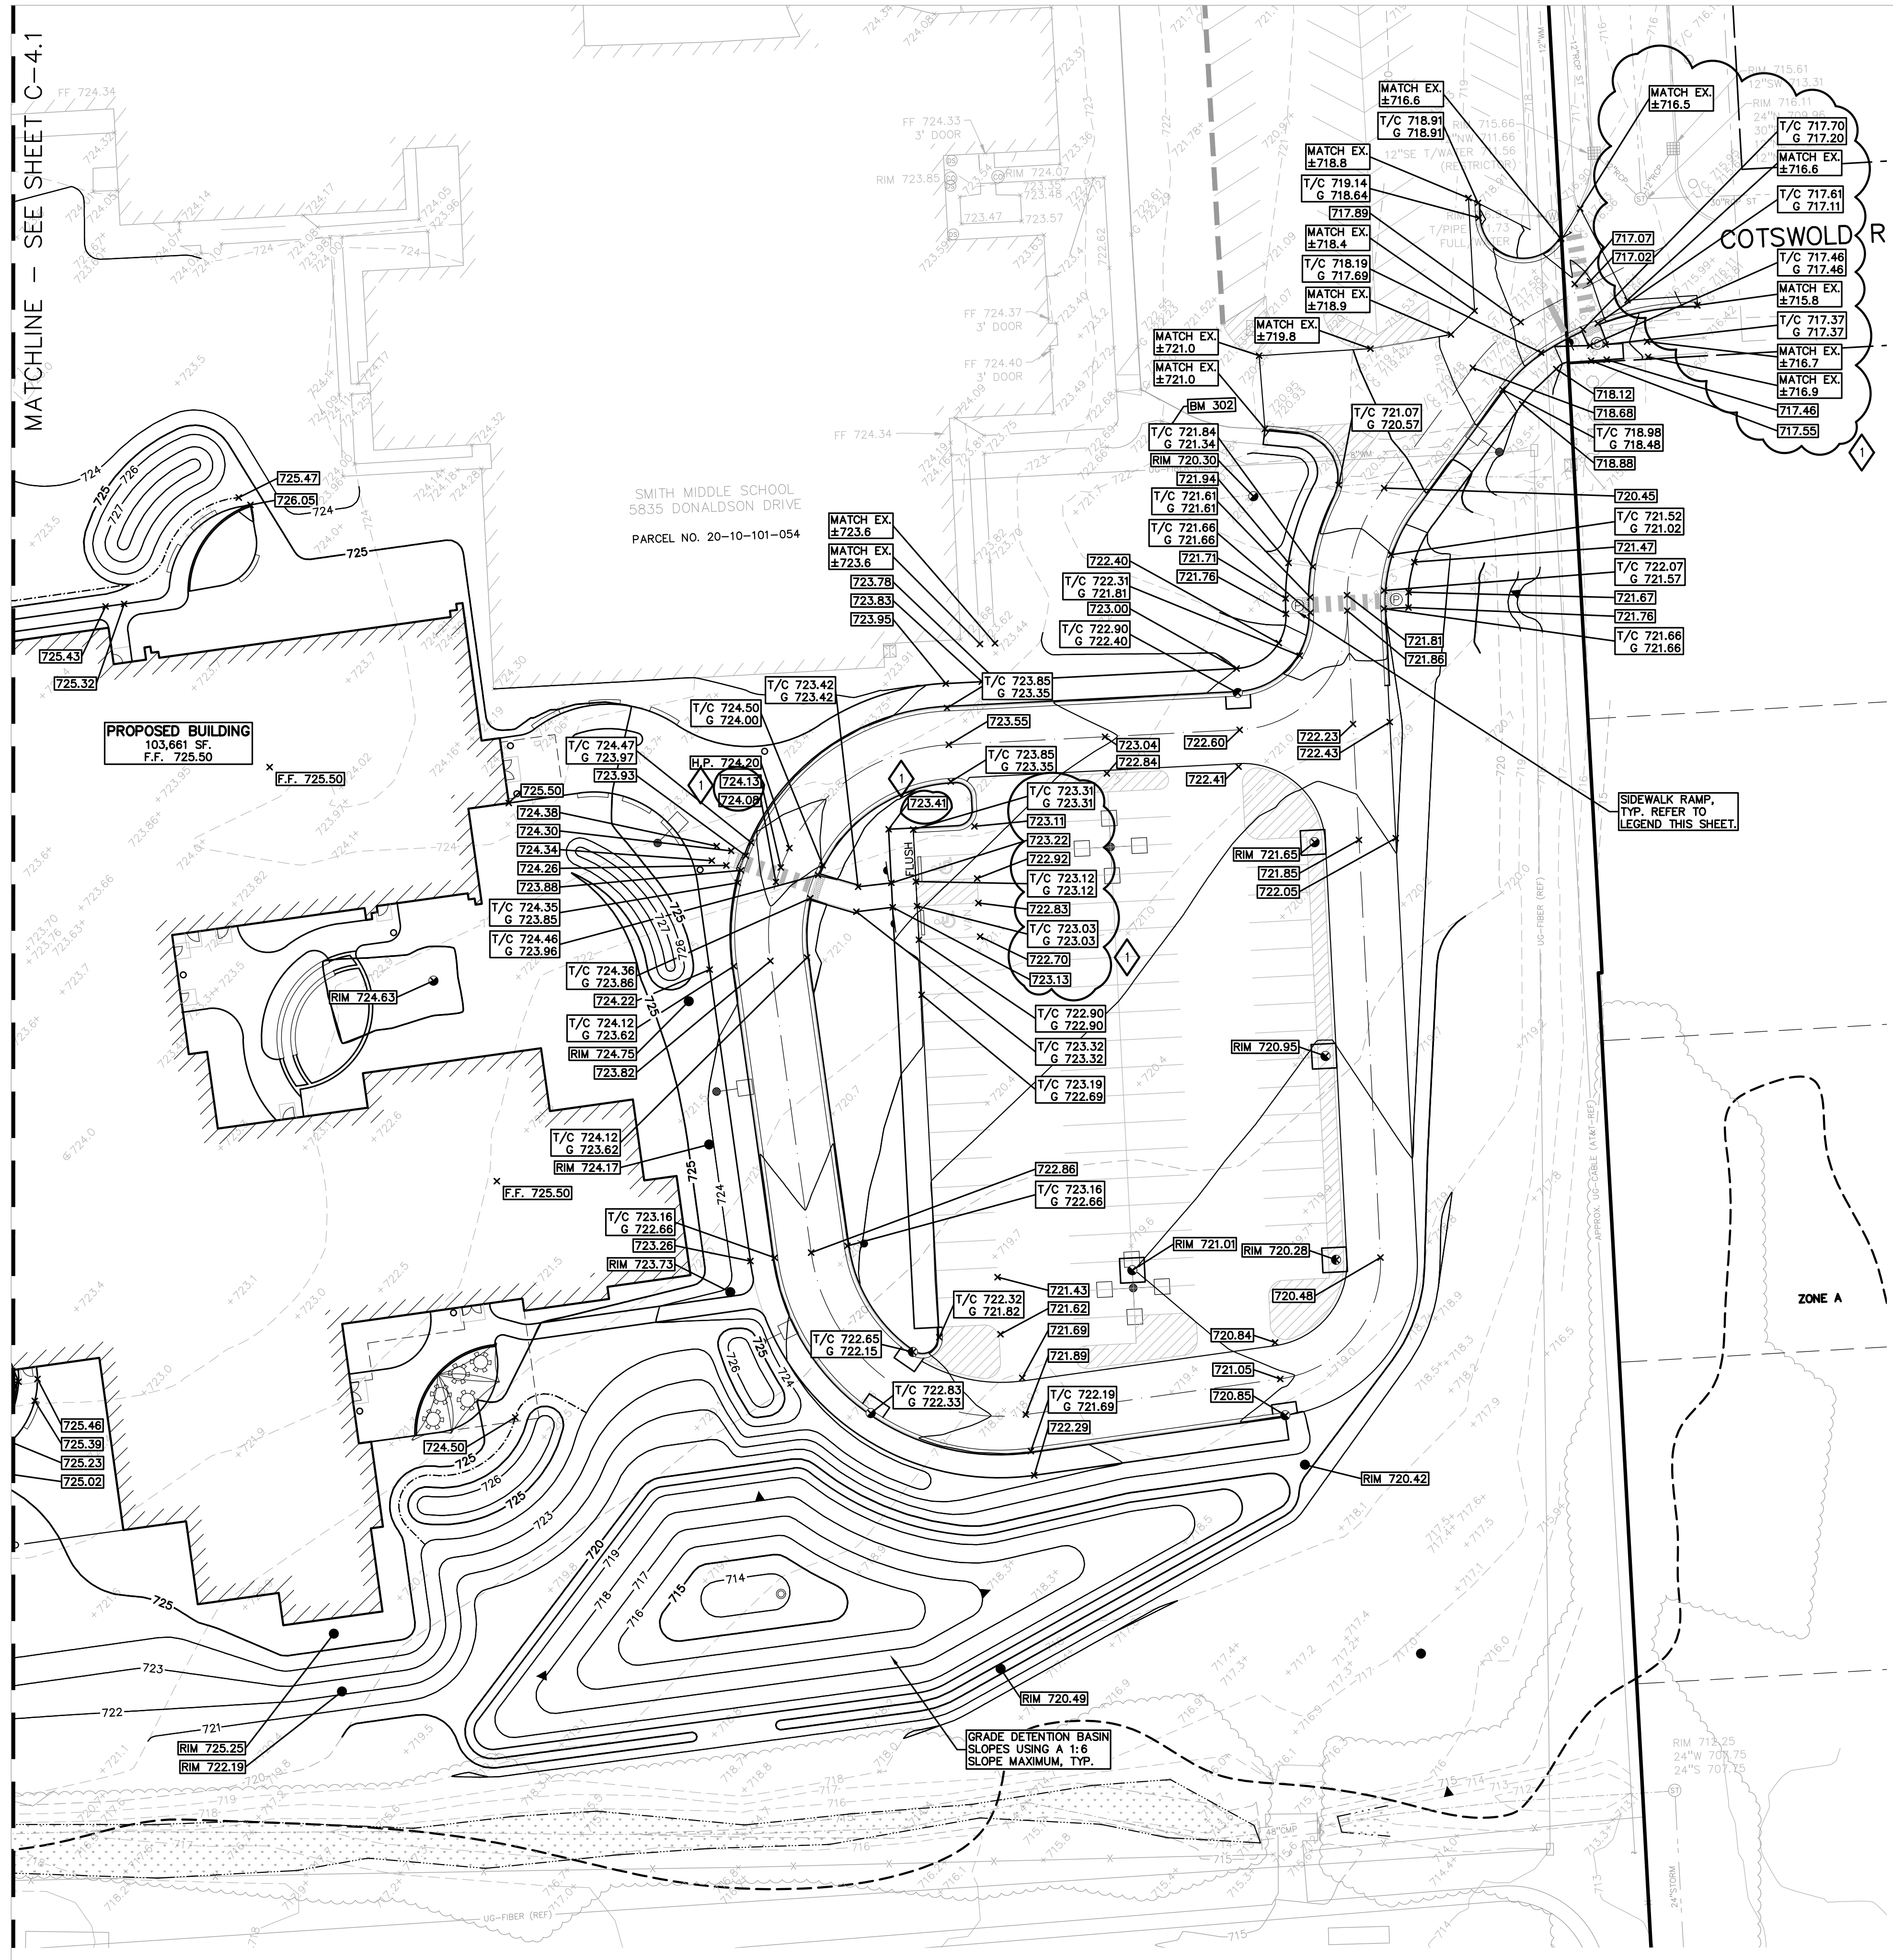

FLOODPLAIN:
PER FLOOD INSURANCE RATE MAP NUMBER 261205032F, DATED SEPTEMBER 29, 2006

BY GRAPHICAL PLOTTING, THE SITE LIES WITHIN:

SPECIAL FLOOD HAZARD AREAS SUBJECT TO INUNDATION BY THE 1% ANNUAL CHANCE FLOOD (THE 1% ANNUAL CHANCE FLOOD (100 YEAR FLOOD), ALSO KNOWN AS THE BASE FLOOD, IS THE FLOOD THAT HAS A 1% CHANCE OF BEING EQUALED OR EXCEEDED IN ANY GIVEN YEAR. THE SPECIAL FLOOD HAZARD AREA IS THE AREA SUBJECT TO FLOODING BY THE 1% ANNUAL CHANCE FLOOD. AREAS OF SPECIAL FLOOD HAZARD INCLUDE ZONES A, AE, AH, AO, AR, A99, V AND VE. THE BASE FLOOD ELEVATION IS THE WATER-SURFACE ELEVATION OF THE 1% ANNUAL CHANCE FLOOD.

OTHER AREAS:
ZONE A - NO BASE FLOOD ELEVATIONS DETERMINED.
ZONE X - AREA TO BE DETERMINED OUTSIDE OF THE 0.2% ANNUAL CHANCE FLOODPLAIN.

LEGAL DESCRIPTION:

PARCEL ID 20-10-101-054
Land in the City of Troy, Oakland County, Michigan, described as follows:
T2N, R11E, SEC 10 PART OF NW 1/4 BEG AT PT DIST S 571.05 FT & S 89-57.00 E 697.50 FT & S 80-10-00 E 189.24 FT FROM NW SEC COR, TH S 89-40-00 E 624.96 FT, TH S 00-10-00 E 683.20 FT, TH N 89-00-00 W 901.78 FT, TH N 00-10-00 W 637.72 FT, TH S 89-02-00 E 275.00 FT, TH N 00-10-00 W 39.24 FT TO BEG 13.79 A

PARCEL ID 20-10-151-022
Land in the City of Troy, Oakland County, Michigan, described as follows:
T2N, R11E, SEC 10 SUPERVISOR'S PLAT NO 25 LOTS 5, 6 & 7, ALSO E 900 FT OF LOTS 8 & 9, ALSO LOT 10 EXC W 397.82 FT OF S 194.29 FT

BENCHMARKS:
(GPS DERIVED - NAVD83)

BM #30
ARROW ON A HYDRANT LOCATED AT THE SOUTHWEST CORNER OF THE FRONT PARKING LOT.
ELEV. = 724.13

BM #30
ARROW ON A HYDRANT LOCATED ON THE SOUTHWEST CORNER OF THE BACK PARKING LOT.
ELEV. = 728.34

GRADING LEGEND:

EXISTING SPOT ELEVATION
PROPOSED SPOT ELEVATION, TYPICALLY TOP OF PAVEMENT IN PAVED AREAS, GUTTER GRADE IN CURB LINES.
EXISTING CONTOUR
PROPOSED CONTOUR
PROPOSED REVERSE GUTTER PAN
PROPOSED RIDGE LINE
PROPOSED SWALE/DITCH

ABBREVIATIONS:
T/C = TOP OF CURB G = GUTTER GRADE
T/P = TOP OF PAVEMENT F.G. = FINISH GRADE
T/S = TOP OF SIDEWALK RIM = RIM ELEVATION
T/W = TOP OF WALL B.W. = BOTTOM OF WALL
F.F. = FINISH FLOOR

REFER TO GRADING NOTES ON SHEET C-7.0

EARTHWORK BALANCING NOTE:
THE CONTRACTOR SHALL BE RESPONSIBLE FOR IMPORTING OR EXPORTING ALL MATERIALS AS REQUIRED TO PROPERLY GRADE THIS PROJECT TO THE FINISHED ELEVATIONS SHOWN ON THE APPROVED PLANS. THE CONTRACTOR SHALL MAKE THEIR OWN DETERMINATION OF CUT AND FILL QUANTITIES AND ALLOW FOR REMOVAL OF EXCESS OR IMPORTATION OF ADDITIONAL MATERIAL AT NO ADDITIONAL COST TO THE OWNER.

EARTHWORK NOTES:

- A REPORT ON GEOTECHNICAL INVESTIGATION DATED DECEMBER 29, 2023, WAS PREPARED BY THE C2 CONSULTING GROUP.
- BID PACKAGE NO. 03C WAS PREVIOUSLY RELEASED TO COVER THE GROUND IMPROVEMENT FOR THE SITE.



TMP ARCHITECTURE INC
191 WEST SQUARE LAKE ROAD
BLOOMFIELD HILLS - MICHIGAN - 48302
PH - 248.338.6565 FX - 248.338.0223
EM - INFO@TMP-ARCHITECTURE.COM

REGISTRATION SEAL

CONSULTANT



PROJECT TITLE
New Smith Middle School Bid Package No. 03C

Troy School District Troy, Michigan

DRAWING TITLE
GRADING PLAN - EAST

ISSUE DATES

DATE	ISSUED FOR:
07-12-2024	ADDENDUM NO. 2
06-18-2024	CONSTRUCTION DOCUMENTS

DRAWN JW
CHECKED TD
APPROVED TD


PROJECT NO.
22102
DRAWING NO.
C-4.2



SCALE: 1" = 30'



CAUTION!
THE LOCATION AND DEPTH OF EXISTING UNDERGROUND UTILITIES AS SHOWN ON THIS DRAWING ARE ONLY APPROXIMATE. NO GUARANTEE IS MADE BY THE CONTRACTOR. THE CONTRACTOR SHALL BE EXCLUSIVELY RESPONSIBLE FOR DETERMINING THE EXACT LOCATION AND DEPTHS PRIOR TO THE START OF CONSTRUCTION.

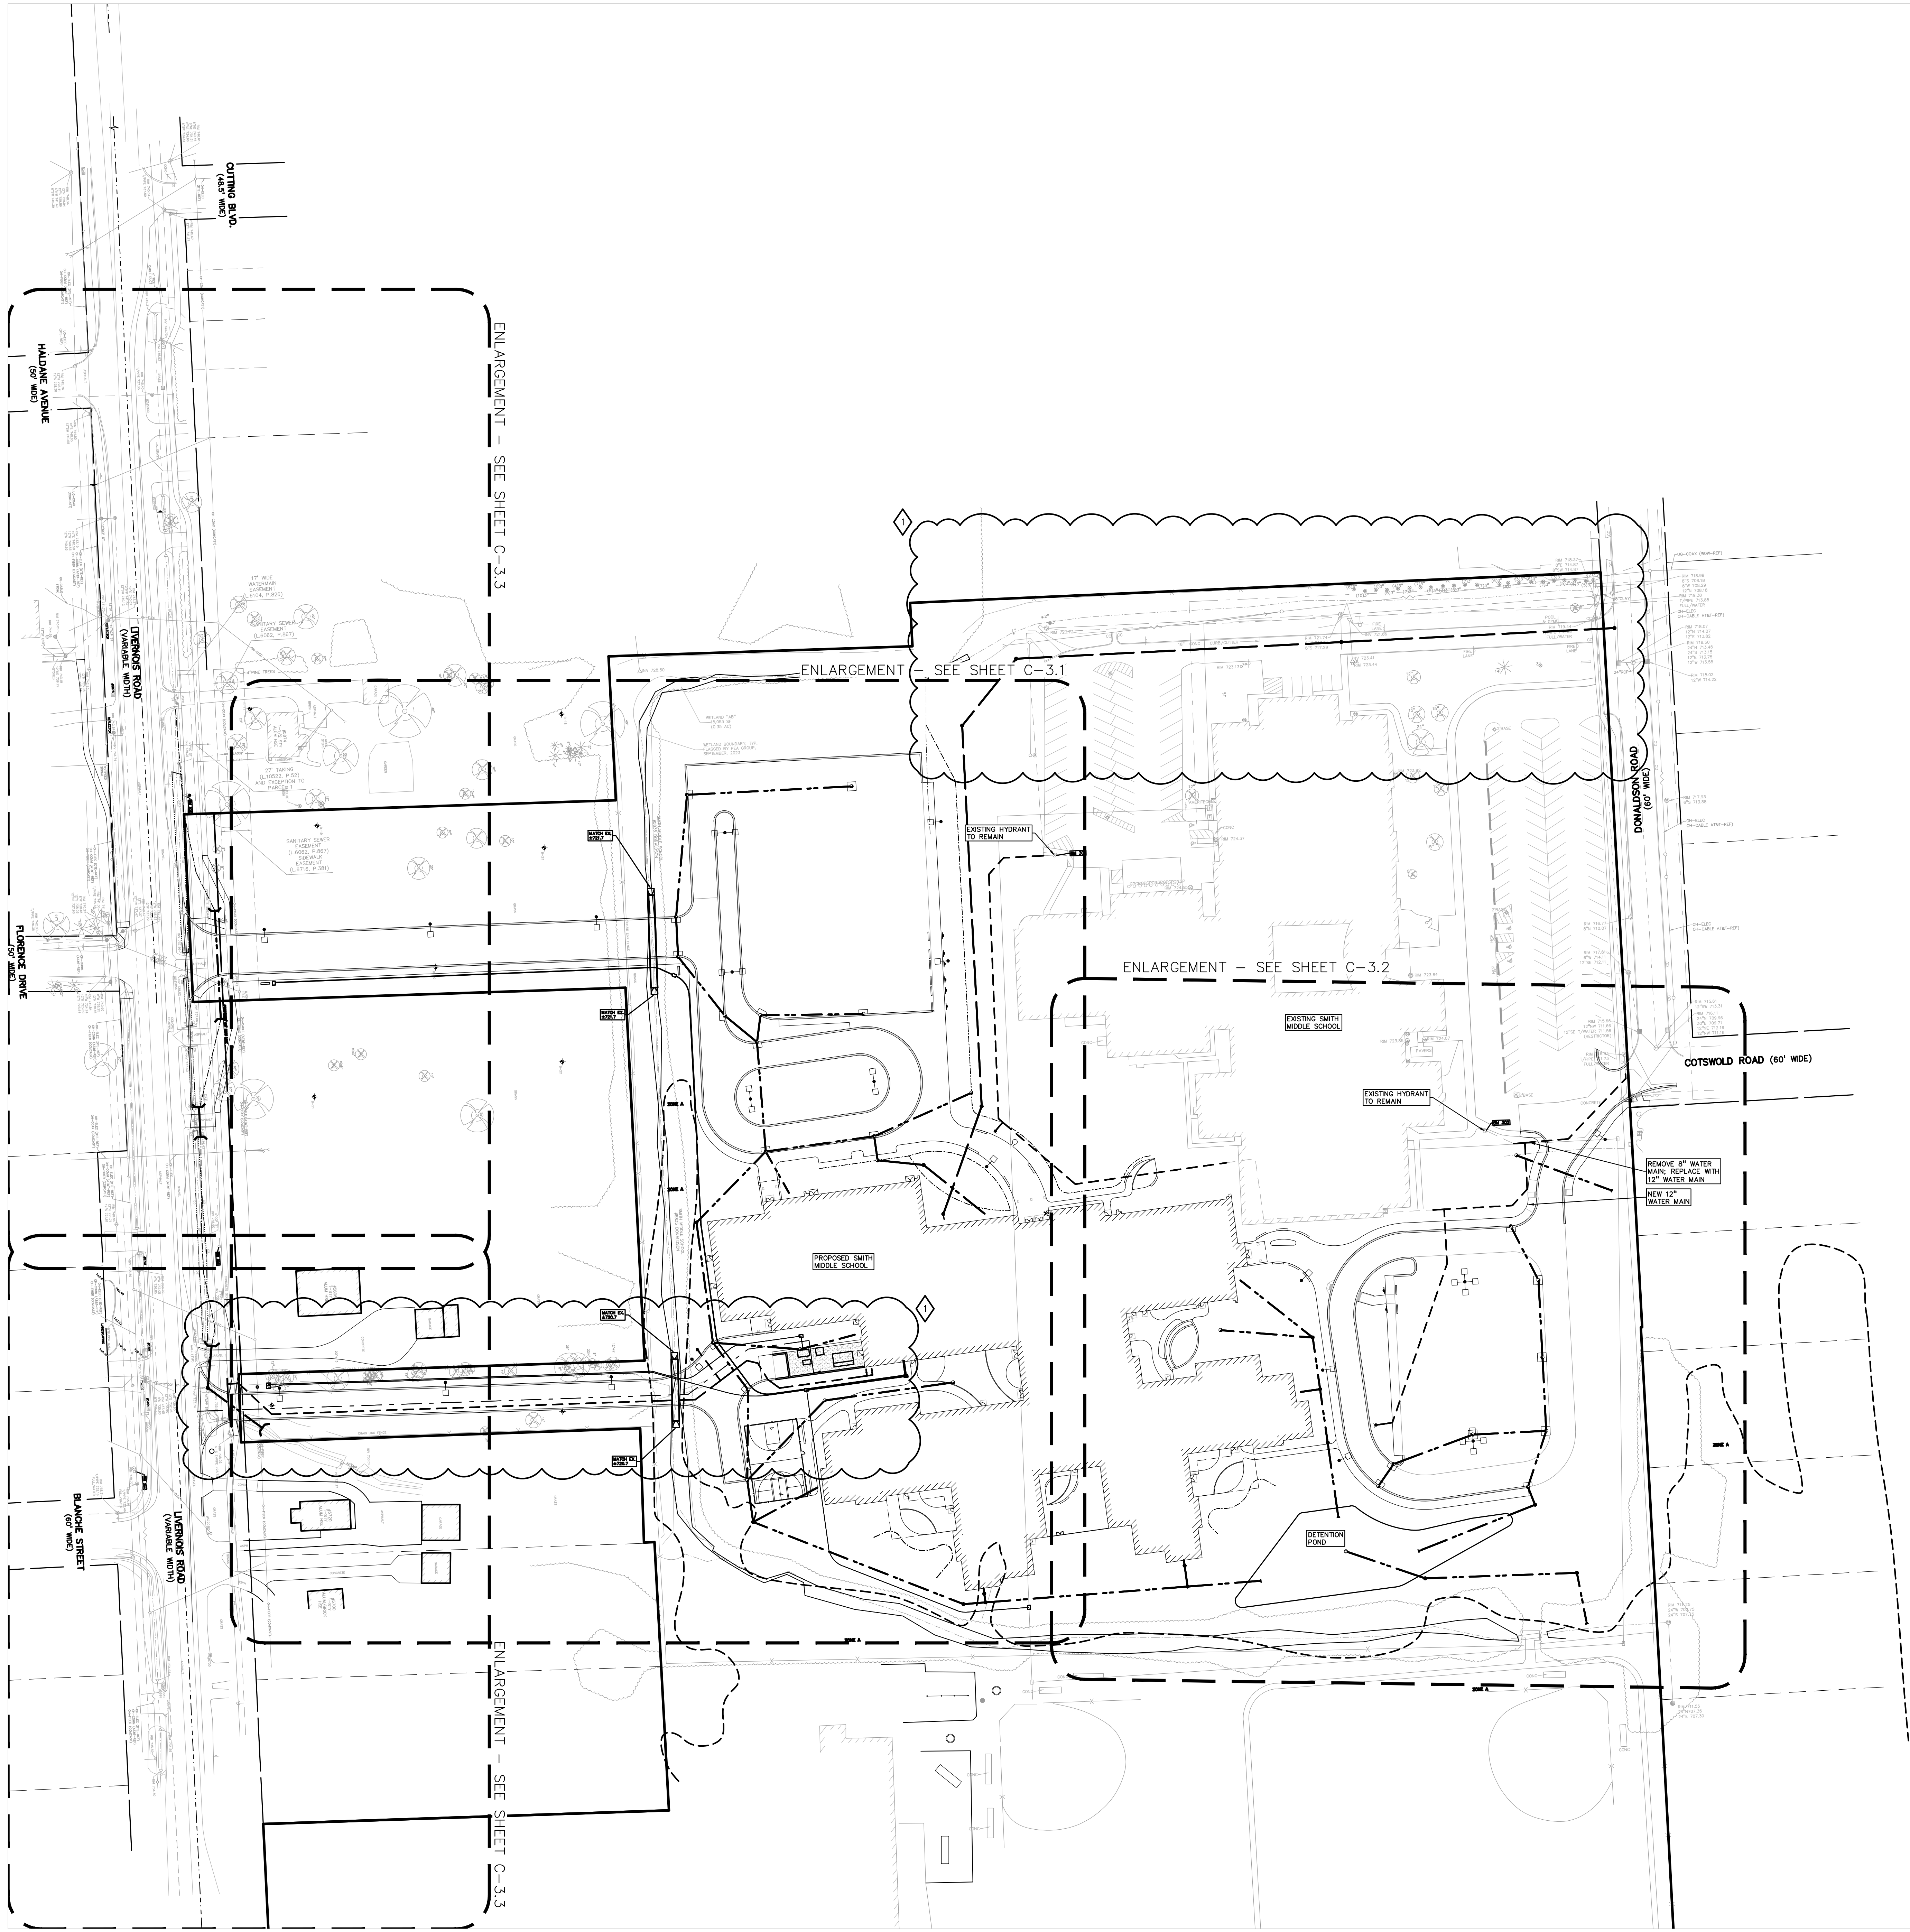

FLOODPLAIN:
 PER FLOOD INSURANCE RATE MAP NUMBER 26125C0532F, DATED SEPTEMBER 29, 2006
 BY GRAPHICAL PLOTTING, THE SITE LIES WITHIN:
 SPECIAL FLOOD HAZARD AREAS SUBJECT TO INUNDATION BY THE 1% ANNUAL CHANCE FLOOD
 THE 1% ANNUAL CHANCE FLOOD (100 YEAR FLOOD), ALSO KNOWN AS THE BASE FLOOD, IS THE FLOOD THAT HAS A 1% CHANCE OF BEING EQUALED OR EXCEEDED IN ANY GIVEN YEAR. THE SPECIAL FLOOD HAZARD AREA IS THE AREA SUBJECT TO FLOODING BY THE 1% ANNUAL CHANCE FLOOD. AREAS OF SPECIAL FLOOD HAZARD INCLUDE ZONES A, AE, AH, AO, AR, AB9, V AND VE. THE BASE FLOOD ELEVATION IS THE WATER-SURFACE ELEVATION OF THE 1% ANNUAL CHANCE FLOOD.
 ZONE A - NO BASE FLOOD ELEVATIONS DETERMINED.
 OTHER AREAS
 ZONE X
 AREA TO BE DETERMINED OUTSIDE OF THE 0.2% ANNUAL CHANCE FLOODPLAIN.

LEGAL DESCRIPTION:
 PARCEL ID 20-10-101-024
 Land in the City of Troy, Oakland County, Michigan, described as follows:
 T2N, R11E, SEC 10 PART OF NW 1/4 BEG AT PT DIST S 571.06 FT & S 89.57-00 E 697.50 FT & S 00-10-00 E 189.24 FT FROM NW SEC COR, TH S 89-40-00 E 624.96 FT, TH S 00-10-00 E 693.20 FT, TH N 89-00-00 W 901.78 FT, TH N 00-10-00 W 637.72 FT, TH S 89-02-00 E 275.00 FT, TH N 00-10-00 W 39.24 FT TO BEG 13.79 A
 PARCEL ID 20-10-151-022
 Land in the City of Troy, Oakland County, Michigan, described as follows:
 T2N, R11E, SEC 10 SUPERVISOR'S PLAT NO 25 LOTS 5, 6 & 7, ALSO E 900 FT OF LOTS 8 & 9, ALSO LOT 10 EXC W 37.82 FT OF S 104.29 FT

BENCHMARKS:
 (GPS DERIVED - NAVD83)
 BM #300
 ARROW ON A HYDRANT LOCATED AT THE SOUTHWEST CORNER OF THE FRONT PARKING LOT.
 ELEV. = 724.13
 BM #301
 ARROW ON A HYDRANT LOCATED ON THE SOUTHWEST CORNER OF THE BACK PARKING LOT.
 ELEV. = 728.34

- UTILITY LEGEND:**
- OH-ELEC-12- EX. OH. ELEC. POLE & GUY WIRE
 - 10-CATV- EX. U.G. CABLE TV & PEDESTAL
 - 10-COM- EX. U.G. COMMUNICATION LINE, PEDESTAL & MANHOLE
 - 10-ELEC-12- EX. U.G. ELEC. MANHOLE, METER & HANDHOLE
 - EX. GAS LINE
 - EX. GAS VALVE & GAS LINE MARKER
 - EX. TRANSFORMER & IRRIGATION VALVE
 - EX. WATER MAIN
 - EX. HYDRANT, GATE VALVE & POST INDICATOR VALVE
 - EX. WATER VALVE BOX & SHUTOFF
 - EX. SANITARY SEWER
 - EX. SANITARY CLEANOUT & MANHOLE
 - EX. COMBINED SEWER MANHOLE
 - EX. STORM SEWER
 - EX. CLEANOUT & MANHOLE
 - EX. SQUARE, ROUND, & BEEHIVE CATCH BASIN
 - EX. YARD DRAIN & ROOF DRAIN
 - EX. UNIDENTIFIED STRUCTURE
 - PROPOSED WATER MAIN
 - PROPOSED HYDRANT AND GATE VALVE
 - PROPOSED TAPPING SLEEVE, VALVE & WELL
 - PROPOSED POST INDICATOR VALVE
 - PROPOSED SANITARY SEWER
 - PROPOSED SANITARY CLEANOUT & MANHOLE
 - PROPOSED STORM SEWER
 - PROPOSED STORM SEWER CLEANOUT & MANHOLE
 - PROPOSED CATCH BASIN, INLET & YARD DRAIN



TMP ARCHITECTURE INC
 191 WEST SQUARE LAKE ROAD
 BLOOMFIELD HILLS - MICHIGAN - 48302
 PH - 248.338.4545 FX - 248.338.0233
 EM - INFO@TMP-ARCHITECTURE.COM

REGISTRATION SEAL

CONSULTANT



PEA GROUP
 t 844.813.2949
 www.peagroup.com

PROJECT TITLE
New Smith Middle School
Bid Package No. 03C



Troy School District
Troy, Michigan

DRAWING TITLE
OVERALL UTILITY PLAN


ISSUE DATES

DATE	ISSUED FOR:
07-12-2024	ADDENDUM NO. 2
06-18-2024	CONSTRUCTION DOCUMENTS
DRAWN	JW
CHECKED	TD
APPROVED	TD

PROJECT NO.
22102
DRAWING NO.
C-5.0

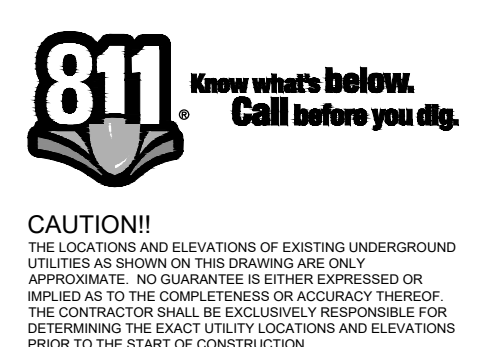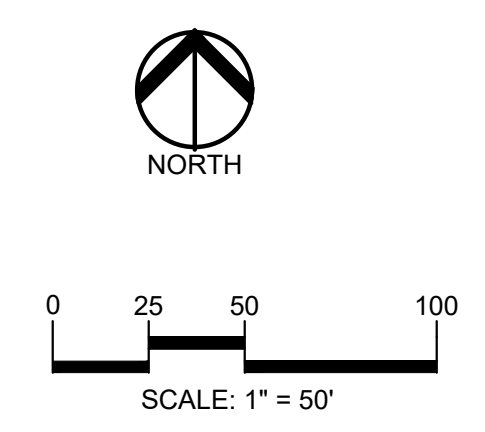

CAUTION!
 THE LOCATION AND DEPTH OF EXISTING UNDERGROUND UTILITIES AND STRUCTURES ON THIS DRAWING ARE ONLY APPROXIMATE. NO GUARANTEE IS GIVEN FOR THE ACCURACY OF THE INFORMATION OR FOR THE CONSEQUENCES OF ACCIDENTS. BEFORE THE CONTRACTOR SHALL BE EXCLUSIVELY RESPONSIBLE FOR DETERMINING THE EXACT LOCATION AND DEPTHS PRIOR TO THE START OF CONSTRUCTION.

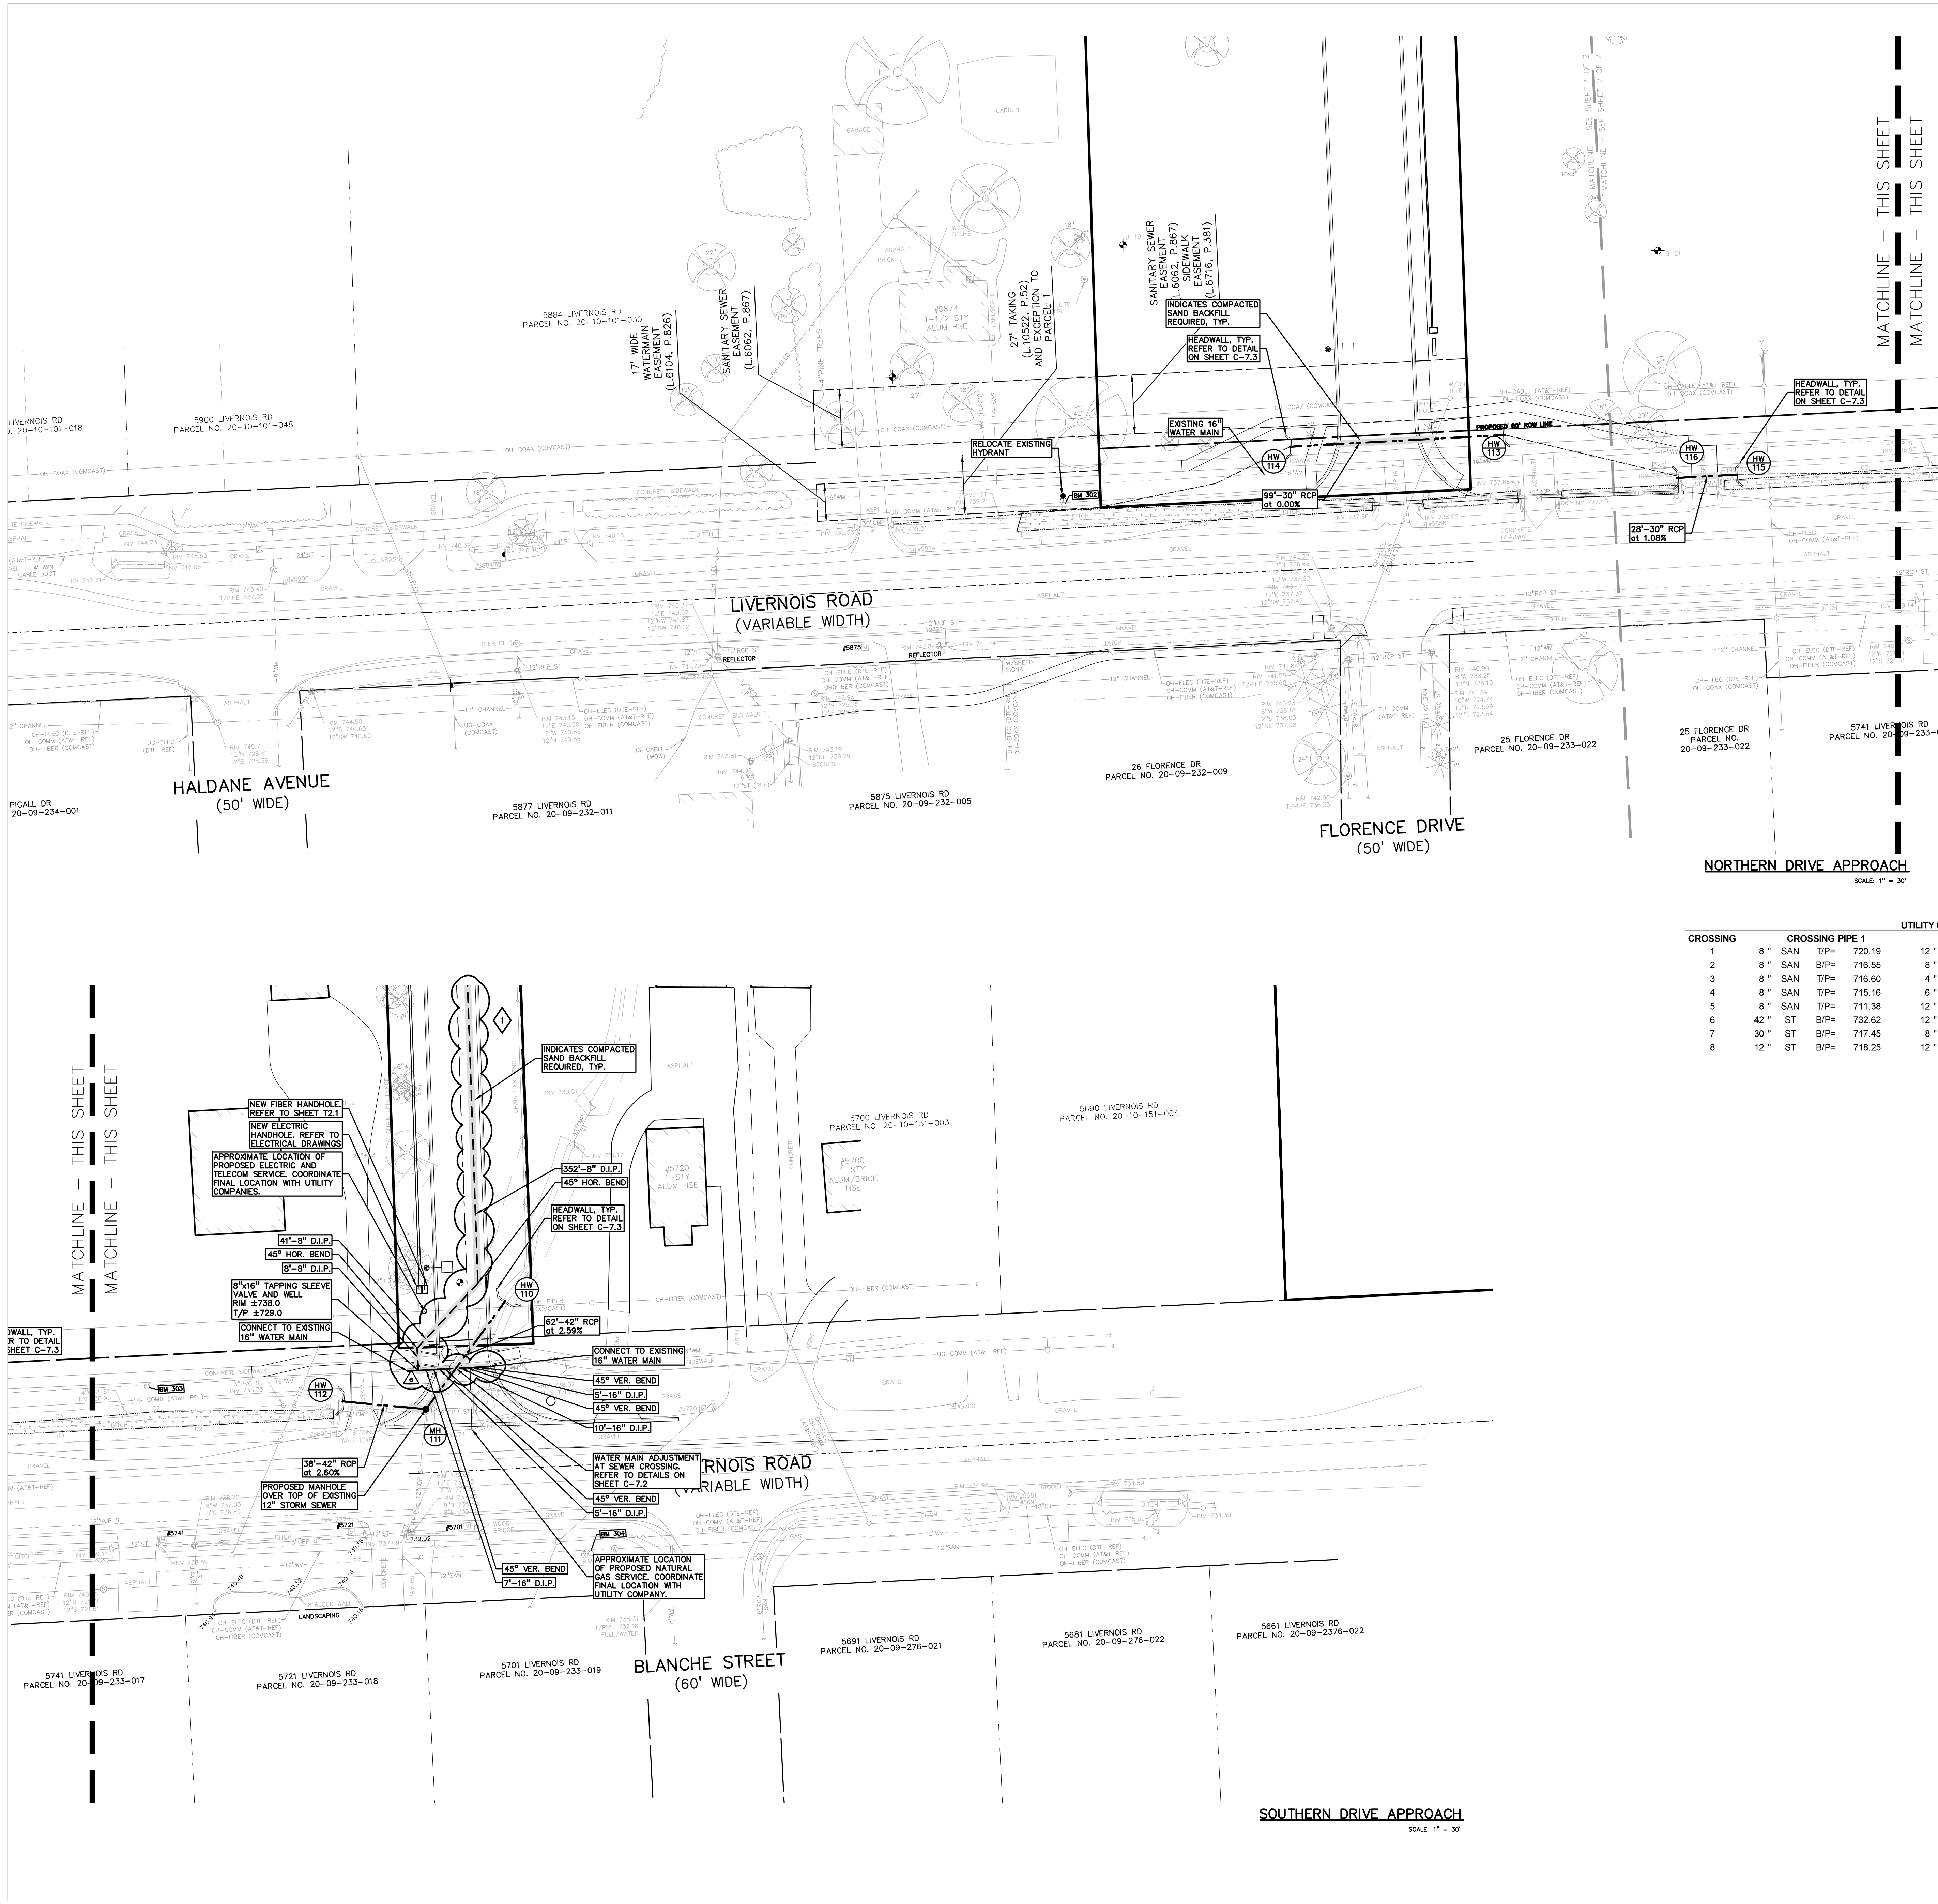

FLOODPLAIN:
 PER FLOOD INSURANCE RATE MAP NUMBER 26125C05327, DATED SEPTEMBER 29, 2006
 BY GRAPHICAL PLOTTING, THE SITE LIES WITHIN:
 SPECIAL FLOOD HAZARD AREAS SUBJECT TO INUNDATION BY THE 1% ANNUAL CHANCE FLOOD
 THE 1% ANNUAL CHANCE FLOOD (100 YEAR FLOOD), ALSO KNOWN AS THE BASE FLOOD, IS THE FLOOD THAT HAS A 1% CHANCE OF BEING EQUALED OR EXCEEDED IN ANY GIVEN YEAR. THE SPECIAL FLOOD HAZARD AREA IS THE AREA SUBJECT TO FLOODING BY THE 1% ANNUAL CHANCE FLOOD. AREAS OF SPECIAL FLOOD HAZARD INCLUDE ZONES A, AE, AH, AO, AR, A99, V AND VE. THE BASE FLOOD ELEVATION IS THE WATER-SURFACE ELEVATION OF THE 1% ANNUAL CHANCE FLOOD.

ZONE A - NO BASE FLOOD ELEVATIONS DETERMINED.
 OTHER AREAS
 ZONE X
 AREA TO BE DETERMINED OUTSIDE OF THE 0.2% ANNUAL CHANCE FLOODPLAIN.

LEGAL DESCRIPTION:
 PARCEL ID 20-10-101-054
 Land in the City of Troy, Oakland County, Michigan, described as follows:
 T2N, R11E, SEC 10 PART OF NW 1/4 BEG AT PT DIST S 571.05 FT & S 89.57-00 E 697.50 FT & S 00-10-00 E 189.24 FT FROM NW SEC COR, TH S 89-40-00 E 624.96 FT, TH S 00-10-00 E 693.20 FT, TH N 89-00-00 W 181.78 FT, TH N 00-10-00 W 637.72 FT, TH S 89-02-00 E 275.00 FT, TH N 00-10-00 W 39.24 FT TO BEG 13.79 A

PARCEL ID 20-10-151-022
 Land in the City of Troy, Oakland County, Michigan, described as follows:
 T2N, R11E, SEC 10 SUPERVISOR'S PLAT NO 25 LOTS 5, 6 & 7, ALSO E 900 FT OF LOTS 8 & 9, ALSO LOT 10 EXC W 37.82 FT OF S 104.29 FT

BENCHMARKS:
 (GPS DERIVED - NAVD83)
 BM #30
 ARROW ON A HYDRANT LOCATED AT THE SOUTHWEST CORNER OF THE FRONT PARKING LOT.
 ELEV. = 724.13
 BM #31
 ARROW ON A HYDRANT LOCATED ON THE SOUTHWEST CORNER OF THE BACK PARKING LOT.
 ELEV. = 728.34

- UTILITY LEGEND:**
- OH-ELEC — EX. OH. ELEC. POLE & GUY WIRE
 - UG-CATV — EX. U.G. CABLE TV & PEDESTAL
 - UG-COMM — EX. U.G. COMMUNICATION LINE, PEDESTAL & MANHOLE
 - UG-ELEC — EX. U.G. ELEC. MANHOLE, METER & HANDHOLE
 - EX. GAS LINE
 - EX. GAS VALVE & GAS LINE MARKER
 - EX. TRANSFORMER & IRRIGATION VALVE
 - EX. WATER MAIN
 - EX. HYDRANT, GATE VALVE & POST INDICATOR VALVE
 - EX. WATER VALVE BOX & SHUTOFF
 - EX. SANITARY SEWER
 - EX. SANITARY CLEANOUT & MANHOLE
 - EX. COMBINED SEWER MANHOLE
 - EX. STORM SEWER
 - EX. CLEANOUT & MANHOLE
 - EX. SQUARE, ROUND, & BEEHIVE CATCH BASIN
 - EX. YARD DRAIN & ROOF DRAIN
 - EX. UNIDENTIFIED STRUCTURE
 - PROPOSED WATER MAIN
 - PROPOSED HYDRANT AND GATE VALVE
 - PROPOSED TAPPING SLEEVE, VALVE & WELL
 - PROPOSED POST INDICATOR VALVE
 - PROPOSED SANITARY SEWER
 - PROPOSED SANITARY CLEANOUT & MANHOLE
 - PROPOSED STORM SEWER
 - PROPOSED STORM SEWER CLEANOUT & MANHOLE
 - PROPOSED CATCH BASIN, INLET & YARD DRAIN

UTILITY CROSSING TABLE

CROSSING	CROSSING PIPE 1	CROSSING PIPE 2	CLEARANCE	NOTES
1	8" SAN T/P = 720.19	12" ST B/P = 721.78	1.59	
2	8" SAN B/P = 716.55	8" WM T/P = 715.05	1.50	DIP WATER MAIN
3	8" SAN T/P = 716.60	4" GAS B/P = 718.64	2.04	
4	8" SAN T/P = 715.16	6" ST B/P = 722.53	7.38	
5	8" SAN T/P = 711.38	12" WM T/P = 712.96	1.58	
6	42" ST B/P = 732.62	12" WM T/P = 731.12	1.50	DIP WATER MAIN
7	30" ST B/P = 717.45	8" WM T/P = 715.95	1.50	DIP WATER MAIN
8	12" ST B/P = 718.25	12" WM T/P = 715.19	3.06	



TMP ARCHITECTURE INC
 191 WEST SQUARE LAKE ROAD
 BLOOMFIELD HILLS - MICHIGAN - 48302
 PH - 248.338.4545 FX - 248.338.0233
 EM - INFO@TMP-ARCHITECTURE.COM

REGISTRATION SEAL

CONSULTANT



PEA GROUP
 t 844.813.2949
 www.peagroup.com

PROJECT TITLE
New Smith Middle School Bld Package No. 03C

Troy School District Troy, Michigan


DRAWING TITLE
UTILITY PLAN - LIVERNOIS

ISSUE DATES

DATE ISSUED FOR:

DRAWN JW
 CHECKED TD
 APPROVED TD

PROJECT NO.
22102
 DRAWING NO.
C-5.3

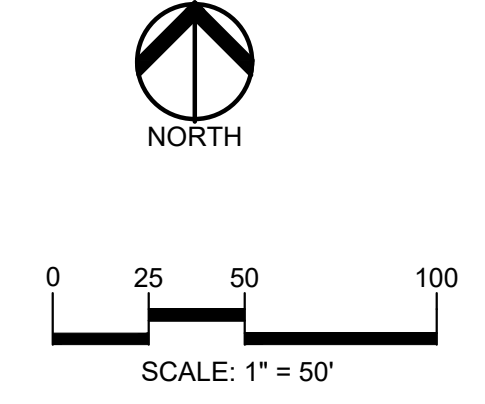

CAUTION!
 THE LOCATION AND DEPTH OF UTILITIES SHOWN ON THIS DRAWING ARE ONLY APPROXIMATE. NO GUARANTEE IS MADE BY THE ENGINEER AS TO THE ACCURACY OF THE INFORMATION PROVIDED. THE CONTRACTOR SHALL BE RESPONSIBLE FOR VERIFYING THE LOCATION AND DEPTH OF UTILITIES PRIOR TO THE START OF CONSTRUCTION.

Drawing File: S:\PROJECTS\2023\21-0301 - TROY SCHOOL DISTRICT CONSTRUCTION\NEW SMITH MIDDLE\03-C-5.3 UTILITY PLAN - LIVERNOIS.dwg
 Job #: 21-0301 - 9-24-23



TMP ARCHITECTURE INC
191 WEST SQUARE LAKE ROAD
BLOOMFIELD HILLS - MICHIGAN - 48302
PH - 248.338.4545 FX - 248.338.0223
EM - INFO@TMP-ARCHITECTURE.COM

REGISTRATION SEAL

CONSULTANT



PROJECT TITLE
New Smith Middle School Bid Package No. 03C

Troy School District Troy, Michigan

DRAWING TITLE
SANITARY SEWER & WATER MAIN PROFILES


ISSUE DATES

DATE	ISSUED FOR:
07-12-2024	ADDENDUM NO. 2
06-18-2024	CONSTRUCTION DOCUMENTS
DRAWN	JW
CHECKED	TD
APPROVED	TD


PROJECT NO.
22102
DRAWING NO.
C-6.0




CAUTION!
THE LOCATION AND DEPTH OF EXISTING UTILITIES SHOWN ON THIS DRAWING ARE ONLY APPROXIMATE. THE CONTRACTOR IS RESPONSIBLE FOR VERIFYING THE LOCATION AND DEPTH OF ALL UTILITIES PRIOR TO THE START OF CONSTRUCTION.

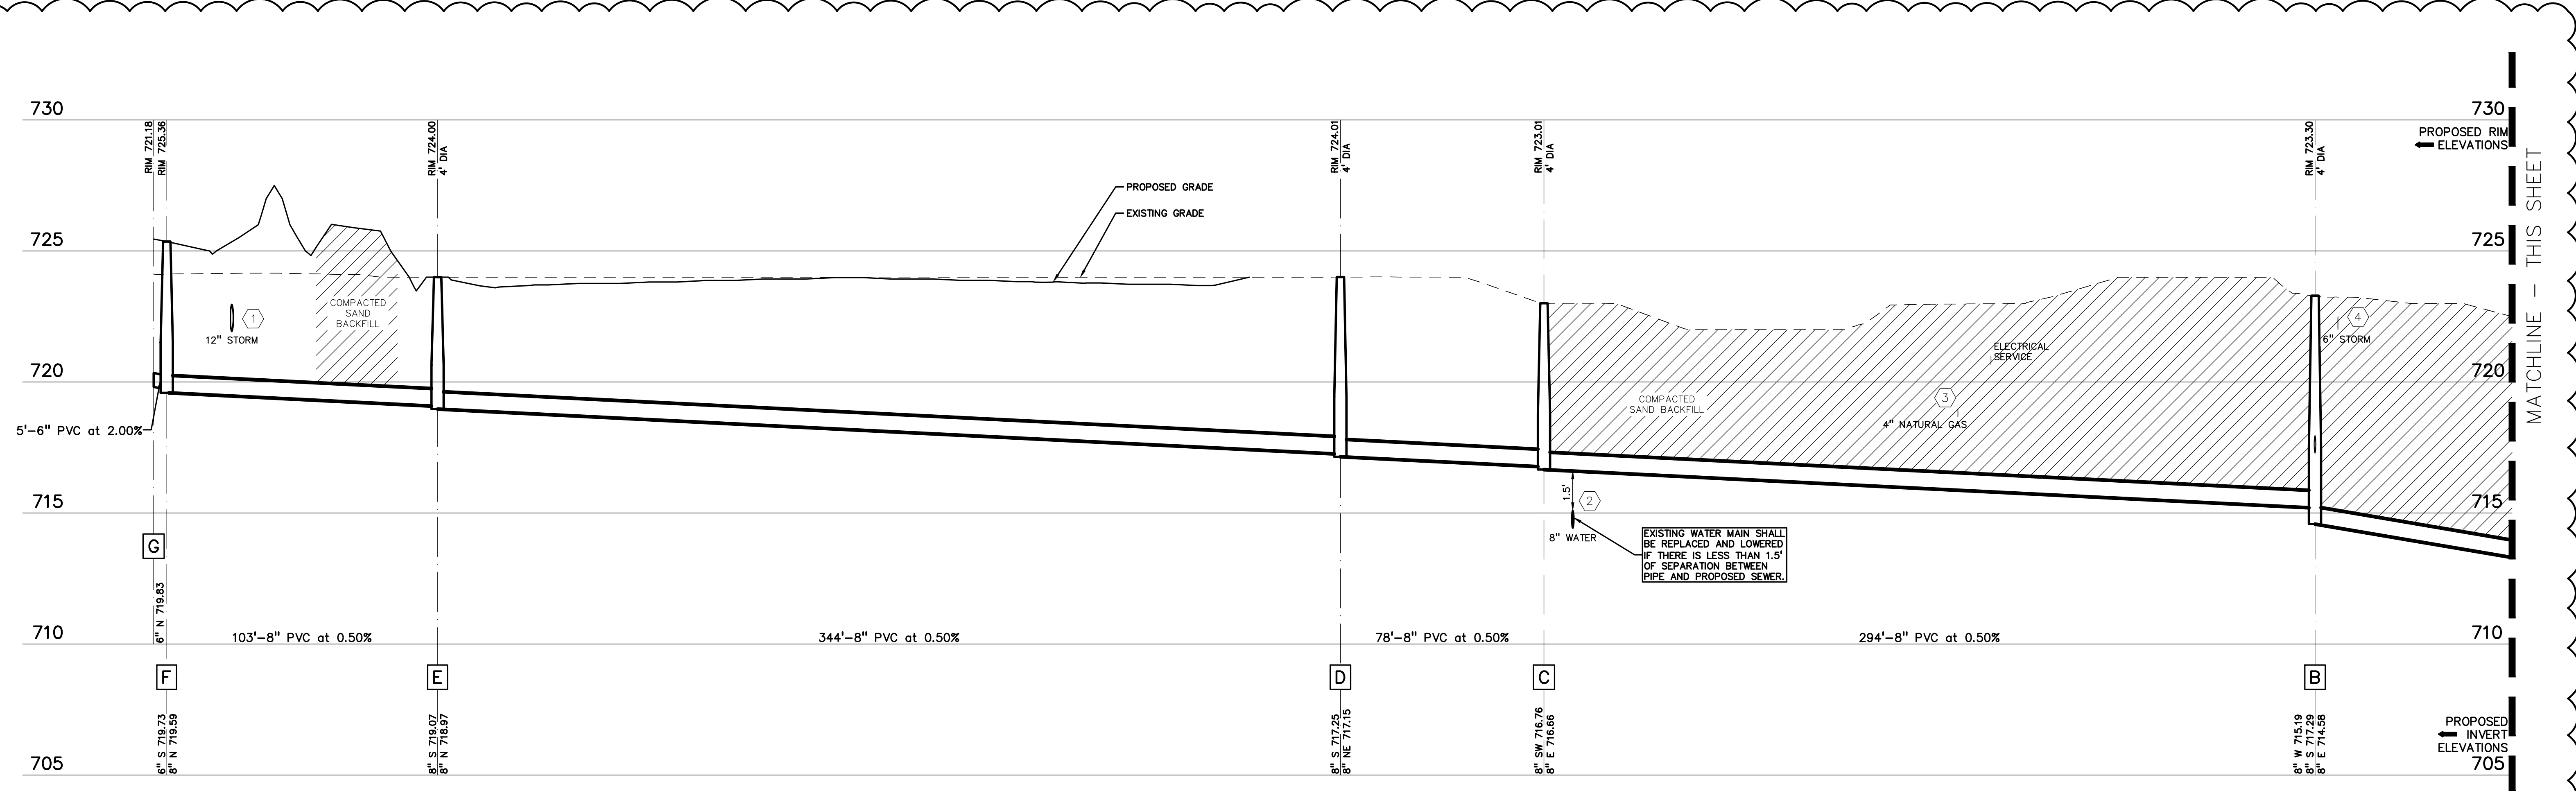

SANITARY G-A PROFILE
HORIZ: 1" = 30'
VERT: 1" = 3'

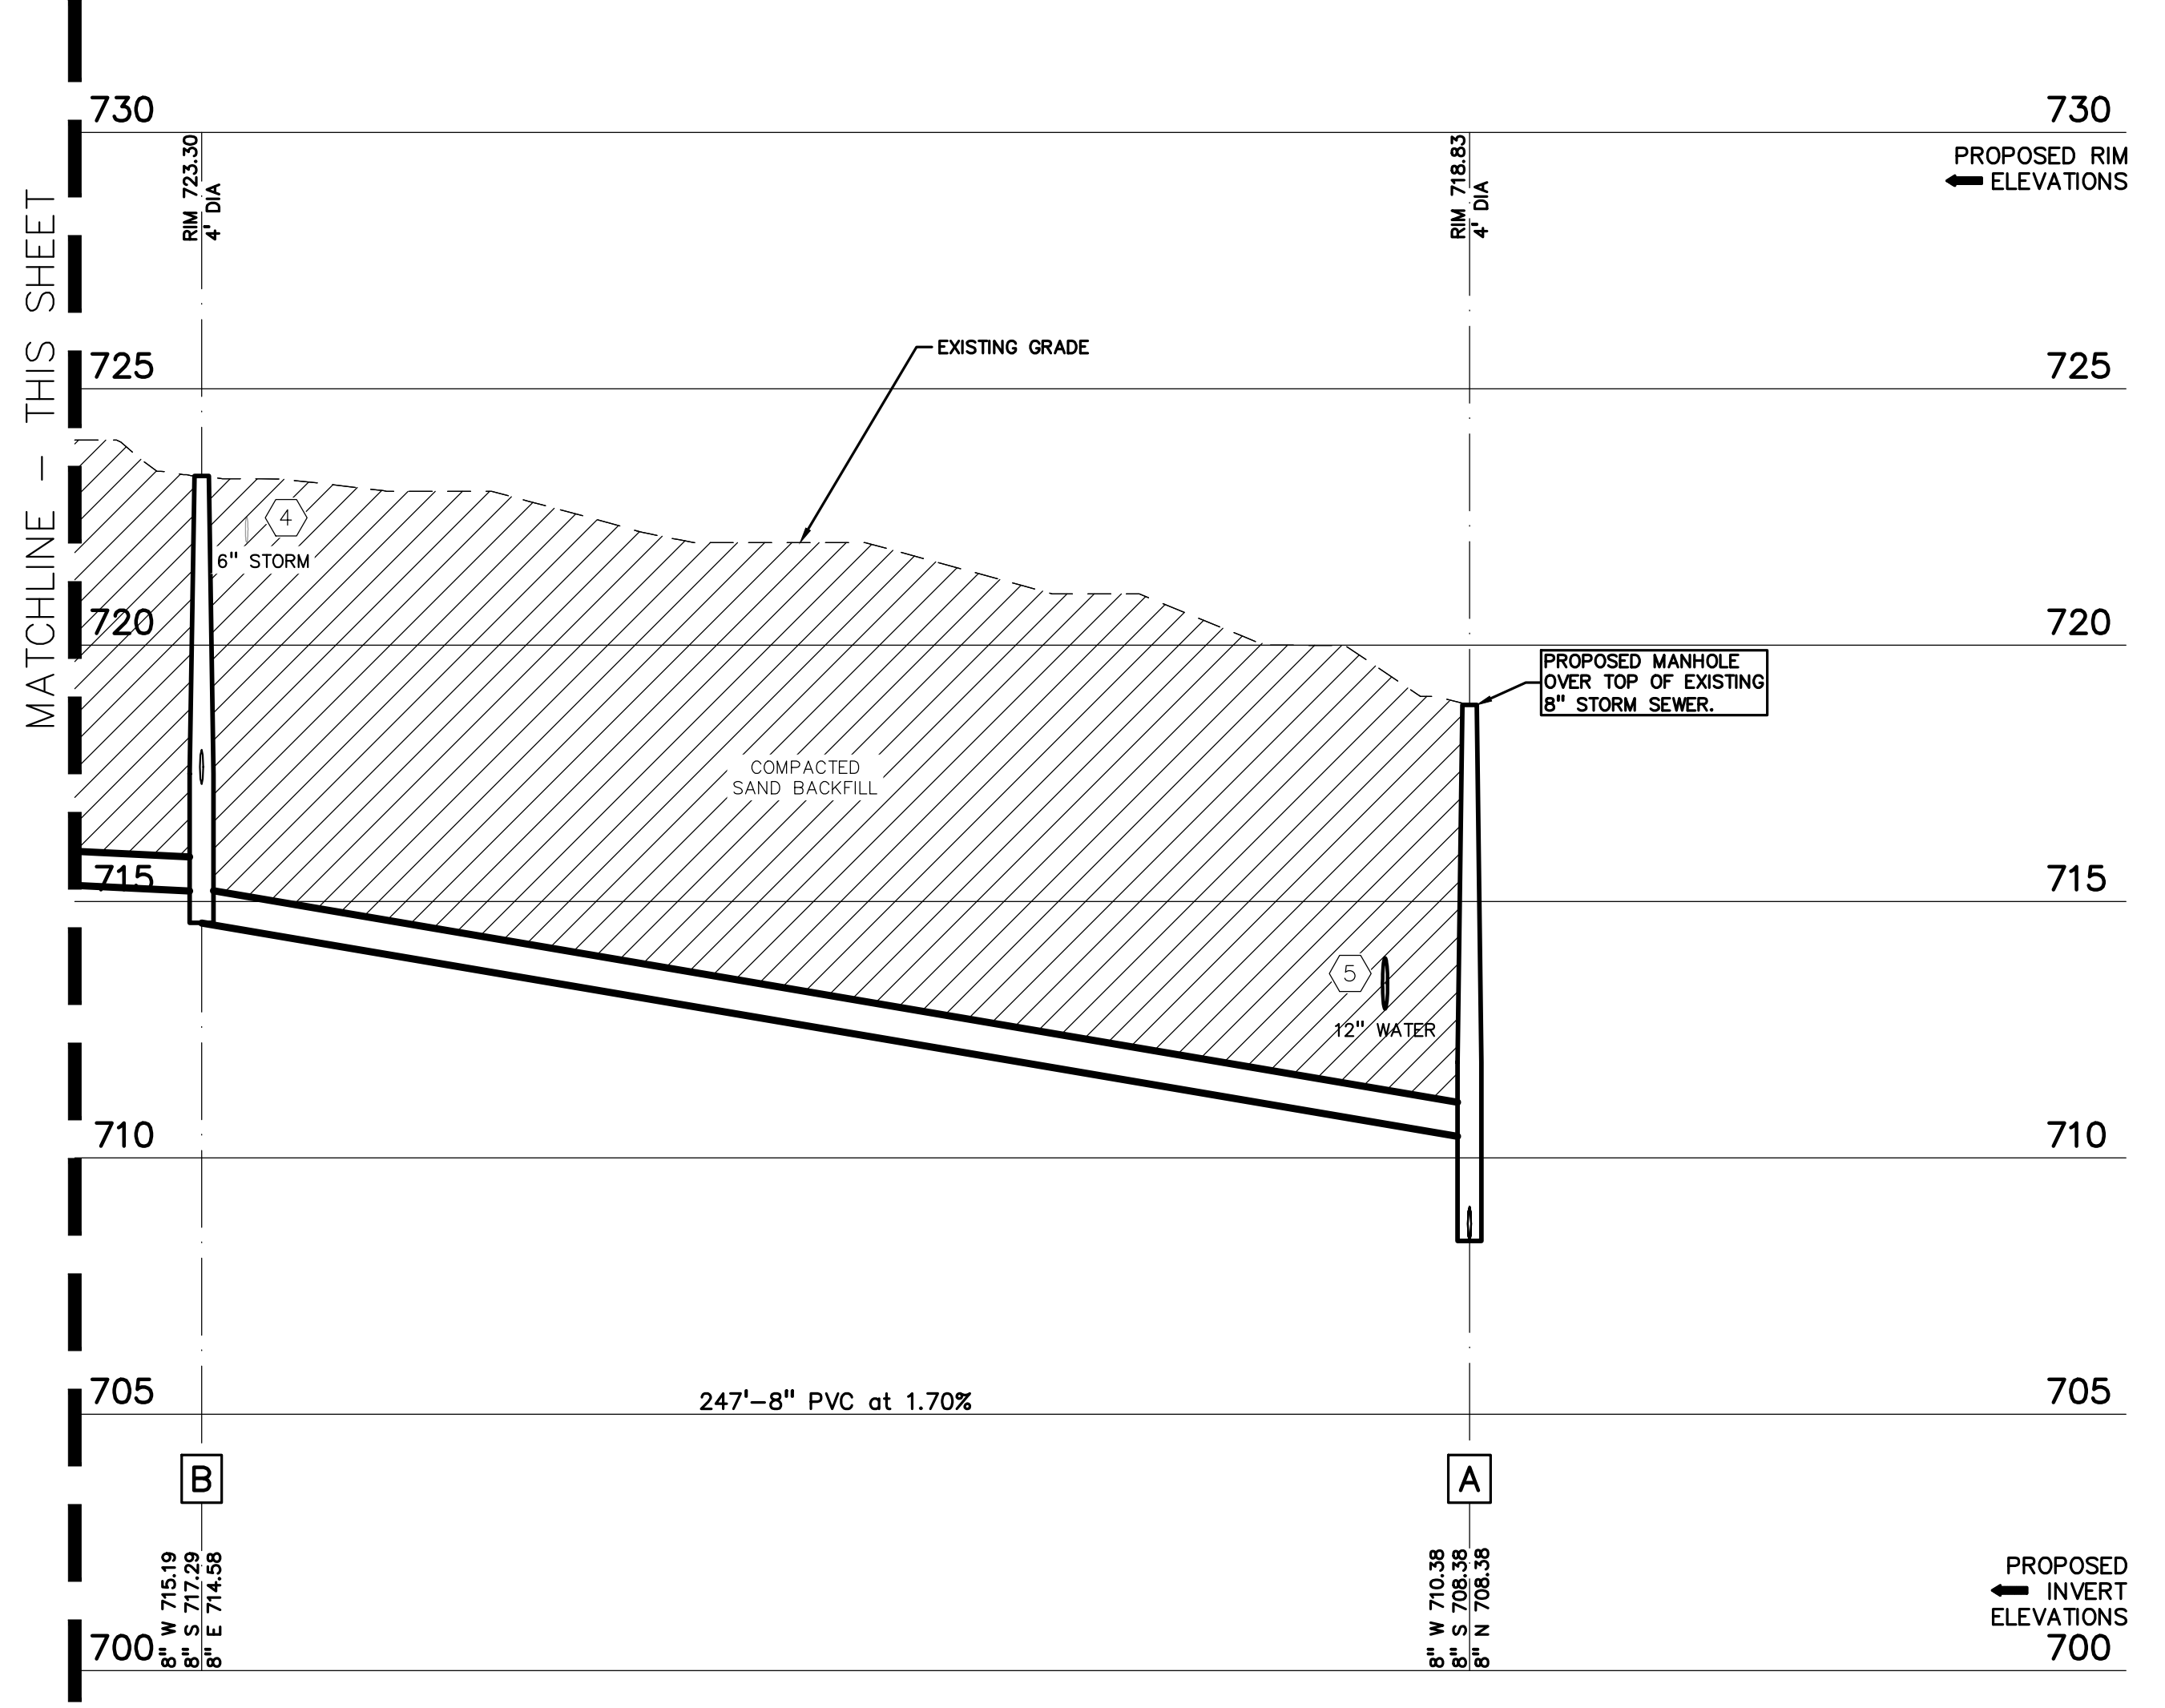

SANITARY G-A PROFILE

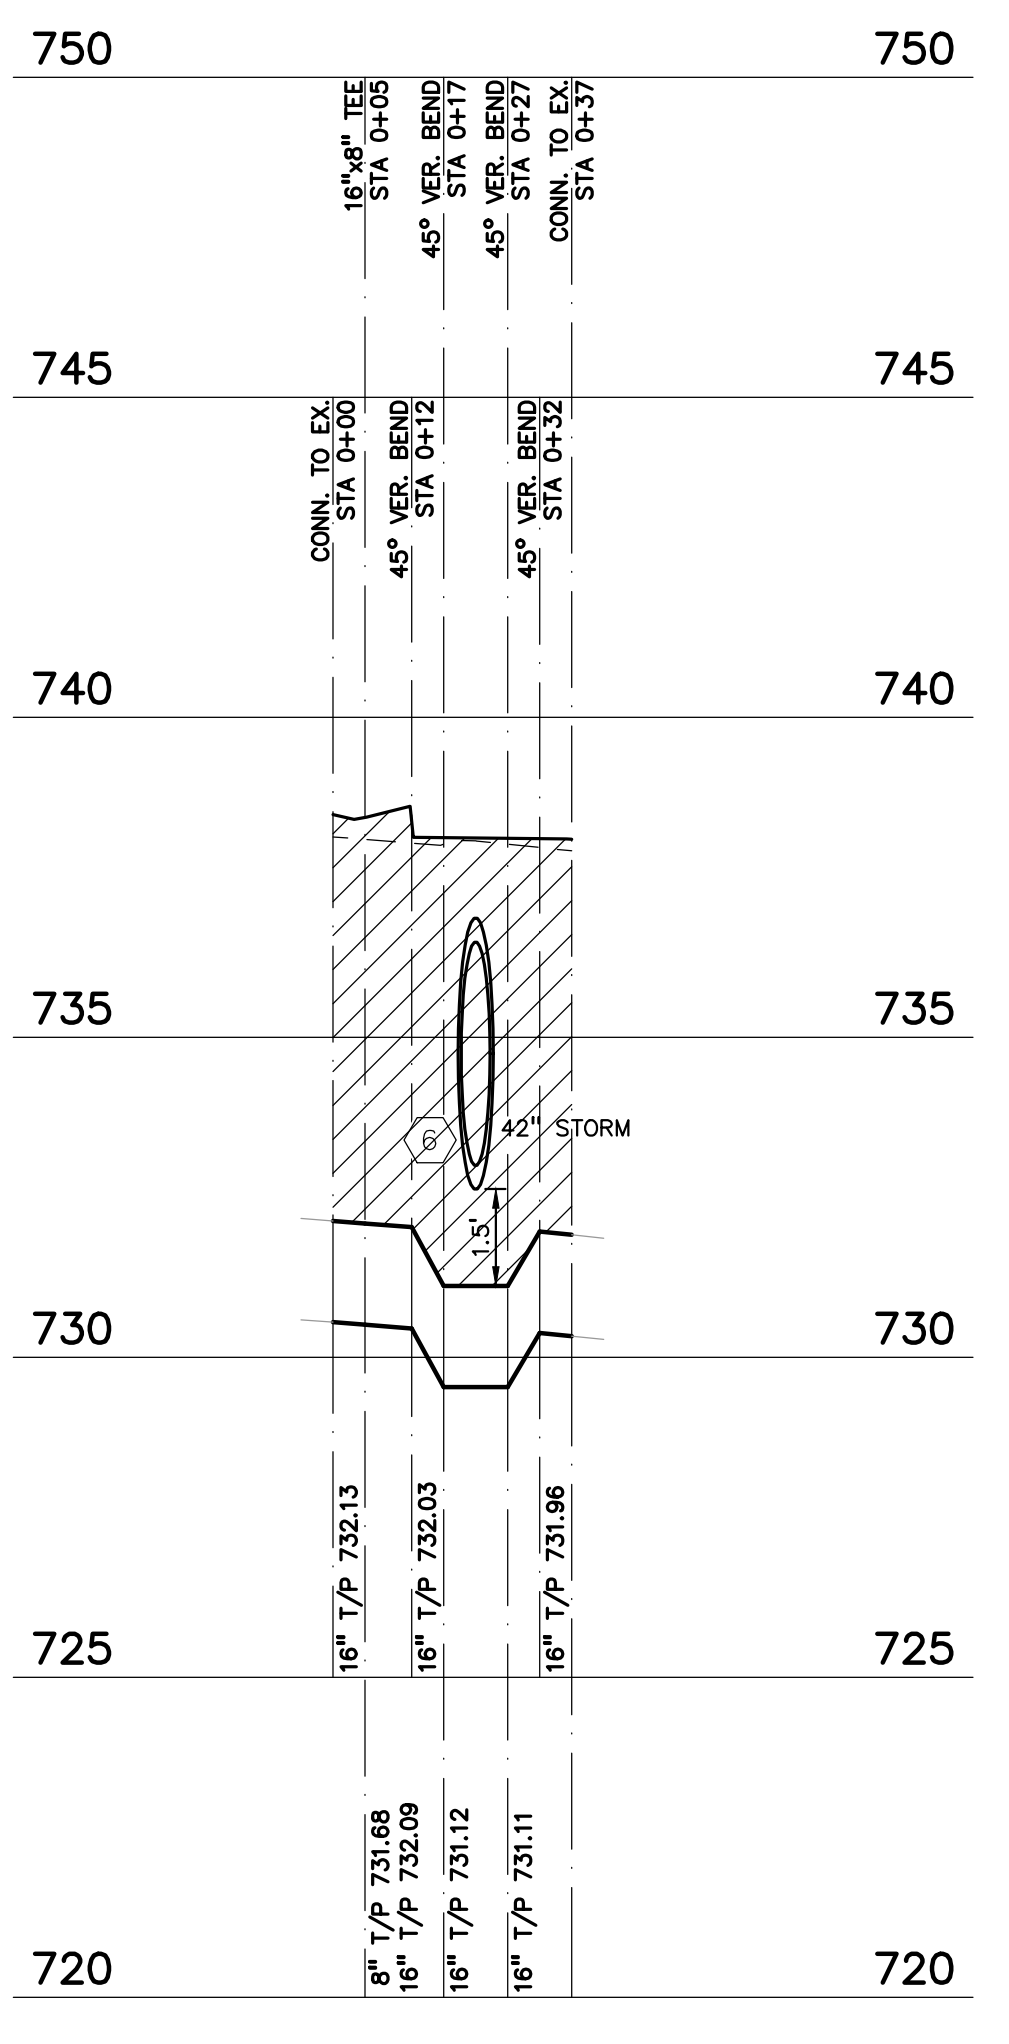

WATER MAIN PROFILE

Owners File: S:\PROJECTS\2023\24-001_TROY_SCHOOLS_2022_BIDDING\DWG\CONSTRUCTION\NEW_SMTM_ARCH\DWG\C-6.0_PIPES-24-001.dwg
 Job: 11, 2024 - 7/25/2024



TMP ARCHITECTURE INC
191 WEST SQUARE LAKE ROAD
BLOOMFIELD HILLS - MICHIGAN - 48302
PH - 248.338.4545 FX - 248.338.0223
EM - INFO@TMP-ARCHITECTURE.COM

REGISTRATION SEAL

CONSULTANT

PEA GROUP
t 844.813.2949
www.peagroup.com

PROJECT TITLE
**New Smith Middle School
Bid Package No. 03C**

**Troy School District
Troy, Michigan**

DRAWING TITLE
STORM SEWER PROFILES





ISSUE DATES

DATE	ISSUED FOR:
07-12-2024	ADDENDUM NO. 2
06-18-2024	CONSTRUCTION DOCUMENTS
DRAWN	JW
CHECKED	TD
APPROVED	TD

PROJECT NO.
22102
DRAWING NO.
C-6.1



CAUTION!
THE LOCATION, DEPTH AND DIRECTION OF EXISTING UTILITIES AS SHOWN ON THIS DRAWING ARE ONLY APPROXIMATE. NO GUARANTEE IS MADE THEREOF OR ANY OTHER INFORMATION. THE CONTRACTOR SHALL BE EXCLUSIVELY RESPONSIBLE FOR DETERMINING THE EXACT LOCATION, DEPTH AND ELEVATIONS PRIOR TO THE START OF CONSTRUCTION.

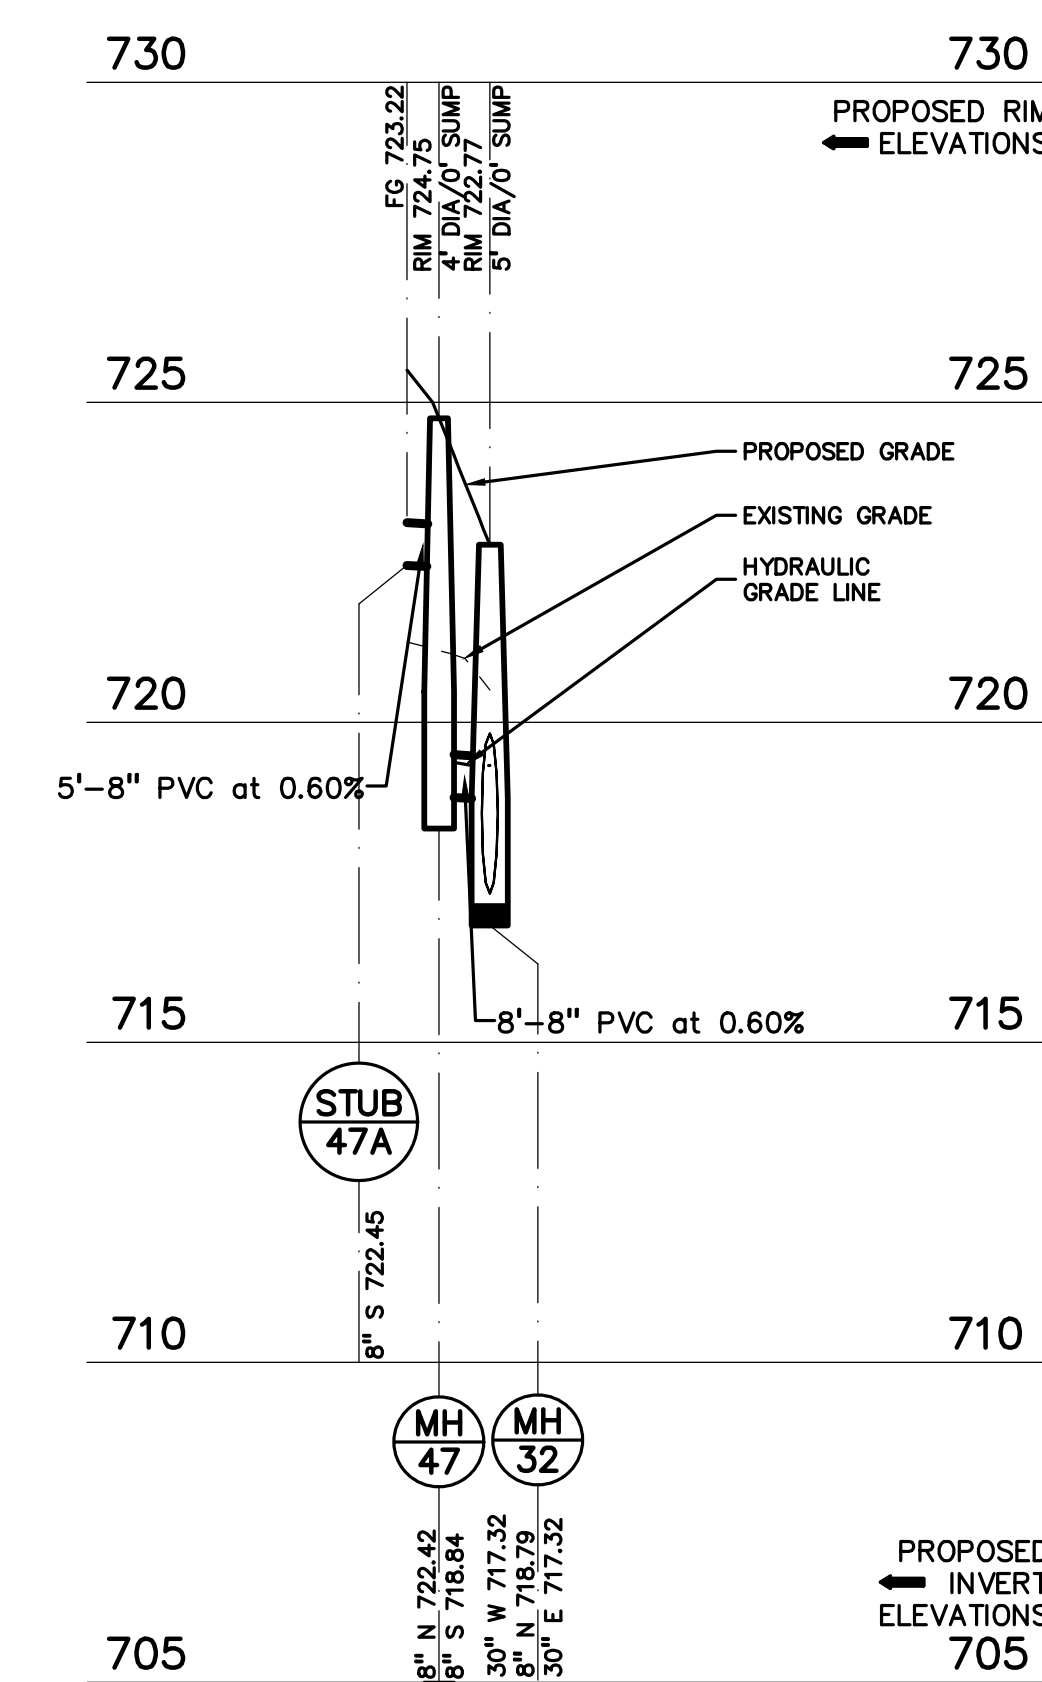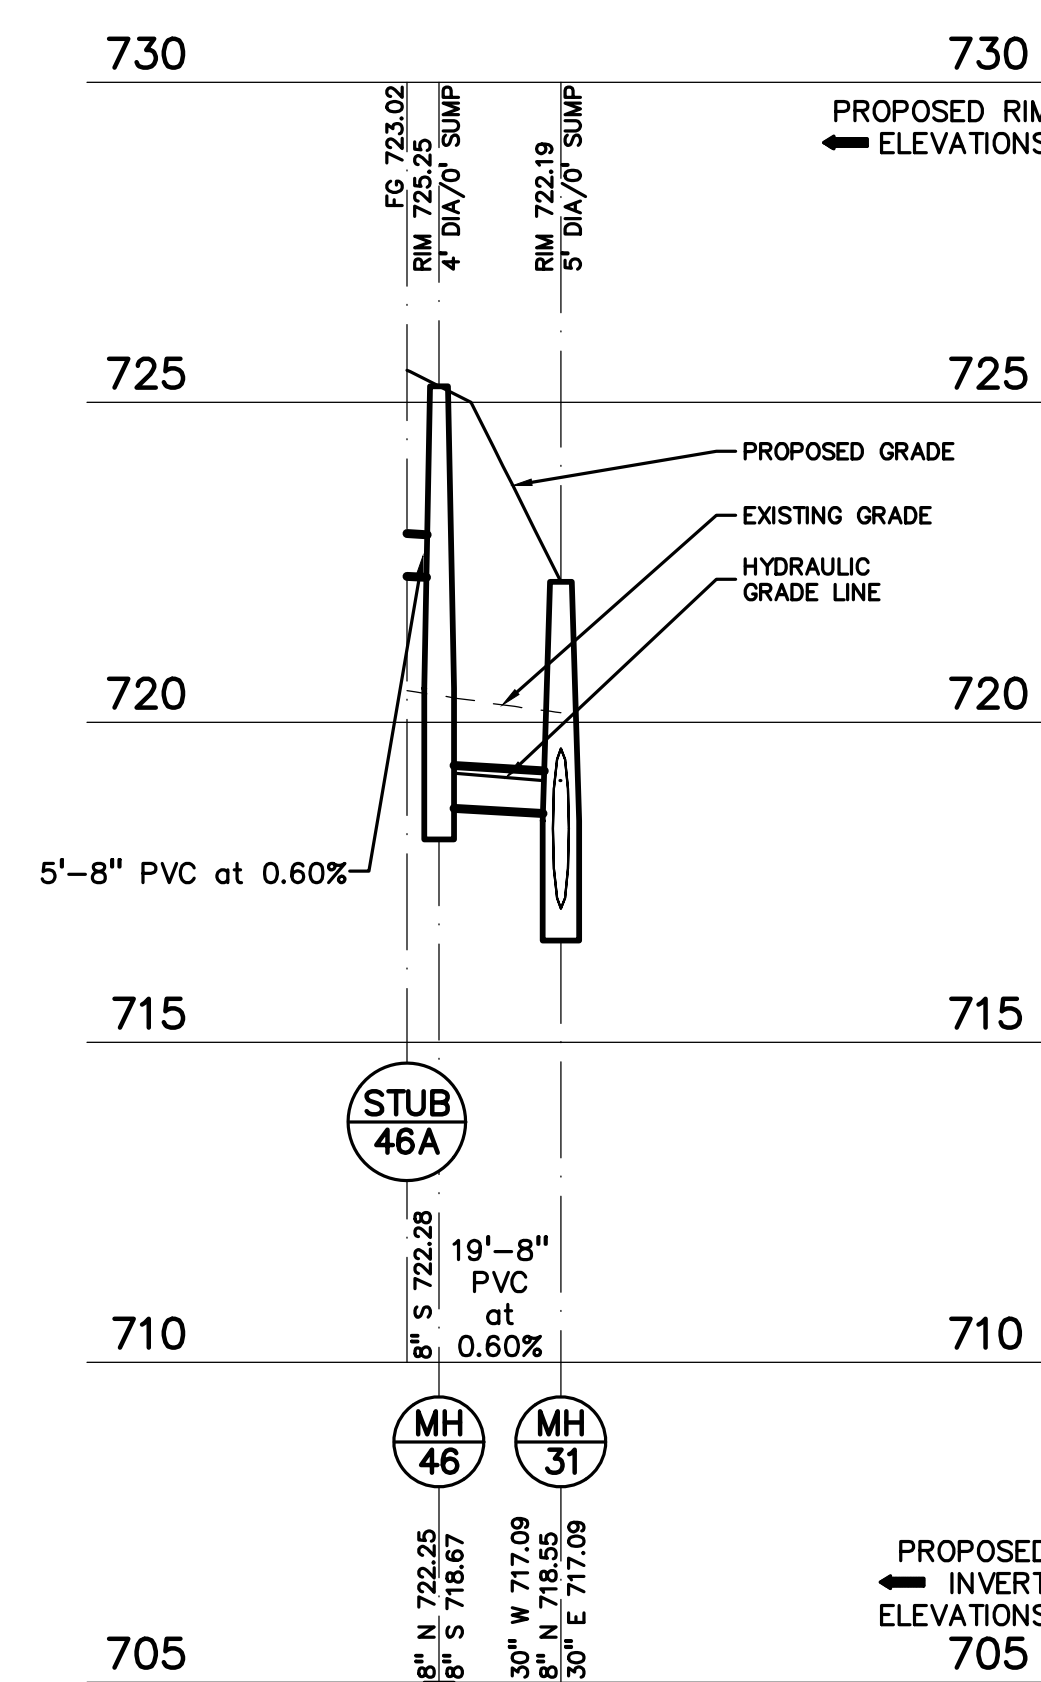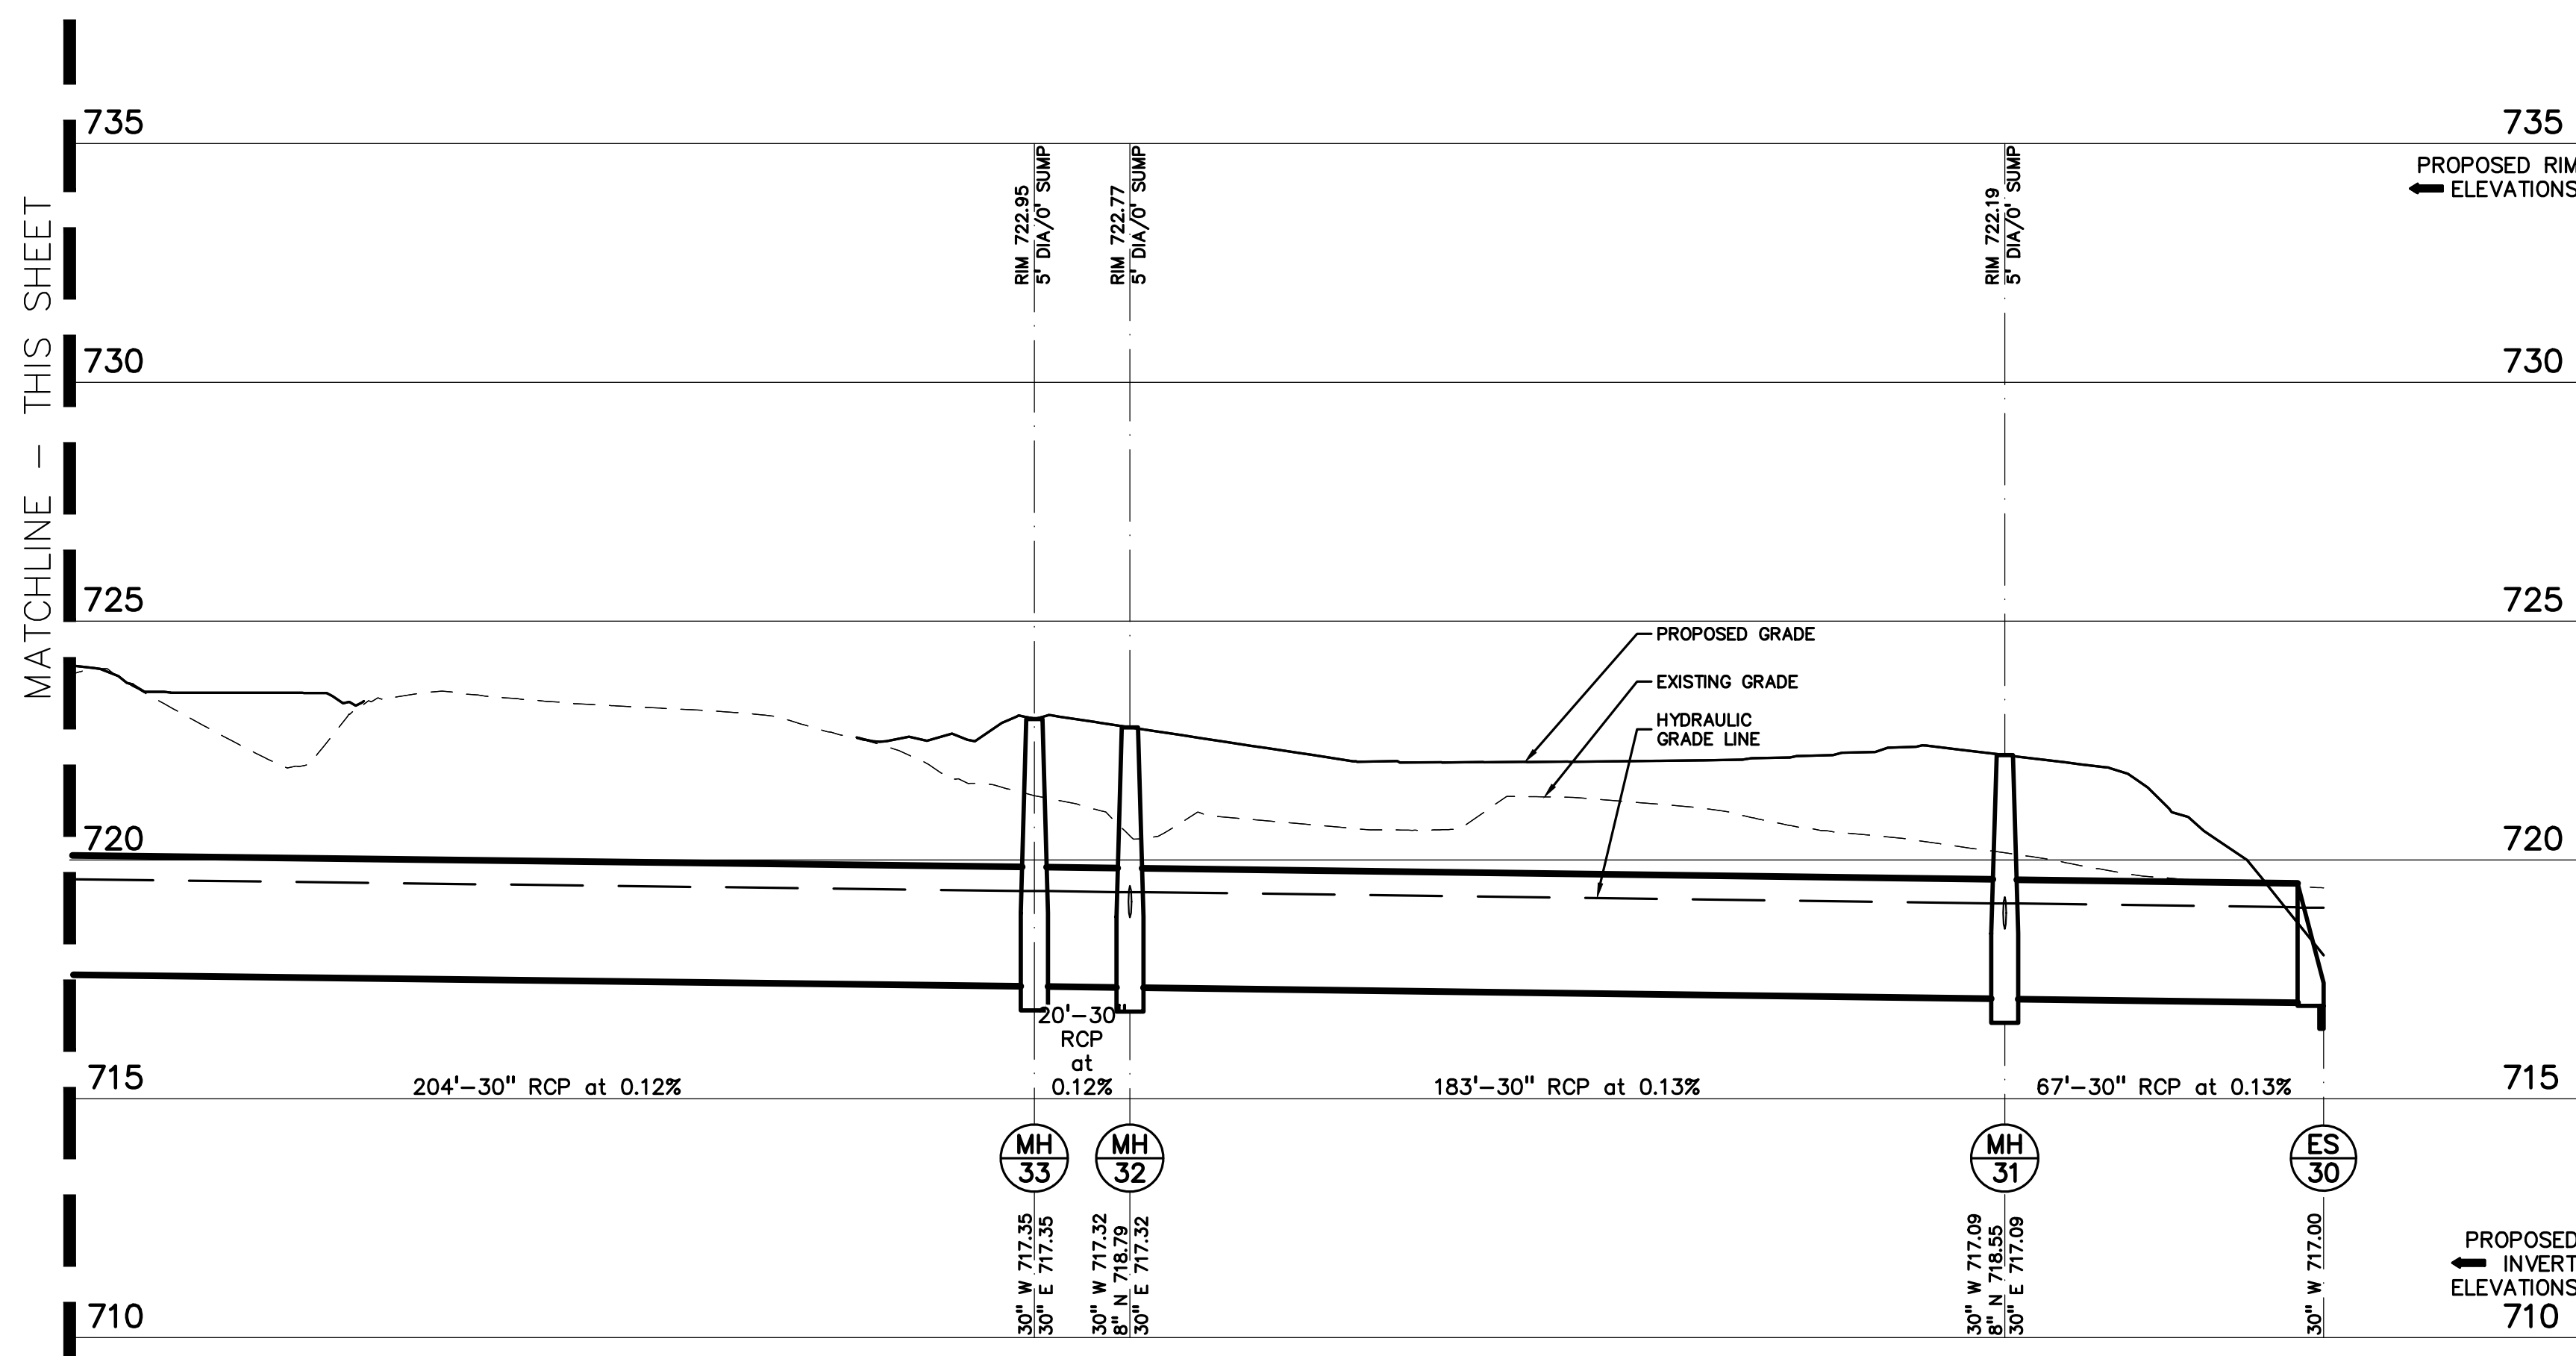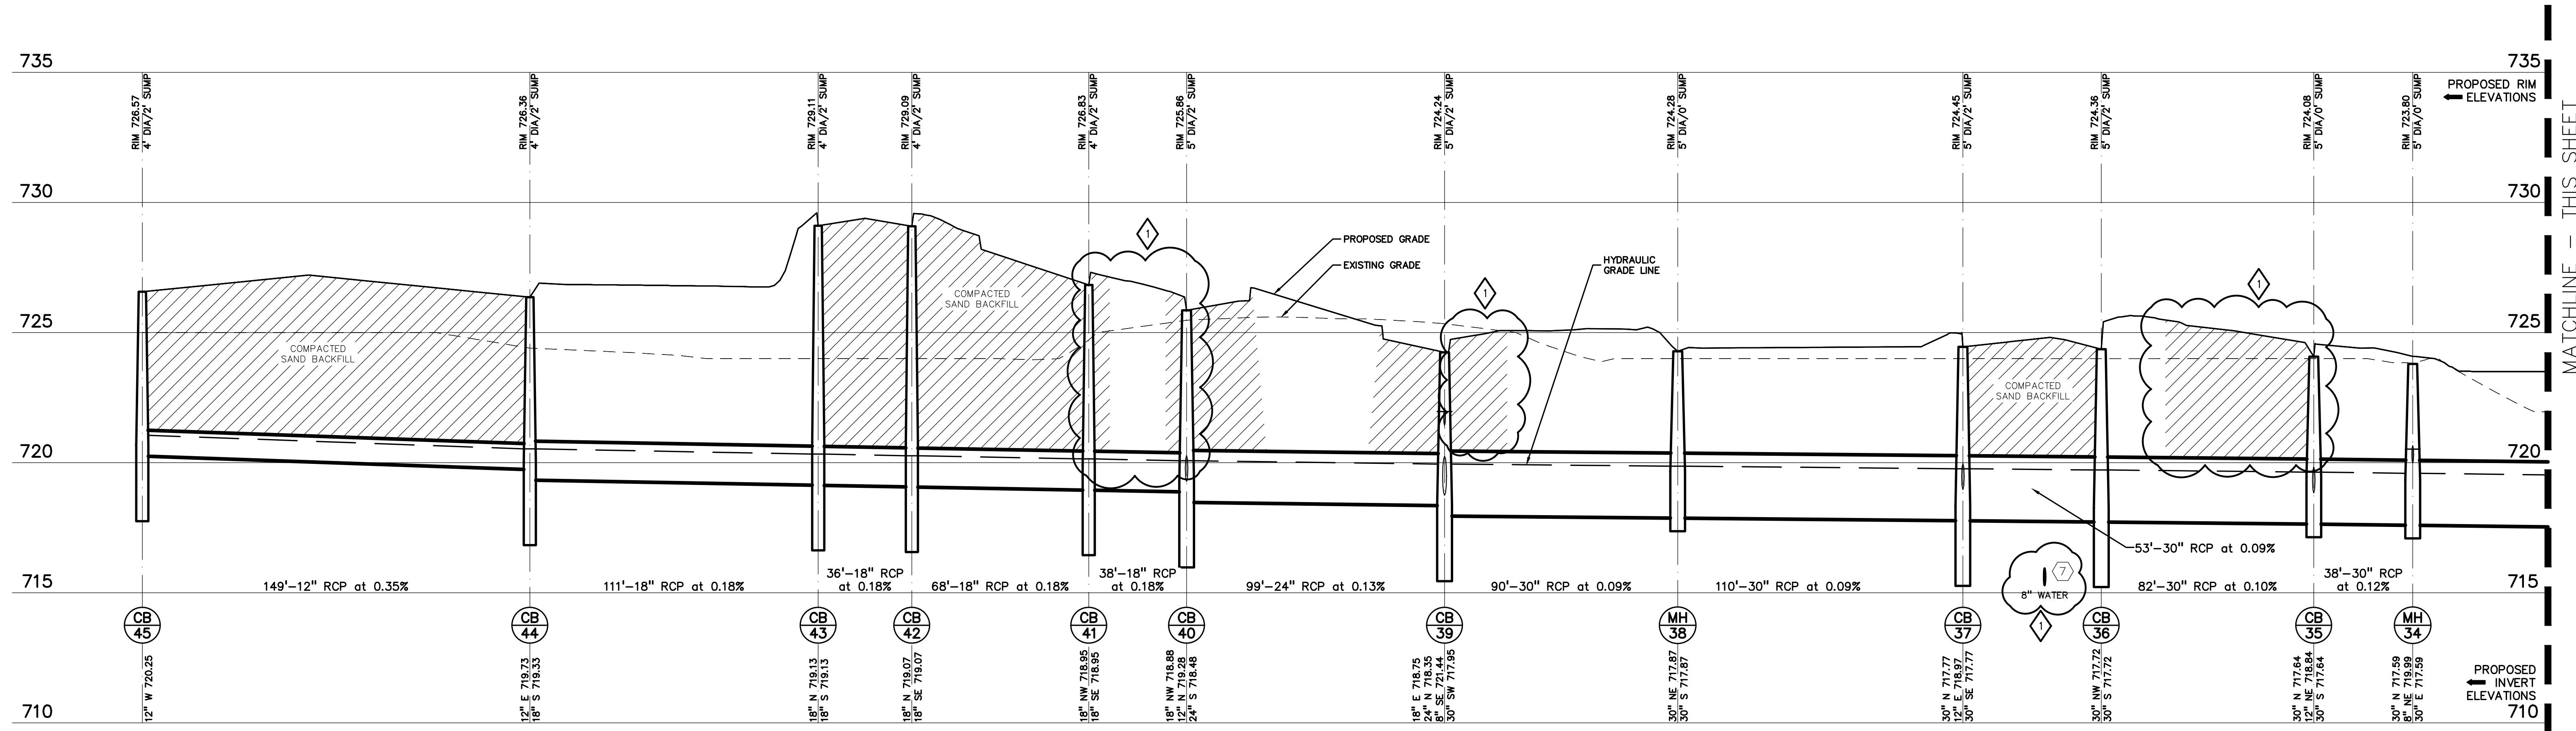

REGISTRATION SEAL

CONSULTANT



PROJECT TITLE
**New Smith Middle School
Bid Package No. 03C**

**Troy School District
Troy, Michigan**

DRAWING TITLE
STORM SEWER PROFILES

ISSUE DATES

07-12-2024 ADDENDUM NO. 2
06-18-2024 CONSTRUCTION DOCUMENTS

DATE ISSUED FOR:

DRAWN .JW

CHECKED TD

APPROVED TD

PROJECT NO.


22102

DRAWING NO.

C-6.2




CAUTION!
THE LOCATION, DEPTH AND DIRECTION OF EXISTING UTILITIES ARE SHOWN ON THIS DRAWING AS ONLY APPROXIMATE. NO GUARANTEE IS MADE THEREOF OR ANY OTHER INFORMATION CONTAINED HEREIN. THE CONTRACTOR SHALL BE EXCLUSIVELY RESPONSIBLE FOR DETERMINING THE EXACT LOCATION AND ELEVATIONS PRIOR TO THE START OF CONSTRUCTION.

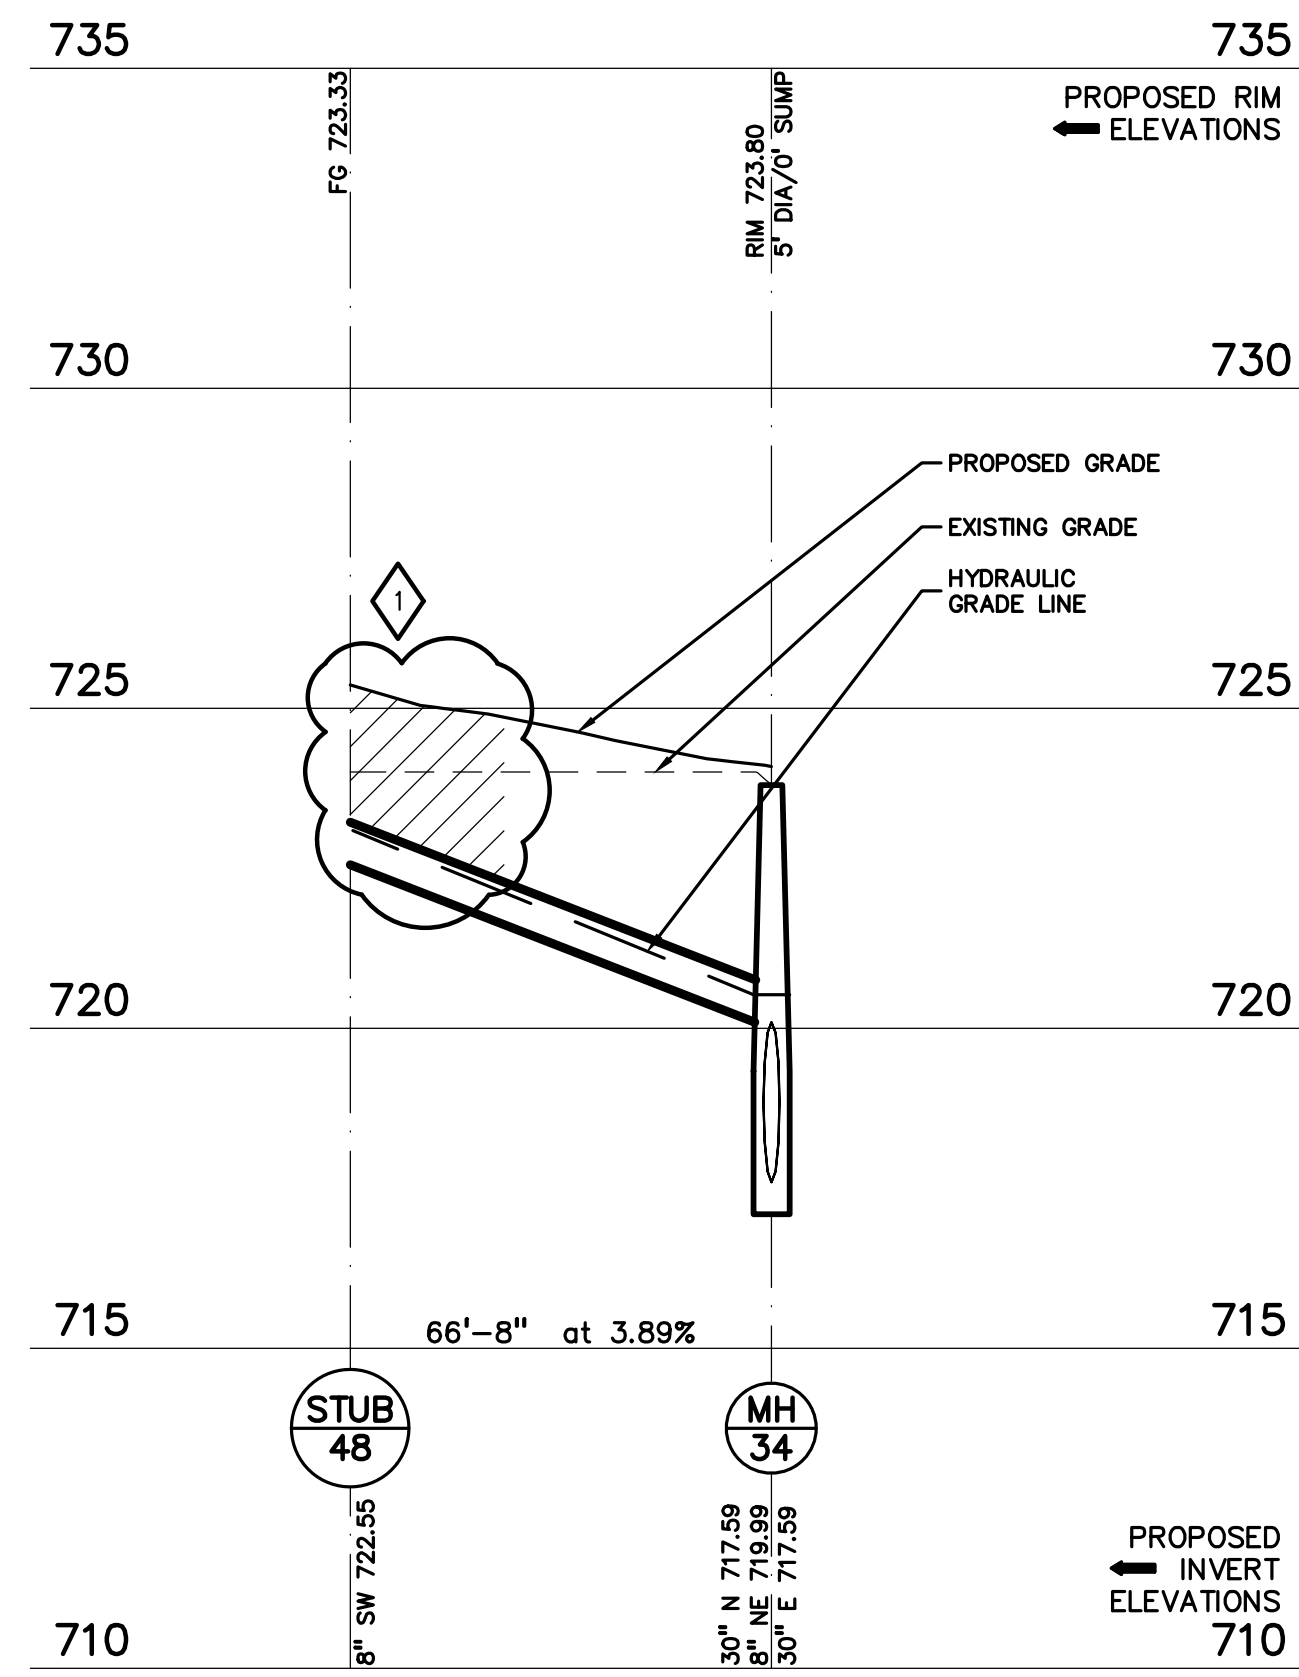


STORM 48-34 PROFILE

HORIZ: 1" = 30'
VERT: 1" = 3'

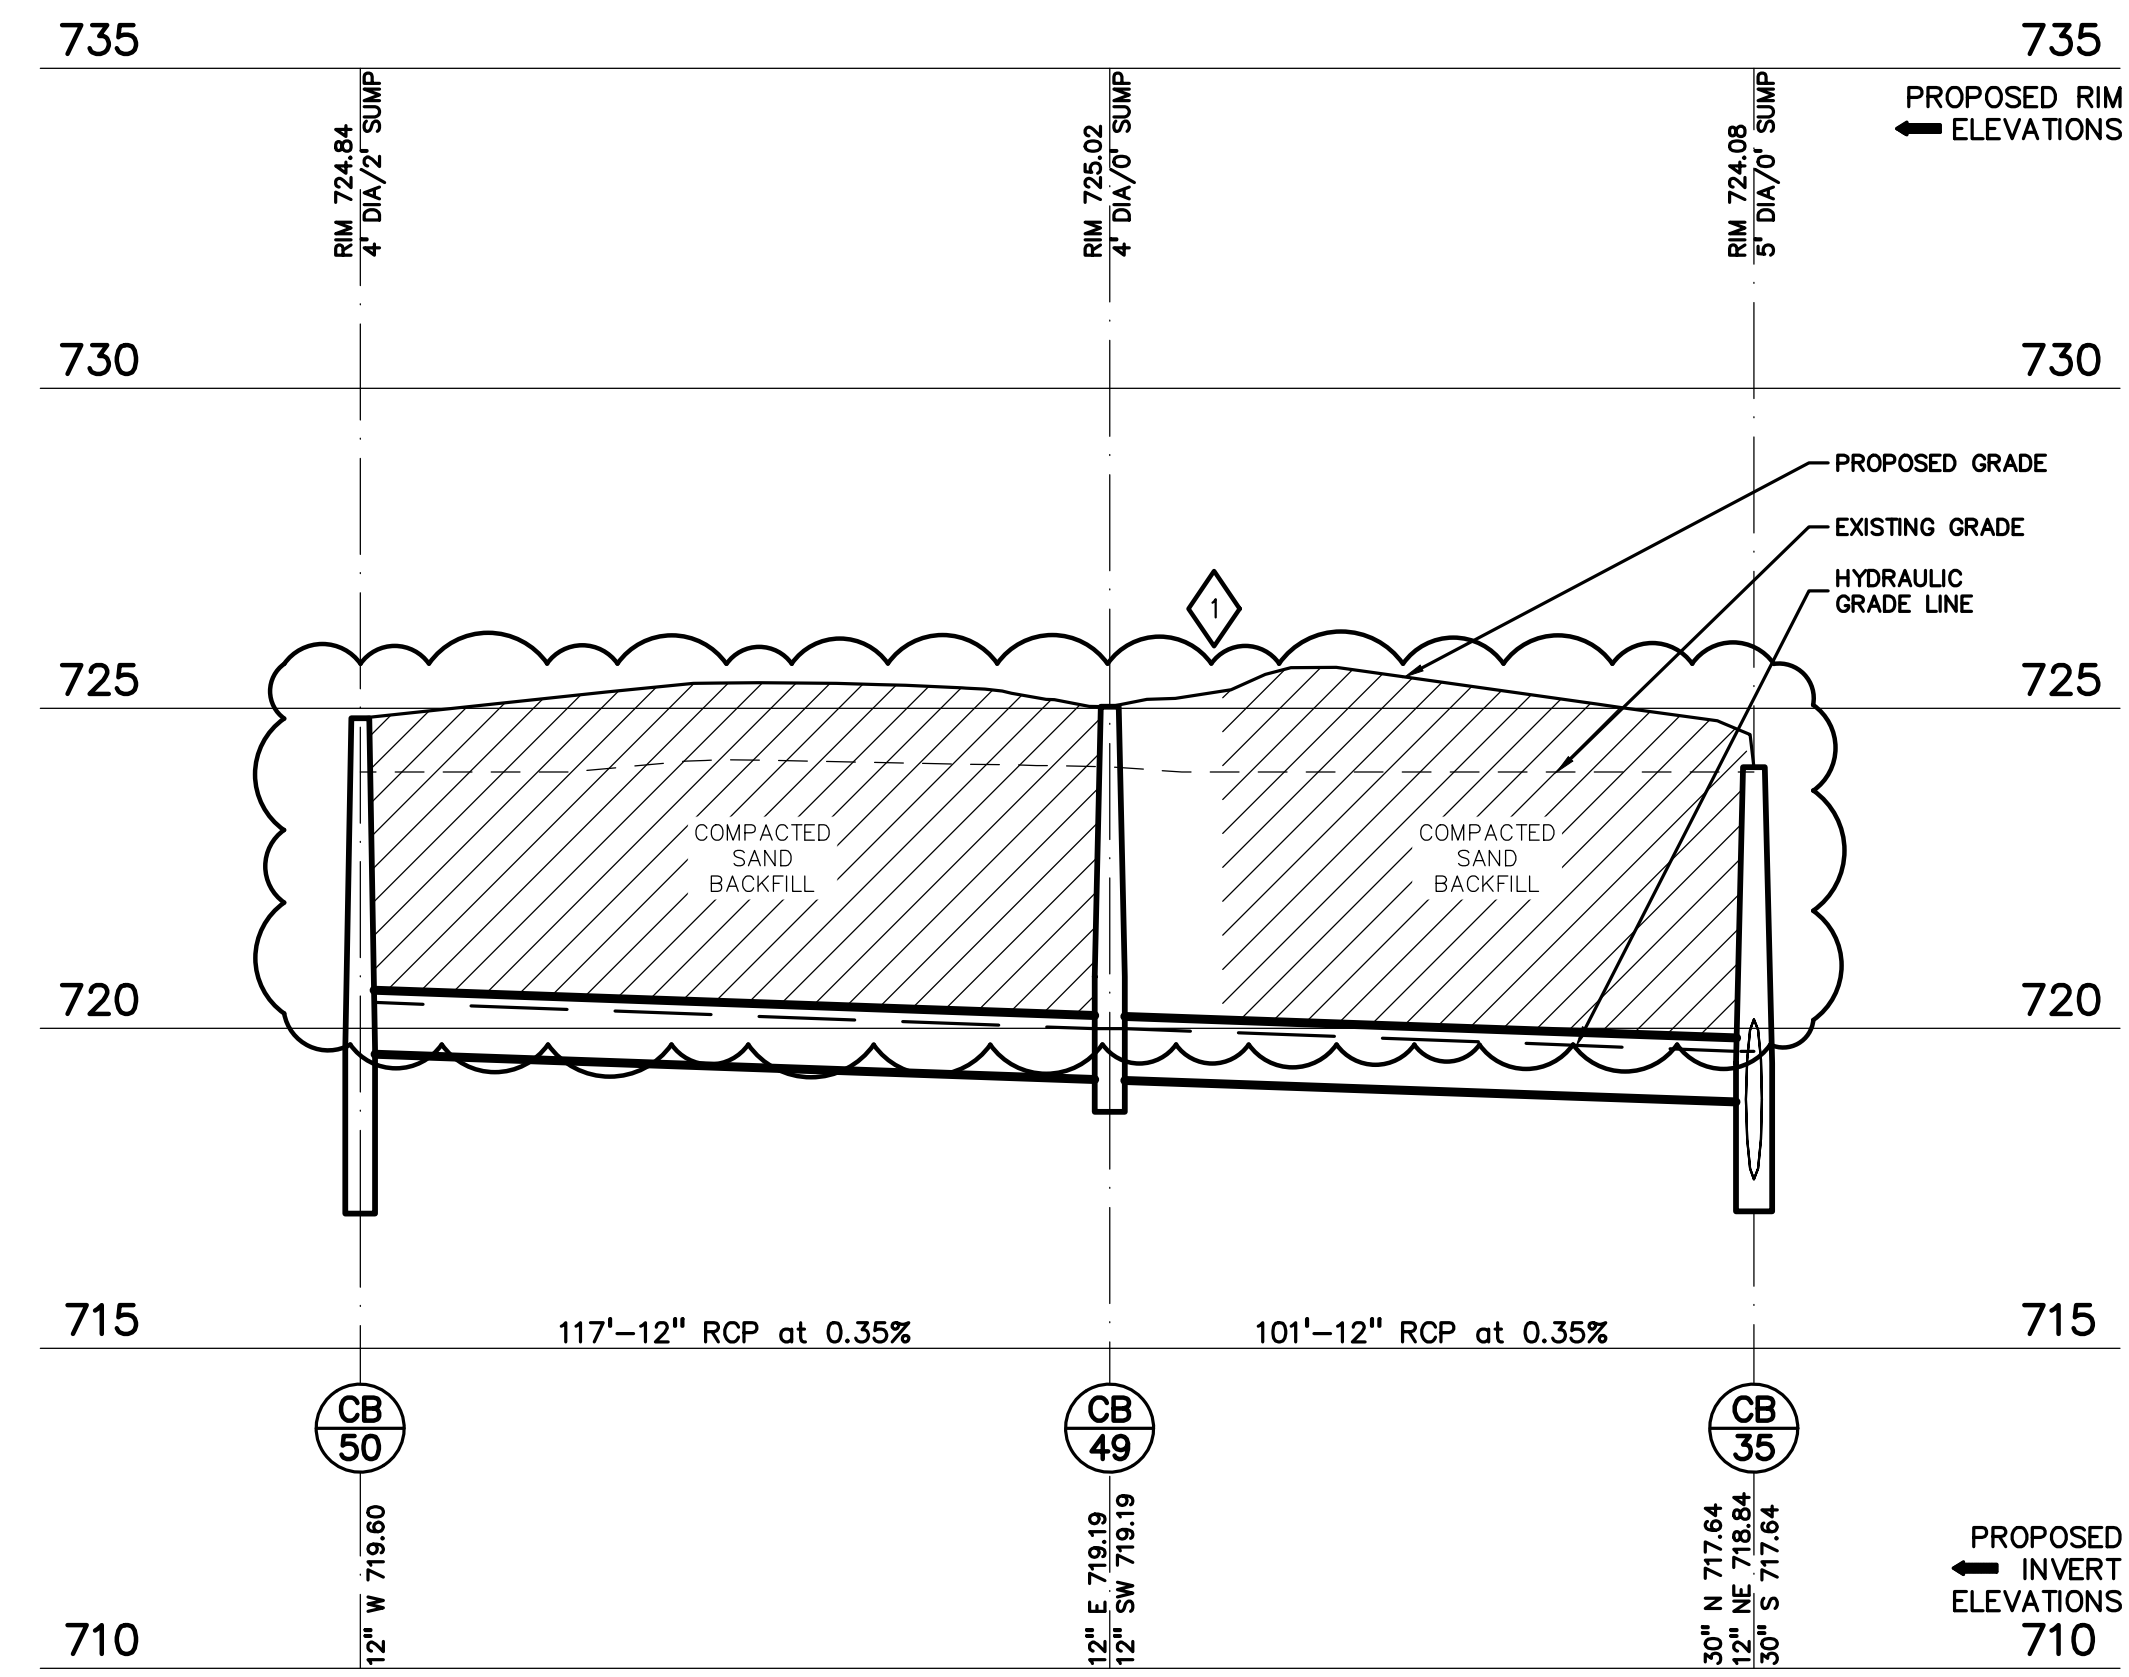


STORM 50-35 PROFILE

HORIZ: 1" = 30'
VERT: 1" = 3'

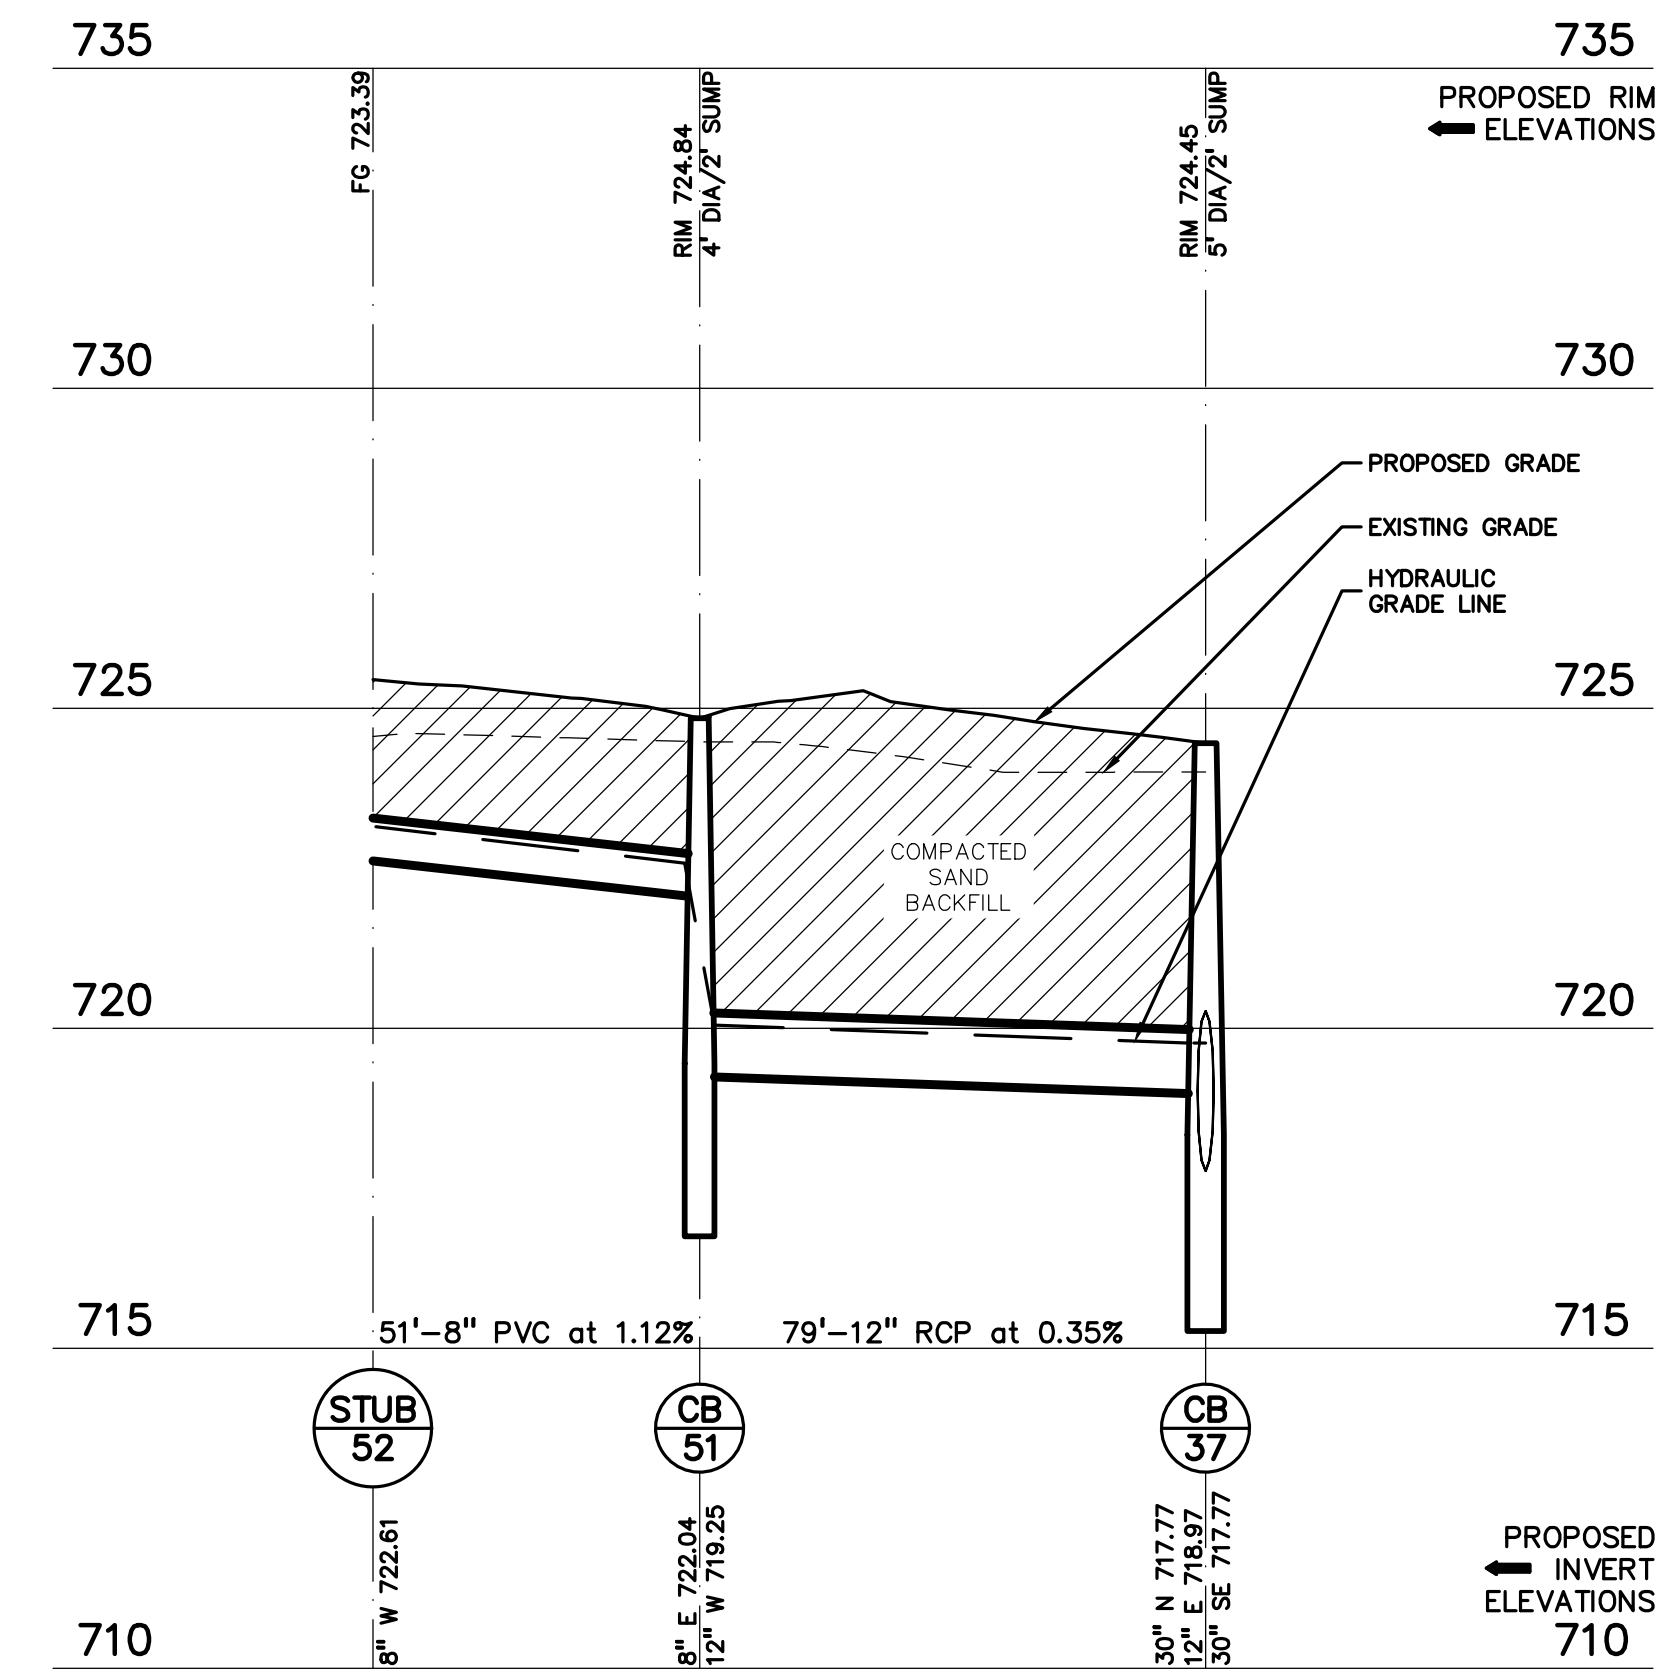


STORM 52-37 PROFILE

HORIZ: 1" = 30'
VERT: 1" = 3'

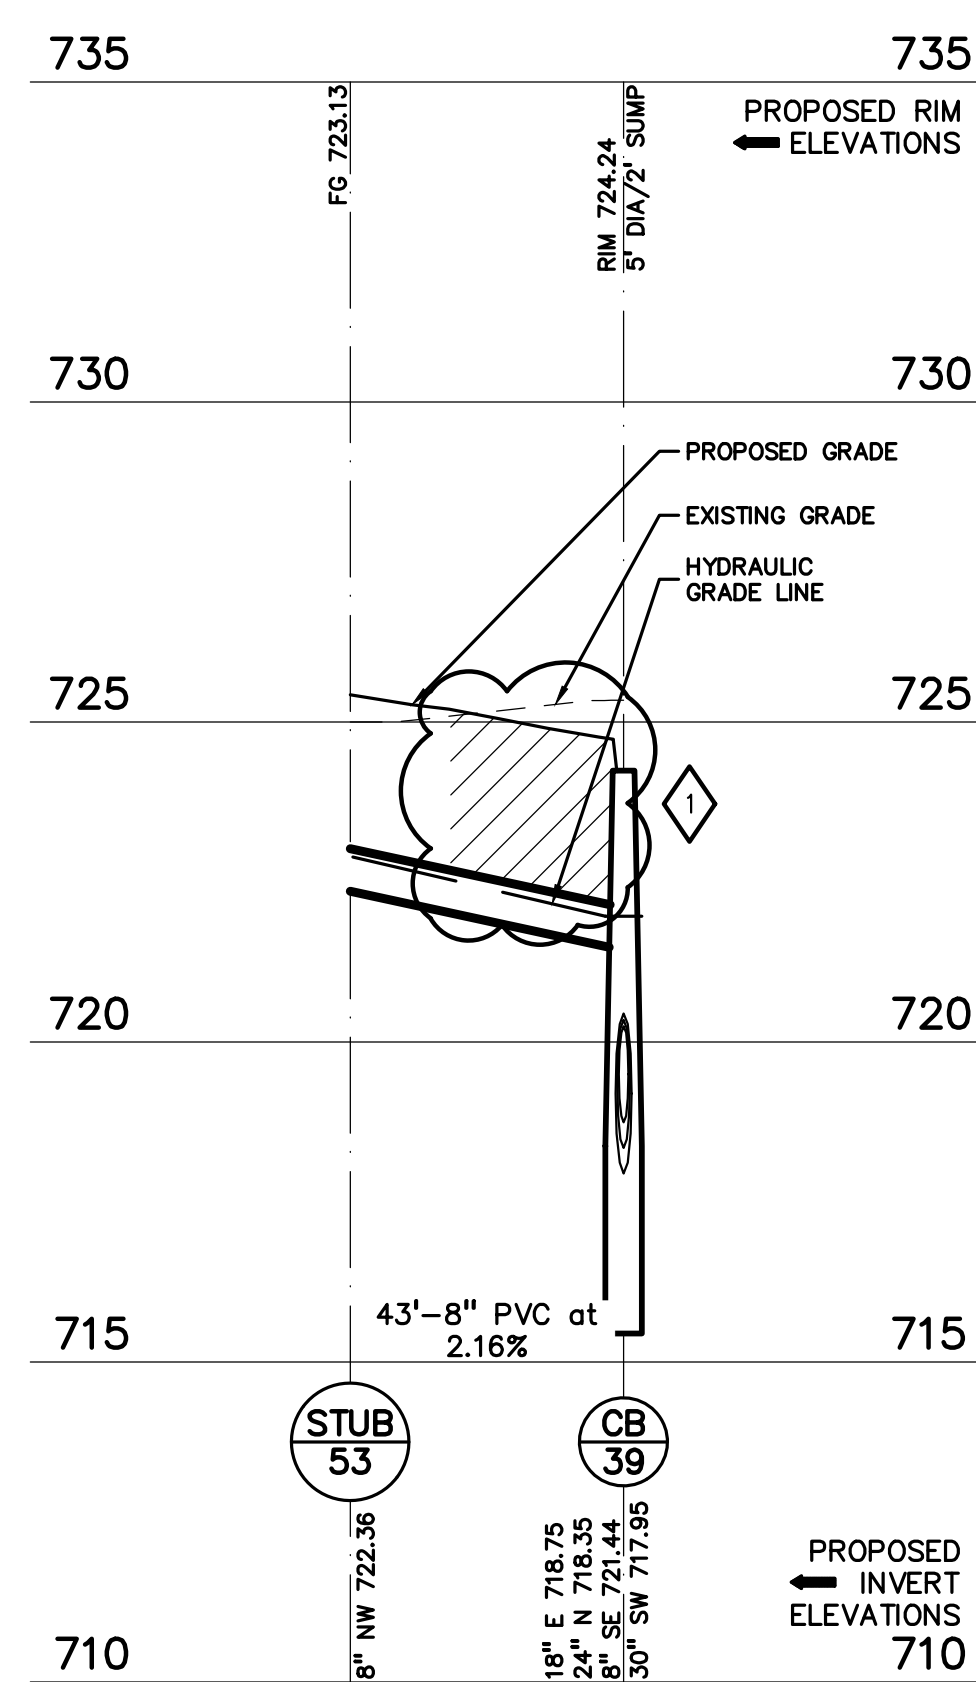


STORM 53-39 PROFILE

HORIZ: 1" = 30'
VERT: 1" = 3'

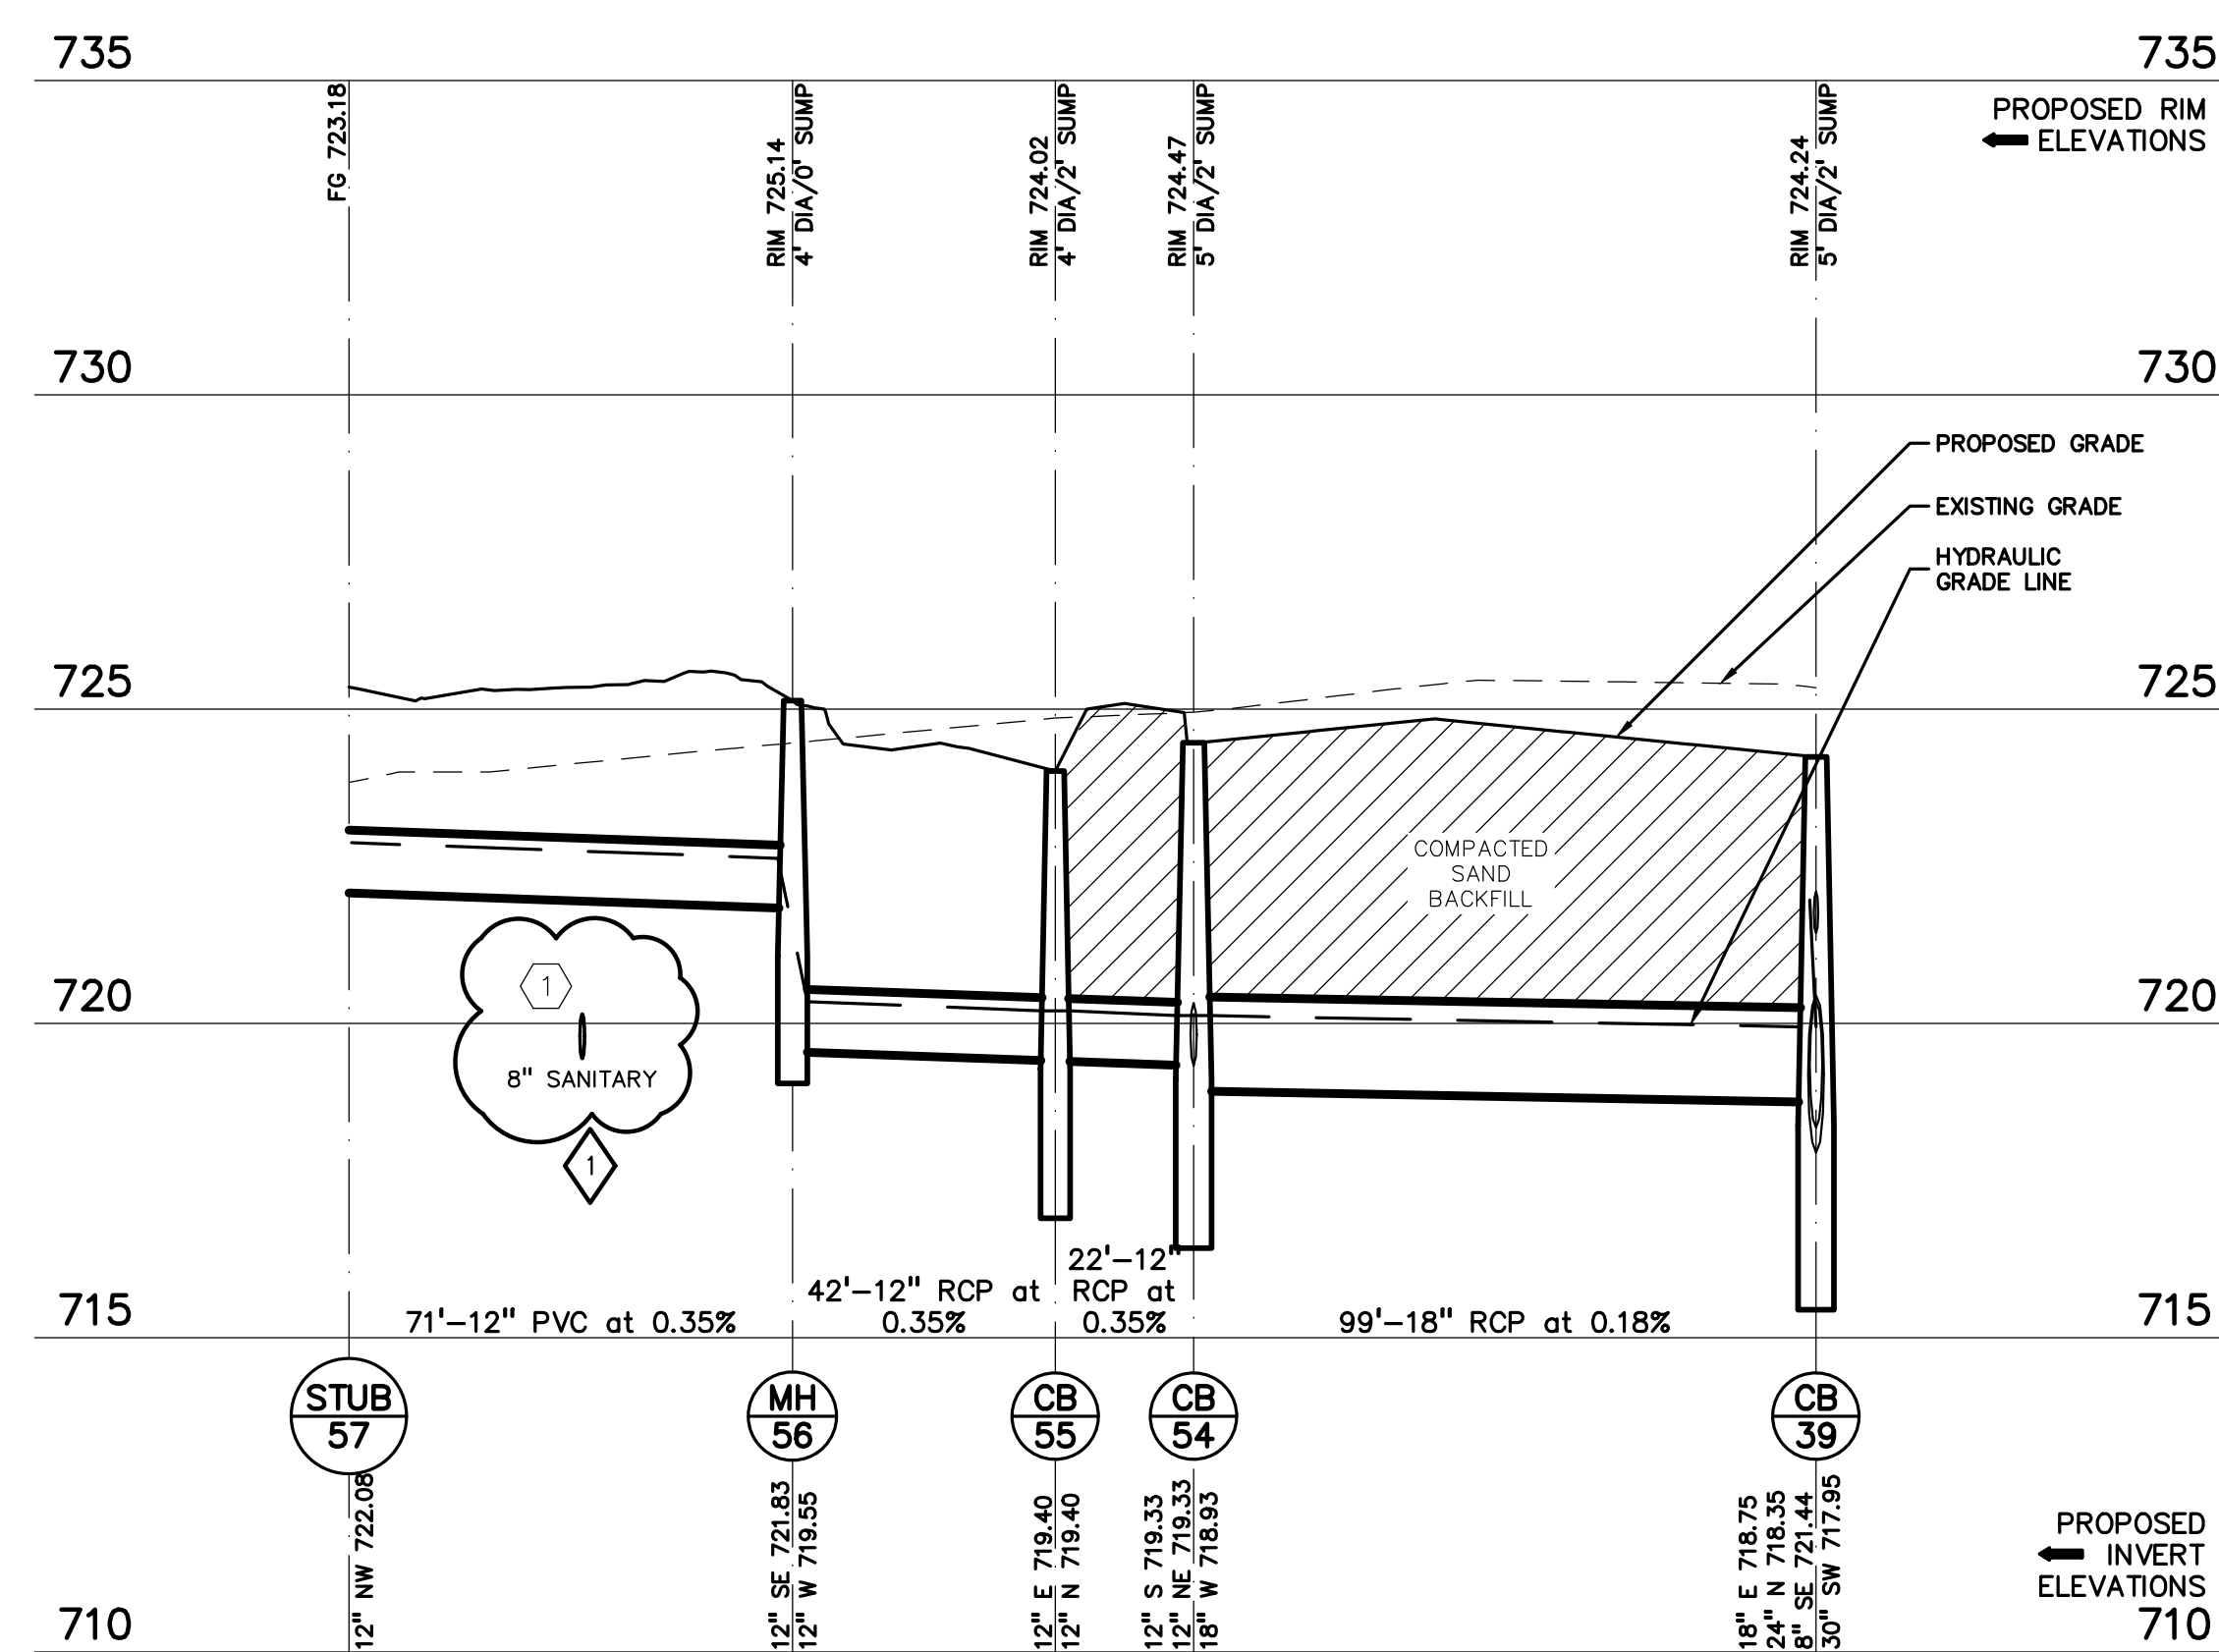

STORM 57-39 PROFILE

HORIZ: 1" = 30'
VERT: 1" = 3'

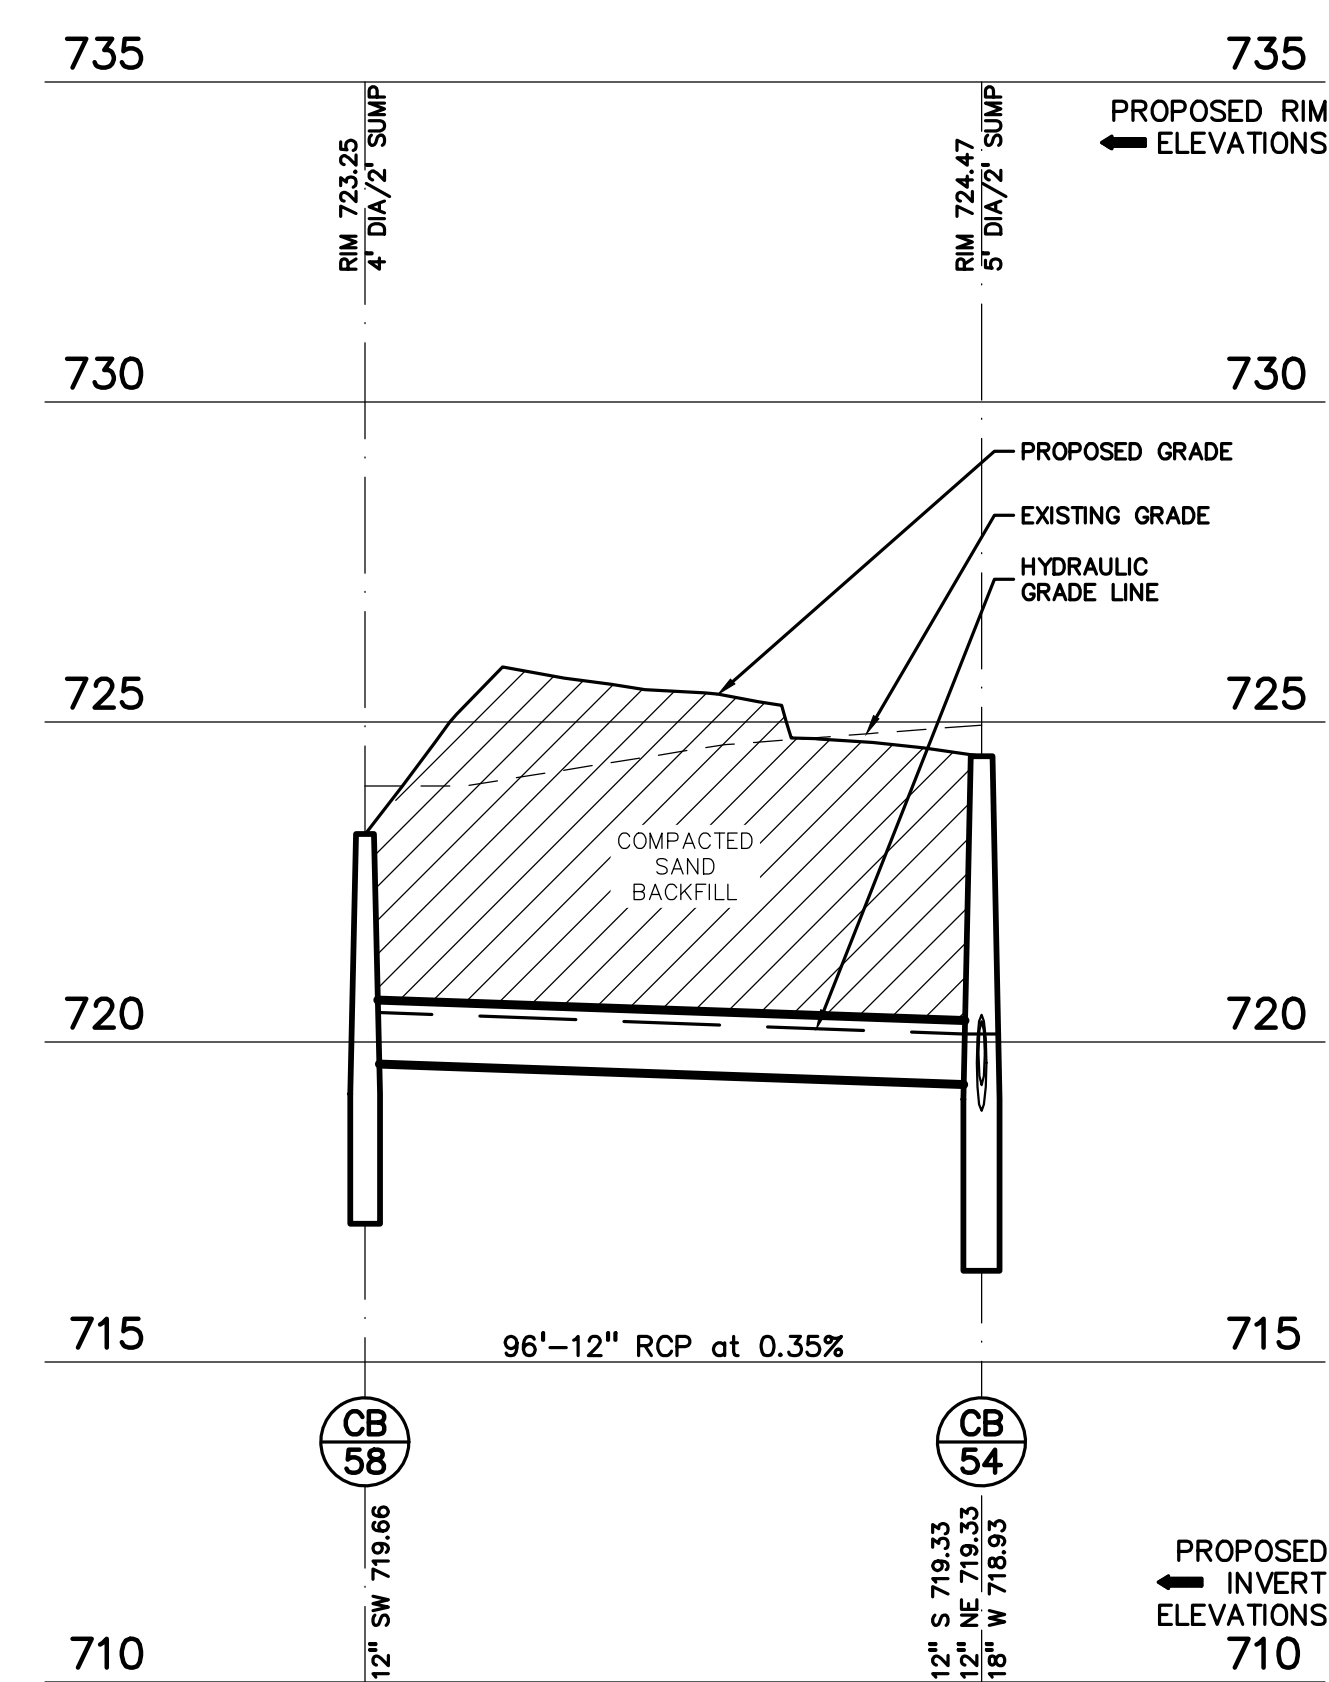

STORM 58-54 PROFILE

HORIZ: 1" = 30'
VERT: 1" = 3'

REGISTRATION SEAL

CONSULTANT



PROJECT TITLE
**New Smith Middle School
Bid Package No. 03C**

**Troy School District
Troy, Michigan**

DRAWING TITLE
**STORM SEWER
PROFILES**


ISSUE DATES

07-12-2024 ADDENDUM NO. 2
06-18-2024 CONSTRUCTION DOCUMENTS

DATE ISSUED FOR:


DRAWN .JW
CHECKED TD
APPROVED TD

PROJECT NO.
22102
DRAWING NO.
C-6.4

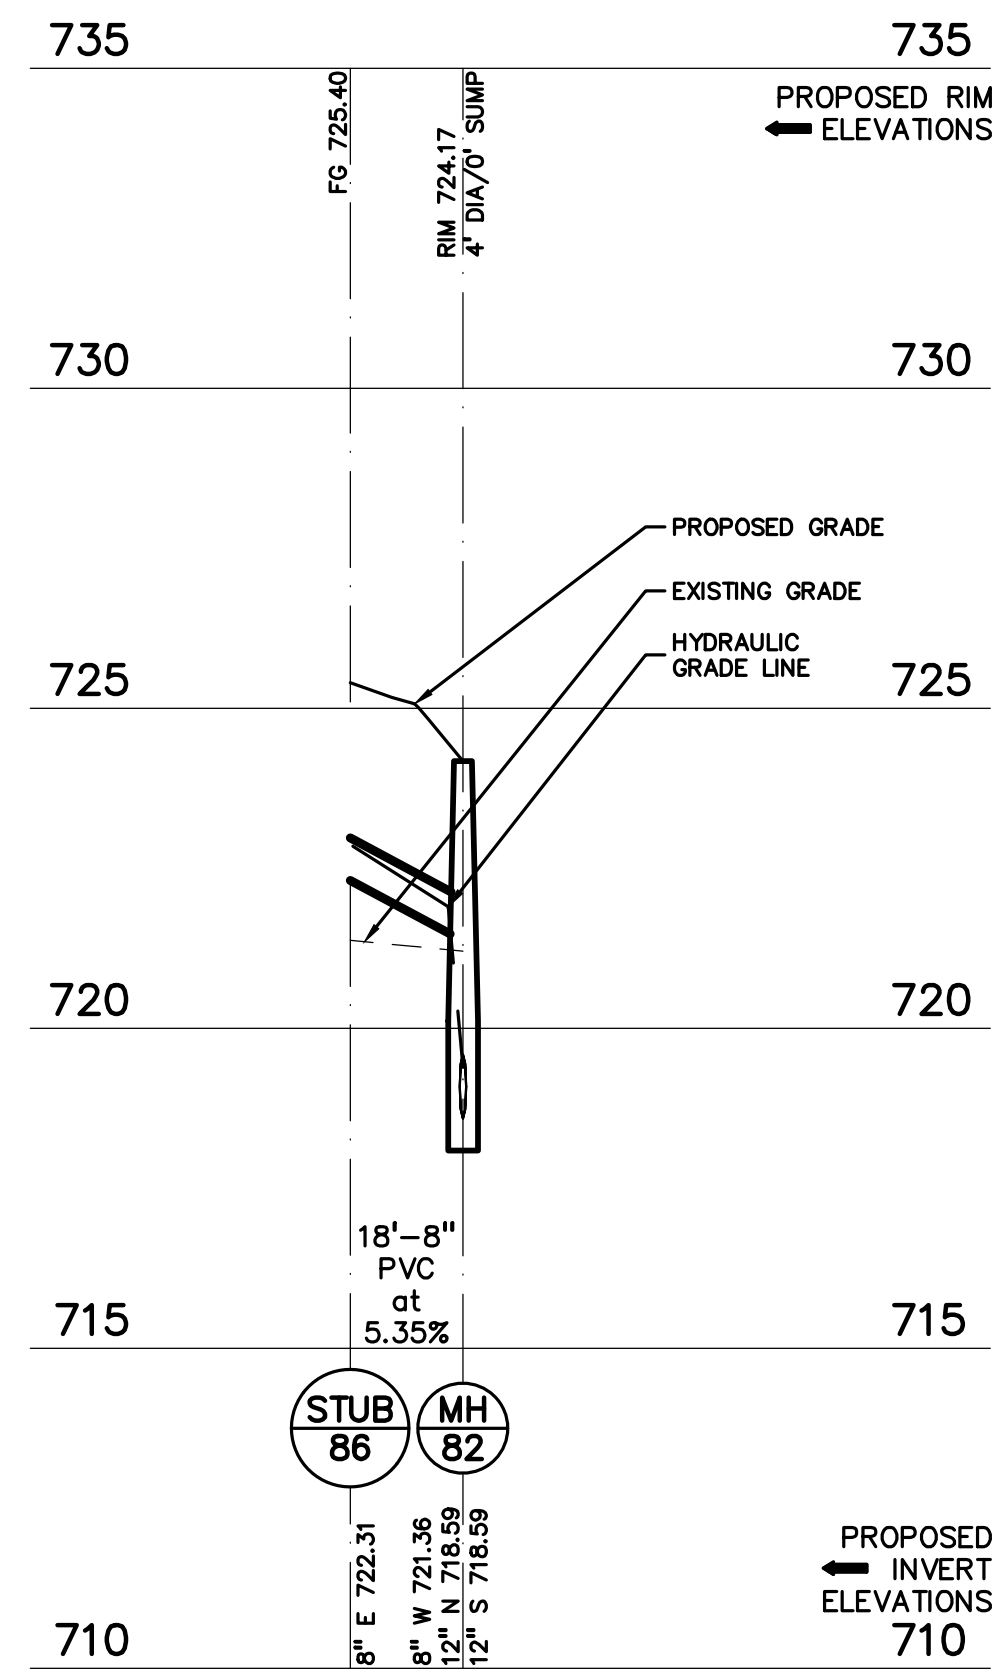


STORM 86-82 PROFILE

HORIZ: 1" = 30'
VERT: 1" = 3'

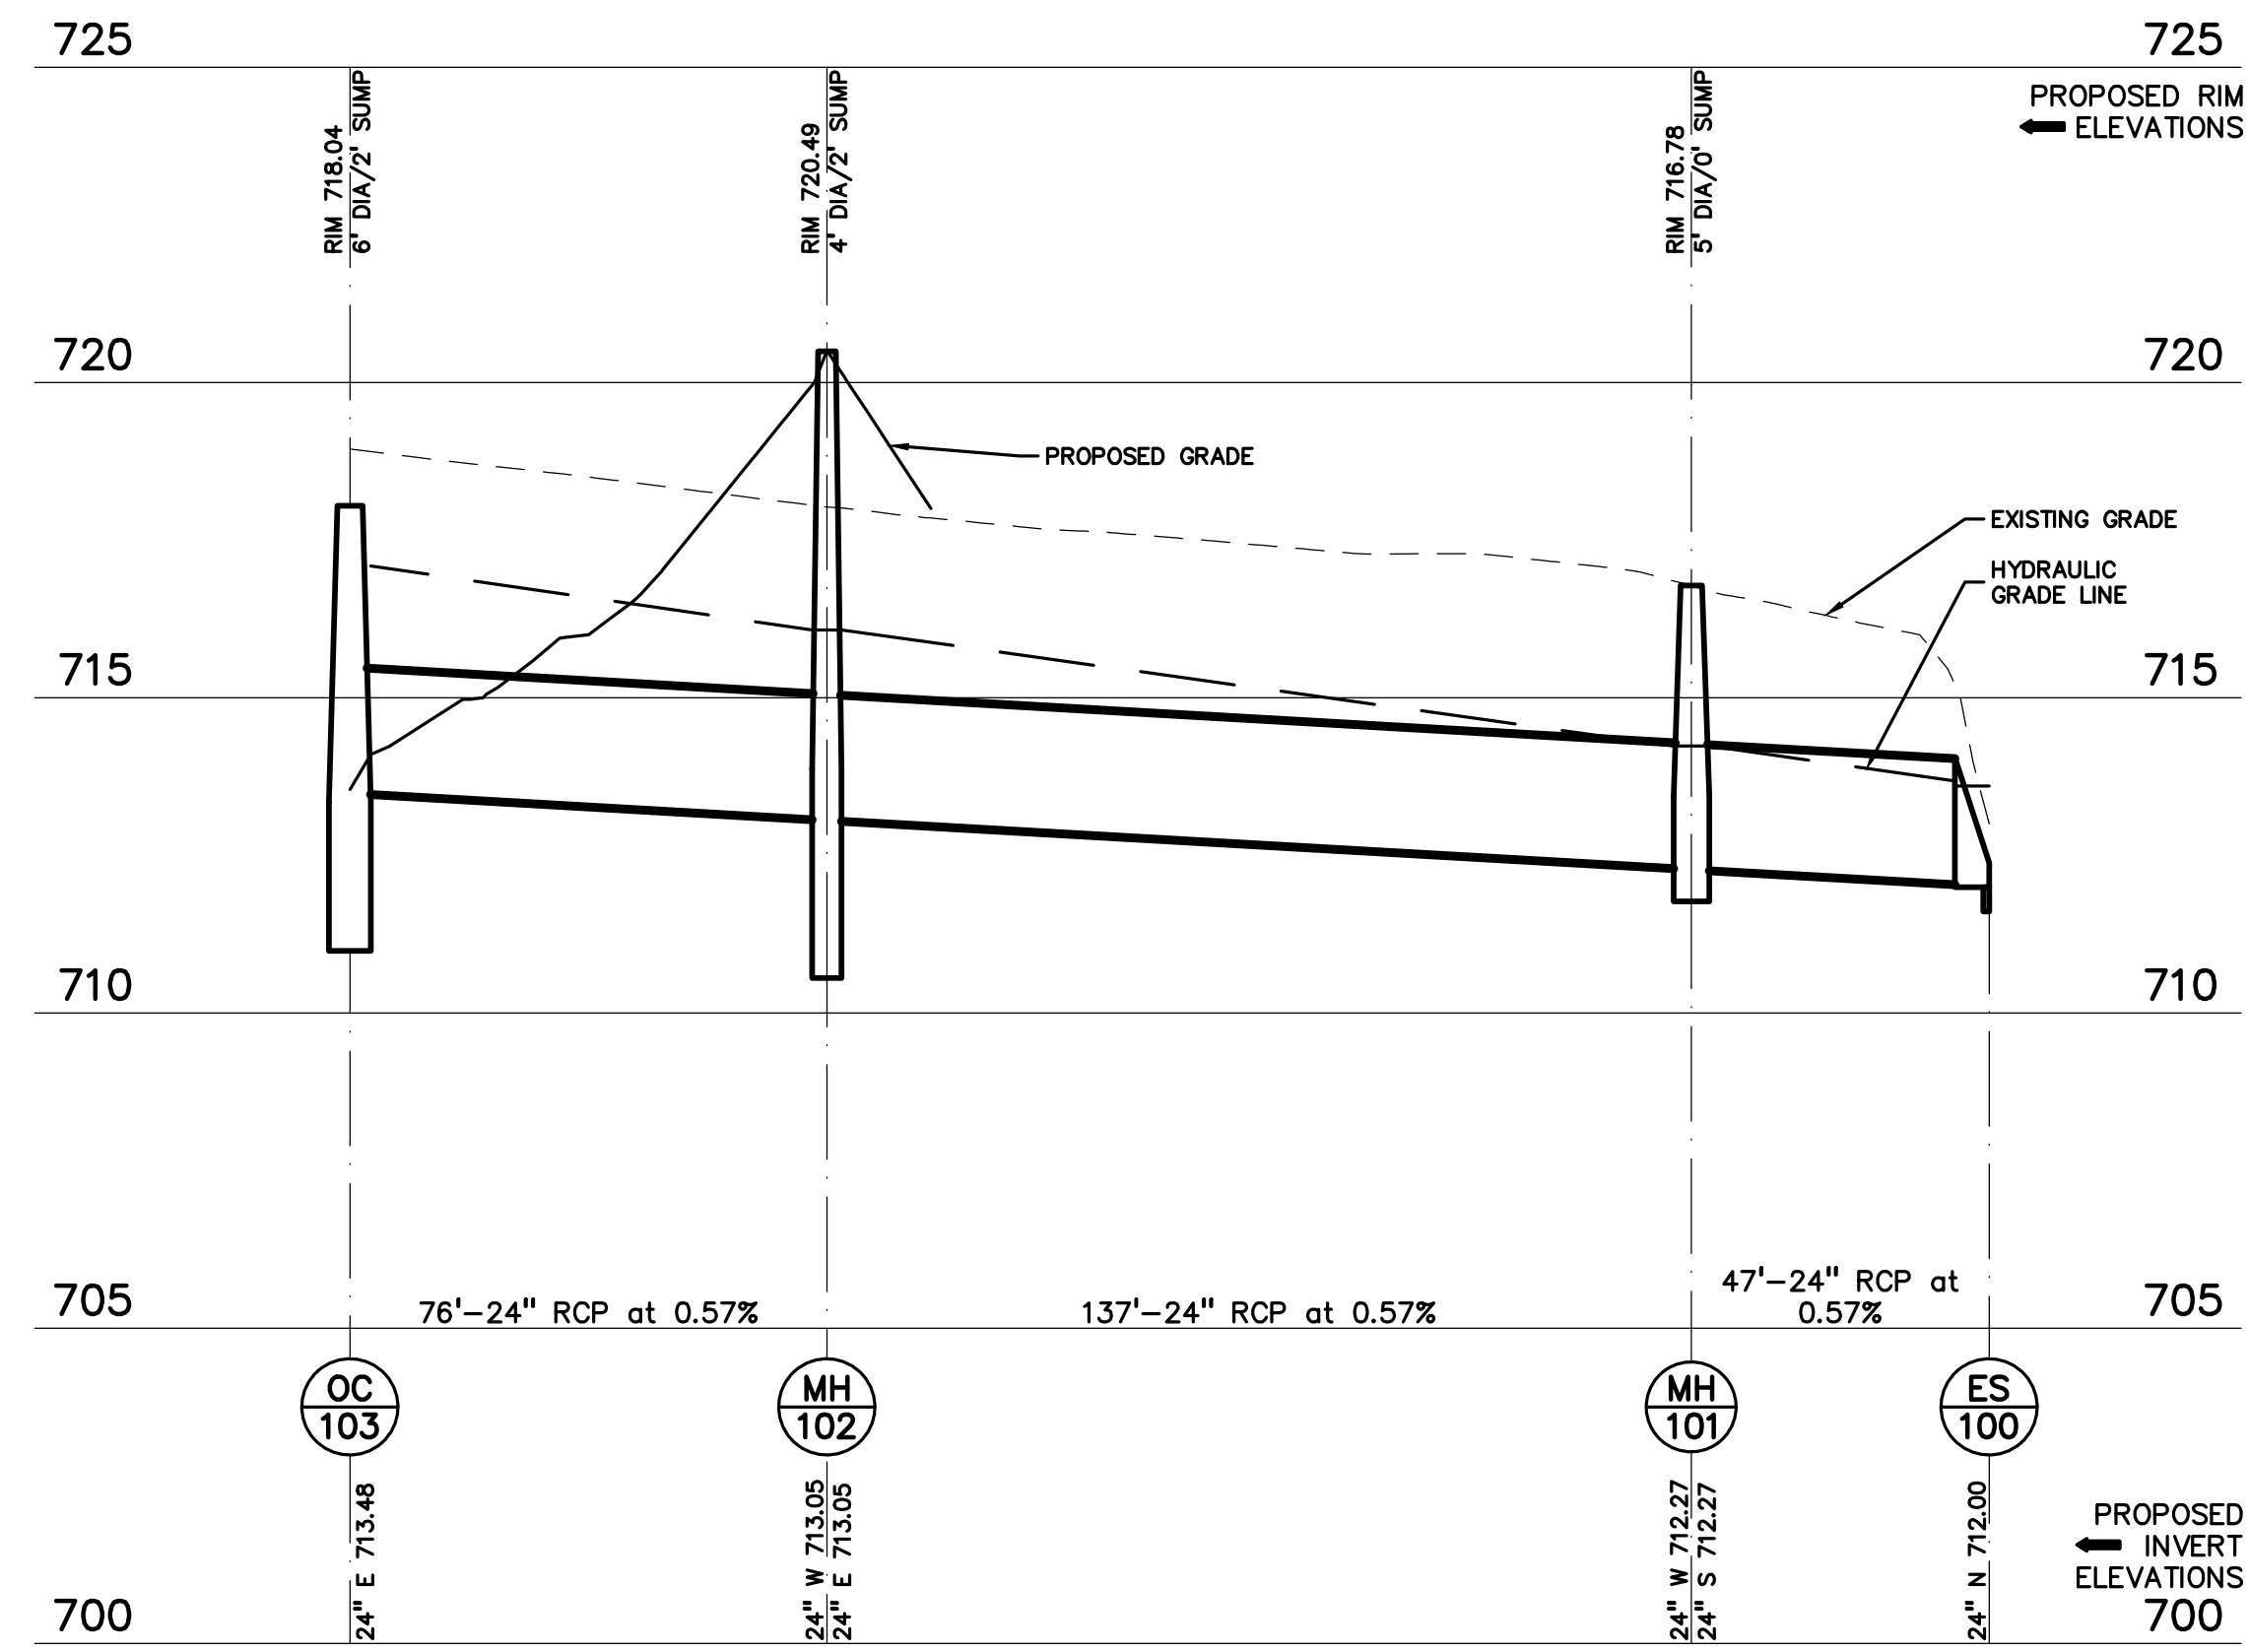


STORM 103-100 PROFILE

HORIZ: 1" = 30'
VERT: 1" = 3'

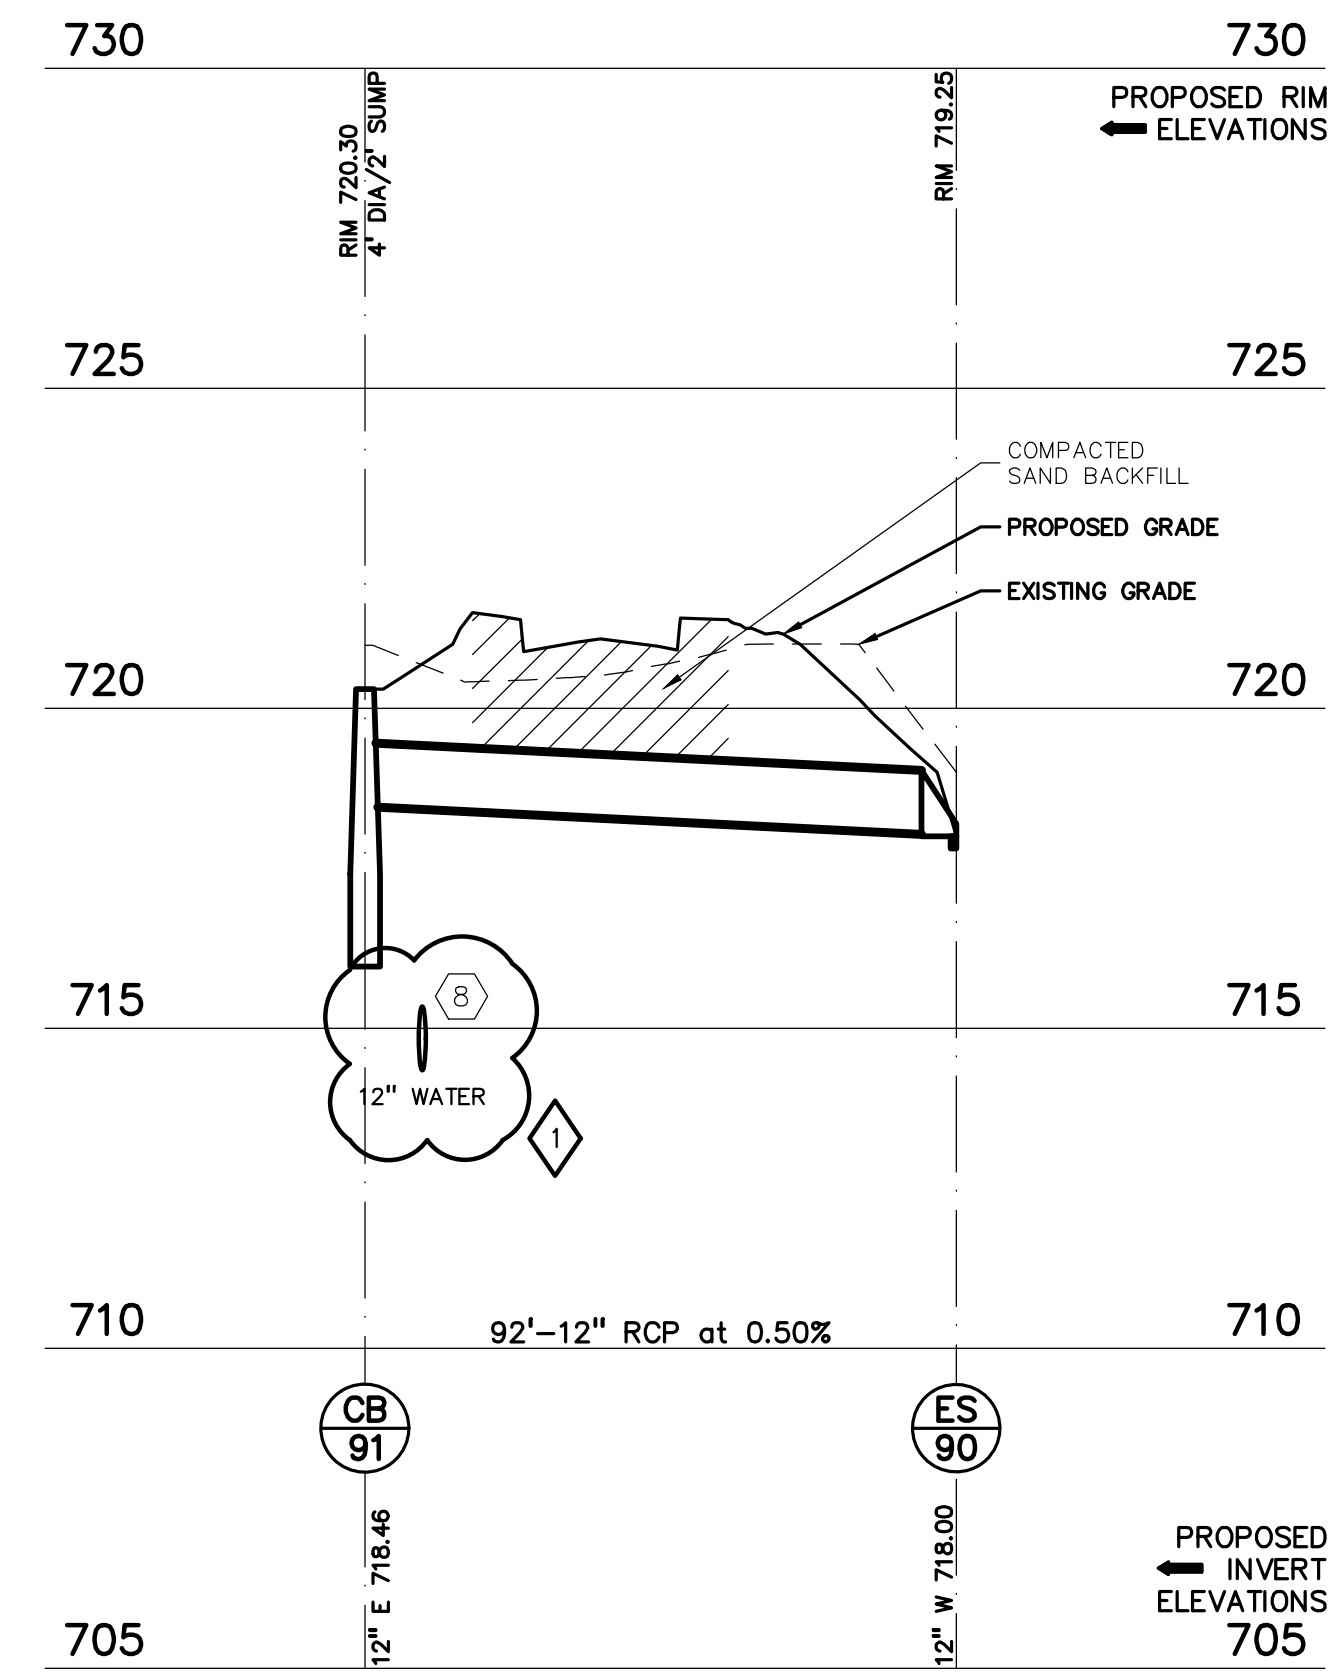


STORM 91-90 PROFILE

HORIZ: 1" = 30'
VERT: 1" = 3'

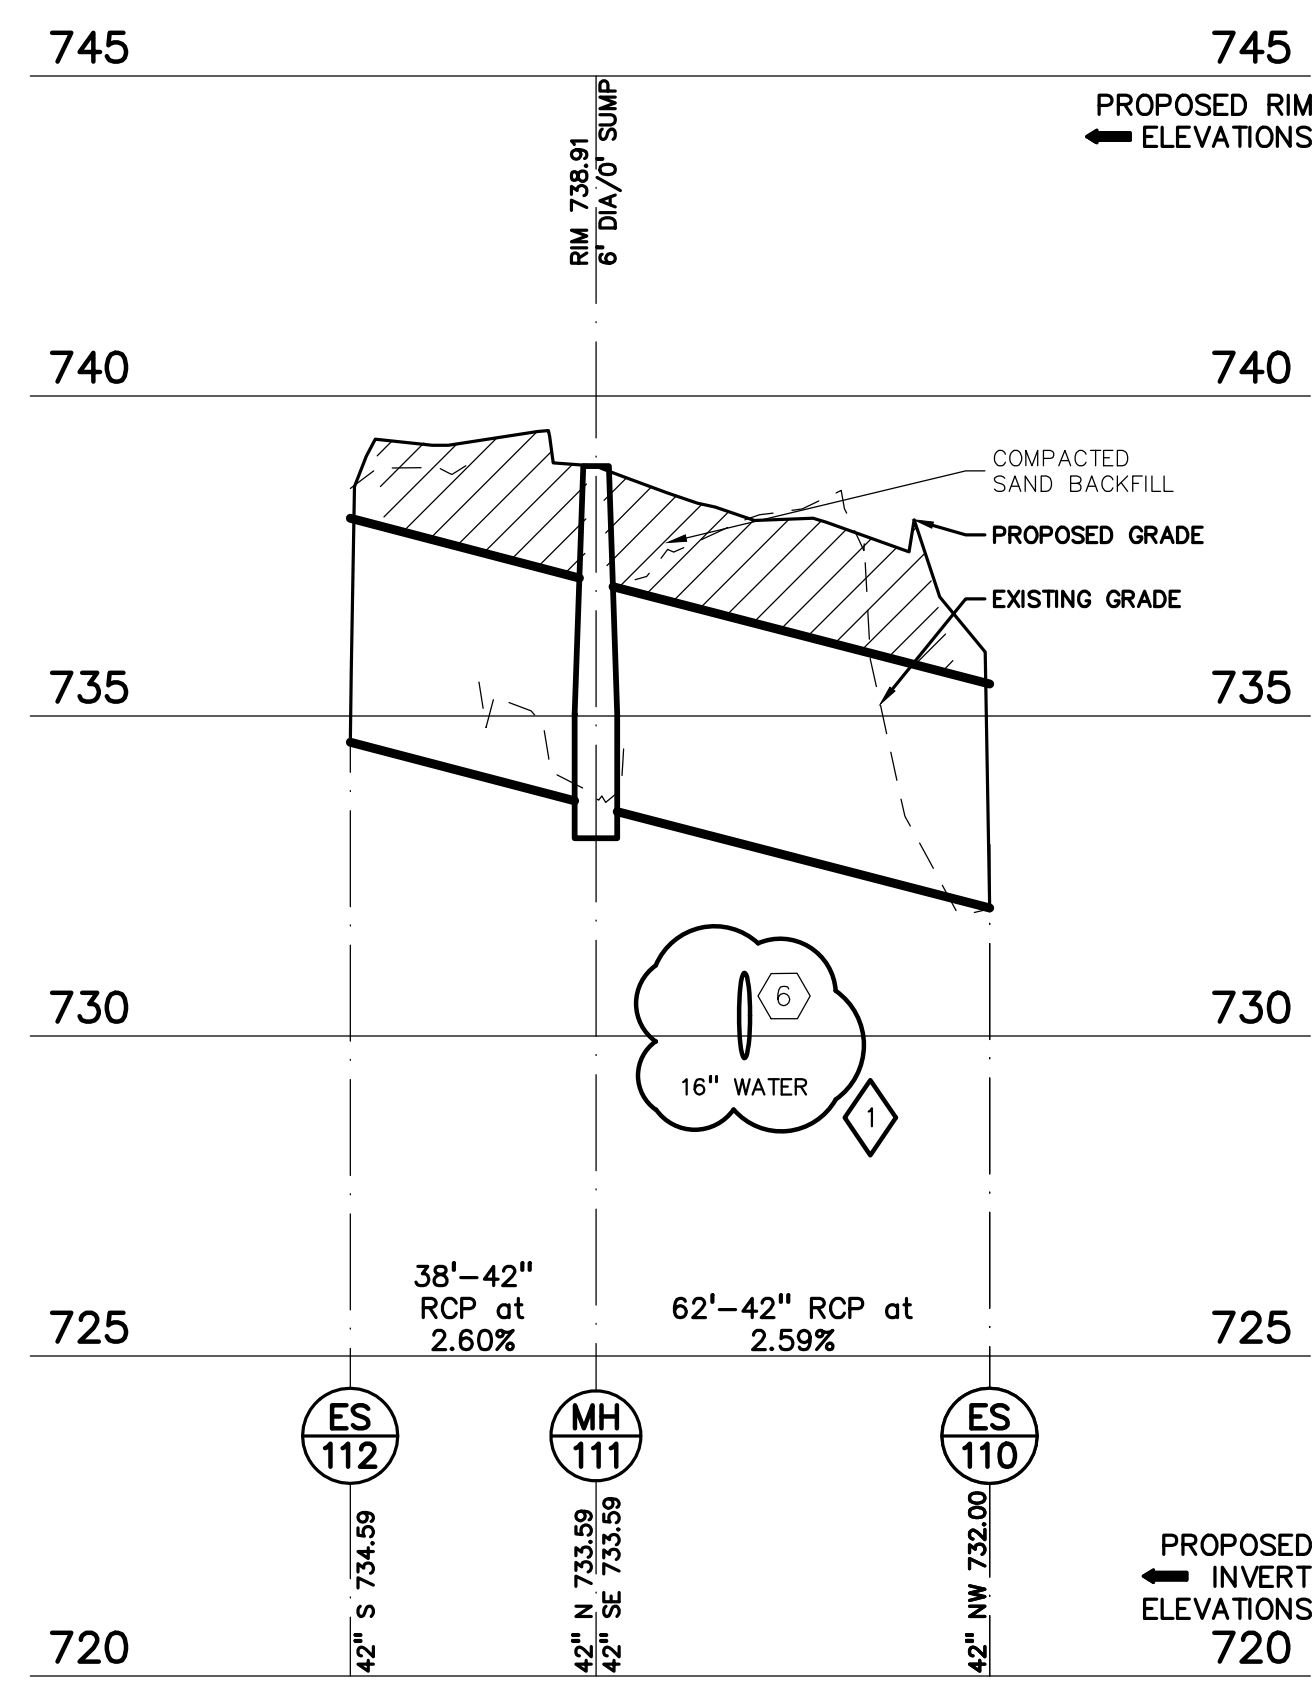


STORM 112-110 PROFILE

HORIZ: 1" = 30'
VERT: 1" = 3'

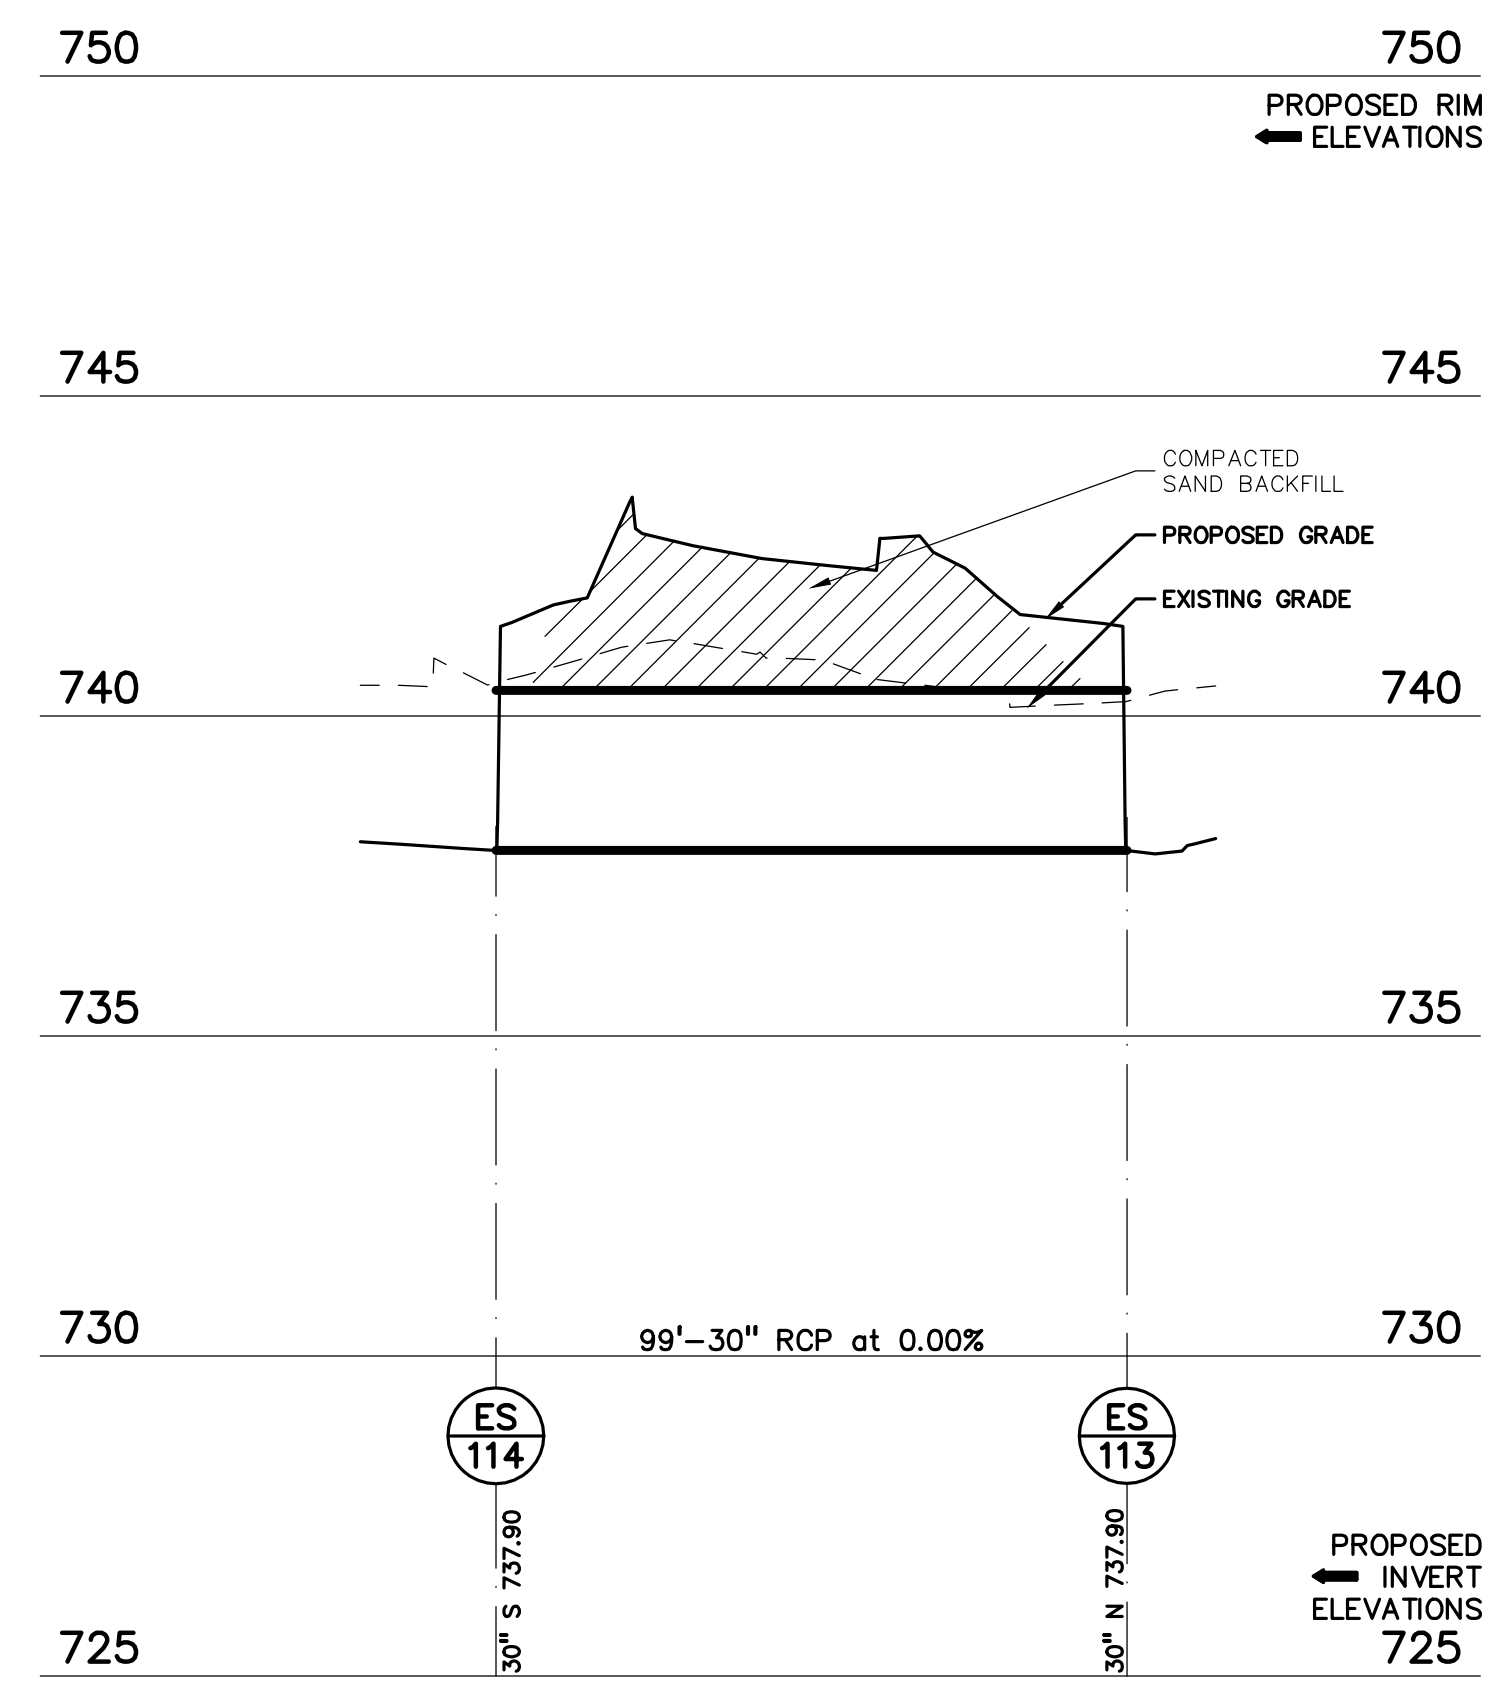

STORM 114-113 PROFILE

HORIZ: 1" = 30'
VERT: 1" = 3'





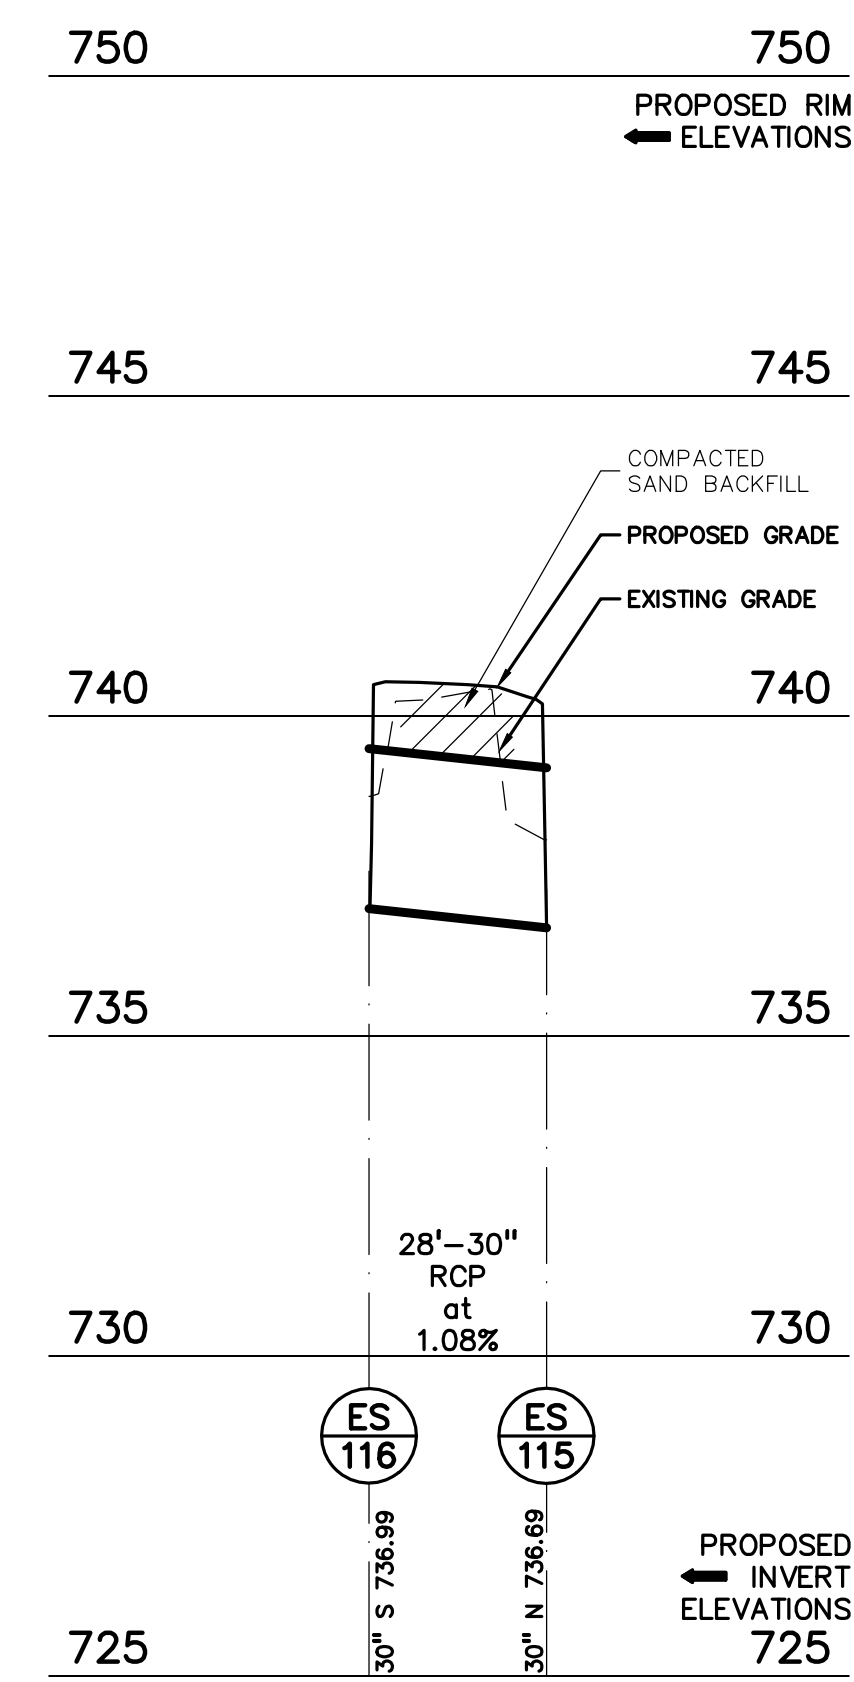


STORM 116-115 PROFILE

HORIZ: 1" = 30'
VERT: 1" = 3'


























CAUTION!
THE LOCATION AND DEPTH OF EXISTING UTILITIES ARE SHOWN ON THIS DRAWING AS ONLY APPROXIMATE. NO GUARANTEE IS GIVEN FOR THE ACCURACY OF THE INFORMATION. THE CONTRACTOR SHALL BE EXCLUSIVELY RESPONSIBLE FOR DETERMINING THE EXACT LOCATION AND DEPTHS PRIOR TO THE START OF CONSTRUCTION.

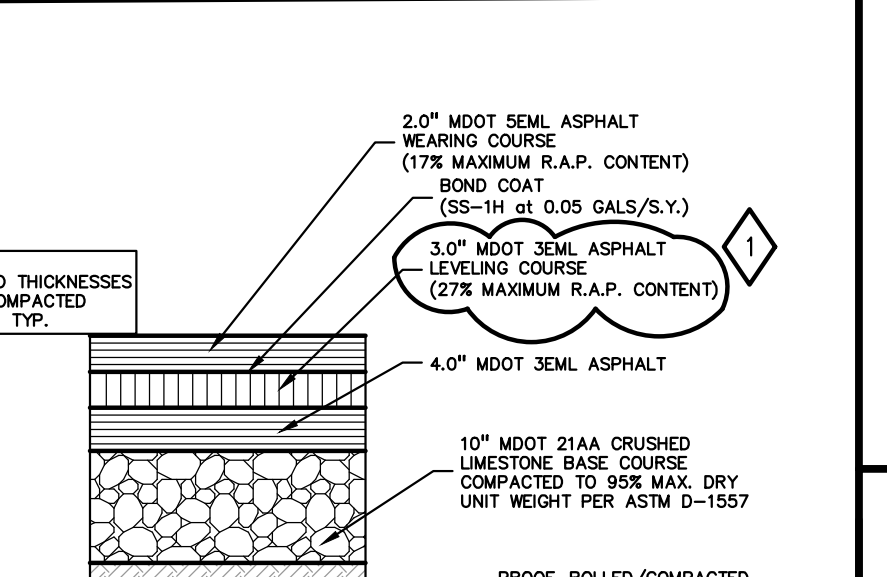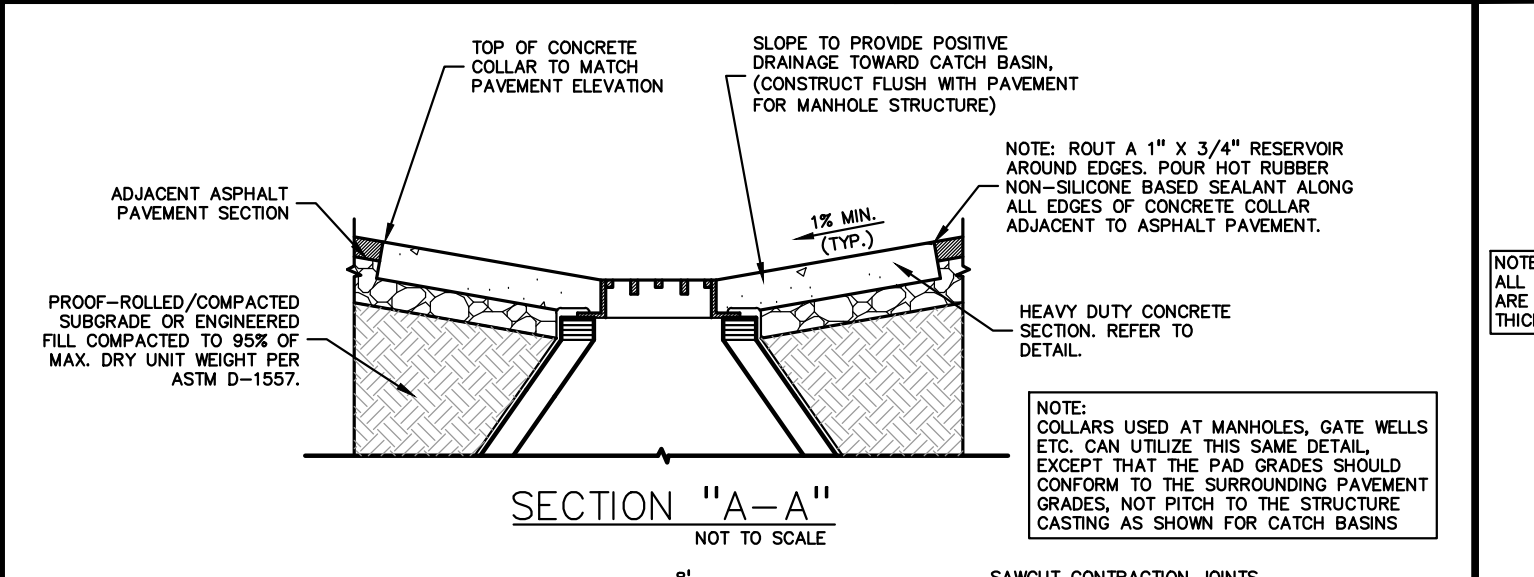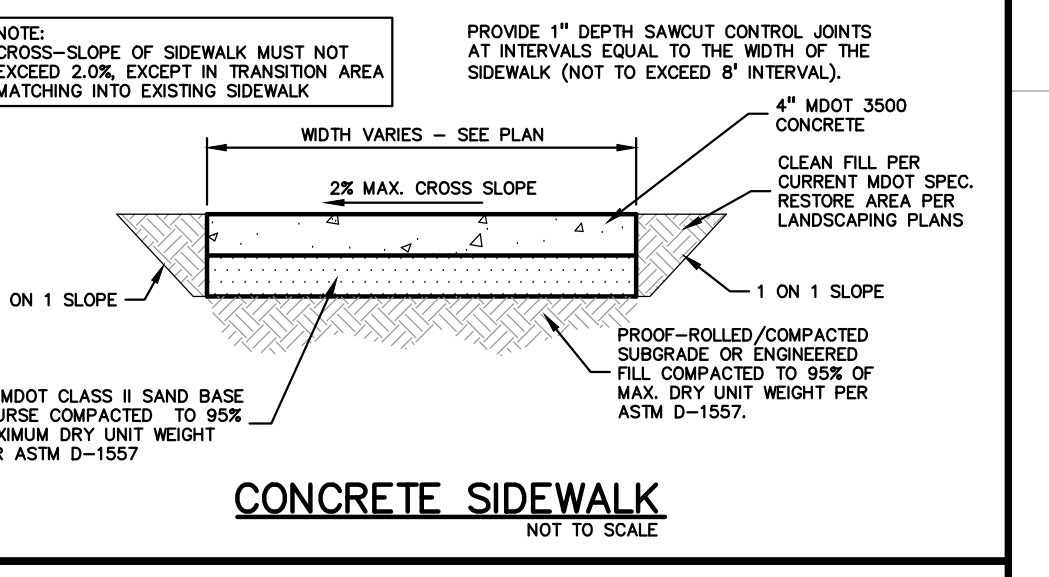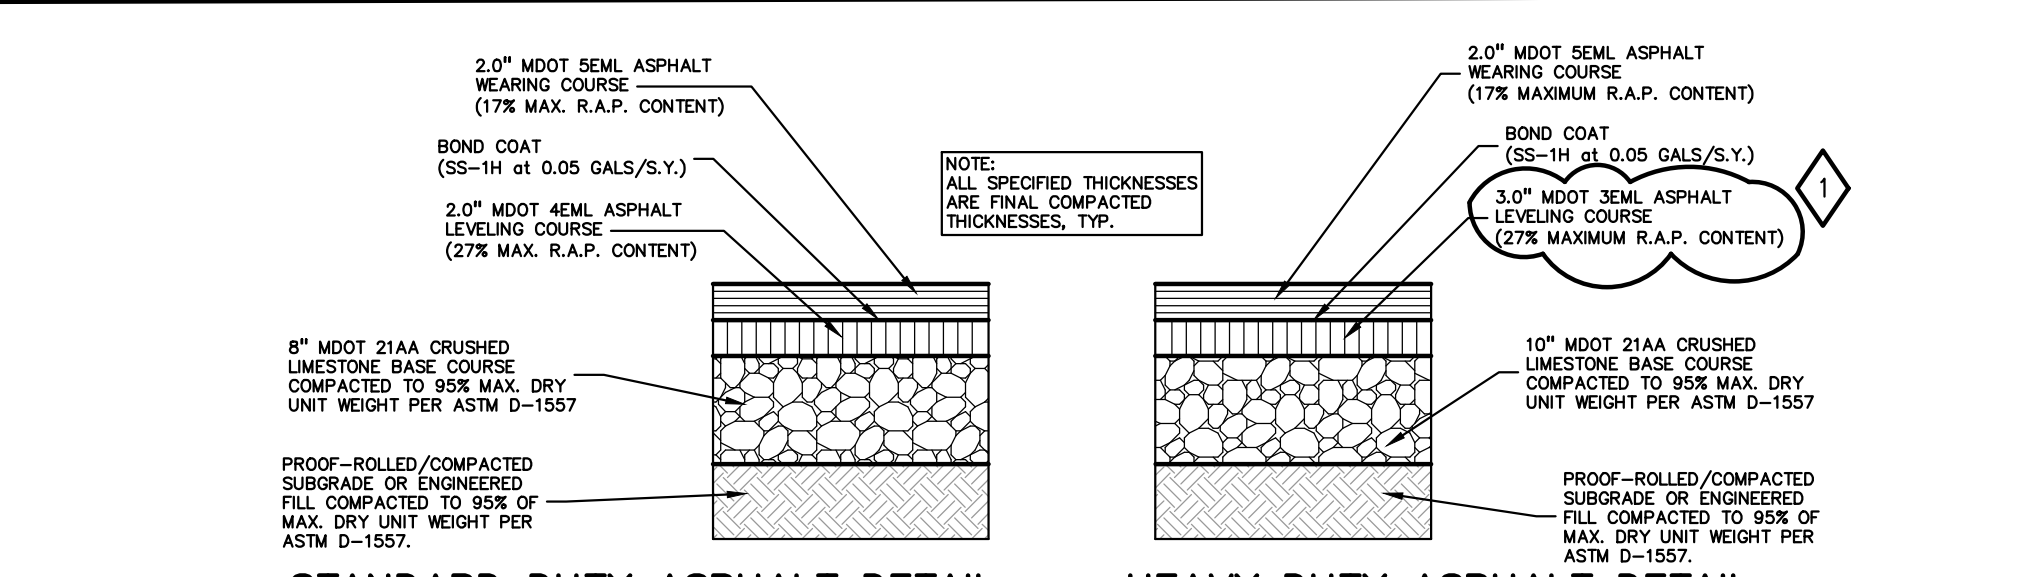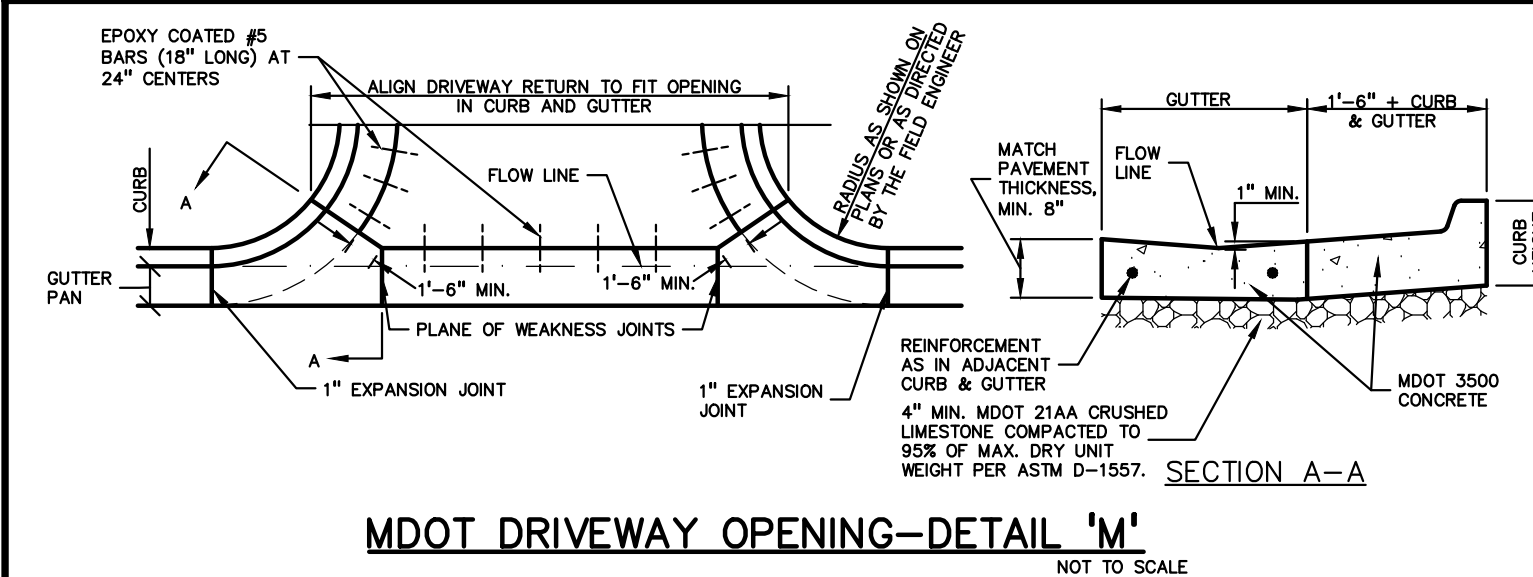

ASPHALT MIX DESIGN CHART

COMMERCIAL ADT 0-300	COMMERCIAL ADT 301-1000	COMMERCIAL ADT 1001-3400	COMMERCIAL ADT 3401-5400	APPLICATION RATE (lb/ft ²)	COURSE APPLICATION
2EL	2DM	2DH	2EH	430-550	BASE
3EL	3DM	3DH	3EH	330-410	BASE AND/OR LEVELING
4EL	4DM	4DH	4EH	230-275	LEVELING AND/OR TOP
5EL	5DM	5DH	5EH	165-220	TOP

  PG 5B-28 PG 64-28 PG 64-28 PG 70-28P

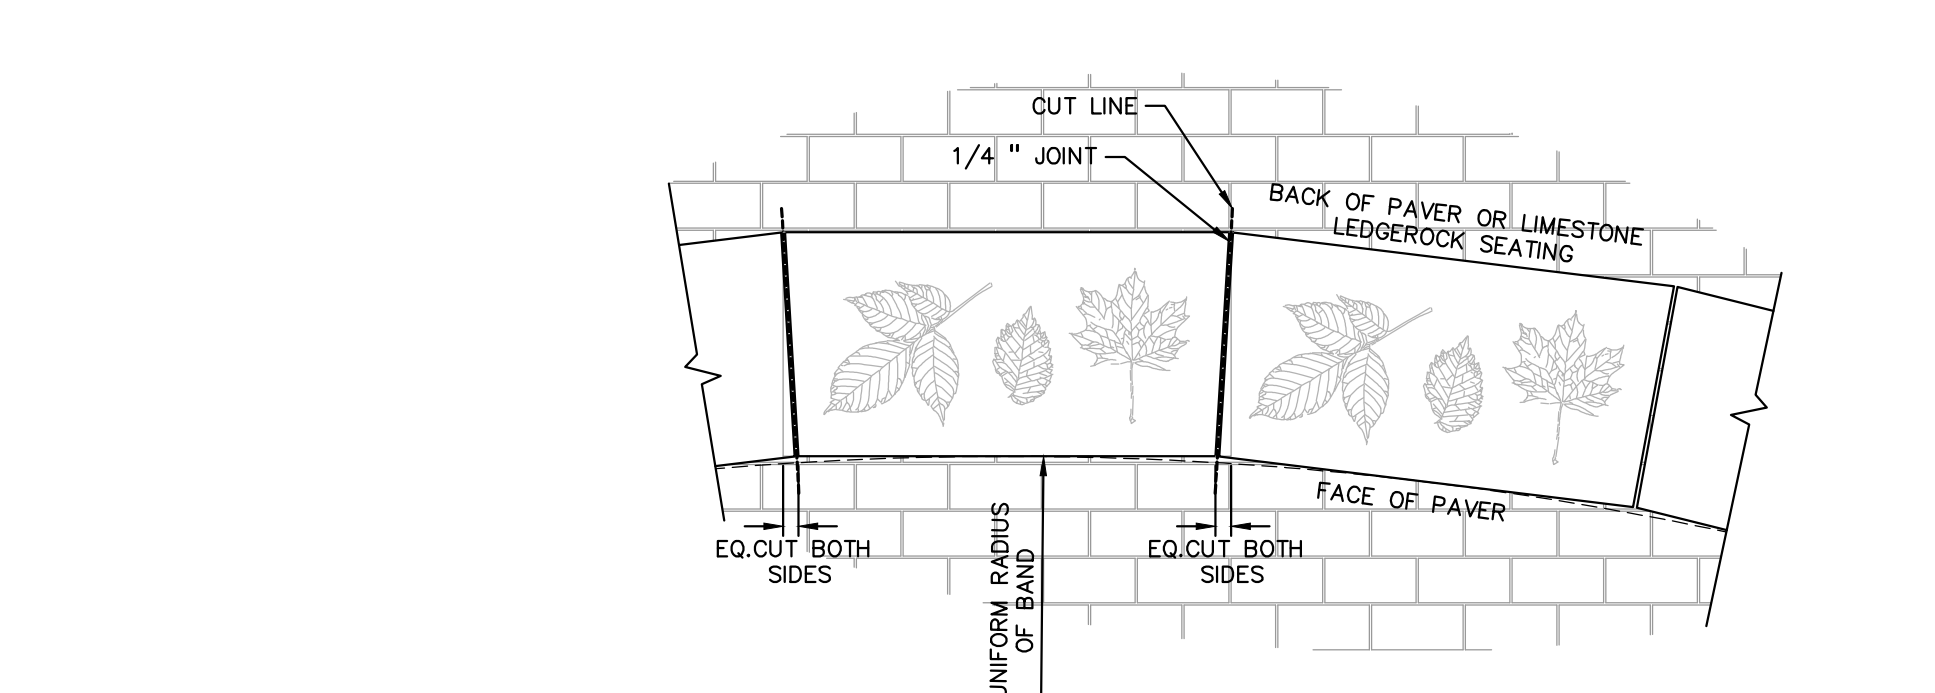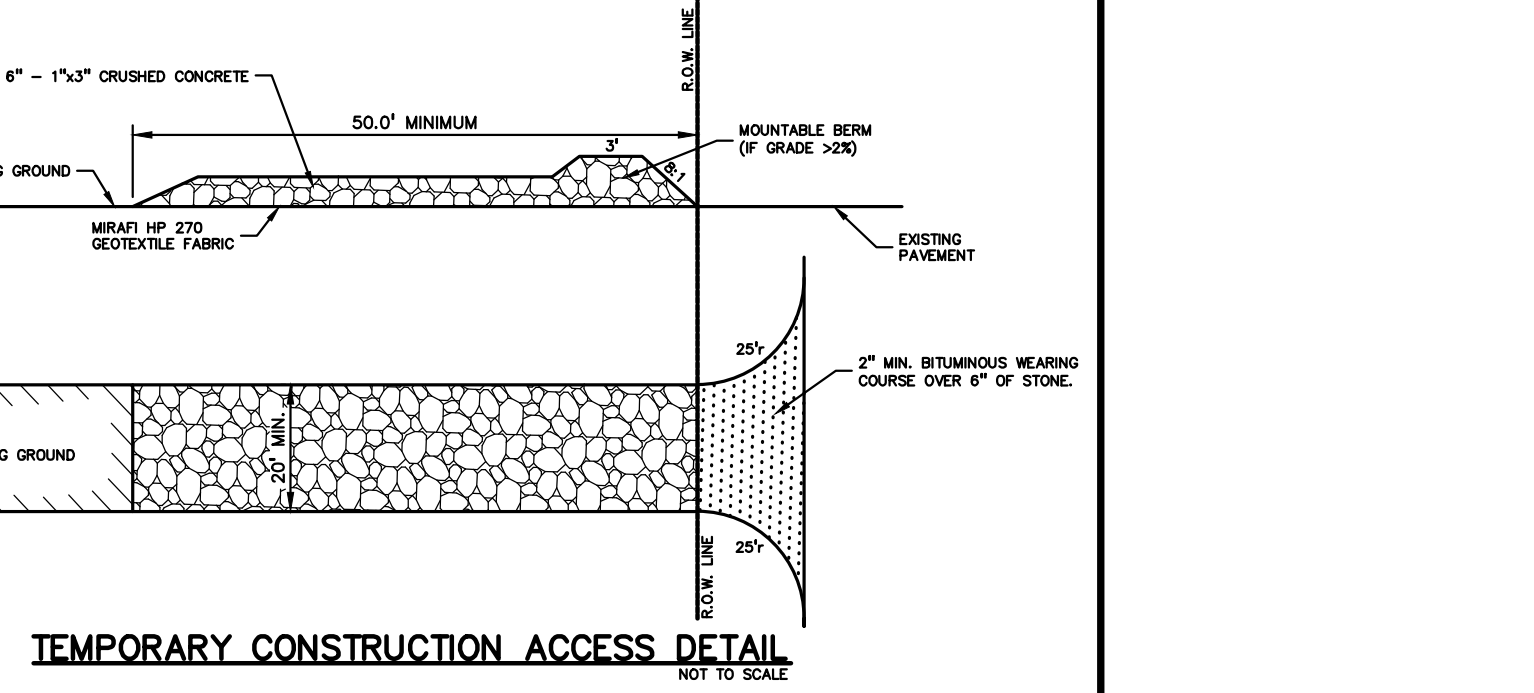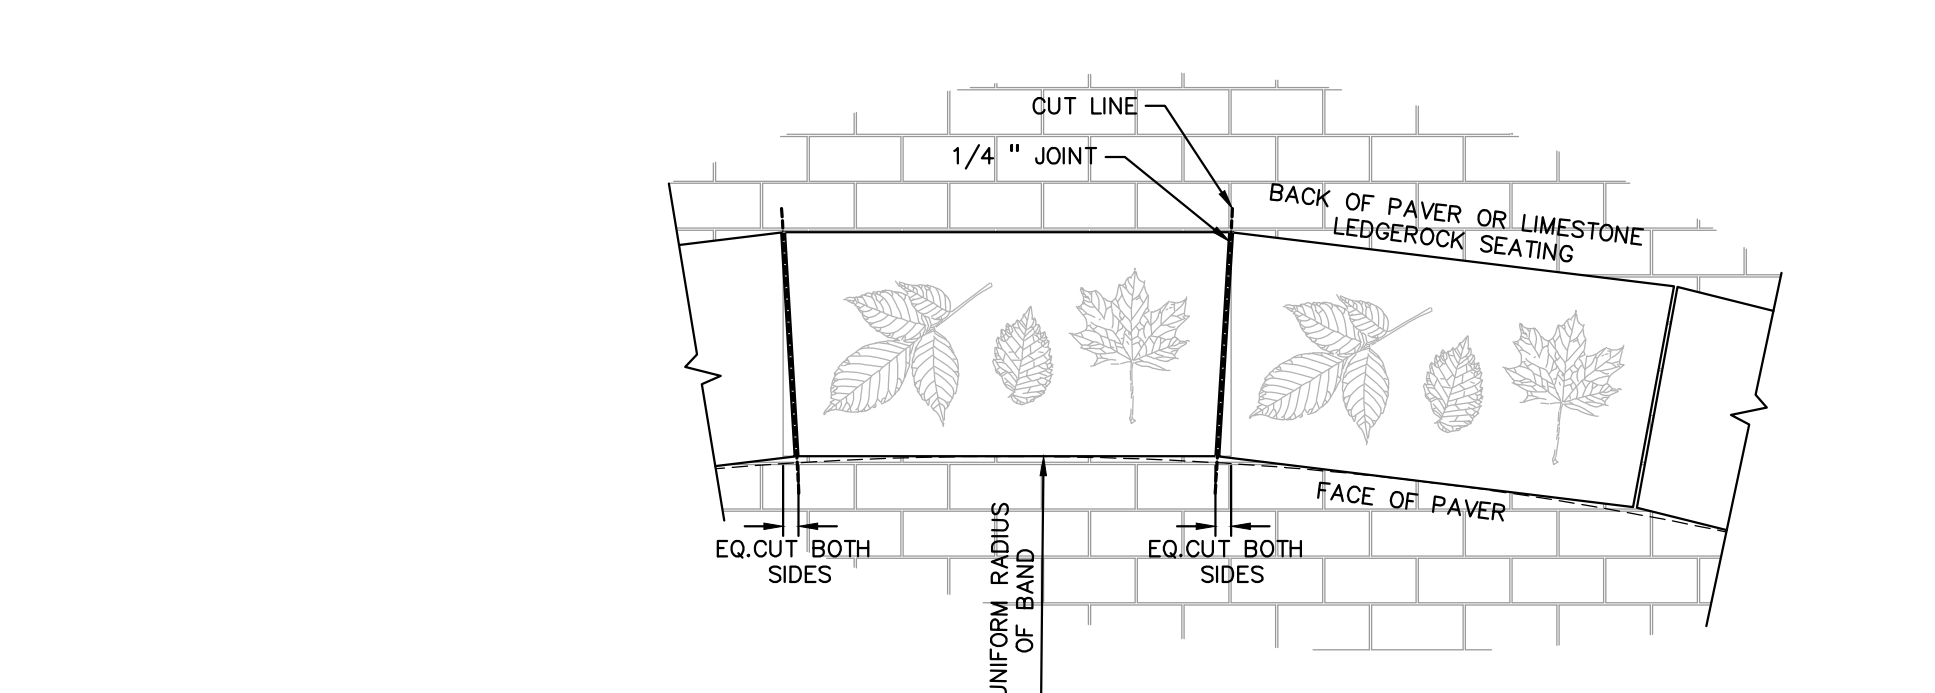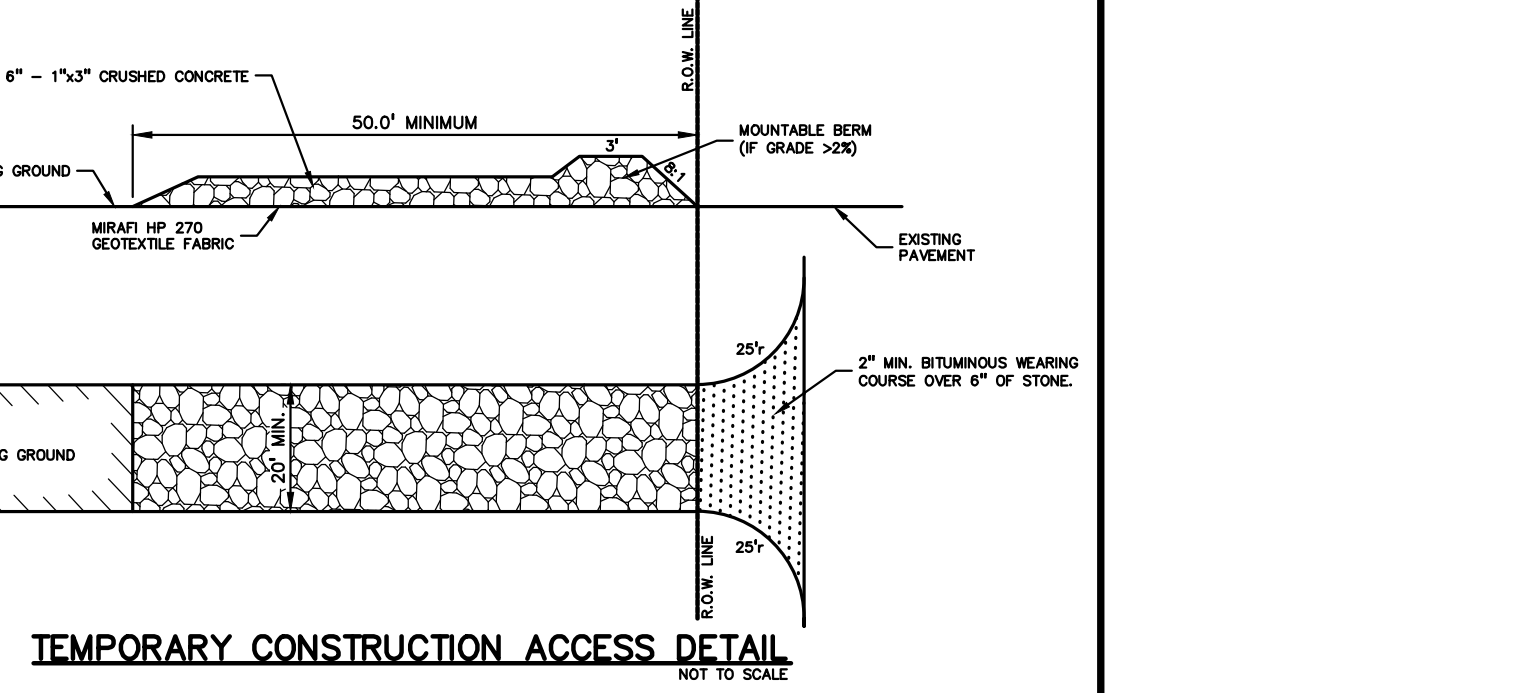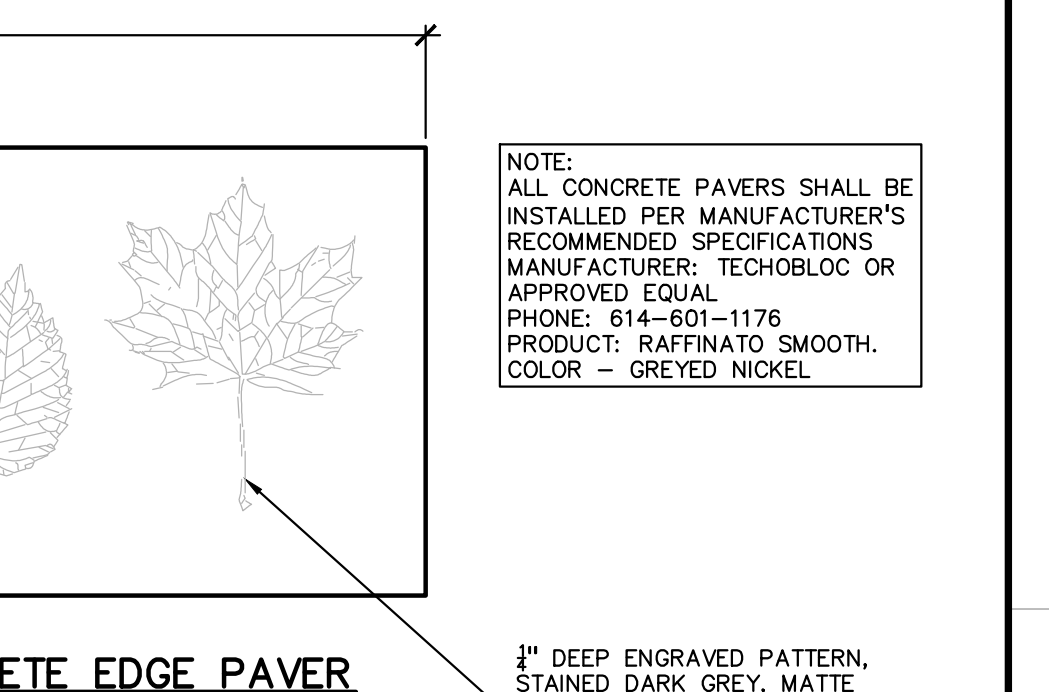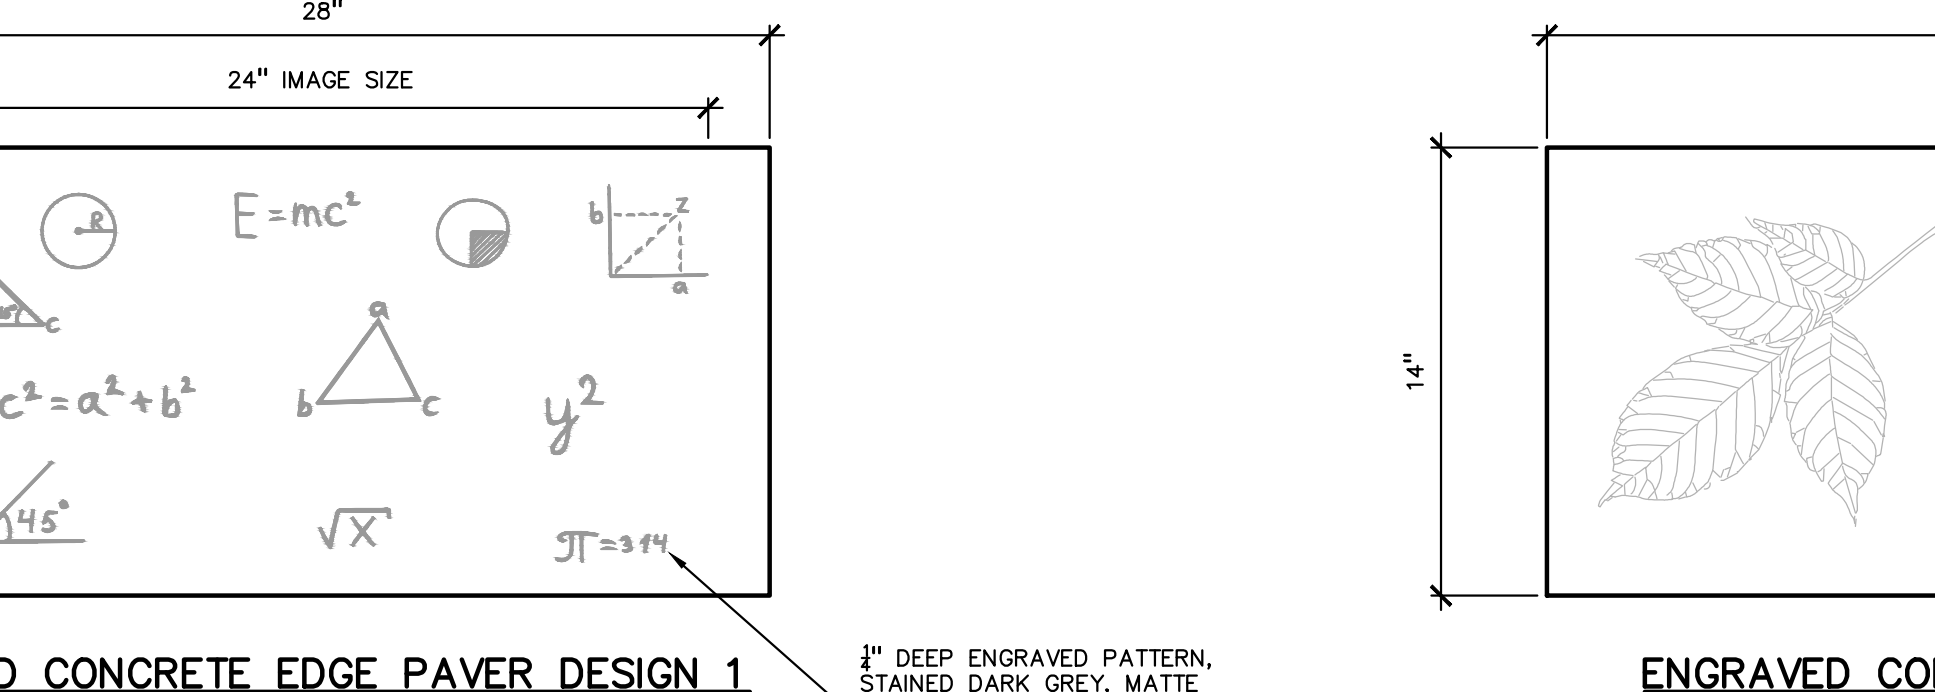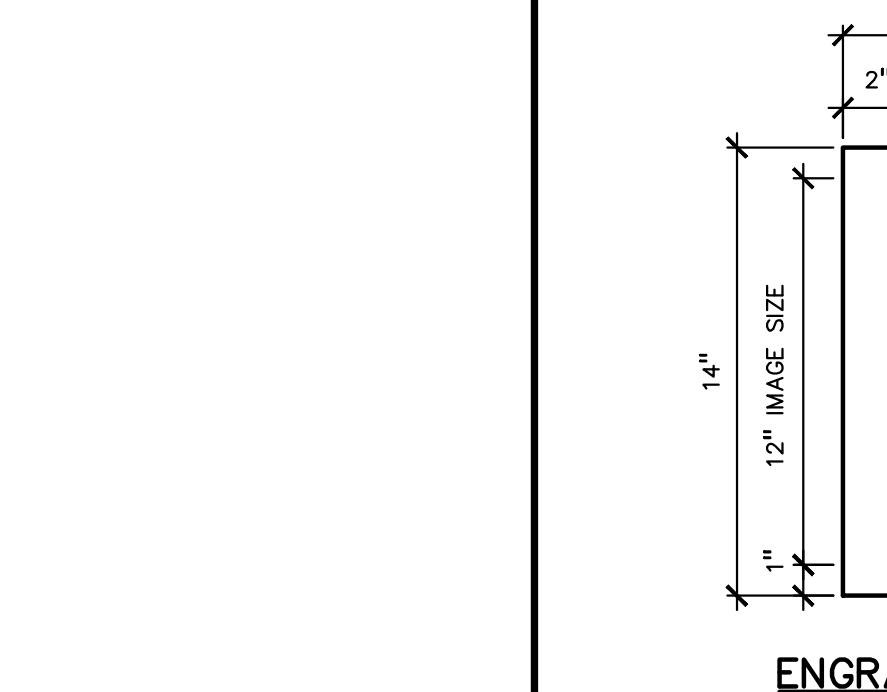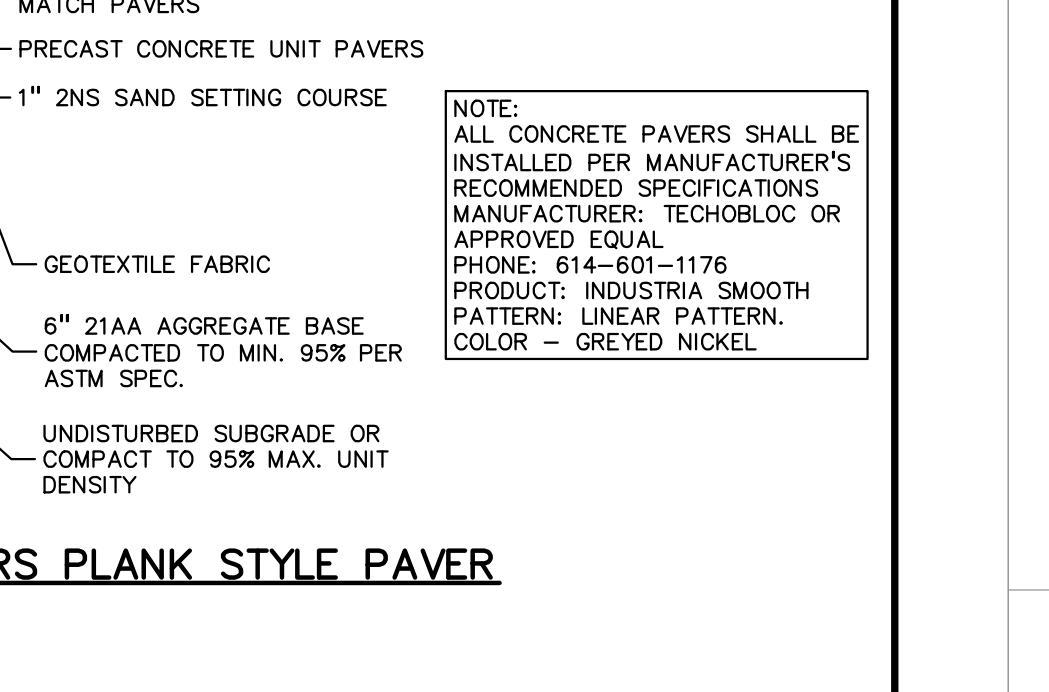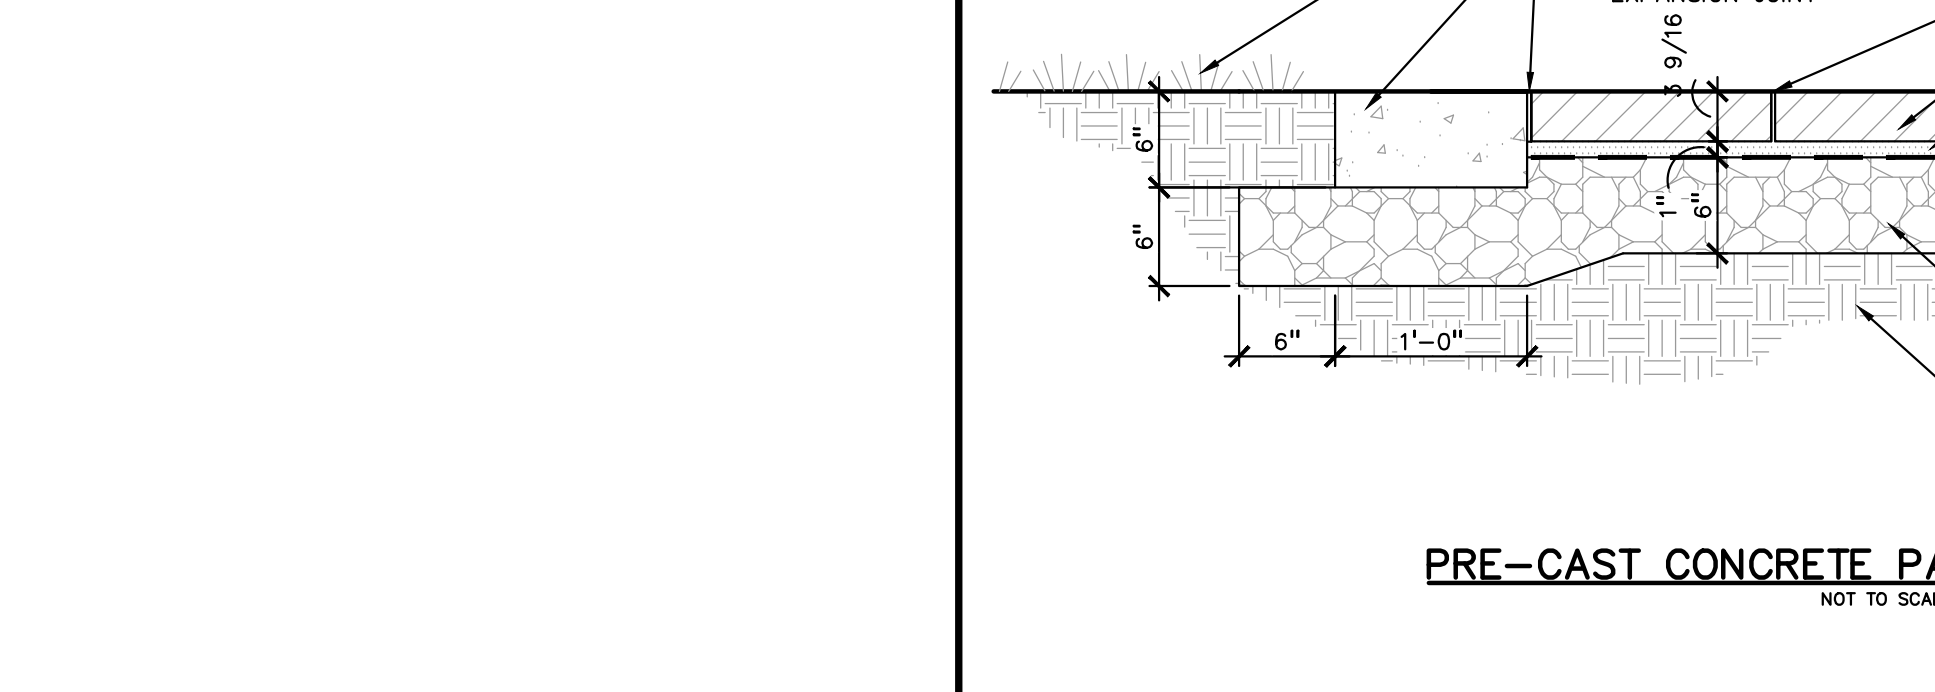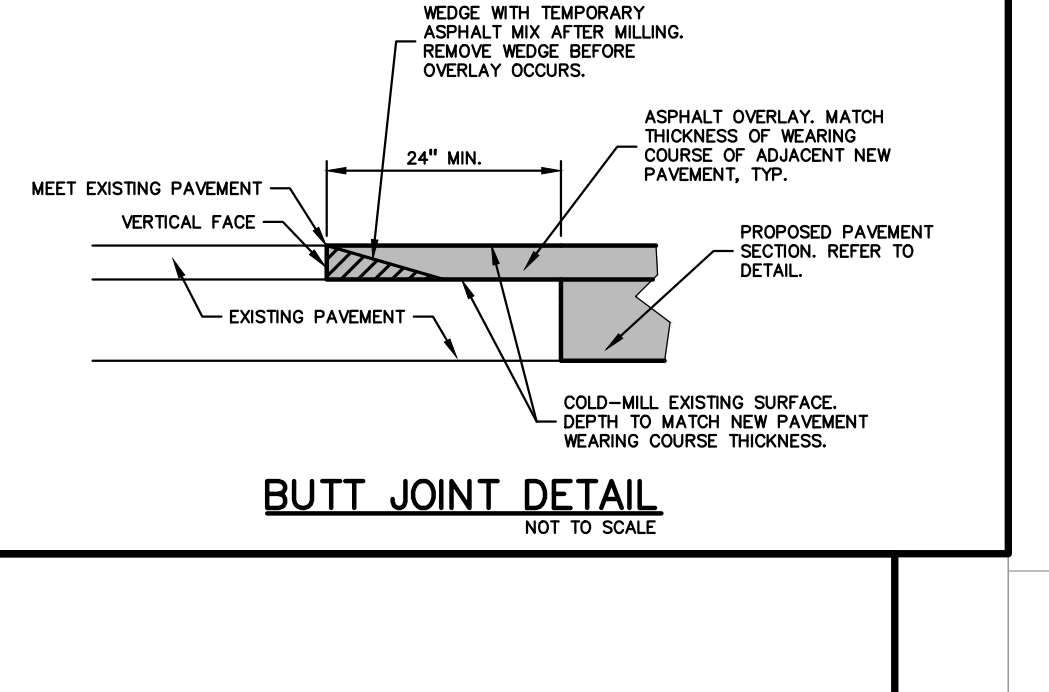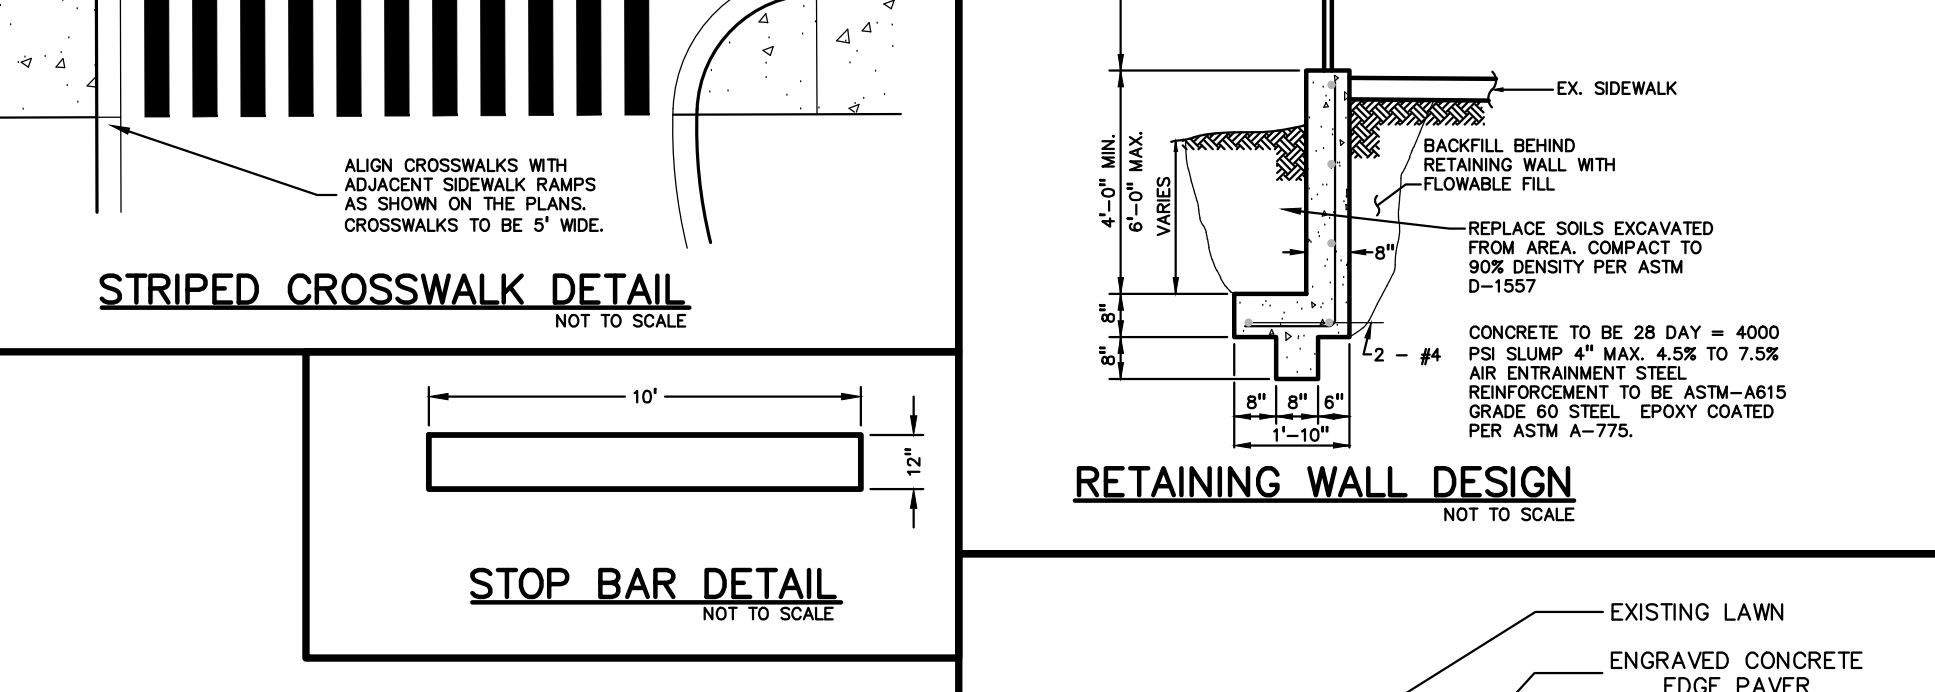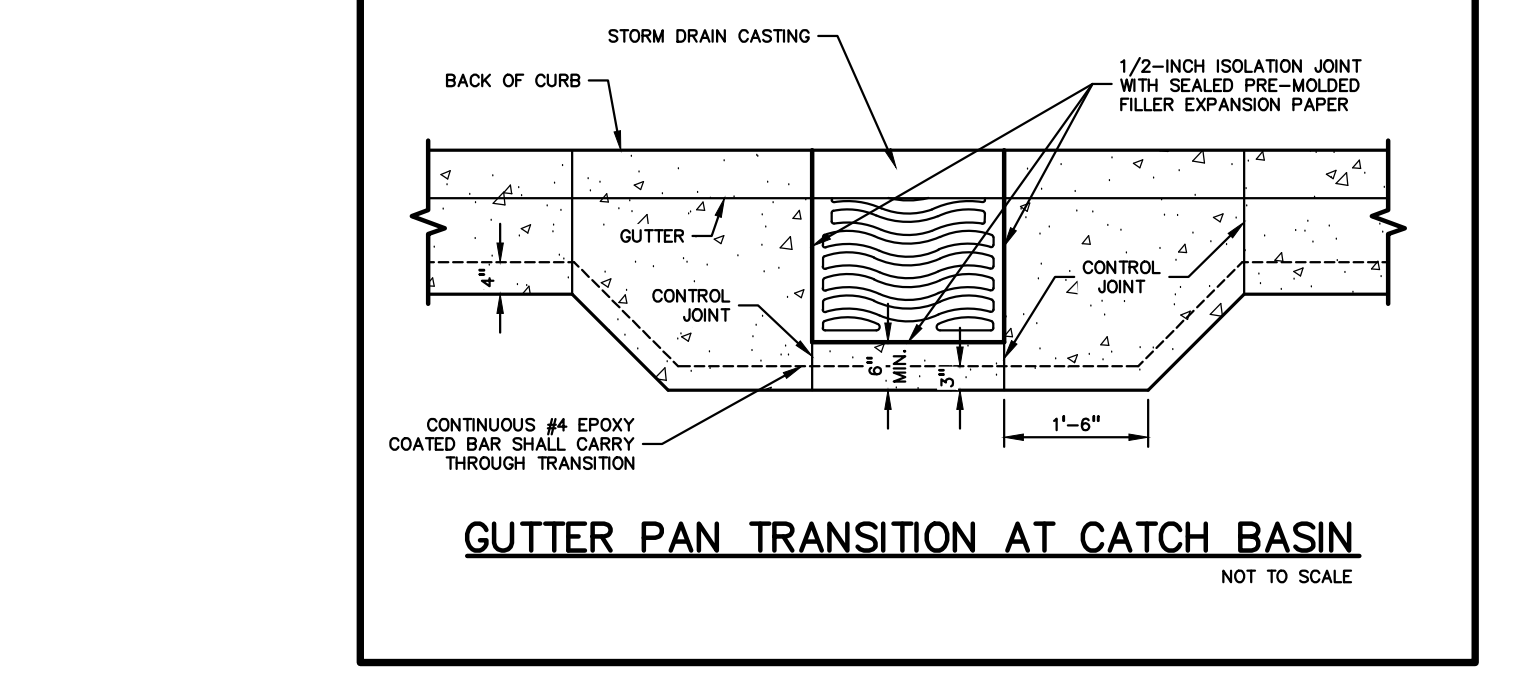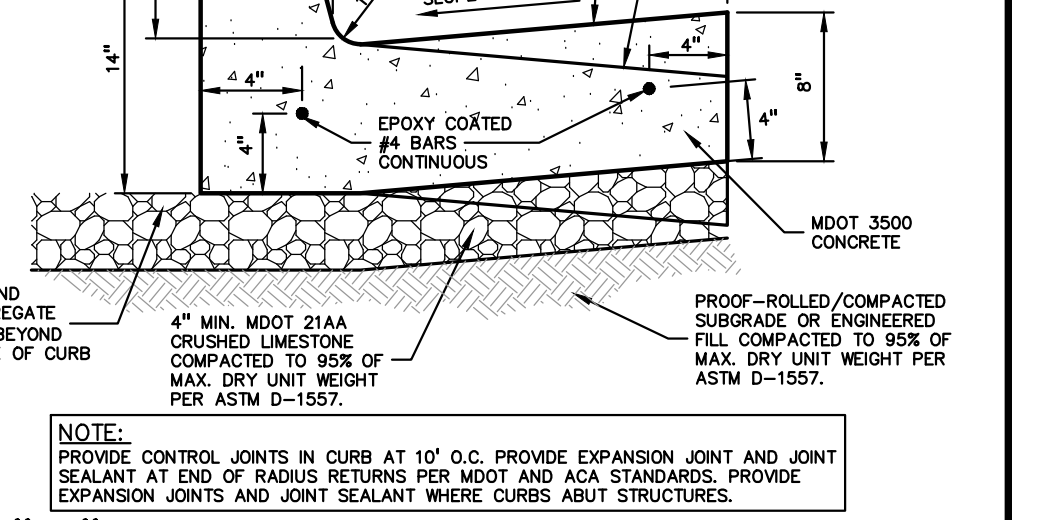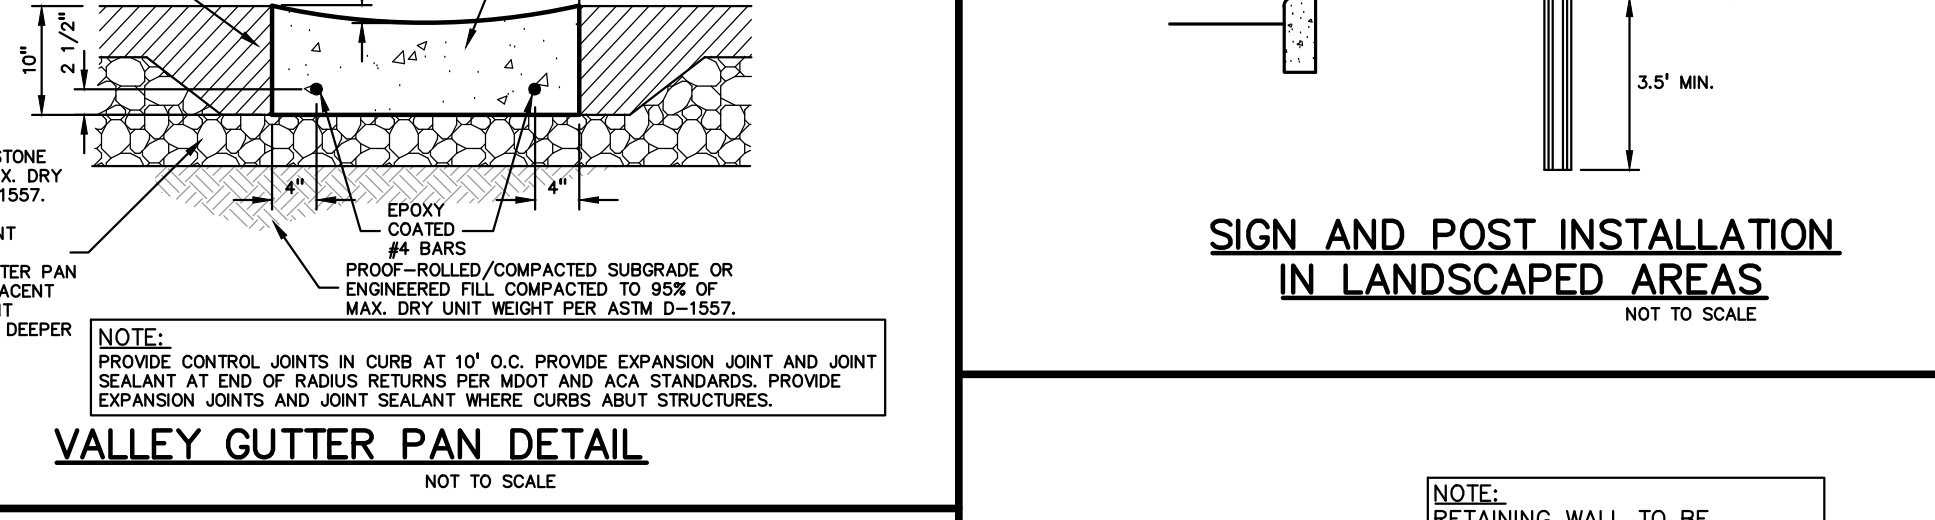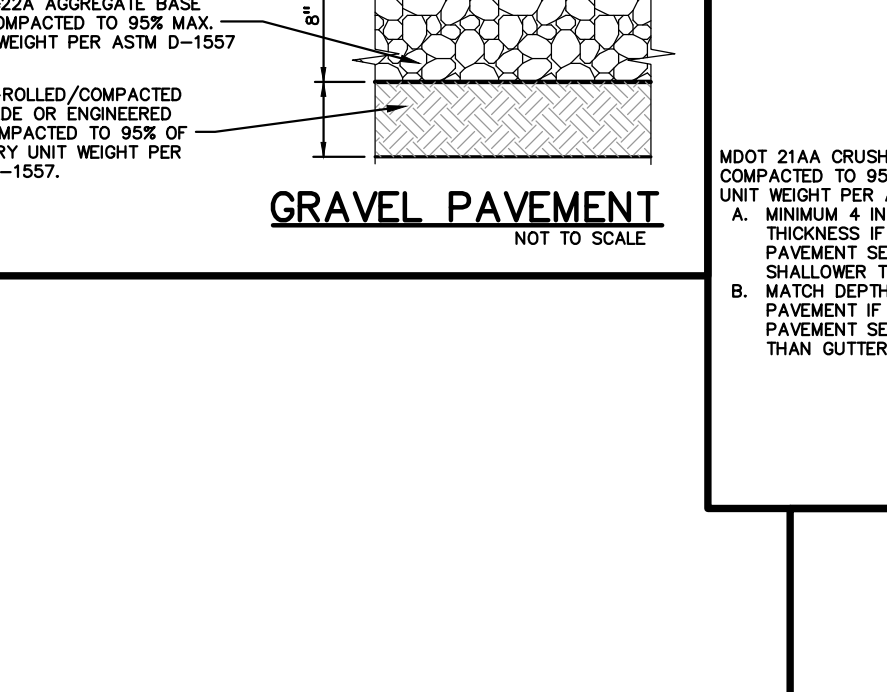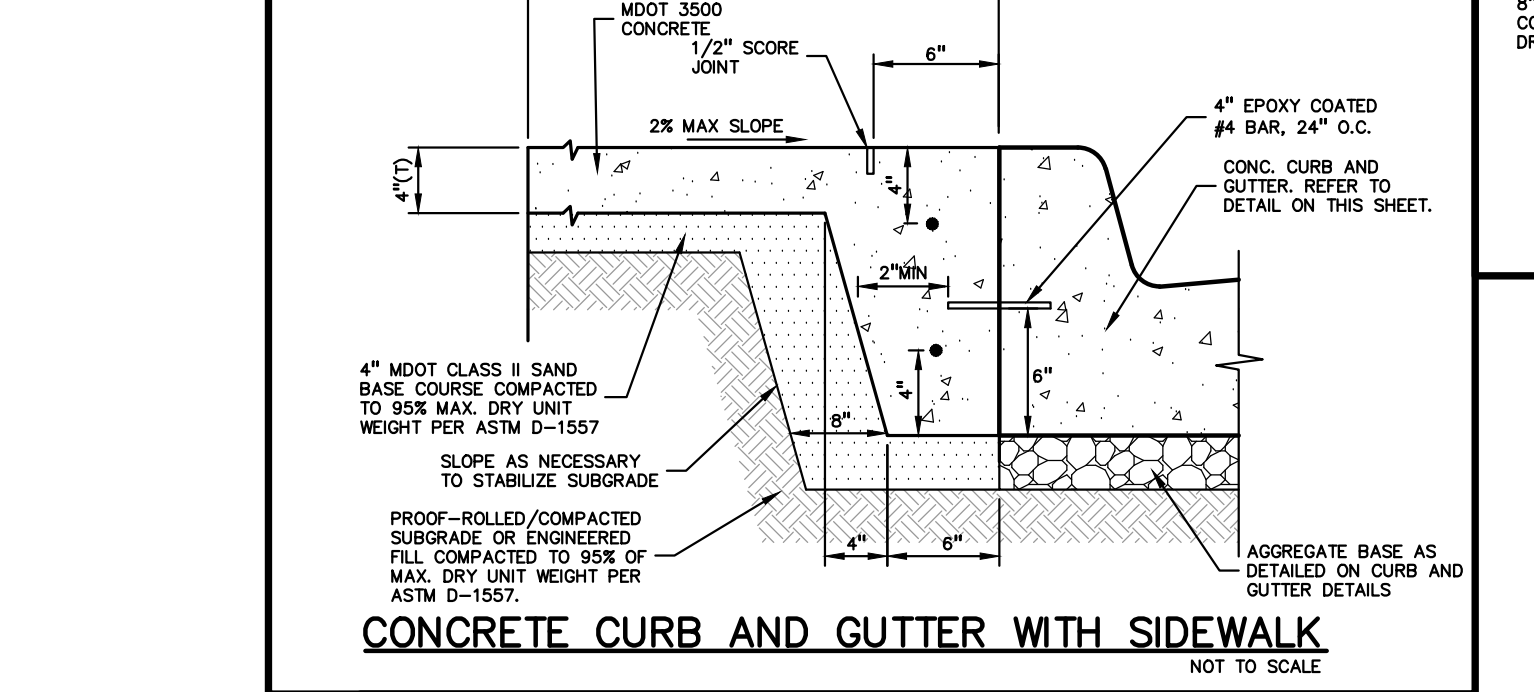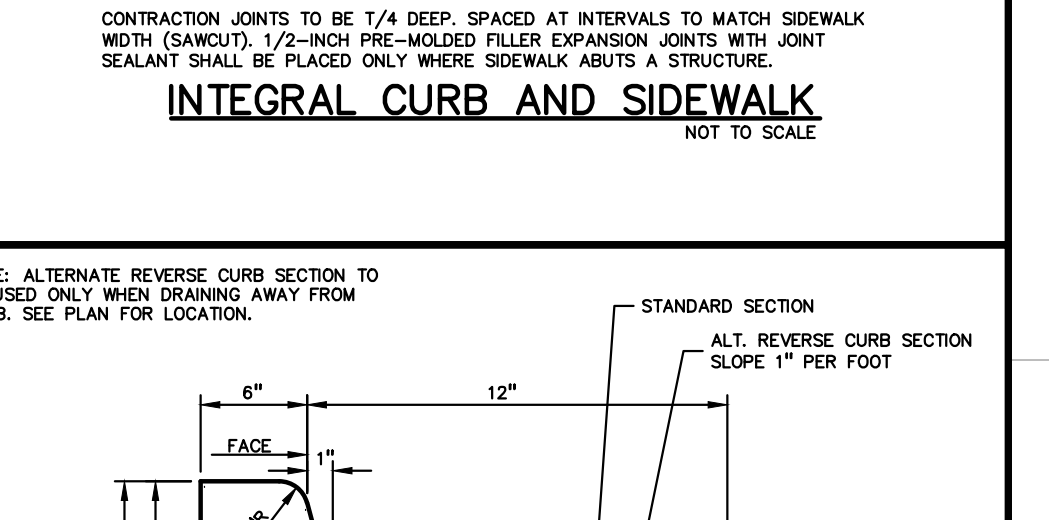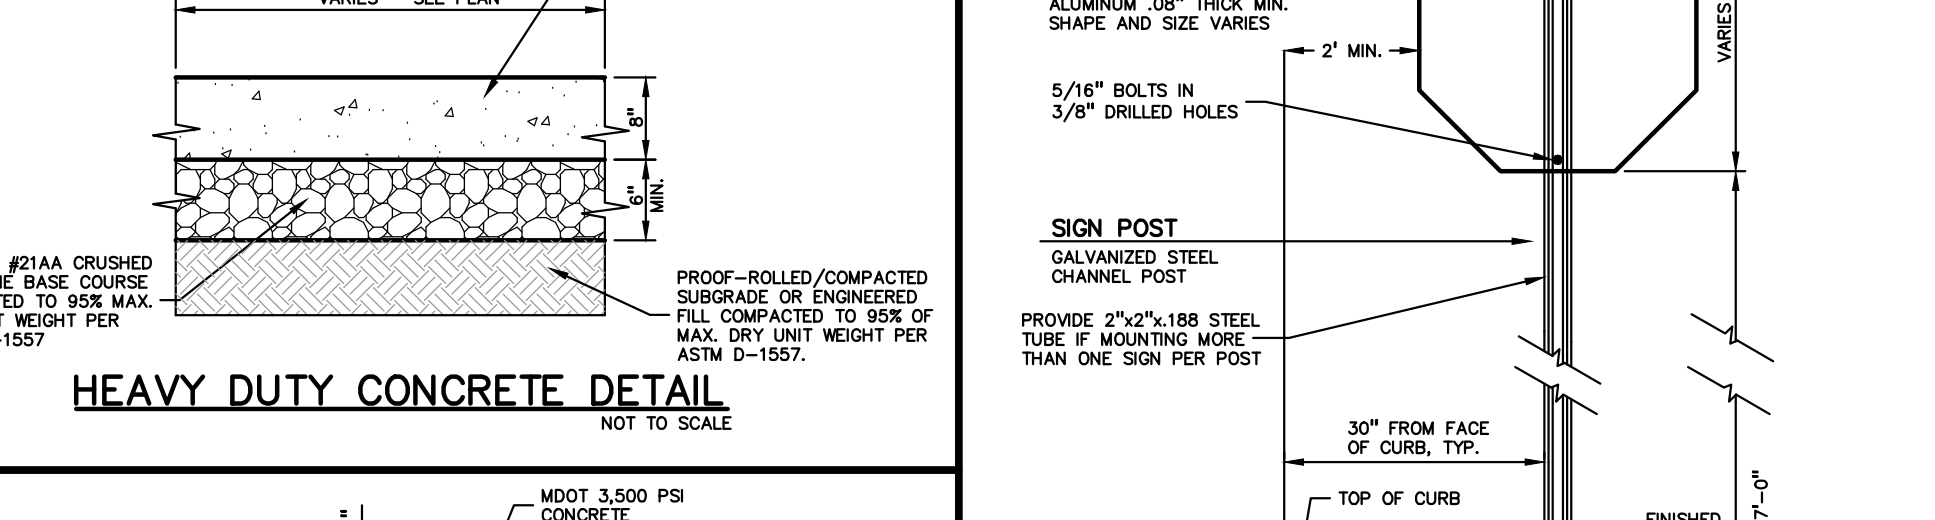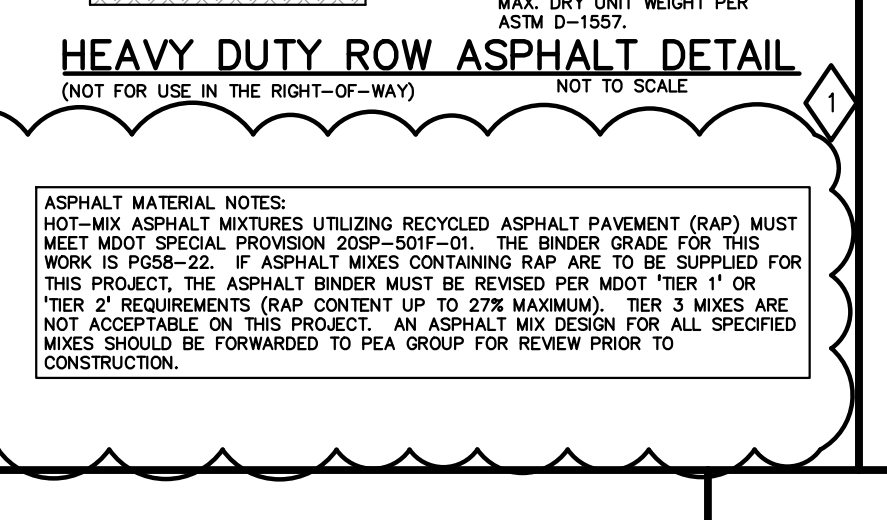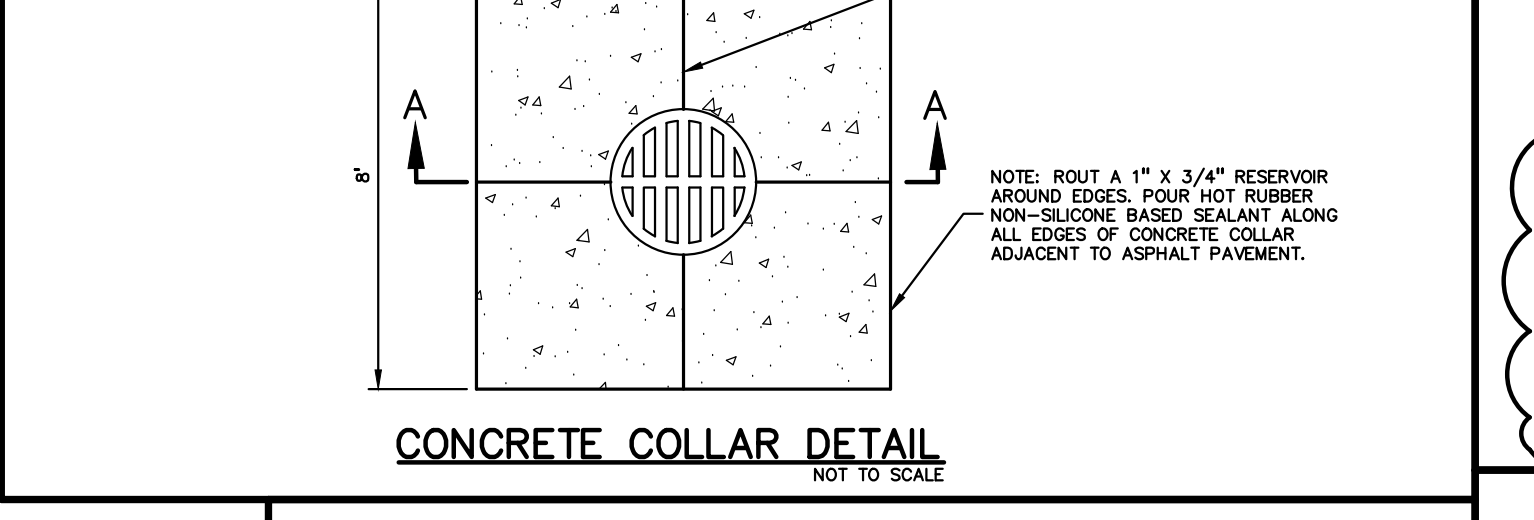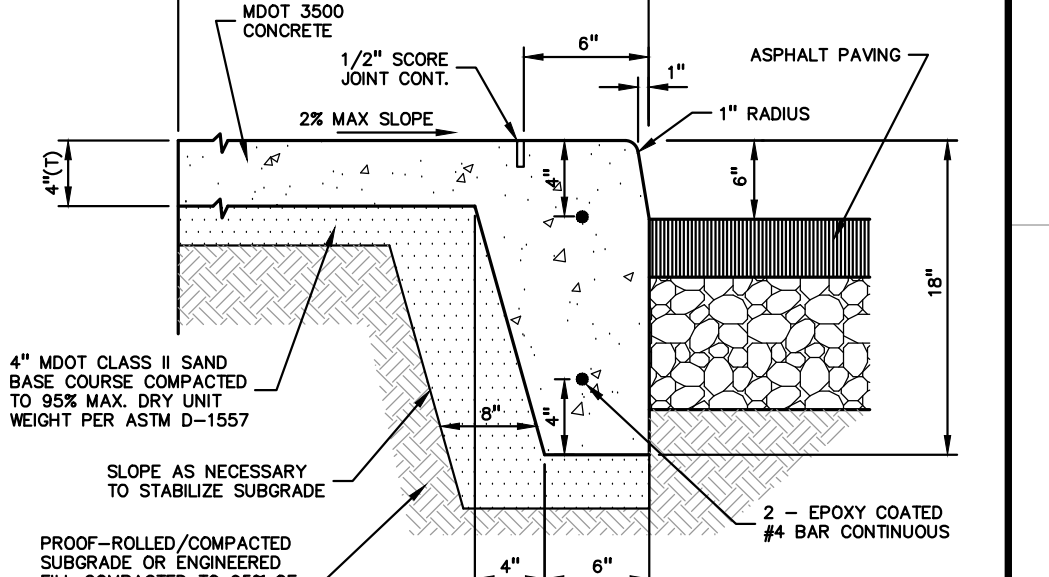

CDS2015-4-C DESIGN NOTES

THE STANDARD CDS2015-4-C CONFIGURATION IS SHOWN. ALTERNATE CONFIGURATIONS ARE AVAILABLE AND ARE LISTED BELOW. SOME CONFIGURATIONS MAY BE COMBINED TO SUIT SITE REQUIREMENTS.

CONFIGURATION DESCRIPTION

- GRATED INLET ONLY (NO INLET PIPES)
- GRATED INLET WITH INLET PIPE OR PIPES
- CURB INLET ONLY (NO INLET PIPES)
- CURB INLET WITH INLET PIPE OR PIPES
- SEPARATE OIL BAFFLE (SINGLE INLET PIPE REQUIRED FOR THIS CONFIGURATION)
- SEDIMENT WEIR FOR NUDEP/NUCAT CONFORMING UNITS

SITE SPECIFIC DATA REQUIREMENTS

STRUCTURE ID	MR34
WATER QUALITY FLOW RATE (CFS OR L/S)	1.00
PEAK FLOW RATE (CFS OR L/S)	14.00
RETURN PERIOD OF PEAK FLOW (YRS)	10
SCREEN APERTURE (2400 OR 4700)	2400

PIPE DATA

PIPE DATA	MATERIAL	DIAMETER
INLET PIPE 1	HDPE	8"
INLET PIPE 2	HDPE	8"
OUTLET PIPE	HDPE	30"

GENERAL NOTES

- CONTECH TO PROVIDE ALL MATERIALS UNLESS NOTED OTHERWISE.
- DIMENSIONS MARKED WITH (1) ARE REFERENCE DIMENSIONS. ACTUAL DIMENSIONS MAY VARY.
- FOR FABRICATION DRAWINGS WITH DETAILED STRUCTURE DIMENSIONS AND WEIGHTS, PLEASE CONTACT YOUR CONTECH ENGINEERED SOLUTIONS LLC REPRESENTATIVE. WWW.CONTECHES.COM
- CDS WATER QUALITY STRUCTURE SHALL BE IN ACCORDANCE WITH ALL DESIGN DATA AND INFORMATION CONTAINED IN THIS DRAWING.
- STRUCTURE SHALL MEET ASBOTO H200 AND CASTINGS SHALL MEET H200 (ASBOTO 10 3000) LOAD RATING, ASSUMING GROUNDWATER ELEVATION AT, OR BELOW, THE OUTLET PIPE INVERT ELEVATION. ENGINEER OF RECORD TO CONFIRM ACTUAL GROUNDWATER ELEVATION.
- PVC HYDRAULIC SHEAR PLATE IS PLACED ON SHELVE AT BOTTOM OF SCREEN CYLINDER. REMOVE AND REPLACE AS NECESSARY DURING MAINTENANCE CLEANING.

INSTALLATION NOTES

- ANY SUB-BASE BACKFILL DEPTH AND/OR ANTI-FLOTATION PROVISIONS ARE SITE-SPECIFIC DESIGN CONSIDERATIONS AND SHALL BE SPECIFIED BY ENGINEER OF RECORD.
- CONTRACTOR TO PROVIDE EQUIPMENT WITH SUFFICIENT LIFTING AND REACH CAPACITY TO LIFT AND SET THE CDS MANHOLE STRUCTURE.
- LIFTING CLUTCHES PROVIDED.
- CONTRACTOR TO ADD JOINT SEALANT BETWEEN ALL STRUCTURE SECTIONS, AND ASSEMBLE STRUCTURE.
- CONTRACTOR TO PROVIDE, INSTALL, AND GROUT PIPES. MATCH PIPE INVERTS WITH ELEVATIONS SHOWN.
- CONTRACTOR TO TAKE APPROPRIATE MEASURES TO ASSURE UNIT IS WATER TIGHT, HOLDING WATER TO FLOWLINE INVERT MINIMUM. IT IS SUGGESTED THAT ALL JOINTS BELOW PIPE INVERTS ARE GROUTED.

FRAME AND COVER (DIAMETER VARIES) N.T.S.

CDS2015-4-C INLINE CDS STANDARD DETAIL

CONTECH ENGINEERED SOLUTIONS LLC
www.conteches.com
9225 Center Point Dr., Suite 400, West Chester, OH 45380
937.338.1122 937.695.7800 937.695.7800 FAX

CDS4030-8-C DESIGN NOTES

THE STANDARD CDS4030-8-C CONFIGURATION IS SHOWN. ALTERNATE CONFIGURATIONS ARE AVAILABLE AND ARE LISTED BELOW. SOME CONFIGURATIONS MAY BE COMBINED TO SUIT SITE REQUIREMENTS.

CONFIGURATION DESCRIPTION

- GRATED INLET ONLY (NO INLET PIPES)
- GRATED INLET WITH INLET PIPE OR PIPES
- CURB INLET ONLY (NO INLET PIPES)
- CURB INLET WITH INLET PIPE OR PIPES
- SEPARATE OIL BAFFLE (SINGLE INLET PIPE REQUIRED FOR THIS CONFIGURATION)
- SEDIMENT WEIR FOR NUDEP/NUCAT CONFORMING UNITS

SITE SPECIFIC DATA REQUIREMENTS

STRUCTURE ID	MR34
WATER QUALITY FLOW RATE (CFS OR L/S)	1.00
PEAK FLOW RATE (CFS OR L/S)	14.00
RETURN PERIOD OF PEAK FLOW (YRS)	10
SCREEN APERTURE (2400 OR 4700)	2400

PIPE DATA

PIPE DATA	MATERIAL	DIAMETER
INLET PIPE 1	HDPE	30"
INLET PIPE 2	HDPE	8"
OUTLET PIPE	HDPE	30"

GENERAL NOTES

- CONTECH TO PROVIDE ALL MATERIALS UNLESS NOTED OTHERWISE.
- DIMENSIONS MARKED WITH (1) ARE REFERENCE DIMENSIONS. ACTUAL DIMENSIONS MAY VARY.
- FOR FABRICATION DRAWINGS WITH DETAILED STRUCTURE DIMENSIONS AND WEIGHTS, PLEASE CONTACT YOUR CONTECH ENGINEERED SOLUTIONS LLC REPRESENTATIVE. WWW.CONTECHES.COM
- CDS WATER QUALITY STRUCTURE SHALL BE IN ACCORDANCE WITH ALL DESIGN DATA AND INFORMATION CONTAINED IN THIS DRAWING.
- STRUCTURE SHALL MEET ASBOTO H200 AND CASTINGS SHALL MEET H200 (ASBOTO 10 3000) LOAD RATING, ASSUMING GROUNDWATER ELEVATION AT, OR BELOW, THE OUTLET PIPE INVERT ELEVATION. ENGINEER OF RECORD TO CONFIRM ACTUAL GROUNDWATER ELEVATION.
- PVC HYDRAULIC SHEAR PLATE IS PLACED ON SHELVE AT BOTTOM OF SCREEN CYLINDER. REMOVE AND REPLACE AS NECESSARY DURING MAINTENANCE CLEANING.


















INSTALLATION NOTES

- ANY SUB-BASE BACKFILL DEPTH AND/OR ANTI-FLOTATION PROVISIONS ARE SITE-SPECIFIC DESIGN CONSIDERATIONS AND SHALL BE SPECIFIED BY ENGINEER OF RECORD.
- CONTRACTOR TO PROVIDE EQUIPMENT WITH SUFFICIENT LIFTING AND REACH CAPACITY TO LIFT AND SET THE CDS MANHOLE STRUCTURE.
- LIFTING CLUTCHES PROVIDED.
- CONTRACTOR TO ADD JOINT SEALANT BETWEEN ALL STRUCTURE SECTIONS, AND ASSEMBLE STRUCTURE.
- CONTRACTOR TO PROVIDE, INSTALL, AND GROUT PIPES. MATCH PIPE INVERTS WITH ELEVATIONS SHOWN.
- CONTRACTOR TO TAKE APPROPRIATE MEASURES TO ASSURE UNIT IS WATER TIGHT, HOLDING WATER TO FLOWLINE INVERT MINIMUM. IT IS SUGGESTED THAT ALL JOINTS BELOW PIPE INVERTS ARE GROUTED.


FRAME AND COVER (DIAMETER VARIES) N.T.S.

CDS4030-8-C INLINE CDS STANDARD DETAIL


CONTECH ENGINEERED SOLUTIONS LLC
www.conteches.com
9225 Center Point Dr., Suite 400, West Chester, OH 45380
937.338.1122 937.695.7800 937.695.7800 FAX

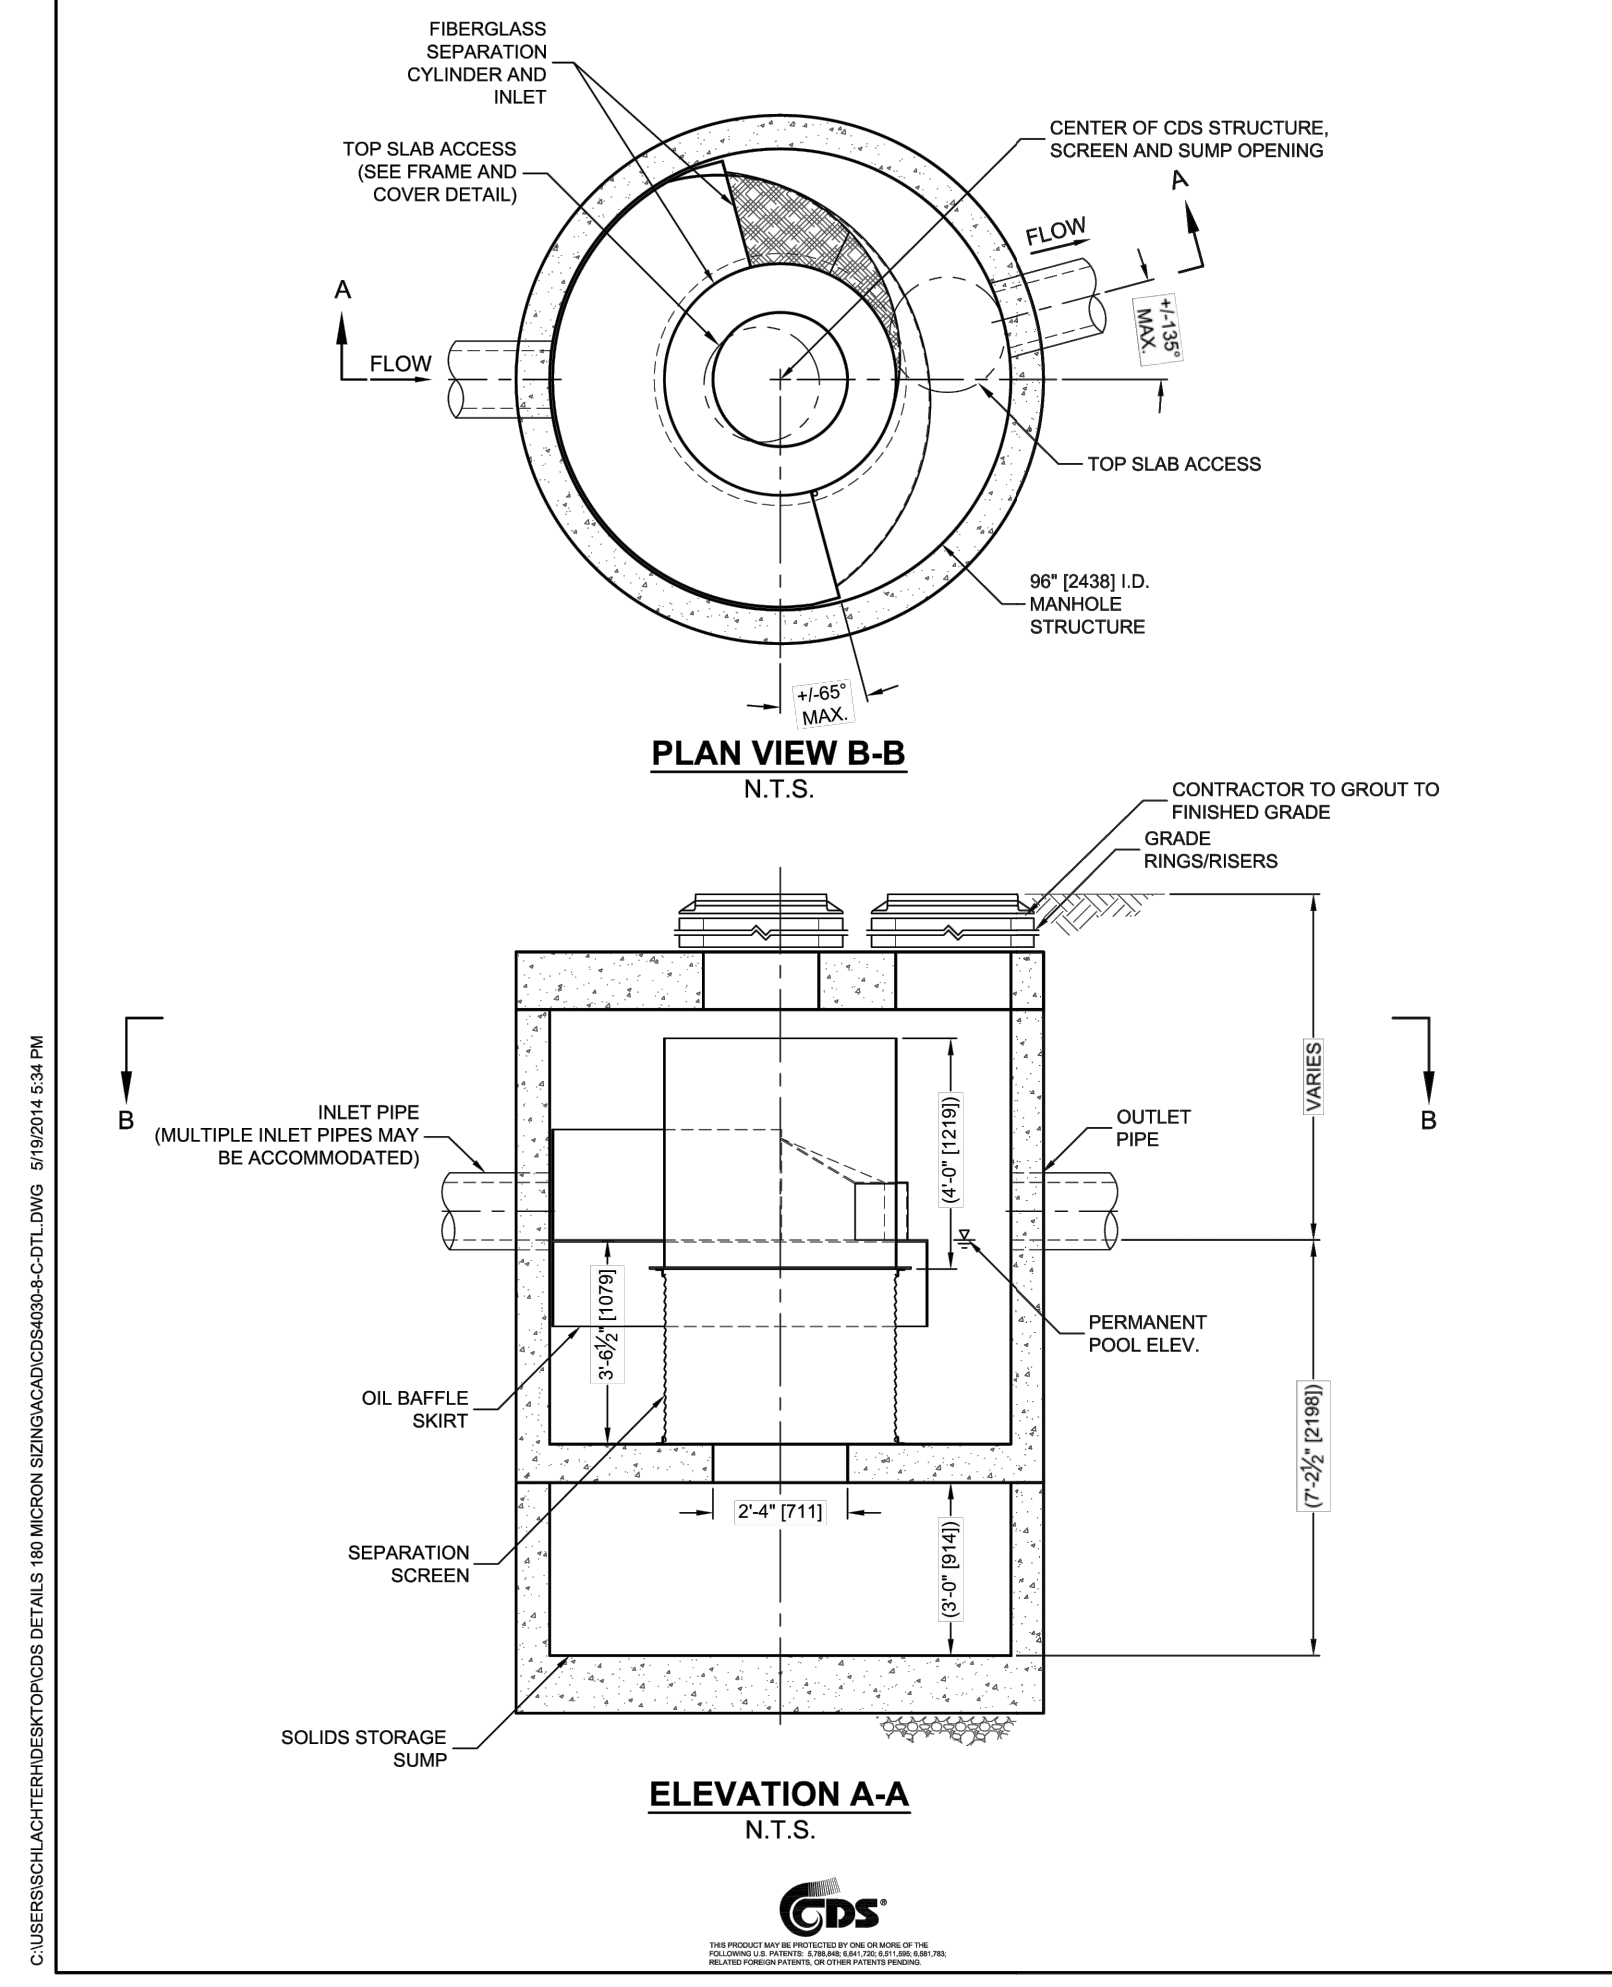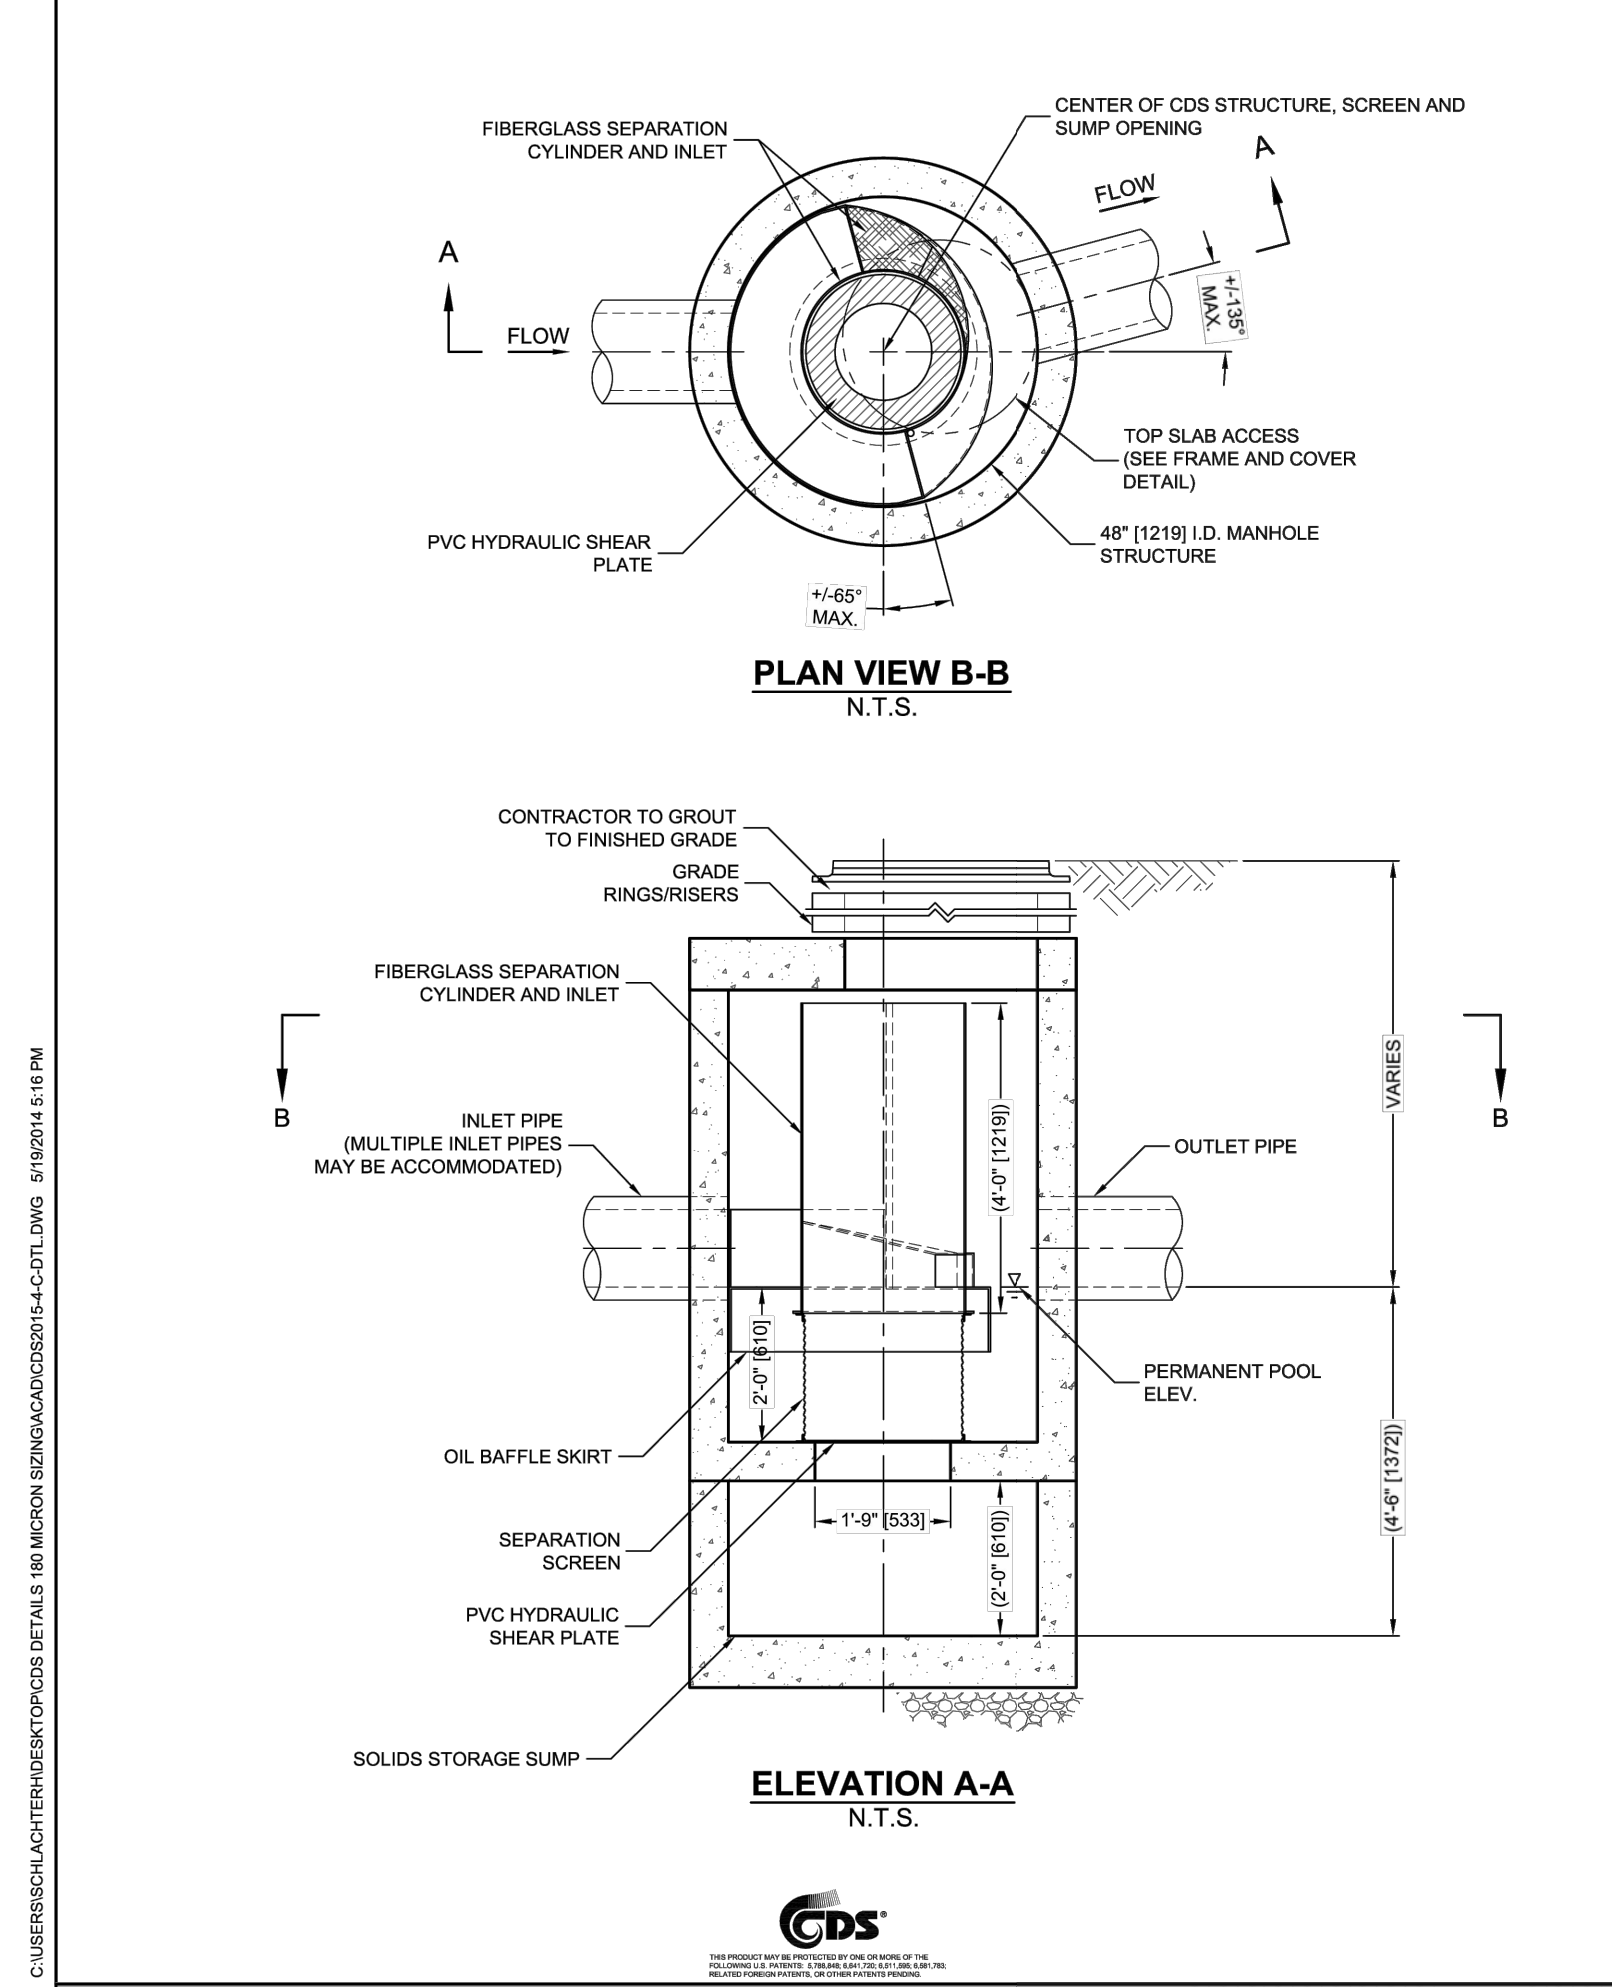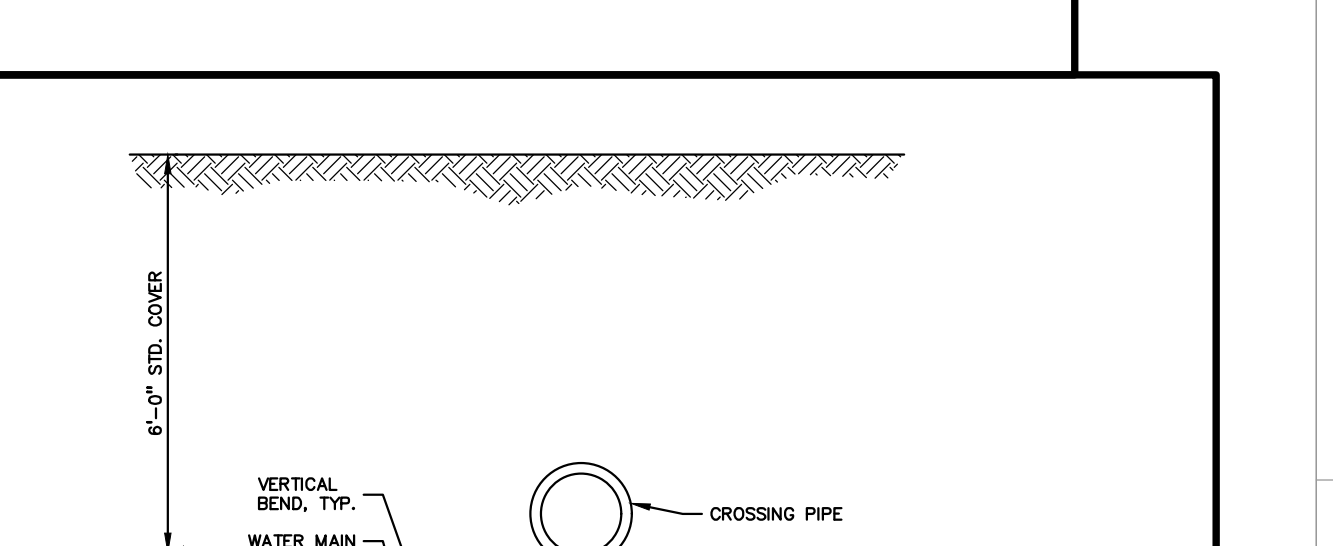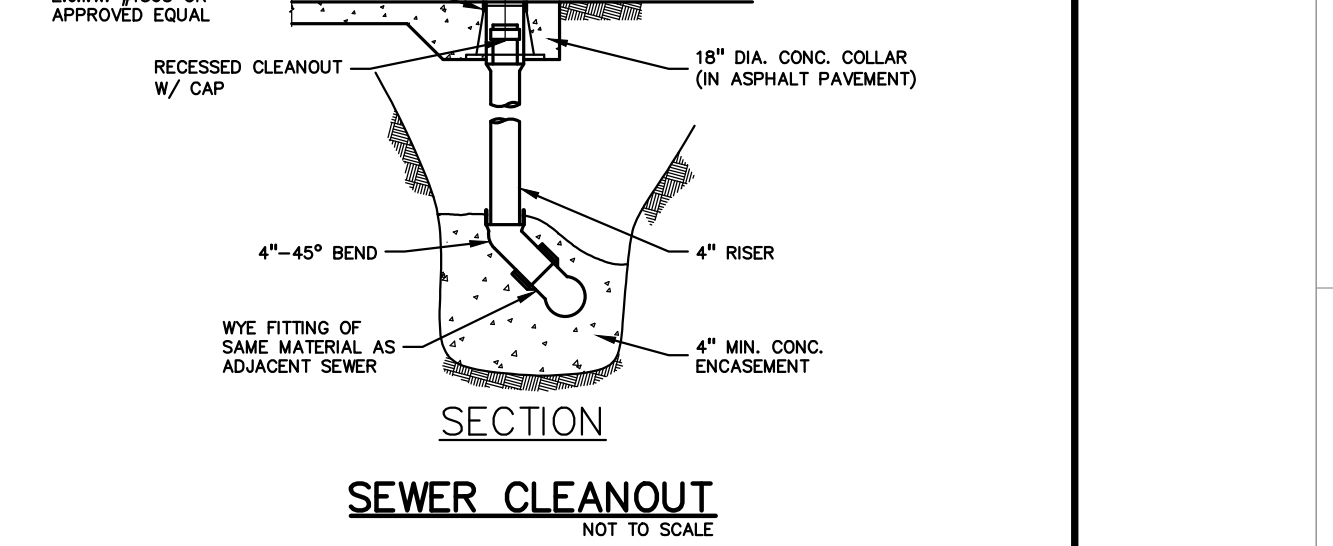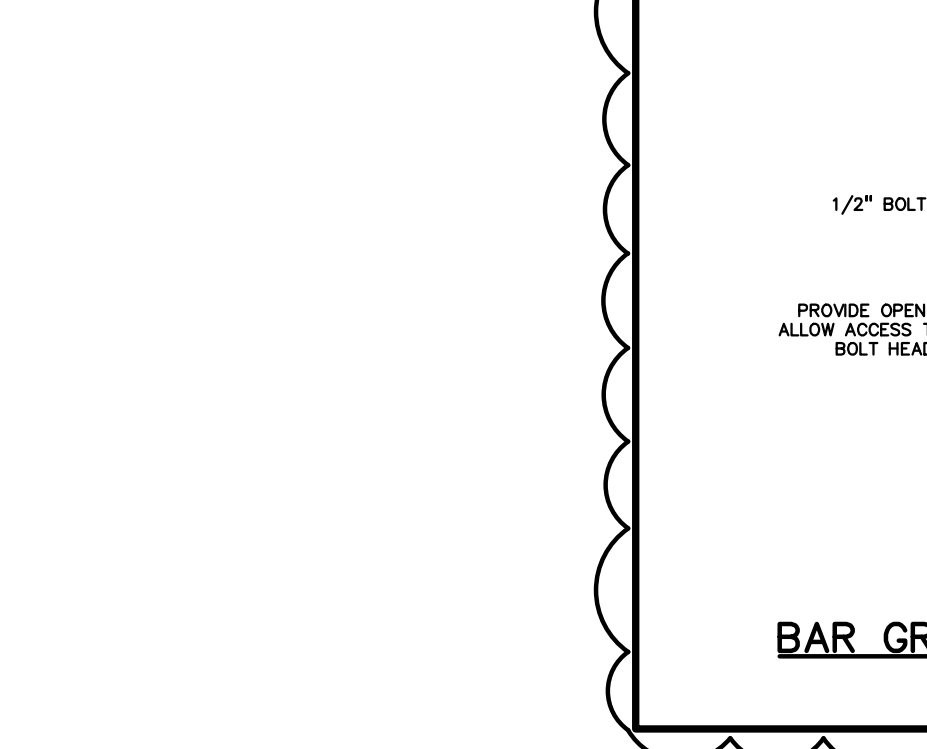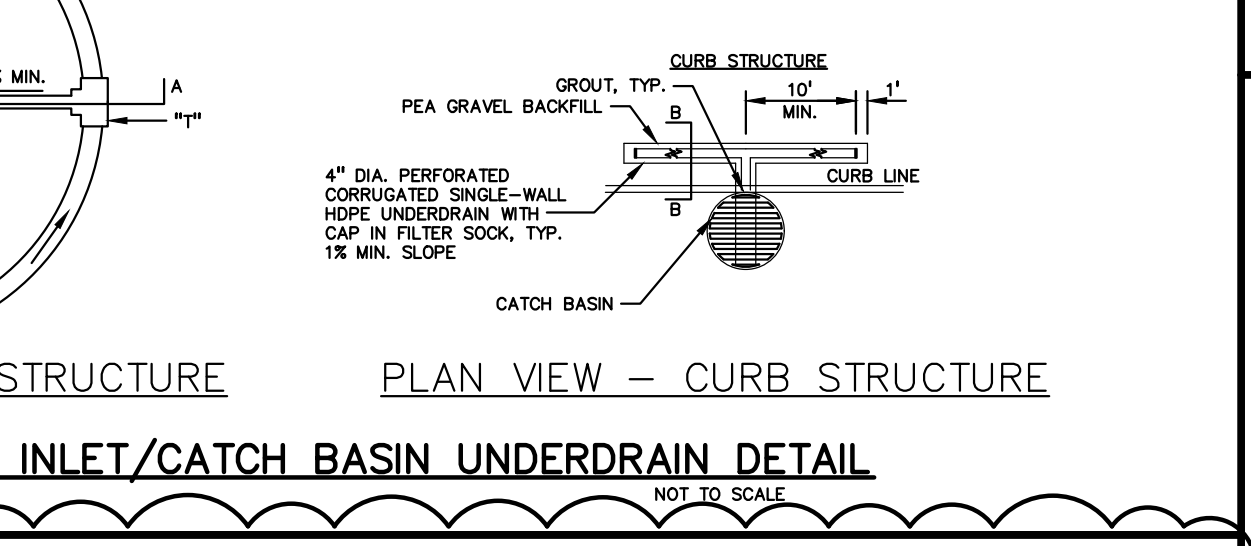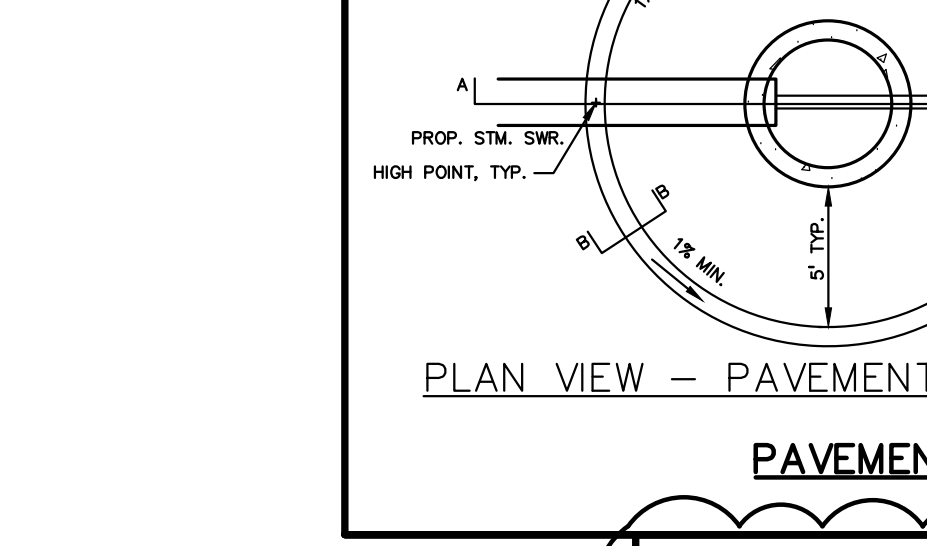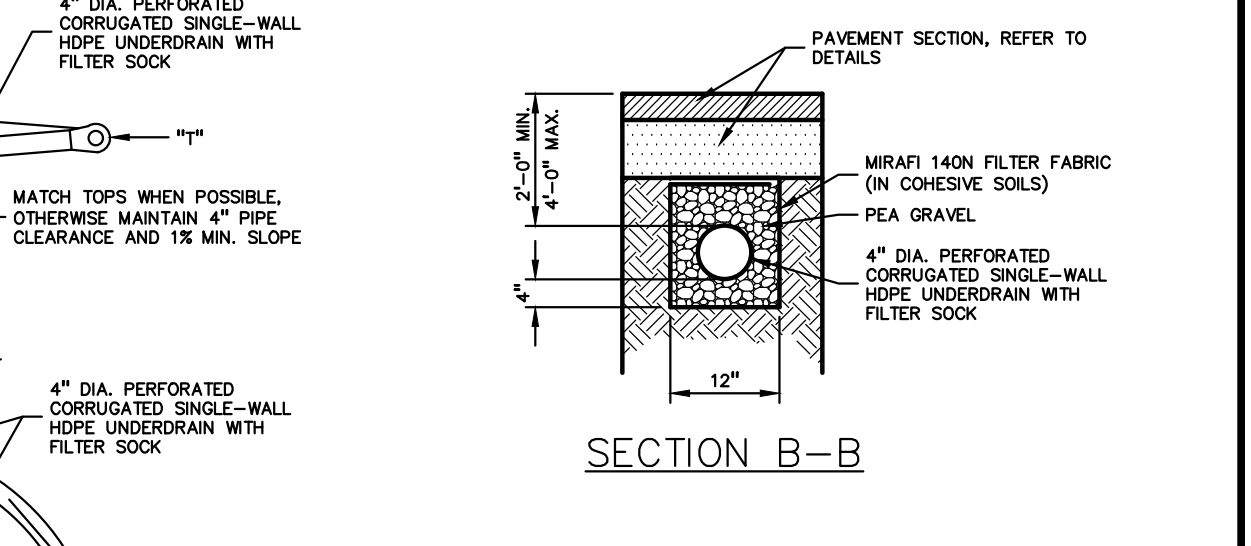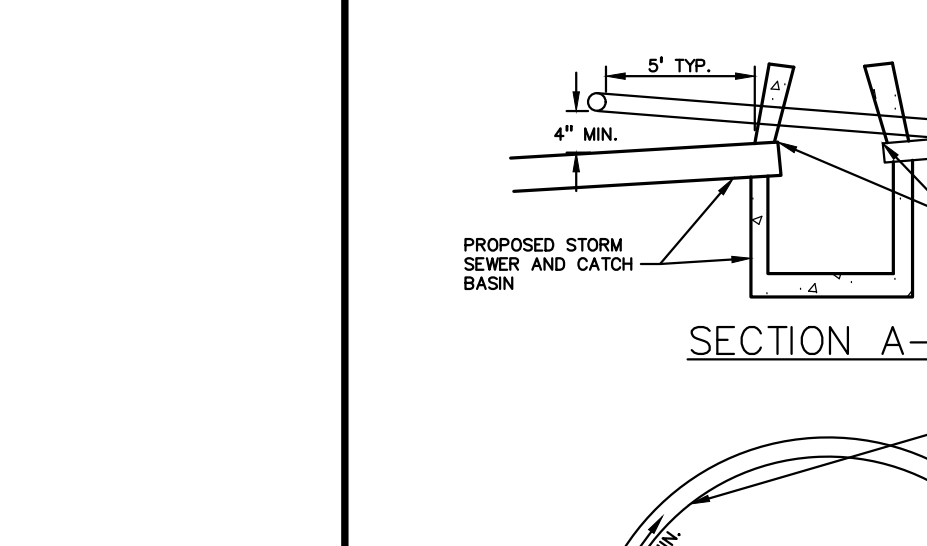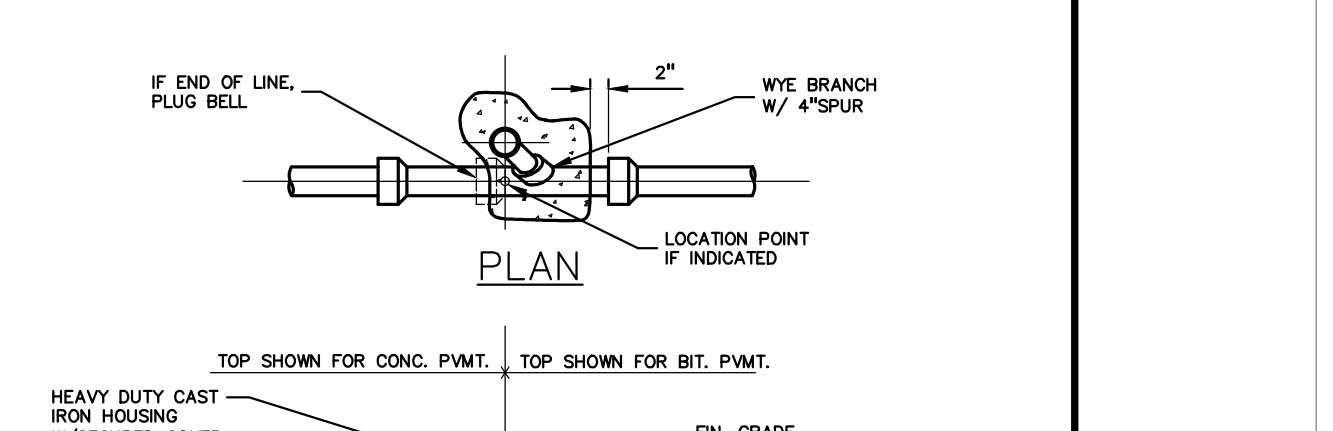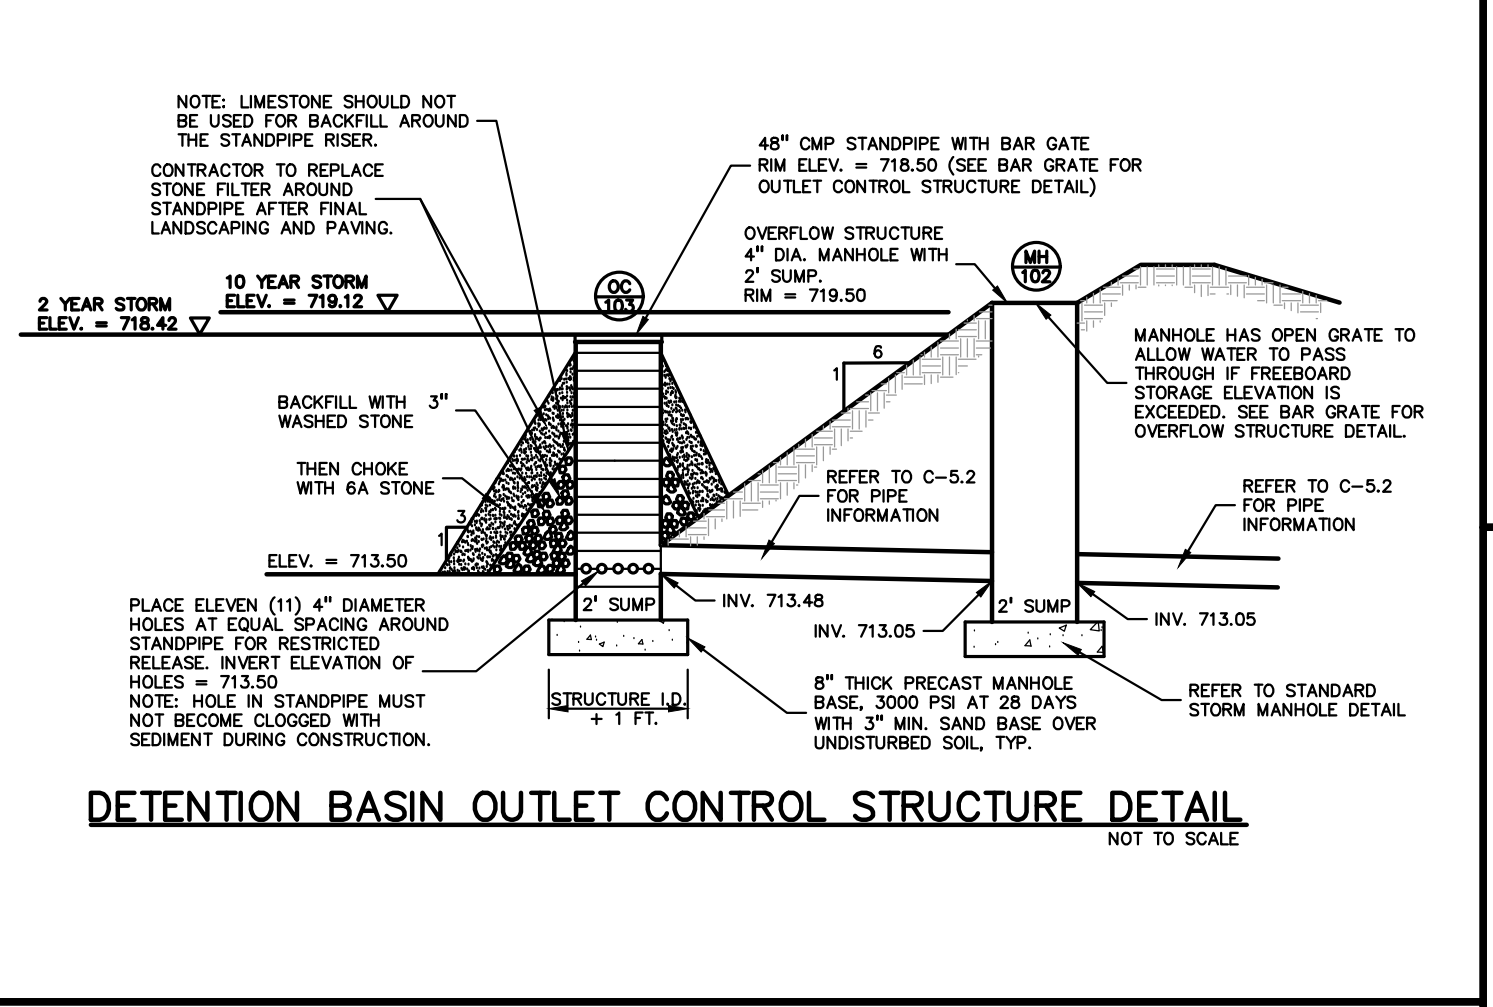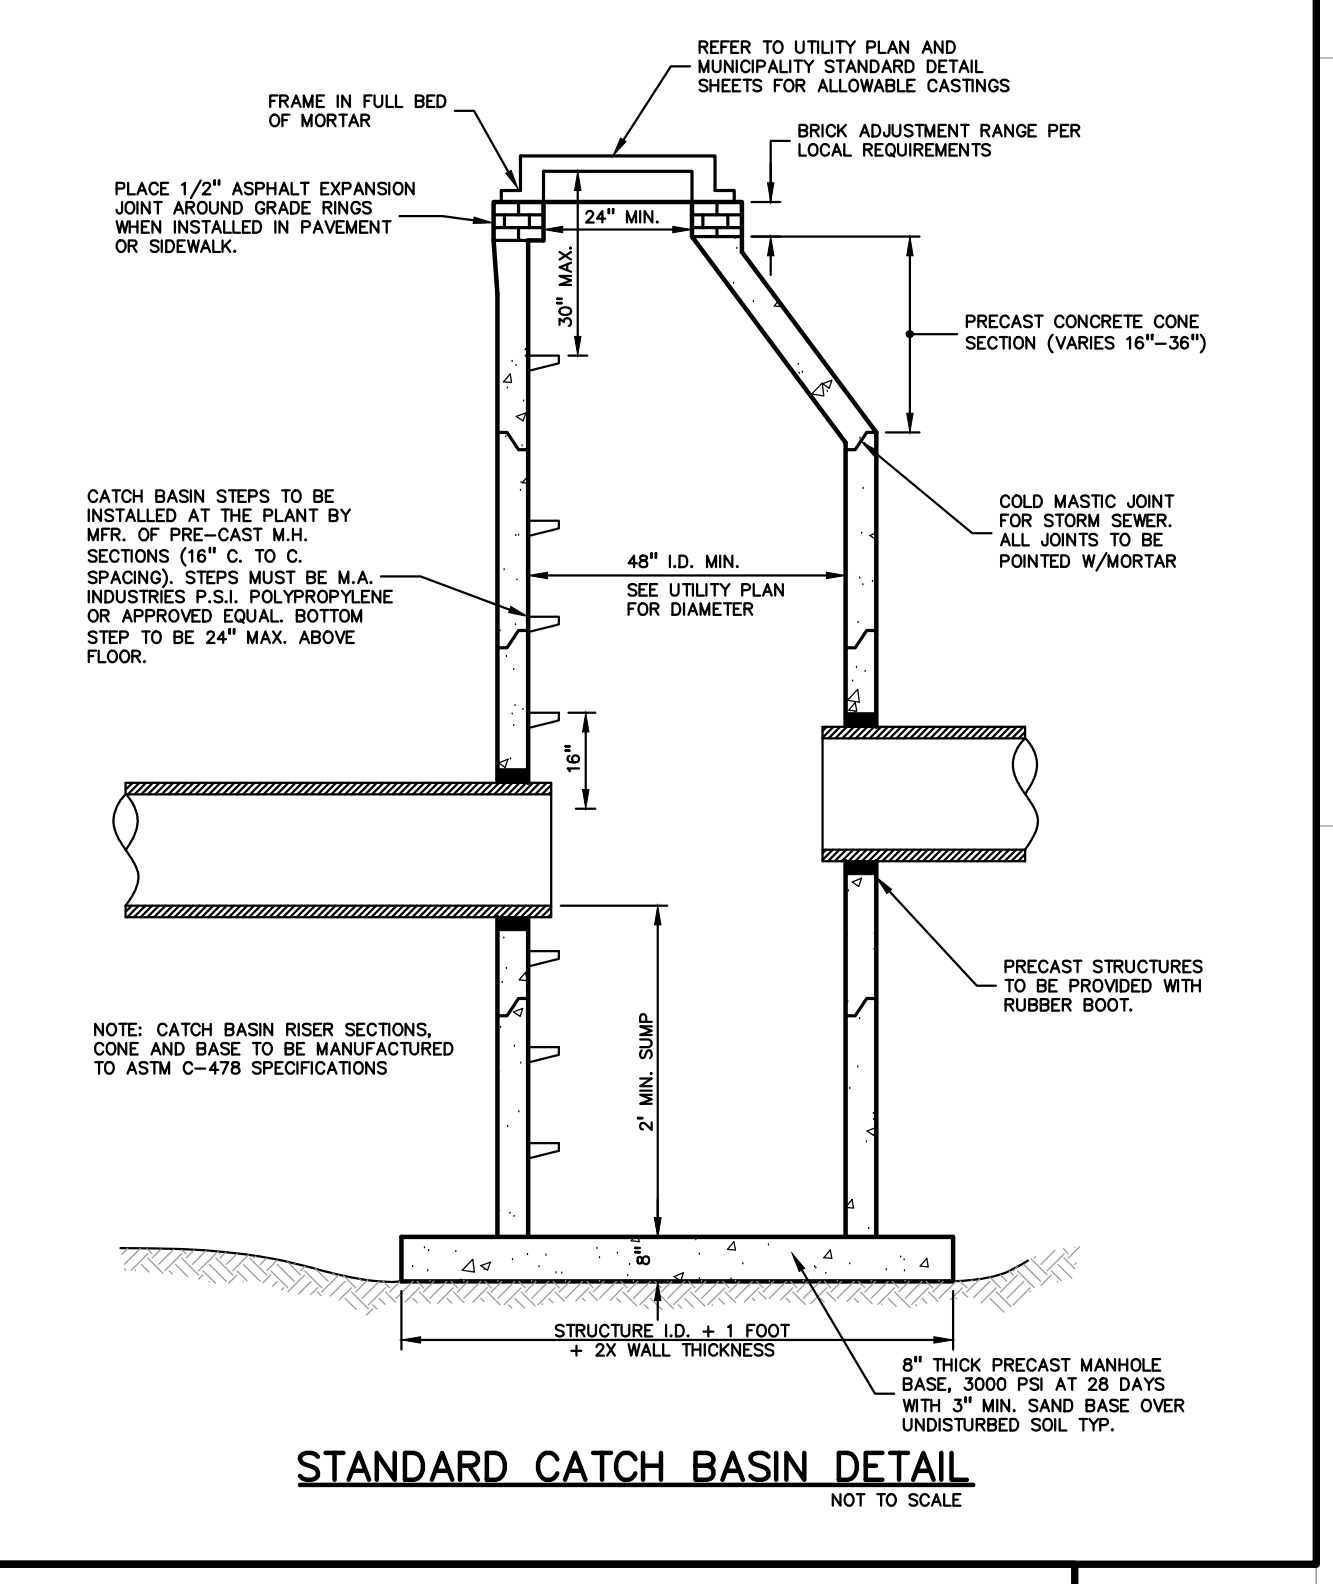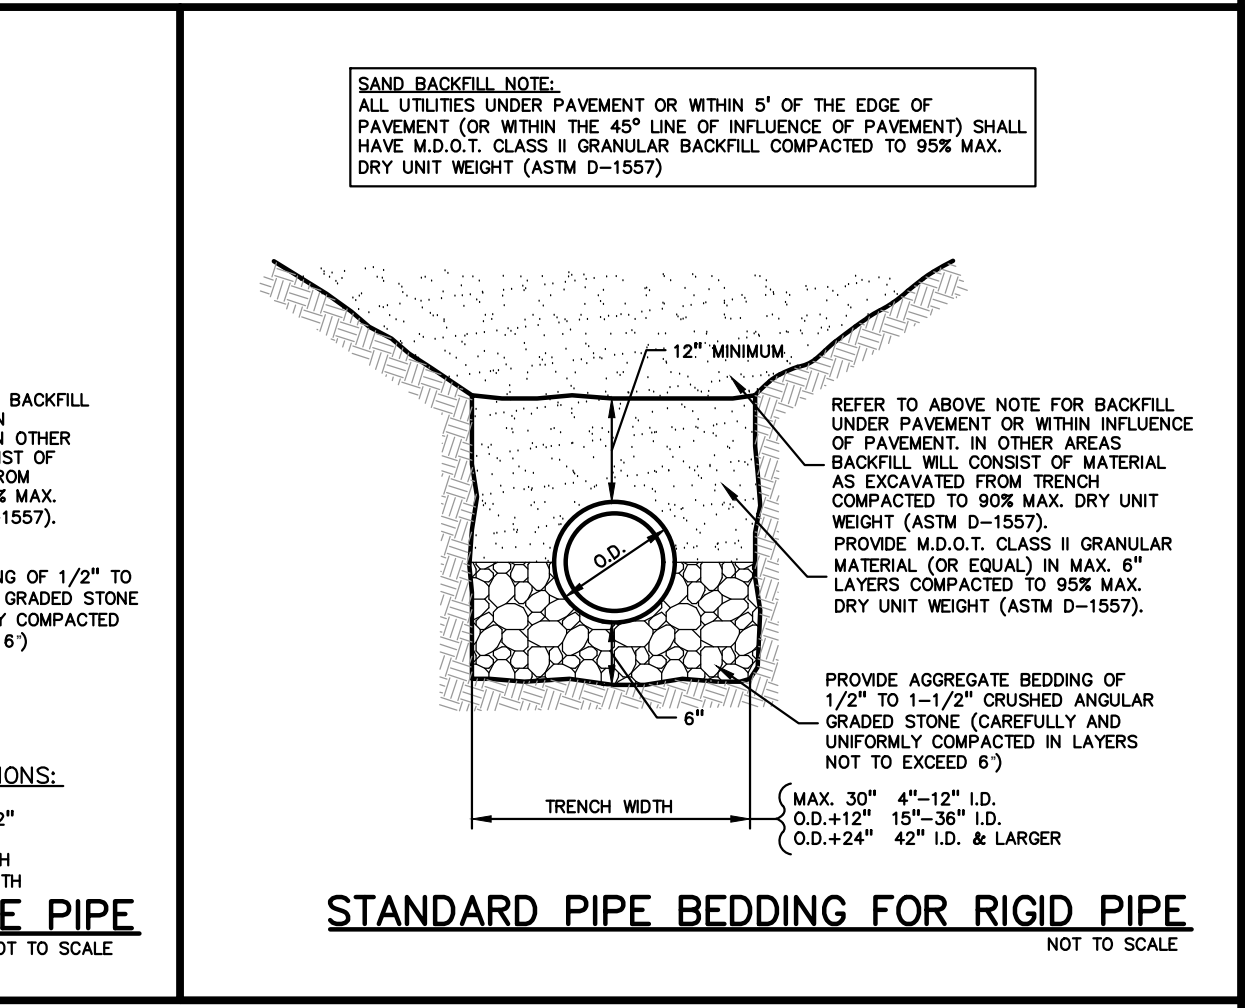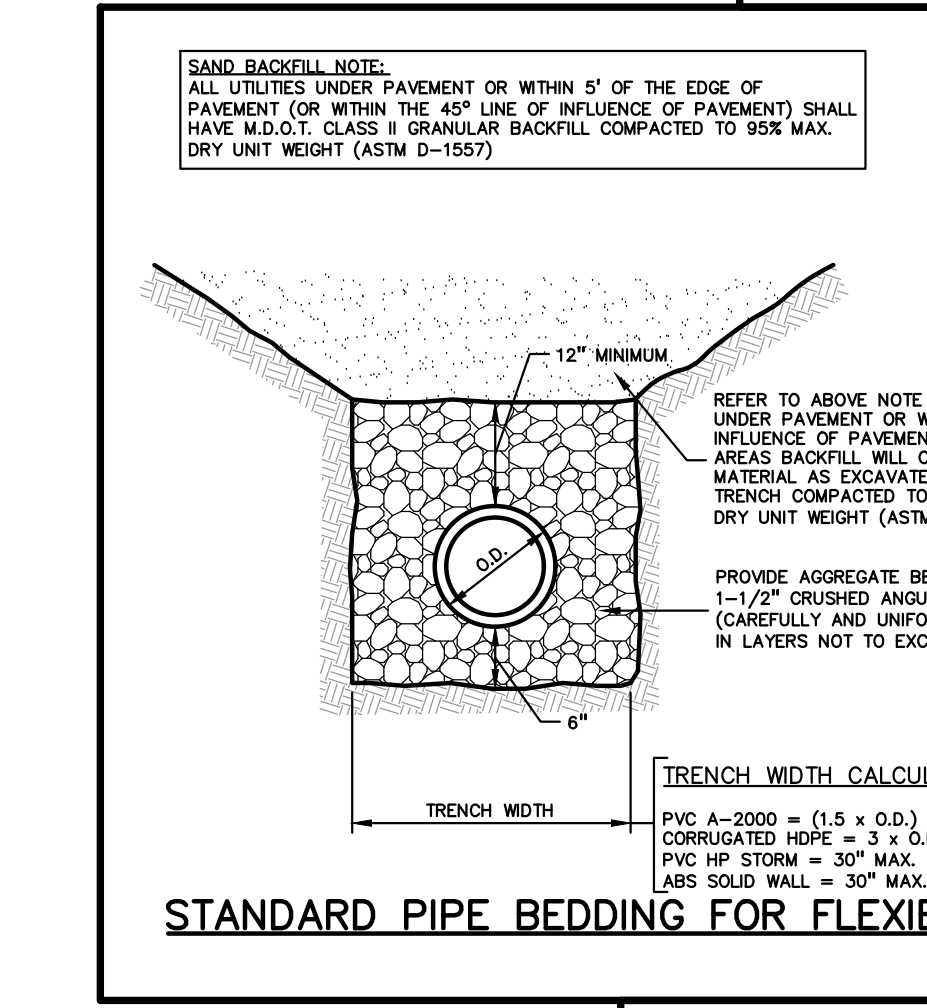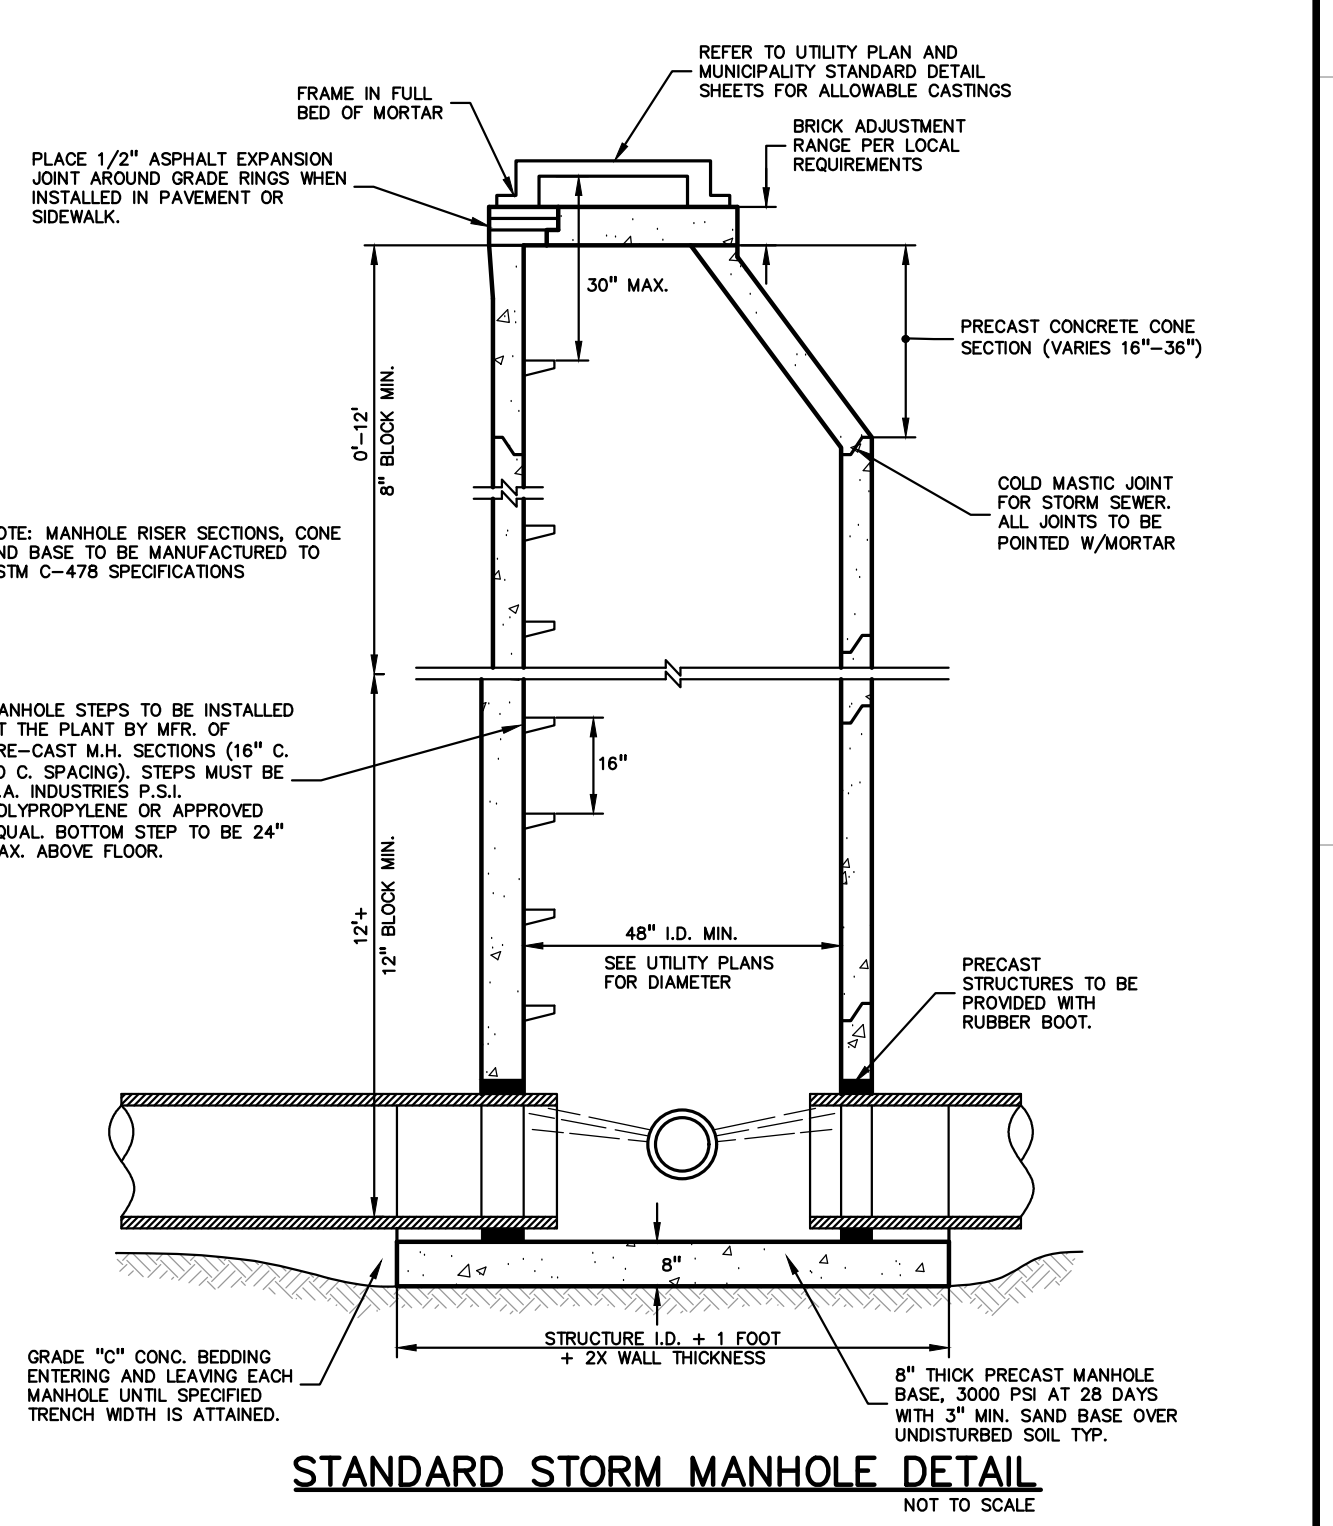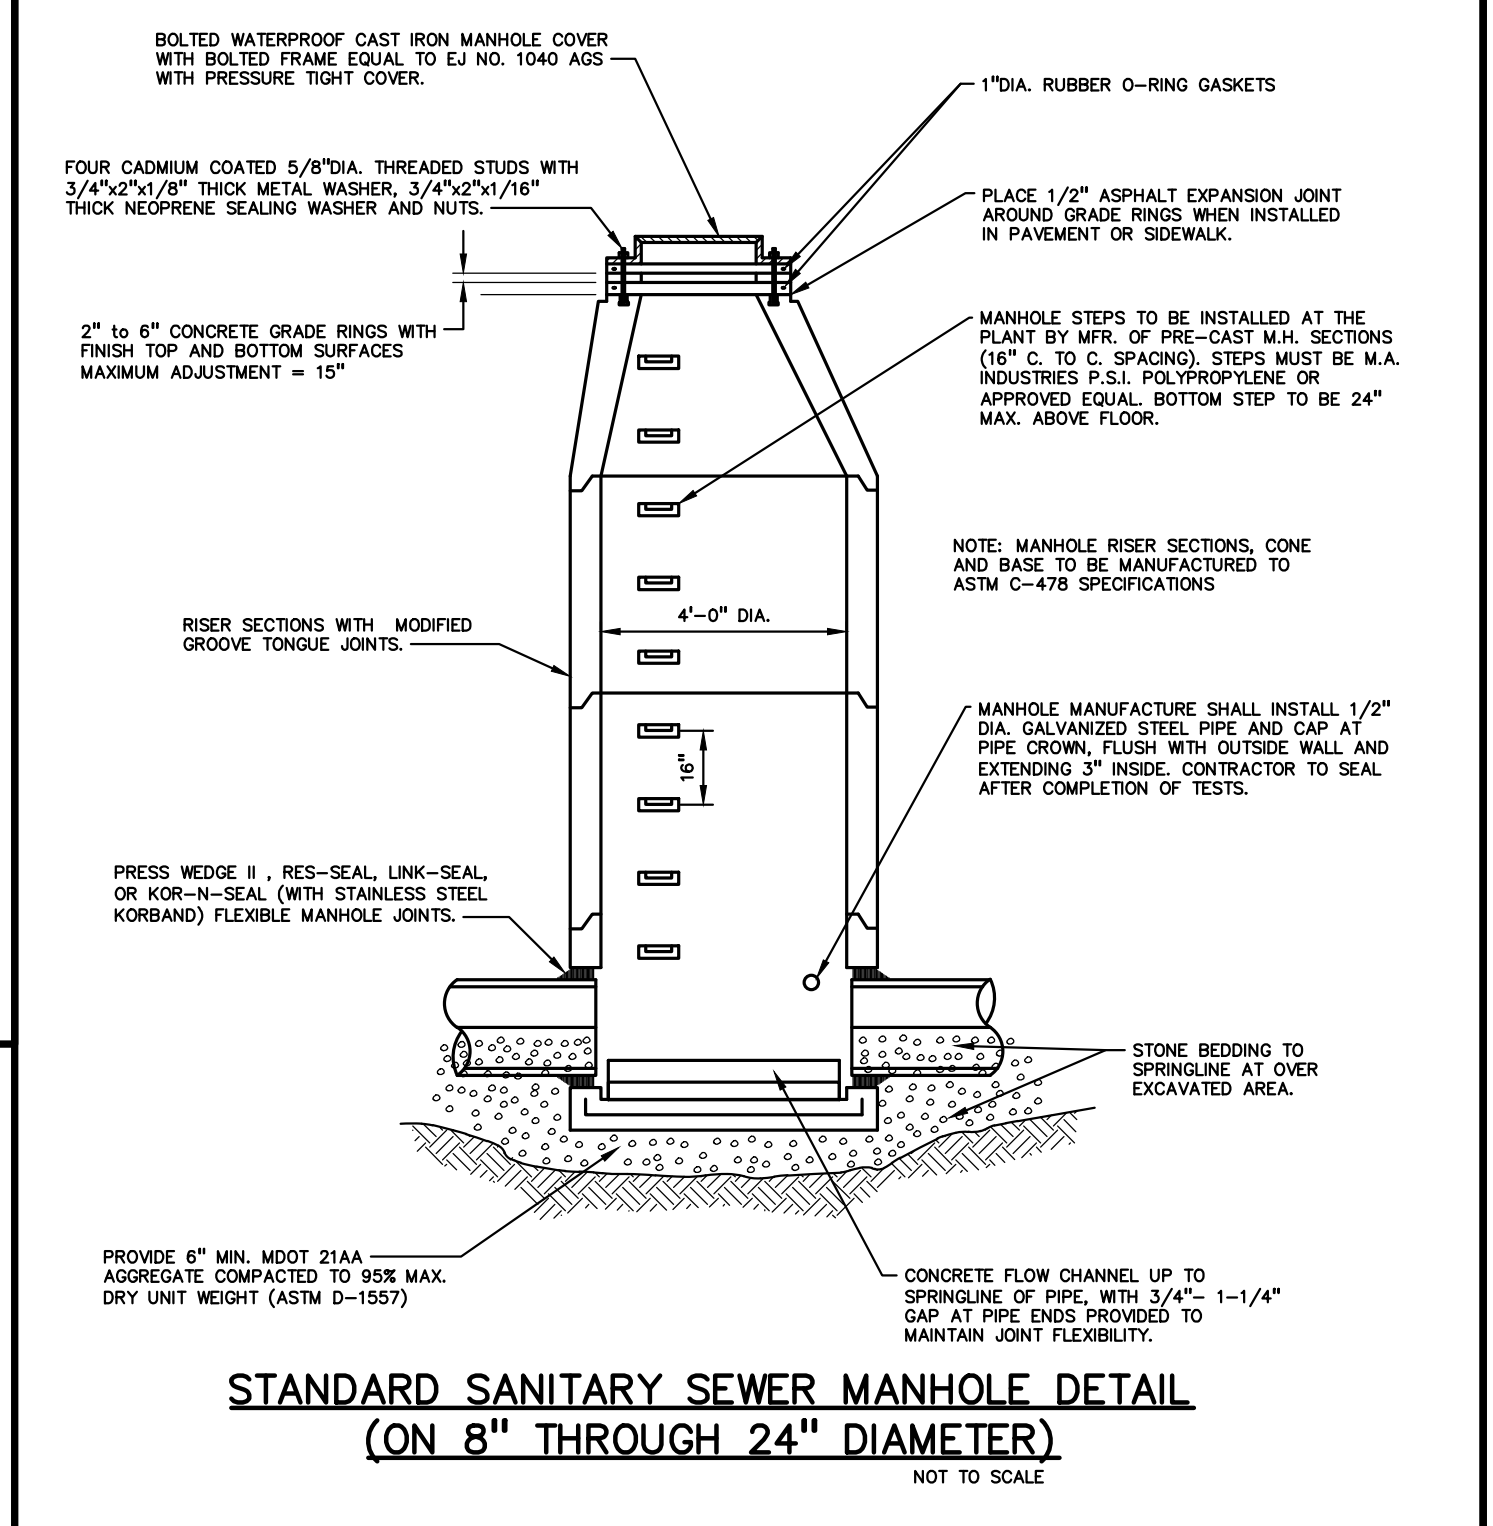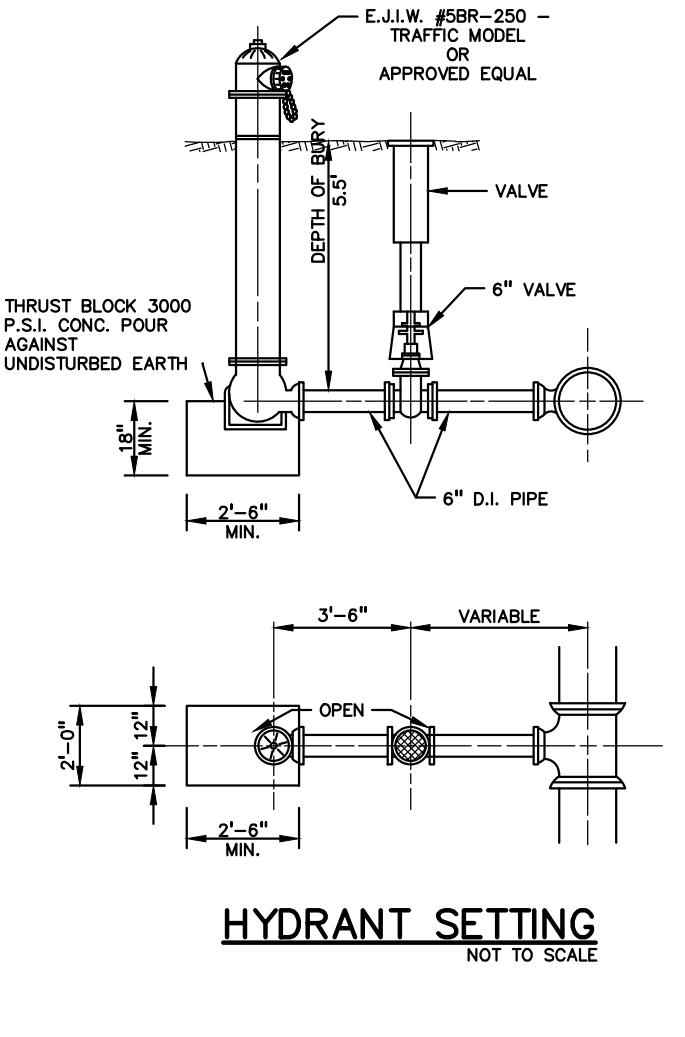

HEADWALL	PIPE DIAMETER	INVERT ELEV.	CENTER OF PIPE ELEV.	BOTTOM OF WALL ELEV.	TOP OF WALL ELEV.	TOP OF WING WALL ELEV.	FINISH GRADE AT WING WALL ELEV.
110	36	732.00	733.50	729.50	736.00	734.50	733.50
112	36	734.59	736.09	732.09	738.59	737.09	736.09
113	30	737.90	739.15	735.40	741.40	739.90	739.90
114	30	737.90	739.15	735.40	741.40	739.90	739.90
115	30	736.69	737.94	734.19	740.19	738.69	737.69
116	30	736.69	737.94	734.19	740.19	738.69	737.69

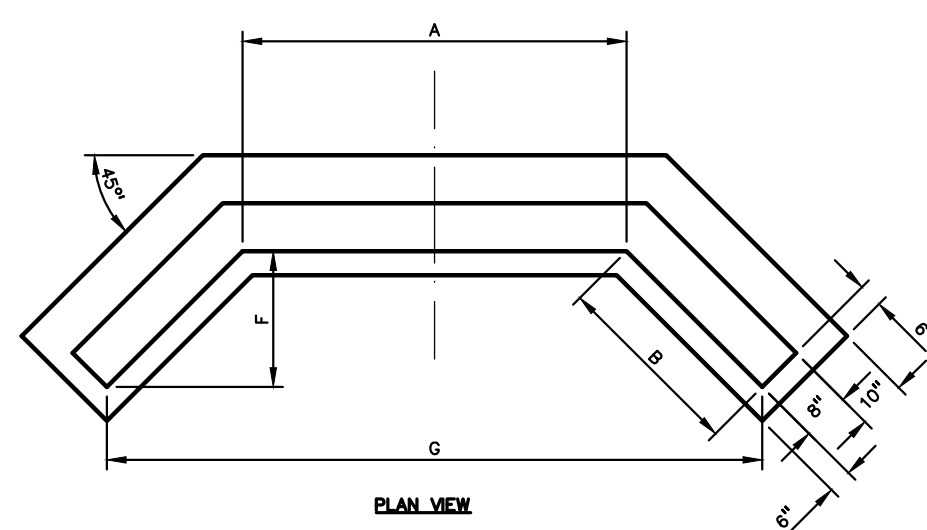

PIPE DIAM.	A	B	C	D	E	F	G
12	36	30	54	40	36	22	78
15	48	30	60	45	37.5	22	92
18	48	30	60	45	39	22	92
24	60	36	64	48	42	26	112
30	72	36	72	54	45	26	124
36	78	48	78	60	48	35	144
48	84	48	90	66	54	35	150

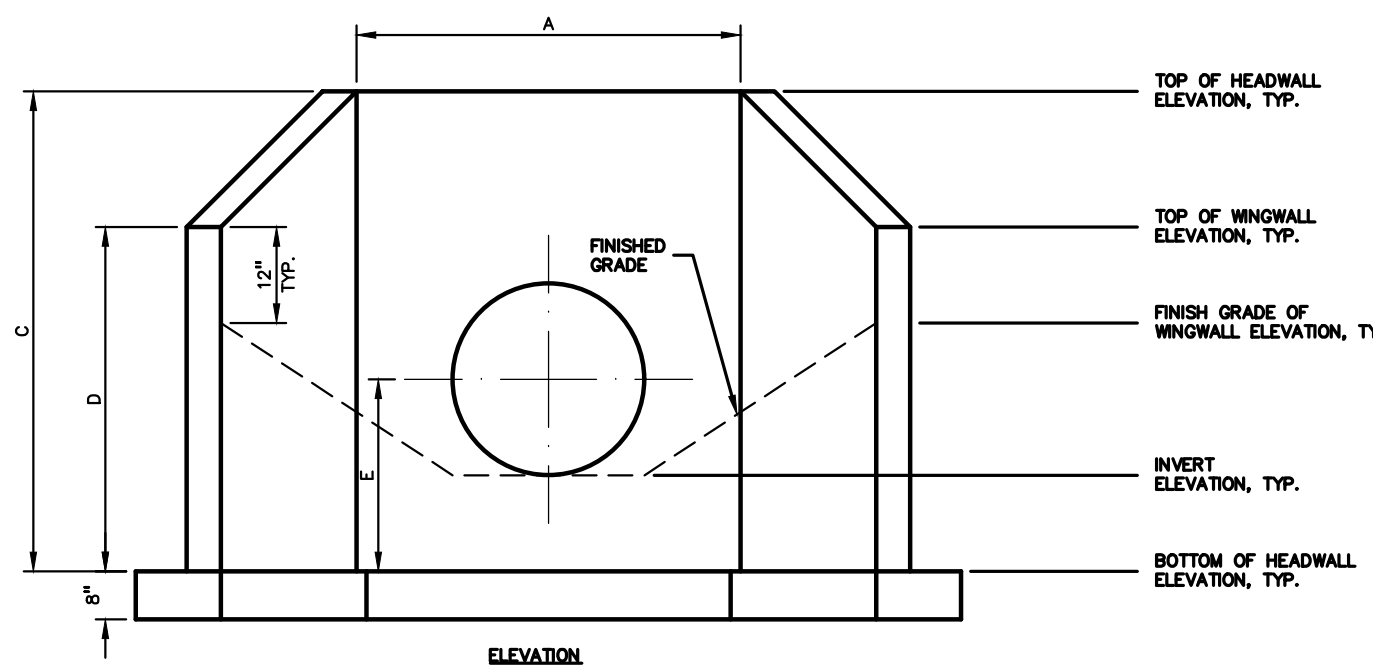

WINGWALL WITH FOOTING
NOT TO SCALE

- NOTES:
1. ALL EXPOSED EDGES TO HAVE 1" BEVELED CORNERS.
 2. JOIN BY CONTRACTOR IN FIELD.
 3. REINFORCING: #4 BARS AT 12" O.C.E.
 4. CONCRETE: 4,000 PSI AT 28 DAYS.

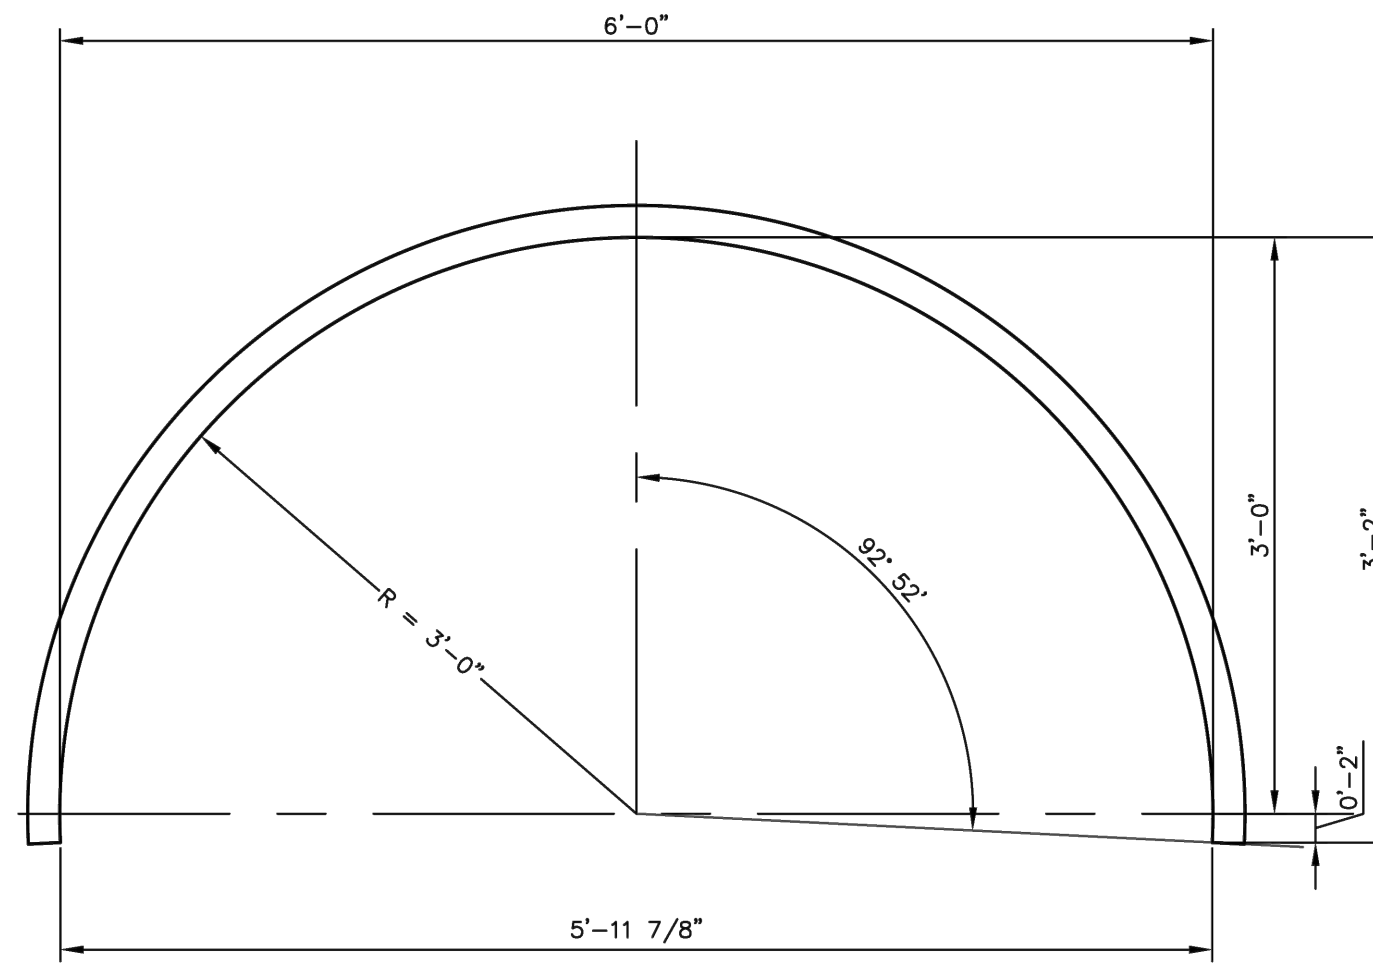


PLATE MAKE-UP: 2 @ 15pl, 1 @ 21pl
AREA = 15.0 SF


ALL DIMENSIONS ARE TO INSIDE CORRUGATION CREST, UNLESS OTHERWISE NOTED.
ALL DIMENSIONS ARE SUBJECT TO MANUFACTURING TOLERANCES.

CONTECH ID# 0000


CONTECH CONSTRUCTION PRODUCTS INC. 6'-0" SPAN X 3'-2" RISE
DWG # 10093618
R/S RATIO = .53

1 of 1


Steel and Aluminum
Structural Plate
Design Guide

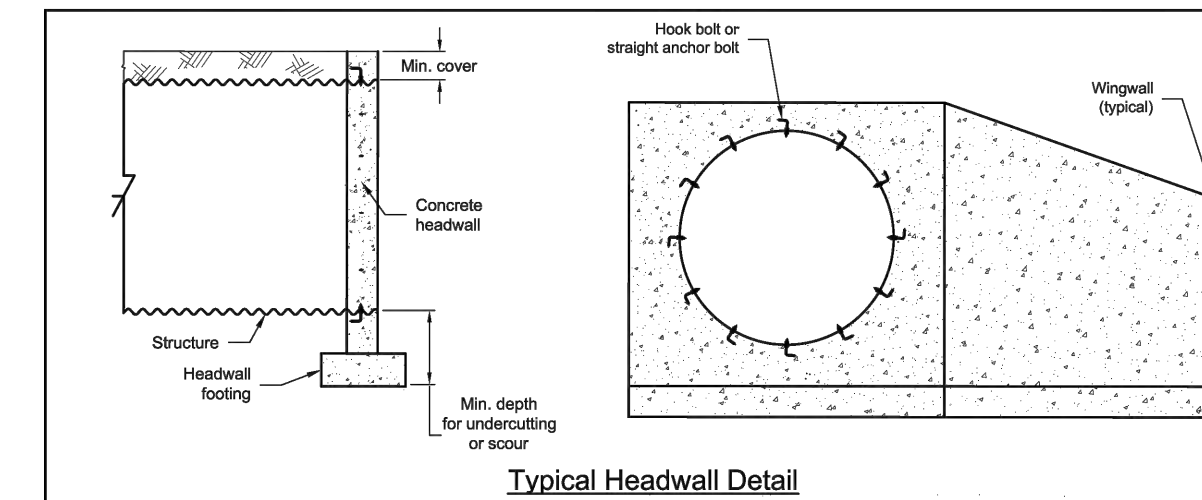


Typical Headwall Detail

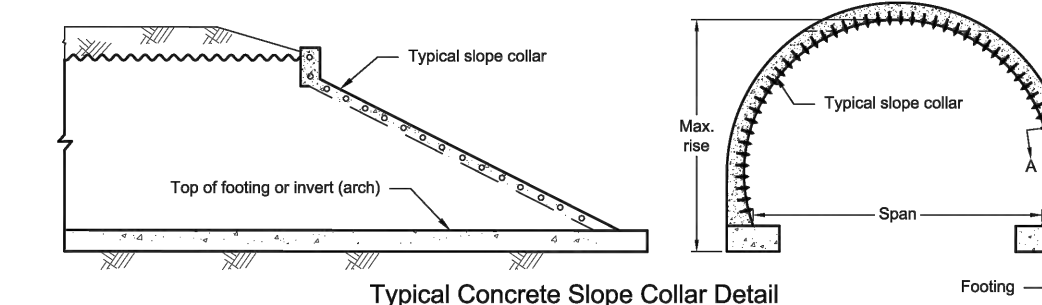

Typical Concrete Slope Collar Detail

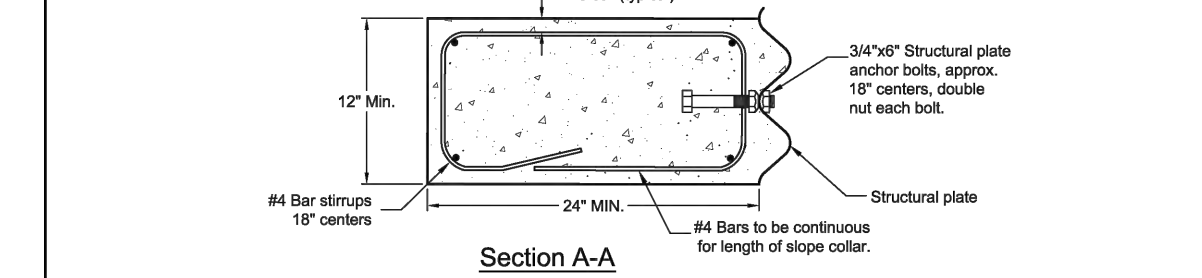


Section A-A

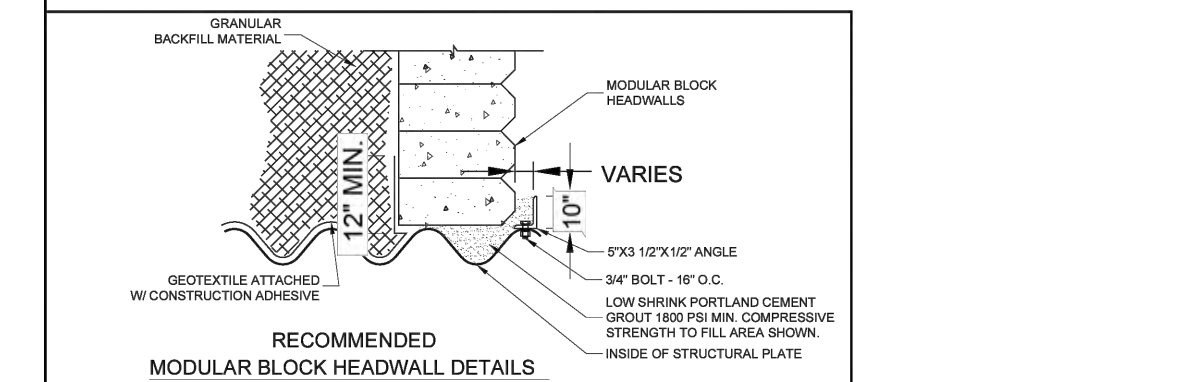


RECOMMENDED MODULAR BLOCK HEADWALL DETAILS

STRUCTURAL PLATE END TREATMENT HEADWALLS AND SLOPE COLLARS

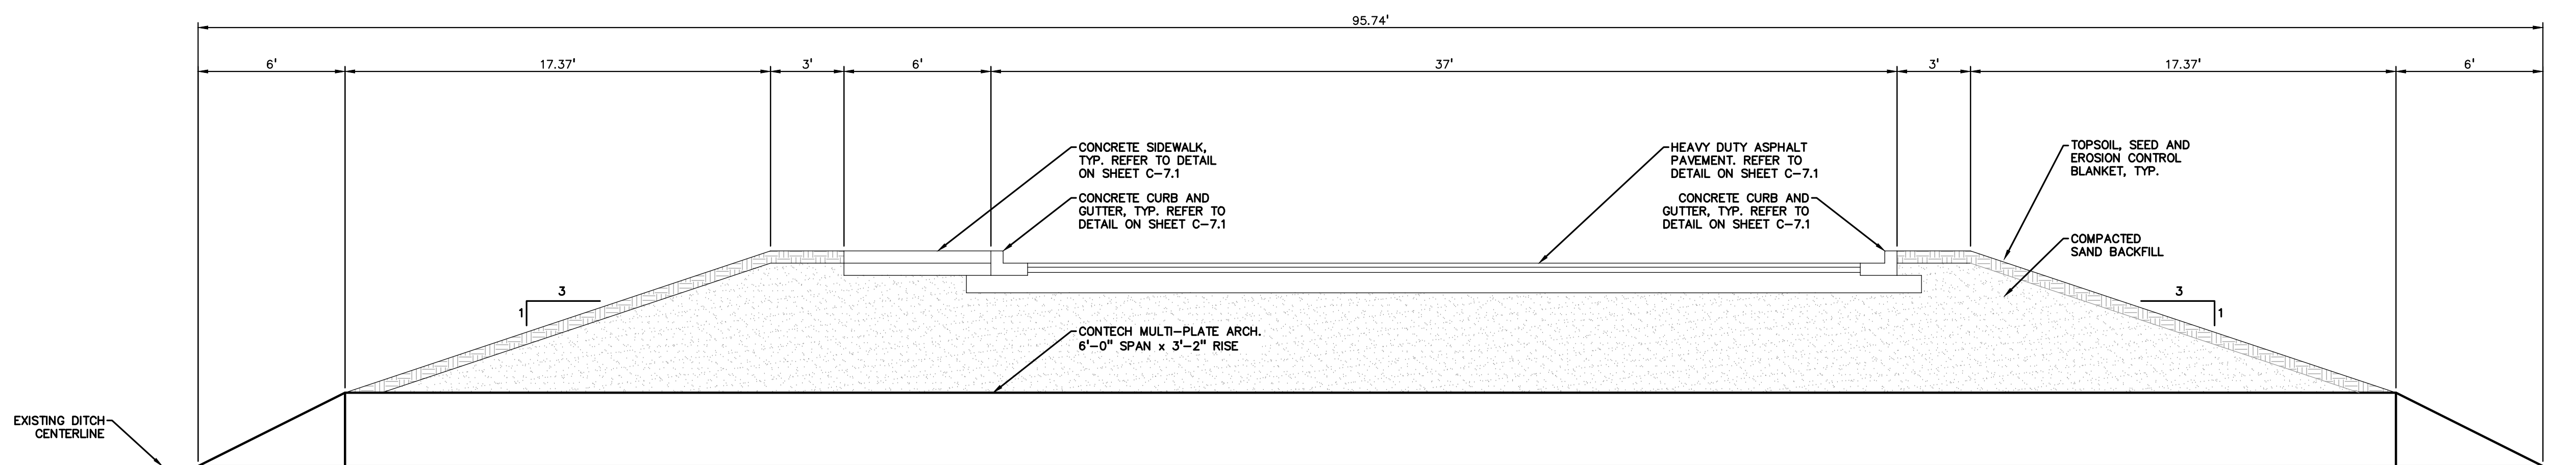

NORTH ENTRY DRIVE CULVERT SECTION
SCALE: 1/4" = 1'

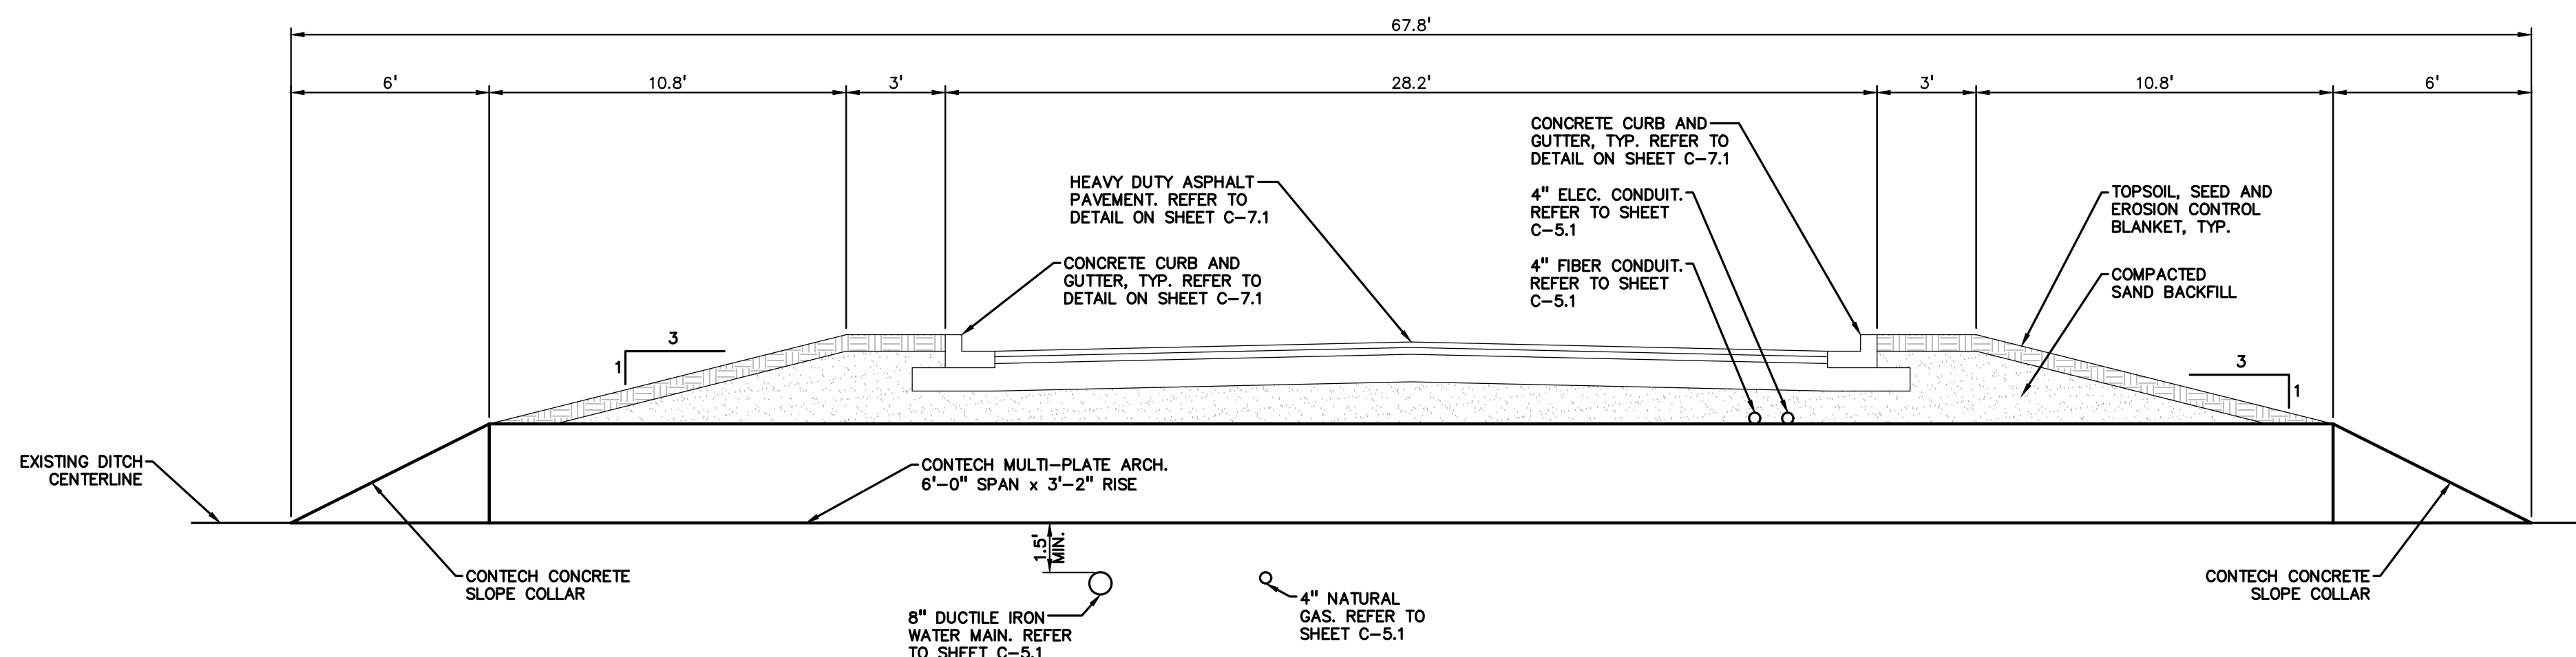

SOUTH ENTRY DRIVE CULVERT SECTION
SCALE: 1/4" = 1'



TMP ARCHITECTURE INC
191 WEST SQUARE LAKE ROAD
BLOOMFIELD HILLS - MICHIGAN - 48302
PH - 248.338.4545 FX - 248.338.0223
EM - INFO@TMP-ARCHITECTURE.COM

REGISTRATION SEAL

CONSULTANT



PROJECT TITLE
**New Smith Middle School
Bid Package No. 03C**

Troy School District
Troy, Michigan

DRAWING TITLE
**CULVERT
DETAILS**

ISSUE DATES

DATE ISSUED FOR:
07-12-2024 ADDENDUM NO. 2
06-18-2024 CONSTRUCTION DOCUMENTS

DRAWN: JMW

CHECKED: TD

APPROVED: TD

PROJECT NO.

22102

DRAWING NO.

C-7.3

REGISTRATION SEAL


CONSULTANT




PROJECT TITLE
New Smith Middle School Bld Package No. 03C

Troy School District
Troy, Michigan


DRAWING TITLE
SITE DETAILS

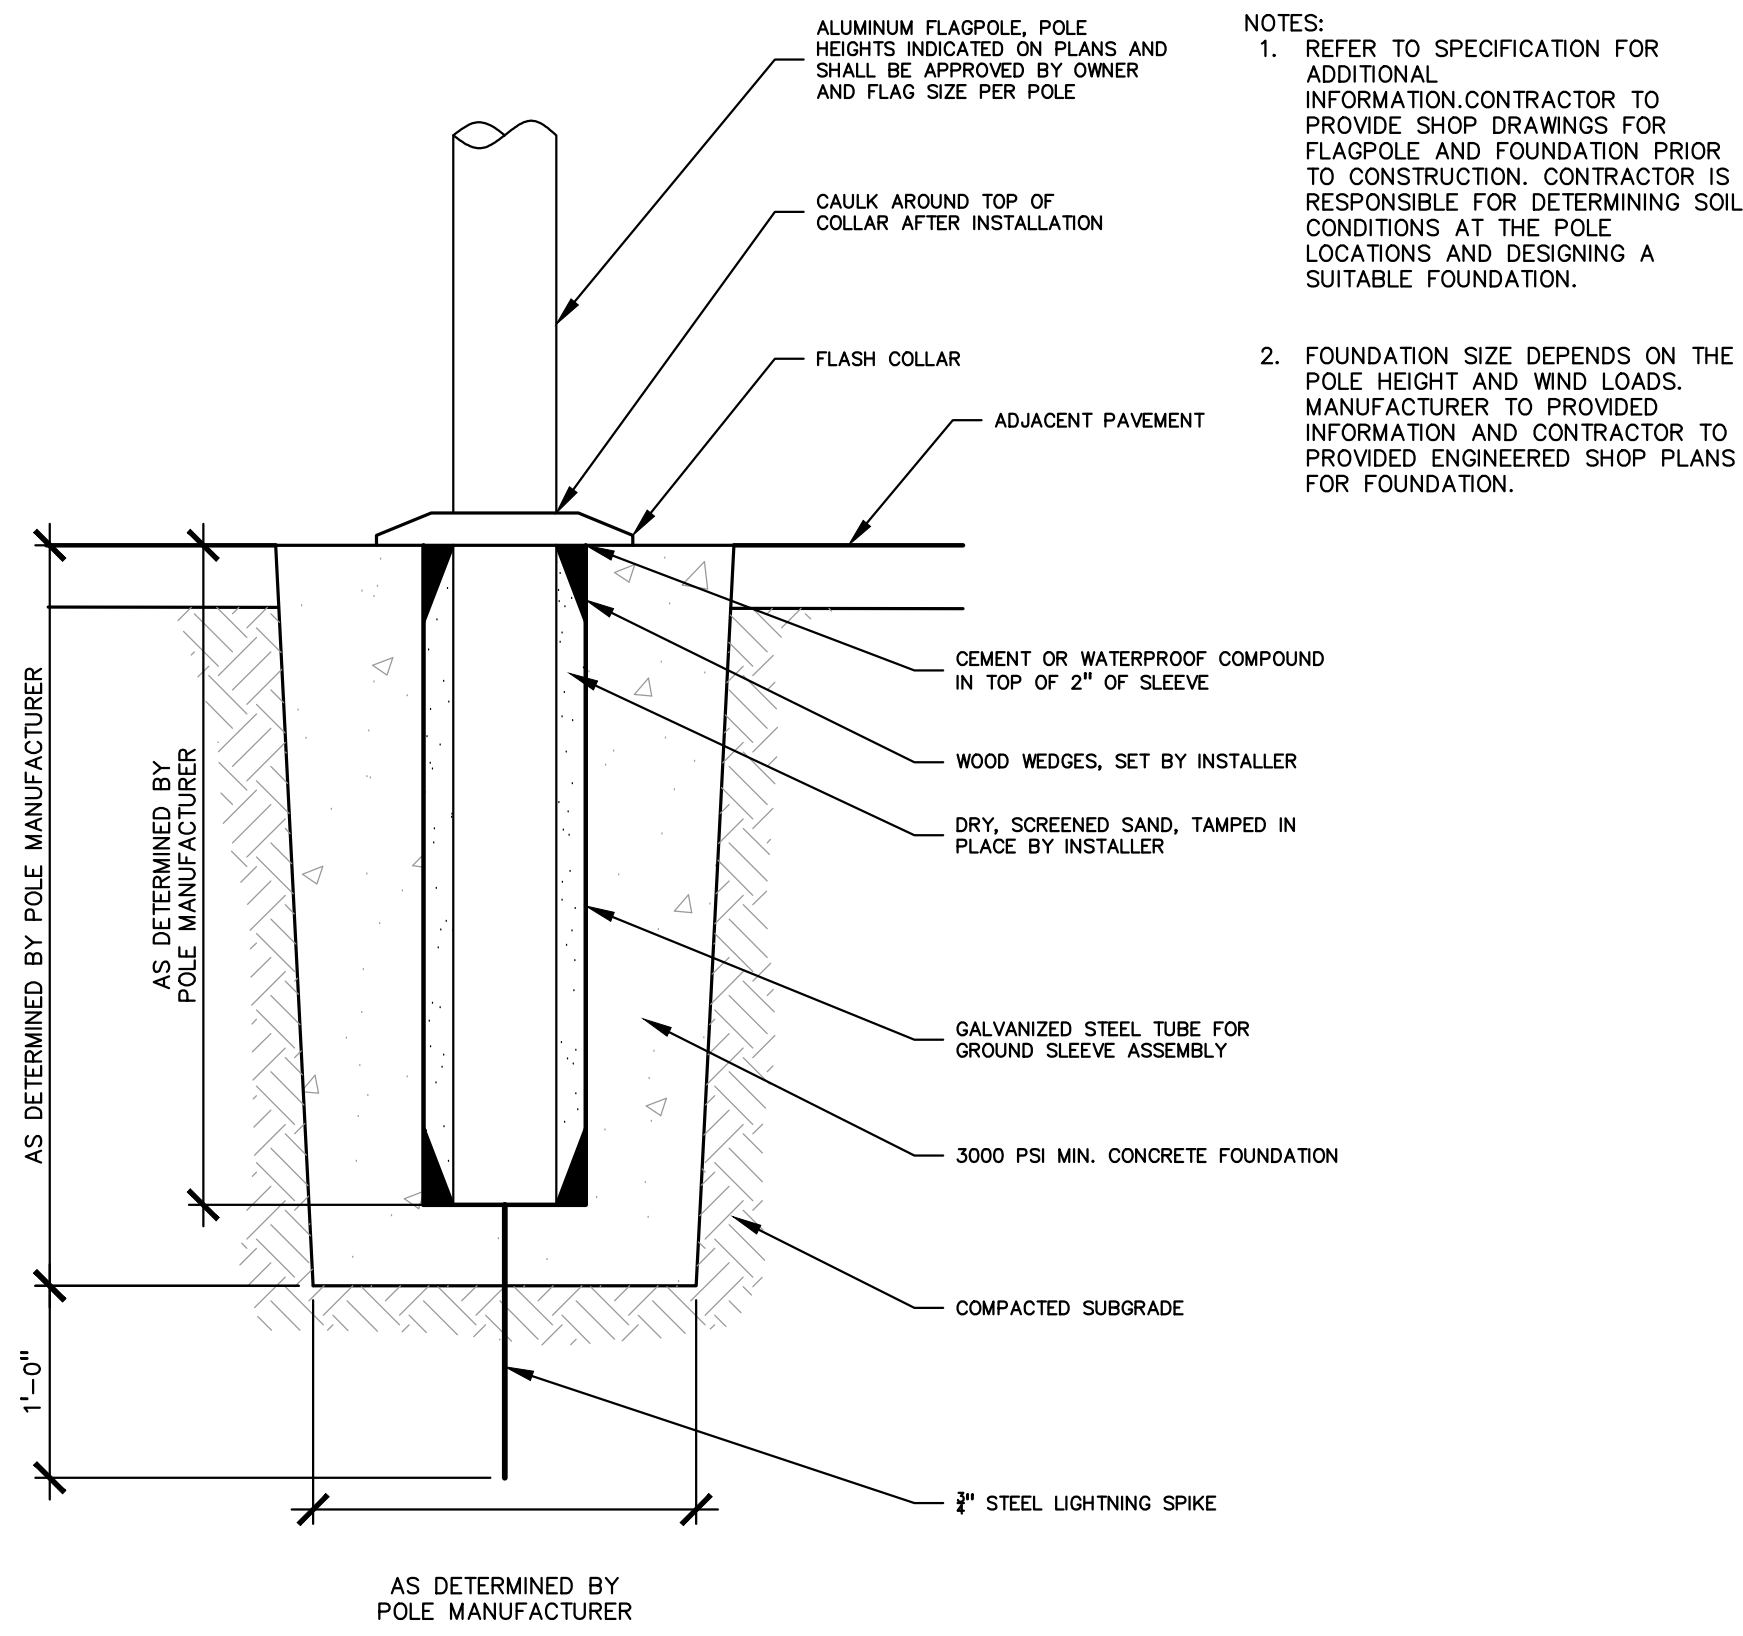


4 FLAGPOLE BASE DETAIL
SCALE: 1 1/2" = 1'-0"

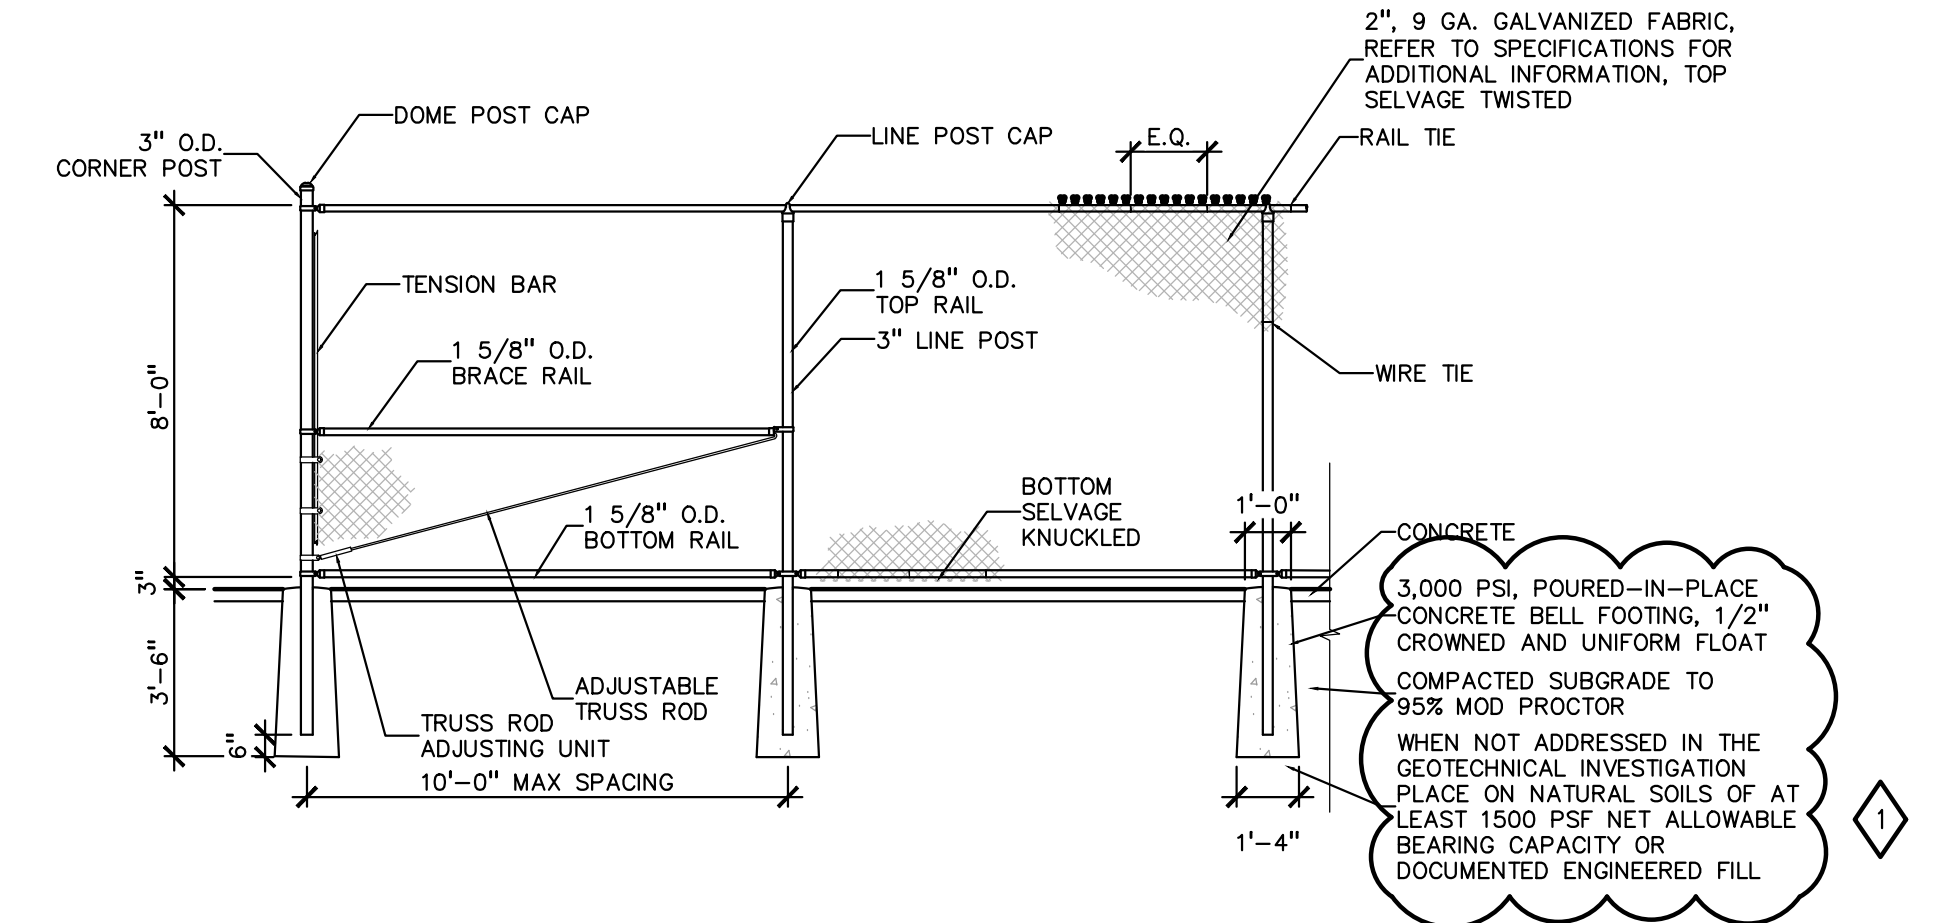


2 8' HT. VINYL COATED CHAIN LINK FENCE DETAIL
SCALE: 1/4" = 1'-0"

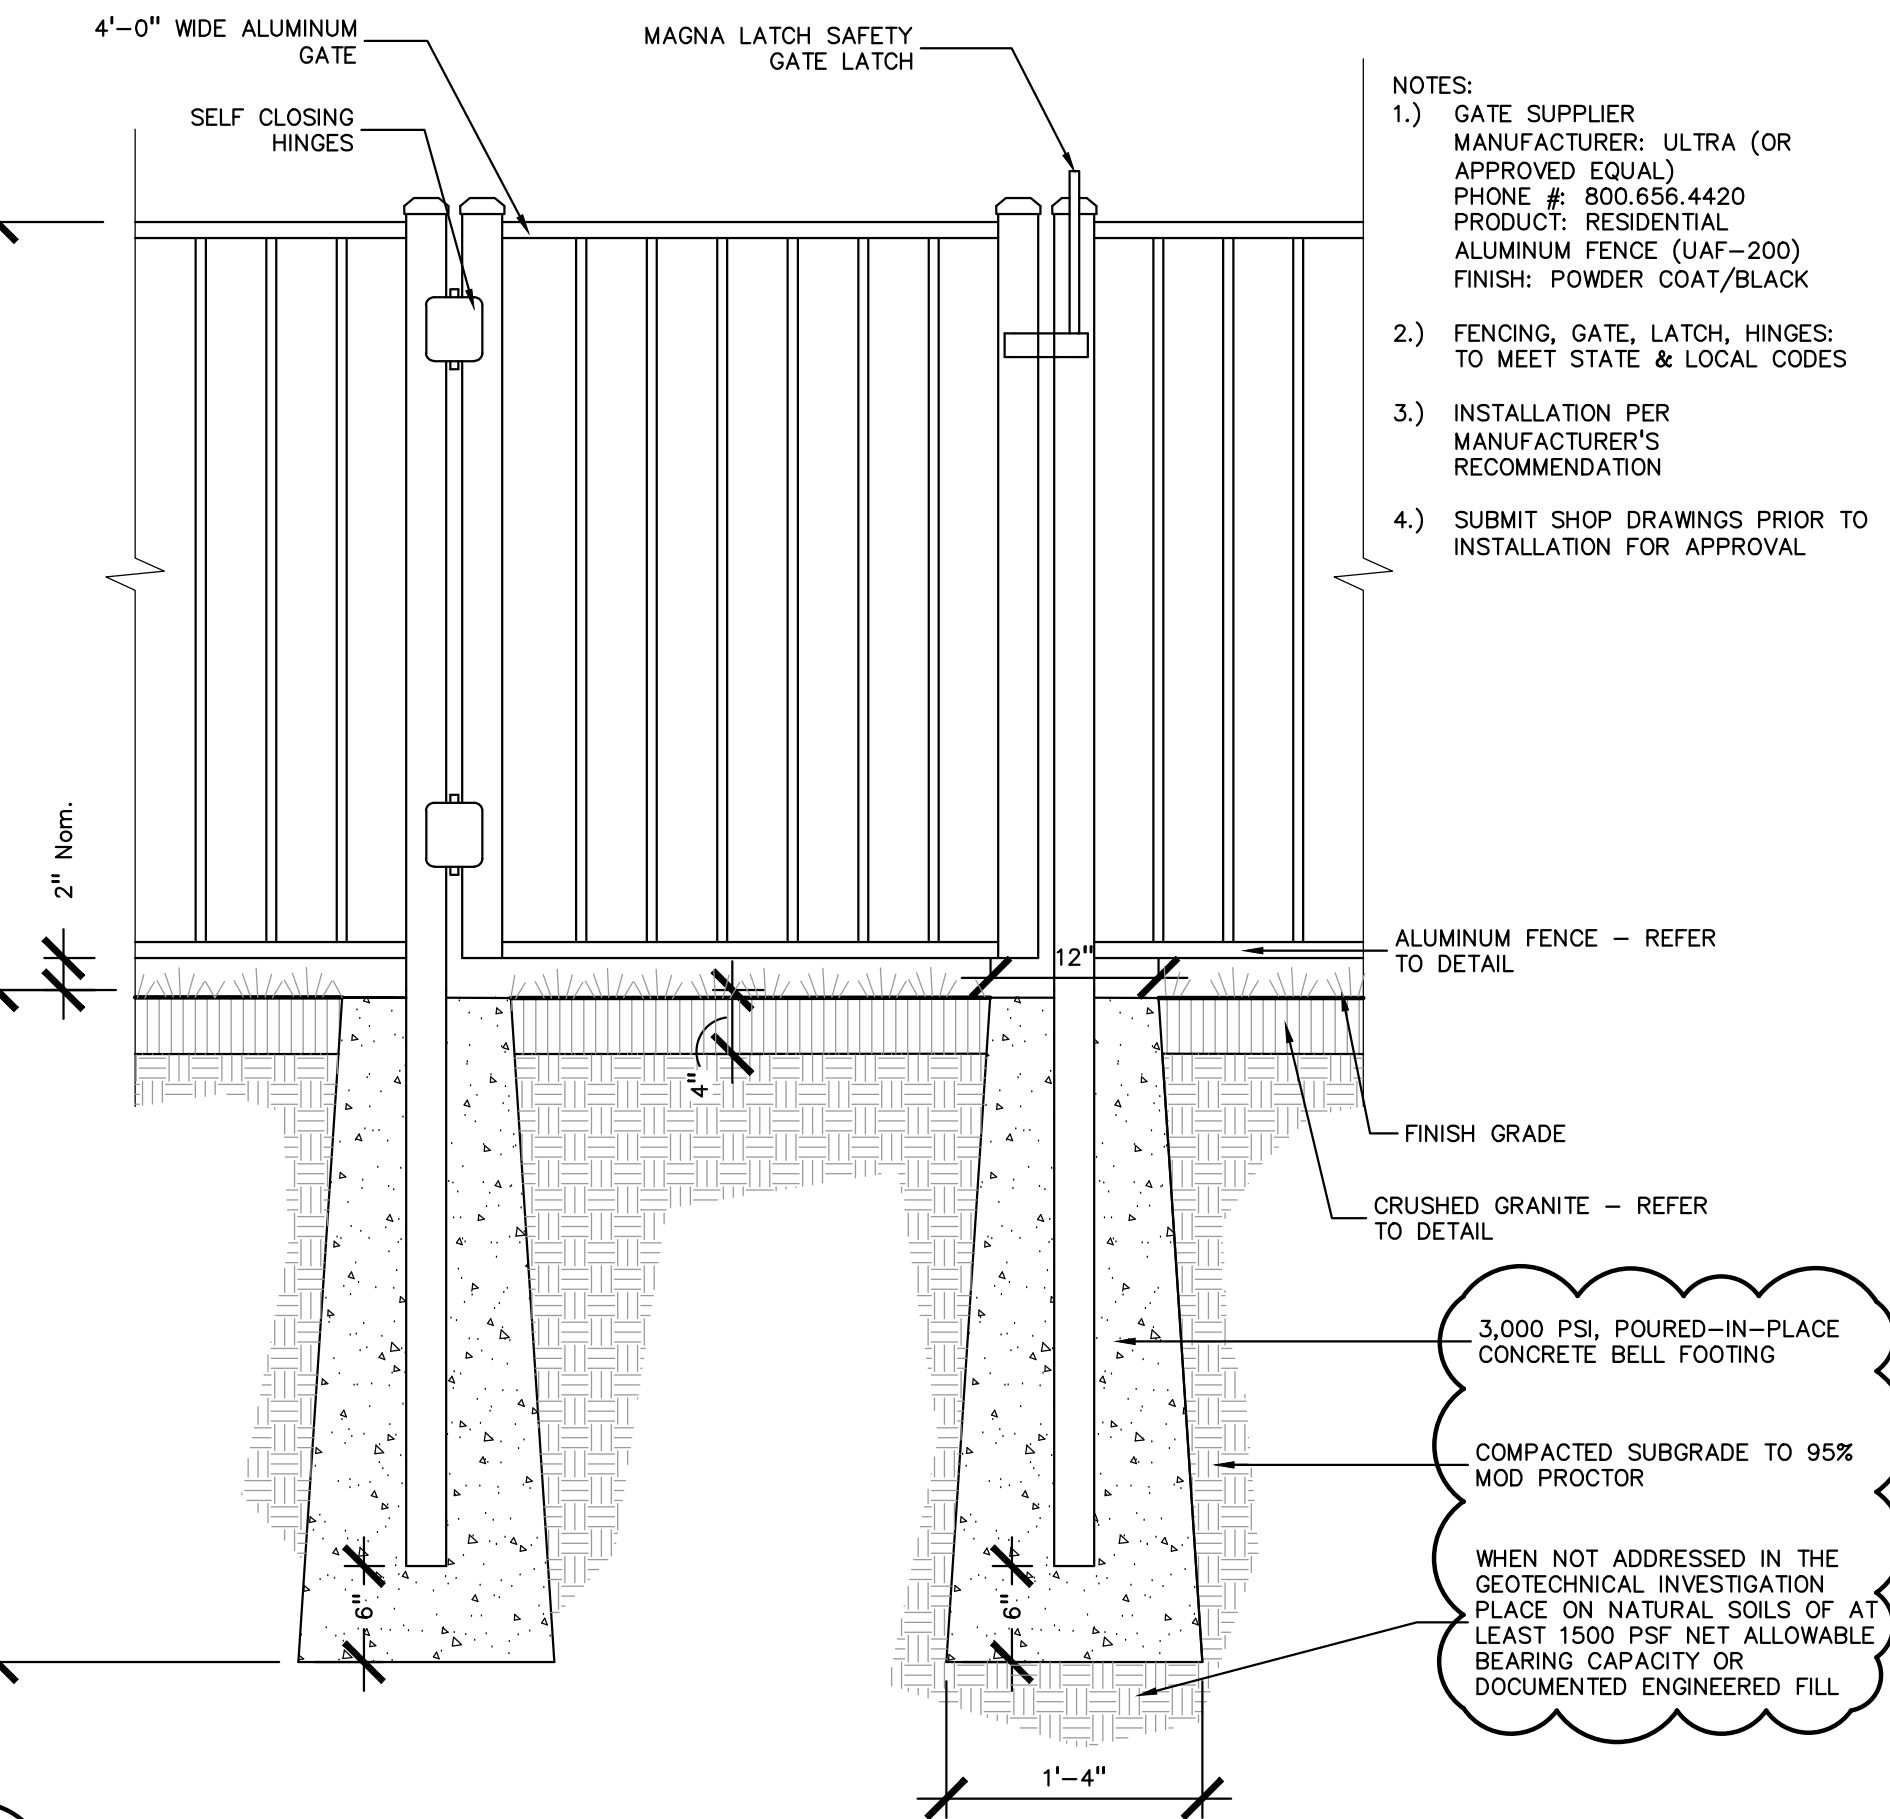

3 ALUMINUM GATE DETAIL
SCALE: 1" = 1'-0"

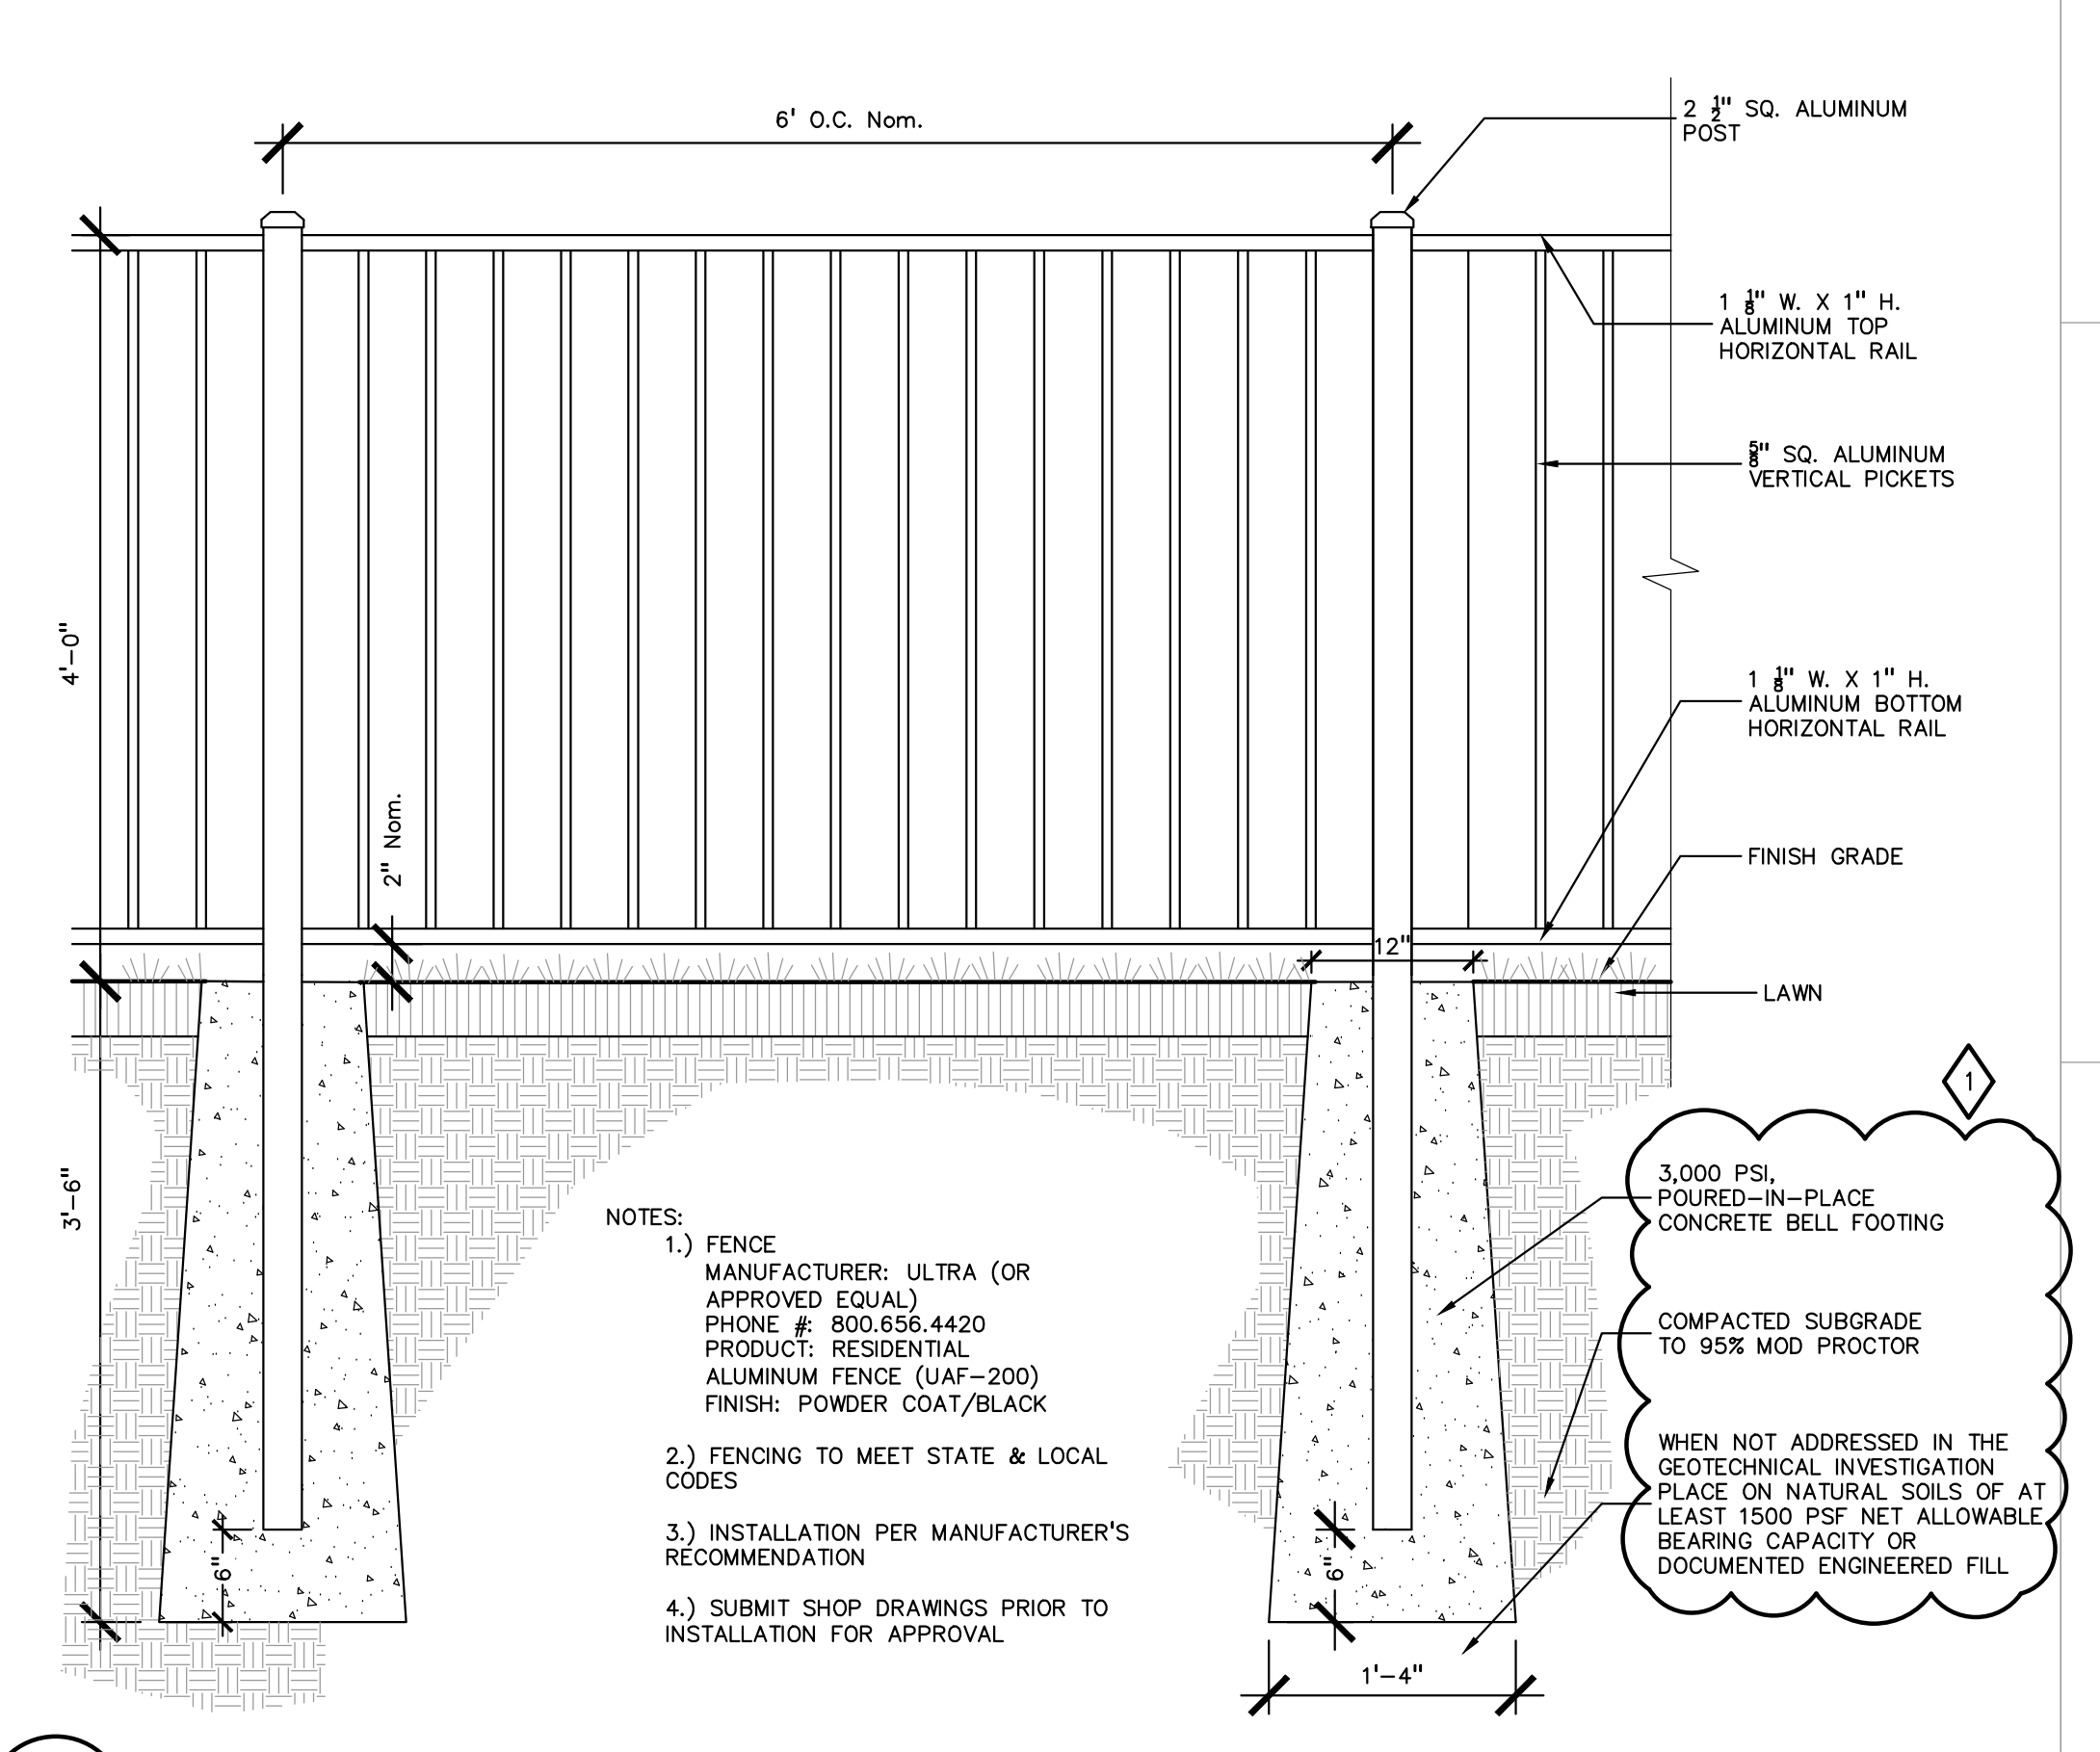

1 ALUMINUM FENCING DETAIL
SCALE: 1" = 1'-0"

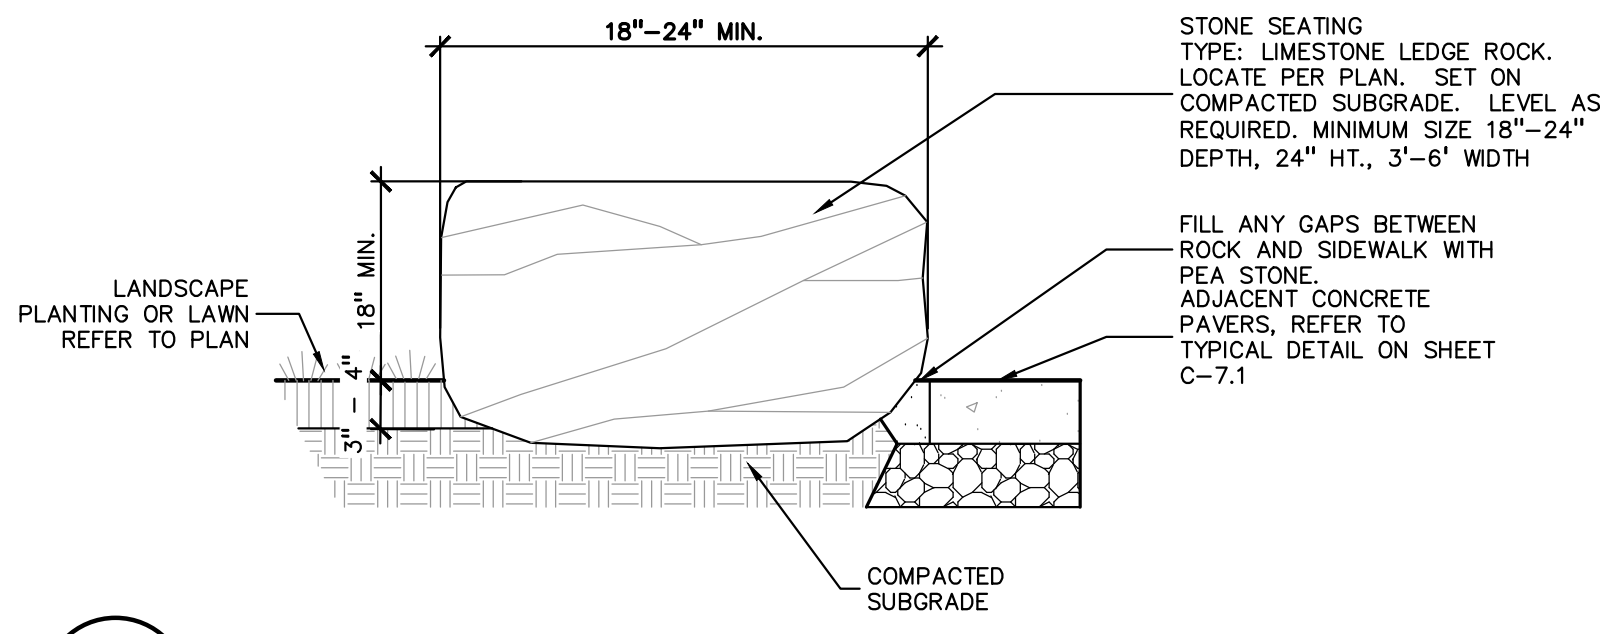

5 LEDGE STONE SEATING DETAIL
SCALE: 1" = 1'-0"

ISSUE DATES

DATE	ISSUED FOR:
07-12-2024	ADDENDUM NO. 2
06-18-2024	CONSTRUCTION DOCUMENTS

DRAWN: JMW
CHECKED: TD
APPROVED: TD

PROJECT NO.
22102
DRAWING NO.
C-7.4

REGISTRATION SEAL


CONSULTANT



PROJECT TITLE
**NEW SMITH
MIDDLE SCHOOL**
Bid Package No. 03B

Troy School District
Troy, Michigan

DRAWING TITLE
Foundation Plan Zone 'B'

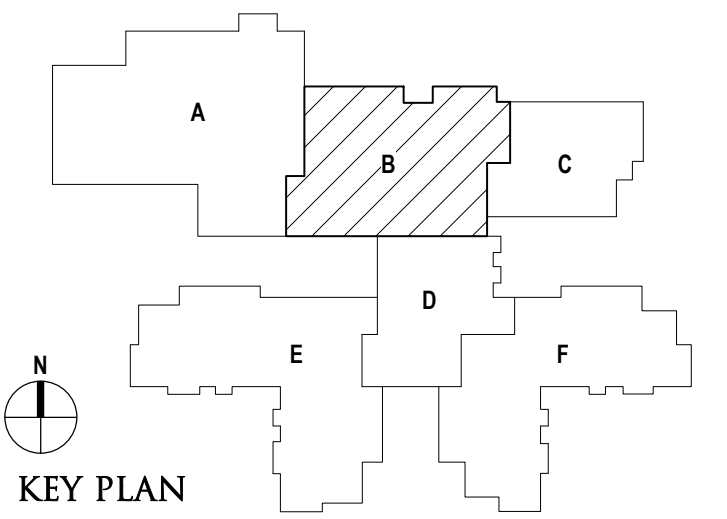

ISSUE DATES


DATE	ISSUED FOR:

07-13-2024	ADDENDUM NO. 2
06-21-2024	BULLETIN NO. 2
06-18-2024	CONSTRUCTION DOCUMENTS
05-30-2024	BULLETIN NO. 1
02-08-2024	ADDENDUM NO. 2
01-23-2024	CONSTRUCTION DOCUMENTS

DRAWN	D. BART
CHECKED	B. KANNERS
APPROVED	E. MANNOR

PROJECT NO.
22102

DRAWING NO.
S1.0B

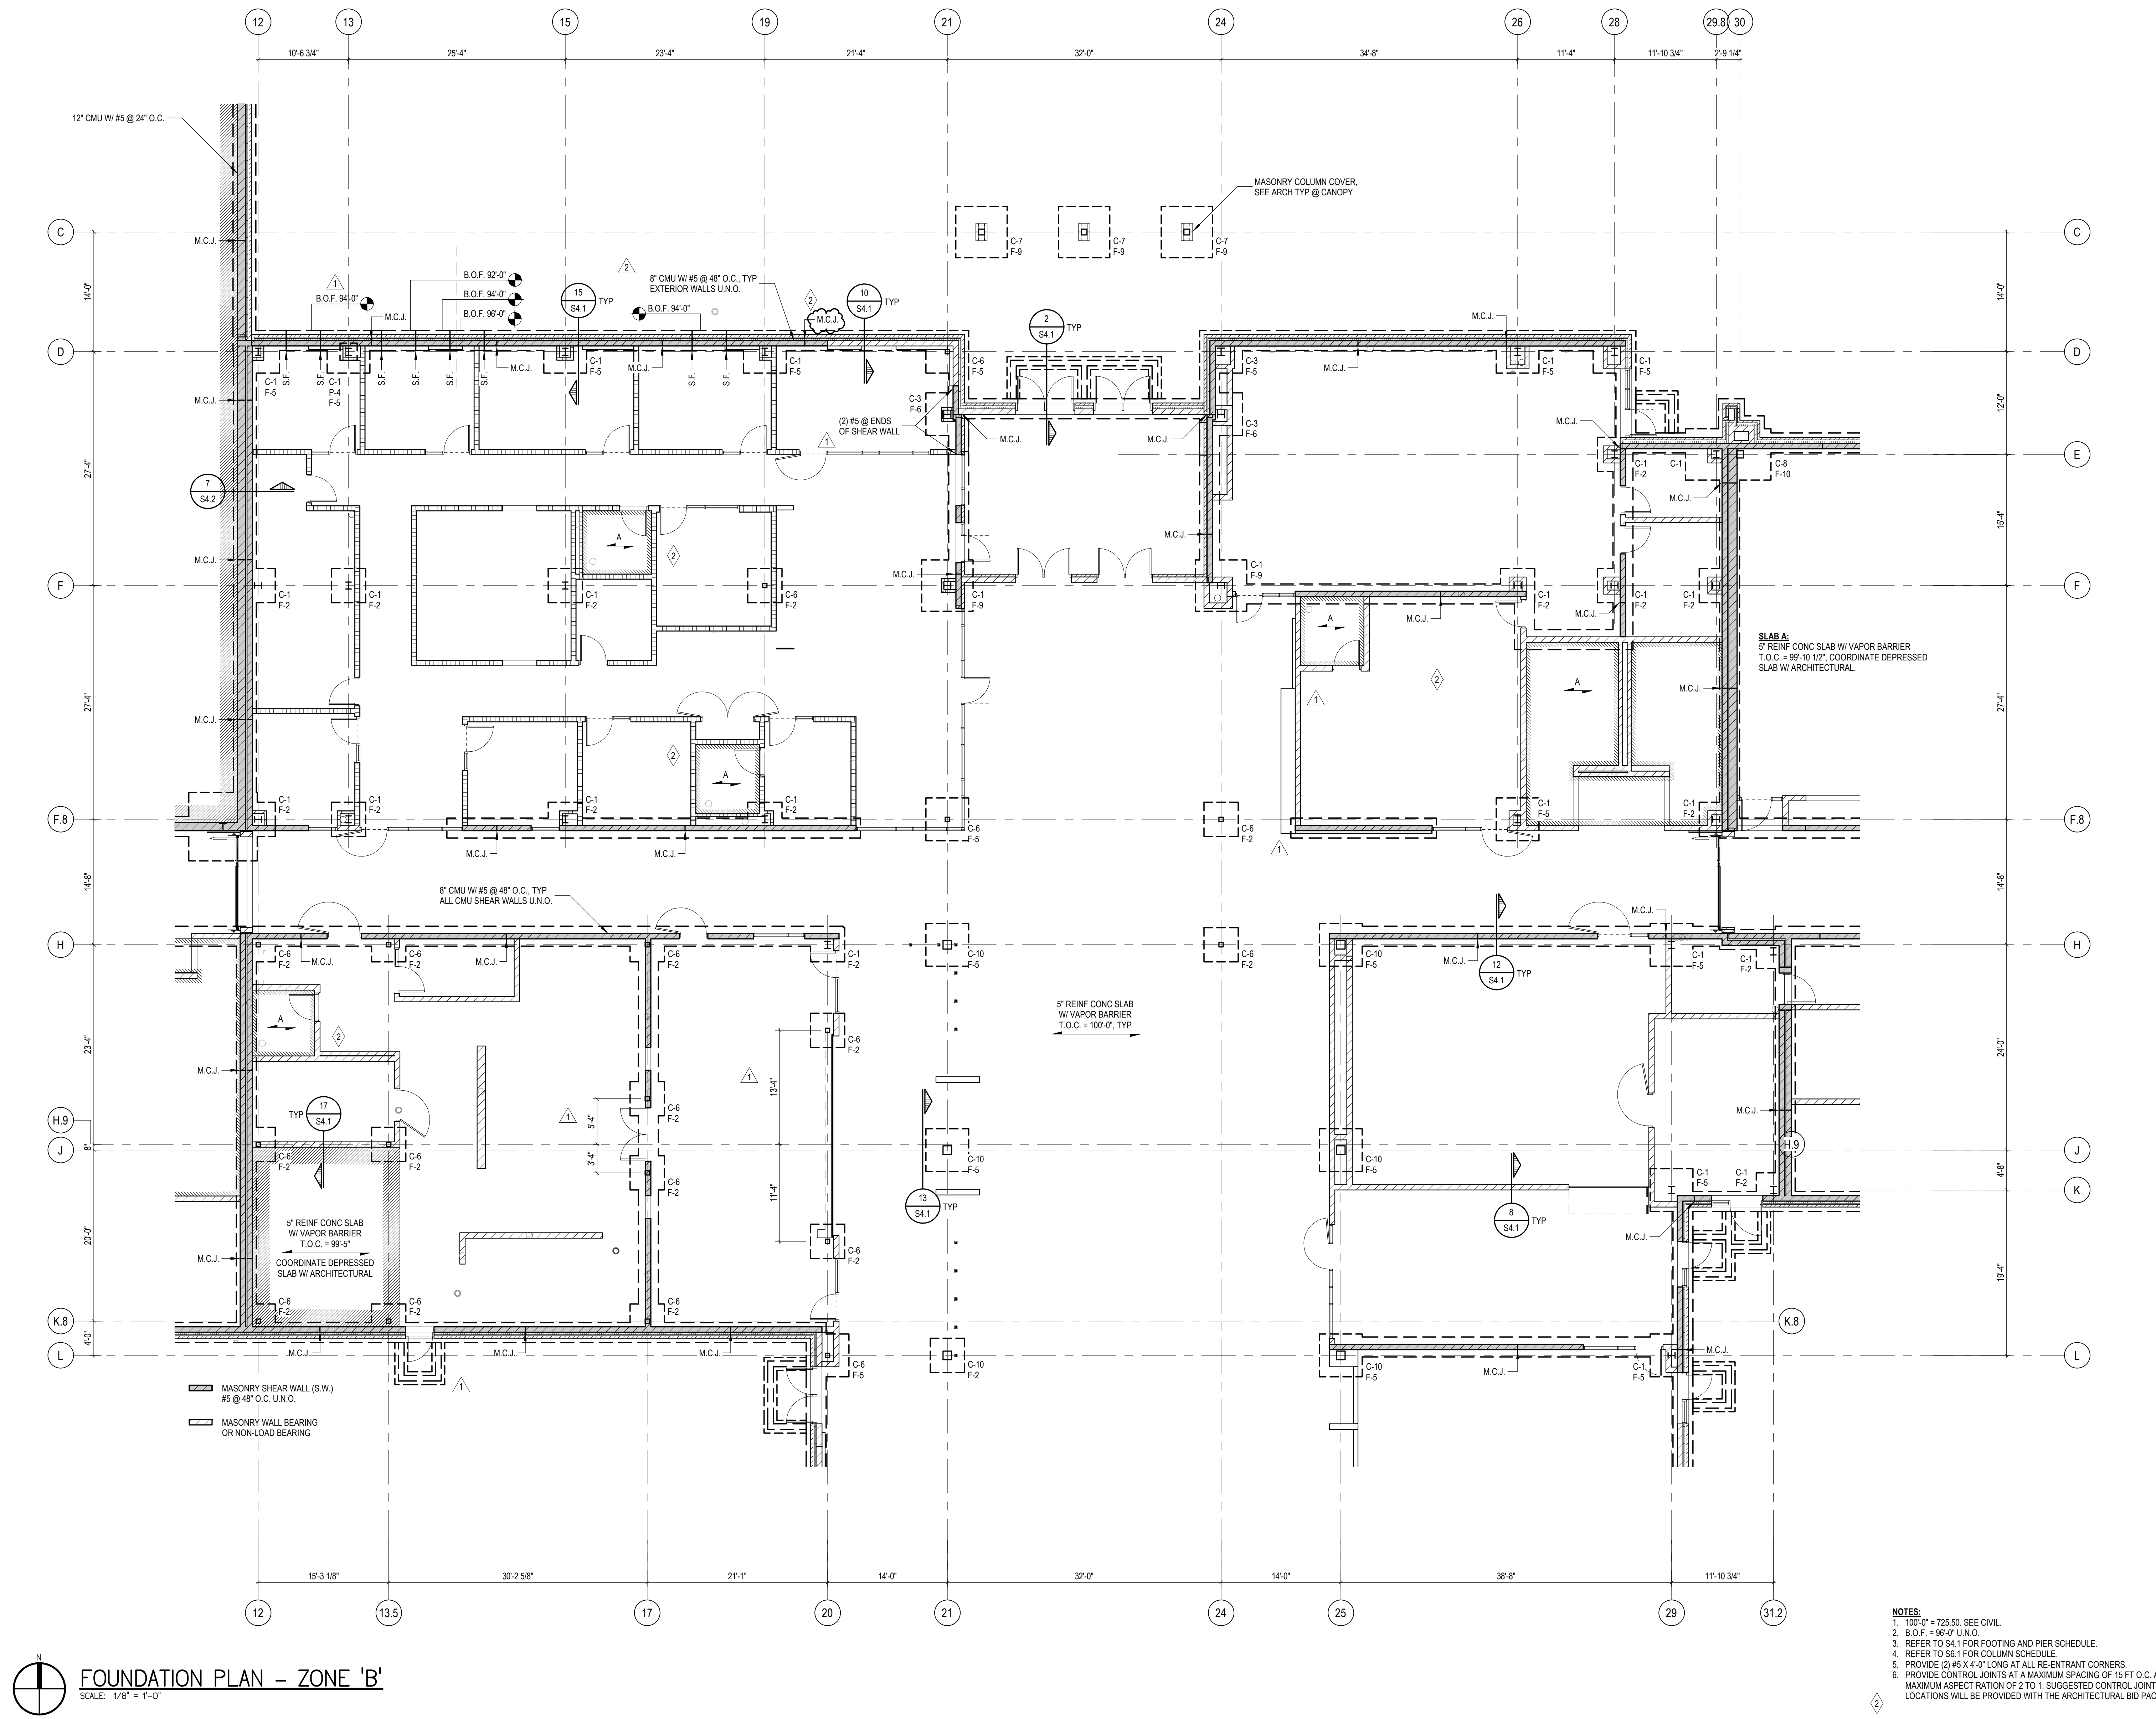

FOUNDATION PLAN - ZONE 'B'
SCALE: 1/8" = 1'-0"

- NOTES:
1. 197'-0" = 725.50. SEE CIVIL.
 2. B.O.F. = 96'-0" U.N.O.
 3. REFER TO S4.1 FOR FOOTING AND PIER SCHEDULE.
 4. REFER TO S6.1 FOR COLUMN SCHEDULE.
 5. PROVIDE (2) #5 X 4'-0" LONG AT ALL RE-ENTRANT CORNERS.
 6. PROVIDE CONTROL JOINTS AT A MAXIMUM SPACING OF 15 FT O.C. AND A MAXIMUM ASPECT RATIO OF 2 TO 1. SUGGESTED CONTROL JOINT LOCATIONS WILL BE PROVIDED WITH THE ARCHITECTURAL BID PACKAGE.



TMP ARCHITECTURE INC
1191 WEST SQUARE LAKE ROAD
BLOOMFIELD HILLS, MICHIGAN 48302
PH: 248.338.4561 FX: 248.338.0223
EM: INFO@TMP-ARCHITECTURE.COM

REGISTRATION SEAL


CONSULTANT



PROJECT TITLE
**NEW SMITH
MIDDLE SCHOOL**
Bid Package No. 03B

Troy School District
Troy, Michigan

DRAWING TITLE
Foundation Plan Zone 'E'

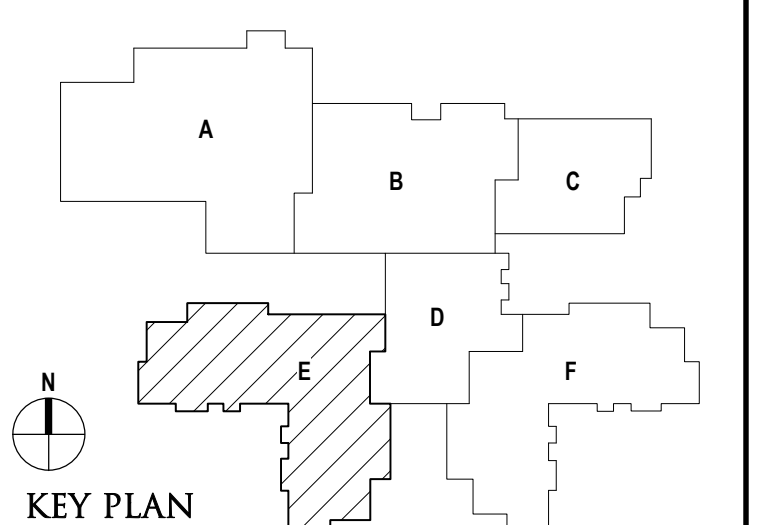


ISSUE DATES

DATE	ISSUED FOR:
07-13-2024	ADDENDUM NO. 2
06-21-2024	BULLETIN NO. 2
06-18-2024	CONSTRUCTION DOCUMENTS
05-30-2024	BULLETIN NO. 1
02-28-2024	ADDENDUM NO. 2
01-23-2024	CONSTRUCTION DOCUMENTS

DATE: ISSUED FOR:
DRAWN: D. BART
CHECKED: B. KANNERS
APPROVED: E. MANNOR

PROJECT NO.
22102
DRAWING NO.
S1.0E

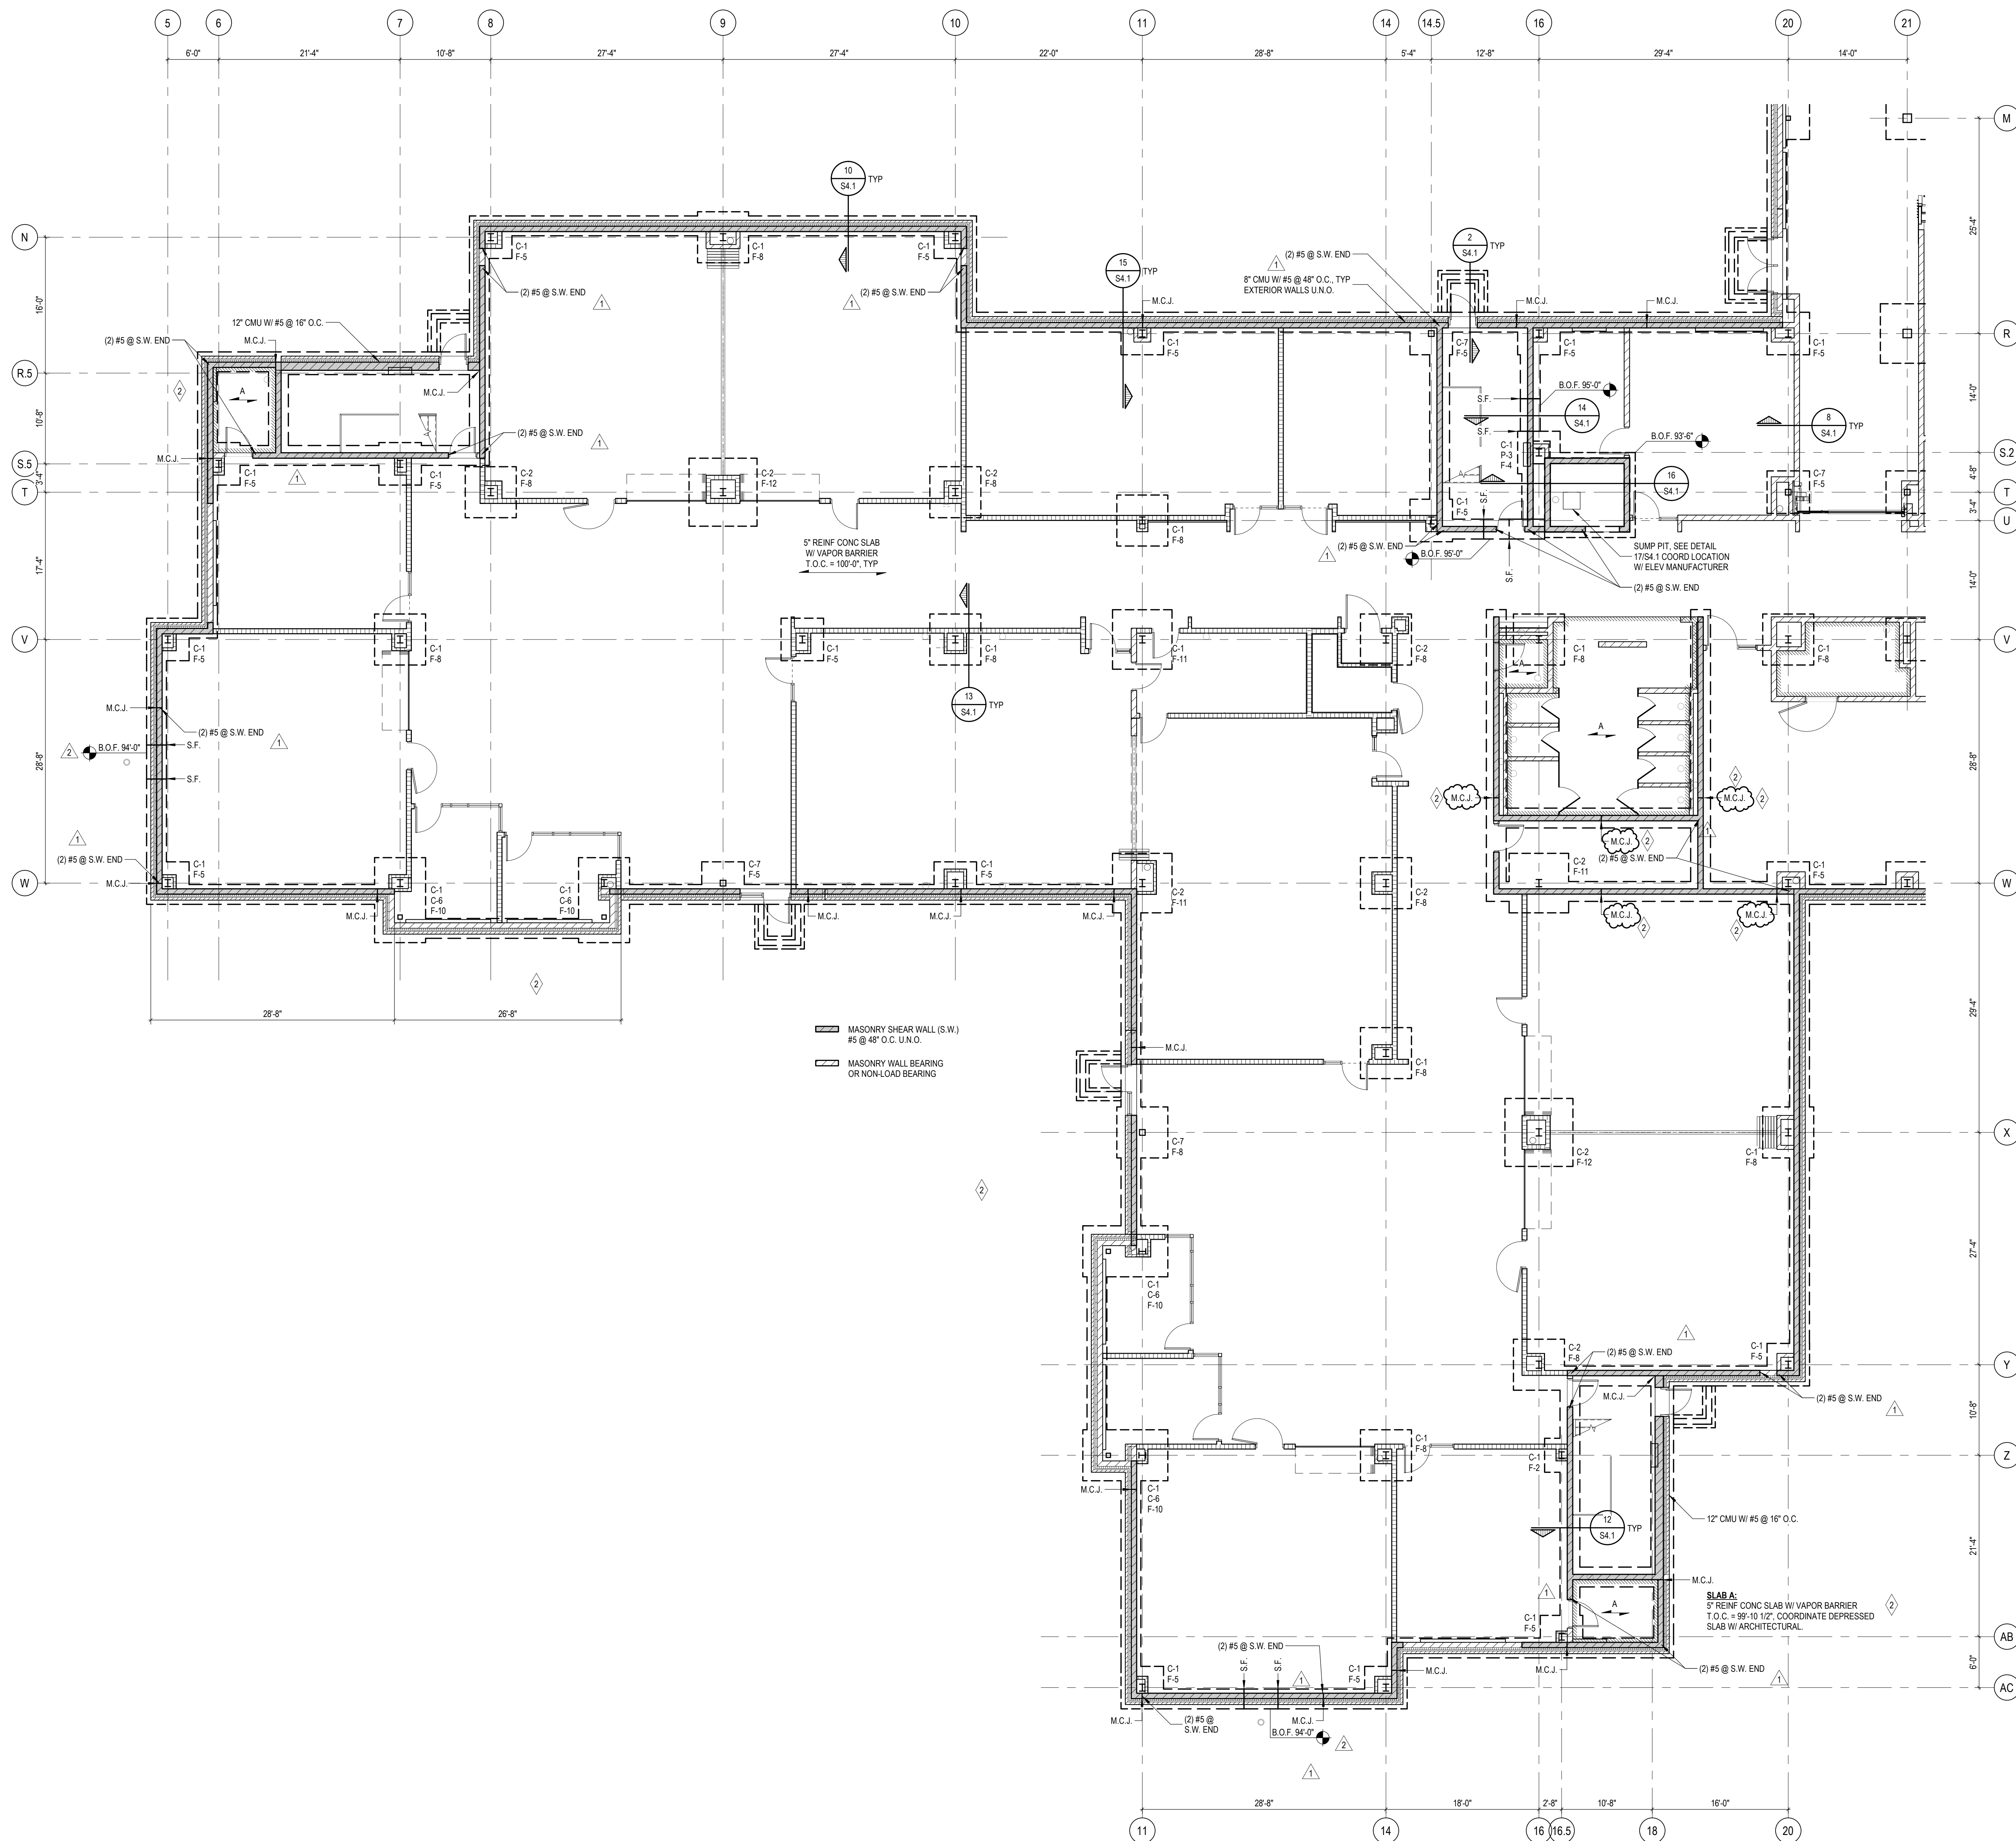


MASONRY SHEAR WALL (S.W.)
#5 @ 48" O.C. U.N.O.

MASONRY WALL BEARING
OR NON-LOAD BEARING

- NOTES:
1. 193'0" = 725.50. SEE CIVIL.
 2. B.O.F. = 96'-0" U.N.O.
 3. REFER TO S4.1 FOR FOOTING AND PIER SCHEDULE.
 4. REFER TO SS.1 FOR COLUMN SCHEDULE.
 5. PROVIDE (2) #5 X 4'-0" LONG AT ALL RE-ENTRANT CORNERS.
 6. PROVIDE CONTROL JOINTS AT A MAXIMUM SPACING OF 15 FT O.C. AND A MAXIMUM ASPECT RATIO OF 2 TO 1. SUGGESTED CONTROL JOINT LOCATIONS WILL BE PROVIDED WITH THE ARCHITECTURAL BID PACKAGE.

FOUNDATION PLAN - ZONE 'E'
SCALE: 1/8" = 1'-0"


Autodesk Docs/22102_Troy Smith MS/24/0065_New Smith Middle School/22102_S.022_Darren.rvt
7/11/2024 11:26:32 AM

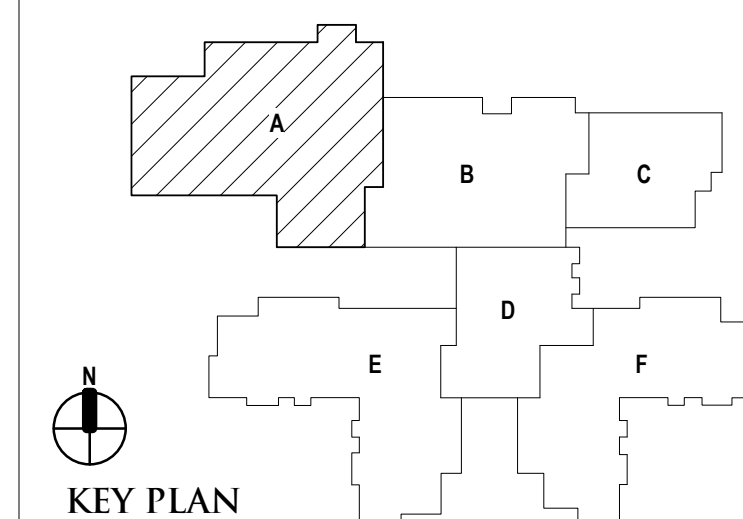

DATE	ISSUED FOR:

07-12-2024	ADDENDUM NO. 2
06-18-2024	CONSTRUCTION DOCUMENTS
DATE:	ISSUED FOR:

DRAWN	do
CHECKED	jw
APPROVED	at

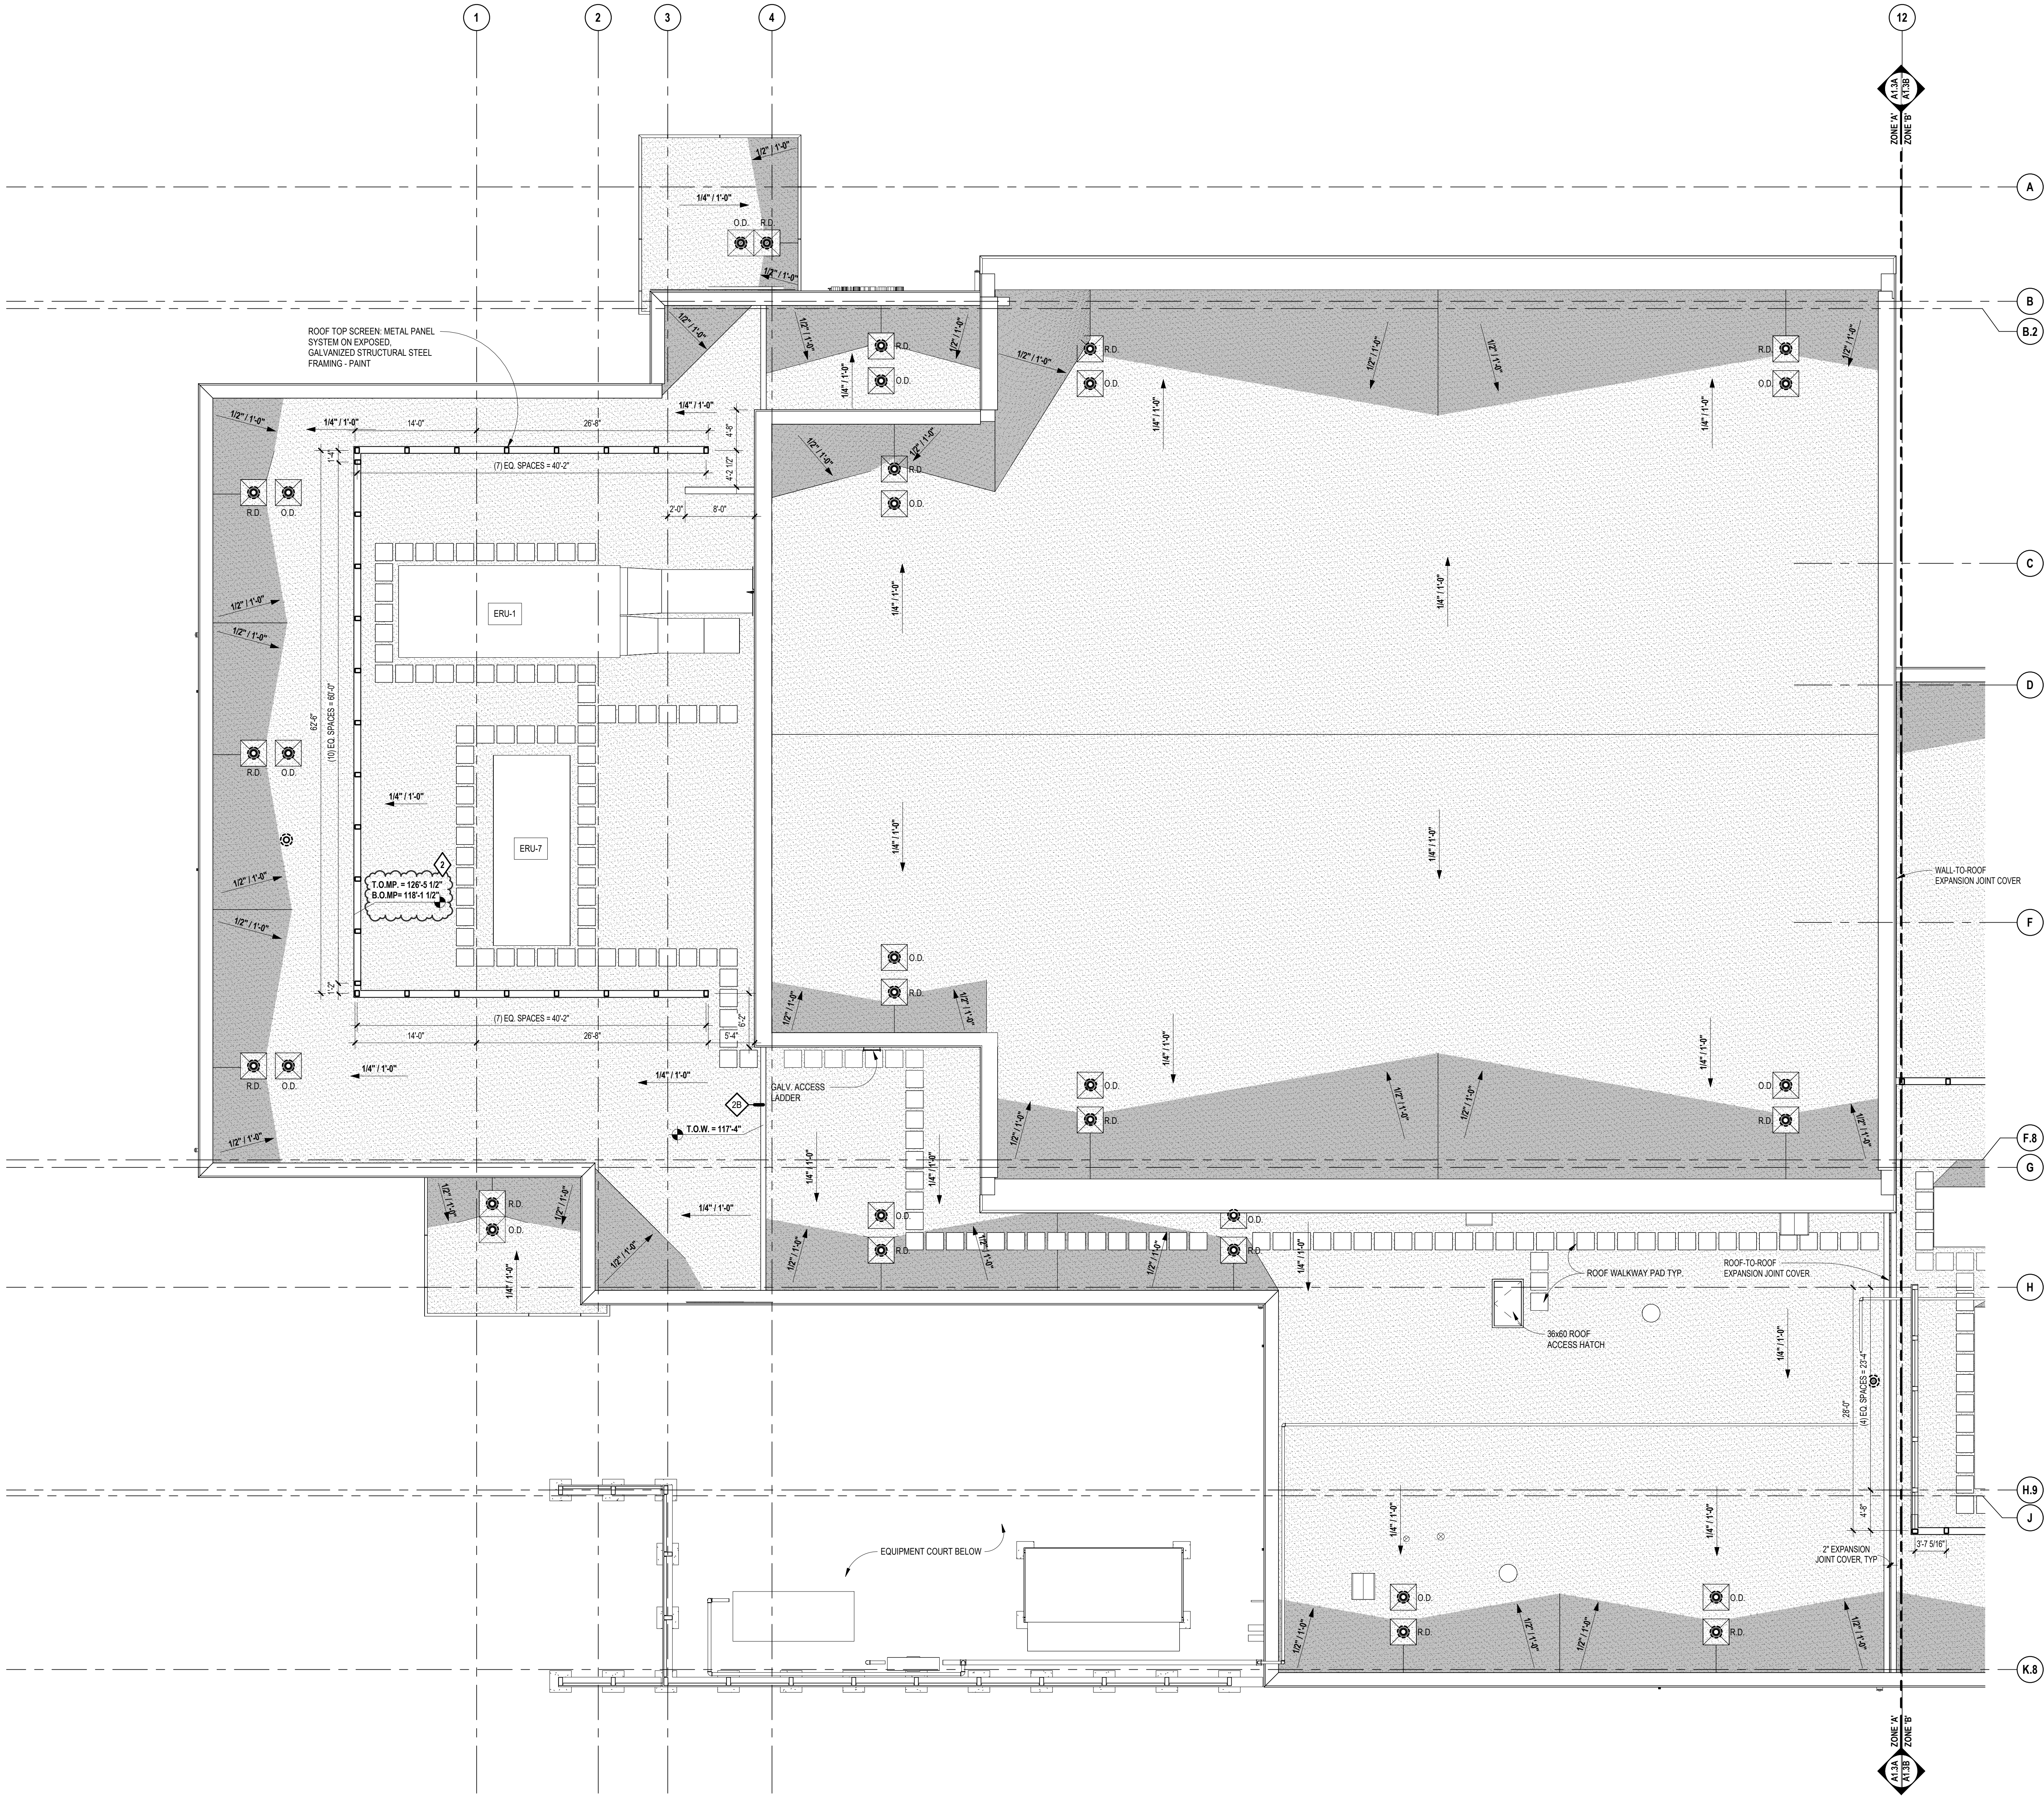


ROOF PLAN LEGEND

- RD/OD: COMBINATION PRIMARY / SECONDARY ROOF DRAIN
- RD: ROOF DRAIN (PRIMARY)
- RO: ROOF DRAIN (SECONDARY)
- EF(RV)(H): EXHAUST FAN (RELIEF VENT) (INTAKE HOOD)
- RTU: ROOF TOP MECHANICAL UNIT
- CU: CONDENSING UNIT (CU) ON EQUIPMENT RAILS
- Roofing on tapered insulation (1/2" PER FOOT, MIN) ON UNIFORM THICKNESS (NON-TAPERED) INSULATION
- Roofing on uniform thickness (NON-TAPERED) INSULATION ON SLOPED METAL DECK
- Roofing on cementitious wood fiber deck with BONDED URETHANE INSULATION
- Roof Patch / Tie-IN (SEE GENERAL NOTE 3)
- APPROXIMATE THICKNESS OF TAPERED INSULATION (IN ADDITION TO UNIFORM THICKNESS INSULATION)
- INDICATES PITCH OF ROOF SURFACE TOWARDS DRAINS (TAPERED INSULATION OR SADDLES)
- SLOPE: INDICATES SLOPE OF ROOF DECK AND SUPPORTING STEEL (ROOF SURFACE ALSO IF NOT OTHERWISE INDICATED)

- ROOF PLAN NOTES**
- REFER TO MECHANICAL DRAWINGS FOR LOCATIONS OF PLUMBING VENTS (FLASH AS PER S.M.A.C.N.A. AND N.R.C.A. STANDARDS).
 - REFER TO MECHANICAL DRAWINGS FOR ADDITIONAL OPENINGS. IF ANY, IN NEW AND/OR EXISTING ROOFS. DETAILS OF SIMILAR OPENINGS REFERENCED ON THIS SHEET ARE APPLICABLE.
 - WHERE NEW OPENINGS OCCUR IN EXISTING ROOF AREAS, INSTALL SUPPLEMENTAL FRAMING UNDER SHEATHING PRIOR TO CUTTING HOLE IN SHEATHING. REPAIR ROOFING TO 2'-0" (MIN) AROUND OPENING.
 - INFORMATION FOR EXISTING CONDITIONS TAKEN FROM HISTORICAL DRAWINGS AND VISUAL INSPECTIONS OF EACH BUILDING. CONTRACTOR SHALL VERIFY ALL EXISTING CONDITIONS IN THE FIELD PRIOR TO INSTALLATION OF NEW WORK AND REPORT ALL DISCREPANCIES TO THE ARCHITECT.
 - LOCATIONS AND QUANTITIES OF ALL EXISTING ROOF PENETRATIONS ARE APPROXIMATE AND MUST BE VERIFIED BY CONTRACTOR PRIOR TO WORK IN THOSE AREAS.
 - CONTRACTOR SHALL BE RESPONSIBLE FOR PROPER FLASHING OF ALL EXISTING DRAINS, CURBS, VENT STACKS, ETC., AFFECTED WITHIN THE PROJECT SCOPE.
 - REFER TO MECHANICAL DRAWINGS FOR LOCATIONS OF NEW PENETRATIONS, FLASH AS SPECIFIED.
 - SEE MECHANICAL DRAWINGS FOR ADDITIONAL OPENINGS. IF ANY, IN NEW AND/OR EXISTING ROOFS. DETAILS OF SIMILAR OPENINGS REFERENCED ON THIS SHEET ARE APPLICABLE.
 - CONTRACTOR SHALL BE RESPONSIBLE FOR THE PROTECTION OF ALL EXISTING UTILITIES ON OR NEAR PROJECT ROOFS DURING THE WORK. PROVIDE PROPER SAFETY MEASURES NEAR ELECTRICAL SERVICE LINES.

ROOF LEVEL PLAN - ZONE 'A'
SCALE: 1/8" = 1'-0"

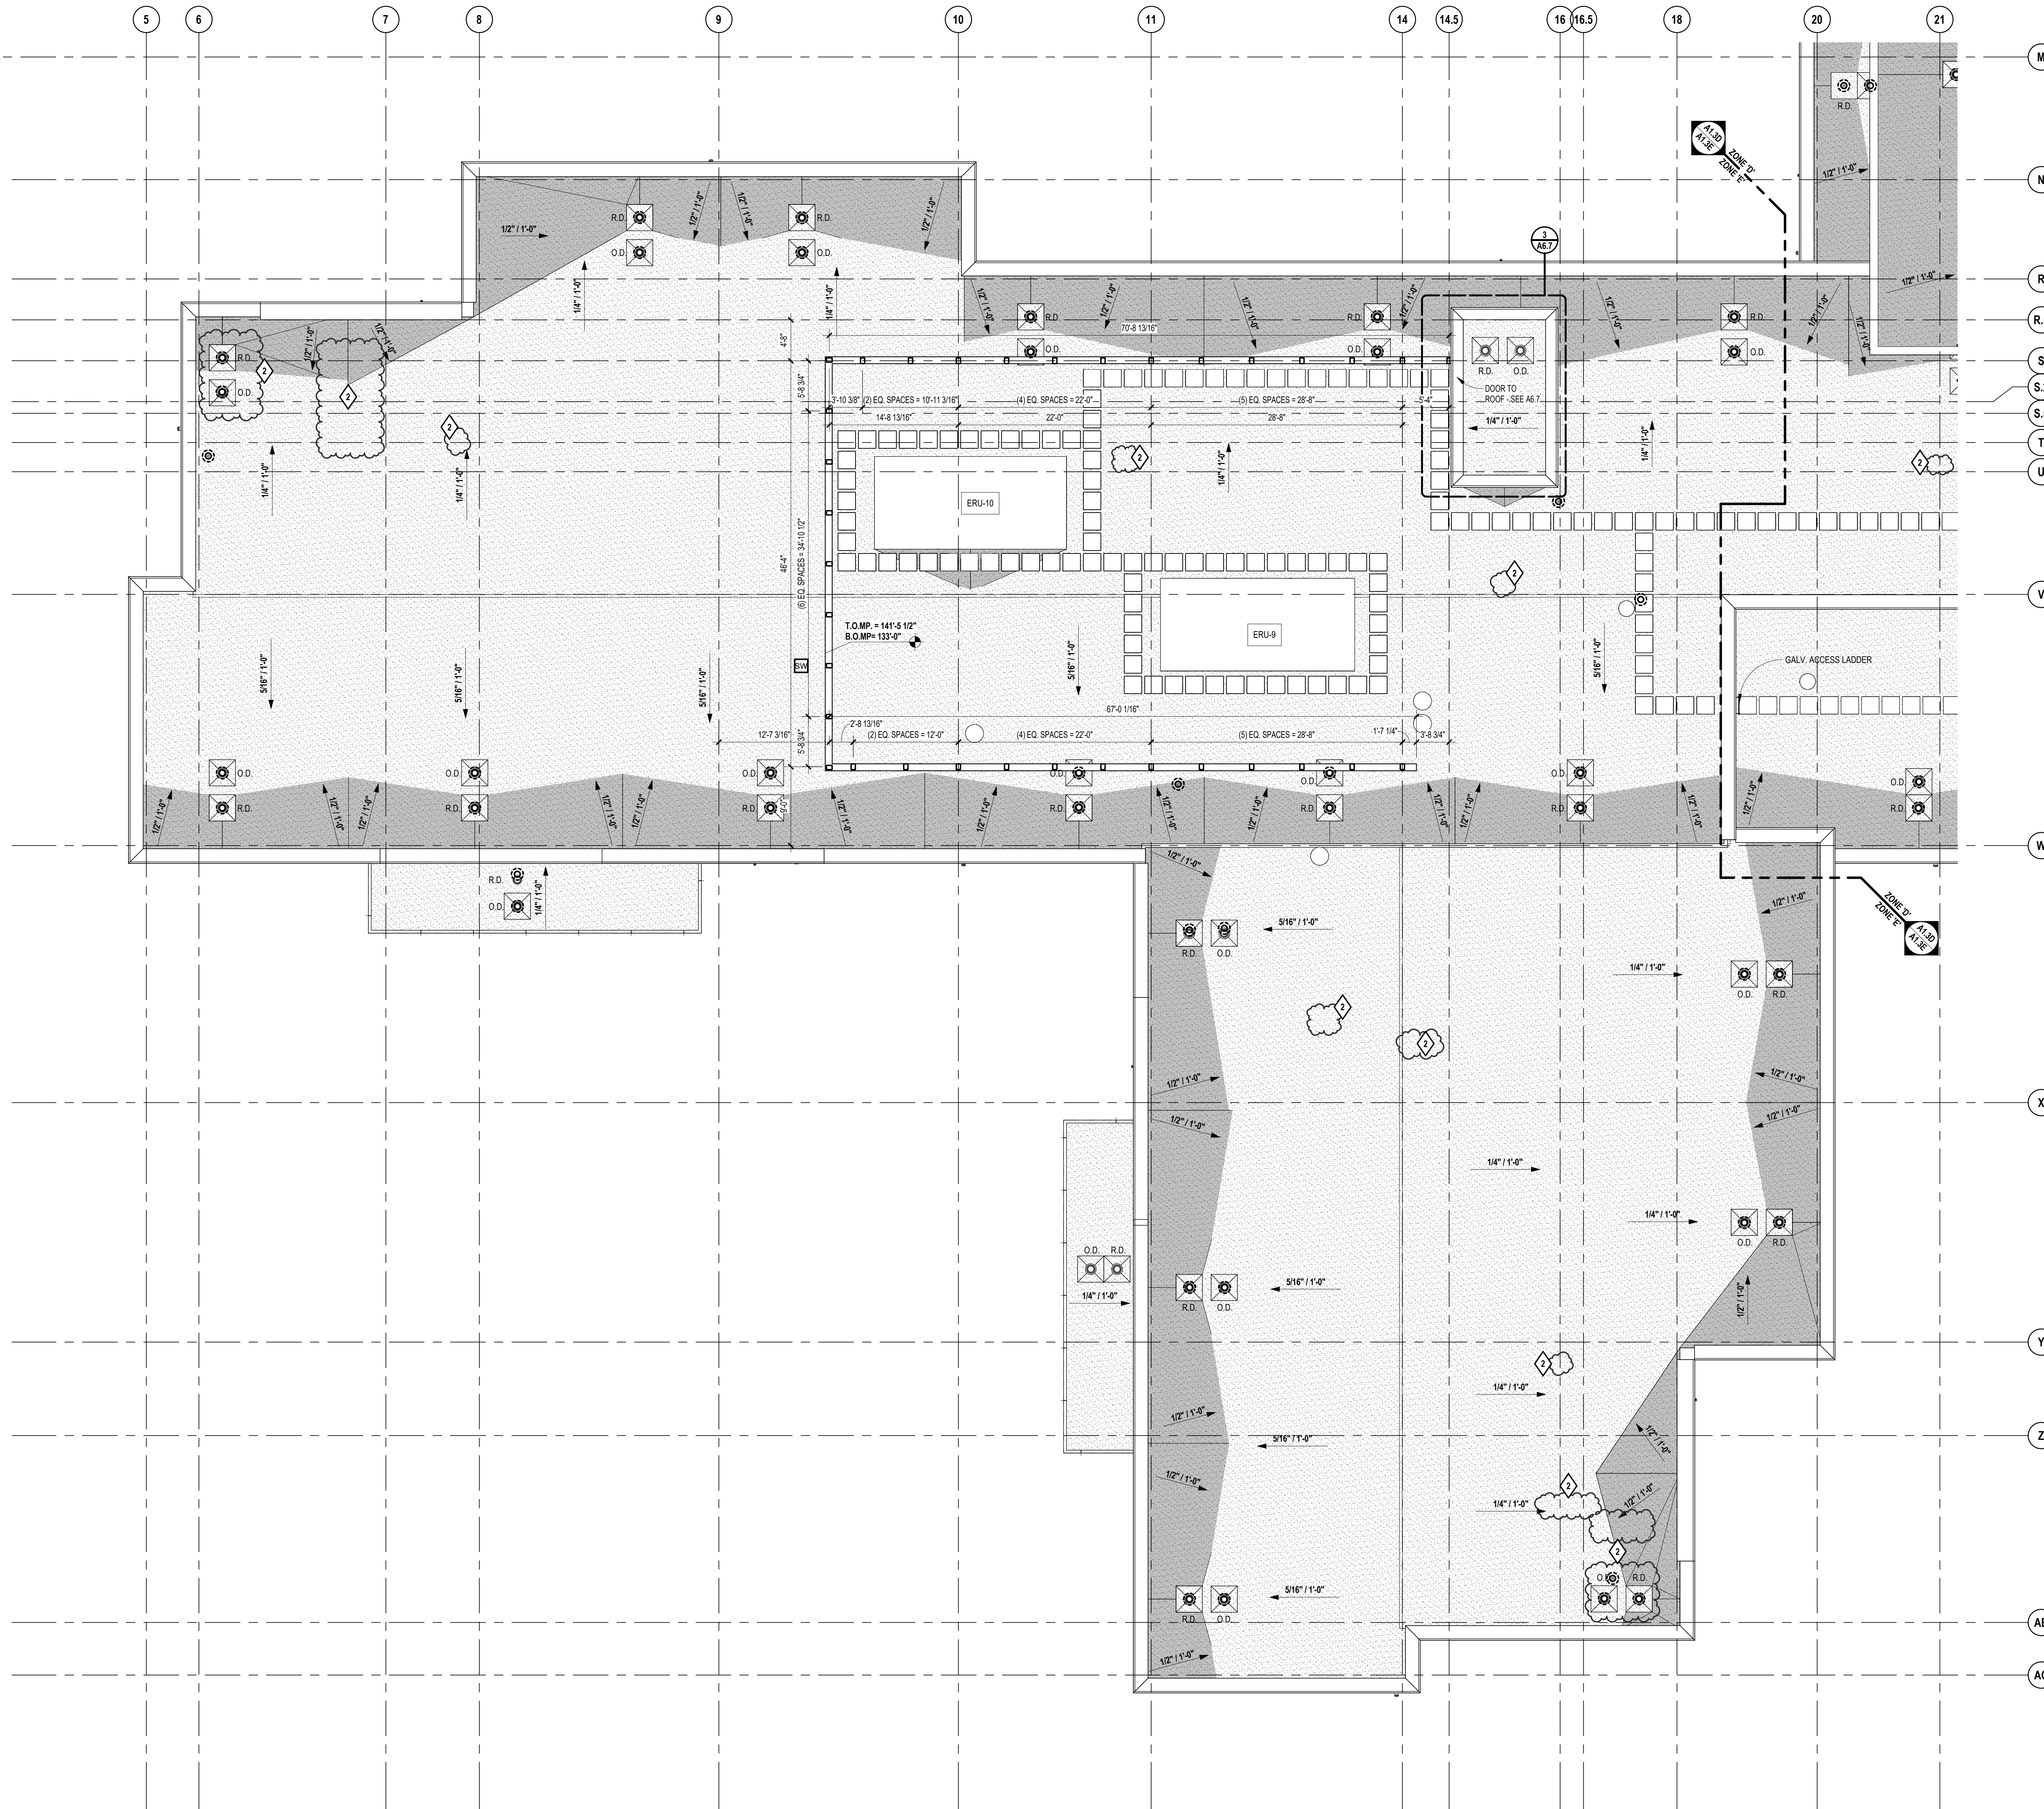

ROOF PLAN LEGEND

- COMBINATION PRIMARY / SECONDARY ROOF DRAIN
- ROOF DRAIN (PRIMARY)
- ROOF DRAIN (SECONDARY)
- EXHAUST FAN (RELIEF VENT) [INTAKE HOOD]
- ROOF TOP MECHANICAL UNIT
- CONDENSING UNIT (CU) ON EQUIPMENT RAILS
- ROOFING ON TAPERED INSULATION (1/2" PER FOOT, MIN) ON UNIFORM THICKNESS (NON-TAPERED) INSULATION
- ROOFING ON UNIFORM THICKNESS (NON-TAPERED) INSULATION ON SLOPED METAL DECK
- ROOFING ON CEMENTITIOUS WOOD FIBER DECK WITH BONDED URETHANE INSULATION
- ROOF PATCH / TIE-IN (SEE GENERAL NOTE 3)
- APPROXIMATE THICKNESS OF TAPERED INSULATION (IN ADDITION TO UNIFORM THICKNESS INSULATION)
- INDICATES PITCH OF ROOF SURFACE TOWARDS DRAINS (TAPERED INSULATION OR SADDLES)
- INDICATES SLOPE OF ROOF DECK AND SUPPORTING STEEL (ROOF SURFACE ALSO IF NOT OTHERWISE INDICATED)

ROOF PLAN NOTES

1. REFER TO MECHANICAL DRAWINGS FOR LOCATIONS OF PLUMBING VENTS (FLASH AS PER S.M.A.C.A. AND N.R.C.A. STANDARDS).
2. REFER TO MECHANICAL DRAWINGS FOR ADDITIONAL OPENINGS, IF ANY, IN NEW AND/OR EXISTING ROOFS. DETAILS OF SIMILAR OPENINGS REFERENCED ON THIS SHEET ARE APPLICABLE.
3. WHERE NEW OPENINGS OCCUR IN EXISTING ROOF AREAS, INSTALL SUPPLEMENTAL FRAMING UNDER SHEATHING PRIOR TO CUTTING HOLE IN SHEATHING. REPAIR ROOFING TO 2'-0" (MIN) AROUND OPENING.
4. INFORMATION FOR EXISTING CONDITIONS TAKEN FROM HISTORICAL DRAWINGS AND VISUAL INSPECTIONS OF EACH BUILDING. CONTRACTOR SHALL VERIFY ALL EXISTING CONDITIONS IN THE FIELD PRIOR TO INSTALLATION OF NEW WORK AND REPORT ALL DISCREPANCIES TO THE ARCHITECT.
5. LOCATIONS AND QUANTITIES OF ALL EXISTING ROOF PENETRATIONS ARE APPROXIMATE AND MUST BE VERIFIED BY CONTRACTOR PRIOR TO WORK IN THOSE AREAS.
6. CONTRACTOR SHALL BE RESPONSIBLE FOR PROPER FLASHING OF ALL EXISTING DRAINS, CURBS, VENT STACKS, ETC., AFFECTED WITHIN THE PROJECT SCOPE.
7. REFER TO MECHANICAL DRAWINGS FOR LOCATIONS OF NEW PENETRATIONS, FLASH AS SPECIFIED.
8. SEE MECHANICAL DRAWINGS FOR ADDITIONAL OPENINGS, IF ANY, IN NEW AND/OR EXISTING ROOFS. DETAILS OF SIMILAR OPENINGS REFERENCED ON THIS SHEET ARE APPLICABLE.
9. CONTRACTOR SHALL BE RESPONSIBLE FOR THE PROTECTION OF ALL EXISTING UTILITIES ON OR NEAR PROJECT ROOFS DURING THE WORK. PROVIDE PROPER SAFETY MEASURES NEAR ELECTRICAL SERVICE LINES.

TMP ARCHITECTURE INC
1191 WEST SQUARE LAKE ROAD
BLOOMFIELD HILLS, MICHIGAN - 48302
PH: 248.338.4564 | FX: 248.338.0223
EM: INFO@TMP-ARCHITECTURE.COM

REGISTRATION SEAL

CONSULTANT

PROJECT TITLE
NEW SMITH MIDDLE SCHOOL
Bid Package No. 03B

Troy School District
Troy, Michigan

DRAWING TITLE
Roof Level Plan - Zone 'E'

KEY PLAN

ISSUE DATES

DATE	ISSUED FOR:

07-12-2024 ADDENDUM NO. 2
06-18-2024 CONSTRUCTION DOCUMENTS

DRAWN do
CHECKED jw
APPROVED dl

PROJECT NO.
22102
DRAWING NO.
A1.3E

ROOF LEVEL PLAN - ZONE 'E'
SCALE: 1/8" = 1'-0"

Autodesk Docs/22102_Troy_Smith_MS22102-ARCH-22.rvt
7/11/2024 10:51:11 AM

REGISTRATION SEAL

CONSULTANT

PROJECT TITLE
**NEW SMITH
 MIDDLE SCHOOL**
 Bid Package No. 03B

Troy School District
 Troy, Michigan


DRAWING TITLE
Wall Sections

ISSUE DATES

07-12-2024 ADDENDUM NO. 2
 06-18-2024 CONSTRUCTION DOCUMENTS
 DATE ISSUED FOR:

DRAWN jr
 CHECKED jw
 APPROVED dt

PROJECT NO.
22102
 DRAWING NO.
A4.3

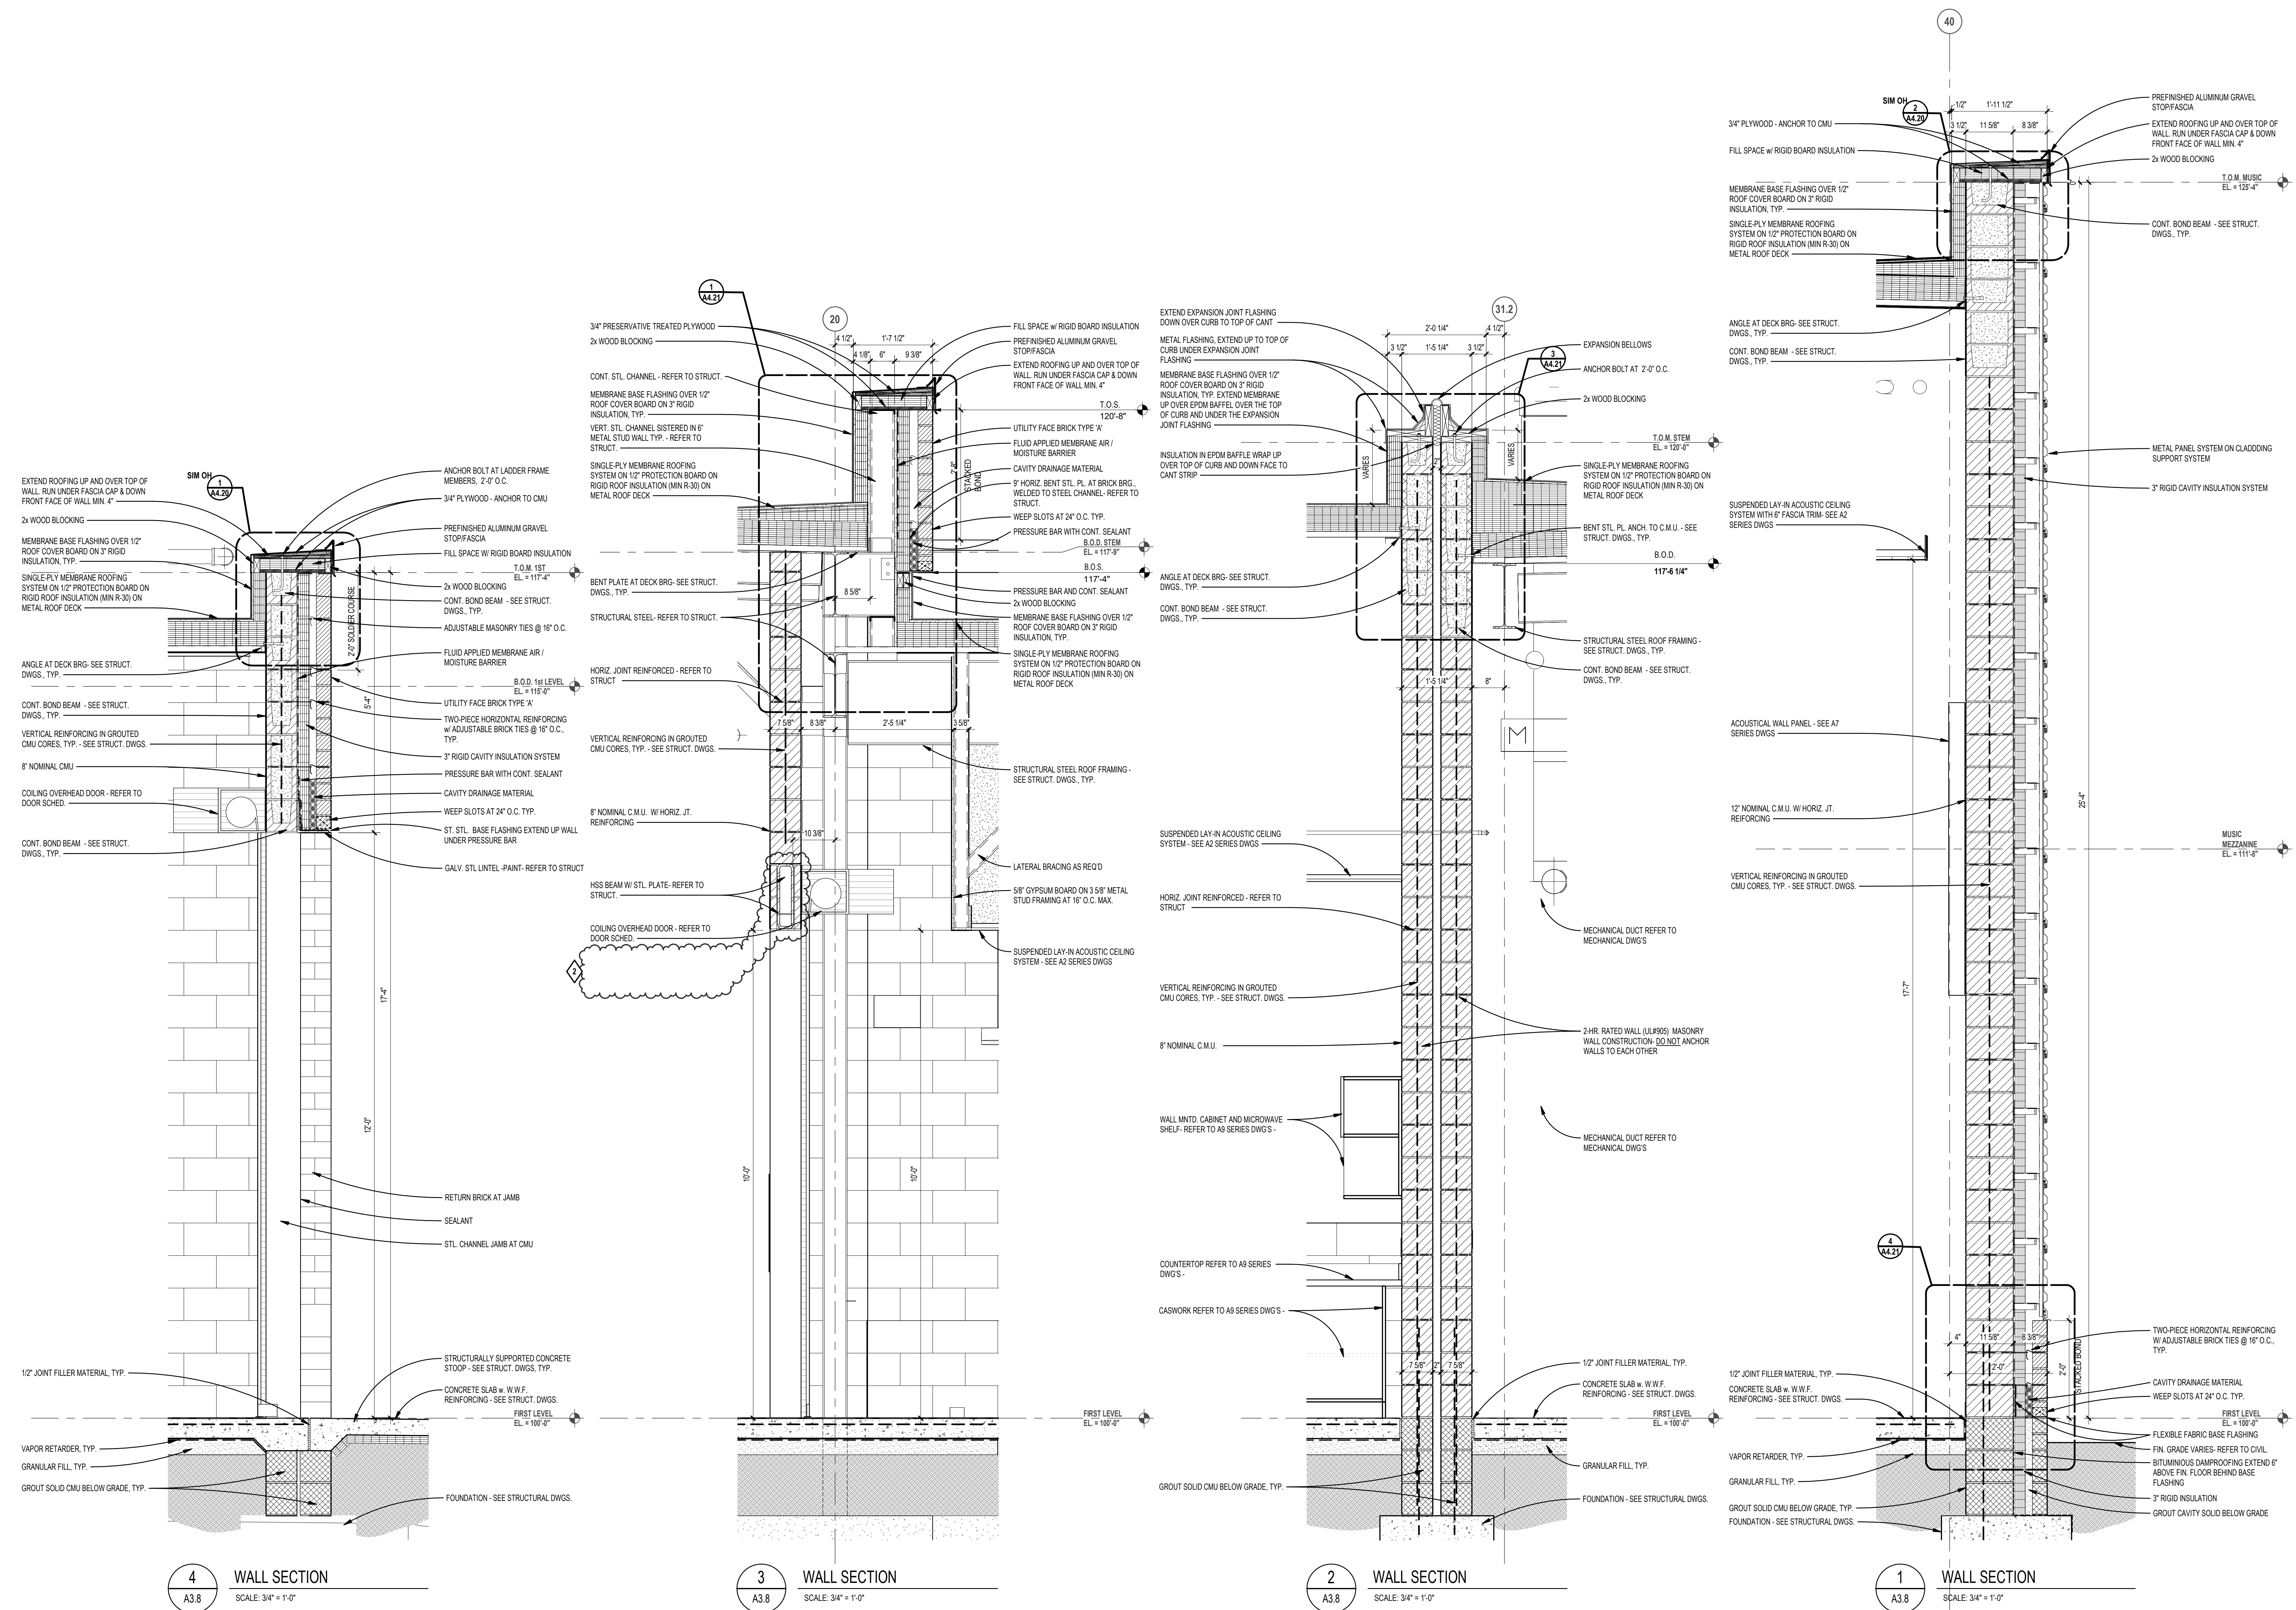

Autodesk Docs/22102_Troy_Smith_MS22102-A4.3-22.rvt
 7/11/2024 10:51:16 AM



TMP ARCHITECTURE INC
1191 WEST SQUARE LAKE ROAD
BLOOMFIELD HILLS - MICHIGAN - 48302
PH: 248.338.4564 | FX: 248.338.0223
EM: INFO@TMP-ARCHITECTURE.COM


REGISTRATION SEAL

CONSULTANT

PROJECT TITLE
NEW SMITH MIDDLE SCHOOL
Bid Package No. 03B

Troy School District
Troy, Michigan

DRAWING TITLE
First Level Casework & Equipment Plan - Zone 'A'

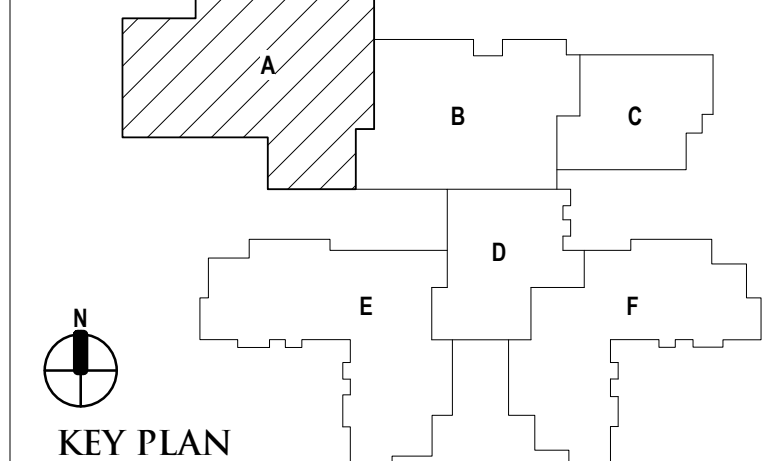

KEY PLAN

ISSUE DATES

DATE	ISSUED FOR:

DATE	ADDENDUM NO. 2 CONSTRUCTION DOCUMENTS
07-12-2024	
06-15-2024	

DRAWN	do
CHECKED	ju
APPROVED	dt

PROJECT NO.

22102

DRAWING NO.

A9.1A

LEGEND

DISP (BY OTHERS) - WALL OR SUSPENDED MOUNT (BY OTHERS)
 FIRE EXTINGUISHER IN CABINET (FEC)
 FIRE EXTINGUISHER ON WALL BRACKET (FE)
 7'-0" HIGH (UON) SURFACE MOUNT CORNER GUARD

VISUAL DISPLAY BOARD NOTES

TYPE OF BOARD
 6'-0" MB1
 WIDTH OF BOARD/STRIP
 HEIGHT OF ALL BOARDS ARE 4'-0" (UON)

NOTES:
 1. MB = MARKERBOARD
 TS = TACKBOARD
 TS = TACK STRIP
 DISP = DISPLAY (BY OTHERS)
 2. MOUNTING HEIGHTS (UON):
 MB/TS = 3'-0" AFF TO BOTTOM
 3. MAP RAILS SHALL BE CONTINUOUS OVER MARKERBOARDS.
 4. ALL MARKERBOARDS SHALL BE PROVIDED WITH TRAYS & MAP RAILS.
 5. LEGEND:
 MB1 = PORCELAIN ENAMEL STEEL HORIZONTAL ORIENTATION
 MB2 = PORCELAIN ENAMEL STEEL VERTICAL ORIENTATION
 MB3 = MAGNETIC GLASS

CASEWORK NOTES

- ALL PREFABRICATED CABINETS INDICATED ARE BASED ON TMI STORAGE SYSTEMS CORPORATION PRODUCTS. REFER TO TMI CATALOG FOR TYPICAL NUMBERING FORMAT.
- ALL TMI CABINETS ARE DESIGNATED USING THE TYPICAL TMI ELEVEN (11) DIGIT NOTATION SYSTEM. THE FIRST FIVE DIGITS ARE THE MODEL NUMBER FOLLOWED BY THREE SETS OF TWO DIGIT NUMBERS FOR THE WIDTH, HEIGHT AND DEPTH.
- WIDTH, HEIGHT AND DEPTH OF PREFABRICATED CABINETS IS INDICATED IN INCHES. UNLESS NOTED OTHERWISE, MODEL DIMENSIONS ARE NOMINAL. UNLESS SPECIFICALLY NOTED, "0000-00-00-00" INDICATES MODIFIED CASEWORK.
- PROVIDE PLASTIC LAMINATE COUNTERTOPS (WITH BACKEND SPLASHES) AT ALL BASE CABINETS. RADIUS ALL OUTSIDE CORNERS (U.O.N.)
- ALL EXPOSED SURFACES OF CASEWORK TO BE FINISHED, TYPICAL.
- WALL CABINETS (OVER COUNTERS) ARE TYPICALLY MOUNTED AT 7'-4" AFF TO TOP (UON).
- PROVIDE FINISHED END PANELS ON ALL EXPOSED CASEWORK ENDS.
- PROVIDE RESTRAINING CHAINS ON ALL END BASE AND WALL CABINET DOORS WHICH OPEN AGAINST PERPENDICULAR WALLS.
- WHERE CASEWORK IS HELD AWAY FROM WALLS, TO FLUSH-OUT WITH ADJACENT CABINETS, SCRIBE ENDFILLER PANELS TO WALLS.
- PROVIDE FILLER PANELS WHERE SHOWN AND/OR OTHERWISE REQUIRED FOR A COMPLETE INSTALLATION.
- PROVIDE LOCKS AT ALL CABINET DOORS AND DRAWERS (U.O.N.)
- MODIFY SINK BASE CABINETS AS REQUIRED TO ACCOMMODATE OVERSIZED SINKS (SEE MECHANICAL FOR OVERSIZED SINK LOCATIONS).
- WHERE BF 34" HIGH BASE CABINETS ARE INDICATED, MODIFY CABINET CONSTRUCTION BY REDUCING THE HEIGHT OF ALL COMPARTMENTS EQUALLY (INDICATE ON SHOP DWGS.)
- PROVIDE INTERMEDIATE PLASTIC LAMINATE CLAD SUPPORT PANELS @ 4'-0" OC MAXIMUM AT ALL UNSUPPORTED COUNTER TOPS (UON).
- PROVIDE GROMMETS AT ALL COUNTERS WITH KNEESPACES, WHERE POWER DATA OUTLETS ARE LOCATED BELOW (REFER TO ELECTRICAL DRAWINGS FOR LOCATIONS). UON. PROVIDE (1) ONE GROMMET PER KNEESPACE (UON). FINAL LOCATIONS WILL BE MARKED-UP ON THE SHOP DRAWING SUBMITTAL.
- PROVIDE MOISTURE RESISTANT PARTICLE BOARD AT SINK BASE, COUNTERTOP, AND SPLASH WITHIN 18" OF SINK.
- IN SCIENCE LABS, ACID NEUTRALIZATION TANKS TO BE PROVIDED IN TEACHER DEMONSTRATION TABLES.
- ALL TYPICAL MUSIC WING CABINETS INDICATED ARE BASED ON WENGER CORPORATION PRODUCTS. REFER TO WENGER CATALOG FOR TYPICAL NUMBERING FORMAT.
- ALL WENGER CABINETRY IS DESIGNATED USING THE PREFIX "W" AND THEN THE WENGER NUMBER SYSTEM.
- ALL SCIENCE CABINETS ARE BASED ON SHELDON PRODUCTS. REFER TO SHELDON CATALOG FOR TYPICAL NUMBER FORMAT.

LOCKER LEGEND

TYPE	DESCRIPTION
L-1	SINGLE-TIER STANDARD LOCKERS (12" X 15" X 72" HIGH) VENTILATED, ON METAL Z' BASE
L-2	SINGLE-TIER ADA ACCESSIBLE LOCKERS (12" X 15" X 72" HIGH) VENTILATED, ON METAL Z' BASE
L-3	DOUBLE-TIER CORRIDOR LOCKERS (12" X 15" X 60" HIGH) VENTILATED, ON METAL Z' BASE
L-4	DOUBLE-TIER ADA ACCESSIBLE CORRIDOR LOCKERS (12" X 15" X 60" HIGH) VENTILATED, ON METAL Z' BASE
L-5	SINGLE-TIER STANDARD LOCKERS (12" X 15" X 30" HIGH) VENTILATED, ON METAL Z' BASE
L-6	SINGLE-TIER ADA ACCESSIBLE STANDARD LOCKERS (12" X 15" X 30" HIGH) VENTILATED, ON METAL Z' BASE
L-7	SINGLE-TIER ATHLETIC LOCKERS (15" X 15" X 72" HIGH), VENTILATED, ON 4" TALL CMU BASE
L-8	SINGLE-TIER ADA ACCESSIBLE ATHLETIC LOCKERS (15" X 15" X 72" HIGH) VENTILATED, ON 4" TALL CMU/CONCRETE BASE (-/-)
L-9	FIVE-TIER ATHLETIC LOCKERS (15" X 15" X 60" HIGH), VENTILATED, ON 4" TALL CMU/CONCRETE BASE
L-10	FIVE-TIER ADA ACCESSIBLE ATHLETIC LOCKERS (15" X 15" X 60" HIGH) VENTILATED, ON 4" TALL CMU BASE
L-11	DOUBLE-TIER ATHLETIC LOCKERS (15" X 15" X 60" HIGH), VENTILATED, ON 18" TALL CMU BASE
L-12	DOUBLE-TIER ADA ACCESSIBLE ATHLETIC LOCKERS (15" X 15" X 60" HIGH) VENTILATED, ON 18" TALL CMU BASE
L-13	DOUBLE-TIER ATHLETIC LOCKERS (24" X 15" X 72" HIGH), VENTILATED, ON 18" TALL CMU BASE
L-14	DOUBLE-TIER ADA ACCESSIBLE ATHLETIC LOCKERS (24" X 15" X 72" HIGH) VENTILATED, ON 18" TALL CMU BASE

LOCKER NOTES:
 1. PROVIDE CONTINUOUS SLOPED TOPS AT ALL LOCKERS (UON)
 2. PROVIDE FILLER PIECES AT ENDS & CORNERS AS REQUIRED
 3. SIZES INDICATED ABOVE REFER TO WIDTH x DEPTH x HEIGHT
 4. LOCKERS TAGGED WITH "A" ARE ACCENT COLOR LOCKERS. SEE SPECIFICATIONS.



PROJECTION SCREEN SCHEDULE

PS-A	22'-6" x 14'-9"	ELECTRICALLY OPERATED, WALL MOUNTED
PS-B	9'-3" x 6'-0-1/2"	FIXED, WALL MOUNTED
PS-C	16'-6" x 10'-4"	ELECTRICALLY OPERATED, RECESSED MOUNTED

NOTES:
 1. REFER TO ELECTRICAL PLANS AND SPECIFICATIONS FOR ADDITIONAL INFORMATION.

INTERIOR SIGNAGE


THIS IS AN INTERIOR SIGNAGE IDENTIFICATION. REFER TO SPECIFICATIONS FOR INTERIOR SIGNAGE TYPE AND SCHEDULED INFORMATION

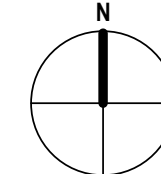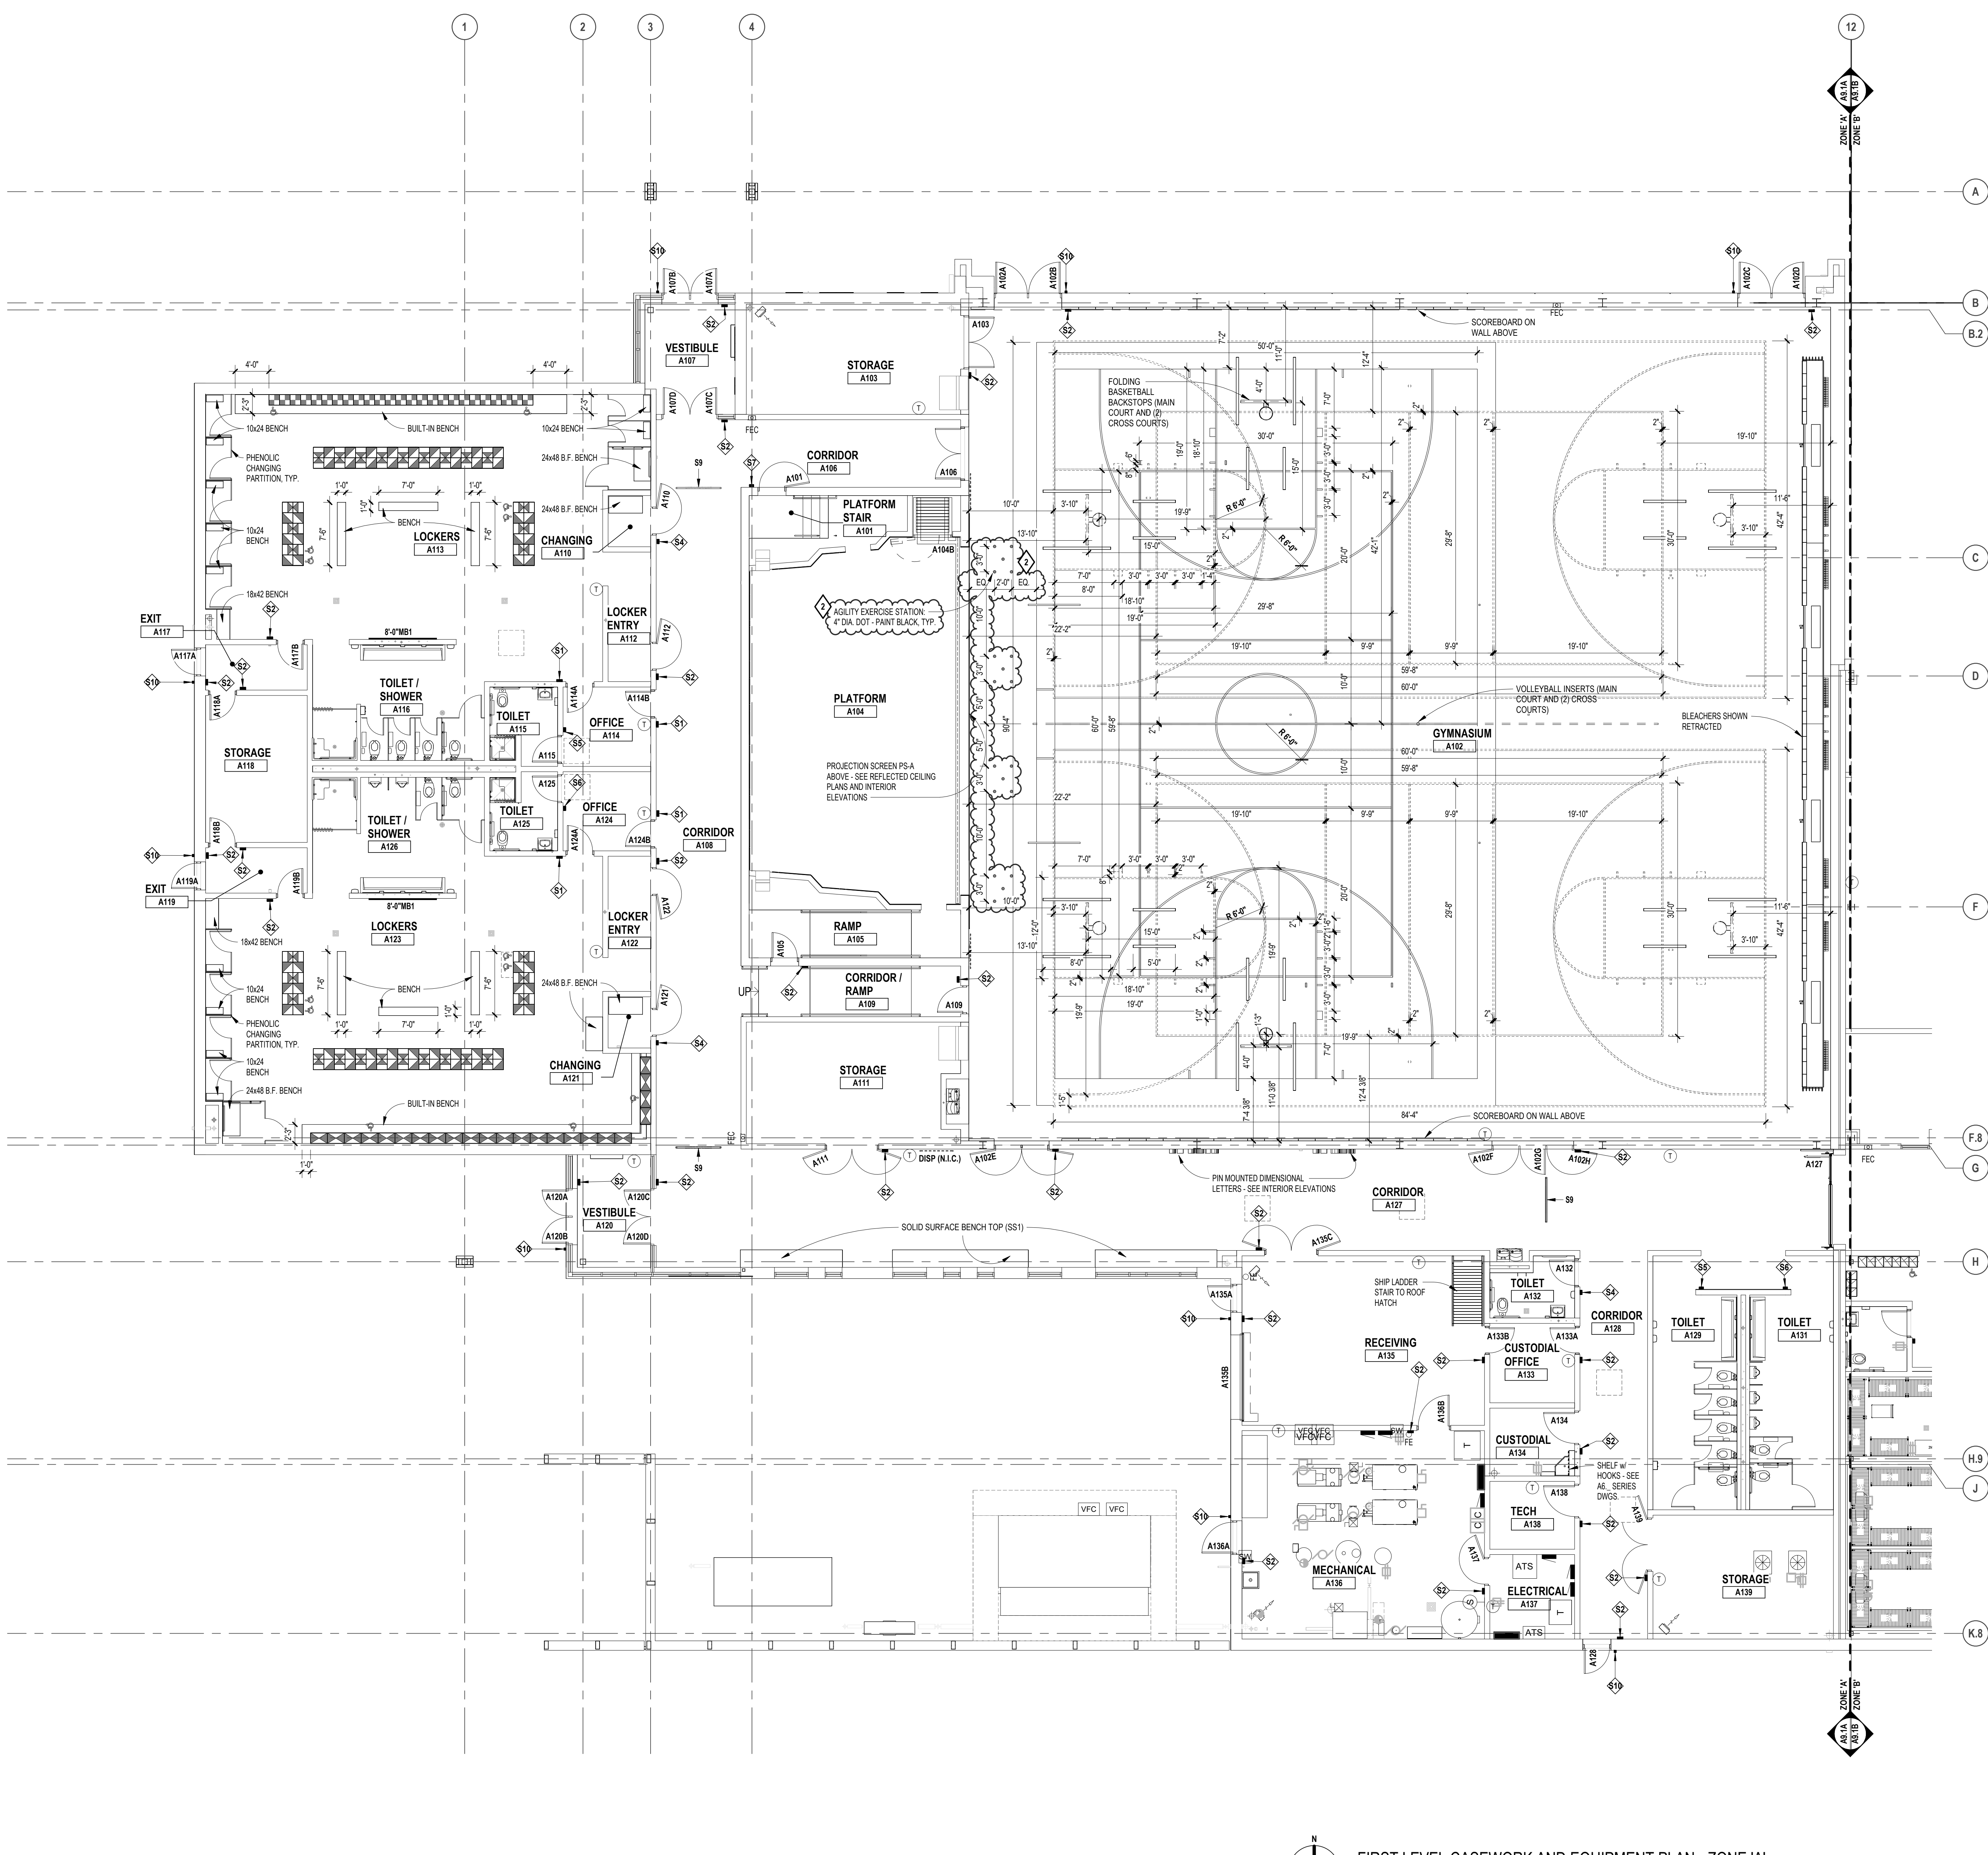

FIRST LEVEL CASEWORK AND EQUIPMENT PLAN - ZONE 'A'
SCALE: 1/8" = 1'-0"

Autodesk Docs/22102_Troy Smith_MS22102_ARCH-22.rvt
7/11/2024 9:00:08 AM

THE FOLLOWING DIMENSION EQUALS ONE INCH WHEN PRINTED TO SCALE.

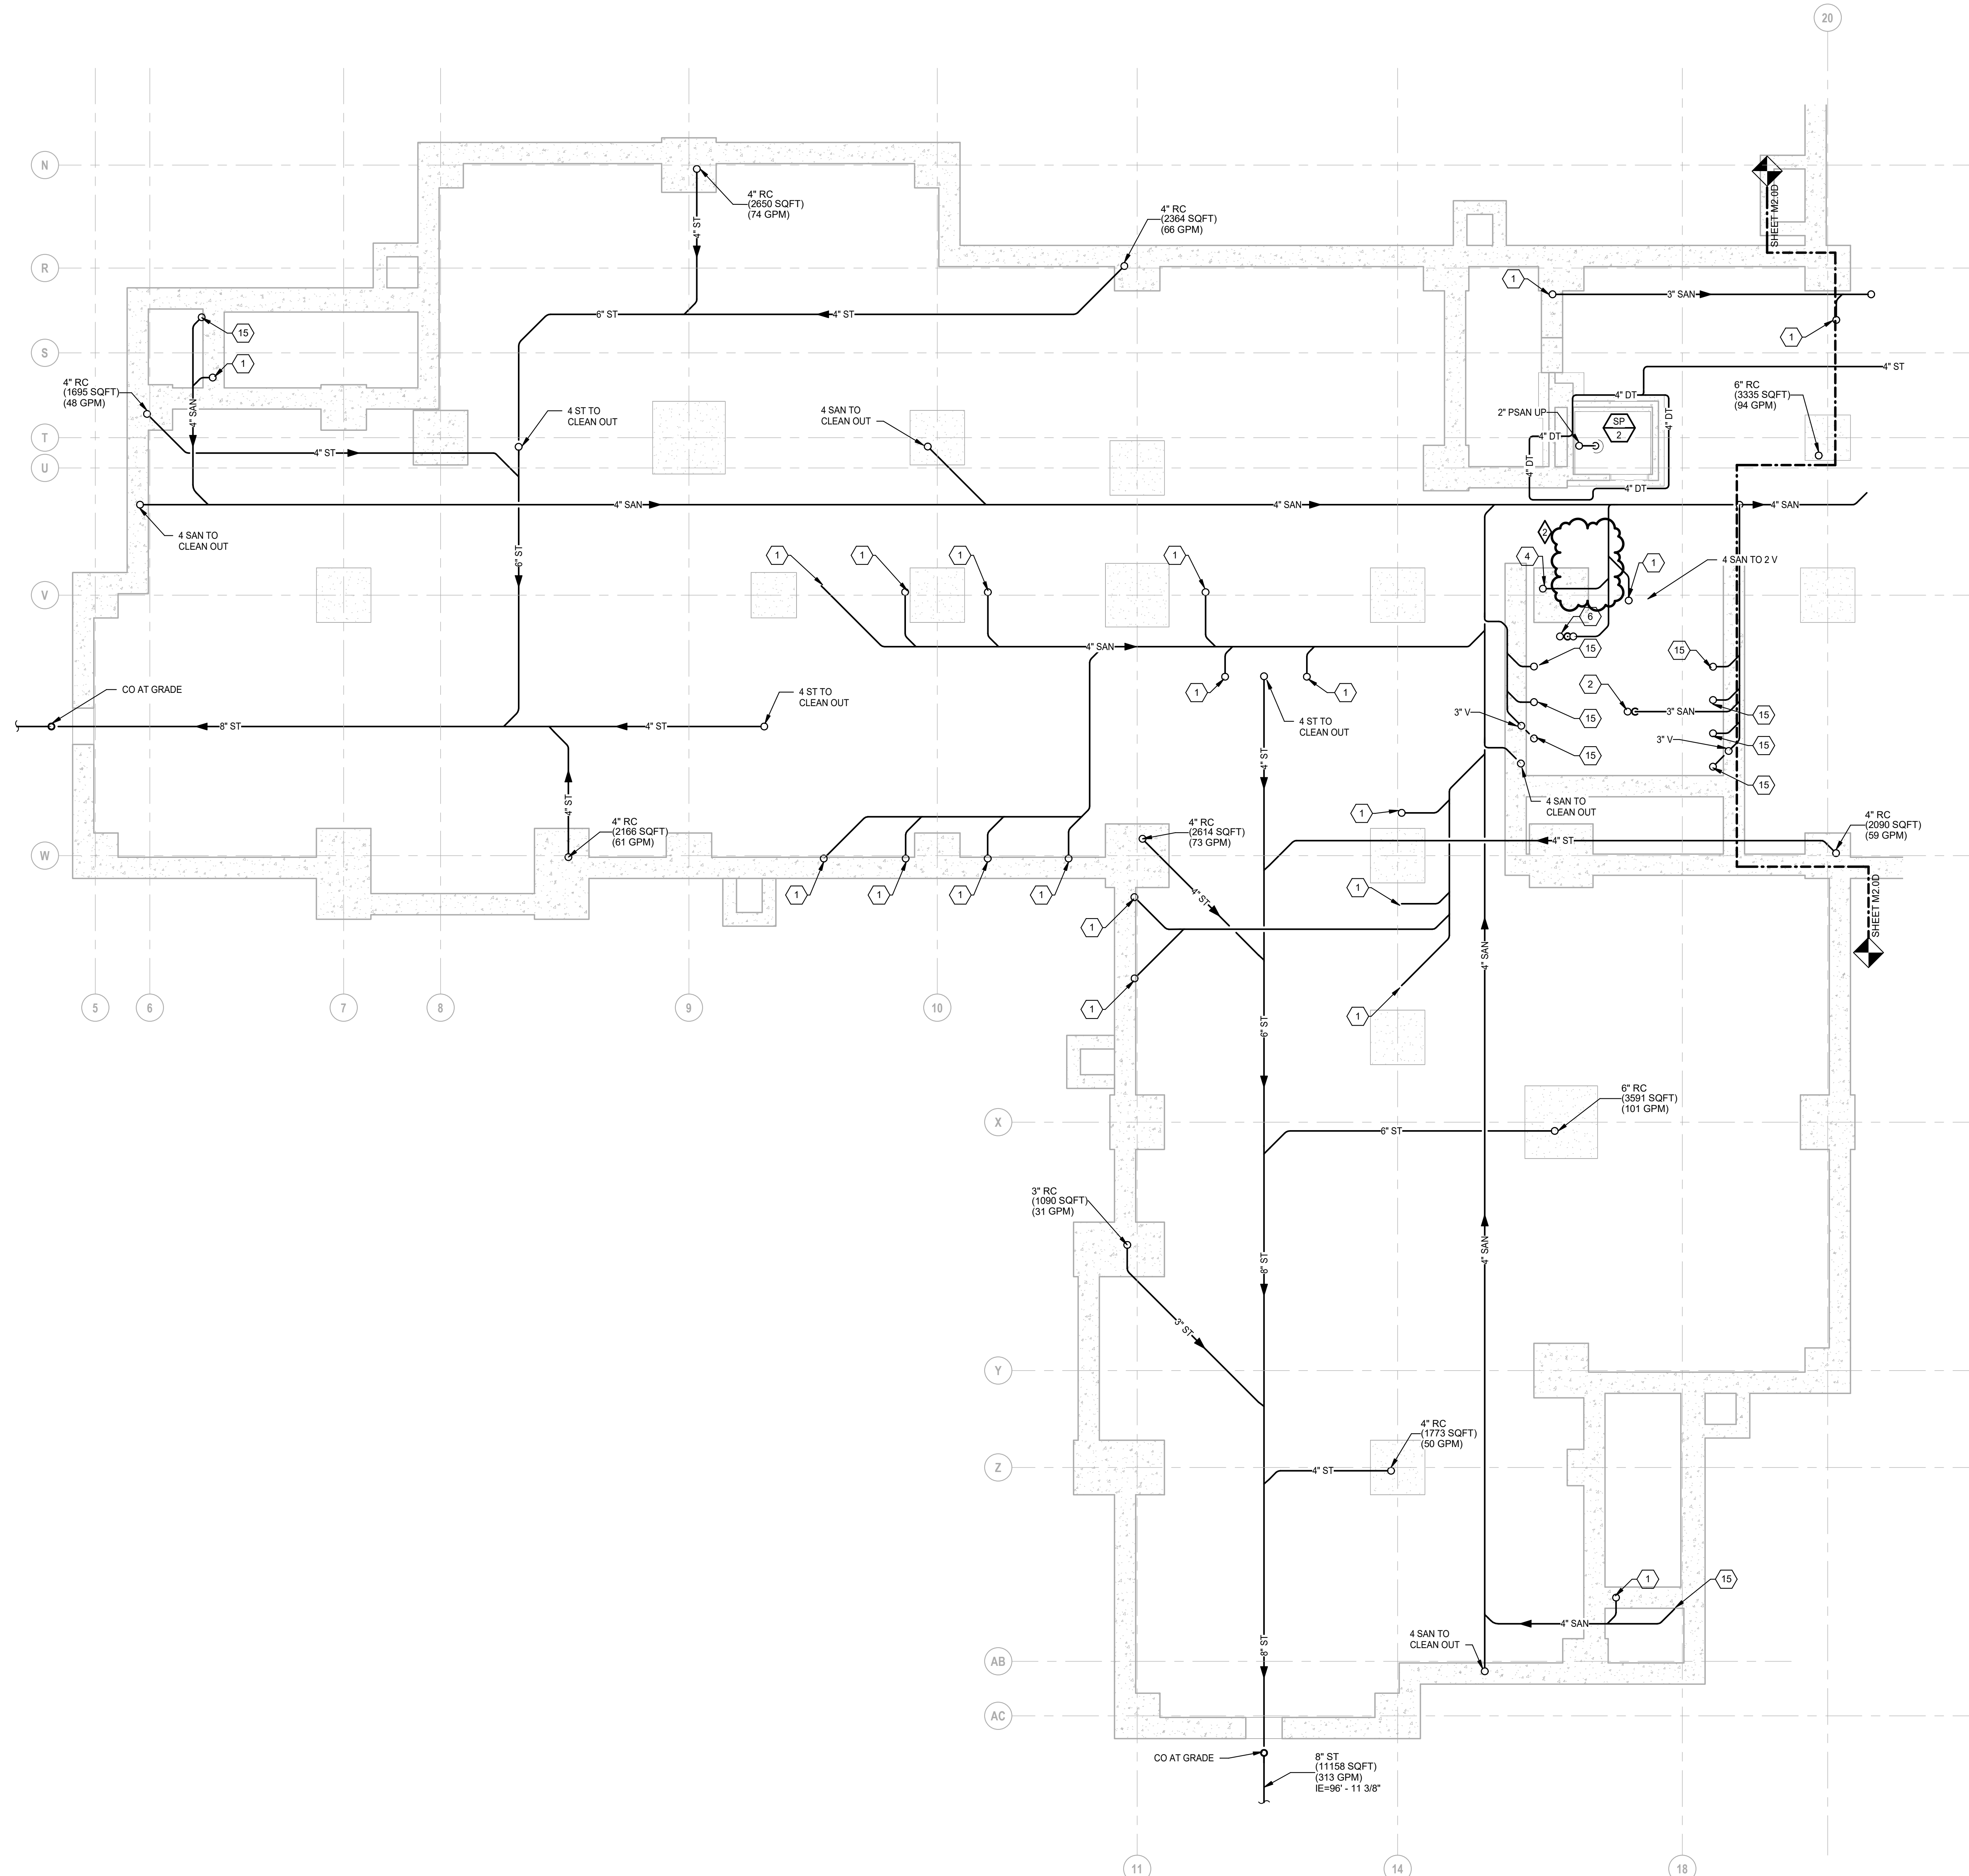

UNDERGROUND PLUMBING PLAN - ZONE 'E'
SCALE: 1/8" = 1'-0"

PLUMBING GENERAL NOTES:

- 1 THESE DRAWINGS ARE DIAGRAMMATIC, AND REPRESENT THE GENERAL INTENT AND ARRANGEMENT OF SYSTEMS. THEY ARE NOT TO BE CONSIDERED FABRICATION/COORDINATION/SHOP DRAWINGS. COORDINATION WITH OTHER TRADES IS REQUIRED. PROVIDE THE ADDITIONAL FITTINGS AND OFFSETS THAT WILL BE REQUIRED TO COMPLETE EACH SYSTEM AND TO AVOID INTERFERENCES WITH ALL OTHER SYSTEMS INCLUDING THE STRUCTURE, SHEET METAL, OTHER PIPING SYSTEMS, ELECTRICAL CONDUITS, BUS DUCTS, CABLE TRAY, LIGHT FIXTURES, ETC. AND/OR OTHER SPACE CONSTRAINTS.
- 2 INSTALL SYSTEMS SUCH THAT REQUIRED CLEARANCE AND SERVICE ACCESS SPACE IS PROVIDED AROUND ALL MECHANICAL AND ELECTRICAL EQUIPMENT, AND AROUND ANY COMPONENTS WHICH REQUIRE SERVICE ACCESS.
- 3 PIPING SHALL NOT BE INSTALLED ABOVE ELECTRICAL TRANSFORMERS, SWITCHBOARDS, PANELBOARDS OR MOTOR CONTROL CENTERS.
- 4 COORDINATE AND PROVIDE ACCESS DOORS WITHIN INACCESSIBLE CEILING SHAFT, AND CHASE AREAS FOR ALL COMPONENTS WHICH REQUIRE SERVICE ACCESS. REFER TO ARCHITECTURAL DRAWINGS FOR CEILING TYPES.
- 5 PROVIDE SUPPLEMENTARY STEEL AS REQUIRED FOR THE PROPER SUPPORT OF ALL SYSTEMS.
- 6 REFER TO ARCHITECTURAL PLANS FOR DIMENSIONED LOCATIONS OF PLUMBING FIXTURES.
- 7 HOT AND COLD WATER PIPING RUN-OUTS TO LAVATORIES AND SINKS SHALL BE 1/2" UNLESS OTHERWISE NOTED.
- 8 PLUMBING VENT PIPING THROUGH ROOF SHALL BE LOCATED A MINIMUM OF 10'-0" FROM ANY FRESH AIR INTAKE LOCATION AND A MINIMUM OF 18" CLEAR FROM THE INSIDE FACE OF PARAPET.
- 9 PROVIDE CODE REQUIRED CLEARANCE FOR ALL CLEANOUTS INSTALLED IN SANITARY WASTE AND VENT PIPING.
- 10 MINIMUM UNDERGROUND PIPE SIZE SHALL BE 3".
- 11 WATER SERVICE ENTRANCE PIPING SHALL BE BURIED WITH DEPTH OF COVER OVER TOP OF PIPE OF AT LEAST 4'-0" OR WITH TOP OF PIPE AT LEAST 12" BELOW LEVEL OF MAXIMUM FROST PENETRATION, OR AS REQUIRED BY AUTHORITIES HAVING JURISDICTION, WHICHEVER IS DEEPEST.

CONSTRUCTION KEY NOTES:

- 1 3 SAN TO SINK/LAV.
- 2 3 SAN TO FDF/S.
- 3 ROUTE 3/4 PUMPED CONDENSATE FROM HP-101 AND HP-102 TO CUSTODIAL A134 AND SPILL INTO SERVICE SINK.
- 4 3 SAN TO EWC.
- 5 3 SAN TO WASHING MACHINE OX BOX LOCATION.
- 6 3 SAN TO SS.
- 7 3 SAN TO SHOWER DRAIN.
- 8 ROUTE PSAN FROM SP-2 TO HUB OUTLET LOCATED IN CUSTODIAL E130.
- 9 ROUTE 1 1/2 CW & 1 1/2 HW UP TO SECOND FLOOR SINKS IN COLUMN SPACE PROVIDED.
- 10 2 SAN TO SINK/LAV.
- 11 3/4 CW TO ROOF MOUNTED HYDRANT. ROUTE HW TO CODE REQUIRED DISTANCE ABOVE FLOOR DRAIN/SINK.
- 12 EXTEND CW & HW TO MV-1 LOCATED UNDER SINK TO PROVIDE TEMPERED WATER TO EMERGENCY EYE WASH.
- 13 ROUTE GREASE SANITARY PIPING FROM THREE COMPARTMENT SINK TO GREASE INTERCEPTOR.
- 14 REFER TO NATURAL GAS DIAGRAM ON SHEET M6.4 FOR ROUTING AND SIZING SPECIFIC INFORMATION.
- 15 4 SAN FOR WC.
- 16 4 SAN FOR SANITARY CHASE.
- 17 ROUTE 1 1/2 IW FROM FSE PROVIDED FIXTURE AND TERMINATE TO CODE REQUIRED DISTANCE TO FLOOR SINK. COORDINATE FINAL PIPING SIZES WITH FSE DRAWINGS PRIOR TO CONSTRUCTION.
- 18 ROUTE PIPING IN CHASE TO FIXTURES. SEE PLUMBING FIXTURE CONNECTION SCHEDULE FOR SIZES TO FIXTURES.
- 19 ROUTE ADDITIONAL 3/4" CW LINE FOR CHEMICAL FEED SYSTEM.
- 20 ROUTE 3/4 CW AND 3/4 HW DOWN IN COLUMN. ROUTE 1/2 CW AND 1/2 HW TO EACH SINK. PIPING UNDER COUNTER SPACE TO CABINET MOUNTED SINK.
- 21 ROUTE 1/2 CW AND 1/2 HW DOWN IN COLUMN OR WALL SPACE. ROUTE 1/2 CW AND 1/2 HW TO SINK. PIPING UNDER COUNTER SPACE TO CABINET MOUNTED SINK.
- 22 ROUTE 1 CW AND 1 HW DOWN IN COLUMN. ROUTE 1/2 CW AND 1/2 HW TO EACH SINK. PIPING UNDER COUNTER SPACE TO CABINET MOUNTED SINK.
- 23 3 SAN TO UR.



TMP ARCHITECTURE INC
1191 WEST SQUARE LAKE ROAD - BOX 289
BLOOMFIELD HILLS - MICHIGAN - 48302
TEL: 248-338-6941 FAX: 248-338-0223
EM: INFO@TMP-ARCHITECTURE.COM

REGISTRATION SEAL

CONSULTANT




Peter Basso Associates Inc
CONSULTING ENGINEERS
5145 Livernois, Suite 100
Troy, Michigan 48068-3276
Tel: 248-879-5666
Fax: 248-879-9007
www.PeterBassoAssociates.com
PBA Project No. 2023.0154

PROJECT TITLE
NEW SMITH MIDDLE SCHOOL
Bid Package No. 03B

Troy School District
TROY, MI

DRAWING TITLE
UNDERGROUND PLUMBING PLAN - ZONE 'E'

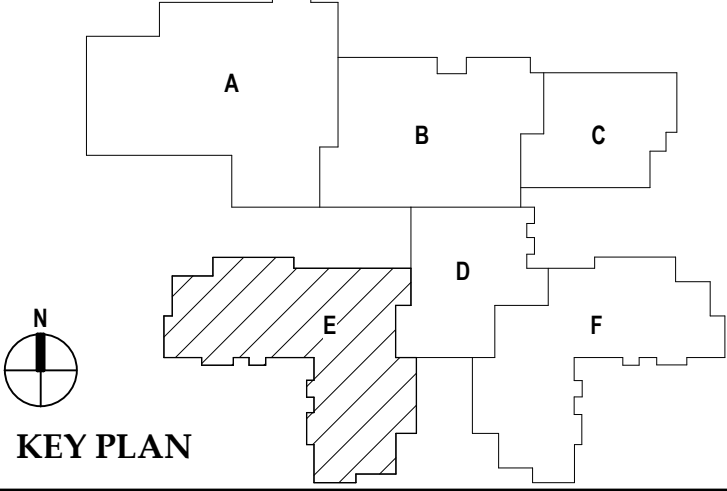

ISSUE DATES

07-12-2024	ADDENDUM #2
08-16-2024	CONSTRUCTION DOCUMENTS

DATE: ISSUED FOR:



DRAWN	MEP
CHECKED	KLH
APPROVED	SVM

PROJECT NO.
22102

DRAWING NO.
M2.0E

7/11/2024 4:03:19 PM Autodesk Docs://22102_Troy_Smith MS/2023-0154_TSD_Smith MS_MEP_v22.rvt

THE FOLLOWING DIMENSION EQUALS ONE INCH WHEN PRINTED TO SCALE.

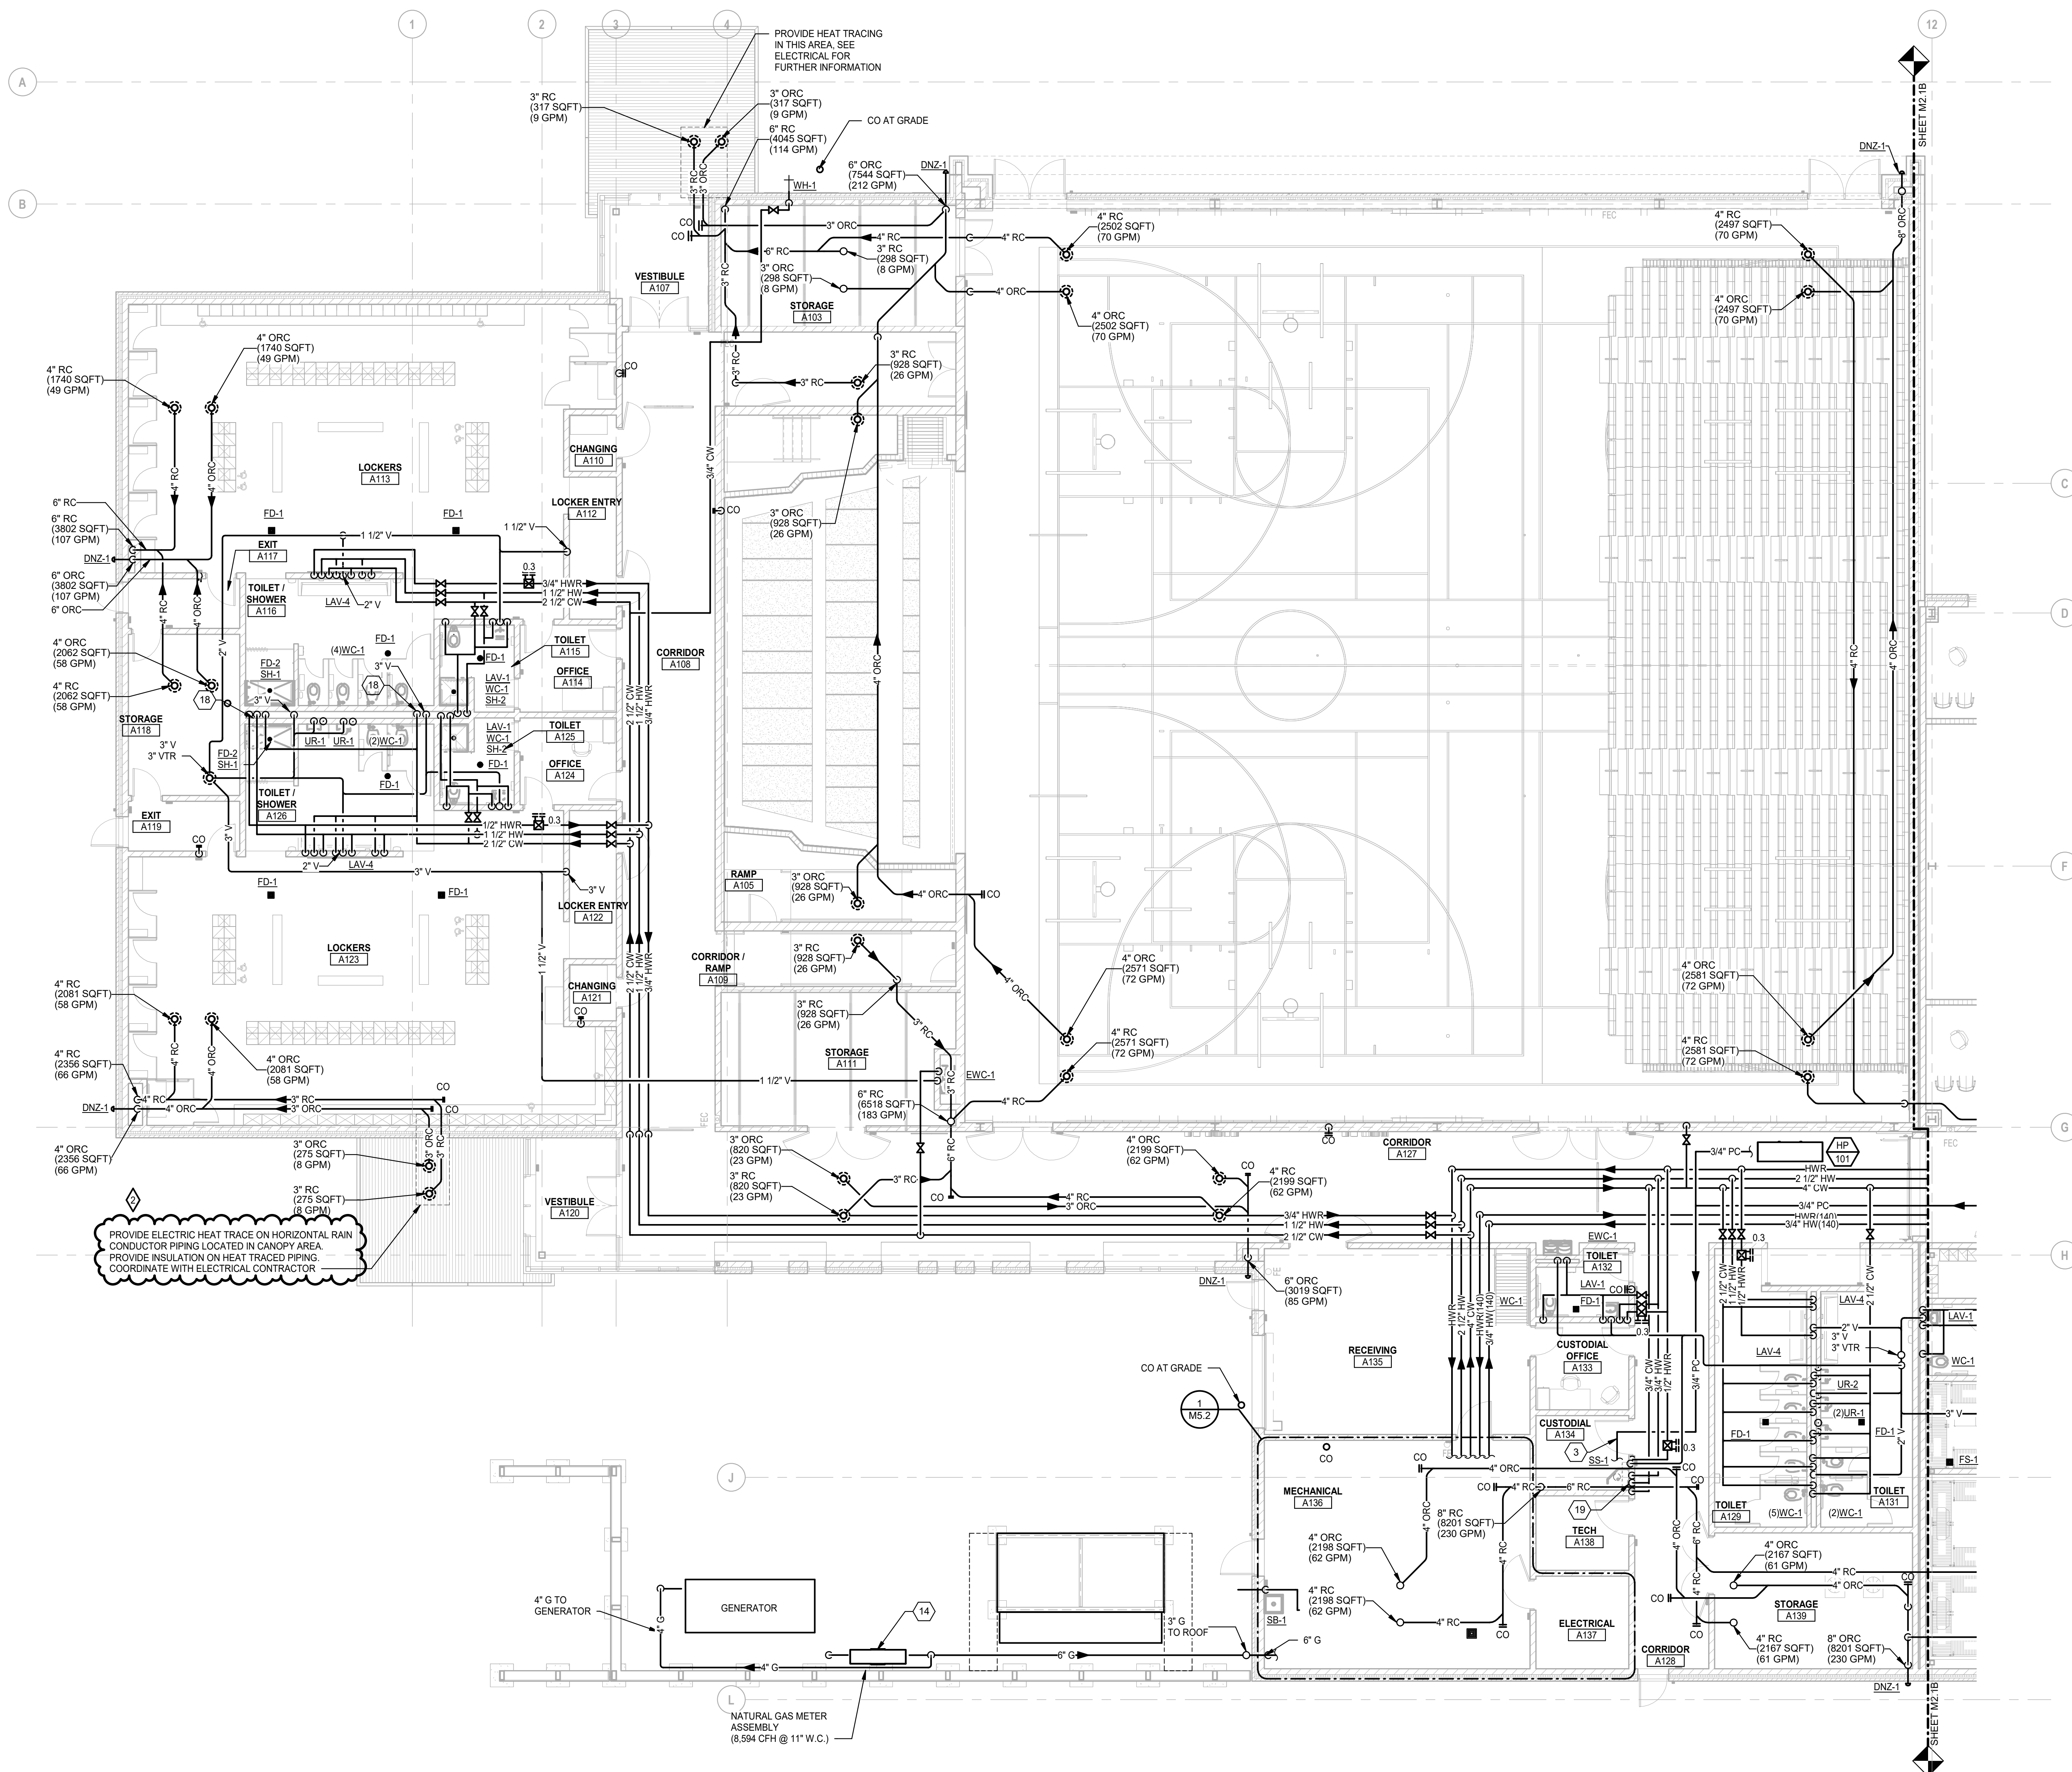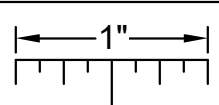

FIRST LEVEL PLUMBING PLAN - ZONE 'A'
SCALE: 1/8" = 1'-0"

PLUMBING GENERAL NOTES:

- THESE DRAWINGS ARE DIAGRAMMATIC AND REPRESENT THE GENERAL INTENT AND ARRANGEMENT OF SYSTEMS. THEY ARE NOT TO BE CONSIDERED FABRICATION OR INSTALLATION DRAWINGS. COORDINATION WITH OTHER TRADES IS REQUIRED. PROVIDE THE ADDITIONAL FITTINGS AND OFFSETS THAT WILL BE REQUIRED TO COMPLETE EACH SYSTEM AND TO AVOID INTERFERENCES WITH ALL OTHER SYSTEMS INCLUDING THE STRUCTURE, SHEET METAL, OTHER PIPING SYSTEMS, ELECTRICAL CONDUITS, BUS DUCTS, CABLE TRAY, LIGHT FIXTURES, ETC. AND/OR OTHER SPACE CONSTRAINTS.
- INSTALL SYSTEMS SUCH THAT REQUIRED CLEARANCE AND SERVICE ACCESS SPACE IS PROVIDED AROUND ALL MECHANICAL AND ELECTRICAL EQUIPMENT, AND AROUND ANY COMPONENTS WHICH REQUIRE SERVICE ACCESS.
- PIPING SHALL NOT BE INSTALLED ABOVE ELECTRICAL TRANSFORMERS, SWITCHBOARDS, PANELBOARDS OR MOTOR CONTROL CENTERS.
- COORDINATE AND PROVIDE ACCESS DOORS WITHIN INACCESSIBLE CEILING SHAFT, AND CHASE AREAS FOR ALL COMPONENTS WHICH REQUIRE SERVICE ACCESS. REFER TO ARCHITECTURAL DRAWINGS FOR CEILING TYPES.
- PROVIDE SUPPLEMENTARY STEEL AS REQUIRED FOR THE PROPER SUPPORT OF ALL SYSTEMS.
- REFER TO ARCHITECTURAL PLANS FOR DIMENSIONED LOCATIONS OF PLUMBING FIXTURES.
- HOT AND COLD WATER PIPING RUN-OUTS TO LAVATORIES AND SINKS SHALL BE 1/2" UNLESS OTHERWISE NOTED.
- PLUMBING VENT PIPING THROUGH ROOF SHALL BE LOCATED A MINIMUM OF 10'-0" FROM ANY FRESH AIR INTAKE LOCATION AND A MINIMUM OF 18" CLEAR FROM THE INSIDE FACE OF PARAPET.
- PROVIDE CODE REQUIRED CLEARANCE FOR ALL CLEANOUTS INSTALLED IN SANITARY WASTE AND VENT PIPING.
- MINIMUM UNDERGROUND PIPE SIZE SHALL BE 3".
- WATER SERVICE ENTRANCE PIPING SHALL BE BURIED WITH DEPTH OF COVER OVER TOP OF PIPE OF AT LEAST 4'-0" OR WITH TOP OF PIPE AT LEAST 12" BELOW LEVEL OF MAXIMUM FROST PENETRATION, OR AS REQUIRED BY AUTHORITIES HAVING JURISDICTION, WHICHEVER IS DEEPEST.

CONSTRUCTION KEY NOTES:

- 3 SAN TO SINKLAV.
- 3 SAN TO FDFIS.
- ROUTE 3/4" PUMPED CONDENSATE FROM HP-101 AND HP-102 TO CUSTODIAL A134 AND SPILL INTO SERVICE SINK.
- 3 SAN TO EWC.
- 3 SAN TO WASHING MACHINE OX BOX LOCATION.
- 3 SAN TO SS.
- 3 SAN TO SHOWER DRAIN.
- ROUTE PSAN FROM SP-2 TO HUB OUTLET LOCATED IN CUSTODIAL A130.
- ROUTE 1 1/2" CW & 1 1/2" HW UP TO SECOND FLOOR SINKS IN COLUMN SPACE PROVIDED.
- 2 SAN TO SINKLAV.
- 3/4" CW TO ROOF MOUNTED HYDRANT. ROUTE IW TO CODE REQUIRED DISTANCE ABOVE FLOOR DRAIN/SINK.
- EXTEND CW & HW TO MV-1 LOCATED UNDER SINK TO PROVIDE TEMPERED WATER TO EMERGENCY EYE WASH.
- ROUTE GREASE SANITARY PIPING FROM THREE COMPARTMENT SINK TO GREASE INTERCEPTOR.
- REFER TO NATURAL GAS DIAGRAM ON SHEET M6.4 FOR ROUTING AND SIZING SPECIFIC INFORMATION.
- 4 SAN FOR WC.
- 4 SAN FOR SANITARY CHASE.
- ROUTE 1 1/2" IW FROM FSE PROVIDED FIXTURE AND TERMINATE TO CODE REQUIRED DISTANCE TO FLOOR SINK. COORDINATE FINAL PIPING SIZES WITH FSE DRAWINGS PRIOR TO CONSTRUCTION.
- ROUTE PIPING IN CHASE TO FIXTURES. SEE PLUMBING FIXTURE CONNECTION SCHEDULE FOR SIZES TO FIXTURES.
- ROUTE ADDITIONAL 3/4" CW LINE FOR CHEMICAL FEED SYSTEM.
- ROUTE 3/4" CW AND 3/4" HW DOWN IN COLUMN. ROUTE 1/2" CW AND 1/2" HW TO EACH SINK. PIPING UNDER COUNTER SPACE TO CABINET MOUNTED SINK.
- ROUTE 1/2" CW AND 1/2" HW DOWN IN COLUMN OR WALL SPACE. ROUTE 1/2" CW AND 1/2" HW TO SINK. PIPING UNDER COUNTER SPACE TO CABINET MOUNTED SINK.
- ROUTE 3/4" CW AND 1" HW DOWN IN COLUMN. ROUTE 1/2" CW AND 1/2" HW TO EACH SINK. PIPING UNDER COUNTER SPACE TO CABINET MOUNTED SINK.
- 3 SAN TO UR.



TMP ARCHITECTURE INC
1191 WEST SQUARE LAKE ROAD - BOX 289
BLOOMFIELD HILLS - MICHIGAN - 48302
PH: 248.338.4661 FX: 248.338.0233
EM: INFO@TMP-ARCHITECTURE.COM

REGISTRATION SEAL

CONSULTANT




Peter Basso Associates Inc
CONSULTING ENGINEERS
5145 Livernois, Suite 100
Troy, Michigan 48068-3276
Tel: 248-879-5666
Fax: 248-879-0007
www.PeterBassoAssociates.com
PBA Project No.: 2023.0154

PROJECT TITLE
NEW SMITH MIDDLE SCHOOL
Bid Package No. 03B

Troy School District TROY, MI

DRAWING TITLE
FIRST LEVEL PLUMBING PLAN - ZONE 'A'

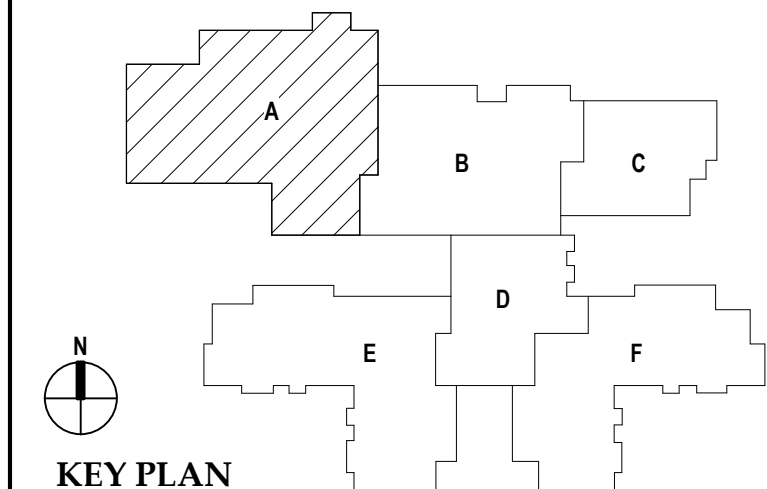

ISSUE DATES


DATE	ISSUED FOR:

DATE	ISSUED FOR:
07-12-2024	ADDENDUM #2
08-16-2024	CONSTRUCTION DOCUMENTS

DATE	ISSUED FOR:

PROJECT NO.
22102
DRAWING NO.
M2.1A

THE FOLLOWING DIMENSION EQUALS ONE INCH WHEN PRINTED TO SCALE.

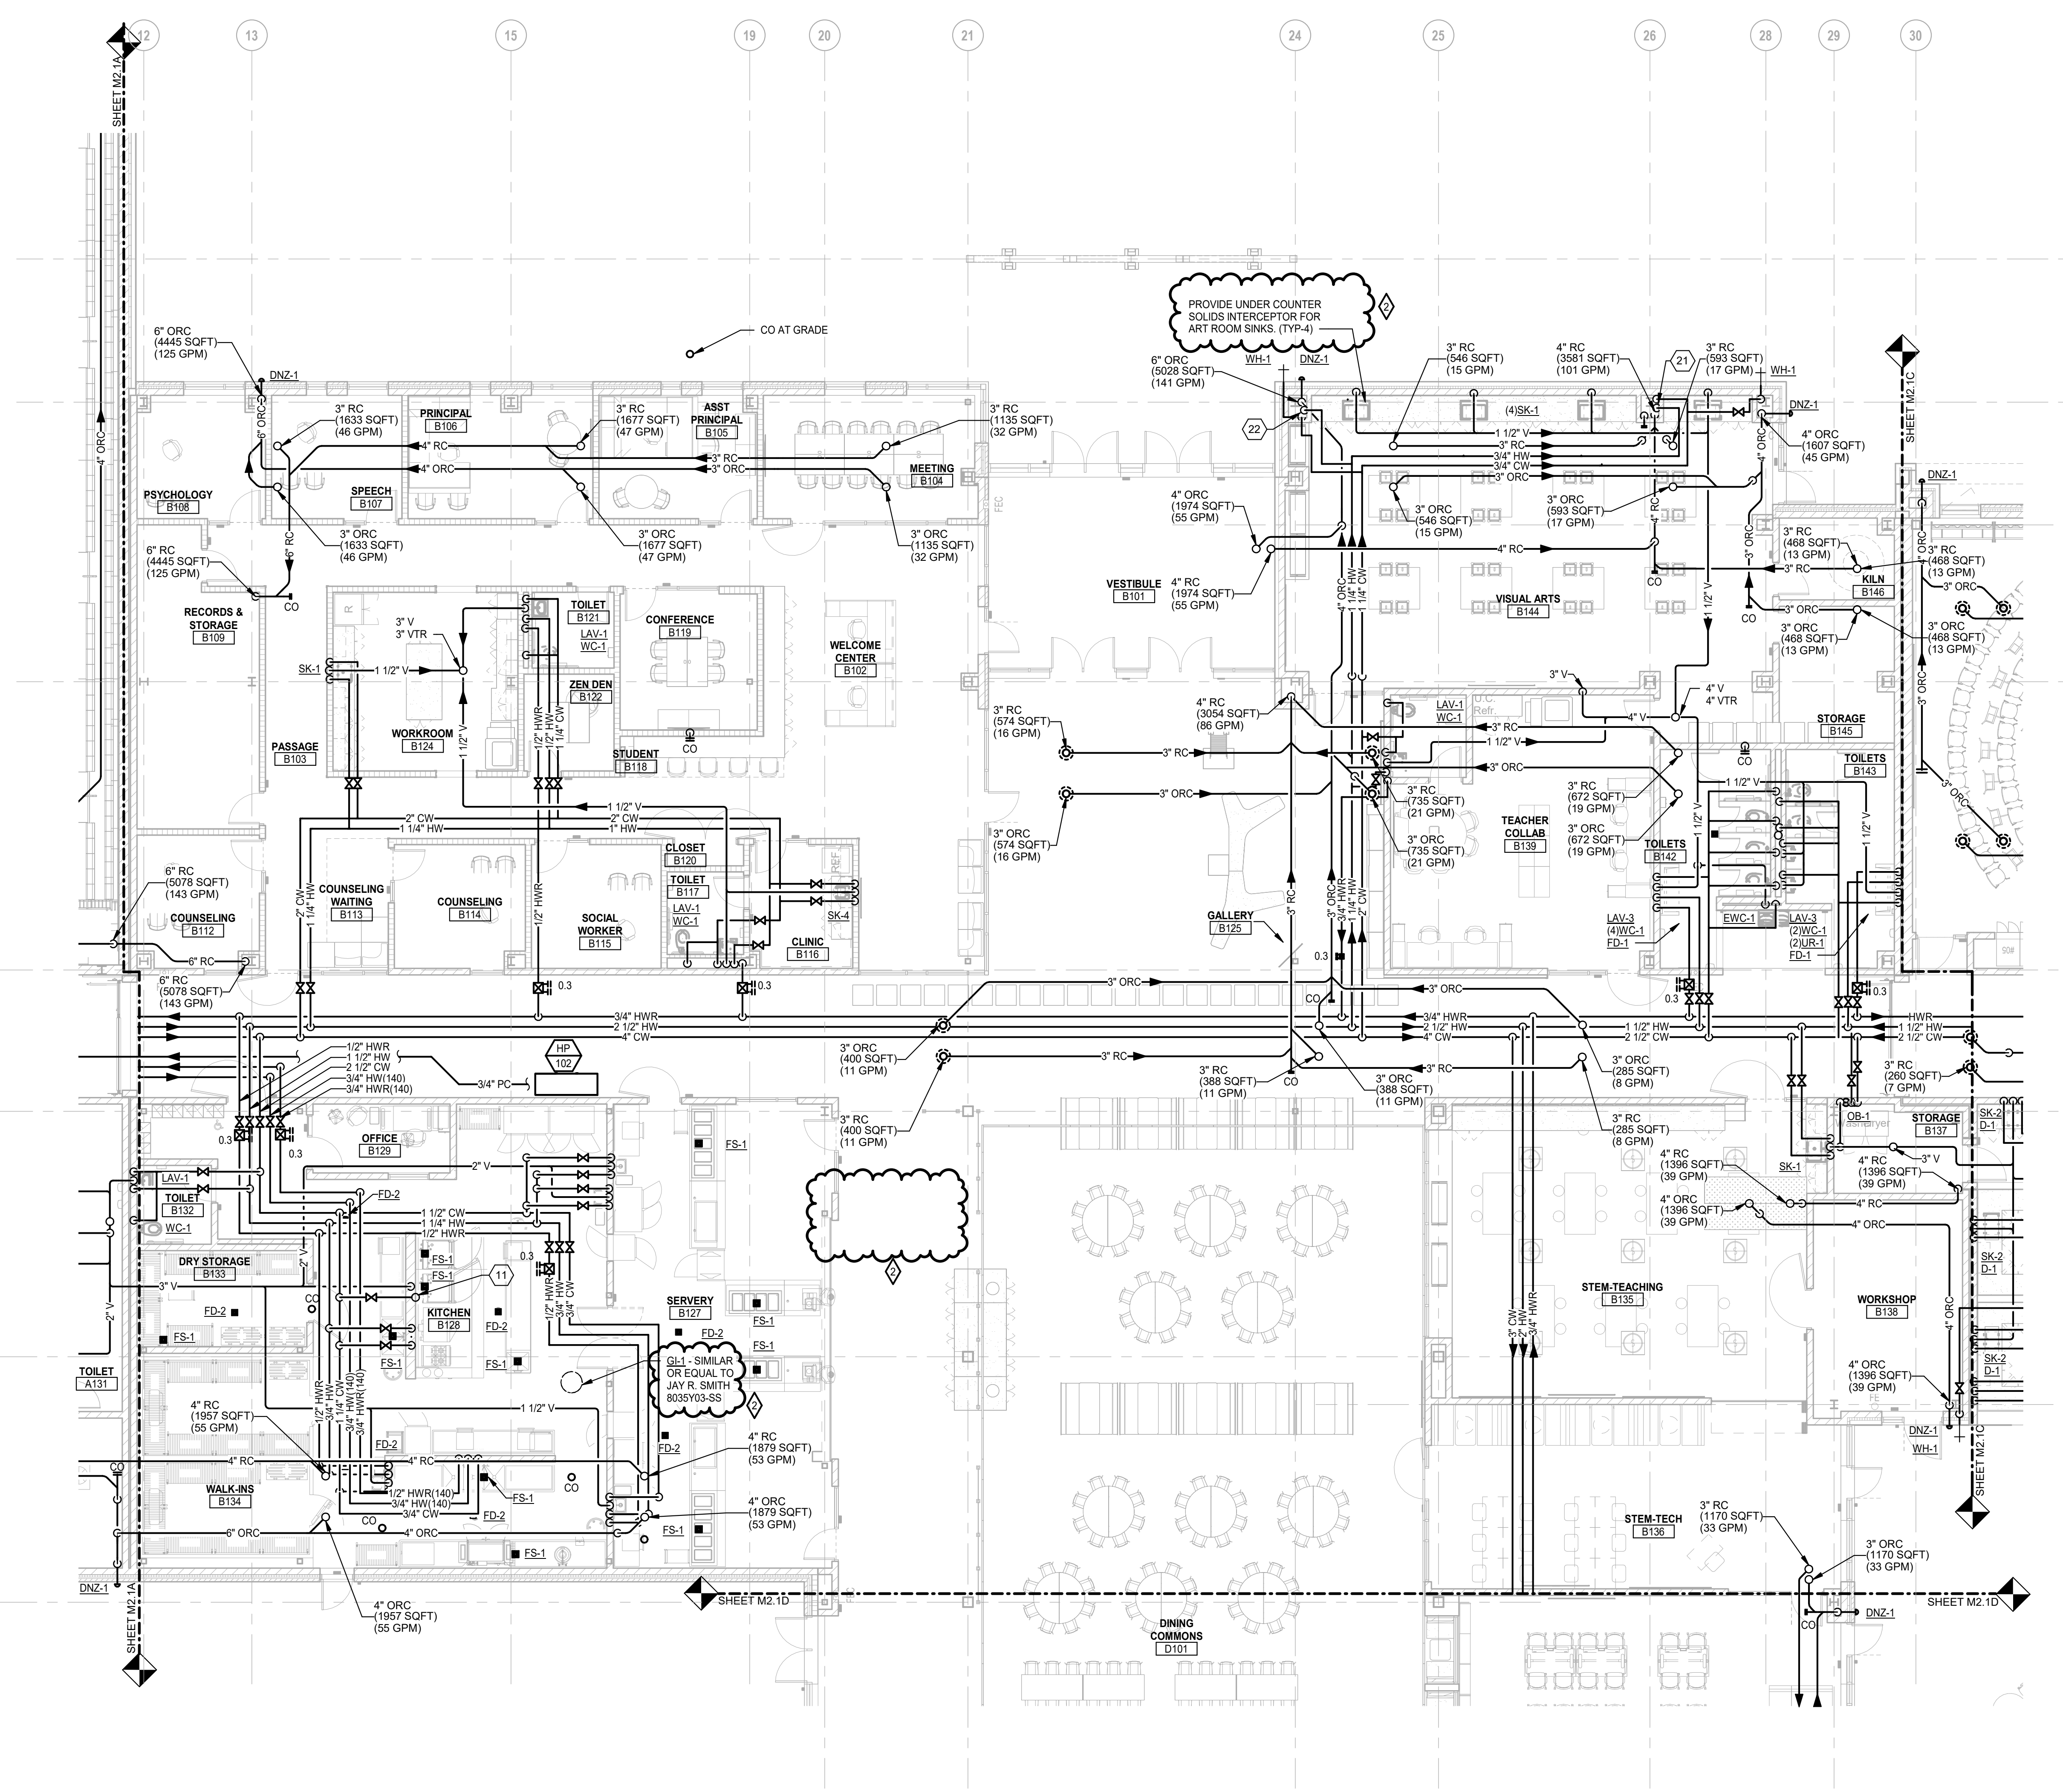

PLUMBING GENERAL NOTES:

- THESE DRAWINGS ARE DIAGRAMMATIC, AND REPRESENT THE GENERAL INTENT AND ARRANGEMENT OF SYSTEMS. THEY ARE NOT TO BE CONSIDERED FABRICATION/COORDINATION/SHOP DRAWINGS. COORDINATION WITH OTHER TRADES IS REQUIRED. PROVIDE THE ADDITIONAL FITTINGS AND OFFSETS THAT WILL BE REQUIRED TO COMPLETE EACH SYSTEM AND TO AVOID INTERFERENCES WITH ALL OTHER SYSTEMS INCLUDING THE STRUCTURE, SHEET METAL, OTHER PIPING SYSTEMS, ELECTRICAL CONDUITS, BUS DUCTS, CABLE TRAY, LIGHT FIXTURES, ETC. AND/OR OTHER SPACE CONSTRAINTS.
- INSTALL SYSTEMS SUCH THAT REQUIRED CLEARANCE AND SERVICE ACCESS SPACE IS PROVIDED AROUND ALL MECHANICAL AND ELECTRICAL EQUIPMENT, AND AROUND ANY COMPONENTS WHICH REQUIRE SERVICE ACCESS.
- PIPING SHALL NOT BE INSTALLED ABOVE ELECTRICAL TRANSFORMERS, SWITCHBOARDS, PANELBOARDS OR MOTOR CONTROL CENTERS.
- COORDINATE AND PROVIDE ACCESS DOORS WITHIN UNACCESSIBLE CEILING SHAFT, AND CHASE AREAS FOR ALL COMPONENTS WHICH REQUIRE SERVICE ACCESS. REFER TO ARCHITECTURAL DRAWINGS FOR CEILING TYPES.
- PROVIDE SUPPLEMENTARY STEEL AS REQUIRED FOR THE PROPER SUPPORT OF ALL SYSTEMS.
- REFER TO ARCHITECTURAL PLANS FOR DIMENSIONED LOCATIONS OF PLUMBING FIXTURES.
- HOT AND COLD WATER PIPING RUN-OUTS TO LAVATORIES AND SINKS SHALL BE 1/2" UNLESS OTHERWISE NOTED.
- PLUMBING VENT PIPING THROUGH ROOF SHALL BE LOCATED A MINIMUM OF 10'-0" FROM ANY FRESH AIR INTAKE LOCATION AND A MINIMUM OF 18" CLEAR FROM THE INSIDE FACE OF PARAPET.
- PROVIDE CODE REQUIRED CLEARANCE FOR ALL CLEANOUTS INSTALLED IN SANITARY WASTE AND VENT PIPING.
- MINIMUM UNDERGROUND PIPE SIZE SHALL BE 3".
- WATER SERVICE ENTRANCE PIPING SHALL BE BURIED WITH DEPTH OF COVER OVER TOP OF PIPE OF AT LEAST 4'-0" OR WITH TOP OF PIPE AT LEAST 12" BELOW LEVEL OF MAXIMUM FROST PENETRATION, OR AS REQUIRED BY AUTHORITIES HAVING JURISDICTION, WHICHEVER IS DEEPEST.

CONSTRUCTION KEY NOTES:

- 3 SAN TO SINKLAV.
- 3 SAN TO FDFIS.
- ROUTE 3/4 PUMPED CONDENSATE FROM HP-101 AND HP-102 TO CUSTODIAL A134 AND SPILL INTO SERVICE SINK.
- 3 SAN TO EWC.
- 3 SAN TO WASHING MACHINE OX BOX LOCATION.
- 3 SAN TO SS.
- 3 SAN TO SHOWER DRAIN.
- ROUTE PSAN FROM SP-2 TO HUB OUTLET LOCATED IN CUSTODIAL B130.
- ROUTE 1 1/2 CW & 1 1/2 HW UP TO SECOND FLOOR SINKS IN COLUMN SPACE PROVIDED.
- 2 SAN TO SINKLAV.
- 3/4 CW TO ROOF MOUNTED HYDRANT. ROUTE IW TO CODE REQUIRED DISTANCE ABOVE FLOOR DRAIN/SINK.
- EXTEND CW & HW TO MV-1 LOCATED UNDER SINK TO PROVIDE TEMPERED WATER TO EMERGENCY EYE WASH.
- ROUTE GREASE SANITARY PIPING FROM THREE COMPARTMENT SINK TO GREASE INTERCEPTOR.
- REFER TO NATURAL GAS DIAGRAM ON SHEET M6.4 FOR ROUTING AND SIZING SPECIFIC INFORMATION.
- 4 SAN FOR WC.
- 4 SAN FOR SANITARY CHASE.
- ROUTE 1 1/2 IW FROM FSE PROVIDED FIXTURE AND TERMINATE TO CODE REQUIRED DISTANCE TO FLOOR SINK. COORDINATE FINAL PIPING SIZES WITH FSE DRAWINGS PRIOR TO CONSTRUCTION.
- ROUTE PIPING IN CHASE TO FIXTURES. SEE PLUMBING FIXTURE CONNECTION SCHEDULE FOR SIZES TO FIXTURES.
- ROUTE ADDITIONAL 3/4" CW LINE FOR CHEMICAL FEED SYSTEM.
- ROUTE 3/4 CW AND 3/4 HW DOWN IN COLUMN. ROUTE 1/2 CW AND 1/2 HW TO EACH SINK. PIPING UNDER COUNTER SPACE TO CABINET MOUNTED SINK.
- ROUTE 1/2 CW AND 1/2 HW DOWN IN COLUMN OR WALL SPACE. ROUTE 1/2 CW AND 1/2 HW TO SINK. PIPING UNDER COUNTER SPACE TO CABINET MOUNTED SINK.
- ROUTE 1 CW AND 1 HW DOWN IN COLUMN. ROUTE 1/2 CW AND 1/2 HW TO EACH SINK. PIPING UNDER COUNTER SPACE TO CABINET MOUNTED SINK.
- 3 SAN TO UR.

FIRST LEVEL PLUMBING PLAN - ZONE 'B'
SCALE: 1/8" = 1'-0"



TMP ARCHITECTURE INC
1191 WEST SQUARE LAKE ROAD - BOX 289
BLOOMFIELD HILLS - MICHIGAN 48302
PH: 248-338-8661 FX: 248-338-0223
EM: INFO@TMP-ARCHITECTURE.COM

REGISTRATION SEAL


CONSULTANT



PROJECT TITLE
**NEW SMITH
MIDDLE SCHOOL**
Bid Package No. 03B

Troy School District
TROY, MI

DRAWING TITLE
**FIRST LEVEL PLUMBING PLAN
- ZONE 'B'**

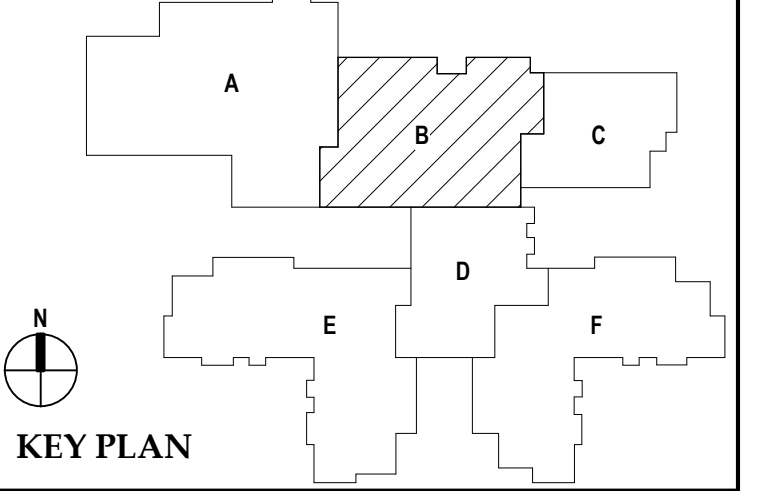

ISSUE DATES



07-12-2024 ADDENDUM #2
08-16-2024 CONSTRUCTION DOCUMENTS

DATE: ISSUED FOR:

DRAWN: MEP
CHECKED: KLH
APPROVED: SVM

PROJECT NO.
22102
DRAWING NO.
M2.1B

THE FOLLOWING DIMENSION EQUALS ONE INCH WHEN PRINTED TO SCALE.

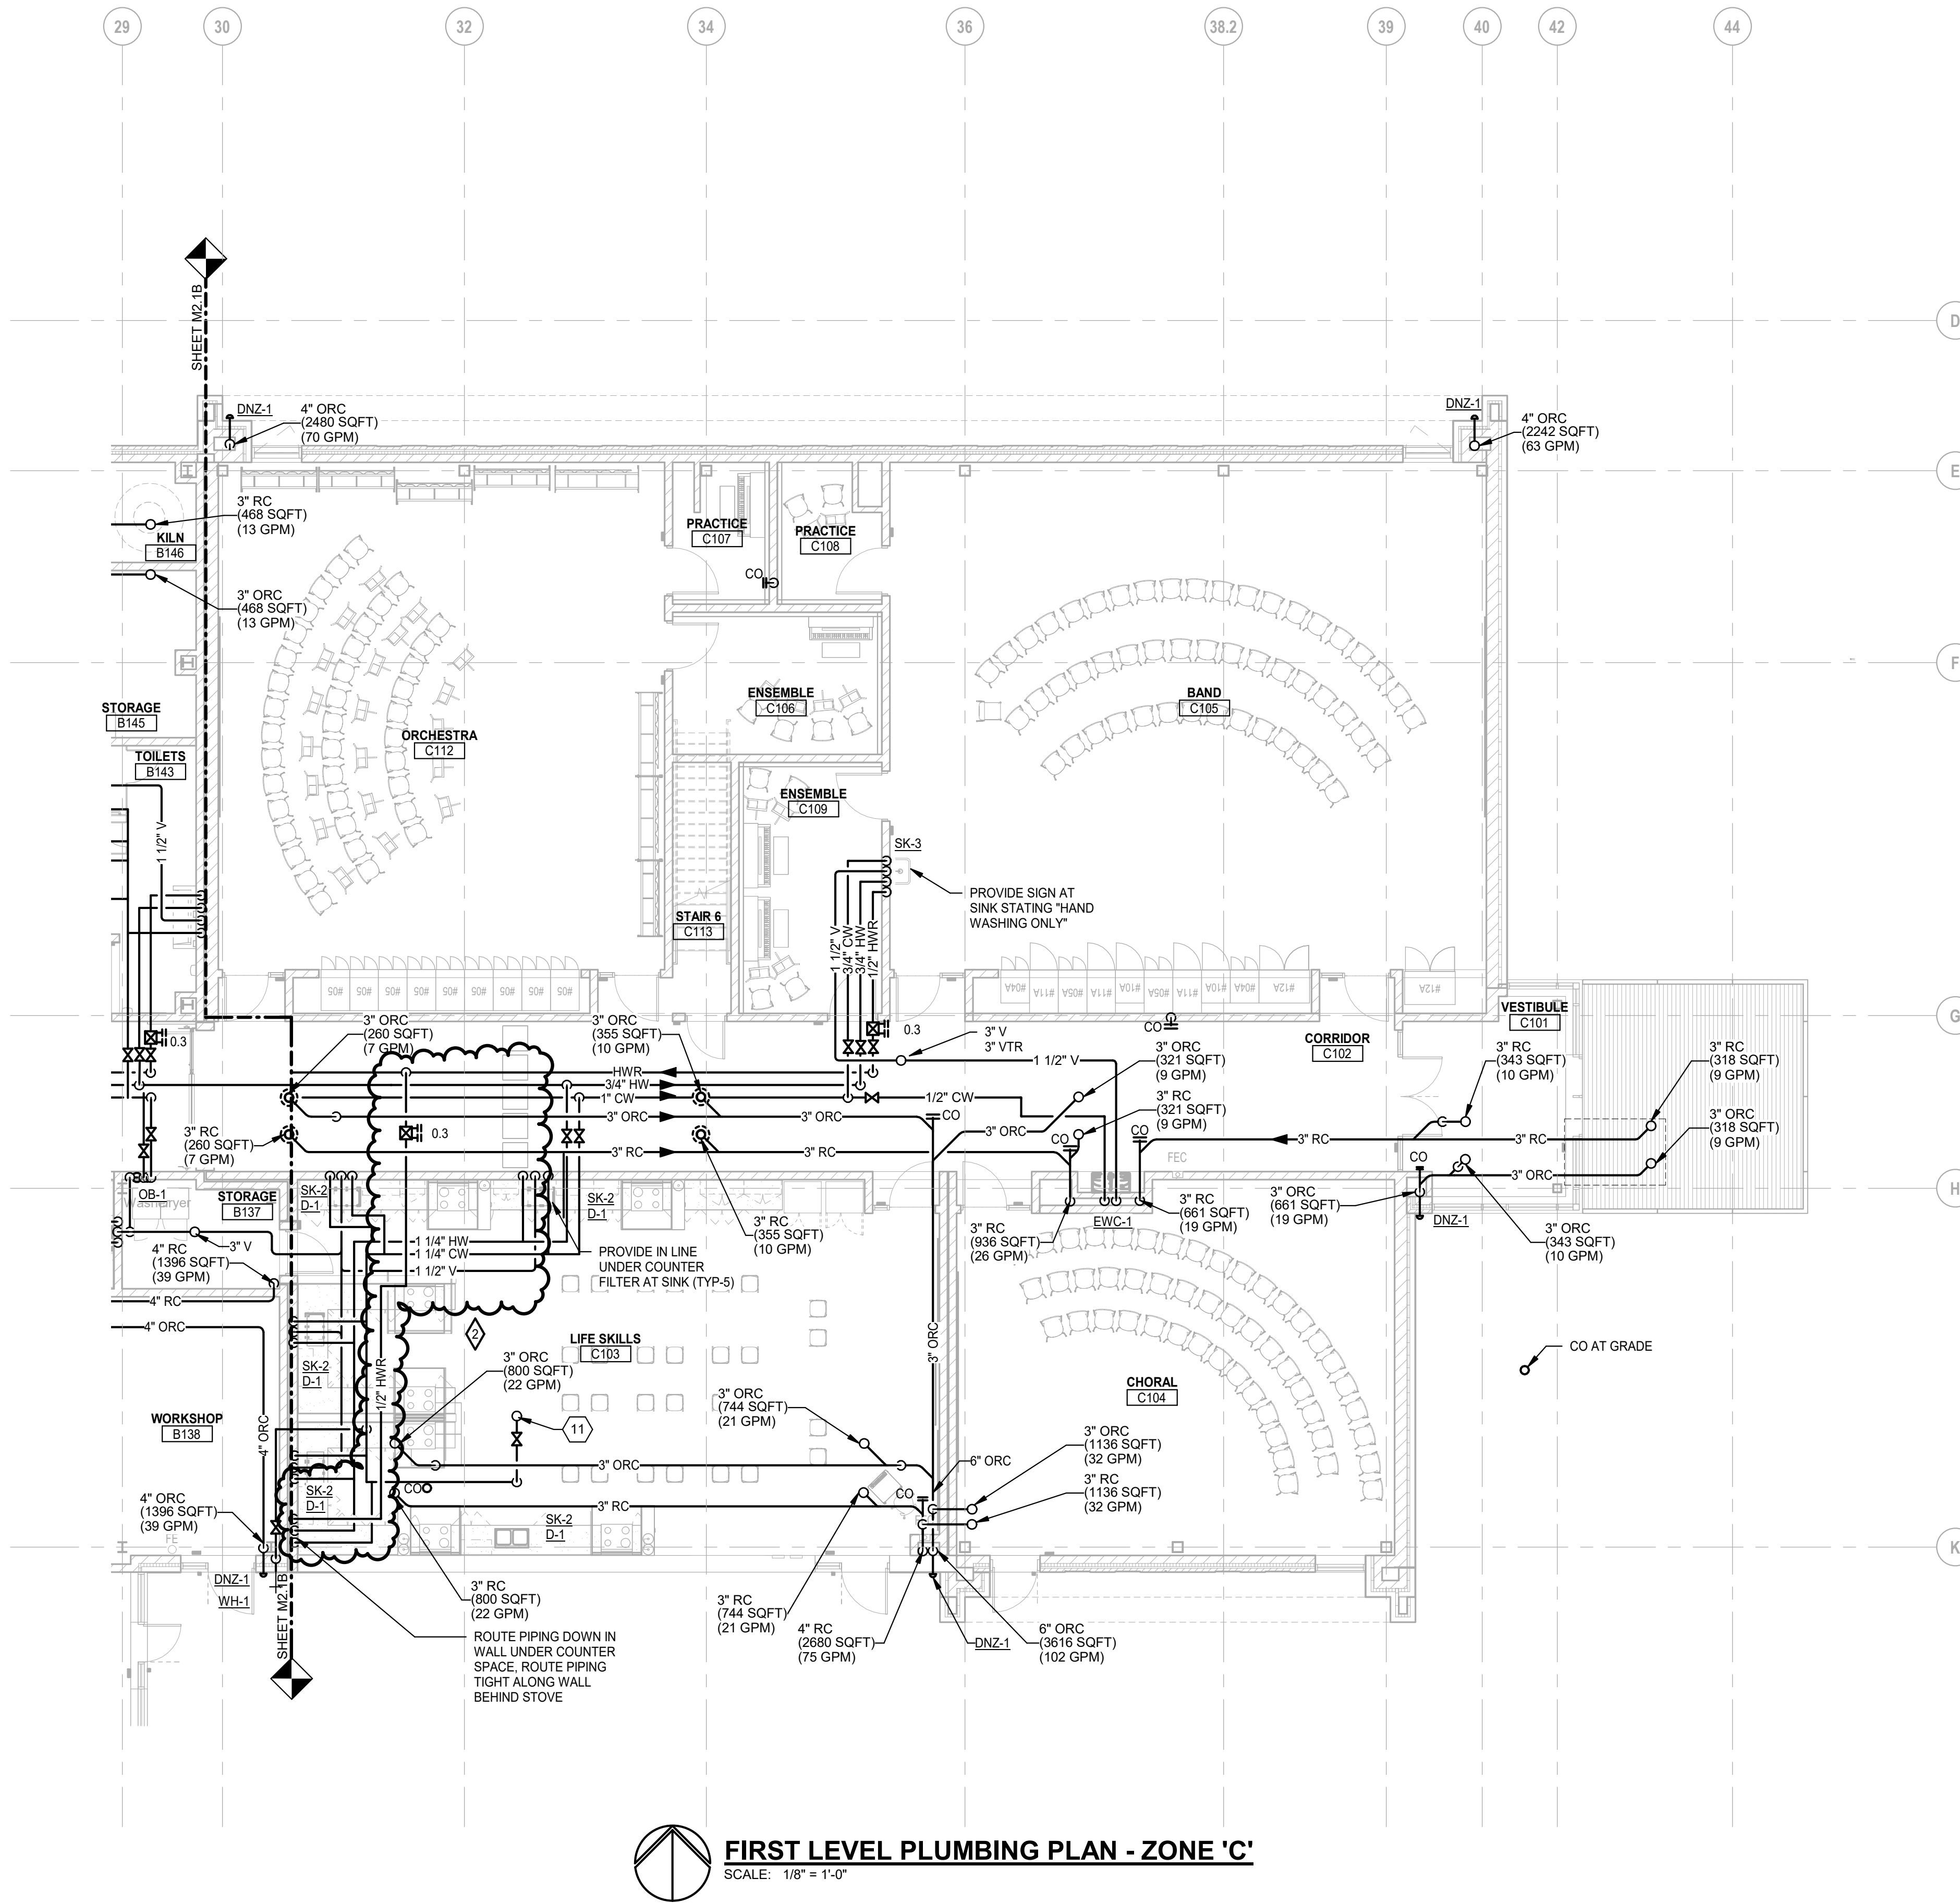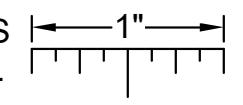

PLUMBING GENERAL NOTES:

- 1 THESE DRAWINGS ARE DIAGRAMMATIC, AND REPRESENT THE GENERAL INTENT AND ARRANGEMENT OF SYSTEMS. THEY ARE NOT TO BE CONSIDERED FABRICATION/COORDINATION/SHOP DRAWINGS. COORDINATION WITH OTHER TRADES IS REQUIRED. PROVIDE THE ADDITIONAL FITTINGS AND OFFSETS THAT WILL BE REQUIRED TO COMPLETE EACH SYSTEM AND TO AVOID INTERFERENCES WITH ALL OTHER SYSTEMS INCLUDING THE STRUCTURE, SHEET METAL, OTHER PIPING SYSTEMS, ELECTRICAL CONDUITS, BUS DUCTS, CABLE TRAY, LIGHT FIXTURES, ETC. AND/OR OTHER SPACE CONSTRAINTS.
- 2 INSTALL SYSTEMS SUCH THAT REQUIRED CLEARANCE AND SERVICE ACCESS SPACE IS PROVIDED AROUND ALL MECHANICAL AND ELECTRICAL EQUIPMENT, AND AROUND ANY COMPONENTS WHICH REQUIRE SERVICE ACCESS.
- 3 PIPING SHALL NOT BE INSTALLED ABOVE ELECTRICAL TRANSFORMERS, SWITCHBOARDS, PANELBOARDS OR MOTOR CONTROL CENTERS.
- 4 COORDINATE AND PROVIDE ACCESS DOORS WITHIN INACCESSIBLE CEILING SHAFT, AND CHASE AREAS FOR ALL COMPONENTS WHICH REQUIRE SERVICE ACCESS. REFER TO ARCHITECTURAL DRAWINGS FOR CEILING TYPES.
- 5 PROVIDE SUPPLEMENTARY STEEL AS REQUIRED FOR THE PROPER SUPPORT OF ALL SYSTEMS.
- 6 REFER TO ARCHITECTURAL PLANS FOR DIMENSIONED LOCATIONS OF PLUMBING FIXTURES.
- 7 HOT AND COLD WATER PIPING RUN-OUTS TO LAVATORIES AND SINKS SHALL BE 1/2" UNLESS OTHERWISE NOTED.
- 8 PLUMBING VENT PIPING THROUGH ROOF SHALL BE LOCATED A MINIMUM OF 10'-0" FROM ANY FRESH AIR INTAKE LOCATION AND A MINIMUM OF 18" CLEAR FROM THE INSIDE FACE OF PARAPET.
- 9 PROVIDE CODE REQUIRED CLEARANCE FOR ALL CLEANOUTS INSTALLED IN SANITARY WASTE AND VENT PIPING.
- 10 MINIMUM UNDERGROUND PIPE SIZE SHALL BE 3".
- 11 WATER SERVICE ENTRANCE PIPING SHALL BE BURIED WITH DEPTH OF COVER OVER TOP OF PIPE OF AT LEAST 4'-0" OR WITH TOP OF PIPE AT LEAST 12" BELOW LEVEL OF MAXIMUM FROST PENETRATION, OR AS REQUIRED BY AUTHORITIES HAVING JURISDICTION, WHICHEVER IS DEEPEST.

CONSTRUCTION KEY NOTES:

- 1 3 SAN TO SINKLAV.
- 2 3 SAN TO FDFIS.
- 3 ROUTE 3/4 PUMPED CONDENSATE FROM HP-101 AND HP-102 TO CUSTODIAL A134 AND SPILL INTO SERVICE SINK.
- 4 3 SAN TO EWC.
- 5 3 SAN TO WASHING MACHINE OX BOX LOCATION.
- 6 3 SAN TO SS.
- 7 3 SAN TO SHOWER DRAIN.
- 8 ROUTE PSAN FROM SP-2 TO HUB OUTLET LOCATED IN CUSTODIAL E130.
- 9 ROUTE 1 1/2 CW & 1 1/2 HW UP TO SECOND FLOOR SINKS IN COLUMN SPACE PROVIDED.
- 10 2 SAN TO SINKLAV.
- 11 3/4 CW TO ROOF MOUNTED HYDRANT. ROUTE HW TO CODE REQUIRED DISTANCE ABOVE FLOOR DRAIN/SINK.
- 12 EXTEND CW & HW TO MV-1 LOCATED UNDER SINK TO PROVIDE TEMPERED WATER TO EMERGENCY EYE WASH.
- 13 ROUTE GREASE SANITARY PIPING FROM THREE COMPARTMENT SINK TO GREASE INTERCEPTOR.
- 14 REFER TO NATURAL GAS DIAGRAM ON SHEET M6.4 FOR ROUTING AND SIZING SPECIFIC INFORMATION.
- 15 4 SAN FOR WC.
- 16 4 SAN FOR SANITARY CHASE.
- 17 ROUTE 1 1/2 IW FROM FSE PROVIDED FIXTURE AND TERMINATE TO CODE REQUIRED DISTANCE TO FLOOR SINK. COORDINATE FINAL PIPING SIZES WITH FSE DRAWINGS PRIOR TO CONSTRUCTION.
- 18 ROUTE PIPING IN CHASE TO FIXTURES. SEE PLUMBING FIXTURE CONNECTION SCHEDULE FOR SIZES TO FIXTURES.
- 19 ROUTE ADDITIONAL 3/4" CW LINE FOR CHEMICAL FEED SYSTEM.
- 20 ROUTE 3/4 CW AND 3/4 HW DOWN IN COLUMN. ROUTE 1/2 CW AND 1/2 HW TO EACH SINK. PIPING UNDER COUNTER SPACE TO CABINET MOUNTED SINK.
- 21 ROUTE 1/2 CW AND 1/2 HW DOWN IN COLUMN OR WALL SPACE. ROUTE 1/2 CW AND 1/2 HW TO SINK. PIPING UNDER COUNTER SPACE TO CABINET MOUNTED SINK.
- 22 ROUTE 1 CW AND 1 HW DOWN IN COLUMN. ROUTE 1/2 CW AND 1/2 HW TO EACH SINK. PIPING UNDER COUNTER SPACE TO CABINET MOUNTED SINK.
- 23 3 SAN TO UR.



TMP ARCHITECTURE INC
1191 WEST SQUARE LAKE ROAD - BOX 289
BLOOMFIELD HILLS - MICHIGAN - 48302
TEL: 248.338.6941 FAX: 248.338.0223
EM: INFO@TMP-ARCHITECTURE.COM

REGISTRATION SEAL

CONSULTANT




Peter Basso Associates Inc
CONSULTING ENGINEERS
5145 Livernois, Suite 100
Troy, Michigan 48068-3276
Tel: 248-879-5566
Fax: 248-879-0007
www.PeterBassoAssociates.com
PBA Project No. 2023.0154

PROJECT TITLE
NEW SMITH MIDDLE SCHOOL
Bid Package No. 03B

Troy School District
TROY, MI

DRAWING TITLE
FIRST LEVEL PLUMBING PLAN - ZONE 'C'

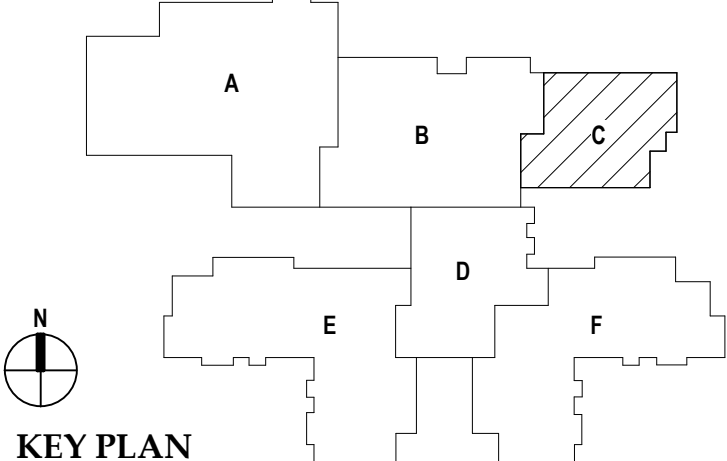

ISSUE DATES


07-12-2024	ADDENDUM #2
06-16-2024	CONSTRUCTION DOCUMENTS

DATE: ISSUED FOR:

DRAWN	MEP
CHECKED	KLH
APPROVED	SVM

PROJECT NO.
22102
DRAWING NO.
M2.1C

THE FOLLOWING DIMENSION EQUALS ONE INCH WHEN PRINTED TO SCALE.

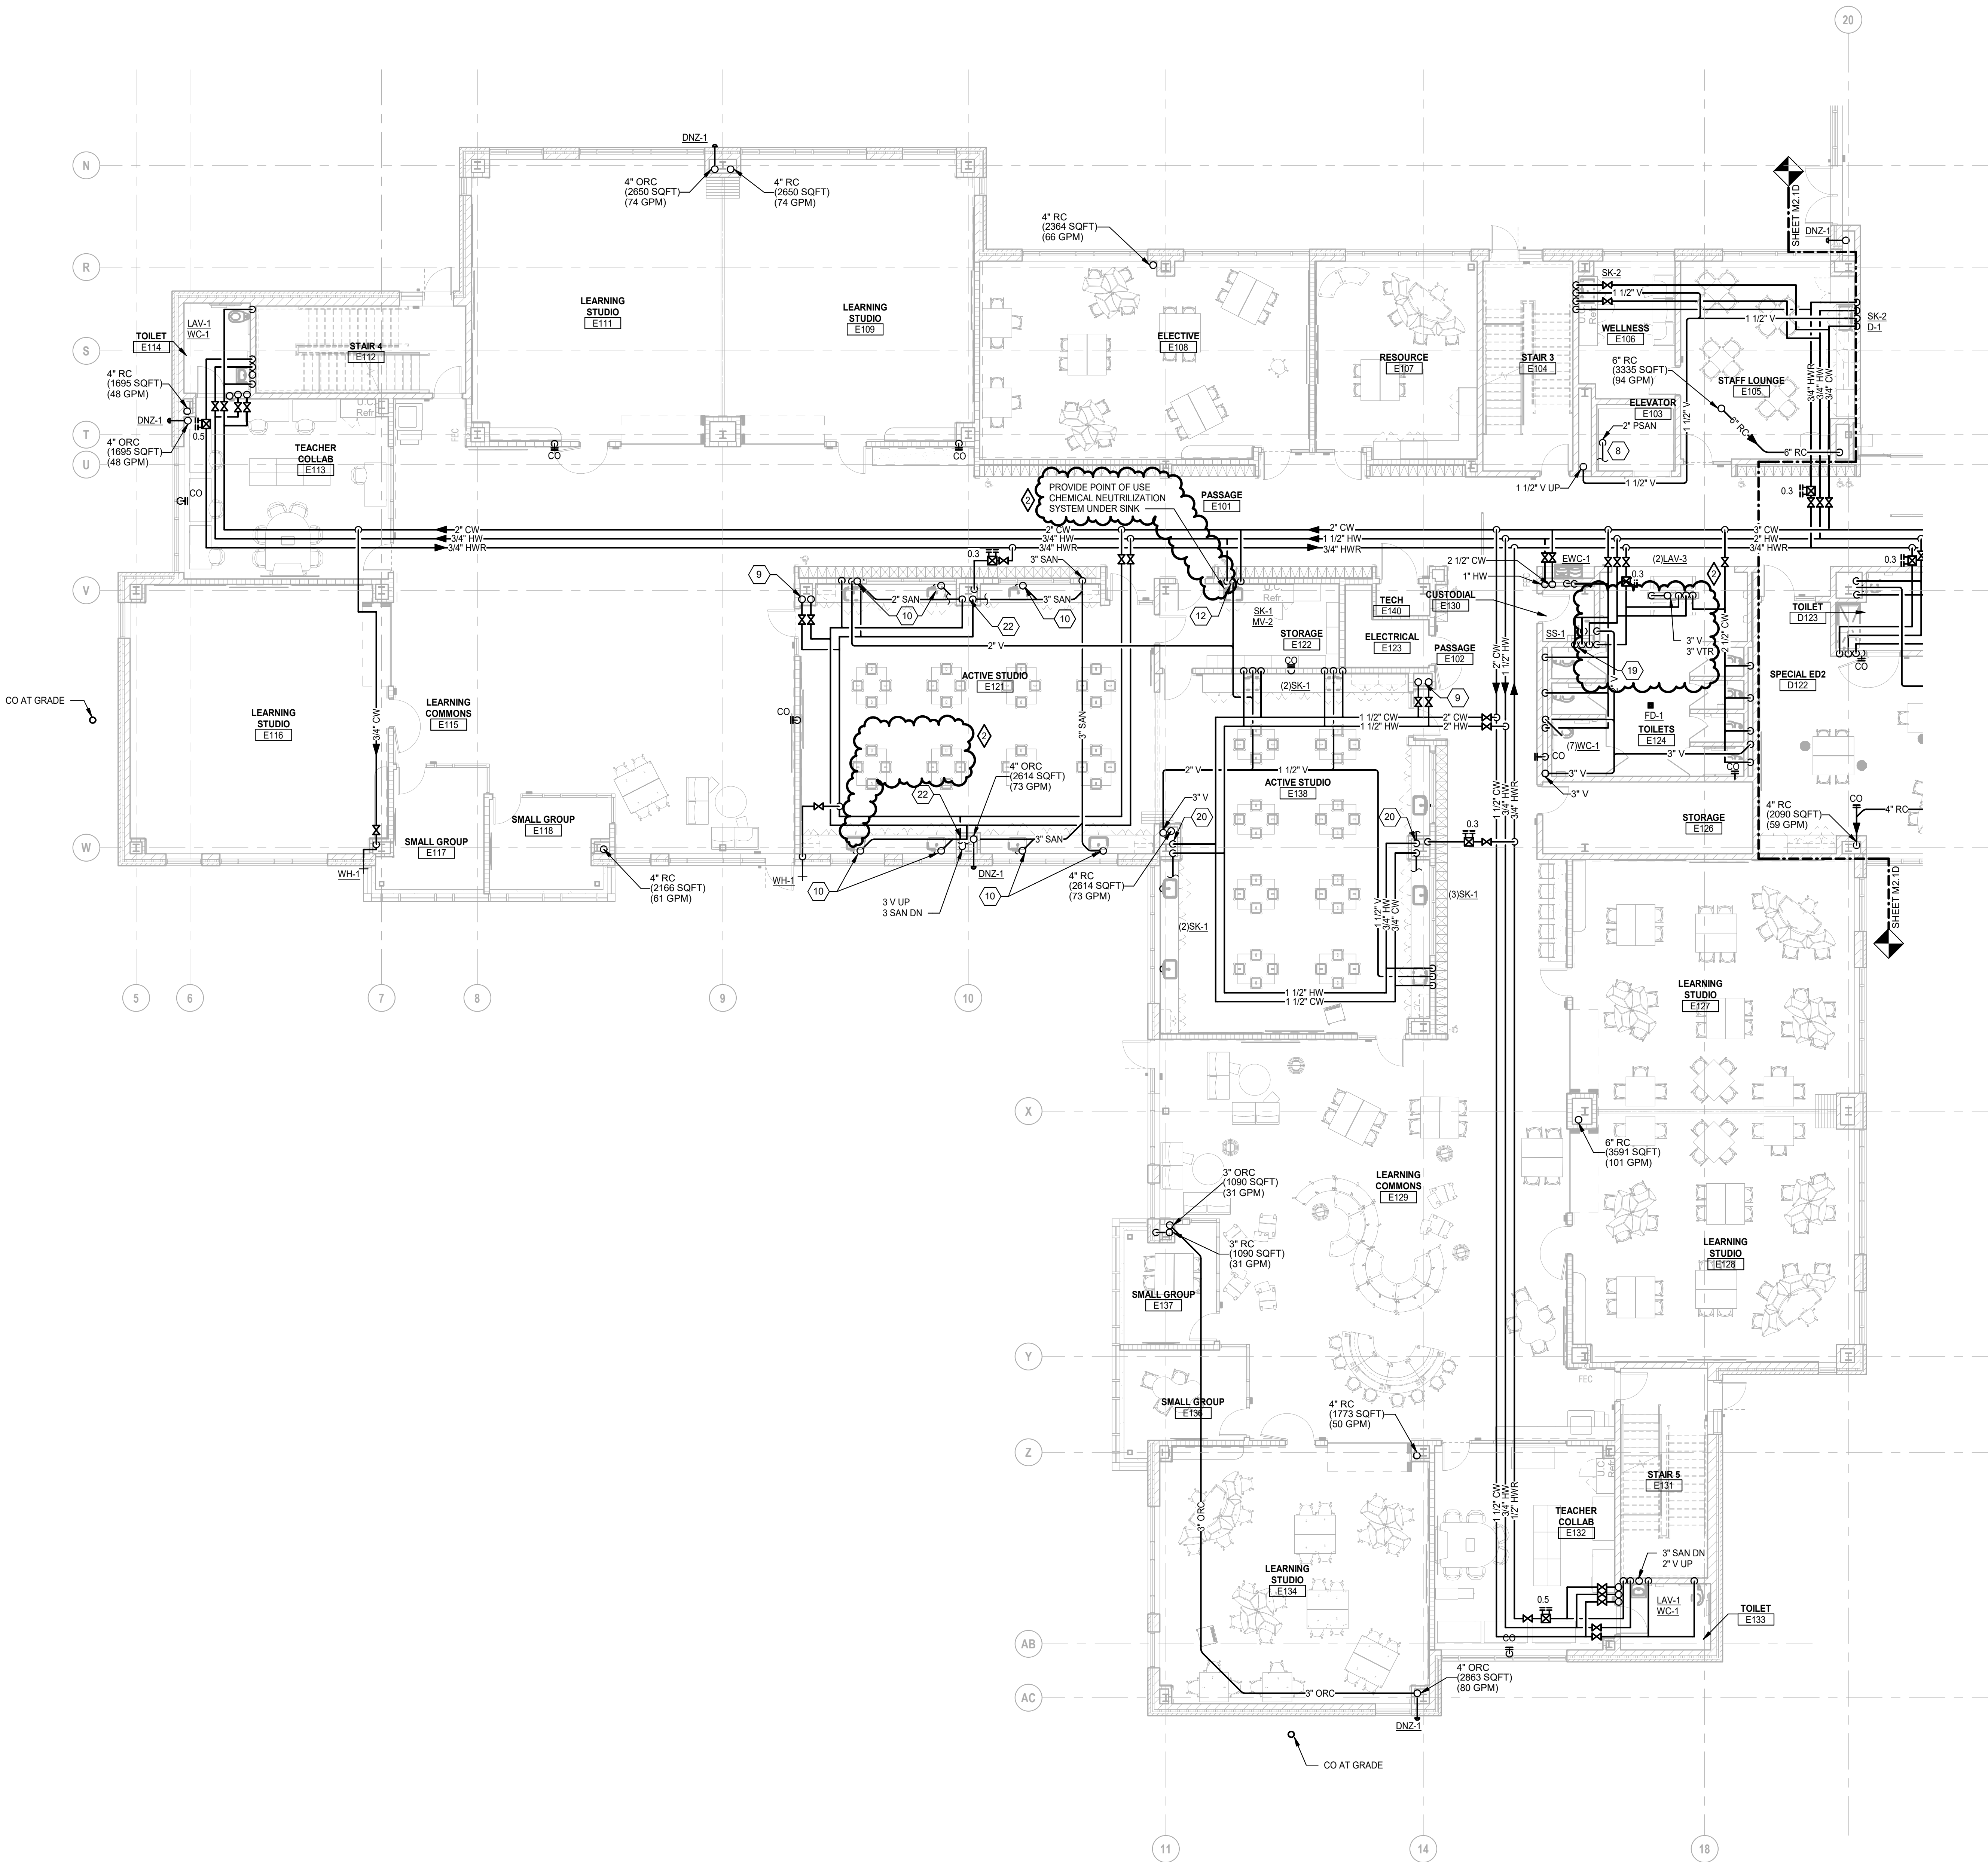

PLUMBING GENERAL NOTES:

- 1 THESE DRAWINGS ARE DIAGNOSTIC, AND REPRESENT THE GENERAL INTENT AND ARRANGEMENT OF SYSTEMS. THEY ARE NOT TO BE CONSIDERED FABRICATION COORDINATION/SHOP DRAWINGS. COORDINATION WITH OTHER TRADES IS REQUIRED. PROVIDE THE ADDITIONAL FITTINGS AND OFFSETS THAT WILL BE REQUIRED TO COMPLETE EACH SYSTEM AND TO AVOID INTERFERENCES WITH ALL OTHER SYSTEMS INCLUDING THE STRUCTURE, SHEET METAL, OTHER PIPING SYSTEMS, ELECTRICAL CONDUITS, BUS DUCTS, CABLE TRAY, LIGHT FIXTURES, ETC. AND/OR OTHER SPACE CONSTRAINTS.
- 2 INSTALL SYSTEMS SUCH THAT REQUIRED CLEARANCE AND SERVICE ACCESS SPACE IS PROVIDED AROUND ALL MECHANICAL AND ELECTRICAL EQUIPMENT, AND AROUND ANY COMPONENTS WHICH REQUIRE SERVICE ACCESS.
- 3 PIPING SHALL NOT BE INSTALLED ABOVE ELECTRICAL TRANSFORMERS, SWITCHBOARDS, PANELBOARDS OR MOTOR CONTROL CENTERS.
- 4 COORDINATE AND PROVIDE ACCESS DOORS WITHIN INACCESSIBLE CEILING SHAFT AND CHASE AREAS FOR ALL COMPONENTS WHICH REQUIRE SERVICE ACCESS. REFER TO ARCHITECTURAL DRAWINGS FOR CEILING TYPES.
- 5 PROVIDE SUPPLEMENTARY STEEL AS REQUIRED FOR THE PROPER SUPPORT OF ALL SYSTEMS.
- 6 REFER TO ARCHITECTURAL PLANS FOR DIMENSIONED LOCATIONS OF PLUMBING FIXTURES.
- 7 HOT AND COLD WATER PIPING RUN-OUTS TO LAVATORIES AND SINKS SHALL BE 1/2" UNLESS OTHERWISE NOTED.
- 8 PLUMBING VENT PIPING THROUGH ROOF SHALL BE LOCATED A MINIMUM OF 10'-0" FROM ANY FRESH AIR INTAKE LOCATION AND A MINIMUM OF 18" CLEAR FROM THE INSIDE FACE OF PARAPET.
- 9 PROVIDE CODE REQUIRED CLEARANCE FOR ALL CLEANOUTS INSTALLED IN SANITARY WASTE AND VENT PIPING.
- 10 MINIMUM UNDERGROUND PIPE SIZE SHALL BE 3".
- 11 WATER SERVICE ENTRANCE PIPING SHALL BE BURIED WITH DEPTH OF COVER OVER TOP OF PIPE OF AT LEAST 4'-0" OR WITH TOP OF PIPE AT LEAST 12" BELOW LEVEL OF MAXIMUM FROST PENETRATION, OR AS REQUIRED BY AUTHORITIES HAVING JURISDICTION, WHICHEVER IS DEEPEST.

CONSTRUCTION KEY NOTES:

- 1 3 SAN TO SINK/LAV.
- 2 3 SAN TO FDIS.
- 3 ROUTE 3/4 PUMPED CONDENSATE FROM HP-101 AND HP-102 TO CUSTODIAL A134 AND SPILL INTO SERVICE SINK.
- 4 3 SAN TO EWC.
- 5 3 SAN TO WASHING MACHINE OX BOX LOCATION.
- 6 3 SAN TO SS.
- 7 3 SAN TO SHOWER DRAIN.
- 8 ROUTE PSAN FROM SP-2 TO HUB OUTLET LOCATED IN CUSTODIAL E130.
- 9 ROUTE 1 1/2 CW & 1 1/2 HW UP TO SECOND FLOOR SINKS IN COLUMN SPACE PROVIDED.
- 10 2 SAN TO SINK/LAV.
- 11 3/4 CW TO ROOF MOUNTED HYDRANT. ROUTE HW TO CODE REQUIRED DISTANCE ABOVE FLOOR DRAIN/SINK.
- 12 EXTEND CW & HW TO MV-1 LOCATED UNDER SINK TO PROVIDE TEMPERED WATER TO EMERGENCY EYE WASH.
- 13 ROUTE GREASE SANITARY PIPING FROM THREE COMPARTMENT SINK TO GREASE INTERCEPTOR.
- 14 REFER TO NATURAL GAS DIAGRAM ON SHEET M6.4 FOR ROUTING AND SIZING SPECIFIC INFORMATION.
- 15 4 SAN FOR WC.
- 16 4 SAN FOR SANITARY CHASE.
- 17 ROUTE 1 1/2 IW FROM FSE PROVIDED FIXTURE AND TERMINATE TO CODE REQUIRED DISTANCE TO FLOOR SINK. COORDINATE FINAL PIPING SIZES WITH FSE DRAWINGS PRIOR TO CONSTRUCTION.
- 18 ROUTE PIPING IN CHASE TO FIXTURES. SEE PLUMBING FIXTURE CONNECTION SCHEDULE FOR SIZES TO FIXTURES.
- 19 ROUTE ADDITIONAL 3/4" CW LINE FOR CHEMICAL FEED SYSTEM.
- 20 ROUTE 3/4 CW AND 3/4 HW DOWN IN COLUMN. ROUTE 1/2 CW AND 1/2 HW TO EACH SINK. PIPING UNDER COUNTER SPACE TO CABINET MOUNTED SINK.
- 21 ROUTE 1/2 CW AND 1/2 HW DOWN IN COLUMN OR WALL SPACE. ROUTE 1/2 CW AND 1/2 HW TO SINK. PIPING UNDER COUNTER SPACE TO CABINET MOUNTED SINK.
- 22 ROUTE 1 CW AND 1 HW DOWN IN COLUMN. ROUTE 1/2 CW AND 1/2 HW TO EACH SINK. PIPING UNDER COUNTER SPACE TO CABINET MOUNTED SINK.
- 23 3 SAN TO UR.



TMP ARCHITECTURE INC
 1191 WEST SQUARE LAKE ROAD - BOX 289
 BLOOMFIELD HILLS - MICHIGAN 48302
 P# 248.338.6941 F# 248.338.0223
 EM- INFO@TMP-ARCHITECTURE.COM

REGISTRATION SEAL


CONSULTANT

Peter Basso Associates Inc
 CONSULTING ENGINEERS
 5145 Livernois, Suite 100
 Troy, Michigan 48068-3276
 Tel. 248-679-5566
 Fax: 248-679-9007
 www.PeterBassoAssociates.com
 PBA Project No. 2023.0154

PROJECT TITLE
NEW SMITH
MIDDLE SCHOOL
Bid Package No. 03B

Troy School District
TROY, MI

DRAWING TITLE
FIRST LEVEL PLUMBING PLAN
- ZONE 'E'

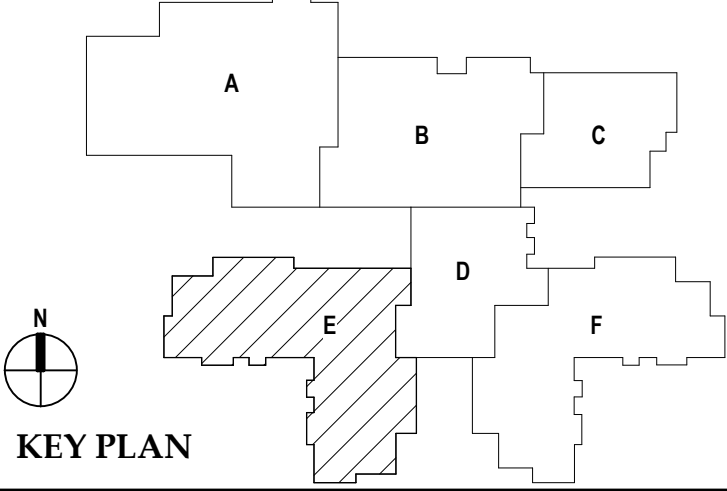

ISSUE DATES

07-12-2024 ADDENDUM #2
 06-16-2024 CONSTRUCTION DOCUMENTS

DATE: ISSUED FOR:

DRAWN	MEP
CHECKED	KLH
APPROVED	SVM



PROJECT NO.
22102

DRAWING NO.
M2.1E

FIRST LEVEL PLUMBING PLAN - ZONE 'E'
 SCALE: 1/8" = 1'-0"

Autodesk Docs\22102_Troy_Smith MS\2023-0154_TSD_Smith MS_MEP_v22.rvt 7/11/2024 4:04:26 PM

THE FOLLOWING DIMENSION EQUALS ONE INCH WHEN PRINTED TO SCALE.

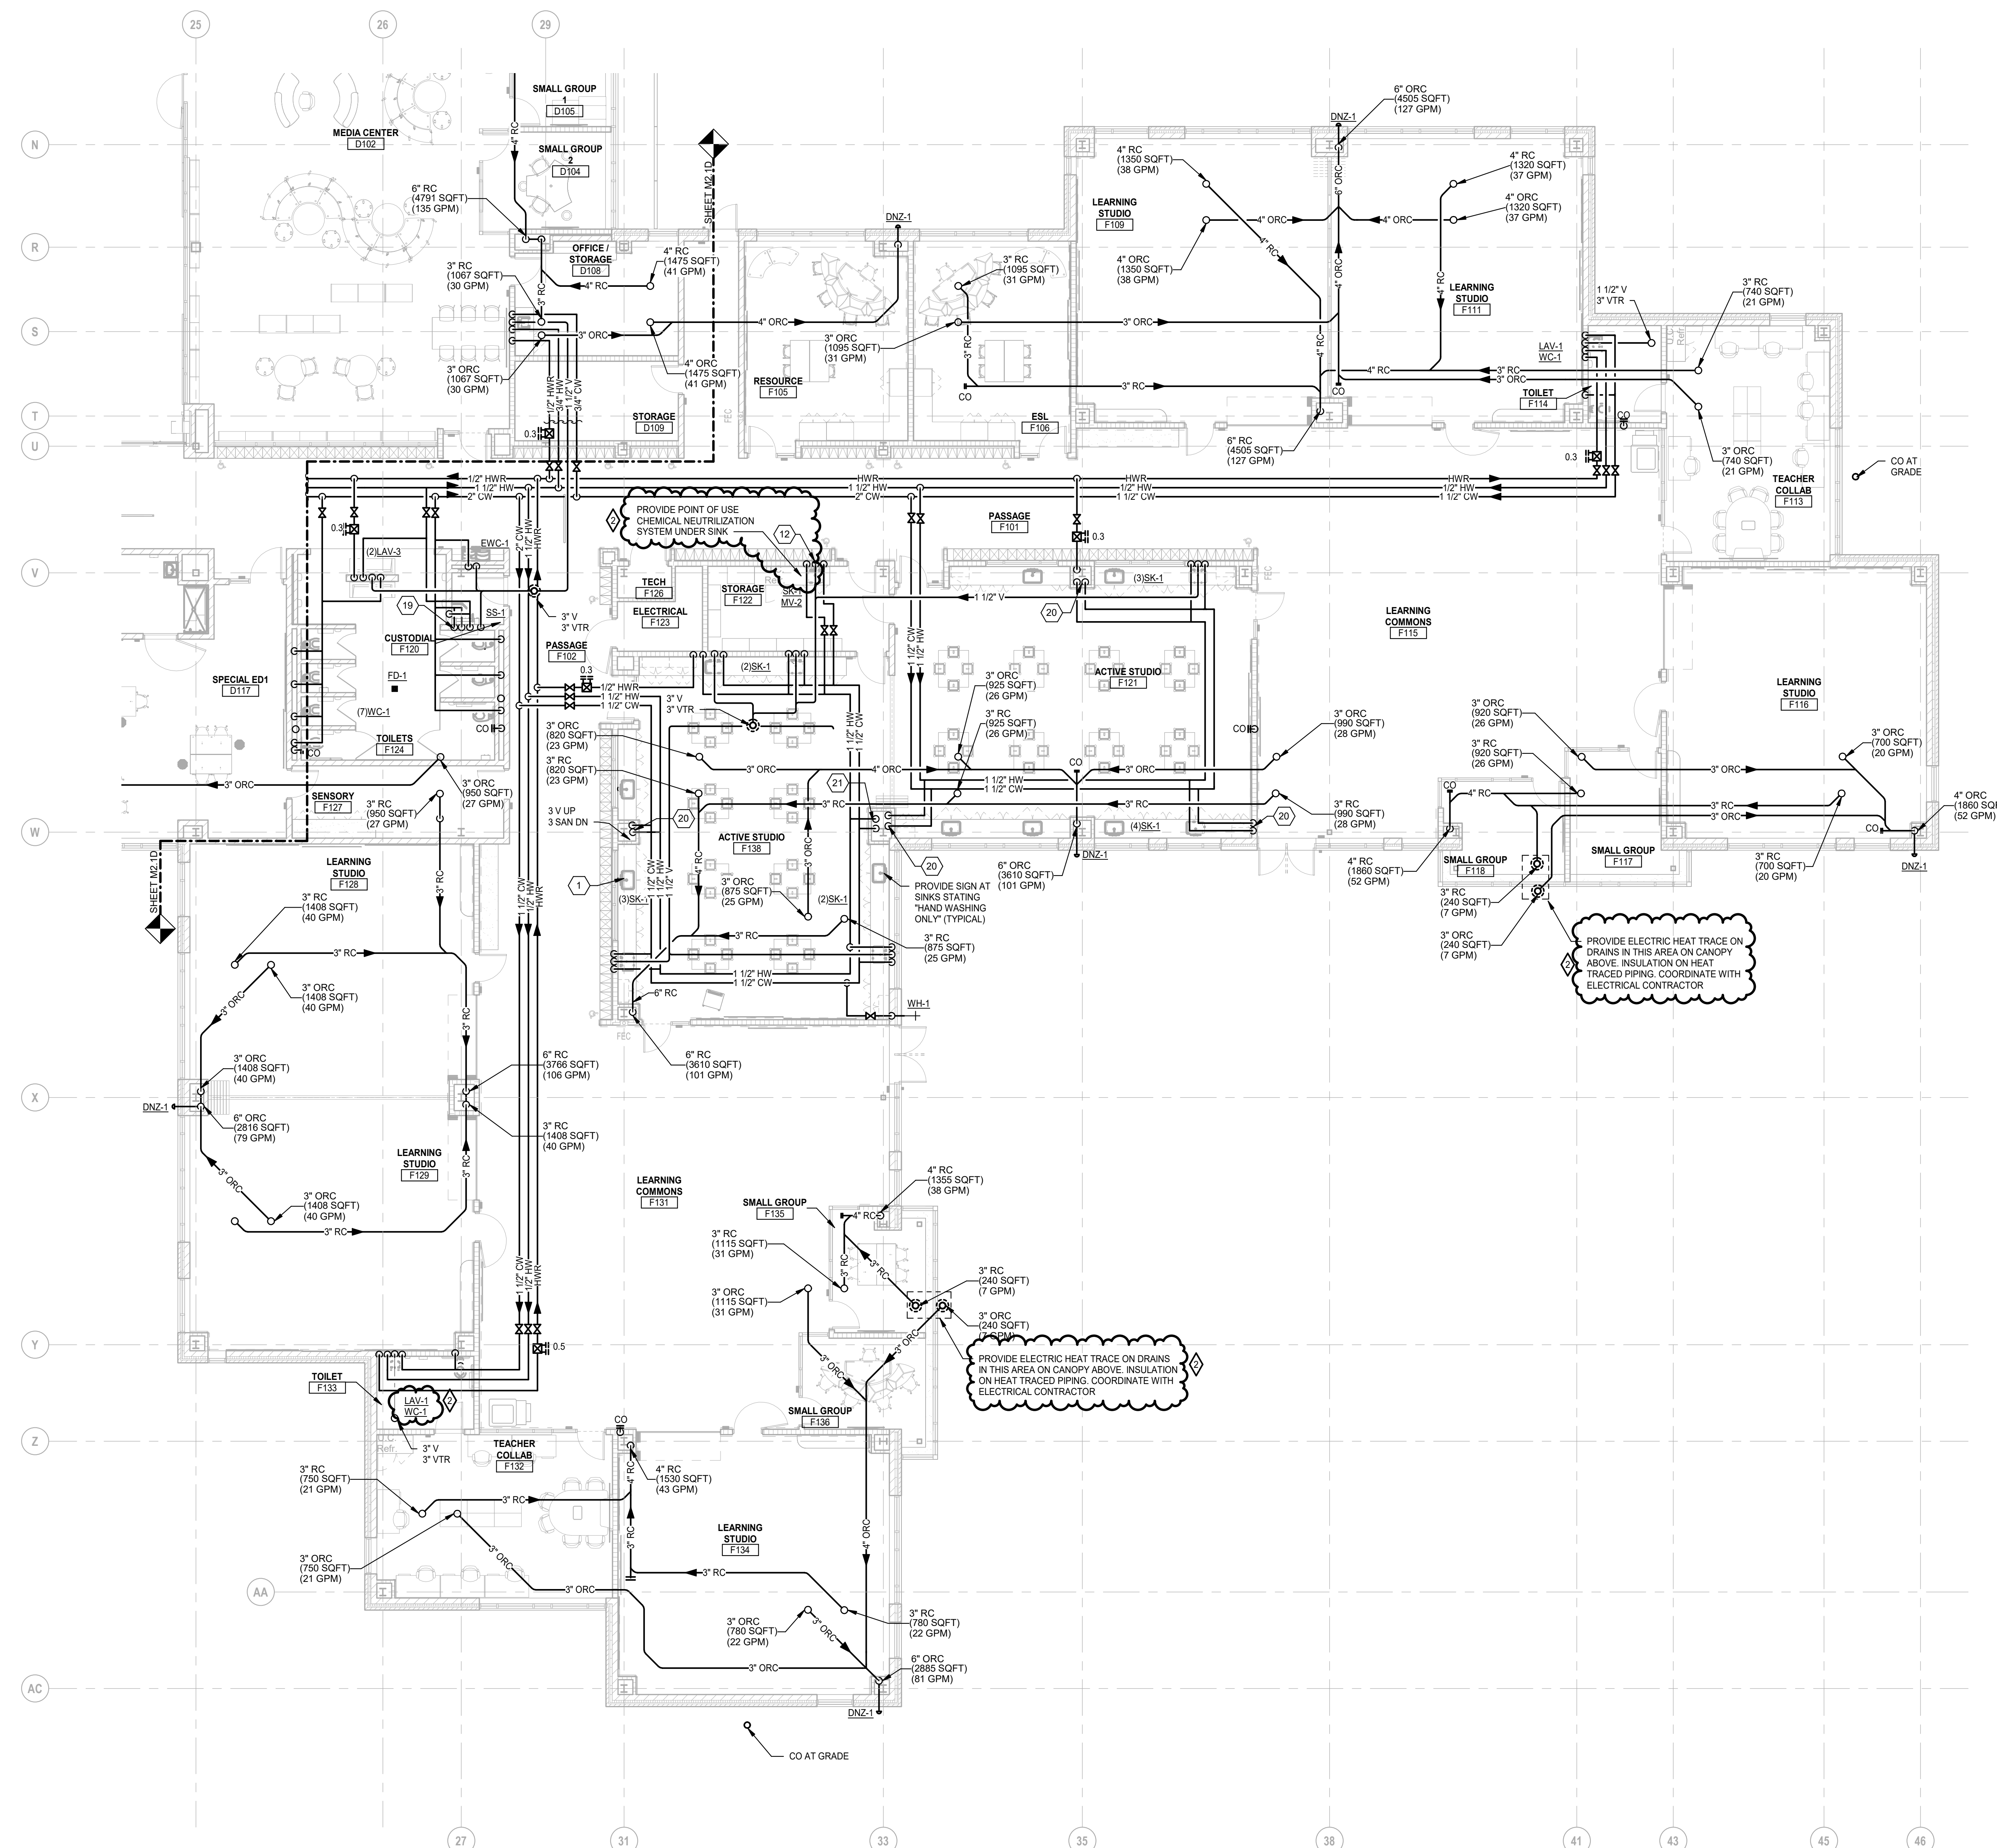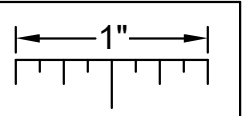

PLUMBING GENERAL NOTES:

- 1 THESE DRAWINGS ARE DIAGRAMMATIC, AND REPRESENT THE GENERAL INTENT AND ARRANGEMENT OF SYSTEMS. THEY ARE NOT TO BE CONSIDERED FABRICATION/COORDINATION SHOP DRAWINGS. COORDINATION WITH OTHER TRADES IS REQUIRED. PROVIDE THE ADDITIONAL FITTINGS AND OFFSETS THAT WILL BE REQUIRED TO COMPLETE EACH SYSTEM AND TO AVOID INTERFERENCES WITH ALL OTHER SYSTEMS INCLUDING THE STRUCTURE, SHEET METAL, OTHER PIPING SYSTEMS, ELECTRICAL CONDUITS, BUS DUCTS, CABLE TRAY, LIGHT FIXTURES, ETC. AND/OR OTHER SPACE CONSTRAINTS.
- 2 INSTALL SYSTEMS SUCH THAT REQUIRED CLEARANCE AND SERVICE ACCESS SPACE IS PROVIDED AROUND ALL MECHANICAL AND ELECTRICAL EQUIPMENT, AND AROUND ANY COMPONENTS WHICH REQUIRE SERVICE ACCESS.
- 3 PIPING SHALL NOT BE INSTALLED ABOVE ELECTRICAL TRANSFORMERS, SWITCHBOARDS, PANELBOARDS OR MOTOR CONTROL CENTERS.
- 4 COORDINATE AND PROVIDE ACCESS DOORS WITHIN INACCESSIBLE CEILING SPACE. REFER TO ARCHITECTURAL PLANS FOR ALL COMPONENTS WHICH REQUIRE SERVICE ACCESS. REFER TO ARCHITECTURAL DRAWINGS FOR CEILING TYPES.
- 5 PROVIDE SUPPLEMENTARY STEEL AS REQUIRED FOR THE PROPER SUPPORT OF ALL SYSTEMS.
- 6 REFER TO ARCHITECTURAL PLANS FOR DIMENSIONED LOCATIONS OF PLUMBING FIXTURES.
- 7 HOT AND COLD WATER PIPING RUN-OUTS TO LAVATORIES AND SINKS SHALL BE 1/2" UNLESS OTHERWISE NOTED.
- 8 PLUMBING VENT PIPING THROUGH ROOF SHALL BE LOCATED A MINIMUM OF 10'-0" FROM ANY FRESH AIR INTAKE LOCATION AND A MINIMUM OF 18" CLEAR FROM THE INSIDE FACE OF PARAPET.
- 9 PROVIDE CODE REQUIRED CLEARANCE FOR ALL CLEANOUTS INSTALLED IN SANITARY WASTE AND VENT PIPING.
- 10 MINIMUM UNDERGROUND PIPE SIZE SHALL BE 3".
- 11 WATER SERVICE ENTRANCE PIPING SHALL BE BURIED WITH DEPTH OF COVER OVER TOP OF PIPE OF AT LEAST 4'-0" OR WITH TOP OF PIPE AT LEAST 12" BELOW LEVEL OF MAXIMUM FROST PENETRATION, OR AS REQUIRED BY AUTHORITIES HAVING JURISDICTION, WHICHEVER IS DEEPEST.

CONSTRUCTION KEY NOTES:

- 1 3 SAN TO SINK/LAV.
- 2 3 SAN TO FDFIS.
- 3 ROUTE 3/4 PUMPED CONDENSATE FROM HP-101 AND HP-102 TO CUSTODIAL A134 AND SPILL INTO SERVICE SINK.
- 4 3 SAN TO EWC.
- 5 3 SAN TO WASHING MACHINE OX BOX LOCATION.
- 6 3 SAN TO SS.
- 7 3 SAN TO SHOWER DRAIN.
- 8 ROUTE PSAN FROM SP-2 TO HUB OUTLET LOCATED IN CUSTODIAL E130.
- 9 ROUTE 1 1/2 CW & 1 1/2 HW UP TO SECOND FLOOR SINKS IN COLUMN SPACE PROVIDED.
- 10 2 SAN TO SINK/LAV.
- 11 3/4 CW TO ROOF MOUNTED HYDRANT. ROUTE HW TO CODE REQUIRED DISTANCE ABOVE FLOOR DRAIN/SINK.
- 12 EXTEND CW & HW TO MV-1 LOCATED UNDER SINK TO PROVIDE TEMPERED WATER TO EMERGENCY EYE WASH.
- 13 ROUTE GREASE SANITARY PIPING FROM THREE COMPARTMENT SINK TO GREASE INTERCEPTOR.
- 14 REFER TO NATURAL GAS DIAGRAM ON SHEET M6.4 FOR ROUTING AND SIZING SPECIFIC INFORMATION.
- 15 4 SAN FOR WC.
- 16 4 SAN FOR SANITARY CHASE.
- 17 ROUTE 1 1/2 IW FROM FSE PROVIDED FIXTURE AND TERMINATE TO CODE REQUIRED DISTANCE TO FLOOR SINK. COORDINATE FINAL PIPING SIZES WITH FSE DRAWINGS PRIOR TO CONSTRUCTION.
- 18 ROUTE PIPING IN CHASE TO FIXTURES. SEE PLUMBING FIXTURE CONNECTION SCHEDULE FOR SIZES TO FIXTURES.
- 19 ROUTE ADDITIONAL 3/4" CW LINE FOR CHEMICAL FEED SYSTEM.
- 20 ROUTE 3/4 CW AND 3/4 HW DOWN IN COLUMN. ROUTE 1/2 CW AND 1/2 HW TO EACH SINK. PIPING UNDER COUNTER SPACE TO CABINET MOUNTED SINK.
- 21 ROUTE 1/2 CW AND 1/2 HW DOWN IN COLUMN OR WALL SPACE. ROUTE 1/2 CW AND 1/2 HW TO SINK. PIPING UNDER COUNTER SPACE TO CABINET MOUNTED SINK.
- 22 ROUTE 1 CW AND 1 HW DOWN IN COLUMN. ROUTE 1/2 CW AND 1/2 HW TO EACH SINK. PIPING UNDER COUNTER SPACE TO CABINET MOUNTED SINK.
- 23 3 SAN TO UR.



TMP ARCHITECTURE INC
1191 WEST SQUARE LAKE ROAD - BOX 289
BLOOMFIELD HILLS - MICHIGAN - 48302
PH: 248.358.6941 FX: 248.358.0233
EM: INFO@TMP-ARCHITECTURE.COM

REGISTRATION SEAL

CONSULTANT




Peter Basso Associates Inc
CONSULTING ENGINEERS
5145 Livernois, Suite 100
Troy, Michigan 48068-3276
Tel: 248-879-5666 Fax: 248-879-9007
www.PeterBassoAssociates.com
PBA Project No. 2023.0154

PROJECT TITLE

NEW SMITH MIDDLE SCHOOL
Bid Package No. 03B

Troy School District
TROY, MI

DRAWING TITLE
FIRST LEVEL PLUMBING PLAN - ZONE 'F'

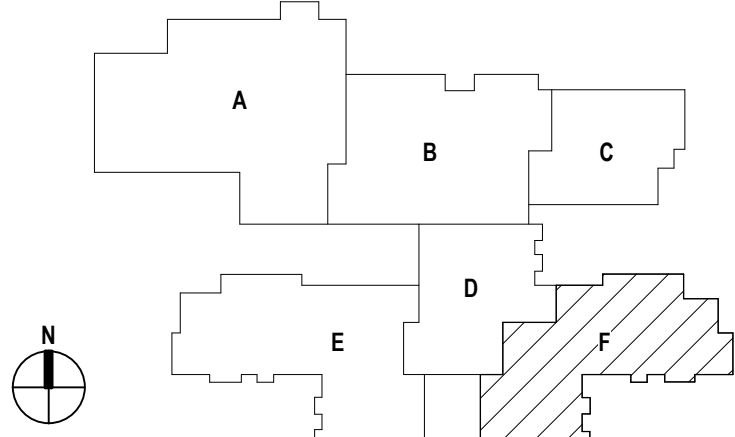

KEY PLAN

ISSUE DATES

DATE	ISSUED FOR:

07-12-2024	ADDENDUM #2
08-16-2024	CONSTRUCTION DOCUMENTS

DATE:	ISSUED FOR:
-------	-------------

DRAWN:	MEP
--------	-----

CHECKED:	KLH
----------	-----

APPROVED:	SVM
-----------	-----

PROJECT NO.


22102

DRAWING NO.

M2.1F

FIRST LEVEL PLUMBING PLAN - ZONE 'F'
SCALE: 1/8" = 1'-0"

THE FOLLOWING DIMENSION EQUALS ONE INCH WHEN PRINTED TO SCALE.

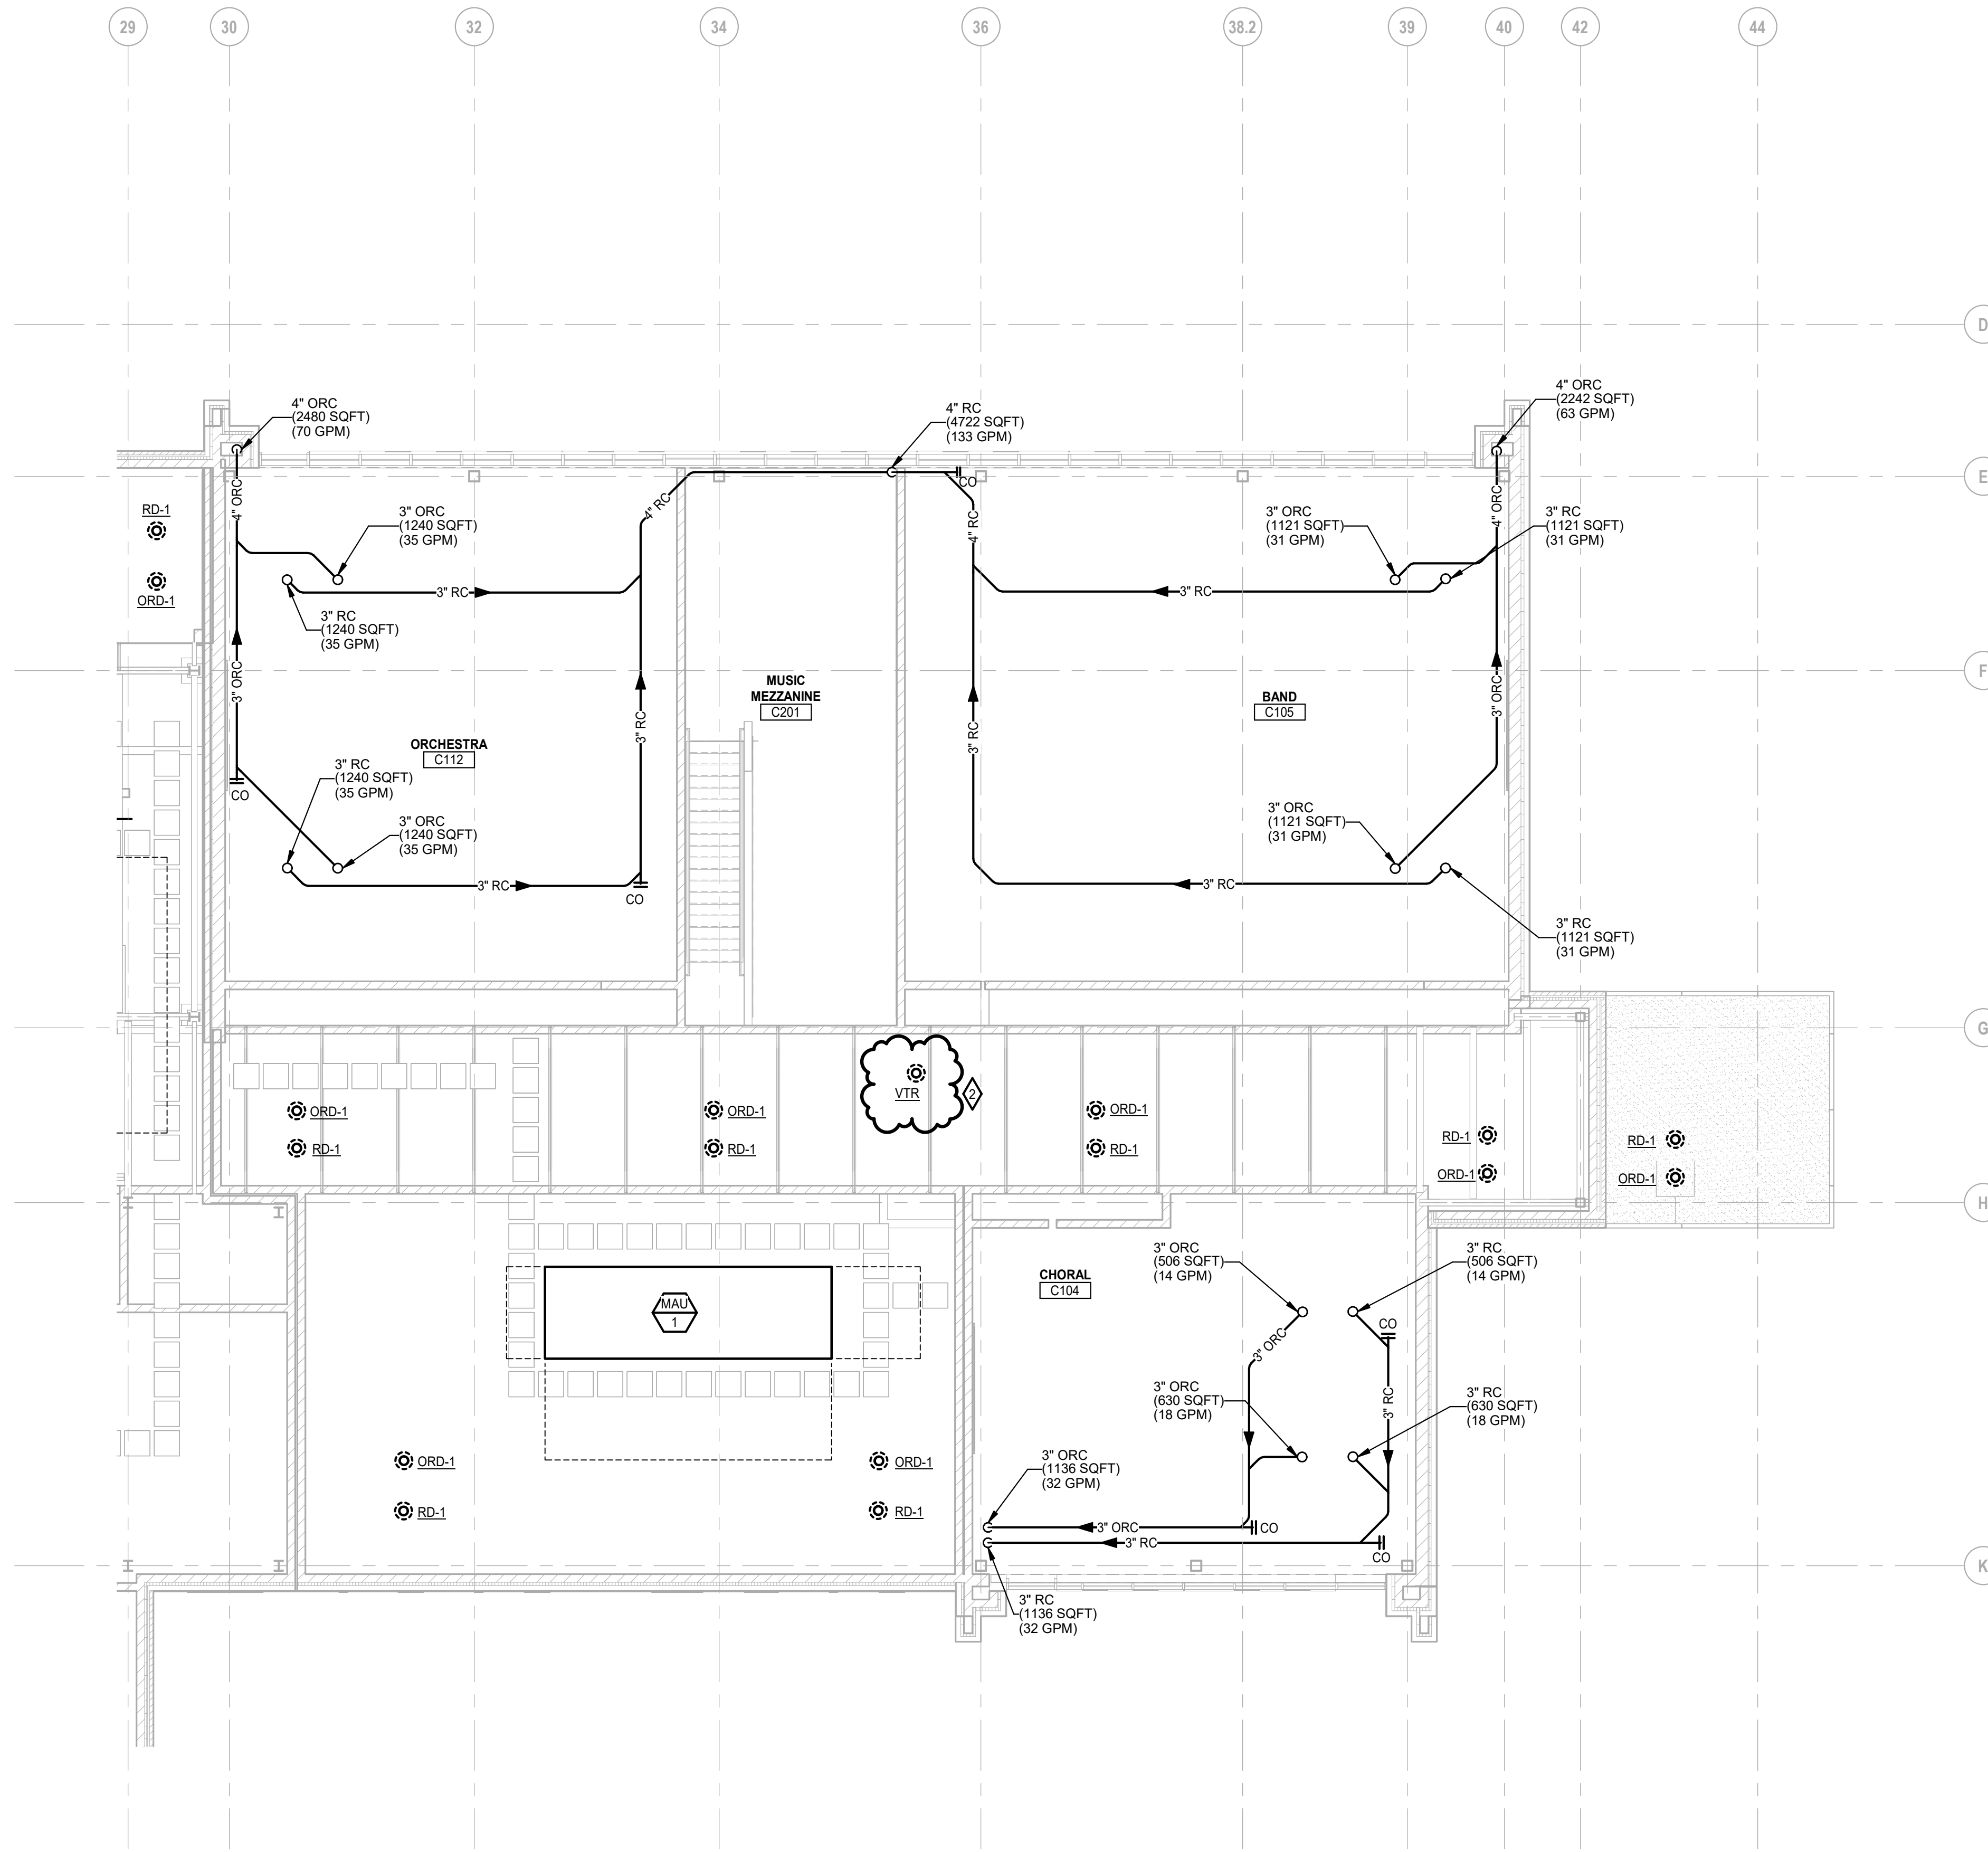

MEZZANINE LEVEL PLUMBING PLAN - ZONE 'C'
SCALE: 1/8" = 1'-0"

PLUMBING GENERAL NOTES:

- THESE DRAWINGS ARE DIAGRAMMATIC, AND REPRESENT THE GENERAL INTENT AND ARRANGEMENT OF SYSTEMS. THEY ARE NOT TO BE CONSIDERED FABRICATION/COORDINATION/SHOP DRAWINGS. COORDINATION WITH OTHER TRADES IS REQUIRED. PROVIDE THE ADDITIONAL FITTINGS AND OFFSETS THAT WILL BE REQUIRED TO COMPLETE EACH SYSTEM AND TO AVOID INTERFERENCES WITH ALL OTHER SYSTEMS INCLUDING THE STRUCTURE, SHEET METAL, OTHER PIPING SYSTEMS, ELECTRICAL CONDUITS, BUS DUCTS, CABLE TRAY, LIGHT FIXTURES, ETC. AND/OR OTHER SPACE CONSTRAINTS.
- INSTALL SYSTEMS SUCH THAT REQUIRED CLEARANCE AND SERVICE ACCESS SPACE IS PROVIDED AROUND ALL MECHANICAL AND ELECTRICAL EQUIPMENT, AND AROUND ANY COMPONENTS WHICH REQUIRE SERVICE ACCESS.
- PIPING SHALL NOT BE INSTALLED ABOVE ELECTRICAL TRANSFORMERS, SWITCHBOARDS, PANELBOARDS OR MOTOR CONTROL CENTERS.
- COORDINATE AND PROVIDE ACCESS DOORS WITHIN INACCESSIBLE CEILING SHAFT, AND CHASE AREAS FOR ALL COMPONENTS WHICH REQUIRE SERVICE ACCESS. REFER TO ARCHITECTURAL DRAWINGS FOR CEILING TYPES.
- PROVIDE SUPPLEMENTARY STEEL AS REQUIRED FOR THE PROPER SUPPORT OF ALL SYSTEMS.
- REFER TO ARCHITECTURAL PLANS FOR DIMENSIONED LOCATIONS OF PLUMBING FIXTURES.
- HOT AND COLD WATER PIPING RUN-OUTS TO LAVATORIES AND SINKS SHALL BE 1/2" UNLESS OTHERWISE NOTED.
- PLUMBING VENT PIPING THROUGH ROOF SHALL BE LOCATED A MINIMUM OF 10'-0" FROM ANY FRESH AIR INTAKE LOCATION AND A MINIMUM OF 18" CLEAR FROM THE INSIDE FACE OF PARAPET.
- PROVIDE CODE REQUIRED CLEARANCE FOR ALL CLEANOUTS INSTALLED IN SANITARY WASTE AND VENT PIPING.
- MINIMUM UNDERGROUND PIPE SIZE SHALL BE 3".
- WATER SERVICE ENTRANCE PIPING SHALL BE BURIED WITH DEPTH OF COVER OVER TOP OF PIPE OF AT LEAST 4'-0" OR WITH TOP OF PIPE AT LEAST 12" BELOW LEVEL OF MAXIMUM FROST PENETRATION, OR AS REQUIRED BY AUTHORITIES HAVING JURISDICTION, WHICHEVER IS DEEPEST.

CONSTRUCTION KEY NOTES:

- 3 SAN TO SINK/LAV.
- 3 SAN TO FDI/FS.
- ROUTE 3/4 PUMPED CONDENSATE FROM HP-101 AND HP-102 TO CUSTODIAL A134 AND SPILL INTO SERVICE SINK.
- 3 SAN TO EWC.
- 3 SAN TO WASHING MACHINE OX BOX LOCATION.
- 3 SAN TO SS.
- 3 SAN TO SHOWER DRAIN.
- ROUTE PSAN FROM SP-2 TO HUB OUTLET LOCATED IN CUSTODIAL E130.
- ROUTE 1 1/2 CW & 1 1/2 HW UP TO SECOND FLOOR SINKS IN COLUMN SPACE PROVIDED.
- 2 SAN TO SINK/LAV.
- 3/4 CW TO ROOF MOUNTED HYDRANT. ROUTE IW TO CODE REQUIRED DISTANCE ABOVE FLOOR DRAIN/SINK.
- EXTEND CW & HW TO MV-1 LOCATED UNDER SINK TO PROVIDE TEMPERED WATER TO EMERGENCY EYE WASH.
- ROUTE GREASE SANITARY PIPING FROM THREE COMPARTMENT SINK TO GREASE INTERCEPTOR.
- REFER TO NATURAL GAS DIAGRAM ON SHEET M6.4 FOR ROUTING AND SIZING SPECIFIC INFORMATION.
- 4 SAN FOR WC.
- 4 SAN FOR SANITARY CHASE.
- ROUTE 1 1/2 IW FROM FSE PROVIDED FIXTURE AND TERMINATE TO CODE REQUIRED DISTANCE TO FLOOR SINK. COORDINATE FINAL PIPING SIZES WITH FSE DRAWINGS PRIOR TO CONSTRUCTION.
- ROUTE PIPING IN CHASE TO FIXTURES. SEE PLUMBING FIXTURE CONNECTION SCHEDULE FOR SIZES TO FIXTURES.
- ROUTE ADDITIONAL 3/4" CW LINE FOR CHEMICAL FEED SYSTEM.
- ROUTE 3/4 CW AND 3/4 HW DOWN IN COLUMN. ROUTE 1/2 CW AND 1/2 HW TO EACH SINK. PIPING UNDER COUNTER SPACE TO CABINET MOUNTED SINK.
- ROUTE 1/2 CW AND 1/2 HW DOWN IN COLUMN OR WALL SPACE. ROUTE 1/2 CW AND 1/2 HW TO SINK. PIPING UNDER COUNTER SPACE TO CABINET MOUNTED SINK.
- ROUTE 1 CW AND 1 HW DOWN IN COLUMN. ROUTE 1/2 CW AND 1/2 HW TO EACH SINK. PIPING UNDER COUNTER SPACE TO CABINET MOUNTED SINK.
- 3 SAN TO UR.



TMP ARCHITECTURE INC
1191 WEST SQUARE LAKE ROAD - BOX 289
BLOOMFIELD HILLS - MICHIGAN - 48302
PH: 248.338.6961 | FX: 248.338.0223
EM: INFO@TMPARCHITECTURE.COM

REGISTRATION SEAL

CONSULTANT




Peter Basso Associates Inc
CONSULTING ENGINEERS
5145 Livernois, Suite 100
Troy, Michigan 48068-3276
Tel: 248-879-5566
Fax: 248-879-0007
www.PeterBassoAssociates.com
PBA Project No.: 2023.0154

PROJECT TITLE
NEW SMITH MIDDLE SCHOOL
Bid Package No. 03B

Troy School District
TROY, MI

DRAWING TITLE
MEZZANINE LEVEL PLUMBING PLAN - ZONE 'C'

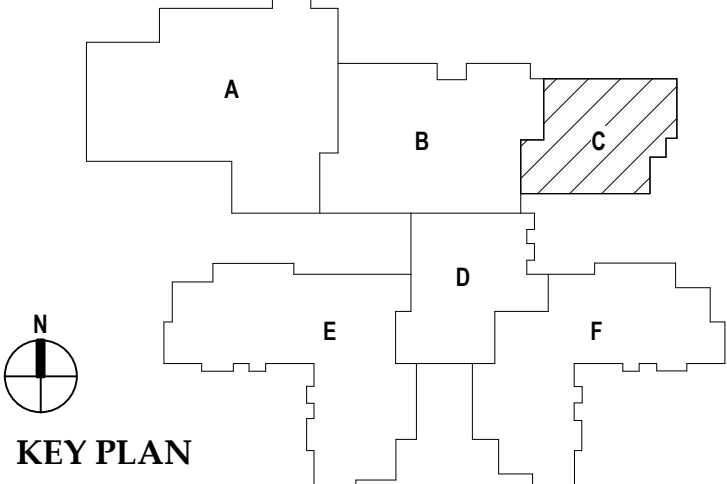

ISSUE DATES	


07-12-2024	ADDENDUM #2
08-16-2024	CONSTRUCTION DOCUMENTS

DATE: ISSUED FOR:

DRAWN: MEP
CHECKED: KLH
APPROVED: SVM

PROJECT NO.
22102
DRAWING NO.
M2.2C

THE FOLLOWING DIMENSION EQUALS ONE INCH WHEN PRINTED TO SCALE.

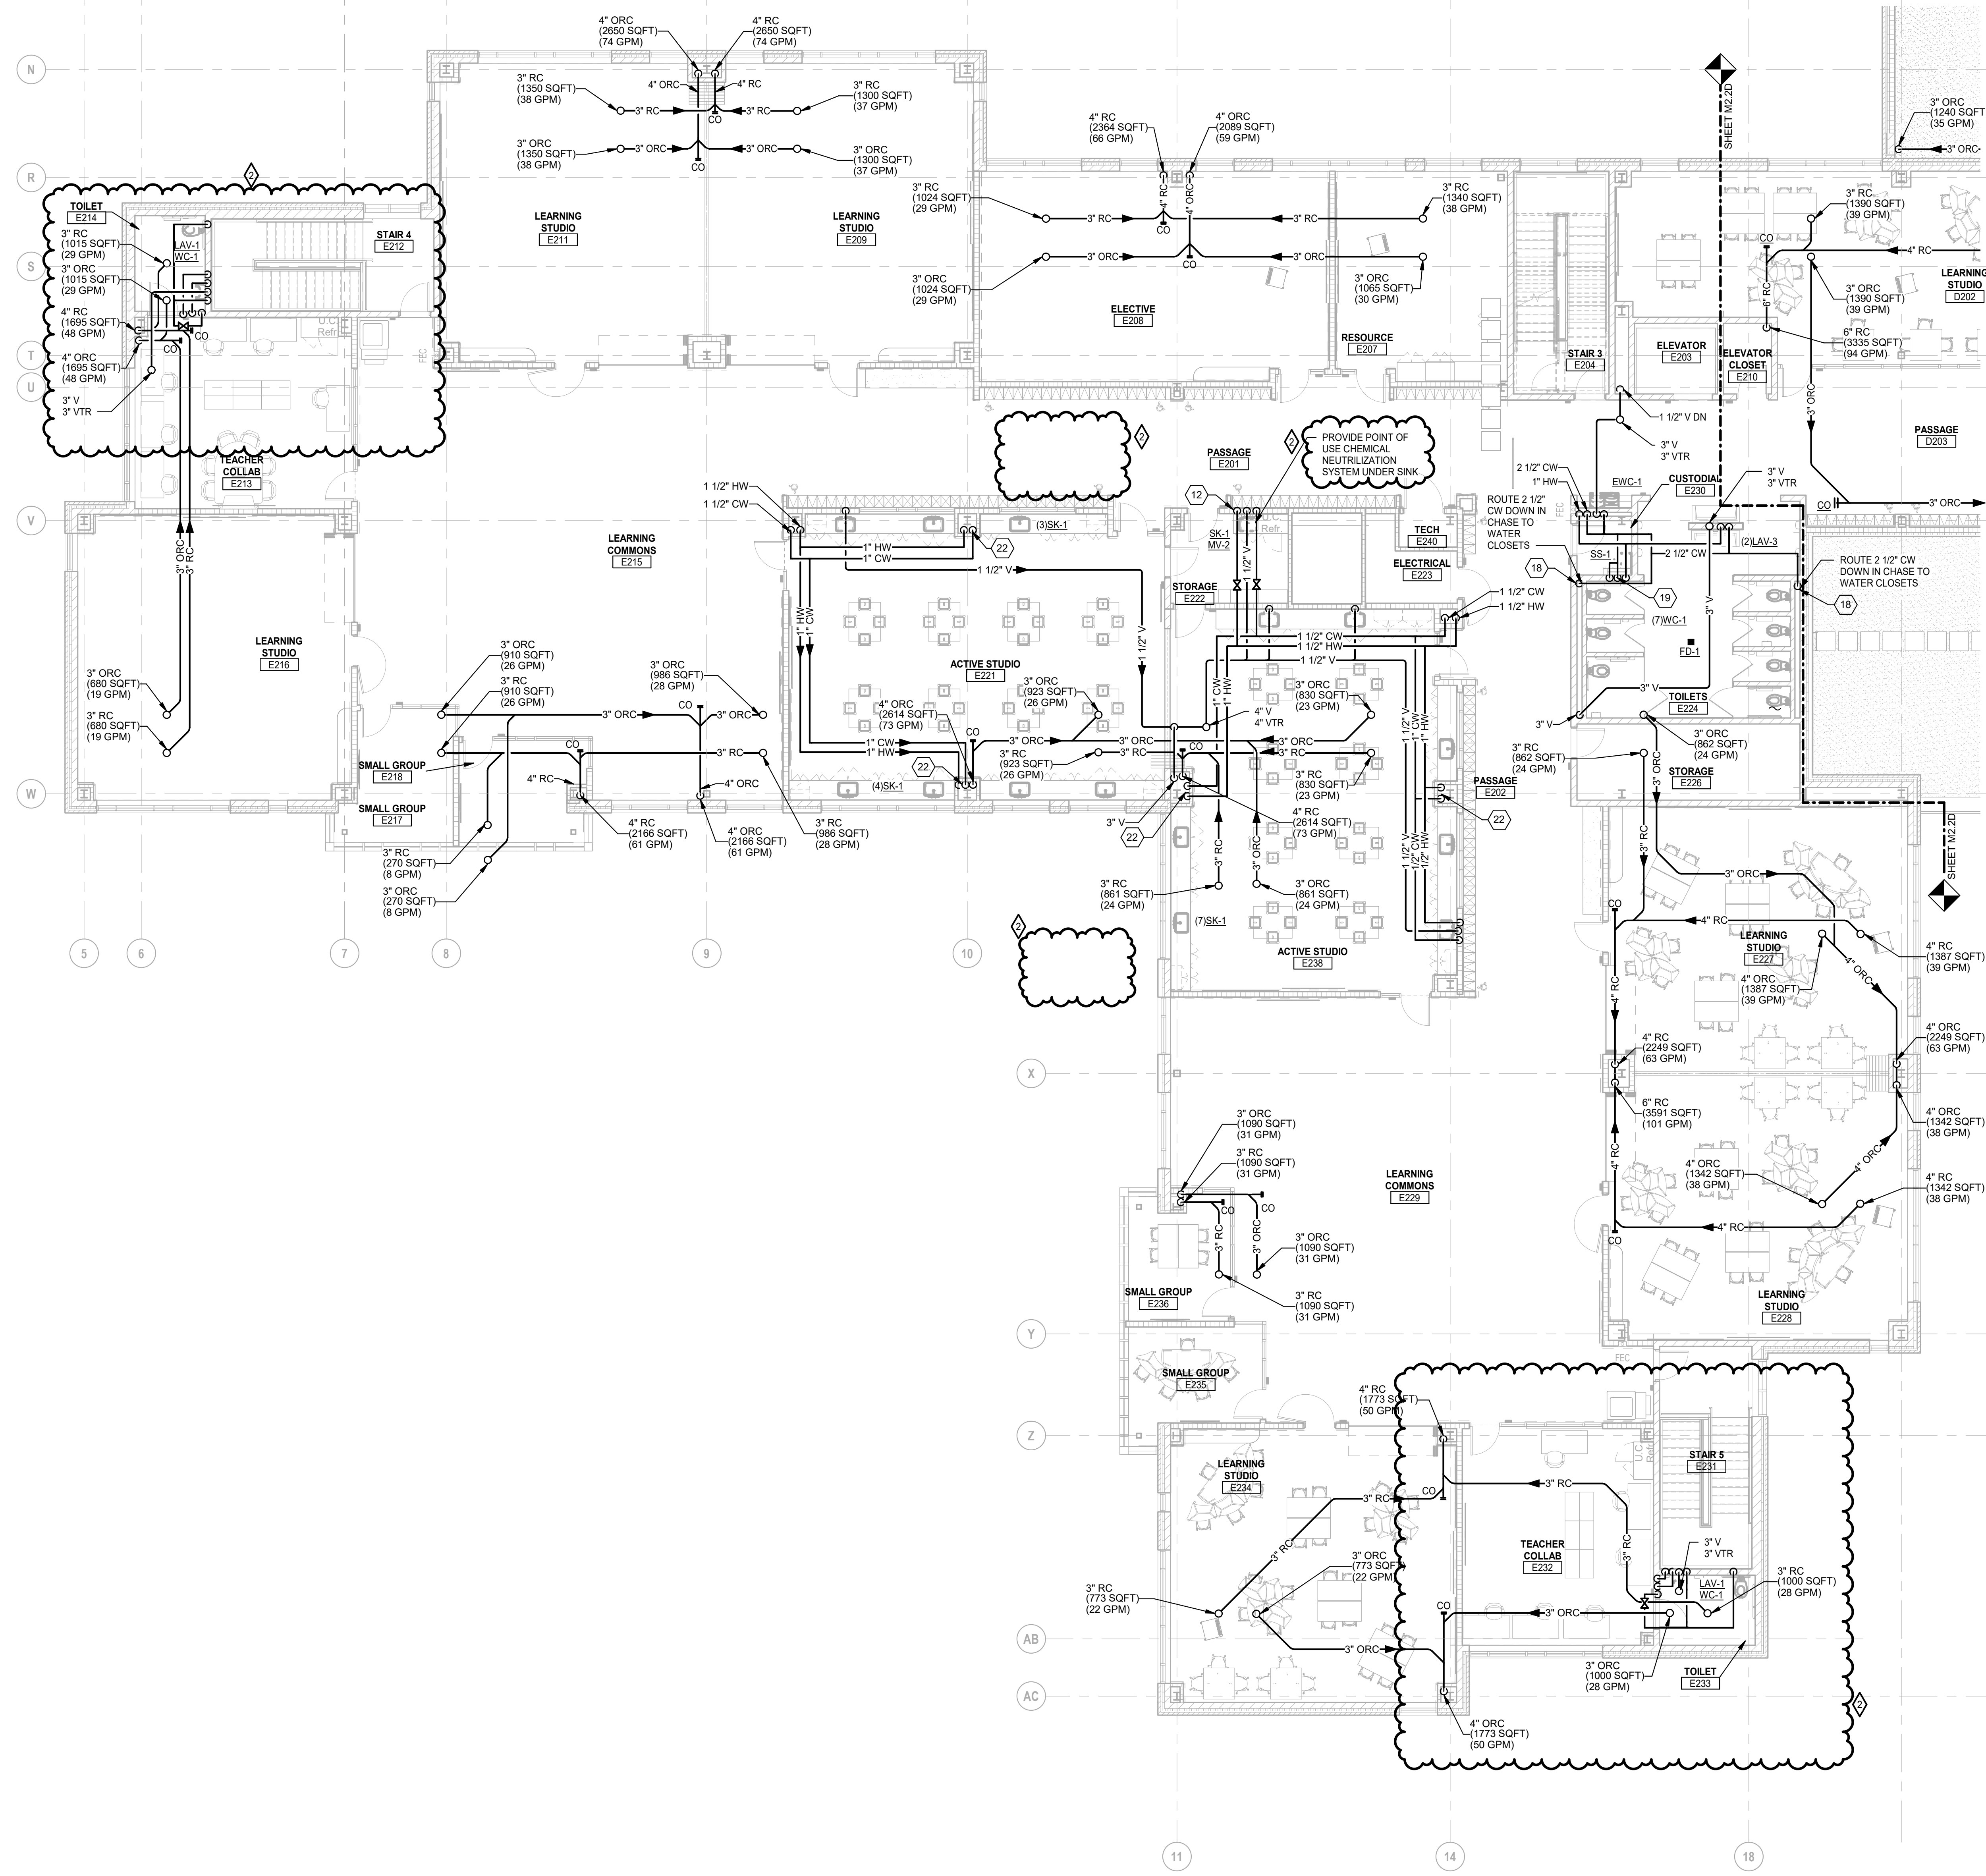

SECOND LEVEL PLUMBING PLAN - ZONE 'E'
SCALE: 1/8" = 1'-0"

PLUMBING GENERAL NOTES:

- 1 THESE DRAWINGS ARE DIAGNOMATIC, AND REPRESENT THE GENERAL INTENT AND ARRANGEMENT OF SYSTEMS. THEY ARE NOT TO BE CONSIDERED FABRICATION OR INSTALLATION DRAWINGS. COORDINATION WITH OTHER TRADES IS REQUIRED. PROVIDE THE ADDITIONAL FITTINGS AND OFFSETS THAT WILL BE REQUIRED TO COMPLETE EACH SYSTEM AND TO AVOID INTERFERENCES WITH ALL OTHER SYSTEMS INCLUDING THE STRUCTURE, SHEET METAL, OTHER PIPING SYSTEMS, ELECTRICAL CONDUITS, BUS DUCTS, CABLE TRAY, LIGHT FIXTURES, ETC. AND/OR OTHER SPACE CONSTRAINTS.
- 2 INSTALL SYSTEMS SUCH THAT REQUIRED CLEARANCE AND SERVICE ACCESS SPACE IS PROVIDED AROUND ALL MECHANICAL AND ELECTRICAL EQUIPMENT, AND AROUND ANY COMPONENTS WHICH REQUIRE SERVICE ACCESS.
- 3 PIPING SHALL NOT BE INSTALLED ABOVE ELECTRICAL TRANSFORMERS, SWITCHBOARDS, PANELBOARDS OR MOTOR CONTROL CENTERS.
- 4 COORDINATE AND PROVIDE ACCESS DOORS WITHIN INACCESSIBLE CEILING SHAFT, AND CHASE AREAS FOR ALL COMPONENTS WHICH REQUIRE SERVICE ACCESS. REFER TO ARCHITECTURAL DRAWINGS FOR CEILING TYPES.
- 5 PROVIDE SUPPLEMENTARY STEEL AS REQUIRED FOR THE PROPER SUPPORT OF ALL SYSTEMS.
- 6 REFER TO ARCHITECTURAL PLANS FOR DIMENSIONED LOCATIONS OF PLUMBING FIXTURES.
- 7 HOT AND COLD WATER PIPING RUN-OUTS TO LAVATORIES AND SINKS SHALL BE 1/2" UNLESS OTHERWISE NOTED.
- 8 PLUMBING VENT PIPING THROUGH ROOF SHALL BE LOCATED A MINIMUM OF 10'-0" FROM ANY FRESH AIR INTAKE LOCATION AND A MINIMUM OF 18" CLEAR FROM THE INSIDE FACE OF PARAPET.
- 9 PROVIDE CODE REQUIRED CLEARANCE FOR ALL CLEANOUTS INSTALLED IN SANITARY WASTE AND VENT PIPING.
- 10 MINIMUM UNDERGROUND PIPE SIZE SHALL BE 3".
- 11 WATER SERVICE ENTRANCE PIPING SHALL BE BURIED WITH DEPTH OF COVER OVER TOP OF PIPE OF AT LEAST 4'-0" OR WITH TOP OF PIPE AT LEAST 12" BELOW LEVEL OF MAXIMUM FROST PENETRATION, OR AS REQUIRED BY AUTHORITIES HAVING JURISDICTION, WHICHEVER IS DEEPEST.

CONSTRUCTION KEY NOTES:

- 1 3 SAN TO SINK/LAV.
- 2 3 SAN TO FDIS.
- 3 ROUTE 3/4 PUMPED CONDENSATE FROM HP-101 AND HP-102 TO CUSTODIAL A134 AND SPILL INTO SERVICE SINK.
- 4 3 SAN TO EWC.
- 5 3 SAN TO WASHING MACHINE OX BOX LOCATION.
- 6 3 SAN TO SS.
- 7 3 SAN TO SHOWER DRAIN.
- 8 ROUTE PSAN FROM SP-2 TO HUB OUTLET LOCATED IN CUSTODIAL E130.
- 9 ROUTE 1 1/2 CW & 1 1/2 HW UP TO SECOND FLOOR SINKS IN COLUMN SPACE PROVIDED.
- 10 2 SAN TO SINK/LAV.
- 11 3/4 CW TO ROOF MOUNTED HYDRANT. ROUTE IW TO CODE REQUIRED DISTANCE ABOVE FLOOR DRAIN/SINK.
- 12 EXTEND CW & HW TO M-V LOCATED UNDER SINK TO PROVIDE TEMPERED WATER TO EMERGENCY EYE WASH.
- 13 ROUTE GREASE SANITARY PIPING FROM THREE COMPARTMENT SINK TO GREASE INTERCEPTOR.
- 14 REFER TO NATURAL GAS DIAGRAM ON SHEET M6.4 FOR ROUTING AND SIZING SPECIFIC INFORMATION.
- 15 4 SAN FOR WC.
- 16 4 SAN FOR SANITARY CHASE.
- 17 ROUTE 1 1/2 IW FROM FSE PROVIDED FIXTURE AND TERMINATE TO CODE REQUIRED DISTANCE TO FLOOR SINK. COORDINATE FINAL PIPING SIZES WITH FSE DRAWINGS PRIOR TO CONSTRUCTION.
- 18 ROUTE PIPING IN CHASE TO FIXTURES. SEE PLUMBING FIXTURE CONNECTION SCHEDULE FOR SIZES TO FIXTURES.
- 19 ROUTE ADDITIONAL 3/4" CW LINE FOR CHEMICAL FEED SYSTEM.
- 20 ROUTE 3/4 CW AND 3/4 HW DOWN IN COLUMN. ROUTE 1/2 CW AND 1/2 HW TO EACH SINK. PIPING UNDER COUNTER SPACE TO CABINET MOUNTED SINK.
- 21 ROUTE 1/2 CW AND 1/2 HW DOWN IN COLUMN OR WALL SPACE. ROUTE 1/2 CW AND 1/2 HW TO SINK. PIPING UNDER COUNTER SPACE TO CABINET MOUNTED SINK.
- 22 ROUTE 1 CW AND 1 HW DOWN IN COLUMN. ROUTE 1/2 CW AND 1/2 HW TO EACH SINK. PIPING UNDER COUNTER SPACE TO CABINET MOUNTED SINK.
- 23 3 SAN TO UR.



TMP ARCHITECTURE INC
1191 WEST SQUARE LAKE ROAD - BOX 289
BLOOMFIELD HILLS - MICHIGAN - 48302
PH: 248.338.4661 FX: 248.338.0223
EM: INFO@TMPARCHITECTURE.COM

REGISTRATION SEAL


CONSULTANT



PROJECT TITLE
NEW SMITH MIDDLE SCHOOL
Bid Package No. 03B

Troy School District
TROY, MI

DRAWING TITLE
SECOND LEVEL PLUMBING PLAN - ZONE 'E'

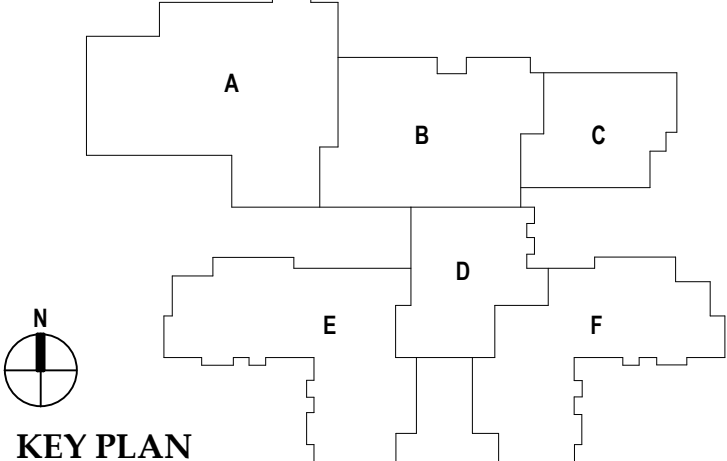

ISSUE DATES table with columns for date, description, and issued for.


07-12-2024 ADDENDUM #2
08-16-2024 CONSTRUCTION DOCUMENTS

DATE: ISSUED FOR: table with columns for date and issued for.

DRAWN: MEP
CHECKED: KLH
APPROVED: SVM
PROJECT NO. 22102
DRAWING NO. M2.2E

7/11/2024 4:04:54 PM Autodesk Docs://22102_Troy_Smith_MS/2024-0184_TSD_Smith_MS_MEP_V22.rvt

THE FOLLOWING DIMENSION EQUALS ONE INCH WHEN PRINTED TO SCALE.

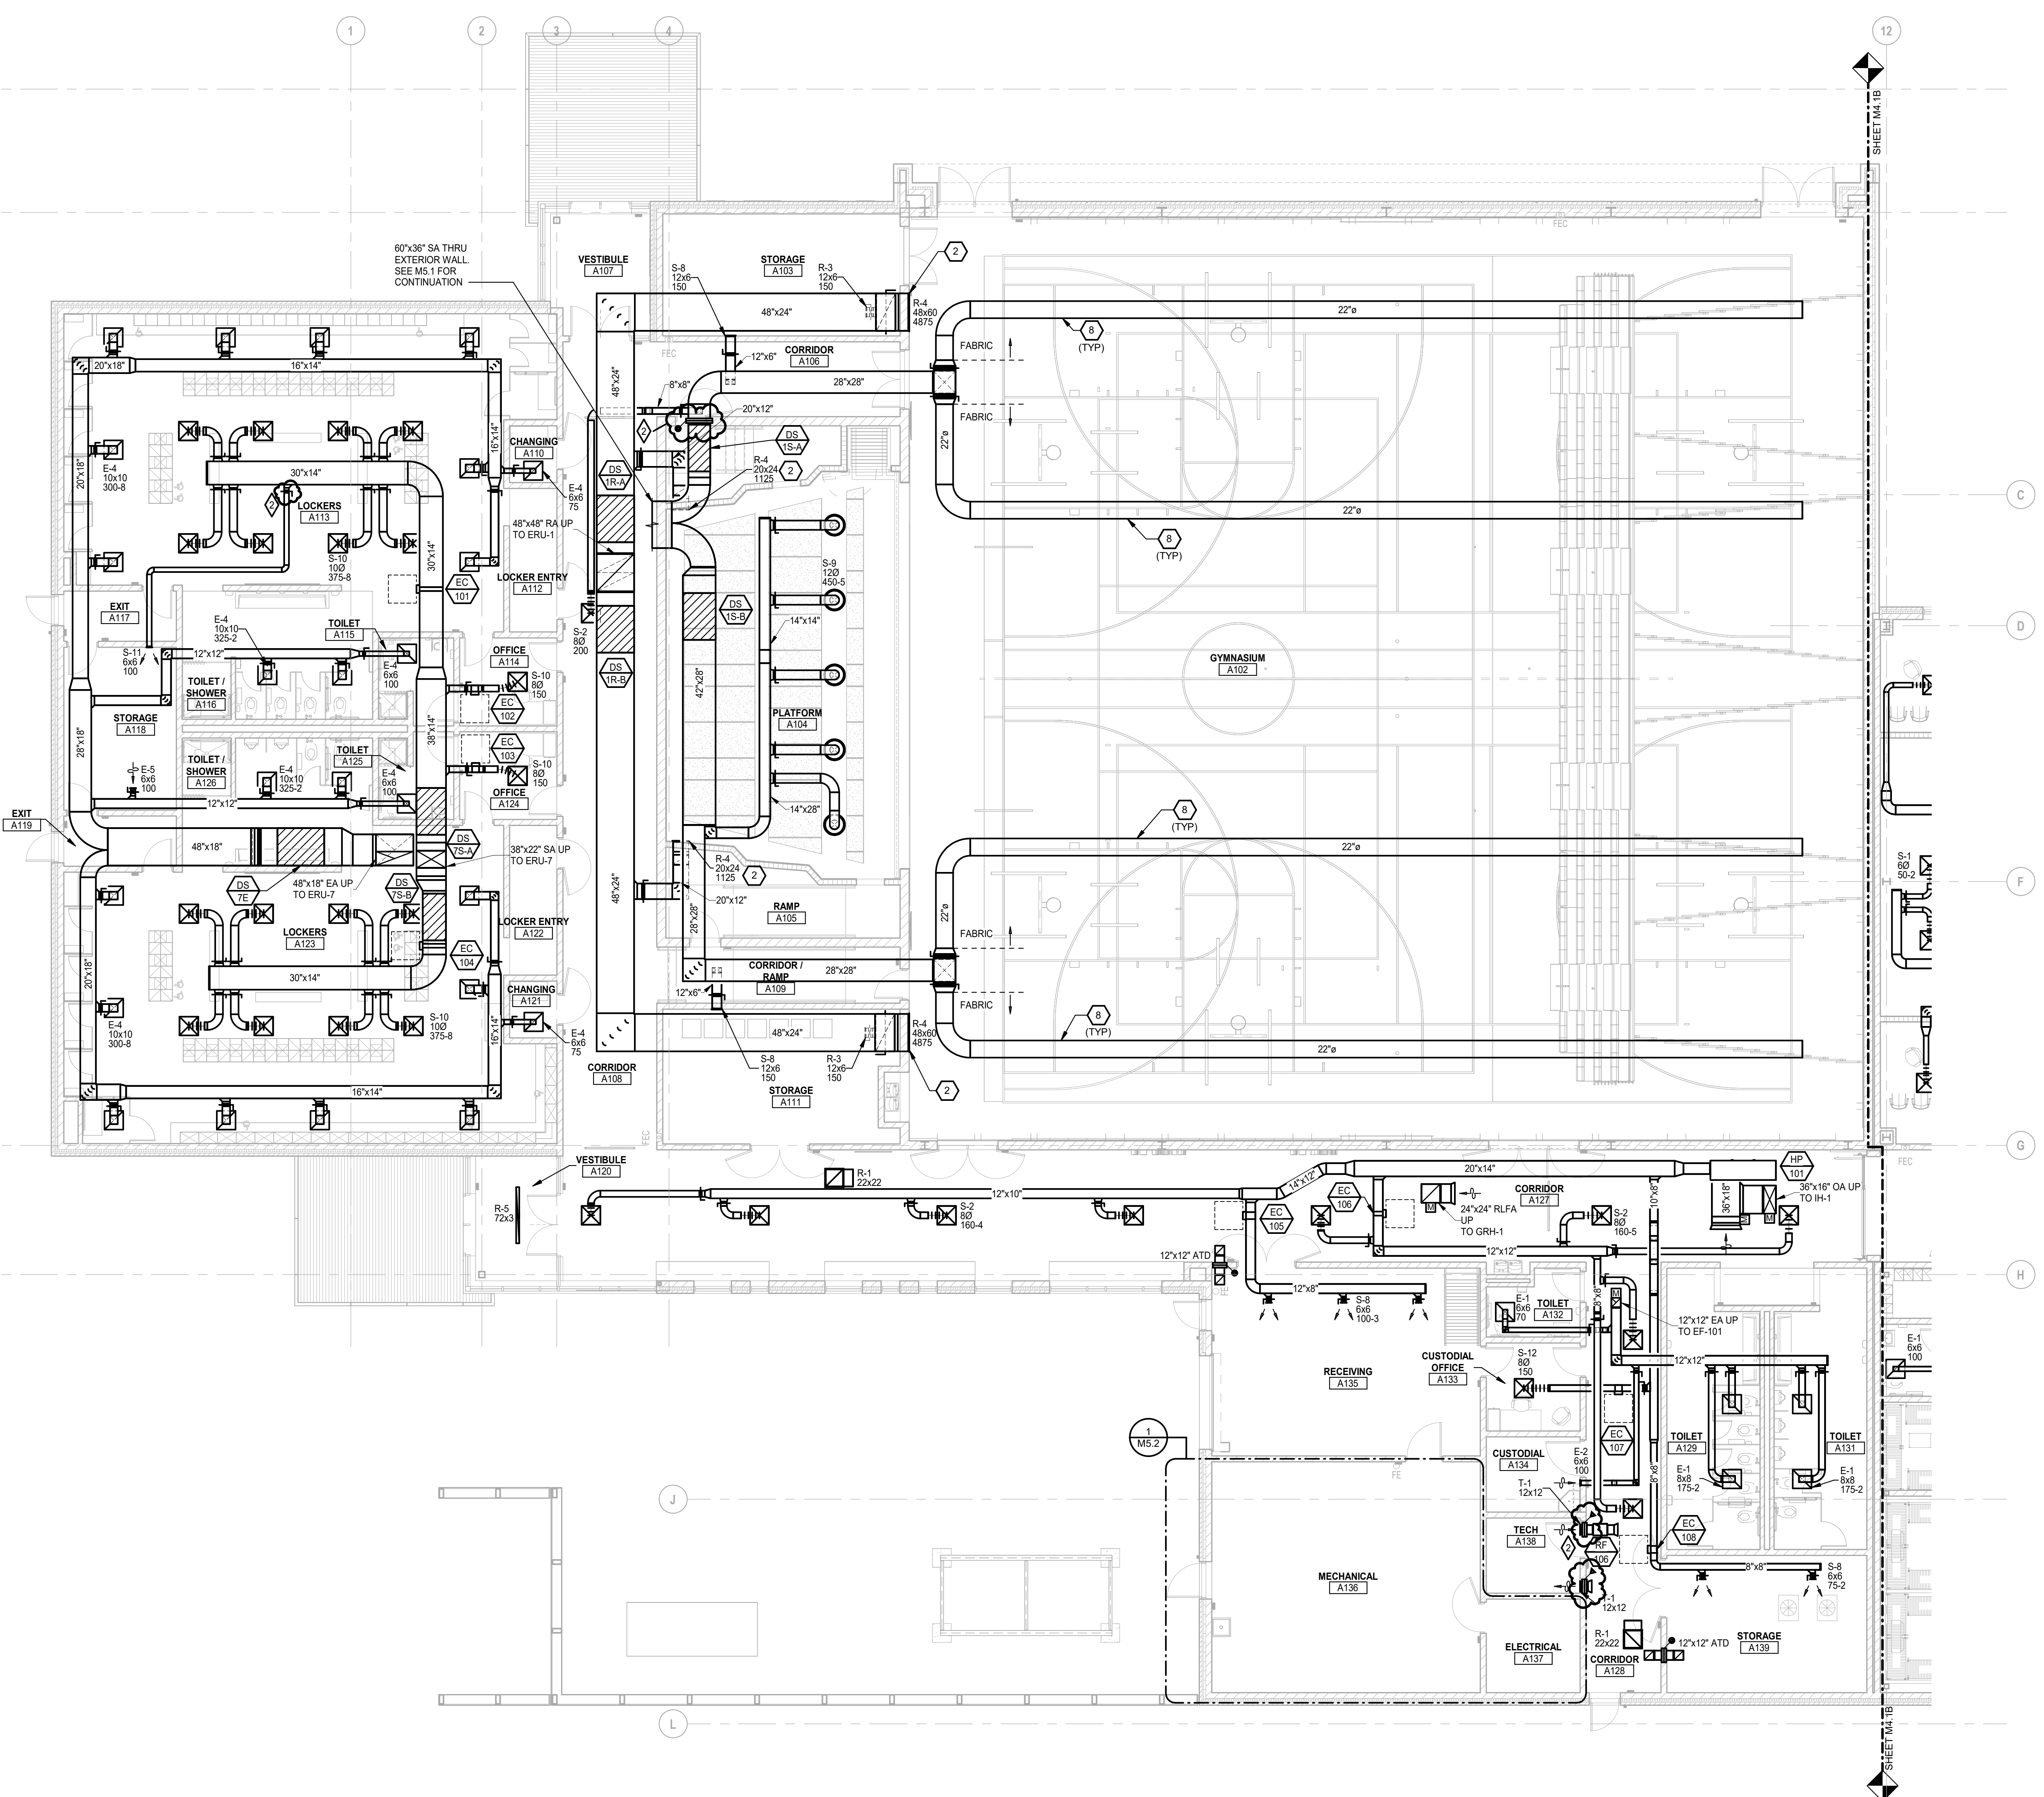

SHEET METAL GENERAL NOTES:

- 1 THESE DRAWINGS ARE DIAGRAMMATIC, AND REPRESENT THE GENERAL INTENT AND ARRANGEMENT OF SYSTEMS. THEY ARE NOT TO BE CONSIDERED FABRICATION COORDINATION SHEETS OF DRAWINGS. COORDINATION WITH OTHER TRADES IS REQUIRED. PROVIDE THE ADDITIONAL FITTINGS AND OFFSETS THAT WILL BE REQUIRED TO COMPLETE EACH SYSTEM AND TO AVOID INTERFERENCES WITH ALL OTHER SYSTEMS INCLUDING THE STRUCTURE, PIPING SYSTEMS, ELECTRICAL CONDUITS, BUS DUCTS, CABLE TRAY, LIGHT FIXTURES, ETC. AND/OR OTHER SPACE CONSTRAINTS.
- 2 INSTALL SYSTEMS SUCH THAT REQUIRED CLEARANCE AND SERVICE ACCESS SPACE IS PROVIDED AROUND ALL MECHANICAL AND ELECTRICAL EQUIPMENT, AND AROUND ANY COMPONENTS WHICH REQUIRE SERVICE ACCESS.
- 3 PIPING AND DUCTWORK SHALL NOT BE INSTALLED ABOVE ELECTRICAL TRANSFORMERS, SWITCHBOARDS, PANELBOARDS OR MOTOR CONTROL CENTERS.
- 4 COORDINATE AND PROVIDE ACCESS DOORS WITH INACCESSIBLE CEILING SHAFT, AND CHASE AREAS FOR ALL COMPONENTS WHICH REQUIRE SERVICE ACCESS. REFER TO ARCHITECTURAL DRAWINGS FOR CEILING TYPES.
- 5 PROVIDE SUPPLEMENTARY STEEL AS REQUIRED FOR THE PROPER SUPPORT OF ALL SYSTEMS.
- 6 REFER TO ARCHITECTURAL REFLECTED CEILING PLANS FOR DIMENSIONED LOCATION OF GRILLES, REGISTERS, AND DIFFUSERS.
- 7 REFER TO TEMPERATURE CONTROLS STANDARD MOUNTING HEIGHTS DETAIL FOR ELEVATIONS OF WALL MOUNTED TEMPERATURE CONTROL DEVICES.

CONSTRUCTION KEY NOTES:

- 1 RELOCATED KILN BY OWNER. ROUTE 6 INCHES EXHAUST CONNECTION FROM KILN UP THROUGH ROOF AND TERMINATE WITH VENT CAP. KILN EXHAUST SHALL BE INSTALLED ACCORDING TO THE MANUFACTURER RECOMMENDATIONS.
- 2 MOUNT BOTTOM OF GRILLE 8 INCHES A.F.F.
- 3 ROUTE 6 INCH DRYER EXHAUST UP THROUGH ROOF AND TERMINATE WITH GOOSENECK.
- 4 PROVIDE DIGITAL TIMER FOR INDICATED EF.
- 5 REFER TO LEARNING STUDIO E128 FOR TYPICAL SHEET METAL LAYOUT.
- 6 REFER TO LEARNING STUDIO E134 FOR TYPICAL SHEET METAL LAYOUT.
- 7 REFER TO ACTIVE STUDIO F138 FOR TYPICAL SHEET METAL LAYOUT.
- 8 PROVIDE FABRIC DUCTWORK IN GYMNASIUM. MECHANICAL CONTRACTOR TO COORDINATE LAYOUT WITH STRUCTURAL STEEL AND JOIST CONFIGURATION.
- 9 ROUTE GREASE DUCT FROM HOOD UP TO EXHAUST FAN.
- 10 ROUTE 6 INCH EA UP THROUGH ROOF TO ROOF CAP ACCESSORY.
- 11 BALANCE TO AIRFLOW INDICATED.
- 12 ROUTE 6 INCH EA THROUGH WALL TO BRICK VENT ACCESSORY.
- 13 PROVIDE DOUBLE WALLED DUCT.
- 14 DUCT LOCATED BENEATH STAIRS.
- 15 ROUTE DUCT TIGHT TO CEILING.
- 16 REFER TO FOOD SERVICE DRAWINGS FOR CONNECTION TO DISHWASHER.
- 17 28x10 MAKEUP AIR CONNECTION TO HOOD.
- 18 PROVIDE 4" CONCRETE CURB AROUND ALL MEZZANINE FLOOR DUCT PENETRATIONS.
- 19 24x12 SA STACKED ABOVE 24x12 EA.
- 20 16x12 SA STACKED ABOVE 12x12 EA.



TMP ARCHITECTURE INC
1191 WEST SQUARE LAKE ROAD - BOX 289
BLOOMFIELD HILLS - MICHIGAN - 48302
PH: 248-388-6961 TX: 248-388-0233
EM: INFO@TMP-ARCHITECTURE.COM

REGISTRATION SEAL

CONSULTANT




Peter Basso Associates Inc
CONSULTING ENGINEERS
5145 Livernois, Suite 100
Troy, Michigan 48068-3276
Tel: 248-879-5666 Fax: 248-879-0007
www.PeterBassoAssociates.com
PBA Project No. 2023.0154

PROJECT TITLE
NEW SMITH MIDDLE SCHOOL
Bid Package No. 03B

Troy School District TROY, MI

DRAWING TITLE
FIRST LEVEL SHEET METAL PLAN - ZONE 'A'

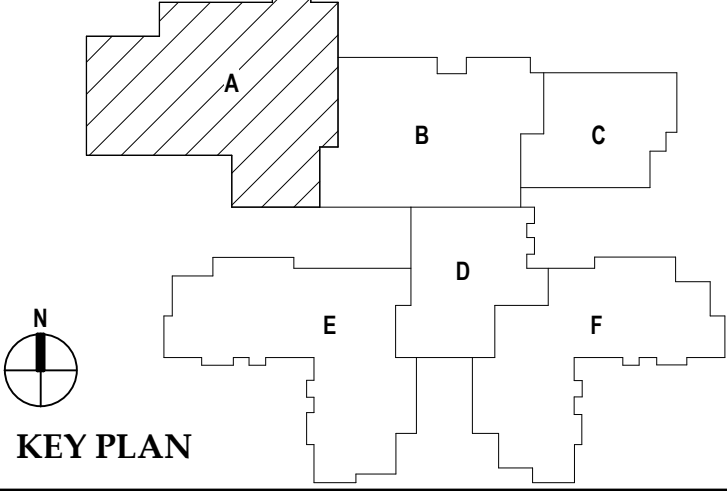

ISSUE DATES

DATE	ISSUED FOR:

07-12-2024 ADDENDUM #2
08-16-2024 CONSTRUCTION DOCUMENTS


DATE	ISSUED FOR:

DRAWN JRB
CHECKED KLH
APPROVED SVM

PROJECT NO.
22102
DRAWING NO.
M4.1A

FIRST LEVEL SHEET METAL PLAN - ZONE 'A'
SCALE: 1/8" = 1'-0"

THE FOLLOWING DIMENSION EQUALS ONE INCH WHEN PRINTED TO SCALE.

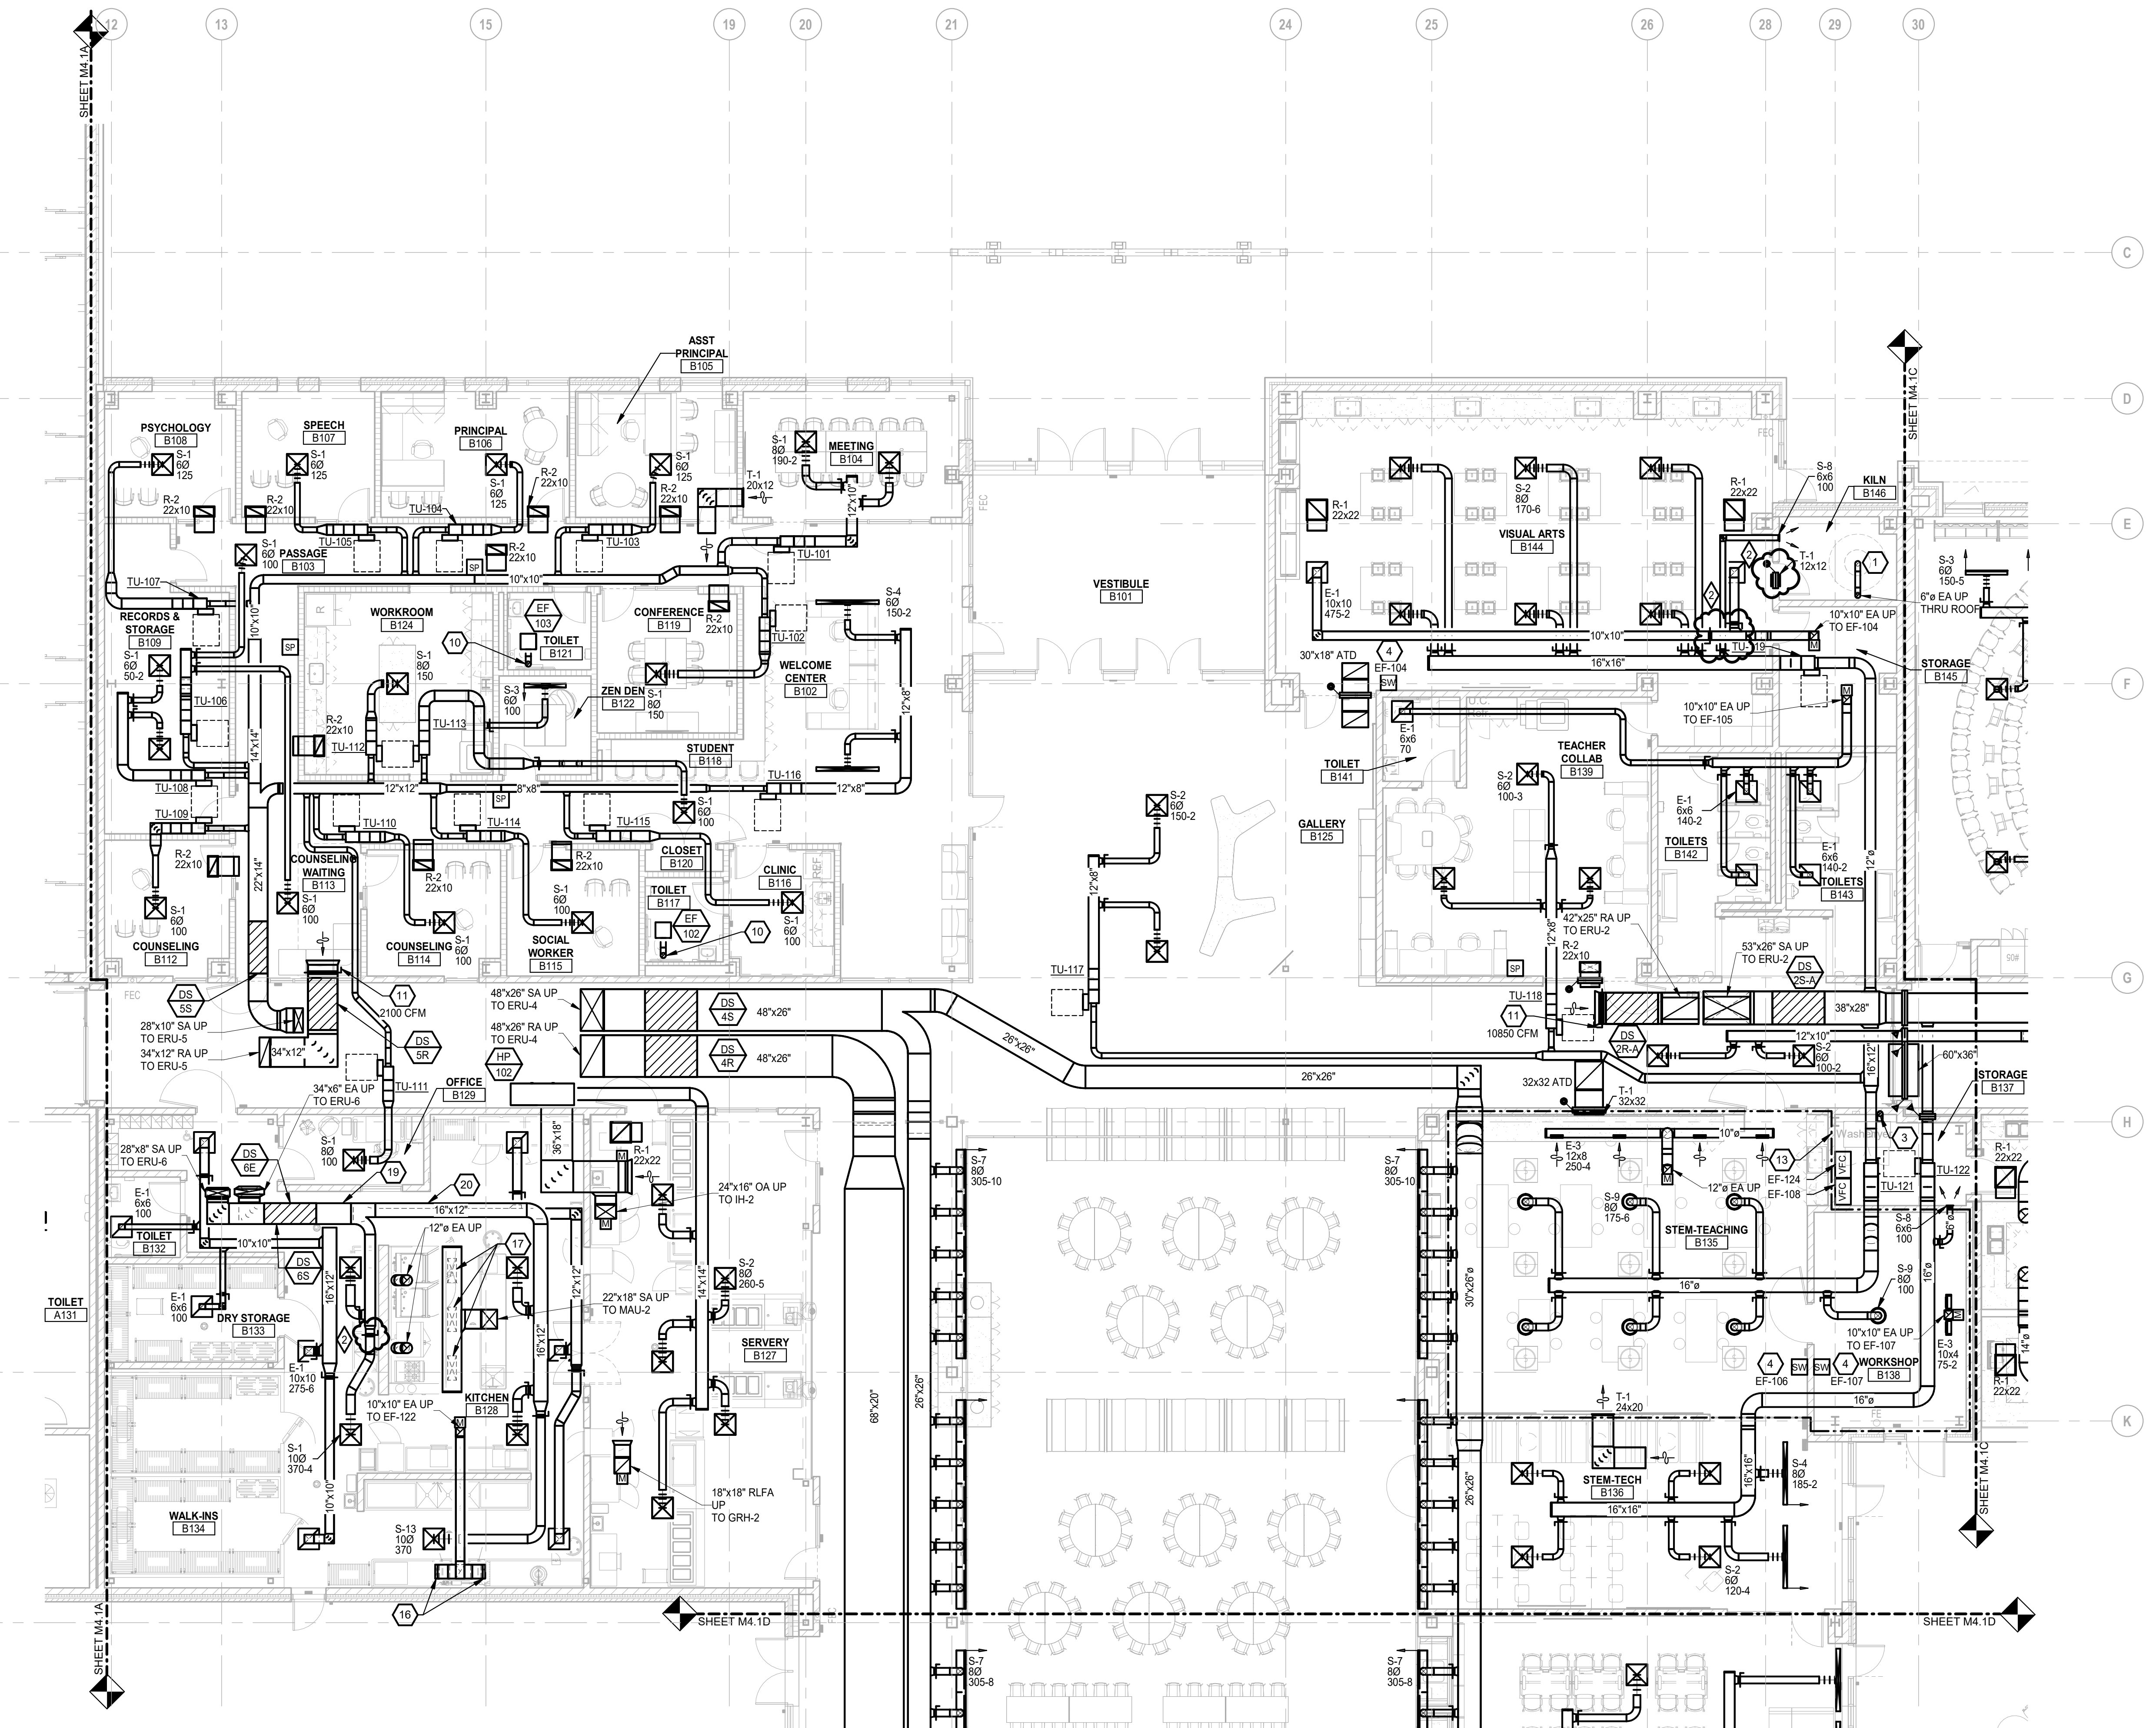

SHEET METAL GENERAL NOTES:

- 1 THESE DRAWINGS ARE DIAGRAMMATIC, AND REPRESENT THE GENERAL INTENT AND ARRANGEMENT OF SYSTEMS. THEY ARE NOT TO BE CONSIDERED FABRICATION COORDINATION DRAWINGS. COORDINATION WITH OTHER TRADES IS REQUIRED. PROVIDE THE ADDITIONAL FITTINGS AND OFFSETS THAT WILL BE REQUIRED TO COMPLETE EACH SYSTEM AND TO AVOID INTERFERENCES WITH ALL OTHER SYSTEMS INCLUDING THE STRUCTURE, PIPING SYSTEMS, ELECTRICAL CONDUITS, BUS DUCTS, CABLE TRAY, LIGHT FIXTURES, ETC. AND/OR OTHER SPACE CONSTRAINTS.
- 2 INSTALL SYSTEMS SUCH THAT REQUIRED CLEARANCE AND SERVICE ACCESS SPACE IS PROVIDED AROUND ALL MECHANICAL AND ELECTRICAL EQUIPMENT, AND AROUND ANY COMPONENTS WHICH REQUIRE SERVICE ACCESS.
- 3 PIPING AND DUCTWORK SHALL NOT BE INSTALLED ABOVE ELECTRICAL TRANSFORMERS, SWITCHBOARDS, PANELBOARDS OR MOTOR CONTROL CENTERS.
- 4 COORDINATE AND PROVIDE ACCESS DOORS WITHIN INACCESSIBLE CEILING SHAFT, AND CHASE AREAS FOR ALL COMPONENTS WHICH REQUIRE SERVICE ACCESS. REFER TO ARCHITECTURAL DRAWINGS FOR CEILING TYPES.
- 5 PROVIDE SUPPLEMENTARY STEEL AS REQUIRED FOR THE PROPER SUPPORT OF ALL SYSTEMS.
- 6 REFER TO ARCHITECTURAL REFLECTED CEILING PLANS FOR DIMENSIONED LOCATION OF GRILLES, REGISTERS, AND DIFFUSERS.
- 7 REFER TO TEMPERATURE CONTROLS STANDARD MOUNTING HEIGHTS DETAIL FOR ELEVATIONS OF WALL MOUNTED TEMPERATURE CONTROL DEVICES.

CONSTRUCTION KEY NOTES:

- 1 RELOCATED KILN BY OWNER. ROUTE 6\"/>

FIRST LEVEL SHEET METAL PLAN - ZONE 'B'
SCALE: 1/8" = 1'-0"



TMP ARCHITECTURE INC
1191 WEST SQUARE LAKE ROAD - BOX 289
BLOOMFIELD HILLS - MICHIGAN 48302
TEL: 248.338.6941 FAX: 248.338.0223
EM: INFO@TMP-ARCHITECTURE.COM

REGISTRATION SEAL

CONSULTANT




Peter Basso Associates Inc
CONSULTING ENGINEERS
5145 Livernois, Suite 100
Troy, Michigan 48098-3276
Tel: 248-679-5666
Fax: 248-679-0007
www.PeterBassoAssociates.com
PBA Project No.: 2023.0154

PROJECT TITLE
NEW SMITH MIDDLE SCHOOL
Bid Package No. 03B

Troy School District
TROY, MI

DRAWING TITLE
FIRST LEVEL SHEET METAL PLAN - ZONE 'B'

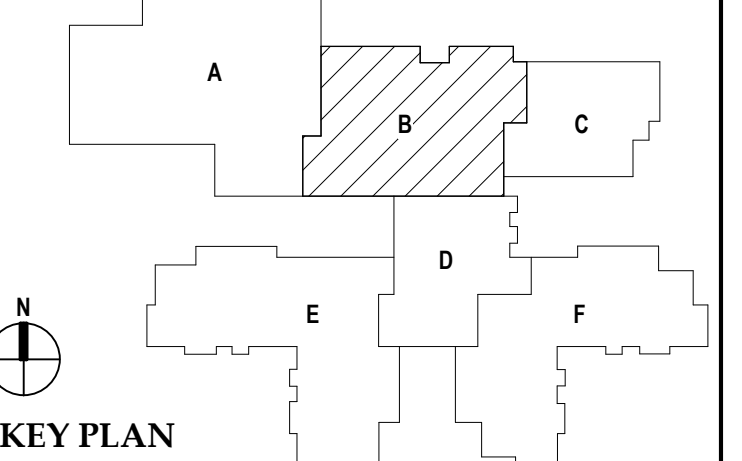

ISSUE DATES

DATE	DESCRIPTION

DATE	ADDENDUM #	CONSTRUCTION DOCUMENTS
07-12-2024		
06-16-2024		




DATE: ISSUED FOR:

DRAWN	JRB
CHECKED	KLH
APPROVED	SVM

PROJECT NO.
22102

DRAWING NO.
M4.1B

THE FOLLOWING DIMENSION EQUALS ONE INCH WHEN PRINTED TO SCALE.

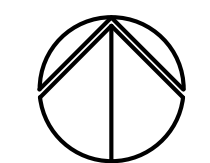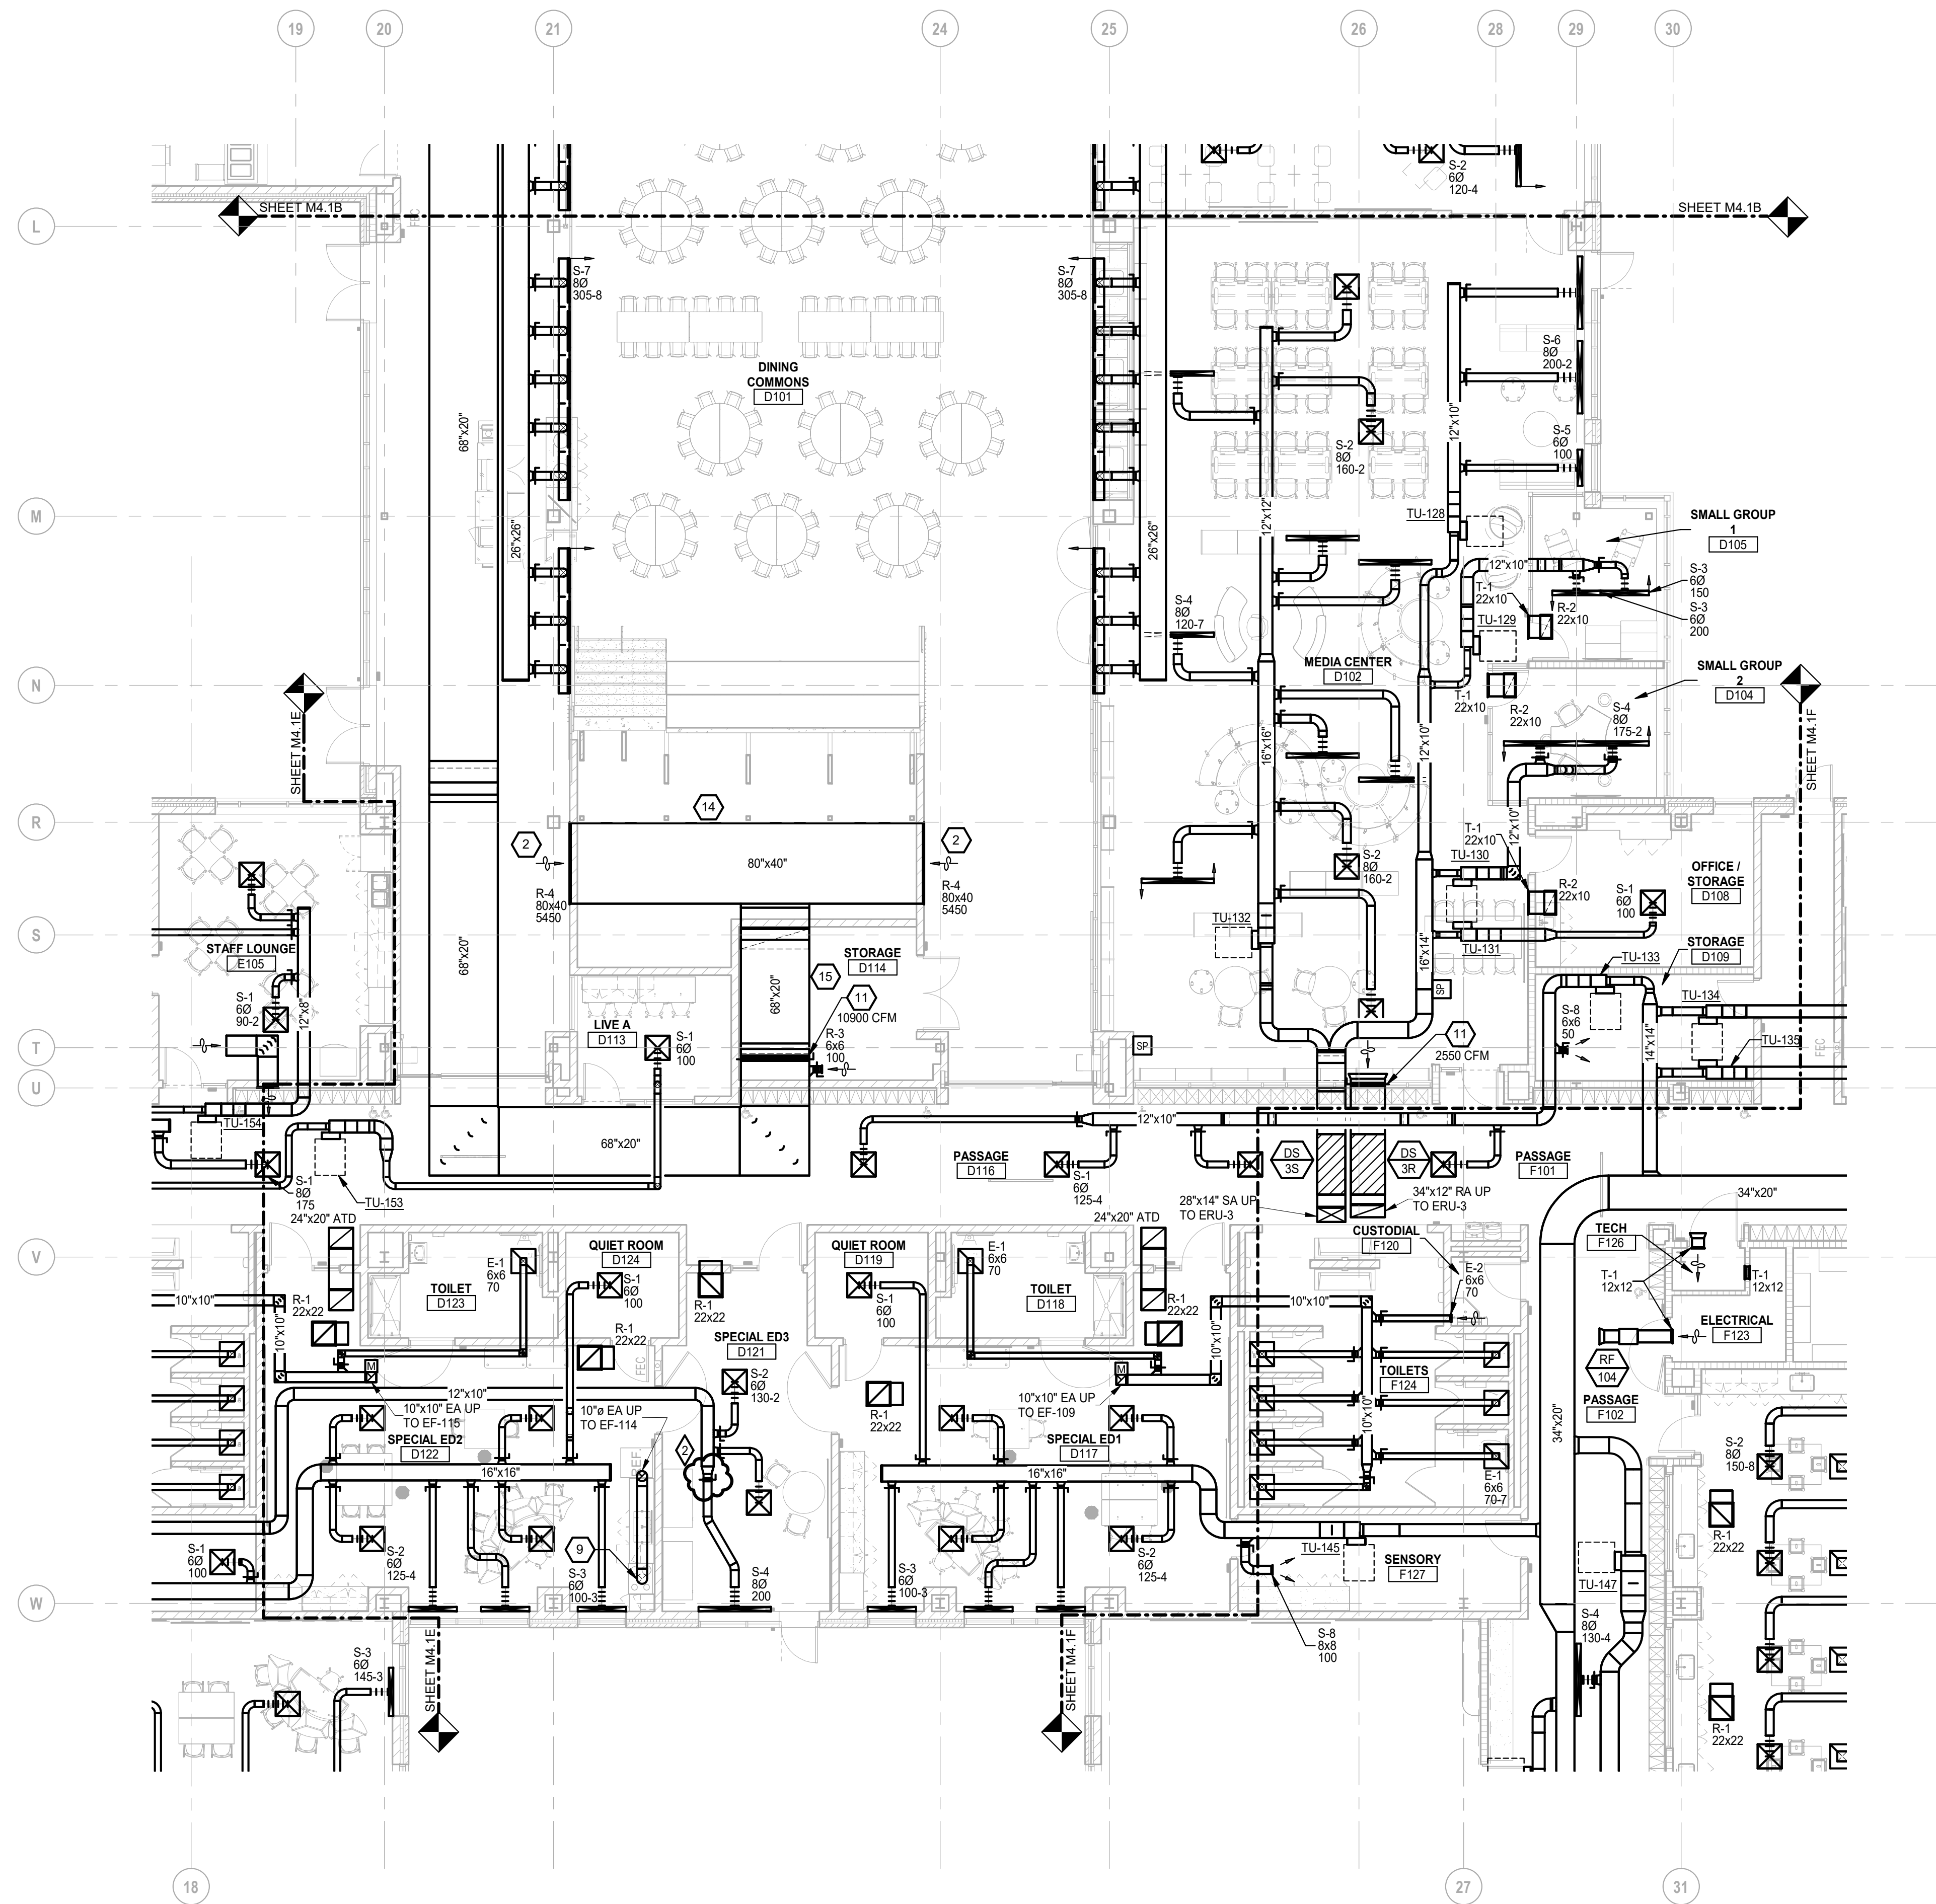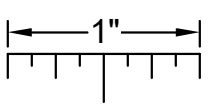

FIRST LEVEL SHEET METAL PLAN - ZONE 'D'

SCALE: 1/8" = 1'-0"

SHEET METAL GENERAL NOTES:

- THESE DRAWINGS ARE DIAGRAMMATIC, AND REPRESENT THE GENERAL INTENT AND ARRANGEMENT OF SYSTEMS. THEY ARE NOT TO BE CONSIDERED FABRICATION/COORDINATION/SHOP DRAWINGS. COORDINATION WITH OTHER TRADES IS REQUIRED. PROVIDE THE ADDITIONAL FITTINGS AND OFFSETS THAT WILL BE REQUIRED TO COMPLETE EACH SYSTEM AND TO AVOID INTERFERENCES WITH ALL OTHER SYSTEMS INCLUDING THE STRUCTURE, PIPING SYSTEMS, ELECTRICAL CONDUITS, BUS DUCTS, CABLE TRAY, LIGHT FIXTURES, ETC. AND/OR OTHER SPACE CONSTRAINTS.
- INSTALL SYSTEMS SUCH THAT REQUIRED CLEARANCE AND SERVICE ACCESS SPACE IS PROVIDED AROUND ALL MECHANICAL AND ELECTRICAL EQUIPMENT, AND AROUND ANY COMPONENTS WHICH REQUIRE SERVICE ACCESS.
- PIPING AND DUCTWORK SHALL NOT BE INSTALLED ABOVE ELECTRICAL TRANSFORMERS, SWITCHBOARDS, PANELBOARDS OR MOTOR CONTROL CENTERS.
- COORDINATE AND PROVIDE ACCESS DOORS WITHIN INACCESSIBLE CEILING SHAFT, AND CHASE AREAS FOR ALL COMPONENTS WHICH REQUIRE SERVICE ACCESS. REFER TO ARCHITECTURAL DRAWINGS FOR CEILING TYPES.
- PROVIDE SUPPLEMENTARY STEEL AS REQUIRED FOR THE PROPER SUPPORT OF ALL SYSTEMS.
- REFER TO ARCHITECTURAL REFLECTED CEILING PLANS FOR DIMENSIONED LOCATION OF GRILLES, REGISTERS, AND DIFFUSERS.
- REFER TO TEMPERATURE CONTROLS STANDARD MOUNTING HEIGHTS DETAIL FOR ELEVATIONS OF WALL MOUNTED TEMPERATURE CONTROL DEVICES.

CONSTRUCTION KEY NOTES:

- RELOCATED KILN BY OWNER. ROUTE 66 INCHES EXHAUST CONNECTION FROM KILN UP THROUGH ROOF AND TERMINATE WITH VENT CAP. KILN EXHAUST SHALL BE INSTALLED ACCORDING TO THE MANUFACTURER RECOMMENDATIONS.
- MOUNT BOTTOM OF GRILLE 8 INCHES A.F.F.
- ROUTE 66 DRYER EXHAUST UP THROUGH ROOF AND TERMINATE WITH GOOSENECK.
- PROVIDE DIGITAL TIMER FOR INDICATED EF.
- REFER TO LEARNING STUDIO E128 FOR TYPICAL SHEET METAL LAYOUT.
- REFER TO LEARNING STUDIO E134 FOR TYPICAL SHEET METAL LAYOUT.
- REFER TO ACTIVE STUDIO F138 FOR TYPICAL SHEET METAL LAYOUT.
- PROVIDE FABRIC DUCTWORK IN GYMNASIUM. MECHANICAL CONTRACTOR TO COORDINATE LAYOUT WITH STRUCTURAL STEEL AND JOIST CONFIGURATION.
- ROUTE GREASE DUCT FROM HOOD UP TO EXHAUST FAN.
- ROUTE 66 EA UP THROUGH ROOF TO ROOF CAP ACCESSORY.
- BALANCE TO AIRFLOW INDICATED.
- ROUTE 66 EA THROUGH WALL TO BRICK VENT ACCESSORY.
- PROVIDE DOUBLE WALLED DUCT.
- DUCT LOCATED BENEATH STAIRS.
- ROUTE DUCT TIGHT TO CEILING.
- REFER TO FOOD SERVICE DRAWINGS FOR CONNECTION TO DISHWASHER.
- 28x10 MAKEUP AIR CONNECTION TO HOOD.
- PROVIDE 4" CONCRETE CURB AROUND ALL MEZZANINE FLOOR DUCT PENETRATIONS.
- 24x12 SA STACKED ABOVE 24x12 EA.
- 16x12 SA STACKED ABOVE 12x12 EA.



TMP ARCHITECTURE INC
1191 WEST SQUARE LAKE ROAD - BOX 289
BLOOMFIELD HILLS - MICHIGAN - 48302
TEL: 248-338-6861 FAX: 248-338-0223
EM: INFO@TMPARCHITECTURE.COM

REGISTRATION SEAL

CONSULTANT




Peter Basso Associates Inc
CONSULTING ENGINEERS
5145 Livernois, Suite 100
Troy, Michigan 48068-3276
Tel: 248-879-5666 Fax: 248-879-0007
www.PeterBassoAssociates.com
PBA Project No. 2023.0154

PROJECT TITLE
**NEW SMITH
MIDDLE SCHOOL**
Bid Package No. 03B

Troy School District
TROY, MI

DRAWING TITLE
**FIRST LEVEL SHEET METAL
PLAN - ZONE 'D'**

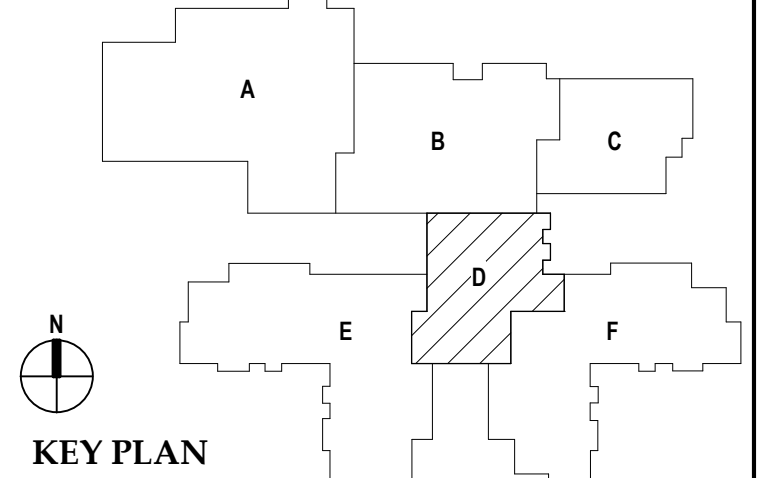

KEY PLAN

ISSUE DATES	

07-12-2024	ADDENDUM #2
05-15-2024	CONSTRUCTION DOCUMENTS
DATE:	ISSUED FOR:
DRAWN: JRB	
CHECKED: KLH	
APPROVED: SVM	

PROJECT NO.
22102

DRAWING NO.
M4.1D

THE FOLLOWING DIMENSION EQUALS ONE INCH WHEN PRINTED TO SCALE.

SHEET METAL GENERAL NOTES:

- THESE DRAWINGS ARE DIAGRAMMATIC AND REPRESENT THE GENERAL INTENT AND ARRANGEMENT OF SYSTEMS. THEY ARE NOT TO BE CONSIDERED FABRICATION OR CONSTRUCTION DRAWINGS. COORDINATION WITH OTHER TRADES IS REQUIRED. PROVIDE THE ADDITIONAL FITTINGS AND OFFSETS THAT WILL BE REQUIRED TO COMPLETE EACH SYSTEM AND TO AVOID INTERFERENCES WITH ALL OTHER SYSTEMS INCLUDING THE STRUCTURE, PIPING SYSTEMS, ELECTRICAL CONDUITS, BUS DUCTS, CABLE TRAY, LIGHT FIXTURES, ETC. AND/OR OTHER SPACE CONSTRAINTS.
- INSTALL SYSTEMS SUCH THAT REQUIRED CLEARANCE AND SERVICE ACCESS SPACE IS PROVIDED AROUND ALL MECHANICAL AND ELECTRICAL EQUIPMENT, AND AROUND ANY COMPONENTS WHICH REQUIRE SERVICE ACCESS.
- PIPING AND DUCTWORK SHALL NOT BE INSTALLED ABOVE ELECTRICAL TRANSFORMERS, SWITCHBOARDS, PANELBOARDS OR MOTOR CONTROL CENTERS.
- COORDINATE AND PROVIDE ACCESS DOORS WITHIN INACCESSIBLE CEILING SHAFT, AND CHASE AREAS FOR ALL COMPONENTS WHICH REQUIRE SERVICE ACCESS. REFER TO ARCHITECTURAL DRAWINGS FOR CEILING TYPES.
- PROVIDE SUPPLEMENTARY STEEL AS REQUIRED FOR THE PROPER SUPPORT OF ALL SYSTEMS.
- REFER TO ARCHITECTURAL REFLECTED CEILING PLANS FOR DIMENSIONED LOCATION OF GRILLES, REGISTERS, AND DIFFUSERS.
- REFER TO TEMPERATURE CONTROLS STANDARD MOUNTING HEIGHTS DETAIL FOR ELEVATIONS OF WALL MOUNTED TEMPERATURE CONTROL DEVICES.

CONSTRUCTION KEY NOTES:

- RELOCATED KILN BY OWNER. ROUTE 6 INCHES EXHAUST CONNECTION FROM KILN UP THROUGH ROOF AND TERMINATE WITH VENT CAP. KILN EXHAUST SHALL BE INSTALLED ACCORDING TO THE MANUFACTURER RECOMMENDATIONS.
- MOUNT BOTTOM OF GRILLE 8 INCHES A.F.F.
- ROUTE 6 INCH DRYER EXHAUST UP THROUGH ROOF AND TERMINATE WITH GOOSENECK.
- PROVIDE DIGITAL TIMER FOR INDICATED EF.
- REFER TO LEARNING STUDIO E128 FOR TYPICAL SHEET METAL LAYOUT.
- REFER TO LEARNING STUDIO E134 FOR TYPICAL SHEET METAL LAYOUT.
- REFER TO ACTIVE STUDIO F138 FOR TYPICAL SHEET METAL LAYOUT.
- PROVIDE FABRIC DUCTWORK IN GYMNASIUM. MECHANICAL CONTRACTOR TO COORDINATE LAYOUT WITH STRUCTURAL STEEL AND JOIST CONFIGURATION.
- ROUTE GREASE DUCT FROM HOOD UP TO EXHAUST FAN.
- ROUTE 6 INCH EA UP THROUGH ROOF TO ROOF CAP ACCESSORY.
- BALANCE TO AIRFLOW INDICATED.
- ROUTE 6 INCH EA THROUGH WALL TO BRICK VENT ACCESSORY.
- PROVIDE DOUBLE WALLED DUCT.
- DUCT LOCATED BENEATH STAIRS.
- ROUTE DUCT TIGHT TO CEILING.
- REFER TO FOOD SERVICE DRAWINGS FOR CONNECTION TO DISHWASHER.
- 28x10 MAKEUP AIR CONNECTION TO HOOD.
- PROVIDE 4" CONCRETE CURB AROUND ALL MEZZANINE FLOOR DUCT PENETRATIONS.
- 24x12 SA STACKED ABOVE 24x12 EA.
- 16x12 SA STACKED ABOVE 12x12 EA.



TMP ARCHITECTURE INC
1191 WEST SQUARE LAKE ROAD - BOX 289
BLOOMFIELD HILLS - MICHIGAN 48302
PH: 248.338.4941 FX: 248.338.0223
EM: INFO@TMPARCHITECTURE.COM

REGISTRATION SEAL

CONSULTANT




Peter Basso Associates Inc
CONSULTING ENGINEERS
5145 Livernois, Suite 100
Troy, Michigan 48068-3276
Tel: 248-879-5666
Fax: 248-879-0007
www.PeterBassoAssociates.com
PBA Project No. 2023.0154

PROJECT TITLE
NEW SMITH MIDDLE SCHOOL
Bid Package No. 03B

Troy School District
TROY, MI

DRAWING TITLE
FIRST LEVEL SHEET METAL PLAN - ZONE 'F'

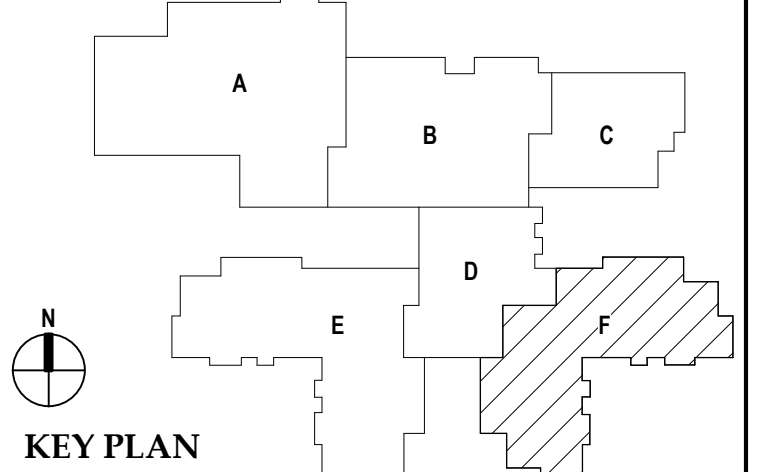

ISSUE DATES

DATE	ISSUED FOR

07-12-2024	ADDENDUM #2
08-16-2024	CONSTRUCTION DOCUMENTS

DATE: ISSUED FOR:


DRAWN: JRB

CHECKED: KLH

APPROVED: SVM

PROJECT NO.
22102


DRAWING NO.
M4.1F

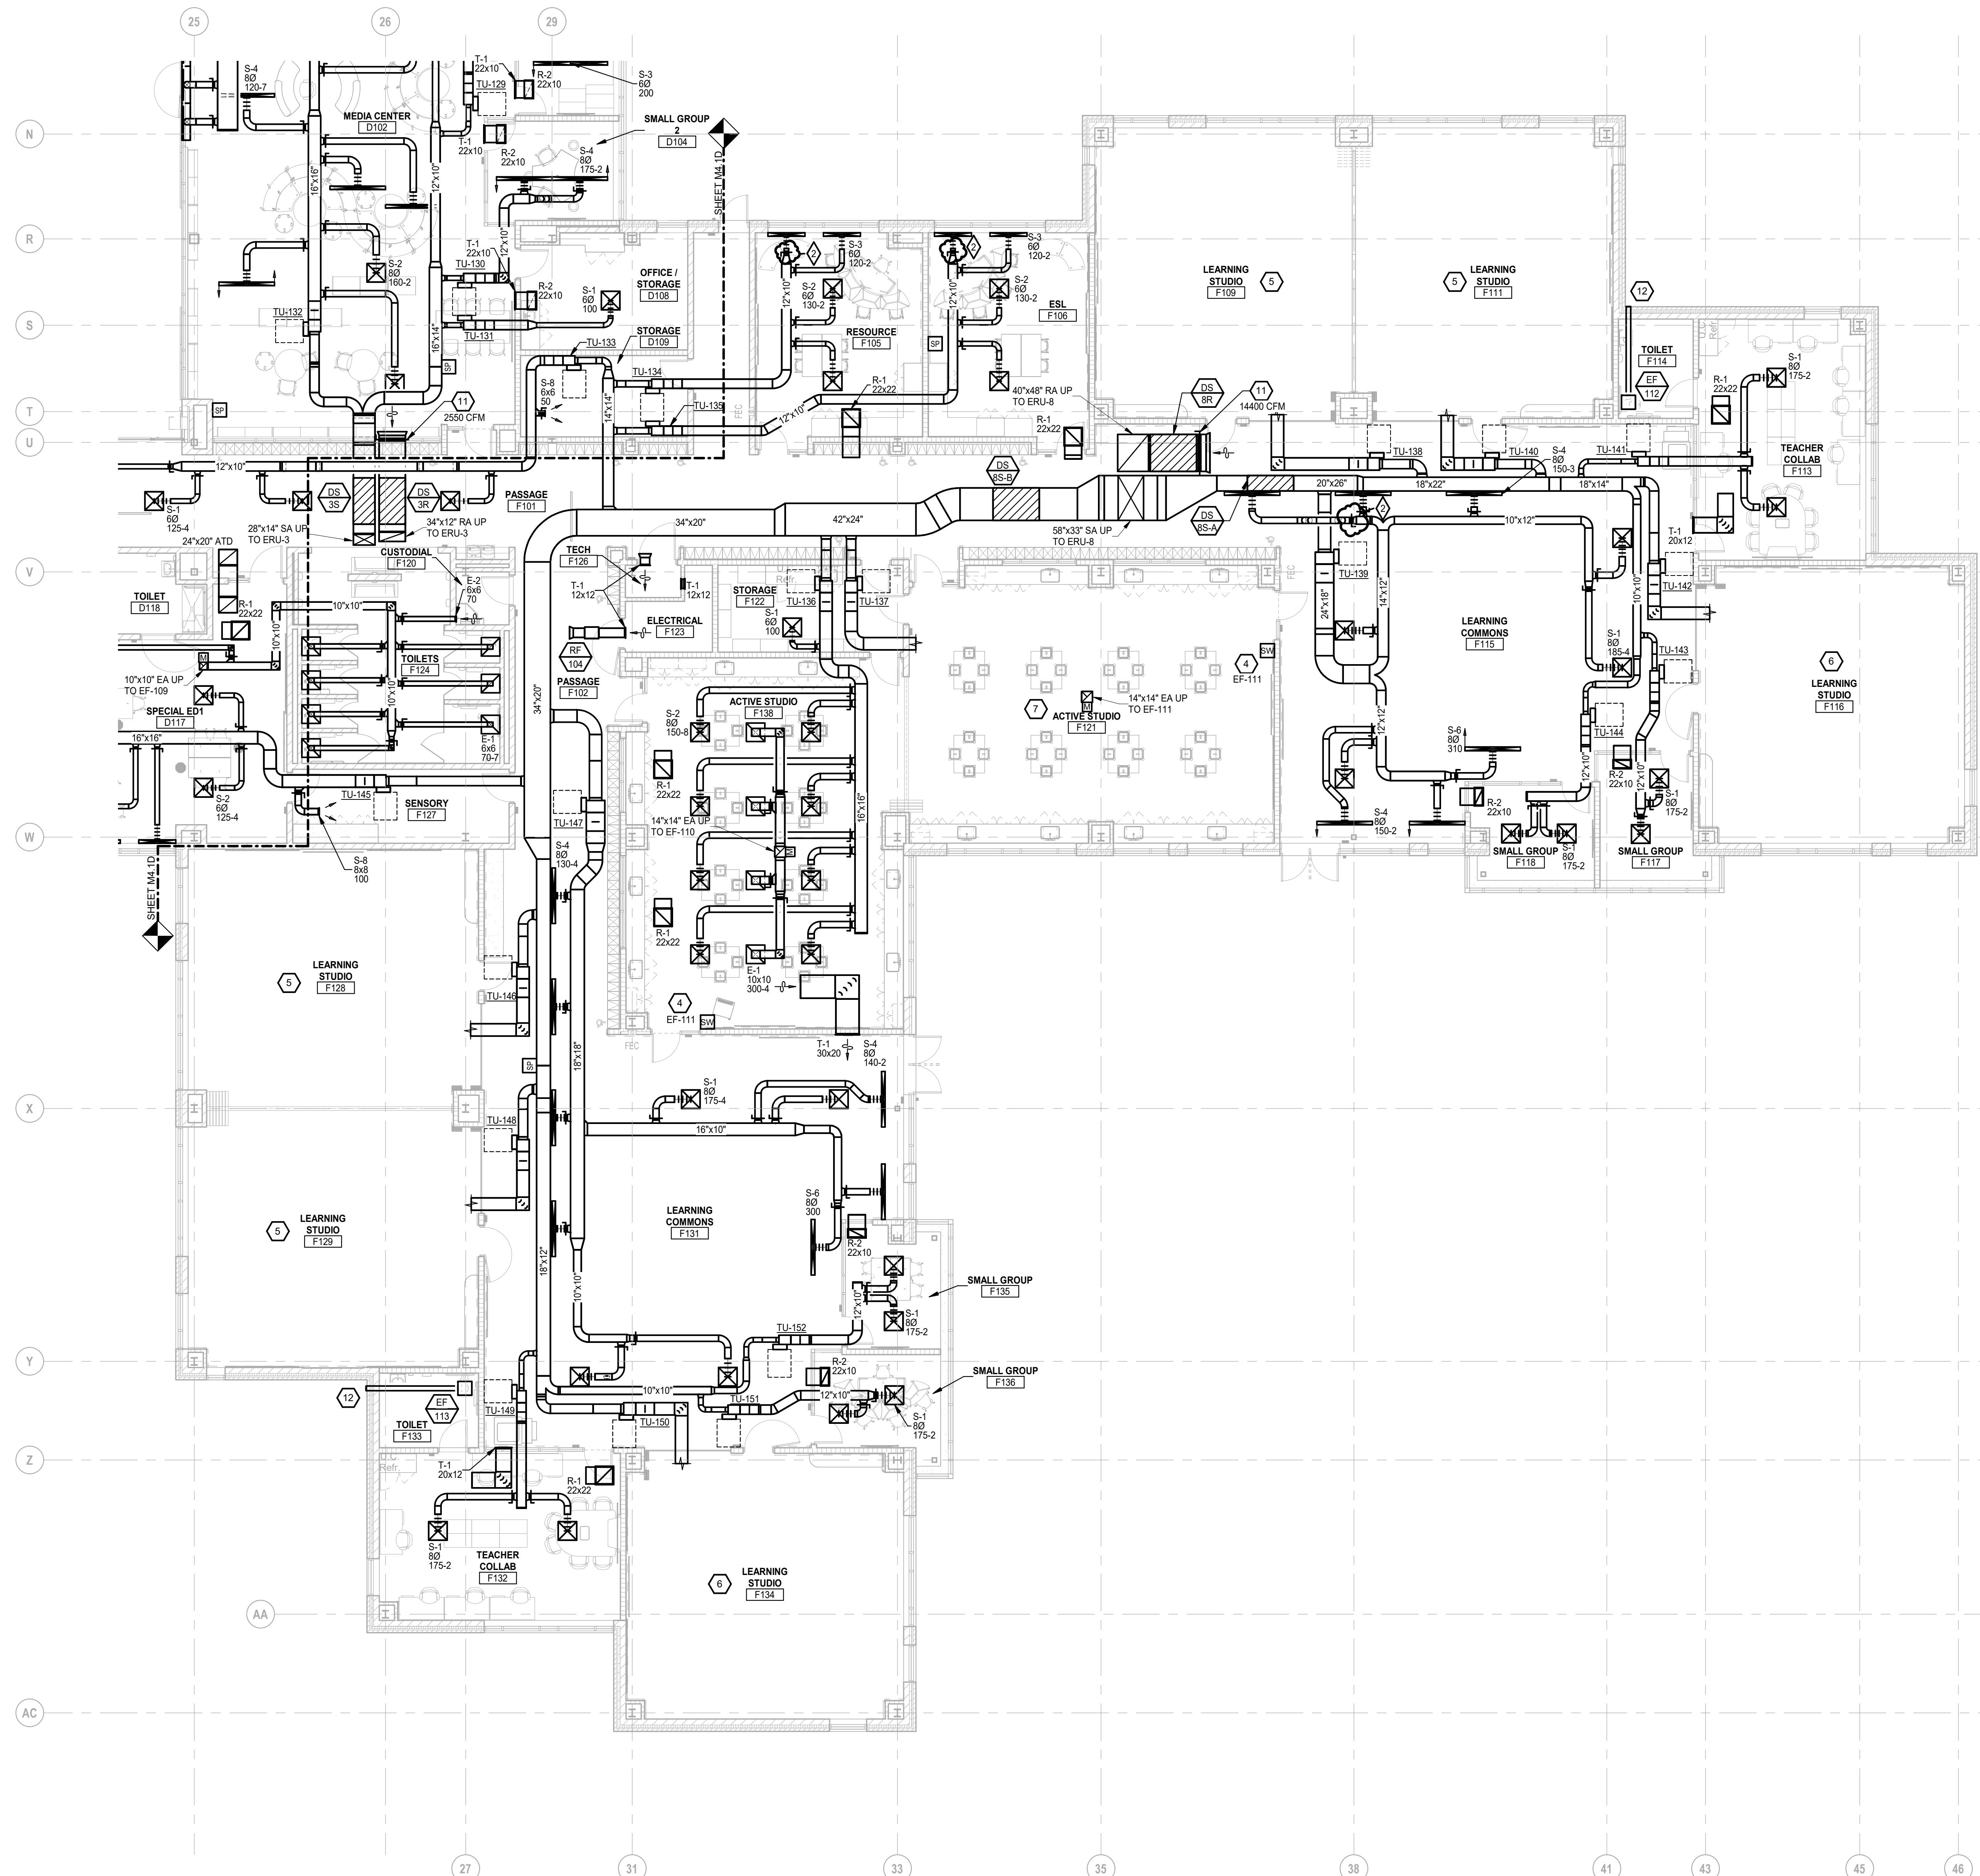

FIRST LEVEL SHEET METAL PLAN - ZONE 'F'
SCALE: 1/8" = 1'-0"

7/11/2024 4:05:32 PM Autodesk Docs://22102_Troy_Smith MS/2023-0154_TSD_Smith MS_MEP_v02.rvt

THE FOLLOWING DIMENSION EQUALS ONE INCH WHEN PRINTED TO SCALE.

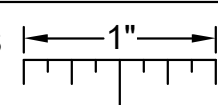

SHEET METAL GENERAL NOTES:

- 1 THESE DRAWINGS ARE DIAGRAMMATIC, AND REPRESENT THE GENERAL INTENT AND ARRANGEMENT OF SYSTEMS. THEY ARE NOT TO BE CONSIDERED FABRICATION COORDINATION DRAWINGS. COORDINATION WITH OTHER TRADES IS REQUIRED. PROVIDE THE ADDITIONAL FITTINGS AND OFFSETS THAT WILL BE REQUIRED TO COMPLETE EACH SYSTEM AND TO AVOID INTERFERENCES WITH ALL OTHER SYSTEMS INCLUDING THE STRUCTURE, PIPING SYSTEMS, ELECTRICAL CONDUITS, BUS DUCTS, CABLE TRAY, LIGHT FIXTURES, ETC. AND/OR OTHER SPACE CONSTRAINTS.
- 2 INSTALL SYSTEMS SUCH THAT REQUIRED CLEARANCE AND SERVICE ACCESS SPACE IS PROVIDED AROUND ALL MECHANICAL AND ELECTRICAL EQUIPMENT, AND AROUND ANY COMPONENTS WHICH REQUIRE SERVICE ACCESS.
- 3 PIPING AND DUCTWORK SHALL NOT BE INSTALLED ABOVE ELECTRICAL TRANSFORMERS, SWITCHBOARDS, PANELBOARDS OR MOTOR CONTROL CENTERS.
- 4 COORDINATE AND PROVIDE ACCESS DOORS WITHIN INACCESSIBLE CEILING SHAFT AND CHASE AREAS FOR ALL COMPONENTS WHICH REQUIRE SERVICE ACCESS. REFER TO ARCHITECTURAL DRAWINGS FOR CEILING TYPES.
- 5 PROVIDE SUPPLEMENTARY STEEL AS REQUIRED FOR THE PROPER SUPPORT OF ALL SYSTEMS.
- 6 REFER TO ARCHITECTURAL REFLECTED CEILING PLANS FOR DIMENSIONED LOCATION OF GRILLES, REGISTERS, AND DIFFUSERS.
- 7 REFER TO TEMPERATURE CONTROLS STANDARD MOUNTING HEIGHTS DETAIL FOR ELEVATIONS OF WALL MOUNTED TEMPERATURE CONTROL DEVICES.

CONSTRUCTION KEY NOTES:

- 1 RELOCATED KILN BY OWNER. ROUTE 6 INCHES EXHAUST CONNECTION FROM KILN UP THROUGH ROOF AND TERMINATE WITH VENT CAP. KILN EXHAUST SHALL BE INSTALLED ACCORDING TO THE MANUFACTURER RECOMMENDATIONS.
- 2 MOUNT BOTTOM OF GRILLE 8 INCHES A.F.F.
- 3 ROUTE 6 INCH DRYER EXHAUST UP THROUGH ROOF AND TERMINATE WITH GOOSENECK.
- 4 PROVIDE DIGITAL TIMER FOR INDICATED EF.
- 5 REFER TO LEARNING STUDIO E128 FOR TYPICAL SHEET METAL LAYOUT.
- 6 REFER TO LEARNING STUDIO E134 FOR TYPICAL SHEET METAL LAYOUT.
- 7 REFER TO ACTIVE STUDIO F138 FOR TYPICAL SHEET METAL LAYOUT.
- 8 PROVIDE FABRIC DUCTWORK IN GYMNASIUM. MECHANICAL CONTRACTOR TO COORDINATE LAYOUT WITH STRUCTURAL STEEL AND JOIST CONFIGURATION.
- 9 ROUTE GREASE DUCT FROM HOOD UP TO EXHAUST FAN.
- 10 ROUTE 6 INCH EA UP THROUGH ROOF TO ROOF CAP ACCESSORY.
- 11 BALANCE TO AIRFLOW INDICATED.
- 12 ROUTE 6 INCH EA THROUGH WALL TO BRICK VENT ACCESSORY.
- 13 PROVIDE DOUBLE WALLED DUCT.
- 14 DUCT LOCATED BENEATH STAIRS.
- 15 ROUTE DUCT TIGHT TO CEILING.
- 16 REFER TO FOOD SERVICE DRAWINGS FOR CONNECTION TO DISHWASHER.
- 17 28x10 MAKEUP AIR CONNECTION TO HOOD.
- 18 PROVIDE 4" CONCRETE CURB AROUND ALL MEZZANINE FLOOR DUCT PENETRATIONS.
- 19 24x12 SA STACKED ABOVE 24x12 EA.
- 20 16x12 SA STACKED ABOVE 12x12 EA.



TMP ARCHITECTURE INC
1191 WEST SQUARE LAKE ROAD - BOX 289
BLOOMFIELD HILLS - MICHIGAN - 48302
PT. 248.338.6941 TX. 248.338.0223
EM - INFO@TMP-ARCHITECTURE.COM

REGISTRATION SEAL

CONSULTANT




Peter Basso Associates Inc
CONSULTING ENGINEERS
5145 Livernois, Suite 100
Troy, Michigan 48068-3276
Tel. 248-879-5666 Fax. 248-879-0007
www.PeterBassoAssociates.com
PBA Project No. 2023.0154

PROJECT TITLE
NEW SMITH MIDDLE SCHOOL
Bid Package No. 03B

Troy School District
TROY, MI

DRAWING TITLE
SECOND LEVEL SHEET METAL PLAN - ZONE 'E'

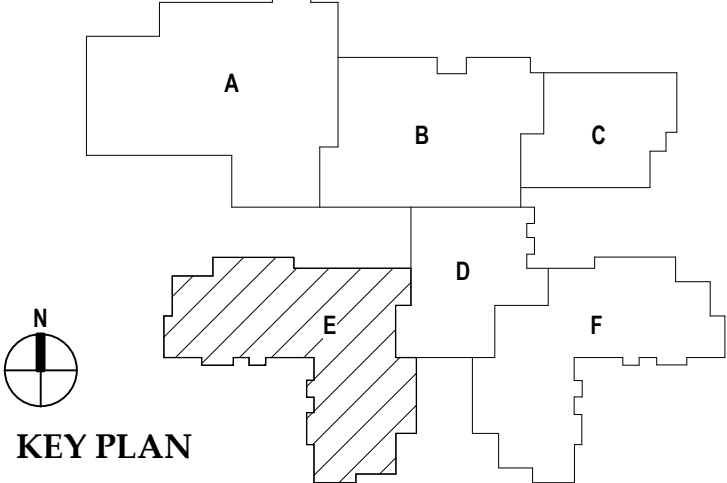


ISSUE DATES

07-12-2024	ADDENDUM #
08-16-2024	CONSTRUCTION DOCUMENTS

DATE: ISSUED FOR:



DRAWN	JRB
CHECKED	KLH
APPROVED	SVM

PROJECT NO.
22102
DRAWING NO.
M4.2E

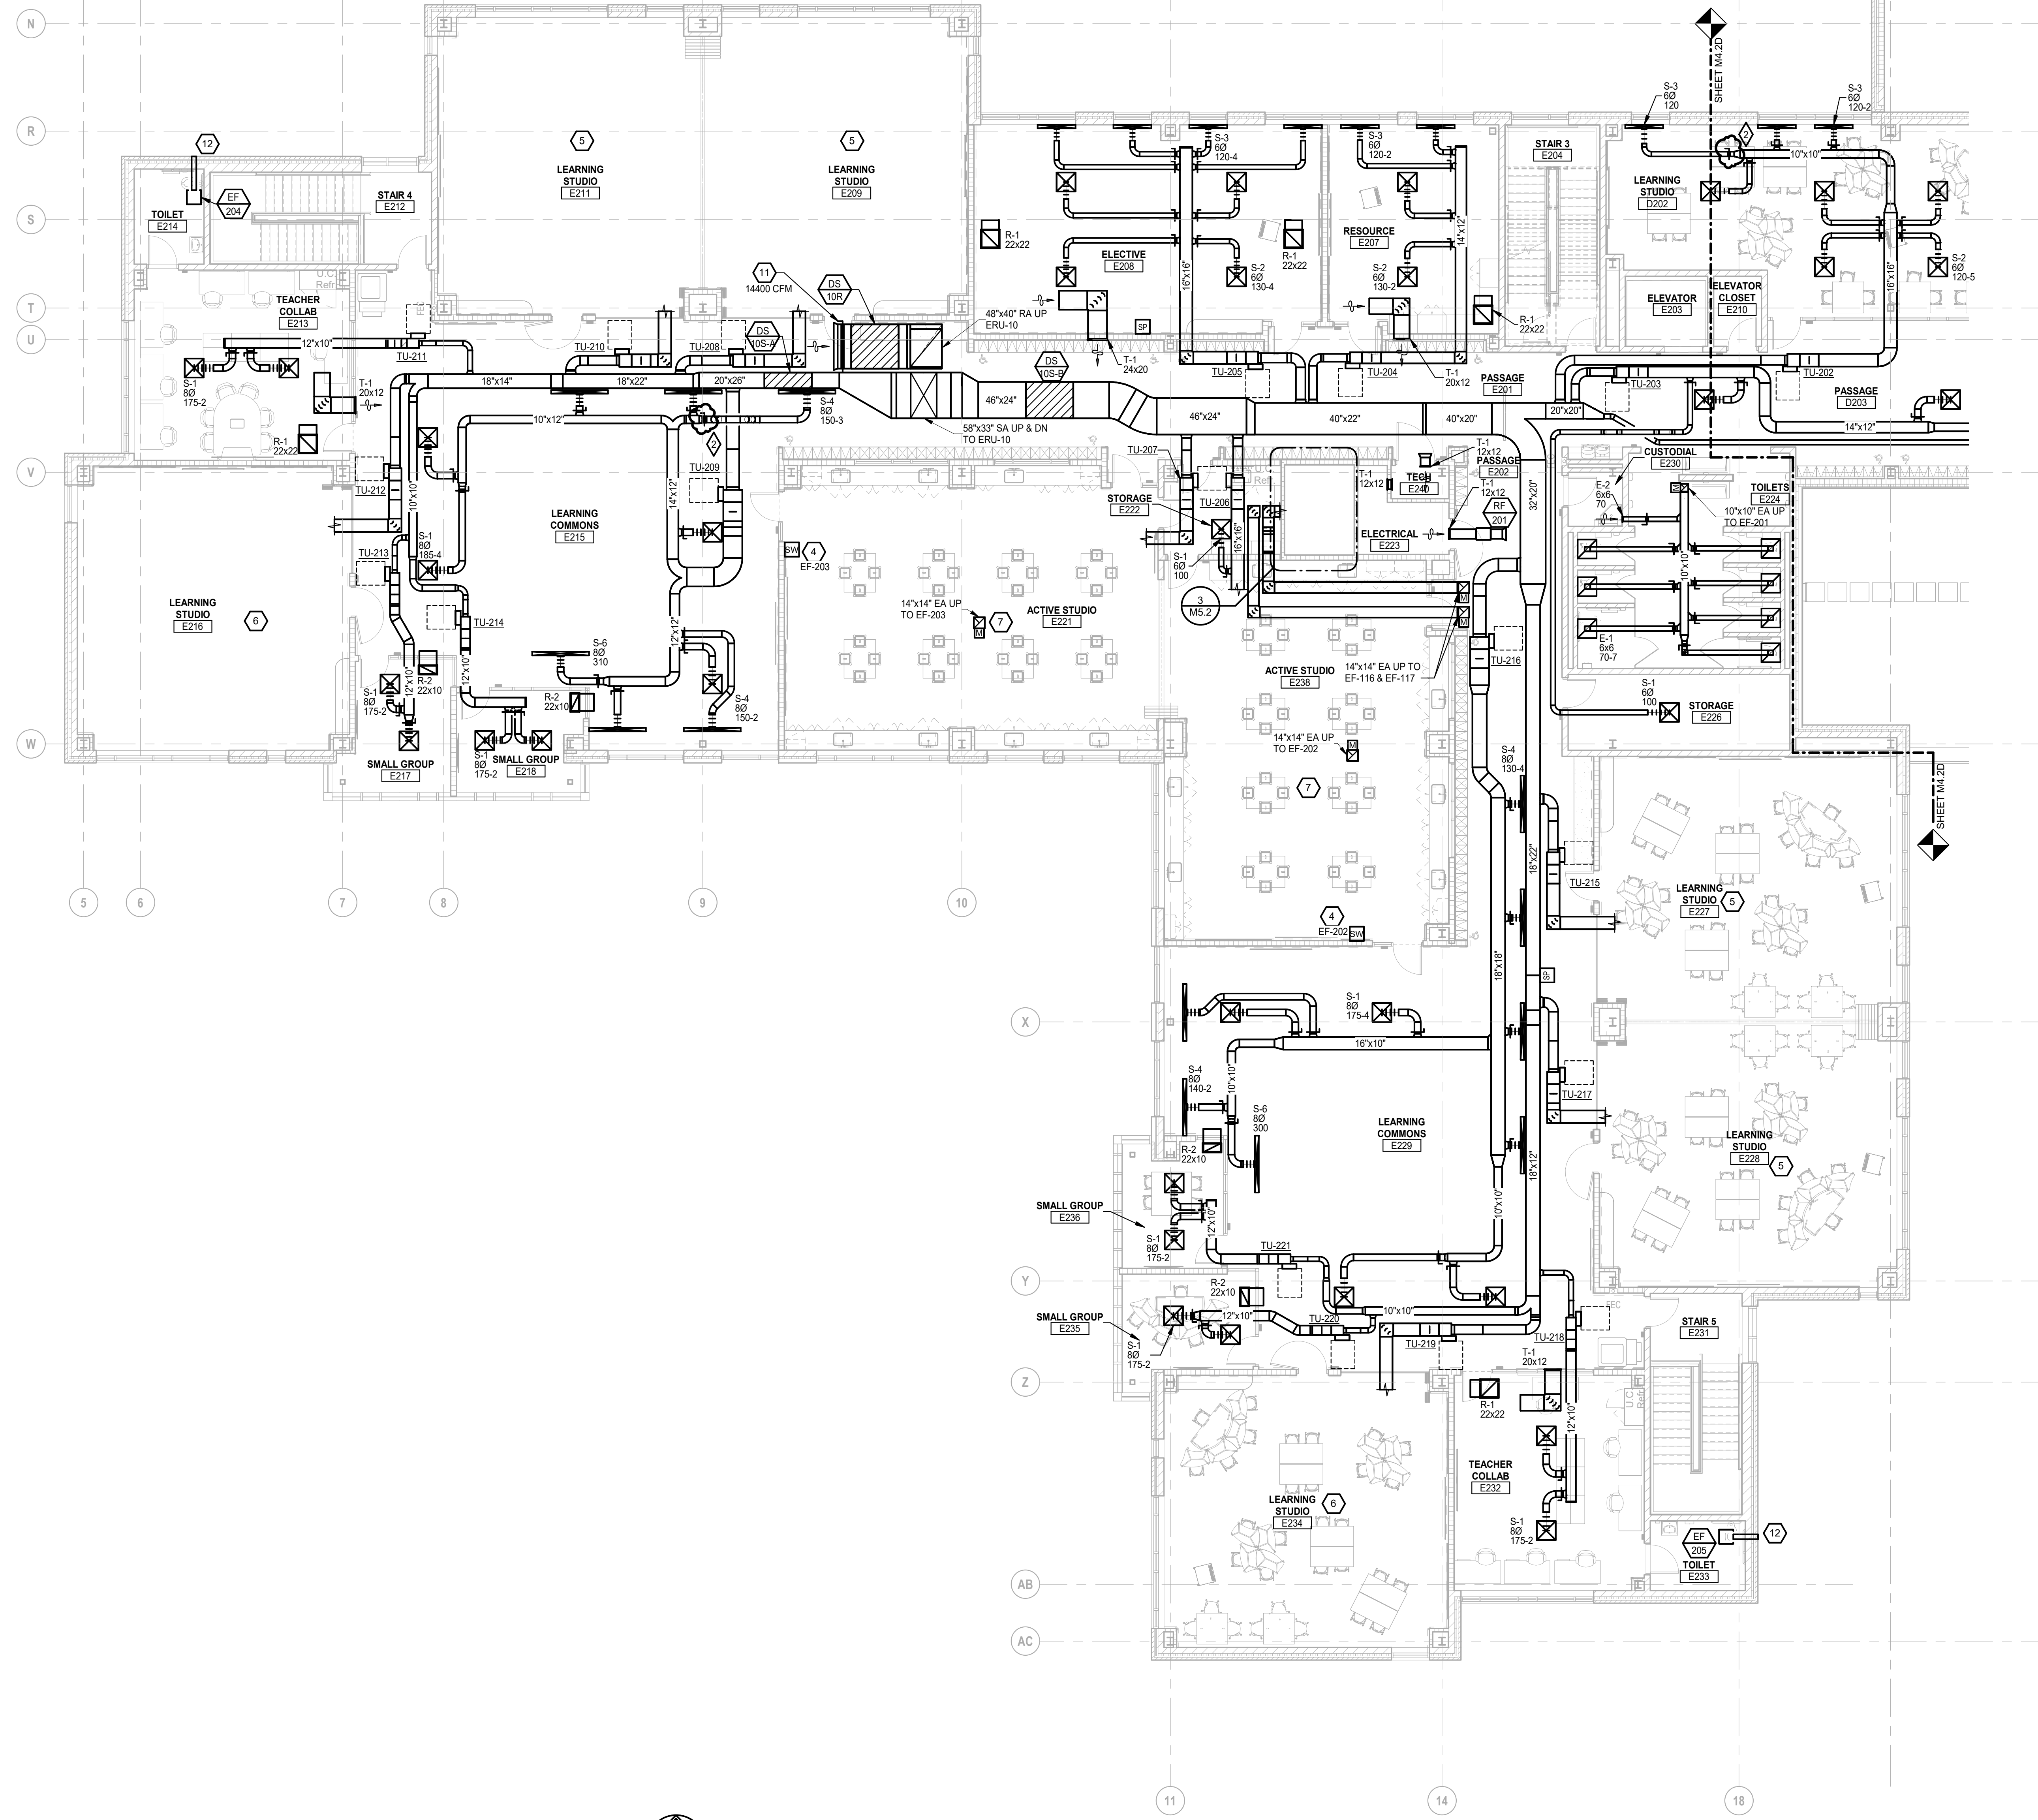

SECOND LEVEL SHEET METAL PLAN - ZONE 'E'
SCALE: 1/8" = 1'-0"

 THE FOLLOWING DIMENSION EQUALS ONE INCH WHEN PRINTED TO SCALE.

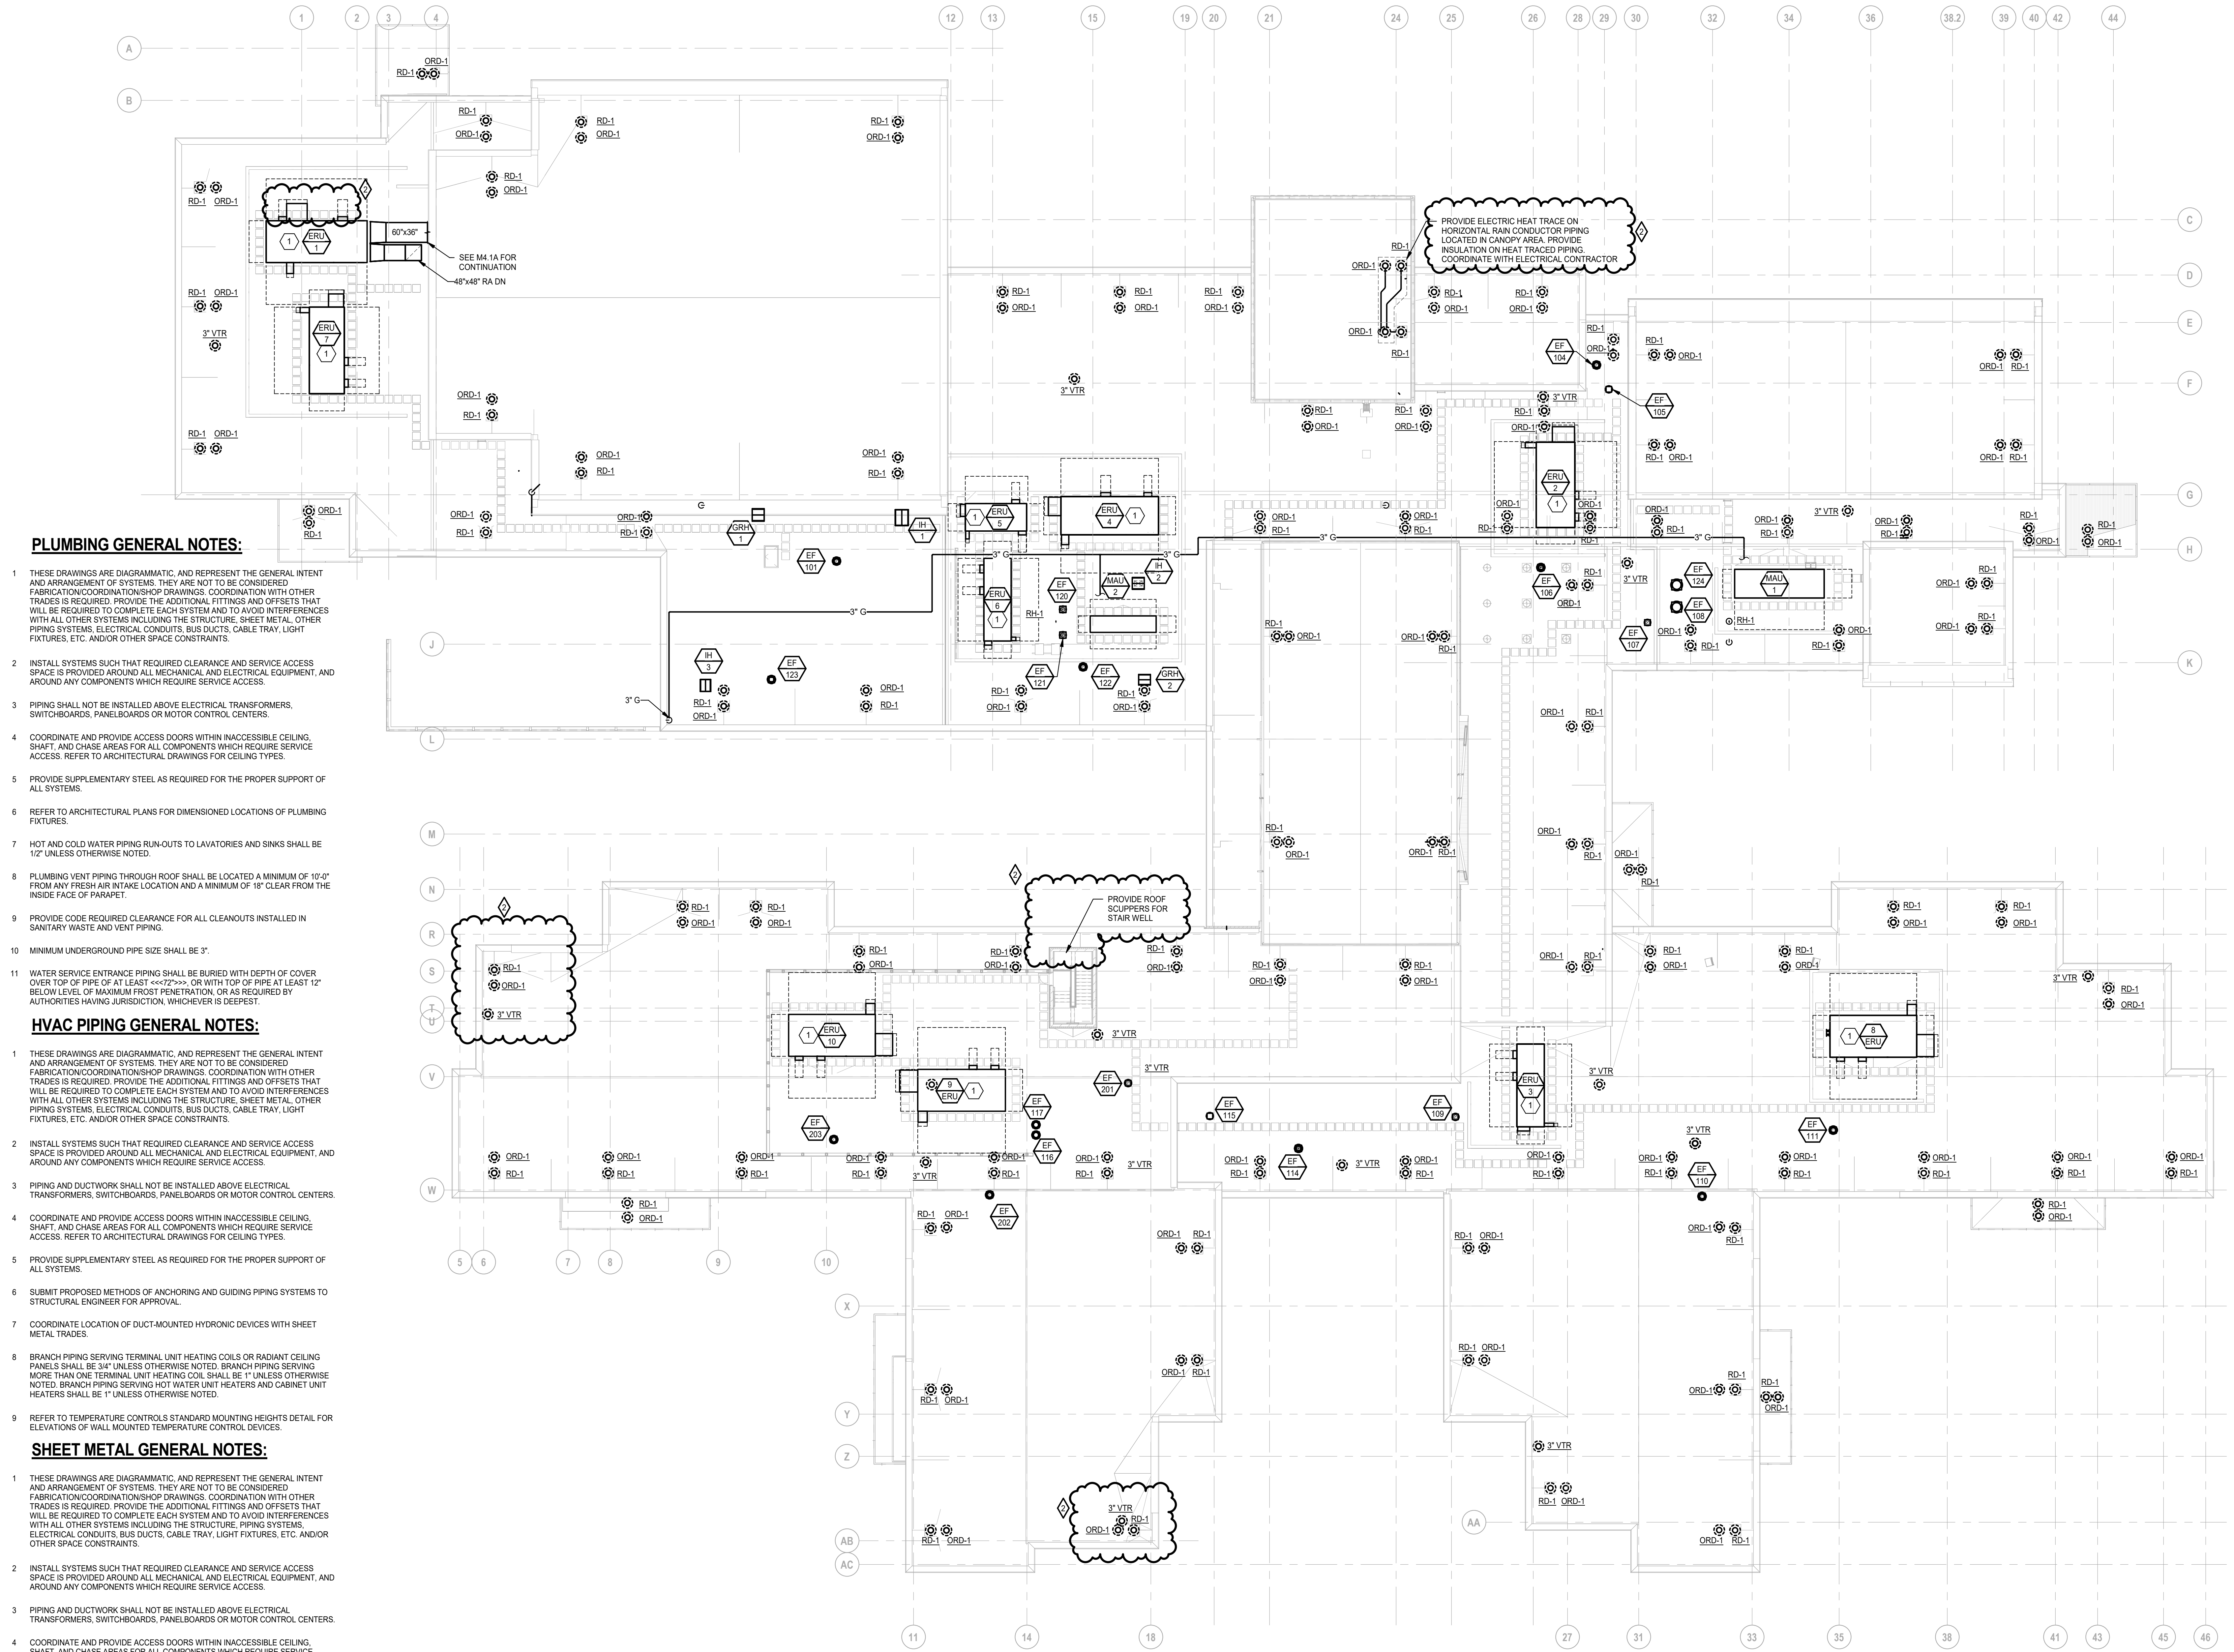

PLUMBING GENERAL NOTES:

- 1 THESE DRAWINGS ARE DIAGRAMMATIC, AND REPRESENT THE GENERAL INTENT AND ARRANGEMENT OF SYSTEMS. THEY ARE NOT TO BE CONSIDERED FABRICATION/COORDINATION/SHOP DRAWINGS. COORDINATION WITH OTHER TRADES IS REQUIRED. PROVIDE THE ADDITIONAL FITTINGS AND OFFSETS THAT WILL BE REQUIRED TO COMPLETE EACH SYSTEM AND TO AVOID INTERFERENCES WITH ALL OTHER SYSTEMS INCLUDING THE STRUCTURE, SHEET METAL, OTHER PIPING SYSTEMS, ELECTRICAL CONDUITS, BUS DUCTS, CABLE TRAY, LIGHT FIXTURES, ETC. AND/OR OTHER SPACE CONSTRAINTS.
- 2 INSTALL SYSTEMS SUCH THAT REQUIRED CLEARANCE AND SERVICE ACCESS SPACE IS PROVIDED AROUND ALL MECHANICAL AND ELECTRICAL EQUIPMENT, AND AROUND ANY COMPONENTS WHICH REQUIRE SERVICE ACCESS.
- 3 PIPING SHALL NOT BE INSTALLED ABOVE ELECTRICAL TRANSFORMERS, SWITCHBOARDS, PANELBOARDS OR MOTOR CONTROL CENTERS.
- 4 COORDINATE AND PROVIDE ACCESS DOORS WITHIN INACCESSIBLE CEILING, SHAFT, AND CHASE AREAS FOR ALL COMPONENTS WHICH REQUIRE SERVICE ACCESS. REFER TO ARCHITECTURAL DRAWINGS FOR CEILING TYPES.
- 5 PROVIDE SUPPLEMENTARY STEEL AS REQUIRED FOR THE PROPER SUPPORT OF ALL SYSTEMS.
- 6 REFER TO ARCHITECTURAL PLANS FOR DIMENSIONED LOCATIONS OF PLUMBING FIXTURES.
- 7 HOT AND COLD WATER PIPING RUN-OUTS TO LAVATORIES AND SINKS SHALL BE 1/2" UNLESS OTHERWISE NOTED.
- 8 PLUMBING VENT PIPING THROUGH ROOF SHALL BE LOCATED A MINIMUM OF 10'0" FROM ANY FRESH AIR INTAKE LOCATION AND A MINIMUM OF 18" CLEAR FROM THE INSIDE FACE OF PARAPET.
- 9 PROVIDE CODE REQUIRED CLEARANCE FOR ALL CLEANOUTS INSTALLED IN SANITARY WASTE AND VENT PIPING.
- 10 MINIMUM UNDERGROUND PIPE SIZE SHALL BE 3".
- 11 WATER SERVICE ENTRANCE PIPING SHALL BE BURIED WITH DEPTH OF COVER OVER TOP OF PIPE OF AT LEAST <<<72" >>>, OR WITH TOP OF PIPE AT LEAST 12" BELOW LEVEL OF MAXIMUM FROST PENETRATION, OR AS REQUIRED BY AUTHORITIES HAVING JURISDICTION, WHICHEVER IS DEEPEST.

HVAC PIPING GENERAL NOTES:

- 1 THESE DRAWINGS ARE DIAGRAMMATIC, AND REPRESENT THE GENERAL INTENT AND ARRANGEMENT OF SYSTEMS. THEY ARE NOT TO BE CONSIDERED FABRICATION/COORDINATION/SHOP DRAWINGS. COORDINATION WITH OTHER TRADES IS REQUIRED. PROVIDE THE ADDITIONAL FITTINGS AND OFFSETS THAT WILL BE REQUIRED TO COMPLETE EACH SYSTEM AND TO AVOID INTERFERENCES WITH ALL OTHER SYSTEMS INCLUDING THE STRUCTURE, SHEET METAL, OTHER PIPING SYSTEMS, ELECTRICAL CONDUITS, BUS DUCTS, CABLE TRAY, LIGHT FIXTURES, ETC. AND/OR OTHER SPACE CONSTRAINTS.
- 2 INSTALL SYSTEMS SUCH THAT REQUIRED CLEARANCE AND SERVICE ACCESS SPACE IS PROVIDED AROUND ALL MECHANICAL AND ELECTRICAL EQUIPMENT, AND AROUND ANY COMPONENTS WHICH REQUIRE SERVICE ACCESS.
- 3 PIPING AND DUCTWORK SHALL NOT BE INSTALLED ABOVE ELECTRICAL TRANSFORMERS, SWITCHBOARDS, PANELBOARDS OR MOTOR CONTROL CENTERS.
- 4 COORDINATE AND PROVIDE ACCESS DOORS WITHIN INACCESSIBLE CEILING, SHAFT, AND CHASE AREAS FOR ALL COMPONENTS WHICH REQUIRE SERVICE ACCESS. REFER TO ARCHITECTURAL DRAWINGS FOR CEILING TYPES.
- 5 PROVIDE SUPPLEMENTARY STEEL AS REQUIRED FOR THE PROPER SUPPORT OF ALL SYSTEMS.
- 6 SUBMIT PROPOSED METHODS OF ANCHORING AND GUIDING PIPING SYSTEMS TO STRUCTURAL ENGINEER FOR APPROVAL.
- 7 COORDINATE LOCATION OF DUCT-MOUNTED HYDRONIC DEVICES WITH SHEET METAL TRADES.
- 8 BRANCH PIPING SERVING TERMINAL UNIT HEATING COILS OR RADIANT CEILING PANELS SHALL BE 3/4" UNLESS OTHERWISE NOTED. BRANCH PIPING SERVING MORE THAN ONE TERMINAL UNIT HEATING COIL SHALL BE 1" UNLESS OTHERWISE NOTED. BRANCH PIPING SERVING HOT WATER UNIT HEATERS AND CABINET UNIT HEATERS SHALL BE 1" UNLESS OTHERWISE NOTED.
- 9 REFER TO TEMPERATURE CONTROLS STANDARD MOUNTING HEIGHTS DETAIL FOR ELEVATIONS OF WALL MOUNTED TEMPERATURE CONTROL DEVICES.

SHEET METAL GENERAL NOTES:

- 1 THESE DRAWINGS ARE DIAGRAMMATIC, AND REPRESENT THE GENERAL INTENT AND ARRANGEMENT OF SYSTEMS. THEY ARE NOT TO BE CONSIDERED FABRICATION/COORDINATION/SHOP DRAWINGS. COORDINATION WITH OTHER TRADES IS REQUIRED. PROVIDE THE ADDITIONAL FITTINGS AND OFFSETS THAT WILL BE REQUIRED TO COMPLETE EACH SYSTEM AND TO AVOID INTERFERENCES WITH ALL OTHER SYSTEMS INCLUDING THE STRUCTURE, PIPING SYSTEMS, ELECTRICAL CONDUITS, BUS DUCTS, CABLE TRAY, LIGHT FIXTURES, ETC. AND/OR OTHER SPACE CONSTRAINTS.
- 2 INSTALL SYSTEMS SUCH THAT REQUIRED CLEARANCE AND SERVICE ACCESS SPACE IS PROVIDED AROUND ALL MECHANICAL AND ELECTRICAL EQUIPMENT, AND AROUND ANY COMPONENTS WHICH REQUIRE SERVICE ACCESS.
- 3 PIPING AND DUCTWORK SHALL NOT BE INSTALLED ABOVE ELECTRICAL TRANSFORMERS, SWITCHBOARDS, PANELBOARDS OR MOTOR CONTROL CENTERS.
- 4 COORDINATE AND PROVIDE ACCESS DOORS WITHIN INACCESSIBLE CEILING, SHAFT, AND CHASE AREAS FOR ALL COMPONENTS WHICH REQUIRE SERVICE ACCESS. REFER TO ARCHITECTURAL DRAWINGS FOR CEILING TYPES.
- 5 PROVIDE SUPPLEMENTARY STEEL AS REQUIRED FOR THE PROPER SUPPORT OF ALL SYSTEMS.
- 6 REFER TO ARCHITECTURAL REFLECTED CEILING PLANS FOR DIMENSIONED LOCATION OF GRILLES, REGISTERS, AND DIFFUSERS.
- 7 REFER TO TEMPERATURE CONTROLS STANDARD MOUNTING HEIGHTS DETAIL FOR ELEVATIONS OF WALL MOUNTED TEMPERATURE CONTROL DEVICES.

CONSTRUCTION KEY NOTES:

- 1 PROVIDE HEAT TRACE ON ERU CONDENSATE DRAIN AND INSULATE PIPING.

ROOF MECHANICAL PLAN
SCALE: 1/16" = 1'-0"



TMP ARCHITECTURE INC
1191 WEST SQUARE LAKE ROAD - BOX 289
BLOOMFIELD HILLS - MICHIGAN 48302
PH: 248.338.4841 FX: 248.338.0223
EM: INFO@TMP-ARCHITECTURE.COM

REGISTRATION SEAL

CONSULTANT




Peter Basso Associates Inc
CONSULTING ENGINEERS
5145 Livernois, Suite 100
Troy, Michigan 48068-3276
Tel: 248-879-5666 Fax: 248-879-0007
www.PeterBassoAssociates.com
PBA Project No. 2023.0154

PROJECT TITLE
NEW SMITH MIDDLE SCHOOL
Bid Package No. 03B

Troy School District
TROY, MI

DRAWING TITLE
ROOF MECHANICAL PLAN

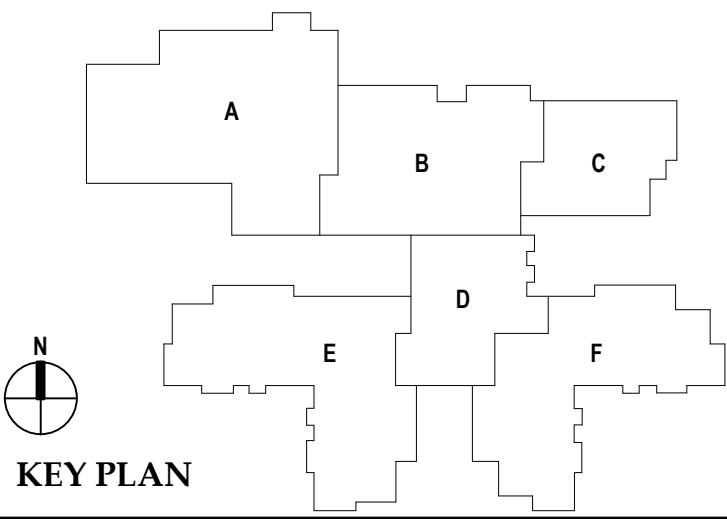

ISSUE DATES


DATE	ISSUED FOR:

07-12-2024 ADDENDUM #2
06-16-2024 CONSTRUCTION DOCUMENTS
DATE: ISSUED FOR:


DRAWN	KLH
CHECKED	KLH
APPROVED	SVW

PROJECT NO.
22102
DRAWING NO.
M5.1


7/11/2024 4:05:01 PM Autocad Docs//22102_Troy Smith MS/2023-0154_TSD_Smith MS_MEP_V22.rvt

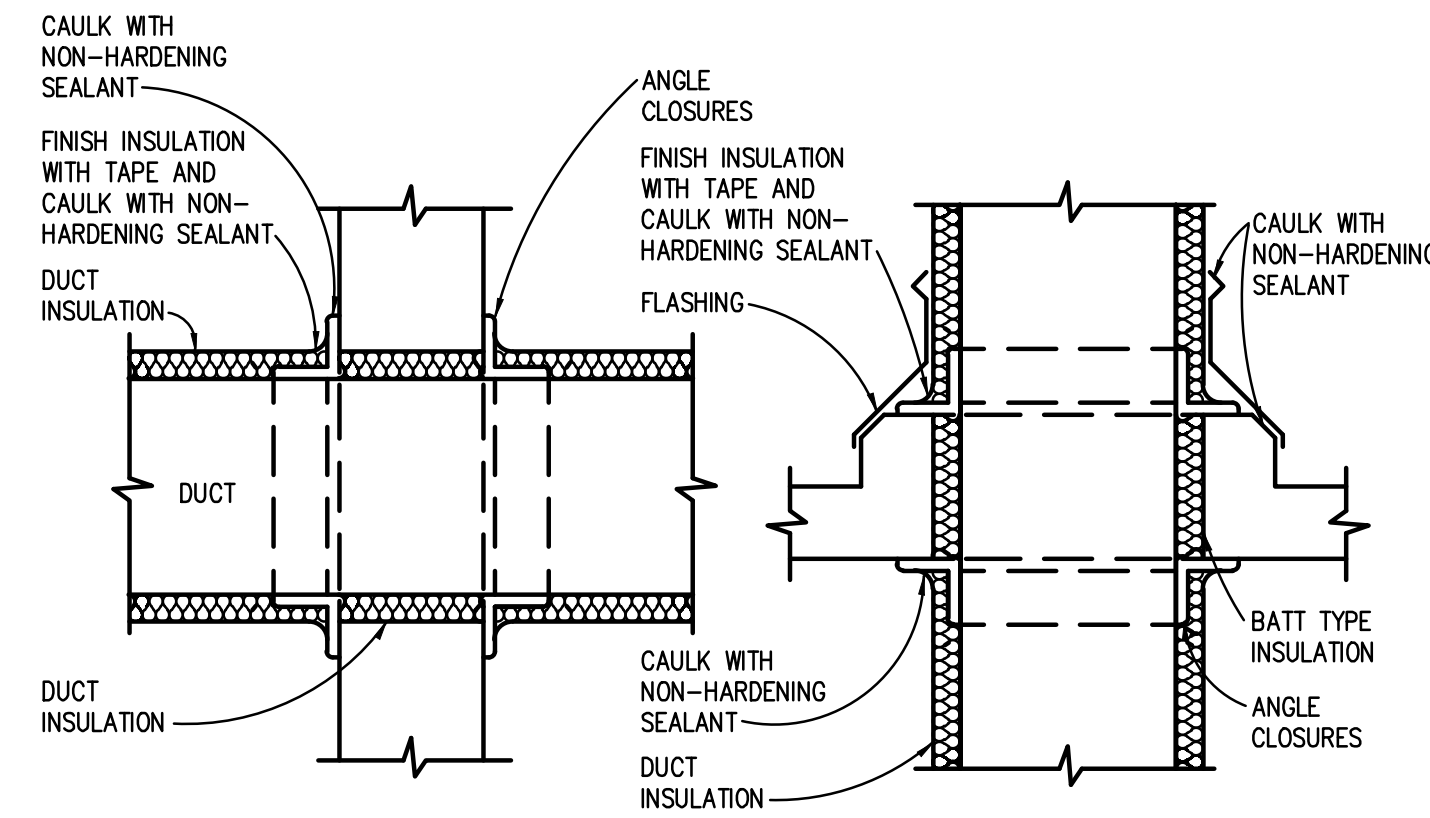


VERTICAL OR HORIZONTAL (NON FIRE RATED ASSEMBLY) DUCT PENETRATION DETAIL
NO SCALE

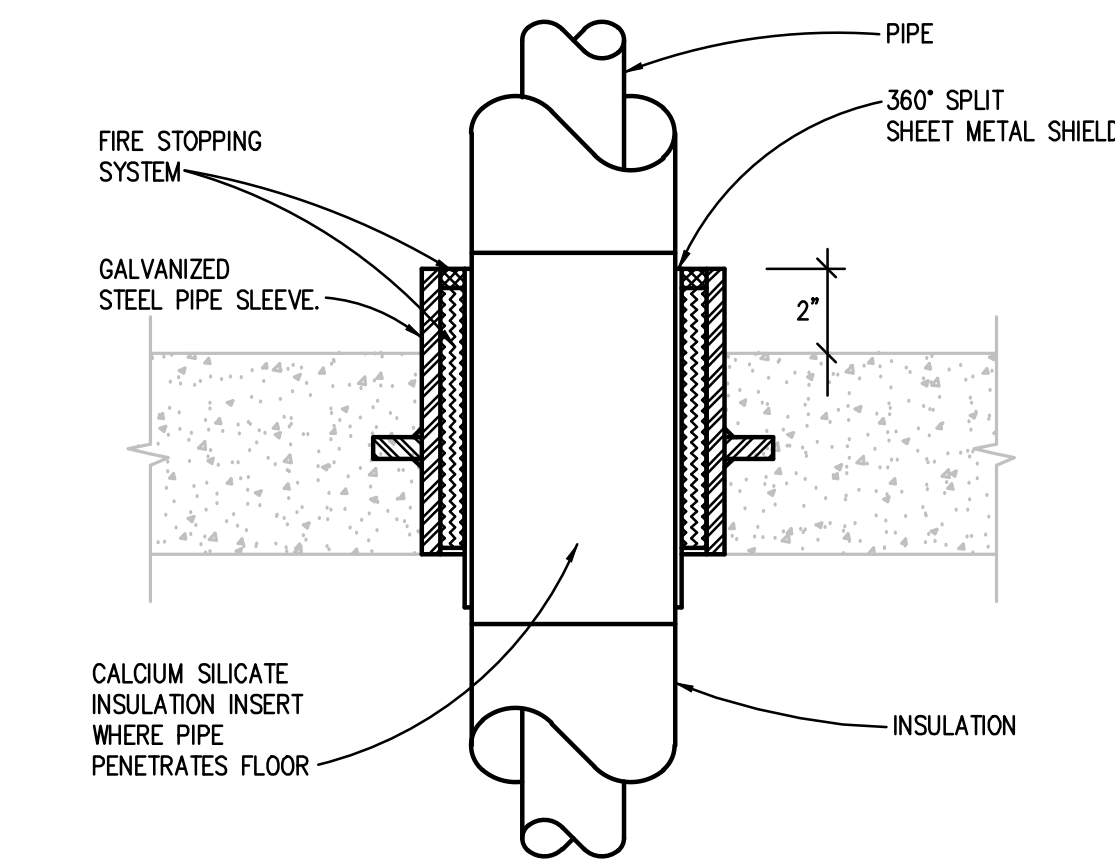


NEW FLOOR PIPE PENETRATION DETAIL
NO SCALE

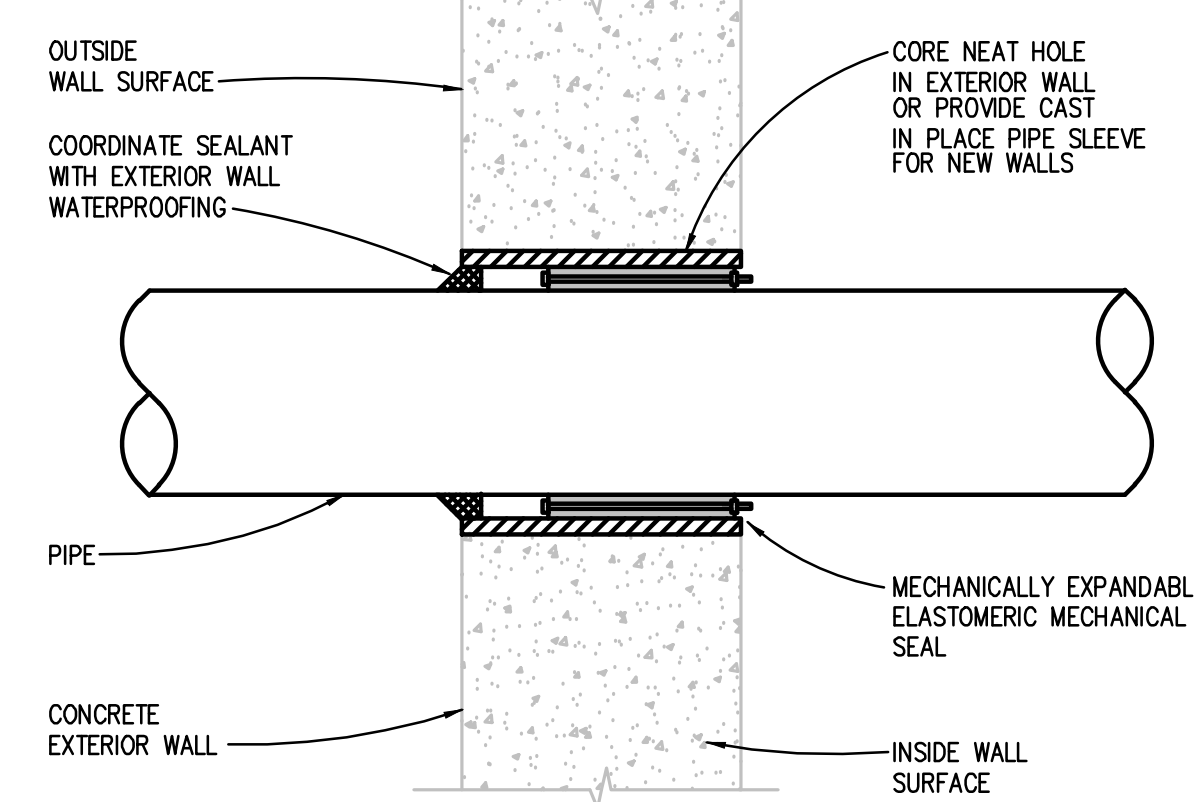

EXTERIOR BELOW GRADE WALL PIPE PENETRATION DETAIL
NO SCALE

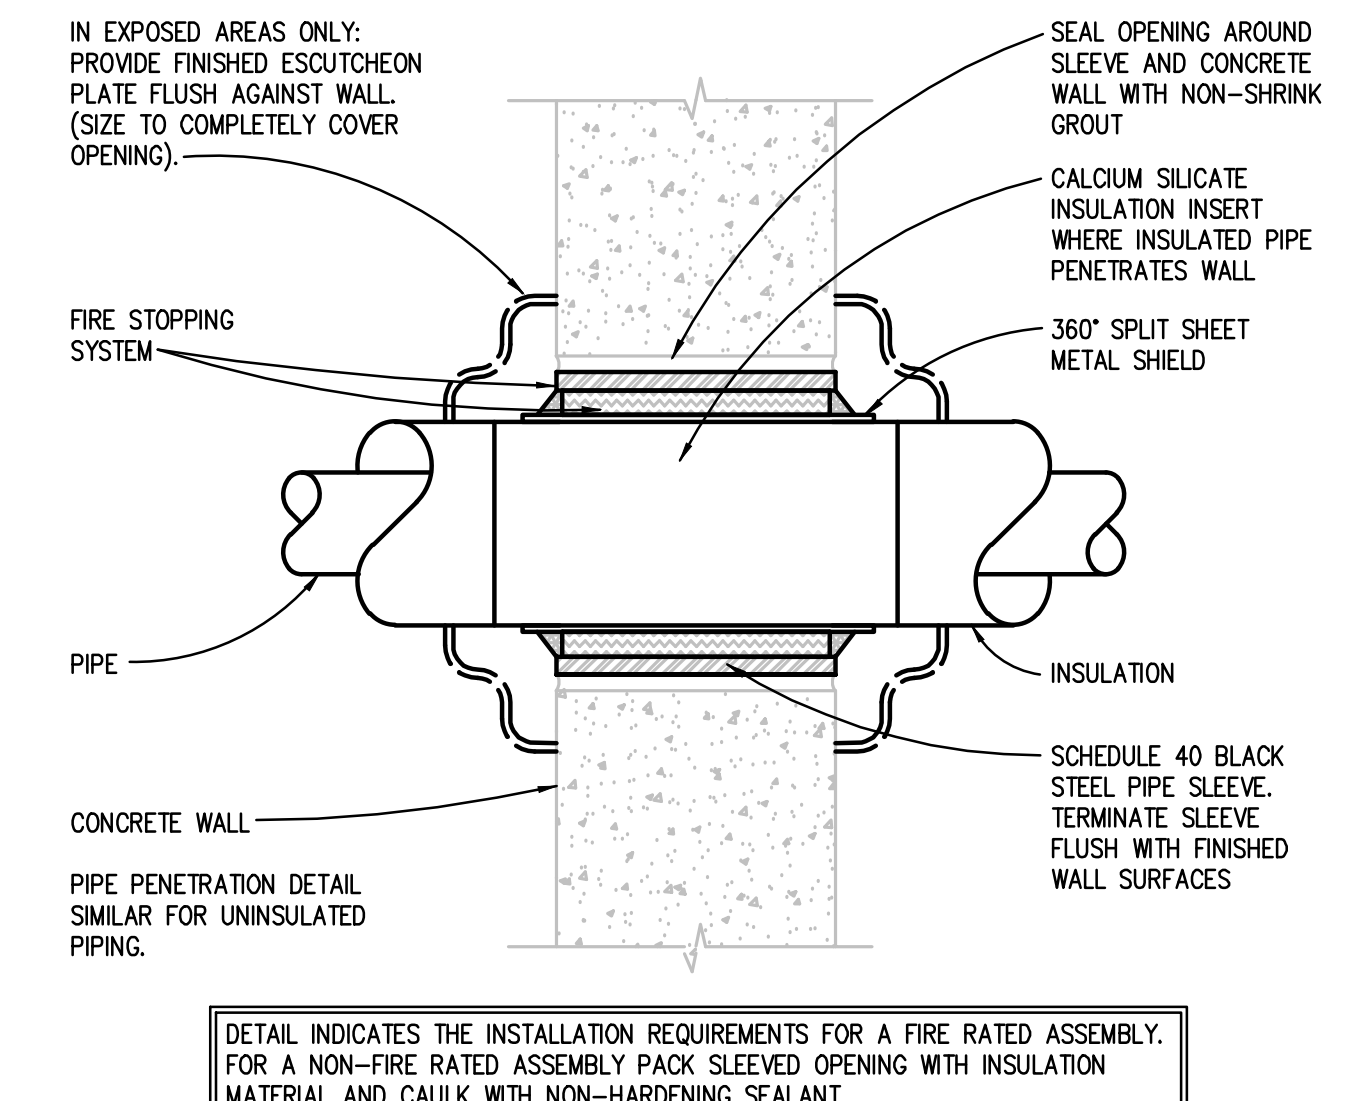

FIRE RATED AND NON-FIRE RATED POURED CONCRETE OR BLOCK WALL PIPE PENETRATION DETAIL
NO SCALE

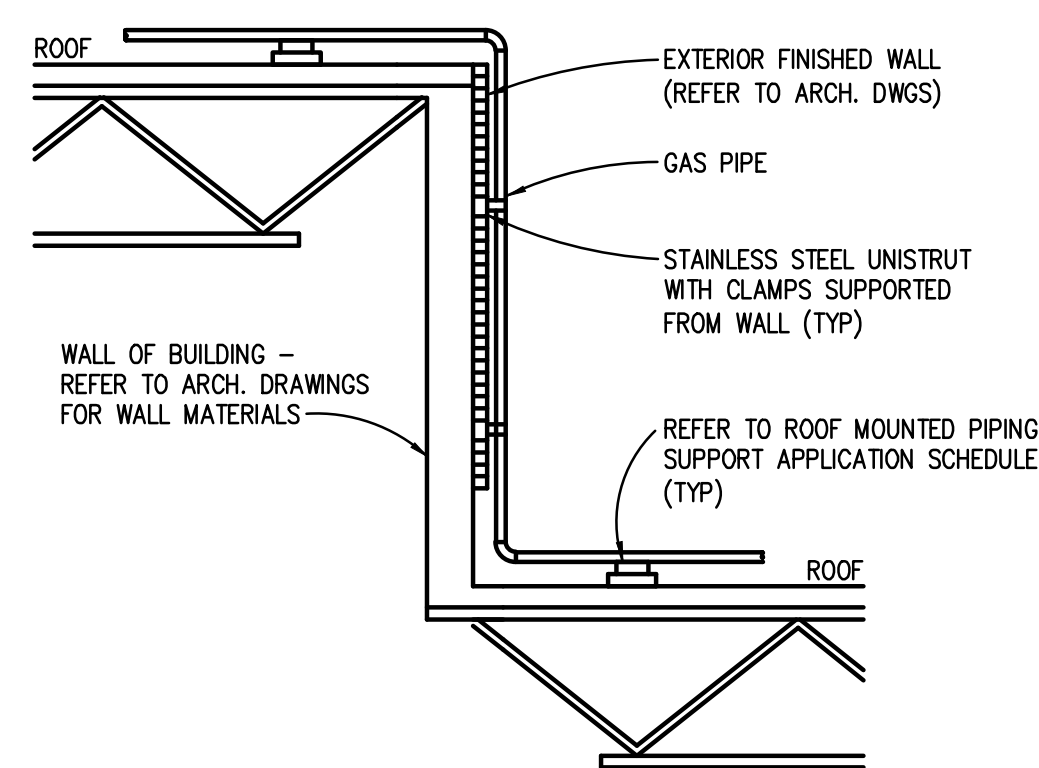

GAS PIPE MOUNTING DETAIL
NO SCALE




BRANCH CONNECTION OFF TOP
APPLIES TO THE FOLLOWING SYSTEMS:
DOMESTIC WATER
STEAM & CONDENSATE
LABORATORY GASES
LABORATORY VACUUM
COMPRESSED AIR
NATURAL GAS


BRANCH CONNECTION OFF BOTTOM
APPLIES TO THE FOLLOWING SYSTEMS:
HOT WATER HEATING
CHILLED WATER
CONDENSER WATER
ENERGY RECOVERY
PROCESS COOLING WATER

NOTE: BOTTOM AS INDICATED OR SIDE CONNECTION IS ACCEPTABLE. CONNECTION ABOVE CENTERLINE OF MAINS IS NOT ACCEPTABLE.


TYPICAL BRANCH TAKE-OFF CONNECTION PIPING DETAIL
NO SCALE

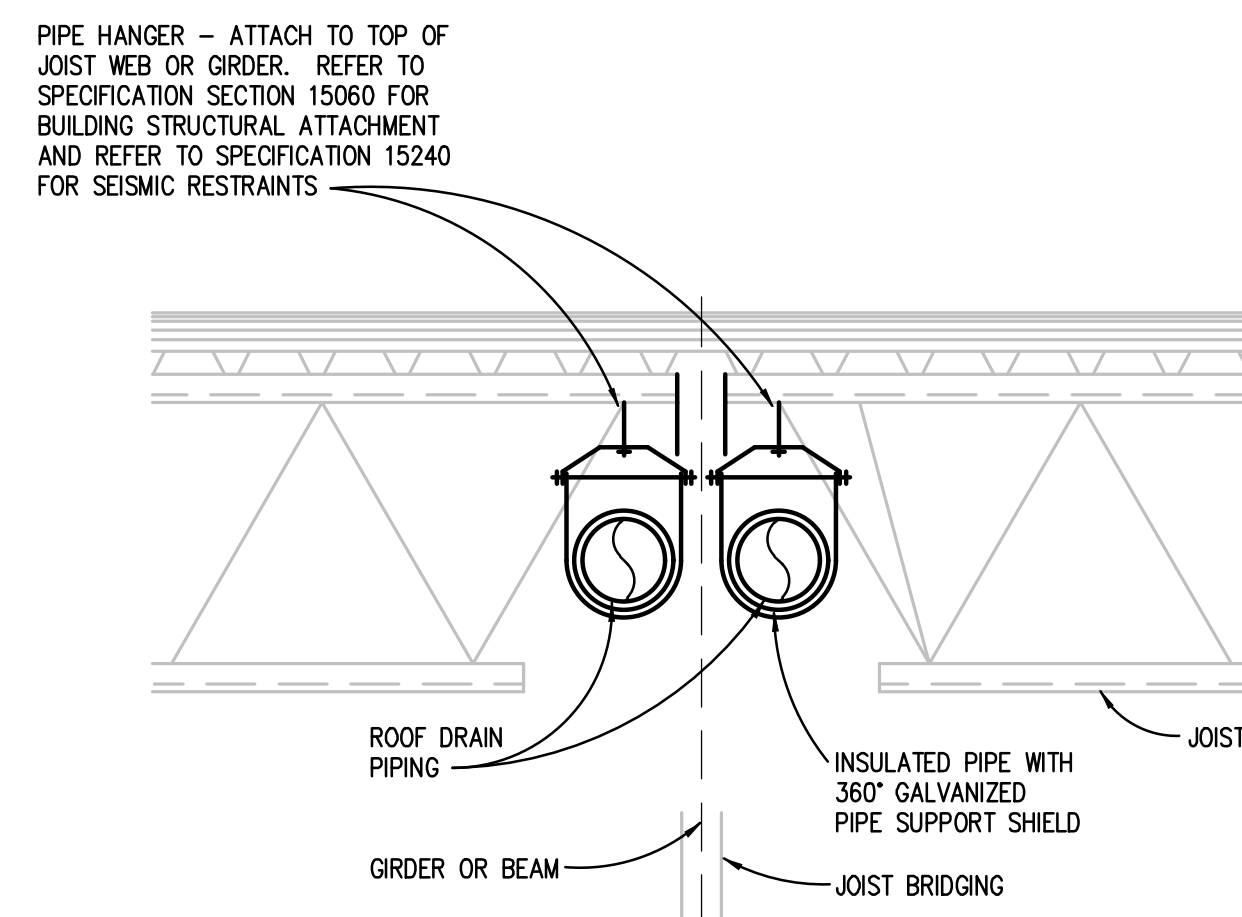


ROOF DRAIN PIPING DETAIL
NO SCALE

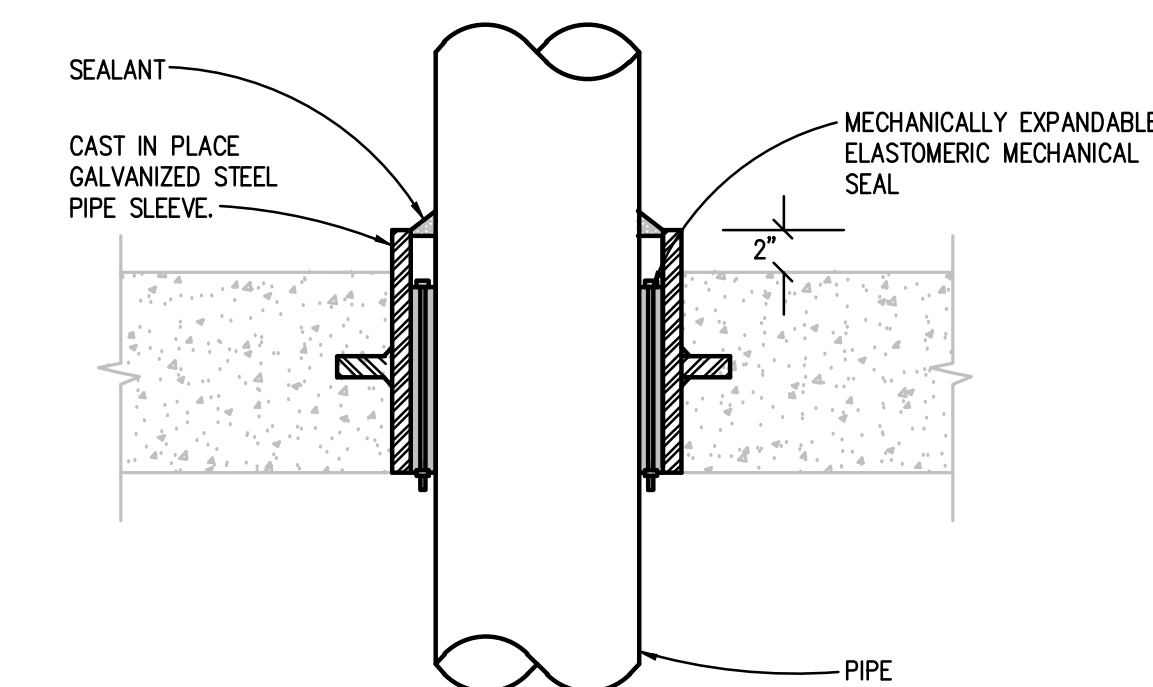


NEW SLAB ON GRADE FLOOR PIPE PENETRATION DETAIL
NO SCALE

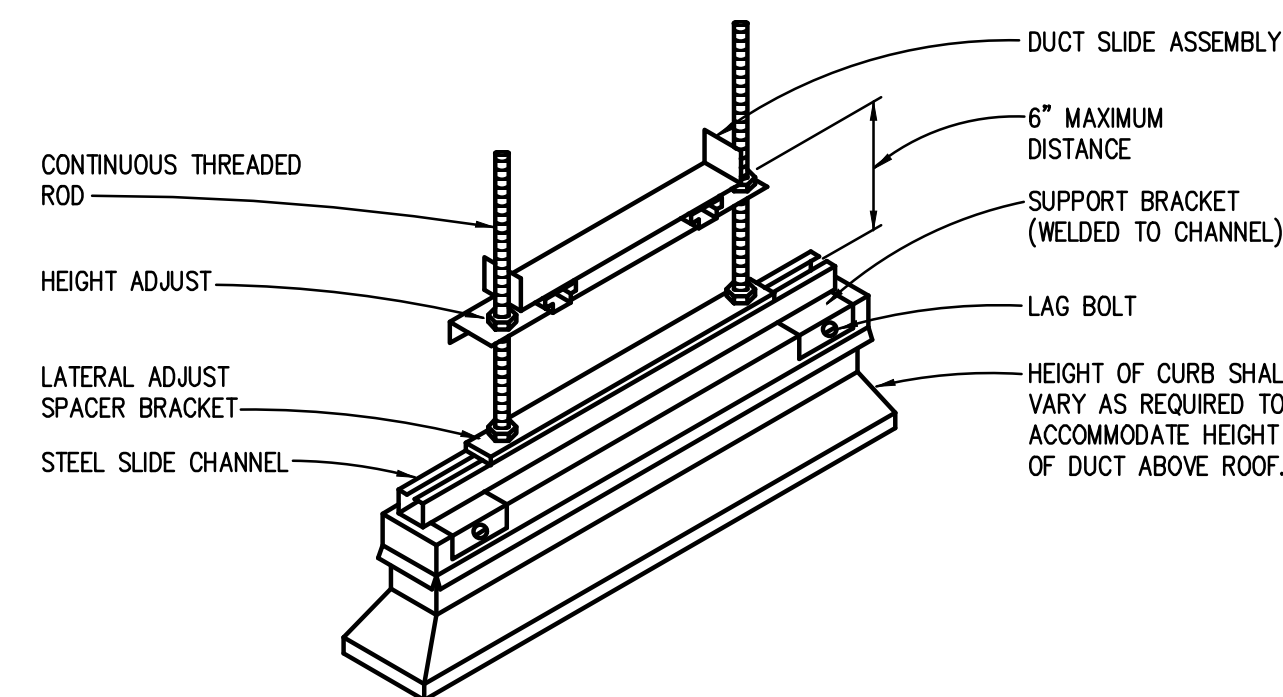


DUCT MOUNTING PEDESTAL DETAIL (ROOF MOUNTED DUCTWORK)
NO SCALE

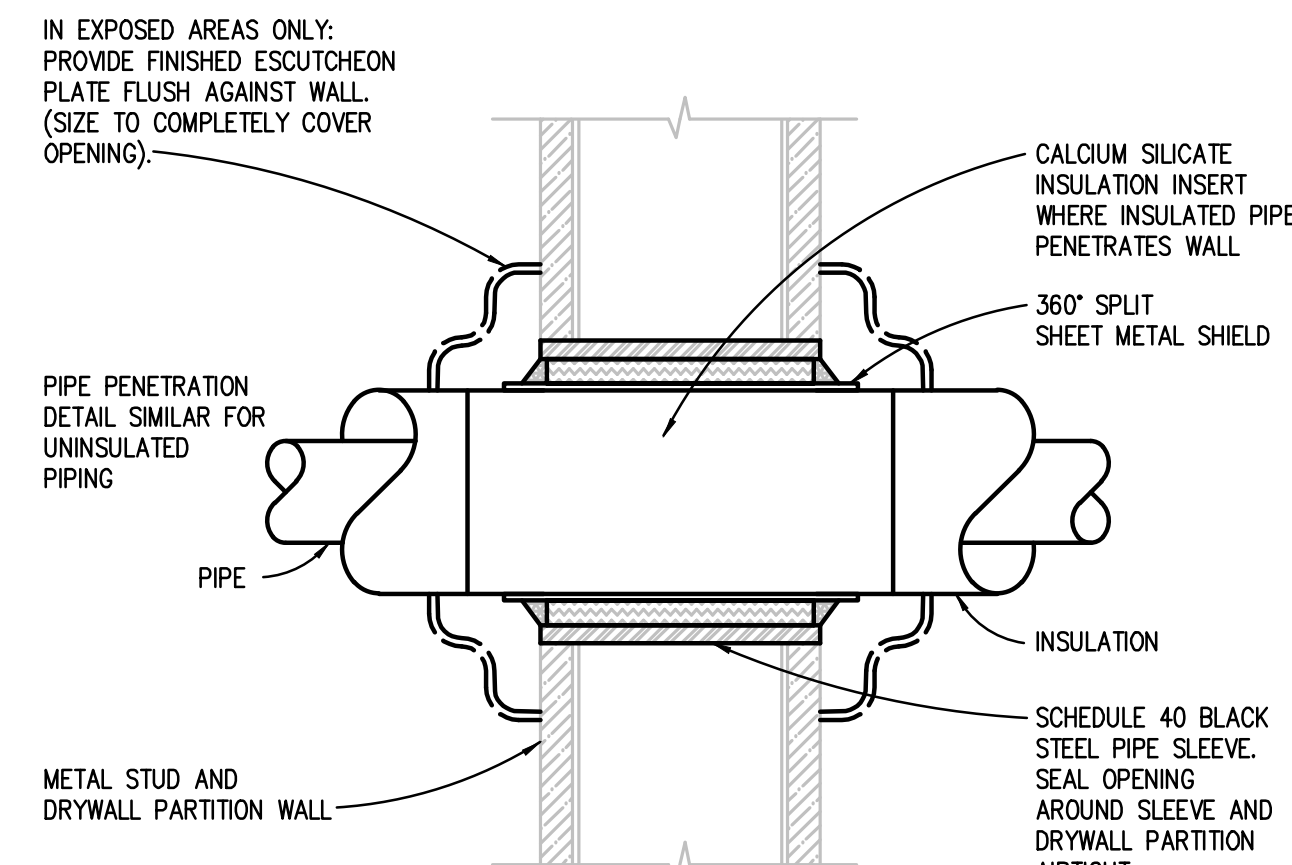


FIRE RATED AND NON-FIRE RATED METAL STUD AND DRYWALL PARTITION WALL PIPE PENETRATION DETAIL
NO SCALE

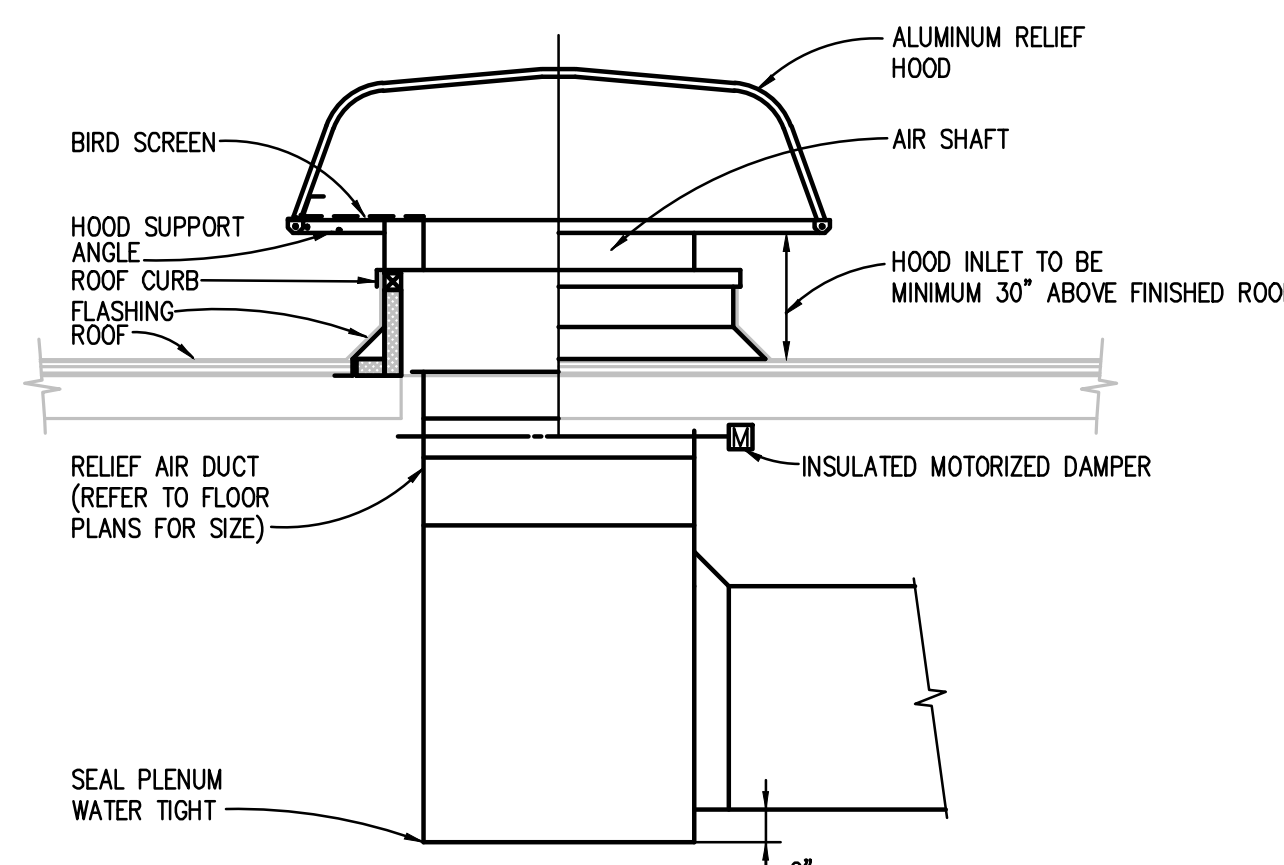


DUCTED INTAKE OR RELIEF HOOD INSTALLATION DETAIL
NO SCALE

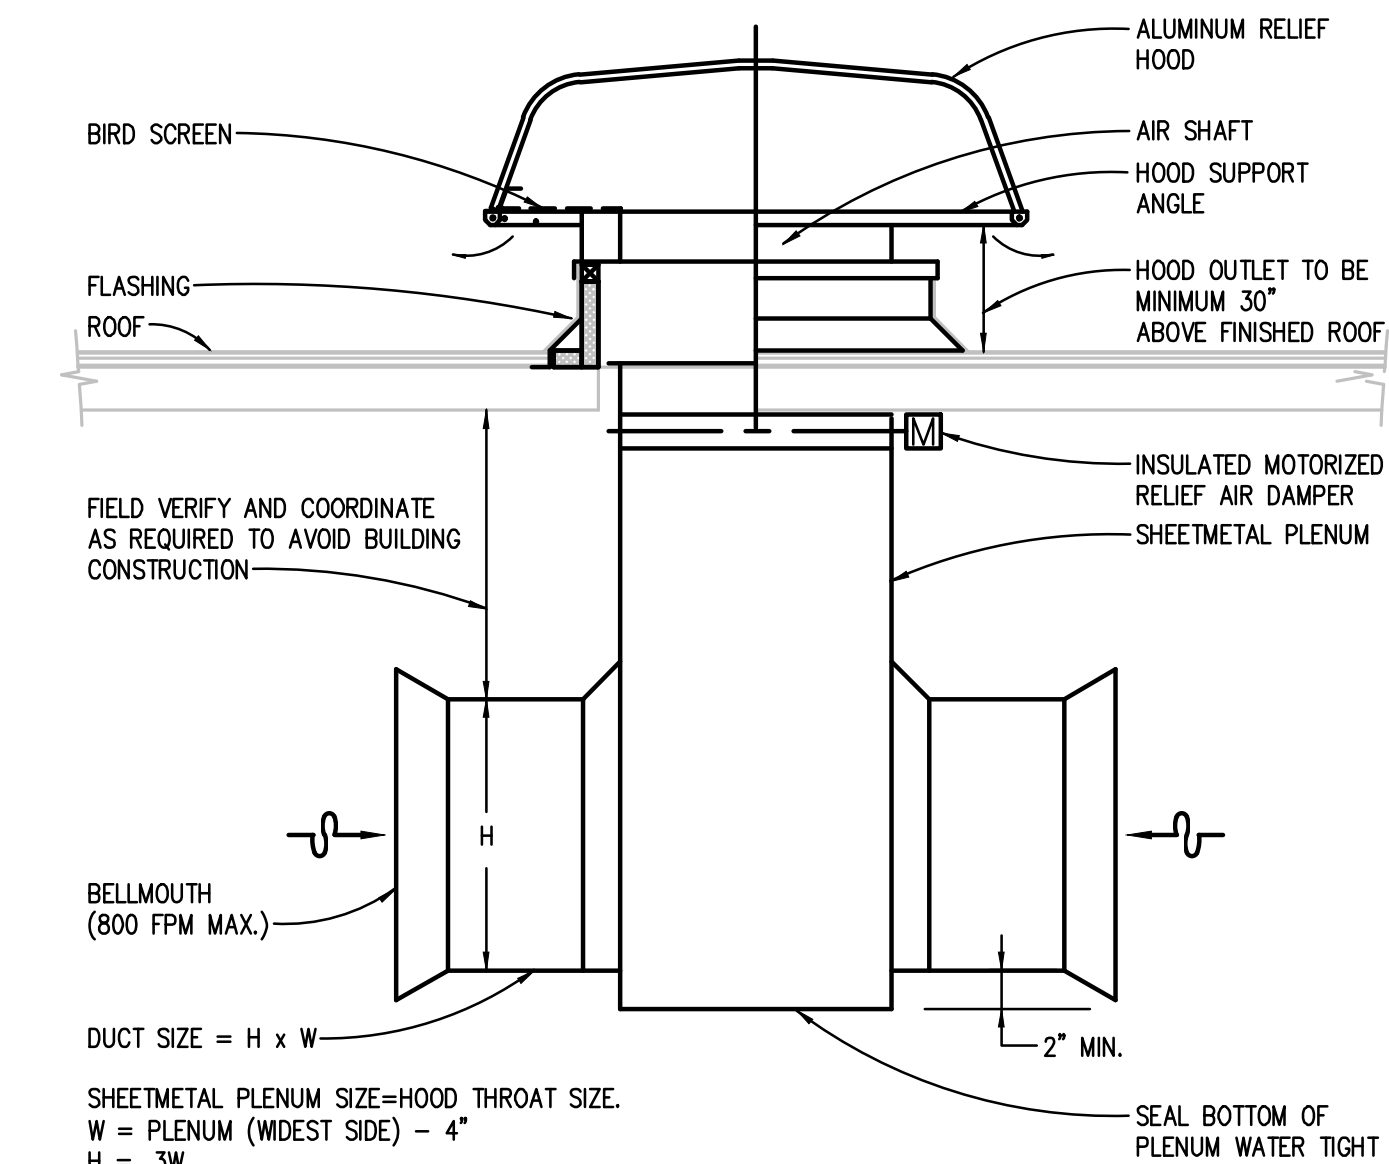


RELIEF AIR DUCTWORK DETAIL
NO SCALE

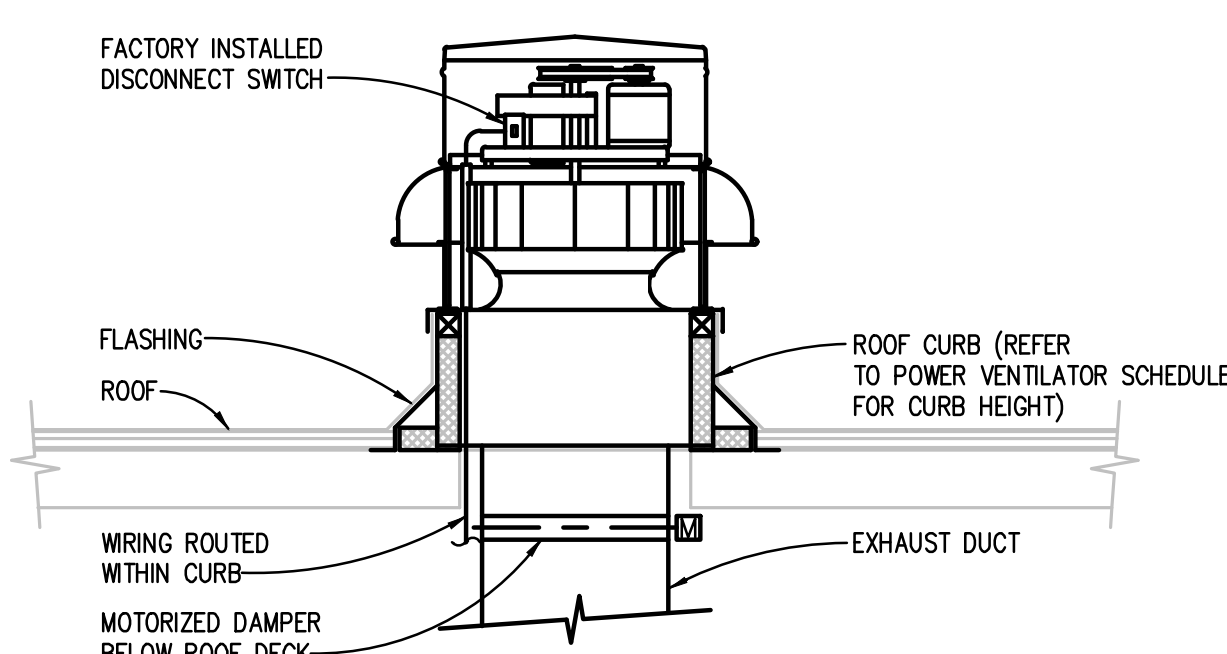

ROOF MOUNTED POWER VENTILATOR EXHAUST FAN DETAIL
NO SCALE

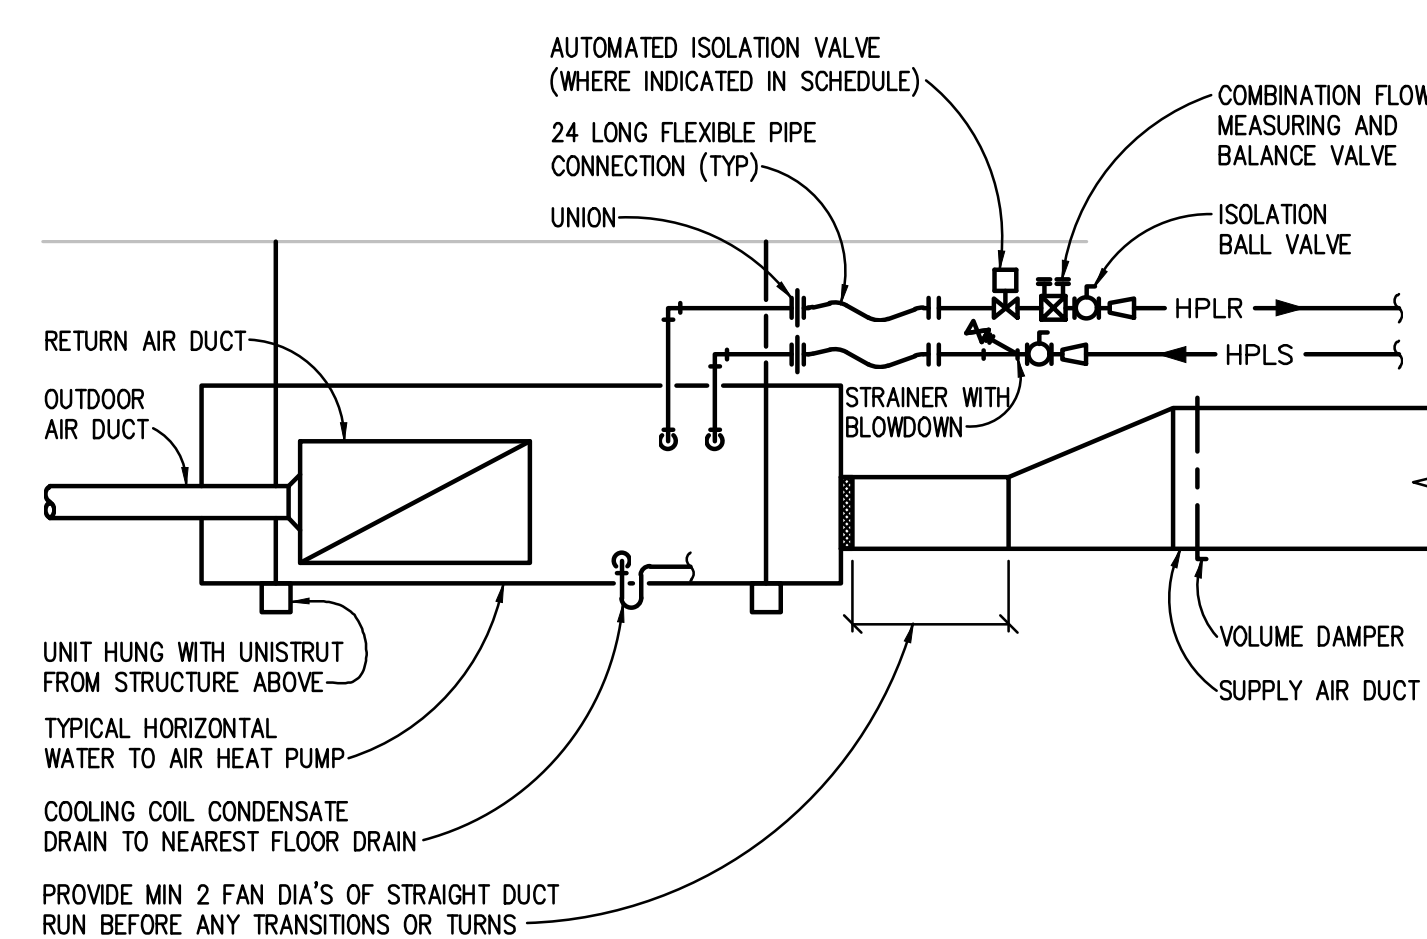

HORIZONTAL HEAT PUMP PIPING DIAGRAM AND INSTALLATION DETAIL
NO SCALE

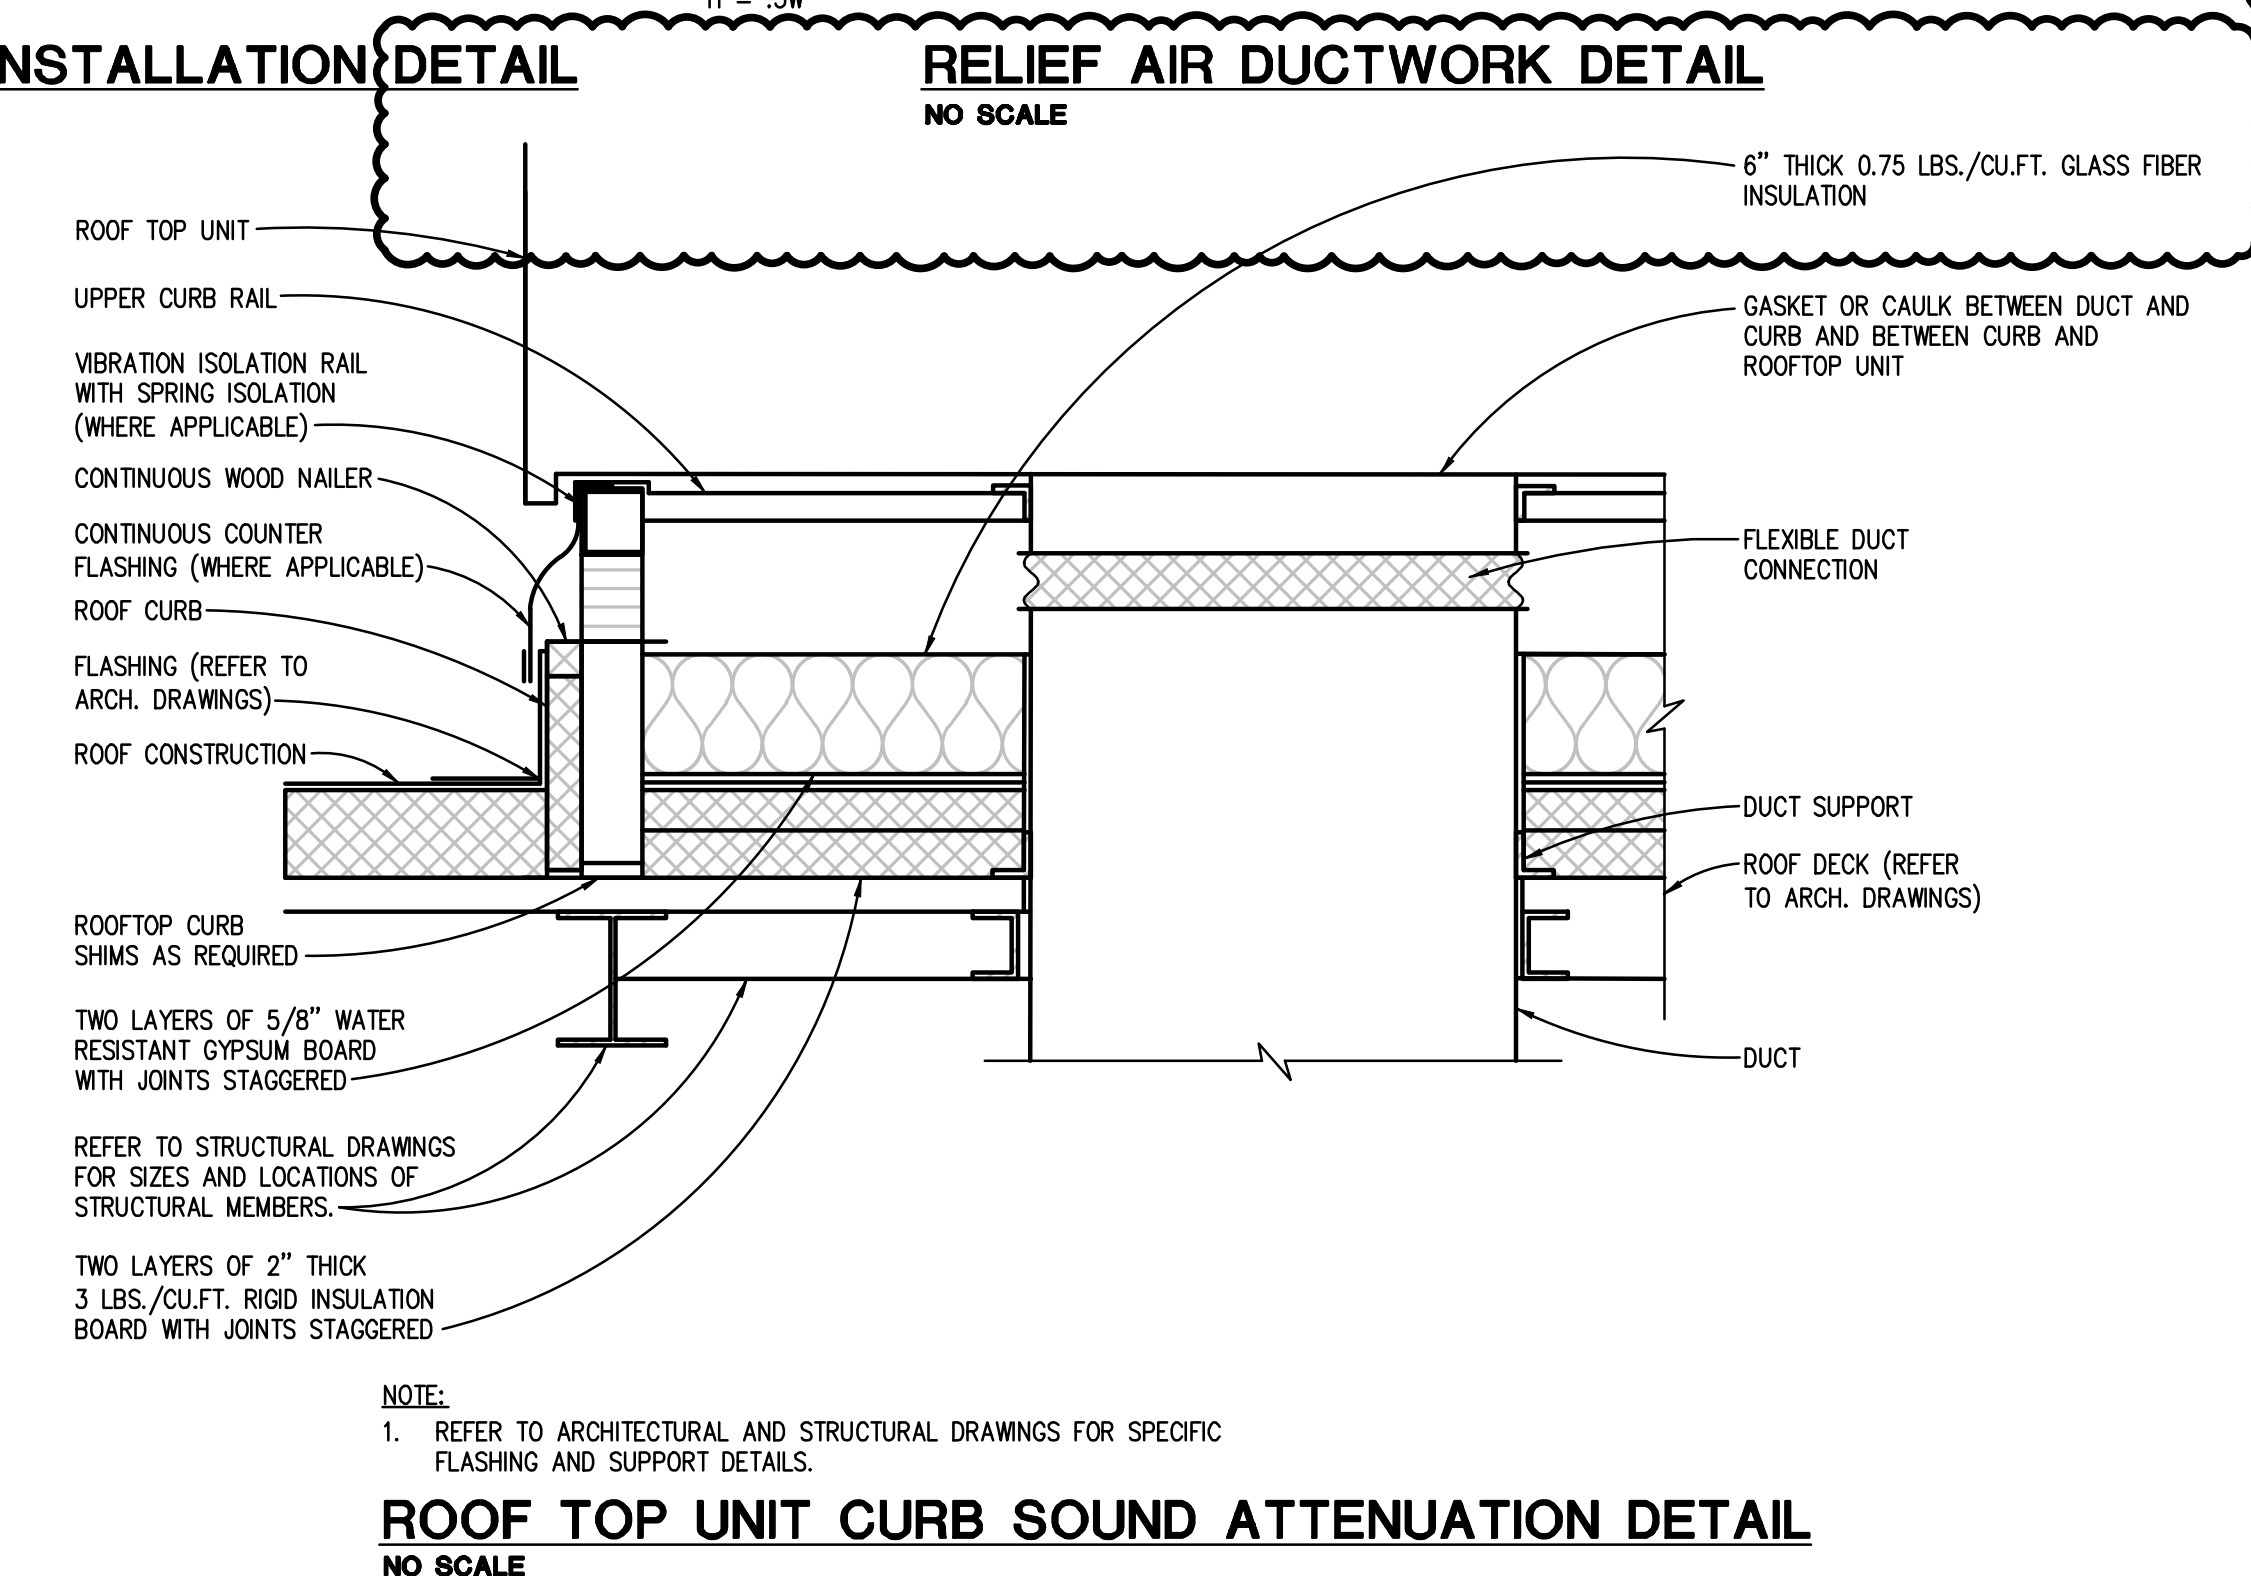

ROOF TOP UNIT CURB SOUND ATTENUATION DETAIL
NO SCALE



TMP ARCHITECTURE INC
1191 WEST SQUARE LAKE ROAD - BOX 289
BLOOMFIELD HILLS - MICHIGAN - 48302
PH: 248-358-4841 FX: 248-358-0223
EM: INFO@TMP-ARCHITECTURE.COM

REGISTRATION SEAL

CONSULTANT



Peter Basso Associates Inc
CONSULTING ENGINEERS
5145 Livernois, Suite 100
Troy, Michigan 48068-5276
Tel 248-879-5666
Fax 248-879-0007
www.PeterBassoAssociates.com
PBA Project No. 20230354

PROJECT TITLE
NEW SMITH MIDDLE SCHOOL
Bid Package No. 03B

Troy School District
Troy, Michigan

DRAWING TITLE
MECHANICAL DETAILS

ISSUE DATES

07-12-2024 ADDENDUM #

06-16-2024 CONSTRUCTION DOCUMENTS

DATE ISSUED FOR:

DRAWN JRB

CHECKED KLH

APPROVED SVM

PROJECT NO.

22102

DRAWING NO.

M6.1

REGISTRATION SEAL

CONSULTANT

PROJECT TITLE
**NEW SMITH
 MIDDLE SCHOOL**
 Bid Package No. 03B

Troy School District
 Troy, Michigan

DRAWING TITLE
MECHANICAL DETAILS


ISSUE DATES

07-12-2024 ADDENDUM #2
 06-18-2024 CONSTRUCTION DOCUMENTS
 DATE ISSUED FOR:


DRAWN JRB
 CHECKED KLH
 APPROVED SVM

PROJECT NO.
22102


DRAWING NO.
M6.6

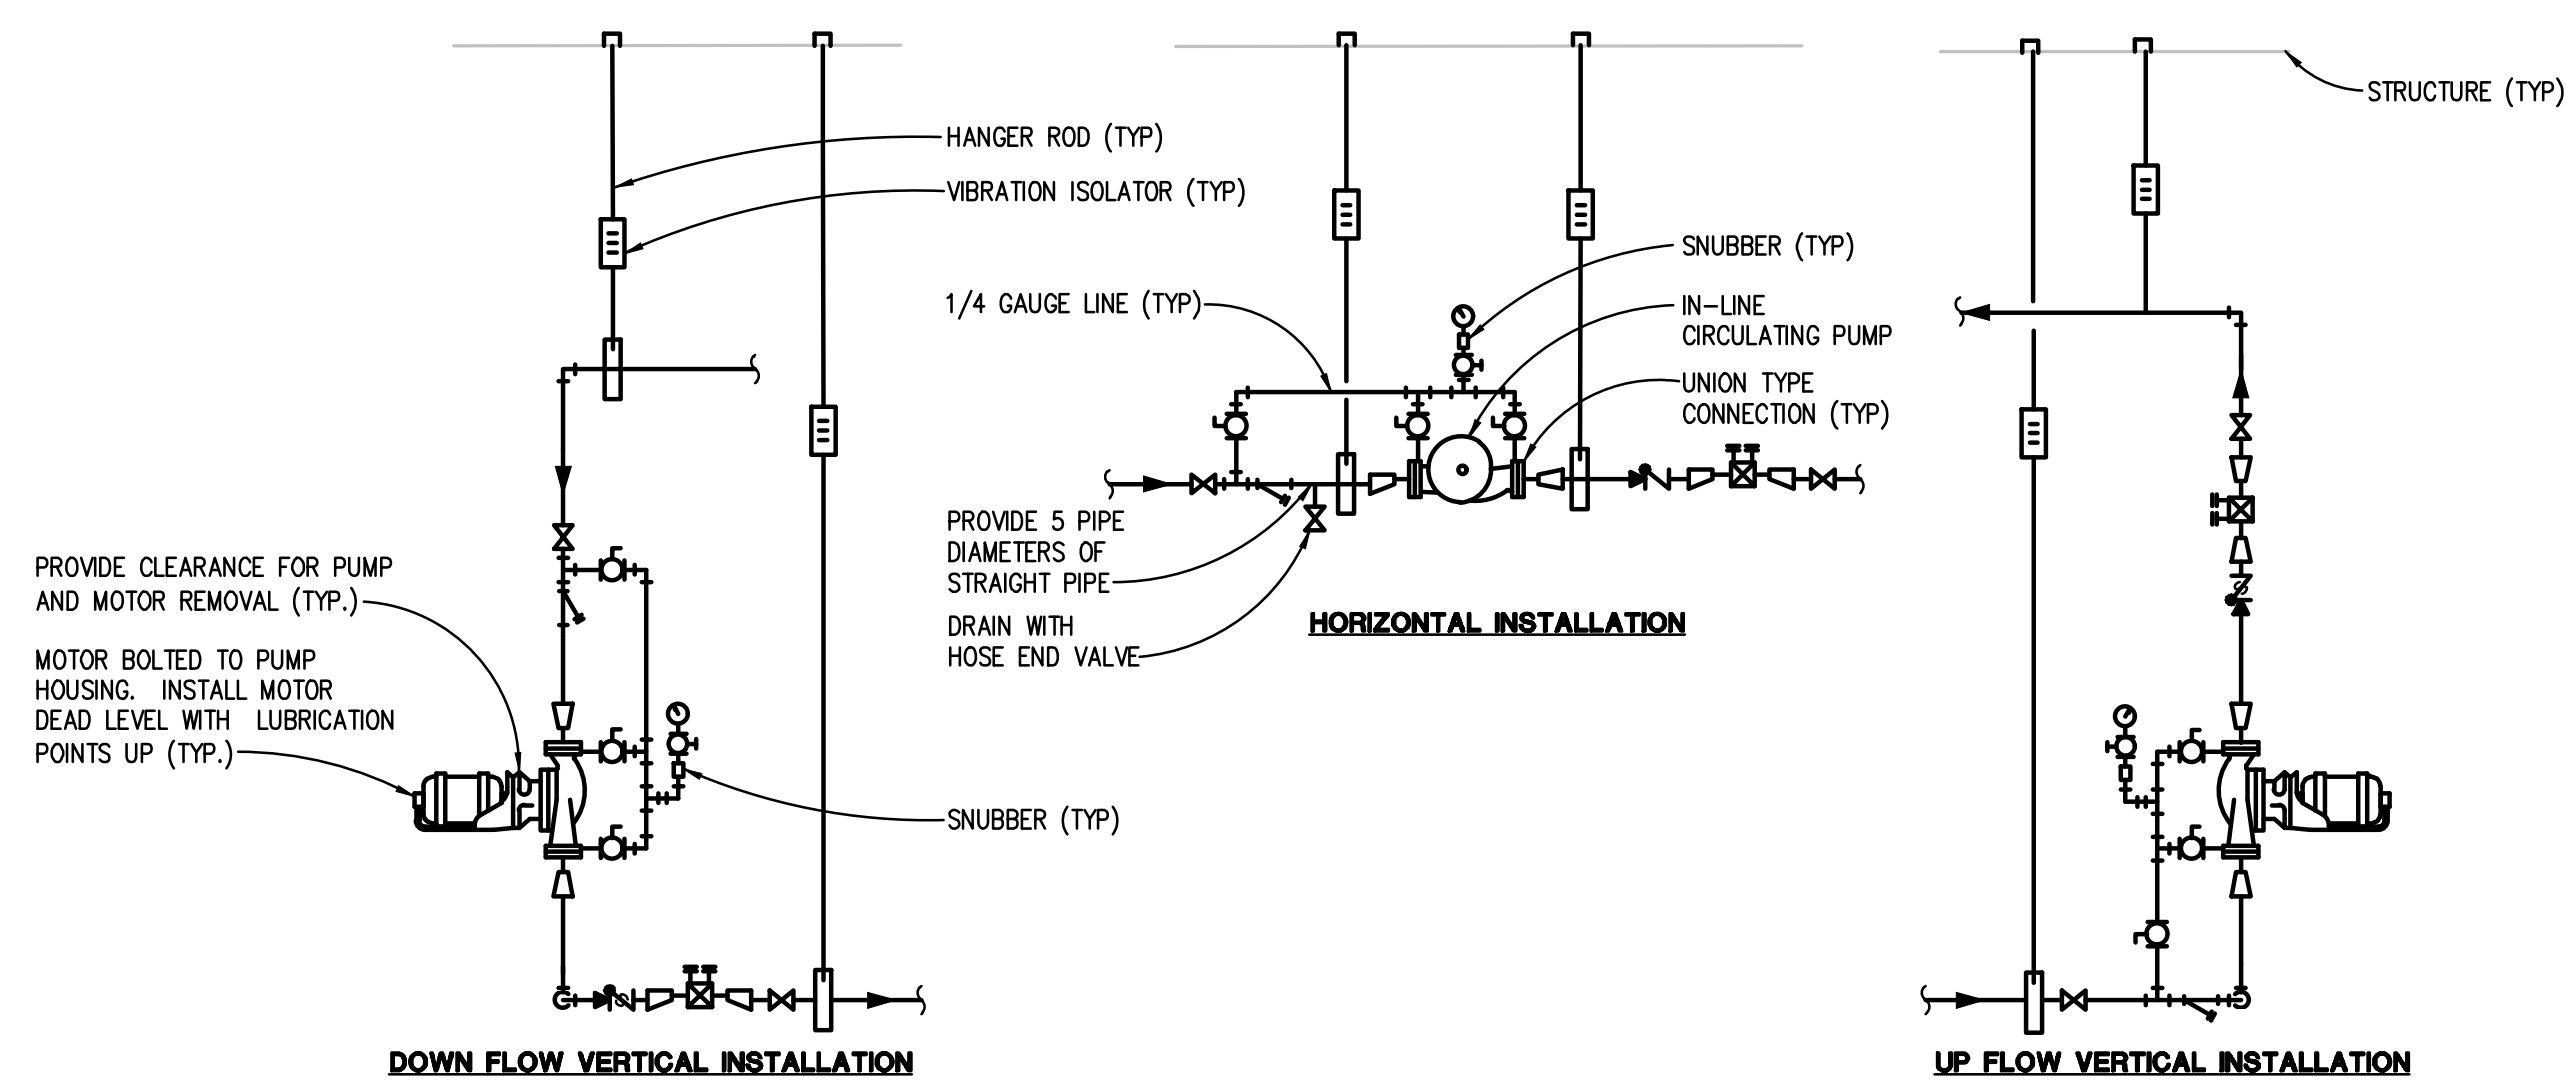


IN-LINE FLEXIBLE COUPLING (BELL AND GOSSETT SERIES 60) CIRCULATING PUMP PIPING DIAGRAM
 NO SCALE

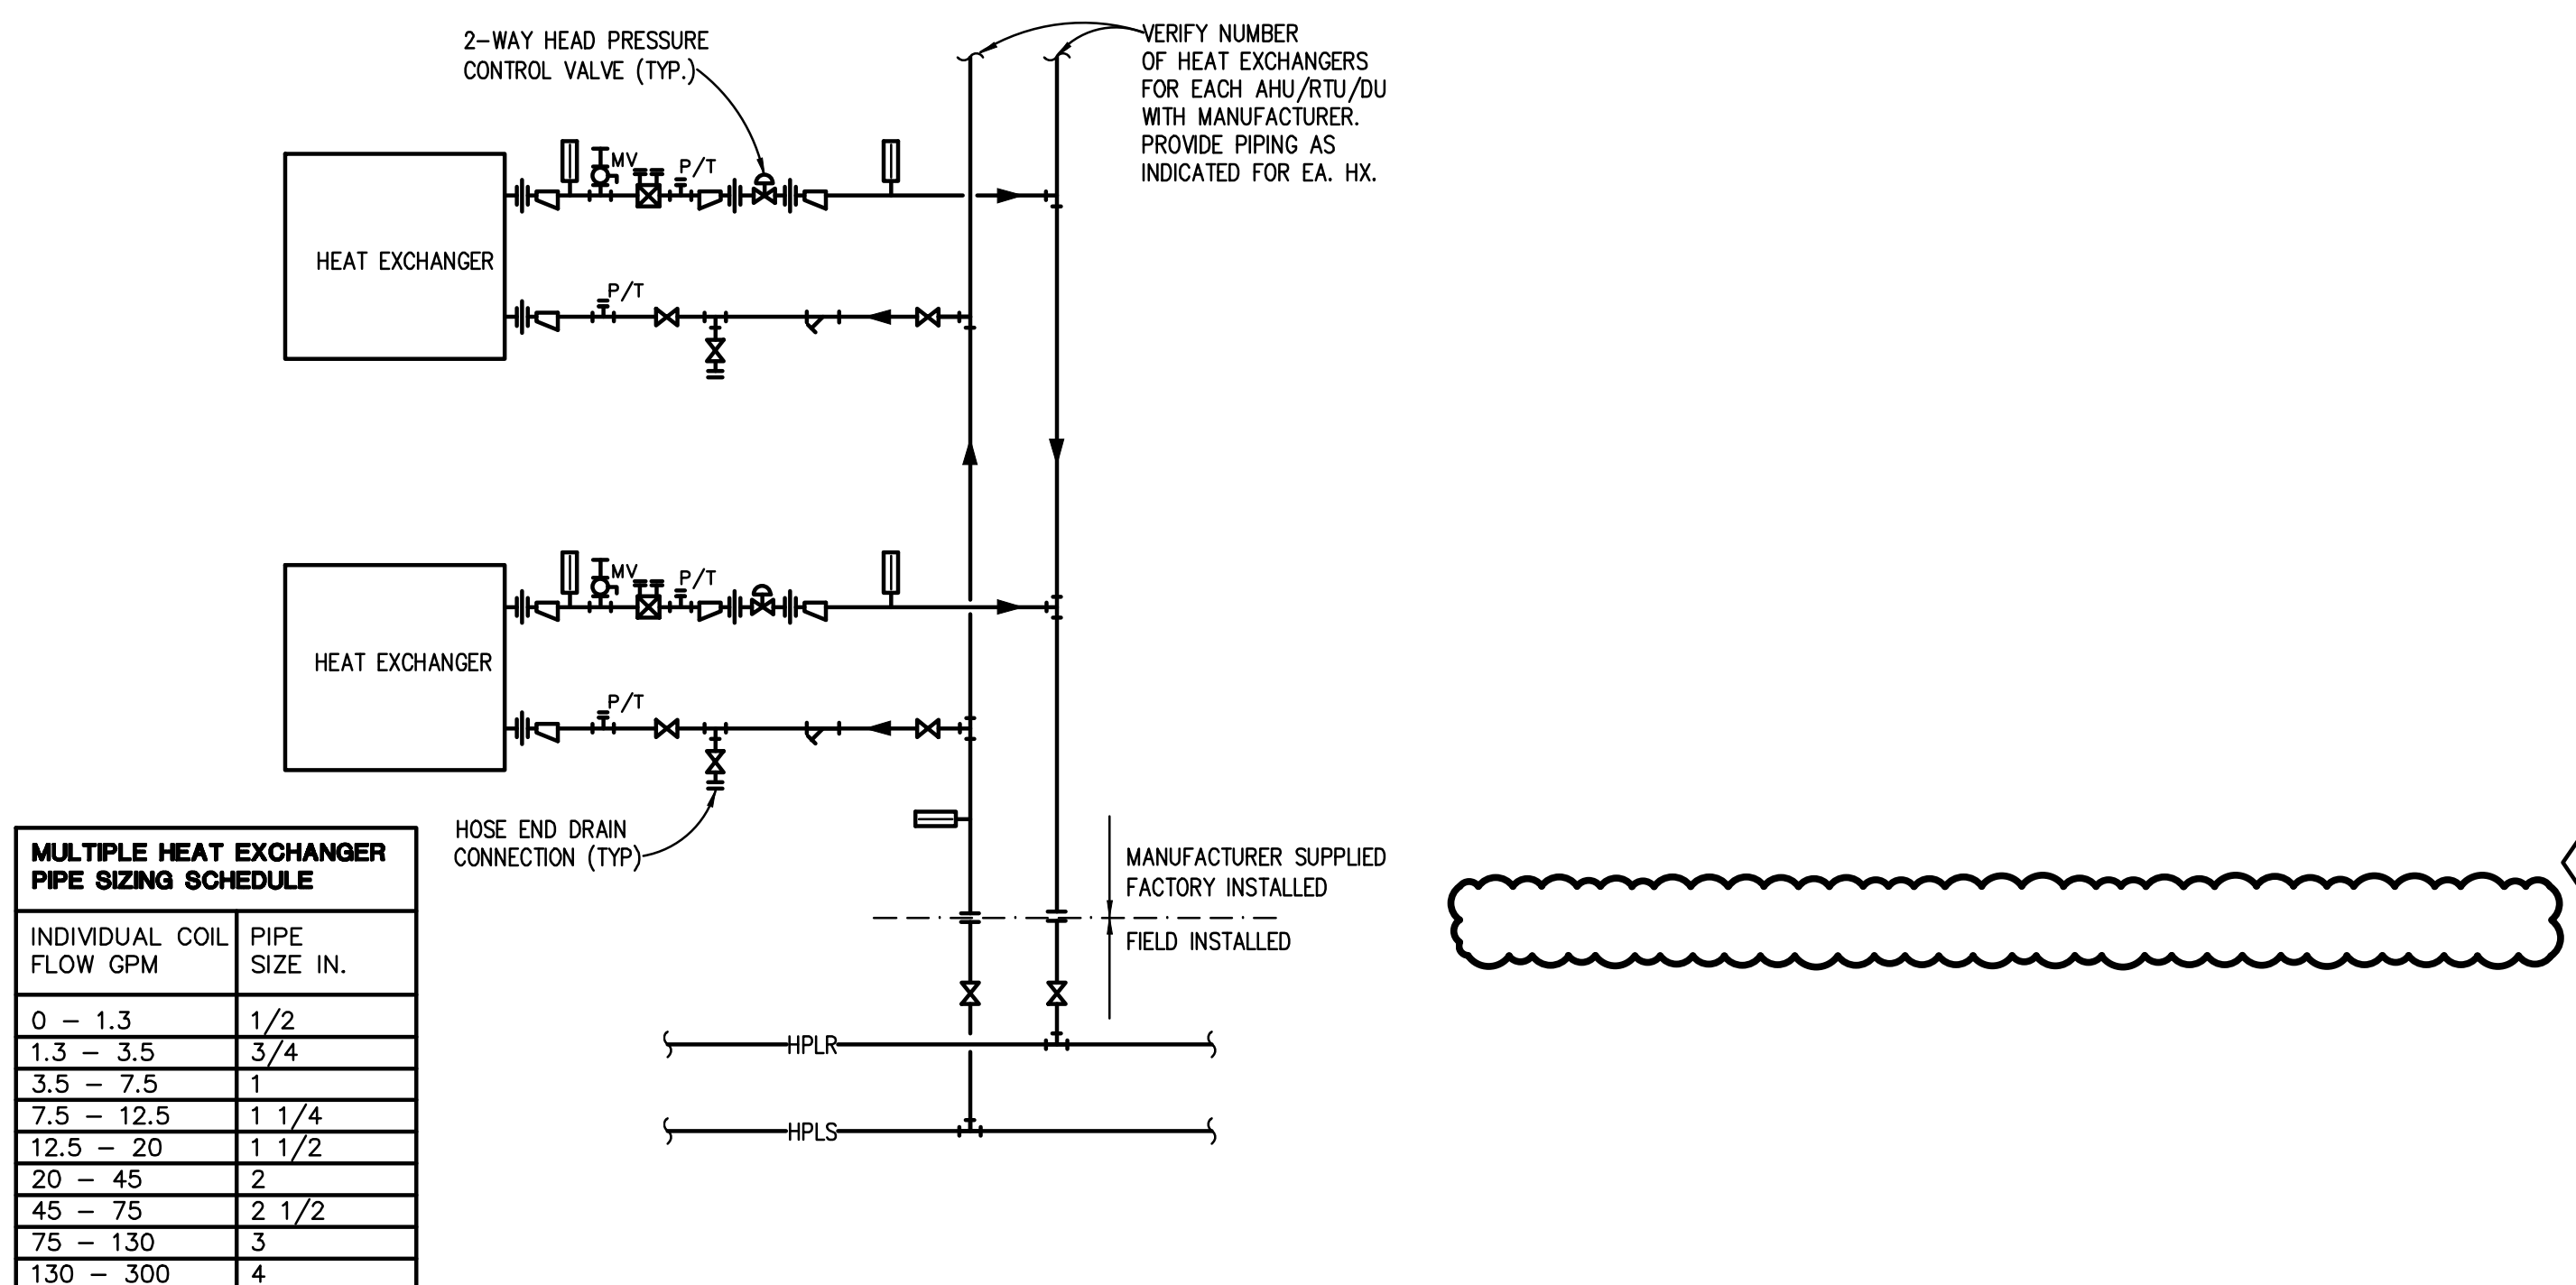


**ERU HEAT PUMP PIPING DIAGRAM
 WITH 2-WAY VALVES**
 ONLY FOR ERU-X

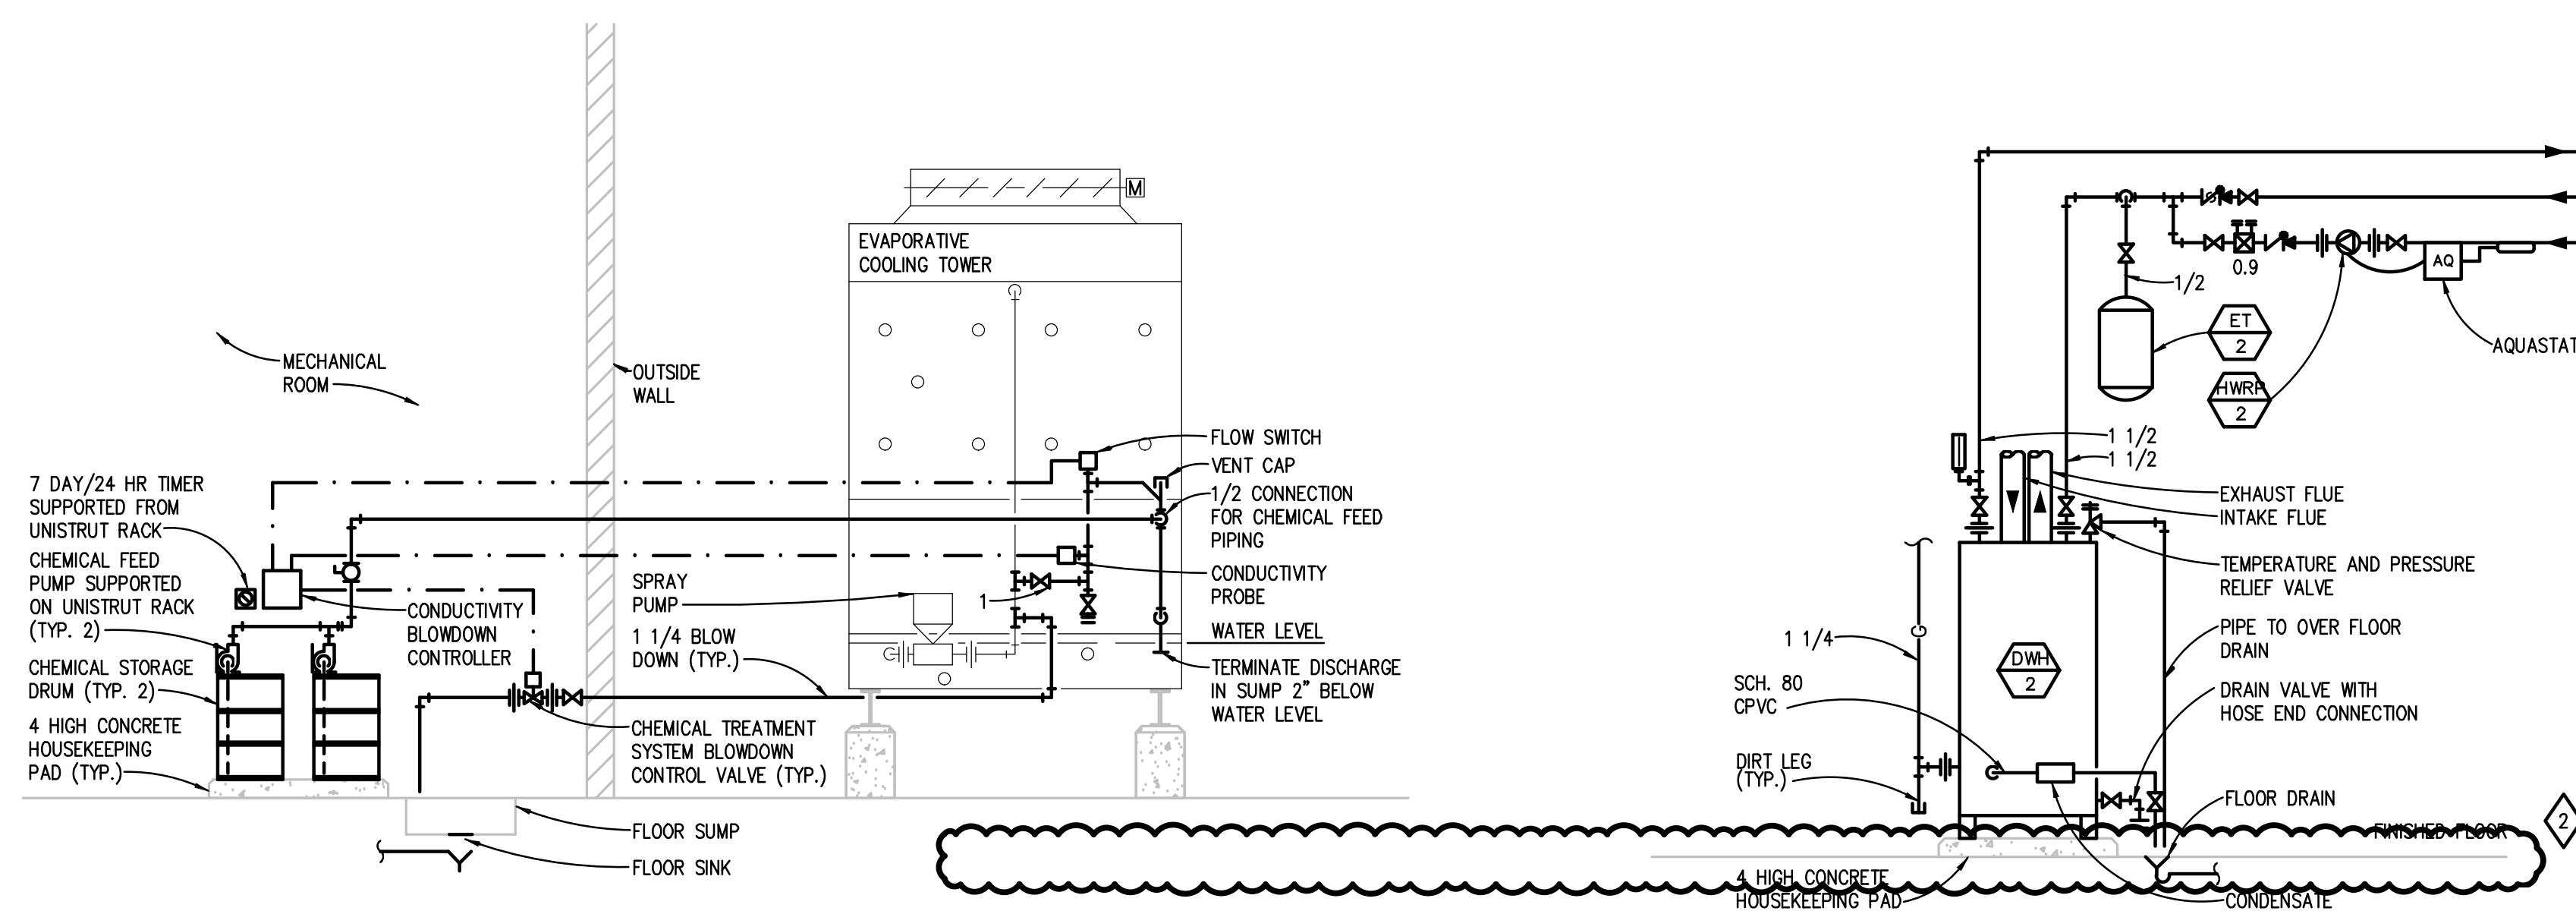

**CLOSED CIRCUIT EVAPORATIVE COOLER SUMP
 CHEMICAL TREATMENT SYSTEM**
 NO SCALE


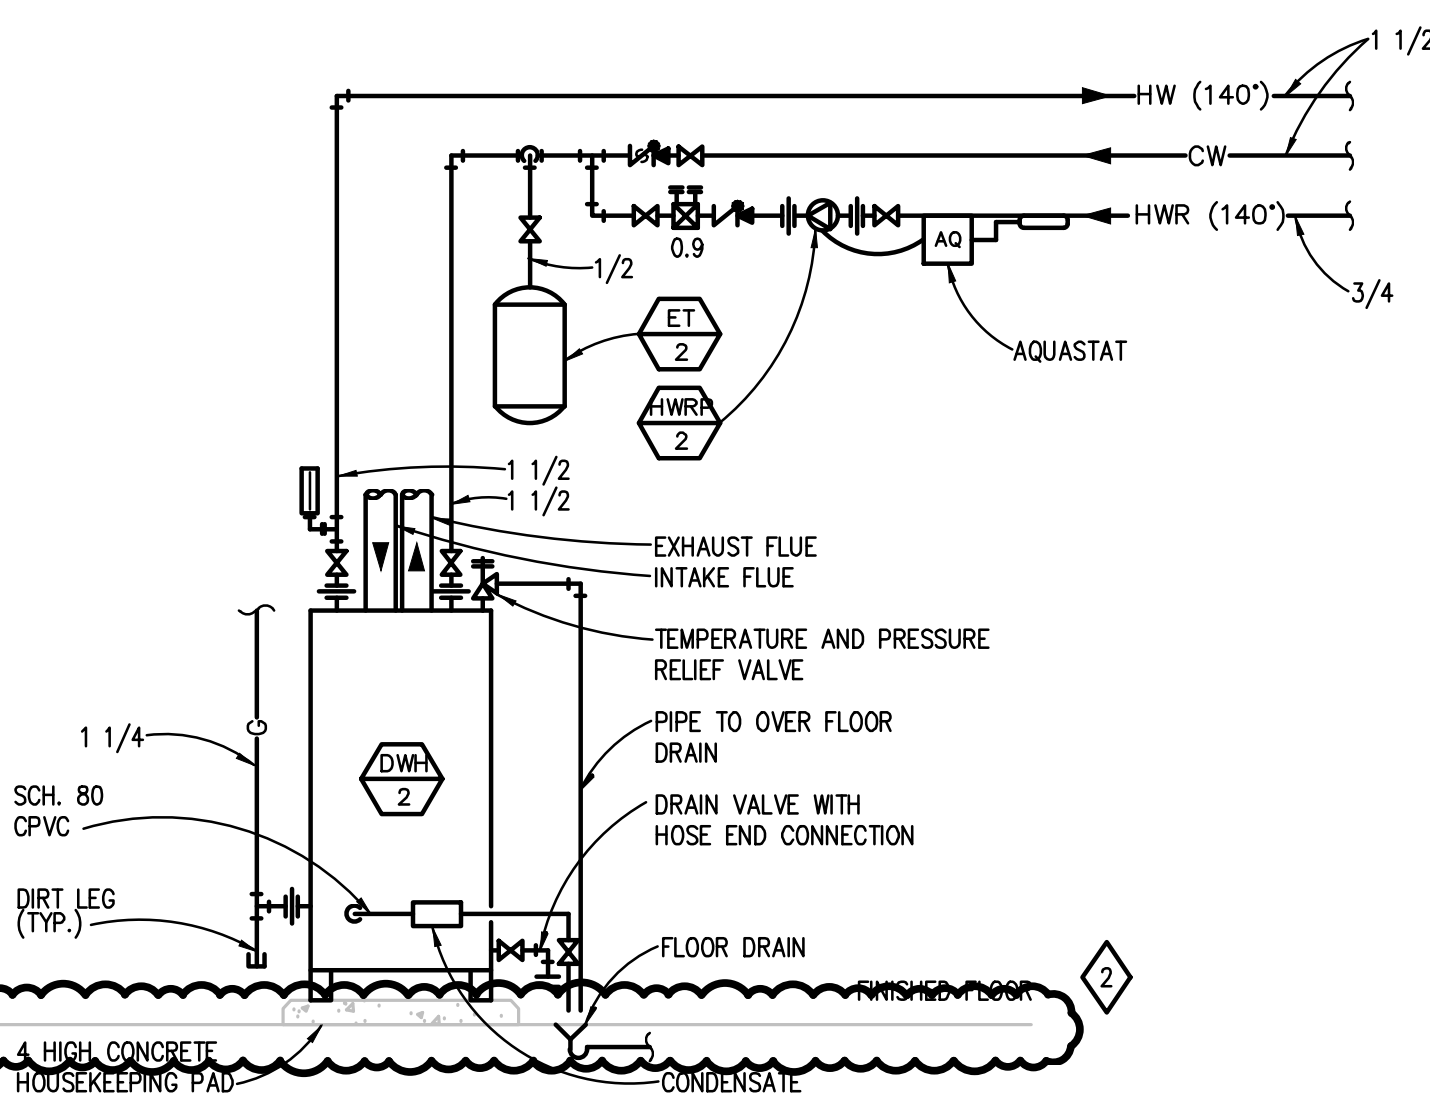


**GAS FIRED CONDENSING WATER
 HEATER PIPING DIAGRAM**
 NO SCALE

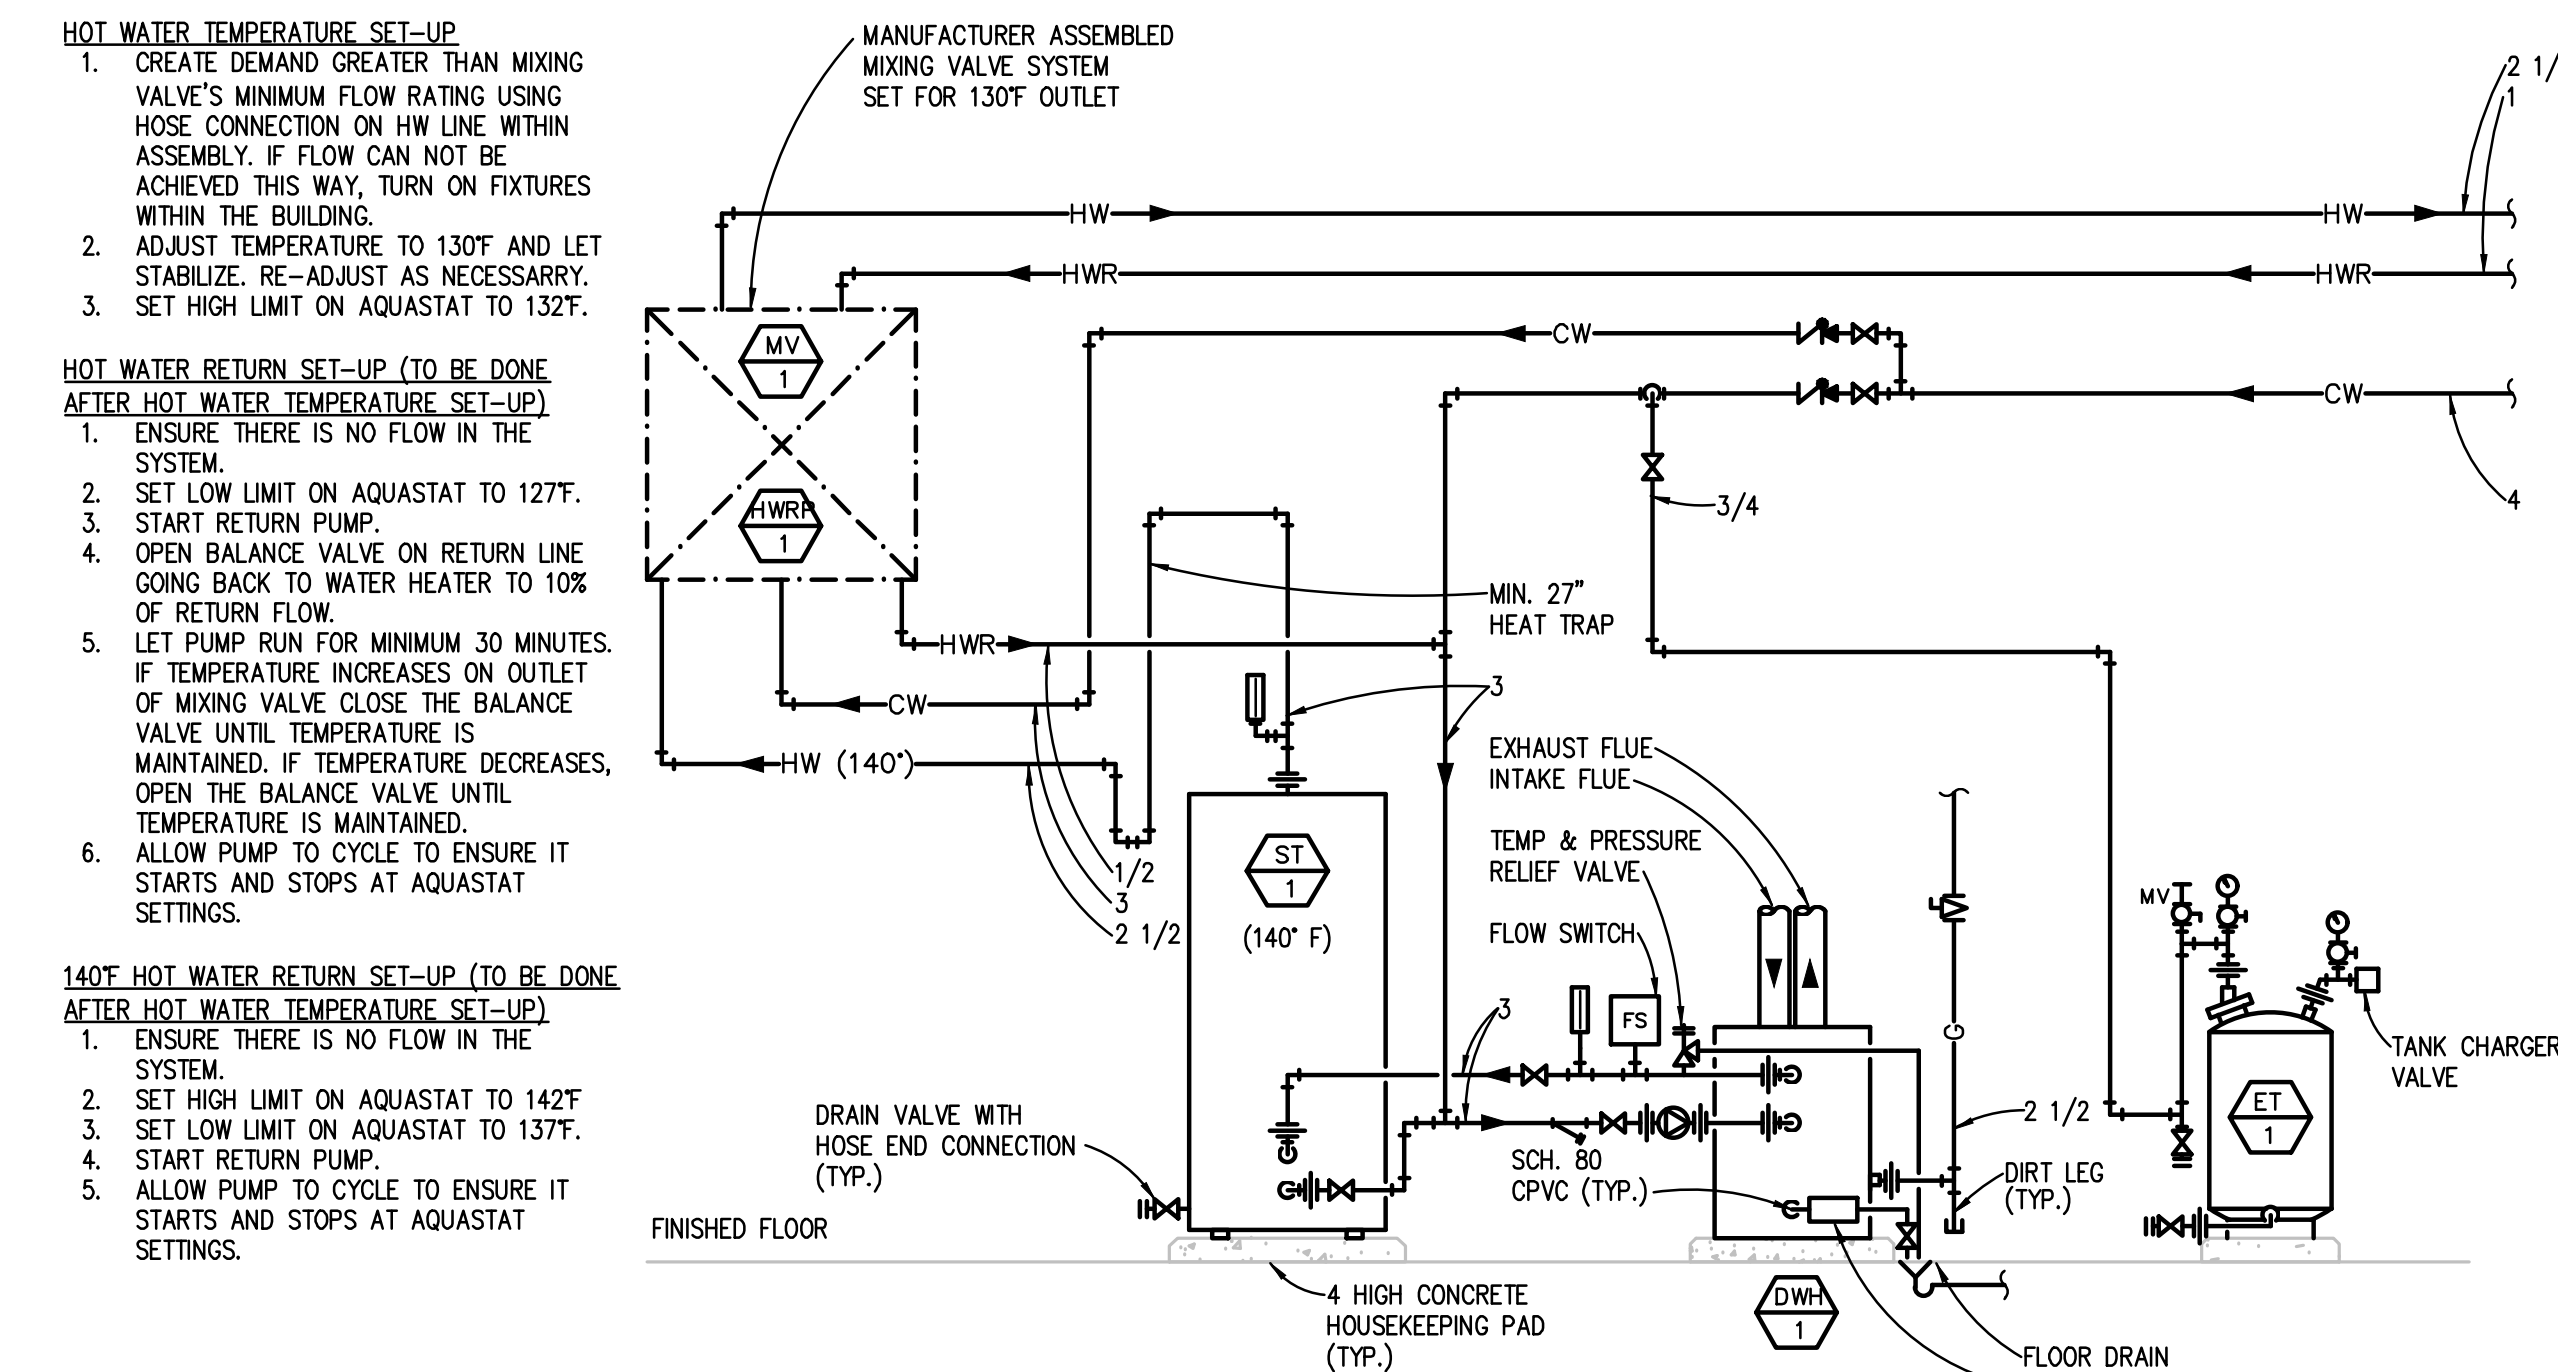

**SINGLE CONDENSING WATER HEATER WITH SINGLE
 STORAGE TANK AND MIXING VALVE PIPING DIAGRAM**
 NO SCALE

THE FOLLOWING DIMENSION EQUALS ONE INCH WHEN PRINTED TO SCALE.

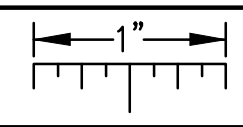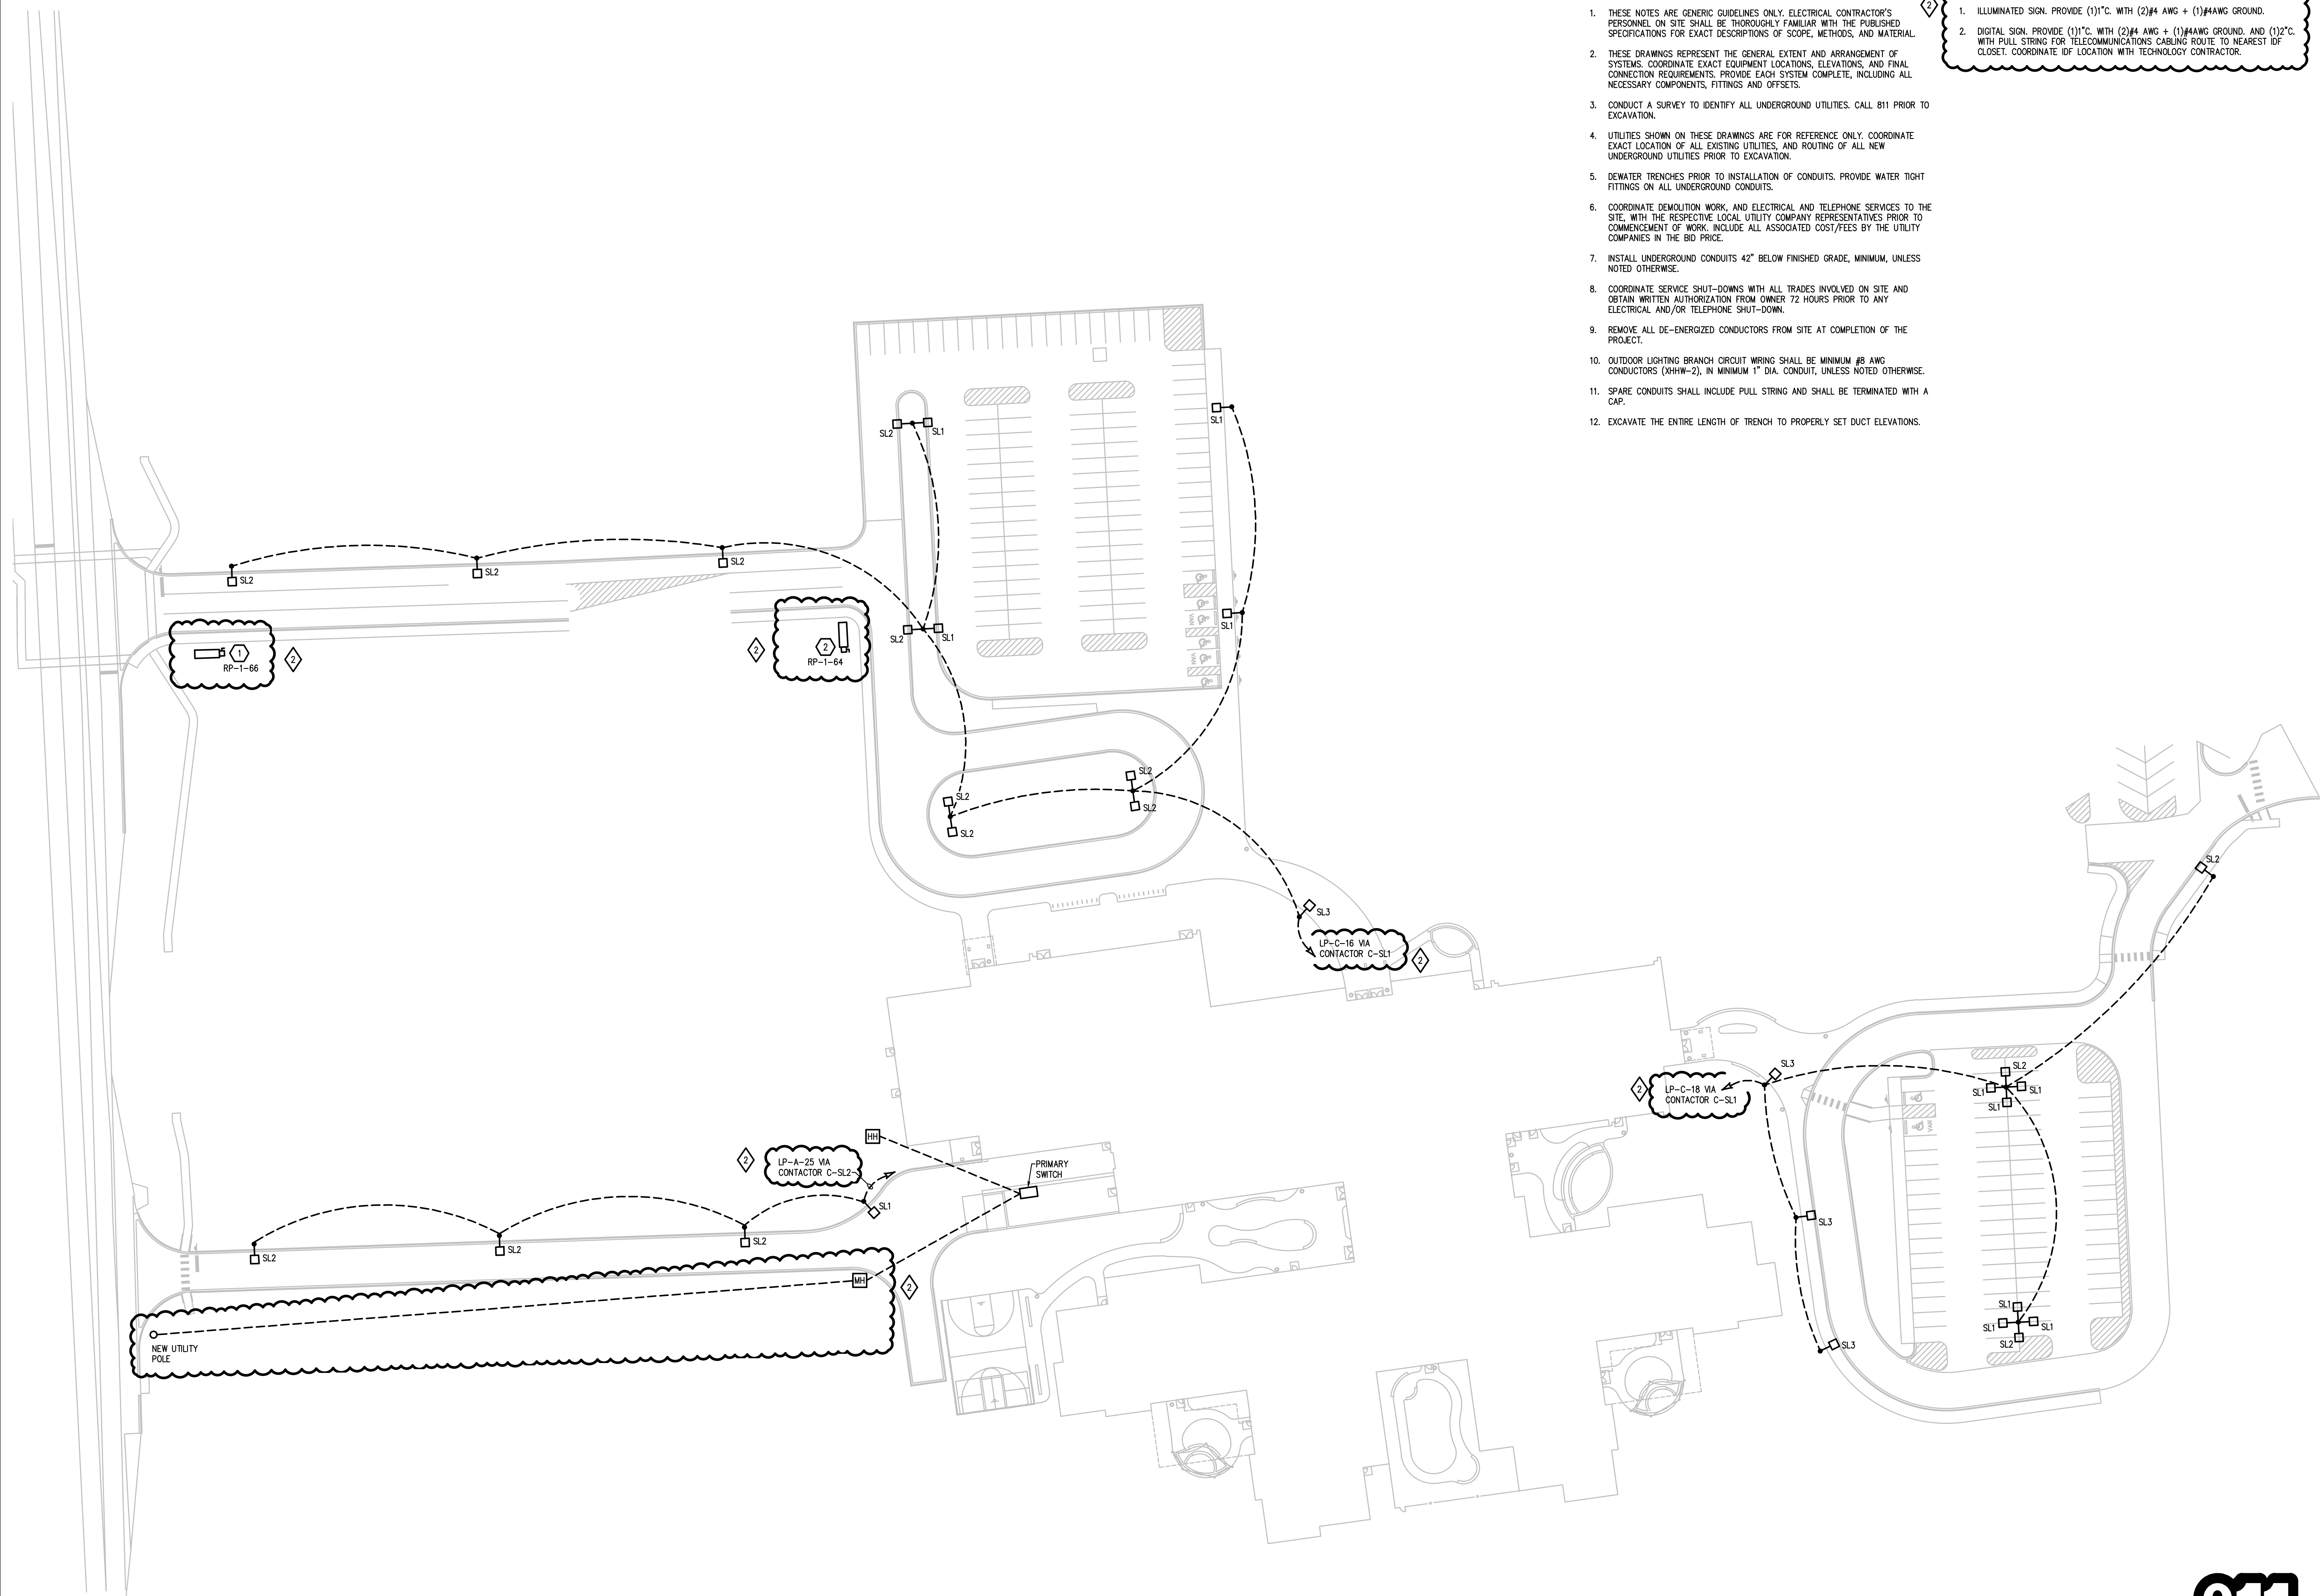SITE PLAN GENERAL NOTES:

- THESE NOTES ARE GENERIC GUIDELINES ONLY. ELECTRICAL CONTRACTOR'S PERSONNEL ON SITE SHALL BE THOROUGHLY FAMILIAR WITH THE PUBLISHED SPECIFICATIONS FOR EXACT DESCRIPTIONS OF SCOPE, METHODS, AND MATERIAL.
- THESE DRAWINGS REPRESENT THE GENERAL EXTENT AND ARRANGEMENT OF SYSTEMS. COORDINATE EXACT EQUIPMENT LOCATIONS, ELEVATIONS, AND FINAL CONNECTION REQUIREMENTS. PROVIDE EACH SYSTEM COMPLETE, INCLUDING ALL NECESSARY COMPONENTS, FITTINGS AND OFFSETS.
- CONDUCT A SURVEY TO IDENTIFY ALL UNDERGROUND UTILITIES. CALL 811 PRIOR TO EXCAVATION.
- UTILITIES SHOWN ON THESE DRAWINGS ARE FOR REFERENCE ONLY. COORDINATE EXACT LOCATION OF ALL EXISTING UTILITIES, AND ROUTING OF ALL NEW UNDERGROUND UTILITIES PRIOR TO EXCAVATION.
- DEWATER TRENCHES PRIOR TO INSTALLATION OF CONDUITS. PROVIDE WATER TIGHT FITTINGS ON ALL UNDERGROUND CONDUITS.
- COORDINATE DEMOLITION WORK, AND ELECTRICAL AND TELEPHONE SERVICES TO THE SITE, WITH THE RESPECTIVE LOCAL UTILITY COMPANY REPRESENTATIVES PRIOR TO COMMENCEMENT OF WORK. INCLUDE ALL ASSOCIATED COST/FEES BY THE UTILITY COMPANIES IN THE BID PRICE.
- INSTALL UNDERGROUND CONDUITS 42" BELOW FINISHED GRADE, MINIMUM, UNLESS NOTED OTHERWISE.
- COORDINATE SERVICE SHUT-DOWNS WITH ALL TRADES INVOLVED ON SITE AND OBTAIN WRITTEN AUTHORIZATION FROM OWNER 72 HOURS PRIOR TO ANY ELECTRICAL AND/OR TELEPHONE SHUT-DOWN.
- REMOVE ALL DE-ENERGIZED CONDUCTORS FROM SITE AT COMPLETION OF THE PROJECT.
- OUTDOOR LIGHTING BRANCH CIRCUIT WIRING SHALL BE MINIMUM #8 AWG CONDUCTORS (XHHW-2), IN MINIMUM 1" DIA. CONDUIT, UNLESS NOTED OTHERWISE.
- SPARE CONDUITS SHALL INCLUDE PULL STRING AND SHALL BE TERMINATED WITH A CAP.
- EXCAVATE THE ENTIRE LENGTH OF TRENCH TO PROPERLY SET DUCT ELEVATIONS.

CONSTRUCTION KEY NOTES:

- ILLUMINATED SIGN. PROVIDE (1)1" C. WITH (2)#4 AWG + (1)#4 AWG GROUND.
- DIGITAL SIGN. PROVIDE (1)1" C. WITH (2)#4 AWG + (1)#4 AWG GROUND. AND (1)2" C. WITH PULL STRING FOR TELECOMMUNICATIONS CABLING ROUTE TO NEAREST IDF CLOSET. COORDINATE IDF LOCATION WITH TECHNOLOGY CONTRACTOR.



ELECTRICAL SITE NEW WORK PLAN
SCALE: 1" = 40'



**Know what's below.
Call before you dig.**



TMP ARCHITECTURE INC
1191 WEST SQUARE LAKE ROAD - BOX 289
BLOOMFIELD HILLS - MICHIGAN - 48302
PTEL: 248-588-4841 FTEL: 248-588-0225
EM: INFO@TMP-ARCHITECTURE.COM

REGISTRATION SEAL

CONSULTANT



Peter Basso Associates Inc
CONSULTING ENGINEERS
5145 Livernois, Suite 100
Troy, Michigan 48066-5276
Tel: 248-879-5666
Fax: 248-879-0007
www.PeterBassoAssociates.com
PBA Project No. 20230354

PROJECT TITLE

**NEW SMITH
MIDDLE SCHOOL**
Bid Package No. 03B

Troy School District
Troy, Michigan

DRAWING TITLE

**ELECTRICAL SITE NEW WORK
PLAN**

ISSUE DATES

07-12-2024 ADDENDUM #2
06-16-2024 CONSTRUCTION DOCUMENTS

DATE: ISSUED FOR:

DRAWN: DDS

CHECKED: ZDB

APPROVED: STP


PROJECT NO.

22102

DRAWING NO.

E0.3

THE FOLLOWING DIMENSION EQUALS ONE INCH WHEN PRINTED TO SCALE.

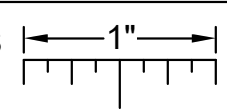

TMP ARCHITECTURE INC
1191 WEST SQUARE LAKE ROAD - BOX 289
BLOOMFIELD HILLS - MICHIGAN - 48302
PH: 248-338-6941 TX: 248-338-0223
EM: INFO@TMP-ARCHITECTURE.COM

REGISTRATION SEAL

CONSULTANT




Peter Basso Associates Inc
CONSULTING ENGINEERS
5145 Livernois, Suite 100
Troy, Michigan 48068-3276
Tel: 248-879-5666 Fax: 248-879-9007
www.PeterBassoAssociates.com
PBA Project No.: 2023.0154

PROJECT TITLE
**NEW SMITH
MIDDLE SCHOOL**
Bid Package No. 03B

Troy School District
TROY, MI

DRAWING TITLE
**ROOF LEVEL ELECTRICAL
COMPOSITE PLAN**

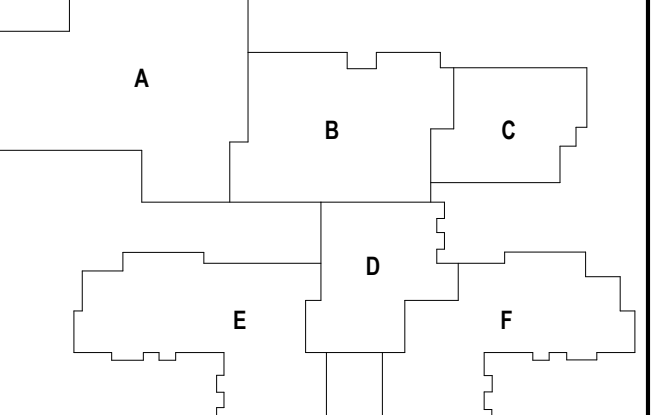

KEY PLAN


ISSUE DATES

DATE	ISSUED FOR:

07-12-2024 ADDENDUM #2
06-15-2024 CONSTRUCTION DOCUMENTS

DRAWN DDB
CHECKED ZDB
APPROVED STP

PROJECT NO.
22102
DRAWING NO.
E0.6

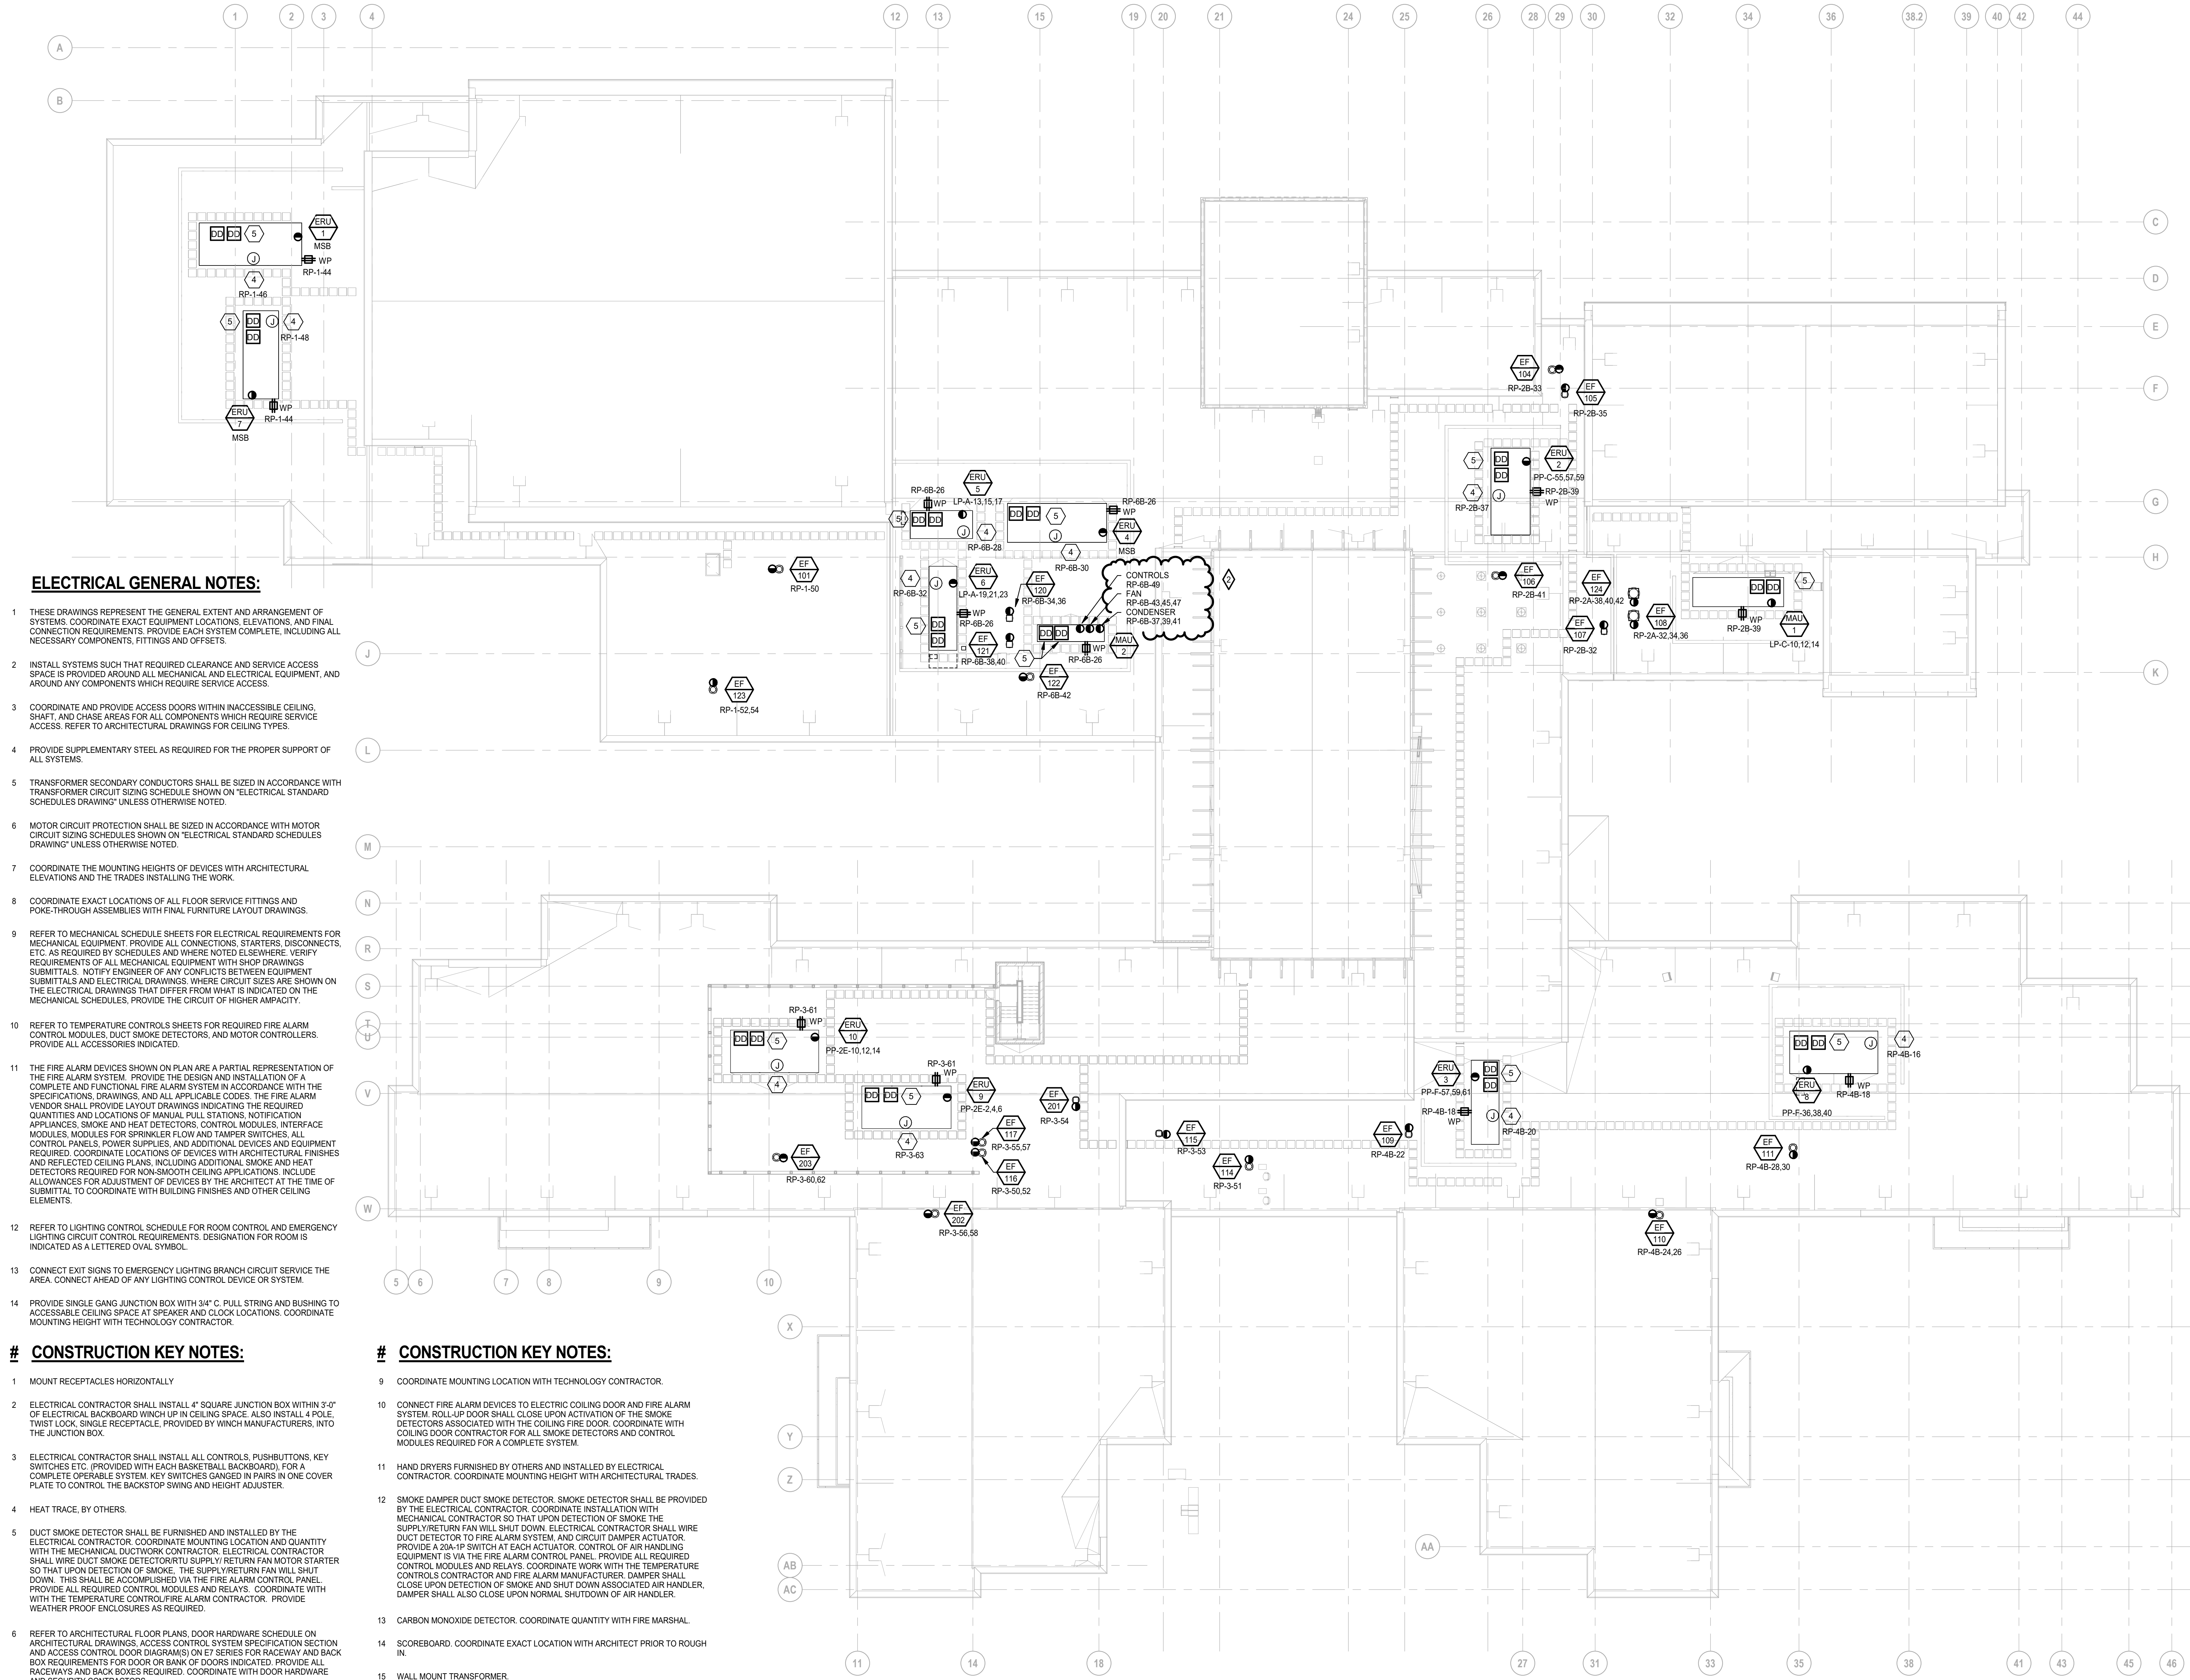

ELECTRICAL GENERAL NOTES:

- THESE DRAWINGS REPRESENT THE GENERAL EXTENT AND ARRANGEMENT OF SYSTEMS. COORDINATE EXACT EQUIPMENT LOCATIONS, ELEVATIONS, AND FINAL CONNECTION REQUIREMENTS. PROVIDE EACH SYSTEM COMPLETE, INCLUDING ALL NECESSARY COMPONENTS, FITTINGS AND OFFSETS.
- INSTALL SYSTEMS SUCH THAT REQUIRED CLEARANCE AND SERVICE ACCESS SPACE IS PROVIDED AROUND ALL MECHANICAL AND ELECTRICAL EQUIPMENT, AND AROUND ANY COMPONENTS WHICH REQUIRE SERVICE ACCESS. REFER TO ARCHITECTURAL DRAWINGS FOR CEILING TYPES.
- COORDINATE AND PROVIDE ACCESS DOORS WITHIN INACCESSIBLE CEILING, SHAFT, AND CHASE AREAS FOR ALL COMPONENTS WHICH REQUIRE SERVICE ACCESS. REFER TO ARCHITECTURAL DRAWINGS FOR CEILING TYPES.
- PROVIDE SUPPLEMENTARY STEEL AS REQUIRED FOR THE PROPER SUPPORT OF ALL SYSTEMS.
- TRANSFORMER SECONDARY CONDUCTORS SHALL BE SIZED IN ACCORDANCE WITH TRANSFORMER CIRCUIT SIZING SCHEDULE SHOWN ON "ELECTRICAL STANDARD SCHEDULES DRAWINGS" UNLESS OTHERWISE NOTED.
- MOTOR CIRCUIT PROTECTION SHALL BE SIZED IN ACCORDANCE WITH MOTOR CIRCUIT SIZING SCHEDULES SHOWN ON "ELECTRICAL STANDARD SCHEDULES DRAWINGS" UNLESS OTHERWISE NOTED.
- COORDINATE THE MOUNTING HEIGHTS OF DEVICES WITH ARCHITECTURAL ELEVATIONS AND THE TRADES INSTALLING THE WORK.
- COORDINATE EXACT LOCATIONS OF ALL FLOOR SERVICE FITTINGS AND POKE-THROUGH ASSEMBLIES WITH FINAL FURNITURE LAYOUT DRAWINGS.
- REFER TO MECHANICAL SCHEDULE SHEETS FOR ELECTRICAL REQUIREMENTS FOR MECHANICAL EQUIPMENT, PROVIDE ALL CONNECTIONS, STARTERS, DISCONNECTS, ETC. AS REQUIRED BY SCHEDULES AND WHERE NOTED ELSEWHERE. VERIFY REQUIREMENTS OF ALL MECHANICAL EQUIPMENT WITH SHOP DRAWINGS SUBMITTALS. NOTIFY ENGINEER OF ANY CONFLICTS BETWEEN EQUIPMENT SUBMITTALS AND ELECTRICAL DRAWINGS WHERE CIRCUIT SIZES ARE SHOWN ON THE ELECTRICAL DRAWINGS THAT DIFFER FROM WHAT IS INDICATED ON THE MECHANICAL SCHEDULES. PROVIDE THE CIRCUIT OF HIGHER AMPACITY.
- REFER TO TEMPERATURE CONTROLS SHEETS FOR REQUIRED FIRE ALARM CONTROL MODULES, DUCT SMOKE DETECTORS, AND MOTOR CONTROLLERS. PROVIDE ALL ACCESSORIES INDICATED.
- THE FIRE ALARM DEVICES SHOWN ON PLAN ARE A PARTIAL REPRESENTATION OF THE FIRE ALARM SYSTEM. PROVIDE THE DESIGN AND INSTALLATION OF A COMPLETE AND FUNCTIONAL FIRE ALARM SYSTEM IN ACCORDANCE WITH THE SPECIFICATIONS, DRAWINGS, AND ALL APPLICABLE CODES. THE FIRE ALARM VENDOR SHALL PROVIDE LAYOUT DRAWINGS INDICATING THE REQUIRED QUANTITIES AND LOCATIONS OF MANUAL PULL STATIONS, NOTIFICATION APPLIANCES, SMOKE AND HEAT DETECTORS, CONTROL MODULES, INTERFACE MODULES, MODULES FOR SPRINKLER FLOW AND TAMPER SWITCHES, AL CONTROL PANELS, POWER SUPPLIES, AND ADDITIONAL DEVICES AND EQUIPMENT REQUIRED. COORDINATE LOCATIONS OF DEVICES WITH ARCHITECTURAL FINISHES AND REFLECTED CEILING PLANS, INCLUDING ADDITIONAL SMOKE AND HEAT DETECTORS REQUIRED FOR NON-SMOOTH CEILING APPLICATIONS. INCLUDE ALLOWANCES FOR ADJUSTMENT OF DEVICES BY THE ARCHITECT AT THE TIME OF SUBMITTAL TO COORDINATE WITH BUILDING FINISHES AND OTHER CEILING ELEMENTS.
- REFER TO LIGHTING CONTROL SCHEDULE FOR ROOM CONTROL AND EMERGENCY LIGHTING CIRCUIT CONTROL REQUIREMENTS. DESIGNATION FOR ROOM IS INDICATED AS A LETTERED OVAL SYMBOL.
- CONNECT EXIT SIGNS TO EMERGENCY LIGHTING BRANCH CIRCUIT SERVICE THE AREA. CONNECT AHEAD OF ANY LIGHTING CONTROL DEVICE OR SYSTEM.
- PROVIDE SINGLE GANG JUNCTION BOX WITH 3/4" C. PULL STRING AND BUSHING TO ACCESSIBLE CEILING SPACE AT SPEAKER AND CLOCK LOCATIONS. COORDINATE MOUNTING HEIGHT WITH TECHNOLOGY CONTRACTOR.

CONSTRUCTION KEY NOTES:


- MOUNT RECEPTACLES HORIZONTALLY
- ELECTRICAL CONTRACTOR SHALL INSTALL 4" SQUARE JUNCTION BOX WITHIN 3'-0" OF ELECTRICAL BACKBOARD WINCH UP IN CEILING SPACE. ALSO INSTALL 4 POLE TWIST LOCK, SINGLE RECEPTACLE, PROVIDED BY WINCH MANUFACTURERS, INTO THE JUNCTION BOX.
- ELECTRICAL CONTRACTOR SHALL INSTALL ALL CONTROLS, PUSHBUTTONS, KEY SWITCHES ETC. (PROVIDED WITH EACH BASKETBALL BACKBOARD), FOR A COMPLETE OPERABLE SYSTEM. KEY SWITCHES GANGED IN PAIRS IN ONE COVER PLATE TO CONTROL THE BASKETTOP SWING AND HEIGHT ADJUSTER.
- HEAT TRACE, BY OTHERS.
- DUCT SMOKE DETECTOR SHALL BE FURNISHED AND INSTALLED BY THE ELECTRICAL CONTRACTOR. COORDINATE MOUNTING LOCATION AND QUANTITY WITH THE MECHANICAL DUCTWORK CONTRACTOR. ELECTRICAL CONTRACTOR SHALL WIRE DUCT SMOKE DETECTOR(S) SUPPLY/RETURN FAN MOTOR STARTER SO THAT UPON DETECTION OF SMOKE, THE SUPPLY/RETURN FAN WILL SHUT DOWN. THIS SHALL BE ACCOMPLISHED VIA THE FIRE ALARM CONTROL PANEL, PROVIDE ALL REQUIRED CONTROL MODULES AND RELAYS. COORDINATE WITH THE TEMPERATURE CONTROL/FIRE ALARM CONTRACTOR. PROVIDE WEATHER PROOF ENCLOSURES AS REQUIRED.
- REFER TO ARCHITECTURAL FLOOR PLANS, DOOR HARDWARE SCHEDULE ON ARCHITECTURAL DRAWINGS, ACCESS CONTROL SYSTEM SPECIFICATION SECTION AND ACCESS CONTROL DOOR DIAGRAM(S) ON E7 SERIES FOR RACEWAY AND BACK BOX REQUIREMENTS FOR DOOR OR BANK OF DOORS INDICATED. PROVIDE ALL RACEWAYS AND BACK BOXES REQUIRED. COORDINATE WITH DOOR HARDWARE AND SECURITY CONTRACTORS.
- PROVIDE 2-2" AND 1-1/2" O.D. CONDUITS FOR TECHNOLOGY AND AUXILIARY SYSTEM WIRE AS INDICATED. STUB CONDUITS FROM CEILING SPACE. PROVIDE PLASTIC BUSHINGS AT EACH END. PROVIDE REMOVABLE/RESEALABLE FIRE STOP PUTTY IN EACH CONDUIT AND FIRE STOP AROUND EACH CONDUIT. COORDINATE WITH TECHNOLOGY CONTRACTOR FOR EXACT LOCATION OF CONDUIT. PROVIDE MINIMUM OF 1" CONDUIT FOR ALL OTHER AREAS REQUIRING SLEEVES.
- PROVIDE 1/2" CONDUIT WITH PULL STRING AND BUSHINGS FOR TECHNOLOGY. ROUTE UNDER BUILDING AND TERMINATE AT EXTERIOR OF BUILDING.

CONSTRUCTION KEY NOTES:

- COORDINATE MOUNTING LOCATION WITH TECHNOLOGY CONTRACTOR.
- CONNECT FIRE ALARM DEVICES TO ELECTRIC COILING DOOR AND FIRE ALARM SYSTEM. ROLL-UP DOOR SHALL CLOSE UPON ACTIVATION OF THE SMOKE DETECTORS ASSOCIATED WITH THE COILING FIRE DOOR. COORDINATE WITH COILING DOOR CONTRACTOR FOR ALL SMOKE DETECTORS AND CONTROL MODULES REQUIRED FOR A COMPLETE SYSTEM.
- HAND DRYERS FURNISHED BY OTHERS AND INSTALLED BY ELECTRICAL CONTRACTOR. COORDINATE MOUNTING HEIGHT WITH ARCHITECTURAL TRADES.
- SMOKE DAMPER DUCT SMOKE DETECTOR. SMOKE DETECTOR SHALL BE PROVIDED BY THE ELECTRICAL CONTRACTOR. COORDINATE INSTALLATION WITH MECHANICAL CONTRACTOR SO THAT UPON DETECTION OF SMOKE THE SUPPLY/RETURN FAN WILL SHUT DOWN. ELECTRICAL CONTRACTOR SHALL WIRE DUCT DETECTOR TO FIRE ALARM SYSTEM, AND CIRCUIT DAMPER ACTUATOR PROVIDE A 20A-TP SWITCH AT EACH ACTUATOR. CONTROL OF AIR HANDLING EQUIPMENT IS VIA THE FIRE ALARM CONTROL PANEL. PROVIDE ALL REQUIRED CONTROL MODULES AND RELAYS. COORDINATE WITH THE TEMPERATURE CONTROLS CONTRACTOR AND FIRE ALARM MANUFACTURER. DAMPER SHALL CLOSE UPON DETECTION OF SMOKE AND SHUT DOWN ASSOCIATED AIR HANDLER. DAMPER SHALL ALSO CLOSE UPON NORMAL SHUTDOWN OF AIR HANDLER.
- CARBON MONOXIDE DETECTOR. COORDINATE QUANTITY WITH FIRE MARSHAL.
- SCOREBOARD. COORDINATE EXACT LOCATION WITH ARCHITECT PRIOR TO ROUGH IN.
- WALL MOUNT TRANSFORMER.
- ELECTRIC RANGE. PROVIDE WALL MOUNTED GFCI MODULE ABOVE COUNTER.
- LIGHTING RELAY PANEL FOR THEATRICAL LIGHTING SYSTEM. REFER TO THEATRICAL LIGHTING EQUIPMENT DRAWINGS.

ROOF ELECTRICAL COMPOSITE PLAN
SCALE: 1/16" = 1'-0"

THE FOLLOWING DIMENSION EQUALS ONE INCH WHEN PRINTED TO SCALE.

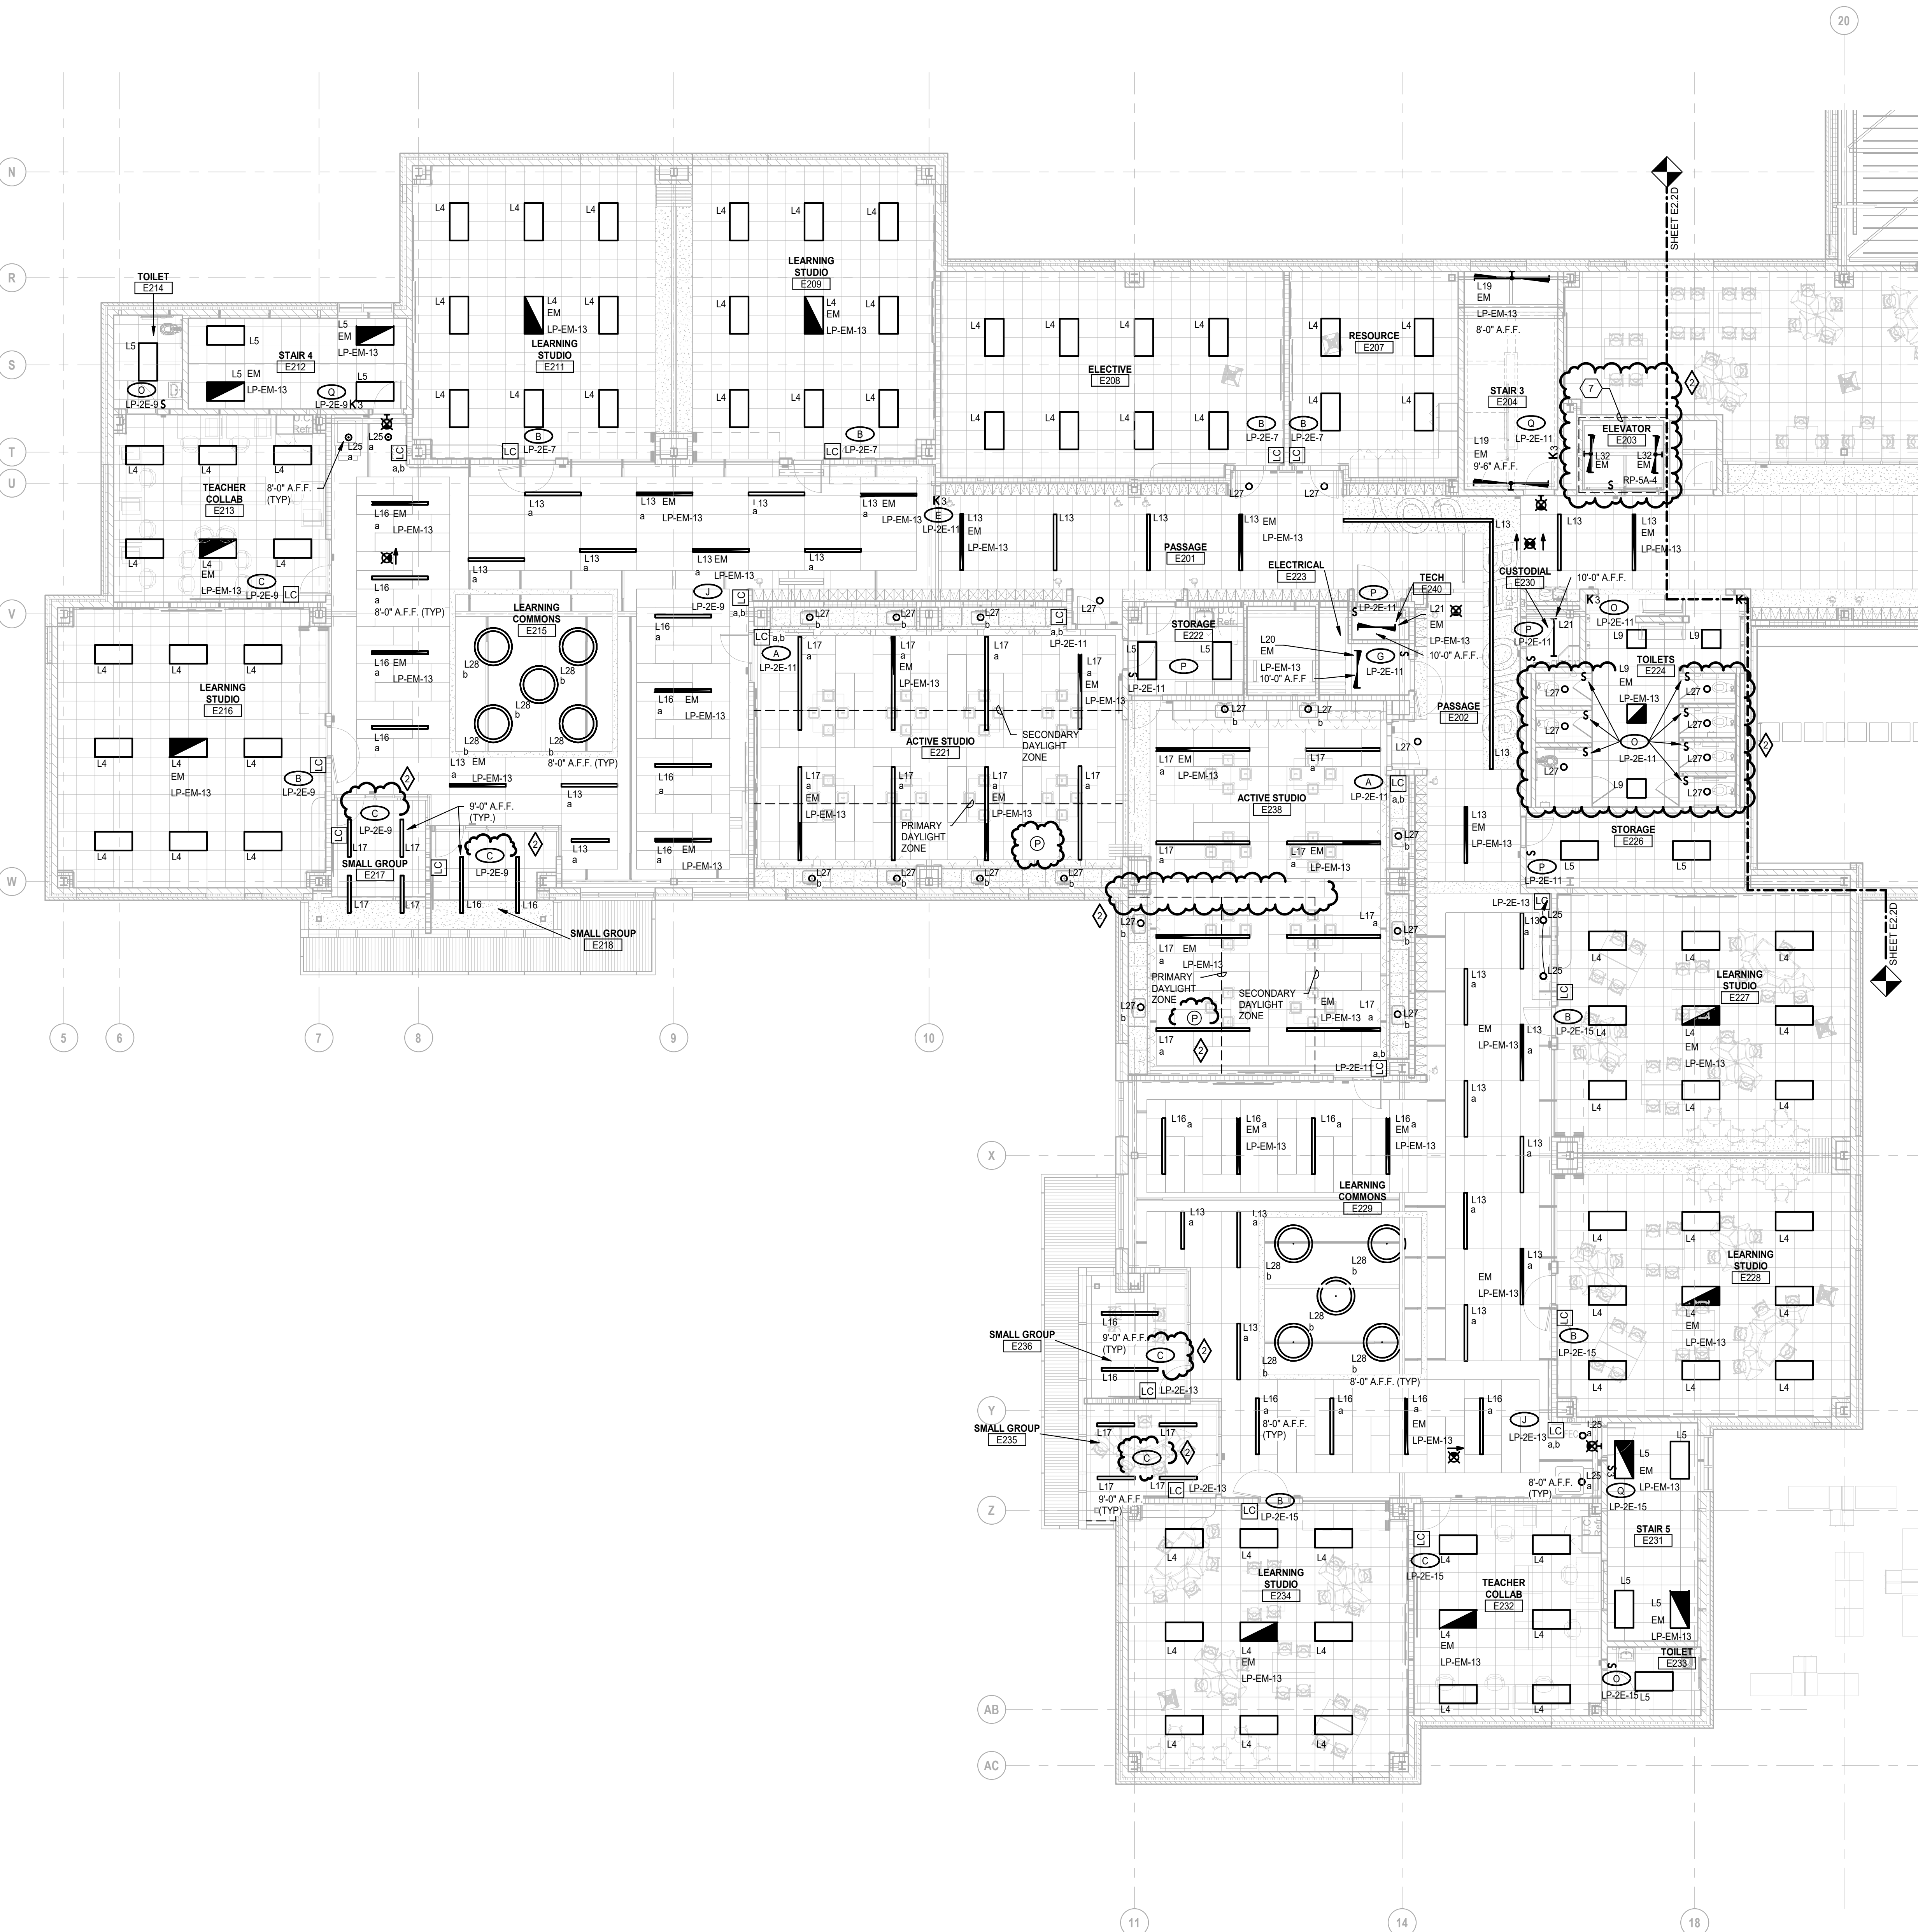

ELECTRICAL GENERAL NOTES:

- THESE DRAWINGS REPRESENT THE GENERAL EXTENT AND ARRANGEMENT OF SYSTEMS. COORDINATE EXACT EQUIPMENT LOCATIONS, ELEVATIONS, AND FINAL CONNECTION REQUIREMENTS. PROVIDE EACH SYSTEM COMPLETE, INCLUDING ALL NECESSARY COMPONENTS, FITTINGS AND OFFSETS.
- INSTALL SYSTEMS SUCH THAT REQUIRED CLEARANCE AND SERVICE ACCESS SPACE IS PROVIDED AROUND ALL MECHANICAL AND ELECTRICAL EQUIPMENT, AND AROUND ANY COMPONENTS WHICH REQUIRE SERVICE ACCESS.
- COORDINATE AND PROVIDE ACCESS DOORS WITHIN INACCESSIBLE CEILING, SHAFT, AND CHASE AREAS FOR ALL COMPONENTS WHICH REQUIRE SERVICE ACCESS. REFER TO ARCHITECTURAL DRAWINGS FOR CEILING TYPES.
- PROVIDE SUPPLEMENTARY STEEL AS REQUIRED FOR THE PROPER SUPPORT OF ALL SYSTEMS.
- TRANSFORMER SECONDARY CONDUCTORS SHALL BE SIZED IN ACCORDANCE WITH TRANSFORMER CIRCUIT SIZING SCHEDULE SHOWN ON "ELECTRICAL STANDARD SCHEDULES DRAWING" UNLESS OTHERWISE NOTED.
- MOTOR CIRCUIT PROTECTION SHALL BE SIZED IN ACCORDANCE WITH MOTOR CIRCUIT SIZING SCHEDULES SHOWN ON "ELECTRICAL STANDARD SCHEDULES DRAWING" UNLESS OTHERWISE NOTED.
- COORDINATE THE MOUNTING HEIGHTS OF DEVICES WITH ARCHITECTURAL ELEVATIONS AND THE TRADES INSTALLING THE WORK.
- COORDINATE EXACT LOCATIONS OF ALL FLOOR SERVICE FITTINGS AND POKE-THROUGH ASSEMBLIES WITH FINAL FURNITURE LAYOUT DRAWINGS.
- REFER TO MECHANICAL SCHEDULE SHEETS FOR ELECTRICAL REQUIREMENTS FOR MECHANICAL EQUIPMENT. PROVIDE ALL CONNECTIONS, STARTERS, DISCONNECTS, ETC. AS REQUIRED BY SCHEDULES AND WHERE NOTED ELSEWHERE. VERIFY REQUIREMENTS OF ALL MECHANICAL EQUIPMENT WITH SHOP DRAWINGS SUBMITTALS. NOTIFY ENGINEER OF ANY CONFLICTS BETWEEN EQUIPMENT SUBMITTALS AND ELECTRICAL DRAWINGS. WHERE CIRCUIT SIZES ARE SHOWN ON THE ELECTRICAL DRAWINGS THAT DIFFERS FROM WHAT IS INDICATED ON THE MECHANICAL SCHEDULES, PROVIDE THE CIRCUIT OF HIGHER AMPACITY.
- REFER TO TEMPERATURE CONTROLS SHEETS FOR REQUIRED FIRE ALARM CONTROL MODULES, QUIET SMOKE DETECTORS, AND MOTOR CONTROLLERS. PROVIDE ALL ACCESSORIES INDICATED.
- THE FIRE ALARM DEVICES SHOWN ON PLAN ARE A PARTIAL REPRESENTATION OF THE COMPLETE AND FUNCTIONAL FIRE ALARM SYSTEM IN ACCORDANCE WITH THE SPECIFICATIONS, DRAWINGS, AND ALL APPLICABLE CODES. THE FIRE ALARM VENDOR SHALL PROVIDE LAYOUT DRAWINGS INDICATING THE REQUIRED QUANTITIES AND LOCATIONS OF MANUAL PULL STATIONS, NOTIFICATION APPLIANCES, SMOKE AND HEAT DETECTORS, CONTROL MODULES, INTERFACE MODULES, MODULES FOR SPRINKLER FLOW AND TAMPER SWITCHES, ALL CONTROL PANELS, POWER SUPPLIES, AND ADDITIONAL DEVICES AND EQUIPMENT REQUIRED. COORDINATE LOCATIONS OF DEVICES WITH ARCHITECTURAL FINISHES AND REFLECTED CEILING PLANS, INCLUDING ADDITIONAL SMOKE AND HEAT DETECTORS REQUIRED FOR NON-SMOOTH CEILING APPLICATIONS. INCLUDE ALLOWANCES FOR ADJUSTMENT OF DEVICES BY THE ARCHITECT AT THE TIME OF SUBMITTAL TO COORDINATE WITH BUILDING FINISHES AND OTHER CEILING ELEMENTS.
- REFER TO LIGHTING CONTROL SCHEDULE FOR ROOM CONTROL AND EMERGENCY LIGHTING CIRCUIT CONTROL REQUIREMENTS. DESIGNATION FOR ROOM IS INDICATED AS A LETTERED OVAL SYMBOL.
- CONNECT EXIT SIGNS TO EMERGENCY LIGHTING BRANCH CIRCUIT SERVICE THE AREA. CONNECT AHEAD OF ANY LIGHTING CONTROL DEVICE OR SYSTEM.
- PROVIDE SINGLE GANG JUNCTION BOX WITH 3/4" C. PULL STRING AND BUSHING TO ACCESSIBLE CEILING SPACE AT SPEAKER AND CLOCK LOCATIONS. COORDINATE MOUNTING HEIGHT WITH TECHNOLOGY CONTRACTOR.

CONSTRUCTION KEY NOTES:

- PROVIDE WIRE GUARD FOR LIGHTING CONTROL DEVICES AND EXIT SIGNS IN SPACE.
- STAGE LIGHTING CONTROL STATION COORDINATE FINAL LOCATION WITH THEATRICAL CONSULTANT.
- PROVIDE SINGLE GANG BOX WITH 3/4" C. PULL STRING TO ACCESSIBLE CEILING FOR DMX CONTROLS. COORDINATE FINAL LOCATION WITH THEATER CONSULTANT.
- STAGE LIGHTING ELECTRIC. COORDINATE FINAL LOCATIONS WITH THEATER CONSULTANT. PROVIDE 3/4" C. TO ERP-24.
- PROVIDE EMERGENCY BATTERY INSIDE LIGHT FIXTURE. BATTERY SHALL OUTPUT 1,400 LUMENS FOR A MINIMUM OF 90 MINUTES.
- ARCHITECTURAL PANEL LIGHT BY OTHERS.
- ELEVATOR HOISTWAY FIT LIGHTING. REFER TO DETAIL.



TMP ARCHITECTURE INC
1191 WEST SQUARE LAKE ROAD - BOX 289
BLOOMFIELD HILLS - MICHIGAN 48302
PH: 248.338.6941 FX: 248.338.0223
EM: INFO@TMP-ARCHITECTURE.COM

REGISTRATION SEAL

CONSULTANT



Peter Basso Associates Inc
CONSULTING ENGINEERS
5145 Livernois, Suite 100
Troy, Michigan 48068-3276
Tel: 248-879-5666 Fax: 248-879-0007
www.PeterBassoAssociates.com
PBA Project No. 2023.0154


PROJECT TITLE

NEW SMITH MIDDLE SCHOOL
Bid Package No. 03B

Troy School District
TROY, MI

DRAWING TITLE

SECOND LEVEL LIGHTING PLAN - ZONE 'E'

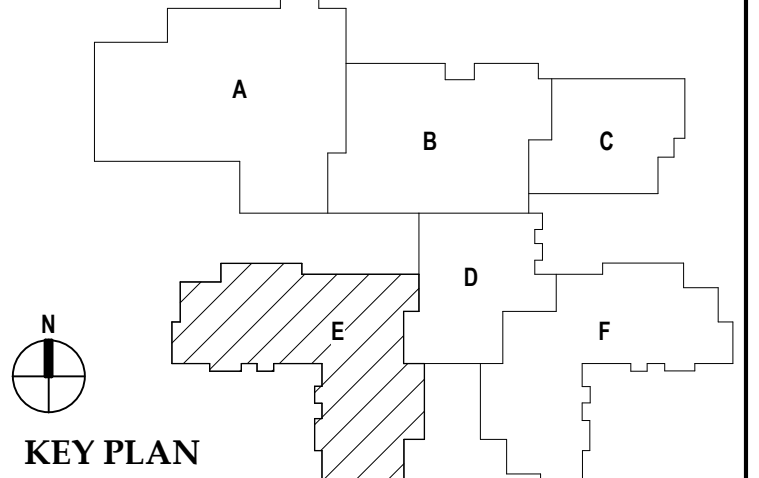

ISSUE DATES

07-12-2024	ADDENDUM #2
08-16-2024	CONSTRUCTION DOCUMENTS

DATE: ISSUED FOR:

DRAWN DDB

CHECKED ZDB

APPROVED STP

PROJECT NO.


22102

DRAWING NO.

E2.2E

SECOND LEVEL LIGHTING PLAN - ZONE 'E'
SCALE: 1/8" = 1'-0"

THE FOLLOWING DIMENSION EQUALS ONE INCH WHEN PRINTED TO SCALE.

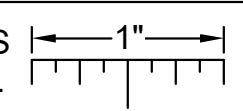


ELECTRICAL GENERAL NOTES:

- 1 THESE DRAWINGS REPRESENT THE GENERAL EXTENT AND ARRANGEMENT OF SYSTEMS. COORDINATE EXACT EQUIPMENT LOCATIONS, ELEVATIONS, AND FINAL CONNECTION REQUIREMENTS. PROVIDE EACH SYSTEM COMPLETE, INCLUDING ALL NECESSARY COMPONENTS, FITTINGS AND OFFSETS.
- 2 INSTALL SYSTEMS SUCH THAT REQUIRED CLEARANCE AND SERVICE ACCESS SPACE IS PROVIDED AROUND ALL MECHANICAL AND ELECTRICAL EQUIPMENT, AND AROUND ANY COMPONENTS WHICH REQUIRE SERVICE ACCESS.
- 3 COORDINATE AND PROVIDE ACCESS DOORS WITHIN INACCESSIBLE CEILING, SHAFT, AND CHASE AREAS FOR ALL COMPONENTS WHICH REQUIRE SERVICE ACCESS. REFER TO ARCHITECTURAL DRAWINGS FOR CEILING TYPES.
- 4 PROVIDE SUPPLEMENTARY STEEL AS REQUIRED FOR THE PROPER SUPPORT OF ALL SYSTEMS.
- 5 TRANSFORMER SECONDARY CONDUCTORS SHALL BE SIZED IN ACCORDANCE WITH TRANSFORMER CIRCUIT SIZING SCHEDULE SHOWN ON "ELECTRICAL STANDARD SCHEDULES DRAWING" UNLESS OTHERWISE NOTED.
- 6 MOTOR CIRCUIT PROTECTION SHALL BE SIZED IN ACCORDANCE WITH MOTOR CIRCUIT SIZING SCHEDULES SHOWN ON "ELECTRICAL STANDARD SCHEDULES DRAWING" UNLESS OTHERWISE NOTED.
- 7 COORDINATE THE MOUNTING HEIGHTS OF DEVICES WITH ARCHITECTURAL ELEVATIONS AND THE TRADES INSTALLING THE WORK.
- 8 COORDINATE EXACT LOCATIONS OF ALL FLOOR SERVICE FITTINGS AND POKE-THROUGH ASSEMBLIES WITH FINAL FURNITURE LAYOUT DRAWINGS.
- 9 REFER TO MECHANICAL SCHEDULE SHEETS FOR ELECTRICAL REQUIREMENTS FOR MECHANICAL EQUIPMENT. PROVIDE ALL CONNECTIONS, STARTERS, DISCONNECTS, ETC. AS REQUIRED BY SCHEDULES AND WHERE NOTED ELSEWHERE. VERIFY REQUIREMENTS OF ALL MECHANICAL EQUIPMENT WITH SHOP DRAWINGS. SUBMITTALS. NOTIFY ENGINEER OF ANY CONFLICTS BETWEEN EQUIPMENT SUBMITTALS AND ELECTRICAL DRAWINGS. WHERE CIRCUIT SIZES ARE SHOWN ON THE ELECTRICAL DRAWINGS THAT DIFFER FROM WHAT IS INDICATED ON THE MECHANICAL SCHEDULES. PROVIDE THE CIRCUIT OF HIGHER AMPACITY.
- 10 REFER TO TEMPERATURE CONTROLS SHEETS FOR REQUIRED FIRE ALARM CONTROL MODULES, DUCT SMOKE DETECTORS, AND MOTOR CONTROLLERS. PROVIDE ALL ACCESSORIES INDICATED.
- 11 THE FIRE ALARM DEVICES SHOWN ON PLAN ARE A PARTIAL REPRESENTATION OF THE COMPLETE AND FUNCTIONAL FIRE ALARM SYSTEM IN ACCORDANCE WITH THE SPECIFICATIONS, DRAWINGS, AND ALL APPLICABLE CODES. THE FIRE ALARM VENDOR SHALL PROVIDE LAYOUT DRAWINGS INDICATING THE REQUIRED QUANTITIES AND LOCATIONS OF MANUAL PULL STATIONS, NOTIFICATION APPLIANCES, SMOKE AND HEAT DETECTORS, CONTROL MODULES, INTERFACE MODULES, MODULES FOR SPRINKLER FLOW AND TAMPER SWITCHES, ALL CONTROL PANELS, POWER SUPPLIES, AND ADDITIONAL DEVICES AND EQUIPMENT REQUIRED. COORDINATE LOCATIONS OF DEVICES WITH ARCHITECTURAL FINISHES AND REFLECTED CEILING PLANS, INCLUDING ADDITIONAL SMOKE AND HEAT DETECTORS REQUIRED FOR NON-SMOOTH CEILING APPLICATIONS. INCLUDE ALLOWANCES FOR ADJUSTMENT OF DEVICES BY THE ARCHITECT AT THE TIME OF SUBMITTAL TO COORDINATE WITH BUILDING FINISHES AND OTHER CEILING ELEMENTS.
- 12 REFER TO LIGHTING CONTROL SCHEDULE FOR ROOM CONTROL AND EMERGENCY LIGHTING CIRCUIT CONTROL REQUIREMENTS. DESIGNATION FOR ROOM IS INDICATED AS A LETTERED OVAL SYMBOL.
- 13 CONNECT EXIT SIGNS TO EMERGENCY LIGHTING BRANCH CIRCUIT SERVICE THE AREA. CONNECT AHEAD OF ANY LIGHTING CONTROL DEVICE OR SYSTEM.
- 14 PROVIDE SINGLE GANG JUNCTION BOX WITH 3/4" C. PULL STRING AND BUSHING TO ACCESSIBLE CEILING SPACE AT SPEAKER AND CLOCK LOCATIONS. COORDINATE MOUNTING HEIGHT WITH TECHNOLOGY CONTRACTOR.

CONSTRUCTION KEY NOTES:

- 1 MOUNT RECEPTACLES HORIZONTALLY
- 2 ELECTRICAL CONTRACTOR SHALL INSTALL 4" SQUARE JUNCTION BOX WITH 3/4" OF ELECTRICAL BACKBOARD WING UP IN CEILING SPACE. ALSO INSTALL 4" FOLE TWIST LOCK, SINGLE RECEPTACLE, PROVIDED BY WINCH MANUFACTURERS, INTO THE JUNCTION BOX.
- 3 ELECTRICAL CONTRACTOR SHALL INSTALL ALL CONTROLS, PUSHBUTTONS, KEY SWITCHES ETC. (PROVIDED WITH EACH BASKETBALL BACKBOARD), FOR A COMPLETE OPERABLE SYSTEM. KEY SWITCHES GANGED IN PAIRS IN ONE COVER PLATE TO CONTROL THE BACKSTOP SWING AND HEIGHT ADJUSTER.
- 4 HEAT TRACE, BY OTHERS.
- 5 DUCT SMOKE DETECTOR SHALL BE FURNISHED AND INSTALLED BY THE ELECTRICAL CONTRACTOR. COORDINATE MOUNTING LOCATION AND QUANTITY WITH THE MECHANICAL DUCTWORK CONTRACTOR. ELECTRICAL CONTRACTOR SHALL WIRE DUCT SMOKE DETECTOR SUPPLY/RETURN FAN MOTOR STARTER SO THAT UPON DETECTION OF SMOKE, THE SUPPLY/RETURN FAN WILL SHUT DOWN. THIS SHALL BE ACCOMPLISHED VIA THE FIRE ALARM CONTROL PANEL. PROVIDE ALL REQUIRED CONTROL MODULES AND RELAYS. COORDINATE WITH THE TEMPERATURE CONTROL/FIRE ALARM CONTRACTOR. PROVIDE WEATHER PROOF ENCLOSURES AS REQUIRED.
- 6 REFER TO ARCHITECTURAL FLOOR PLANS, DOOR HARDWARE SCHEDULE ON ARCHITECTURAL DRAWINGS, ACCESS CONTROL SYSTEM SPECIFICATION SECTION AND ACCESS CONTROL DOOR DIAGRAM(S) ON E7 SERIES FOR RACEWAY AND BACK BOX REQUIREMENTS FOR DOOR OR BANK OF DOORS INDICATED. PROVIDE ALL RACEWAYS AND BACK BOXES REQUIRED. COORDINATE WITH DOOR HARDWARE AND SECURITY CONTRACTORS.
- 7 PROVIDE 2" AND 1-1/4" U.O.N. CONDUITS FOR TECHNOLOGY AND AUXILIARY SYSTEM WIRE AS INDICATED. SUB CONDUITS FROM CEILING SPACE. PROVIDE PLASTIC BUSHINGS AT EACH END. PROVIDE REMOVABLE/RESEALABLE FIRE STOP PUTTY IN EACH CONDUIT AND FIRE STOP AROUND EACH CONDUIT. COORDINATE WITH TECHNOLOGY CONTRACTOR FOR EXACT LOCATION OF CONDUIT. PROVIDE MINIMUM OF 1" CONDUIT FOR ALL OTHER AREAS REQUIRED SLEEVES.
- 8 PROVIDE 1 1/2" CONDUIT WITH PULL STRING AND BUSHINGS FOR TECHNOLOGY ROUTE UNDER BUILDING AND TERMINATE AT EXTERIOR OF BUILDING.
- 9 COORDINATE MOUNTING LOCATION WITH TECHNOLOGY CONTRACTOR.
- 10 CONNECT FIRE ALARM DEVICES TO ELECTRIC COILING DOOR AND FIRE ALARM SYSTEM. ROLL UP DOOR SHALL CLOSE UPON ACTIVATION OF THE SMOKE DETECTORS ASSOCIATED WITH THE COILING FIRE DOOR. COORDINATE WITH COILING DOOR CONTRACTOR FOR ALL SMOKE DETECTORS AND CONTROL MODULES REQUIRED FOR A COMPLETE SYSTEM.
- 11 HAND DRYERS FURNISHED BY OTHERS AND INSTALLED BY ELECTRICAL CONTRACTOR. COORDINATE MOUNTING HEIGHT WITH ARCHITECTURAL TRADES.
- 12 SMOKE DAMPER DUCT SMOKE DETECTOR. SMOKE DETECTOR SHALL BE PROVIDED BY THE ELECTRICAL CONTRACTOR. COORDINATE INSTALLATION WITH MECHANICAL CONTRACTOR SO THAT UPON DETECTION OF SMOKE THE SUPPLY/RETURN FAN WILL SHUT DOWN. ELECTRICAL CONTRACTOR SHALL WIRE DUCT DETECTOR TO FIRE ALARM SYSTEM AND CIRCUIT DAMPER ACTUATOR. PROVIDE A 20A-IP SWITCH AT EACH ACTUATOR. CONTROL OF AIR HANDLING EQUIPMENT IS VIA THE FIRE ALARM CONTROL PANEL. PROVIDE ALL REQUIRED CONTROL MODULES AND RELAYS. COORDINATE WORK WITH THE TEMPERATURE CONTROL CONTRACTOR AND FIRE ALARM MANUFACTURER. DAMPER SHALL CLOSE UPON DETECTION OF SMOKE AND SHUT DOWN ASSOCIATED AIR HANDLER. DAMPER SHALL ALSO CLOSE UPON NORMAL SHUTDOWN OF AIR HANDLER.
- 13 CARBON MONOXIDE DETECTOR. COORDINATE QUANTITY WITH FIRE MARSHAL.
- 14 SCOREBOARD. COORDINATE EXACT LOCATION WITH ARCHITECT PRIOR TO ROUGH IN.
- 15 WALL MOUNT TRANSFORMER.
- 16 ELECTRIC RANGE. PROVIDE WALL MOUNTED GFCI MODULE ABOVE COUNTER.
- 17 LIGHTING RELAY PANEL FOR THEATRICAL LIGHTING SYSTEM. REFER TO THEATRICAL LIGHTING EQUIPMENT DRAWINGS.

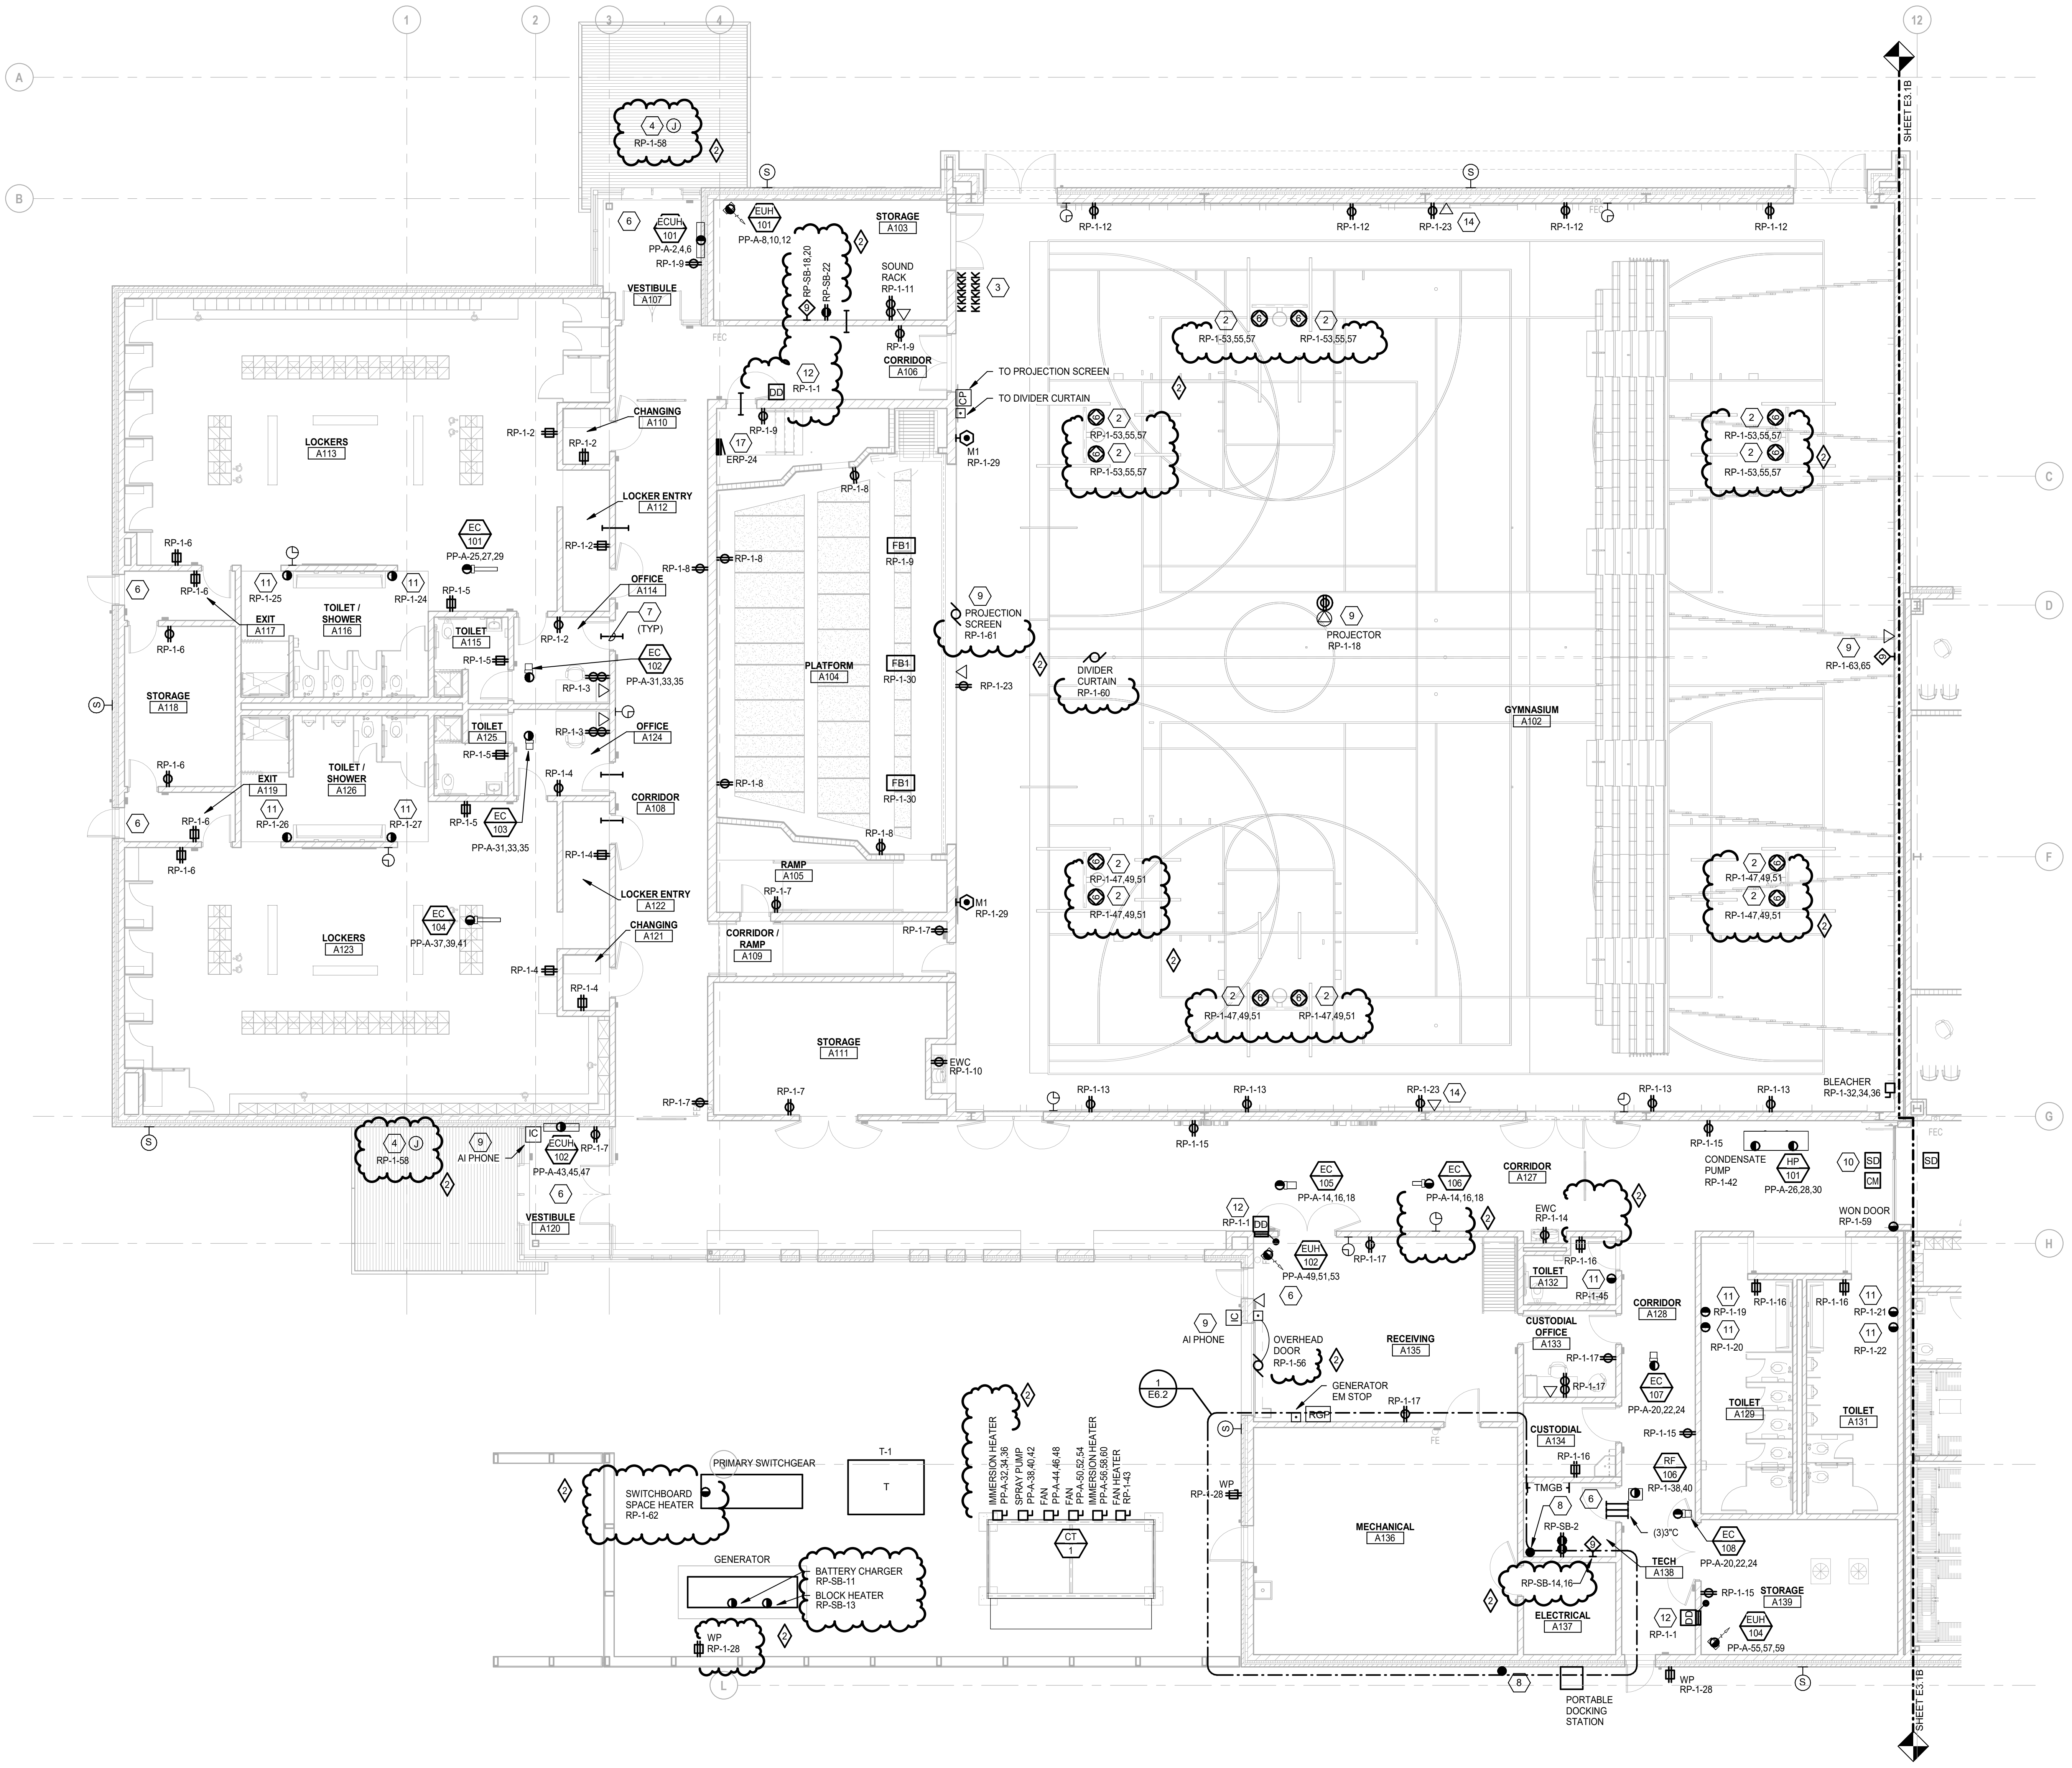

FIRST LEVEL POWER AND AUXILIARY SYSTEMS PLAN - ZONE 'A'
SCALE: 1/8" = 1'-0"



TMP ARCHITECTURE INC
1191 WEST SQUARE LAKE ROAD - BOX 289
BLOOMFIELD HILLS - MICHIGAN 48302
PH: 248.388.6941 FX: 248.388.6223
EM: INFO@TMPARCHITECTURE.COM

REGISTRATION SEAL

CONSULTANT




Peter Basso Associates Inc
CONSULTING ENGINEERS
5145 Livernois, Suite 100
Troy, Michigan 48068-3276
Tel: 248-879-5666 Fax: 248-879-0007
www.PeterBassoAssociates.com
PBA Project No. 2023.0154

PROJECT TITLE

NEW SMITH MIDDLE SCHOOL
Bid Package No. 03B

Troy School District
TROY, MI

DRAWING TITLE
FIRST LEVEL POWER AND AUXILIARY SYSTEMS PLAN - ZONE 'A'

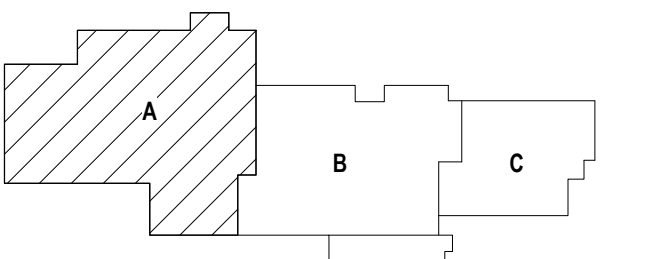

KEY PLAN

ISSUE DATES

DATE	ISSUED FOR:

DATE	ADDENDUM #	CONSTRUCTION DOCUMENTS
07-12-2024		
08-16-2024		

DATE	ISSUED FOR:


PROJECT NO.

22102

DRAWING NO.

E3.1A

THE FOLLOWING DIMENSION EQUALS ONE INCH WHEN PRINTED TO SCALE.

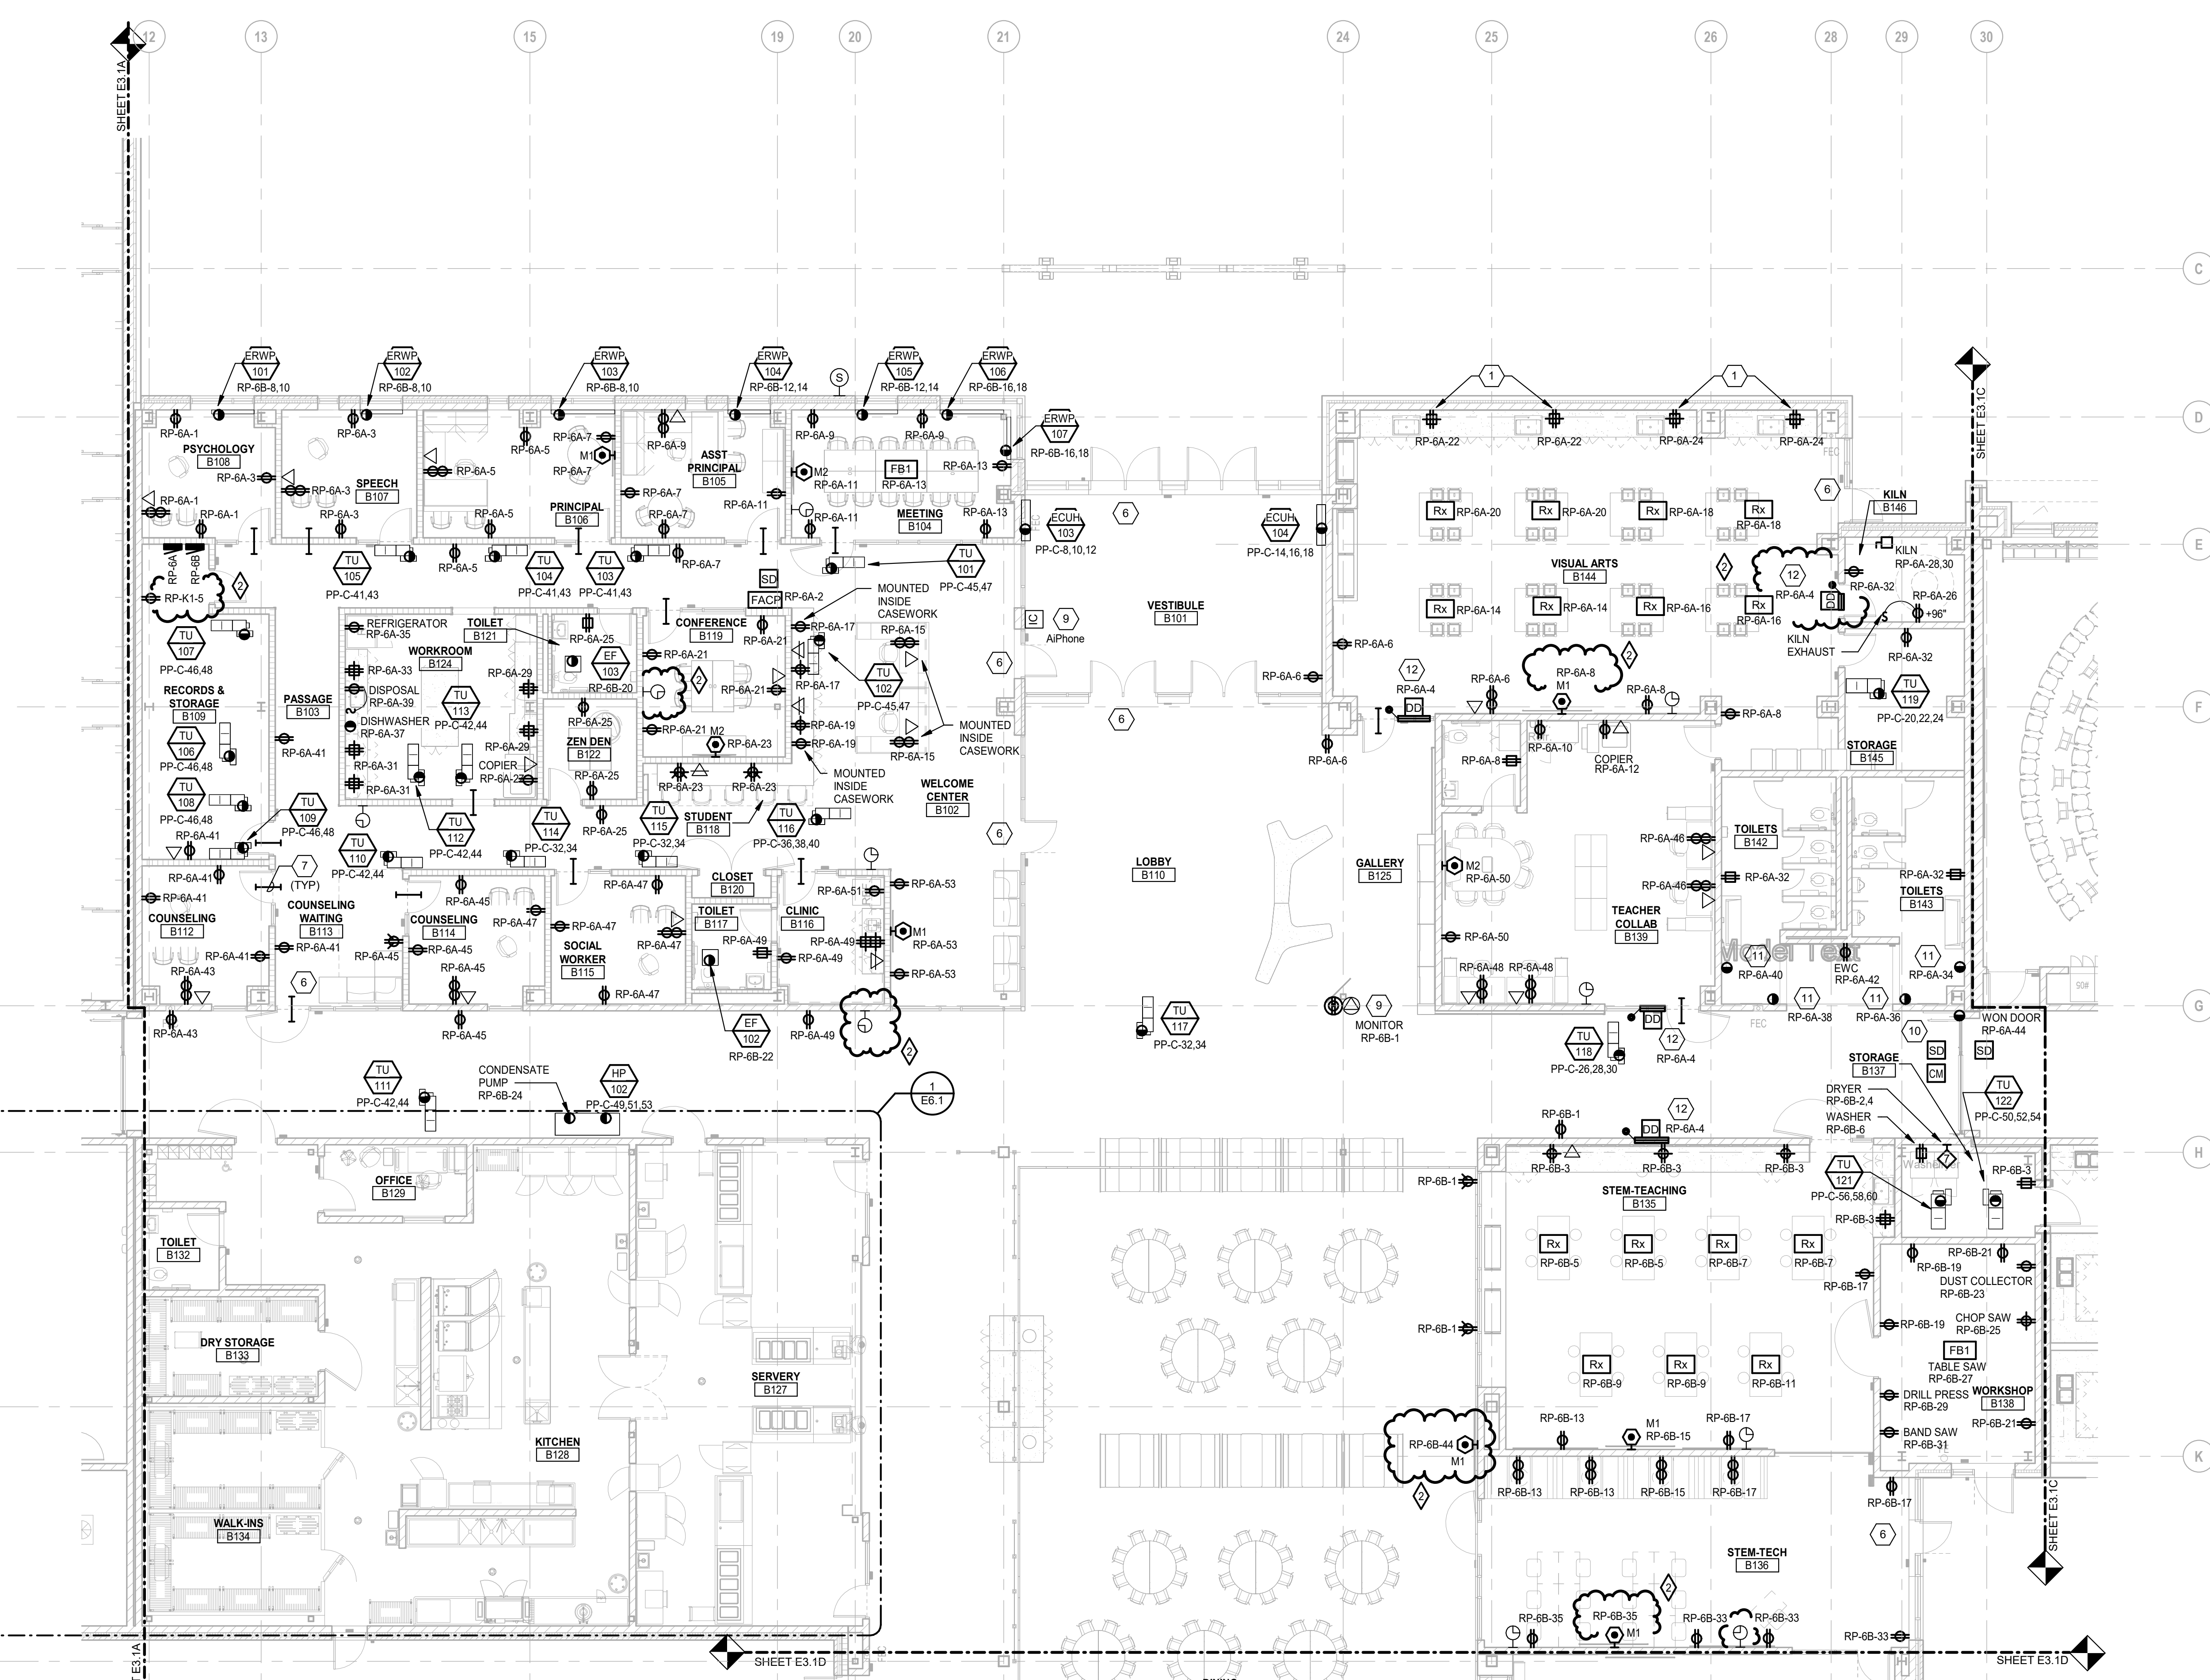

FIRST LEVEL POWER AND AUXILIARY SYSTEMS PLAN - ZONE B'
SCALE: 1/8" = 1'-0"

ELECTRICAL GENERAL NOTES:

- THESE DRAWINGS REPRESENT THE GENERAL EXTENT AND ARRANGEMENT OF SYSTEMS. COORDINATE EXACT EQUIPMENT LOCATIONS, ELEVATIONS, AND FINAL CONNECTION REQUIREMENTS. PROVIDE EACH SYSTEM COMPLETE, INCLUDING ALL NECESSARY COMPONENTS, FITTINGS AND OFFSETS.
- INSTALL SYSTEMS SUCH THAT REQUIRED CLEARANCE AND SERVICE ACCESS SPACE IS PROVIDED AROUND ALL MECHANICAL AND ELECTRICAL EQUIPMENT, AND AROUND ANY COMPONENTS WHICH REQUIRE SERVICE ACCESS.
- COORDINATE AND PROVIDE ACCESS DOORS WITHIN INACCESSIBLE CEILING, SHAFT, AND CHASE AREAS FOR ALL COMPONENTS WHICH REQUIRE SERVICE ACCESS. REFER TO ARCHITECTURAL DRAWINGS FOR CEILING TYPES.
- PROVIDE SUPPLEMENTARY STEEL AS REQUIRED FOR THE PROPER SUPPORT OF ALL SYSTEMS.
- TRANSFORMER SECONDARY CONDUCTORS SHALL BE SIZED IN ACCORDANCE WITH TRANSFORMER CIRCUIT SIZING SCHEDULE SHOWN ON "ELECTRICAL STANDARD SCHEDULES DRAWING" UNLESS OTHERWISE NOTED.
- MOTOR CIRCUIT PROTECTION SHALL BE SIZED IN ACCORDANCE WITH MOTOR CIRCUIT SIZING SCHEDULES SHOWN ON "ELECTRICAL STANDARD SCHEDULES DRAWING" UNLESS OTHERWISE NOTED.
- COORDINATE THE MOUNTING HEIGHTS OF DEVICES WITH ARCHITECTURAL ELEVATIONS AND THE TRADES INSTALLING THE WORK.
- COORDINATE EXACT LOCATIONS OF ALL FLOOR SERVICE FITTINGS AND POKE-THROUGH ASSEMBLIES WITH FINAL FURNITURE LAYOUT DRAWINGS.
- REFER TO MECHANICAL SCHEDULE SHEETS FOR ELECTRICAL REQUIREMENTS FOR MECHANICAL EQUIPMENT. PROVIDE ALL CONNECTIONS, STARTERS, DISCONNECTS, ETC. AS REQUIRED BY SCHEDULES AND WHERE NOTED ELSEWHERE. VERIFY REQUIREMENTS OF ALL MECHANICAL EQUIPMENT WITH SHOP DRAWINGS, SUBMITTALS. NOTIFY ENGINEER OF ANY CONFLICTS BETWEEN EQUIPMENT SUBMITTALS AND ELECTRICAL DRAWINGS. WHERE CIRCUIT SIZES ARE SHOWN ON THE ELECTRICAL DRAWINGS THAT DIFFER FROM WHAT IS INDICATED ON THE MECHANICAL SCHEDULES, PROVIDE THE CIRCUIT OF HIGHER AMPACITY.
- REFER TO TEMPERATURE CONTROLS SHEETS FOR REQUIRED FIRE ALARM CONTROL MODULES, DUCT SMOKE DETECTORS, AND MOTOR CONTROLLERS. PROVIDE ALL ACCESSORIES INDICATED.
- THE FIRE ALARM DEVICES SHOWN ON PLAN ARE A PARTIAL REPRESENTATION OF THE COMPLETE AND FUNCTIONAL FIRE ALARM SYSTEM IN ACCORDANCE WITH THE SPECIFICATIONS, DRAWINGS, AND ALL APPLICABLE CODES. THE FIRE ALARM VENDOR SHALL PROVIDE LAYOUT DRAWINGS INDICATING THE REQUIRED QUANTITIES AND LOCATIONS OF MANUAL PULL STATIONS, NOTIFICATION APPLIANCES, SMOKE AND HEAT DETECTORS, CONTROL MODULES, INTERFACE MODULES, MODULES FOR SPRINKLER FLOW AND TAMPER SWITCHES, ALL CONTROL PANELS, POWER SUPPLIES, AND ADDITIONAL DEVICES AND EQUIPMENT REQUIRED. COORDINATE WITH ARCHITECTURAL FINISHES AND REFLECTED CEILING PLANS, INCLUDING ADDITIONAL SMOKE AND HEAT DETECTORS REQUIRED FOR NON-SMOOTH CEILING APPLICATIONS, INCLUDE ALLOWANCES FOR ADJUSTMENT OF WHICH IS INDICATED ON THE TIME OF SUBMITTAL TO COORDINATE WITH BUILDING FINISHES AND OTHER CEILING ELEMENTS.
- REFER TO LIGHTING CONTROL SCHEDULE FOR ROOM CONTROL AND EMERGENCY LIGHTING CIRCUIT CONTROL REQUIREMENTS. DESIGNATION FOR ROOM IS INDICATED AS A LETTERED OVAL SYMBOL.
- CONNECT EXIT SIGNS TO EMERGENCY LIGHTING BRANCH CIRCUIT SERVICE THE AREA. CONNECT AHEAD OF ANY LIGHTING CONTROL DEVICE OR SYSTEM.
- PROVIDE SINGLE GANG JUNCTION BOX WITH 3/4" C. PULL STRING AND BUSHING TO ACCESSIBLE CEILING SPACE AT SPARKER AND CLOCK LOCATIONS. COORDINATE MOUNTING HEIGHT WITH TECHNOLOGY CONTRACTOR.

CONSTRUCTION KEY NOTES:

- MOUNT RECEPTACLES HORIZONTALLY
- ELECTRICAL CONTRACTOR SHALL INSTALL 4" SQUARE JUNCTION BOX WITH 3/4" OF ELECTRICAL BACKDROP WING UP IN CEILING SPACE. ALSO INSTALL 4" POLE TWIST LOCK, SINGLE RECEPTACLE, PROVIDED BY WINCH MANUFACTURERS, INTO THE JUNCTION BOX.
- ELECTRICAL CONTRACTOR SHALL INSTALL ALL CONTROLS, PUSHBUTTONS, KEY SWITCHES ETC. (PROVIDED WITH EACH BASKETBALL BACKBOARD) FOR A COMPLETE OPERABLE SYSTEM. KEY SWITCHES GANGED IN Pairs IN ONE COVER PLATE TO CONTROL THE BACKSTOP SWING AND HEIGHT ADJUSTER.
- HEAT TRACE, BY OTHERS.
- DUCT SMOKE DETECTOR SHALL BE FURNISHED AND INSTALLED BY THE ELECTRICAL CONTRACTOR. COORDINATE MOUNTING LOCATION AND QUANTITY WITH THE MECHANICAL DUCTWORK CONTRACTOR. ELECTRICAL CONTRACTOR SHALL WIRE DUCT SMOKE DETECTOR SUPPLY/RETURN FAN MOTOR STARTER SO THAT UPON DETECTION OF SMOKE, THE SUPPLY/RETURN FAN WILL SHUT DOWN. THIS SHALL BE ACCOMPLISHED VIA THE FIRE ALARM CONTROL PANEL. PROVIDE ALL REQUIRED CONTROL MODULES AND RELAYS. COORDINATE WITH THE TEMPERATURE CONTROL/FIRE ALARM CONTRACTOR. PROVIDE WEATHER PROOF ENCLOSURES AS REQUIRED.
- REFER TO ARCHITECTURAL FLOOR PLANS, DOOR HARDWARE SCHEDULE ON ARCHITECTURAL DRAWINGS, ACCESS CONTROL SYSTEM SPECIFICATION SECTION AND ACCESS CONTROL DOOR DIAGRAMS) ON E7 SERIES FOR RACEWAY AND BACK BOX REQUIREMENTS FOR DOOR OR BANK OF DOORS INDICATED. PROVIDE ALL RACEWAYS AND BACK BOXES REQUIRED. COORDINATE WITH DOOR HARDWARE AND SECURITY CONTRACTORS.
- PROVIDE 2" AND 1-1/4" O.D. CONDUITS FOR TECHNOLOGY AND AUXILIARY SYSTEM WIRE AS INDICATED. STUB CONDUITS FROM CEILING SPACE. PROVIDE PLASTIC BUSHINGS AT EACH END. PROVIDE REMOVABLE/RESEALABLE FIRE STOP PUTTY IN EACH CONDUIT AND FIRE STOP AROUND EACH CONDUIT. COORDINATE WITH TECHNOLOGY CONTRACTOR FOR EXACT LOCATION OF CONDUIT. PROVIDE MINIMUM OF 1" CONDUIT FOR ALL OTHER AREAS REQUIRING SLEEVES.
- PROVIDE 1/2" CONDUIT WITH PULL STRING AND BUSHINGS FOR TECHNOLOGY. ROUTE UNDER BUILDING AND TERMINATE AT EXTERIOR OF BUILDING.
- COORDINATE MOUNTING LOCATION WITH TECHNOLOGY CONTRACTOR.
- CONNECT FIRE ALARM DEVICES TO ELECTRIC COILING DOOR AND FIRE ALARM SYSTEM. ROLL UP DOOR SHALL CLOSE UPON ACTIVATION OF THE SMOKE DETECTORS ASSOCIATED WITH THE COILING FIRE DOOR. COORDINATE WITH COILING DOOR CONTRACTOR FOR ALL SMOKE DETECTORS AND CONTROL MODULES REQUIRED FOR A COMPLETE SYSTEM.
- HAND DRYERS FURNISHED BY OTHERS AND INSTALLED BY ELECTRICAL CONTRACTOR. COORDINATE MOUNTING HEIGHT WITH ARCHITECTURAL TRADES.
- SMOKE DAMPER DUCT SMOKE DETECTOR. SMOKE DETECTOR SHALL BE PROVIDED BY THE ELECTRICAL CONTRACTOR. COORDINATE INSTALLATION WITH MECHANICAL CONTRACTOR SO THAT UPON DETECTION OF SMOKE THE SUPPLY/RETURN FAN WILL SHUT DOWN. ELECTRICAL CONTRACTOR SHALL WIRE DUCT DETECTOR TO FIRE ALARM SYSTEM AND CIRCUIT DAMPER ACTUATOR. PROVIDE 20A-1P SWITCH AT EACH ACTUATOR. CONTROL OF AIR HANDLING EQUIPMENT IS VIA THE FIRE ALARM CONTROL PANEL. PROVIDE ALL REQUIRED CONTROL MODULES AND RELAYS. COORDINATE WORK WITH THE TEMPERATURE CONTROLS CONTRACTOR AND FIRE ALARM MANUFACTURER. DAMPER SHALL CLOSE UPON DETECTION OF SMOKE AND SHUT DOWN ASSOCIATED AIR HANDLER. DAMPER SHALL ALSO CLOSE UPON NORMAL SHUTDOWN OF AIR HANDLER.
- CARBON MONOXIDE DETECTOR. COORDINATE QUANTITY WITH FIRE MARSHAL.
- SCOREBOARD. COORDINATE EXACT LOCATION WITH ARCHITECT PRIOR TO ROUGH IN.
- WALL MOUNT TRANSFORMER.
- ELECTRIC RANGE. PROVIDE WALL MOUNTED GFCI MODULE ABOVE COUNTER.
- LIGHTING RELAY PANEL FOR THEATRICAL LIGHTING SYSTEM. REFER TO THEATRICAL LIGHTING EQUIPMENT DRAWINGS.



TMP ARCHITECTURE INC
1191 WEST SQUARE LAKE ROAD - BOX 289
BLOOMFIELD HILLS - MICHIGAN 48302
PH: 248.338.6941 | FX: 248.338.0223
EM: INFO@TMP-ARCHITECTURE.COM

REGISTRATION SEAL


CONSULTANT



PROJECT TITLE
NEW SMITH MIDDLE SCHOOL
Bid Package No. 03B

Troy School District
TROY, MI

DRAWING TITLE
FIRST LEVEL POWER AND AUXILIARY SYSTEMS PLAN - ZONE B'

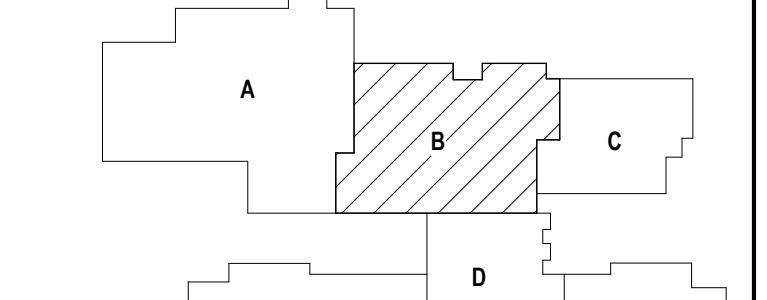

KEY PLAN

ISSUE DATES

DATE	ISSUED FOR:
07-12-2024	ADDENDUM #2
08-16-2024	CONSTRUCTION DOCUMENTS

DRAWN	DDB
CHECKED	ZDB
APPROVED	STP



PROJECT NO.

22102

DRAWING NO.

E3.1B

THE FOLLOWING DIMENSION EQUALS ONE INCH WHEN PRINTED TO SCALE.

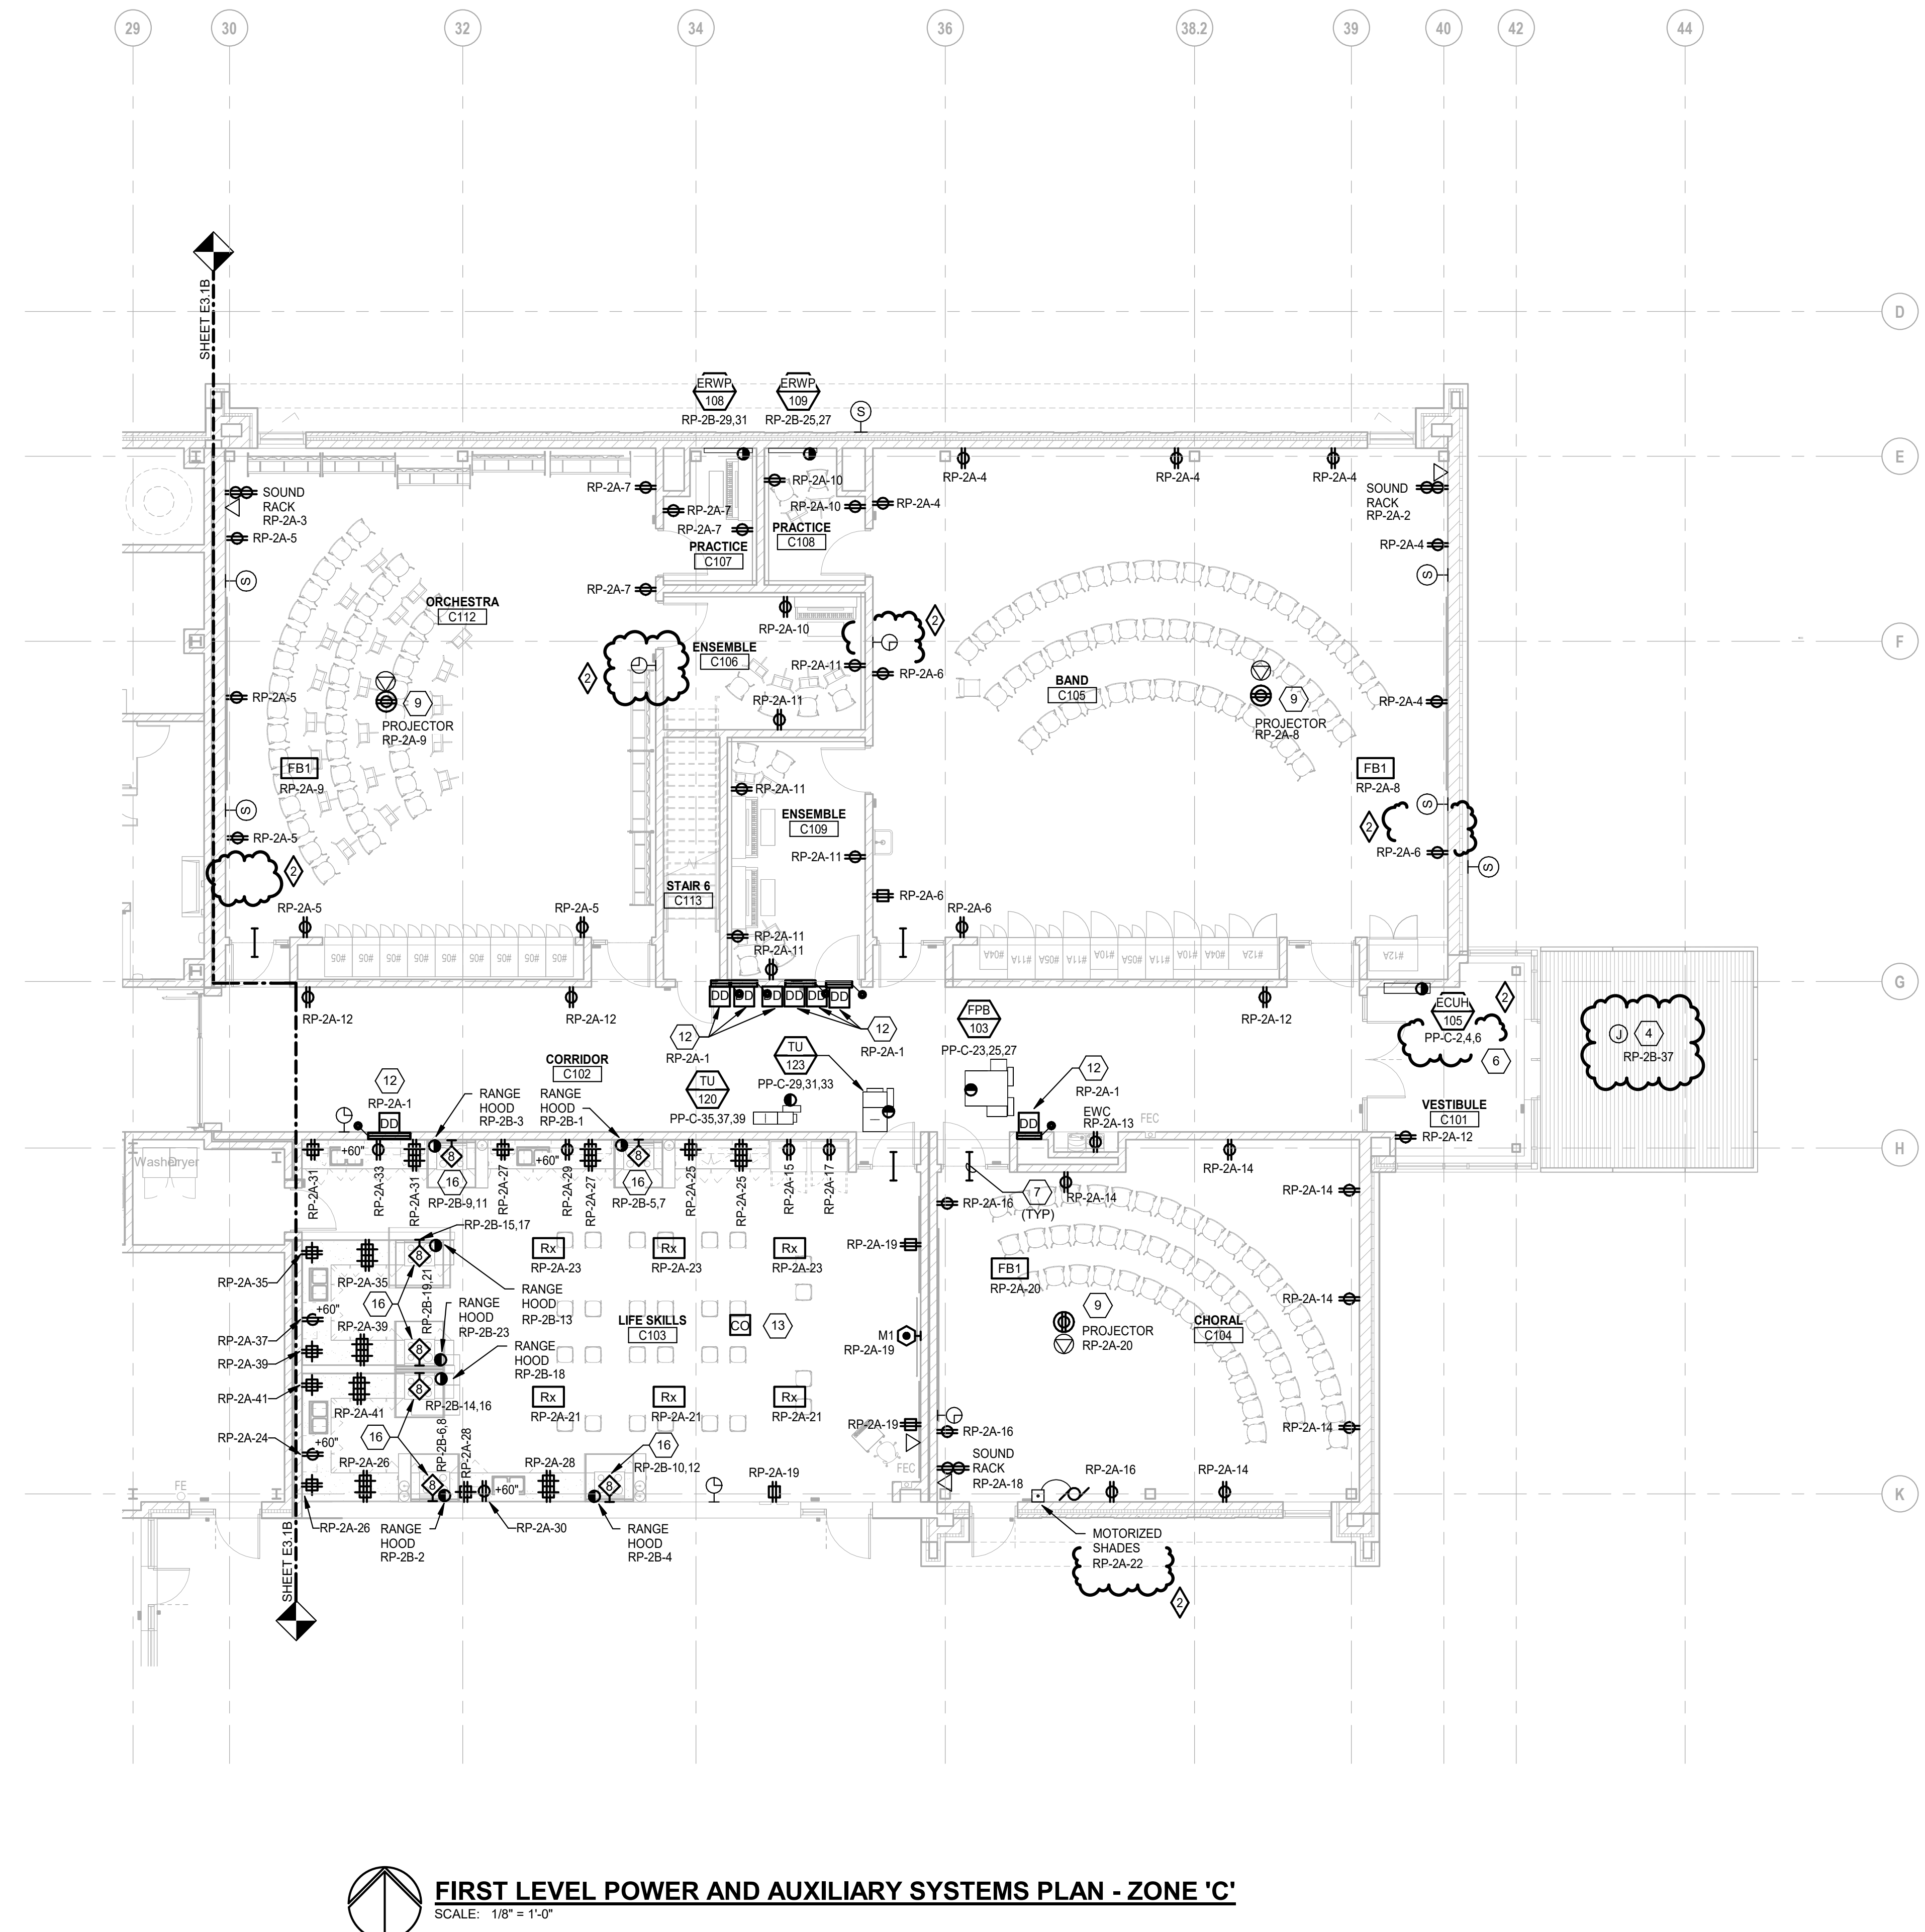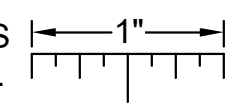

FIRST LEVEL POWER AND AUXILIARY SYSTEMS PLAN - ZONE 'C'
SCALE: 1/8" = 1'-0"

ELECTRICAL GENERAL NOTES:

- 1 THESE DRAWINGS REPRESENT THE GENERAL EXTENT AND ARRANGEMENT OF SYSTEMS. COORDINATE EXACT EQUIPMENT LOCATIONS, ELEVATIONS, AND FINAL CONNECTION REQUIREMENTS. PROVIDE EACH SYSTEM COMPLETE, INCLUDING ALL NECESSARY COMPONENTS, FITTINGS AND OFFSETS.
- 2 INSTALL SYSTEMS SUCH THAT REQUIRED CLEARANCE AND SERVICE ACCESS SPACE IS PROVIDED AROUND ALL MECHANICAL AND ELECTRICAL EQUIPMENT, AND AROUND ANY COMPONENTS WHICH REQUIRE SERVICE ACCESS.
- 3 COORDINATE AND PROVIDE ACCESS DOORS WITHIN INACCESSIBLE CEILING, SHAFT, AND CHASE AREAS FOR ALL COMPONENTS WHICH REQUIRE SERVICE ACCESS. REFER TO ARCHITECTURAL DRAWINGS FOR CEILING TYPES.
- 4 PROVIDE SUPPLEMENTARY STEEL AS REQUIRED FOR THE PROPER SUPPORT OF ALL SYSTEMS.
- 5 TRANSFORMER SECONDARY CONDUCTORS SHALL BE SIZED IN ACCORDANCE WITH TRANSFORMER CIRCUIT SIZING SCHEDULE SHOWN ON "ELECTRICAL STANDARD SCHEDULES DRAWING" UNLESS OTHERWISE NOTED.
- 6 MOTOR CIRCUIT PROTECTION SHALL BE SIZED IN ACCORDANCE WITH MOTOR CIRCUIT SIZING SCHEDULES SHOWN ON "ELECTRICAL STANDARD SCHEDULES DRAWING" UNLESS OTHERWISE NOTED.
- 7 COORDINATE THE MOUNTING HEIGHTS OF DEVICES WITH ARCHITECTURAL ELEVATIONS AND THE TRADES INSTALLING THE WORK.
- 8 COORDINATE EXACT LOCATIONS OF ALL FLOOR SERVICE FITTINGS AND POKE-THROUGH ASSEMBLIES WITH FINAL FURNITURE LAYOUT DRAWINGS.
- 9 REFER TO MECHANICAL SCHEDULE SHEETS FOR ELECTRICAL REQUIREMENTS FOR MECHANICAL EQUIPMENT. PROVIDE ALL CONNECTIONS, STARTERS, DISCONNECTS, ETC. AS REQUIRED BY SCHEDULES AND WHERE NOTED ELSEWHERE. VERIFY REQUIREMENTS OF ALL MECHANICAL EQUIPMENT WITH SHOP DRAWINGS SUBMITTALS. NOTIFY ENGINEER OF ANY CONFLICTS BETWEEN EQUIPMENT SUBMITTALS AND ELECTRICAL DRAWINGS. WHERE CIRCUIT SIZES ARE SHOWN ON THE ELECTRICAL DRAWINGS THAT DIFFER FROM WHAT IS INDICATED ON THE MECHANICAL SCHEDULES, PROVIDE THE CIRCUIT OF HIGHER AMPACITY.
- 10 REFER TO TEMPERATURE CONTROLS SHEETS FOR REQUIRED FIRE ALARM CONTROL MODULES, DUCT SMOKE DETECTORS, AND MOTOR CONTROLLERS. PROVIDE ALL ACCESSORIES INDICATED.
- 11 THE FIRE ALARM DEVICES SHOWN ON PLAN ARE A PARTIAL REPRESENTATION OF THE COMPLETE AND FUNCTIONAL FIRE ALARM SYSTEM IN ACCORDANCE WITH THE SPECIFICATIONS, DRAWINGS, AND ALL APPLICABLE CODES. THE FIRE ALARM VENDOR SHALL PROVIDE LAYOUT DRAWINGS INDICATING THE REQUIRED QUANTITIES AND LOCATIONS OF MANUAL PULL STATIONS, NOTIFICATION APPLIANCES, SMOKE AND HEAT DETECTORS, CONTROL MODULES, INTERFACE MODULES, MODULES FOR SPRINKLER FLOW AND TAMPER SWITCHES, ALL CONTROL PANELS, POWER SUPPLIES, AND ADDITIONAL DEVICES AND EQUIPMENT REQUIRED. COORDINATE LOCATIONS OF ALL ARCHITECTURAL FINISHES AND REFLECTED CEILING PLANS, INCLUDING ADDITIONAL SMOKE AND HEAT DETECTORS REQUIRED FOR NON-SMOOTH CEILING APPLICATIONS. INCLUDE ALLOWANCES FOR ADJUSTMENT OF DEVICES BY THE ARCHITECT AT THE TIME OF SUBMITTAL TO COORDINATE WITH BUILDING FINISHES AND OTHER CEILING ELEMENTS.
- 12 REFER TO LIGHTING CONTROL SCHEDULE FOR ROOM CONTROL AND EMERGENCY LIGHTING CIRCUIT CONTROL REQUIREMENTS. DESIGNATION FOR ROOM IS INDICATED AS A LETTERED OVAL SYMBOL.
- 13 CONNECT EXIT SIGNS TO EMERGENCY LIGHTING BRANCH CIRCUIT SERVICE THE AREA. CONNECT AHEAD OF ANY LIGHTING CONTROL DEVICE OR SYSTEM.
- 14 PROVIDE SINGLE GANG JUNCTION BOX WITH 3/4" C. PULL STRING AND BUSHING TO ACCESSIBLE CEILING SPACE AT SPEAKER AND LOCK LOCATIONS. COORDINATE MOUNTING HEIGHT WITH TECHNOLOGY CONTRACTOR.

CONSTRUCTION KEY NOTES:

- 1 MOUNT RECEPTACLES HORIZONTALLY
- 2 ELECTRICAL CONTRACTOR SHALL INSTALL 4" SQUARE JUNCTION BOX WITH 3/4" OF ELECTRICAL BACKING INSIDE OF CEILING SPACE. ALSO INSTALL A POLE TWIST LOCK, SINGLE RECEPTACLE, PROVIDED BY WINCH MANUFACTURERS, INTO THE JUNCTION BOX.
- 3 ELECTRICAL CONTRACTOR SHALL INSTALL ALL CONTROLS, PUSHBUTTONS, KEY SWITCHES ETC. (PROVIDED WITH EACH BASKETBALL BACKBOARD), FOR A COMPLETE OPERABLE SYSTEM. KEY SWITCHES GANGED IN PAIRS IN ONE COVER PLATE TO CONTROL THE BACKSTOP SWING AND HEIGHT ADJUSTER.
- 4 HEAT TRACE, BY OTHERS.
- 5 DUCT SMOKE DETECTOR SHALL BE FURNISHED AND INSTALLED BY THE ELECTRICAL CONTRACTOR. COORDINATE MOUNTING LOCATION AND QUANTITY WITH THE MECHANICAL DUCTWORK CONTRACTOR. ELECTRICAL CONTRACTOR SHALL WIRE DUCT SMOKE DETECTOR TO SUPPLY RETURN FAN MOTOR STARTER SO THAT UPON DETECTION OF SMOKE, THE SUPPLY/RETURN FAN WILL SHUT DOWN. THIS SHALL BE ACCOMPLISHED VIA THE FIRE ALARM CONTROL PANEL. PROVIDE ALL REQUIRED CONTROL MODULES AND RELAYS. COORDINATE WITH THE TEMPERATURE CONTROL/FIRE ALARM CONTRACTOR. PROVIDE WEATHER PROOF ENCLOSURES AS REQUIRED.
- 6 REFER TO ARCHITECTURAL FLOOR PLANS, DOOR HARDWARE SCHEDULE ON ARCHITECTURAL DRAWINGS, ACCESS CONTROL SYSTEM SPECIFICATION SECTION AND ACCESS CONTROL DOOR DIAGRAM(S) ON E7 SERIES FOR RACEWAY AND BACK BOX REQUIREMENTS FOR DOOR OR BANK OF DOORS INDICATED. PROVIDE ALL RACEWAYS AND BACK BOXES REQUIRED. COORDINATE WITH DOOR HARDWARE AND SECURITY CONTRACTORS.
- 7 PROVIDE 2-2" AND 1-1/4" U.O.N. CONDUITS FOR TECHNOLOGY AND AUXILIARY SYSTEM WIRE AS INDICATED. STUB CONDUITS FROM CEILING SPACE. PROVIDE PLASTIC BUSHINGS AT EACH END. PROVIDE REMOVABLE/RESEALABLE FIRE STOP PUTTY IN EACH CONDUIT AND FIRE STOP AROUND EACH CONDUIT. COORDINATE WITH TECHNOLOGY CONTRACTOR FOR EXACT LOCATION OF CONDUIT. PROVIDE MINIMUM OF 1" CONDUIT FOR ALL OTHER AREAS REQUIRING SLEEVES.
- 8 PROVIDE 1/2" CONDUIT WITH PULL STRING AND BUSHINGS FOR TECHNOLOGY. ROUTE UNDER BUILDING AND TERMINATE AT EXTERIOR OF BUILDING.
- 9 COORDINATE MOUNTING LOCATION WITH TECHNOLOGY CONTRACTOR.
- 10 CONNECT FIRE ALARM DEVICES TO ELECTRIC COILING DOOR AND FIRE ALARM SYSTEM. ROLL UP DOOR SHALL CLOSE UPON ACTIVATION OF THE SMOKE DETECTORS ASSOCIATED WITH THE COILING FIRE DOOR. COORDINATE WITH COILING DOOR CONTRACTOR FOR ALL SMOKE DETECTORS AND CONTROL MODULES REQUIRED FOR A COMPLETE SYSTEM.
- 11 HAND DRYERS FURNISHED BY OTHERS AND INSTALLED BY ELECTRICAL CONTRACTOR. COORDINATE MOUNTING HEIGHT WITH ARCHITECTURAL TRADES.
- 12 SMOKE DAMPER DUCT SMOKE DETECTOR. SMOKE DETECTOR SHALL BE PROVIDED BY THE ELECTRICAL CONTRACTOR. COORDINATE INSTALLATION WITH MECHANICAL CONTRACTOR SO THAT UPON DETECTION OF SMOKE THE SUPPLY/RETURN FAN WILL SHUT DOWN. ELECTRICAL CONTRACTOR SHALL WIRE DUCT DETECTOR TO FIRE ALARM SYSTEM AND CIRCUIT DAMPER ACTUATOR. PROVIDE A 20A-IP SWITCH AT EACH ACTUATOR. CONTROL OF AIR HANDLING EQUIPMENT IS VIA THE FIRE ALARM CONTROL PANEL. PROVIDE ALL REQUIRED CONTROL MODULES AND RELAYS. COORDINATE WORK WITH THE TEMPERATURE CONTROL CONTRACTOR AND FIRE ALARM MANUFACTURER. DAMPER SHALL CLOSE UPON DETECTION OF SMOKE AND SHUT DOWN ASSOCIATED AIR HANDLER. DAMPER SHALL ALSO CLOSE UPON NORMAL SHUTDOWN OF AIR HANDLER.
- 13 CARBON MONOXIDE DETECTOR. COORDINATE QUANTITY WITH FIRE MARSHAL.
- 14 SCOREBOARD. COORDINATE EXACT LOCATION WITH ARCHITECT PRIOR TO ROUGH IN.
- 15 WALL MOUNT TRANSFORMER.
- 16 ELECTRIC RANGE. PROVIDE WALL MOUNTED GFCI MODULE ABOVE COUNTER.
- 17 LIGHTING RELAY PANEL FOR THEATRICAL LIGHTING SYSTEM. REFER TO THEATRICAL LIGHTING EQUIPMENT DRAWINGS.



TMP ARCHITECTURE INC
1191 WEST SQUARE LAKE ROAD - BOX 289
BLOOMFIELD HILLS - MICHIGAN 48302
PH: 248.338.4941 FX: 248.338.0223
EM: INFO@TMP-ARCHITECTURE.COM

REGISTRATION SEAL


CONSULTANT

Peter Basso Associates Inc
CONSULTING ENGINEERS
5145 Livernois, Suite 100
Troy, Michigan 48068-3276
Tel: 248-679-5666
Fax: 248-679-0007
www.PeterBassoAssociates.com
PBA Project No. 2023.0154

PROJECT TITLE
**NEW SMITH
MIDDLE SCHOOL**
Bid Package No. 03B

Troy School District
TROY, MI

DRAWING TITLE
FIRST LEVEL POWER AND AUXILIARY
SYSTEMS PLAN - ZONE 'C'

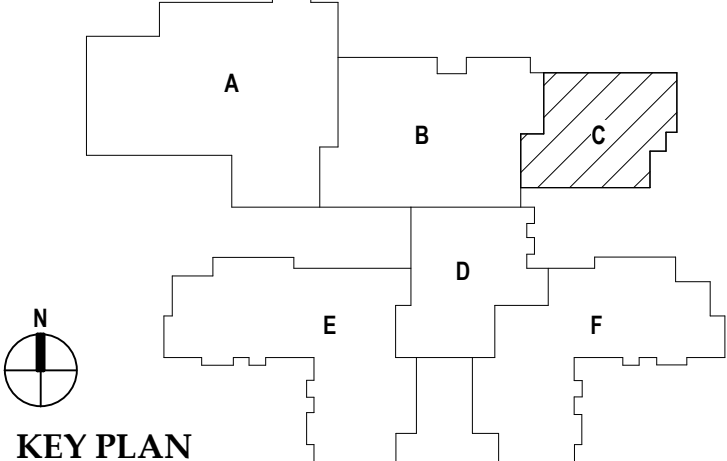

ISSUE DATES




DATE	ISSUED FOR:

DATE	ADDENDUM #
07-12-2024	ADDENDUM #2
08-16-2024	CONSTRUCTION DOCUMENTS

DATE	ISSUED FOR:

PROJECT NO.
22102
DRAWING NO.
E3.1C

THE FOLLOWING DIMENSION EQUALS ONE INCH WHEN PRINTED TO SCALE.

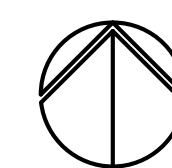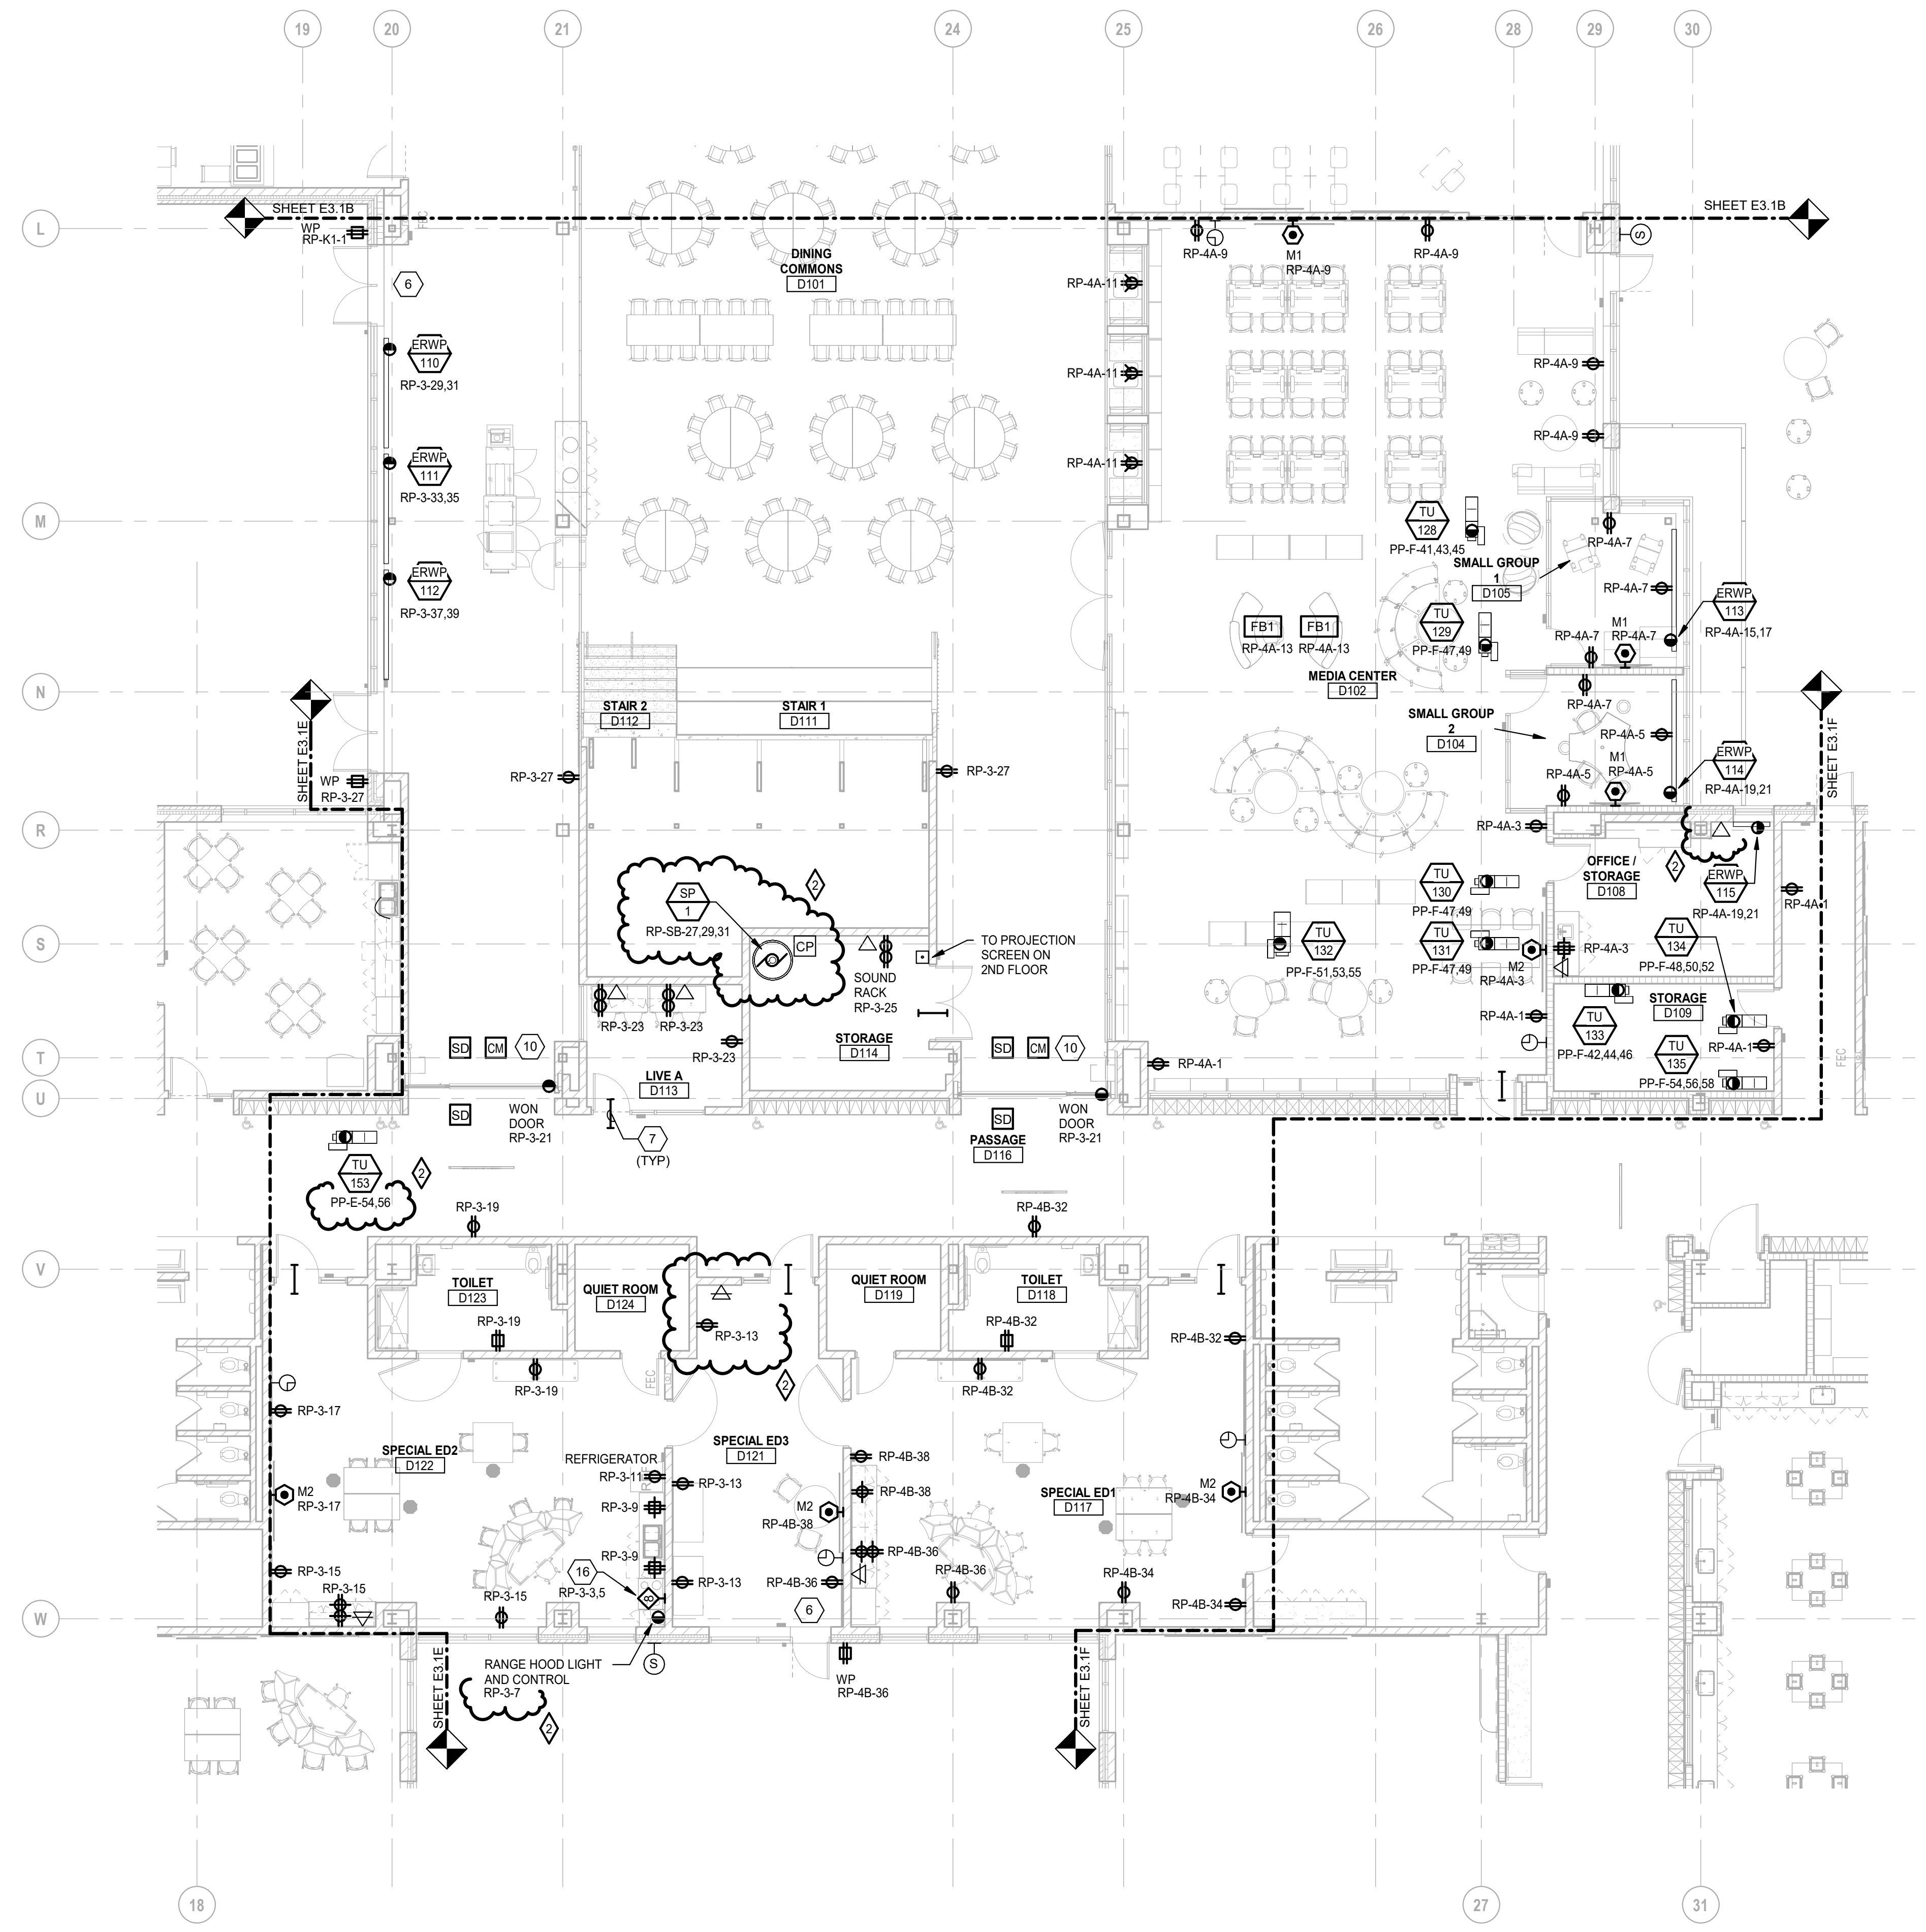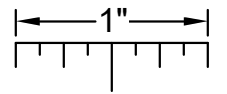

FIRST LEVEL POWER AND AUXILIARY SYSTEMS PLAN - ZONE 'D'
SCALE: 1/8" = 1'-0"

ELECTRICAL GENERAL NOTES:

- THESE DRAWINGS REPRESENT THE GENERAL EXTENT AND ARRANGEMENT OF SYSTEMS. COORDINATE EXACT EQUIPMENT LOCATIONS, ELEVATIONS, AND FINAL CONNECTION REQUIREMENTS. PROVIDE EACH SYSTEM COMPLETE, INCLUDING ALL NECESSARY COMPONENTS, FITTINGS AND OFFSETS.
- INSTALL SYSTEMS SUCH THAT REQUIRED CLEARANCE AND SERVICE ACCESS SPACE IS PROVIDED AROUND ALL MECHANICAL AND ELECTRICAL EQUIPMENT, AND AROUND ANY COMPONENTS WHICH REQUIRE SERVICE ACCESS.
- COORDINATE AND PROVIDE ACCESS DOORS WITHIN INACCESSIBLE CEILING, SHAFT, AND CHASE AREAS FOR ALL COMPONENTS WHICH REQUIRE SERVICE ACCESS. REFER TO ARCHITECTURAL DRAWINGS FOR CEILING TYPES.
- PROVIDE SUPPLEMENTARY STEEL AS REQUIRED FOR THE PROPER SUPPORT OF ALL SYSTEMS.
- TRANSFORMER SECONDARY CONDUCTORS SHALL BE SIZED IN ACCORDANCE WITH TRANSFORMER CIRCUIT SIZING SCHEDULE SHOWN ON "ELECTRICAL STANDARD SCHEDULES DRAWING" UNLESS OTHERWISE NOTED.
- MOTOR CIRCUIT PROTECTION SHALL BE SIZED IN ACCORDANCE WITH MOTOR CIRCUIT SIZING SCHEDULES SHOWN ON "ELECTRICAL STANDARD SCHEDULES DRAWING" UNLESS OTHERWISE NOTED.
- COORDINATE THE MOUNTING HEIGHTS OF DEVICES WITH ARCHITECTURAL ELEVATIONS AND THE TRADES INSTALLING THE WORK.
- COORDINATE EXACT LOCATIONS OF ALL FLOOR SERVICE FITTINGS AND POKE-THROUGH ASSEMBLIES WITH FINAL FURNITURE LAYOUT DRAWINGS.
- REFER TO MECHANICAL SCHEDULE SHEETS FOR ELECTRICAL REQUIREMENTS FOR MECHANICAL EQUIPMENT. PROVIDE ALL CONNECTIONS, STARTERS, DISCONNECTS, ETC. AS REQUIRED BY SCHEDULES AND WHERE NOTED ELSEWHERE. VERIFY REQUIREMENTS OF ALL MECHANICAL EQUIPMENT WITH SHOP DRAWINGS SUBMITTALS. NOTIFY ENGINEER OF ANY CONFLICTS BETWEEN EQUIPMENT SUBMITTALS AND ELECTRICAL DRAWINGS. WHERE CIRCUIT SIZES ARE SHOWN ON THE ELECTRICAL DRAWINGS THAT DIFFER FROM WHAT IS INDICATED ON THE MECHANICAL SCHEDULES, PROVIDE THE CIRCUIT OF HIGHER AMPACITY.
- REFER TO TEMPERATURE CONTROLS SHEETS FOR REQUIRED FIRE ALARM CONTROL MODULES, DUCT SMOKE DETECTORS, AND MOTOR CONTROLLERS. PROVIDE ALL ACCESSORIES INDICATED.
- THE FIRE ALARM DEVICES SHOWN ON PLAN ARE A PARTIAL REPRESENTATION OF THE COMPLETE AND FUNCTIONAL FIRE ALARM SYSTEM IN ACCORDANCE WITH THE SPECIFICATIONS, DRAWINGS, AND ALL APPLICABLE CODES. THE FIRE ALARM VENDOR SHALL PROVIDE LAYOUT DRAWINGS INDICATING THE REQUIRED QUANTITIES AND LOCATIONS OF MANUAL PULL STATIONS, NOTIFICATION APPLIANCES, SMOKE AND HEAT DETECTORS, CONTROL MODULES, INTERFACE MODULES, MODULES FOR SPRINKLER FLOW AND TAMPER SWITCHES, ALL CONTROL PANELS, POWER SUPPLIES, AND ADDITIONAL DEVICES AND EQUIPMENT REQUIRED. COORDINATE LOCATIONS OF DEVICES WITH ARCHITECTURAL FINISHES AND REFLECTED CEILING PLANS, INCLUDING ADDITIONAL SMOKE AND HEAT DETECTORS REQUIRED FOR NON-SMOOTH CEILING APPLICATIONS. INCLUDE ALLOWANCES FOR ADJUSTMENT OF DEVICES BY THE ARCHITECT AT THE TIME OF SUBMITTAL TO COORDINATE WITH BUILDING FINISHES AND OTHER CEILING ELEMENTS.
- REFER TO LIGHTING CONTROL SCHEDULE FOR ROOM CONTROL AND EMERGENCY LIGHTING CIRCUIT CONTROL REQUIREMENTS. DESIGNATION FOR ROOM IS INDICATED AS A LETTERED OVAL SYMBOL.
- CONNECT EXIT SIGNS TO EMERGENCY LIGHTING BRANCH CIRCUIT SERVICE THE AREA. CONNECT AHEAD OF ANY LIGHTING CONTROL DEVICE OR SYSTEM.
- PROVIDE SINGLE GANG JUNCTION BOX WITH 3/4" C. PULL STRING AND BUSHING TO ACCESSIBLE CEILING SPACE AT SPEAKER AND LOCK LOCATIONS. COORDINATE MOUNTING HEIGHT WITH TECHNOLOGY CONTRACTOR.

CONSTRUCTION KEY NOTES:

- MOUNT RECEPTACLES HORIZONTALLY
- ELECTRICAL CONTRACTOR SHALL INSTALL 4" SQUARE JUNCTION BOX WITH 3/4" OF ELECTRICAL BACKBOXING WITHIN 3" OF CEILING SPACE. ALSO INSTALL 4 POLE TWIST LOCK, SINGLE RECEPTACLE, PROVIDED BY WINCH MANUFACTURERS, INTO THE JUNCTION BOX.
- ELECTRICAL CONTRACTOR SHALL INSTALL ALL CONTROLS, PUSHBUTTONS, KEY SWITCHES ETC. (PROVIDED WITH EACH BASKETBALL BACKBOARD), FOR A COMPLETE OPERABLE SYSTEM. KEY SWITCHES GANGED IN PAIRS IN ONE COVER PLATE TO CONTROL THE BACKSTOP SWING AND HEIGHT ADJUSTER.
- HEAT TRACE, BY OTHERS.
- DUCT SMOKE DETECTOR SHALL BE FURNISHED AND INSTALLED BY THE ELECTRICAL CONTRACTOR. COORDINATE MOUNTING LOCATION AND QUANTITY WITH THE MECHANICAL DUCTWORK CONTRACTOR. ELECTRICAL CONTRACTOR SHALL WIRE DUCT SMOKE DETECTOR WITH SUPPLY/RETURN FAN MOTOR STARTER SO THAT UPON DETECTION OF SMOKE, THE SUPPLY/RETURN FAN WILL SHUT DOWN. THIS SHALL BE ACCOMPLISHED VIA THE FIRE ALARM CONTROL PANEL. PROVIDE ALL REQUIRED CONTROL MODULES AND RELAYS. COORDINATE WITH THE TEMPERATURE CONTROL/FIRE ALARM CONTRACTOR. PROVIDE WEATHER PROOF ENCLOSURES AS REQUIRED.
- REFER TO ARCHITECTURAL FLOOR PLANS, DOOR HARDWARE SCHEDULE ON ARCHITECTURAL DRAWINGS, ACCESS CONTROL SYSTEM SPECIFICATION SECTION AND ACCESS CONTROL DOOR DIAGRAM(S) ON E7 SERIES FOR RACEWAY AND BACK BOX REQUIREMENTS FOR DOOR OR BANK OF DOORS INDICATED. PROVIDE ALL RACEWAYS AND BACK BOXES REQUIRED. COORDINATE WITH DOOR HARDWARE AND SECURITY CONTRACTORS.
- PROVIDE 2" AND 1-1/4" U.O.N. CONDUITS FOR TECHNOLOGY AND AUXILIARY SYSTEM WIRE AS INDICATED. STUB CONDUITS FROM CEILING SPACE. PROVIDE PLASTIC BUSHINGS AT EACH END. PROVIDE REMOVABLE/RESEALABLE FIRE STOP PUTTY IN EACH CONDUIT AND FIRE STOP AROUND EACH CONDUIT. COORDINATE WITH TECHNOLOGY CONTRACTOR FOR EXACT LOCATION OF CONDUIT. PROVIDE MINIMUM OF 1" CONDUIT FOR ALL OTHER AREAS REQUIRING SLEEVES.
- PROVIDE 1 1/2" CONDUIT WITH PULL STRING AND BUSHINGS FOR TECHNOLOGY ROUTE UNDER BUILDING AND TERMINATE AT EXTERIOR OF BUILDING.
- COORDINATE MOUNTING LOCATION WITH TECHNOLOGY CONTRACTOR.
- CONNECT FIRE ALARM DEVICES TO ELECTRIC COILING DOOR AND FIRE ALARM SYSTEM. ROLL UP DOOR SHALL CLOSE UPON ACTIVATION OF THE SMOKE DETECTORS ASSOCIATED WITH THE COILING FIRE DOOR. COORDINATE WITH COILING DOOR CONTRACTOR FOR ALL SMOKE DETECTORS AND CONTROL MODULES REQUIRED FOR A COMPLETE SYSTEM.
- HAND DRYERS FURNISHED BY OTHERS AND INSTALLED BY ELECTRICAL CONTRACTOR. COORDINATE MOUNTING HEIGHT WITH ARCHITECTURAL TRADES.
- SMOKE DAMPER DUCT SMOKE DETECTOR. SMOKE DETECTOR SHALL BE PROVIDED BY THE ELECTRICAL CONTRACTOR. COORDINATE INSTALLATION WITH MECHANICAL CONTRACTOR SO THAT UPON DETECTION OF SMOKE THE SUPPLY/RETURN FAN WILL SHUT DOWN. ELECTRICAL CONTRACTOR SHALL WIRE DUCT DETECTOR TO FIRE ALARM SYSTEM AND CIRCUIT DAMPER ACTUATOR. PROVIDE A 20A-1P SWITCH AT EACH ACTUATOR. CONTROL OF AIR HANDLING EQUIPMENT IS VIA THE FIRE ALARM CONTROL PANEL. PROVIDE ALL REQUIRED CONTROL MODULES AND RELAYS. COORDINATE WORK WITH THE TEMPERATURE CONTROLS CONTRACTOR AND FIRE ALARM MANUFACTURER. DAMPER SHALL CLOSE UPON DETECTION OF SMOKE AND SHUT DOWN ASSOCIATED AIR HANDLER. DAMPER SHALL ALSO CLOSE UPON NORMAL SHUTDOWN OF AIR HANDLER.
- CARBON MONOXIDE DETECTOR. COORDINATE QUANTITY WITH FIRE MARSHAL.
- SCOREBOARD. COORDINATE EXACT LOCATION WITH ARCHITECT PRIOR TO ROUGH IN.
- WALL MOUNT TRANSFORMER.
- ELECTRIC RANGE. PROVIDE WALL MOUNTED GFCI MODULE ABOVE COUNTER.
- LIGHTING RELAY PANEL FOR THEATRICAL LIGHTING SYSTEM. REFER TO THEATRICAL LIGHTING EQUIPMENT DRAWINGS.



TMP ARCHITECTURE INC
1191 WEST SQUARE LAKE ROAD - BOX 289
BLOOMFIELD HILLS - MICHIGAN 48302
PH: 248.338.4841 FX: 248.338.0223
EM: INFO@TMP-ARCHITECTURE.COM

REGISTRATION SEAL

CONSULTANT




Peter Basso Associates Inc
CONSULTING ENGINEERS
5145 Livernois, Suite 100
Troy, Michigan 48068-3276
Tel: 248-679-5666
Fax: 248-679-0007
www.PeterBassoAssociates.com
PBA Project No. 2023.0154

PROJECT TITLE

**NEW SMITH
MIDDLE SCHOOL**
Bid Package No. 03B

Troy School District
TROY, MI

DRAWING TITLE
**FIRST LEVEL POWER AND AUXILIARY
SYSTEMS PLAN - ZONE 'D'**

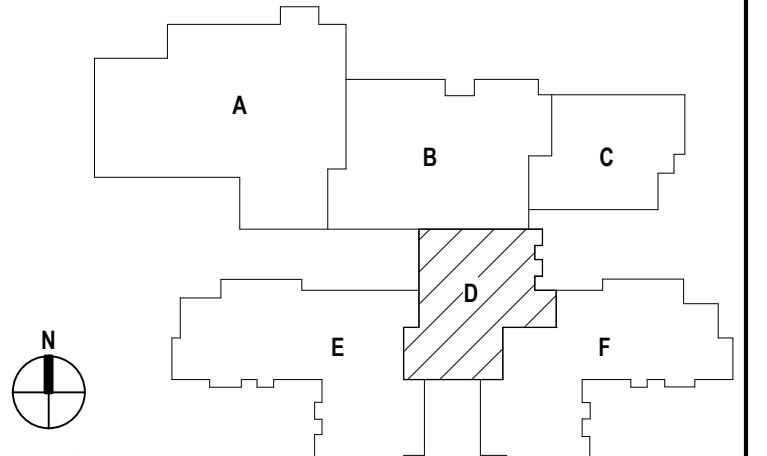

ISSUE DATES

DATE	ISSUED FOR:

DATE	ADDENDUM #	CONSTRUCTION DOCUMENTS
07-12-2024		
08-16-2024		

DATE	ISSUED FOR:

DRAWN	DDG
CHECKED	ZDB
APPROVED	STP



PROJECT NO.

22102

DRAWING NO.

E3.1D

THE FOLLOWING DIMENSION EQUALS ONE INCH WHEN PRINTED TO SCALE.

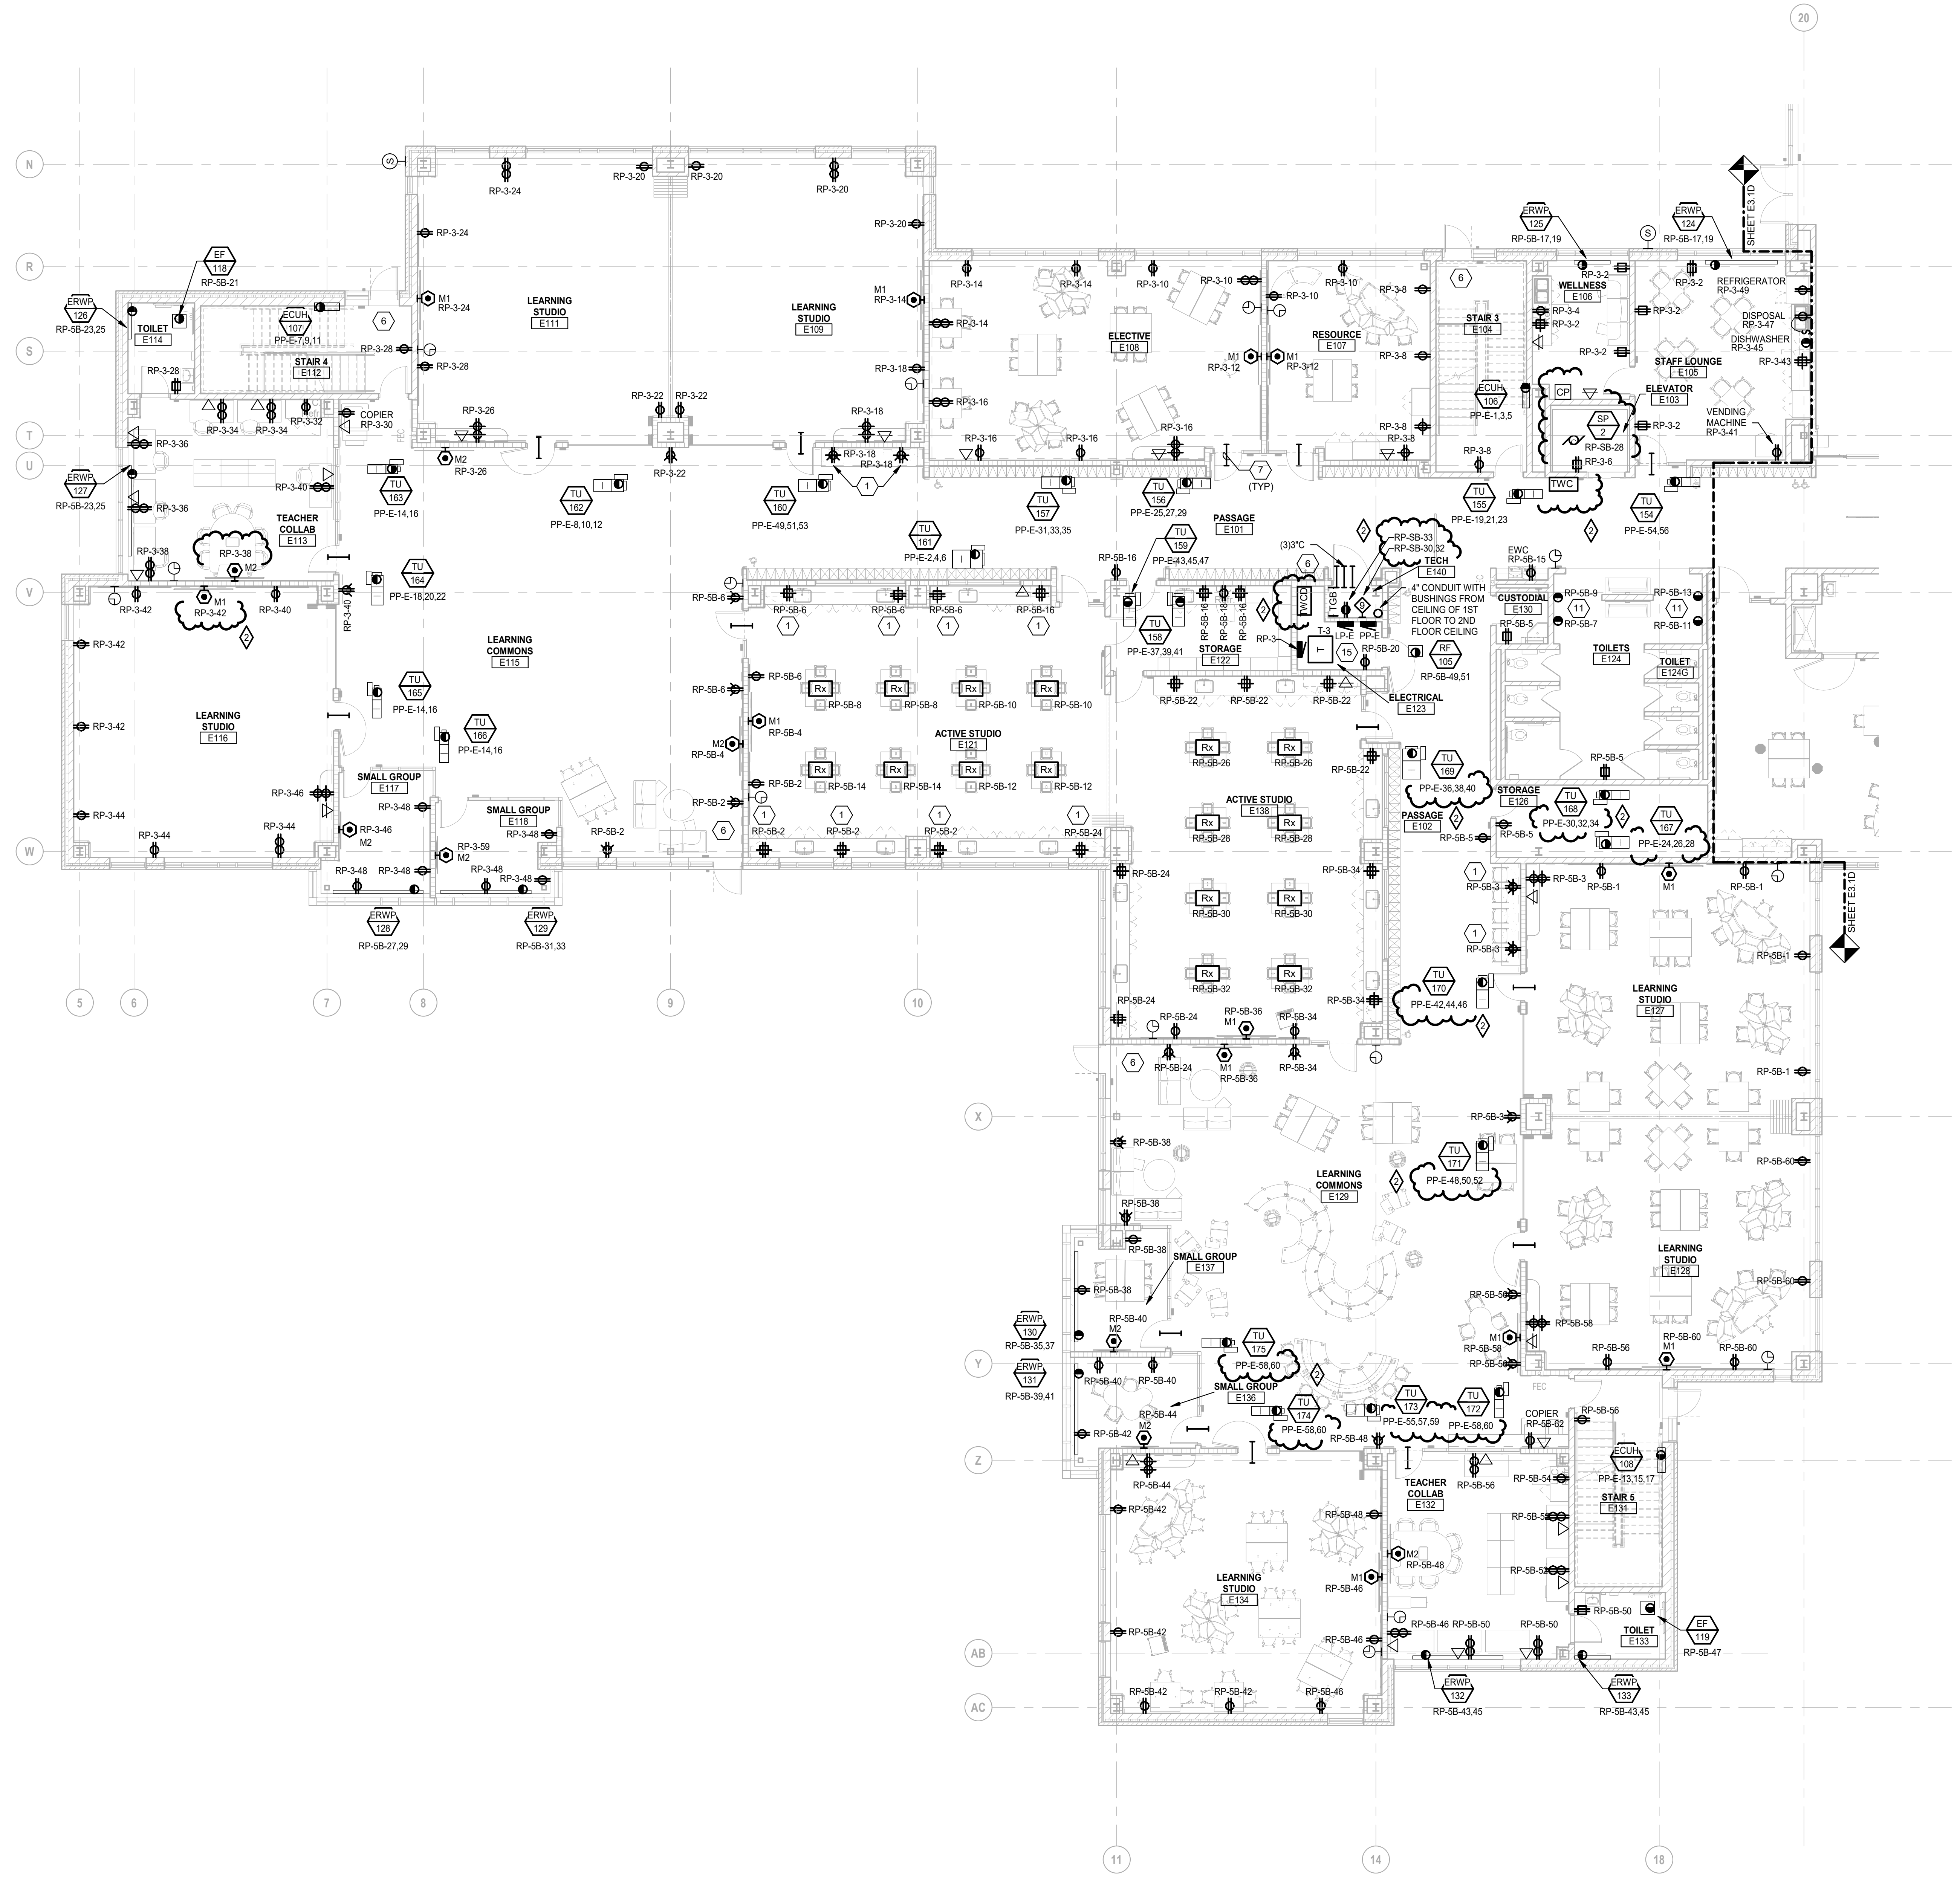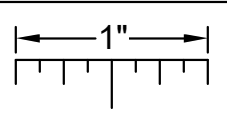

FIRST LEVEL POWER AND AUXILIARY SYSTEMS PLAN - ZONE 'E'
SCALE: 1/8" = 1'-0"

ELECTRICAL GENERAL NOTES:

- THESE DRAWINGS REPRESENT THE GENERAL EXTENT AND ARRANGEMENT OF SYSTEMS. COORDINATE EXACT EQUIPMENT LOCATIONS, ELEVATIONS, AND FINAL CONNECTION REQUIREMENTS. PROVIDE EACH SYSTEM COMPLETE, INCLUDING ALL NECESSARY COMPONENTS, FITTINGS AND OFFSETS.
- INSTALL SYSTEMS SUCH THAT REQUIRED CLEARANCE AND SERVICE ACCESS SPACE IS PROVIDED AROUND ALL MECHANICAL AND ELECTRICAL EQUIPMENT, AND AROUND ANY COMPONENTS WHICH REQUIRE SERVICE ACCESS.
- COORDINATE AND PROVIDE ACCESS DOORS WITHIN INACCESSIBLE CEILING, SHAFT, AND CHASE AREAS FOR ALL COMPONENTS WHICH REQUIRE SERVICE ACCESS. REFER TO ARCHITECTURAL DRAWINGS FOR CEILING TYPES.
- PROVIDE SUPPLEMENTARY STEEL AS REQUIRED FOR THE PROPER SUPPORT OF ALL SYSTEMS.
- TRANSFORMER SECONDARY CONDUCTORS SHALL BE SIZED IN ACCORDANCE WITH TRANSFORMER CIRCUIT SIZING SCHEDULE SHOWN ON "ELECTRICAL STANDARD SCHEDULES DRAWING" UNLESS OTHERWISE NOTED.
- MOTOR CIRCUIT PROTECTION SHALL BE SIZED IN ACCORDANCE WITH MOTOR CIRCUIT SIZING SCHEDULES SHOWN ON "ELECTRICAL STANDARD SCHEDULES DRAWING" UNLESS OTHERWISE NOTED.
- COORDINATE THE MOUNTING HEIGHTS OF DEVICES WITH ARCHITECTURAL ELEVATIONS AND THE TRADES INSTALLING THE WORK.
- COORDINATE EXACT LOCATIONS OF ALL FLOOR SERVICE FITTINGS AND POKE-THROUGH ASSEMBLIES WITH FINAL FURNITURE LAYOUT DRAWINGS.
- REFER TO MECHANICAL SCHEDULE SHEETS FOR ELECTRICAL REQUIREMENTS FOR MECHANICAL EQUIPMENT. PROVIDE ALL CONNECTIONS, STARTERS, DISCONNECTS, ETC. AS REQUIRED BY SCHEDULES AND WHERE NOTED ELSEWHERE. VERIFY REQUIREMENTS OF ALL MECHANICAL EQUIPMENT WITH SHOP DRAWINGS. SUBMITTALS. NOTIFY ENGINEER OF ANY CONFLICTS BETWEEN EQUIPMENT SUBMITTALS AND ELECTRICAL DRAWINGS. WHERE CIRCUIT SIZES ARE SHOWN ON THE ELECTRICAL DRAWINGS THAT DIFFER FROM WHAT IS INDICATED ON THE MECHANICAL SCHEDULES, PROVIDE THE CIRCUIT OF HIGHER AMPACITY.
- REFER TO TEMPERATURE CONTROLS SHEETS FOR REQUIRED FIRE ALARM CONTROL MODULES, DUCT SMOKE DETECTORS, AND MOTOR CONTROLLERS. PROVIDE ALL ACCESSORIES INDICATED.
- THE FIRE ALARM DEVICES SHOWN ON PLAN ARE A PARTIAL REPRESENTATION OF THE COMPLETE AND FUNCTIONAL FIRE ALARM SYSTEM IN ACCORDANCE WITH THE SPECIFICATIONS, DRAWINGS, AND ALL APPLICABLE CODES. THE FIRE ALARM VENDOR SHALL PROVIDE LAYOUT DRAWINGS INDICATING THE REQUIRED QUANTITIES AND LOCATIONS OF MANUAL PULL STATIONS, NOTIFICATION APPLIANCES, SMOKE AND HEAT DETECTORS, CONTROL MODULES, INTERFACE MODULES, MODULES FOR SPRINKLER FLOW AND TAMPER SWITCHES, ALL CONTROL PANELS, POWER SUPPLIES, AND ADDITIONAL DEVICES AND EQUIPMENT REQUIRED. COORDINATE LOCATIONS OF ALL ARCHITECTURAL FINISHES AND REFLECTED CEILING PLANS, INCLUDING ADDITIONAL SMOKE AND HEAT DETECTORS REQUIRED FOR NON-SMOOTH CEILING APPLICATIONS. INCLUDE ALLOWANCES FOR ADJUSTMENT OF HEIGHTS BY THE ARCHITECT AT THE TIME OF SUBMITTAL TO COORDINATE WITH BUILDING FINISHES AND OTHER CEILING ELEMENTS.
- REFER TO LIGHTING CONTROL SCHEDULE FOR ROOM CONTROL AND EMERGENCY LIGHTING CIRCUIT CONTROL REQUIREMENTS. DESIGNATION FOR ROOM IS INDICATED AS A LETTERED OVAL SYMBOL.
- CONNECT EXISTING SIGNS TO EMERGENCY LIGHTING BRANCH CIRCUIT SERVICE THE AREA. CONNECT AHEAD OF ANY LIGHTING CONTROL DEVICE OR SYSTEM.
- PROVIDE SINGLE GANG JUNCTION BOX WITH 3/4" C. PULL STRING AND BUSHING TO ACCESSIBLE CEILING SPACE AT SPEAKER AND CLOCK LOCATIONS. COORDINATE MOUNTING HEIGHT WITH TECHNOLOGY CONTRACTOR.

CONSTRUCTION KEY NOTES:

- MOUNT RECEPTACLES HORIZONTALLY
- ELECTRICAL CONTRACTOR SHALL INSTALL 4" SQUARE JUNCTION BOX WITHIN 3'-0" OF ELECTRICAL BACKBOARD WING UP IN CEILING SPACE. ALSO INSTALL 4 POLE TWIST LOCK, SINGLE RECEPTACLE, PROVIDED BY WINCH MANUFACTURERS, INTO THE JUNCTION BOX.
- ELECTRICAL CONTRACTOR SHALL INSTALL ALL CONTROLS, PUSHBUTTONS, KEY SWITCHES ETC. (PROVIDED WITH EACH BASKETBALL BACKBOARD), FOR A COMPLETE OPERABLE SYSTEM. KEY SWITCHES GANGED IN Pairs IN ONE COVER PLATE TO CONTROL THE BACKSTOP SWING AND HEIGHT ADJUSTER.
- HEAT TRACE, BY OTHERS.
- DUCT SMOKE DETECTOR SHALL BE FURNISHED AND INSTALLED BY THE ELECTRICAL CONTRACTOR. COORDINATE MOUNTING LOCATION AND QUANTITY WITH THE MECHANICAL DUCTWORK CONTRACTOR. ELECTRICAL CONTRACTOR SHALL WIRE DUCT SMOKE DETECTOR TO SUPPLY/RETURN FAN MOTOR STARTER SO THAT UPON DETECTION OF SMOKE, THE SUPPLY/RETURN FAN WILL SHUT DOWN. THIS SHALL BE ACCOMPLISHED VIA THE FIRE ALARM CONTROL PANEL. PROVIDE ALL REQUIRED CONTROL MODULES AND RELAYS. COORDINATE WITH THE TEMPERATURE CONTROL/FIRE ALARM CONTRACTOR. PROVIDE WEATHER PROOF ENCLOSURES AS REQUIRED.
- REFER TO ARCHITECTURAL FLOOR PLANS, DOOR HARDWARE SCHEDULE ON ARCHITECTURAL DRAWINGS, ACCESS CONTROL SYSTEM SPECIFICATION SECTION AND ACCESS CONTROL DOOR DIAGRAM(S) ON E7 SERIES FOR RACEWAY AND BACK BOX REQUIREMENTS FOR DOOR OR BANK OF DOORS INDICATED. PROVIDE ALL RACEWAYS AND BACK BOXES REQUIRED. COORDINATE WITH DOOR HARDWARE AND SECURITY CONTRACTORS.
- PROVIDE 2" AND 1-1/4" O.D. CONDUITS FOR TECHNOLOGY AND AUXILIARY SYSTEM WIRE AS INDICATED. STUB CONDUITS FROM CEILING SPACE. PROVIDE PLASTIC BUSHINGS AT EACH END. PROVIDE REMOVABLE/RESEALABLE FIRE STOP PUTTY IN EACH CONDUIT AND FIRE STOP AROUND EACH CONDUIT. COORDINATE WITH TECHNOLOGY CONTRACTOR FOR EXACT LOCATION OF CONDUIT. PROVIDE MINIMUM OF 1" CONDUIT FOR ALL OTHER AREAS REQUIRING SLEEVES.
- PROVIDE 1/2" CONDUIT WITH PULL STRING AND BUSHINGS FOR TECHNOLOGY ROUTE UNDER BUILDING AND TERMINATE AT EXTERIOR OF BUILDING.
- COORDINATE MOUNTING LOCATION WITH TECHNOLOGY CONTRACTOR.
- CONNECT FIRE ALARM DEVICES TO ELECTRIC COILING DOOR AND FIRE ALARM SYSTEM. ROLL UP DOOR SHALL CLOSE UPON ACTIVATION OF THE SMOKE DETECTORS ASSOCIATED WITH THE COILING FIRE DOOR. COORDINATE WITH COILING DOOR CONTRACTOR FOR ALL SMOKE DETECTORS AND CONTROL MODULES REQUIRED FOR A COMPLETE SYSTEM.
- HAND DRYERS FURNISHED BY OTHERS AND INSTALLED BY ELECTRICAL CONTRACTOR. COORDINATE MOUNTING HEIGHT WITH ARCHITECTURAL TRADES.
- SMOKE DAMPER DUCT SMOKE DETECTOR. SMOKE DETECTOR SHALL BE PROVIDED BY THE ELECTRICAL CONTRACTOR. COORDINATE INSTALLATION WITH MECHANICAL CONTRACTOR SO THAT UPON DETECTION OF SMOKE THE SUPPLY/RETURN FAN WILL SHUT DOWN. ELECTRICAL CONTRACTOR SHALL WIRE DUCT DETECTOR TO FIRE ALARM SYSTEM AND CIRCUIT DAMPER ACTUATOR. PROVIDE A 20A-1P SWITCH AT EACH ACTUATOR. CONTROL OF AIR HANDLING EQUIPMENT IS VIA THE FIRE ALARM CONTROL PANEL. PROVIDE ALL REQUIRED CONTROL MODULES AND RELAYS. COORDINATE WORK WITH THE TEMPERATURE CONTROLS CONTRACTOR AND FIRE ALARM MANUFACTURER. DAMPER SHALL CLOSE UPON DETECTION OF SMOKE AND SHUT DOWN ASSOCIATED AIR HANDLER. DAMPER SHALL ALSO CLOSE UPON NORMAL SHUTDOWN OF AIR HANDLER.
- CARBON MONOXIDE DETECTOR. COORDINATE QUANTITY WITH FIRE MARSHAL.
- SCOREBOARD. COORDINATE EXACT LOCATION WITH ARCHITECT PRIOR TO ROUGH IN.
- WALL MOUNT TRANSFORMER.
- ELECTRIC RANGE. PROVIDE WALL MOUNTED GFCI MODULE ABOVE COUNTER.
- LIGHTING RELAY PANEL FOR THEATRICAL LIGHTING SYSTEM. REFER TO THEATRICAL LIGHTING EQUIPMENT DRAWINGS.

TMP ARCHITECTURE INC
1191 WEST SQUARE LAKE ROAD - BOX 289
BLOOMFIELD HILLS - MICHIGAN - 48302
PH: 248.338.6941 FX: 248.338.0223
EM: INFO@TMPARCHITECTURE.COM

REGISTRATION SEAL

CONSULTANT

Peter Basso Associates Inc
CONSULTING ENGINEERS
5145 Livernois, Suite 100
Troy, Michigan 48068-3276
Tel: 248-679-5666
Fax: 248-679-0007
www.PeterBassoAssociates.com
PBA Project No. 2023.0154

PROJECT TITLE

NEW SMITH MIDDLE SCHOOL

Bid Package No. 03B

Troy School District
TROY, MI

DRAWING TITLE

FIRST LEVEL POWER AND AUXILIARY SYSTEMS PLAN - ZONE 'E'

KEY PLAN

ISSUE DATES

DATE	ISSUED FOR:
07-12-2024	ADDENDUM #2
08-16-2024	CONSTRUCTION DOCUMENTS



DATE: ISSUED FOR:

DRAWN	DOS
CHECKED	ZDB
APPROVED	STP

PROJECT NO.
22102

DRAWING NO.
E3.1E

THE FOLLOWING DIMENSION EQUALS ONE INCH WHEN PRINTED TO SCALE.

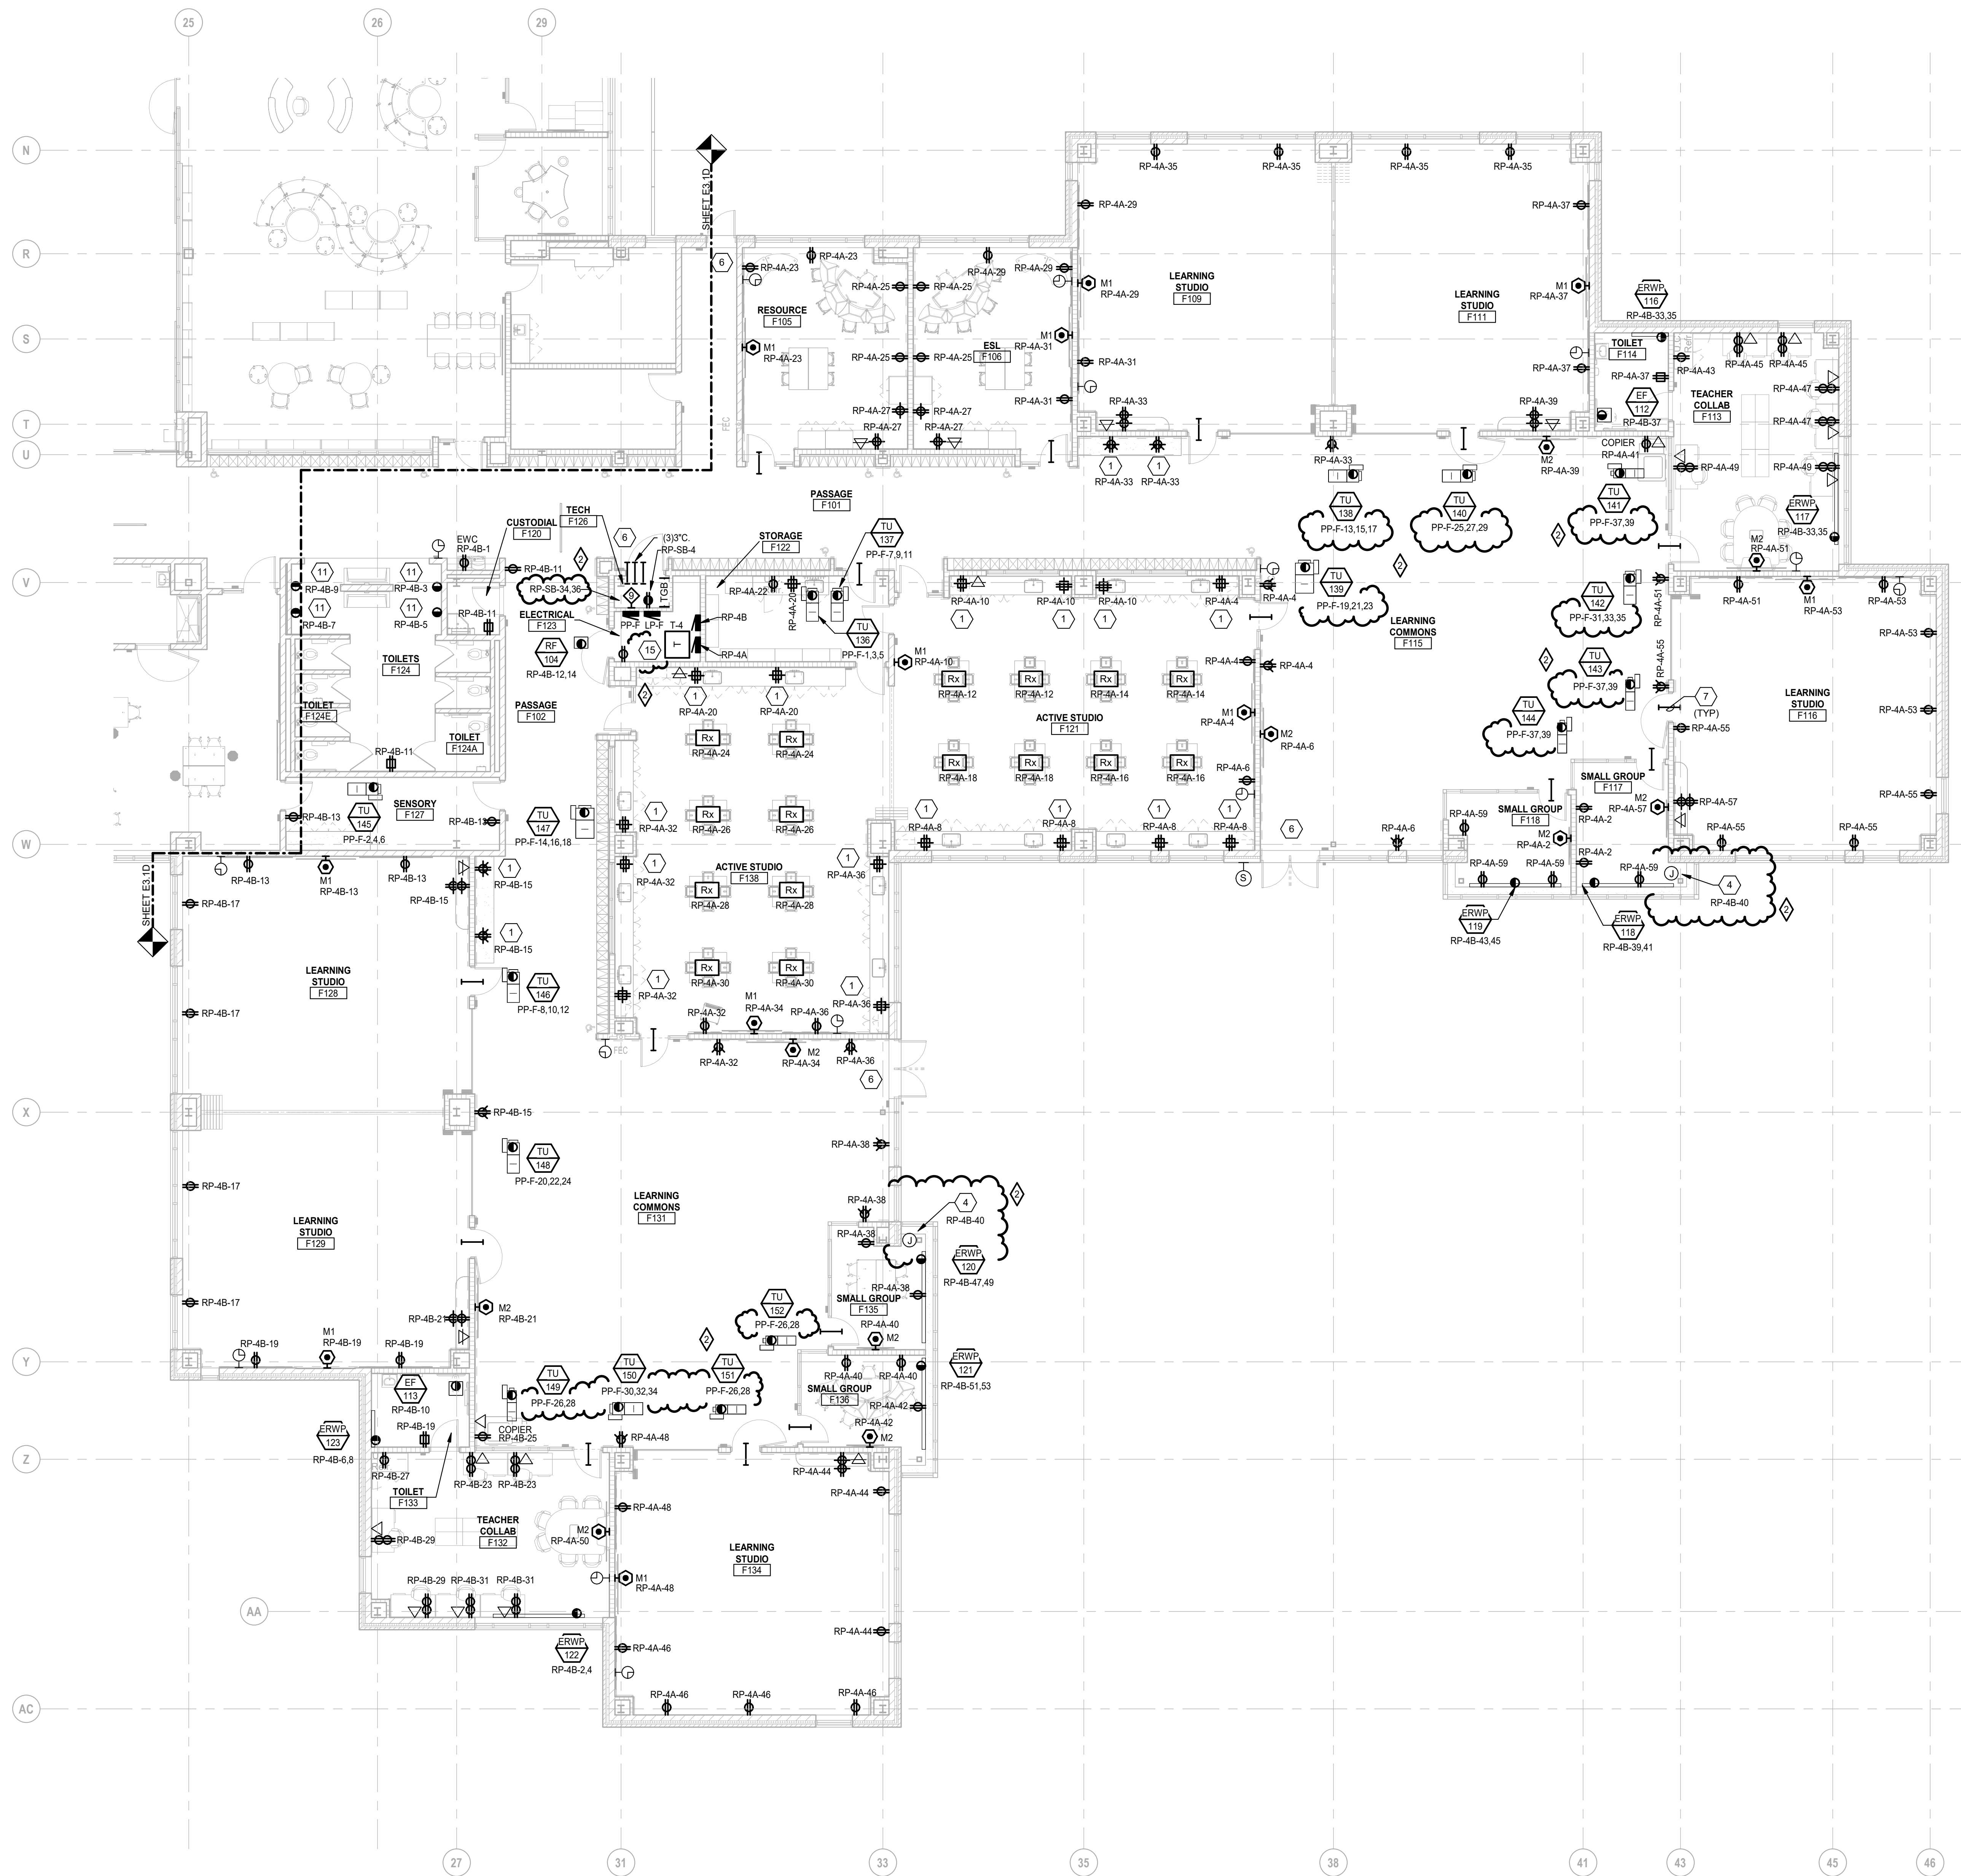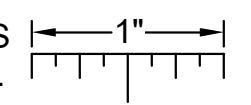

FIRST LEVEL POWER AND AUXILIARY SYSTEMS PLAN - ZONE 'F'
SCALE: 1/8" = 1'-0"

ELECTRICAL GENERAL NOTES:

- 1 THESE DRAWINGS REPRESENT THE GENERAL EXTENT AND ARRANGEMENT OF SYSTEMS. COORDINATE EXACT EQUIPMENT LOCATIONS, ELEVATIONS, AND FINAL CONNECTION REQUIREMENTS. PROVIDE EACH SYSTEM COMPLETE, INCLUDING ALL NECESSARY COMPONENTS, FITTINGS AND OFFSETS.
- 2 INSTALL SYSTEMS SUCH THAT REQUIRED CLEARANCE AND SERVICE ACCESS SPACE IS PROVIDED AROUND ALL MECHANICAL AND ELECTRICAL EQUIPMENT, AND AROUND ANY COMPONENTS WHICH REQUIRE SERVICE ACCESS.
- 3 COORDINATE AND PROVIDE ACCESS DOORS WITHIN INACCESSIBLE CEILING, SHAFT, AND CHASE AREAS FOR ALL COMPONENTS WHICH REQUIRE SERVICE ACCESS. REFER TO ARCHITECTURAL DRAWINGS FOR CEILING TYPES.
- 4 PROVIDE SUPPLEMENTARY STEEL AS REQUIRED FOR THE PROPER SUPPORT OF ALL SYSTEMS.
- 5 TRANSFORMER SECONDARY CONDUCTORS SHALL BE SIZED IN ACCORDANCE WITH TRANSFORMER CIRCUIT SIZING SCHEDULE SHOWN ON "ELECTRICAL STANDARD SCHEDULES DRAWING" UNLESS OTHERWISE NOTED.
- 6 MOTOR CIRCUIT PROTECTION SHALL BE SIZED IN ACCORDANCE WITH MOTOR CIRCUIT SIZING SCHEDULES SHOWN ON "ELECTRICAL STANDARD SCHEDULES DRAWING" UNLESS OTHERWISE NOTED.
- 7 COORDINATE THE MOUNTING HEIGHTS OF DEVICES WITH ARCHITECTURAL ELEVATIONS AND THE TRADES INSTALLING THE WORK.
- 8 COORDINATE EXACT LOCATIONS OF ALL FLOOR SERVICE FITTINGS AND POKE-THROUGH ASSEMBLIES WITH FINAL FURNITURE LAYOUT DRAWINGS.
- 9 REFER TO MECHANICAL SCHEDULE SHEETS FOR ELECTRICAL REQUIREMENTS FOR MECHANICAL EQUIPMENT. PROVIDE ALL CONNECTIONS, STARTERS, DISCONNECTS, ETC. AS REQUIRED BY SCHEDULES AND WHERE NOTED ELSEWHERE. VERIFY REQUIREMENTS OF ALL MECHANICAL EQUIPMENT WITH SHOP DRAWINGS. INTERFACE QUANTITIES AND LOCATIONS OF MANUAL PULL STATIONS, NOTIFICATION APPLIANCES, SMOKE AND HEAT DETECTORS, CONTROL MODULES, INTERFACE MODULES, MODULES FOR SPRINKLER FLOW AND TAMPER SWITCHES, ALL CONTROL PANELS, POWER SUPPLIES, AND ADDITIONAL DEVICES AND EQUIPMENT REQUIRED. COORDINATE LOCATIONS OF DEVICES BY THE ARCHITECT AT THE TIME OF SUBMITTAL TO COORDINATE WITH BUILDING FINISHES AND OTHER CEILING ELEMENTS.
- 10 REFER TO TEMPERATURE CONTROLS SHEETS FOR REQUIRED FIRE ALARM CONTROL MODULES, DUCT SMOKE DETECTORS, AND MOTOR CONTROLLERS. PROVIDE ALL ACCESSORIES INDICATED.
- 11 THE FIRE ALARM DEVICES SHOWN ON PLAN ARE A PARTIAL REPRESENTATION OF THE FIRE ALARM SYSTEM. PROVIDE THE DESIGN AND INSTALLATION OF A COMPLETE AND FUNCTIONAL FIRE ALARM SYSTEM IN ACCORDANCE WITH THE SPECIFICATIONS, DRAWINGS, AND ALL APPLICABLE CODES. THE FIRE ALARM VENDOR SHALL PROVIDE LAYOUT DRAWINGS INDICATING THE REQUIRED QUANTITIES AND LOCATIONS OF MANUAL PULL STATIONS, NOTIFICATION APPLIANCES, SMOKE AND HEAT DETECTORS, CONTROL MODULES, INTERFACE MODULES, MODULES FOR SPRINKLER FLOW AND TAMPER SWITCHES, ALL CONTROL PANELS, POWER SUPPLIES, AND ADDITIONAL DEVICES AND EQUIPMENT REQUIRED. COORDINATE LOCATIONS OF DEVICES BY THE ARCHITECT AT THE TIME OF SUBMITTAL TO COORDINATE WITH BUILDING FINISHES AND OTHER CEILING ELEMENTS.
- 12 REFER TO LIGHTING CONTROL SCHEDULE FOR ROOM CONTROL AND EMERGENCY LIGHTING CIRCUIT CONTROL REQUIREMENTS. DESIGNATION FOR ROOM IS INDICATED AS A LETTERED OVAL SYMBOL.
- 13 CONNECT EXIT SIGNS TO EMERGENCY LIGHTING BRANCH CIRCUIT SERVICE THE AREA. CONNECT AHEAD OF ANY LIGHTING CONTROL DEVICE OR SYSTEM.
- 14 PROVIDE SINGLE GANG JUNCTION BOX WITH 3/4" C. PULL STRING AND BUSHING TO ACCESSIBLE CEILING SPACE AT SPEAKER AND CLOCK LOCATIONS. COORDINATE MOUNTING HEIGHT WITH TECHNOLOGY CONTRACTOR.

CONSTRUCTION KEY NOTES:

- 1 MOUNT RECEPTACLES HORIZONTALLY
- 2 ELECTRICAL CONTRACTOR SHALL INSTALL 4" SQUARE JUNCTION BOX WITH 3/4" OF ELECTRICAL BACKBOARD WING UP IN CEILING SPACE. ALSO INSTALL A POLE TWIST LOCK, SINGLE RECEPTACLE, PROVIDED BY WINCH MANUFACTURERS, INTO THE JUNCTION BOX.
- 3 ELECTRICAL CONTRACTOR SHALL INSTALL ALL CONTROLS, PUSHBUTTONS, KEY SWITCHES ETC. (PROVIDED WITH EACH BASKETBALL BACKBOARD), FOR A COMPLETE OPERABLE SYSTEM. KEY SWITCHES GANGED IN PAIRS IN ONE COVER PLATE TO CONTROL THE BACKSTOP SWING AND HEIGHT ADJUSTER.
- 4 HEAT TRACE, BY OTHERS.
- 5 DUCT SMOKE DETECTOR SHALL BE FURNISHED AND INSTALLED BY THE ELECTRICAL CONTRACTOR. COORDINATE MOUNTING LOCATION AND QUANTITY WITH THE MECHANICAL DUCTWORK CONTRACTOR. ELECTRICAL CONTRACTOR SHALL WIRE DUCT SMOKE DETECTOR RETURN FAN MOTOR STARTER SO THAT UPON DETECTION OF SMOKE, THE SUPPLY/RETURN FAN WILL SHUT DOWN. THIS SHALL BE ACCOMPLISHED VIA THE FIRE ALARM CONTROL PANEL. PROVIDE ALL REQUIRED CONTROL MODULES AND RELAYS. COORDINATE WITH THE TEMPERATURE CONTROL/FIRE ALARM CONTRACTOR. PROVIDE WEATHER PROOF ENCLOSURES AS REQUIRED.
- 6 REFER TO ARCHITECTURAL FLOOR PLANS, DOOR HARDWARE SCHEDULE ON ARCHITECTURAL DRAWINGS, ACCESS CONTROL SYSTEM SPECIFICATION SECTION AND ACCESS CONTROL DOOR DIAGRAM(S) ON E7 SERIES FOR RACEWAY AND BACK BOX REQUIREMENTS FOR DOOR OR BANK OF DOORS INDICATED. PROVIDE ALL RACEWAYS AND BACK BOXES REQUIRED. COORDINATE WITH DOOR HARDWARE AND SECURITY CONTRACTORS.
- 7 PROVIDE 2" AND 1-1/4" U.O.N. CONDUITS FOR TECHNOLOGY AND AUXILIARY SYSTEM WIRE AS INDICATED. STUB CONDUITS FROM CEILING SPACE. PROVIDE PLASTIC BUSHINGS AT EACH END. PROVIDE REMOVABLE/RESEALABLE FIRE STOP PUTTY IN EACH CONDUIT AND FIRE STOP AROUND EACH CONDUIT. COORDINATE WITH TECHNOLOGY CONTRACTOR FOR EXACT LOCATION OF CONDUIT. PROVIDE MINIMUM OF 1" CONDUIT FOR ALL OTHER AREAS REQUIRING SLEEVES.
- 8 PROVIDE 1/2" CONDUIT WITH PULL STRING AND BUSHINGS FOR TECHNOLOGY. ROUTE UNDER BUILDING AND TERMINATE AT EXTERIOR OF BUILDING.
- 9 COORDINATE MOUNTING LOCATION WITH TECHNOLOGY CONTRACTOR.
- 10 CONNECT FIRE ALARM DEVICES TO ELECTRIC COILING DOOR AND FIRE ALARM SYSTEM. ROLL UP DOOR SHALL CLOSE UPON ACTIVATION OF THE SMOKE DETECTORS ASSOCIATED WITH THE COILING FIRE DOOR. COORDINATE WITH COILING DOOR CONTRACTOR FOR ALL SMOKE DETECTORS AND CONTROL MODULES REQUIRED FOR A COMPLETE SYSTEM.
- 11 HAND DRYERS FURNISHED BY OTHERS AND INSTALLED BY ELECTRICAL CONTRACTOR. COORDINATE MOUNTING HEIGHT WITH ARCHITECTURAL TRADES.
- 12 SMOKE DAMPER DUCT SMOKE DETECTOR. SMOKE DETECTOR SHALL BE PROVIDED BY THE ELECTRICAL CONTRACTOR. COORDINATE INSTALLATION WITH MECHANICAL CONTRACTOR SO THAT UPON DETECTION OF SMOKE THE SUPPLY/RETURN FAN WILL SHUT DOWN. ELECTRICAL CONTRACTOR SHALL WIRE DUCT DETECTOR TO FIRE ALARM SYSTEM AND CIRCUIT DAMPER ACTUATOR. PROVIDE A 20A-IP SWITCH AT EACH ACTUATOR. CONTROL OF AIR HANDLING EQUIPMENT IS VIA THE FIRE ALARM CONTROL PANEL. PROVIDE ALL REQUIRED CONTROL MODULES AND RELAYS. COORDINATE WORK WITH THE TEMPERATURE CONTROL CONTRACTOR AND FIRE ALARM MANUFACTURER. DAMPER SHALL CLOSE UPON DETECTION OF SMOKE AND SHUT DOWN ASSOCIATED AIR HANDLER. DAMPER SHALL ALSO CLOSE UPON NORMAL SHUTDOWN OF AIR HANDLER.
- 13 CARBON MONOXIDE DETECTOR. COORDINATE QUANTITY WITH FIRE MARSHAL.
- 14 SCOREBOARD. COORDINATE EXACT LOCATION WITH ARCHITECT PRIOR TO ROUGH IN.
- 15 WALL MOUNT TRANSFORMER.
- 16 ELECTRIC RANGE. PROVIDE WALL MOUNTED GFCI MODULE ABOVE COUNTER.
- 17 LIGHTING RELAY PANEL FOR THEATRICAL LIGHTING SYSTEM. REFER TO THEATRICAL LIGHTING EQUIPMENT DRAWINGS.



TMP ARCHITECTURE INC
1191 WEST SQUARE LAKE ROAD - BOX 289
BLOOMFIELD HILLS - MICHIGAN 48302
PH: 248-338-6941 FX: 248-338-0223
EM: INFO@TMP-ARCHITECTURE.COM

REGISTRATION SEAL

CONSULTANT




Peter Basso Associates Inc
CONSULTING ENGINEERS
5145 Livernois, Suite 100
Troy, Michigan 48068-3276
Tel: 248-879-5666 Fax: 248-879-0007
www.PeterBassoAssociates.com
PBA Project No. 2023.0154

PROJECT TITLE

NEW SMITH MIDDLE SCHOOL
Bid Package No. 03B

Troy School District
TROY, MI

DRAWING TITLE
FIRST LEVEL POWER AND AUXILIARY SYSTEMS PLAN - ZONE 'F'

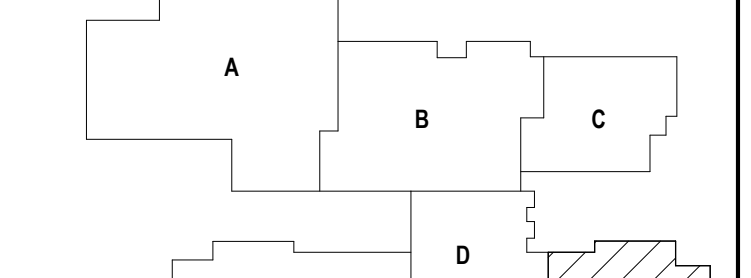

KEY PLAN

ISSUE DATES

DATE	ISSUED FOR:



07-12-2024	ADDENDUM #2
08-16-2024	CONSTRUCTION DOCUMENTS
DATE:	ISSUED FOR:

DRAWN	DDS
CHECKED	ZDB
APPROVED	STP

PROJECT NO.
22102

DRAWING NO.
E3.1F

THE FOLLOWING DIMENSION EQUALS ONE INCH WHEN PRINTED TO SCALE.

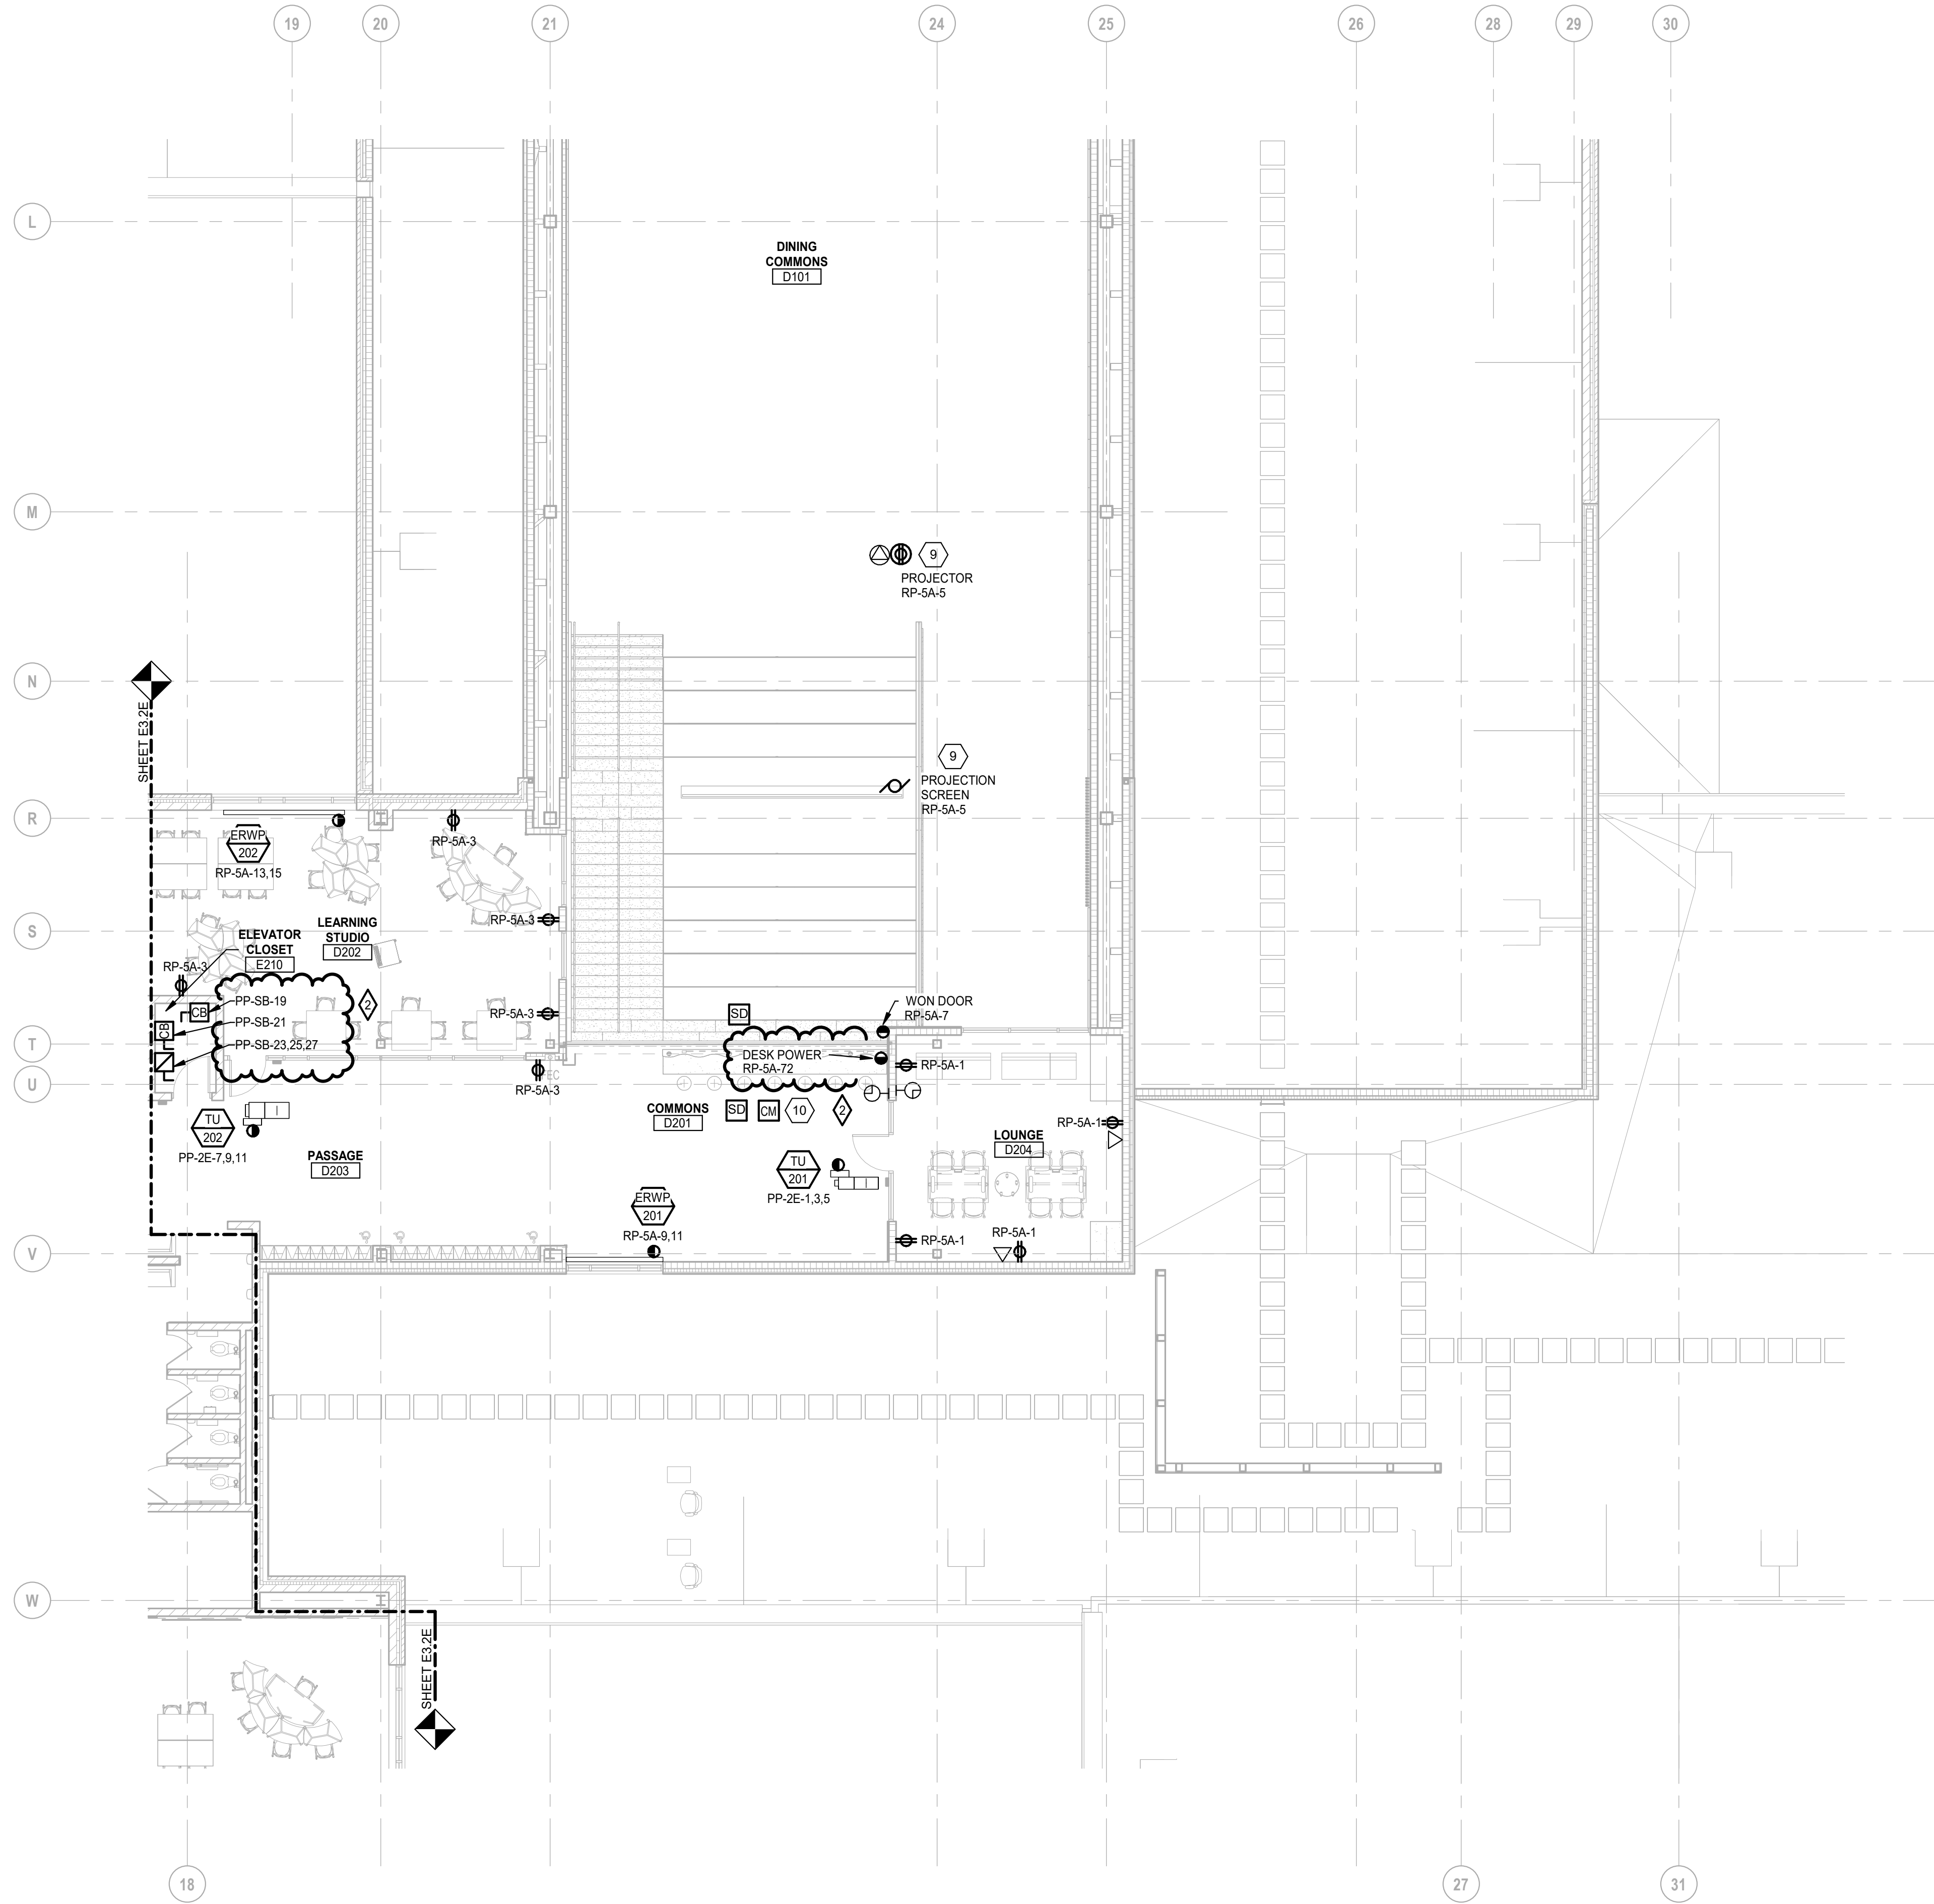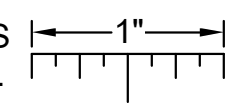

SECOND LEVEL POWER AND AUXILIARY SYSTEMS PLAN - ZONE 'D'
SCALE: 1/8" = 1'-0"

ELECTRICAL GENERAL NOTES:

- 1 THESE DRAWINGS REPRESENT THE GENERAL EXTENT AND ARRANGEMENT OF SYSTEMS. COORDINATE EXACT EQUIPMENT LOCATIONS, ELEVATIONS, AND FINAL CONNECTION REQUIREMENTS. PROVIDE EACH SYSTEM COMPLETE, INCLUDING ALL NECESSARY COMPONENTS, FITTINGS AND OFFSETS.
- 2 INSTALL SYSTEMS SUCH THAT REQUIRED CLEARANCE AND SERVICE ACCESS SPACE IS PROVIDED AROUND ALL MECHANICAL AND ELECTRICAL EQUIPMENT, AND AROUND ANY COMPONENTS WHICH REQUIRE SERVICE ACCESS.
- 3 COORDINATE AND PROVIDE ACCESS DOORS WITHIN INACCESSIBLE CEILING, SHAFT, AND CHASE AREAS FOR ALL COMPONENTS WHICH REQUIRE SERVICE ACCESS. REFER TO ARCHITECTURAL DRAWINGS FOR CEILING TYPES.
- 4 PROVIDE SUPPLEMENTARY STEEL AS REQUIRED FOR THE PROPER SUPPORT OF ALL SYSTEMS.
- 5 TRANSFORMER SECONDARY CONDUCTORS SHALL BE SIZED IN ACCORDANCE WITH TRANSFORMER CIRCUIT SIZING SCHEDULE SHOWN ON "ELECTRICAL STANDARD SCHEDULES DRAWING" UNLESS OTHERWISE NOTED.
- 6 MOTOR CIRCUIT PROTECTION SHALL BE SIZED IN ACCORDANCE WITH MOTOR CIRCUIT SIZING SCHEDULES SHOWN ON "ELECTRICAL STANDARD SCHEDULES DRAWING" UNLESS OTHERWISE NOTED.
- 7 COORDINATE THE MOUNTING HEIGHTS OF DEVICES WITH ARCHITECTURAL ELEVATIONS AND THE TRADES INSTALLING THE WORK.
- 8 COORDINATE EXACT LOCATIONS OF ALL FLOOR SERVICE FITTINGS AND POKE-THROUGH ASSEMBLIES WITH FINAL FURNITURE LAYOUT DRAWINGS.
- 9 REFER TO MECHANICAL SCHEDULE SHEETS FOR ELECTRICAL REQUIREMENTS FOR MECHANICAL EQUIPMENT. PROVIDE ALL CONNECTIONS, STARTERS, DISCONNECTS, ETC. AS REQUIRED BY SCHEDULES AND WHERE NOTED ELSEWHERE. VERIFY REQUIREMENTS OF ALL MECHANICAL EQUIPMENT WITH SHOP DRAWINGS SUBMITTALS. NOTIFY ENGINEER OF ANY CONFLICTS BETWEEN EQUIPMENT SUBMITTALS AND ELECTRICAL DRAWINGS WHERE CIRCUIT SIZES ARE SHOWN ON THE ELECTRICAL DRAWINGS THAT DIFFER FROM WHAT IS INDICATED ON THE MECHANICAL SCHEDULES. PROVIDE THE CIRCUIT OF HIGHER AMPACITY.
- 10 REFER TO TEMPERATURE CONTROLS SHEETS FOR REQUIRED FIRE ALARM CONTROL MODULES, DUCT SMOKE DETECTORS, AND MOTOR CONTROLLERS. PROVIDE ALL ACCESSORIES INDICATED.
- 11 THE FIRE ALARM DEVICES SHOWN ON PLAN ARE A PARTIAL REPRESENTATION OF THE COMPLETE AND FUNCTIONAL FIRE ALARM SYSTEM IN ACCORDANCE WITH THE SPECIFICATIONS, DRAWINGS, AND ALL APPLICABLE CODES. THE FIRE ALARM VENDOR SHALL PROVIDE LAYOUT DRAWINGS INDICATING THE REQUIRED QUANTITIES AND LOCATIONS OF MANUAL PULL STATIONS, NOTIFICATION APPLIANCES, SMOKE AND HEAT DETECTORS, CONTROL MODULES, INTERFACE MODULES, MODULES FOR SPRINKLER FLOW AND TAMPER SWITCHES, ALL CONTROL PANELS, POWER SUPPLIES, AND ADDITIONAL DEVICES AND EQUIPMENT REQUIRED. COORDINATE LOCATIONS OF DEVICES WITH ARCHITECTURAL FINISHES AND REFLECTED CEILING PLANS, INCLUDING ADDITIONAL SMOKE AND HEAT DETECTORS REQUIRED FOR NON-SMOOTH CEILING APPLICATIONS. INCLUDE ALLOWANCES FOR ADJUSTMENT OF DEVICES BY THE ARCHITECT AT THE TIME OF SUBMITTAL TO COORDINATE WITH BUILDING FINISHES AND OTHER CEILING ELEMENTS.
- 12 REFER TO LIGHTING CONTROL SCHEDULE FOR ROOM CONTROL AND EMERGENCY LIGHTING CIRCUIT CONTROL REQUIREMENTS. DESIGNATION FOR ROOM IS INDICATED AS A LETTERED OVAL SYMBOL.
- 13 CONNECT EXIT SIGNS TO EMERGENCY LIGHTING BRANCH CIRCUIT SERVICE THE AREA. CONNECT AHEAD OF ANY LIGHTING CONTROL DEVICE OR SYSTEM.
- 14 PROVIDE SINGLE GANG JUNCTION BOX WITH 3/4" C. PULL STRING AND BUSHING TO ACCESSIBLE CEILING SPACE AT SPEAKER AND CLOCK LOCATIONS. COORDINATE MOUNTING HEIGHT WITH TECHNOLOGY CONTRACTOR.

CONSTRUCTION KEY NOTES:

- 1 MOUNT RECEPTACLES HORIZONTALLY
- 2 ELECTRICAL CONTRACTOR SHALL INSTALL 4" SQUARE JUNCTION BOX WITH 3/4" OF ELECTRICAL CONDUIT SWING UP IN CEILING SPACE. ALSO INSTALL 4" POLE TWIST LOCK, SINGLE RECEPTACLE, PROVIDED BY WINCH MANUFACTURERS, INTO THE JUNCTION BOX.
- 3 ELECTRICAL CONTRACTOR SHALL INSTALL ALL CONTROLS, PUSHBUTTONS, KEY SWITCHES ETC. (PROVIDED WITH EACH BASKETBALL BACKBOARD), FOR A COMPLETE OPERABLE SYSTEM. KEY SWITCHES GANGED IN PAIRS IN ONE COVER PLATE TO CONTROL THE BACKSTOP SWING AND HEIGHT ADJUSTER.
- 4 HEAT TRACE, BY OTHERS.
- 5 DUCT SMOKE DETECTOR SHALL BE FURNISHED AND INSTALLED BY THE ELECTRICAL CONTRACTOR. COORDINATE MOUNTING LOCATION AND QUANTITY WITH THE MECHANICAL DUCTWORK CONTRACTOR. ELECTRICAL CONTRACTOR SHALL WIRE DUCT SMOKE DETECTOR TO SUPPLY/RETURN FAN MOTOR STARTER SO THAT UPON DETECTION OF SMOKE, THE SUPPLY/RETURN FAN WILL SHUT DOWN. THIS SHALL BE ACCOMPLISHED VIA THE FIRE ALARM CONTROL PANEL. PROVIDE ALL REQUIRED CONTROL MODULES AND RELAYS. COORDINATE WITH THE TEMPERATURE CONTROL/FIRE ALARM CONTRACTOR. PROVIDE WEATHER PROOF ENCLOSURES AS REQUIRED.
- 6 REFER TO ARCHITECTURAL FLOOR PLANS, DOOR HARDWARE SCHEDULE ON ARCHITECTURAL DRAWINGS, ACCESS CONTROL SYSTEM SPECIFICATION SECTION AND ACCESS CONTROL DOOR DIAGRAM(S) ON E7 SERIES FOR RACEWAY AND BACK BOX REQUIREMENTS FOR DOOR OR BANK OF DOORS INDICATED. PROVIDE ALL RACEWAYS AND BACK BOXES REQUIRED. COORDINATE WITH DOOR HARDWARE AND SECURITY CONTRACTORS.
- 7 PROVIDE 2" AND 1-1/4" U.O.N. CONDUITS FOR TECHNOLOGY AND AUXILIARY SYSTEM WIRE AS INDICATED. SUB CONDUITS FROM CEILING SPACE. PROVIDE PLASTIC BUSHINGS AT EACH END. PROVIDE REMOVABLE/RESEALABLE FIRE STOP PUTTY IN EACH CONDUIT AND FIRE STOP AROUND EACH CONDUIT. COORDINATE WITH TECHNOLOGY CONTRACTOR FOR EXACT LOCATION OF CONDUIT. PROVIDE MINIMUM OF 1" CONDUIT FOR ALL OTHER AREAS REQUIRING SLEEVES.
- 8 PROVIDE 1/2" CONDUIT WITH PULL STRING AND BUSHINGS FOR TECHNOLOGY. ROUTE UNDER BUILDING AND TERMINATE AT EXTERIOR OF BUILDING.
- 9 COORDINATE MOUNTING LOCATION WITH TECHNOLOGY CONTRACTOR.
- 10 CONNECT FIRE ALARM DEVICES TO ELECTRIC COILING DOOR AND FIRE ALARM SYSTEM. ROLL UP DOOR SHALL CLOSE UPON ACTIVATION OF THE SMOKE DETECTORS ASSOCIATED WITH THE COILING FIRE DOOR. COORDINATE WITH COILING DOOR CONTRACTOR FOR ALL SMOKE DETECTORS AND CONTROL MODULES REQUIRED FOR A COMPLETE SYSTEM.
- 11 HAND DRYERS FURNISHED BY OTHERS AND INSTALLED BY ELECTRICAL CONTRACTOR. COORDINATE MOUNTING HEIGHT WITH ARCHITECTURAL TRADES.
- 12 SMOKE DAMPER DUCT SMOKE DETECTOR. SMOKE DETECTOR SHALL BE PROVIDED BY THE ELECTRICAL CONTRACTOR. COORDINATE INSTALLATION WITH MECHANICAL CONTRACTOR SO THAT UPON DETECTION OF SMOKE THE SUPPLY/RETURN FAN WILL SHUT DOWN. ELECTRICAL CONTRACTOR SHALL WIRE DUCT DETECTOR TO FIRE ALARM SYSTEM AND CIRCUIT DAMPER ACTUATOR. PROVIDE A 20A-1P SWITCH AT EACH ACTUATOR. CONTROL OF AIR HANDLING EQUIPMENT IS VIA THE FIRE ALARM CONTROL PANEL. PROVIDE ALL REQUIRED CONTROL MODULES AND RELAYS. COORDINATE WORK WITH THE TEMPERATURE CONTROL CONTRACTOR AND FIRE ALARM MANUFACTURER. DAMPER SHALL CLOSE UPON DETECTION OF SMOKE AND SHUT DOWN ASSOCIATED AIR HANDLER. DAMPER SHALL ALSO CLOSE UPON NORMAL SHUTDOWN OF AIR HANDLER.
- 13 CARBON MONOXIDE DETECTOR. COORDINATE QUANTITY WITH FIRE MARSHAL.
- 14 SCOREBOARD. COORDINATE EXACT LOCATION WITH ARCHITECT PRIOR TO ROUGH IN.
- 15 WALL MOUNT TRANSFORMER.
- 16 ELECTRIC RANGE. PROVIDE WALL MOUNTED GFCI MODULE ABOVE COUNTER.
- 17 LIGHTING RELAY PANEL FOR THEATRICAL LIGHTING SYSTEM. REFER TO THEATRICAL LIGHTING EQUIPMENT DRAWINGS.



TMP ARCHITECTURE INC
1191 WEST SQUARE LAKE ROAD - BOX 289
BLOOMFIELD HILLS - MICHIGAN 48302
PH: 248.358.6941 FX: 248.358.0223
EM: INFO@TMP-ARCHITECTURE.COM

REGISTRATION SEAL

CONSULTANT




Peter Basso Associates Inc
CONSULTING ENGINEERS
5145 Livernois, Suite 100
Troy, Michigan 48068-3276
Tel: 248-879-5666
Fax: 248-879-0007
www.PeterBassoAssociates.com
PBA Project No. 2023.0154

PROJECT TITLE
NEW SMITH MIDDLE SCHOOL
Bid Package No. 03B

Troy School District
TROY, MI

DRAWING TITLE
SECOND LEVEL POWER AND AUXILIARY SYSTEMS PLAN - ZONE 'D'

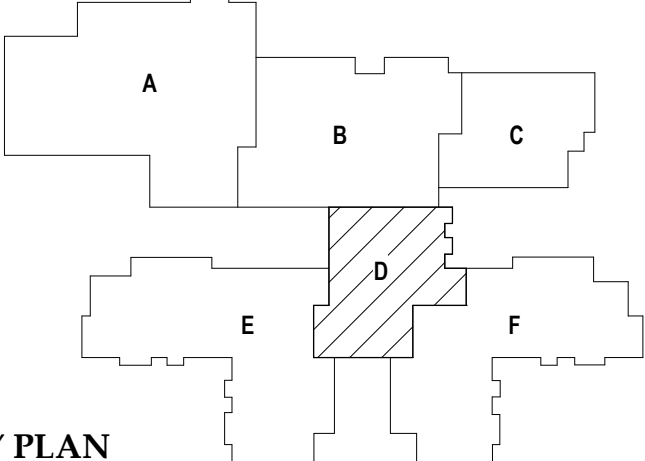

KEY PLAN

ISSUE DATES

DATE	ISSUED FOR:

DATE	ADDENDUM #	CONSTRUCTION DOCUMENTS
07-12-2024		
08-16-2024		

DATE	ISSUED FOR:

DRAWN	DDG


CHECKED	ZDB

APPROVED	STP

PROJECT NO.
22102

DRAWING NO.
E3.2D

THE FOLLOWING DIMENSION EQUALS ONE INCH WHEN PRINTED TO SCALE.

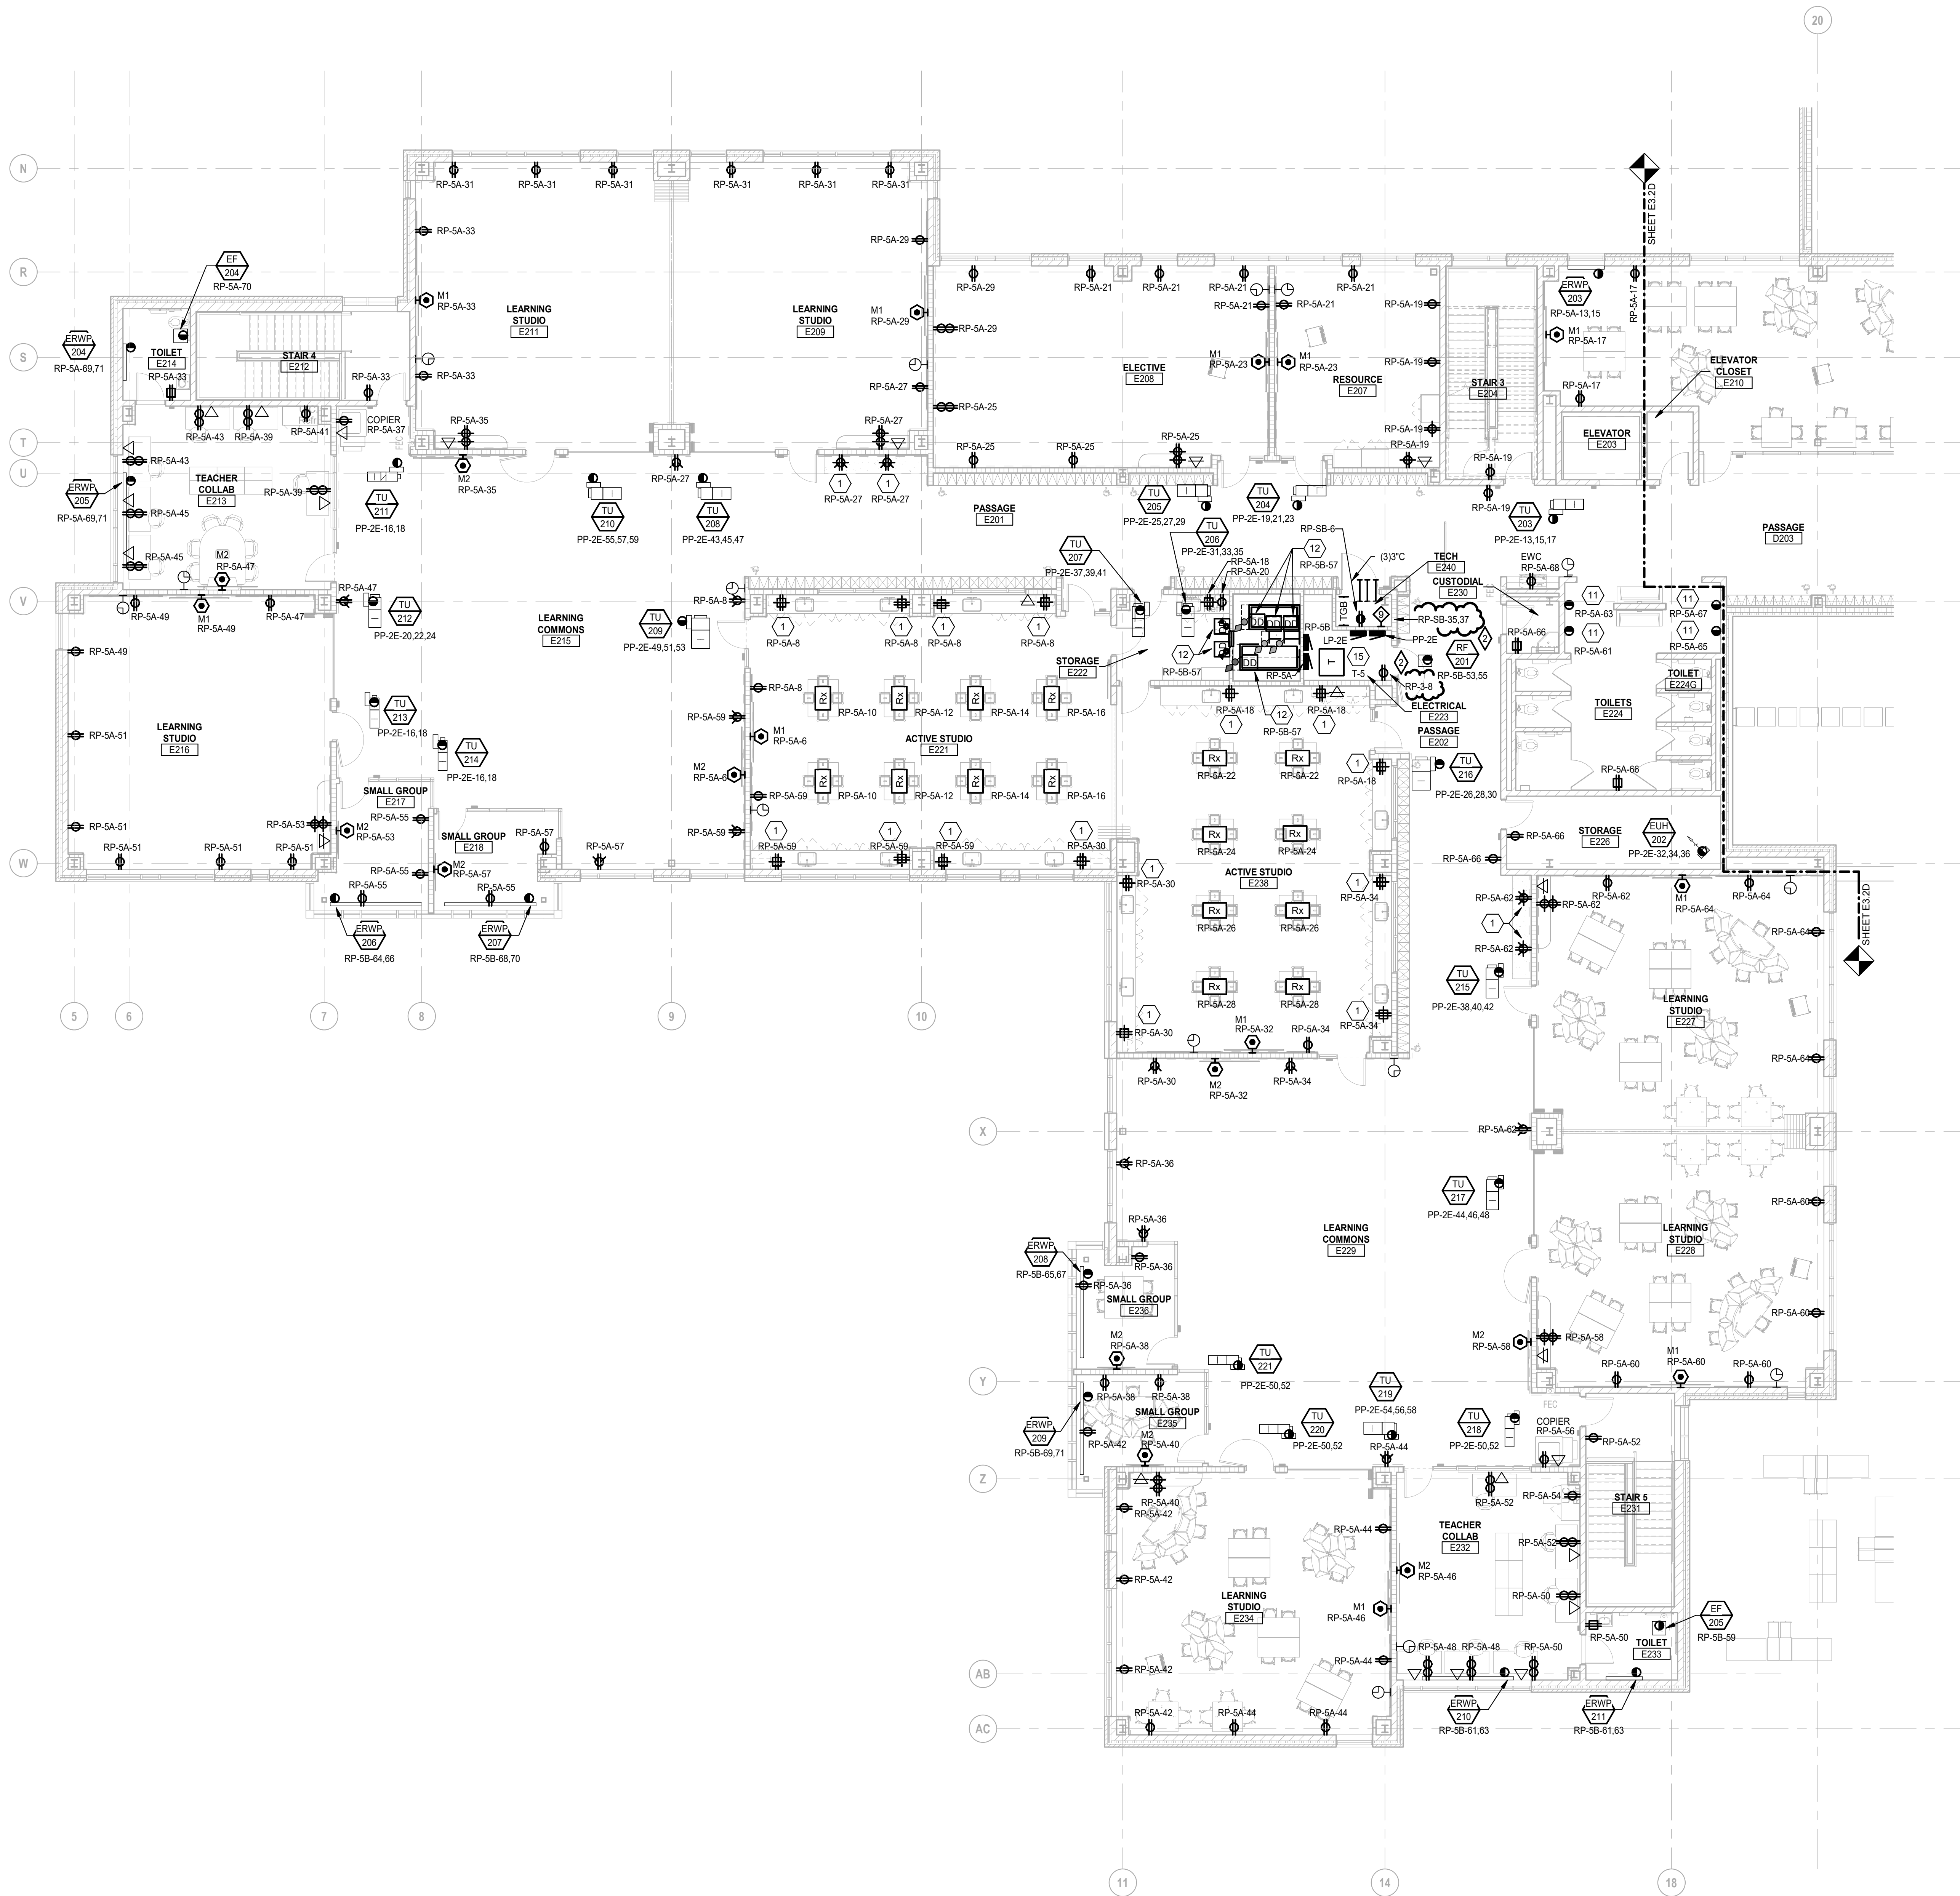

ELECTRICAL GENERAL NOTES:

1. THESE DRAWINGS REPRESENT THE GENERAL EXTENT AND ARRANGEMENT OF SYSTEMS. COORDINATE EXACT EQUIPMENT LOCATIONS, ELEVATIONS, AND FINAL CONNECTION REQUIREMENTS. PROVIDE EACH SYSTEM COMPLETE, INCLUDING ALL NECESSARY COMPONENTS, FITTINGS AND OFFSETS.
2. INSTALL SYSTEMS SUCH THAT REQUIRED CLEARANCE AND SERVICE ACCESS SPACE IS PROVIDED AROUND ALL MECHANICAL AND ELECTRICAL EQUIPMENT, AND AROUND ANY COMPONENTS WHICH REQUIRE SERVICE ACCESS.
3. COORDINATE AND PROVIDE ACCESS DOORS WITHIN INACCESSIBLE CEILING, SHAFT, AND CHASE AREAS FOR ALL COMPONENTS WHICH REQUIRE SERVICE ACCESS. REFER TO ARCHITECTURAL DRAWINGS FOR CEILING TYPES.
4. PROVIDE SUPPLEMENTARY STEEL AS REQUIRED FOR THE PROPER SUPPORT OF ALL SYSTEMS.
5. TRANSFORMER SECONDARY CONDUCTORS SHALL BE SIZED IN ACCORDANCE WITH TRANSFORMER CIRCUIT SIZING SCHEDULE SHOWN ON "ELECTRICAL STANDARD SCHEDULES DRAWING" UNLESS OTHERWISE NOTED.
6. MOTOR CIRCUIT PROTECTION SHALL BE SIZED IN ACCORDANCE WITH MOTOR CIRCUIT SIZING SCHEDULES SHOWN ON "ELECTRICAL STANDARD SCHEDULES DRAWING" UNLESS OTHERWISE NOTED.
7. COORDINATE THE MOUNTING HEIGHTS OF DEVICES WITH ARCHITECTURAL ELEVATIONS AND THE TRADES INSTALLING THE WORK.
8. COORDINATE EXACT LOCATIONS OF ALL FLOOR SERVICE FITTINGS AND POKE-THROUGH ASSEMBLIES WITH FINAL FURNITURE LAYOUT DRAWINGS.
9. REFER TO MECHANICAL SCHEDULE SHEETS FOR ELECTRICAL REQUIREMENTS FOR MECHANICAL EQUIPMENT. PROVIDE ALL CONNECTIONS, STARTERS, DISCONNECTS, ETC. AS REQUIRED BY SCHEDULES AND WHERE NOTED ELSEWHERE. VERIFY REQUIREMENTS OF ALL MECHANICAL EQUIPMENT WITH SHOP DRAWINGS. SUBMITTALS. NOTIFY ENGINEER OF ANY CONFLICTS BETWEEN EQUIPMENT SUBMITTALS AND ELECTRICAL DRAWINGS WHERE CIRCUIT SIZES ARE SHOWN ON THE ELECTRICAL DRAWINGS THAT DIFFER FROM WHAT IS INDICATED ON THE MECHANICAL SCHEDULES. PROVIDE THE CIRCUIT OF HIGHER AMPACITY.
10. REFER TO TEMPERATURE CONTROLS SHEETS FOR REQUIRED FIRE ALARM CONTROL MODULES, DUCT SMOKE DETECTORS, AND MOTOR CONTROLLERS. PROVIDE ALL ACCESSORIES INDICATED.
11. THE FIRE ALARM DEVICES SHOWN ON PLAN ARE A PARTIAL REPRESENTATION OF A COMPLETE AND FUNCTIONAL FIRE ALARM SYSTEM IN ACCORDANCE WITH THE SPECIFICATIONS, DRAWINGS, AND ALL APPLICABLE CODES. THE FIRE ALARM VENDOR SHALL PROVIDE LAYOUT DRAWINGS INDICATING THE REQUIRED QUANTITIES AND LOCATIONS OF MANUAL PULL STATIONS, NOTIFICATION APPLIANCES, SMOKE AND HEAT DETECTORS, CONTROL MODULES, INTERFACE MODULES, MODULES FOR SPRINKLER FLOW AND TAMPER SWITCHES, ALL CONTROL PANELS, POWER SUPPLIES, AND ADDITIONAL DEVICES AND EQUIPMENT REQUIRED. COORDINATE LOCATIONS OF ALL ARCHITECTURAL FINISHES AND REFLECTED CEILING PLANS, INCLUDING ADDITIONAL SMOKE AND HEAT DETECTORS REQUIRED FOR NON-SMOOTH CEILING APPLICATIONS. INCLUDE ALLOWANCES FOR ADJUSTMENT OF HEIGHT AS REQUIRED BY THE ARCHITECT AT THE TIME OF SUBMITTAL TO COORDINATE WITH BUILDING FINISHES AND OTHER CEILING ELEMENTS.
12. REFER TO LIGHTING CONTROL SCHEDULE FOR ROOM CONTROL AND EMERGENCY LIGHTING CIRCUIT CONTROL REQUIREMENTS. DESIGNATION FOR ROOM IS INDICATED AS A LETTERED OVAL SYMBOL.
13. CONNECT EXIT SIGNS TO EMERGENCY LIGHTING BRANCH CIRCUIT SERVICE THE AREA. CONNECT AHEAD OF ANY LIGHTING CONTROL DEVICE OR SYSTEM.
14. PROVIDE SINGLE GANG JUNCTION BOX WITH 3/4" C. PULL STRING AND BUSHING TO ACCESSIBLE CEILING SPACE AT SPEAKER AND CLOCK LOCATIONS. COORDINATE MOUNTING HEIGHT WITH TECHNOLOGY CONTRACTOR.

CONSTRUCTION KEY NOTES:

1. MOUNT RECEPTACLES HORIZONTALLY.
2. ELECTRICAL CONTRACTOR SHALL INSTALL 4" SQUARE JUNCTION BOX WITHIN 3'-0" OF ELECTRICAL BACKBOARD WING UP IN CEILING SPACE. ALSO INSTALL 4 POLE TWIST LOCK, SINGLE RECEPTACLE, PROVIDED BY WINCH MANUFACTURERS, INTO THE JUNCTION BOX.
3. ELECTRICAL CONTRACTOR SHALL INSTALL ALL CONTROLS, PUSHBUTTONS, KEY SWITCHES ETC. (PROVIDED WITH EACH BASKETBALL BACKBOARD), FOR A COMPLETE OPERABLE SYSTEM. KEY SWITCHES GANGED IN PAIRS IN ONE COVER PLATE TO CONTROL THE BACKSTOP SWING AND HEIGHT ADJUSTER.
4. HEAT TRACE, BY OTHERS.
5. DUCT SMOKE DETECTOR SHALL BE FURNISHED AND INSTALLED BY THE ELECTRICAL CONTRACTOR. COORDINATE MOUNTING LOCATION AND QUANTITY WITH THE MECHANICAL DUCTWORK CONTRACTOR. ELECTRICAL CONTRACTOR SHALL WIRE DUCT SMOKE DETECTOR TO SUPPLY/RETURN FAN MOTOR STARTER SO THAT UPON DETECTION OF SMOKE, THE SUPPLY/RETURN FAN WILL SHUT DOWN. THIS SHALL BE ACCOMPLISHED VIA THE FIRE ALARM CONTROL PANEL. PROVIDE ALL REQUIRED CONTROL MODULES AND RELAYS. COORDINATE WITH THE TEMPERATURE CONTROL/FIRE ALARM CONTRACTOR. PROVIDE WEATHER PROOF ENCLOSURES AS REQUIRED.
6. REFER TO ARCHITECTURAL FLOOR PLANS, DOOR HARDWARE SCHEDULE ON ARCHITECTURAL DRAWINGS, ACCESS CONTROL SYSTEM SPECIFICATION SECTION AND ACCESS CONTROL DOOR DIAGRAM(S) ON E7 SERIES FOR RACEWAY AND BACK BOX REQUIREMENTS FOR DOOR OR BANK OF DOORS INDICATED. PROVIDE ALL RACEWAYS AND BACK BOXES REQUIRED. COORDINATE WITH DOOR HARDWARE AND SECURITY CONTRACTORS.
7. PROVIDE 2" AND 1-1/4" O.D. CONDUITS FOR TECHNOLOGY AND AUXILIARY SYSTEM WIRE AS INDICATED. STUB CONDUITS FROM CEILING SPACE. PROVIDE PLASTIC BUSHINGS AT EACH END. PROVIDE REMOVABLE/RESEALABLE FIRE STOP PUTTY IN EACH CONDUIT AND FIRE STOP AROUND EACH CONDUIT. COORDINATE WITH TECHNOLOGY CONTRACTOR FOR EXACT LOCATION OF CONDUIT. PROVIDE MINIMUM OF 1" CONDUIT FOR ALL OTHER AREAS REQUIRING SLEEVES.
8. PROVIDE 1/2" CONDUIT WITH PULL STRING AND BUSHINGS FOR TECHNOLOGY. ROUTE UNDER BUILDING AND TERMINATE AT EXTERIOR OF BUILDING.
9. COORDINATE MOUNTING LOCATION WITH TECHNOLOGY CONTRACTOR.
10. CONNECT FIRE ALARM DEVICES TO ELECTRIC COILING DOOR AND FIRE ALARM SYSTEM. ROLL UP DOOR SHALL CLOSE UPON ACTIVATION OF THE SMOKE DETECTORS ASSOCIATED WITH THE COILING FIRE DOOR. COORDINATE WITH COILING DOOR CONTRACTOR FOR ALL SMOKE DETECTORS AND CONTROL MODULES REQUIRED FOR A COMPLETE SYSTEM.
11. HAND DRYERS FURNISHED BY OTHERS AND INSTALLED BY ELECTRICAL CONTRACTOR. COORDINATE MOUNTING HEIGHT WITH ARCHITECTURAL TRADES.
12. SMOKE DAMPER DUCT SMOKE DETECTOR. SMOKE DETECTOR SHALL BE PROVIDED BY THE ELECTRICAL CONTRACTOR. COORDINATE INSTALLATION WITH MECHANICAL CONTRACTOR SO THAT UPON DETECTION OF SMOKE THE SUPPLY/RETURN FAN WILL SHUT DOWN. ELECTRICAL CONTRACTOR SHALL WIRE DUCT DETECTOR TO FIRE ALARM SYSTEM AND CIRCUIT DAMPER ACTUATOR. PROVIDE A 20A-IP SWITCH AT EACH ACTUATOR. CONTROL OF AIR HANDLING EQUIPMENT IS VIA THE FIRE ALARM CONTROL PANEL. PROVIDE ALL REQUIRED CONTROL MODULES AND RELAYS. COORDINATE WORK WITH THE TEMPERATURE CONTROLS CONTRACTOR AND FIRE ALARM MANUFACTURER. DAMPER SHALL CLOSE UPON DETECTION OF SMOKE AND SHUT DOWN ASSOCIATED AIR HANDLER. DAMPER SHALL ALSO CLOSE UPON MANUAL SHUTDOWN OF AIR HANDLER.
13. CARBON MONOXIDE DETECTOR. COORDINATE QUANTITY WITH FIRE MARSHAL.
14. SCOREBOARD. COORDINATE EXACT LOCATION WITH ARCHITECT PRIOR TO ROUGH IN.
15. WALL MOUNT TRANSFORMER.
16. ELECTRIC RANGE. PROVIDE WALL MOUNTED GFCI MODULE ABOVE COUNTER.
17. LIGHTING RELAY PANEL FOR THEATRICAL LIGHTING SYSTEM. REFER TO THEATRICAL LIGHTING EQUIPMENT DRAWINGS.



TMP ARCHITECTURE INC
1191 WEST SQUARE LAKE ROAD - BOX 289
BLOOMFIELD HILLS - MICHIGAN - 48302
PH: 248.338.6941 | FX: 248.338.0223
EM: INFO@TMPARCHITECTURE.COM

REGISTRATION SEAL


CONSULTANT

Peter Basso Associates Inc
CONSULTING ENGINEERS
5145 Livernois, Suite 100
Troy, Michigan 48068-3276
Tel: 248-879-5666
Fax: 248-879-0007
www.PeterBassoAssociates.com
PBA Project No. 2023.0154

PROJECT TITLE
NEW SMITH MIDDLE SCHOOL
Bid Package No. 03B

Troy School District
TROY, MI

DRAWING TITLE
SECOND LEVEL POWER AND AUXILIARY SYSTEMS PLAN - ZONE 'E'

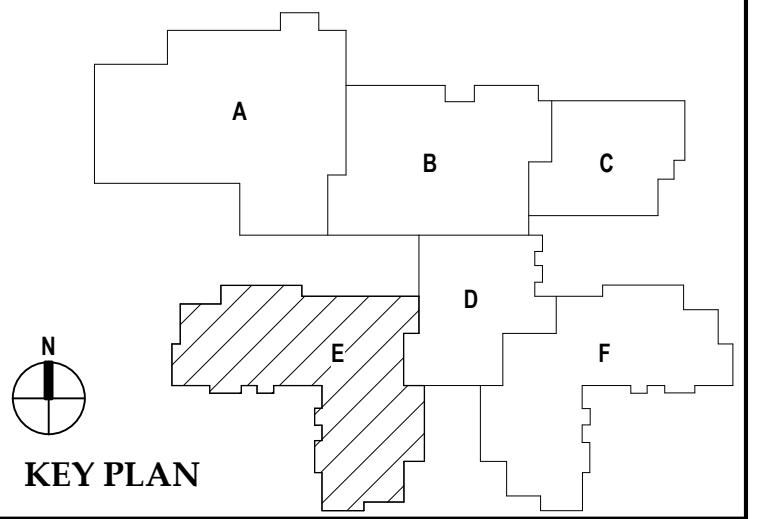

ISSUE DATES

DATE	ISSUED FOR:
07-12-2024	ADDENDUM #2
08-16-2024	CONSTRUCTION DOCUMENTS

DATE	ISSUED FOR:

PROJECT NO.
22102
DRAWING NO.
E3.2E

SECOND LEVEL POWER AND AUXILIARY SYSTEMS PLAN - ZONE 'E'
SCALE: 1/8" = 1'-0"

CONSTRUCTION KEY NOTES:

DIAGRAM GENERAL NOTES:

- 1. PORTABLE GENERATOR DOCKING STATION.
2. LISTED 2 HOUR FIRE-RATED CONDUIT AND CABLING ASSEMBLY PER 700.10(D).
3. SEPARATE VERTICAL SECTIONS PER 700.10(B)(6).
4. PROVIDE GENERATOR PROTECTION RELAYS.
5. PRE-PURCHASED EQUIPMENT COORDINATE WITH OWNER AND CONSTRUCTION MANAGER.

- 1. THESE DRAWINGS REPRESENT THE GENERAL EXTENT AND ARRANGEMENT OF SYSTEMS. COORDINATE EXACT EQUIPMENT LOCATIONS, ELEVATIONS, AND FINAL CONNECTION REQUIREMENTS. PROVIDE EACH SYSTEM COMPLETE, INCLUDING ALL NECESSARY COMPONENTS, FITTINGS AND OFFSETS.
2. FEEDER AND BRANCH CIRCUIT CONDUCTORS SHALL BE SIZED IN ACCORDANCE WITH THE 'FEEDER AND BRANCH CIRCUIT SIZING SCHEDULE-GENERAL PURPOSE' ON THE 'ELECTRICAL STANDARD SCHEDULES DRAWING' UNLESS SPECIFICALLY NOTED OTHERWISE.
3. TRANSFORMER SECONDARY CONDUCTORS SHALL BE SIZED IN ACCORDANCE WITH THE 'TRANSFORMER CIRCUIT SIZING SCHEDULE-GENERAL PURPOSE' ON THE 'ELECTRICAL STANDARD SCHEDULES DRAWING' UNLESS SPECIFICALLY NOTED OTHERWISE.
4. MOTOR CIRCUIT PROTECTION SHALL BE SIZED IN ACCORDANCE WITH THE MOTOR CIRCUIT SIZING SCHEDULES ON THE 'ELECTRICAL STANDARD SCHEDULES DRAWING' UNLESS SPECIFICALLY NOTED OTHERWISE.
5. BASIS OF DESIGN IS EATON DISTRIBUTION EQUIPMENT AND ASCO TRANSFER SWITCHES. IF THE CONTRACTOR ELECTS TO PROVIDE EQUIPMENT FROM OTHER APPROVED MANUFACTURERS, THE CONTRACTOR SHALL BE RESPONSIBLE TO COORDINATE THE LAYOUT AND CLEARANCE REQUIREMENTS IN ALL SPACES CONTAINING ELECTRICAL EQUIPMENT AND PROVIDE EQUIPMENT MEETING THE SPECIFICATIONS AND ACHIEVING CODE REQUIRED CLEARANCES WITHIN THE SPACE PROVIDED.
6. VARIABLE FREQUENCY CONTROLLERS (VFC) FURNISHED BY MECHANICAL TRADES. ELECTRICAL CONTRACTOR SHALL INSTALL VFC, PROVIDE POWER FEEDER FROM DISTRIBUTION EQUIPMENT TO VFC AND PROVIDE POWER FEEDER FROM VFC TO MOTOR. REFER TO SPECIFICATIONS FOR APPLICATION OF VFC POWER CABLE FROM VFC TO MOTOR.



TMP ARCHITECTURE INC
1191 WEST SQUARE LAKE ROAD - BOX 289
BLOOMFIELD HILLS - MICHIGAN 48302
TEL: 248-338-8661 FAX: 248-338-0223
EM: INFO@TMP-ARCHITECTURE.COM

REGISTRATION SEAL

CONSULTANT



Peter Basso Associates Inc
CONSULTING ENGINEERS
5145 Livernois, Suite 200
Troy, Michigan 48068-5276
Tel: 248-879-5666
Fax: 248-879-0007
www.PeterBassoAssociates.com
PBA Project No. 20230354

PROJECT TITLE
NEW SMITH
MIDDLE SCHOOL
Bid Package No. 03B

Troy School District
Troy, Michigan

DRAWING TITLE
ONE LINE DIAGRAM

ISSUE DATES

07-12-2024 ADDENDUM #2
06-18-2024 CONSTRUCTION DOCUMENTS

DATE: ISSUED FOR:

DRAWN DDB


CHECKED ZDB

APPROVED STP

PROJECT NO.
22102

DRAWING NO.
E5.1

g:\2023\2023-0154-00\CAD\2023-0154-E5-DC.dwg, E5.1, 7/11/2024 2:22:09 PM, Suha A. Matti, None_0.09448, Peter Basso Associates Inc.

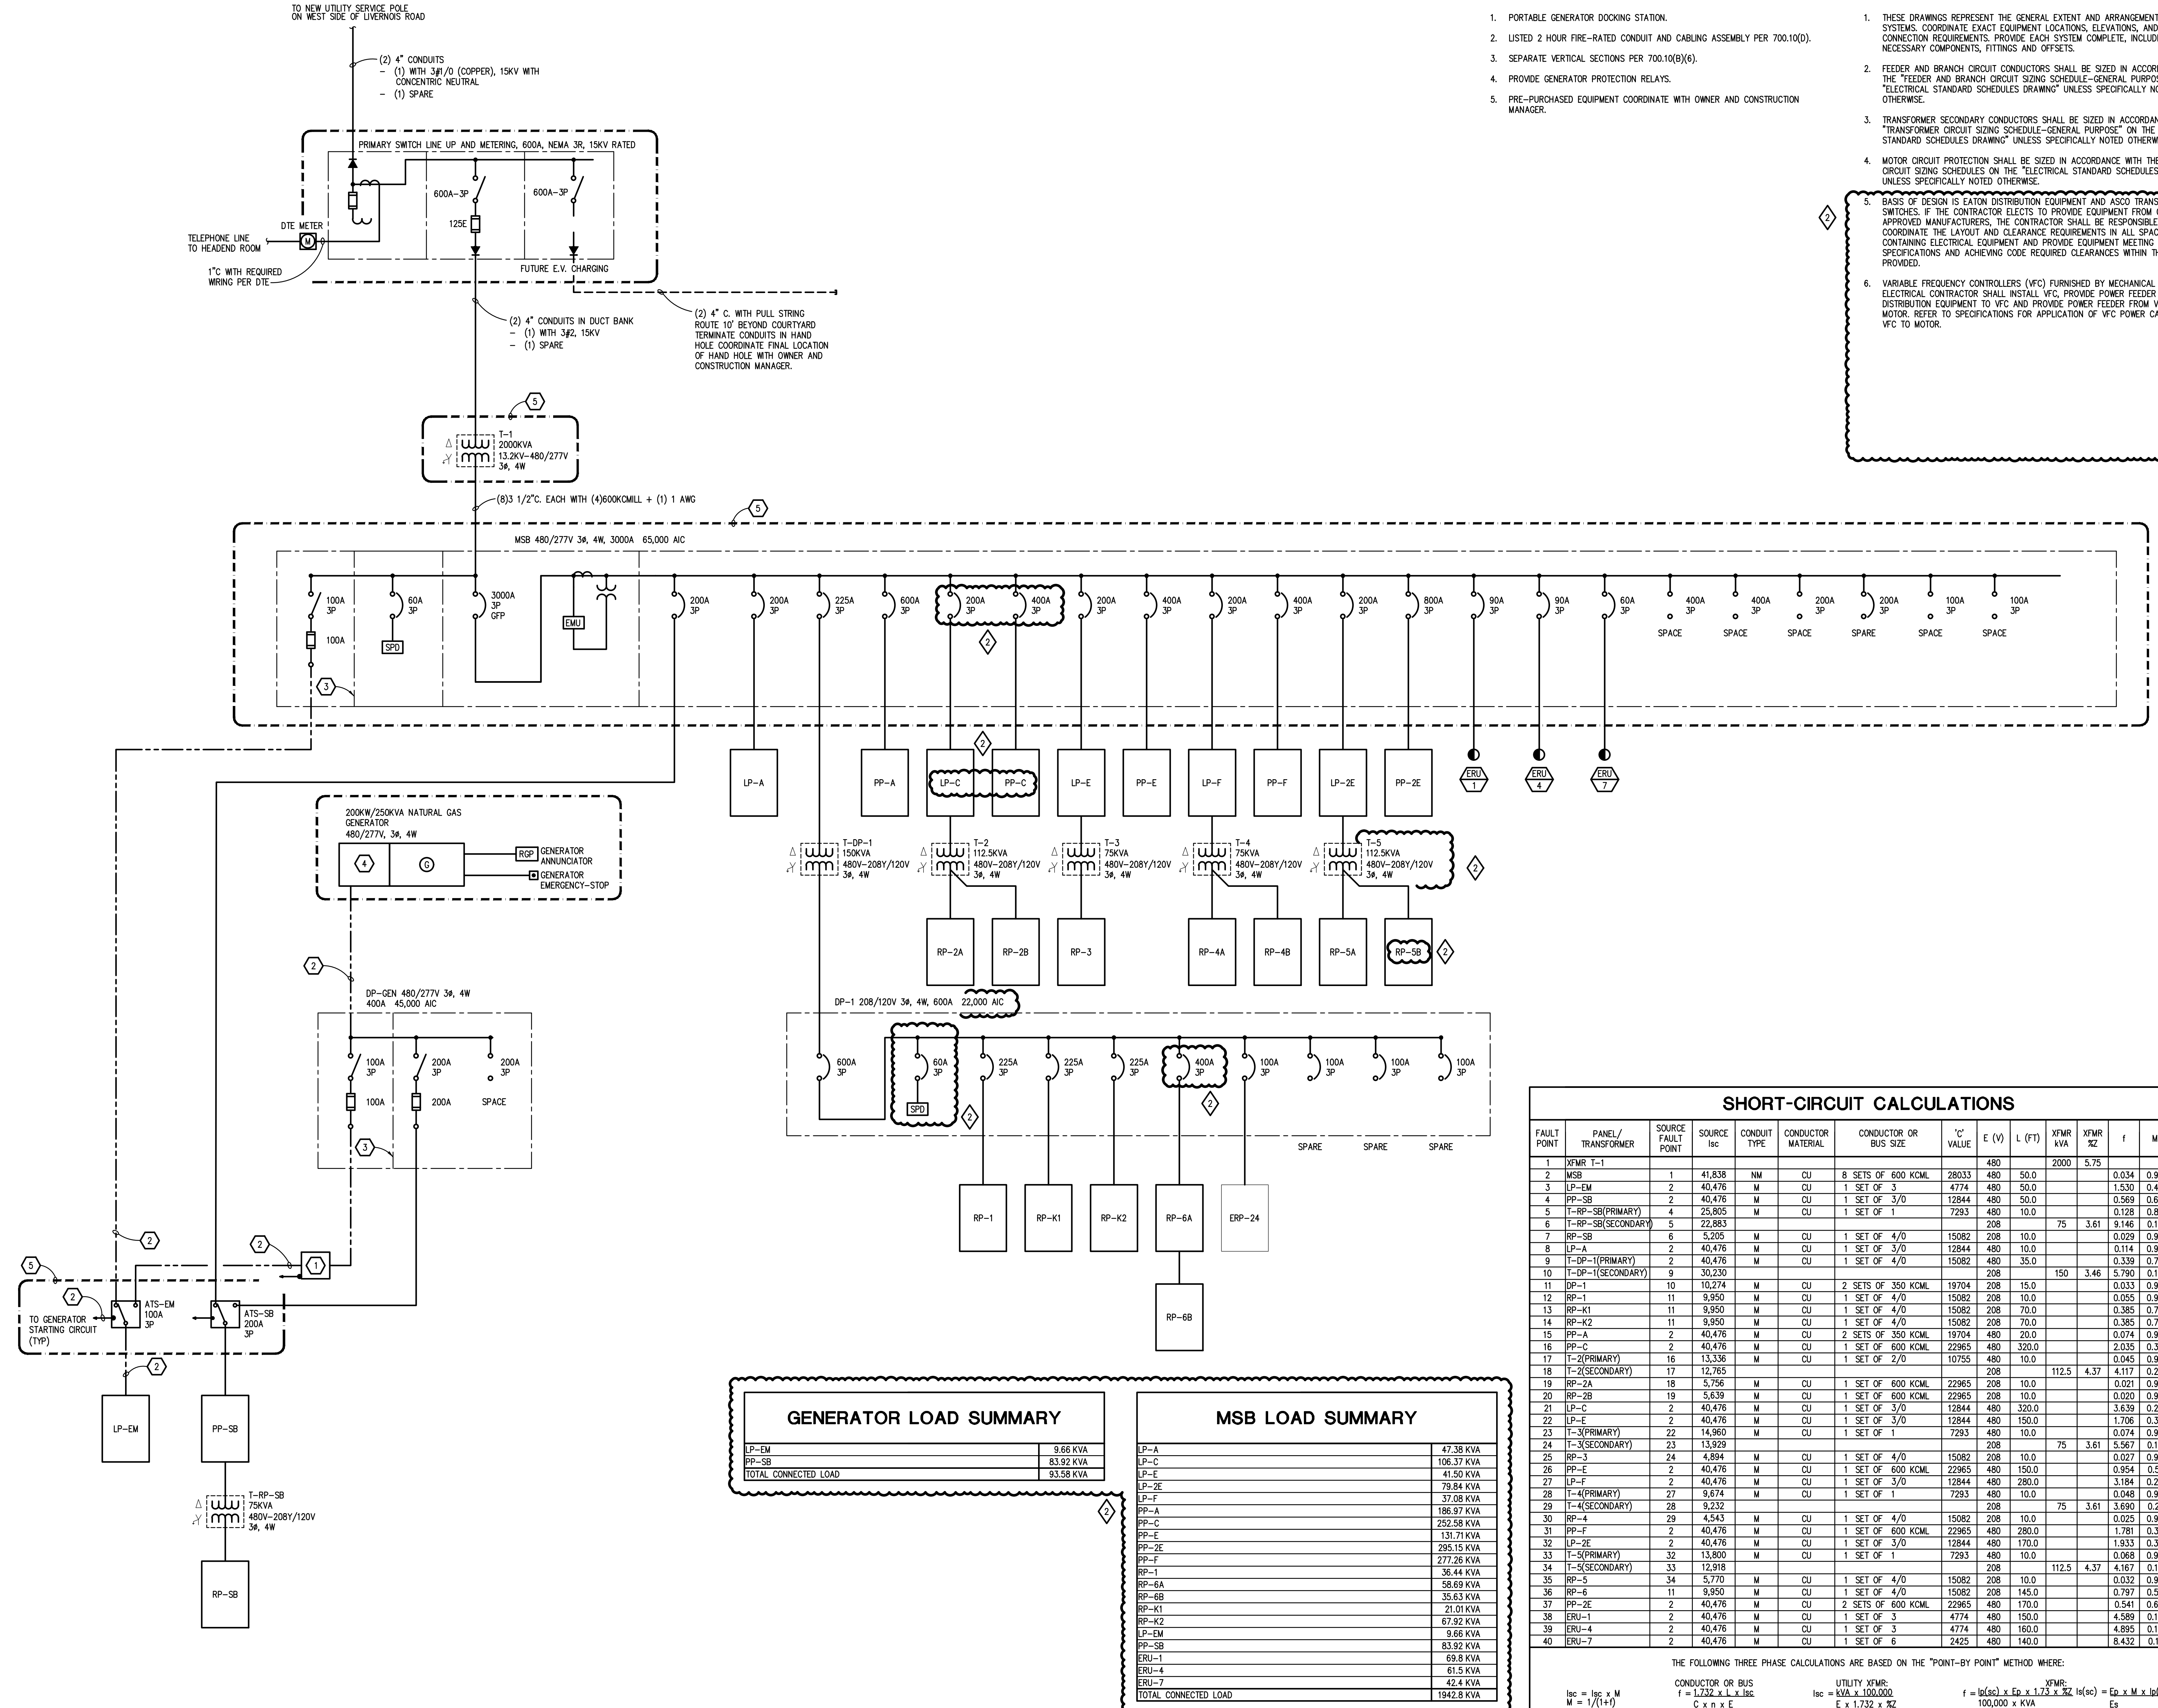

GENERATOR LOAD SUMMARY table with columns for load name and kVA. Loads include LP-EM (9.66 kVA), PP-SB (83.92 kVA), and total connected load (93.58 kVA).

MSB LOAD SUMMARY table with columns for load name and kVA. Loads include LP-A (47.38 kVA), LP-C (106.37 kVA), LP-E (41.50 kVA), LP-F (79.84 kVA), LP-EM (37.08 kVA), LP-F (186.97 kVA), LP-F (252.58 kVA), LP-E (131.71 kVA), PP-2E (291.15 kVA), PP-2E (277.26 kVA), RP-1 (36.44 kVA), RP-6A (58.69 kVA), RP-6B (35.63 kVA), RP-K1 (21.01 kVA), RP-K2 (67.92 kVA), LP-EM (9.66 kVA), PP-SB (83.92 kVA), ERU-1 (69.8 kVA), ERU-4 (61.5 kVA), ERU-7 (42.4 kVA), and total connected load (1942.8 kVA).

SHORT-CIRCUIT CALCULATIONS table with columns for fault point, panel/transformer, source fault point, source kVA, conduit type, conductor material, conductor or bus size, 'c' value, E (V), L (FT), XFR kVA, XFR XZ, f, M, and Isc.

THE FOLLOWING THREE PHASE CALCULATIONS ARE BASED ON THE 'POINT-BY-POINT' METHOD WHERE:
Isc = Isc x M
f = 1/(1+f)
UTILITY XFR: Isc = kVA x 100,000 / E x 1.732 x XZ
XFR: f = Isp(s) x Ep x 1.73 x XZ / 100,000 x kVA
Isc = Ep x M x Isp(s) / Es
L = LENGTH (ft) OF CONDUCTOR, C = CONSTANT FROM TABLE, n = NUMBER OF CONDUCTORS PER PHASE
Isc = AVAILABLE SHORT CIRCUIT (A), E = VOLTAGE OF CIRCUIT
Copyright 2021 by Peter Basso Associates, Inc.



TMP ARCHITECTURE INC
1191 WEST SQUARE LAKE ROAD - BOX 289
BLOOMFIELD HILLS - MICHIGAN 48302
PH: 248-338-6161 FX: 248-338-0223
EM: INFO@TMP-ARCHITECTURE.COM

REGISTRATION SEAL

CONSULTANT



Peter Basso Associates Inc
CONSULTING ENGINEERS
5145 Livorno, Suite 100
Troy, Michigan 48068-3276
Tel: 248-679-5666 Fax: 248-679-0007
www.PeterBassoAssociates.com
PBA Project No. 2023.0154

PROJECT TITLE
NEW SMITH MIDDLE SCHOOL
Bid Package No. 03B

Troy School District
TROY, MI

DRAWING TITLE
PANEL SCHEDULES

ISSUE DATES

07-12-2024 ADDENDUM #2
08-16-2024 CONSTRUCTION DOCUMENTS

DATE ISSUED FOR:

DRAWN DDB

CHECKED ZDB

APPROVED STP

PROJECT NO.
22102

DRAWING NO.
E5.2

PANELBOARD LP-EM table with columns: #, LOAD TYPE, DESCRIPTION, CB TYPE, CB, A, B, C, CB, CB TYPE, DESCRIPTION, LOAD TYPE, #. Includes bus ampacity, main type, minimum A.I.C., mounting, and calculated loads.

Summary table for PANELBOARD LP-EM showing demand factor, calculated load, and feeder and overcurrent information.

PANELBOARD LP-A table with columns: #, LOAD TYPE, DESCRIPTION, CB TYPE, CB, A, B, C, CB, CB TYPE, DESCRIPTION, LOAD TYPE, #. Includes bus ampacity, main type, minimum A.I.C., mounting, and calculated loads.

Summary table for PANELBOARD LP-A showing demand factor, calculated load, and feeder and overcurrent information.

PANELBOARD LP-F table with columns: #, LOAD TYPE, DESCRIPTION, CB TYPE, CB, A, B, C, CB, CB TYPE, DESCRIPTION, LOAD TYPE, #. Includes bus ampacity, main type, minimum A.I.C., mounting, and calculated loads.

Summary table for PANELBOARD LP-F showing demand factor, calculated load, and feeder and overcurrent information.

PANELBOARD PP-SB table with columns: #, LOAD TYPE, DESCRIPTION, CB TYPE, CB, A, B, C, CB, CB TYPE, DESCRIPTION, LOAD TYPE, #. Includes bus ampacity, main type, minimum A.I.C., mounting, and calculated loads.

Summary table for PANELBOARD PP-SB showing demand factor, calculated load, and feeder and overcurrent information.

PANELBOARD LP-C table with columns: #, LOAD TYPE, DESCRIPTION, CB TYPE, CB, A, B, C, CB, CB TYPE, DESCRIPTION, LOAD TYPE, #. Includes bus ampacity, main type, minimum A.I.C., mounting, and calculated loads.

Summary table for PANELBOARD LP-C showing demand factor, calculated load, and feeder and overcurrent information.

PANELBOARD LP-2E table with columns: #, LOAD TYPE, DESCRIPTION, CB TYPE, CB, A, B, C, CB, CB TYPE, DESCRIPTION, LOAD TYPE, #. Includes bus ampacity, main type, minimum A.I.C., mounting, and calculated loads.

Summary table for PANELBOARD LP-2E showing demand factor, calculated load, and feeder and overcurrent information.

PANELBOARD RP-SB table with columns: #, LOAD TYPE, DESCRIPTION, CB TYPE, CB, A, B, C, CB, CB TYPE, DESCRIPTION, LOAD TYPE, #. Includes bus ampacity, main type, minimum A.I.C., mounting, and calculated loads.

Summary table for PANELBOARD RP-SB showing demand factor, calculated load, and feeder and overcurrent information.

PANELBOARD LP-E table with columns: #, LOAD TYPE, DESCRIPTION, CB TYPE, CB, A, B, C, CB, CB TYPE, DESCRIPTION, LOAD TYPE, #. Includes bus ampacity, main type, minimum A.I.C., mounting, and calculated loads.

Summary table for PANELBOARD LP-E showing demand factor, calculated load, and feeder and overcurrent information.

PANELBOARD PP-A table with columns: #, LOAD TYPE, DESCRIPTION, CB TYPE, CB, A, B, C, CB, CB TYPE, DESCRIPTION, LOAD TYPE, #. Includes bus ampacity, main type, minimum A.I.C., mounting, and calculated loads.

Summary table for PANELBOARD PP-A showing demand factor, calculated load, and feeder and overcurrent information.



TMP ARCHITECTURE INC
1191 WEST SQUARE LAKE ROAD - BOX 289
BLOOMFIELD HILLS - MICHIGAN - 48302
TEL: 248-338-6941 FAX: 248-338-0223
EM: INFO@TMPARCHITECTURE.COM

REGISTRATION SEAL

CONSULTANT



Peter Basso Associates Inc
CONSULTING ENGINEERS
5145 Livernois, Suite 100
Troy, Michigan 48068-3276
Tel: 248-979-5666
Fax: 248-979-0007
www.PeterBassoAssociates.com
PBA Project No. 2023.0154

PROJECT TITLE
NEW SMITH MIDDLE SCHOOL
Bid Package No. 03B

Troy School District
TROY, MI

DRAWING TITLE
PANEL SCHEDULES

ISSUE DATES

07-12-2024 ADDENDUM #2
08-16-2024 CONSTRUCTION DOCUMENTS

DATE: ISSUED FOR:

DRAWN: DDB

CHECKED: ZDB

APPROVED: STP

PROJECT NO.
22102

DRAWING NO.
E5.3

PANELBOARD PP-2E table with columns for #, LOAD TYPE, DESCRIPTION, CB TYPE, CB, A, B, C, CB, CB TYPE, DESCRIPTION, LOAD TYPE, #. Includes panelboard information, branch circuit connected load, demand factor, calculated load, feeder and overcurrent, notes, and panelboard location.

PANELBOARD PP-2E table with columns for #, LOAD TYPE, DESCRIPTION, CB TYPE, CB, A, B, C, CB, CB TYPE, DESCRIPTION, LOAD TYPE, #. Includes panelboard information, branch circuit connected load, demand factor, calculated load, feeder and overcurrent, notes, and panelboard location.

PANELBOARD PP-E table with columns for #, LOAD TYPE, DESCRIPTION, CB TYPE, CB, A, B, C, CB, CB TYPE, DESCRIPTION, LOAD TYPE, #. Includes panelboard information, branch circuit connected load, demand factor, calculated load, feeder and overcurrent, notes, and panelboard location.

PANELBOARD RP-1 table with columns for #, LOAD TYPE, DESCRIPTION, CB TYPE, CB, A, B, C, CB, CB TYPE, DESCRIPTION, LOAD TYPE, #. Includes panelboard information, branch circuit connected load, demand factor, calculated load, feeder and overcurrent, notes, and panelboard location.

PANELBOARD RP-2B table with columns for #, LOAD TYPE, DESCRIPTION, CB TYPE, CB, A, B, C, CB, CB TYPE, DESCRIPTION, LOAD TYPE, #. Includes panelboard information, branch circuit connected load, demand factor, calculated load, feeder and overcurrent, notes, and panelboard location.

PANELBOARD RP-3 table with columns for #, LOAD TYPE, DESCRIPTION, CB TYPE, CB, A, B, C, CB, CB TYPE, DESCRIPTION, LOAD TYPE, #. Includes panelboard information, branch circuit connected load, demand factor, calculated load, feeder and overcurrent, notes, and panelboard location.

7/11/2024 2:10:21 PM Autodesk Docs/22102_Troy_Smith MS/2024-0154_TSD_Smith MS_MEP_v02.rvt



TMP ARCHITECTURE INC
1391 WEST SQUARE LAKE ROAD - BOX 289
BLOOMFIELD HILLS - MICHIGAN 48302
P.O. BOX 384661 | TX: 214.358.0223
EM-INFO@TMPARCHITECTURE.COM

REGISTRATION SEAL

CONSULTANT



Peter Basso Associates Inc
CONSULTING ENGINEERS
5145 Livernois, Suite 100
Troy, Michigan 48068-3276
Tel: 248-879-5566 Fax: 248-879-0007
www.PeterBassoAssociates.com
PBA Project No. 2023.0354

PROJECT TITLE
**NEW SMITH
MIDDLE SCHOOL**
Bid Package No. 03B

Troy School District
TROY, MI

DRAWING TITLE
PANEL SCHEDULES

ISSUE DATES table with columns for date, description, and author.

DATE ISSUED FOR: 07-12-2024

DRAWN DDB
CHECKED ZDB
APPROVED STP

PROJECT NO.
22102
DRAWING NO.
E5.4

PANELBOARD RP-5A table with columns for #, LOAD TYPE, DESCRIPTION, CB TYPE, CB, A, B, C, CB, CB TYPE, DESCRIPTION, LOAD TYPE, #. Includes summary table below with totals: TOTAL (kVA): 36.01, TOTAL: 97.28.

PANELBOARD INFORMATION table with columns for PANELBOARD INFORMATION, BRANCH CIRCUIT CONNECTED LOAD, DEMAND CALCULATED FACTOR LOAD, FEEDER AND OVERCURRENT, NOTES. Includes summary table below with totals: TOTAL (kVA): 36.01, TOTAL: 97.28.

PANELBOARD RP-K2 table with columns for #, LOAD TYPE, DESCRIPTION, CB TYPE, CB, A, B, C, CB, CB TYPE, DESCRIPTION, LOAD TYPE, #. Includes summary table below with totals: TOTAL (kVA): 87.82, TOTAL: 188.52.

PANELBOARD INFORMATION table with columns for PANELBOARD INFORMATION, BRANCH CIRCUIT CONNECTED LOAD, DEMAND CALCULATED FACTOR LOAD, FEEDER AND OVERCURRENT, NOTES. Includes summary table below with totals: TOTAL (kVA): 87.82, TOTAL: 188.52.

PANELBOARD RP-K1 table with columns for #, LOAD TYPE, DESCRIPTION, CB TYPE, CB, A, B, C, CB, CB TYPE, DESCRIPTION, LOAD TYPE, #. Includes summary table below with totals: TOTAL (kVA): 21.81, TOTAL: 58.32.

PANELBOARD INFORMATION table with columns for PANELBOARD INFORMATION, BRANCH CIRCUIT CONNECTED LOAD, DEMAND CALCULATED FACTOR LOAD, FEEDER AND OVERCURRENT, NOTES. Includes summary table below with totals: TOTAL (kVA): 21.81, TOTAL: 58.32.

PANELBOARD PP-F table with columns for #, LOAD TYPE, DESCRIPTION, CB TYPE, CB, A, B, C, CB, CB TYPE, DESCRIPTION, LOAD TYPE, #. Includes summary table below with totals: TOTAL (kVA): 277.26, TOTAL: 333.49.









PANELBOARD INFORMATION table with columns for PANELBOARD INFORMATION, BRANCH CIRCUIT CONNECTED LOAD, DEMAND CALCULATED FACTOR LOAD, FEEDER AND OVERCURRENT, NOTES. Includes summary table below with totals: TOTAL (kVA): 277.26, TOTAL: 333.49.

PANELBOARD RP-2A table with columns for #, LOAD TYPE, DESCRIPTION, CB TYPE, CB, A, B, C, CB, CB TYPE, DESCRIPTION, LOAD TYPE, #. Includes summary table below with totals: TOTAL (kVA): 87.82, TOTAL: 87.28.

PANELBOARD INFORMATION table with columns for PANELBOARD INFORMATION, BRANCH CIRCUIT CONNECTED LOAD, DEMAND CALCULATED FACTOR LOAD, FEEDER AND OVERCURRENT, NOTES. Includes summary table below with totals: TOTAL (kVA): 87.82, TOTAL: 87.28.

PANELBOARD RP-4A table with columns for #, LOAD TYPE, DESCRIPTION, CB TYPE, CB, A, B, C, CB, CB TYPE, DESCRIPTION, LOAD TYPE, #. Includes summary table below with totals: TOTAL (kVA): 27.31, TOTAL: 75.80.


PANELBOARD INFORMATION table with columns for PANELBOARD INFORMATION, BRANCH CIRCUIT CONNECTED LOAD, DEMAND CALCULATED FACTOR LOAD, FEEDER AND OVERCURRENT, NOTES. Includes summary table below with totals: TOTAL (kVA): 27.31, TOTAL: 75.80.

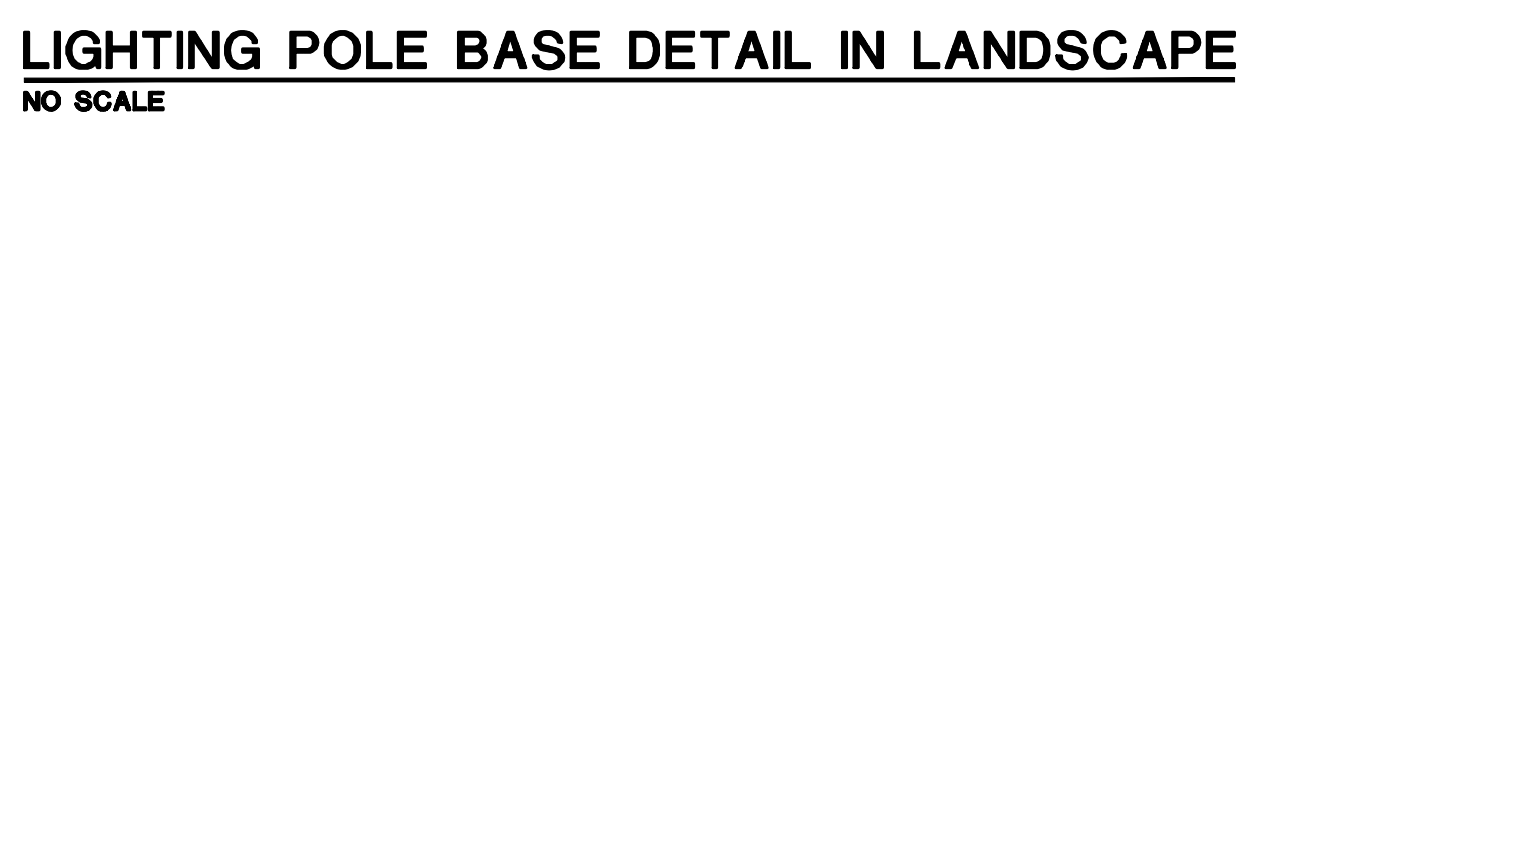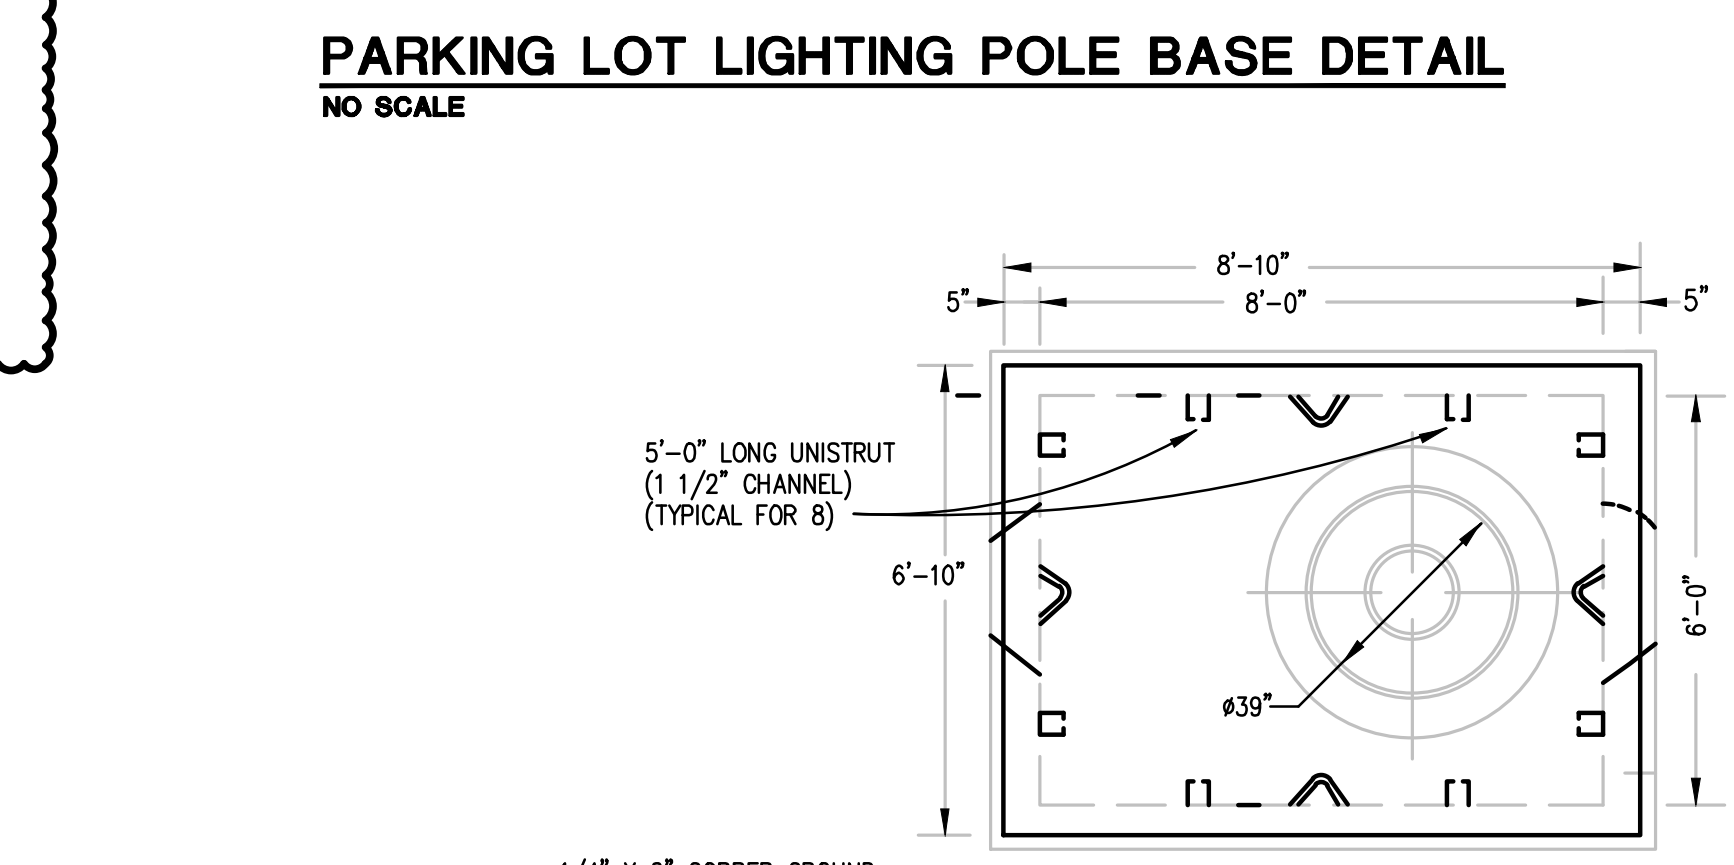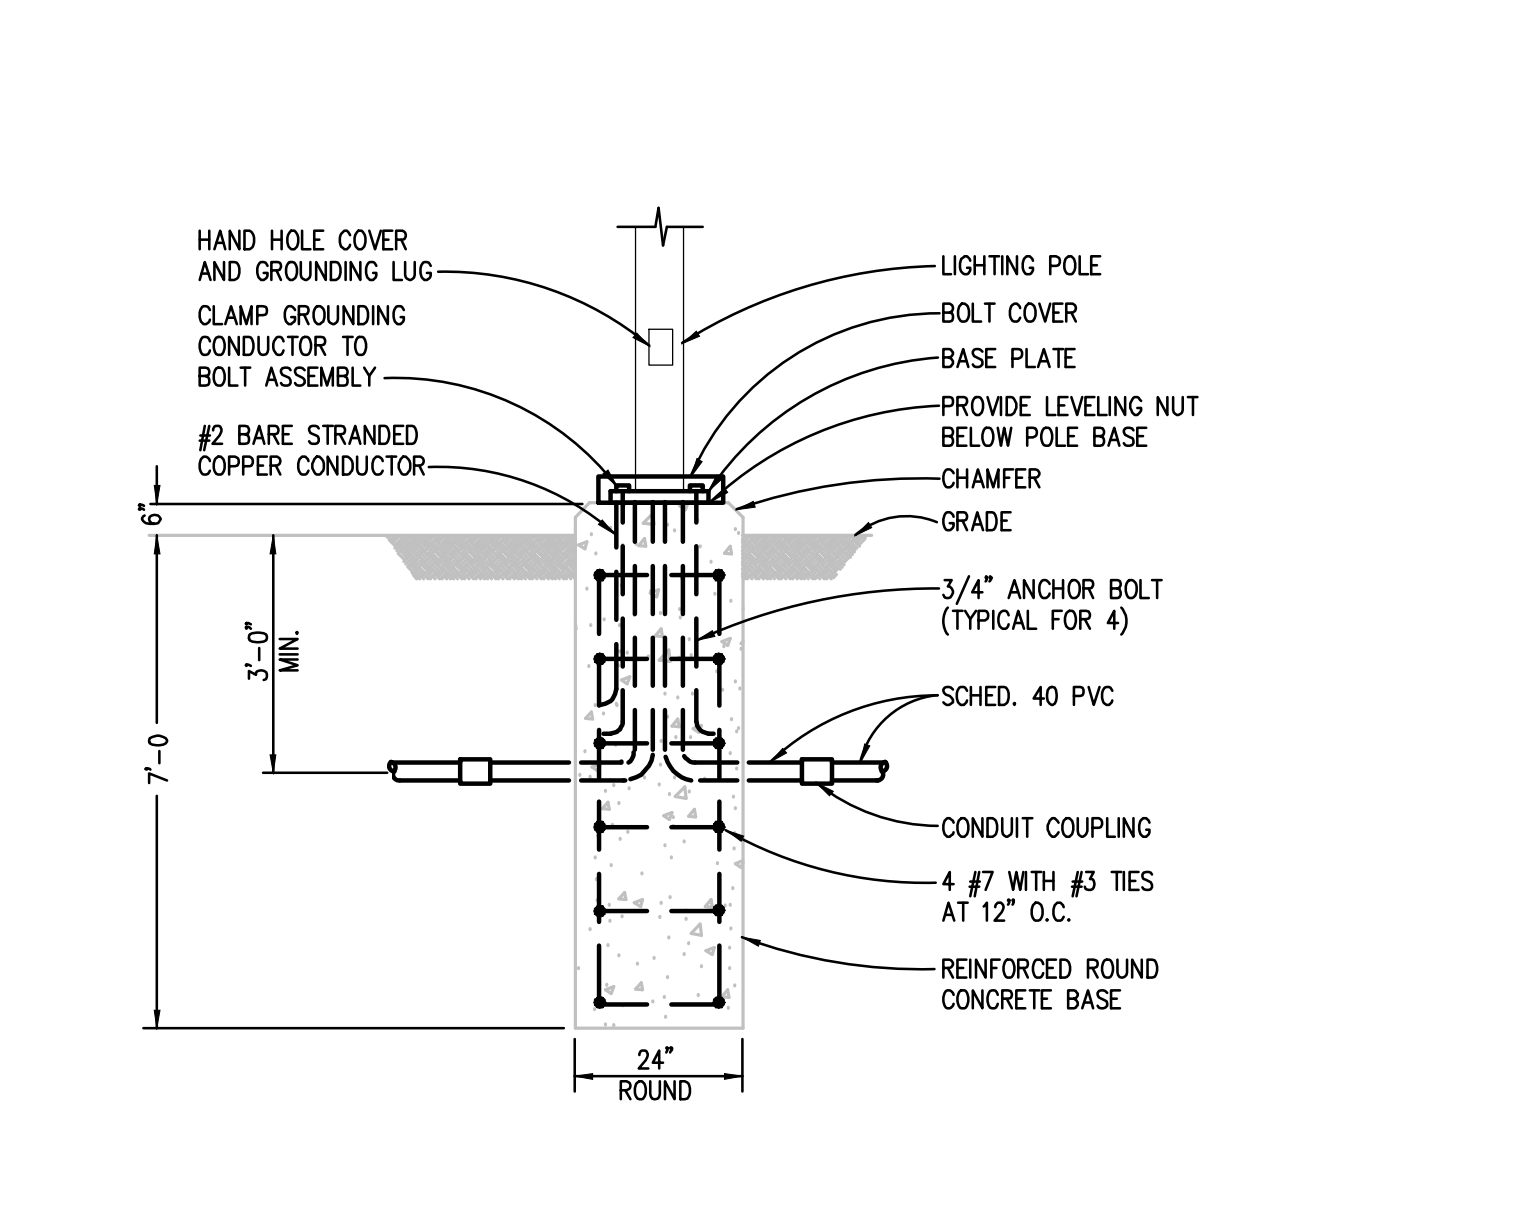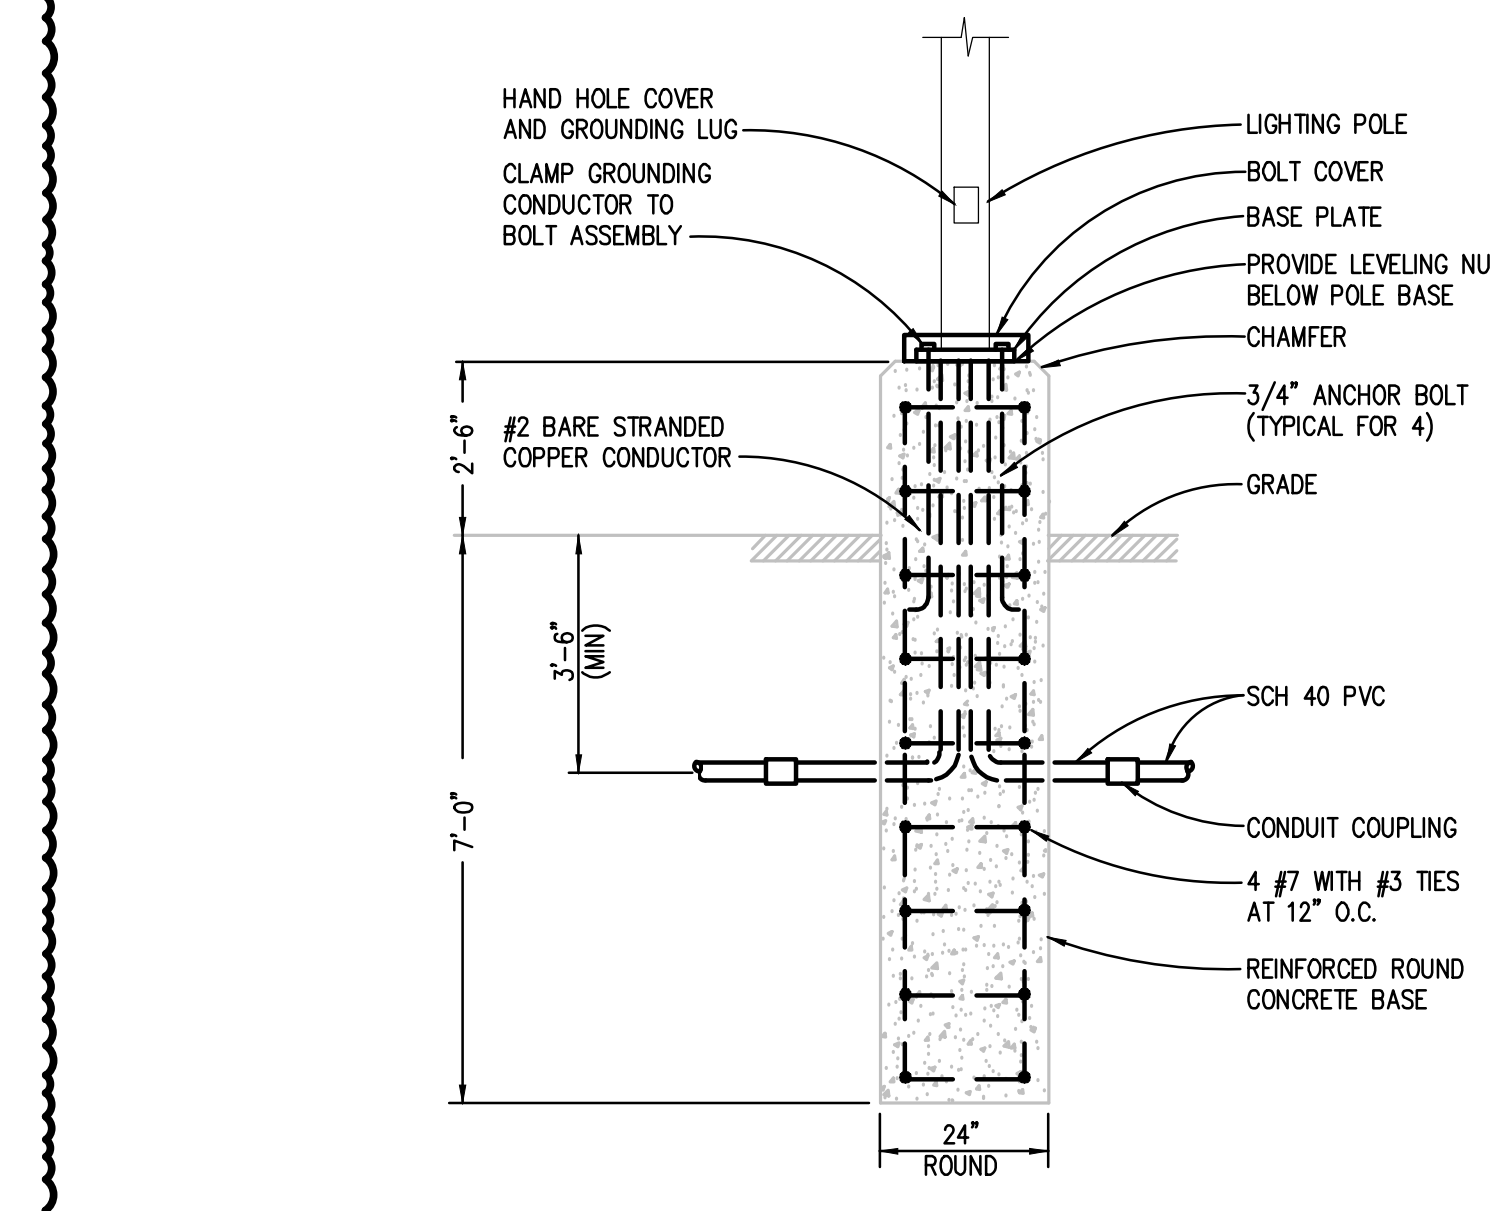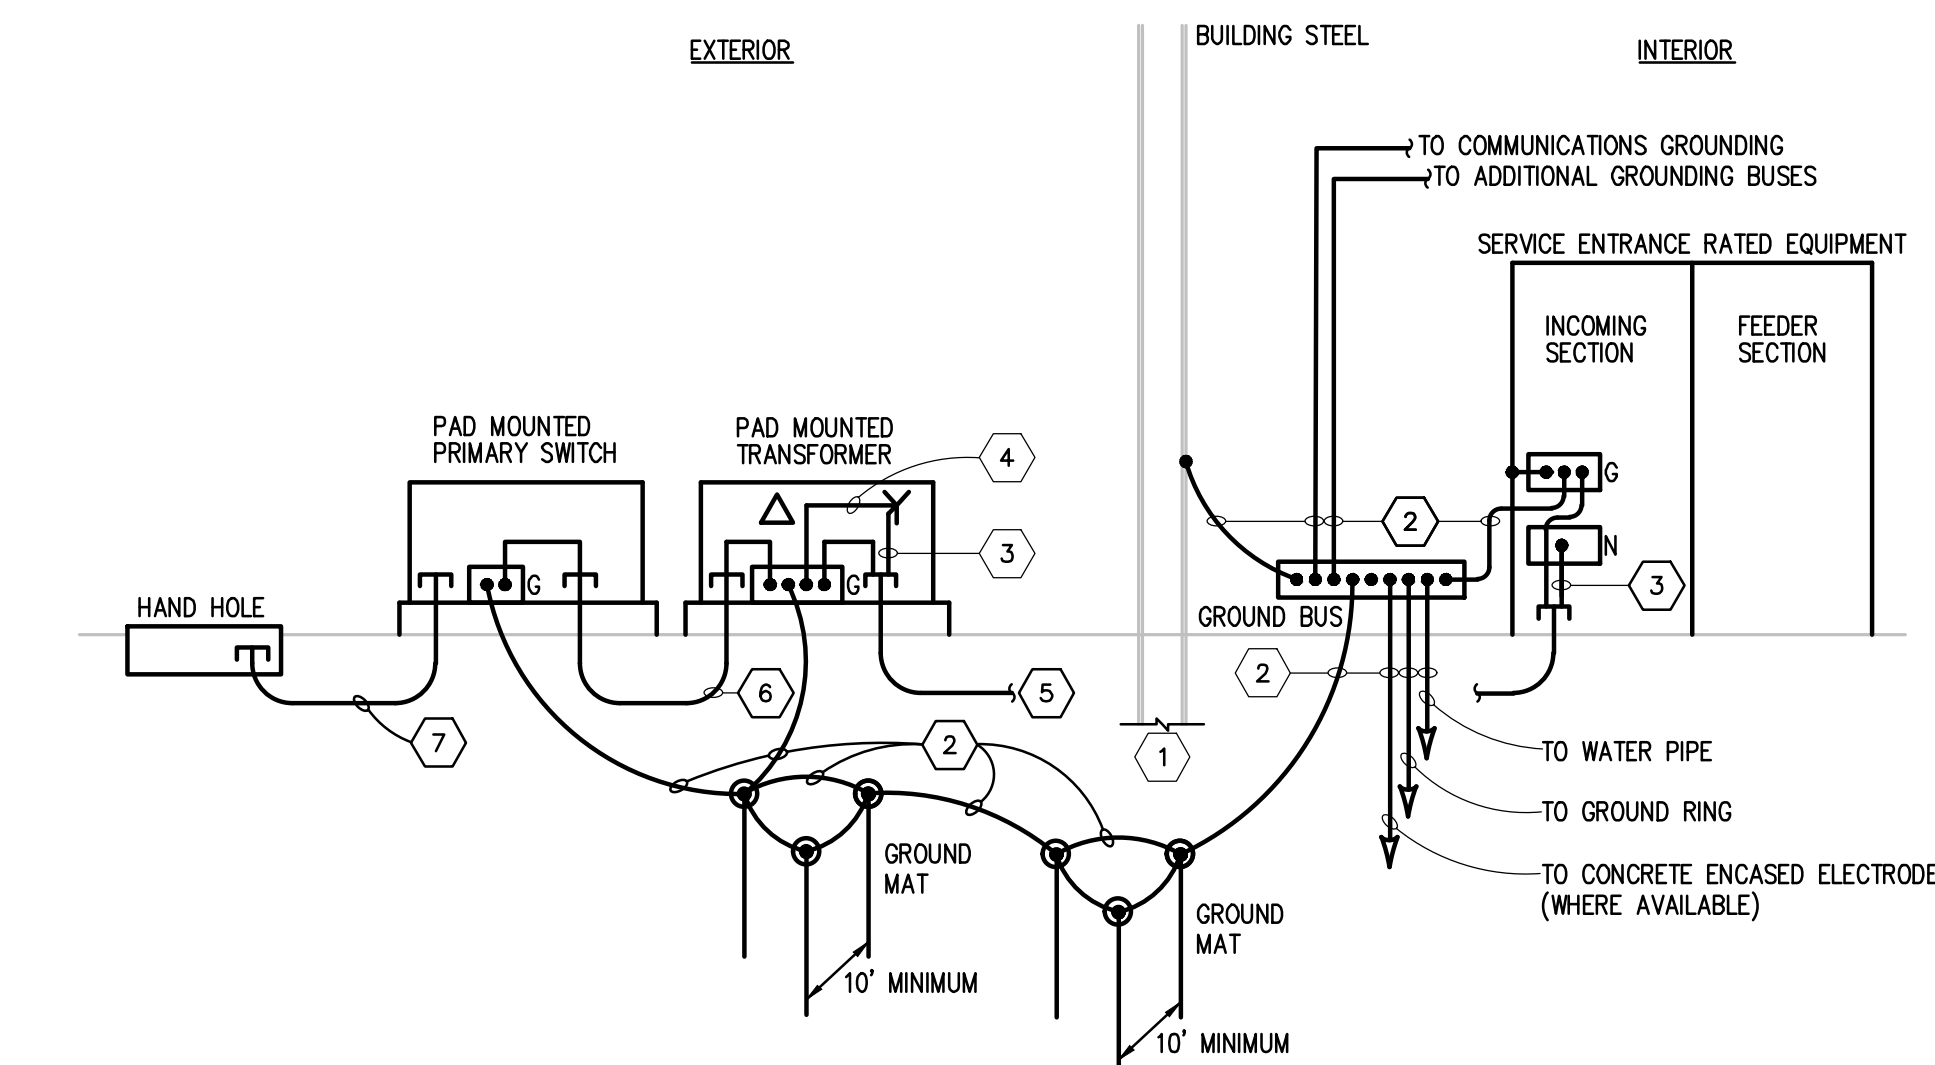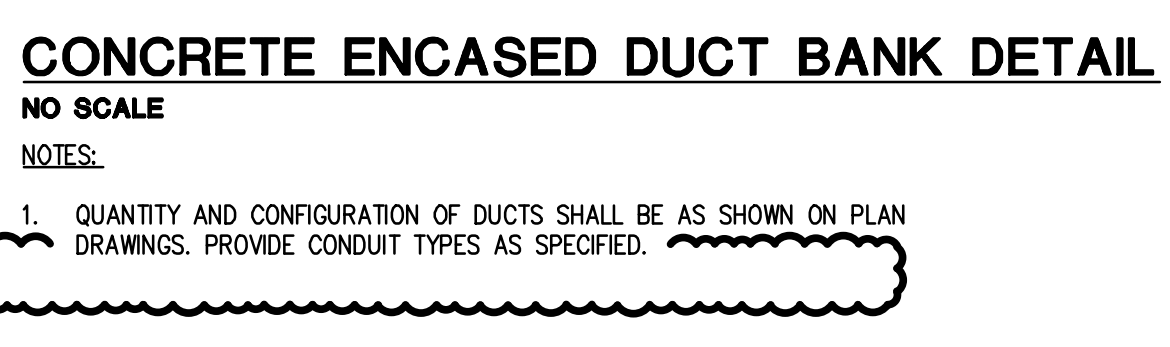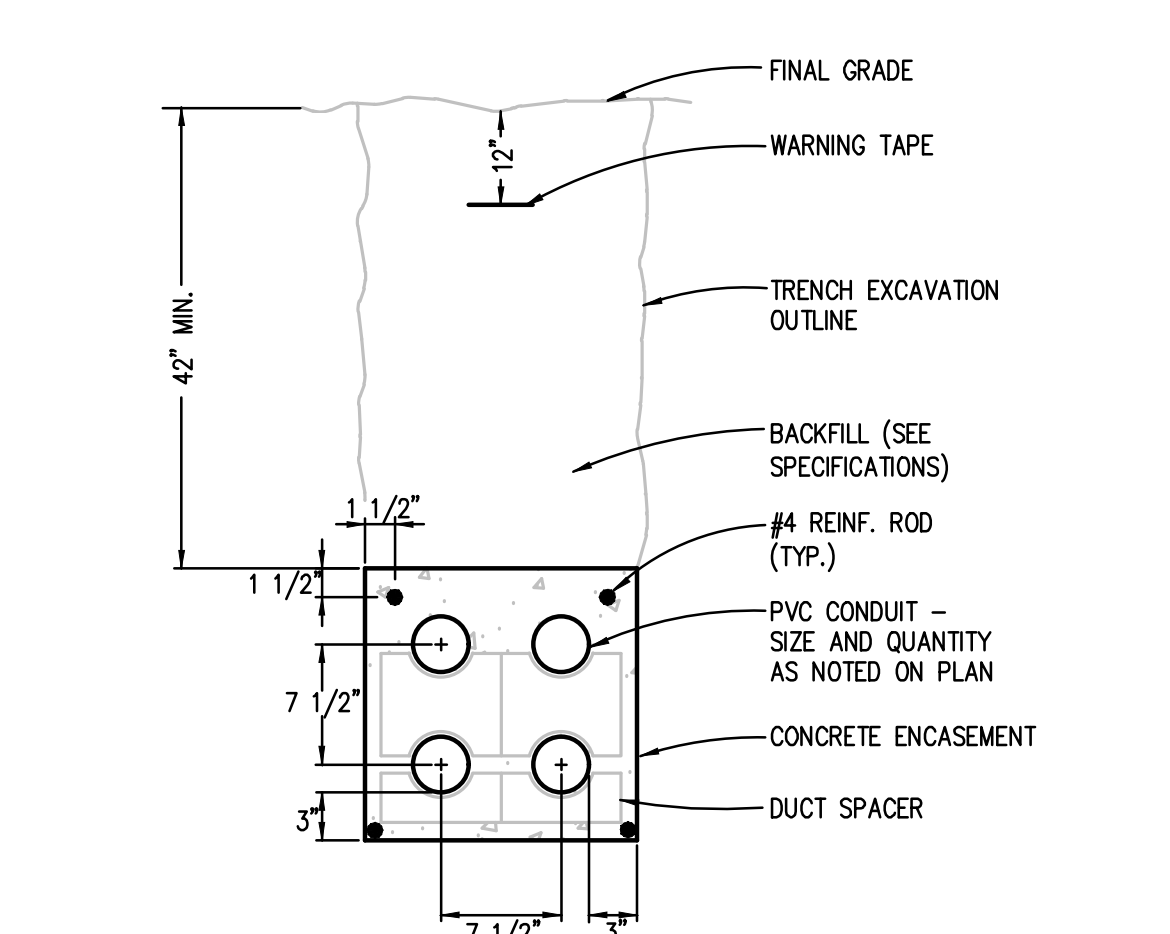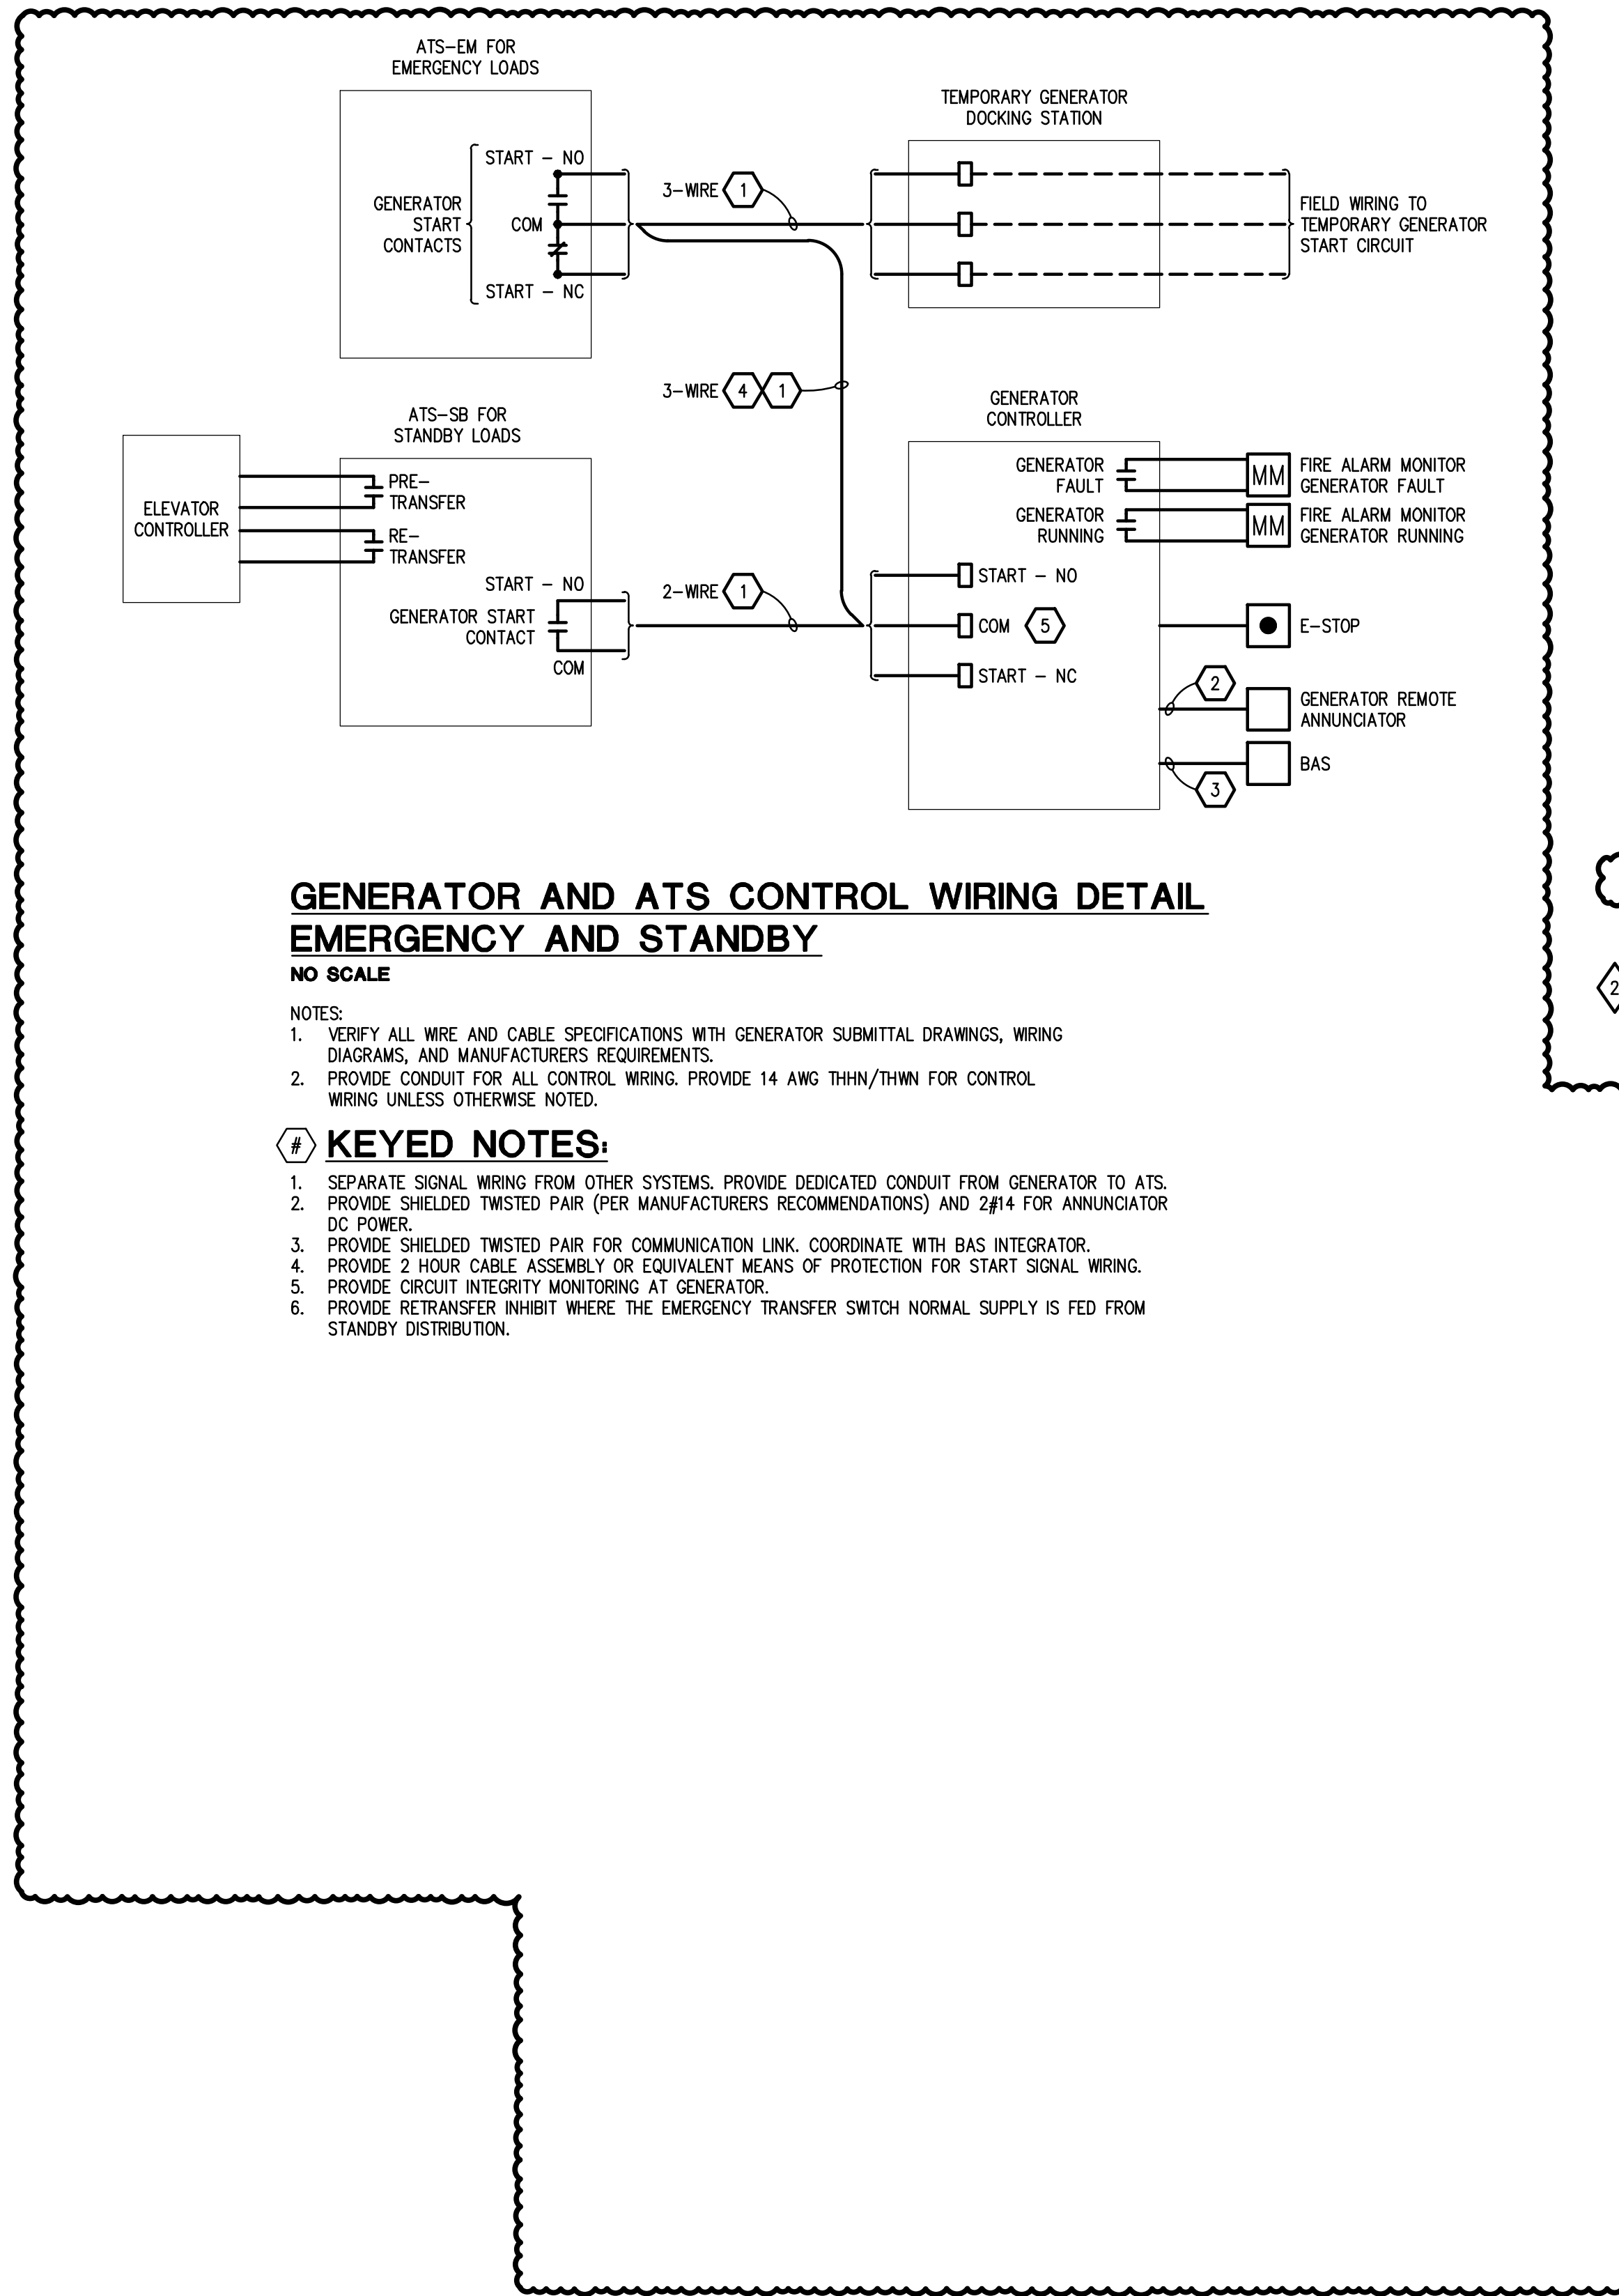

ISSUE DATES


07-12-2024	ADDENDUM #2
06-16-2024	CONSTRUCTION DOCUMENTS
DATE:	ISSUED FOR:
DRAWN	DDB
CHECKED	ZDB
APPROVED	STP

g:\2023\2023-0154-00\CAD\2023-0154-E7-01.dwg, E7.1, 7/11/2024 2:06:51 PM, Suha A. Matti, None ,0.09448, Peter Basso Associates Inc.

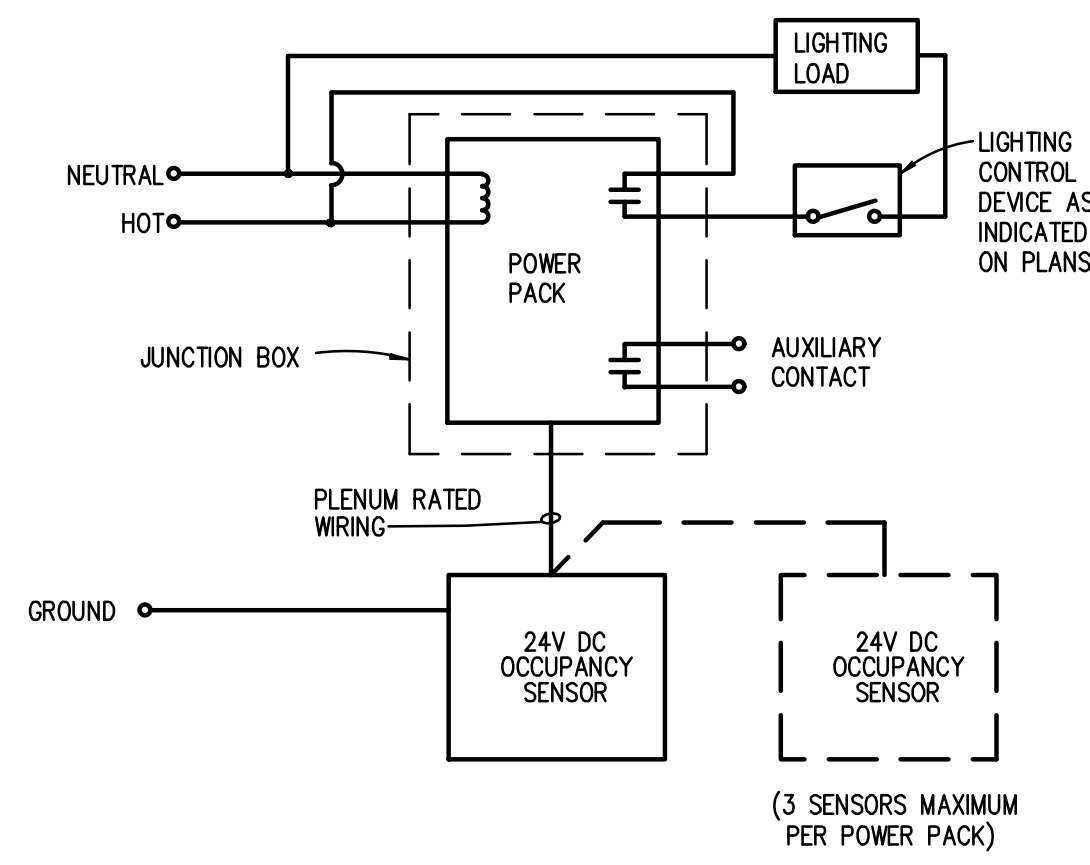


- NOTES:
- REFER TO SPECIFICATIONS FOR ACCEPTED MANUFACTURERS.
 - PROVIDE POWER PACKS AND SLAVE PACKS AS REQUIRED FOR SWITCHING AS INDICATED ON PLAN. REVISE DETAIL AS REQUIRED BY MANUFACTURER.
 - MOUNTING LOCATION PER MANUFACTURER'S RECOMMENDATION.
 - ADJUST SENSITIVITY LEVELS PER THE OWNER REQUIREMENTS.
 - PROVIDE FACTORY SUPPORT FOR AIMING/ADJUSTING OF SENSORS.
 - PLACE CEILING MOUNTED OCCUPANCY SENSORS IN CENTER OF A FULL CEILING TILE, WHERE APPLICABLE.
 - SENSOR ADJUSTMENT: BEFORE MAKING ADJUSTMENTS, MAKE SURE ROOM FURNITURE IS INSTALLED, LIGHTING CIRCUITS ARE TURNED ON, AND THE HVAC SYSTEMS ARE IN THE ON POSITION. VAV SYSTEMS SHOULD BE SET TO THEIR HIGHEST AIRFLOW. SET THE LOGIC CONFIGURATION DIP SWITCHES TO "NEUTR". EITHER REQUIRES MOTION DETECTION BY ONLY ONE TECHNOLOGY. SET THE TIME DELAY PER OWNERS DIRECTION.

OCCUPANCY SENSOR WIRING DIAGRAM
NO SCALE

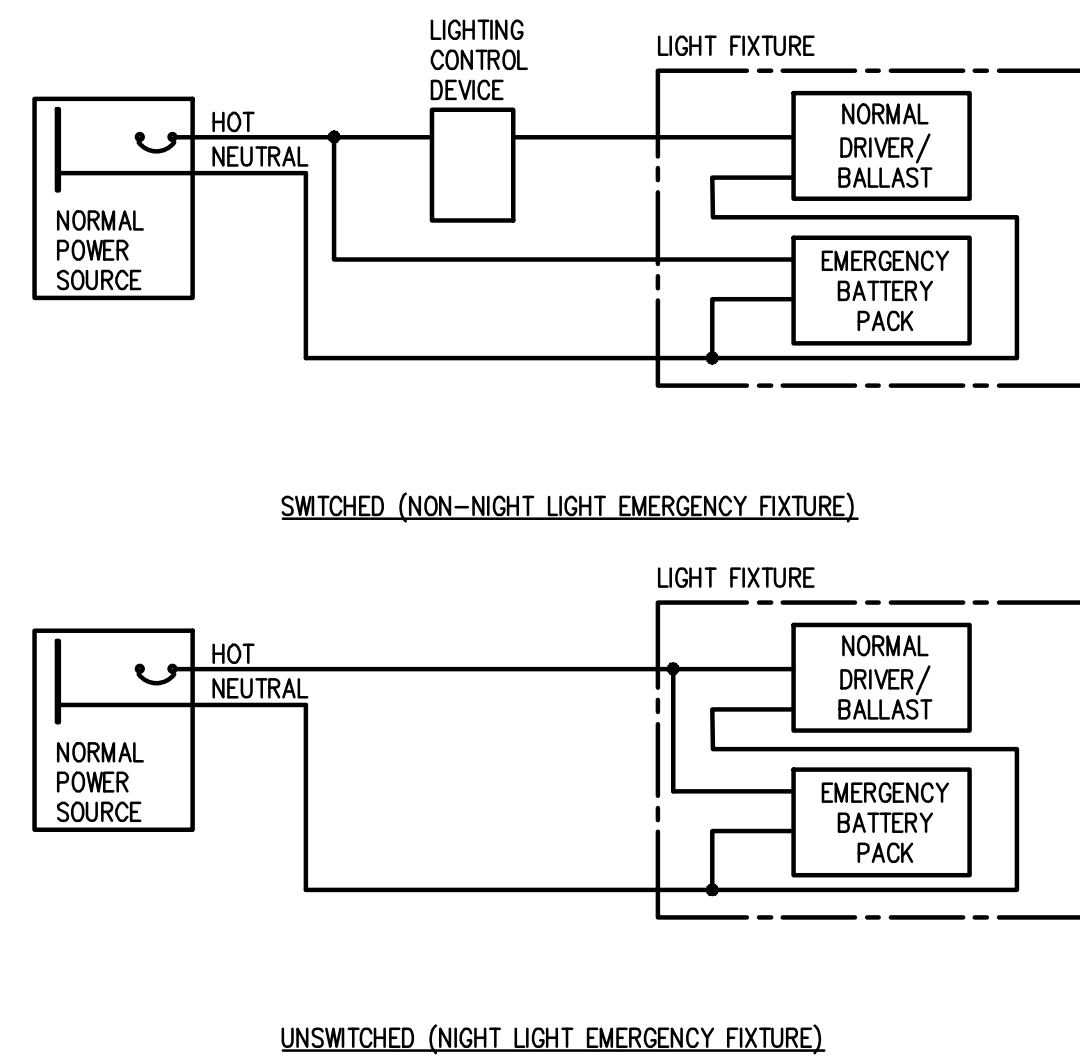


EMERGENCY BATTERY BACKUP WIRING DIAGRAM - INTERNAL TO LIGHT FIXTURE
NO SCALE

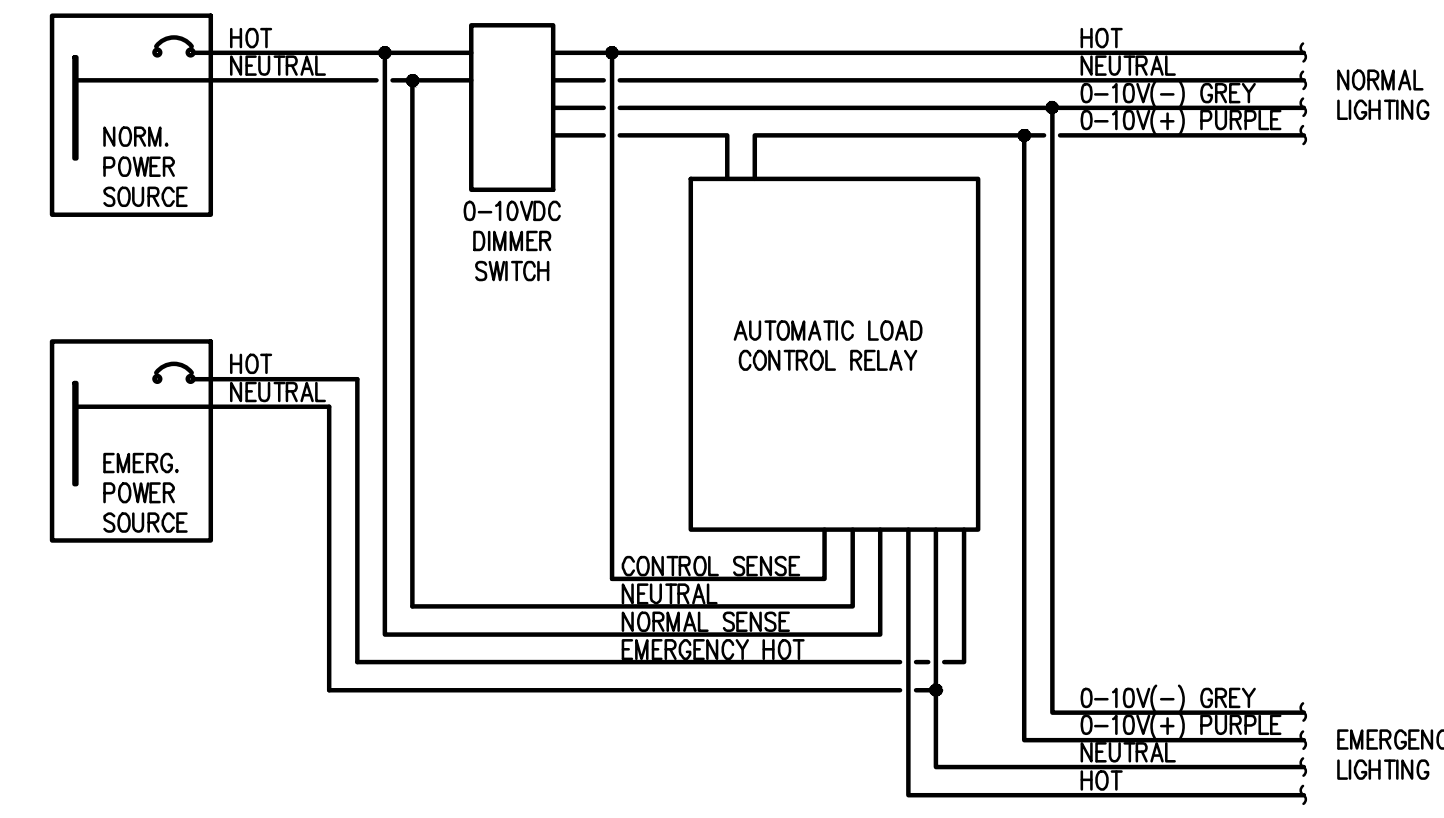


AUTOMATIC LOAD CONTROL RELAY FOR 0-10V DIMMING
NO SCALE


- NOTES:
- BASIS OF DESIGN IS LVS CONTROLS EPC-2-D. REFER TO SPECIFICATIONS FOR APPROVED MANUFACTURERS. ADJUST WIRING AS NECESSARY FOR OTHER APPROVED MANUFACTURERS.
 - PROVIDE ONE AUTOMATIC LOAD CONTROL RELAY PER SWITCHING CIRCUIT.

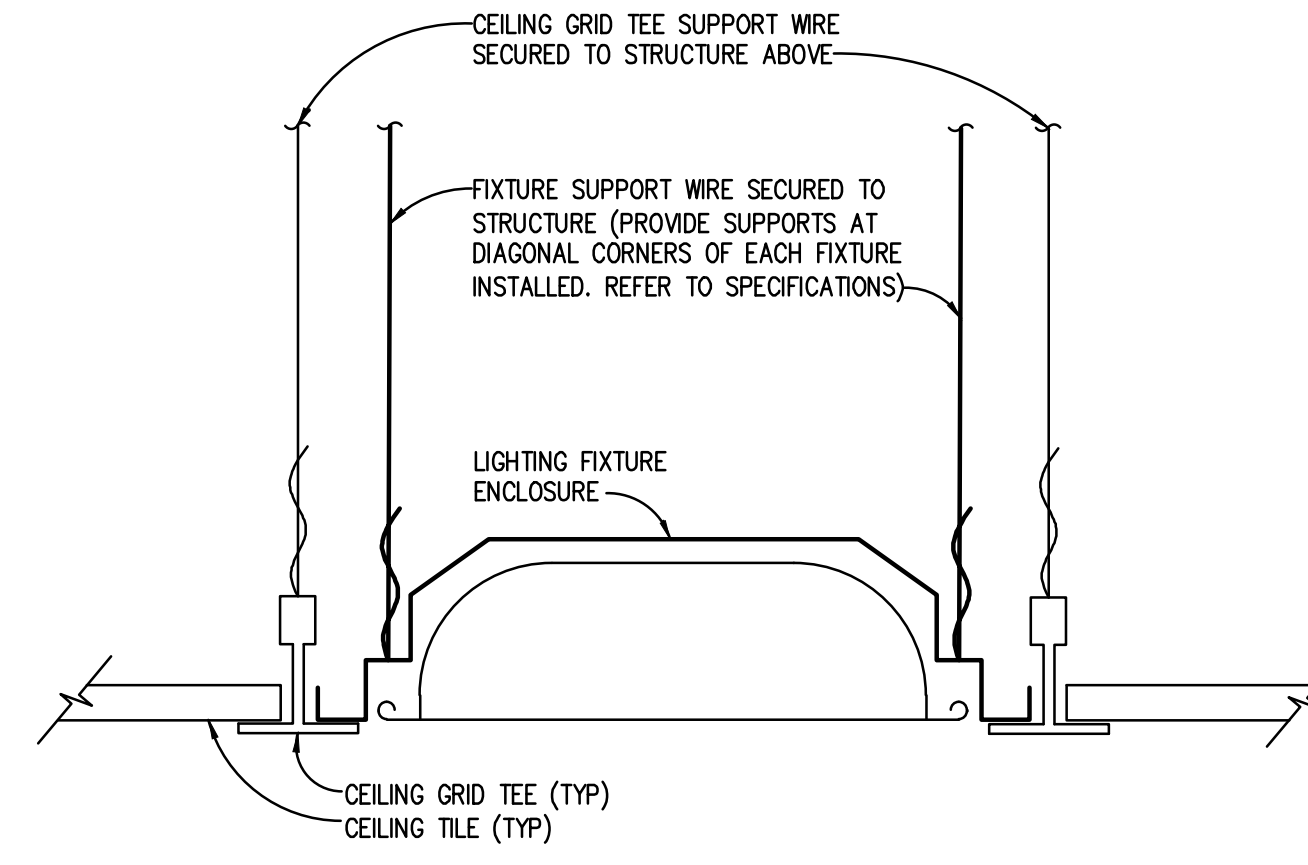

RECESSED LIGHTING FIXTURE INSTALLATION DETAIL
NO SCALE

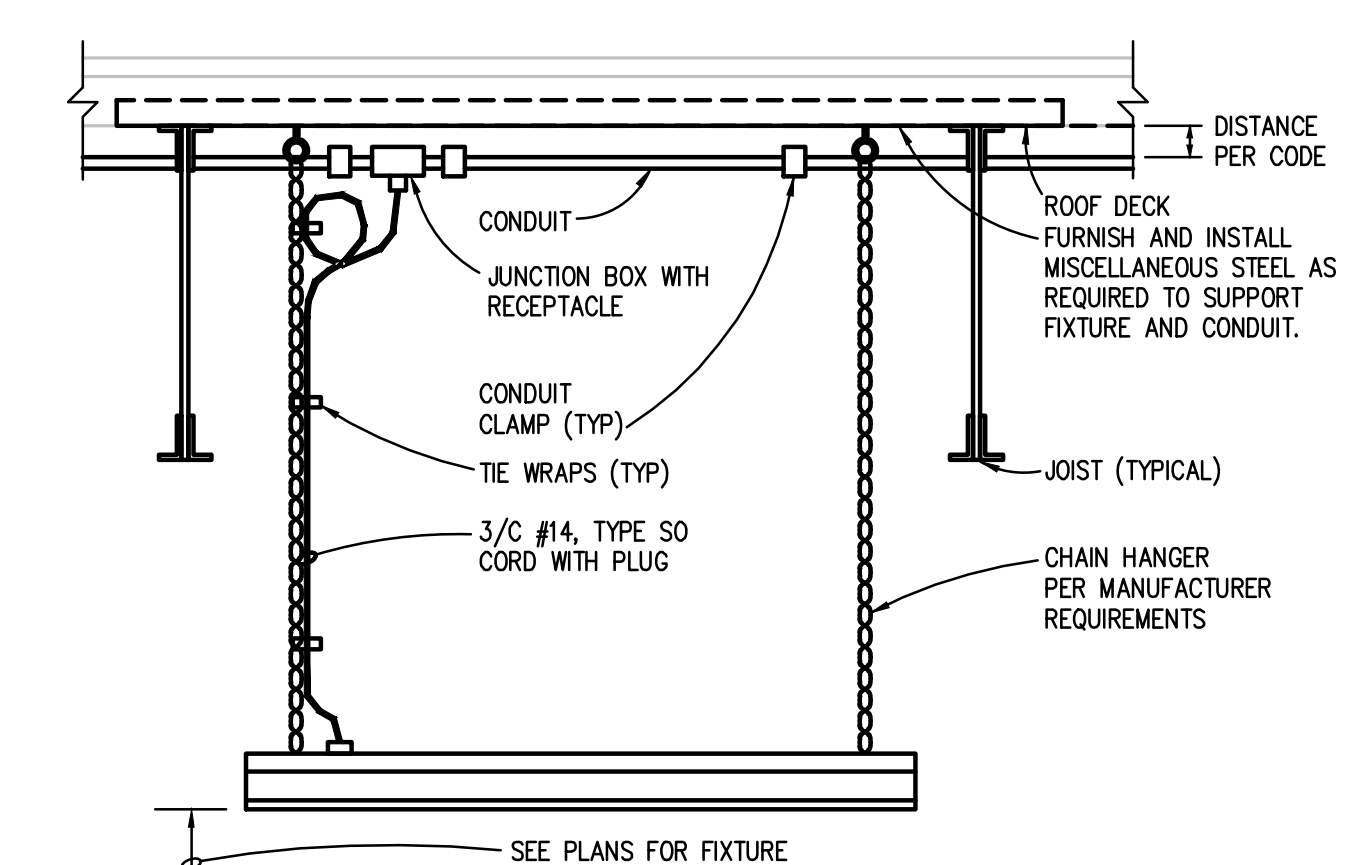


TYPICAL MOUNTING DETAIL FOR CHAIN HUNG LIGHTING FIXTURES
NO SCALE

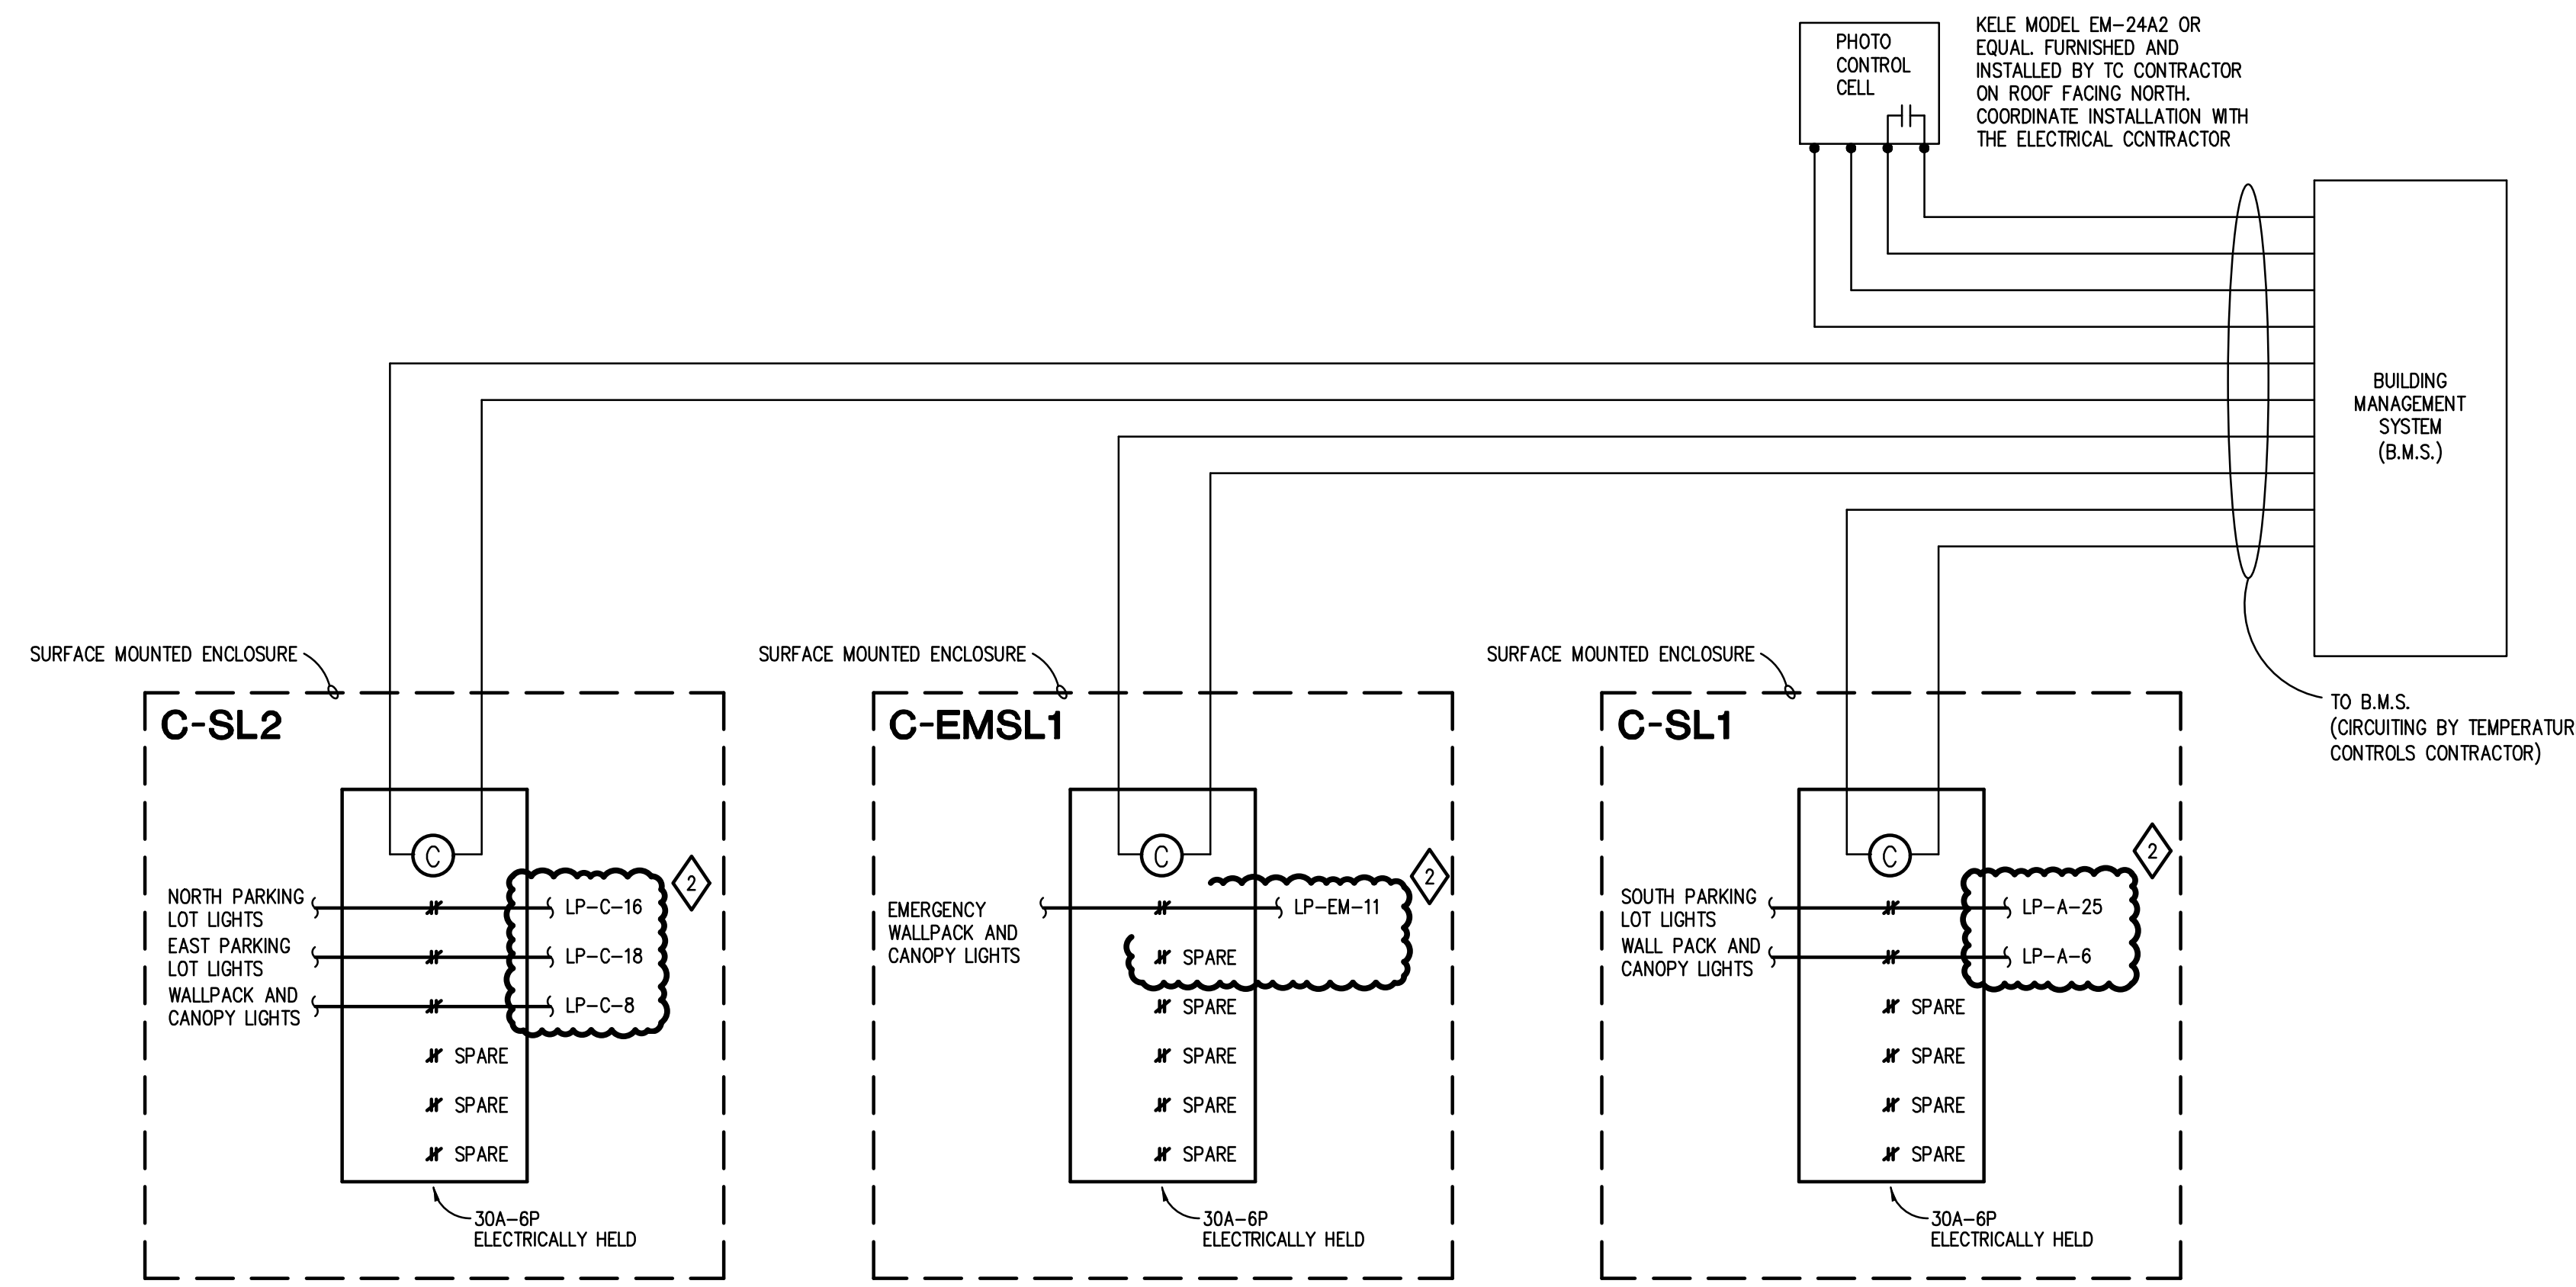

EXTERIOR LIGHTING CONTROL CONTACTOR DETAILS
NO SCALE

- NOTES:
- REFER TO PLANS FOR CONTACTOR LOCATIONS
 - CONTACTOR ENCLOSURE SHALL BE 20\"/>

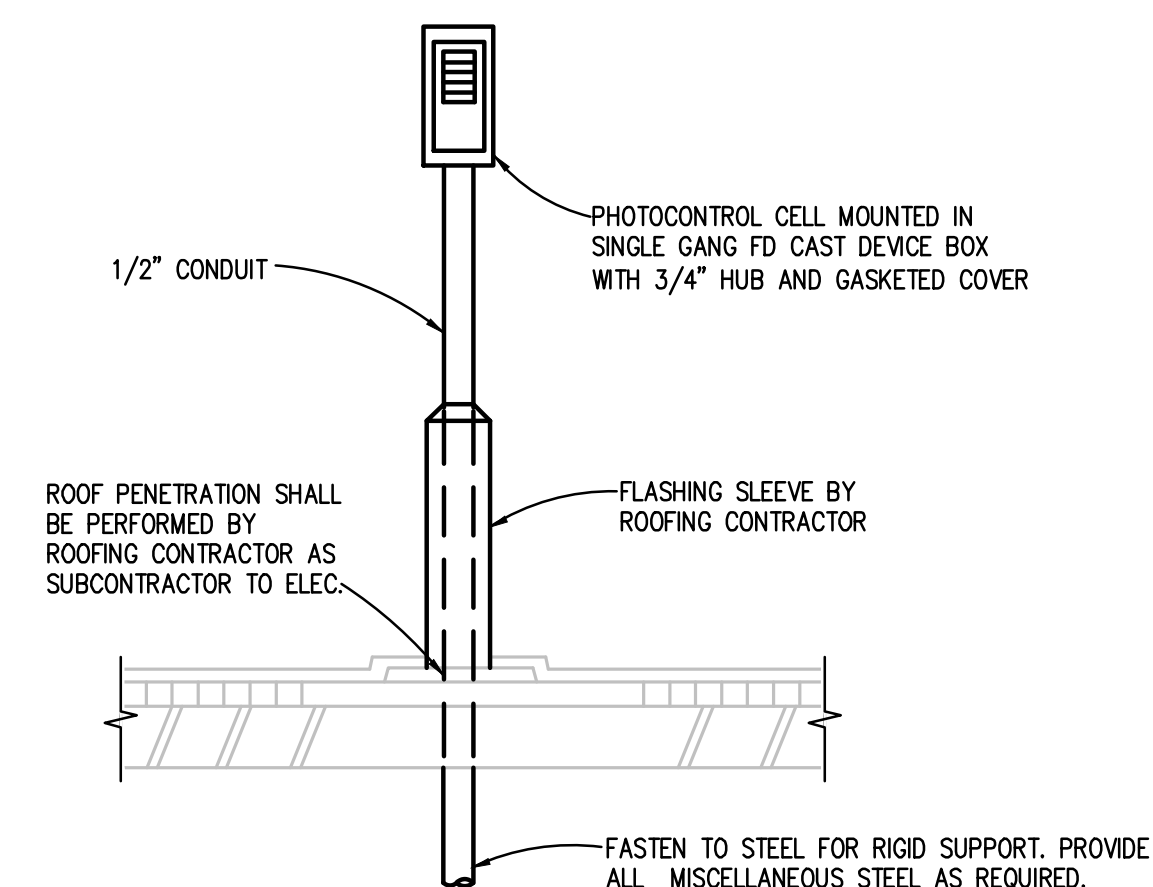

PHOTOCONTROL CELL MOUNTING DETAIL
NO SCALE



TMP ARCHITECTURE INC
1191 WEST SQUARE LAKE ROAD - BOX 289
BLOOMFIELD HILLS - MICHIGAN - 48302
PH: 248.388.4841 FX: 248.388.0023
EM: INFO@TMP-ARCHITECTURE.COM

REGISTRATION SEAL

CONSULTANT



Peter Basso Associates Inc
CONSULTING ENGINEERS
5145 Livernois, Suite 200
Troy, Michigan 48068-5276
Tel 248-879-5666
Fax 248-879-0007
www.PeterBassoAssociates.com
PSA Project No. 20230354

PROJECT TITLE
NEW SMITH MIDDLE SCHOOL
Bid Package No. 03B

Troy School District
Troy, Michigan

DRAWING TITLE
ELECTRICAL DETAILS AND DIAGRAMS

ISSUE DATES

07-12-2024	ADDENDUM #2
06-16-2024	CONSTRUCTION DOCUMENTS

DATE: ISSUED FOR:

DRAWN	DDG
CHECKED	ZDB
APPROVED	STP

PROJECT NO.
22102
DRAWING NO.
E7.2



July 11th, 2024

Troy School District 2022 Bond
Bid Package 3B: New Smith Middle School

Pre-Bid Meeting Agenda

I. Introductions

- A) Barton Malow Builders:
 - Shawn Mow – Senior Superintendent
 - Josh Eisenman – Project Manager
 - Adam Lewis – Project Engineer

- B) Troy Schools District:
 - Michelle Kerns – Owners Representative
 - Rob Carson – Director of Operations

- C) TMP Architecture, Inc
 - John Waldrop – Project Manager
 - Franco Antonnicola - Field Architect

II. Project Overview

- A) Summary of Bid Package Work Scope:
 - New 125,000 Sqft Middle School.
 - Accompanying sitework and new access drives off Livernois Rd
- B) The Contracts for this project are held between Troy School District and the Contractor. Barton Malow Builders is the Construction Manager acting as an agent to The Troy School District
- C) Construction Milestone Schedule is as follows as well as located in section 00230 of the Project Manual. The intent is to perform all work as expeditiously as possible. School is intended to open Fall of 2026. Owner turnover planed for early Summer of 2026
- D) The project will utilize Autodesk Build as the document processing software. Please review the project work scopes for the cost information and details.
- E) This project will use Oracle Textura Payment Manager. Cost and other information can be found in section 01 2000 Price and Payment Procedures of the Project Manual.
- F) Site Walk
 - Contractors are encouraged to walk the sites before submitting a bid. Barton Malow Builders must be notified of your site visit at least 4 hours before arriving. Sign in the office before visiting an area.



Preliminary Schedule

MILESTONE ACTIVITY	SCHEDULED START	SCHEDULED COMPLETION
Early LOI		August 1 st , 2024
Early Submittals	August 1 st , 2024	August 15 th , 2024
Contracts Awarded		August 20 th , 2024
Submittals	August 21 st , 2024	September 12 th , 2024
Construction	September 1 st , 2024	June 15 th , 2026
Project Substantial Completion		June 15 th , 2026
Punch List	June 15 th , 2026	July 15 th , 2026

Bidder Requirements

- A) Bid Due Date and Requirements
 - Bids are due on **July 23rd, 2024 (07/23/2024) by 2:00 pm EST** by online submission through Building Connected. Bid opening will be held virtually at 2:30 pm on July 23rd, 2024. A link to the livestream can be found in the information section in Building Connected. Earthwork, Landscaping, Paving, and Structured Cabling will be Due on July 30th, 2024.
 - **Any bid that does not include a completed, signed, and notarized Familial Relationship Disclosure Form or Iran Economic Sanction Form (located in the Project Manual) will not be accepted.**
- B) Bonding Requirements
 - The contractor is required to provide a 5% bid security with their bid. **Any bid that does not include a bid security will not be accepted.**
 - After award of contract, the contractor will be required to provide Performance & Payment Bonds.
 - The bonding company supplying the bond must be based in the United States and licensed to do business in the State of Michigan with a rating of A-7 or higher.
- C) Addendum Status
 - Addendum No. 1 was sent out on Tuesday July 9th, 2023.
 - Addendum No. 2 coming early next week.
 - Includes RFI Responses, small updates to the drawings, and some scope reassignments.
- **Safety:**
 - A) Each contractor is required to provide a personal fall arrest system for workers above 6 feet (above 24 feet on ladder). This includes all work on the roof. Provide harness, lanyard, and tie-off points per MIOSHA standards. The 6-foot tie-off rule is a Barton Malow standard and will be enforced. All workers on fully planked, and guard rail scaffolding will not be required to wear a harness.



- B) Ear/Eye protection will be required as it applies to the work being performed.
- C) Each contractor working within an aerial lift must be certified to drive the piece of equipment onsite. Lift cards will be required.
- D) Each contractor is required to have one worker certified in CPR/first aid onsite at all times.
- E) Contractors, as well as employees must be Certified Lead Renovators as required by the EPA effective April 22, 2010.
- F) Barton Malow has a zero-tolerance policy regarding safety. Any workers found conducting work in an unsafe manner will be sent home.
- G) Each awarded contractor will be responsible for providing Barton Malow (3) safety binders with specific safety documents enclosed.
- H) Each contractor that builds a scaffold must have a certified competent scaffold builder reviewing the scaffold erection. In addition, a competent person is required to check the scaffold daily for any changes in the scaffold condition. Scaffold certification cards will be required. Include all costs in base bid.

III. Questions & Comments

- o All contractors are to include all costs to provide 100% fall protection per Barton Malow's 6-foot fall rule. The 6-foot fall rule states: all contractors working at or above 6 feet must provide and use a fall arrest system with tie off points. However, using a guard rail system with complete top, mid, and toe rails/boards is acceptable in compliance with the MIOSHA standards.
- o All contractors shall include all costs to install all new work within occupied spaces during non-instructional times related to the work occurring during the school year.
- o The end of the day for all contractors shall be 11:00 pm Mon-Fri.
- o Submit RFIs to Barton Malow Builders through BuildingConnected for a response.
- o Pay close attention to plans and specifications.
- o It is encouraged for all contractors to qualify their bid if there are any items that are unclear.
- o This project does not fall under the Davis Bacon Prevailing Wage Law or Michigan prevailing wage.
- o The bidder's list is available upon request to any subcontractors. Please contact Barton Malow for details.
- o Please note: MIOSHA inspections have recently been full complete 3-to-4-day inspections. All contractors are to always follow all MIOSHA and BMC standards. Failure to abide by the standards will not be tolerated.

Respectfully Submitted,
BARTON MALOW BUILDERS
Nolan Gerds – Project Engineer



MEETING SIGN-IN SHEET

DATE: 07/11/2024 PROJECT: BP#3B TROY SCHOOL DISTRICT
 TIME: 2:00PM NEW SMITH MIDDLE SCHOOL
 LOCATION: SMITH MIDDLE SCHOOL - 5835 DONALDSON DR, TROY, MI, 48085 SUBJECT: PRE-BID MEETING

ATTENDEES (Please print legibly)	COMPANY	CATEGORY BIDDING	TELEPHONE	E-MAIL ADDRESS
Josh Eisenman	Barton Malow Builders		586-651-2658	josh.eisenman@bartonmalow.com
Shawn Mow	Barton Malow Builders		810-560-7159	shawn.mow@bartonmalow.com
Adam Lewis	Barton Malow Builders		248-953-5682	adam.lewis@bartonmalow.com
Scott Albaugh	Albaugh Masonry	Masonry	248-762-1711	Sralbaugh@albaughmasonry.com
Jim Burnard	Albaugh Masonry	Masonry	248-762-5924	jburnard@albaughmasonry.com
Paul Basset	BB Glass	Glass/ Glazing	248-852-2323	Pbasset@bbconstruct.com
MATT HEAROLD	BB GLASS	GLASS/ GLAZING	248-852-2323	mhearold@bbconstruct.com
Alex Brewer	Metro Electric	electric	586-752-2622	abrewer@metroelect.com
DAVE DELLER	CHRISTMAN CONSTRUCTORS	Electrical	517-599-5571	ddeller@christmanconstructors.com
JD Hocking	Bumler Mechanical	Mechanical	810-343-2499	jd.hocking@bumlormech.com
Jim Bobzeak	Western Mechanical	P/B/MECH	586-790-6900	Bobzeak@westernmech.com
Brendon Butzcan	Western	P/B/mech	586-612-9002	butzcan
Math Alexander	FAP Painting	Paint	810-602-0162	M/66ALEX@ya.com

7-11-24
SMITH 2pm

MEETING SIGN-IN SHEET

ATTENDEES (Please print legibly)	COMPANY	CATEGORY BIDDING	TELEPHONE	E-MAIL ADDRESS
PETE KALAS	Fox Remolding	tile/cabinetry/DAWD	810-622-0162	M66AEC@yale
ROB WASHINGTON	BLK	Carpentry	313-971-3960	rWashington@3KConstruction.com
TYLER GOZDOR	Interior Image	Flooring	248-940-7662	tyler@interior-image.com
TODD UNDERHILL	INNOVATED ENERGY CONSERVATION	ELECTRICAL	(810) 429-2010	TUNDERHILL@IECCOMPART.com
Subhash Pappagari	Danboise Mechanical	Plumbing	248-699-7860	SPappagari@danboisemechanical.com
Colin McLean	Clark	Carpentry	248-312-9972	colin@clarkcc.com
David Talbot	CLS	Carpentry	586-899-8547	dtalbot@clarkcc.com
JEFF GARRISON	ELITE MECH. SERV.	FIRE SUPPR.	248-216-8524	jefft@elitefire.com