

MODERNIZATION LAKEWOOD ELEMENTARY SCHOOL 1100 N. HAM LANE LODI, CA 95242

LIMITED PROJECT SCOPE DESCRIPTION

THE PROJECT SCOPE INTENDED TO BE DESCRIBED IN THESE DRAWINGS INCLUDES CONSTRUCTION OF:

1. REMOVAL AND REPLACEMENT OF WALKWAYS AROUND CLASSROOMS AND INSIDE QUAD AS INDICATED.
2. UNDERCUTTING OF DOORS & INSTALLATION OF (N) DOOR BOTTOMS & THRESHOLDS AT NEW WALKWAYS.
3. ASPHALT GRINDING, OVERLAY, SEALING AND STRIPING OF (E) HARCOURTS WHERE INDICATED.

THE MODERNIZATION WORK FOR THE REMAINDER OF THE PROJECT WILL BE BID AND CONSTRUCTED AT A LATER DATE.

ABBREVIATIONS

& L @ ∅ # ⊥ # ⊥	And Angle At Centerline Diameter Perpendicular Pound or Number Plate	E. (E)EXST. EA. E.J. EL. ELEC. EMER. ENCL. EQ. EQPT. E.W.C. EXP. EXT.	East Existing Each Expansion Joint Elevation Electrical Emergency Enclosure Equal Equipment Electric Water Cooler Expansion Exterior	K.P. KIT.	Kickplate Kitchen	S. S.D.	South Soap Dispenser
A.C. ACOUS. A.D. ADJ. A.F.F. AGGR. ALUM./AL. ARCH. ASPH. AUTO. A.V.	Asphalt Concrete Acoustical Area Drain Adjustable Above Finished Floor Aggregate Aluminum Architectural Asphalt Automatic Auto Visual	F.A. F.B. F.D. FDN. F.E. F.F.E. F.H.M.B. F.H.M.S. FIN. FL. F.L. FLASHG. F.O.C. F.O.F. F.O.S. F.R.P. F.S. FT. FTG. FURR. FUT.	Fire Alarm Fiberboard Floor Drain Foundation Fire Extinguisher Finish Floor Elevation Flat Head Machine Bolt Flat Head Machine Screw Finish Floor Fusible Link Flashing Face of Concrete/Curb Face of Finish Face of Studs Fiberglass Reinforced Plastic Full Size Foot/Foot Footing Furring Future	(N) N. N.I.C. NO./# NOM. N.T.S.	New North Not in Contract Number Nominal Not to Scale	O/ O.A. OBS. O.C. O.D. O.H. OFF.	Over Overall Obscure On Center Outside Diameter Opposite Hand Office
CAB. C.B. CB. CEM. CER. C.G. C.I. C.J. C.L. CLG. CLKG. CLR. C.M.P. C.M.U. CNTR. COL. CONC. CONN. CONSTR. CONT. CORR.	Cabinet Catch Basin Chalkboard Cement Ceramic Corner Guard Cast Iron Construction Join/Control Joint Chain Link Calling Calking Clear Corrugated Metal Pipe Concrete Masonry Unit Counter Column Concrete Connection Construction Continuous Corridor	GA. GALV. G.B. GLASS/GLAZING GND. GR. GRV. G.I. G.S.M. GYP. GYP.BD. HOR. HDWD. HDW. HOR. H.B. HR. HGT. I.D. IN. INFO. INSUL. INT. JAN. JST. JT.	Gauge Galvanized Grab Bar Glass/Glazing Ground Grade Gypsum Galvanized Iron Galvanized Sheet Metal Gypsum Board Header Hardwood Hardware Horizontal Hose Bib Hour (Fire Rating) Height Inside Diameter Inch Information Insulation Interior Janitor Joist Joint	PRCST. PERF. P.LAM. PLAS. PLYWD. P.M. P.M.F. PR. P.O.T. PRE-FAB PROJ. P.T.D. P.T.D./R. PTN. P.T.R. R. RAD. R.B. R.D. R.E. REFR. REINF. REQ. RET. RM. R.O. RWD. R.W.L. R.H.W.S.	Precast Perforated Plastic Laminate Plaster Plywood Pressed Metal Pressed Metal Frame Pair Path of Travel Prefabricated Project Paper Towel Dispenser Paper Towel Dispenser Receptacle Partition Paper Towel Receptacle Riser Radius Rubber Base Roof Drain Rim Elevation Refrigerator Refrigerator Reinforced Required Return Room Round Opening Redwood Rain Water Leader Round Head Wood Screw	T. TB. T.B. T.&G. TEL. THK. THRES. THRU. T.O.C. T.O.P. T.O.W. T.P.D. TYP. U.O.N. UR. V.C.T. VERT. V.F. W. W.C. W.D. W.H. WID. WSCOT. W.W.M. WDW. WT. YD.	Toilet Tackboard Towel Bar Tongue & Groove Telephone Thick Threshold Through Top of Curb Top of Pavement Top of Wall Toilet Paper Dispenser Typical Unless Otherwise Noted Urinal Vinyl Composition Tile Vertical Vinyl Fabric West W/ With Water Closet Wood Water Heater Without Wainscot Wire Mesh Window Weight Yard

SYMBOL LEGEND

SHEET NUMBERING SYSTEM A2.6.A Building Designation Room Name Room Number Building Unit	STRUCTURAL GRID INDICATOR (Center of Framing) A
ROOM NAME and NUMBER REFERENCE WOMEN A103 Room Name Room Number Building Unit	STRUCTURAL GRID INDICATOR (Face of Framing) 3
KEYNOTE REFERENCE 2200.A7.05	MATCH LINE MATCH LINE
SHEET NOTE REFERENCE SN.01	CENTERLINE CENTERLINE
DETAIL REFERENCE X XXXX Detail Number Sheet Number	PROPERTYLINE PROPERTYLINE
BUILDING SECTION REFERENCE X XXXX Section Number Sheet Number	WORK POINT, CONTROL POINT OR DATUM WORK POINT, CONTROL POINT OR DATUM
STOREFRONT, WINDOW OR LOUVER REFERENCE X XXXX Window Covering Reference H-HORIZONTAL BLINDS V-VERTICAL BLINDS D-DARKENING DRAPES	INTERIOR ELEVATION REFERENCE 4.5 1.5 2 4.5 1.5 2 3.5 2.5 INTERIOR ELEVATION DETAIL NUMBER SHEET NUMBER
DOOR REFERENCE A101	WINDOW (PLAN VIEW) 4.5 1.5 2 4.5 1.5 2 3.5 2.5 WINDOW (PLAN VIEW)
CEILING TYPE REFERENCE C2	REVISION REVISION Revision Number
WALL TYPE REFERENCE C2	RADIUS R=92'-4" (1) Radius Point Number Radius Dimension
EXTERIOR FINISH REFERENCE A	CASEWORK REFERENCE 221A L Indicates all drawers and doors to have locks installed
PAINT COLOR REFERENCE PC1 (Architect to provide color selection)	METAL SHELVING REFERENCE MS1
	LABORATORY CASEWORK REFERENCE 99
	MUSIC CASEWORK REFERENCE 99
	ACOUSTICAL PANEL REFERENCE AP1
	SIGN REFERENCE S2

MATERIAL LEGEND

	EARTH		WOOD TRIM
	GRAVEL/AGGREGATE BASE		STEEL
	SAND OR PLASTER		TILE
	CONCRETE		BATT INSULATION
	BLOCKING		BRICK
	FRAMING (CONTINUOUS)		GYPSUM BOARD
	PLYWOOD		FIRTEX

APPLICABLE CODES

TITLE 19 CCR, PUBLIC SAFETY, STATE FIRE MARSHAL REGULATIONS
TITLE 24 CCR, PART 1 - 2022 BUILDING STANDARDS ADMINISTRATIVE CODE
TITLE 24 CCR, PART 2 - 2019 CALIFORNIA BUILDING CODE, VOL. 1 & 2 (CBC)
TITLE 24 CCR, PART 3 - 2019 CALIFORNIA ELECTRICAL CODE (CEC)
TITLE 24 CCR, PART 4 - 2019 CALIFORNIA MECHANICAL CODE (CMC)
TITLE 24 CCR, PART 5 - 2019 CALIFORNIA PLUMBING CODE (CPC)
TITLE 24 CCR, PART 6 - 2019 CALIFORNIA ENERGY CODE (CEC)
TITLE 24 CCR, PART 9 - 2019 CALIFORNIA FIRE CODE (CFC)
TITLE 24 CCR, PART 11 - 2019 CALIFORNIA GREEN BUILDING STDS CODE
TITLE 24 CCR, PART 12 - 2019 CALIFORNIA REFERENCED STANDARDS
2016 NFPA 13, INSTALLATION OF SPRINKLER SYSTEMS (CA AMENDED)
2016 NFPA 14, INSTALLATION OF STANDPIPE AND HOSE SYSTEMS
2017 NFPA 17, DRY CHEMICAL EXTINGUISHING SYSTEMS
2017 NFPA 17A, WET CHEMICAL EXTINGUISHING SYSTEMS
2016 NFPA 20, INSTALLATION OF STATIONARY PUMPS FOR FIRE PROTECTION
2016 NFPA 24, INSTALLATION OF PRIVATE FIRE SERVICE MAINS
2016 NFPA 72, NATIONAL FIRE ALARM CODE (CA AMENDED)
2016 NFPA 80, FIRE DOOR AND OTHER OPENING PROTECTIVE
2015 NFPA 720, INSTALLATION OF CARBON MONOXIDE DETECTION AND WARNING EQUIPMENT
2015 NFPA 2001, CLEAN AGENT FIRE EXTINGUISHING SYSTEMS

CONTRACTOR SHALL KEEP A COPY OF TITLE 24, PARTS 1-5 ON THE SITE AT ALL TIMES.
TITLE 24, PART 1, SECTION 4.317(c):

"THE INTENT OF THESE DRAWINGS AND SPECIFICATIONS IS THAT THE WORK OF THE ALTERATION, REHABILITATION OR RECONSTRUCTION IS TO BE IN ACCORDANCE WITH TITLE 24, CALIFORNIA CODE OF REGULATIONS. SHOULD ANY EXISTING CONDITIONS SUCH AS DETERIORATION OR NONCOMPLYING CONSTRUCTION BE DISCOVERED WHICH IS NOT COVERED BY THE CONTRACT DOCUMENTS WHEREIN THE FINISHED WORK WILL NOT COMPLY WITH TITLE 24, CALIFORNIA CODE OF REGULATIONS A CONSTRUCTION CHANGE DOCUMENT, OR SEPARATE SET OF PLANS AND SPECIFICATIONS, DETAILING AND SPECIFYING THE REQUIRED REPAIR WORK SHALL BE SUBMITTED TO AND APPROVED BY DSA BEFORE PROCEEDING WITH REPAIR WORK."

NOTES:

1. ALL NEW WORK SHALL CONFORM TO THE 2019 EDITION, TITLE 24, CALIFORNIA CODE OF REGULATIONS.
2. CHANGES TO THE STRUCTURAL, ACCESSIBILITY OR FIRE AND LIFE-SAFETY PORTIONS OF THE APPROVED PLANS AND SPECIFICATIONS AFTER THE WORK HAS BEEN APPROVED SHALL BE MADE BY A CONSTRUCTION CHANGE DOCUMENT AS REQUIRED IN SECTION 4-338, PART 1, CAC, AND SHALL BE SUBMITTED TO AND APPROVED BY DSA PRIOR TO COMMENCEMENT OF THE WORK. ALL CONSTRUCTION CHANGE DOCUMENTS SHALL BE PREPARED AND SUBMITTED TO DSA IN COMPLIANCE WITH DSA INTERPRETATION OF REGULATIONS A-6. CONSTRUCTION CHANGE DOCUMENTS ARE NOT VALID UNTIL APPROVED BY DSA PER SECTION 4-338, PART 1, TITLE 24, AND NO WORK SHALL COMMENCE UNTIL APPROVED BY DSA.
3. A DSA CERTIFIED PROJECT INSPECTOR EMPLOYED BY THE DISTRICT (OWNER) AND APPROVED BY THE DIVISION OF THE STATE ARCHITECT SHALL PROVIDE CONTINUOUS INSPECTION OF THE WORK. THE DUTIES OF THE INSPECTOR ARE DEFINED IN SECTION 4-343, CALIFORNIA BUILDING STANDARDS ADMINISTRATIVE CODE (PART 1, TITLE 24, CCR)
4. A DSA CERTIFIED INSPECTOR WITH CLASS 3 IS REQUIRED FOR THIS PROJECT (IR A-7)
5. AN LEA TESTING LABORATORY DIRECTLY EMPLOYED BY THE OWNER SHALL CONDUCT ALL THE REQUIRED TESTS AND INSPECTIONS FOR THE PROJECT.
6. GRADING PLANS, DRAINAGE IMPROVEMENT, ROAD AND ACCESS REQUIREMENTS AND ENVIRONMENTAL HEALTH CONSIDERATIONS SHALL COMPLY WITH ALL LOCAL ORDINANCES.
7. ADDENDA SHALL BE APPROVED BY DSA.

PROJECT TEAM

OWNER

LODI UNIFIED SCHOOL DISTRICT
1305 E. VINE STREET
LODI, CA 95240
CONTACT: JOE PATTY
PHONE: (209) 712-6363
EMAIL: jpatty@lodiusd.net

ARCHITECT

HENRY + ASSOCIATES ARCHITECTS
730 HOWE AVE, SUITE 450
SACRAMENTO, CA 95825
CONTACT: STEPHEN HENRY
PHONE: (916) 799-3027
EMAIL: stephen@henry-architects.com

STRUCTURAL

RW ENGINEERS
1450 HARBORVIEW, SUITE F
WEST SACRAMENTO, CA 95691
CONTACT: GREG RICHARDS
PHONE: (916) 716-6910
EMAIL: grichards@rwengineers.com

MECHANICAL

CAPITAL ENGINEERING CONSULTANTS, INC.
11020 SUN CENTER DRIVE, SUITE 100
RANCHO CORDOVA, CA 95670
CONTACT: MIKE MINGE
PHONE: (916) 851-3500
EMAIL: mminge@capital-engineering.com

ELECTRICAL

M. NEILS ENGINEERING, INC.
100 HOWE AVENUE, SUITE 235N
SACRAMENTO, CA 95825
CONTACT: SINISIA GLUSIC
PHONE: (916) 923-4400
EMAIL: SGlusic@mneilsengineering.com

CIVIL

WARREN CONSULTING ENGINEERS, INC.
1117 WINDFIELD WAY, SUITE 110
EL DORADO HILLS, CA 95762
CONTACT: MARTY GEE
PHONE: (916) 985-1870
EMAIL: marty@wceinc.com

LANDSCAPE

MTW GROUP
2707 K STREET, SUITE 201
SACRAMENTO, CA 95816
CONTACT: BRYAN WALKER
PHONE: (916) 369-3990
EMAIL: bryan@mtwgroup.com

PROJECT DESCRIPTION


1. PAINTING OF CLASSROOMS & REPLACEMENT OF FLOORING AT BUILDING A, B, C, D AND E.
2. MODERNIZATION OF TOILET ROOMS AT BUILDINGS A, B, C, AND E.
3. D.A. PATH OF TRAVEL WALKWAY REPLACEMENT THROUGHOUT CAMPUS.
4. RECONFIGURATION AND EXPANSION OF EXISTING PARKING LOT.
5. OVERLAY, SEALING AND RESTRIPIING OF HARCOURTS.
6. CONSTRUCTION OF NEW BUS TURNOUT/DROP-OFF.

DEFERRED APPROVALS

1. (NONE)

VICINITY MAP

LAKEWOOD ELEMENTARY SCHOOL
1100 N. HAM LANE, LODI, CA 95242
PROJECT LOCATION

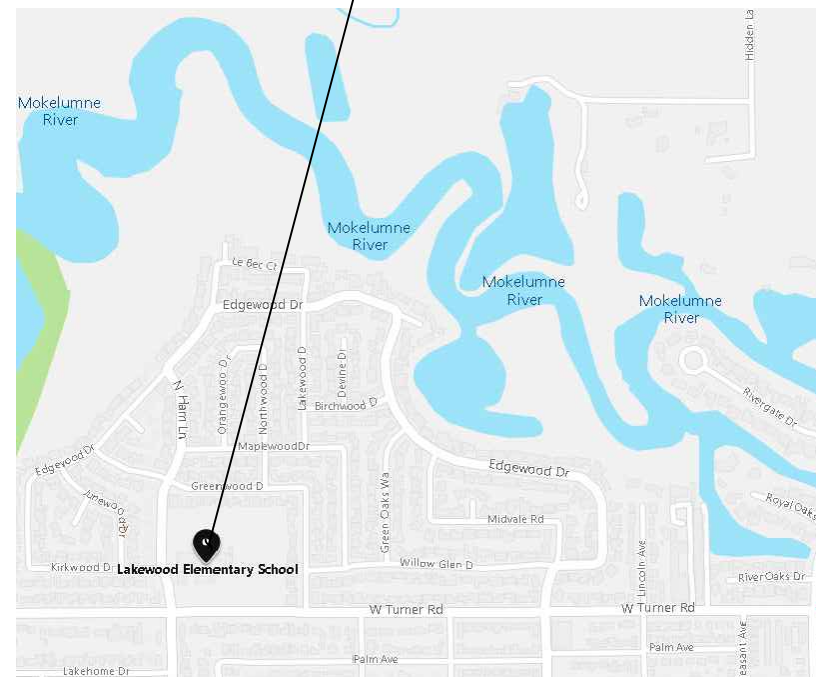

SHEET INDEX

CS COVER SHEET

ARCHITECTURAL

~~A0.1 TYPICAL DETAILS~~
A0.2 TYPICAL DETAILS
A1.1.0 FIRE AUTHORITY APPROVAL SITE PLAN
A1.1.1 CODE ANALYSIS SITE PLAN
A1.1.2 SITE PLAN
A1.2.1 ENLARGED SITE PLANS
A1.3.1 TYPICAL SITE DETAILS
A1.3.2 TYPICAL SITE DETAILS
A2.1A DEMOLITION & FLOOR PLANS - BUILDING A
~~A2.1B DEMOLITION & FLOOR PLANS - BUILDING B~~
A2.1B DEMOLITION & FLOOR PLANS - BUILDING B
~~A2.2A ENLARGED TOILET PLANS, INT. ELEVATIONS, REFLECTED CEILING PLAN - BUILDING B~~
A2.1C DEMOLITION & FLOOR PLANS - BUILDING C
~~A2.2A ENLARGED TOILET PLANS, INT. ELEVATIONS, REFLECTED CEILING PLAN - BUILDING C~~
~~A2.2B DEMOLITION & FLOOR PLANS - BUILDING B~~
A2.2 D FLOOR PLAN - BUILDING D
~~A2.3D REFLECTED CEILING PLAN - BUILDING D~~
A2.1E DEMOLITION & FLOOR PLANS - BUILDING E
~~A2.3E ENLARGED TOILET PLANS, INT. ELEVATIONS & REFLECTED CEILING PLAN - BUILDING E~~
A3.1.1 DOOR SCHEDULE & DETAILS
~~A3.1.2 MATERIALS SCHEDULE~~
A3.1.3 CASEWORK SCHEDULE
~~A3.1.4 INTERIOR ELEVATIONS - BUILDING A~~
~~A3.1.5 INTERIOR ELEVATIONS - BUILDING B~~
~~A3.1.6 INTERIOR ELEVATIONS - BUILDING C~~
~~A3.1.7 INTERIOR ELEVATIONS - BUILDING D~~
~~A3.1.8 INTERIOR ELEVATIONS - BUILDING E~~

STRUCTURAL

~~S0.1 GENERAL NOTES~~
~~S0.2 GENERAL NOTES & TYPICAL DETAILS~~
~~S2.1 STRUCTURAL BUILDING PLANS~~
~~S2.2 PARTIAL PLANS - BUILDING E~~
~~S2.3 TRANSITION ENCLOSURE PLANS & DETAILS~~
~~S4.1 DETAILS~~

MECHANICAL

M0.1 MECHANICAL - LEGEND, SCHEDULE AND NOTES
~~M0.2 MECHANICAL - EQUIPMENT SCHEDULES~~
M1.1 MECHANICAL - OVERALL DEMOLITION AND NEW SITE
~~M2.1A MECHANICAL - DEMOLITION & FLOOR PLANS - BUILDING A~~
~~M2.1B MECHANICAL - DEMOLITION & FLOOR PLANS - BUILDING B~~
~~M2.1C MECHANICAL - DEMOLITION & FLOOR PLANS - BUILDING C~~
~~M2.1D MECHANICAL - DEMOLITION & FLOOR PLANS - BUILDING D~~
~~M2.1E MECHANICAL - DEMOLITION & FLOOR PLANS - BUILDING E~~
~~M3.1 MECHANICAL - DETAILS~~
~~M3.2 MECHANICAL - CONTROLS~~
~~M3.3 MECHANICAL - CONTROLS~~

PLUMBING

P0.1 PLUMBING - LEGEND, SCHEDULES & NOTES
P0.2 PLUMBING - FIXTURE SCHEDULE
P1.1 PLUMBING - OVERALL DEMOLITION AND NEW SITE
~~P2.1A PLUMBING - DEMOLITION & FLOOR PLANS - BUILDING A~~
~~P2.1B PLUMBING - DEMOLITION & FLOOR PLANS - BUILDING B~~
~~P2.1C PLUMBING - DEMOLITION & FLOOR PLANS - BUILDING C~~
~~P2.1D PLUMBING - DEMOLITION & FLOOR PLANS - BUILDING D~~
~~P2.1E PLUMBING - DEMOLITION & FLOOR PLANS - BUILDING E~~
P5.1 PLUMBING - DETAILS

ELECTRICAL

E0.1 ELECTRICAL SHEET INDEX, SYMBOL LIST, ABBREVIATIONS AND NOTES
E1.1 SITE PLAN - ELECTRICAL
~~E2.1A FLOOR PLANS - LIGHTING - BUILDING A~~
~~E2.1B FLOOR PLANS - ELECTRICAL - BUILDING A~~
~~E2.1C FLOOR PLANS - LIGHTING - BUILDING B~~
~~E2.1D FLOOR PLANS - ELECTRICAL - BUILDING B~~
~~E2.1E FLOOR PLANS - LIGHTING - BUILDING C~~
~~E2.1F FLOOR PLANS - ELECTRICAL - BUILDING C~~
~~E2.1G FLOOR PLANS - LIGHTING - BUILDING D~~
~~E2.1H FLOOR PLANS - ELECTRICAL - BUILDING D~~
~~E2.1I FLOOR PLANS - LIGHTING - BUILDING E~~
~~E2.1J FLOOR PLANS - ELECTRICAL - BUILDING E~~


CIVIL

C0.1 CIVIL COVER SHEET
C0.2 PARTIAL TOPOGRAPHIC SURVEY
C0.3 PARTIAL TOPOGRAPHIC SURVEY
C1.1 PARTIAL DEMOLITION PLAN
C1.2 PARTIAL DEMOLITION PLAN
C2.1 PARTIAL GRADING PLAN
C2.2 PARTIAL GRADING PLAN
C3.1 PARTIAL UTILITY PLAN
C3.2 PARTIAL UTILITY PLAN
C4.1 PARTIAL PAVING PLAN
C4.2 PARTIAL PAVING PLAN
C4.3 STRIPING AND SIGNAGE PLAN
C4.4 STRIPING AND SIGNAGE PLAN AND DETAILS
C5.1 DETAILS
~~C5.2 DETAILS AND SECTIONS~~

~~C6.1 EROSION CONTROL PLAN~~
~~C7 COVER SHEET - FRONTAGE IMPROVEMENTS~~
~~C8 GENERAL NOTES - FRONTAGE IMPROVEMENTS~~
~~C9 IMPROVEMENT PLAN - FRONTAGE IMPROVEMENTS~~


LANDSCAPE

L0.1 TREE SHADING PLAN
L0.2 TREE SHADING PLAN
L1.1 TREE PLANTING PLAN
L1.2 TREE PLANTING PLAN
L2.1 SHRUB PLANTING PLAN
L2.2 SHRUB PLANTING PLAN
L3.1 LANDSCAPE IRRIGATION PLAN
L3.2 LANDSCAPE IRRIGATION PLAN
L4.1 LANDSCAPE PLANTING DETAILS
L4.2 LANDSCAPE IRRIGATION DETAILS
L5.1 WATER EFFICIENCY CHARTS

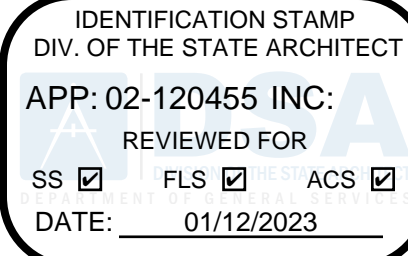

730 Howe Avenue, Suite 450
Sacramento, CA 95825
Phone: 916.921.2112
Fax: 916.921.2212

HENRY+
ASSOCIATES
ARCHITECTS

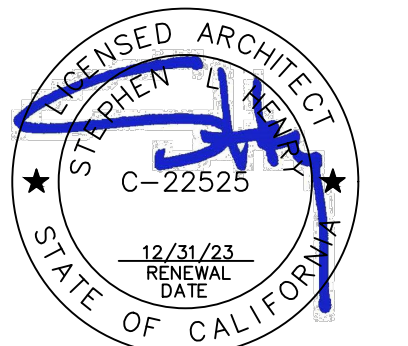




MODERNIZATION LAKEWOOD
ELEMENTARY SCHOOL

COVER SHEET

CONSULTANT









PROJECT NO.	REVISIONS	BY
21-32-052		
DATE 3/28/2022		
DRAWN MS		
CHECKED JCBS		
SCALE N.T.S.		
CADFILE		
UPDATED 11/17/2022		
SHEET NO.		

CS

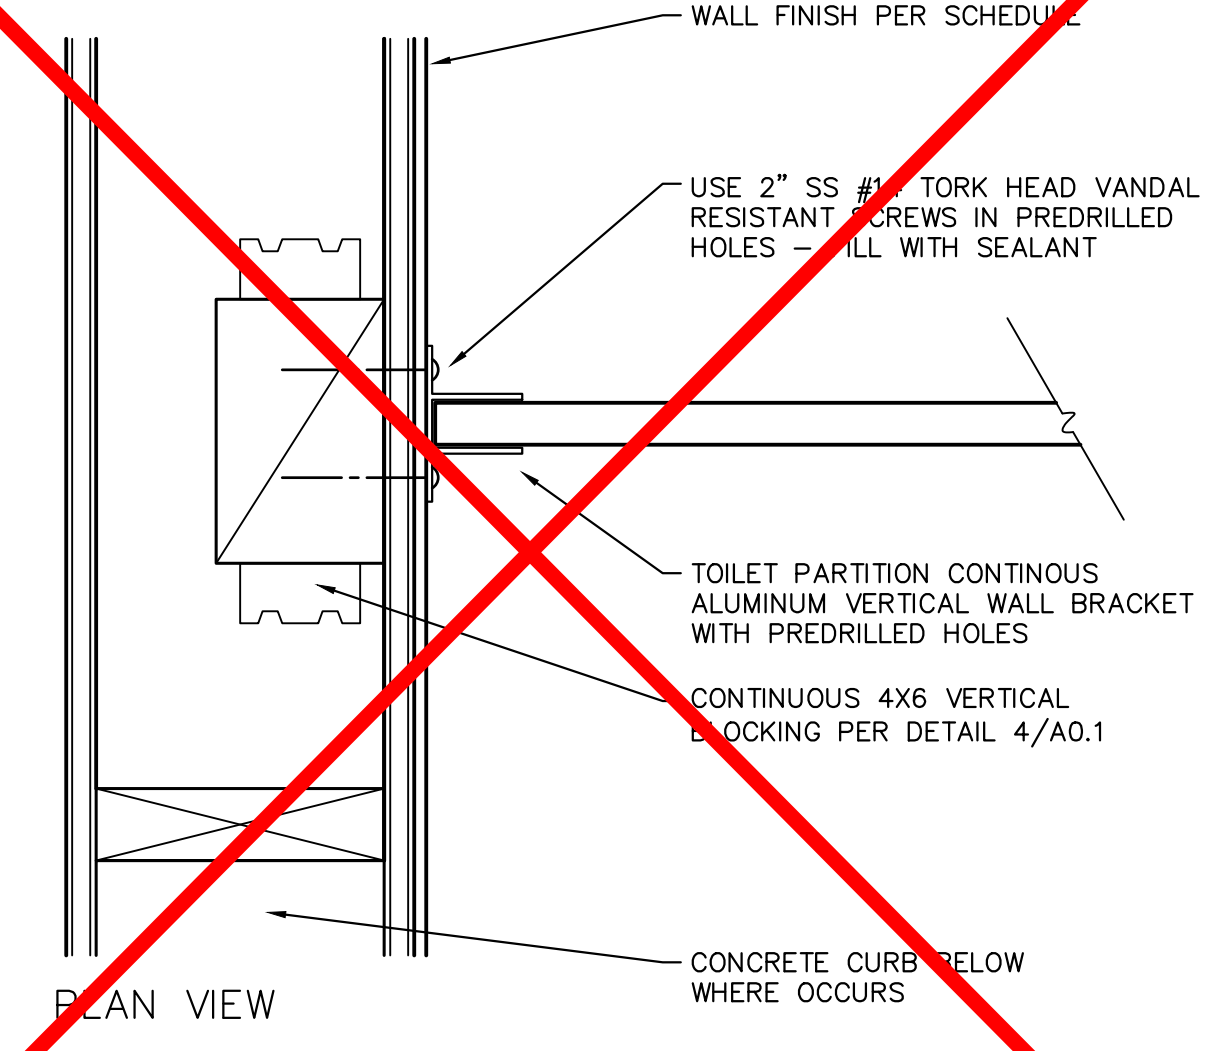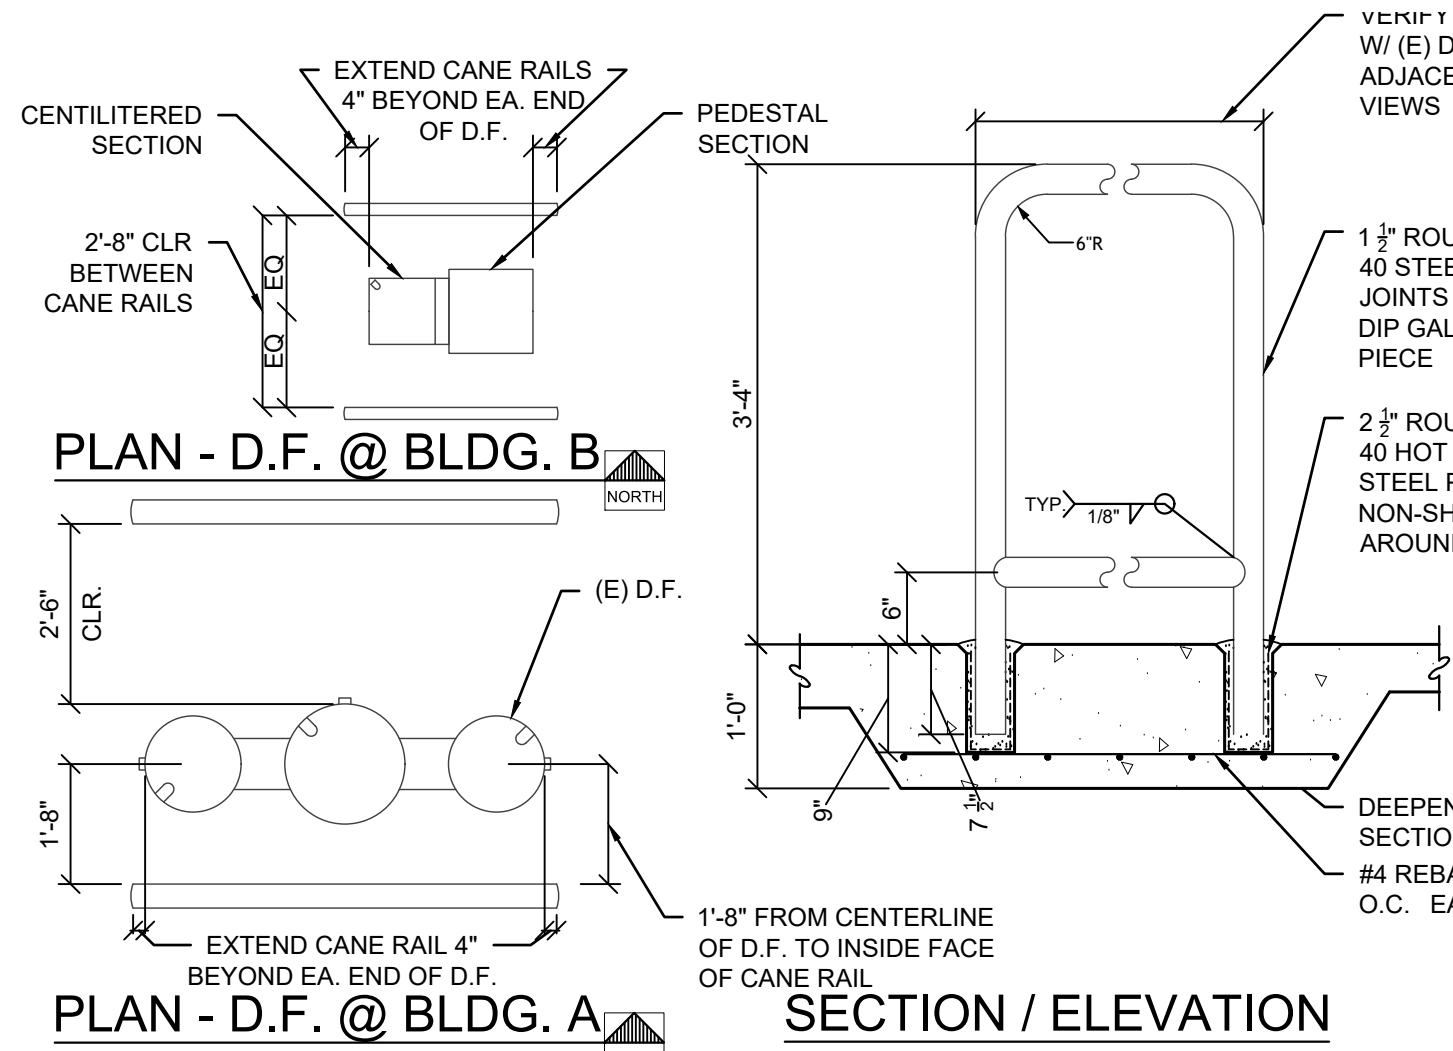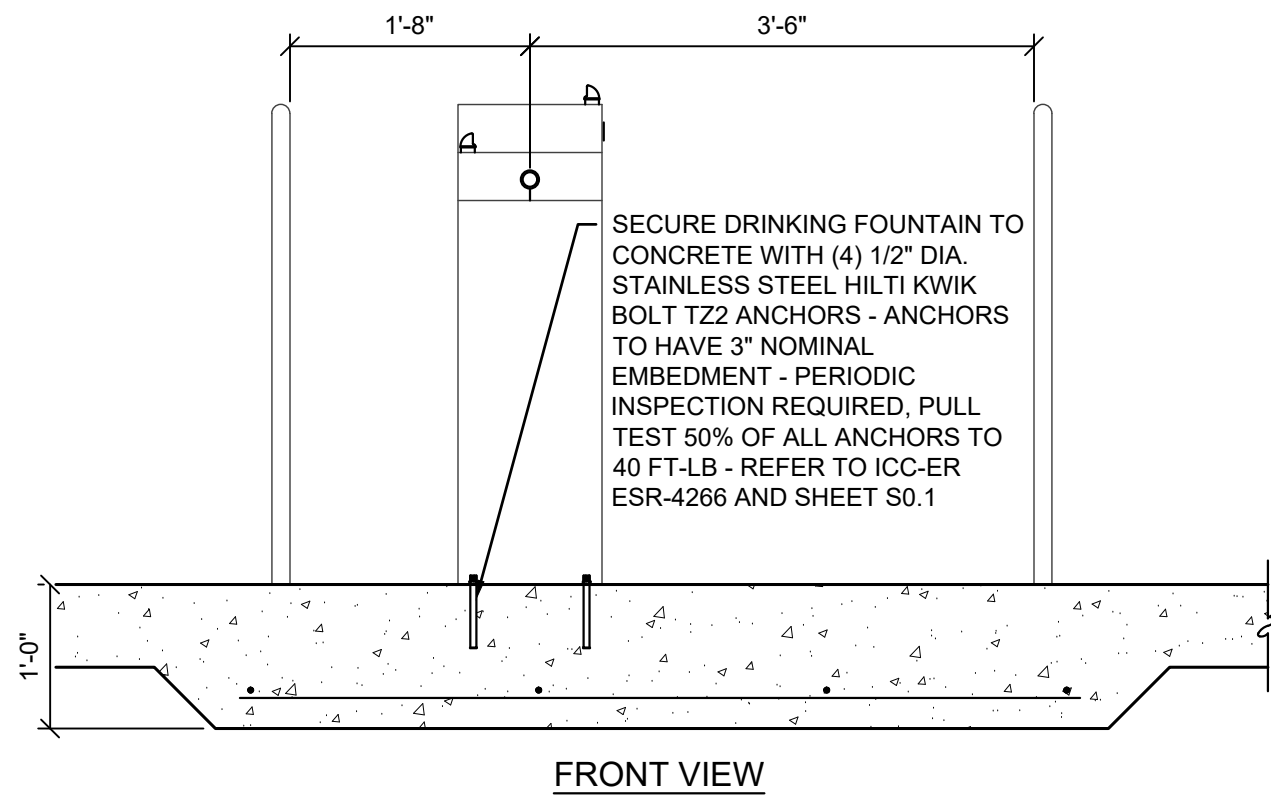

6 CANE RAILS @ D.F.'s

3 TOILET PARTITION MOUNTING @ WALL

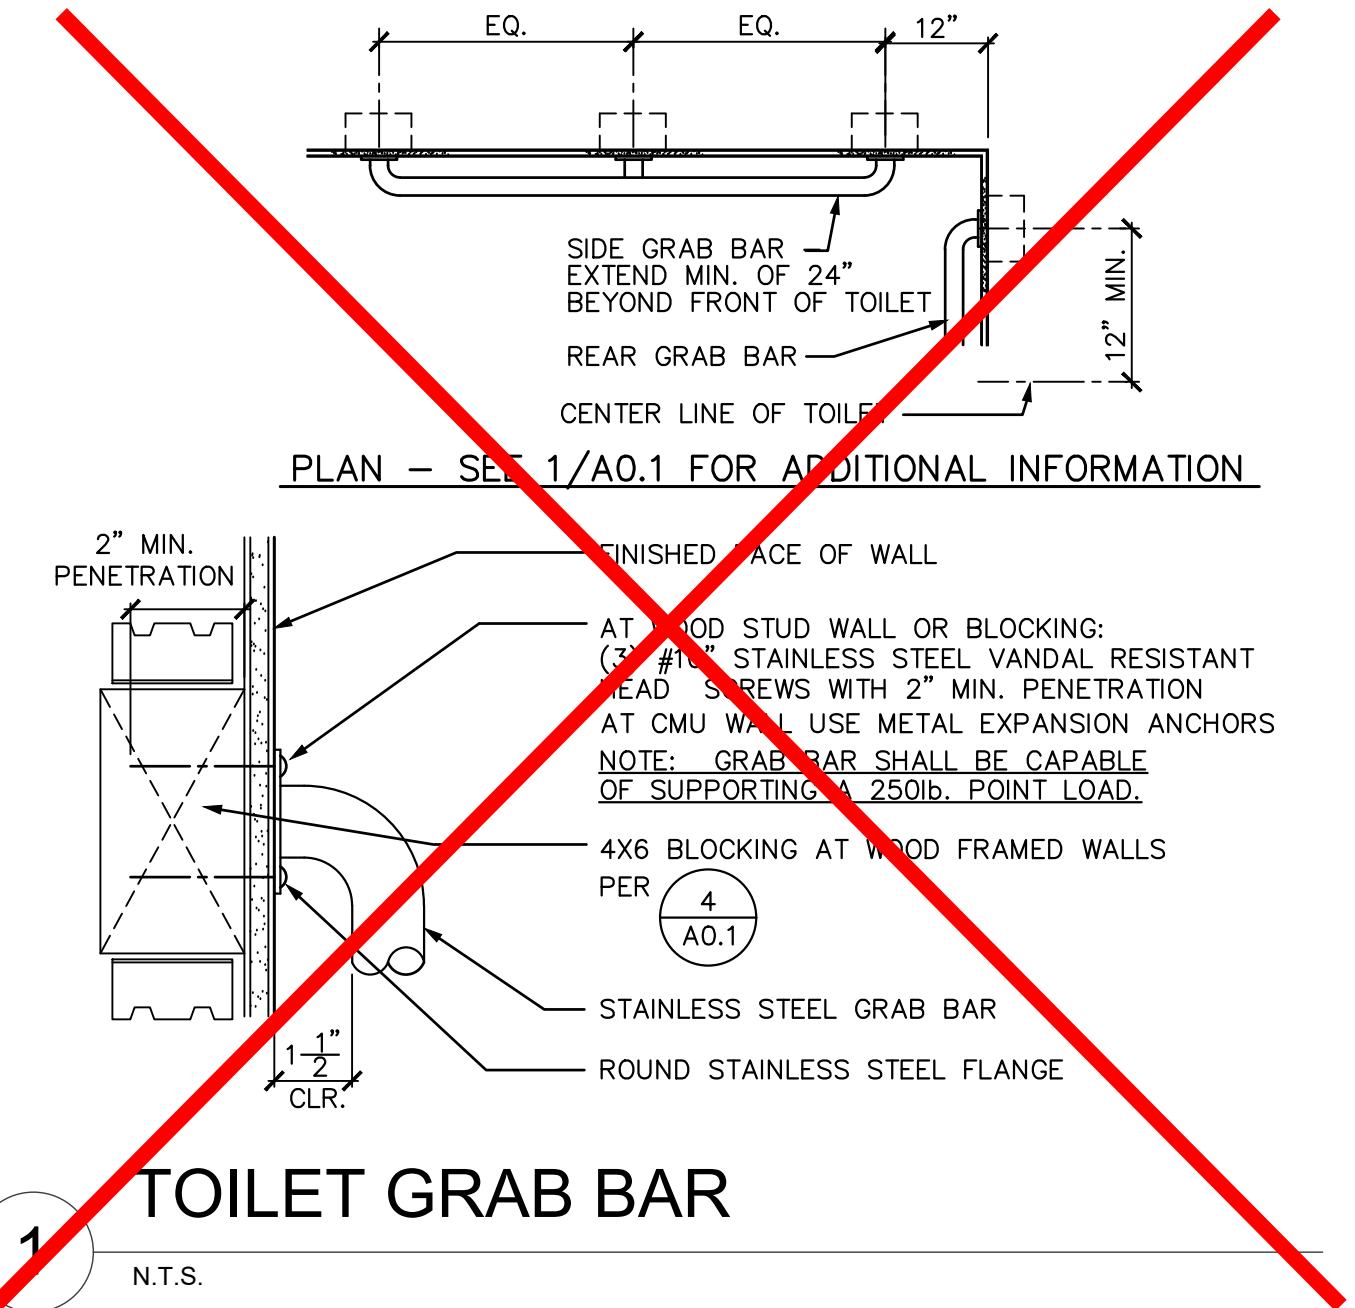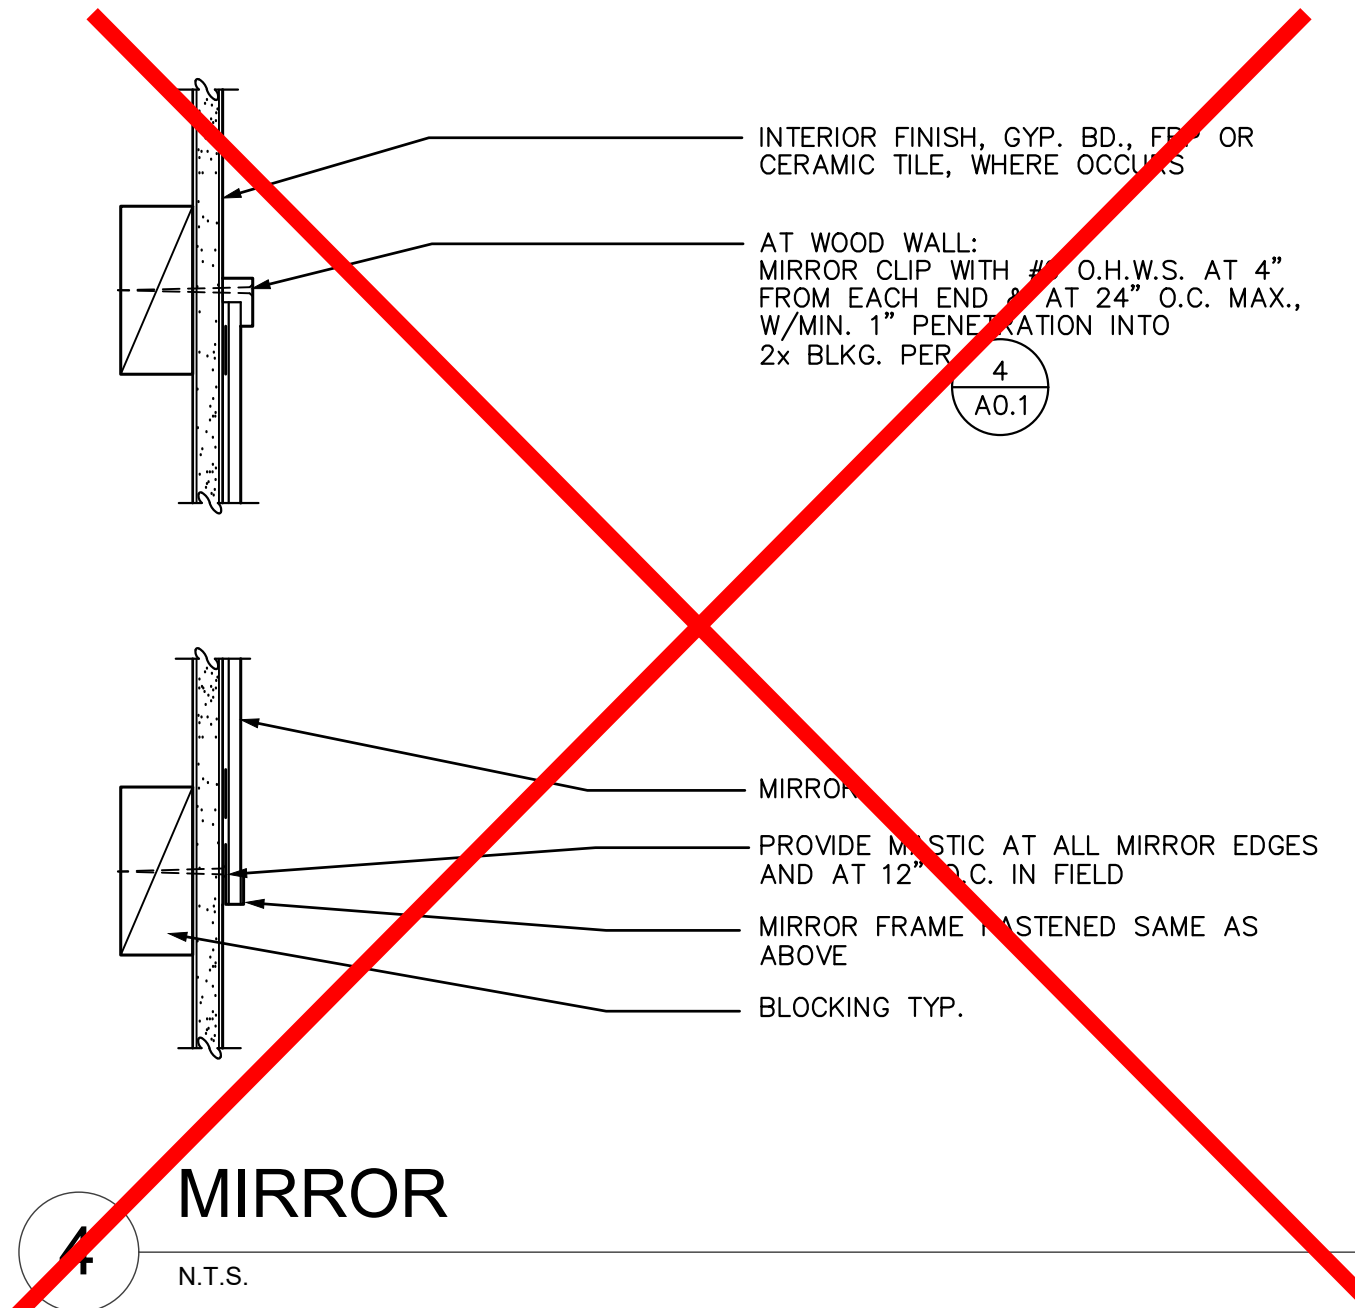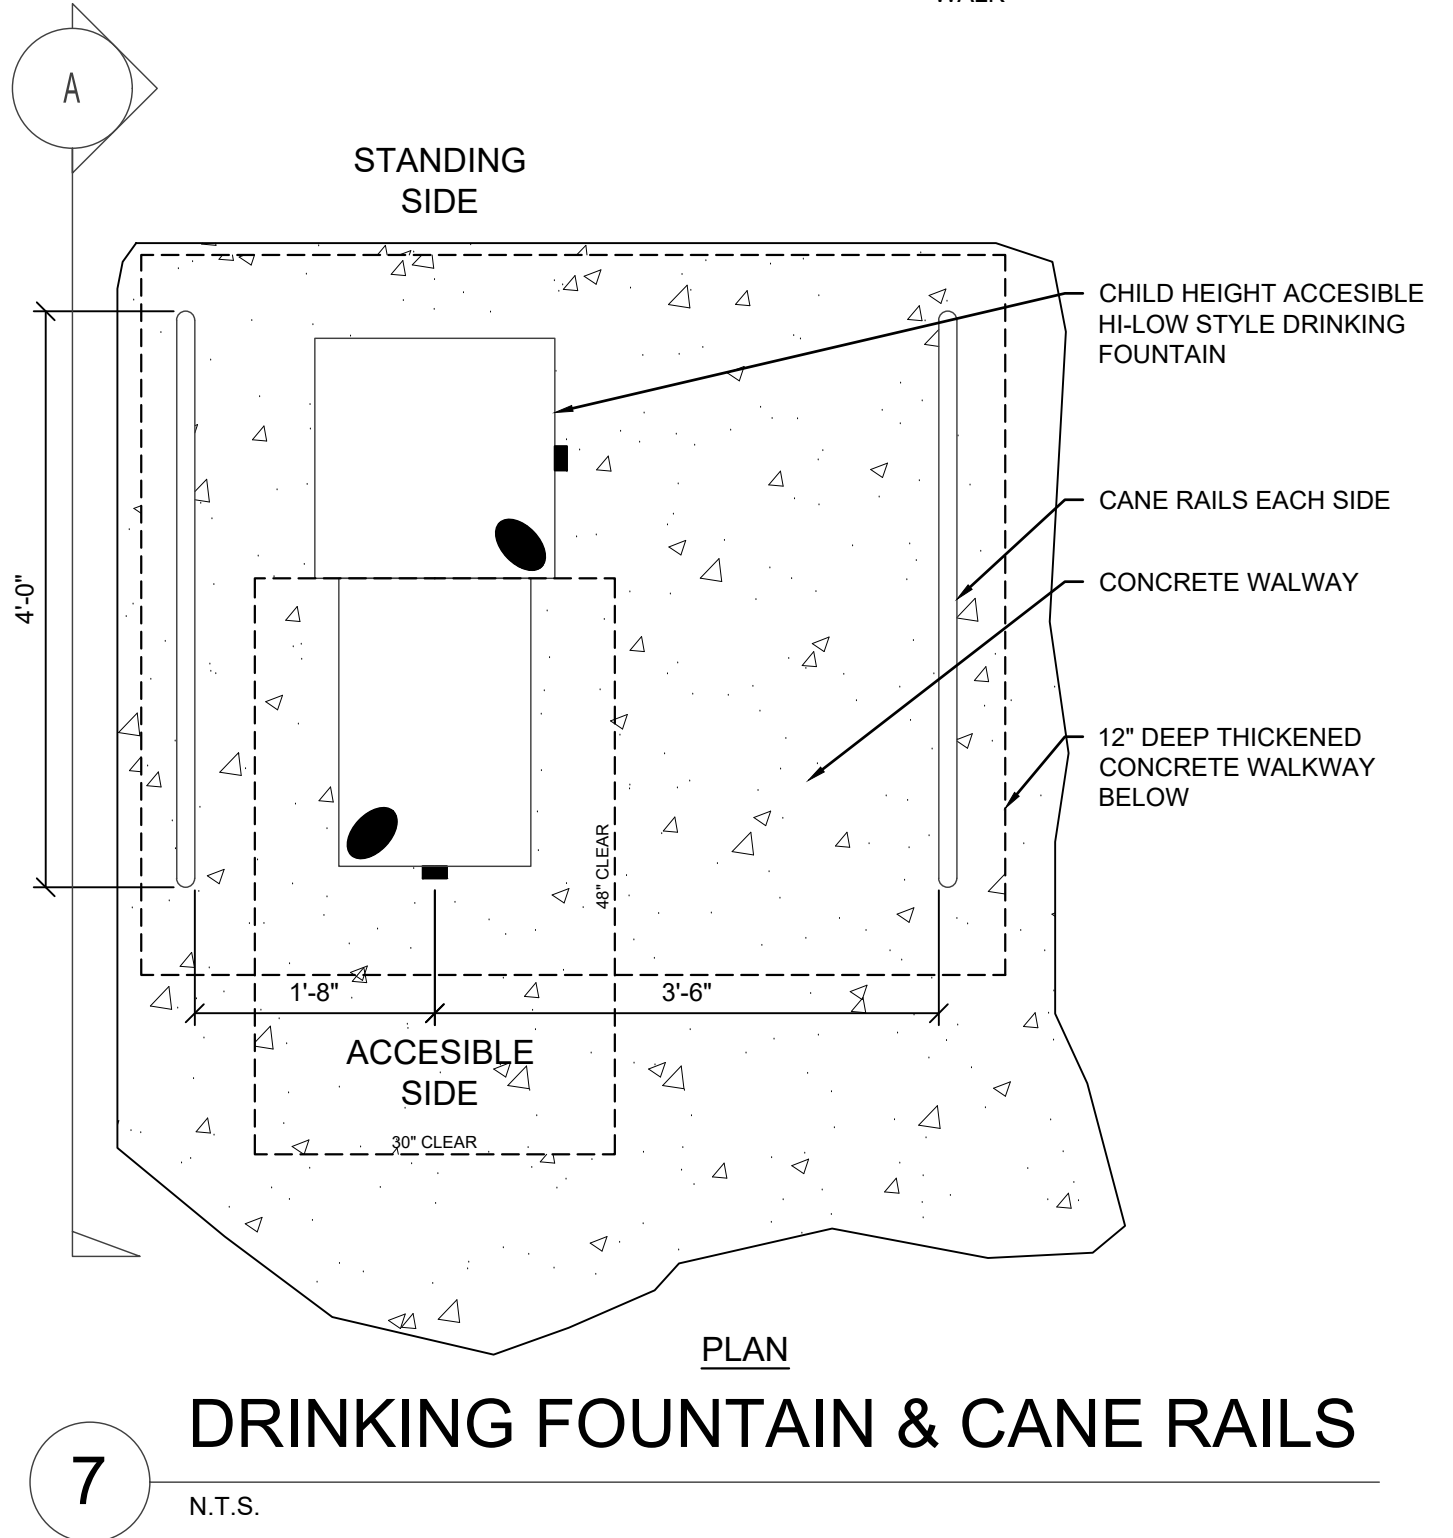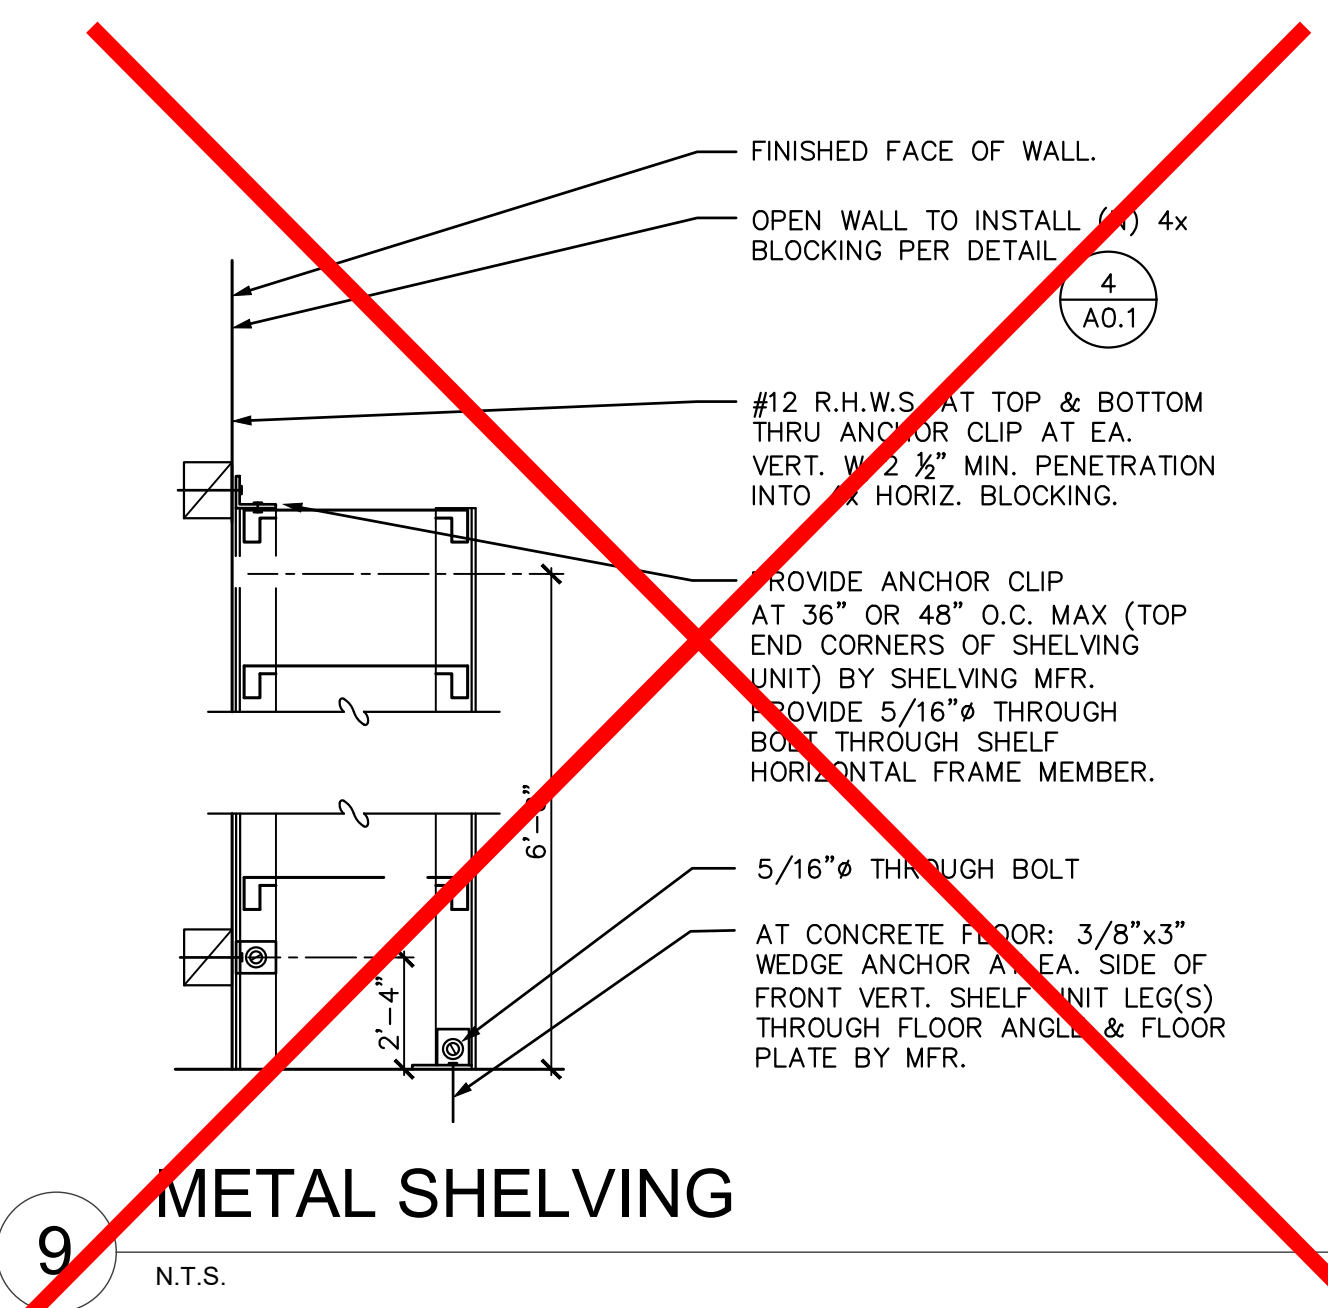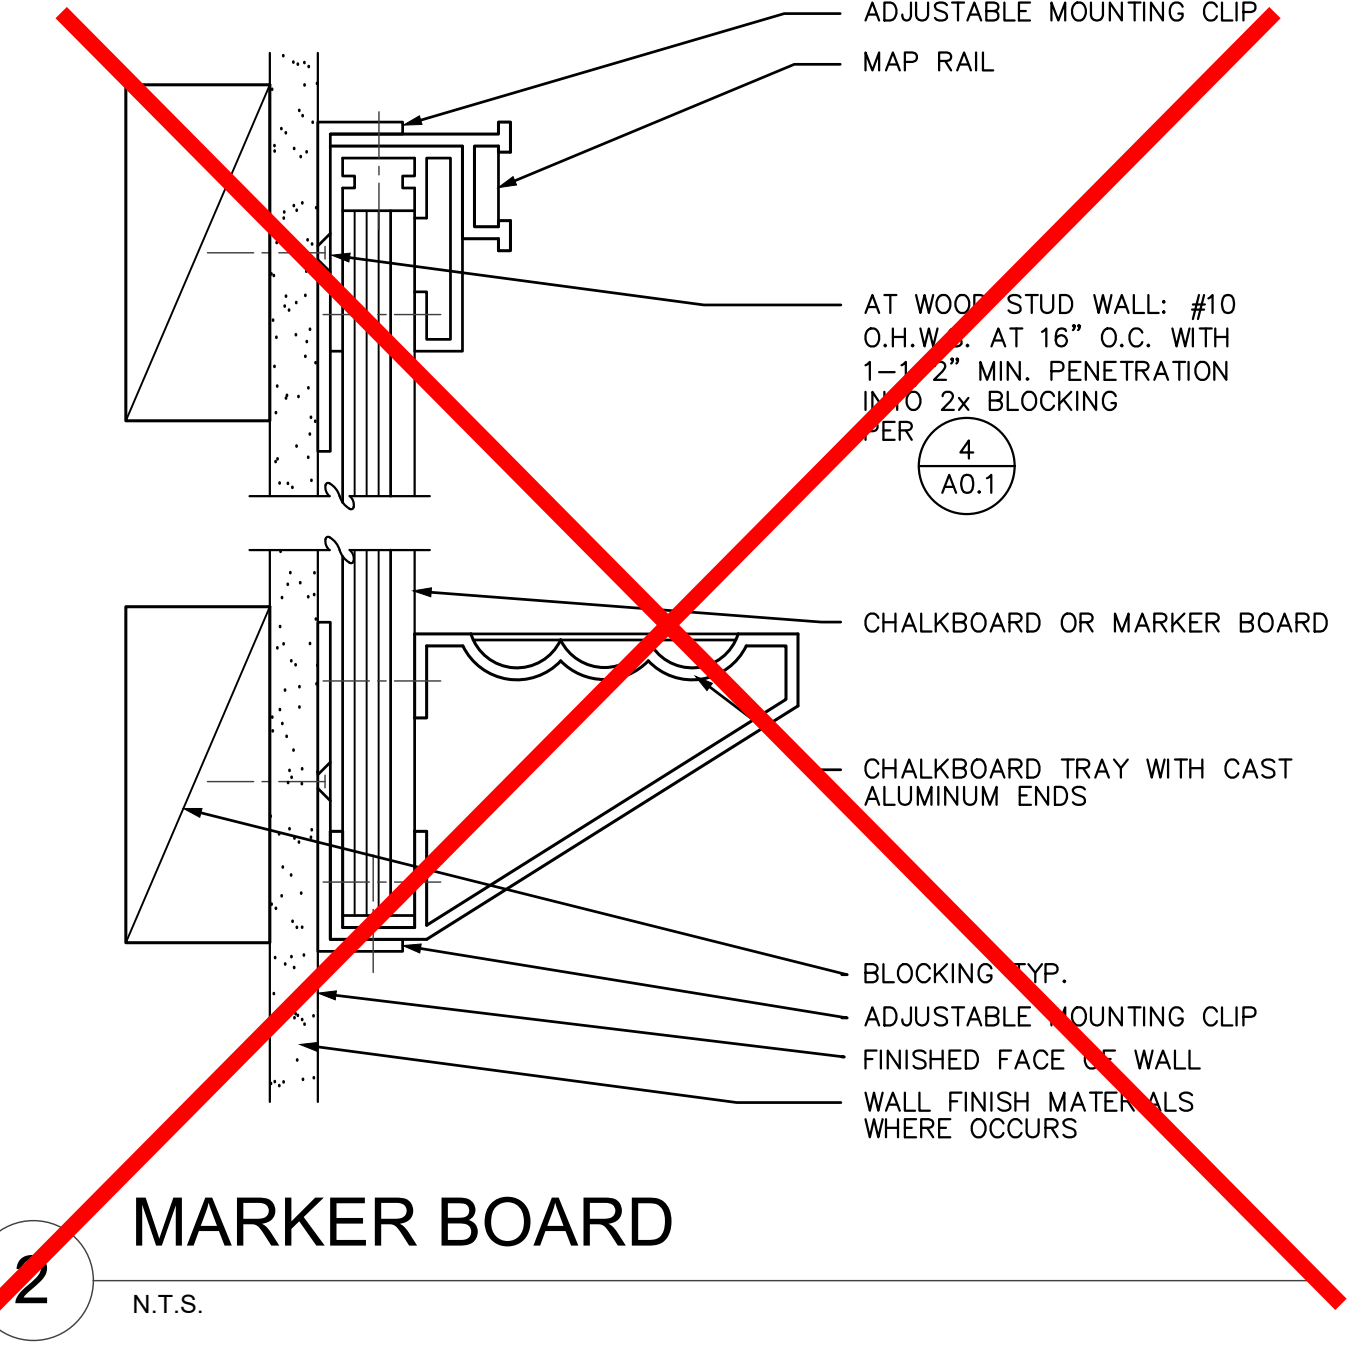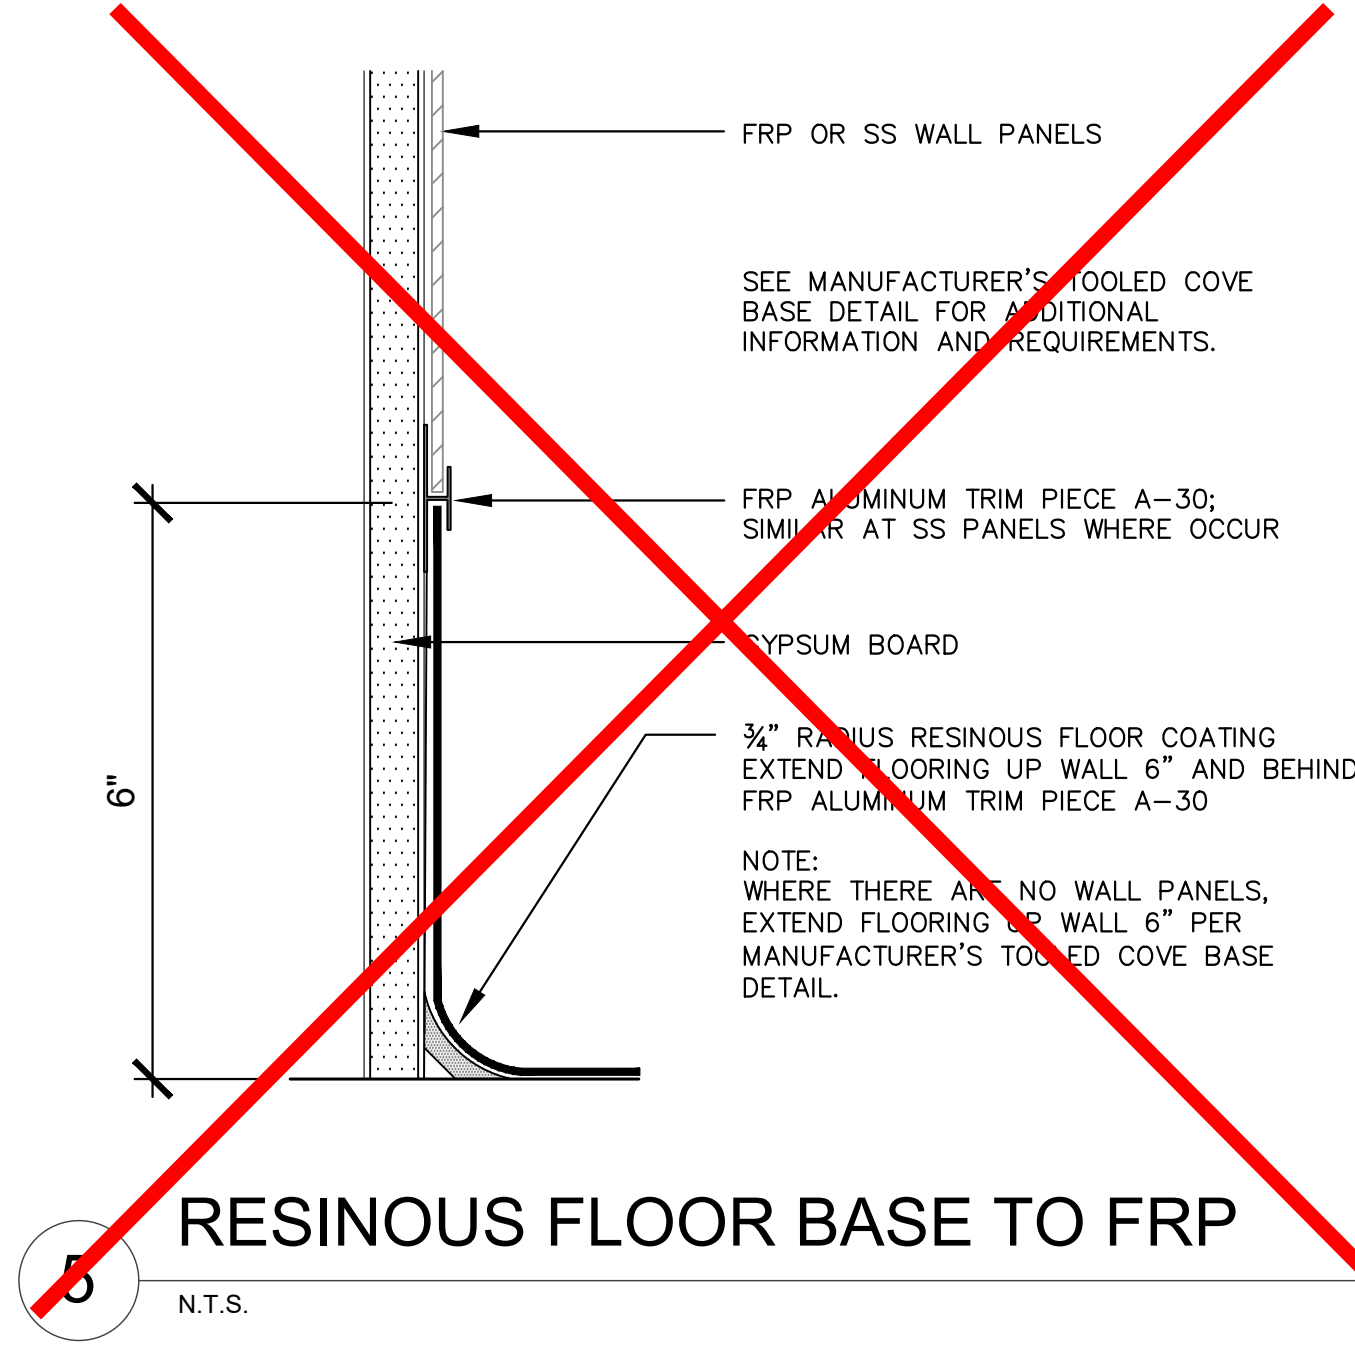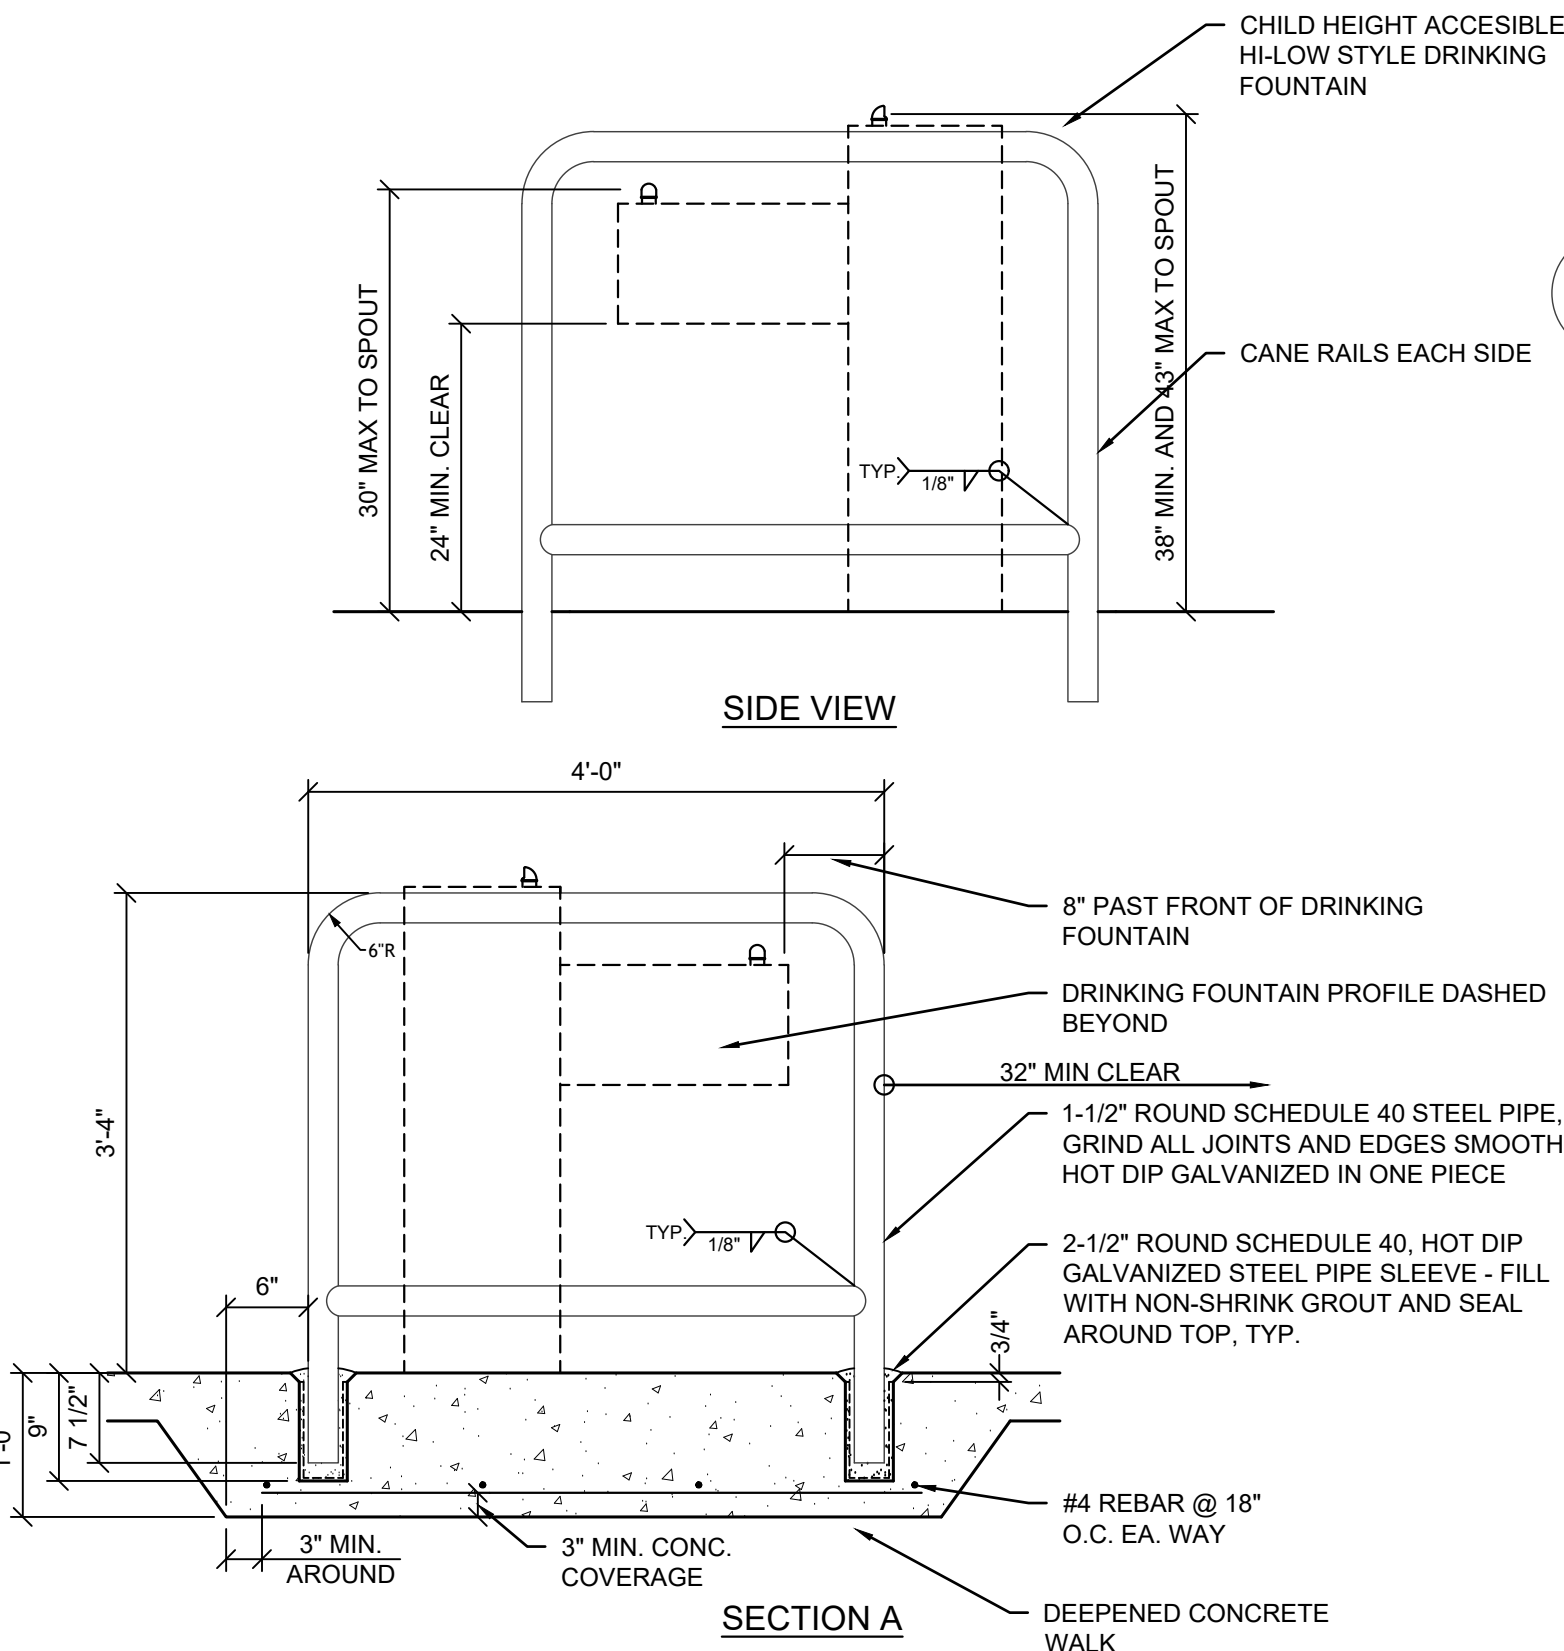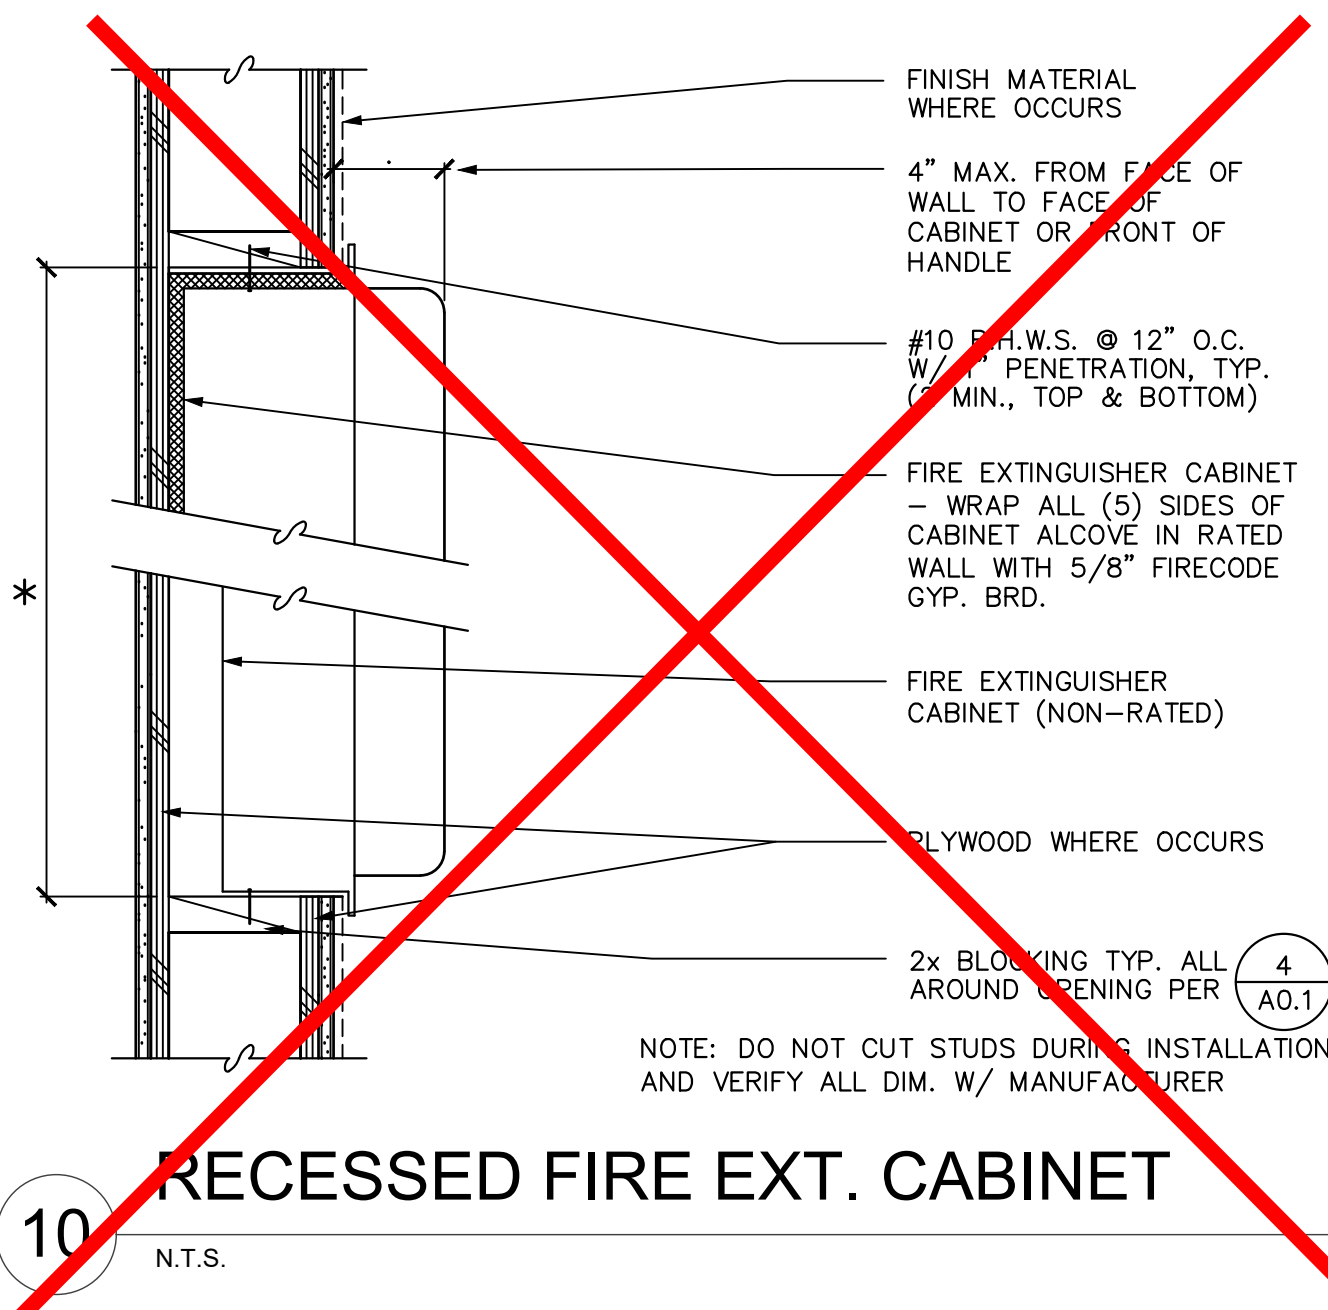

IDENTIFICATION STAMP
DIV. OF THE STATE ARCHITECT
APP: 02-120455 INC:
REVIEWED FOR
SS ☒ FLS ☒ ACS ☒
DATE: 01/12/2023

730 Howe Avenue, Suite 450
Sacramento, CA 95825
Phone: 916.921.2112
Fax: 916.921.2212

HENRY+
ASSOCIATES
ARCHITECTS



MODERNIZATION LAKEWOOD
ELEMENTARY SCHOOL

TYPICAL DETAILS

CONSULTANT		
PROJECT NO.	REVISIONS	BY
21-32-052		
DATE		
3/28/2022		
DRAWN		
MS		
CHECKED		
JCBS		
SCALE	N.T.S.	
CADFILE		
UPDATED		
11/17/2022		
SHEET NO.		

A0.2

FIRE & LIFE SAFETY SITE CONDITIONS SUBMITTAL

Division of the State Architect (DSA) documents referenced within this publication are available on the DSA Forms or DSA Publications webpages.

To facilitate the Division of the State Architect's (DSA) fire and life safety plan review of project site conditions, DSA requires the design professional to provide the following information at time of project submittal for projects consisting of construction of a new campus, construction of new building(s), additions to existing buildings, and for site alternate design means for fire department emergency vehicle access, and fire suppression water supply.

Information associated with compliance items 1 through 3 below is to be provided for all project types indicated above. Information associated with items 4 through 7 is to be completed when an alternate means is utilized. Acknowledgement by the school district and signature from the Local Fire Authority (LFA) is only required when an alternate design means is being requested.

The Project Information and Fire & Life Safety Information sections are to be completed for all projects and imaged onto the fire access site plan. When an alternate design/means is proposed, all sections on pages 1 and 2 are to be completed and imaged on the fire access site plan.

For additional information refer to the instructions at the end of this form and DSA Policy PL 09-01: Fire Flow for Buildings.

PROJECT INFORMATION

School District/Owner:	LODI UNIFIED SCHOOL DISTRICT
Project Name/School:	MODERNIZATION LAKEWOOD ES / LAKEWOOD ELEMENTARY SCHOOL
Project Address:	1100 N. HAM LANE, LODI, CA 95242

FIRE & LIFE SAFETY INFORMATION

1. Has a fire hydrant flow test been performed within the past 12 months? (If yes, provide a copy of the test data.)	Yes <input type="checkbox"/>	No <input checked="" type="checkbox"/>	
2. Was the fire hydrant water flow test performed as part of this LFA review?	Yes <input type="checkbox"/>	No <input checked="" type="checkbox"/>	
3. Is the project located within a designated fire hazard severity zone (FHSZ) as established by Cal-Fire? (If yes, indicate FHSZ classification below.)	Yes <input type="checkbox"/>	No <input checked="" type="checkbox"/>	
Refer to the following website for FHSZ locations: http://gis.fire.ca.gov/FHSZ/	Moderate <input type="checkbox"/>	High <input type="checkbox"/>	Very High <input type="checkbox"/>
Wildland Interface Area (WIFA) (If any designations are checked, project design must meet the requirements of CBC Chapter 7A.)	WIFA <input type="checkbox"/>		

DSA 810 FIRE & LIFE SAFETY SITE CONDITIONS SUBMITTAL

CONDITION MEANS AND METHODS RESOLUTION		ALTERNATE ACCEPTED			
		Yes	No	N/A	N/R
4.	Emergency vehicle access roadways do not meet CFC requirements.				
4a.	Acceptable Alternate: Emergency vehicle and personnel access as proposed by the project architect is acceptable for providing fire suppression and protection of life and property.	X			
5.	Fire Hydrants: Number and spacing does not meet CFC requirements.			X	
5a.	Acceptable Alternate: Number of fire hydrants and spacing as proposed by the project architect is acceptable for fire suppression and protection of life and property.				
6.	Fire Hydrants: Water flow and pressure are less than CFC minimum.			X	
6a.	Acceptable Alternate: The available flow and pressure is acceptable for providing fire suppression and protection of life and property.				
7.	Location of fire department connection(s) serving fire sprinkler systems or standpipe systems does not meet CFC requirements.			X	
7a.	Acceptable Alternate: The location of fire department connection serving the fire sprinkler system and/or standpipe system is acceptable for providing fire suppression and protection of life and property.				

School District Acceptance of Acceptable Design Alternates

By signing this form, the school district acknowledges and accepts the proposed design as an alternative to California Building Code (CBC) and California Fire Code (CFC) minimum requirements, as indicated by one or more of the conditions indicated at items 4a, 5a, 6a or 7a, for providing fire and life safety protection of life and property.

Accepted by: Leonard Kuhn Title: CBO

Signature: _____ Date: 12/8/2022

LOCAL FIRE AUTHORITY (LFA) INFORMATION


LFA Agency Name:	CITY OF LODI FIRE DEPARTMENT		
LFA Review Official:	BRAD DOELL		
Title:	BATTALION CHIEF / FIRE MARSHALL	Work Phone:	209-333-6739
Work Email:	bdoell@lodi.gov		
LFA Reviewer's Signature:	<u>Brad Doell</u>	Date:	12/7/22

LFA STATEMENT OF ALTERNATE MEANS

THE FOLLOWING ALTERNATE MEANS ARE ACCEPTABLE TO THE CITY OF LODI FIRE DEPARTMENT (LFA) AS A WAY TO MITIGATE THE DISTANCES IN EXCESS OF 150' FROM THE HARDCOURT EMERGENCY VEHICLE ACCESS STAGING LOCATION TO BUILDING B, BUILDING C AND BUILDING E:

- THE LFA CARRIES IN EXCESS OF 1,000 LF OF FIRE HOSE ON THEIR TRUCKS AND IS TRAINED AND PREPARED TO COUPLE AND EXTEND FIRE HOSE AS MAY BE NECESSARY TO REACH THE ABOVE LISTED BUILDINGS AND AS MAY BE REQUIRED TO FIGHT A FIRE.
- FOR AN ALTERNATE EMERGENCY RESPONSE APPROACH REQUIRED BY THE LFA AT BUILDING E AND BUILDING C, THE LFA WOULD STAGE THEIR EQUIPMENT AT N. HAM LANE WEST OF BUILDING E AND ENTER THE SITE THROUGH THE MAIN GATE JUST SOUTH OF BUILDING E. THE LFA HAS THE PROPER KEY CARDS AND ACCESS KEYS TO OPEN THESE GATES.

Brad Doell, Battalion Chief / Fire Marshal
City of Lodi Fire Department

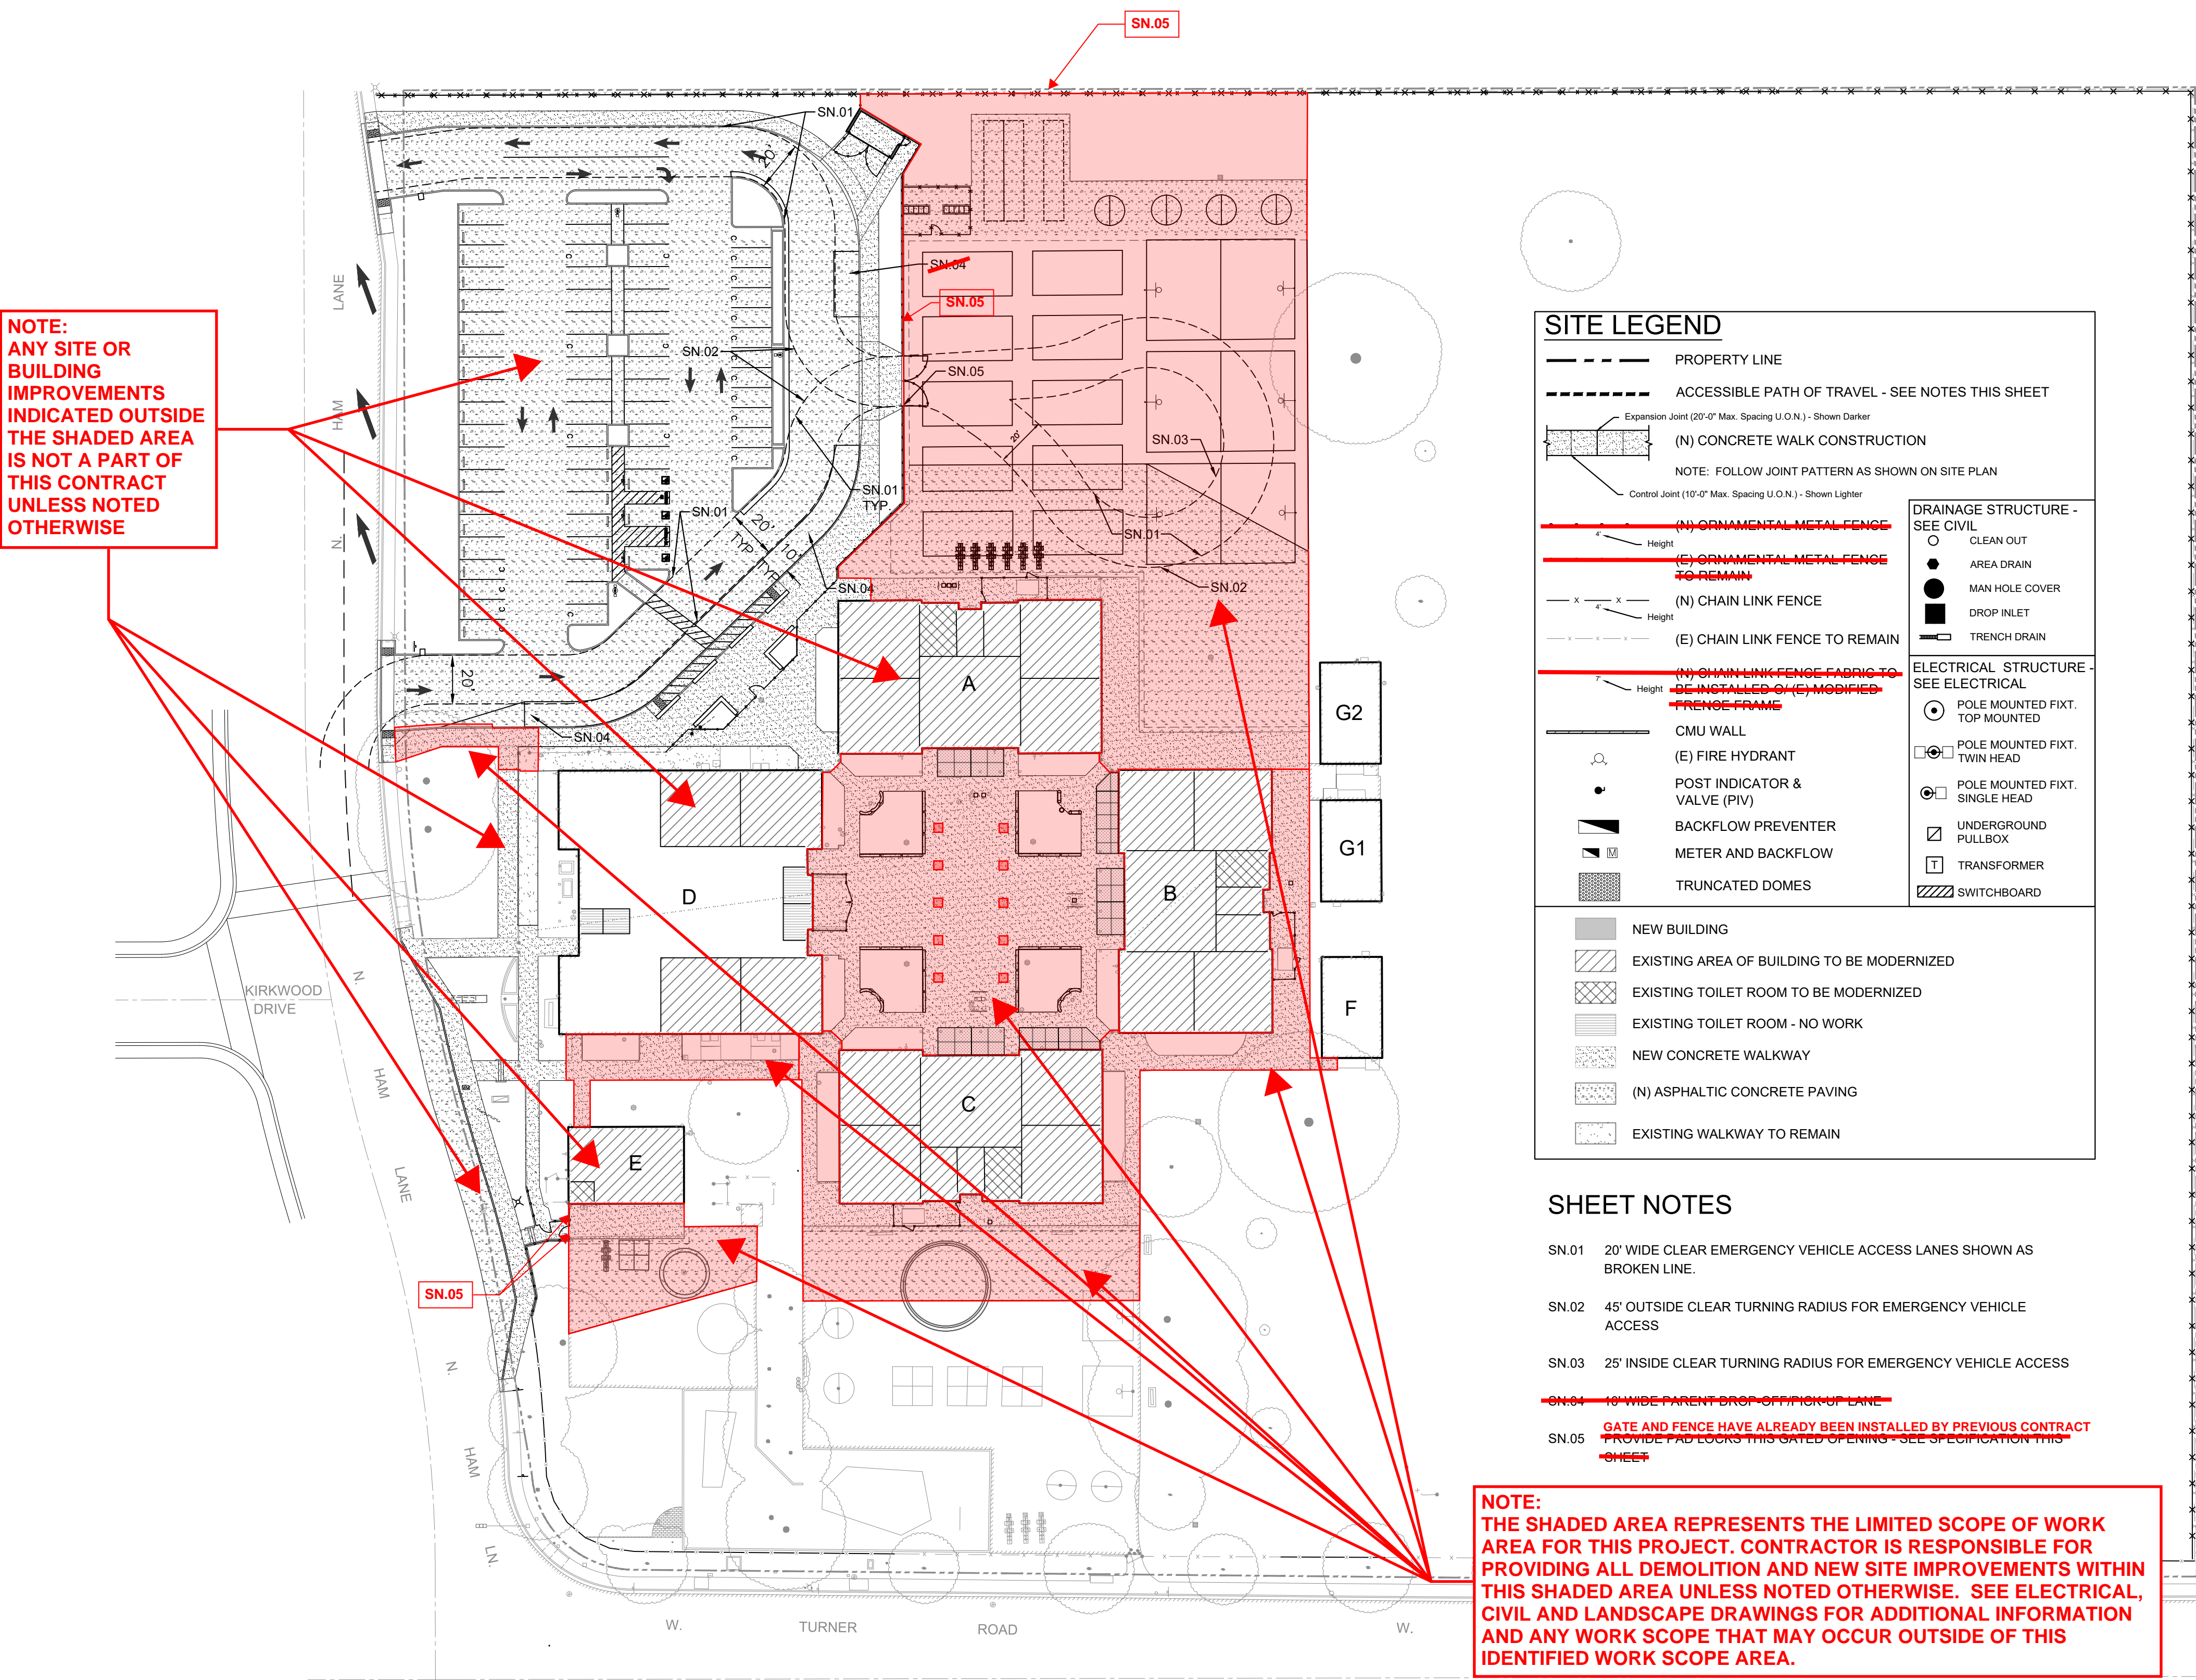

NOTE:
ANY SITE OR
BUILDING
IMPROVEMENTS
INDICATED OUTSIDE
THE SHADED AREA
IS NOT A PART OF
THIS CONTRACT
UNLESS NOTED
OTHERWISE

SITE LEGEND

--- PROPERTY LINE

--- ACCESSIBLE PATH OF TRAVEL - SEE NOTES THIS SHEET

(N) CONCRETE WALK CONSTRUCTION

NOTE: FOLLOW JOINT PATTERN AS SHOWN ON SITE PLAN

(N) ORNAMENTAL METAL FENCE

(E) ORNAMENTAL METAL FENCE TO REMAIN

(N) CHAIN LINK FENCE

(E) CHAIN LINK FENCE TO REMAIN

(N) CHAIN LINK FENCE FABRIC TO BE INSTALLED (SHE) MODIFIED FENCE FRAMES

CMU WALL

(E) FIRE HYDRANT

POST INDICATOR & VALVE (PIV)

BACKFLOW PREVENTER

METER AND BACKFLOW

TRUNCATED DOMES

NEW BUILDING

EXISTING AREA OF BUILDING TO BE MODERNIZED

EXISTING TOILET ROOM TO BE MODERNIZED

EXISTING TOILET ROOM - NO WORK

NEW CONCRETE WALKWAY

(N) ASPHALTIC CONCRETE PAVING

EXISTING WALKWAY TO REMAIN

DRAINAGE STRUCTURE - SEE CIVIL

CLEAN OUT

AREA DRAIN

MAN HOLE COVER

DROP INLET

TRENCH DRAIN

ELECTRICAL STRUCTURE - SEE ELECTRICAL

POLE MOUNTED FIXT. TOP MOUNTED

POLE MOUNTED FIXT. TWIN HEAD

POLE MOUNTED FIXT. SINGLE HEAD

UNDERGROUND PULLBOX

TRANSFORMER

SWITCHBOARD

SHEET NOTES

- SN.01 20' WIDE CLEAR EMERGENCY VEHICLE ACCESS LANES SHOWN AS BROKEN LINE.
- SN.02 45' OUTSIDE CLEAR TURNING RADIUS FOR EMERGENCY VEHICLE ACCESS
- SN.03 25' INSIDE CLEAR TURNING RADIUS FOR EMERGENCY VEHICLE ACCESS
- ~~SN.04 18' WIDE PARENT DROP OFF/PICK UP LANE~~
- SN.05 ~~GATE AND FENCE HAVE ALREADY BEEN INSTALLED BY PREVIOUS CONTRACT PROVIDE PAD LOCKS THIS GATED OFFERING - SEE SPECIFICATION THIS SHEET~~


NOTE:
THE SHADED AREA REPRESENTS THE LIMITED SCOPE OF WORK AREA FOR THIS PROJECT. CONTRACTOR IS RESPONSIBLE FOR PROVIDING ALL DEMOLITION AND NEW SITE IMPROVEMENTS WITHIN THIS SHADED AREA UNLESS NOTED OTHERWISE. SEE ELECTRICAL, CIVIL AND LANDSCAPE DRAWINGS FOR ADDITIONAL INFORMATION AND ANY WORK SCOPE THAT MAY OCCUR OUTSIDE OF THIS IDENTIFIED WORK SCOPE AREA.

KEY BOX & PADLOCK SPECIFICATION

KEY BOX: KNOX RESIDENTIAL BOX MODEL 1002 BLACK MOUNT TO 6" GATE POST WITH THROUGH BOLT AS RECOMMENDED BY MFR. VERIFY ANY SPECIAL KEYING WITH SCHOOL DISTRICT, LOCAL FIRE DEPARTMENT AND POLICE.


PADLOCK: KNOX PADLOCK MODEL 3781 PADLOCK TO BE KEYPED PER LOCAL FIRE DEPARTMENT AND POLICE STANDARDS - PROVIDE 2.

BUILDING DATA					
BUILDING	DSA APPLICATION NUMBER	CONSTRUCTION TYPE	OCCUPANCY TYPE	AREA (SF)	CERTIFIED
BLDG. A - CLASSROOMS	23521, 02-106411	VB, NOT SPRINKLERED	E	6,320	Y
BLDG. B - CLASSROOMS	23521, 02-106411	VB, NOT SPRINKLERED	E	6,320	Y
BLDG. C - CLASSROOMS	23521, 02-106411	VB, NOT SPRINKLERED	E	6,320	Y
BLDG. D - ADMINISTRATION/ MULTI-PURPOSE/CLASSROOMS	25287, 02-106411, 02-112790	VB, NOT SPRINKLERED	B/A-2/E	10,575	Y
BLDG. E - KINDERGARTEN	23521	VB, NOT SPRINKLERED	E	1,425	Y
BLDG. F - RELOCATABLE	46992	VB, NOT SPRINKLERED	E	960	Y
BLDG. G1 - RELOCATABLE	48768	VB, NOT SPRINKLERED	E	960	Y
BLDG. G2 - RELOCATABLE	48768	VB, NOT SPRINKLERED	E	960	Y

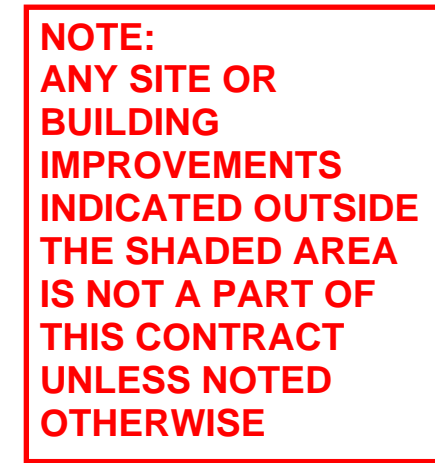

NOTE:
THE SHADED AREA REPRESENTS THE LIMITED SCOPE OF WORK AREA FOR THIS PROJECT. CONTRACTOR IS RESPONSIBLE FOR PROVIDING ALL DEMOLITION AND NEW SITE IMPROVEMENTS WITHIN THIS SHADED AREA UNLESS NOTED OTHERWISE. SEE ELECTRICAL, CIVIL AND LANDSCAPE DRAWINGS FOR ADDITIONAL INFORMATION AND ANY WORK SCOPE THAT MAY OCCUR OUTSIDE OF THIS IDENTIFIED WORK SCOPE AREA.

SITE LEGEND

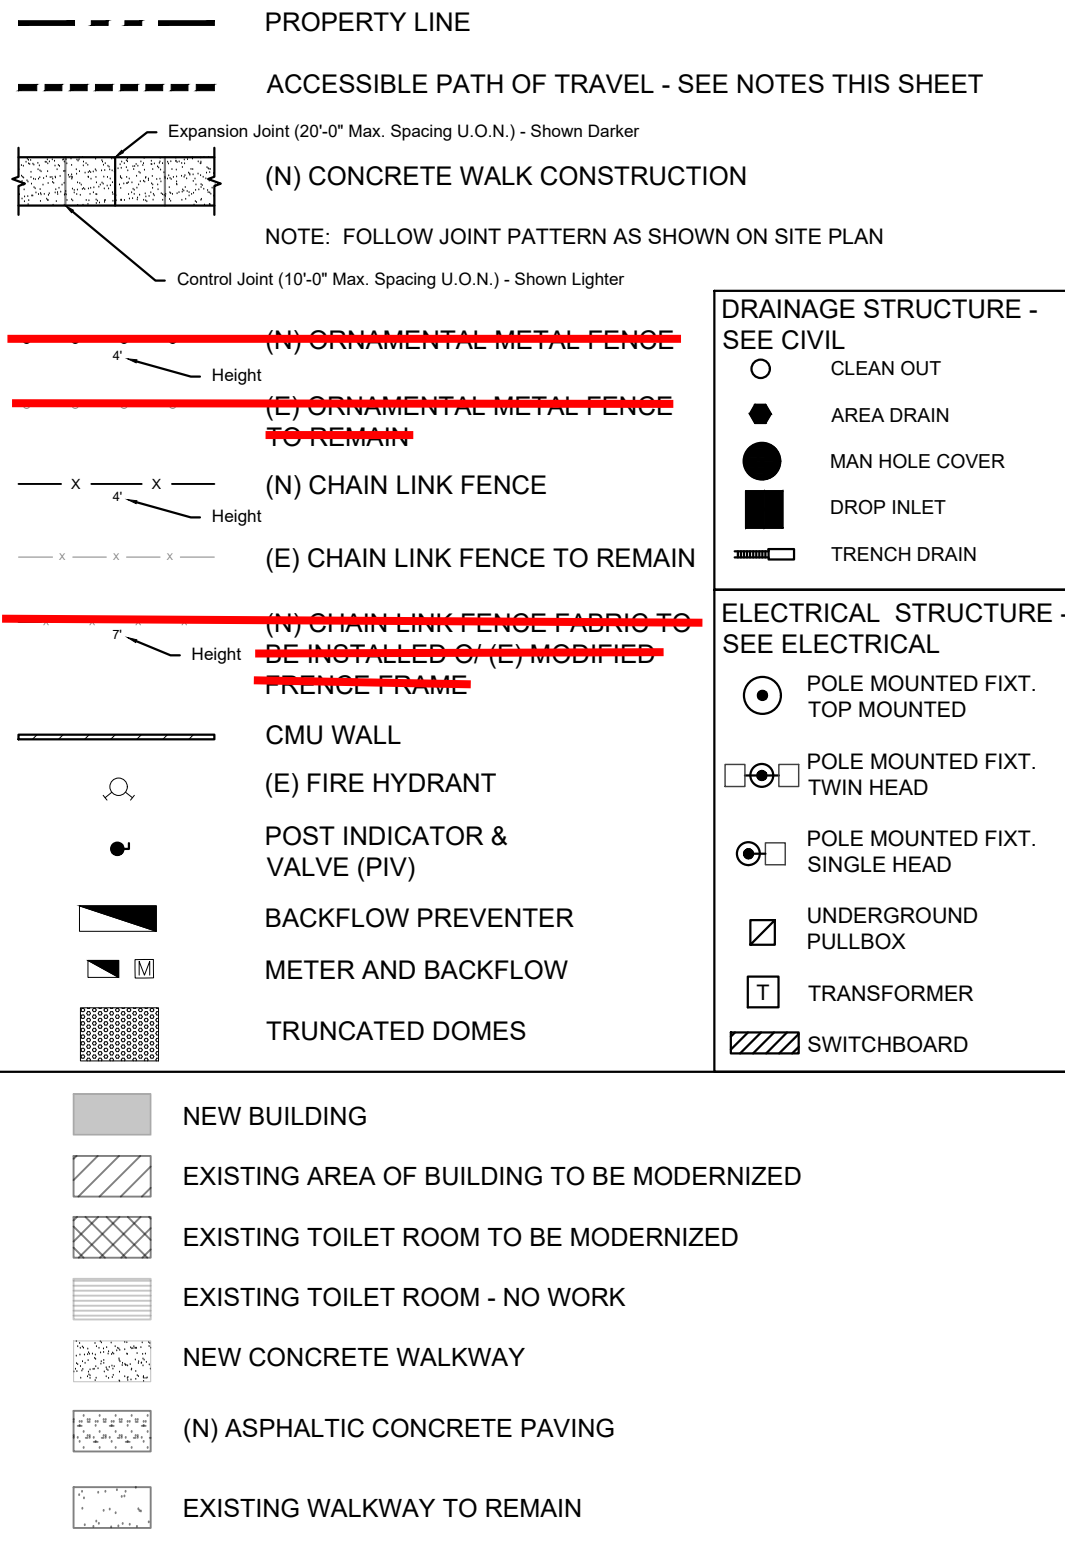

SHEET NOTES

SN.01	D.A. PATH OF TRAVEL
SN.02	D.A. PATH OF TRAVEL FROM PUBLIC RIGHT OF WAY
SN.03	D.A. STUDENT TOILET ROOMS CONSTRUCTED UNDER DSA IDENTIFICATION NO. 02-111648
SN.04	D.A. STAFF TOILET ROOMS CONSTRUCTED UNDER DSA IDENTIFICATION NO. 02-111648
SN.05	NEW TOW-AWAY SIGN - SEE CIVIL
SN.06	NEW 20' CLEAR EMERGENCY VEHICLE ACCESS GATES
SN.07	D.A. STUDENT TOILET ROOMS TO BE CONSTRUCTED BY THIS CONTRACT, DSA IDENTIFICATION NO. 02-120455

KEYNOTES

3200 SITEWORK
3200.A4 (E) FIRE HYDRANT


PATH OF TRAVEL: - - - - -

Path of travel (P.O.T.) as indicated is a barrier free access without any abrupt vertical changes exceeding $\frac{1}{2}$ " at 1:2 Maximum slope, except that level changes do not exceed $\frac{1}{4}$ " vertical (11B-303 & 11B-403.4). P.O.T. is a minimum of 48" wide (11B-403.5.1Ex3) slip resistant surface with 5% max. slope and 1:48 max. cross slope (11B-403.3). Passing spaces (11B-403.5.3) of 60"x60" min. are located not more than 200' apart. Walks with continuous gradients have 80" in length of level areas (11B-403.7) not more than 400' apart. P.O.T. shall be maintained free of overhanging obstructions to 80" min (11B-307.4) and protruding objects (11B-307) greater than 4" projection from wall above 27" and less than 80". There is no drop-off over 4" at the edge of walk or landing unless identified by a guard, a handrail, or a warning curb at least 6" in height above the walk (11B-303.5).


Design Professional in General Responsible Charge Statement

The POT identified in the construction documents is compliant with current applicable California Building Code accessibility provisions **for path of travel requirements for alterations and structural repairs.** As part of the design of this project, the POT was examined and any elements, components or portion of the POT that were determined to be noncompliant 1) have been identified and 2) the corrective work necessary to bring them into compliance has been included within the scope of this project's work through details, drawings and specification incorporated into these construction documents. Any noncompliant elements, components or portion of the POT that will not be corrected by this project based on valuation threshold limitations or a finding of unreasonable hardship are so indicated in these construction documents.

During construction, if POT items within the scope of the project represented as code compliant are found to be nonconforming beyond reasonable construction tolerances, they shall be brought into compliance with the CBC as a part of this project by means of a "Construction Change Document" (form **DSA 140**).

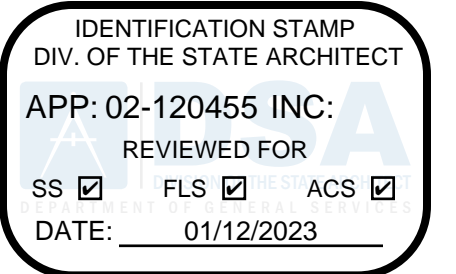

730 Howe Avenue, Suite 450
Sacramento, CA 95825
Phone: 916.921.2112
Fax: 916.921.2212

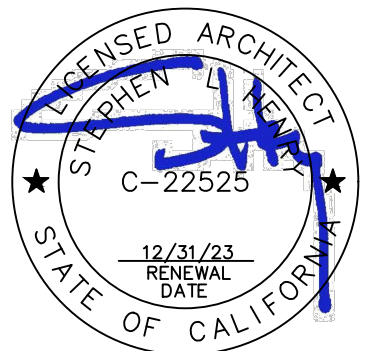

MODERNIZATION LAKEWOOD ELEMENTARY SCHOOL

CODE ANALYSIS SITE PLAN

CONSULTANT


PROJECT NO. 21-32-052	REVISIONS	BY
DATE 3/28/2022		
DRAWN MS		
CHECKED JCBS		
SCALE AS SHOWN		
CADFILE		
UPDATED 11/17/2022		
SHEET NO.		

A1.1.1



GENERAL NOTES

- SAFETY: CONTRACTOR SHALL BE SOLELY AND COMPLETELY RESPONSIBLE FOR THE CONDITIONS OF THE PREMISES ON WHICH THE WORK IS PERFORMER AND FOR THE SAFETY OF ALL PERSONS AND PROPERTY ON THE SITE BOTH DURING AND OUTSIDE OF NORMAL WORKING HOURS, UNTIL SUCH WORK IS ACCEPTED BY THE OWNER.
- UNDERGROUND SERVICES: THE CONTRACTOR SHALL BE RESPONSIBLE FOR CONTACTING ALL UTILITY COMPANIES AND/OR UTILITY DISTRICTS AS TO THE LOCATION OF ALL UNDERGROUND FACILITIES. THE CONTRACTOR SHALL BE RESPONSIBLE FOR UNDERGROUND UTILITIES OR OTHER BURIED OBJECTS WHICH MAY BE ENCOUNTERED BUT WHICH ARE NOT SHOWN ON THESE DRAWINGS.
- USE OF BARRICADES AND SITE CONTROLS: WHEN THE WORK AREA HAS TRENCHES OR DITCHES DEEPER THAN ONE FOOT, THE CONTRACTOR SHALL PROVIDE FENCING AND BARRICADES AT SUCH TRENCHES OR DITCHES DURING THE WORK DAY. CONTRACTOR SHALL EXPEDITE THE FILLING AND COMPACTING OF SUCH TRENCHES OR DITCHES.
- QUANTITIES: MATERIAL QUANTITIES IF ANY ARE NOTED ON THESE DRAWINGS ARE NOT GUARANTEED CONTRACT QUANTITIES. CONTRACTOR IS TO PERFORM HIS OWN ESTIMATES AND QUANTITY TAKE-OFFS. CONTRACTOR IS TO PROVIDE ALL MATERIALS NECESSARY TO COMPLETE THE PROJECT, EVEN IF QUANTITIES ARE DIFFERENT THAN THOSE SHOWN ON THE DRAWINGS.
- PRE-EXISTING CONDITIONS
 - CONTRACTORS SHALL VISIT THE SITE AND BECOME FAMILIAR WITH EXISTING OBSERVABLE SITE CONDITIONS PRIOR TO SUBMITTING BID.
 - ALL ITEMS NOT SHOWN AS (E) EXISTING SHALL BE CONSIDERED NEW AND ARE PART OF THIS CONTRACT.

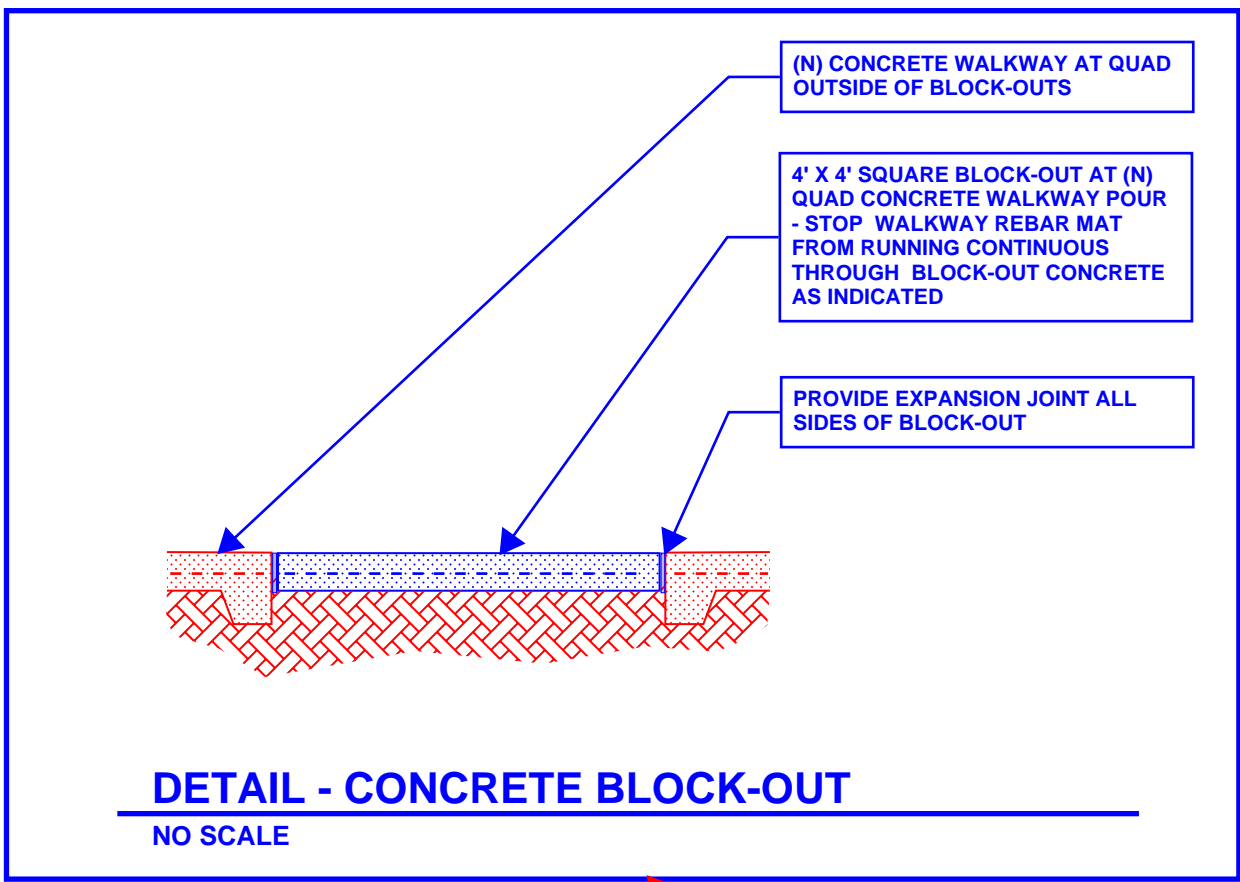

SITE LEGEND

PROPERTY LINE

ACCESSIBLE PATH OF TRAVEL - SEE NOTES THIS SHEET

(N) CONCRETE WALK CONSTRUCTION

NOTE: FOLLOW JOINT PATTERN AS SHOWN ON SITE PLAN

(N) ORNAMENTAL METAL FENCE

(E) ORNAMENTAL METAL FENCE TO REMAIN

(N) CHAIN LINK FENCE

(E) CHAIN LINK FENCE TO REMAIN

(N) CHAIN LINK FENCE FABRIC TO BE INSTALLED OR (E) MODIFIED FENCE FRAME

CMU WALL

(E) FIRE HYDRANT

POST INDICATOR & VALVE (PIV)

BACKFLOW PREVENTER

METER AND BACKFLOW

TRUNCATED DOMES

DRAINAGE STRUCTURE - SEE CIVIL

CLEAN OUT

AREA DRAIN

MAN HOLE COVER

DROP INLET

TRENCH DRAIN

ELECTRICAL STRUCTURE - SEE ELECTRICAL

POLE MOUNTED FIXT. TOP MOUNTED

POLE MOUNTED FIXT. TWIN HEAD

POLE MOUNTED FIXT. SINGLE HEAD

UNDERGROUND PULLBOX

TRANSFORMER

SWITCHBOARD

NEW BUILDING

EXISTING AREA OF BUILDING TO BE MODERNIZED

EXISTING TOILET ROOM TO BE MODERNIZED

EXISTING TOILET ROOM - NO WORK

NEW CONCRETE WALKWAY

(N) ASPHALTIC CONCRETE PAVING

EXISTING WALKWAY TO REMAIN

SHEET NOTES

- SN.01 (N) FARMING LOT WALKWAYS AND LANDSCAPING - SEE CIVIL AND LANDSCAPE DRAWINGS
- SN.02 (N) TRASH ENCLOSURE - SEE CIVIL AND STRUCTURAL DRAWINGS
- SN.03 (N) TETHERBALL COURTS - SEE ENLARGED PLAN AND CIVIL SHEETS.
- SN.04 (N) ENTRY AREA, GATE, FENCING, BENCHES & PLANTERS - SEE CIVIL, LANDSCAPE, ELECTRICAL & ENLARGED PLAN
- SN.05 (N) CONCRETE STAIR, WALKWAYS & BUS TURNOUT - SEE CIVIL DRAWINGS
- SN.06 (N) 7" TALL SLATED CHAIN LINK FENCE W/ 1 1/2" SQUARES OF 10' X 10' 7/8" HDPE SLATS ALONG ENTIRE NORTH AND EAST PROPERTY LINES INSTALLED JUST INSIDE OF (E) CHAIN LINK FENCE - SEE DETAIL 10/A1.1.2
- SN.07 (E) CHAIN LINK FENCE FABRIC TO BE REMOVED - POSTS TO BE REMOVED - CONTRACTOR IS REQUIRED TO SALVAGE AND PROTECT (E) ORNAMENTAL IRON FENCE PANELS, GATES AND POSTS (IF SALVAGEABLE) AND STORE FOR REUSE. INSTALL (E) SALVAGED AND (N) ORNAMENTAL IRON FENCE COMPONENTS IN (N) LOCATION AND CONFIGURATION AS INDICATED HERE AND ON CIVIL DRAWINGS. (E) ORNAMENTAL IRON FENCING COMPONENTS THAT ARE TO BE SALVAGED INCLUDE APPROXIMATELY 27 WHOLE PANELS, 3 PARTIAL PANELS, 2-MAN GATE ASSEMBLIES, 1-PAIR VEHICLE GATES AND 27 LINE POSTS. THESE QUANTITIES ARE ONLY APPROXIMATE AND THE CONTRACTOR IS REQUIRED TO FIELD VERIFY EXACT QUANTITIES, CONDITIONS AND SALVAGEABLE OF THE (E) ORNAMENTAL IRON FENCE COMPONENTS
- SN.08 (N) QUAD AREA CONCRETE WALKWAYS, PLANTERS, BENCHES - SEE CIVIL AND LANDSCAPE
- SN.09 (E) CHAIN LINK FENCE FABRIC TO BE REMOVED - POSTS TO BE REMOVED - CONTRACTOR IS REQUIRED TO SALVAGE AND PROTECT (E) ORNAMENTAL IRON FENCE PANELS, GATES AND POSTS (IF SALVAGEABLE) AND STORE FOR REUSE. INSTALL (E) SALVAGED AND (N) ORNAMENTAL IRON FENCE COMPONENTS IN (N) LOCATION AND CONFIGURATION AS INDICATED HERE AND ON CIVIL DRAWINGS. (E) ORNAMENTAL IRON FENCING COMPONENTS THAT ARE TO BE SALVAGED INCLUDE APPROXIMATELY 27 WHOLE PANELS, 3 PARTIAL PANELS, 2-MAN GATE ASSEMBLIES, 1-PAIR VEHICLE GATES AND 27 LINE POSTS. THESE QUANTITIES ARE ONLY APPROXIMATE AND THE CONTRACTOR IS REQUIRED TO FIELD VERIFY EXACT QUANTITIES, CONDITIONS AND SALVAGEABLE OF THE (E) ORNAMENTAL IRON FENCE COMPONENTS
- SN.10 (E) CHAIN LINK GATES TO BE REMOVED AND REPLACED WITH SAME SIZE SLATS AND TO MATCH THE (N) MODIFIED FENCE HEIGHT. INSTALL NO-CLIMB FENCE FABRIC ON (N) GATE FRAME
- SN.11 PROVIDE (N) FENCE POSTS AND (N) NO-CLIMB FENCE FABRIC WHERE FENCE LINE AND CONFIGURATION HAVE BEEN MODIFIED TO ACCOMMODATE (E) OR (N) GRADE MODIFICATIONS - SEE DETAIL 10/A1.1.2
- SN.12 REPLACE (E) PARKING LOT ENTRANCE SIGN WITH (N) PARKING LOT ENTRANCE SIGN - SEE CIVIL
- SN.13 (E) CHAIN LINK FENCE FABRIC AND GATES AT (E) HVAC EQUIPMENT YARD OR STORAGE YARD TO BE REMOVED AND STORED. GATE AND FENCE POSTS TO REMAIN AND PROTECTED AGAINST DAMAGE DURING DEMOLITION AND CONCRETE POUR. FOLLOWING INSTALLATION OF (N) CONCRETE WALKWAYS, ADJUST FENCE FRAME TO ACCOMMODATE (N) TOP OF WALKWAY ELEVATION AND REINSTALL THE (E) GATE AND FENCE FABRIC O/ (E) POSTS.
- SN.14 WRAP THE (E) HVAC UNITS, CONDUIT, LINE SETS AND DUCTWORK WITH HEAVY PLASTIC SHEET AND PROTECT AGAINST CONCRETE SPLATTERS, DUST AND OTHER DAMAGE. DURING CONCRETE WALKWAY DEMOLITION AND NEW CONSTRUCTION OPERATIONS. SEE CIVIL FOR EXTENT OF WALKWAY DEMOLITION AND REPLACEMENT.
- SN.15 DISCONNECT (E) DUCT SUPPORTS FROM CONCRETE WALKWAY AND DUCTS AS REQUIRED. TEMPORARILY SUPPORT DUCTS AS REQUIRED TO ALLOW FOR REMOVAL OF (E) CONCRETE WALKWAY AND INSTALLATION AND FINISHING OF (N) CONCRETE WALKWAY. ADJUST (E) DUCT SUPPORTS AS REQUIRED FOR (N) TOP OF WALKWAY ELEVATION AND FASTEN TO CONCRETE WALKWAY USING FASTENER TYPES TO MATCH (E).
- SN.16 (E) DRINKING FOUNTAIN TO BE REMOVED STORED AND PROTECTED DURING WALKWAY DEMOLITION AND (N) CONSTRUCTION. PROTECT (E) PLUMBING WASTE & SUPPLY LINES DURING CONSTRUCTION. FOLLOWING INSTALLATION OF (N) WALKWAY, ADJUST/EXTEND/MODIFY (E) PLUMBING LINES AND REINSTALL DRINKING FOUNTAIN PER MANUFACTURER'S RECOMMENDATIONS.
- SN.17 (E) ACCESSIBLE BOTTLE FILLER TO BE REMOVED STORED AND PROTECTED DURING WALKWAY DEMOLITION AND (N) CONSTRUCTION. PROTECT (E) PLUMBING WASTE & SUPPLY LINES DURING CONSTRUCTION. FOLLOWING INSTALLATION OF (N) WALKWAY, ADJUST/EXTEND/MODIFY (E) PLUMBING LINES AND REINSTALL BOTTLE FILLER PER MANUFACTURER'S RECOMMENDATIONS.
- SN.18 REMOVE TWO (E) DRINKING FOUNTAINS THIS LOCATION AND INSTALL (N) CHILD HEIGHT ACCESSIBLE, HI-LOW STYLE DRINKING FOUNTAIN. MODIFY PLUMBING SUPPLY AND WASTE LINES AS REQUIRED - SEE PLUMBING AND DETAIL 7/A0.2
- SN.19 THIS (E) DRINKING FOUNTAIN IS REQUIRED HIGH HEIGHT ACCESSIBLE WITH BUBBLER HEIGHT AT +36" ABOVE CONCRETE WALK.
- SN.20 (E) DRINKING FOUNTAIN TO BE REMOVED. CAP PLUMBING BELOW GRADE.
- SN.21 FOLLOWING REINSTALLATION OF (E) D.F. INSTALL NEW CANE RAILS PER DETAIL 6/A0.2
- SN.22 (N) 8' LONG METAL BENCH, TYPICAL OF 24 - SEE DETAIL 9/A1.3.1 FOR MOUNTING DETAIL
- SN.23 BLOCK-OUT (N) CONCRETE WALKWAY POUR FOR FUTURE SHADE STRUCTURE FOOTINGS - SEE ENLARGED FUTURE SHADE STRUCTURE FOOTING BLOCK-OUT PLAN THIS SHEET

NOTE: ANY SITE OR BUILDING IMPROVEMENTS INDICATED OUTSIDE THE SHADED AREA IS NOT A PART OF THIS CONTRACT UNLESS NOTED OTHERWISE

PHASE 2 SCOPE SEE PHASING NOTE THIS SHEET

PHASE 1 SCOPE SEE PHASING NOTE THIS SHEET

FUTURE SHADE STRUCTURE FOOTING BLOCK-OUT PLAN

NOTE: THE SHADED AREA REPRESENTS THE LIMITED SCOPE OF WORK AREA FOR THIS PROJECT. CONTRACTOR IS RESPONSIBLE FOR PROVIDING ALL DEMOLITION AND NEW SITE IMPROVEMENTS WITHIN THIS SHADED AREA UNLESS NOTED OTHERWISE. SEE ELECTRICAL, CIVIL AND LANDSCAPE DRAWINGS FOR ADDITIONAL INFORMATION AND ANY WORK SCOPE THAT MAY OCCUR OUTSIDE OF THIS IDENTIFIED WORK SCOPE AREA.


PHASING NOTE: PHASE 1 - COMPLETE ALL CONCRETE WALKWAYS AROUND BUILDINGS AND IN QUAD AREA BEFORE STARTING THE PHASE 2 WORK. CONCRETE WALKWAYS MUST BE COMPLETED PRIOR TO START OF SCHOOL. PHASE 2 - COMPLETE A.C. GRINDING, OVERLAY, SEALING AND STRIPING AT HARD COURTS FOLLOWING COMPLETION OF THE PHASE 1 SCOPE.

SEE LANDSCAPE DRAWINGS FOR DESCRIPTION OF (N) BENCHES TO BE INSTALLED AND (E) BENCHES AND OTHER (E) SITE COMPONENTS TO BE RELOCATED - SEE PROJECT MANUAL FOR (N) BENCH SPECIFICATION

1 SITE PLAN


SCALE: 1" = 40'-0"

40' 80'

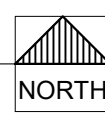

IDENTIFICATION STAMP
DIV. OF THE STATE ARCHITECT
APP: 02-120455 INC:
REVIEWED FOR
SS ☒ FLS ☒ ACS ☒
DATE: 01/12/2023

730 Howe Avenue, Suite 450
Sacramento, CA 95825
Phone: 916.921.2112
Fax: 916.921.2212

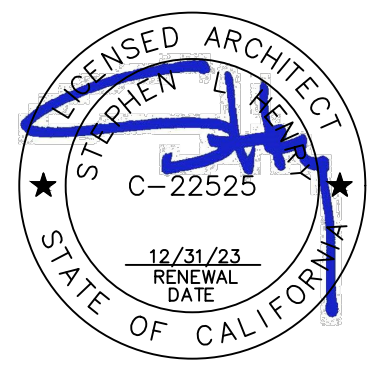


MODERNIZATION LAKEWOOD
ELEMENTARY SCHOOL

SITE PLAN


CONSULTANT

PROJECT NO.	REVISIONS	BY
21-32-052		
DATE		
3/28/2022		
DRAWN		
MS		
CHECKED		
JCBS		
SCALE		
AS SHOWN		
CADFILE		
UPDATED		
11/17/2022		
SHEET NO.		


A1.1.2

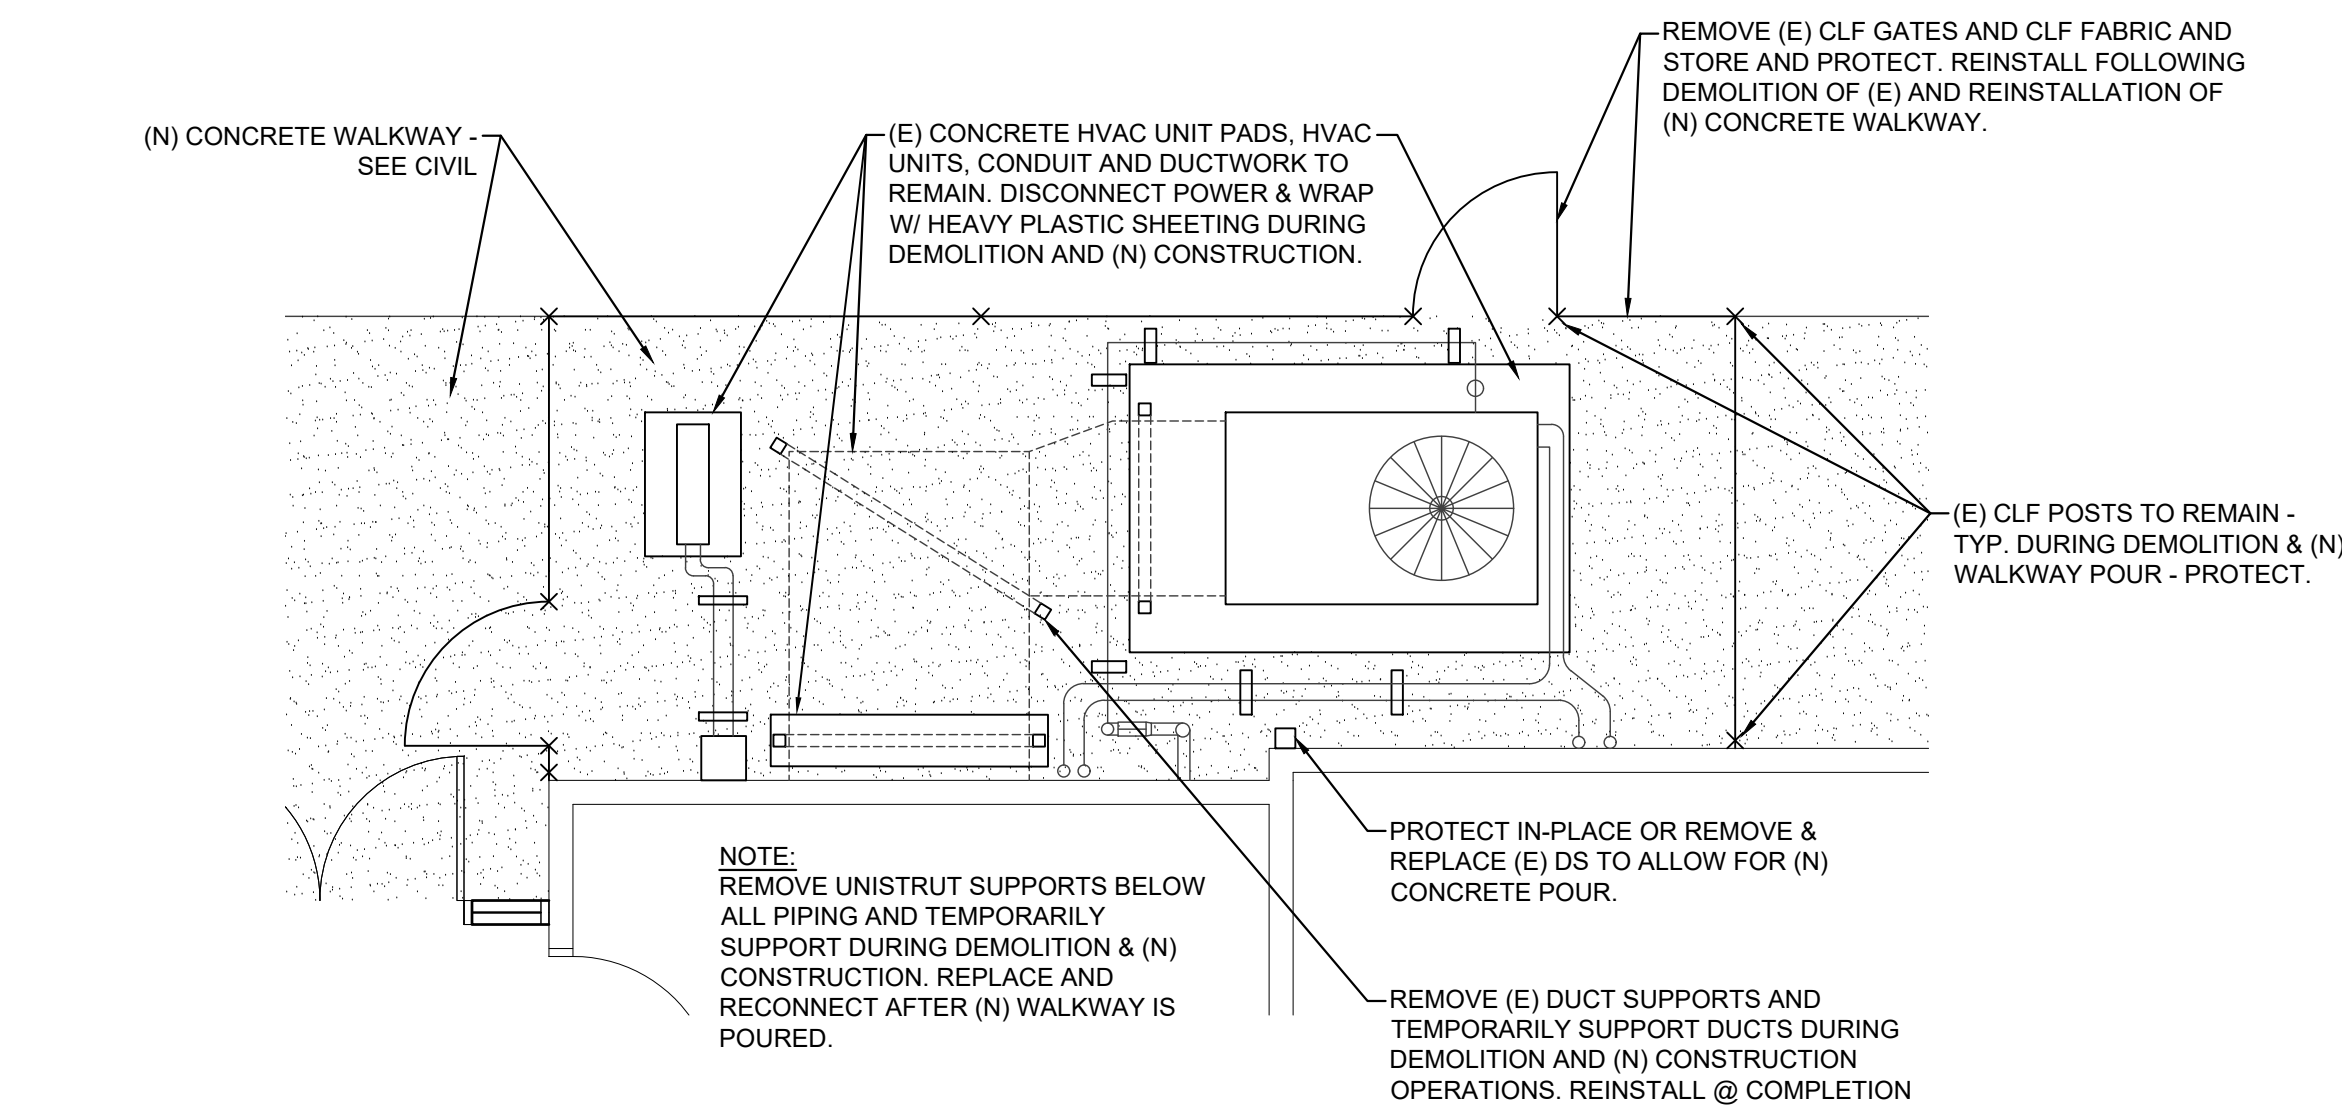


4 ENLARGED PARTIAL SITE PLAN
SCALE: 1/4" = 1'-0" 0 2' 8' NORTH

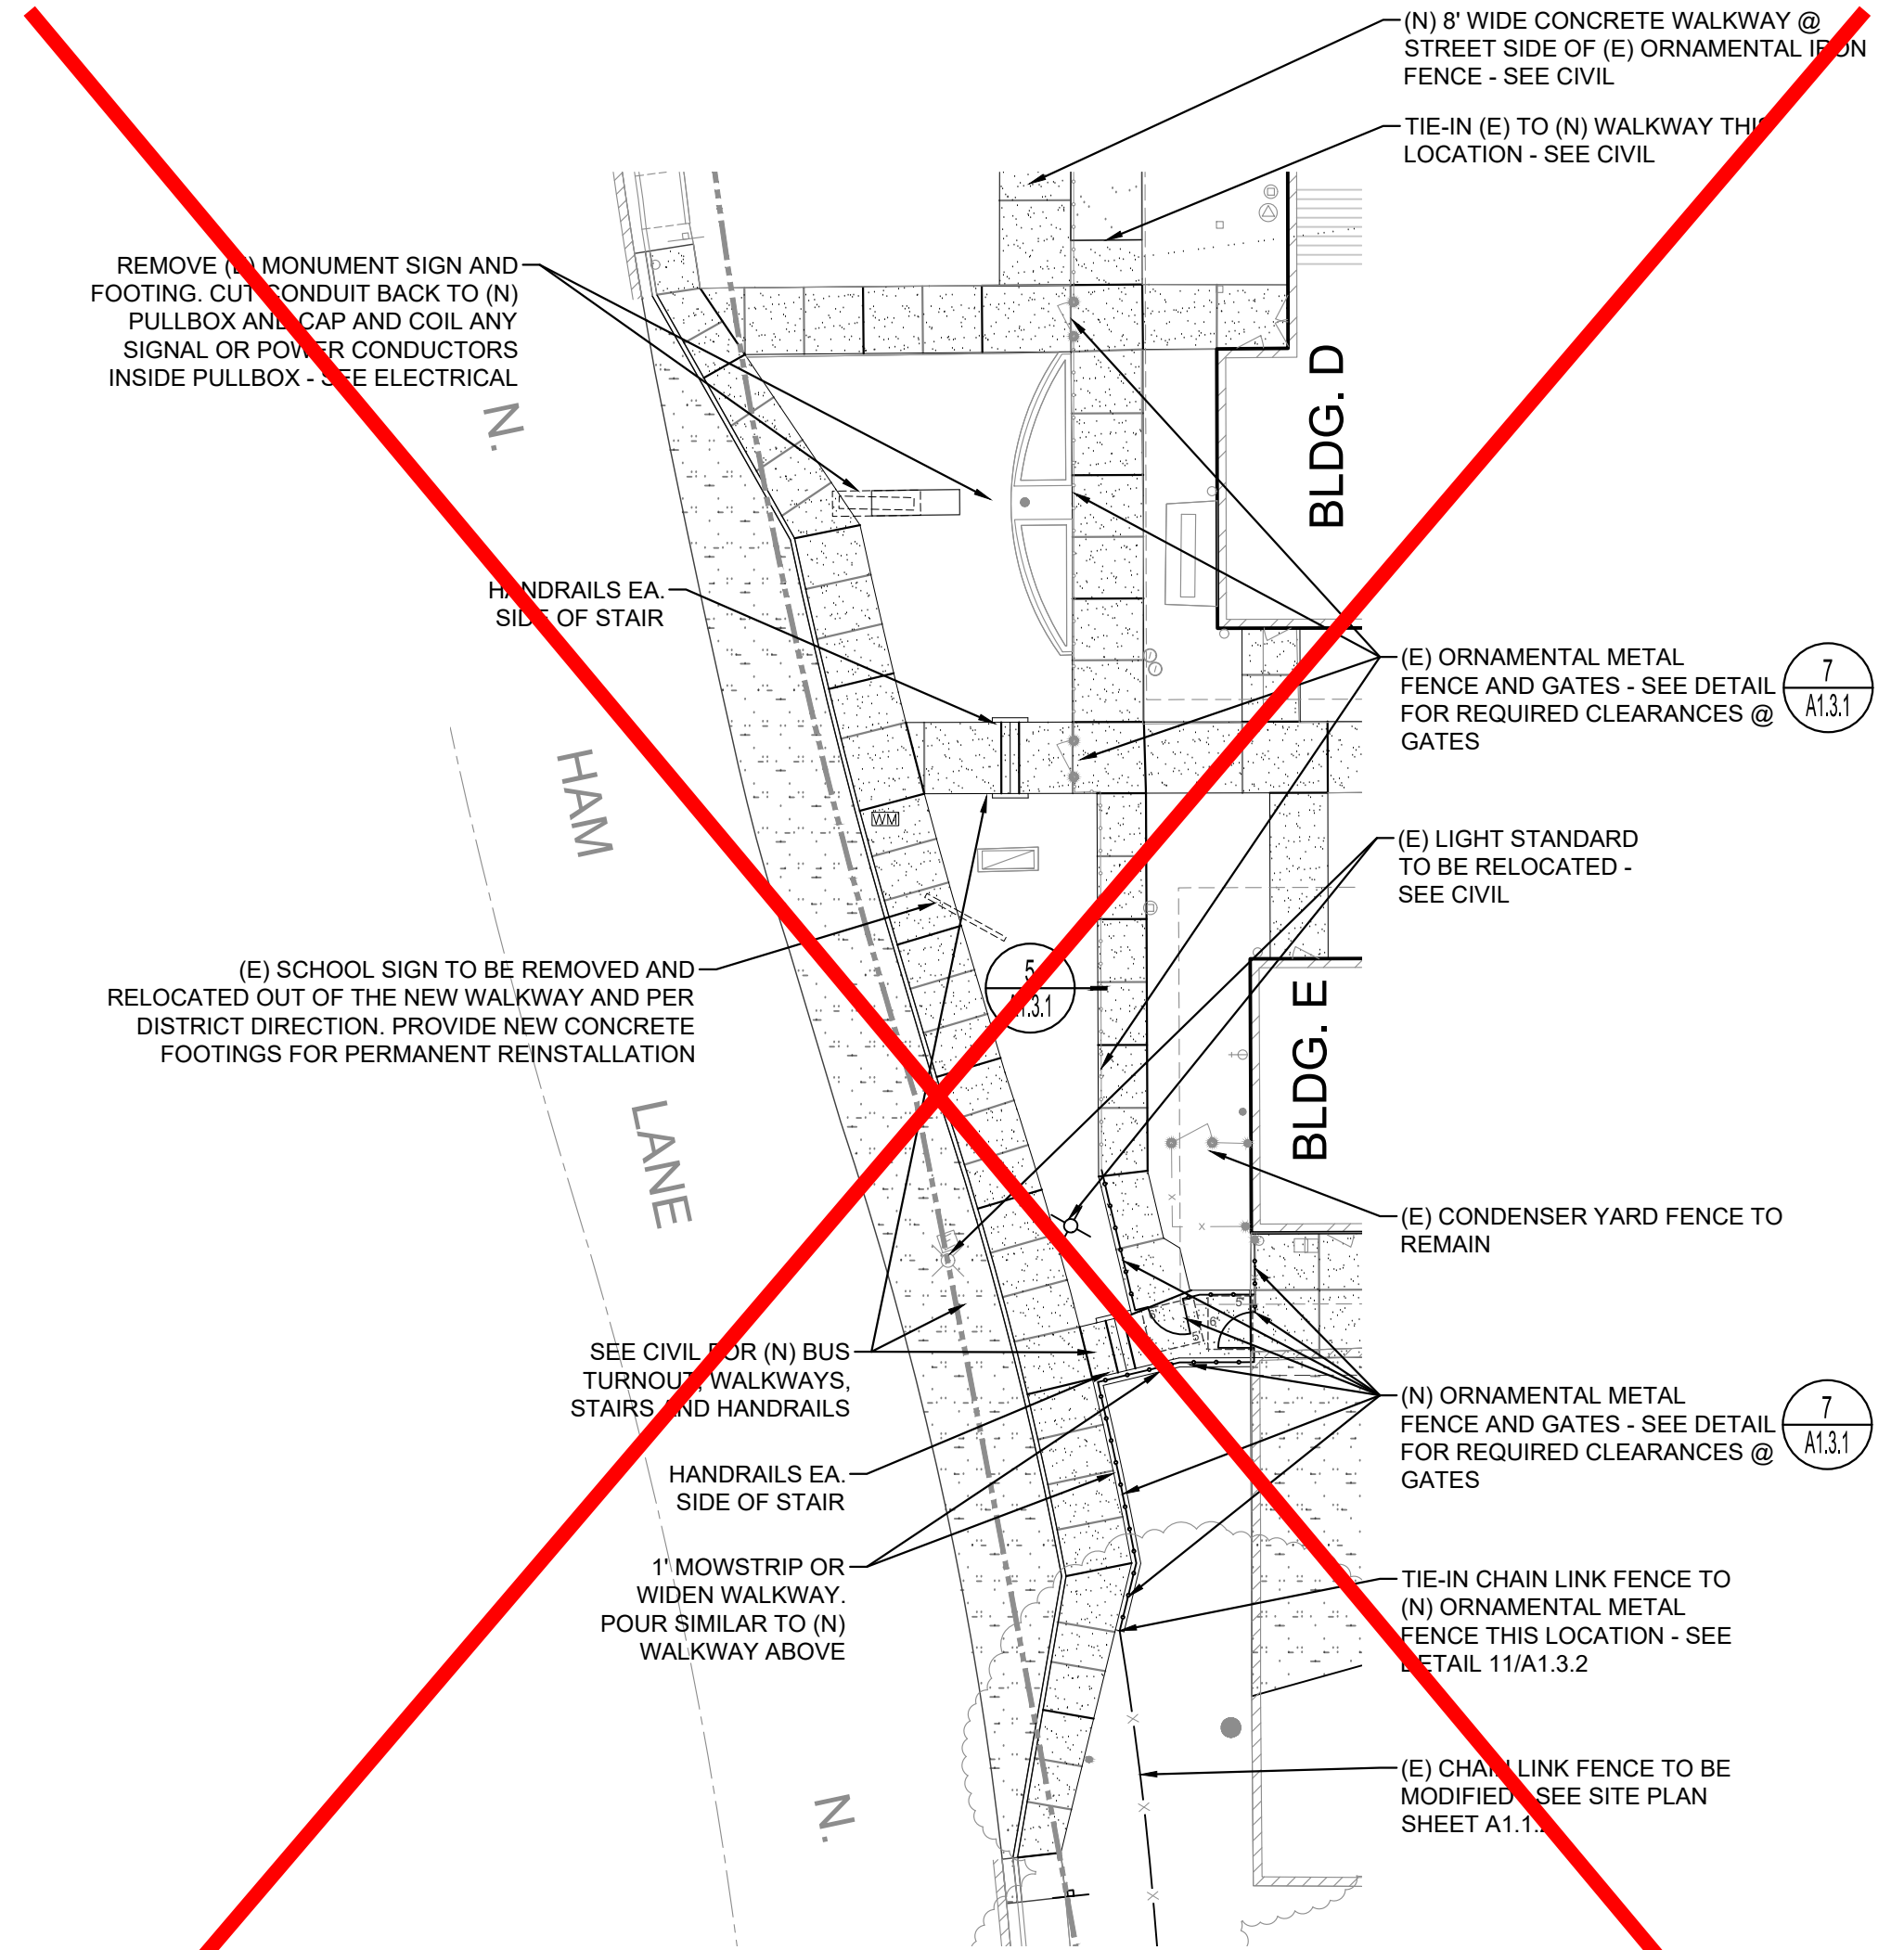

3 ENLARGED PARTIAL SITE PLAN
SCALE: 1" = 20'-0" 0 10 20 40 NORTH

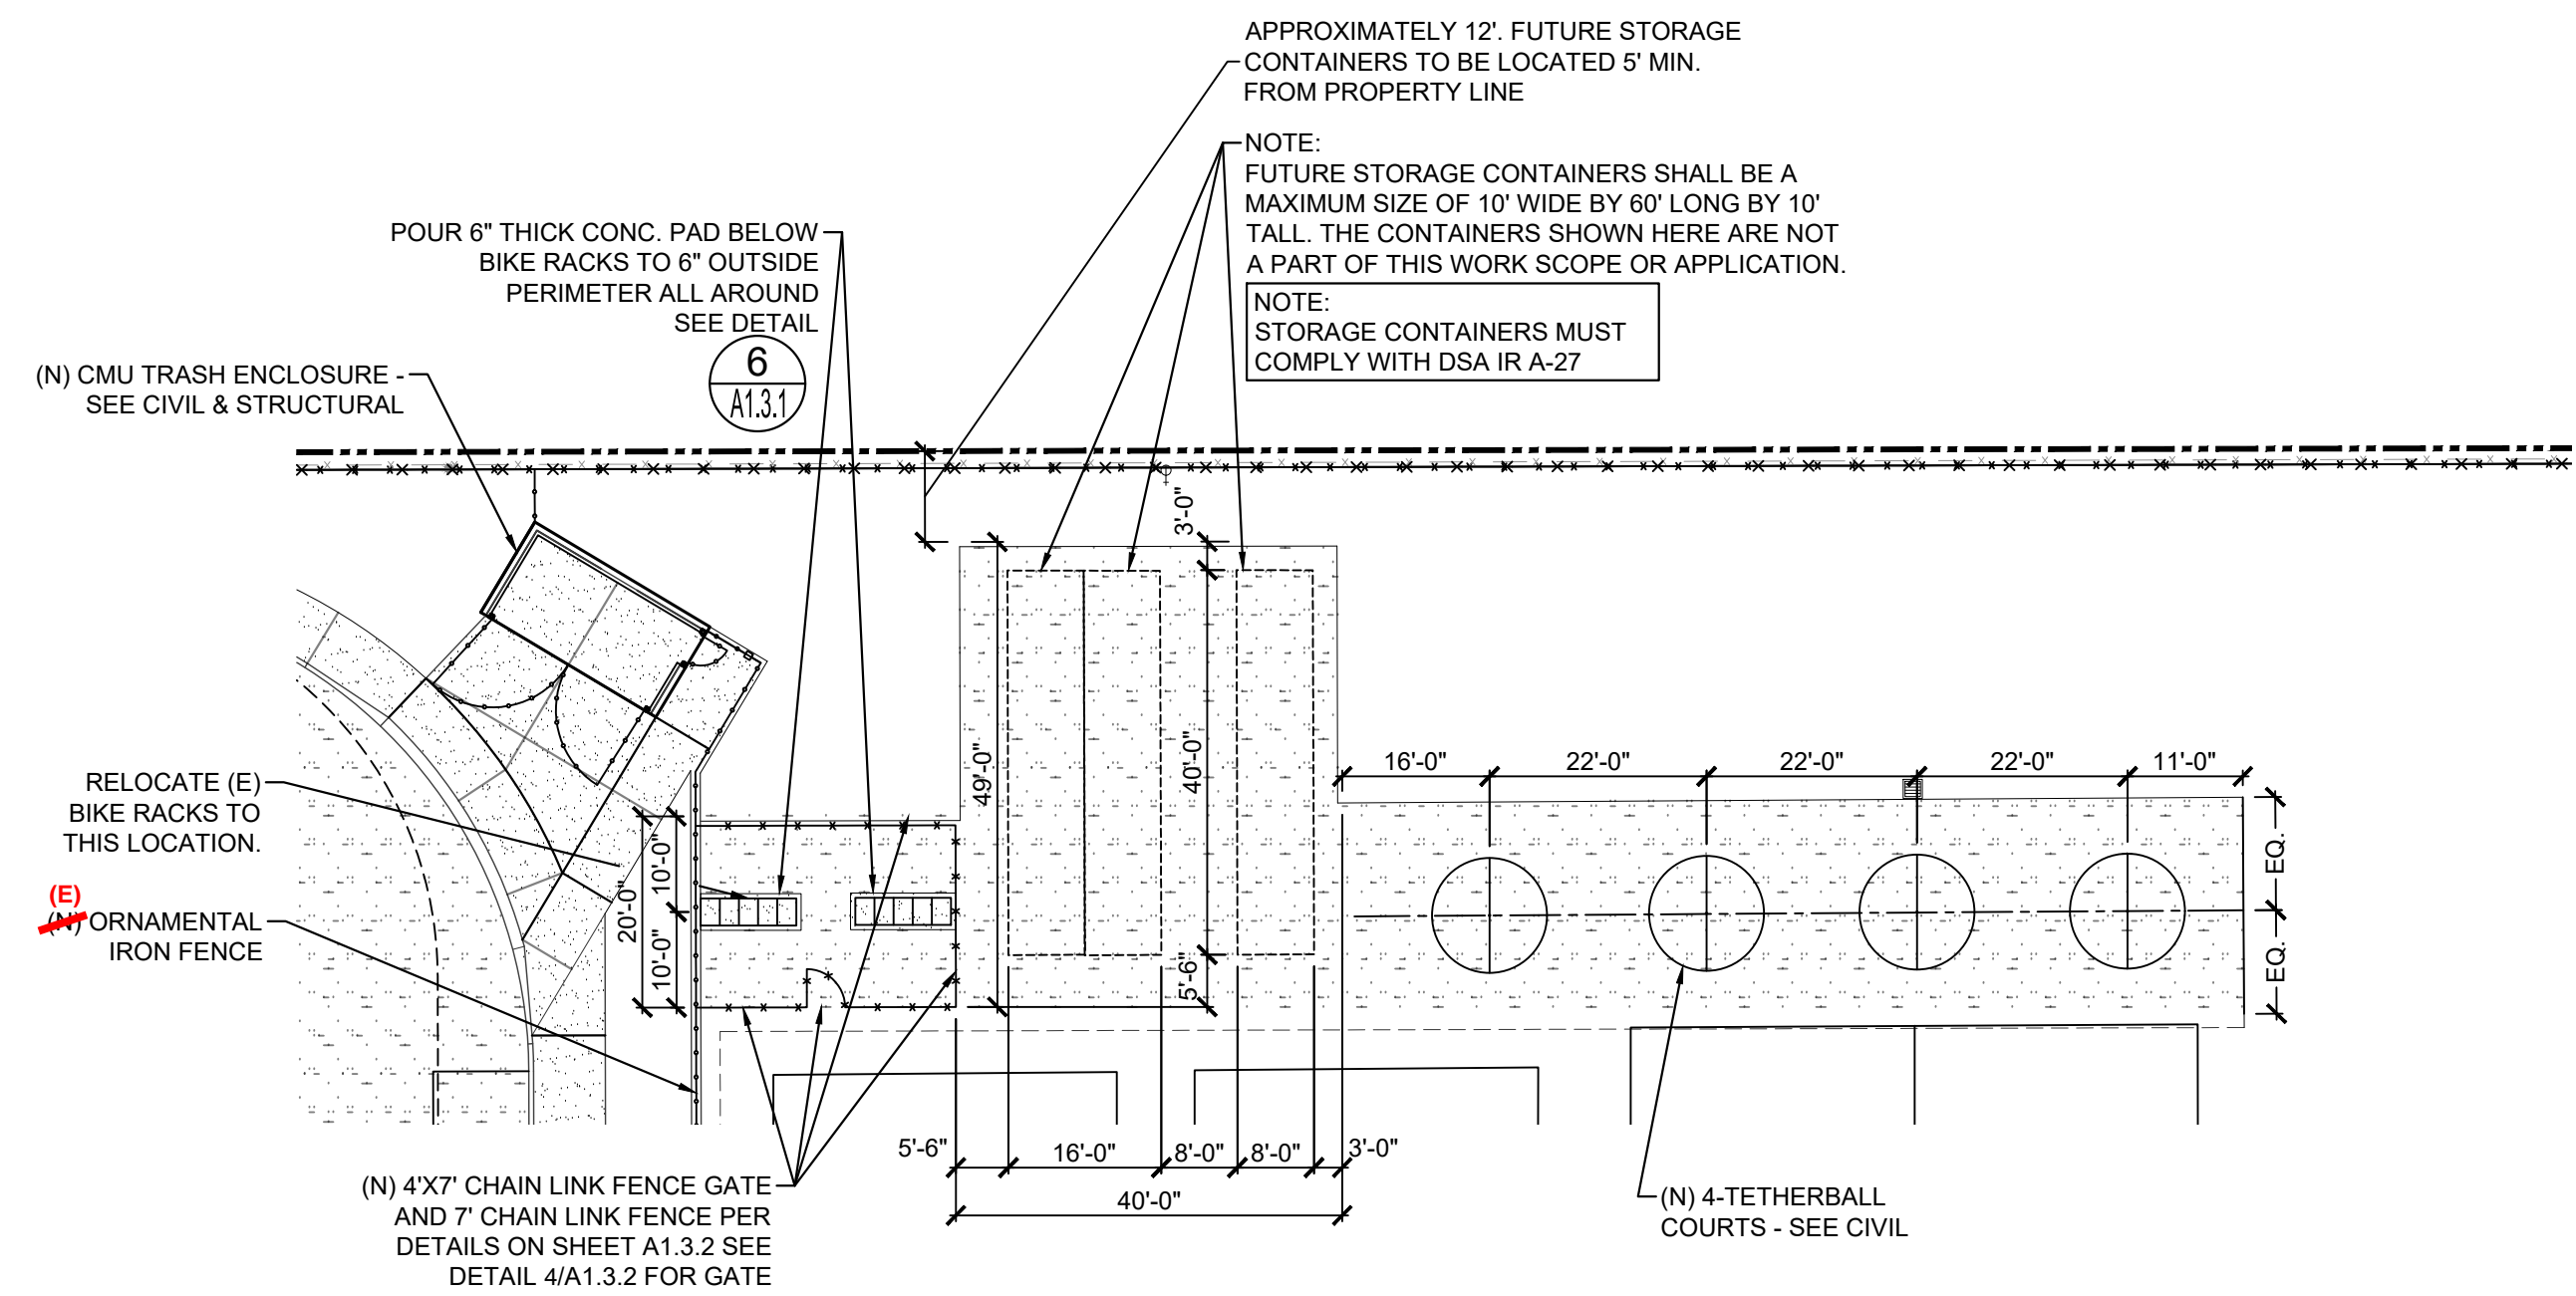


1 ENLARGED PARTIAL SITE PLAN
SCALE: 1" = 20'-0" 0 10 20 40 NORTH

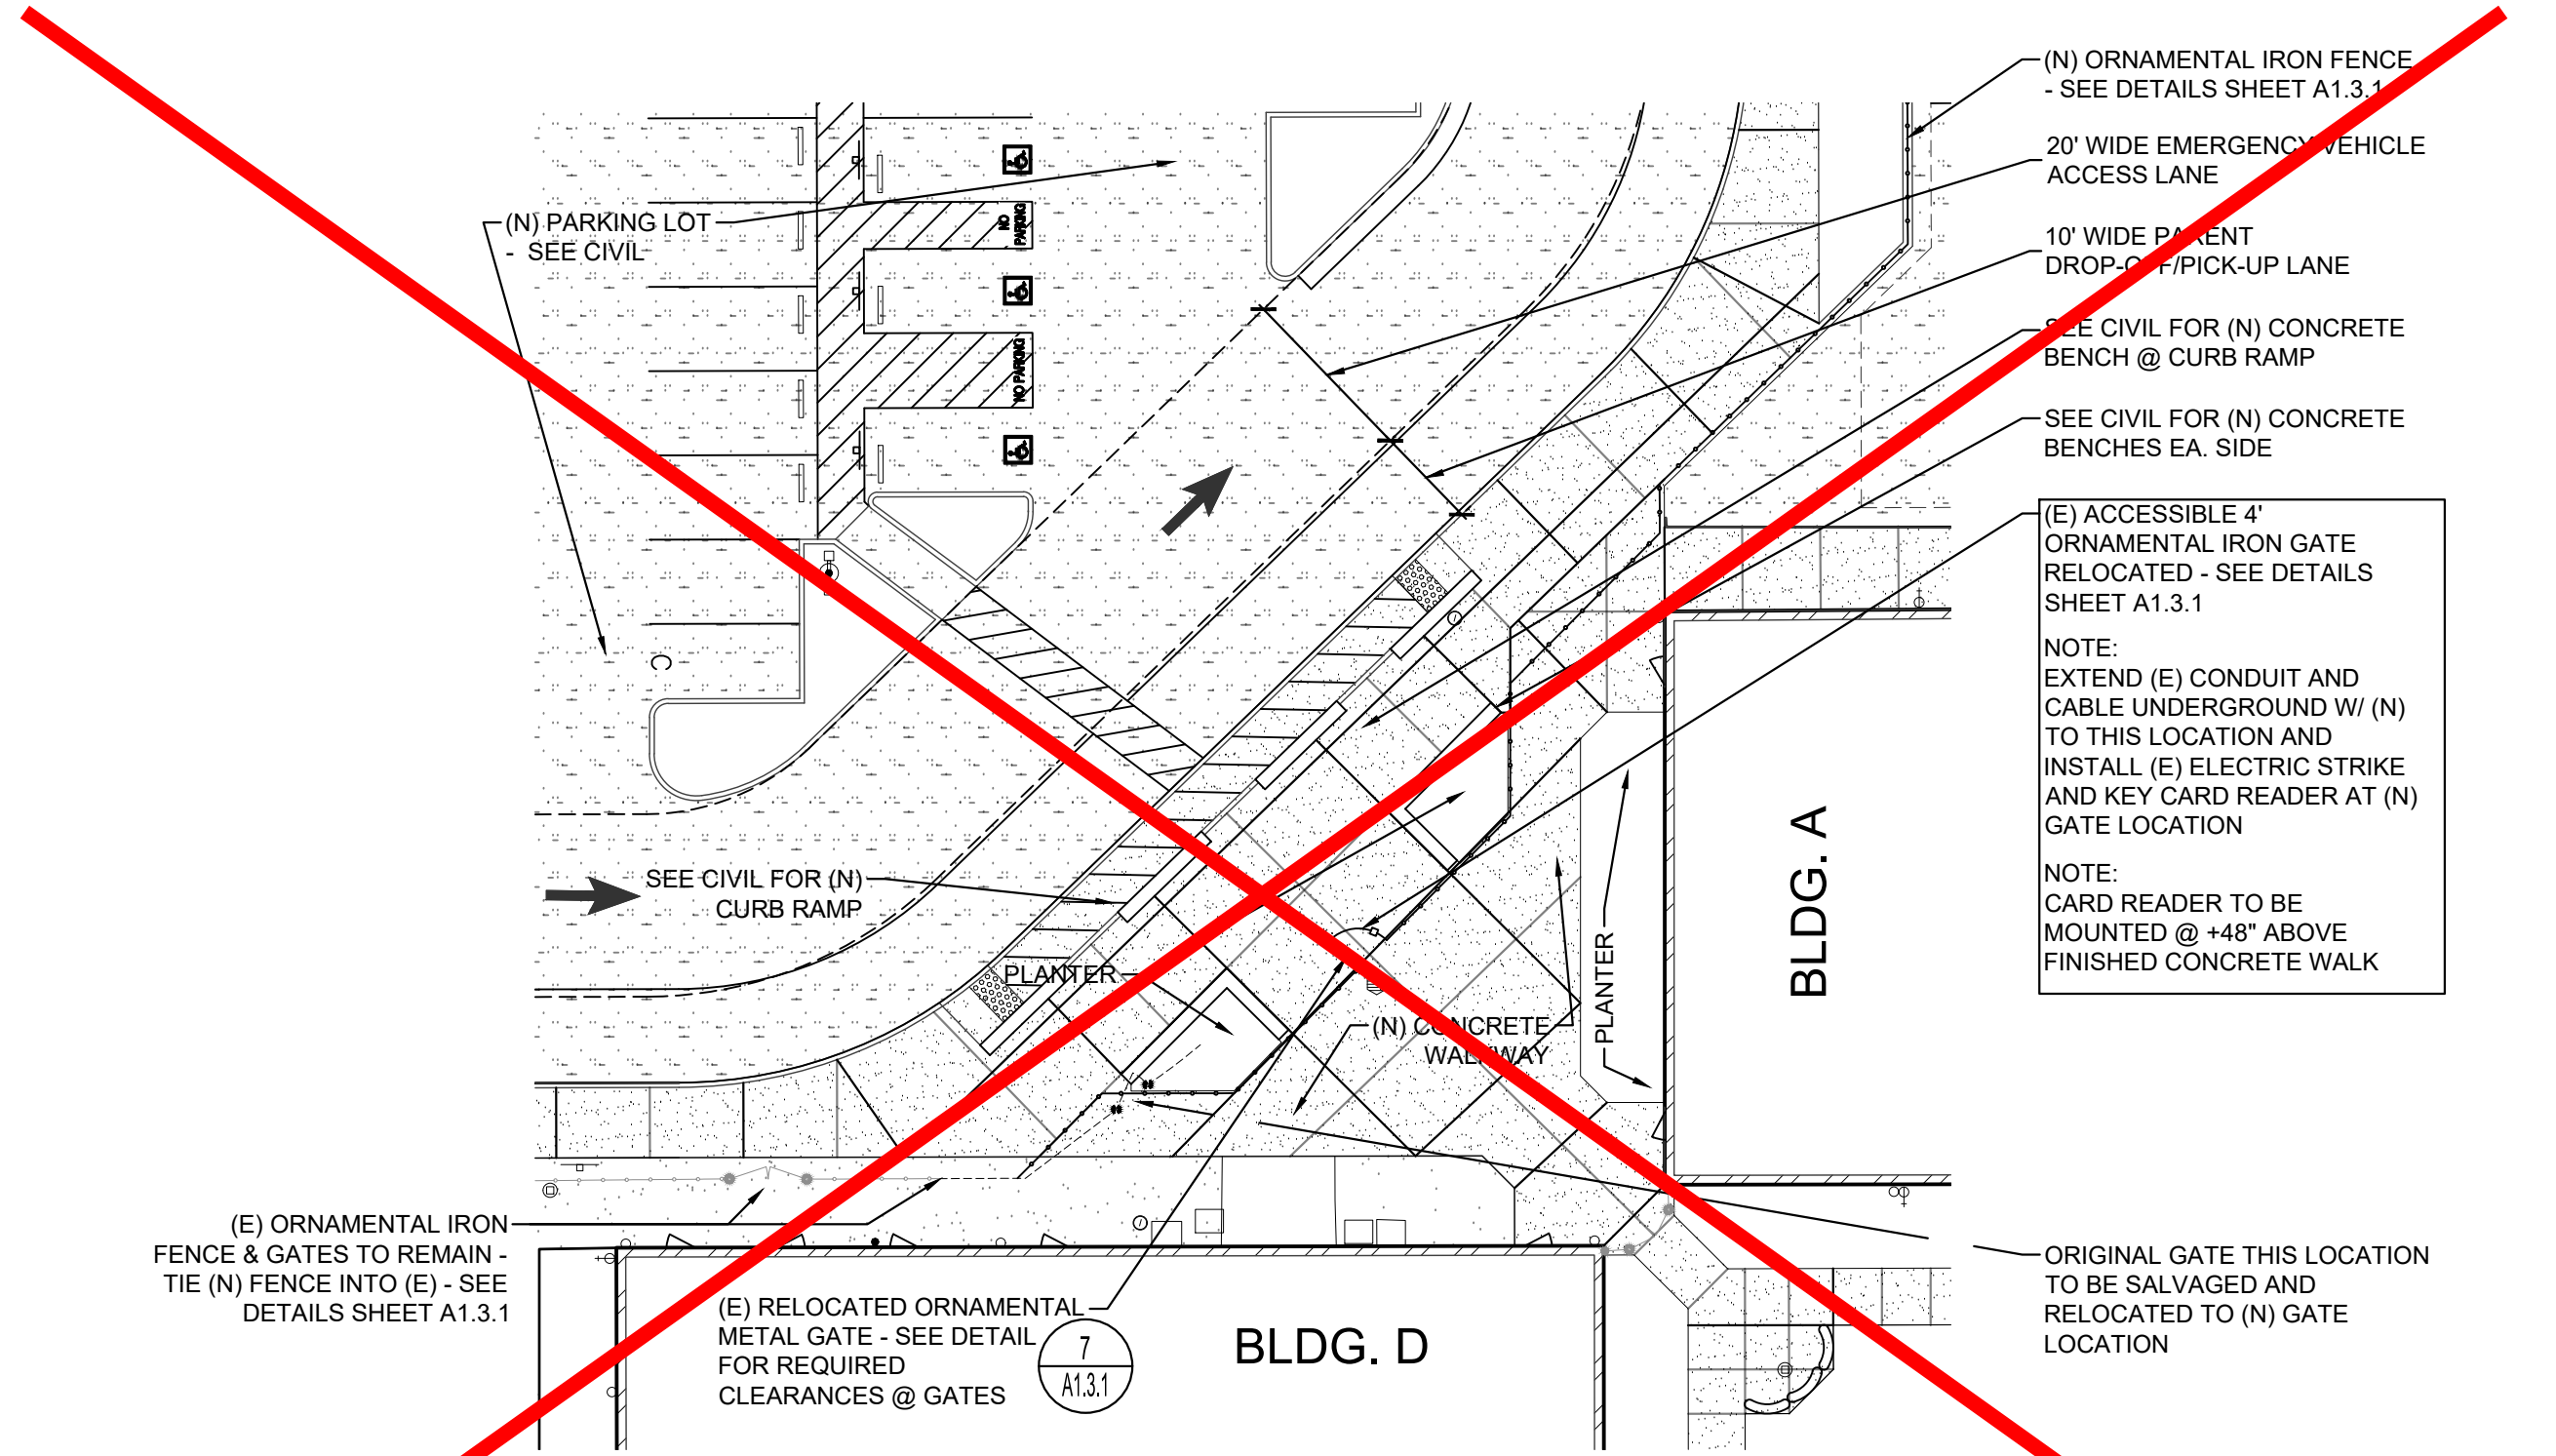

2 ENLARGED PARTIAL SITE PLAN
SCALE: 1" = 20'-0" 0 10 20 40 NORTH

IDENTIFICATION STAMP
DIV. OF THE STATE ARCHITECT
APP: 02-120455 INC:
REVIEWED FOR
SS ☒ FLS ☒ ACS ☒
DATE: 01/12/2023

730 Howe Avenue, Suite 450
Sacramento, CA 95825
Phone: 916.921.2112
Fax: 916.921.2212

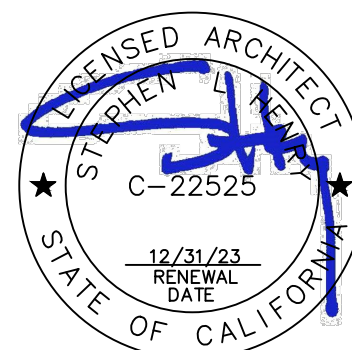

MODERNIZATION LAKEWOOD
ELEMENTARY SCHOOL

ENLARGED SITE PLANS


CONSULTANT

PROJECT NO.	REVISIONS	BY
21-32-052		
DATE		
3/28/2022		
DRAWN		
MS		
CHECKED		
JCBS		
SCALE		
N.T.S.		
CADFILE		
UPDATED		
11/17/2022		
SHEET NO.		

A1.2.1




A1.3.1

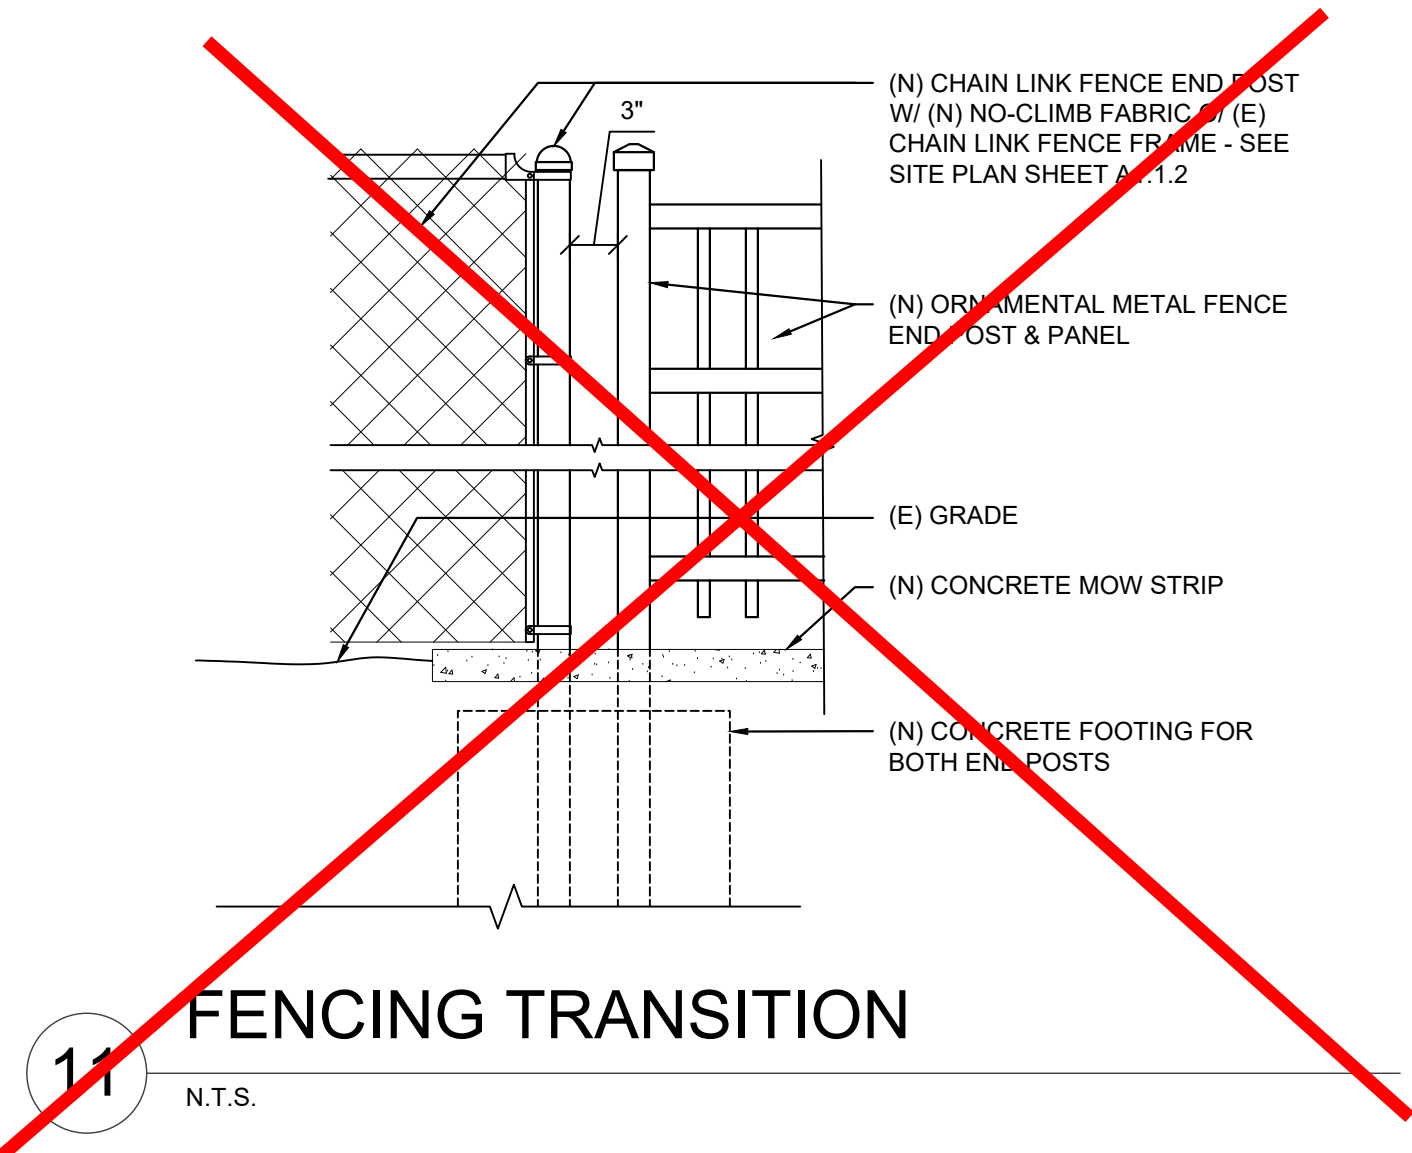


11 FENCING TRANSITION

N.T.S.

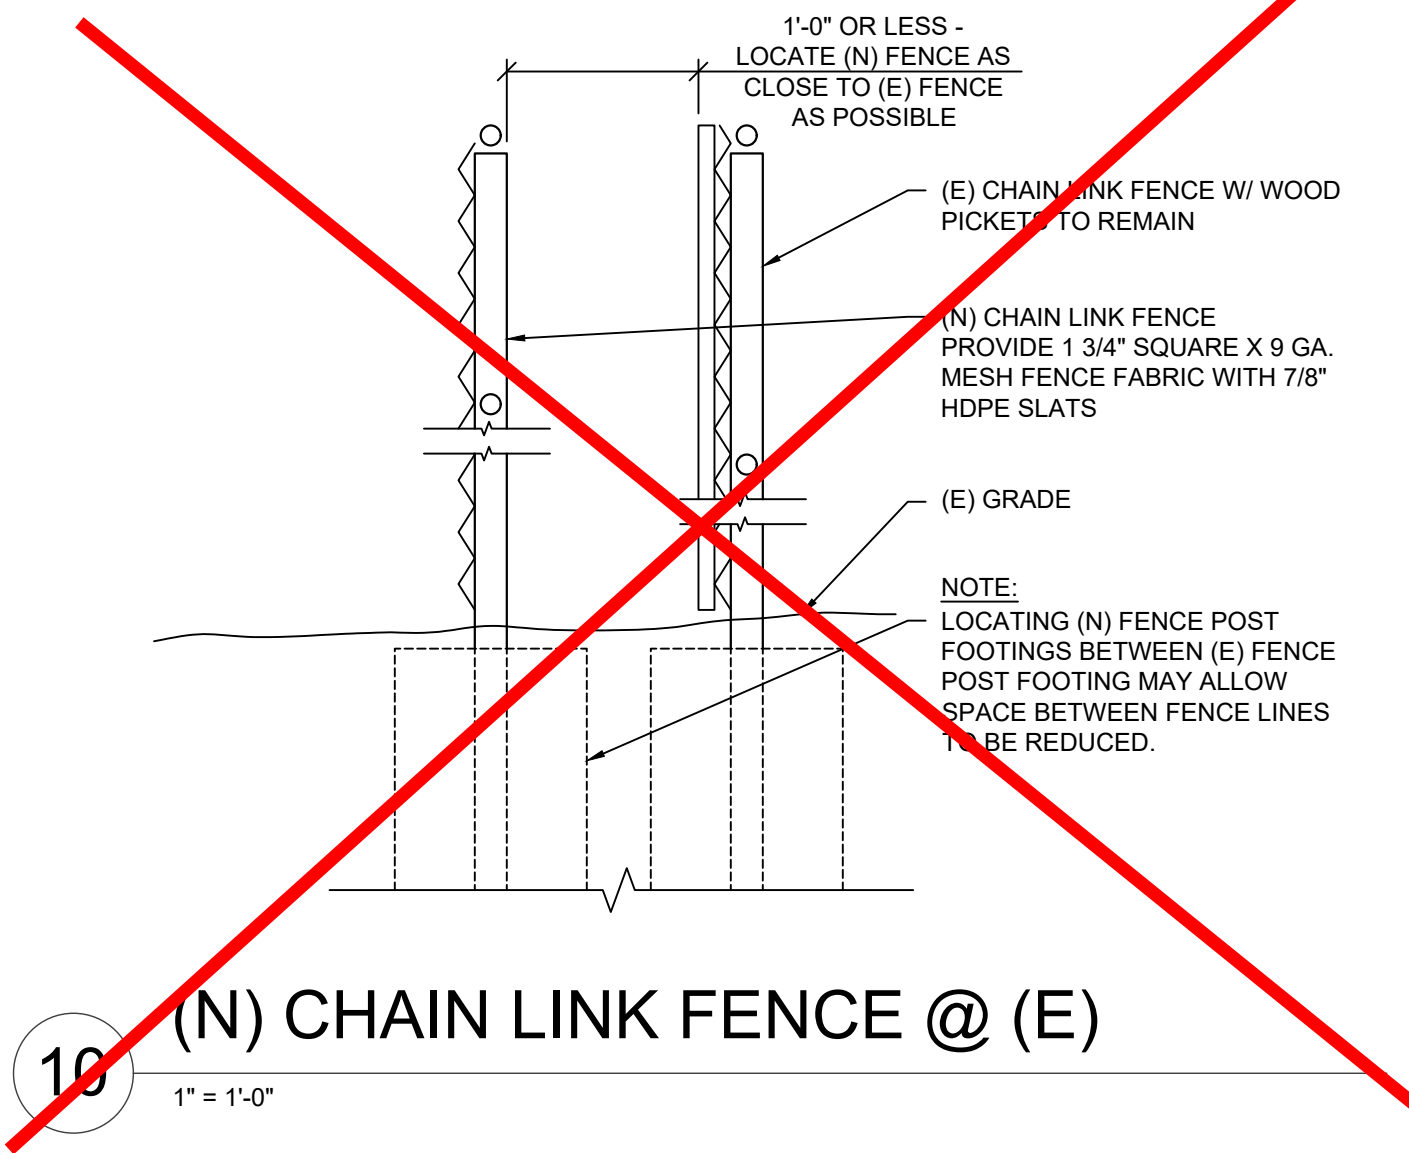


16 (N) CHAIN LINK FENCE @ (E)

1" = 1'-0"

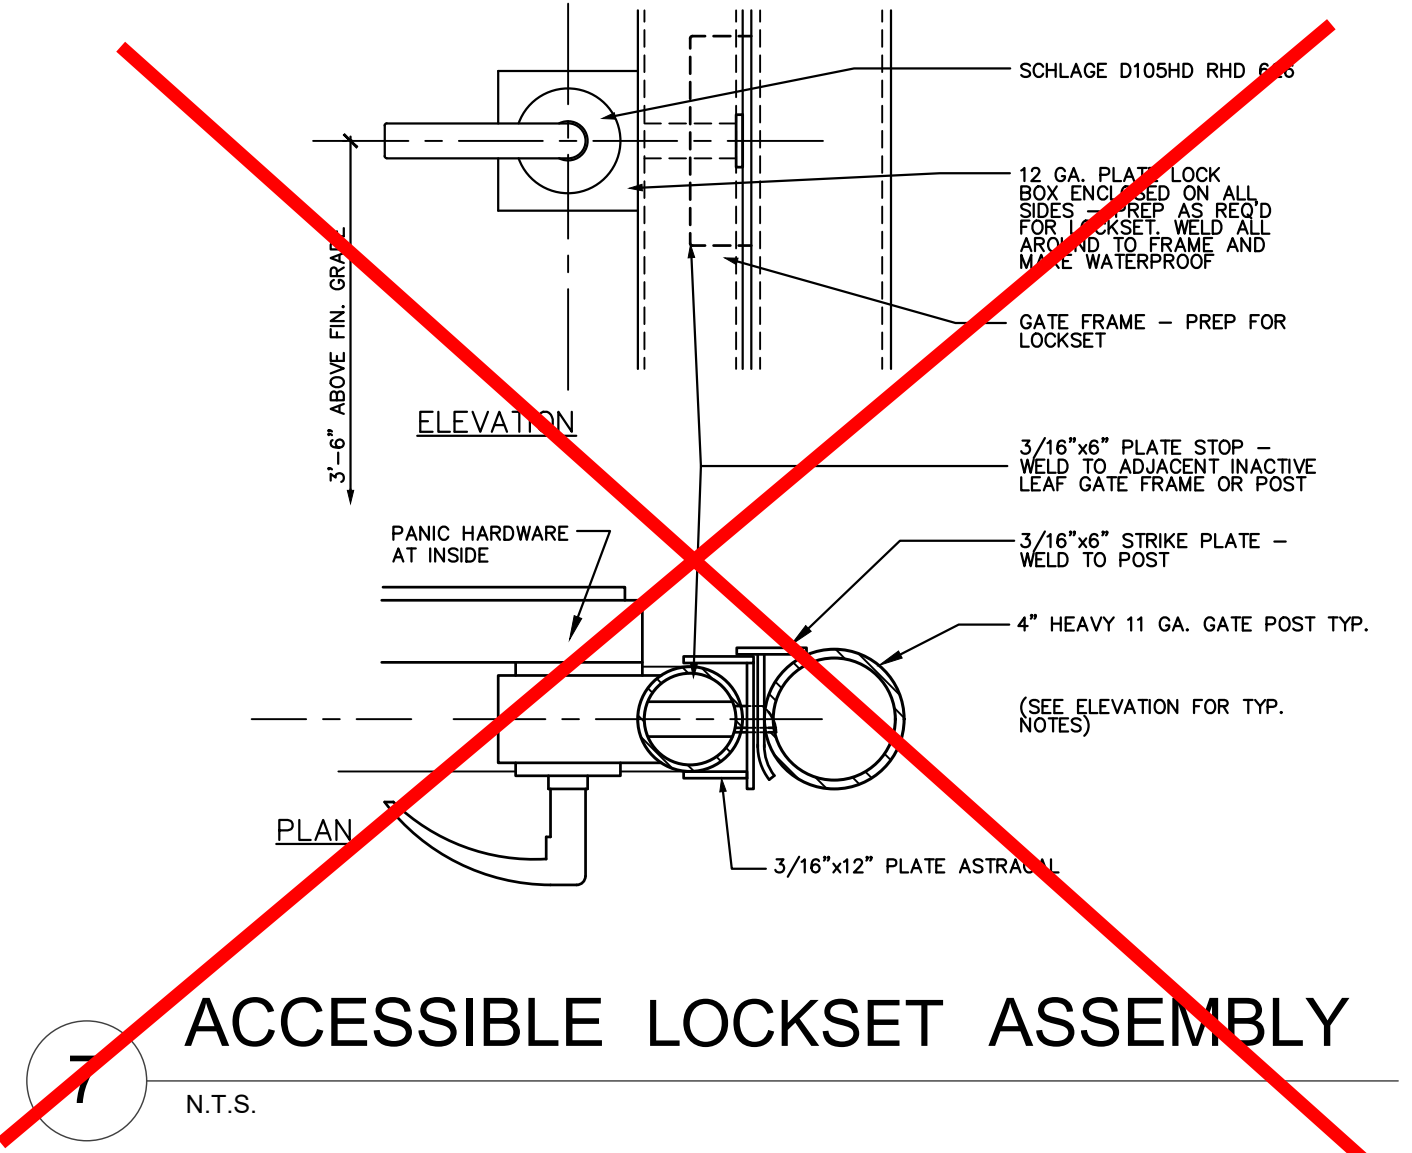

7 ACCESSIBLE LOCKSET ASSEMBLY

N.T.S.

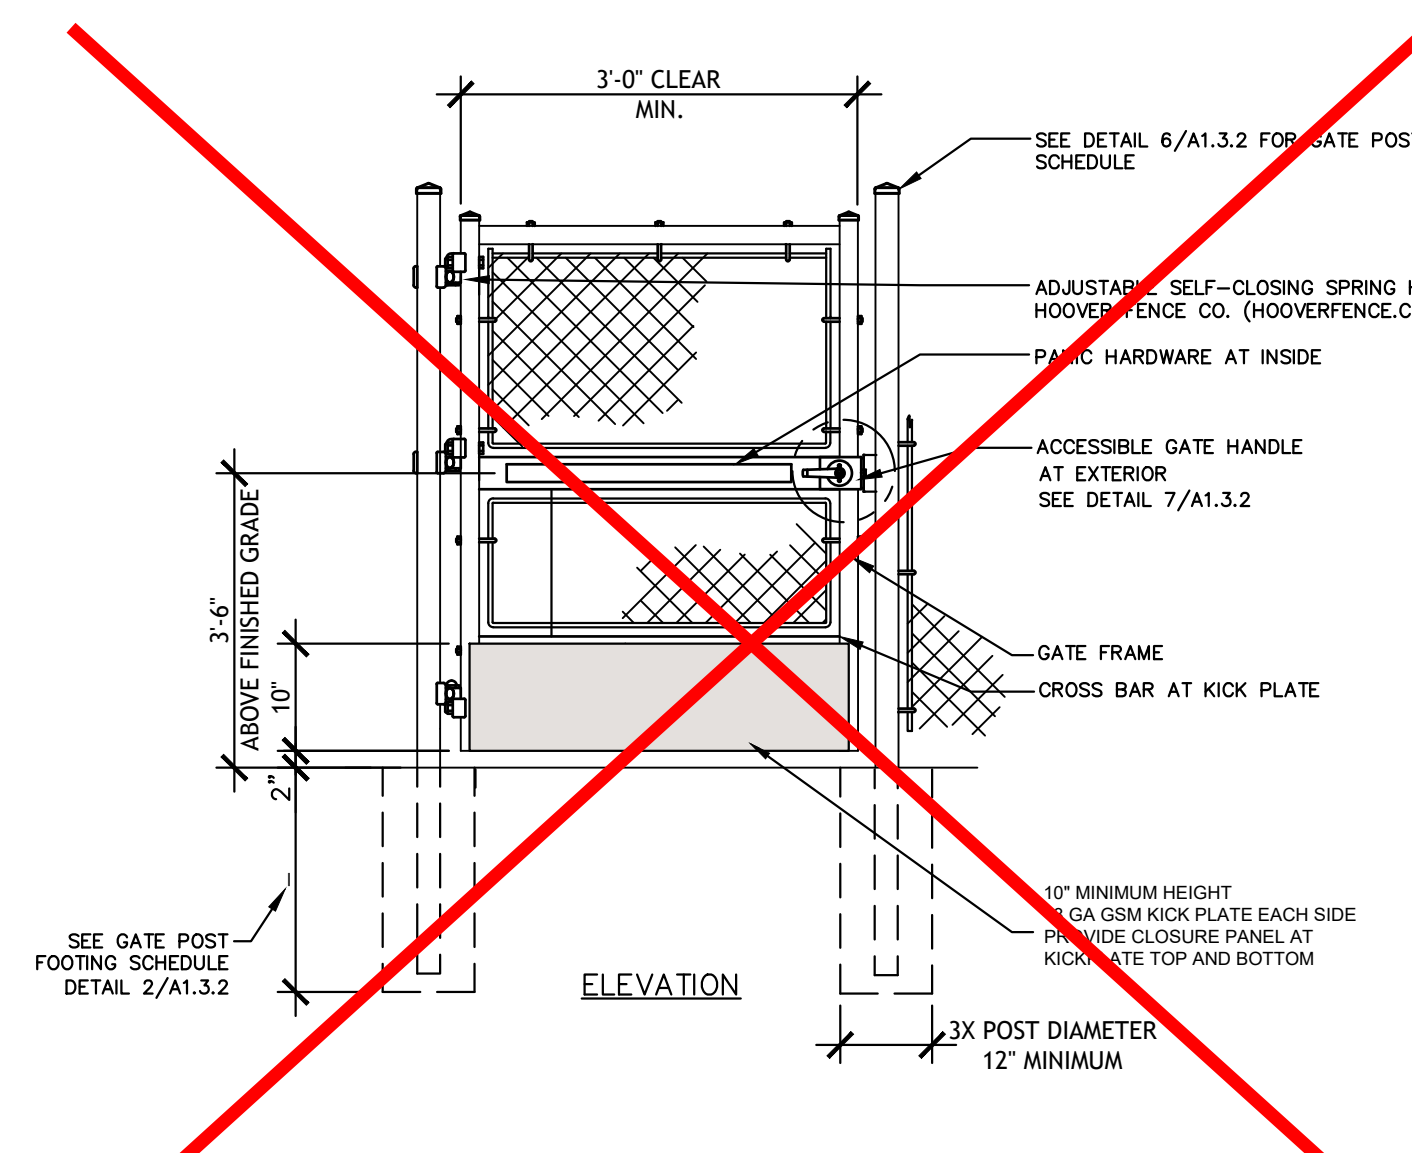

3 ACCESSIBLE CHAIN LINK GATE


N.T.S.

GATE POST SCHEDULE				
FENCE HEIGHT (H)	GATE WIDTH	NOMINAL SIZE OF PIPE INCHES	ACTUAL O.D. INCHES	WEIGHT PER FOOT POUNDS
LESS THAN 6 FEET	SINGLE GATES 6 FEET OR LESS AND DOUBLE GATES 12 FEET OR LESS	2 1/2	2.875	5.79
"	SINGLE SWING GATES OVER 6 FEET THRU 13 FEET AND DOUBLE GATES OVER 12 FEET THRU 26 FEET	3 1/2	4.0	9.11
"	SINGLE SWING GATES OVER 13 FEET THRU 18 FEET AND DOUBLE GATES OVER 26 FEET THRU 36 FEET	4	4.5	10.79
6 FEET TO 8 FEET INCLUSIVE	SINGLE GATES 6 FEET OR LESS AND DOUBLE GATES 12 FEET OR LESS	2 1/2	2.875	5.79
"	SINGLE SWING GATES OVER 6 FEET THRU 13 FEET AND DOUBLE GATES OVER 12 FEET THRU 26 FEET	4	4.5	10.79
"	SINGLE SWING GATES OVER 13 FEET THRU 18 FEET AND DOUBLE GATES OVER 26 FEET THRU 36 FEET	5	5.563	14.62

6 GATE POST SCHEDULE


N.T.S.

GATE POST FOOTING SCHEDULE			
GATE WIDTH		FOOTING MIN. DEPTH, D.	
SINGLE GATE	DOUBLE GATE	H TO 6'	H>6' TO 8'
TO 8'	TO 16'	3'-0"	3'-0"
> 8' TO 10'	> 16' TO 20'	3'-0"	3'-9"
> 10' TO 12'	> 20' TO 24'	3'-6"	4'-3"
> 12' TO 13'	> 24' TO 26'	4'-0"	4'-6"
> 13' TO 14'	> 26' TO 28'	3'-0"	3'-6"
> 14' TO 16'	> 28' TO 32'	3'-3"	4'-0"
> 16' TO 18'	> 32' TO 26'	3'-9"	4'-6"
> INDICATES "GREATER THAN"			

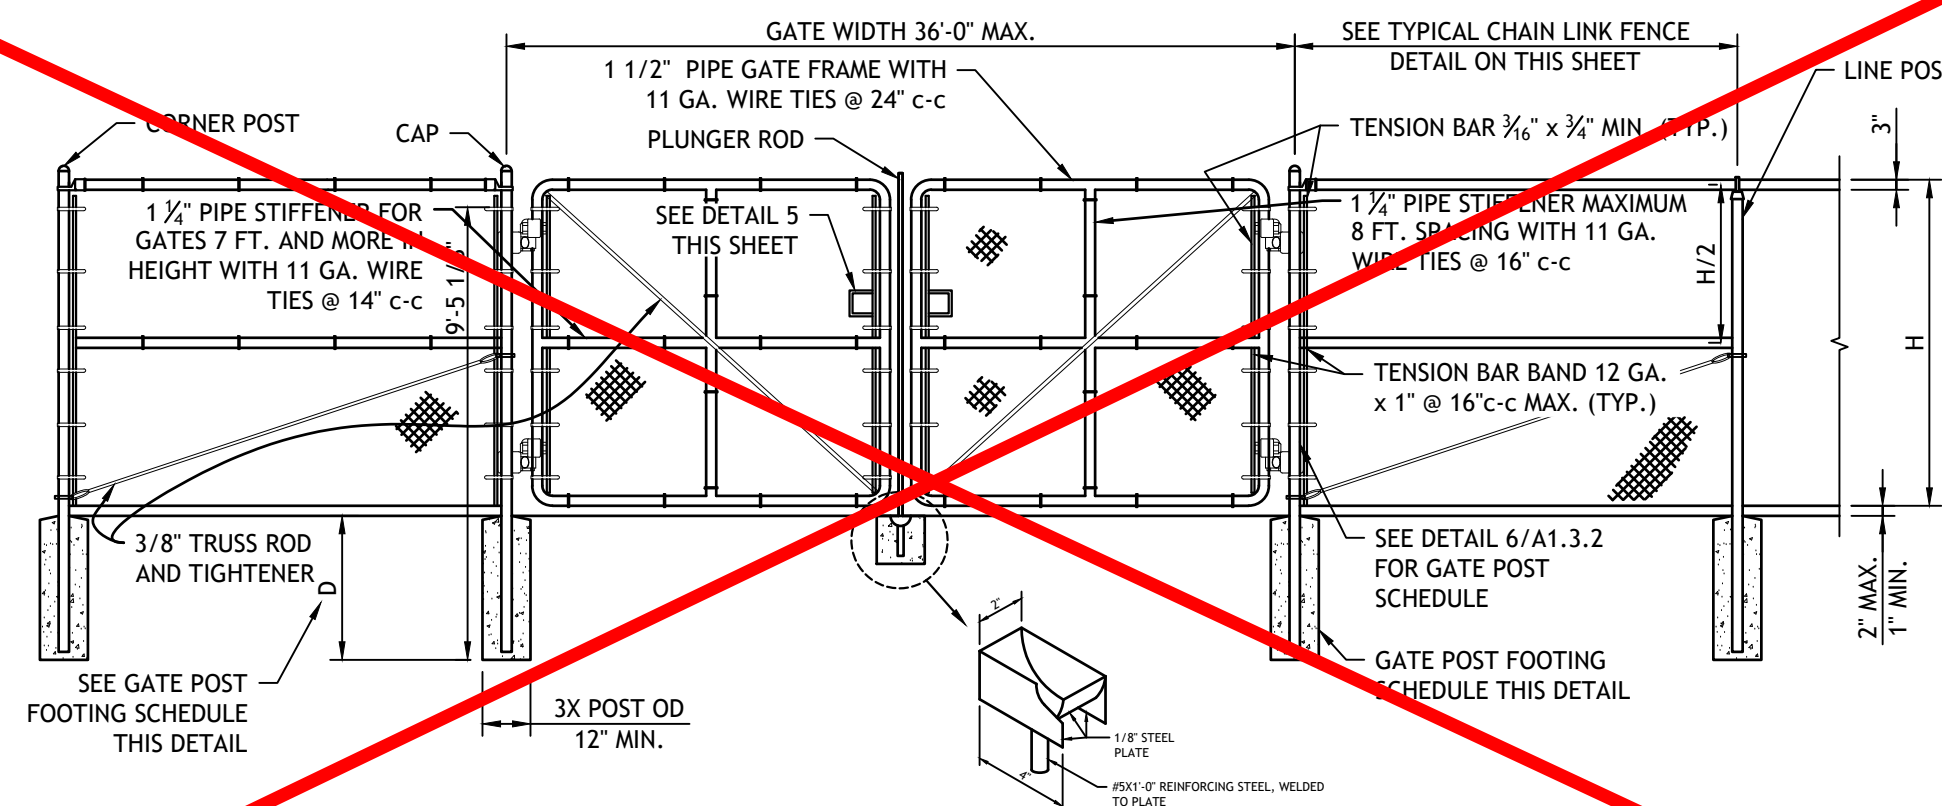


2 DOUBLE CLF GATE & GATE POST FOOTING SCHEDULE

N.T.S.

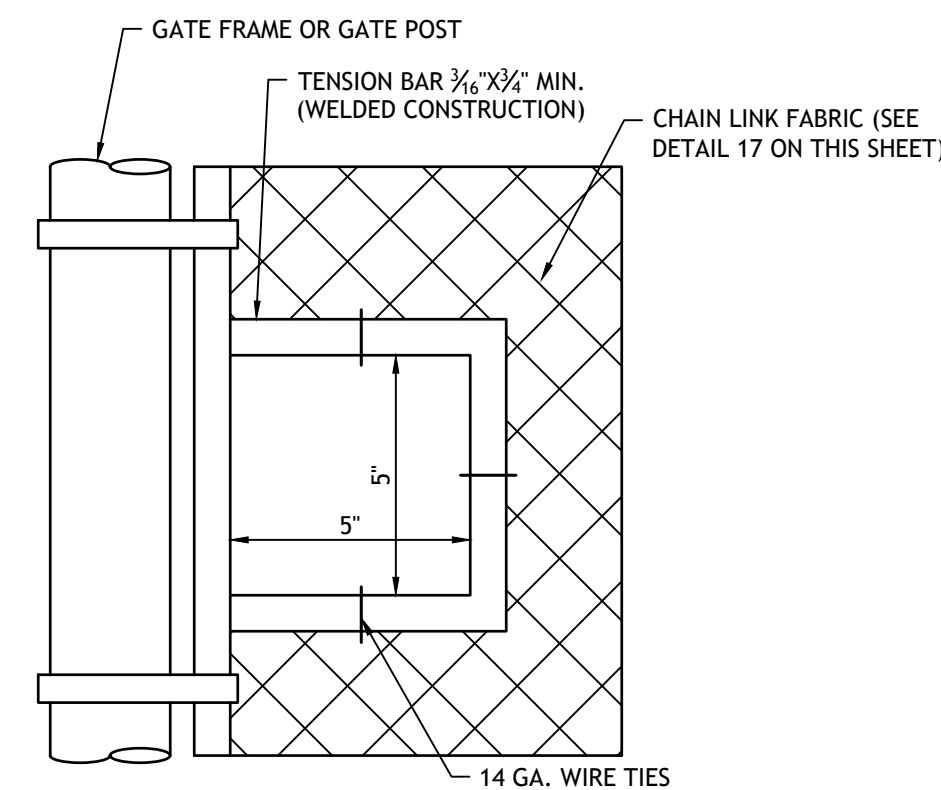

5 CUT OUT CHAIN LOCK/ FENCE POST FOOTING SCHEDULE

N.T.S.

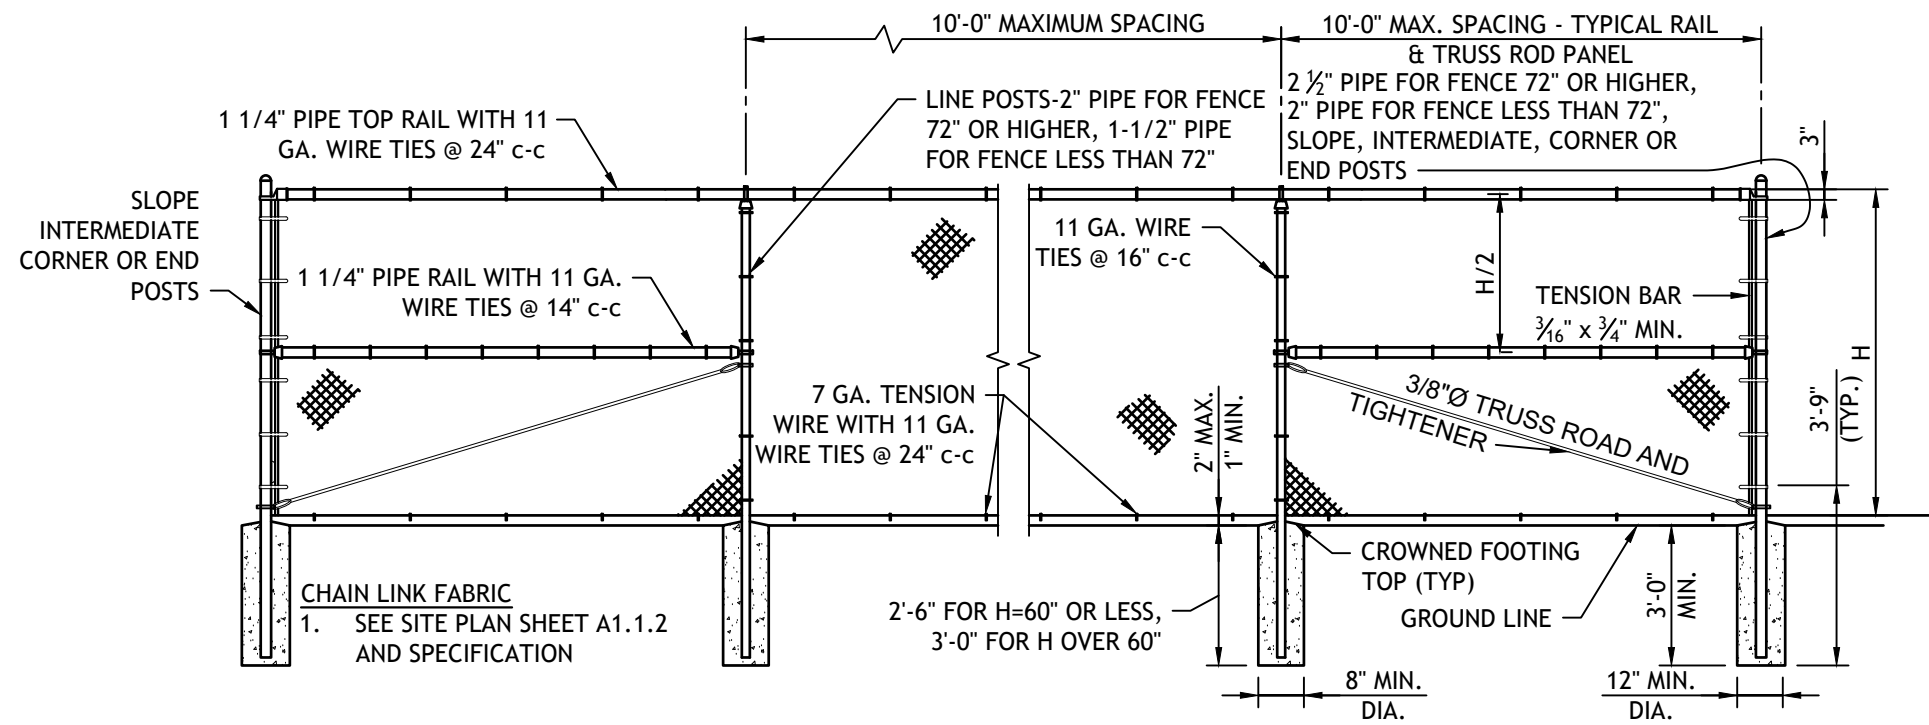


1 TYPICAL CHAIN LINK FENCE

N.T.S.

- NOTES
1. MATERIALS FOR CHAIN LINK FENCE AND GATES SHALL CONFORM TO CALTRANS SECTION 206-6 OF THE STANDARD SPECIFICATIONS EXCEPT AS INDICATED HERON OR MODIFIED BY PROJECT PLANS.
 2. FABRIC SHALL HAVE KNUCKLED FINISH ON BOTH TOP AND BOTTOM EDGES.
 3. ALL GATE HINGES SHALL BE HEAVY DUTY MALLEABLE IRON OR STEEL, INDUSTRIAL SERVICE TYPE AND NOT LESS THAN 3-INCHES IN WIDTH.
 4. ALL COMPONENTS SHALL BE GALVANIZED STEEL.
 5. CONSTRUCTION OF CHAIN LINK FENCE OR GATES SHALL CONFORM TO CALTRANS SECTION 304-3 OF THE STANDARD SPECIFICATIONS EXCEPT AS INDICATED HERON OR MODIFIED BY PROJECT PLANS.
 6. CAP OR TOP SHALL BE SECURED TO POST USING 1/4-INCH RIVET.
 7. CORNER OR SLOPE POSTS SHALL BE INSTALLED WHEN THE CHANGE IN DEFLECTION ANGLE IS 30 DEGREES OR MORE AT CORNER OR SLOPE POINTS. CONSTRUCT SLOPE POSTS AS THOUGH THEY WERE CORNER POSTS.
 8. INTERMEDIATE POSTS SHALL BE PROVIDED WHEN THE DISTANCE BETWEEN CORNER OR SLOPE POSTS EXCEEDS 300 FEET. THEY SHALL BE CONSTRUCTED AS THOUGH THEY WERE CORNER OR SLOPE POSTS.
 9. THREADS OF ALL 3/8-INCH ROUND TRUSS RODS SHALL BE PEENED AFTER INSTALLATION.
 10. WHEN TOP RAIL IS OMITTED BY PLAN, PROVIDE 7-GATE TENSION WIRE WITH 11-GA FIBRIC TIES OR HOG RINGS SPACED AT 24-INCH INTERVALS.
 11. GATES SHALL BE PROVIDED WITH A COMBINATION SPRING LATCH AND PLUNGER ROD, APPROVED BY THE ARCHITECT.
 12. TENSION WIRE SHALL BE SECURELY FASTENED TO THE TERMINAL POSTS AND BE TAUT AND FREE OF SAG.
 13. THE FABRIC SHALL BE PLACED ON THE OUTWARD FACING SIDE OF THE POSTS, STRETCHED TAUT, AND FASTENED SECURELY.


8 FENCE, POST AND GATE NOTES

N.T.S.

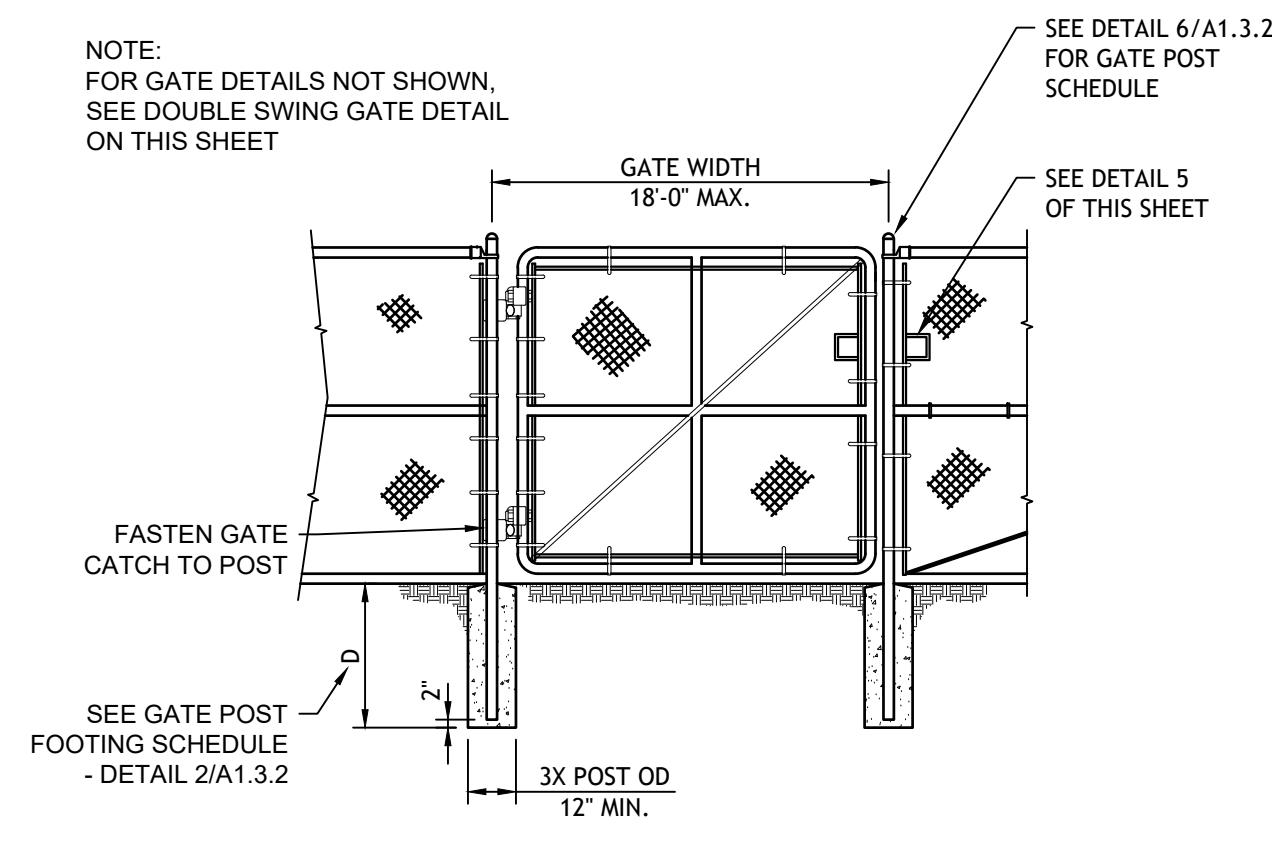


4 SINGLE CHAIN LINK FENCE GATE

N.T.S.

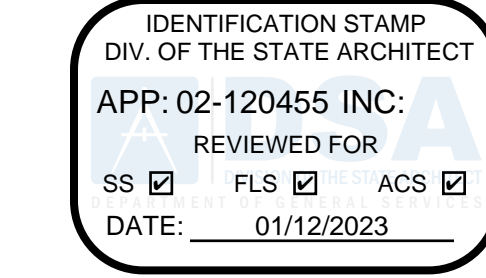

730 Howe Avenue, Suite 450
Sacramento, CA 95825
Phone: 916.921.2112
Fax: 916.921.2212

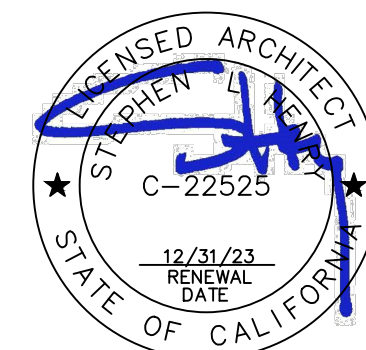


MODERNIZATION LAKEWOOD
ELEMENTARY SCHOOL

TYPICAL SITE DETAILS


CONSULTANT

PROJECT NO.	REVISIONS	BY
21-32-052		
DATE		
3/28/2022		
DRAWN		
MS		
CHECKED		
JCBS		
SCALE		
AS SHOWN		
CADFILE		
UPDATED		
11/17/2022		
SHEET NO.		

A1.3.2

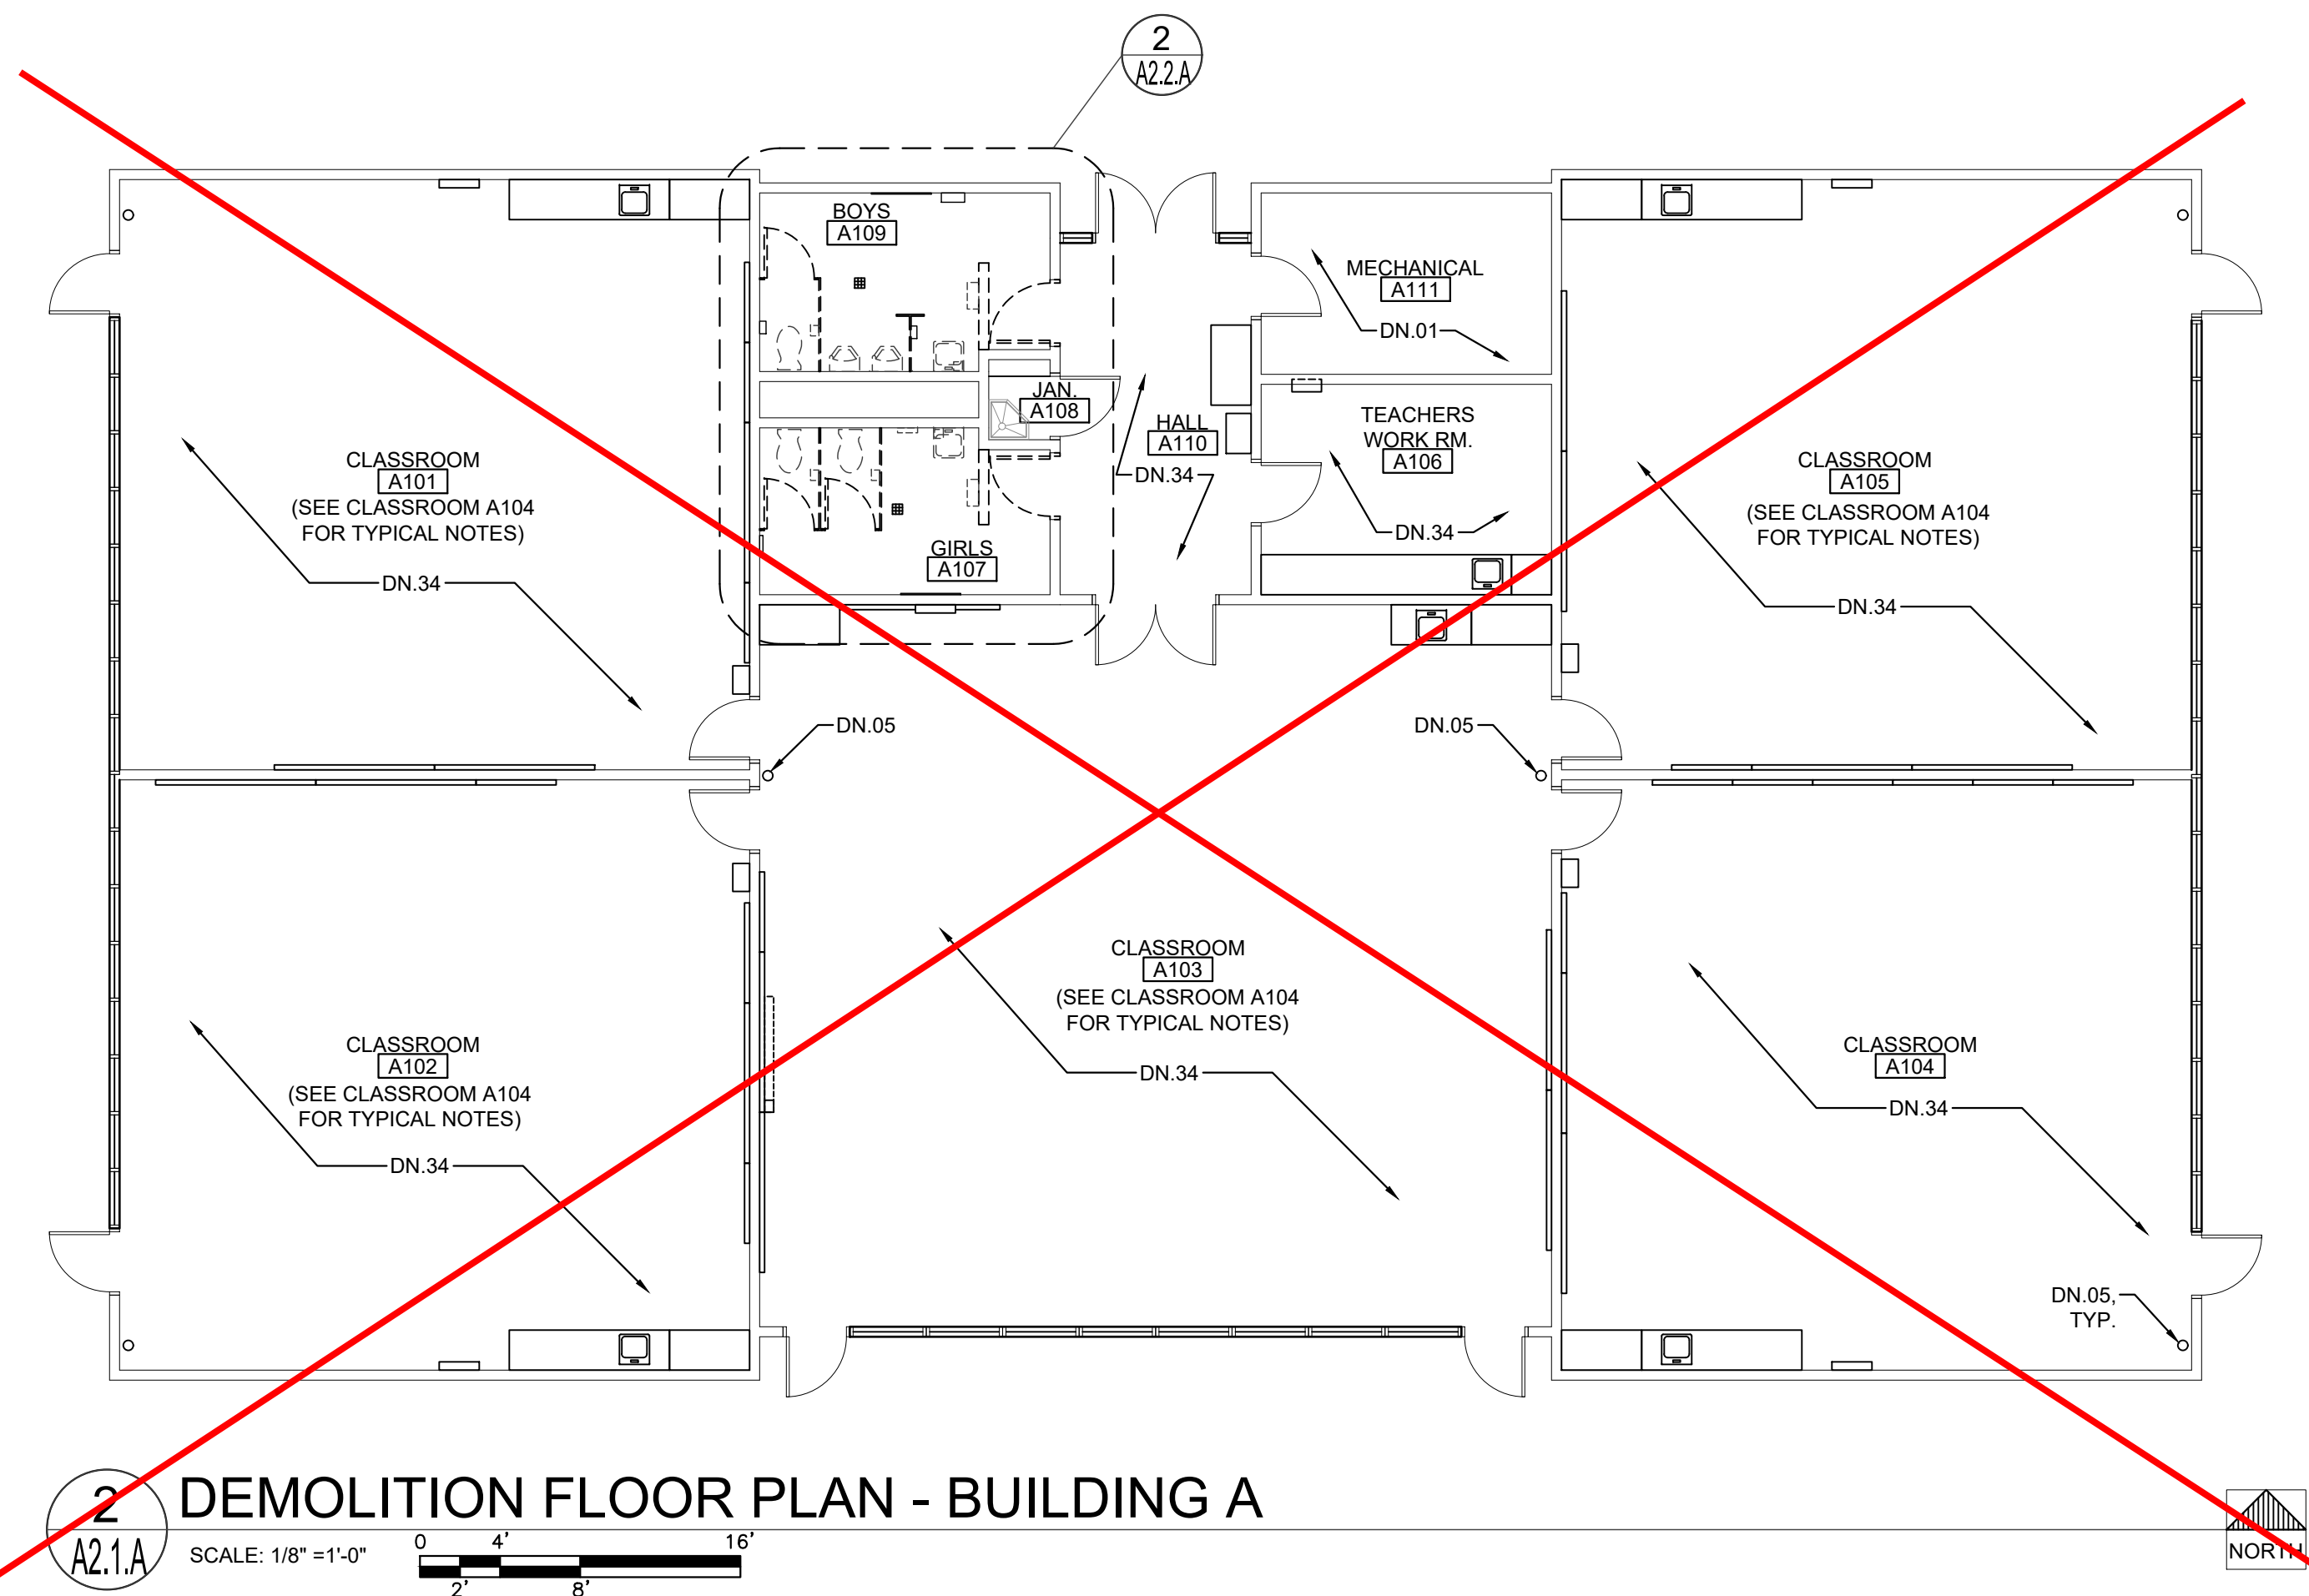

2 DEMOLITION FLOOR PLAN - BUILDING A
SCALE: 1/8" = 1'-0"
0 4' 8' 16'

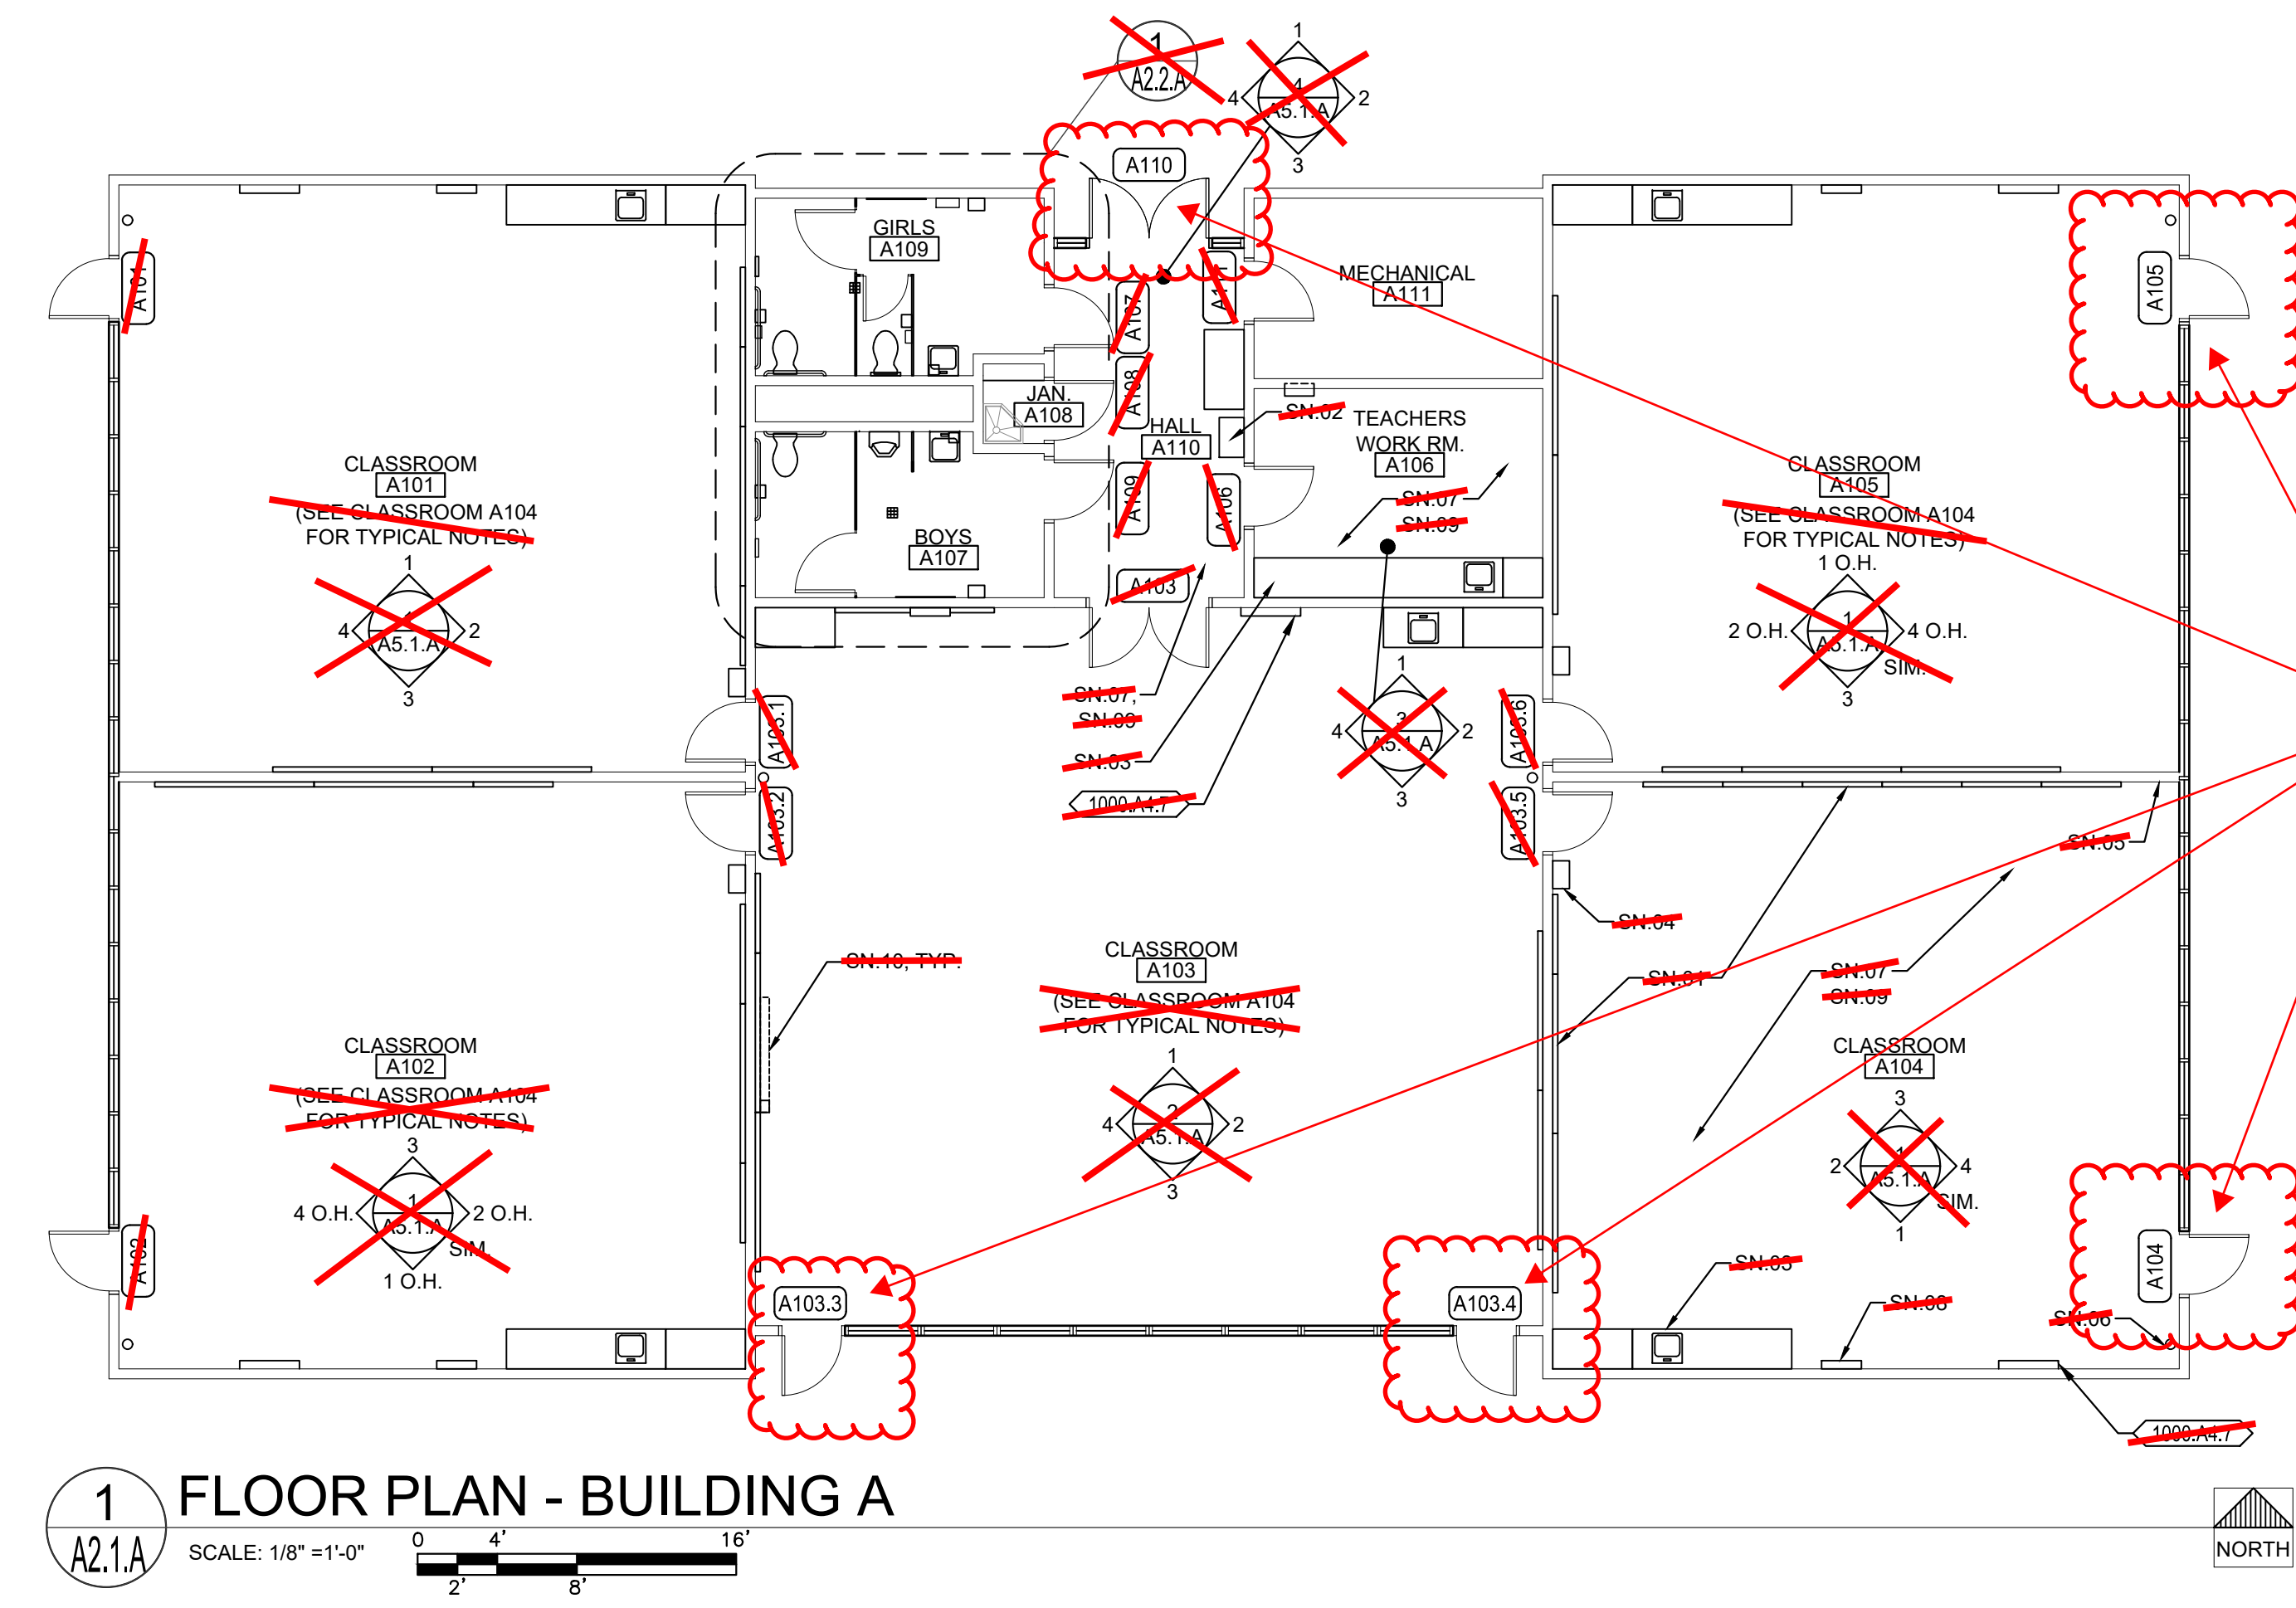

1 FLOOR PLAN - BUILDING A
SCALE: 1/8" = 1'-0"
0 4' 8' 16'

KEYNOTES

NOTE: NOT ALL NOTES MAY BE USED

- 0300 CONCRETE**
0300.A1 CONCRETE SLAB ON GRADE
- 0600 WOOD, PLASTICS, COMPOSITES**
0600.D1 PLASTIC LAMINATE CASEWORK
- 0900 FINISHES**
0900.A5 RESINOUS FLOOR COATING W/ 6" INTEGRAL COVED BASE
0900.B5 FIBERGLASS REINFORCED PLASTIC PANELS (FRP)
0900.B7 RESINOUS WALL COATING INSTALLED O/ (E) CERAMIC TILE WAINSCOTING
- 1000 SPECIALTIES**
1000.A4 SIGNS
1. PARKING LOT ENTRANCE SIGN "TOWAWAY"
2. DISABLED ACCESSIBLE PARKING STALL SIGN
3. ROOM IDENTIFICATION SIGN
4. RESTROOM IDENTIFICATION SIGN
5. TACTILE EXIT SIGN
6. SELF-ILLUMINATING EXIT SIGN
7. ASSISTIVE LISTENING DEVICE SIGN
1000.A5 TOILET PARTITION
1. TOILET PARTITION PILASTER
1000.A6 URINAL PARTITION
1000.A7 TOILET ACCESSORIES
1. PAPER TOWEL DISPENSER
2. TOILET PAPER DISPENSER
3. SANITARY NAPKIN DISPENSER
4. SOAP DISPENSER
5. MIRROR
6. SANITARY NAPKIN DISPOSAL RECEPTACLE
7. GARBAGE BIN
8. SHELF
9. MOP RACK
10. BABY CHANGING STATION
11. TOILET SEAT COVER DISPENSER
12. WASTE RECEPTACLE
13. WASTE RECEPTACLE-FREE STANDING
- 2200 PLUMBING**
2200.A1 PLUMBING EQUIPMENT
1. SINK
2. LAVATORY
3. TOILET
4. URINAL
5. DRINKING FOUNTAIN
6. MOP SINK
7. WATER HEATER
8. ROOF DRAIN/OVERFLOW COMBO UNIT
9. FLOOR DRAIN - SLOPE FLOOR TO DRAIN 2% MAX. SLOPE
10. ROOF/OVERFLOW DRAIN DISCHARGE
11. CONDENSATE DRAIN LINE
12. VENT RISER PIPE
13. BOTTLE FILLER
- 2300 HVAC**
2300.A2 CEILING REGISTER - SEE MECHANICAL
2300.A3 MECHANICAL DUCT
- 2600 ELECTRICAL**
2600.A2 LIGHT FIXTURE
2600.A7 FIRE ALARM DEVICE

GENERAL NOTES

- THE EXISTING CLASSROOMS ARE NOT IDENTICAL IN REGARD TO QUANTITY OR LOCATION OF VARIOUS WALL OR CEILING MOUNTED ITEMS REQUIRED TO BE REMOVED OR PROTECTED IN PLACE AND MASKED FOR PAINTING. THE DEMOLITION PLANS AND NOTES ARE GENERAL IN NATURE AND REPRESENT THE GENERAL DEMOLITION OR PROTECT-IN-PLACE SCOPE. THE CONTRACTOR IS REQUIRED TO REMOVE AND MASK IN PLACE ALL EXISTING DRY MARKER BOARDS, TACKBOARDS, CASEWORK, PROJECTION SCREENS, FIRE EXTINGUISHERS, WINDOW COVERINGS & TRACKS, LIGHT FIXTURES OR ANY OTHER ITEM WHETHER SPECIFICALLY SHOWN OR NOT AND AS REQUIRED FOR INSTALLATION OF NEW FINISHES. SOME ITEMS WILL BE REQUIRED TO BE REMOVED AND TEMPORARILY STORED AND PROTECTED FOR LATER INSTALLATION.
- NOT ALL OF THE EXISTING INTRUSION ALARM AND DATA NETWORKING/DISTRIBUTION COMPONENTS ARE SHOWN IN THE PLANS. THESE ITEMS ARE TO REMAIN AS INSTALLED AND SHALL BE MASKED USING PLASTIC SHEETING AND ANY OTHER PROTECTION MEASURES NECESSARY DURING CONSTRUCTION OPERATIONS AND PRIOR TO PAINTING. VERIFY WITH OWNER THE EXACT PROTECTION AND MASKING MEASURES AND LIMITATIONS PRIOR TO MASKING.

DEMOLITION NOTES

NOTE: NOT ALL NOTES MAY BE USED

- DN.01 THERE ARE NO ITEMS BEING REMOVED IN THIS ROOM EXCEPT AS MAY BE SHOWN HERE OR OTHER PLAN SHEETS. SEE ARCHITECTURAL FLOOR PLAN AND INTERIOR ELEVATIONS FOR WORK SCOPE IMPROVEMENTS.
- DN.02 REMOVE (E) DOOR, SIDELIGHT PANEL, TRANSOM GLAZING AND ENTIRE FRAME. PROTECT IN PLACE AND/OR SALVAGE ANY INTRUSION ALARM COMPONENTS FOR FUTURE INSTALLATION AND CONNECTION.
- DN.03 REMOVE (E) CASEWORK AND SHELVING
- DN.04 REMOVE (E) DRY MARKER BOARDS & TACKBOARDS
- DN.05 REMOVE (E) FIRE EXTINGUISHER & HANGER. STORE AND PROTECT FOR FUTURE REINSTALLATION.
- DN.06 REMOVE (E) LIGHT FIXTURES AT CEILING OR WALLS THROUGHOUT - SEE ELECTRICAL.
- DN.07 REMOVE (E) DATA NETWORKING/DISTRIBUTION EQUIPMENT IF NECESSARY TO PERFORM NEW WORK OR PROTECT IN PLACE.
- DN.08 REMOVE (E) SOAP & PAPER TOWEL DISPENSER. STORE AND PROTECT FOR FUTURE REINSTALLATION.
- DN.09 DIMENSIONS PROVIDED ARE BASED ON (E) DIMENSIONS TAKEN IN THE FIELD. THIS PLUMBING FIXTURE MAY NEED TO BE MOVED LATERALLY AND/OR UP/DOWN TO ALLOW FOR PROPER DISABLED ACCESSIBLE CLEARANCES PER ADA. CONTRACTOR TO COORDINATE EXACT FINAL LOCATION AND REMOVE (E) FINISHES AS REQUIRED TO MODIFY (E) OR INSTALL (N) PLUMBING FIXTURE CARRIER, WASTE LINES, PLUMBING SUPPLY LINES OR VENT PIPES ETC. PATCH BACK FINISHES TO MATCH SURROUNDING FINISHES.
- DN.9.1 REMOVE (N) FINISHES AS REQUIRED TO MODIFY (E) OR INSTALL (N) PLUMBING FIXTURE CARRIER, WASTE LINES, PLUMBING SUPPLY LINES OR VENT PIPES ETC. PATCH BACK FINISHES TO MATCH SURROUNDING FINISHES.
- DN.10 PREP (E) FLOOR AS REQUIRED TO INSTALL NEW FLOOR FINISH
- DN.11 REMOVE (E) TOILET ROOM ACCESSORY
- DN.12 REMOVE (E) TOILET ROOM ACCESSORIES. STORE & PROTECT FOR FUTURE REINSTALLATION
- DN.13 REMOVE (E) TOILET PARTITION, MOUNTING HARDWARE AND ANY EXPOSED BLOCKING. PATCH BACK EXISTING SURFACE TO MATCH.
- DN.14 REMOVE (E) LAVATORY - SEE PLUMBING
- DN.15 REMOVE (E) TOILET - SEE PLUMBING
- DN.16 REMOVE (E) URINAL - SEE PLUMBING
- DN.17 REMOVE (E) MOP SINK - SEE PLUMBING
- DN.18 REMOVE (E) WATER HEATER
- DN.19 REMOVE (E) SINK, FAUCET, COUNTERTOP, LEDGERS & BASE CABINET - SEE PLUMBING. PREP WALL FOR NEW FINISHES
- DN.20 REMOVE (E) TILE, MASONRY OR FRP WAINSCOTING. PREP WALL FOR (N) FINISHES DN.21 REMOVE (E) MOP HOLDER
- DN.22 REMOVE (E) PARTITION. PATCH (E) FINISHES (FLOOR, WALLS & CEILING) TO MATCH SURROUNDING FINISHES WHERE PARTITION WILL NOT BE REPLACED.
- DN.23 REMOVE (E) DOOR AND HARDWARE. HOLLOW METAL FRAME TO REMAIN. INFILL DOOR OPENING PER DETAILS.
- DN.24 REMOVE (E) DOOR, FRAME AND ANY TRIM. PREP OPENING FOR (N) DOOR, FRAME AND FINISHES.
- DN.25 REMOVE (E) CARPET, SHEET VINYL, VINYL TILE FLOORING, SELF-RAISING BASE OR RUBBER BASE. PREP FLOOR FOR NEW FINISH.
- DN.26 REMOVE (E) WALL MOUNTED JANITORIAL DILUTION CONTROL UNIT. STORE AND PROTECT FOR REINSTALLATION.
- DN.27 REMOVE (E) SURFACE MOUNTED THERMOSTAT, ELECTRICAL OUTLET, SIGNAL OUTLET AND ANY ASSOCIATED CONDUIT AND CONDUCTOR - SEE ELECTRICAL OR MECHANICAL FOR MORE SPECIFIC MODIFICATIONS OR RELOCATION. PREP SURFACES FOR NEW FINISH.
- DN.28 REMOVE (E) SURFACE MOUNTED INTRUSION ALARM, DATA NETWORKING OR OTHER DEVICE AND RELOCATE - SEE ELECTRICAL.
- DN.29 REMOVE (E) RETURN AIR REGISTER AND EXTEND (E) DUCT TO NEW PARTITION WALL FACE AND REINSTALL RETURN AIR REGISTER - SEE MECHANICAL.
- DN.30 REMOVE/RELOCATE (E) FIRE ALARM CONDUIT, CABLE AND COMPONENTS PER ELECTRICAL. PREP SURFACES FOR NEW FINISH.
- DN.31 REMOVE (E) GLAZING, GLAZING TRIM, WALL PANEL & WALL PANEL TRIM AS REQUIRED FOR INSTALLATION OF (N) DOOR THIS LOCATION. PREP SURFACES FOR NEW FINISH.
- DN.32 REMOVE (E) WAINSCOTING OR OTHER WALL FINISHES AND PREP WALL SURFACE AS REQUIRED FOR INSTALLATION OF (N) WALL FINISH.
- DN.33 REMOVE (E) CONCRETE SLAB AS REQUIRED TO MODIFY OR INSTALL WASTE LINES-PATCH BACK W/ (N) CONCRETE.
- DN.34 REMOVE (E) CARPET & WALL BASE THROUGHOUT - SEE HAZARDOUS MATERIALS DOCUMENTATION FOR REMOVAL OF (E) VAT BELOW CARPET.


SHEET NOTES

(NOTE: NOT ALL NOTES MAY BE USED)

- SN.01 (E) DRY MARKER BOARDS, TACK BOARDS AND MAP RAILS TO REMAIN IN PLACE AND PROTECTED
- SN.02 (E) DATA NETWORKING COMPONENTS TO REMAIN IN PLACE AND PROTECTED
- SN.03 (E) CASEWORK TO REMAIN IN PLACE & PROTECTED
- SN.04 (E) TELEPHONE TO REMAIN IN PLACE AND PROTECTED
- SN.05 (E) FOLDING PARTITION WALL, WOOD TRIM AND BEAM ABOVE TO REMAIN IN PLACE. PREP AND PAINT BOTH SIDES OF WALL AND ALL ITEMS TO MATCH WALLS
- SN.06 (E) FIRE EXTINGUISHER BRACKET TO REMAIN IN PLACE AND PROTECTED. TEMPORARILY REMOVE FIRE EXTINGUISHER AND REPLACE FOLLOWING INSTALLATION OF (N) WALL FINISH.
- SN.07 (E) CARPET TO BE REPLACED WITH (N) LVP FLOORING. OTHER FINISHES TO BE PROTECTED DURING CONSTRUCTION OPERATIONS
- SN.08 (E) CLOCK/SPEAKER TO REMAIN IN PLACE AND PROTECTED
- SN.09 (E) DATA OUTLETS, POWER OUTLETS, LIGHT SWITCHES, ELECTRICAL PANELS, SIGNAGE, HVAC UNITS, ELECTRICAL TRANSFORMERS AND OTHER SIMILAR BUILDING COMPONENTS TO REMAIN IN PLACE AND PROTECTED. PREP AND PAINT TO MATCH WALLS ONLY IF PREVIOUSLY PAINTED.
- SN.10 (E) PROJECTOR & PROJECTION SCREEN TO REMAIN IN PLACE AND PROTECTED. PAINT ANY MOUNTING.
- SN.11 INFILL FRAME (E) DOOR OPENING. PROVIDE THERMAL INSULATION AND PROVIDE GYPSUM WALLBOARD FINISH AT INTERIOR TO MATCH. - SEE ELEVATION AND DETAILS.
- SN.12 (E) LIGHT FIXTURES, FIRE ALARM & INTRUSION ALARM COMPONENTS TO REMAIN IN PLACE AND PROTECTED.
- SN.13 (E) ACCESS PANELS, HVAC DUCTS AND REGISTERS TO REMAIN IN PLACE AND PROTECTED - PAINT TO MATCH (N) PAINT AT CEILING.
- SN.14 REINSTALL (E) TOILET ACCESSORIES OR JANITOR EQUIPMENT SALVAGED DURING DEMOLITION OPERATIONS
- SN.15 NO NEW WORK THIS SPACE
- SN.16 DISABLED ACCESSIBLE
- SN.17 (E) EXPOSED WIRING, CABLING AND WIREMOLD RACEWAY TO REMAIN IN PLACE. SNAP CLOSE ANY WIREMOLD RACEWAY THAT IS NOT PROPERLY CLOSED AND REINSTALL ADDITIONAL CABLE FASTENERS AS NECESSARY FOR POSITIVE ATTACHMENT TO WALL PRIOR TO PREP AND PAINT. THESE ITEMS ARE TO REMAIN IN PLACE AND BE PREP'D AND PAINTED ALONG WITH NEW WALL FINISH.
- SN.18 PREP AND PAINT EXISTING WINDOW FRAMES, DOOR FRAMES AND DOOR. DO NOT PAINT THE BUILDING EXTERIOR SIDE.
- SN.19 PREP AND PAINT EXISTING WALLS, HVAC REGISTERS AND CEILING SURFACES. PATCH BACK ANY DAMAGED VINYL WALL COVERING WITH (N) TO MATCH OR CEILING OR WALL SURFACES DAMAGED DUE TO ITEMS REMOVED DURING DEMOLITION TO MATCH (E) PRIOR TO INSTALLATION OF (N) PAINTING OR FINISHES.
- SN.20 PREP AND PAINT (E) EXPOSED BEAMS AND WOOD TRIM AT HEAD OF WALL
- SN.21 COORDINATE INSTALLATION OF (N) TOILET OR URINAL PARTITION. PROVIDE ALL NECESSARY FOR CONNECTIONS IN WALLS AND CEILINGS FOR CONNECTION POINTS. REPLACE AND REPAIR WALL AND CEILING FINISHES TO MATCH SURROUNDING FINISHES.
- SN.22 (E) PLUMBING FIXTURE TO REMAIN IN PLACE. NO NEW WORK.
- SN.23 (N) 2X6 WOOD STUD PARTITION WITH WATER RESISTANT GYPSUM WALLBOARD EA. SIDE. FINISH TO MATCH EXISTING WALL FINISHES. PROVIDE ACOUSTICAL INSULATION PER SPECIFICATION.
- SN.24 (E) ACCESS PANELS TO REMAIN. PROTECT AND PAINT TO MATCH WALLS. CUT (N) FRP WAINSCOTING AROUND ACCESS PANEL.
- SN.25 PREP AND PAINT (E) WOOD SHELVING
- SN.26 REMOVE (E) CEILING TILES THAT ARE COMING LOOSE AND REINSTALL WITH NEW ADHESIVE PRIOR TO PAINTING.

IDENTIFICATION STAMP
DIV. OF THE STATE ARCHITECT
APP: 02-120455 INC:
REVIEWED FOR
SS ☒ FLS ☒ ACS ☒
DATE: 01/12/2023

730 Howe Avenue, Suite 450
Sacramento, CA 95825
Phone: 916.921.2112
Fax: 916.921.2212

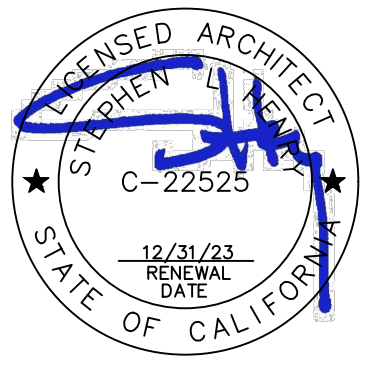

MODERNIZATION LAKEWOOD
ELEMENTARY SCHOOL

DEMOLITION & FLOOR
PLANS - BUILDING A

CONSULTANT

PROJECT NO.	REVISIONS	BY
21-32-052		
DATE		
3/28/2022		
DRAWN		
MS		
CHECKED		
JCBS		
SCALE		
AS SHOWN		
CADFILE		
UPDATED		
11/17/2022		
SHEET NO.		

A2.1.A

KEYNOTES

NOTE: NOT ALL NOTES MAY BE USED

- 0300 CONCRETE**
0300.A1 CONCRETE SLAB ON GRADE
- 0600 WOOD, PLASTICS, COMPOSITES**
0600.D PLASTIC LAMINATE CASEWORK
- 0900 FINISHES**
0900.A6 RESINOUS FLOOR COATING W/ 6" INTERLACED COVER
0900.B5 FIBERGLASS REINFORCED PLASTIC PANELS (FRP)
0900.B7 RESINOUS WALL COATING INSTALLED BY (E) CERAMIC TILE WAINSCOTING
- 1000 SPECIALTIES**
1000.A4 SIGNS
1. PARKING LOT ENTRANCE SIGN "TOWAWAY"
2. DISABLED ACCESSIBLE PARKING STALL SIGN
3. ROOM IDENTIFICATION SIGN
4. RESTROOM IDENTIFICATION SIGN
5. TACTILE EXIT SIGN
6. SELF-ILLUMINATING EXIT SIGN
7. ASSISTIVE LISTENING DEVICE SIGN
- 1000.A5 TOILET PARTITION
1000.A6 URINAL PARTITION
1000.A7 TOILET ACCESSORIES
1. PAPER TOWEL DISPENSER
2. TOILET PAPER DISPENSER
3. SANITARY NAPKIN DISPENSER
4. SOAP DISPENSER
5. MIRROR
6. SANITARY NAPKIN DISPOSAL RECEPTACLE
7. GRAB BAR
8. SHELF
9. MOP SINK
10. BABY CHANGING STATION
11. TOILET SEAT COVER DISPENSER
12. WASTE RECEPTACLE
13. WASTE RECEPTACLE-FREE STANDING
- 2200 PLUMBING**
2200.A1 PLUMBING EQUIPMENT
SINK
2. LAVATORY
3. TOILET
4. URINAL
5. DRINKING FOUNTAIN
6. MOP SINK
7. WATER HEATER
8. ROOF DRAIN/OVERFLOW COMBO UNIT
9. FLOOR DRAIN-SLOPE & DRAIN TO DRAIN 2% MAX. SLOPE
10. ROOF/OVERFLOW DRAIN DISCHARGE
11. CONDENSATE DRAIN LINE
12. VENT RISER PIPE
13. BOTTLE FILLER
- 2300 HVAC
2300.A2 CEILING REGISTER - SEE MECHANICAL
2300.A3 MECHANICAL DUCT
- 2600 ELECTRICAL**
2600.A2 LIGHT FIXTURE
2600.A7 FIRE ALARM DEVICE

GENERAL NOTES

1. THE EXISTING CLASSROOMS ARE NOT IDENTICAL IN REGARD TO QUANTITY OR LOCATION OF VARIOUS WALL OR CEILING MOUNTED ITEMS REQUIRED TO BE REMOVED OR PROTECTED IN PLACE AND MASKED FOR PAINTING. THE DEMOLITION PLANS AND NOTES ARE GENERAL IN NATURE AND REPRESENT THE GENERAL DEMOLITION OR PROTECT-IN-PLACE SCOPE. THE CONTRACTOR IS REQUIRED TO REMOVE OR PROTECT IN PLACE ALL EXISTING DRY MARKER BOARDS, TACKBOARDS, CASEWORK, PROJECTION SCREENS, FIRE EXTINGUISHERS, WINDOW COVERINGS & TRAYS, LIGHT FIXTURES OR ANY OTHER ITEM WHETHER SPECIFICALLY SHOWN OR NOT AND AS REQUIRED FOR INSTALLATION OF NEW FINISHES. SOME ITEMS WILL BE REQUIRED TO BE REMOVED AND TEMPORARILY STORED AND PROTECTED FOR LATER INSTALLATION.
2. NOT ALL OF THE EXISTING INTRUSION ALARM AND DATA NETWORKING/DISTRIBUTION COMPONENTS ARE SHOWN IN THE PLANS. THESE ITEMS ARE TO REMAIN AS INSTALLED AND SHALL BE MASKED USING PLASTIC SHEETING AND ANY OTHER PROTECTION MEASURES NECESSARY DURING CONSTRUCTION OPERATIONS AND PRIOR TO PAINTING. VERIFY WITH OWNER THE EXACT PROTECTION AND MASKING MEASURES AND LIMITATIONS PRIOR TO MASKING.
3. WHERE PLUMBING FIXTURES OR OTHER COMPONENTS ARE REMOVED FROM WALLS, FLOORS OR CEILINGS AND/OR WALLS, FLOORS OR CEILINGS ARE REMOVED TO ALLOW ACCESS TO UTILITIES OR OTHER ITEMS, THE CONTRACTOR IS REQUIRED TO PATCH BACK THE EXISTING FINISH WITH LIKE FINISHES IN PREPARATION FOR INSTALLATION OF NEW FINISH.

DEMOLITION NOTES


NOTE: NOT ALL NOTES MAY BE USED

- DN.01 THERE ARE NO ITEMS BEING REMOVED IN THIS ROOM EXCEPT AS MAY BE SHOWN HERE OR OTHER PLAN SHEETS. SEE ARCHITECTURAL FLOOR PLAN AND INTERIOR ELEVATIONS FOR WORK SCOPE IMPROVEMENTS
- DN.02 REMOVE (E) DOOR, SIDELIGHT PANEL, TRANSOM GLAZING AND ENTIRE FRAME. PROTECT IN PLACE AND/OR SALVAGE ANY INTRUSION ALARM COMPONENTS FOR FUTURE INSTALLATION AND CONNECTION
- DN.03 REMOVE (E) CASEWORK AND SHELVING
- DN.04 REMOVE (E) DRY MARKER BOARDS & TACKBOARDS
- DN.05 REMOVE (E) FIRE EXTINGUISHER & HANGER. STORE AND PROTECT FOR FUTURE REINSTALLATION
- DN.06 REMOVE (E) LIGHT FIXTURES AT CEILING OR WALLS THROUGHOUT - SEE ELECTRICAL
- DN.07 REMOVE (E) DATA NETWORKING/DISTRIBUTION EQUIPMENT IF NECESSARY TO PERFORM NEW WORK OR PROTECT IN PLACE
- DN.08 REMOVE (E) SOAP & PAPER TOWEL DISPENSER. STORE AND PROTECT FOR FUTURE REINSTALLATION
- DN.09 DIMENSIONS PROVIDED ARE BASED ON (E) DIMENSIONS TAKEN IN THE FIELD. THIS PLUMBING FIXTURE MAY NEED TO MOVE LATERALLY AND/OR DOWN TO ALLOW FOR PROPER DISABLED ACCESSIBLE CLEARANCES PER SET A01. CONTRACTOR TO COORDINATE EXACT FINAL LOCATION AND REMOVE (E) FINISHES AS REQUIRED TO MODIFY (E) OR INSTALL (N) PLUMBING FIXTURE CARRIER, WASTE LINES, PLUMBING SUPPLY LINES, VENT PIPES ETC. PATCH BACK FINISHES TO MATCH SURROUNDING FINISHES.
- DN.10 REMOVE (E) FINISHES AS REQUIRED TO MODIFY (E) OR INSTALL (N) PLUMBING FIXTURE CARRIER, WASTE LINES, PLUMBING SUPPLY LINES OR VENT PIPES ETC. PATCH BACK FINISHES TO MATCH SURROUNDING FINISHES
- DN.10 PREP (E) FLOOR AS REQUIRED TO INSTALL NEW FLOOR FINISH
- DN.11 REMOVE (E) TOILET ROOM ACCESSORY
- DN.12 REMOVE (E) TOILET ROOM ACCESSORIES. STORE & PROTECT FOR FUTURE REINSTALLATION
- DN.13 REMOVE (E) TOILET PARTITION, MOUNTING HARDWARE AND ANY EXPOSED BLOCKING. PATCH BACK EXISTING SURFACE TO MATCH
- DN.14 REMOVE (E) LAVATORY - SEE PLUMBING
- DN.15 REMOVE (E) TOILET - SEE PLUMBING
- DN.16 REMOVE (E) URINAL - SEE PLUMBING
- DN.17 REMOVE (E) MOP SINK - SEE PLUMBING
- DN.18 REMOVE (E) WATER HEATER
- DN.19 REMOVE (E) SINK, FAUCET, COUNTERTOP, LEDGERS & BASE CABINET - SEE PLUMBING. PREP WALL FOR NEW FINISHES
- DN.20 REMOVE (E) TILE, MASONRY OR FRP WAINSCOTING. PREP WALL FOR (N) FINISHES DN.21 REMOVE (E) MOP HOLDER
- DN.22 REMOVE (E) PARTITION. PATCH (E) FINISHES (FLOOR WALLS & CEILING) TO MATCH SURROUNDING FINISHES WHERE PARTITION WILL NOT BE REPLACED.
- DN.23 REMOVE (E) DOOR AND HARDWARE. HOLLOW METAL FRAME TO REMAIN. INFILL DOOR OPENING PER DETAILS.
- DN.24 REMOVE (E) DOOR, FRAME AND ANY TRIM. PREP OPENING FOR (N) DOOR, FRAME AND FINISHES.
- DN.25 REMOVE (E) CARPET, SHEET VINYL, VINYL TILE FLOORING, SELF-COATING BASE OR RUBBER BASE. PREP FLOOR FOR NEW FINISH.
- DN.26 REMOVE (E) WALL MOUNTED JANITORIAL DILUTION CONTROL UNIT. STORE AND PROTECT FOR REINSTALLATION
- DN.27 REMOVE (E) SURFACE MOUNTED THERMOSTAT, ELECTRICAL OUTLET AND ANY ASSOCIATED CONDUIT AND CONDUCTOR - SEE ELECTRICAL OR MECHANICAL FOR MORE SPECIFIC MODIFICATIONS OR RELOCATION. PREP SURFACES FOR NEW FINISH.
- DN.28 REMOVE (E) SURFACE MOUNTED INTRUSION ALARM, DATA NETWORKING OR OTHER DEVICE AND RELOCATE - SEE ELECTRICAL
- DN.29 REMOVE (E) RETURN AIR REGISTER AND EXTEND (E) DUCT TO NEW PARTITION WALL FACE AND REINSTALL RETURN AIR REGISTER - SEE MECHANICAL
- DN.30 REMOVE/RELOCATE (E) FIRE ALARM CONDUIT, CABLE AND COMPONENTS PER ELECTRICAL. PREP SURFACES FOR NEW FINISH.
- DN.31 REMOVE (E) GLAZING, GLAZING TRIM, WALL PANEL & WALL PANEL TRIM AS REQUIRED FOR INSTALLATION OF (N) DOOR THIS LOCATION. PREP SURFACES FOR NEW FINISH
- DN.32 REMOVE (E) WAINSCOTING OR OTHER WALL FINISHES AND PREP WALL SURFACE AS REQUIRED FOR INSTALLATION OF (N) WALL FINISH
- DN.33 REMOVE (E) CONCRETE SLAB AS REQUIRED TO MODIFY OR INSTALL WASTE LINES-PATCH BACK W/ (N) CONCRETE
- DN.34 REMOVE (E) CARPET & WALL BASE THROUGHOUT. SEE HAZARDOUS MATERIALS DOCUMENTATION FOR REMOVAL OF (E) VAT BELOW CARPET.

SHEET NOTES


(NOTE: NOT ALL NOTES MAY BE USED)

- SN.01 (E) DRY MARKER BOARDS, TACK BOARDS AND MAP RAILS TO REMAIN IN PLACE AND PROTECTED
- SN.02 (E) DATA NETWORKING COMPONENTS TO REMAIN IN PLACE AND PROTECTED
- SN.03 (E) CASEWORK TO REMAIN IN PLACE & PROTECTED
- SN.04 (E) TELEPHONE TO REMAIN IN PLACE AND PROTECTED
- SN.05 (E) FOLDING PARTITION WALL, WOOD TRIM AND BEAM ABOVE TO REMAIN IN PLACE. PREP AND PAINT BOTH SIDES OF WALL AND ALL ITEMS TO MATCH WALLS
- SN.06 (E) FIRE EXTINGUISHER BRACKET TO REMAIN IN PLACE AND PROTECTED. TEMPORARILY REMOVE FIRE EXTINGUISHER AND REPLACE FOLLOWING INSTALLATION OF (N) WALL FINISH.
- SN.07 (E) CARPET TO BE REPLACED WITH (N) LVP FLOORING. OTHER FINISHES TO BE PROTECTED DURING CONSTRUCTION OPERATIONS
- SN.08 (E) CLOCK/SPEAKER TO REMAIN IN PLACE AND PROTECTED
- SN.09 (E) DATA OUTLETS, POWER OUTLETS, LIGHT SWITCHES, ELECTRICAL PANELS, SIGNAGE, HVAC UNITS, ELECTRICAL TRANSFORMERS AND OTHER SIMILAR BUILDING COMPONENTS TO REMAIN IN PLACE AND PROTECTED. PREP AND PAINT TO MATCH WALLS ONLY IF PREVIOUSLY PAINTED.
- SN.10 (E) PROJECTOR & PROJECTION SCREEN TO REMAIN IN PLACE AND PROTECTED. PAINT ANY MOUNTING BRACKETS TO MATCH WALL FINISH.
- SN.11 INFILL FRAME (E) DOOR OPENING. PROVIDE THERMAL INSULATION AND PROVIDE GYPSUM WALLBOARD FINISH AT INTERIOR TO MATCH. - SEE ELEVATION AND DETAILS.
- SN.12 (E) LIGHT FIXTURES, FIRE ALARM & INTRUSION ALARM COMPONENTS TO REMAIN IN PLACE AND PROTECTED
- SN.13 (E) ACCESS PANELS, HVAC DUCTS AND REGISTERS TO REMAIN IN PLACE AND PROTECTED - PAINT TO MATCH (N) PAINT AT CEILING.
- SN.14 REINSTALL (E) TOILET ACCESSORIES OR JANITOR EQUIPMENT SALVAGED DURING DEMOLITION OPERATIONS
- SN.15 NO NEW WORK THIS SPACE
- SN.16 DISABLED ACCESSIBLE
- SN.17 (E) EXPOSED WIRING, CABLE AND WIREMOLD RACEWAY TO REMAIN IN PLACE. SNAP CLOSE ANY WIREMOLD RACEWAY THAT IS NOT PROPERLY CLOSED AND INSTALL ADDITIONAL CABLE FASTENERS AS NECESSARY FOR POSITIVE ATTACHMENT TO WALL PRIOR TO PREP AND PAINT. THESE ITEMS ARE TO REMAIN IN PLACE AND BE PREP'D AND PAINTED ALONG WITH NEW WALL FINISH.
- SN.18 PREP AND PAINT EXISTING WINDOW FRAMES, DOOR FRAMES AND DOOR. DO NOT PAINT THE BUILDING EXTERIOR SIDE.
- SN.19 PREP AND PAINT EXISTING WALLS, HVAC REGISTERS AND CEILING SURFACES. PATCH BACK ANY DAMAGED VINYL WALL COVERING WITH (N) TO MATCH OR CEILING OR WALL SURFACES DAMAGED DUE TO ITEMS REMOVED DURING DEMOLITION TO MATCH (E) PRIOR TO INSTALLATION OF (N) PAINTING OR FINISHES.
- SN.20 PREP AND PAINT (E) EXPOSED BEAMS AND WOOD TRIM AT HEAD OF WALL
- SN.21 COORDINATE INSTALLATION OF (N) TOILET OR URINAL PARTITION. PROVIDE ALL NECESSARY BLOCKING IN WALLS OR CEILING FOR CONNECTION POINTS. REPLACE AND REPAIR WALL AND CEILING FINISHES TO MATCH SURROUNDING FINISHES.
- SN.22 (E) PLUMBING FIXTURE TO REMAIN IN PLACE. NO NEW WORK.
- SN.23 (N) 2X6 WOOD STUD PARTITION WITH WATER RESISTANT GYPSUM WALLBOARD EA. SIDE. FINISH TO MATCH EXISTING WALL FINISHES. PROVIDE ACOUSTICAL INSULATION PER SPECIFICATION.
- SN.24 (E) ACCESS PANELS TO REMAIN. PROTECT AND PAINT TO MATCH WALLS. CUT (N) FRP WAINSCOTING AROUND ACCESS PANEL.
- SN.25 PREP AND PAINT (E) WOOD SHELVING
- SN.26 REMOVE (E) CEILING TILES THAT ARE COMING LOOSE AND REINSTALL WITH NEW ADHESIVE PRIOR TO PAINTING.

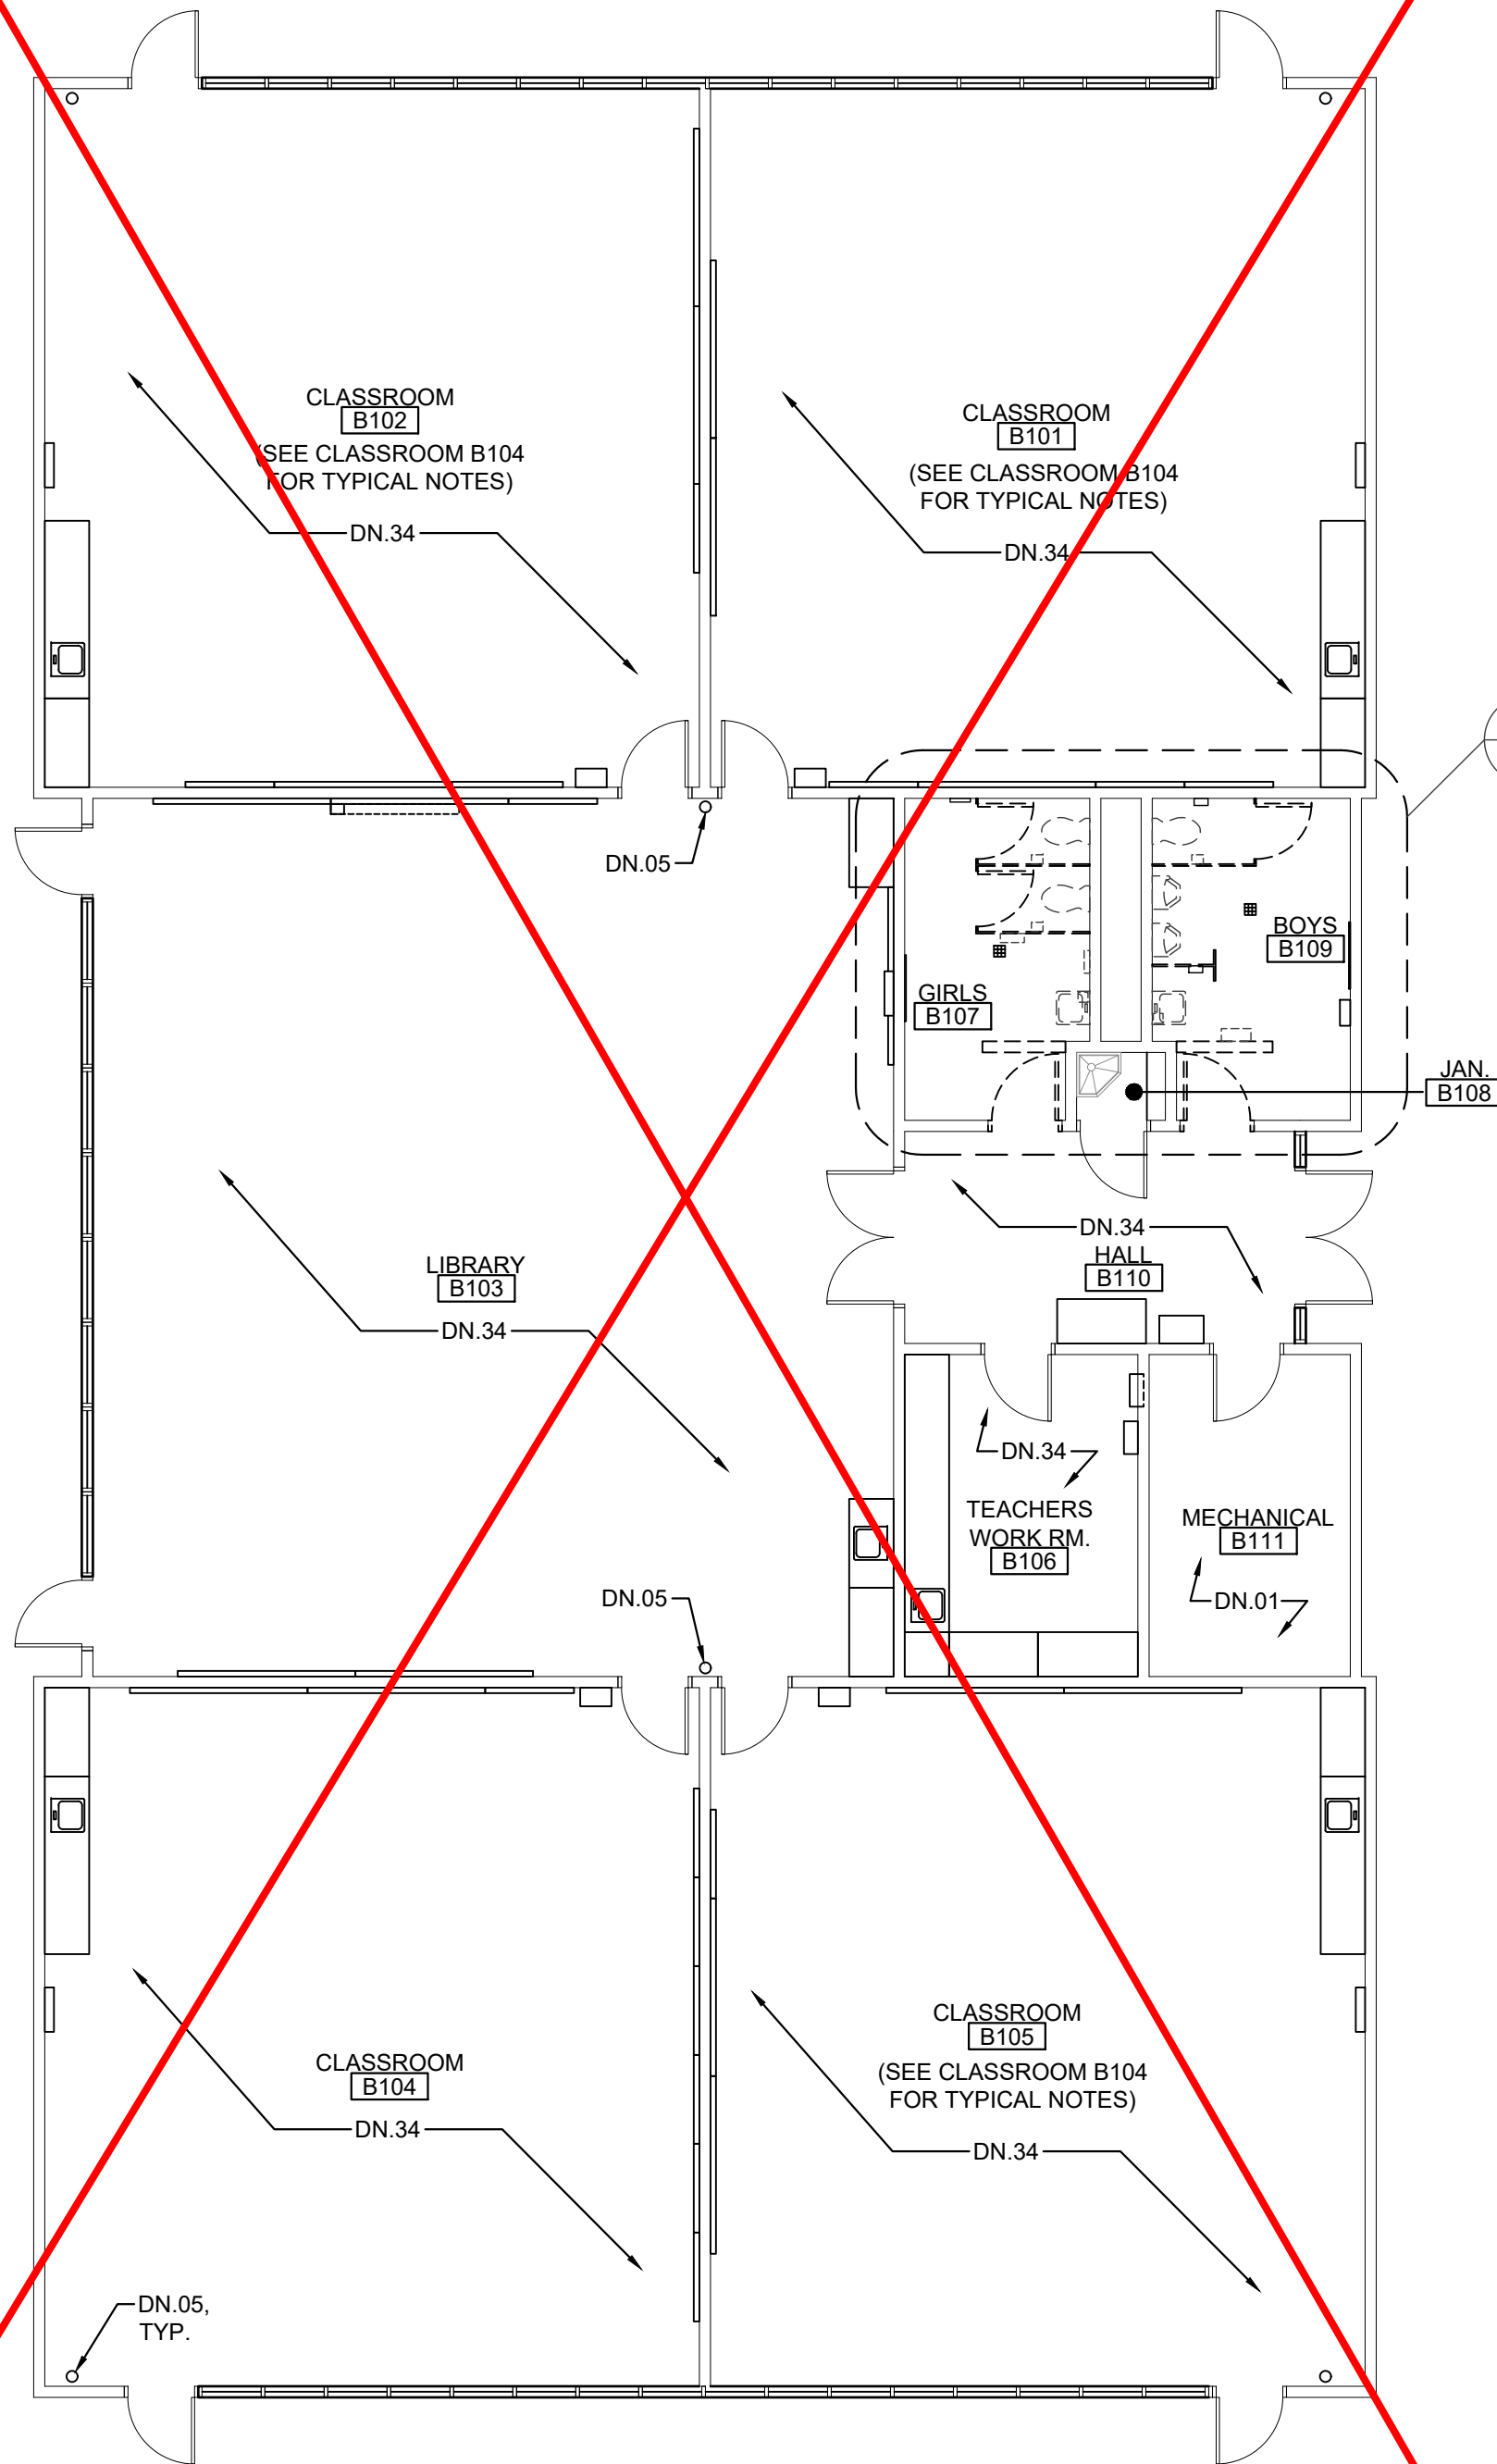



DEMOLITION FLOOR PLAN - BUILDING B

SCALE: 1/8" = 1'-0"

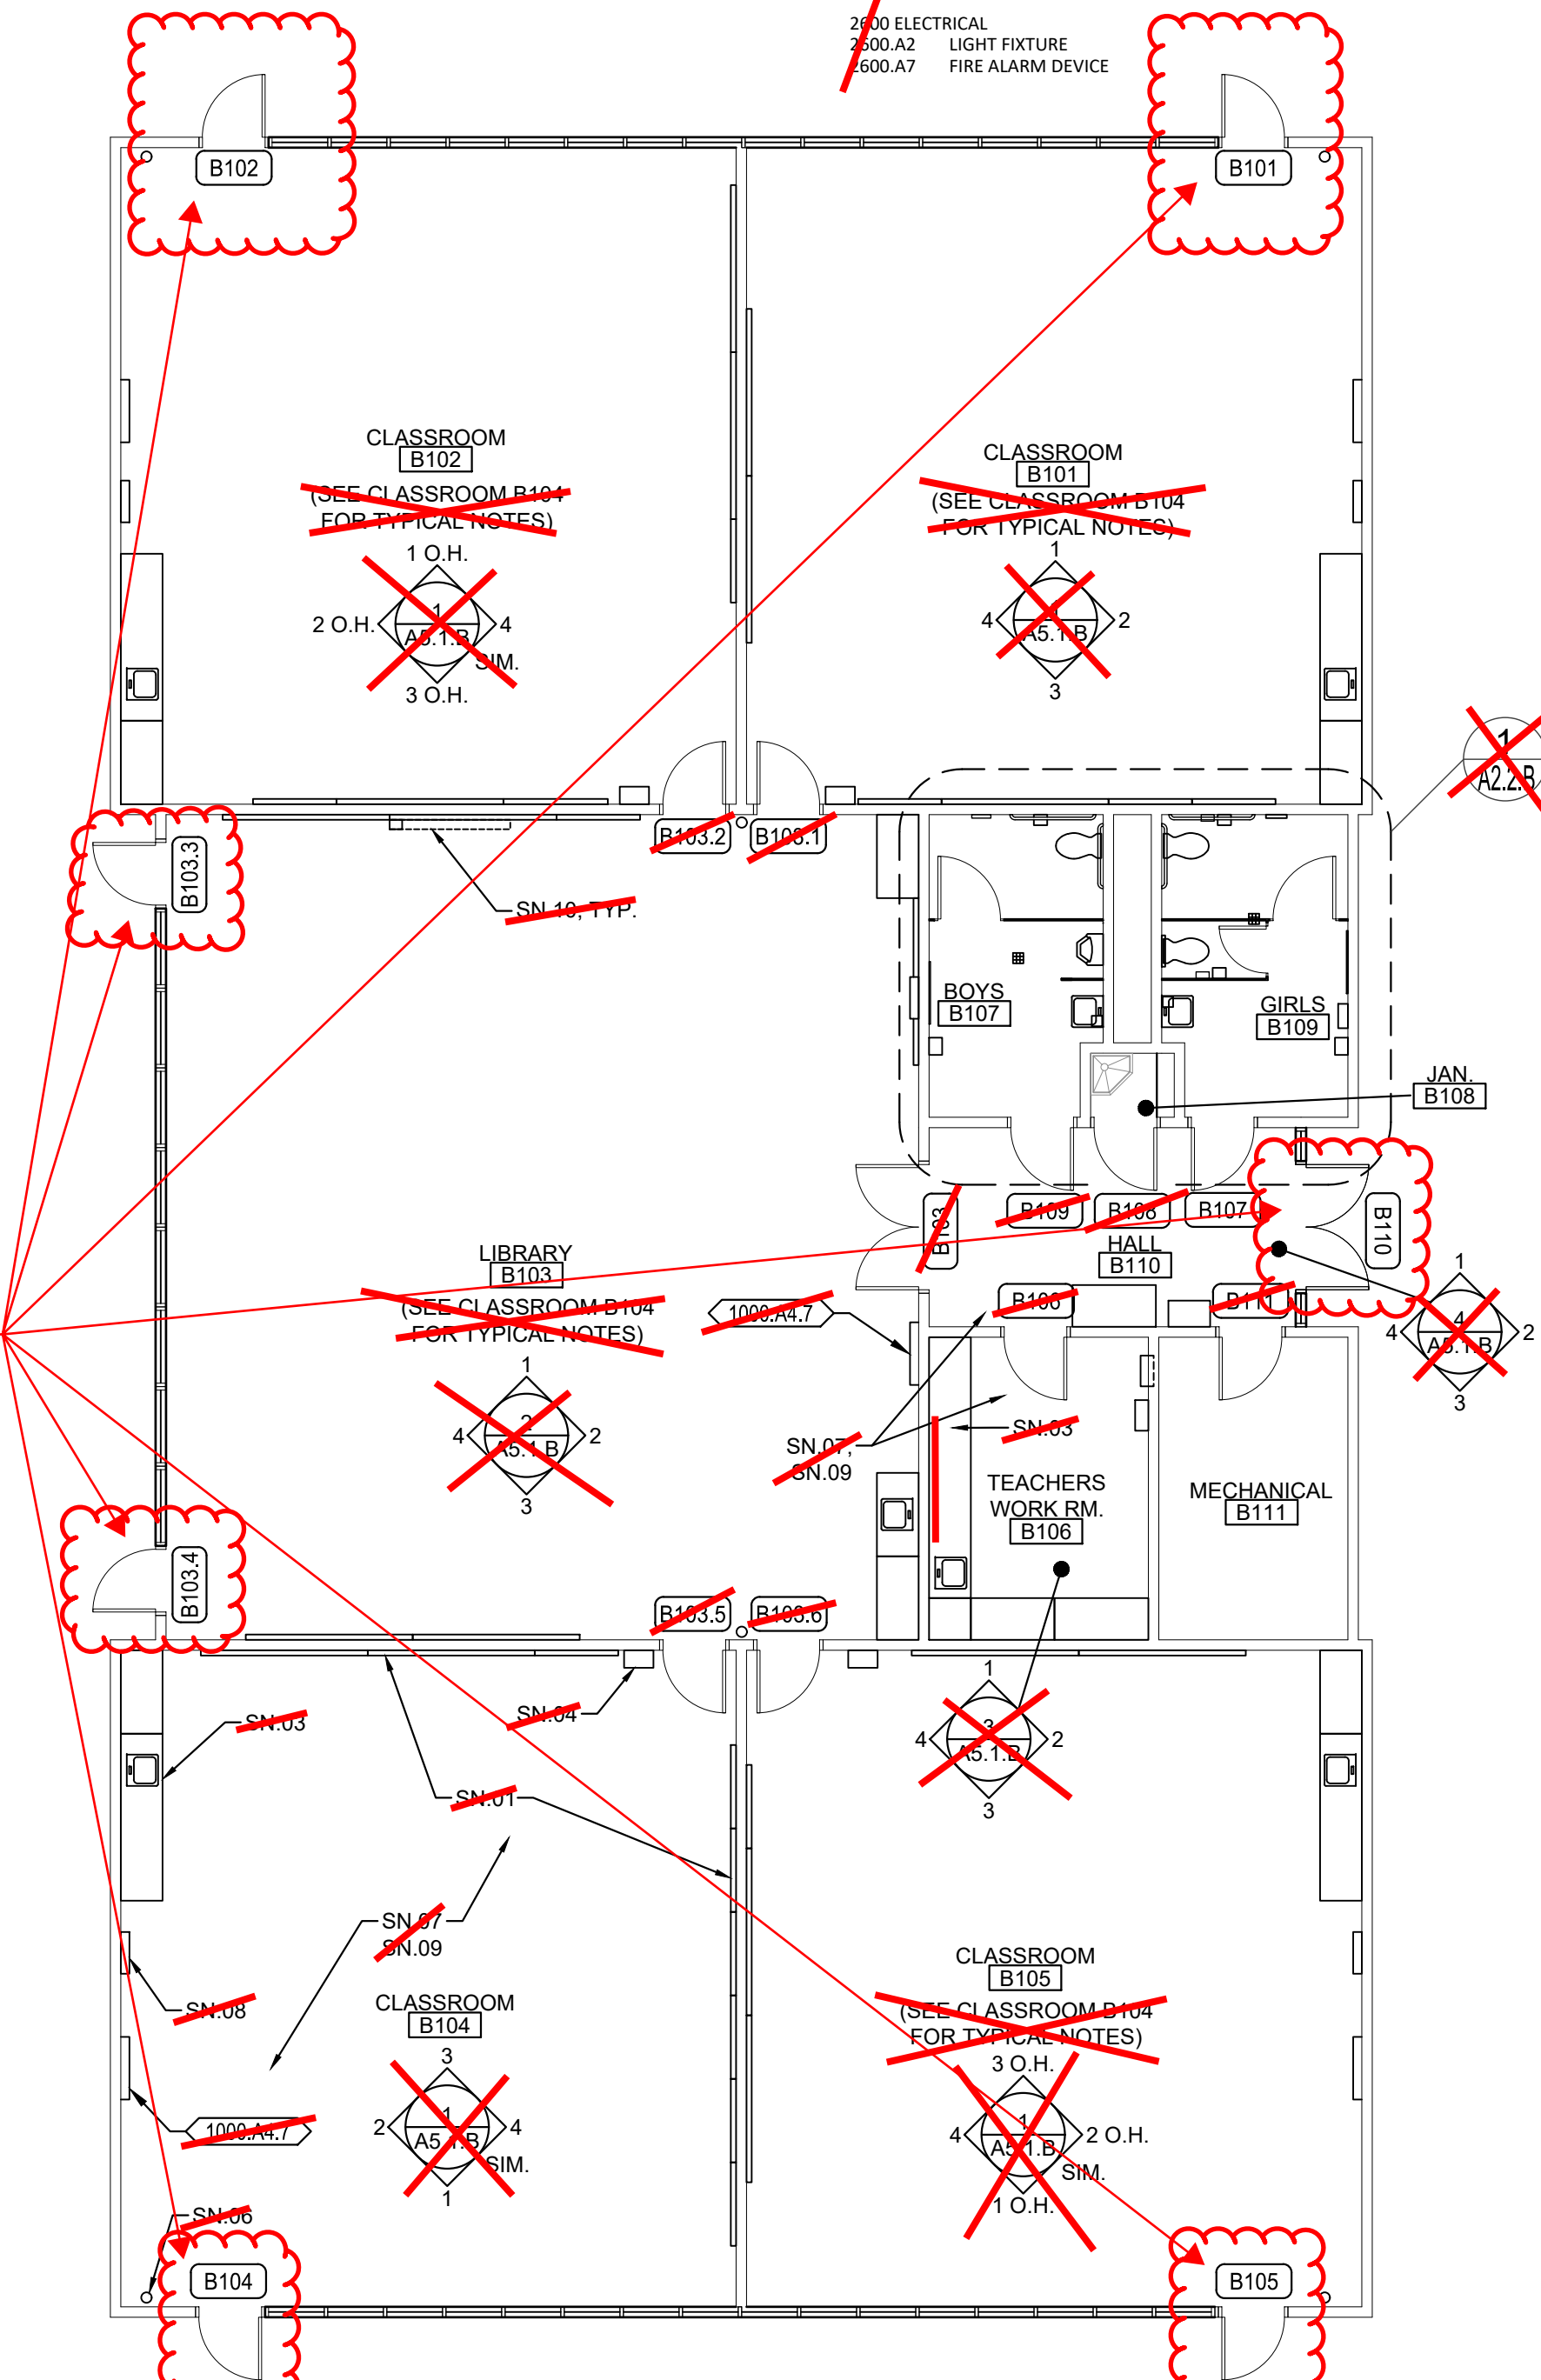


FLOOR PLAN - BUILDING B

SCALE: 1/8" = 1'-0"

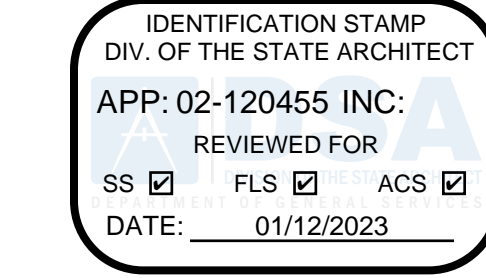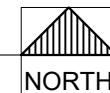

730 Howe Avenue, Suite 450
Sacramento, CA 95825
Phone: 916.921.2112
Fax: 916.921.2212

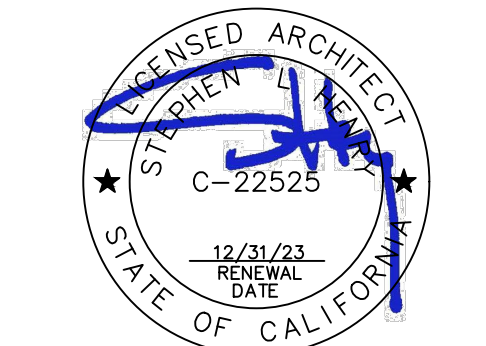


MODERNIZATION LAKEWOOD
ELEMENTARY SCHOOL

DEMOLITION & FLOOR
PLANS - BUILDING B


CONSULTANT

PROJECT NO.	REVISIONS	BY
21-32-052		
DATE		
3/28/2022		
DRAWN		
MS		
CHECKED		
JCBS		
SCALE		
AS SHOWN		
CADFILE		
UPDATED		
11/17/2022		
SHEET NO.		

A2.1.B

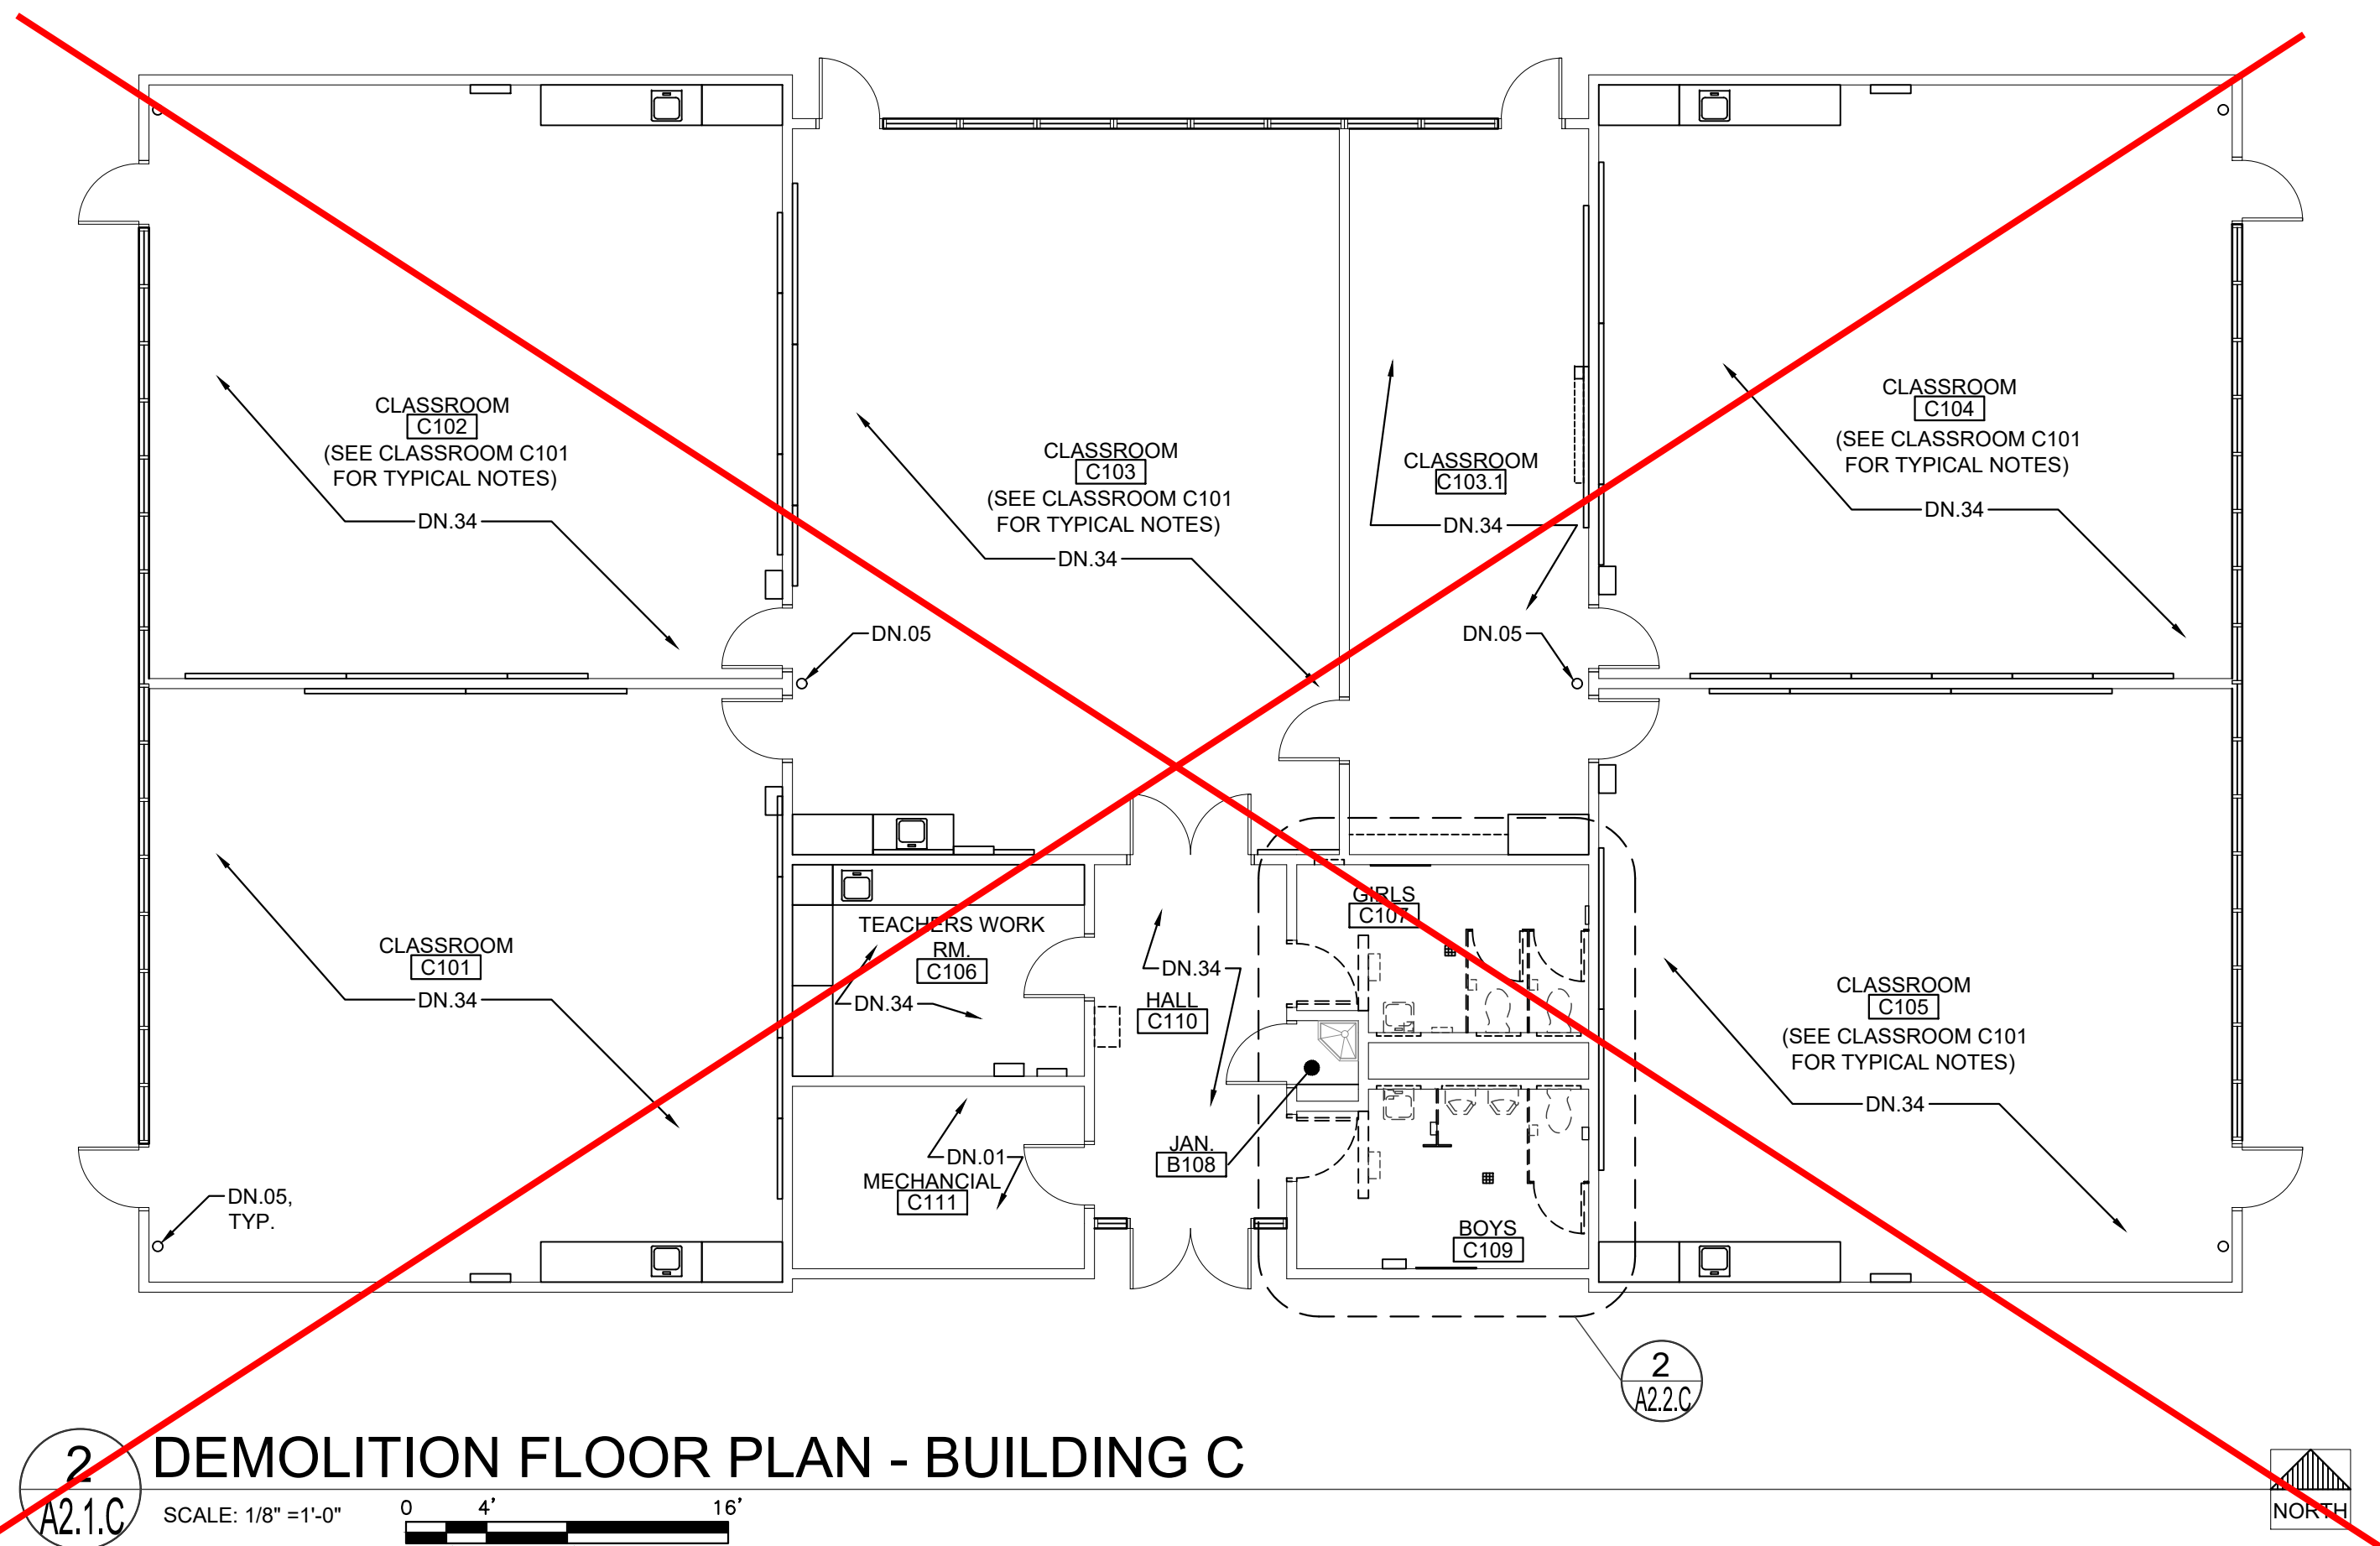

2 DEMOLITION FLOOR PLAN - BUILDING C

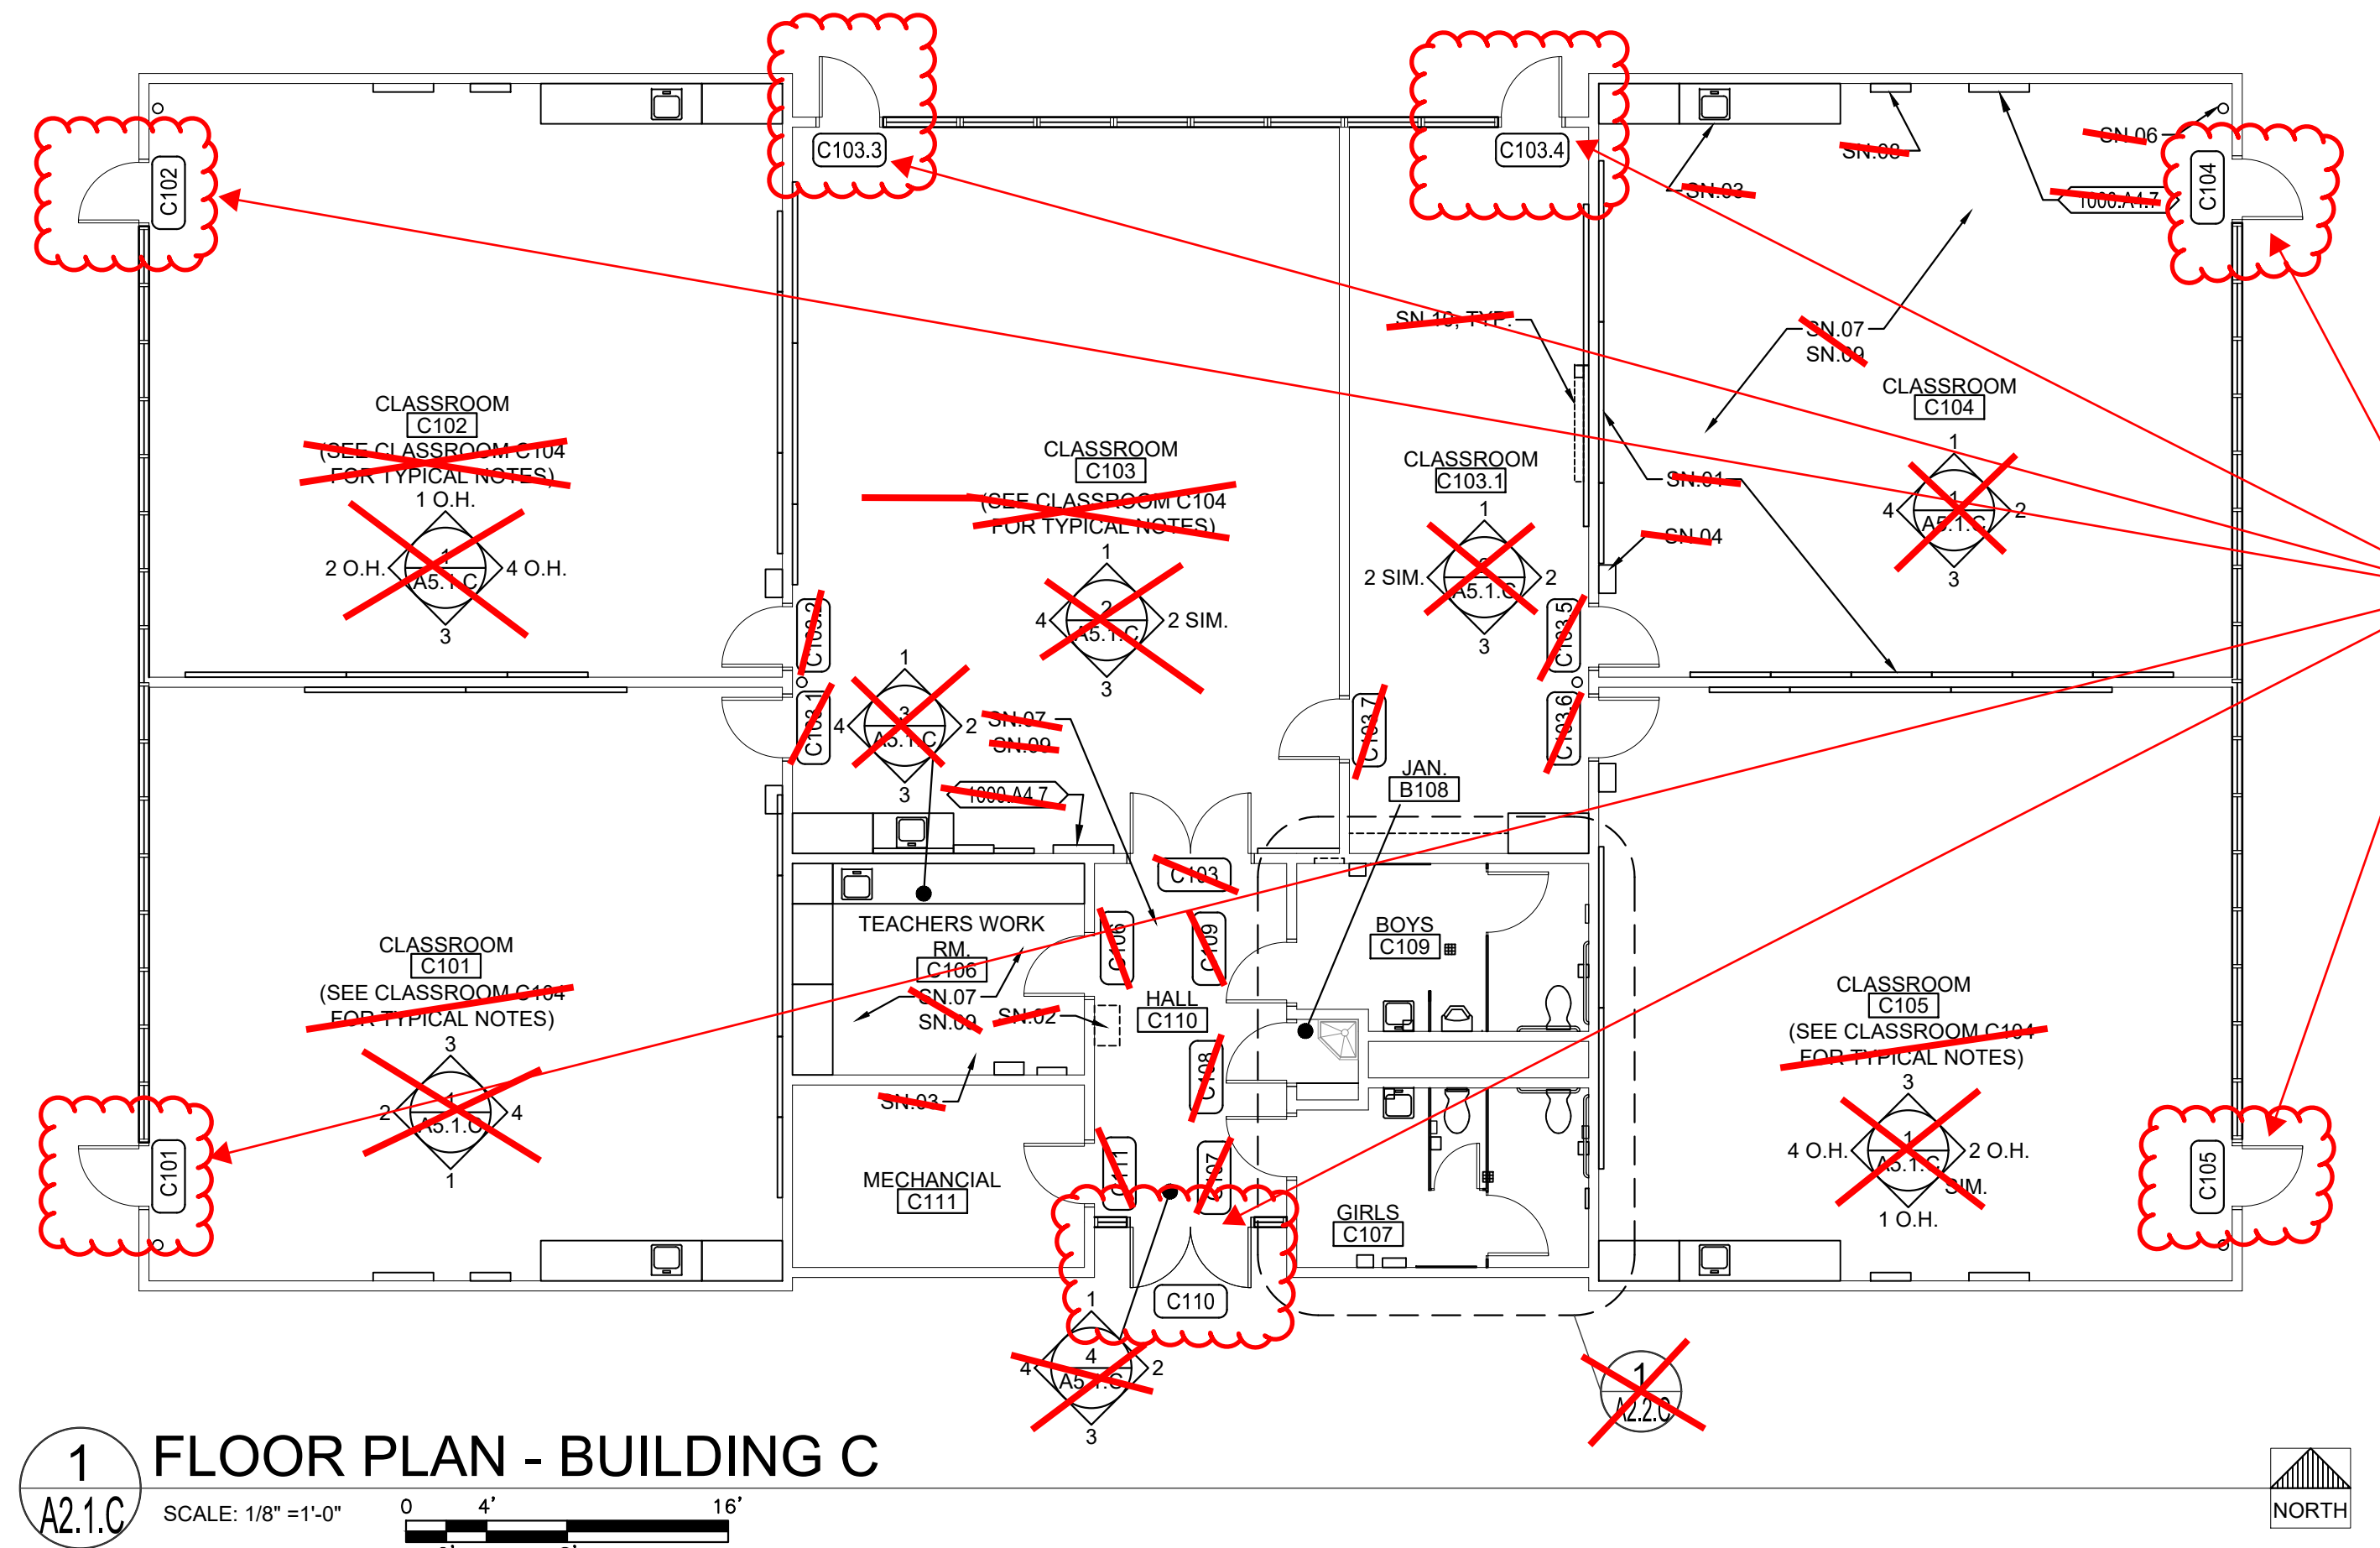

1 FLOOR PLAN - BUILDING C

KEYNOTES

- NOTE: NOT ALL NOTES MAY BE USED
- 0300 CONCRETE**
0300.A1 CONCRETE SLAB ON GRADE
- 0600 WOOD, PLASTICS, COMPOSITES**
0600.D1 PLASTIC LAMINATE CASEWORK
- 0900 FINISHES**
0900.A6 RESINOUS FLOOR COATING W/ 6" INTEGRAL COVED BASE
0900.B5 FIBERGLASS REINFORCED PLASTIC PANELS (FRP)
0900.B7 RESINOUS WALL COATING INSTALLED O/ (E) CERAMIC TILE WAINSCOTING
- 1000 SPECIALTIES**
1000.A4 SIGNS
1. PARKING LOT ENTRANCE SIGN "TOWAWAY"
2. DISABLED ACCESSIBLE PARKING STALL SIGN
3. ROOM IDENTIFICATION SIGN
4. RESTROOM IDENTIFICATION SIGN
5. TACTILE EXIT SIGN
6. SELF-ILLUMINATING EXIT SIGN
7. ASSISTIVE LISTENING DEVICE SIGN
- 1000.A5 TOILET PARTITION
1. TOILET PARTITION PLASTER
- 1000.A6 URINAL PARTITION
- 1000.A7 TOILET ACCESSORIES
1. PAPER TOWEL DISPENSER
2. TOILET PAPER DISPENSER
3. SANITARY NAPKIN DISPENSER
4. SOAP DISPENSER
5. MIRROR
6. SANITARY NAPKIN DISPOSAL RECEPTACLE
7. GRAB BAR
8. SHELF
9. MOP BACK
10. BABY CHANGING STATION
11. TOILET SEAT COVER DISPENSER
12. WASTE RECEPTACLE
13. WASTE RECEPTACLE-FREE STANDING
- 2200 PLUMBING**
2200.A1 PLUMBING EQUIPMENT
1. SINK
2. LAVATORY
3. TOILET
4. URINAL
5. DRINKING FOUNTAIN
6. MOP SINK
7. WATER HEATER
8. ROOF DRAIN/OVERFLOW COMBO UNIT
9. FLOOR DRAIN - SLOPE FLOOR TO DRAIN 2% MAX. SLOPE
10. ROOF/OVERFLOW DRAIN DISCHARGE
11. CONDENSATE DRAIN LINE
12. VENT RISER PIPE
13. BOTTLE FILLER
- 2300 HVAC
2300.A2 CEILING REGISTER - SEE MECHANICAL
2300.A3 MECHANICAL DUCT
- 2600 ELECTRICAL
2600.A2 LIGHT FIXTURE
2600.A7 FIRE ALARM DEVICE

GENERAL NOTES

- THE EXISTING CLASSROOMS ARE NOT IDENTICAL IN REGARD TO QUANTITY OR LOCATION OF VARIOUS WALL OR CEILING MOUNTED ITEMS REQUIRED TO BE REMOVED OR PROTECTED IN PLACE AND MASKED FOR PAINTING. THE DEMOLITION PLANS AND NOTES ARE GENERAL IN NATURE AND REPRESENT THE GENERAL DEMOLITION OR PROTECT-IN-PLACE SCOPE. THE CONTRACTOR IS REQUIRED TO MASK OR PROTECT AND MASK IN PLACE ALL EXISTING DRY MARKER BOARDS, TACKBOARDS, CASEWORK, PROJECTION SCREENS, FIRE EXTINGUISHERS, WINDOW COVERINGS & TRACKS, LIGHT FIXTURES OR ANY OTHER ITEM WHETHER SPECIFICALLY SHOWN OR NOT AND AS REQUIRED FOR INSTALLATION OF NEW FINISHES. SOME ITEMS WILL BE REQUIRED TO BE REMOVED AND TEMPORARILY STORED AND PROTECTED FOR LATER INSTALLATION.
2. NOT ALL OF THE EXISTING INTRUSION ALARM AND DATA NETWORKING/DISTRIBUTION COMPONENTS ARE SHOWN IN THE PLANS. THESE ITEMS ARE TO REMAIN AS INSTALLED AND SHALL BE MASKED USING PLASTIC SHEETING AND ANY OTHER PROTECTION MEASURES NECESSARY DURING CONSTRUCTION OPERATIONS AND PRIOR TO PAINTING. VERIFY WITH OWNER THE EXACT PROTECTION AND MASKING MEASURES AND LIMITATIONS PRIOR TO MASKING.
3. WHERE PLUMBING FIXTURES OR OTHER COMPONENTS ARE REMOVED FROM WALLS, FLOORS OR CEILINGS AND/OR WALLS, FLOORS OR CEILINGS ARE REMOVED TO ALLOW ACCESS TO UTILITIES OR OTHER ITEMS, THE CONTRACTOR IS REQUIRED TO PATCH BACK THE EXISTING FINISH WITH LIKE FINISHES IN PREPARATION FOR INSTALLATION OF NEW FINISH.

DEMOLITION NOTES

- NOTE: NOT ALL NOTES MAY BE USED
- DN.01 THERE ARE NO ITEMS BEING REMOVED IN THIS ROOM EXCEPT AS MAY BE SHOWN HERE OR OTHER PLAN SHEETS. SEE ARCHITECTURAL FLOOR PLAN AND INTERIOR ELEVATIONS FOR WORK SCOPE IMPROVEMENTS
- DN.02 REMOVE (E) DOOR, SIDELIGHT PANEL, TRANSOM GLAZING AND ENTIRE FRAME. PROTECT IN PLACE AND/OR SALVAGE ANY INTRUSION ALARM COMPONENTS FOR FUTURE INSTALLATION AND CONNECTION
- DN.03 REMOVE (E) CASEWORK AND SHELVING
- DN.04 REMOVE (E) DRY MARKER BOARDS & TACKBOARDS
- DN.05 REMOVE (E) FIRE EXTINGUISHER & HANGER. STORE AND PROTECT FOR FUTURE REINSTALLATION
- DN.06 REMOVE (E) LIGHT FIXTURES AT CEILING OR WALLS THROUGHOUT - SEE ELECTRICAL
- DN.07 REMOVE (E) DATA NETWORKING/DISTRIBUTION EQUIPMENT IF NECESSARY TO PERFORM NEW WORK OR PROTECT IN PLACE
- DN.08 REMOVE (E) SOAP & PAPER TOWEL DISPENSER. STORE AND PROTECT FOR FUTURE REINSTALLATION
- DN.09 DIMENSIONS PROVIDED ARE BASED ON (E) DIMENSIONS TAKEN IN THE FIELD. THIS PLUMBING FIXTURE MAY NEED TO MOVE LATERALLY AND/OR UP/DOWN TO ALLOW FOR PROPER DISABLED ACCESSIBLE CLEARANCES PER PER (A)1. COORDINATE EXACT FINAL LOCATION AND REMOVE (E) FINISHES AS REQUIRED TO MODIFY (E) OR INSTALL (N) PLUMBING FIXTURE CARRIER, WASTE LINES, PLUMBING SUPPLY LINES OR VENT PIPES ETC. PATCH BACK FINISHES TO MATCH SURROUNDING FINISHES
- DN.9.1 REMOVE (E) FINISHES AS REQUIRED TO MODIFY (E) OR INSTALL (N) PLUMBING FIXTURE CARRIER, WASTE LINES, PLUMBING SUPPLY LINES OR VENT PIPES ETC. PATCH BACK FINISHES TO MATCH SURROUNDING FINISHES
- DN.10 PREP (E) FLOOR AS REQUIRED TO INSTALL NEW FLOOR FINISH
- DN.11 REMOVE (E) TOILET ROOM ACCESSORY
- DN.12 REMOVE (E) TOILET ROOM ACCESSORIES. STORE & PROTECT FOR FUTURE REINSTALLATION
- DN.13 REMOVE (E) TOILET PARTITION, MOUNTING HARDWARE AND ANY EXPOSED BLOCKING. PATCH BACK EXISTING SURFACE TO MATCH
- DN.14 REMOVE (E) LAVATORY - SEE PLUMBING
- DN.15 REMOVE (E) TOILET - SEE PLUMBING
- DN.16 REMOVE (E) URINAL - SEE PLUMBING
- DN.17 REMOVE (E) MOP SINK - SEE PLUMBING
- DN.18 REMOVE (E) WATER HEATER
- DN.19 REMOVE (E) SINK, FAUCET, COUNTERTOP, LEDGERS & BASE CABINET - SEE PLUMBING. PREP WALL FOR NEW FINISHES
- DN.20 REMOVE (E) TILE, MASS WITE OR FRP WAINSCOTING. PREP WALL FOR (N) FINISHES DN.21 REMOVE (E) MOP HOLDER
- DN.22 REMOVE (E) PARTITION, PATCH (E) FINISHES (FLOOR, WALLS & CEILING) TO MATCH SURROUNDING FINISHES WHERE PARTITION WILL NOT BE REPLACED.
- DN.23 REMOVE (E) DOOR AND HARDWARE. HOLLOW METAL FRAME TO REMAIN. INFILL DOOR OPENING PER DETAILS.
- DN.24 REMOVE (E) DOOR, FRAME AND ANY TRIM. PREP OPENING FOR (N) DOOR, FRAME AND FINISHES.
- DN.25 REMOVE (E) CARPET, SHEET VINYL, VINYL TILE FLOORING, SELF-DOING BASE OR RUBBER BASE. PREP FLOOR FOR NEW FINISH.
- DN.26 REMOVE (E) WALL MOUNTED JANITORIAL DILUTION CONTROL UNIT. STORE AND PROTECT FOR REINSTALLATION
- DN.27 REMOVE (E) SURFACE MOUNTED THERMOSTAT, ELECTRICAL OUTLET, SIGNAL OUTLET AND ANY ASSOCIATED CONDUIT AND CONDUCTOR - SEE ELECTRICAL OR MECHANICAL FOR MORE SPECIFIC MODIFICATIONS OR RELOCATION. PREP SURFACES FOR NEW FINISH
- DN.28 REMOVE (E) SURFACE MOUNTED INTRUSION ALARM, DATA NETWORKING OR OTHER DEVICE AND RELOCATE - SEE ELECTRICAL
- DN.29 REMOVE (E) RETURN AIR REGISTER AND EXTEND (E) DUCT TO NEW PARTITION WALL FACE AND REINSTALL RETURN AIR REGISTER - SEE MECHANICAL
- DN.30 REMOVE/RELOCATE (E) FIRE ALARM CONDUIT, CABLE AND COMPONENTS PER ELECTRICAL. PREP SURFACES FOR NEW FINISH
- DN.31 REMOVE (E) GLAZING TRIM, WALL PANEL & WALL PANEL TRIM AS REQUIRED FOR INSTALLATION OF (N) DOOR THIS LOCATION. PREP SURFACES FOR NEW FINISH
- DN.32 REMOVE (E) WAINSCOTING OR OTHER WALL FINISHES AND PREP WALL SURFACE AS REQUIRED FOR INSTALLATION OF (N) WALL FINISH
- DN.33 REMOVE (E) CONCRETE SLAB AS REQUIRED TO MODIFY OR INSTALL WASTE LINES-PATCH BACK W/ (N) CONCRETE
- DN.34 REMOVE (E) CARPET & WALL BASE THROUGHOUT. SEE HAZARDOUS MATERIALS DOCUMENTATION FOR REMOVAL OF (E) VAT BELOW CARPET.


SHEET NOTES

- (NOTE: NOT ALL NOTES MAY BE USED)
- SN.01 (E) DRY MARKER BOARDS, TACK BOARDS AND MAP RAILS TO REMAIN IN PLACE AND PROTECTED
- SN.02 (E) DATA NETWORKING COMPONENTS TO REMAIN IN PLACE AND PROTECTED
- SN.03 (E) CASEWORK TO REMAIN IN PLACE & PROTECTED
- SN.04 (E) TELEPHONE TO REMAIN IN PLACE AND PROTECTED
- SN.05 (E) FOLDING PARTITION WALL, WOOD TRIM AND BEAM ABOVE TO REMAIN IN PLACE. PREP AND PAINT BOTH SIDES OF WALL AND ALL ITEMS TO MATCH WALLS
- SN.06 (E) FIRE EXTINGUISHER BRACKET TO REMAIN IN PLACE AND PROTECTED. TEMPORARILY REMOVE FIRE EXTINGUISHER AND REPLACE FOLLOWING INSTALLATION OF (N) WALL FINISH.
- SN.07 (E) CARPET TO BE REPLACED WITH (N) LVP FLOORING. OTHER FINISHES TO BE PROTECTED DURING CONSTRUCTION OPERATIONS
- SN.08 (E) CLOCK/SPEAKER TO REMAIN IN PLACE AND PROTECTED
- SN.09 (E) DATA OUTLETS, POWER OUTLETS, LIGHT SWITCHES, ELECTRICAL PANELS, SIGNAGE, HVAC UNITS, ELECTRICAL TRANSFORMERS AND OTHER SIMILAR BUILDING COMPONENTS TO REMAIN IN PLACE AND PROTECTED. PREP AND PAINT TO MATCH WALLS ONLY IF PREVIOUSLY PAINTED.
- SN.10 (E) PROJECTOR & PROJECTION SCREEN TO REMAIN IN PLACE AND PROTECTED. PAINT ANY MOUNTING BOARDS TO MATCH WALL FINISH.
- SN.11 INFILL FRAME IN DOOR OPENING. PROVIDE THERMAL INSULATION AND PROVIDE GYPSUM WALLBOARD FINISH AT INTERIOR TO MATCH. - SEE ELEVATION AND DETAILS.
- SN.12 (E) LIGHT FIXTURES, FIRE ALARM & INTRUSION ALARM COMPONENTS TO REMAIN IN PLACE AND PROTECTED
- SN.13 (E) ACCESS PANELS, HVAC DUCTS AND REGISTERS TO REMAIN IN PLACE AND PROTECTED - PAINT TO MATCH (N) PAINT AT CEILING.
- SN.14 REINSTALL (E) TOILET ACCESSORIES OR JANITOR EQUIPMENT SALVAGED DURING DEMOLITION OPERATIONS
- SN.15 NO NEW WORK THIS SPACE
- SN.16 DISABLED ACCESSIBLE
- SN.17 (E) EXPOSED WIRING, CABLING AND WIREMOLD RACEWAY TO REMAIN IN PLACE. SNAP CLOSED ANY WIREMOLD RACEWAY THAT IS NOT PROPERLY CLAMPED AND INSTALL ADDITIONAL CABLE FASTENERS AS NECESSARY FOR POSITIVE ATTACHMENT TO WALL PRIOR TO PREP AND PAINT. THESE ITEMS ARE TO REMAIN IN PLACE AND BE PREP'D AND PAINTED ALONG WITH NEW WALL FINISH.
- SN.18 PREP AND PAINT EXISTING WINDOW FRAMES, DOOR FRAMES AND DOOR. DO NOT PAINT THE BUILDING EXTERIOR SIDE.
- SN.19 PREP AND PAINT EXISTING WALLS, HVAC REGISTERS AND CEILING SURFACES. PATCH BACK ANY DAMAGED VINYL WALL COVERING WITH (N) TO MATCH OR CEILING OR WALL SURFACES DAMAGED DUE TO ITEMS REMOVED DURING DEMOLITION TO MATCH (E) PRIOR TO INSTALLATION OF (N) PAINTING OR FINISHES
- SN.20 PREP AND PAINT (E) EXPOSED BEAMS AND WOOD TRIM AT HEAD OF WALL
- SN.21 COORDINATE INSTALLATION OF (N) TOILET OR URINAL PARTITION. PROVIDE ALL NECESSARY BLOCKING IN WALLS AND CEILINGS FOR CONNECTION POINTS. REPLACE AND REPAIR WALL AND CEILING FINISHES TO MATCH SURROUNDING FINISHES.
- SN.22 (E) PLUMBING FIXTURE TO REMAIN IN PLACE. NO NEW WORK.
- SN.23 (N) 2X6 WOOD STUD PARTITION WITH WATER RESISTANT GYPSUM WALLBOARD EA. SIDE. FINISH TO MATCH EXISTING WALL FINISHES. PROVIDE ACOUSTICAL INSULATION PER SPECIFICATION.
- SN.24 (E) ACCESS PANELS TO REMAIN. PROTECT AND PAINT TO MATCH WALLS. CUT (N) FRP WAINSCOTING AROUND ACCESS PANEL.
- SN.25 PREP AND PAINT (E) WOOD SHELVING
- SN.26 REMOVE (E) CEILING TILES THAT ARE COMING LOOSE AND REINSTALL WITH NEW ADHESIVE PRIOR TO PAINTING.

IDENTIFICATION STAMP
DIV. OF THE STATE ARCHITECT
APP: 02-120455 INC:
REVIEWED FOR
SS ☒ FLS ☒ ACS ☒
DATE: 01/12/2023

730 Howe Avenue, Suite 450
Sacramento, CA 95825
Phone: 916.921.2112
Fax: 916.921.2212

HENRY+
ASSOCIATES
ARCHITECTS

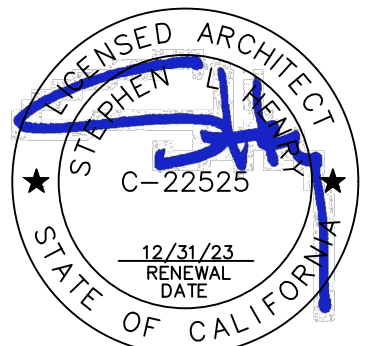

MODERNIZATION LAKEWOOD
ELEMENTARY SCHOOL

DEMOLITION & FLOOR
PLANS - BUILDING C

CONSULTANT

PROJECT NO.	REVISIONS	BY
21-32-052		
DATE		
3/28/2022		
DRAWN		
MS		
CHECKED		
JCBS		
SCALE		
1/4"=1'-0"		
CADFILE		
UPDATED		
11/17/2022		
SHEET NO.		

A2.1.C


1
A2.2.D

FLOOR PLAN - BUILDING D

SCALE: 1/8" = 1'-0"



NOTE:
CLASSROOM D108, D109, D115 & D116
ARE THE ONLY SPACES WITHIN BLDG. D
THAT WILL BE PAINTED & WILL RECEIVE
NEW FLOORING. SEE DOOR SCHEDULE
FOR NEW WORK SCOPE AT EXTERIOR
DOORS.

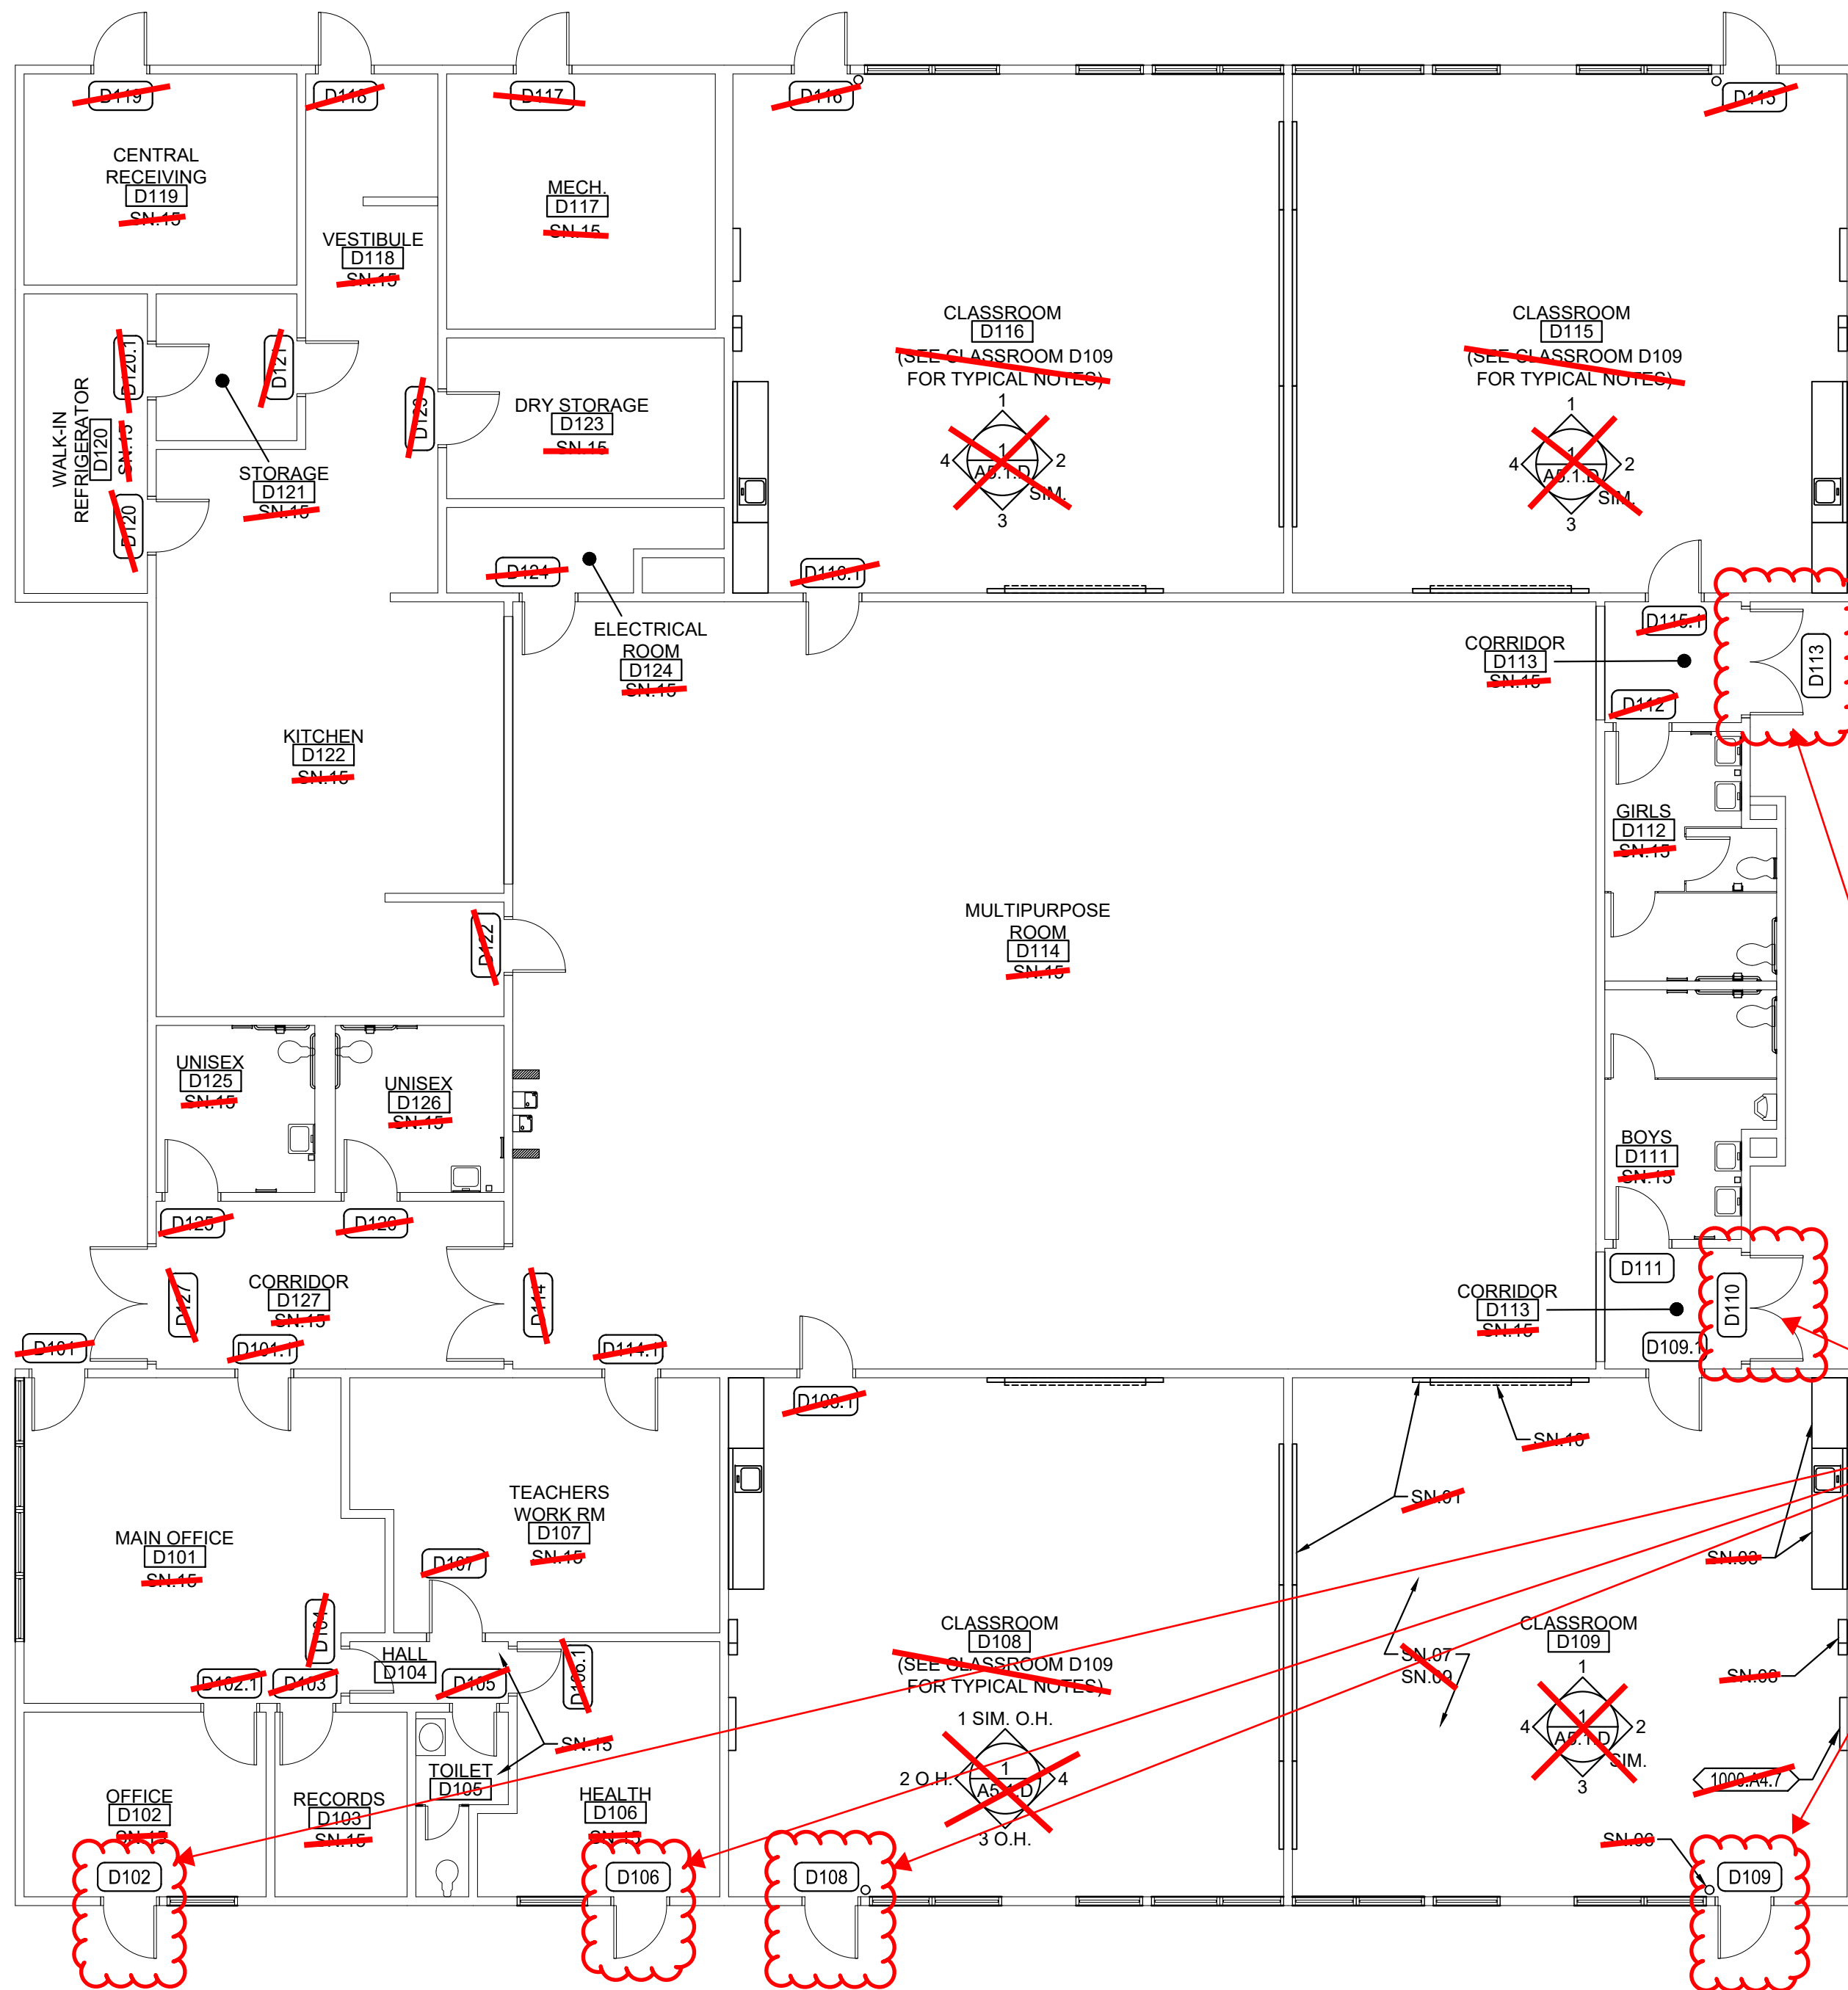

SEE DOOR
SCHEDULE FOR
DOORS REQUIRING
MODIFICATIONS DUE
TO NEW CONCRETE
WALKWAY POURED
ADJACENT TO THE
DOOR

KEYNOTES

NOTE: NOT ALL NOTES MAY BE USED

0300 CONCRETE

0300.A1 CONCRETE SLAB ON GRADE

0500 WOOD, PLASTICS, COMPOSITES

0500.D1 PLASTIC LAMINATE CASEWORK

0900 FINISHES

0900.A6 RESINOUS FLOOR COATING W/ 6" INTEGRAL COVED BASE

0900.B5 FIBERGLASS REINFORCED PLASTIC PANELS (FRP)

0900.B7 RESINOUS WALL COATING INSTALLED O/ (E) CERAMIC TILE WAINSCOTING

1000 SPECIALTIES

1000.A4 SIGNS

1. PARKING LOT ENTRANCE SIGN "TOWAWAY"
2. DISABLED ACCESSIBLE PARKING STALL SIGN
3. ROOM IDENTIFICATION SIGN
4. RESTROOM IDENTIFICATION SIGN
5. TACTILE EXIT SIGN
6. SELF-ILLUMINATING EXIT SIGN
7. ASSISTIVE LISTENING DEVICE SIGN

1000.A5 TOILET PARTITION

1. TOILET PARTITION PILASTER

1000.A6 URINAL PARTITION

1000.A7 TOILET ACCESSORIES

1. PAPER TOWEL DISPENSER
2. TOILET PAPER DISPENSER
3. SANITARY NAPKIN DISPENSER
4. SOAP DISPENSER
5. MIRROR
6. SANITARY NAPKIN DISPOSAL RECEPTACLE
7. GRAB BAR
8. SHELF
9. MOP JACK
10. BABY CHANGING STATION
11. TOILET SEAT COVER DISPENSER
12. WASTE RECEPTACLE
13. WASTE RECEPTACLE-FREE STANDING

2200 PLUMBING

2200.A1 PLUMBING EQUIPMENT

1. SINK
2. LAVATORY
3. TOILET
4. URINAL
5. DRINKING FOUNTAIN
6. MOP SINK
7. WATER HEATER
8. ROOF DRAIN/OVERFLOW COMBO UNIT
9. FLOOR DRAIN - SLOPE FLOOR TO DRAIN 2% MAX. SLOPE
10. ROOF/OVERFLOW DRAIN DISCHARGE
11. CONDENSATE DRAIN LINE
12. VENT RISER PIPE
13. BOTTLE FILLER

2300 HVAC

2300.A2 CEILING REGISTER - SEE MECHANICAL

2300.A3 MECHANICAL DUCT

2600 ELECTRICAL

2600.A2 LIGHT FIXTURE

2600.A7 FIRE ALARM DEVICE

GENERAL NOTES

1. THE EXISTING CLASSROOMS ARE NOT IDENTICAL IN REGARD TO QUANTITY OR LOCATION OF VARIOUS WALL OR CEILING MOUNTED ITEMS REQUIRED TO BE REMOVED OR PROTECTED IN PLACE AND MASKED FOR PAINTING. THE DEMOLITION PLANS AND NOTES ARE GENERAL IN NATURE AND REPRESENT THE GENERAL DEMOLITION OR PROTECT-IN-PLACE SCOPE. THE CONTRACTOR IS REQUIRED TO MOVE OR PROTECT/MASK IN PLACE ALL EXISTING DRY MARKER BOARDS, TACKBOARDS, CASEWORK, PROJECTION SCREENS, FIRE EXTINGUISHERS, WINDOW COVERINGS & TRACKS, LIGHT FIXTURES OR ANY OTHER ITEM WHETHER SPECIFICALLY SHOWN ON LOT AND AS REQUIRED FOR INSTALLATION OF NEW FINISHES. SOME ITEMS WILL BE REQUIRED TO BE REMOVED AND TEMPORARILY STORED AND PROTECTED FOR LATER INSTALLATION.
2. NOT ALL OF THE EXISTING INTRUSION ALARM AND DATA NETWORKING/DISTRIBUTION COMPONENTS ARE SHOWN IN THE PLANS. THESE ITEMS ARE TO REMAIN AS INSTALLED AND SHALL BE MASKED USING PLASTIC SHEETING AND ANY OTHER PROTECTION MEASURES NECESSARY DURING CONSTRUCTION OPERATIONS AND PRIOR TO PAINTING. VERIFY WITH OWNER THE EXACT PROTECTION AND MASKING MEASURES AND LIMITATIONS PRIOR TO MASKING.
3. WHERE PLUMBING FIXTURES OR OTHER COMPONENTS ARE REMOVED FROM WALLS, FLOORS OR CEILINGS AND/OR WALLS, FLOORS OR CEILINGS ARE REMOVED TO ALLOW ACCESS TO UTILITIES OR OTHER ITEMS, THE CONTRACTOR IS REQUIRED TO PATCH BACK THE EXISTING FINISH WITH LIKE FINISHES IN PREPARATION FOR INSTALLATION OF NEW FINISH.

DEMOLITION NOTES

NOTE: NOT ALL NOTES MAY BE USED

- DN.01 THERE ARE NO ITEMS BEING REMOVED IN THIS ROOM EXCEPT AS MAY BE SHOWN HERE OR OTHER PLAN SHEETS. SEE ARCHITECTURAL FLOOR PLAN AND INTERIOR ELEVATIONS FOR WORK SCOPE IMPROVEMENTS.
- DN.02 REMOVE (E) DOOR, SIDELIGHT PANEL, TRANSOM GLAZING AND ENTIRE FRAME. PROTECT IN PLACE AND/OR SALVAGE ANY INTRUSION ALARM COMPONENTS FOR FUTURE INSTALLATION AND CONNECTION
- DN.03 REMOVE (E) CASEWORK AND SHELVING
- DN.04 REMOVE (E) DRY MARKER BOARDS & TACKBOARDS
- DN.05 REMOVE (E) FIRE EXTINGUISHER & HANGER. STORE AND PROTECT FOR FUTURE REINSTALLATION
- DN.06 REMOVE (E) LIGHT FIXTURES AT CEILING OR WALLS THROUGHOUT - SEE ELECTRICAL
- DN.07 REMOVE (E) DATA NETWORKING/DISTRIBUTION EQUIPMENT IF NECESSARY TO PERFORM NEW WORK OR PROTECT IN PLACE
- DN.08 REMOVE (E) SOAP & PAPER TOWEL DISPENSER. STORE AND PROTECT FOR FUTURE REINSTALLATION
- DN.09 DIMENSIONS PROVIDED ARE BASED ON (E) DIMENSIONS TAKEN IN THE FIELD. THIS PLUMBING FIXTURE MAY NEED TO MOVE LATERALLY AND/OR UP/DOWN TO ALLOW FOR PROPER DISHOWN ACCESSIBLE CLEARANCES PER SHEET A0.1. CONTRACTOR TO COORDINATE EXACT FINAL LOCATION AND REMOVE (E) FINISHES AS REQUIRED TO MODIFY (E) OR INSTALL (N) PLUMBING FIXTURE CARRIER, WASTE LINES, PLUMBING SUPPLY LINES OR VENT PIPES ETC. PATCH BACK FINISHES TO MATCH SURROUNDING FINISHES TO MATCH SURROUNDING FINISHES.
- DN.9.1 REMOVE (E) FINISHES AS REQUIRED TO MODIFY (E) OR INSTALL (N) PLUMBING FIXTURE CARRIER, WASTE LINES, PLUMBING SUPPLY LINES OR VENT PIPES ETC. PATCH BACK FINISHES TO MATCH SURROUNDING FINISHES.
- DN.10 PREP (E) FLOOR AS REQUIRED TO INSTALL NEW FLOOR FINISH
- DN.11 REMOVE (E) TOILET ROOM ACCESSORY
- DN.12 REMOVE (E) TOILET ROOM ACCESSORIES. STORE & PROTECT FOR FUTURE REINSTALLATION
- DN.13 REMOVE (E) TOILET PARTITION, MOUNTING HARDWARE AND ANY EXPOSED BLOCKING. PATCH BACK EXISTING SURFACE TO MATCH.
- DN.14 REMOVE (E) LAVATORY - SEE PLUMBING
- DN.15 REMOVE (E) TOILET - SEE PLUMBING
- DN.16 REMOVE (E) URINAL - SEE PLUMBING
- DN.17 REMOVE (E) MOP SINK - SEE PLUMBING
- DN.18 REMOVE (E) WATER HEATER
- DN.19 REMOVE (E) SINK, FAUCET, COUNTERTOP, LEDGERS & BASE CABINET - SEE PLUMBING. PREP WALL FOR NEW FINISHES
- DN.20 REMOVE (E) TILE, MASONITE OR FRP WAINSCOTING. PREP WALL FOR (N) FINISHESDN.21REMOVE (E) MOP HOLDER
- DN.22 REMOVE (E) PARTITION. PATCH (E) FINISHES (FLOOR, WALLS & CEILING) TO MATCH SURROUNDING FINISHES WHERE PARTITION WILL NOT BE REPLACED.
- DN.23 REMOVE (E) DOOR AND HARDWARE. HOLLOW METAL FRAME TO REMAIN. INFILL DOOR OPENING PER DETAILS.
- DN.24 REMOVE (E) DOOR, FRAME AND ANY TRIM. PREP OPENING FOR (N) DOOR, FRAME AND FINISHES.
- DN.25 REMOVE (E) CARPET, SHEET VINYL, VINYL TILE FLOORING, SELF-COVING BASE OR RUBBER BASE. PREP FLOOR FOR NEW FINISH.
- DN.26 REMOVE (E) WALL MOUNTED JANITORIAL DILUTION CONTROL UNIT. STORE AND PROTECT FOR REINSTALLATION.
- DN.27 REMOVE (E) SURFACE MOUNTED THERMOSTAT, ELECTRICAL OUTLET, SIGNAL OUTLET AND ANY ASSOCIATED CONDUIT AND CONDUCTOR - SEE ELECTRICAL OR MECHANICAL FOR MORE SPECIFIC MODIFICATIONS OR RELOCATION. PREP SURFACE FOR NEW FINISH.
- DN.28 REMOVE (E) SURFACE MOUNTED INTRUSION ALARM, DATA NETWORKING OR OTHER DEVICE AND RELOCATE - SEE ELECTRICAL
- DN.29 REMOVE (E) RETURN AIR REGISTER AND EXTEND (E) DUCT TO NEW PARTITION WALL FACE AND REINSTALL RETURN AIR REGISTER - SEE MECHANICAL
- DN.30 REMOVE/RELOCATE (E) FIRE ALARM CONDUIT, CABLE AND COMPONENTS PER ELECTRICAL. PREP SURFACES FOR NEW FINISH.
- DN.31 REMOVE(E) GLAZING, GLAZING TRIM, WALL PANEL & WALL PANEL TRIM AS REQUIRED FOR INSTALLATION OF (N) DOOR THIS LOCATION. PREP SURFACES FOR NEW FINISH
- DN.32 REMOVE (E) WAINSCOTING OR OTHER WALL FINISHES AND PREP WALL SURFACE AS REQUIRED FOR INSTALLATION OF (N) WALL FINISH
- DN.33 REMOVE (E) CONCRETE SLAB AS REQUIRED TO MODIFY OR INSTALL WASTE LINES-PATCH BACK W/ (N) CONCRETE
- DN.34 REMOVE (E) CARPET & WALL BASE THROUGHOUT. SEE HAZARDOUS MATERIALS DOCUMENTATION FOR REMOVAL OF (E) VAT BELOW CARPET.

SHEET NOTES


(NOTE: NOT ALL NOTES MAY BE USED)

- SN.01 (E) DRY MARKER BOARDS, TACK BOARDS AND MAP RAILS TO REMAIN IN PLACE AND PROTECTED
- SN.02 (E) DATA NETWORKING COMPONENTS TO REMAIN IN PLACE AND PROTECTED
- SN.03 (E) CASEWORK TO REMAIN IN PLACE & PROTECTED
- SN.04 (E) TELEPHONE TO REMAIN IN PLACE AND PROTECTED
- SN.05 (E) FOLDING PARTITION WALL, WOOD TRIM AND BEAM ABOVE TO REMAIN IN PLACE. PREP AND PAINT BOTH SIDES OF WALL AND ALL ITEMS TO MATCH WALLS
- SN.06 (E) FIRE EXTINGUISHER BRACKET TO REMAIN IN PLACE AND PROTECTED. TEMPORARILY REMOVE FIRE EXTINGUISHER AND REPLACE FOLLOWING INSTALLATION OF (N) WALL FINISH.
- SN.07 (E) CARPET TO BE REPLACED WITH (N) LVP FLOORING. OTHER FINISHES TO BE PROTECTED DURING CONSTRUCTION OPERATIONS
- SN.08 (E) CLOCK/SPEAKER TO REMAIN IN PLACE AND PROTECTED
- SN.09 (E) DATA OUTLETS, POWER OUTLETS, LIGHT SWITCHES, ELECTRICAL PANELS, SIGNAGE, HVAC UNITS, ELECTRICAL TRANSFORMERS AND OTHER SIMILAR BUILDING COMPONENTS TO REMAIN IN PLACE AND PROTECTED. PREP AND PAINT TO MATCH WALLS ONLY IF PREVIOUSLY PAINTED.
- SN.10 (E) PROJECTOR & PROJECTION SCREEN TO REMAIN IN PLACE AND PROTECTED. PAINT ANY MOUNTING BRACKETS TO MATCH WALL FINISH
- SN.11 INFILL FRAME (E) DOOR OPENING. PROVIDE THERMAL INSULATION AND PROVIDE GYPSUM WALLBOARD FINISH AT INTERIOR TO MATCH - SEE ELEVATION AND DETAILS.
- SN.12 (E) LIGHT FIXTURES, FIRE ALARM & INTRUSION ALARM COMPONENTS TO REMAIN IN PLACE AND PROTECTED
- SN.13 (E) ACCESS PANELS, HVAC DUCTS AND REGISTERS TO REMAIN IN PLACE AND PROTECTED - PAINT TO MATCH (N) PAINT AT CEILING.
- SN.14 REINSTALL (E) TOILET ACCESSORIES OR JANITOR EQUIPMENT SALVAGED DURING DEMOLITION OPERATIONS
- SN.15 NO NEW WORK THIS SPACE
- SN.16 DISABLED ACCESSIBLE
- SN.17 (E) EXPOSED WIRING, CABLEING AND WIREMOLD RACEWAY TO REMAIN IN PLACE. SNAP CLOSE ANY OPENLY RACEWAY TO MATCH WALL FINISH. THERE IS NO NEW WORK TO INSTALL ADDITIONAL CABLE FASTENERS AS NECESSARY FOR POSITIVE ATTACHMENT TO WALL. PRIOR TO PREP AND PAINT, THESE ITEMS ARE TO REMAIN IN PLACE AND BE PREP'D AND PAINTED ALONG WITH NEW WALL FINISH.
- SN.18 PREP AND PAINT EXISTING WINDOW FRAMES, DOOR FRAMES AND DOOR DO NOT PAINT THE BUILDING EXTERIOR SIDE.
- SN.19 PREP AND PAINT EXISTING WALLS, HVAC REGISTERS AND CEILING SURFACES. PATCH BACK ANY DAMAGED VINYL WALLCOVERING WITH (N) TO MATCH OR CEILING OR WALL SURFACES DAMAGED DUE TO ITEMS REMOVED DURING DEMOLITION TO MATCH (E) PRIOR TO INSTALLATION OF (N) PAINTING OR FINISHES.
- SN.20 PREP AND PAINT (E) EXPOSED BEAMS AND WOOD TRIM AT HEAD OF WALL
- SN.21 COORDINATE INSTALLATION OF (N) TOILET OR URINAL PARTITION. PROVIDE ALL NECESSARY BLOCKING IN WALLS AND CEILINGS FOR CONNECTION POINTS. REPLACE AND REPAIR WALL AND CEILING FINISHES TO MATCH SURROUNDING FINISHES.
- SN.22 (E) PLUMBING FIXTURE TO REMAIN IN PLACE. NO NEW WORK.
- SN.23 (N) 2X6 WOOD STUD PARTITION WITH WATER RESISTANT GYPSUM WALLBOARD EA. SIDE. FINISH TO MATCH EXISTING WALL FINISHES. PROVIDE ACOUSTICAL INSULATION PER SPECIFICATION.
- SN.24 (E) ACCESS PANELS TO REMAIN. PROTECT AND PAINT TO MATCH WALLS. CUT (N) FRP WAINSCOTING AROUND ACCESS PANEL.
- SN.25 PREP AND PAINT (E) WOOD SHELVING
- SN.26 REMOVE (E) CEILING TILES THAT ARE COMING LOOSE AND REINSTALL WITH NEW ADHESIVE PRIOR TO PAINTING.

IDENTIFICATION STAMP
DIV. OF THE STATE ARCHITECT
APP: 02-120455 INC:
REVIEWED FOR
SS ☒ FLS ☒ ACS ☒
DATE: 01/12/2023

730 Howe Avenue, Suite 450
Sacramento, CA 95825
Phone: 916.921.2112
Fax: 916.921.2212

HENRY+
ASSOCIATES
ARCHITECTS

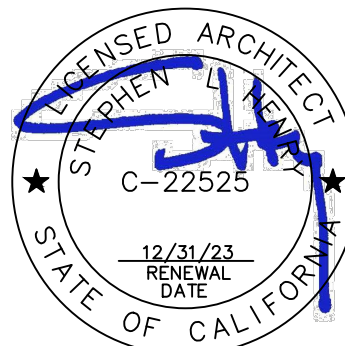

MODERNIZATION LAKEWOOD
ELEMENTARY SCHOOL

FLOOR PLAN - BUILDING D

CONSULTANT

PROJECT NO.	REVISIONS	BY
21-32-052		
DATE		
3/28/2022		
DRAWN		
MS		
CHECKED		
JCBS		
SCALE		
AS SHOWN		
CADFILE		
UPDATED		
11/17/2022		
SHEET NO.		

A2.2.D

KEYNOTES

NOTE: NOT ALL NOTES MAY BE USED

0300 CONCRETE

0300.A1 CONCRETE SLAB ON GRADE

0600 WOOD, PLASTICS, COMPOSITES

0600.D1 PLASTIC LAMINATE CASEWORK

0900 FINISHES

0900.A RESINOUS FLOOR COATING W/ 6" INTEGRAL COVED BASE
0900.B5 FIBERGLASS REINFORCED PLASTIC PANELS (FRP)
0900.B7 RESINOUS WALL COATING INSTALLED O/ (E) CERAMIC TILE WAINSCOTING

1000 SPECIALTIES

1000.A4 SIGNS

1. PARKING LOT ENTRANCE SIGN "TOWAWAY"
2. DISABLED ACCESSIBLE PARKING STALL SIGN
3. ROOM IDENTIFICATION SIGN
4. RESTROOM IDENTIFICATION SIGN
5. TACTILE EXIT SIGN
6. SELF-ILLUMINATING EXIT SIGN
7. ASSISTIVE LISTENING DEVICE SIGN

1000.A5 TOILET PARTITION

1000.A6 URINAL PARTITION

1000.A7 TOILET ACCESSORIES

1. PAPER TOWEL DISPENSER
2. TOILET PAPER DISPENSER
3. SANITARY NAPKIN DISPENSER
4. SOAP DISPENSER
5. MIRROR
6. SANITARY NAPKIN DISPOSAL RECEPTACLE
7. GRAB BAR
8. SHELF
9. MOP RACK
10. BABY CHANGING STATION
11. TOILET SEAT COVER DISPENSER
12. WASTE RECEPTACLE
13. WASTE RECEPTACLE-FREE STANDING

2200 PLUMBING

2200.A1 PLUMBING EQUIPMENT

1. SINK
2. LAVATORY
3. TOILET
4. URINAL
5. DRINKING FOUNTAIN
6. MOP SINK
7. WATER HEATER
8. ROOF DRAIN/OVERFLOW COMBO UNIT
9. FLOOR DRAIN - SLOPE FLOOR TO DRAIN 2% MAX. SLOPE
10. ROOF/OVERFLOW DRAIN DISCHARGE
11. CONDENSATE DRAIN LINE
12. VENT RISER PIPE
13. BOTTLE FILLER

2300.HVAC

2300.A2 CEILING REGISTER - SEE MECHANICAL

2300.A3 MECHANICAL DUCT

2600 ELECTRICAL

2600.A2 LIGHT FIXTURE

2600.A7 FIRE ALARM DEVICE

GENERAL NOTES

1. THE EXISTING CLASSROOMS ARE NOT IDENTICAL IN REGARD TO QUANTITY OR LOCATION OF VARIOUS WALL OR CEILING MOUNTED ITEMS REQUIRED TO BE REMOVED OR PROTECTED IN PLACE AND MASKED FOR PAINTING. THE DEMOLITION PLANS AND NOTES ARE GENERAL IN NATURE AND REPRESENT THE GENERAL DEMOLITION OR PROTECT-IN-PLACE SCOPE. THE CONTRACTOR IS REQUIRED TO REMOVE OR PROTECT AND MASK IN PLACE ALL EXISTING DRY MARKER BOARDS, TACKBOARDS, CASEWORK, PROJECTION SCREENS, FIRE EXTINGUISHERS, WINDOW COVERINGS & TRACKS, LIGHT FIXTURES OR ANY OTHER ITEM WHETHER SPECIFICALLY SHOWN OR NOT AND AS REQUIRED FOR INSTALLATION OF NEW FINISHES. SOME ITEMS WILL BE REQUIRED TO BE REMOVED AND TEMPORARILY STORED AND PROTECTED FOR LATER INSTALLATION.
2. NOT ALL OF THE EXISTING INTRUSION ALARM AND DATA NETWORKING/DISTRIBUTION COMPONENTS ARE SHOWN IN THE PLANS. THESE ITEMS ARE TO REMAIN AS INSTALLED AND SHALL BE MASKED USING PLASTIC SHEETING AND ANY OTHER PROTECTION MEASURES NECESSARY DURING CONSTRUCTION OPERATIONS AND PRIOR TO PAINTING. VERIFY WITH OWNER THE EXACT PROTECTION AND MASKING MEASURES AND LIMITATIONS PRIOR TO MASKING.
3. WHERE PLUMBING FIXTURES OR OTHER COMPONENTS ARE REMOVED FROM WALLS, FLOORS OR CEILINGS AND/OR WALLS, FLOORS OR CEILINGS ARE REMOVED TO ALLOW ACCESS TO UTILITIES OR OTHER ITEMS, THE CONTRACTOR IS REQUIRED TO PATCH BACK THE EXISTING FINISH WITH LIKE FINISHES IN PREPARATION FOR INSTALLATION OF NEW FINISH.

DEMOLITION NOTES

NOTE: NOT ALL NOTES MAY BE USED

- DN.01 THERE ARE NO ITEMS BEING REMOVED IN THIS ROOM EXCEPT AS MAY BE SHOWN HERE OR OTHER PLANS SHEETS. SEE ARCHITECTURAL FLOOR PLAN AND INTERIOR ELEVATIONS FOR WORK SCOPE IMPROVEMENTS
- DN.02 REMOVE (E) DOOR, SIDE/LIGHT PANEL, TRANSOM GLAZING AND ENTIRE FRAME. PROTECT IN PLACE AND/OR SAVAGE ANY INTRUSION ALARM COMPONENTS FOR FUTURE INSTALLATION AND CONNECTION
- DN.03 REMOVE (E) CASEWORK AND SHELVING
- DN.04 REMOVE (E) DRY MARKER BOARDS & TACKBOARDS
- DN.05 REMOVE (E) FIRE EXTINGUISHER & HANGER, STORE AND PROTECT FOR FUTURE REINSTALLATION
- DN.06 REMOVE (E) LIGHT FIXTURES AT CEILING OR WALLS THROUGHOUT - SEE ELECTRICAL
- DN.07 REMOVE (E) DATA NETWORKING/DISTRIBUTION EQUIPMENT IF NECESSARY TO PERFORM NEW WORK OR PROTECT IN PLACE
- DN.08 REMOVE (E) SOAP & PAPER TOWEL DISPENSER, STORE AND PROTECT FOR FUTURE REINSTALLATION
- DN.09 DIMENSIONS PROVIDED ARE BASED ON (E) DIMENSIONS TAKEN IN THE FIELD. THIS PLUMBING FIXTURE MAY NEED TO MOVE LATERALLY AND/OR UP/DOWN TO ALLOW FOR PROPER DISABLED ACCESSIBLE CLEARANCES PER SHEET A2.1, CONDUCTOR TO COORDINATE EXACT FINAL LOCATION AND REMOVE (E) FINISHES AS REQUIRED TO MODIFY (E) OR INSTALL (N) PLUMBING FIXTURE CARRIER, WASTE LINES, PLUMBING SUPPLY LINES OR VENT PIPES ETC. PATCH BACK FINISHES TO MATCH SURROUNDING FINISHES.
- DN.9.1 REMOVE (E) FINISHES AS REQUIRED TO MODIFY (E) OR INSTALL (N) PLUMBING FIXTURE CARRIER, WASTE LINES, PLUMBING SUPPLY LINES OR VENT PIPES ETC. PATCH BACK FINISHES TO MATCH SURROUNDING FINISHES.
- DN.10 PREP (E) FLOOR AS REQUIRED TO INSTALL NEW FLOOR FINISH
- DN.11 REMOVE (E) TOILET ROOM ACCESSORY
- DN.12 REMOVE (E) TOILET ROOM ACCESSORIES, STORE & PROTECT FOR FUTURE REINSTALLATION
- DN.13 REMOVE (E) TOILET PARTITION, MOUNTING HARDWARE AND ANY EXPOSED BLOCKING. PATCH BACK EXISTING SURFACE TO MATCH.
- DN.14 REMOVE (E) LAVATORY - SEE PLUMBING
- DN.15 REMOVE (E) TOILET - SEE PLUMBING
- DN.16 REMOVE (E) URINAL - SEE PLUMBING
- DN.17 REMOVE (E) MOP SINK - SEE PLUMBING
- DN.18 REMOVE (E) WATER HEATER
- DN.19 REMOVE (E) SINK, FAUCET, COUNTERTOP, LEDGERS & BASE CABINET - SEE PLUMBING. PREP WALL FOR NEW FINISHES
- DN.20 REMOVE (E) TILE, MASONITE OR FRP WAINSCOTING. PREP WALL FOR (N) FINISHES DN.21 REMOVE (E) MOP HOLDER
- DN.22 REMOVE (E) PARTITION, PATCH (E) FINISHES (FLOOR, WALLS & CEILING) TO MATCH SURROUNDING FINISHES WHERE PARTITION WILL NOT BE REPLACED.
- DN.23 REMOVE (E) DOOR AND HARDWARE. HOLLOW METAL FRAME TO REMAIN. INFILL DOOR OPENING PER DETAILS.
- DN.24 REMOVE (E) DOOR, FRAME AND ANY TRIM. PREP OPENING FOR (N) DOOR, FRAME AND FINISHES.
- DN.25 REMOVE (E) CARPET, SHEET VINYL, VINYL TILE FLOORING, SELF-COVING BASE OR RUBBER BASE. PREP FLOOR FOR NEW FINISH
- DN.26 REMOVE (E) WALL MOUNTED JANITORIAL DILUTION CONTROL UNIT. STORE AND PROTECT FOR REINSTALLATION.
- DN.27 REMOVE (E) SURFACE MOUNTED THERMOSTAT, ELECTRICAL OUTLET, SIGNAL OUTLET AND ANY ASSOCIATED CONDUIT AND CONDUCTOR. - SEE ELECTRICAL OR MECHANICAL FOR MORE SPECIFIC MODIFICATIONS OR RELOCATION. PREP SURFACES FOR NEW FINISH.
- DN.28 REMOVE (E) SURFACE MOUNTED INTRUSION ALARM, DATA NETWORKING OR OTHER DEVICE AND RELOCATE - SEE ELECTRICAL
- DN.29 REMOVE (E) RETURN AIR REGISTER AND EXTEND (E) DUCT TO NEW PARTITION WALL FACE AND REINSTALL RETURN AIR REGISTER - SEE MECHANICAL
- DN.30 REMOVE/RELOCATE (E) FIRE ALARM CONDUIT, CABLE AND COMPONENTS PER ELECTRICAL. PREP SURFACES FOR NEW FINISH
- DN.31 REMOVE (E) GLAZING, GLAZING TRIM, WALL PANEL & WALL PANEL TRIM AS REQUIRED FOR INSTALLATION OF (N) DOOR THIS LOCATION. PREP SURFACES FOR NEW FINISH
- DN.32 REMOVE (E) WAINSCOTING OR OTHER WALL FINISHES AND PREP WALL SURFACE AS REQUIRED FOR INSTALLATION OF (N) WALL FINISH
- DN.33 REMOVE (E) CONCRETE SLAB AS REQUIRED TO MODIFY OR INSTALL WASTE LINES-PATCH BACK W/ (N) CONCRETE
- DN.34 REMOVE (E) CARPET & WALL BASE THROUGHOUT. SEE HAZARDOUS MATERIALS DOCUMENTATION FOR REMOVAL OF (E) VAT BELOW CARPET.

SHEET NOTES

(NOTE: NOT ALL NOTES MAY BE USED)


- SN.01 (E) DRY MARKER BOARDS, TACK BOARDS AND MAP RAILS TO REMAIN IN PLACE AND PROTECTED
- SN.02 (E) DATA NETWORKING COMPONENTS TO REMAIN IN PLACE AND PROTECTED
- SN.03 (E) CASEWORK TO REMAIN IN PLACE & PROTECTED
- SN.04 (E) TELEPHONE TO REMAIN IN PLACE AND PROTECTED
- SN.05 (E) FOLDING PARTITION WALL, WOOD TRIM AND BEAM ABOVE TO REMAIN IN PLACE. PREP AND PAINT BOTH SIDES OF WALL AND ALL ITEMS TO MATCH WALLS
- SN.06 (E) FIRE EXTINGUISHER BRACKET TO REMAIN IN PLACE AND PROTECTED. TEMPORARILY REMOVE FIRE EXTINGUISHER AND REPLACE FOLLOWING INSTALLATION OF (N) WALL FINISH.
- SN.07 (E) CARPET TO BE REPLACED WITH (N) LVP FLOORING. OTHER FINISHES TO BE PROTECTED DURING CONSTRUCTION OPERATIONS
- SN.08 (E) CLOCK/SPEAKER TO REMAIN IN PLACE AND PROTECTED
- SN.09 (E) DATA OUTLETS, POWER OUTLETS, LIGHT SWITCHES, ELECTRICAL PANELS, SIGNAGE, HVAC UNITS, ELECTRICAL TRANSFORMERS AND OTHER SIMILAR BUILDING COMPONENTS TO REMAIN IN PLACE AND PROTECTED. PREP AND PAINT TO MATCH WALLS ONLY IF PREVIOUSLY PAINTED.
- SN.10 (E) PROJECTOR & PROJECTION SCREEN TO REMAIN IN PLACE AND PROTECTED. PAINT ANY MOUNTING BOARDS TO MATCH WALL FINISH
- SN.11 INFILL FRAME (E) DOOR OPENING. PROVIDE THERMAL INSULATION AND PROVIDE GYPSUM WALLBOARD FINISH AT INTERIOR TO MATCH. - SEE ELEVATION AND DETAILS.
- SN.12 (E) LIGHT FIXTURES, FIRE ALARM & INTRUSION ALARM COMPONENTS TO REMAIN IN PLACE AND PROTECTED
- SN.13 (E) ACCESS PANELS, HVAC DUCTS AND REGISTERS TO REMAIN IN PLACE AND PROTECTED - PAINT TO MATCH (N) PAINT AT CEILING
- SN.14 REINSTALL (E) TOILET ACCESSORIES OR JANITOR EQUIPMENT SALVAGED DURING DEMOLITION OPERATIONS
- SN.15 NO NEW WORK THIS SPACE
- SN.16 DISABLED ACCESSIBLE
- SN.17 (E) EXPOSED WIRING, CABLING AND WIREMOLD RACEWAY TO REMAIN IN PLACE. SNAP CLOSED ANY WIREMOLD RACEWAY THAT IS NOT PROPERLY CLOSED AND INSTALL ADDITIONAL CABLE FASTENERS AS NECESSARY FOR POSITIVE ATTACHMENT TO WALL PRIOR TO PREP AND PAINT. THESE ITEMS ARE TO REMAIN IN PLACE AND BE PREP'D AND PAINTED ALONG WITH NEW WALL FINISH.
- SN.18 PREP AND PAINT EXISTING WINDOW FRAMES, DOOR FRAMES AND DOOR. DO NOT PAINT THE BUILDING EXTERIOR SIDE.
- SN.19 PREP AND PAINT EXISTING WALLS, HVAC REGISTERS AND CEILING SURFACES. PATCH BACK ANY DAMAGED VINYL WALL COVERING WITH (N) TO MATCH OR CEILING OR WALL SURFACES DAMAGED DUE TO ITEMS REMOVED DURING DEMOLITION TO MATCH (E) PRIOR TO INSTALLATION OF (N) PAINTING OR FINISHES.
- SN.20 PREP AND PAINT (E) EXPOSED BEAMS AND WOOD TRIM AT HEAD OF WALL
- SN.21 COORDINATE INSTALLATION OF (N) TOILET OR URINAL PARTITION. PROVIDE ALL NECESSARY BLOCKING IN WALLS AND CEILINGS FOR CONNECTION POINTS. REPLACE AND REPAIR WALL AND CEILING FINISHES TO MATCH SURROUNDING FINISHES.
- SN.22 (E) PLUMBING FIXTURE TO REMAIN IN PLACE. NO NEW WORK.
- SN.23 (N) 2X6 WOOD STUD PARTITION WITH WATER RESISTANT GYPSUM WALLBOARD ON SIDE. FINISH TO MATCH EXISTING WALL FINISHES. PROVIDE ACOUSTICAL INSULATION PER SPECIFICATION.
- SN.24 (E) ACCESS PANELS TO REMAIN, PROTECT AND PAINT TO MATCH WALLS. CUT (N) FRP WAINSCOTING AROUND ACCESS PANEL.
- SN.25 PREP AND PAINT (E) WOOD SHELVING
- SN.26 REMOVE (E) CEILING TILES THAT ARE COMING LOOSE AND REINSTALL WITH NEW ADHESIVE PRIOR TO PAINTING.

SEE DOOR SCHEDULE FOR DOORS REQUIRING MODIFICATIONS DUE TO NEW CONCRETE WALKWAY POURED ADJACENT TO THE DOOR

NOTE: THERE IS NO CONSTRUCTION SCOPE AT BUILDING E EXCEPT FOR THE MODIFICATIONS TO THE 2-EXISTING EXTERIOR DOORS, THAT ARE TO REMAIN, AND AS DESCRIBED IN THE DOOR SCHEDULE


ELEVATION - DOOR INFILL

SCALE: 3/4" = 1'-0"

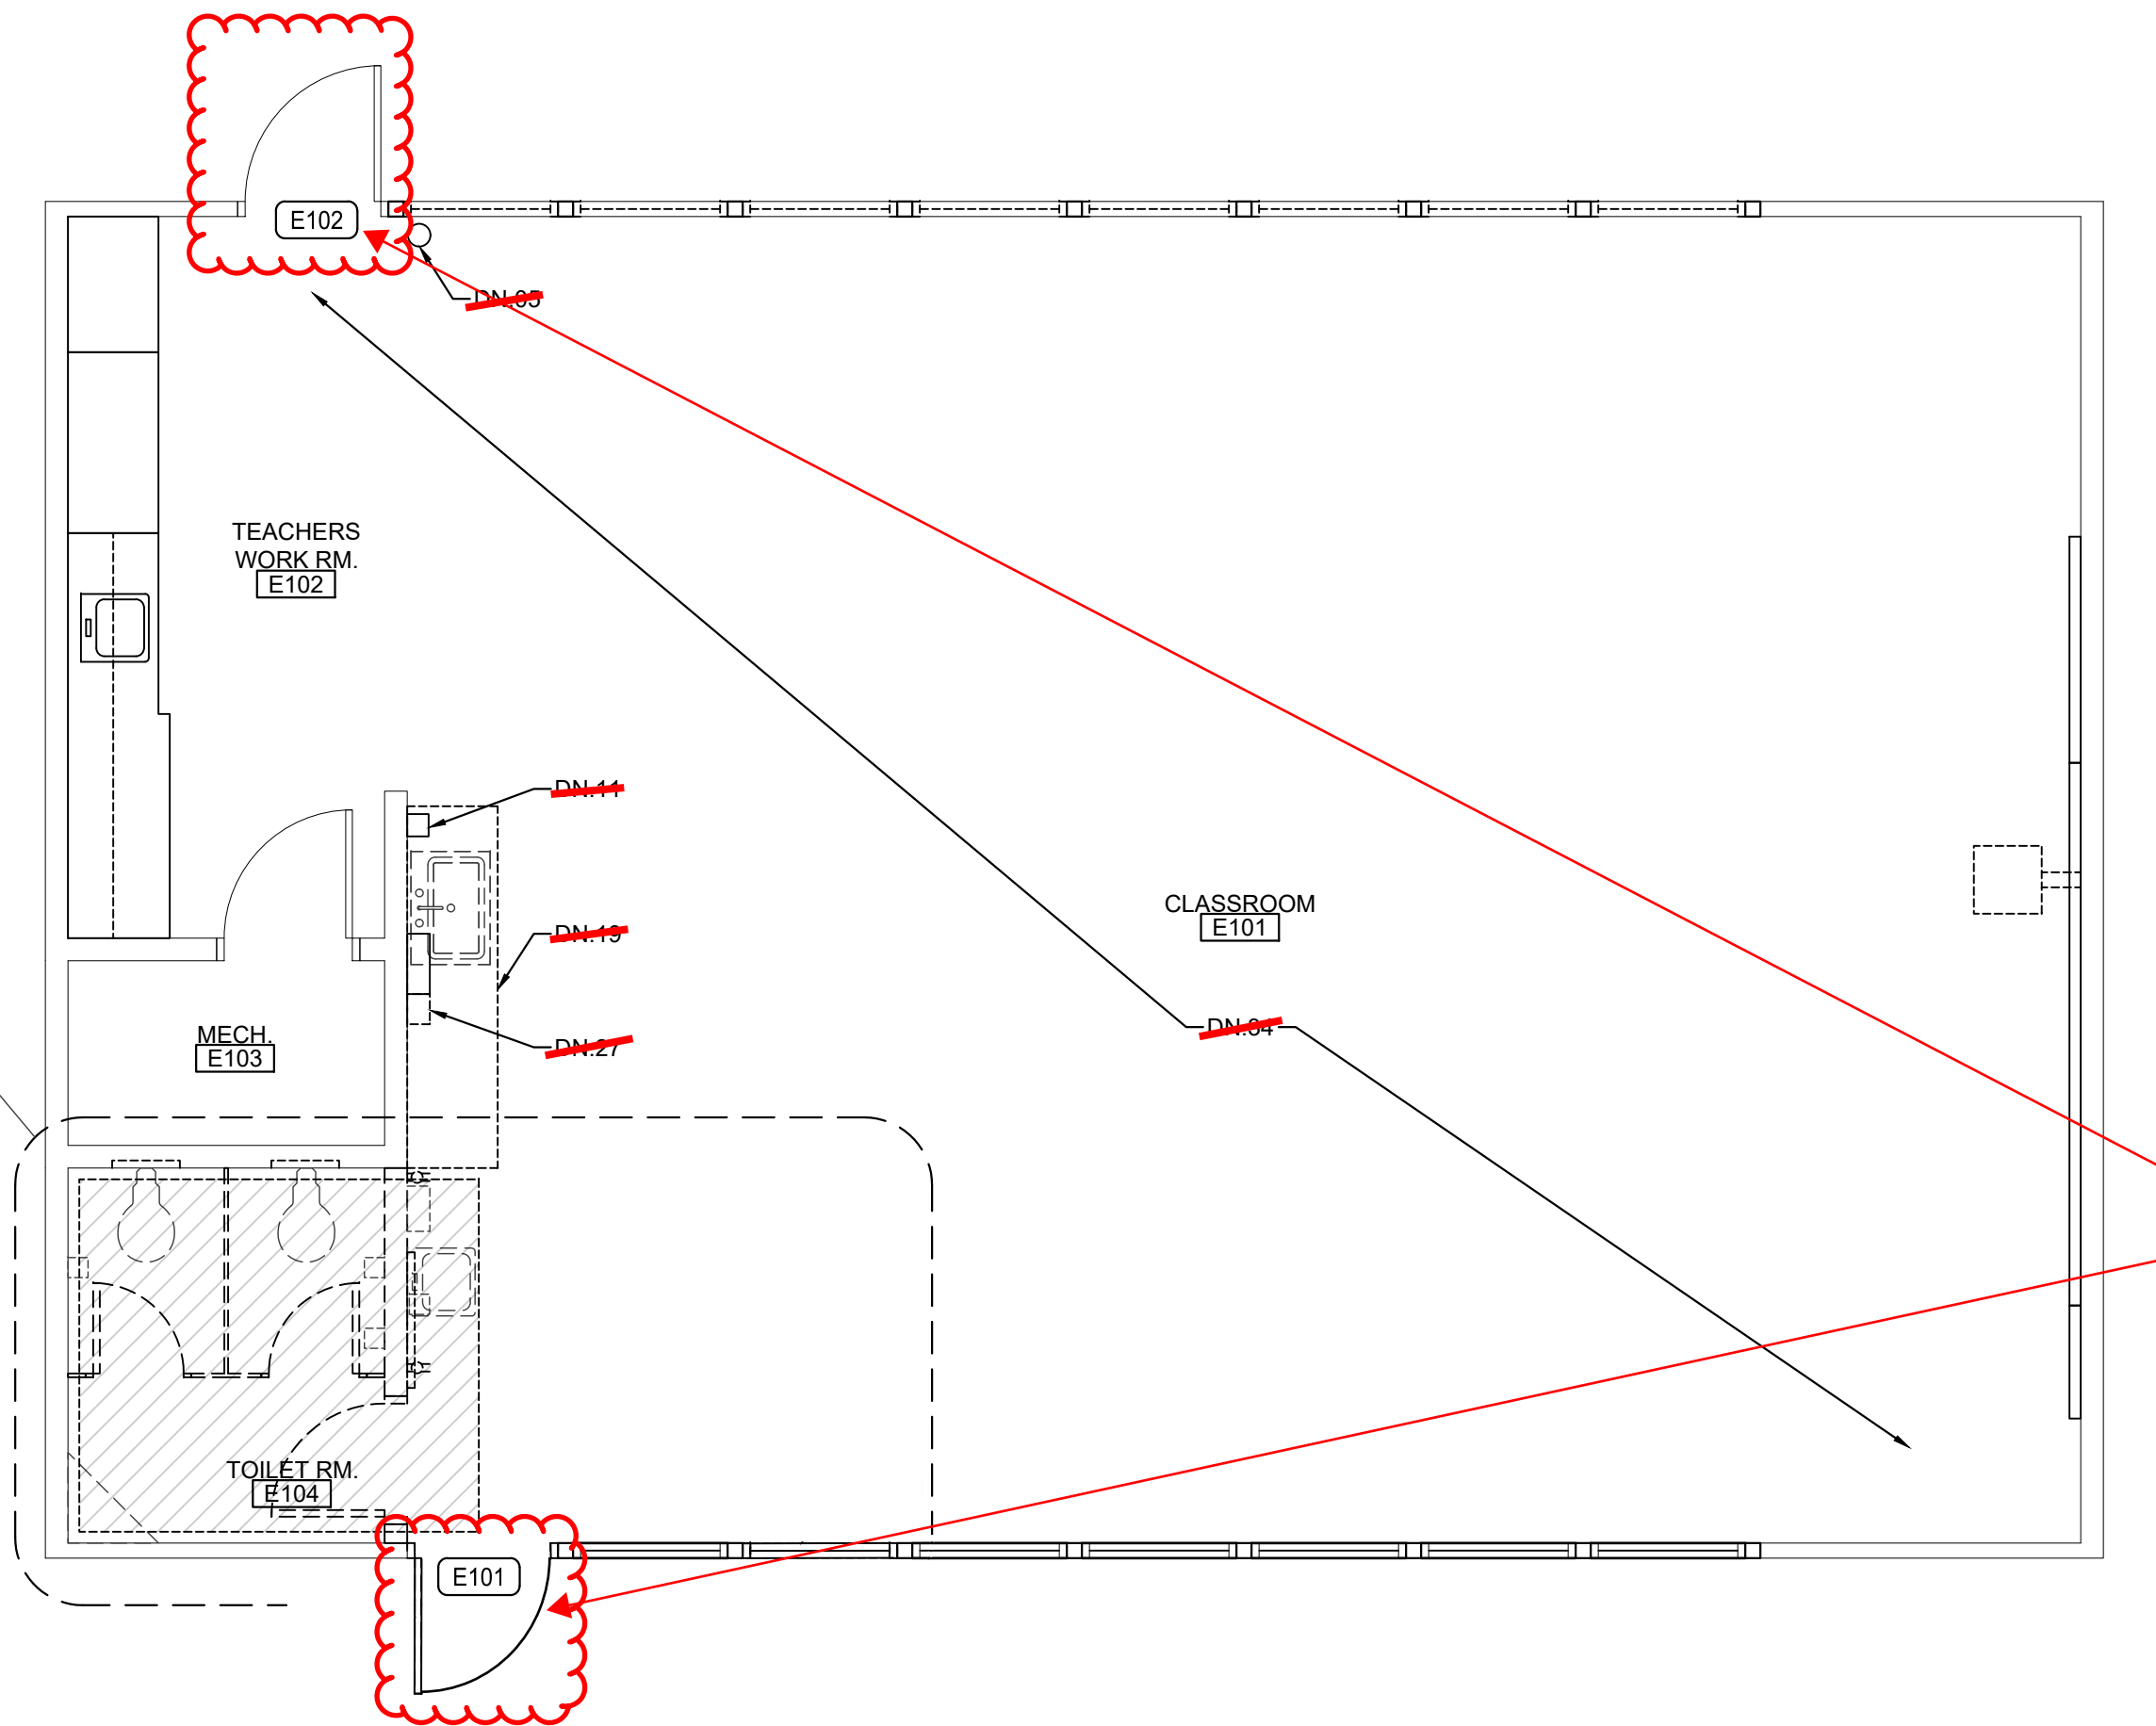

DEMOLITION FLOOR PLAN - BUILDING E

SCALE: 1/4" = 1'-0"

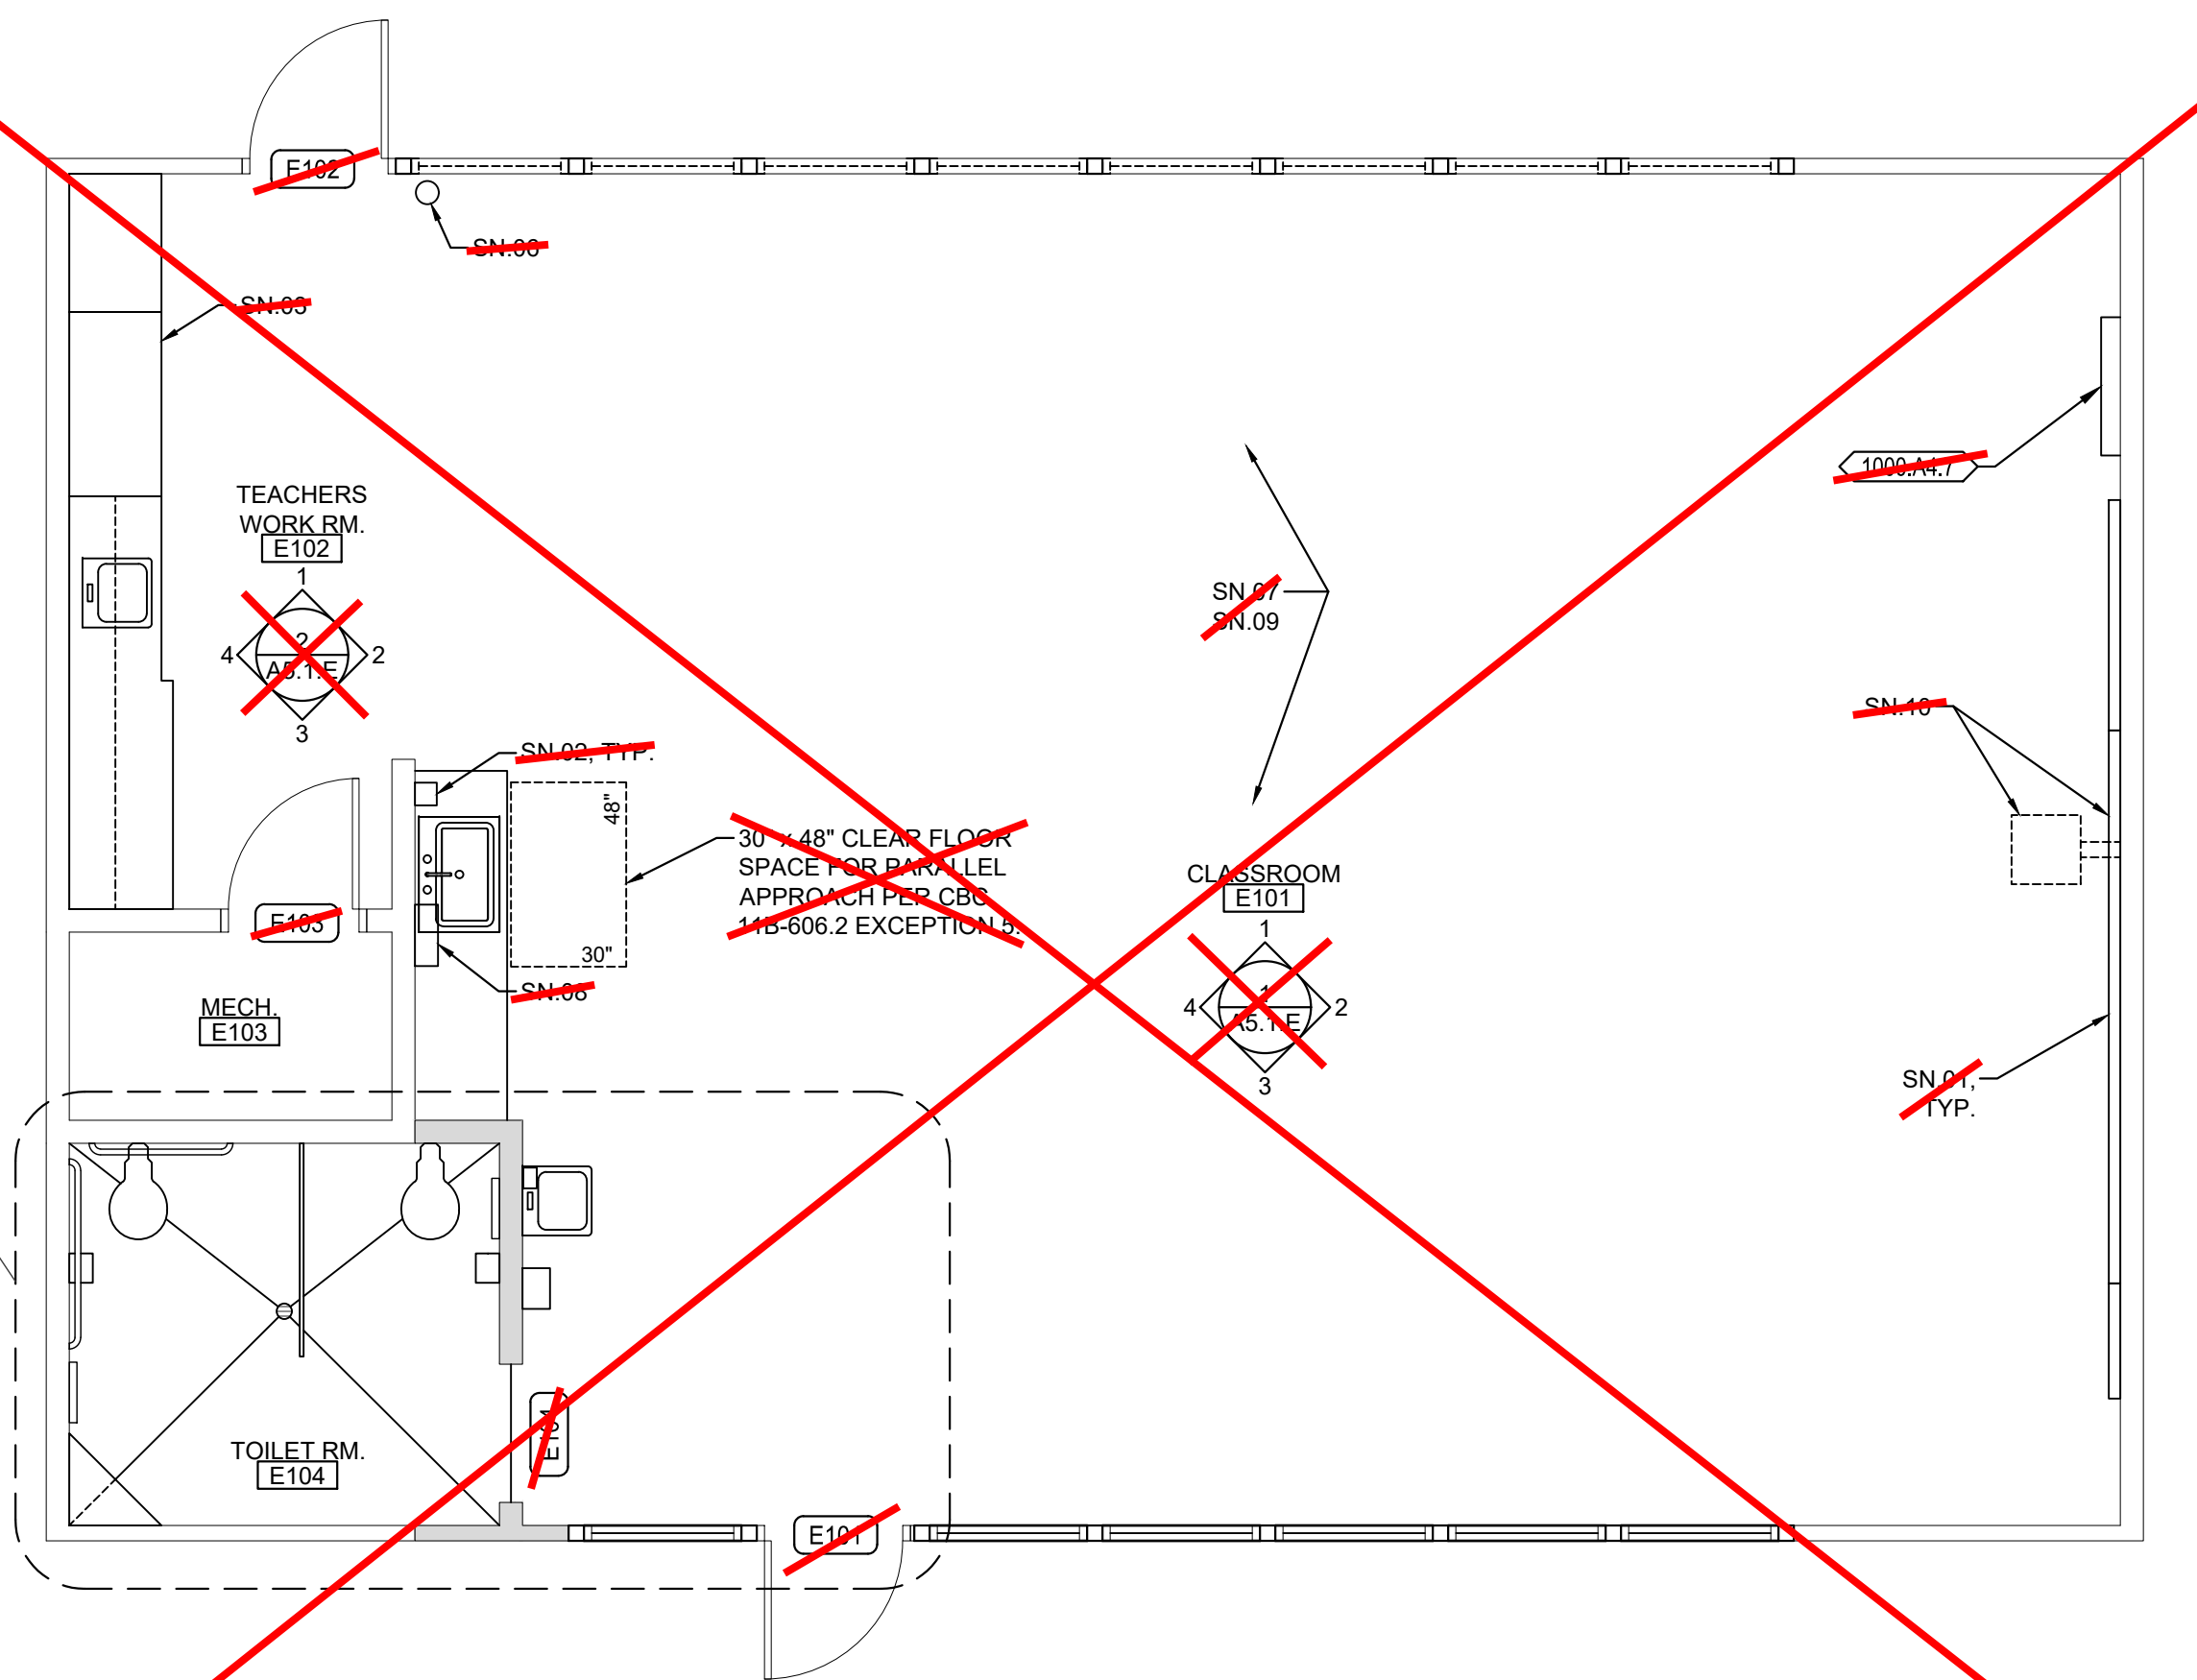

FLOOR PLAN - BUILDING E

SCALE: 1/4" = 1'-0"

QC	
INI	%

MECHANICAL GENERAL NOTES	
1.	ALL WORK SHALL COMPLY WITH ALL APPLICABLE CODES, SPECIFICATIONS, LOCAL ORDINANCES AND INDUSTRY STANDARDS.
2.	VERIFY EXACT LOCATION OF ALL (E) EQUIPMENT, DUCTWORK, DIFFUSERS, REGISTERS AND GRILLES. NOTIFY ARCHITECT IMMEDIATELY OF ANY DISCREPANCIES BETWEEN (E) SYSTEMS AND DRAWINGS.
3.	COORDINATE EXACT LOCATION OF EQUIPMENT AND ALL PENETRATIONS THROUGH ROOF, FLOORS AND WALLS WITH ARCHITECTURAL STRUCTURAL SYSTEMS PRIOR TO COMMENCING WORK.
4.	COORDINATE EXACT SIZE AND ROUTING OF DUCTWORK WITH ARCHITECTURAL PLANS, STRUCTURE AND EQUIPMENT PRIOR TO COMMENCING WORK.
5.	SEE ARCHITECTURAL REFLECTED CEILING PLAN FOR EXACT LOCATION OF ALL CEILING DIFFUSERS, REGISTERS AND GRILLES.
6.	FURNISH AND INSTALL MANUAL AIR DAMPERS AT ALL DUCT BRANCH TAKEOFFS TO A SINGLE SUPPLY DIFFUSER.
7.	FLEXIBLE DUCTWORK CONNECTIONS TO CEILING DIFFUSERS ARE LIMITED TO 9" MAXIMUM LENGTH.
8.	ALL DUCTWORK, CEILING DIFFUSERS/REGISTERS/GRILLES, EQUIPMENT, PIPING ETC., ARE NEW U.O.N. (SHOWN HEAVY). (C) DUCTWORK, PIPING ETC. IS SHOWN LIGHT. SEE LEGEND.
9.	(E) DUCTWORK AND ITEMS TO BE REMOVED ARE SHOWN DOTTED (X) OUT. SEE LEGEND. COORDINATE CLOSELY WITH (N) DUCTWORK AND P.O.S.'S SHOWN. ALL OTHER (E) DUCTWORK ETC. TO REMAIN.
10.	WHERE INLET DUCT DIAMETER AND DIFFUSER NECK SIZE ARE THE SAME (I.E. 24" & 24") CONTRACTOR SHALL OVERSIZE THE SHEET METAL PLENUM TO ACCOMMODATE THE ROUND DUCT CONNECTION.
11.	THERMOSTATS AND ROOM TEMPERATURE SENSORS SHALL BE INSTALLED AT 48" ABOVE FINISHED FLOOR (TO TOP OF DEWEE), DO NOT INSTALL THERMOSTATS AND ROOM TEMPERATURE SENSORS ABOVE CABEWOK, SHELVEING OR OTHER OBSTRUCTIONS OVER 24" IN DEPTH AND 24" IN HEIGHT.

MEP COMPONENT ANCHORAGE NOTE	
ALL MECHANICAL, PLUMBING, AND ELECTRICAL COMPONENTS SHALL BE ANCHORED AND INSTALLED PER THE DETAILS ON THE DSA APPROVED CONSTRUCTION DOCUMENTS. THE FOLLOWING COMPONENTS SHALL BE ANCHORED OR BRACED TO MEET THE FORCE AND DISPLACEMENT REQUIREMENTS PRESCRIBED IN THE 2019 CBC, SECTIONS 1617A.1.18 THROUGH 1617A.1.26 AND ASCE 7-16 CHAPTER 13, 26 AND 30.	
1.	ALL PERMANENT EQUIPMENT AND COMPONENTS.
2.	TEMPORARY, MOVABLE OR MOBILE EQUIPMENT THAT IS PERMANENTLY ATTACHED (e.g. HARD WIRED) TO THE BUILDING UTILITY SERVICES SUCH AS ELECTRICITY, GAS OR WATER. "PERMANENTLY ATTACHED" SHALL INCLUDE ALL ELECTRICAL CONNECTIONS EXCEPT PLUGS FOR 110/220 VOLT RECEPTACLES HAVING FLEXIBLE CABLE.
3.	TEMPORARY, MOVABLE OR MOBILE EQUIPMENT WHICH IS HEAVIER THAN 400 POUNDS OR HAS A CENTER OF MASS LOCATED 4 FEET OR MORE ABOVE THE ADJACENT FLOOR OR ROOF LEVEL THAT DIRECTLY SUPPORT THE COMPONENT ARE REQUIRED TO BE RESTRAINED IN A MANNER APPROVED BY DSA.
THE FOLLOWING MECHANICAL AND ELECTRICAL COMPONENTS SHALL BE POSITIVELY ATTACHED TO THE STRUCTURE, BUT NEED NOT DEMONSTRATE DESIGN COMPLIANCE WITH THE REFERENCES NOTED ABOVE. THESE COMPONENTS SHALL HAVE FLEXIBLE CONNECTIONS PROVIDED BETWEEN THE COMPONENT AND ASSOCIATED DUCTWORK, PIPING, AND CONDUIT. FLEXIBLE CONNECTIONS MUST ALLOW MOVEMENT IN BOTH TRANSVERSE AND LONGITUDINAL DIRECTIONS.	
A.	COMPONENTS WEIGHING LESS THAN 400 POUNDS AND HAVE A CENTER OF MASS LOCATED 4 FEET OR LESS ABOVE THE ADJACENT FLOOR OR ROOF LEVEL THAT DIRECTLY SUPPORT THE COMPONENT.
B.	COMPONENTS WEIGHING LESS THAN 20 POUNDS, OR IN THE CASE OF DISTRIBUTION SYSTEMS, LESS THAN 5 POUNDS PER FOOT, WHICH ARE SUSPENDED FROM A ROOF OR FLOOR OR HUNG FROM A WALL.
THE ANCHORAGE OF ALL MECHANICAL, ELECTRICAL AND PLUMBING COMPONENTS SHALL BE SUBJECT TO THE APPROVAL OF THE DESIGN PROFESSIONAL IN GENERAL RESPONSIBLE CHARGE OR STRUCTURAL ENGINEER DELEGATED RESPONSIBILITY AND ACCEPTANCE BY DSA. THE PROJECT INSPECTOR WILL VERIFY THAT ALL COMPONENTS AND EQUIPMENT HAVE BEEN ANCHORED IN ACCORDANCE WITH THE ABOVE REQUIREMENTS.	

PIPING, DUCTWORK & ELECTRICAL DISTRIBUTION SYSTEM BRACING NOTE	
PIPING, DUCTWORK, AND ELECTRICAL DISTRIBUTION SYSTEMS SHALL BE BRACED TO COMPLY WITH THE FORCES AND DISPLACEMENTS PRESCRIBED IN ASCE 7-16 SECTION 13.3 AS DEFINED IN ASCE 7-16 SECTION 13.6.5, 13.6.6, 13.6.7, 13.6.8, AND 2019 CBC, SECTIONS 1617A.1.24, 1617A.1.25, AND 1617A.1.26.	
THE METHOD OF SHOWING BRACING AND ATTACHMENTS TO THE STRUCTURE FOR THE IDENTIFIED DISTRIBUTION SYSTEM ARE AS NOTED BELOW. WHEN BRACING AND ATTACHMENTS ARE BASED ON PREAPPROVED INSTALLATION GUIDE (e.g., OSHPD OPM FOR 2013 CBC OR LATER), COPIES OF THE BRACING SYSTEM INSTALLATION GUIDE OR MANUAL SHALL BE AVAILABLE ON THE JOBSITE PRIOR TO THE START OF AND DURING THE HANGING AND BRACING OF THE DISTRIBUTION SYSTEMS. THE STRUCTURAL ENGINEER OF RECORD SHALL VERIFY THE ADEQUACY OF THE STRUCTURE TO SUPPORT THE HANGER AND BRACE LOADS.	
MECHANICAL PIPING (MP), MECHANICAL DUCTS (MD), PLUMBING PIPING (PP), ELECTRICAL DISTRIBUTION SYSTEMS (E):	
MP □ MD □ PP □ E □	OPTION 1: DETAILED ON THE APPROVED DRAWINGS WITH PROJECT SPECIFIC NOTES AND DETAILS
MP <input checked="" type="checkbox"/> MD <input checked="" type="checkbox"/> PP □ E □	OPTION 2: SHALL COMPLY WITH THE APPLICABLE OSHPD PRE-APPROVED (OPM #) #0043-13

MECHANICAL LEGEND cont'd		
SYMBOL	ABBREVIATION	DESCRIPTION
"F	ABV	ABOVE
	ABC	ABOVE CEILING
	BDD	BACK DRAFT DAMPER
	BHP	BRAKE HORSE POWER
	BTU(H)	BRITISH THERMAL UNITS (PER HOUR)
	CLG	CEILING
	CEF	CEILING EXHAUST FAN
	CFM	CUBIC FEET OF AIR FLOW PER MINUTE
	DPR	DAMPER
		DEGREES FAHRENHEIT
	DIA	DIAMETER, PHASE
	DL	DOOR LOUVER
	ENT	ENTERING
	EDB	ENTERING DRY BULB
	EW	ENTERING WATER
	EWT	ENTERING WATER TEMPERATURE
	EWB	ENTERING WET BULB
	EVAP	EVAPORATOR
	EA	EXHAUST AIR
	EAD	EXHAUST AIR DAMPER
	EF	EXHAUST FAN
	(E), EXIST	EXISTING
	(E)	EXISTING TO BE REMOVED
	ESP	EXTERNAL STATIC PRESSURE
	FLA	FULL LOAD AMPS
	GA	GAUGE
	HTG	HEATING
	KW	KILOWATTS
	KWH	KILOWATT HOUR
	LDB	LEAVING DRY BULB IN DEGREES FAHRENHEIT
	LWB	LEAVING WET BULB IN DEGREES FAHRENHEIT
	LRA	LOCKED ROTOR AMPERES
	LVR	LOUVER
	MAD	MANUAL AIR DAMPER
	MD	MOTORIZED AIR DAMPER
	MIN	MINIMUM
	MCC	MOTOR CONTROL CENTER
	(N)	NEW
	OA	OUTSIDE AIR
	OAD	OUTSIDE AIR DAMPER
	POC	POINT OF CONNECTION
	RS	REFRIGERANT SUCTION PIPING
	RL	REFRIGERANT LIQUID PIPING
	RV or P&TRV	RELIEF VALVE OR PRESSURE & TEMPERATURE RELIEF VALVE
	RA	RETURN AIR
	RAD	RETURN AIR DAMPER
	RPM	REVOLUTIONS PER MINUTE
	RLA	RUNNING LOAD AMPERES
	SM	SHEET METAL
	SQFT	SQUARE FEET
	SQIN	SQUARE INCHES
	SP	STATIC PRESSURE
	SA	SUPPLY AIR
	T	THERMOSTAT, "X" INDICATES DEVICE CONTROLLED. 48" AFF (TO TOP OF STAT)
	MBH	THOUSAND BRITISH THERMAL UNITS PER HOUR
	TSP	TOTAL STATIC PRESSURE
	TYP	TYPICAL
	WT	WEIGHT

DIFFUSER, REGISTER & GRILLE SCHEDULE						
SYMBOL	DESCRIPTION	KRUEGER	METALAIRE	HAILOR	TITUS	TUTTLE & BAILEY
 R, T, E <input checked="" type="checkbox"/> <input checked="" type="checkbox"/>	CEILING OR SIDEWALL RETURN, TRANSFER OR EXHAUST GRILLE WITH 36° OR 48° HORIZONTAL BARS.	800 H	SRH	7145 H	350 RL	T70D
NOTES: 1. ALL SYMBOLS NOTED MAY NOT BE USED. REFER TO PLANS FOR SIZE AND QUANTITY. 2. FURNISH ALL PRODUCTS OF A SINGLE MANUFACTURER. 3. COORDINATE DIFFUSER TYPE WITH ARCHITECTURAL REFLECTED CEILING PLAN.						

IDENTIFICATION STAMP
DIV. OF THE STATE ARCHITECT
APP: 02-120455 INC:
REVIEWED FOR
SS ☒ FLS ☒ ACS ☒
DATE: 01/12/2023

730 Howe Avenue, Suite 450
Sacramento, CA 95825
Phone: 916.921.2112
Fax: 916.921.2212

HENRY+ASSOCIATES
ARCHITECTS

DATE SIGNED: 12/20/2022

MODERNIZATION LAKEWOOD
ELEMENTARY SCHOOL

MECHANICAL - LEGEND,
SCHEDULE AND NOTES

CONSULTANT

DATE SIGNED: 12/20/2022

PROJECT NO. 21-32-052	REVISIONS	BY
DATE 3/28/2022		
DRAWN MS		
CHECKED JCBS		
SCALE AS SHOWN		
CADFILE		
UPDATED 11/17/2022		
SHEET NO.		

M0.1




Rancho Cordova, California
MM - RL 220210.00
PM - DESIGN TEAM PROJECT NO.

I:\2022\220210_0041200_Drawing\2205_AutoCAD Project Files\A11.1.dwg, December 20, 2022 02:12 PM, Richard J. Long



- SHEET NOTES:**
1. NEW PELICAN THERMOSTAT WITH TOP OF BOX AT 46" ABOVE FINISHED FLOOR.
 2. (E) SPLIT OUTDOOR UNIT AND CURB. COMB OUT ALL COIL FINS. REINSTALL. (E) REFRIGERANT LINE SETS AND RECHARGE WITH NEW REFRIGERANT TO EQUIPMENT PER SPECIFICATIONS. SEE 3/M5.1 FOR DETAIL.
 3. (E) PACKAGE AC-UNIT AND CURB. COMB OUT ALL COIL FINS.
 4. (E) DUCTWORK TO REMAIN.
 5. (E) DUCT SUPPORT AND PAD TO REMAIN.
 6. REINSTALL. (E) DUCT SUPPORT. ADJUST HEIGHT OF SUPPORT TO WORK WITH NEW FINISHED GRADE ELEVATION. SECURE TO CONC. W/ (4) 3/8" DIA. "HILTI" KWIK BOLT T22, W/ MIN. 1-5/8" EMBEDMENT.



IDENTIFICATION NUMBER APP: 02-120455 INC: REVIEWED FOR SS <input checked="" type="checkbox"/> FLS <input checked="" type="checkbox"/> ACS <input checked="" type="checkbox"/> DATE: 01/12/2023		
730 Howe Avenue, Suite 450 Sacramento, CA 95825 Phone: 916.921.2112 Fax: 916.921.2212		
		
		
<h1 style="margin: 0;">MODERNIZATION LAKEWOOD ELEMENTARY SCHOOL</h1> <h1 style="margin: 0;">MECHANICAL - OVERALL DEMOLITION AND NEW SITE</h1>		
CONSULTANT		
		
DATE SIGNED: 12/20/2022		
PROJECT NO. 21-32-052	REVISIONS	BY
DATE 3/28/2022		
DRAWN MS		
CHECKED JCBS		
SCALE AS SHOWN		
CADFILE		
UPDATED 11/17/2022		
SHEET NO.		
<h1 style="margin: 0;">M1.1</h1>		

QC
INI %

PLUMBING GENERAL NOTES

- SEE ARCHITECTURAL DRAWINGS FOR BUILDING DIMENSIONS AND EXACT LOCATIONS OF PLUMBING FIXTURES.
- COORDINATE LOCATION OF PIPING WITH OTHER TRADES ON THIS PROJECT.
- ~~CONSEAL ALL PIPING IN WALL, FURRING, PARTITIONS, ETC., EXCEPT AT MECHANICAL ROOMS.~~
- ~~SEAL ALL PIPE PENETRATIONS THRU FLOORS WATER TIGHT.~~
- ~~ALL FLOOR MOUNTED FIXTURES, CLEAN OUTS & FLOOR DRAINING TO BE FLUSH MOUNTED WITH 2% MAX. SLOPE.~~
- ~~DOMESTIC HOT WATER HEATERS SHALL BE SEISMICALLY SECURED TO BUILDING STRUCTURE WITH ADEQUATE STRUCTURAL SUPPORT WITH ANCHOR BOLTS.~~
- ~~PENETRATIONS OF RATED ASSEMBLIES SHALL BE FIRE STOPPED. FIRE STOPPING SHALL BE AN APPROVED MATERIAL OF THE ENFORCING AGENCY.~~
- ~~OFFSET VENTS THRU ROOF 10 FEET MINIMUM FROM AIR INTAKES AND 4 FEET FROM OUTSIDE WALLS.~~
- FIELD VERIFY EXACT SIZES, LOCATIONS AND ELEVATIONS OF ALL PIPING CONNECTIONS, OTHER WORK, ETC., PRIOR TO TRENCHING OR INSTALLING OF ANY NEW WORK.

MEP COMPONENT ANCHORAGE NOTE

- ALL MECHANICAL, PLUMBING, AND ELECTRICAL COMPONENTS SHALL BE ANCHORED AND INSTALLED PER THE DETAILS ON THE DSA APPROVED CONSTRUCTION DOCUMENTS. THE FOLLOWING COMPONENTS SHALL BE ANCHORED OR BRACED TO MEET THE FORCE AND DISPLACEMENT REQUIREMENTS PRESCRIBED IN THE 2019 CBC, SECTIONS 1617A.1.18 THROUGH 1617A.1.26 AND ASCE 7-16 CHAPTER 13, 26 AND 30.
- ALL PERMANENT EQUIPMENT AND COMPONENTS.
 - TEMPORARY, MOVABLE OR MOBILE EQUIPMENT THAT IS PERMANENTLY ATTACHED (e.g. HARD WIRED) TO THE BUILDING UTILITY SERVICES SUCH AS ELECTRICITY, GAS OR WATER. "PERMANENTLY ATTACHED" SHALL INCLUDE ALL ELECTRICAL CONNECTIONS EXCEPT PLUGS FOR 110/220 VOLT RECEPTACLES HAVING FLEXIBLE CABLE.
 - TEMPORARY, MOVABLE OR MOBILE EQUIPMENT WHICH IS HEAVIER THAN 400 POUNDS OR HAS A CENTER OF MASS LOCATED 4 FEET OR MORE ABOVE THE ADJACENT FLOOR OR ROOF LEVEL THAT DIRECTLY SUPPORT THE COMPONENT ARE REQUIRED TO BE RESTRAINED IN A MANNER APPROVED BY DSA.
- THE FOLLOWING MECHANICAL AND ELECTRICAL COMPONENTS SHALL BE POSITIVELY ATTACHED TO THE STRUCTURE, BUT NEED NOT DEMONSTRATE DESIGN COMPLIANCE WITH THE REFERENCES NOTED ABOVE. THESE COMPONENTS SHALL HAVE FLEXIBLE CONNECTIONS PROVIDED BETWEEN THE COMPONENT AND ASSOCIATED DUCTWORK, PIPING, AND CONDUIT. FLEXIBLE CONNECTIONS MUST ALLOW MOVEMENT IN BOTH TRANSVERSE AND LONGITUDINAL DIRECTIONS.
- COMPONENTS WEIGHING LESS THAN 400 POUNDS AND HAVE A CENTER OF MASS LOCATED 4 FEET OR LESS ABOVE THE ADJACENT FLOOR OR ROOF LEVEL THAT DIRECTLY SUPPORT THE COMPONENT.
 - COMPONENTS WEIGHING LESS THAN 20 POUNDS, OR IN THE CASE OF DISTRIBUTION SYSTEMS, LESS THAN 5 POUNDS PER FOOT, WHICH ARE SUSPENDED FROM A ROOF OR FLOOR OR HUNG FROM A WALL.
- THE ANCHORAGE OF ALL MECHANICAL, ELECTRICAL AND PLUMBING COMPONENTS SHALL BE SUBJECT TO THE APPROVAL OF THE DESIGN PROFESSIONAL IN GENERAL RESPONSIBLE CHARGE OR STRUCTURAL ENGINEER DELEGATED RESPONSIBILITY AND ACCEPTANCE BY DSA. THE PROJECT INSPECTOR WILL VERIFY THAT ALL COMPONENTS AND EQUIPMENT HAVE BEEN ANCHORED IN ACCORDANCE WITH THE ABOVE REQUIREMENTS.

PIPING, DUCTWORK & ELECTRICAL DISTRIBUTION SYSTEM BRACING NOTE

- PIPING, DUCTWORK, AND ELECTRICAL DISTRIBUTION SYSTEMS SHALL BE BRACED TO COMPLY WITH THE FORCES AND DISPLACEMENTS PRESCRIBED IN ASCE 7-16 SECTION 13.3 AS DEFINED IN ASCE 7-16 SECTION 13.6.5, 13.6.6, 13.6.7, 13.6.8, AND 2019 CBC, SECTIONS 1617A.1.24, 1617A.1.25, AND 1617A.1.26.
- THE METHOD OF SHOWING BRACING AND ATTACHMENTS TO THE STRUCTURE FOR THE IDENTIFIED DISTRIBUTION SYSTEM ARE AS NOTED BELOW. WHEN BRACING AND ATTACHMENTS ARE BASED ON PREAPPROVED INSTALLATION GUIDE (e.g., OSHPD OPM FOR 2013 CBC OR LATER), COPIES OF THE BRACING SYSTEM INSTALLATION GUIDE OR MANUAL SHALL BE AVAILABLE ON THE JOBSITE PRIOR TO THE START OF AND DURING THE HANGING AND BRACING OF THE DISTRIBUTION SYSTEMS. THE STRUCTURAL ENGINEER OF RECORD SHALL VERIFY THE ADEQUACY OF THE STRUCTURE TO SUPPORT THE HANGER AND BRACE LOADS.
- MECHANICAL PIPING (MP), MECHANICAL DUCTS (MD), PLUMBING PIPING (PP), ELECTRICAL DISTRIBUTION SYSTEMS (E):
- MP ☐ MD ☐ PP ☐ E ☐ OPTION 1: DETAILED ON THE APPROVED DRAWINGS WITH PROJECT SPECIFIC NOTES AND DETAILS
- MP ☐ MD ☐ PP ☒ E ☐ OPTION 2: SHALL COMPLY WITH THE APPLICABLE OSHPD PRE-APPROVED (OPM #) #0043-13

PLUMBING LEGEND

SYMBOL	ABBREVIATION	DESCRIPTION
	AP/ AD	ACCESS PANEL WITH ACCESS DOOR
	ABC	ABOVE CEILING
	COP	CAP ON END OF PIPE
	CKV	CHECK VALVE
	CW	COLD WATER
	CWR	COLD WATER RISE
	CWD	COLD WATER DROP
	CD	CONDENSATE DRAIN LINE (INSIDE BLDG. TO BE INSULATED)
	CD	CONDENSATE DRAIN LINE (EXTERIOR NO INSULATION)
	CO	CLEANOUT
	CO	DEGREES FAHRENHEIT
	DIA.	DIAMETER, SQUARE (FEET)
	(D), (R)	DROP, RISE
	(E)	EXISTING TO BE REMOVED
	FU	FIXTURE UNIT
	FD	FLOOR DRAIN
	FS	FLOOR SINK
	FV, FT	FLUSH VALVE, FLUSH TANK
	(FA), (TA)	FROM ABOVE, TO ABOVE
	(FB), (TB)	FROM BELOW, TO BELOW
	G	GAS
	GSOV	GAS SHUT OFF VALVE
	GV	GATE VALVE
	GPM	GALLONS PER MINUTE
	GLV	GLOBE VALVE
	GPR	GAS PRESSURE REGULATOR
	CO	GRADE CLEANOUT
	HB	HOSE BIBB
	HW	HOT WATER PIPING
	HWR	HOT WATER PIPING RISE
	HWD	HOT WATER PIPING DROP
	HWRET	HOT WATER RETURN
	HWRET(R)	HOT WATER RETURN RISE
	HWRET(D)	HOT WATER RETURN DROP
	(N), (E)	NEW, EXISTING
	POC	POINT OF CONNECTION, NEW TO EXISTING
	P & TRV	PRESSURE & TEMPERATURE RELIEF VALVE PIPING
	RV or P&TRV	RELIEF VALVE OR PRESSURE & TEMPERATURE RELIEF VALVE
	RET	RETURN
	RE, IE	RIM ELEVATION, INVERT ELEVATION
	(R), (D)	RISE, DROP
	R, D	RISER DOWN (ELBOW)
	RD	RISER UP (ELBOW)
	S, W	RISE OR DROP
	TYP	ROOF DRAIN
	UF	SOIL, WASTE OR SANITARY SEWER BELOW FLOOR
	V	TYPICAL
	V	UNDER FLOOR
	V	VENT PIPING
	VB	VENT, VENT RISER, VENT THRU ROOF
	VB	VALVE BOX

ELECTRIC WATER HEATER SCHEDULE


UNIT	LOCATION	"AO SMITH" MODEL NO.	STORAGE CAPACITY GALLONS	RECOVERY GALLONS @ 100° F RISE	MAX. TEMP SETTING	TOTAL WATTAGE	KW	VOLTS	WATER TEMP	WATER PRESS (PSI)	PIPING DETAIL	MOUNTING DETAIL	NOTES
	TEACHERS WK. ROOM E102	E102	6	6 GPH	90°F	1650	1.65	120V/1Ø	85		1 P5.1	2 P5.1	1. SINGLE ELEMENT OPERATION 2. SIDE WATER CONNECTIONS.

EXPANSION TANK SCHEDULE

UNIT	LOCATION	"AMTROL" MODEL NO.	TANK VOLUME GALLONS	MAX. ACCEPT. VOLUME	DETAIL	NOTES
	TEACHERS WK. ROOM E102	ST-5	2.0	0.45	2 P5.1	8" x 2 x 12", 13 LBS. SUPPORT W/ QUICK STRAP #QS-5

IDENTIFICATION STAMP
DIV. OF THE STATE ARCHITECT
APP: 02-120455 INC:
REVIEWED FOR
SS ☒ FLS ☒ ACS ☒
DATE: 01/12/2023

730 Howe Avenue, Suite 450
Sacramento, CA 95825
Phone: 916.921.2112
Fax: 916.921.2212

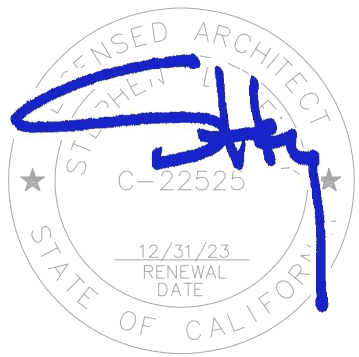

MODERNIZATION LAKEWOOD
ELEMENTARY SCHOOL

PLUMBING - LEGEND,
SCHEDULE AND NOTES

CONSULTANT



DATE SIGNED: 12/20/2022

PROJECT NO. 21-32-052	REVISIONS	BY
DATE 3/28/2022		
DRAWN MS		
CHECKED JCBS		
SCALE AS SHOWN		
CADFILE		
UPDATED 11/17/2022		
SHEET NO.		

P0.1



RANCHO CORDOVA, CALIFORNIA
MM - RL
PM - DESIGN TEAM
220210.00
PROJECT NO.

QC
INI
%

PLUMBING FIXTURE SPECIFICATION & CONNECTION SCHEDULE													
ADA	SYMBOL	FIXTURE	FIXTURE MANUFACTURER AND MODEL No.	FAUCET OR VALVE MANUFACTURER AND MODEL No.	TRIM MANUFACTURER AND MODEL No.	REMARKS	VENT	WASTE		COLD WATER		HOT WATER	
								BRANCH	OUTLET	BRANCH	OUTLET	BRANCH	OUTLET
		WC-1 WATER CLOSET WALL MOUNTED FLUSH VALVE STD/ACCESSIBLE	"AMERICAN STANDARD" AFWALL NO. 3351.001, 1.28 GPF WALL HUNG, VITREOUS CHINA, ELONGATED, SIPHON JET ACTION, 1-1/2" TOP SPUD.	"SLOAN" ROYAL 111 HET 1.28, ADA COMPLIANT, 1.28 GPF (MANUAL)	SEAT: "CHURCH" MODEL 295SSCT OR "BEMIS" MODEL 1955SSCT. PROVIDE WITH SELF- SUSTAINING CONCEALED CHECK HINGES, ONE PIECE STAINLESS STEEL POST HINGES, WHITE COLOR. CARRIER: "J.R. SMITH" 126 OR 200 SERIES. OR "ZURN" Z1203 AND Z1204 SERIES PROVIDE REAR SUPPORT LUG AND ANCHOR FOOT ASSEMBLY.	MOUNT AT HEIGHT INDICATED ON ARCHITECTURAL DRAWINGS. WHERE USED FOR CBC ACCESSIBLE WATER CLOSETS, THE FLUSH VALVE HANDLE SHALL BE MOUNTED ON THE WIDE SIDE OF THE WATER CLOSET ENCLOSURE.	2"	4"	4"	1-1/4"	1"	--	--
		WC-2 WATER CLOSET FLOOR MOUNTED FLUSH VALVE KINDERGARTEN	"KOHLER" PRIMARY 1.28, NO. K-96064-SS FLOOR MOUNTED, ELONGATED, SIPHON JET ACTION 1-1/2" TOP SPUD, 10-1/2" RIM HEIGHT. ANTIMICROBIAL	"SLOAN" ROYAL 111 HET 1.28, ADA COMPLIANT, 1.28 GPF (MANUAL)	SEAT: "KOHLER" MODEL K-4686 . PROVIDE WITH SELF- SUSTAINING CONCEALED CHECK HINGES, ONE PIECE STAINLESS STEEL POST HINGES, WHITE COLOR.	WHERE USED FOR CBC ACCESSIBLE WATER CLOSETS, THE FLUSH VALVE HANDLE SHALL BE MOUNTED ON THE WIDE SIDE OF THE WATER CLOSET ENCLOSURE.	2"	4"	4"	1-1/4"	1"	-	-
		UR-1 URINAL WALL MOUNTED FLUSH VALVE ACCESSIBLE	"AMERICAN STANDARD" PINTBROOK NO. 6002.001, 0.125 GPF, WALL HUNG, VITREOUS CHINA, SIPHON JET ACTION. 3/4" TOP SPUD, 2" THREADED OUTLET.	"SLOAN" ROYAL 100-0-125 GPF (MANUAL) POLISHED CHROME	CARRIER: "J.R. SMITH" 637 SERIES OR "ZURN" Z1222	MOUNT AT HEIGHT INDICATED ON ARCHITECTURAL DRAWINGS.	1 1/2"	2"	2"	1-1/2"	3/4"	--	--
		L-1 LAVATORY WALL MOUNTED COLD WATER ONLY STD/ACCESSIBLE	"AMERICAN STANDARD" LUCERNE NO. 0355.012, WALL HUNG, VITREOUS CHINA WITH CONTOURED BACK AND SIDE SPLASH SHIELDS, FRONT OVERFLOW, CONCEALED ARM RECESS, 4" CENTERS, 20" x 18" D SHAPED BOWL	"MOEN" 8884 NEWER VERSION, SINGLE-HANDLE ADA METERING LAVATORY FAUCET, CHROME PLATED SOLID BRASS CONSTRUCTION, SINGLE HOLE MOUNT, 0.5GPM MAX. ADA COMPLIANT. PROVIDE WITH DECK PLATE	ADA COMPLIANT. LAVATORY GRID DRAIN WITH 1-1/4" OFFSET TAIL PIECE AND P-TRAP. GRID NO. 7723.018, CHROME FINISH. MOUNT P-TRAP FLUSH TO WALL. CARRIER: "J R SMITH" 0700 OR ZURN Z1231	MOUNT AT HEIGHT INDICATED ON ARCHITECTURAL DRAWINGS. PROVIDE CONCEALED ARMS AND FLOOR SUPPORT, WITH FEET OF SUPPORT SECURELY ANCHORED TO FLOOR. IN ADDITION ANCHOR TOP OF SUPPORT TO WALL CONSTRUCTION.	1 1/2"	2"	1 1/2"	3/4"	1/2"	-	-
		S-1 SINK COUNTER MOUNTED COLD WATER ONLY W/BUBBLER	"ELKAY" MODEL DRKADQ3119-65-BP, 19" FRONT TO BACK, 6 1/2" WIDE x 6 1/2" DEPTH OVERALL, 18 GAUGE STAINLESS STEEL, SIDE LEDGES WITH SELF- RIM. PROVIDE REAR DRAIN LOCATION. VANDAL RESISTANT BACKING PLATE AT BUBBLER AND FAUCET FOR VANDAL RESISTANT PINS. BACKING PLATE SHALL BE 14 GAUGE SS FORMED AS A CHANNEL.	"CHICAGO" ECAST MODEL 350-E35ABCP(VVAVVP) GOOSENECK FAUCET, "HAWES" 5054LF BUBBLER, VANDAL RESISTANT. PROVIDE VANDAL PROOF PIN (VPP) IN BUBBLER AND FAUCET. ARRANGE TO MATE WITH SLOTS IN SINK. PROVIDE 1.5 GPM VANDAL RESISTANT LAMINAR FLOW AERATOR.	"ELKAY" MODEL LKAD18, OFFSET STRAINER DRAIN AND P-TRAP. INSTALL P-TRAP FLUSH TO WALL.	ARRANGE FINAL INSTALLATION OF SINK SUCH THAT THE BUBBLER WILL BE WITHIN 5" OF THE EDGE OF THE COUNTERTOP. INSTALL FAUCET IN CENTER OF SIDE SPLASH. PROVIDE SLOT FOR BUBBLER AT 15° ANGLE FROM FRONT OF THE SINK AND INSTALL THE BUBBLER AT 15° ANGLE	1-1/2"	2"	1-1/2"	3/4"	1/2"	-	-
		FD FLOOR DRAIN	GENERAL SERVICE FD - ZURN MODEL Z-415, OR EQUAL, WITH TYPE "B" STRAINER FOR EXPOSED CONCRETE AND TYPE "S" STRAINER FOR TILE FLOOR. PROVIDE BRONZE TRIM. FD IN MECHANICAL SERVICE AREAS - ZURN MODEL Z-541, OR EQUAL, 12 INCH DIAMETER HEAVY DUTY DRAIN. FD IN AT INDIRECT DRAIN LOCATIONS - ZURN MODEL Z-415, OR EQUAL, WITH TYPE "T" STRAINER, RECESS RIM FLUSH WITH FLOOR. OTHER APPROVED EQUAL MANUFACTURERS INCLUDE: JAY R. SMITH, WATTS & MIFAB.				2"	2"	2"	-	-	-	-
		TP TRAP PRIMER	MIFAB "M-600" SERIES. REQUIRES 3PSI DROP TO ACTIVATE.			PROVIDE ACCESS PANEL	-	-	-	1/2"	1/2"	-	-
		HB HOSE BIBB	INTERIOR WALL MOUNTED - ACORN MODEL 8121CP-LF WOOD FORD MODEL 24PC, OR EQUAL.	WITH INTEGRAL VACUUM BREAKER PROTECTED, CARTRIDGE OPERATED HOSE VALVE WITH LOCK SHIELD BOUNDT. AND REMOVABLE KEY HANDLE.		SET HEIGHT AT 18" ABOVE FINISHED FLOOR	-	-	-	1"	3/4"	-	-
		WHA WATER HAMMER ARRESTOR	SEE SPECIFICATIONS										
		DF-1 DRINKING FOUNTAIN PEDESTAL CHILD ADA/ STANDARD DUAL HEIGHT	"HAWES" 3150 CHILD ADA DUAL HEIGHT PEDESTAL DRINKING FOUNTAIN	INTEGRAL	WITH P-TRAP DRAIN TO DRYWELL	INSTALL PER MANUFACTURER'S RECOMMENDATIONS CHILD ADA HIGH/ LOW DRINKING FOUNTAIN	-	-	-	3/4"	1/2"	-	-
GENERAL NOTES: 1. WATER SUPPLIES AND STOPS: A. PROVIDE 85 PERCENT IPS RED BRASS PIPE, SECURELY ANCHORED TO BUILDING CONSTRUCTION, FOR EACH CONNECTION TO FAUCETS, STOPS, HOSE BIBBS, ETC. EACH FIXTURE, EXCEPT HOSE BIBBS, SHALL HAVE A STOP VALVE INSTALLED ON WATER SUPPLY LINES TO PERMIT REPAIRS WITHOUT SHUTTING OFF WATER MAINS. B. PROVIDE ALL WATER SUPPLIES TO FIXTURES WITH COMPRESSION SHUT-OFF STOPS WITH IPS INLETS WITH THREADED BRASS NIPPLES AT PIPE CONNECTION AND LOCK SHIELD LOOSE KEY. PROVIDE COMBINATION FIXTURES WITH COMPRESSION STOP AND IPS INLET ON EACH WATER SUPPLY FITTING. PROVIDE LOOSE KEY HANDLE FOR EACH STOP. C. PROVIDE 1/2 INCH RISER TUBES WITH REDUCING COUPLING FOR ALL FIXTURES, UNLESS OTHERWISE NOTED. REFER TO SPECIFICATION SECTION 22 40 00. 2. PIPE, PLUMBING FITTINGS, FIXTURES, SOLDER AND FLUX SHALL COMPLY WITH LEAD FREE REQUIREMENTS OF THE CALIFORNIA HEALTH AND SAFETY CODE SECTION 116875. PROVIDE PRODUCTS LISTED AND LABELED AS COMPLYING WITH NSF 61, ANNEX G, OR PROVIDE OTHER EVIDENCE OF COMPLIANCE WITH THE CALIFORNIA HEALTH AND SAFETY CODE SECTION 116875. PROVIDE PRODUCT SUBMITTAL INFORMATION PROVING COMPLIANCE WITH LEAD FREE REQUIREMENTS. ALSO SEE GENERAL NOTES ON SHEET P0.1 AND SPECIFICATION SECTIONS, 22 00 50, 22 10 00 AND 22 40 00.													

IDENTIFICATION STAMP
DIV. OF THE STATE ARCHITECT
APP: 02-120455 INC:
REVIEWED FOR
SS ☒ FLS ☒ ACS ☒
DATE: 01/12/2023

730 Howe Avenue, Suite 450
Sacramento, CA 95825
Phone: 916.921.2112
Fax: 916.921.2212



MODERNIZATION LAKEWOOD
ELEMENTARY SCHOOL

PLUMBING -
FIXTURE SCHEDULE

CONSULTANT


DATE SIGNED: 12/20/2022

PROJECT NO. 21-32-052	REVISIONS	BY
DATE 3/28/2022		
DRAWN MS		
CHECKED JCBS		
SCALE AS SHOWN		
CADFILE		
UPDATED 11/17/2022		
SHEET NO.		

P0.2

Rancho Cordova, California
MM - RL 220210.00
PM - DESIGN TEAM PROJECT NO.

QC	
INI	%

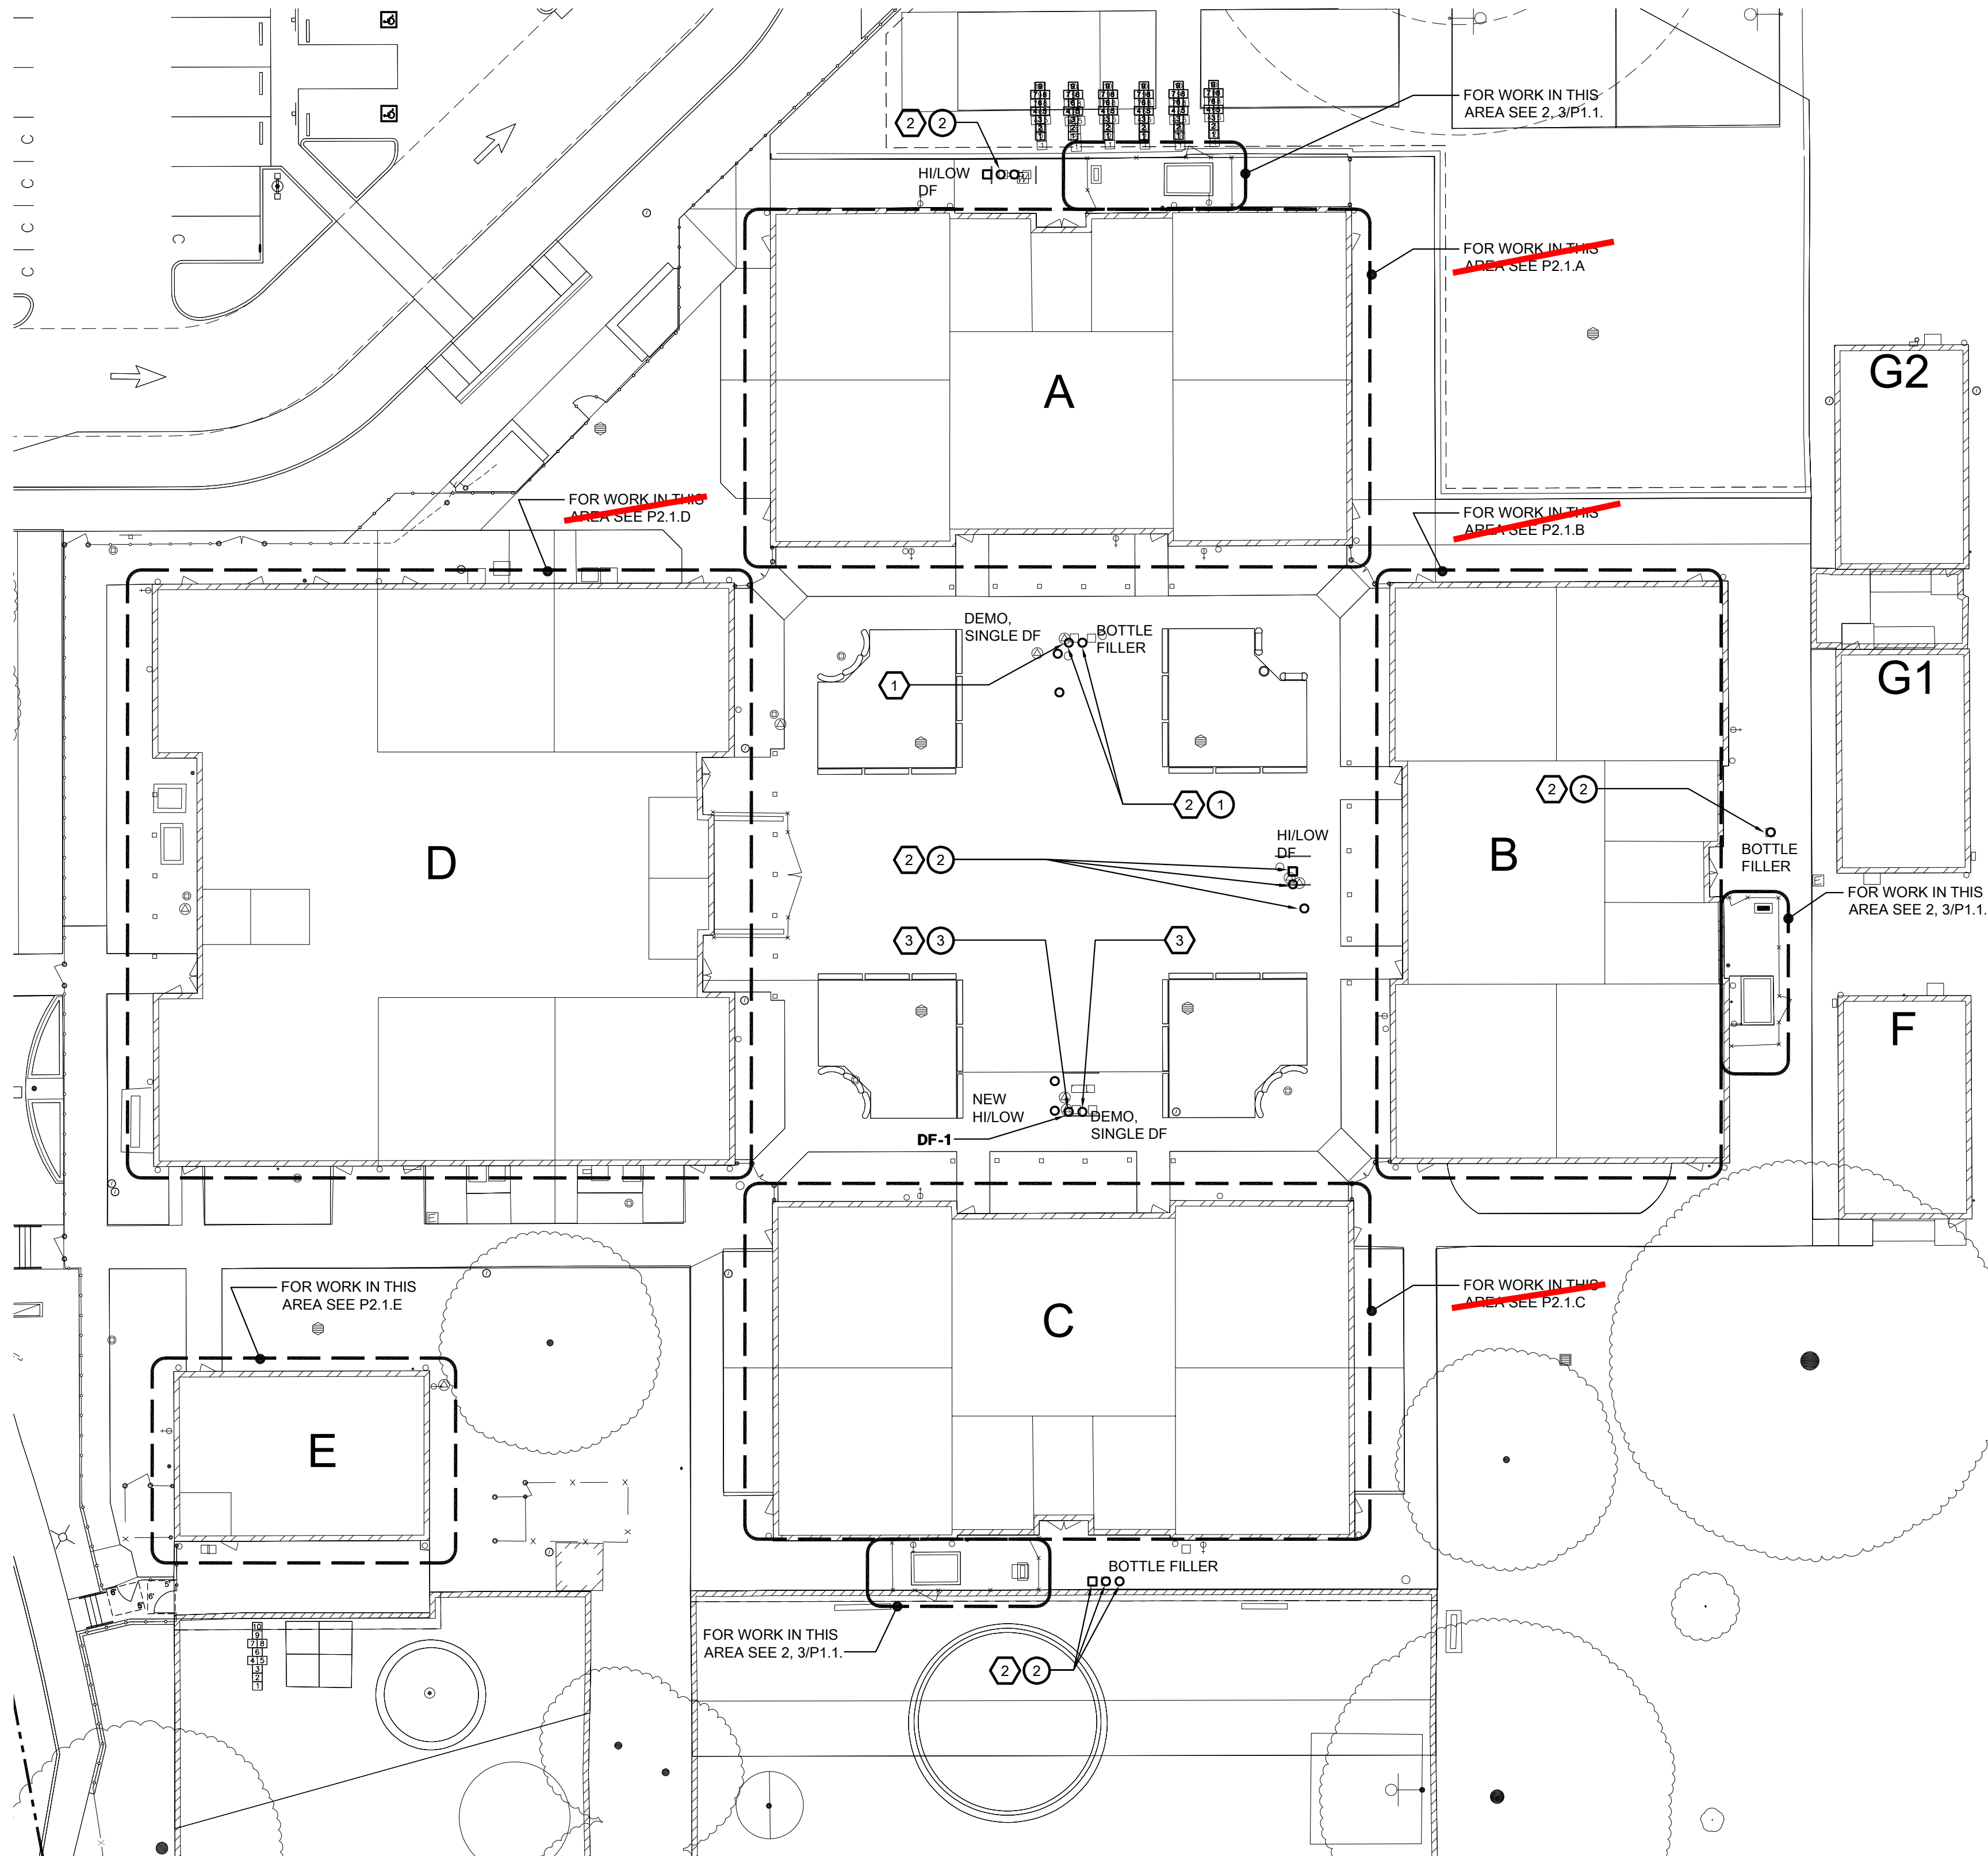

1 PLUMBING SITE PLAN
P1.1 SCALE: 1" = 20'-0"

GENERAL SHEET NOTES:


1. REMOVE AND REPLACE WITH NEW ALL THE SOV IN THE EXISTING VALVE BOX(S) SERVING THE DRINKING FOUNTAIN(S).
2. PROVIDE FULL SIZE GSOV AND UNION ON ALL PIPING AT AC-UNIT(S).

DEMOLITION SHEET NOTES:


1. REMOVE DF, DISCONNECT PLUMBING SERVICES FROM (E) DRINKING FOUNTAIN. CAP PIPING BEHIND SURFACES.
2. DISCONNECT PLUMBING SERVICES FROM (E) DRINKING FOUNTAIN (DF) OR BOTTLE FILLER (BF). REMOVE AND PROTECT OPENING FOR SHUT OFF VALVE (SOV) IN VALVE BOX (VB). PREPARE FOR EXTENSION TO NEW HEIGHT OF NEW CONCRETE. REMOVE AND STORE (E) DRINKING FOUNTAIN IN PROTECTED LOCATION. PROTECT WATER AND WASTE LINES AND PREPARE FOR RECONNECTION.
3. DISCONNECT PLUMBING SERVICES FROM (E) DRINKING FOUNTAIN. CAP PIPING BEHIND SURFACES.
4. (E) GAS RISER FROM BELOW GRADE. DISCONNECT GAS PIPING DOWNSTREAM OF GAS PRESSURE REGULATOR AND PREPARE FOR RECONNECTION.
5. REMOVE AND SET ASIDE GAS PIPING TO THE EQUIPMENT YARD BETWEEN THE TWO CAPS NOTED ON THE PLAN. PROTECT PIPING AND COVER OPEN ENDS OF PIPING PER SPECIFICATIONS. LABEL WHICH BUILDING GAS PIPING BELONGS. REMOVE GAS PIPE SUPPORTS.

SHEET NOTES:

1. REINSTALL (E) BOTTLE FILLER WITH NEW BOTTLE FILLER MOUNTING SUPPORT HARDWARE AT NEW CONCRETE PAD. PROVIDE EXTENSION PIECE(S) AS REQUIRED FOR THE SHUT OFF VALVE IN VB AND FOR THE DRY WELL VB. EACH VB SHALL HAVE A NEW EXTENSION PIECE(S) AND APPROPRIATELY MARKED LID(S). EXTEND WASTE AND WATER FOR NEW FIXTURE LOCATION.
2. REINSTALL (E) DF/ BOTTLE FILLER WITH NEW DF/ BOTTLE FILLER MOUNTING SUPPORT HARDWARE AT NEW CONCRETE PAD. PROVIDE EXTENSION PIECE(S) AS REQUIRED FOR THE SHUT OFF VALVE IN VB AND FOR THE DRY WELL VB. EACH VB SHALL HAVE A NEW EXTENSION PIECE(S) AND APPROPRIATELY MARKED LID(S). EXTEND WASTE AND WATER FOR NEW FIXTURE LOCATION.
3. NEW HI/LOW DF WITH NEW DF MOUNTING SUPPORT HARDWARE AT NEW CONCRETE PAD. CONNECT AND EXTEND (E) WASTE AND (E) WATER SYSTEMS TO NEW FIXTURE. FOR DETAIL SEE 3/P5.1.
4. (E) GAS RISER FROM BELOW GRADE. RECONNECT GAS PIPING DOWNSTREAM OF GAS PRESSURE REGULATOR. PROVIDE (N) GSOV AND UNION. ADJUST PIPING LENGTHS SO THAT THE DIRT LEG AND PIPING HAS A MINIMUM CLEARANCE ABOVE THE NEW FINISHED CONCRETE OF 1.5' CLEAR.
5. REINSTALL GAS PIPING BETWEEN POC'S NOTED ON THE PLANS BETWEEN THE RISER AND TO THE AC-UNIT. PROVIDE NEW GAS PIPE SUPPORTS PER 4/P5.1. REPLACE (E) GSOV AT UNIT WITH NEW GSOV AND UNION. REPLACE (E) GAS FLEX CONNECTION (FC) WITH NEW GAS FC. PROVIDE GAS DIRT LEG AT CONNECTION TO UNIT. PROVIDE CONDENSATE (CD) PIPING AND FULL SIZE CD LINES AND SPILL TO EXISTING LOCATION.

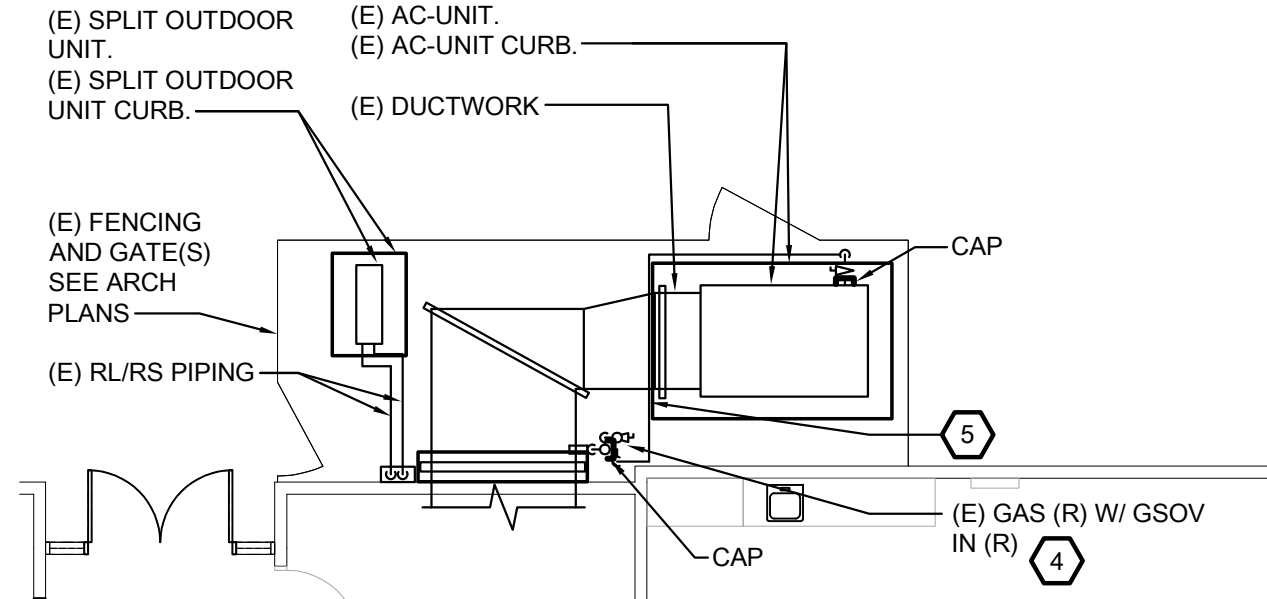

2 PLUMBING TEMPORARY REMOVAL ENLARGED BUILDING A YARD PLAN
P1.1 SCALE: 1/8" = 1'-0" (SIMILAR FOR BUILDING B AND C)

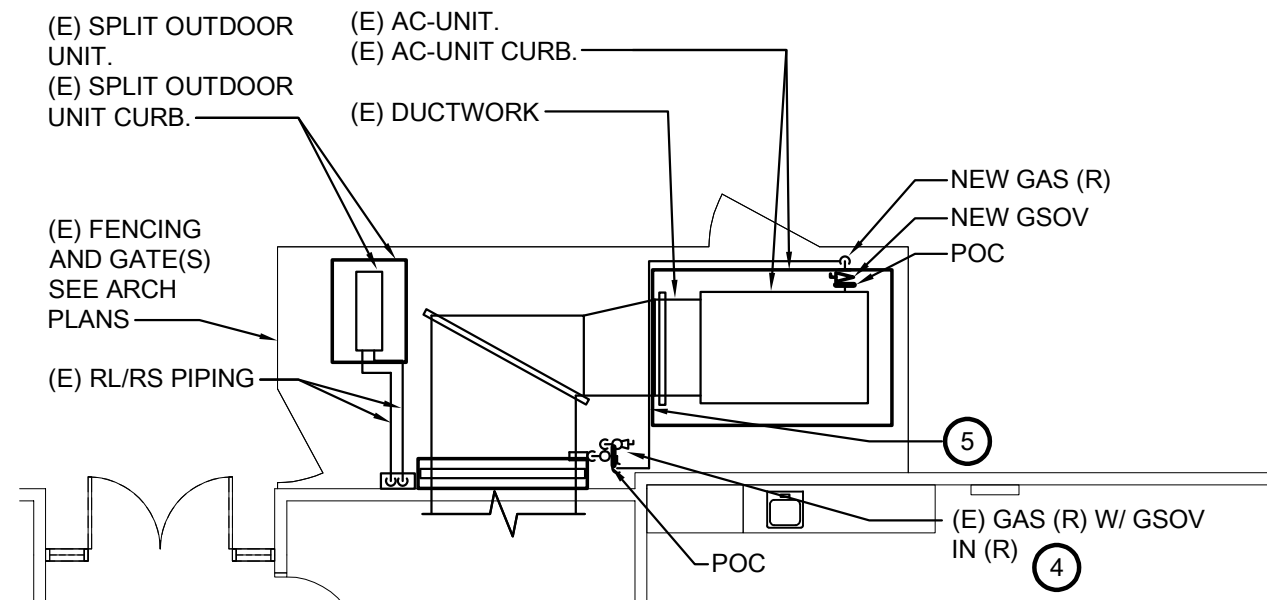

3 PLUMBING ENLARGED BUILDING A YARD PLAN
P1.1 SCALE: 1/8" = 1'-0" (SIMILAR FOR BUILDING B AND C)

IDENTIFICATION STAMP
DIV. OF THE STATE ARCHITECT
APP: 02-120455 INC:
REVIEWED FOR
SS ☒ FLS ☒ ACS ☒
DATE: 01/12/2023

730 Howe Avenue, Suite 450
Sacramento, CA 95825
Phone: 916.921.2112
Fax: 916.921.2212



MODERNIZATION LAKEWOOD
ELEMENTARY SCHOOL
PLUMBING -
OVERALL DEMOLITION
AND NEW SITE

CONSULTANT




DATE SIGNED: 12/20/2022

PROJECT NO.	REVISIONS	BY
21-32-052		
DATE		
3/28/2022		
DRAWN		
MS		
CHECKED		
JCBS		
SCALE		
AS SHOWN		
CADFILE		
UPDATED		
11/17/2022		
SHEET NO.		

P1.1


QC	
INI	%

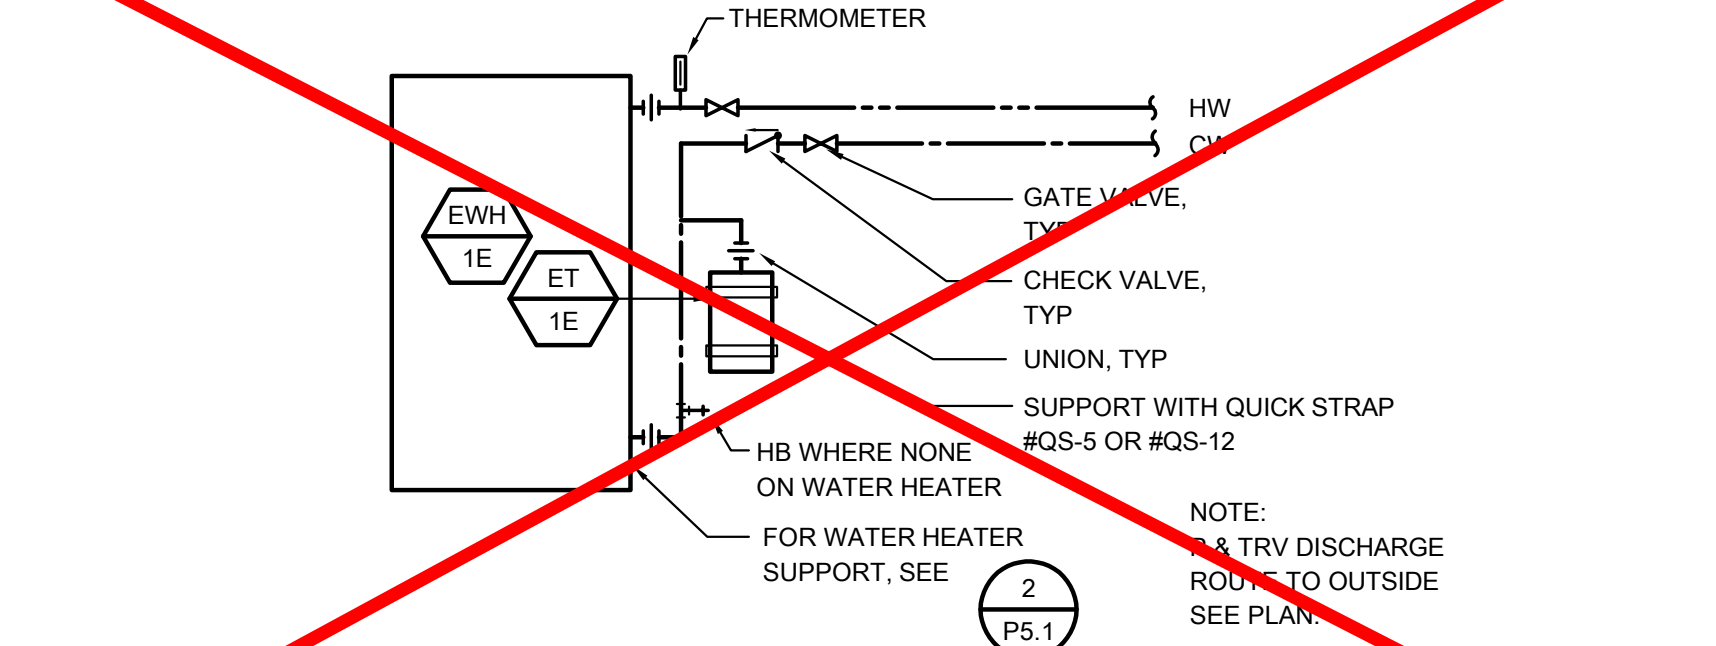

ELECTRIC WATER HEATER PIPING

SCALE : NONE


1 P5.1

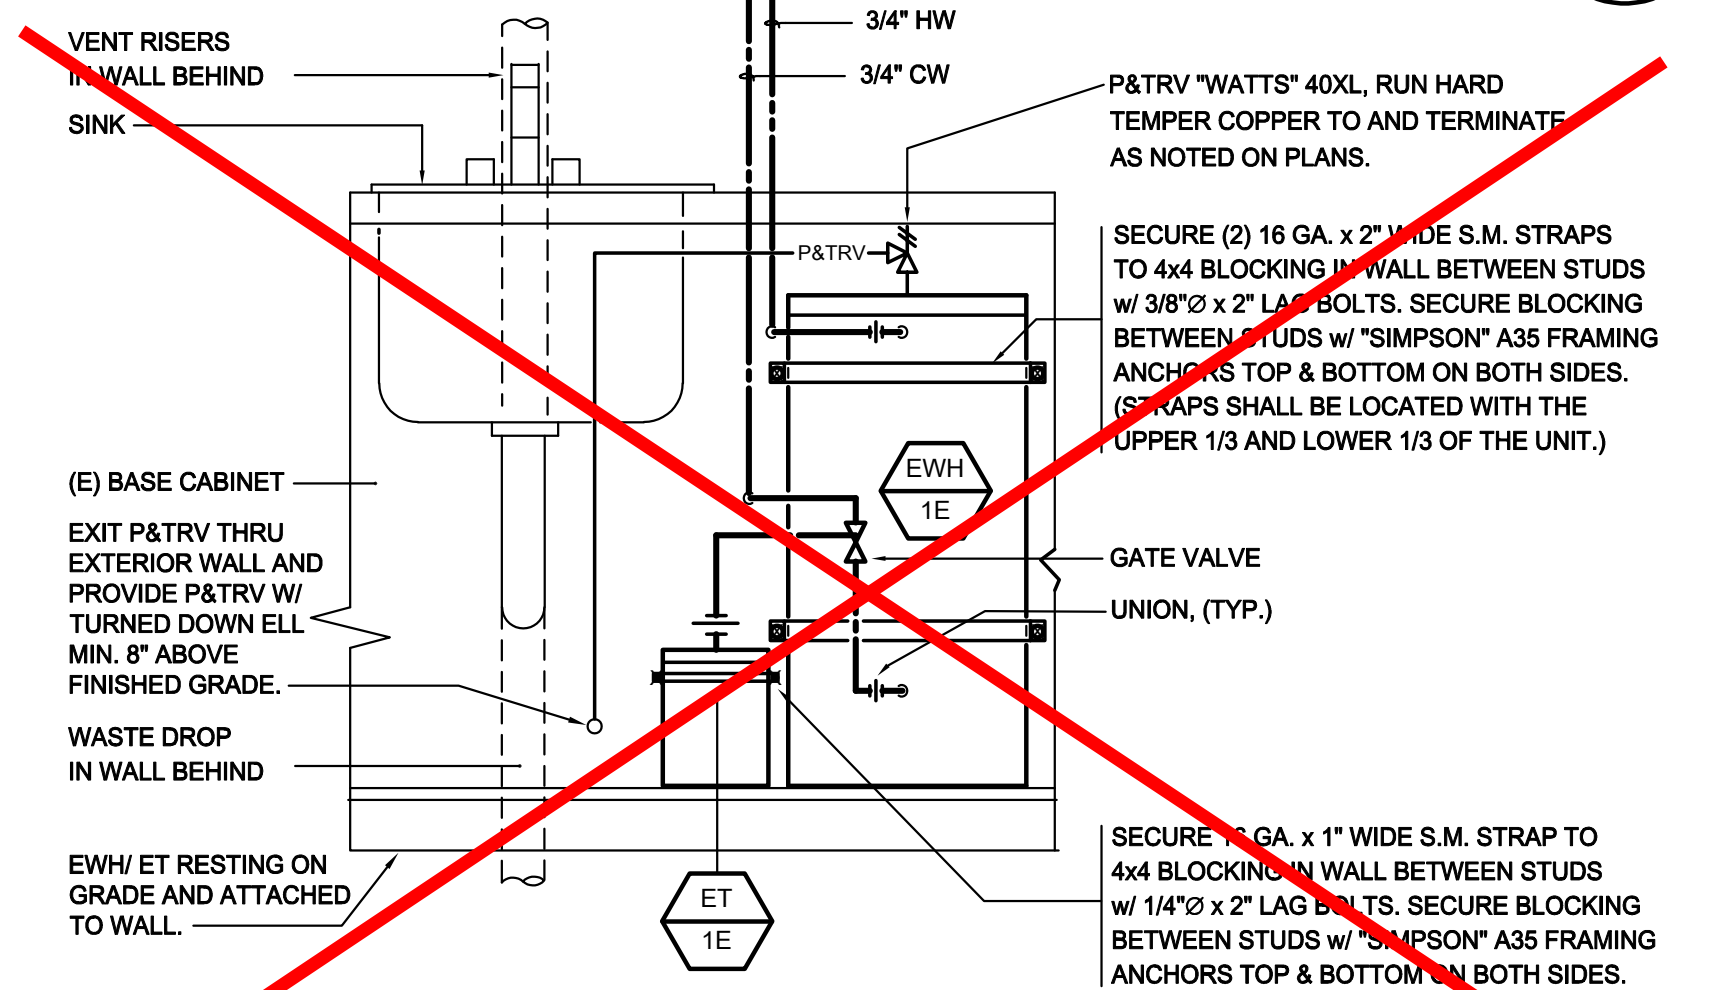

UNDERCOUNTER WATER HEATER

SCALE : NONE


2 P5.1

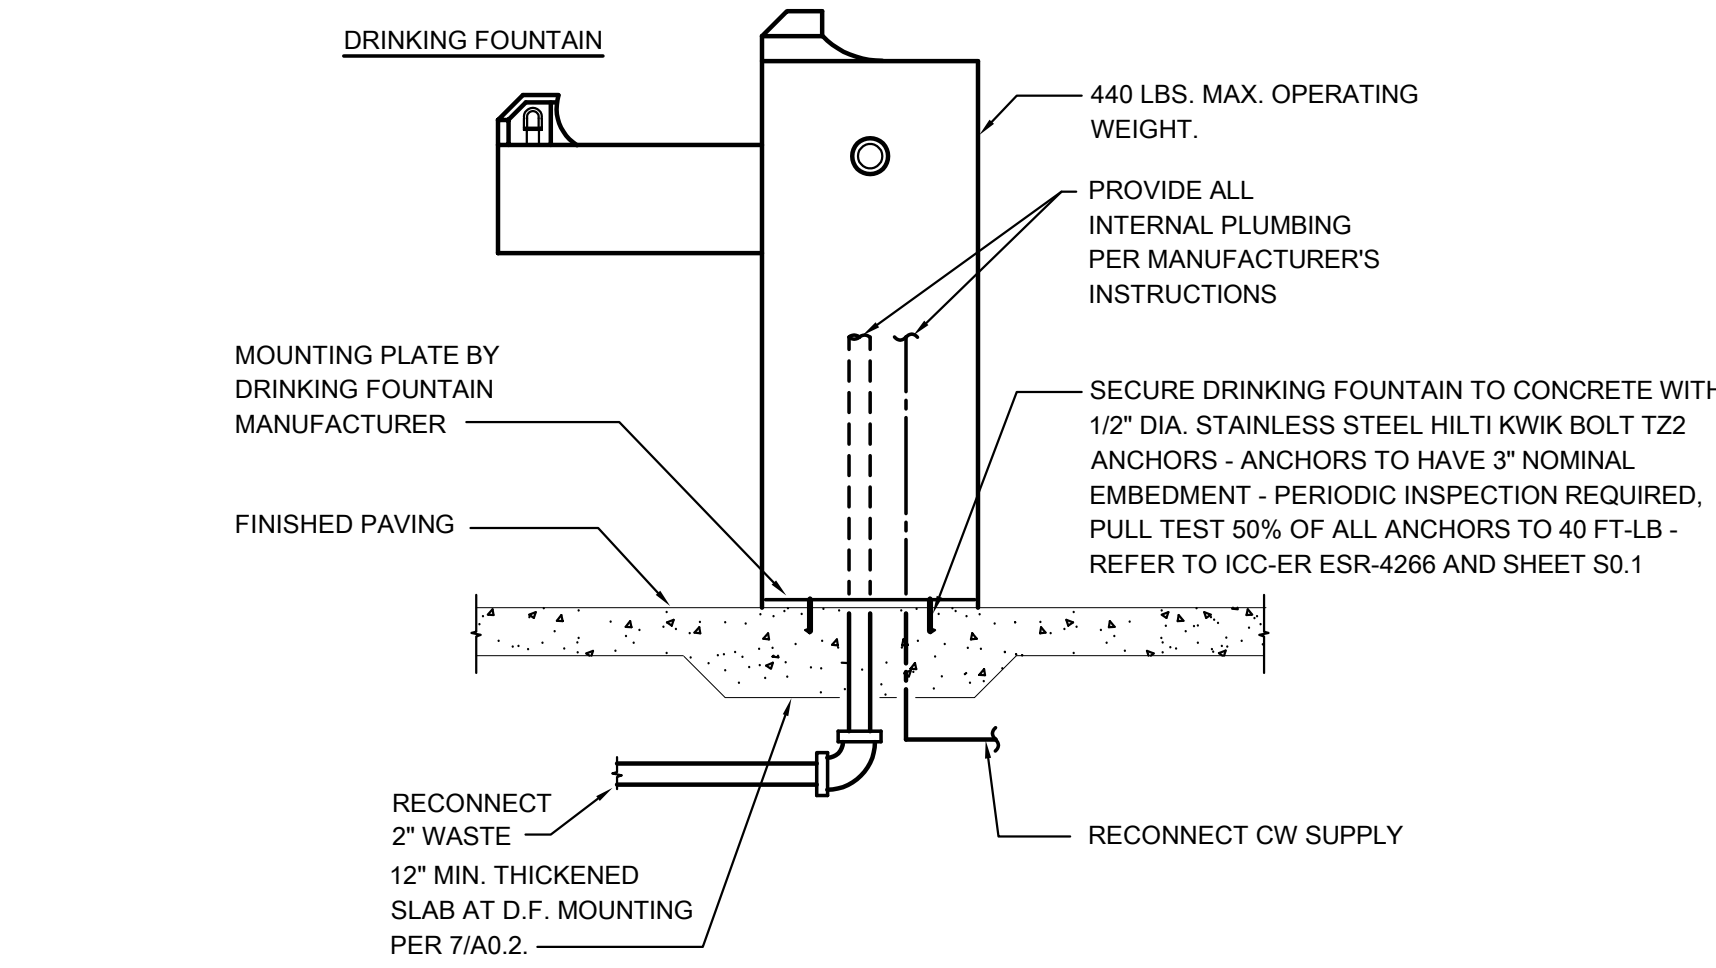

DRINKING FOUNTAIN DETAIL

SCALE : NONE

3 P5.1

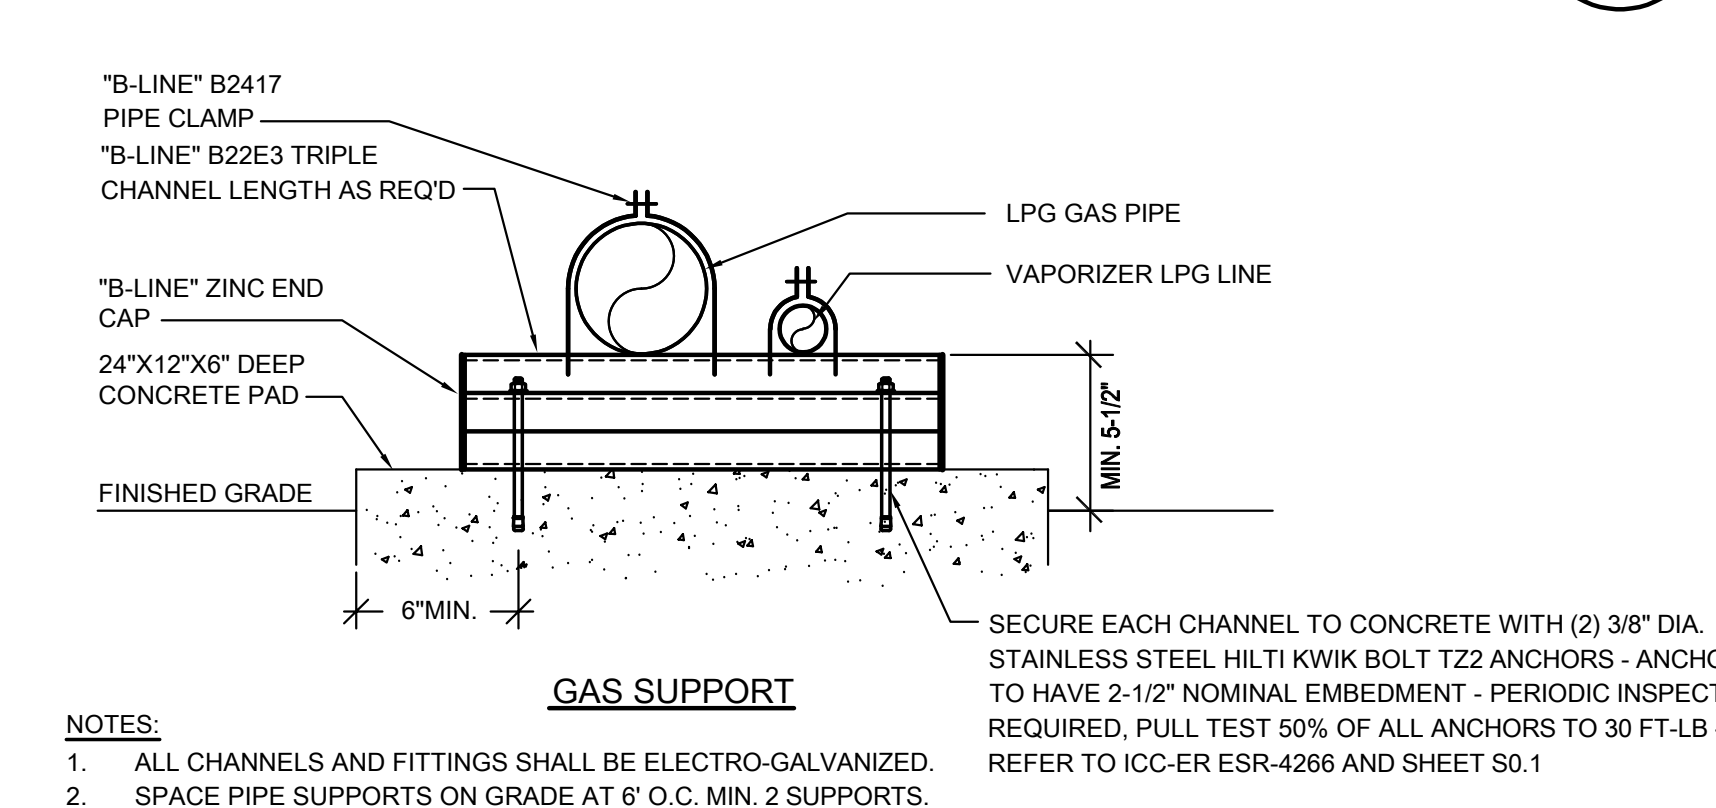

PIPE SUPPORT MOUNTING

SCALE : NONE

4 P5.1



RANCHO CORDOVA, CALIFORNIA
MM - RL 220210.00
PM - DESIGN TEAM PROJECT NO.

IDENTIFICATION STAMP
DIV. OF THE STATE ARCHITECT
APP: 02-120455 INC:
REVIEWED FOR
SS ☒ FLS ☒ ACS ☒
DATE: 01/12/2023

730 Howe Avenue, Suite 450
Sacramento, CA 95825
Phone: 916.921.2112
Fax: 916.921.2212



MODERNIZATION LAKEWOOD
ELEMENTARY SCHOOL

PLUMBING -
DETAILS

CONSULTANT		
DATE SIGNED: 12/20/2022		
PROJECT NO. 21-32-052	REVISIONS	BY
DATE 3/28/2022		
DRAWN MS		
CHECKED JCBS		
SCALE AS SHOWN		
CADFILE		
UPDATED 11/17/2022		
SHEET NO.		

P5.1

All changes to these plans must be in writing and must be approved by M. Neils Engineering, Inc.

ABBREVIATIONS	
A	AMPERES
AC	ALTERNATING CURRENT
A.F.F.	ABOVE FINISHED FLOOR
A.I.C.	AMPERE INTERRUPTING CAPACITY
AMP	AMPERE
AWG	AMERICAN WIRE GAUGE
BKR	BREAKER
C.	CONDUIT
C.B.	CIRCUIT BREAKER
CKT	CIRCUIT
CLG.	CEILING
C.O.	CONDUIT ONLY, WITH PULL WIRE
DC	DIRECT CURRENT
(E)	EXISTING
(ER)	EXISTING RELOCATED
EMT	ELECTRICAL METALLIC CONDUIT
(F)	FUTURE
GA.	GAUGE
GND	GROUND
GFCI	GROUND FAULT CIRCUIT INTERRUPTER
HP	HORSEPOWER
HVAC	HEATING, VENTILATING AND AIR CONDITIONING
Isc	SHORT CIRCUIT AMPERES
ISO	ISOLATED
K	THOUSAND
KV	KILO VOLT
KVA	KILO VOLT AMPERE
KW	KILO WATT
MAX.	MAXIMUM
MFR.	MANUFACTURER
MIN.	MINIMUM
MTD.	MOUNTED
N	NEUTRAL
(N)	NEW
NEMA	NATIONAL ELECTRICAL MANUFACTURERS ASSOCIATION
N.I.C.	NOT IN CONTRACT
PFB	PROVISIONS FOR FUTURE CIRCUIT BREAKER
PH	PHASE
(R)	REMOVE
(RE)	RELOCATE EXISTING
RCPT.	RECEPTACLE
S.M.S	SHEET METAL SCREW
SWBD	SWITCHBOARD
SYS	SYSTEM
TYP.	TYPICAL
UG	UNDERGROUND
UL	UNDERWRITERS LABORATORY
V	VOLT
VA	VOLT-AMPERES
W	WIRE, WATT
WP	WEATHER PROTECTED
XFMR	TRANSFORMER

ELECTRICAL SYMBOL LIST	
	ENCLOSED LUMINAIRE - CEILING LAY-IN
	EXISTING LUMINAIRE TO BE REMOVED
	SWITCH, +45° AFF - "a,b" LETTER DENOTES MULTI-SWITCH FUNCTION, TYPICAL FOR ALL SWITCHES, MOTION SENSORS AND DAYLIGHT SENSORS UNLESS NOTED OTHERWISE. "K" DENOTES SINGLE POLE TOGGLE SWITCH.
	DIMMER ON/OFF SWITCH - +45°AFF.
	OCCUPANCY SENSOR SWITCH WITH MANUAL OVERRIDE - WALL MOUNTED AT +45° AFF UNLESS NOTED OTHERWISE
	OCCUPANCY AREA SENSOR SWITCH - CEILING MOUNTED OS = OCCUPANCY SENSOR; PC = PHOTOCELL; DL = DAYLIGHT
	JUNCTION BOX - SIZE AS REQUIRED BY CODE
	DUPLEX CONVENIENCE OUTLET - NEMA 5-20R +18" A.F.F. TYPICAL FOR ALL CONVENIENCE OUTLETS, UNLESS NOTED OTHERWISE. LETTERS SHOWN ADJACENT TO OUTLET DESIGNATE THE FOLLOWING: "A" - HORIZONTAL ABOVE COUNTER
	GFCI DUPLEX CONVENIENCE OUTLET - NEMA 5-20R
	QUADPLEX CONVENIENCE OUTLET - NEMA 5-20R, +18" A.F.F. UNLESS NOTED OTHERWISE. LETTER "A" SHOWN ADJACENT TO OUTLET DESIGNATES MOUNTED ABOVE COUNTER.
	SPECIAL RECEPTACLE AS SHOWN ON PLANS
	DATA OUTLET, +18" A.F.F. UNLESS NOTED OTHERWISE. LETTER "A" SHOWN ADJACENT TO OUTLET DESIGNATES MOUNTED ABOVE COUNTER, "BC" DESIGNATES OUTLET MOUNTED ON WALL JUST BELOW CEILING.
	SPEAKER - WALL MOUNTED
	CLOCK OUTLET/CLOCK - WALL MOUNTED
	CONDUIT RUN CONCEALED IN CEILINGS OR WALLS. NUMBER OF HASH MARKS DENOTES QUANTITY OF WIRES. CURVED HASH MARK DENOTES QUANTITY OF #12 GREEN GROUND WIRES. CONDUCTORS OTHER THAN #12 ARE INDICATED ON PLANS. NO HASH MARKS DENOTES 2 #12 AWG AND 1 #12 GREEN GROUND IN 1/2" CONDUIT. TYPICAL FOR ALL CONDUITS.
	FLEXIBLE CONDUIT CONCEALED. NUMBER OF HASH MARKS DENOTES QUANTITY OF WIRES. CURVED HASH MARK DENOTES QUANTITY OF #12 GREEN GROUND WIRES. CONDUCTORS OTHER THAN #12 ARE INDICATED ON PLANS. NO HASH MARKS DENOTES 2 #12 AWG AND 1 #12 GREEN GROUND IN 1/2" MINIMUM DIAMETER CONDUIT.
	CONDUIT RUN UNDERFLOOR OR UNDERGROUND MINIMUM 1" DIAMETER.
	CONDUIT HOMERUN TO PANELBOARD, SWITCHBOARD OR TERMINAL CABINET
	CONDUIT TURNED AND RISED UP
	CONDUIT TURNED AND DROPPED DOWN
	CONDUIT WITH CAP
	CONDUIT STUB WITH INSULATED BUSHING
	EXISTING CONDUIT AND WIRING
	EXISTING PANELBOARD - SURFACE MOUNTED
	EXISTING PANELBOARD - FLUSH MOUNTED
	TERMINAL CABINET
	SWITCHBOARD, DISTRIBUTION PANEL, OR MOTOR CONTROL CENTER
	EQUIPMENT DISCONNECT SWITCH - EXTERNALLY OPERATED, FUSED WITH FUSE SIZE INDICATED
	EQUIPMENT DISCONNECT SWITCH - EXTERNALLY OPERATED, NON-FUSIBLE
	EQUIPMENT CONTROLLER
	EQUIPMENT MOTOR POWER CONNECTIONS PART OF ELECTRICAL WORK
	UNDERGROUND PULLBOX. SEE PLANS FOR BOX SIZE (BASED ON CHRISTY PRODUCTS) AND
	MECHANICAL EQUIPMENT DESIGNATION - SEE MECHANICAL PLANS
	DRAWING SHEET NUMBERED NOTE DESIGNATION - APPLIES TO NUMBERED NOTE ON SAME SHEET
	DRAWING PLAN OR DETAIL DESIGNATION - "1" OR "A" DENOTES PLAN OR DETAIL NUMBER, "E-1" DENOTES SHEET NUMBER
SYMBOL LIST NOTES:	
1. EXISTING ELECTRICAL EQUIPMENT, OUTLETS, AND DEVICES ARE SHOWN THE SAME AS NEW, EXCEPT LIGHTLY AND ACCOMPANIED BY (E). SUCH ELECTRICAL EQUIPMENT, OUTLETS, AND DEVICES ARE TO REMAIN AS IS, UNLESS OTHERWISE NOTED ON PLAN OR SPECIFICATION.	
2. VERIFY ON SITE THAT ALL PANELBOARDS HAVE MINIMUM WORKING SPACES PER CODE AND THAT THE DEDICATED PANELBOARD SPACES ARE CLEAR OF ALL DUCTS, PIPING AND EQUIPMENT FOREIGN TO THE PANEL BOARDS. NOTIFY THE ENGINEER FOR CORRECTIVE ACTION IN THE EVENT THAT FOREIGN OBJECTS IMPEDE THE DEDICATED PANELBOARD AREAS.	

DEMOLITION GENERAL NOTES

1. INFORMATION SHOWN RELATIVE TO EXISTING CONDITIONS IS BASED UPON AVAILABLE RECORDS AND DATA. THEREFORE, IT SHALL BE REGARDED AS AN APPROXIMATION ONLY. CONTRACTOR AGREES THAT IN ACCORDANCE WITH GENERALLY ACCEPTED CONSTRUCTION PRACTICES, CONTRACTOR WILL BE REQUIRED TO ASSUME SOLE AND COMPLETE RESPONSIBILITY FOR JOB SITE CONDITIONS DURING THE COURSE OF CONSTRUCTION OF THE PROJECT. PRIOR TO SUBMITTING BID AND/OR BEFORE START OF ANY ELECTRICAL WORK, INSPECT ALL EXISTING LOCATIONS AND CONDITIONS AND ASCERTAIN WORK REQUIRED TO CLEAR PROJECT AREA OF ALL EXISTING ELECTRICAL ITEMS NOT BEING REUSED OR EXISTING TO REMAIN AS IS. REPORT ALL DISCREPANCIES AND COORDINATE ALL DEMOLITION WORK WITH THE OWNER'S REPRESENTATIVE. MAINTAIN SERVICE TO EXISTING ELECTRICAL EQUIPMENT IN AREAS ADJACENT TO REMODEL AREA, UNLESS OTHERWISE NOTED.
2. PROTECT ALL EXISTING ELECTRICAL AND FIRE ALARM EQUIPMENT ON EXISTING WALLS AND CEILINGS NOT REQUIRED TO BE DEMOLISHED UNLESS OTHERWISE NOTED. DELIVER ALL EXISTING ELECTRICAL EQUIPMENT IN REMODELED AREAS, THAT ARE REMOVED AND NOT REUSED ELSEWHERE, AND ARE DEEMED TO BE SALVAGEABLE IN THE JUDGMENT OF THE CONTRACTOR AND OWNER'S REPRESENTATIVE, TO THE OWNER. DELIVER ALL SALVAGED ELECTRICAL EQUIPMENT AND OTHER ITEMS TO A LOCATION DESIGNATED BY THE OWNER'S REPRESENTATIVE. REMOVE FROM SITE, ALL OTHER ELECTRICAL EQUIPMENT, HARDWARE, AND OTHER ITEMS THAT ARE DEEMED UNSALVAGEABLE BY CONTRACTOR AND THE OWNER'S REPRESENTATIVE.
3. CUT, PATCH AND MATCH IN ALL AREAS AFFECTED BY REMOVAL OF ELECTRICAL EQUIPMENT AND DEVICES.
4. CAUSE AS LITTLE INTERFERENCE OR INTERRUPTION OF EXISTING UTILITIES AND SERVICES AS POSSIBLE. SCHEDULE ANY POWER OR OTHER UTILITY SHUTDOWN WITH THE OWNER'S REPRESENTATIVE. SHUTDOWNS WHICH MAY BE REQUIRED SHALL BE PRESENTED IN WRITING TO THE OWNER'S REPRESENTATIVE FOR APPROVAL TWO WEEKS PRIOR TO COMMENCEMENT OF WORK. SHUTDOWN WORK SHALL BE PERFORMED ON OVERTIME HOURS IF SO DIRECTED BY OWNER'S REPRESENTATIVE.
5. DISCONNECT AND REMOVE ALL EXISTING ELECTRICAL EQUIPMENT, FIXTURES, OUTLETS, DEVICES, CONDUIT, WIRING AND OTHER ELECTRICAL ITEMS, WHETHER SHOWN OR NOT, FROM EXISTING CEILINGS AND WALLS WHICH ARE TO BE DEMOLISHED. MAINTAIN CIRCUIT CONTINUITY TO ALL EXISTING REMAINING DEVICES, UNLESS OTHERWISE NOTED.
6. COORDINATE WITH OTHER TRADES AND PROMPTLY TRANSMIT ALL INFORMATION REQUIRED BY THEM. COORDINATE THE SEQUENCE OF DEMOLITION WITH OTHER TRADES TO ENSURE THAT ALL WORK PROCEEDS WITH A MINIMUM OF INTERFERENCE AND DELAY.
7. RELOCATE ALL CONDUITS THAT ARE TO REMAIN IN SERVICE WHICH ARE IN A LOCATION TO CONFLICT WITH NEW WORK.
8. WHEREVER EXISTING ELECTRICAL DEVICES, PANELS, CONDUITS, CABLES, AND OTHER ITEMS, CONFLICT WITH REMODEL WORK, WHETHER SHOWN OR NOT, RELOCATE THESE ITEMS TO COORDINATE WITH NEW CONSTRUCTION.
9. REUSE EXISTING CONDUITS AND WIRING WHEREVER POSSIBLE UNLESS OTHERWISE NOTED TO BE REMOVED.
10. PROVIDE FIRE RATED BACKBOXES TO MAINTAIN FIRE RATING OF CEILING OR WALLS AT LOCATIONS WHERE RECESSED ELECTRICAL EQUIPMENT SUCH AS LIGHT FIXTURES, SWITCHES, RECEPTACLES, PANELS, AND OTHER ITEMS, ARE INSTALLED IN RATED WALLS OR CEILINGS.
11. PROVIDE PROTECTIVE COVERING OVER EXISTING EQUIPMENT WHEN INSTALLING ALL NEW WORK.
12. PROVIDE NEW PANEL DIRECTORIES FOR EXISTING PANELS INVOLVED IN THIS RENOVATION WORK, REFLECTING ALL CHANGES TO CIRCUIT DESIGNATIONS.
13. ASBESTOS REMOVAL: IN THE EVENT ASBESTOS IS FOUND TO BE PRESENT IN AREAS CONFLICTING WITH ELECTRICAL WORK, BEFORE CONTINUATION OF WORK IN THOSE AREAS, NOTIFY THE OWNER'S REPRESENTATIVE FOR THE REMOVAL OF SUCH HAZARDOUS MATERIAL BY A CERTIFIED ASBESTOS CONTRACTOR.
14. CIRCUIT NUMBERS AND CIRCUITING BASED UPON AS-BUILTS. ACTUAL CONDITION MAY VARY. TRACE AND VERIFY ALL CIRCUITS SHOWN ARE AVAILABLE FOR DEMOLITION AND REUSE AS NEEDED DURING THE REMODEL PHASE. DOCUMENT ALL CHANGES ON AS-BUILT DRAWINGS.

MEP COMPONENT ANCHORAGE NOTE

MEP COMPONENT ANCHORAGE NOTE

ALL MECHANICAL, PLUMBING, AND ELECTRICAL COMPONENTS SHALL BE ANCHORED AND INSTALLED PER THE DETAILS ON THE DSA APPROVED CONSTRUCTION DOCUMENTS, WHERE NO DETAIL IS INDICATED, THE FOLLOWING COMPONENTS SHALL BE ANCHORED OR BRACED TO MEET THE FORCE AND DISPLACEMENT REQUIREMENTS PRESCRIBED IN THE 2019 CBC, SECTIONS 1617A.1.18 THROUGH 1617A.1.26 AND ASCE 7-16 CHAPTER 13, 26, AND 30.

1. ALL PERMANENT EQUIPMENT AND COMPONENTS
2. TEMPORARY OR MOVABLE EQUIPMENT THAT IS PERMANENTLY ATTACHED (E.G. HARD WIRED) TO THE BUILDING UTILITY SERVICES SUCH AS ELECTRICITY, GAS OR WATER.
3. MOVABLE EQUIPMENT WHICH IS STATIONED IN ONE PLACE FOR MORE THAN 8 HOURS AND HEAVIER THAN 400 POUNDS OR HAS A CENTER OF MASS LOCATED 4 FEET OR MORE ABOVE THE ADJACENT FLOOR OR ROOF LEVEL THAT DIRECTLY SUPPORT THE COMPONENT ARE REQUIRED TO BE ANCHORED WITH TEMPORARY ATTACHMENTS.

THE FOLLOWING MECHANICAL AND ELECTRICAL COMPONENTS SHALL BE POSITIVELY ATTACHED TO THE STRUCTURE, BUT THE ATTACHMENT NEED NOT BE DETAILED ON THE PLANS. THESE COMPONENTS SHALL HAVE FLEXIBLE CONNECTIONS PROVIDED BETWEEN THE COMPONENT AND ASSOCIATED DUCTWORK, PIPING AND CONDUIT.

- A. COMPONENTS WEIGHING LESS THAN 400 POUNDS AND HAVE A CENTER OF MASS LOCATED 4 FEET OR LESS ABOVE THE ADJACENT FLOOR OR ROOF LEVEL THAT DIRECTLY SUPPORT THE COMPONENT.
- B. COMPONENTS WEIGHING LESS THAN 20 POUNDS, OR IN THE CASE OF DISTRIBUTED SYSTEMS, LESS THAN 5 POUNDS PER FOOT, WHICH ARE SUSPENDED FROM A ROOF OR FLOOR OR HUNG FROM A WALL.

FOR THOSE ELEMENTS THAT DO NOT REQUIRE DETAILS ON THE APPROVED DRAWINGS, THE INSTALLATION SHALL BE SUBJECT TO THE APPROVAL OF THE DESIGN PROFESSIONAL IN GENERAL, RESPONSIBLE CHARGE OR STRUCTURAL ENGINEER DELEGATED RESPONSIBILITY AND THE DSA DISTRICT STRUCTURAL ENGINEER. THE PROJECT INSPECTOR WILL VERIFY THAT ALL COMPONENTS AND EQUIPMENT HAVE BEEN ANCHORED IN ACCORDANCE WITH THE ABOVE REQUIREMENTS.

PIPING, DUCTWORK AND ELECTRICAL DISTRIBUTION SYSTEM BRACING NOTE

PIPING, DUCTWORK AND ELECTRICAL DISTRIBUTION SYSTEM SHALL BE BRACED TO COMPLY WITH THE FORCES AND DISPLACEMENTS PRESCRIBED IN ASCE 7-16 SECTION 13.3 AS DEFINED IN ASCE 7-16 SECTION 13.6.5, 13.6.6, 13.6.7, 13.6.8, AND 2019 CBC, SECTIONS 1616A.1.24, 1616A.1.25, AND 1616A.1.26.

THE METHOD OF SHOWING BRACING AND ATTACHMENTS TO THE STRUCTURE FOR THE IDENTIFIED DISTRIBUTION SYSTEM ARE AS NOTED WHEN. BRACING BRACING AND ATTACHMENTS ARE BASED ON A PREAPPROVED INSTALLATION GUIDE (E.G. SMACNA OR OSHPD OPM). COPIES OF THE BRACING SYSTEM INSTALLATION GUIDE OR MANUAL SHALL BE AVAILABLE ON THE JOBSITE PRIOR TO THE START AND DURING THE HANGING AND BRACING OF THE DISTRIBUTION SYSTEMS. THE STRUCTURAL ENGINEER OF RECORD SHALL VERIFY THE ADEQUACY OF THE STRUCTURE TO SUPPORT THE HANGER AND BRACE LOADS.


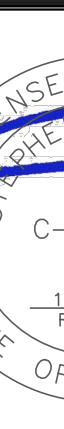

MECHANICAL PIPING (MP), MECHANICAL DUCTS (MD), PLUMBING PIPING (PP), ELECTRICAL DISTRIBUTION SYSTEMS (E):


MP|MD|PP|E| - OPTION 1 : DETAILED ON THE APPROVED DRAWINGS WITH PROJECT SPECIFIC NOTES AND DETAILS.

MP|MD|PP|E| - OPTION 2: SHALL COMPLY WITH THE APPLICABLE OSHPD PRE-APPROVED (OPM #)

[illegible]



LUMINAIRE SCHEDULE					
TYPE	MANUFACTURER CATALOG NO.	VOLTAGE DESCRIPTION	LIGHT SOURCE (LED, WATTS, LUMENS, COLOR TEMPERATURE, CRI, R9 IF AVAILABLE)	MOUNTING	REMARK NOTE NO.
A	WILLIAMS P26 P26-1-4-L45-9-35-PA-DIM-120	120V LED 1x4 SURFACE	LED, 33.7W, 3500K, 90CRI	SURFACE	
B	WILLIAMS 39 39-4-L30-9-35-A	120V LED 1x4 SURFACE	LED, 22.8W, 3500K, 90CRI	SURFACE	
P1	Gardco P26-48L-400-NW-G2-AR-3-120-CS50	120V SINGLE PureForm LED P26	LED, 60W, 8827LM, 4000K, 70CRI	POLE	
	Gardco SRS-CB-5-11-25-D1-DT5	25 FT STRAIGHT ROUND STEEL POLE			
P2	Gardco PureForm LED P26 P26-48L-400-NW-G2-AR-3-120-CS50	120V TWIN PureForm LED P26	LED, 60W, 8827LM 4000K, 70CRI	POLE	
	Gardco SRS-CB-5-11-25-D2-DT5	25 FT STRAIGHT ROUND STEEL POLE			
<u>LUMINAIRE SCHEDULE REMARK NOTES:</u> <u>GENERAL NOTE:</u> REFER TO PLAN FOR LOCATION, QUANTITIES, AND SWITCH FUNCTION.					

<div>IDENTIFICATION STAMP DIV. OF THE STATE ARCHITECT APP: 02-120455 INC: REVIEWED FOR SS <input checked="" type="checkbox"/> FLS <input checked="" type="checkbox"/> ACS <input checked="" type="checkbox"/> DATE: 01/12/2023</div>		
730 Howe Avenue, Suite 450 Sacramento, CA 95825 Phone: 916.921.2112 Fax: 916.921.2212		
<div>HENRY+ ASSOCIATES ARCHITECTS</div>		
<div></div>		
MODERNIZATION LAKEWOOD ELEMENTARY SCHOOL ELECTRICAL SHEET INDEX, SYMBOL LIST, ABBREVIATIONS AND NOTES		
CONSULTANT		
<div> 01/04/2023</div>		
PROJECT NO. 21-32-052	REVISIONS	BY
DATE 3/28/2022		
DRAWN MNE		
CHECKED SKL		
SCALE AS NOTED		
CADFILE		
UPDATED 11/17/2022		
SHEET NO. E0.1		

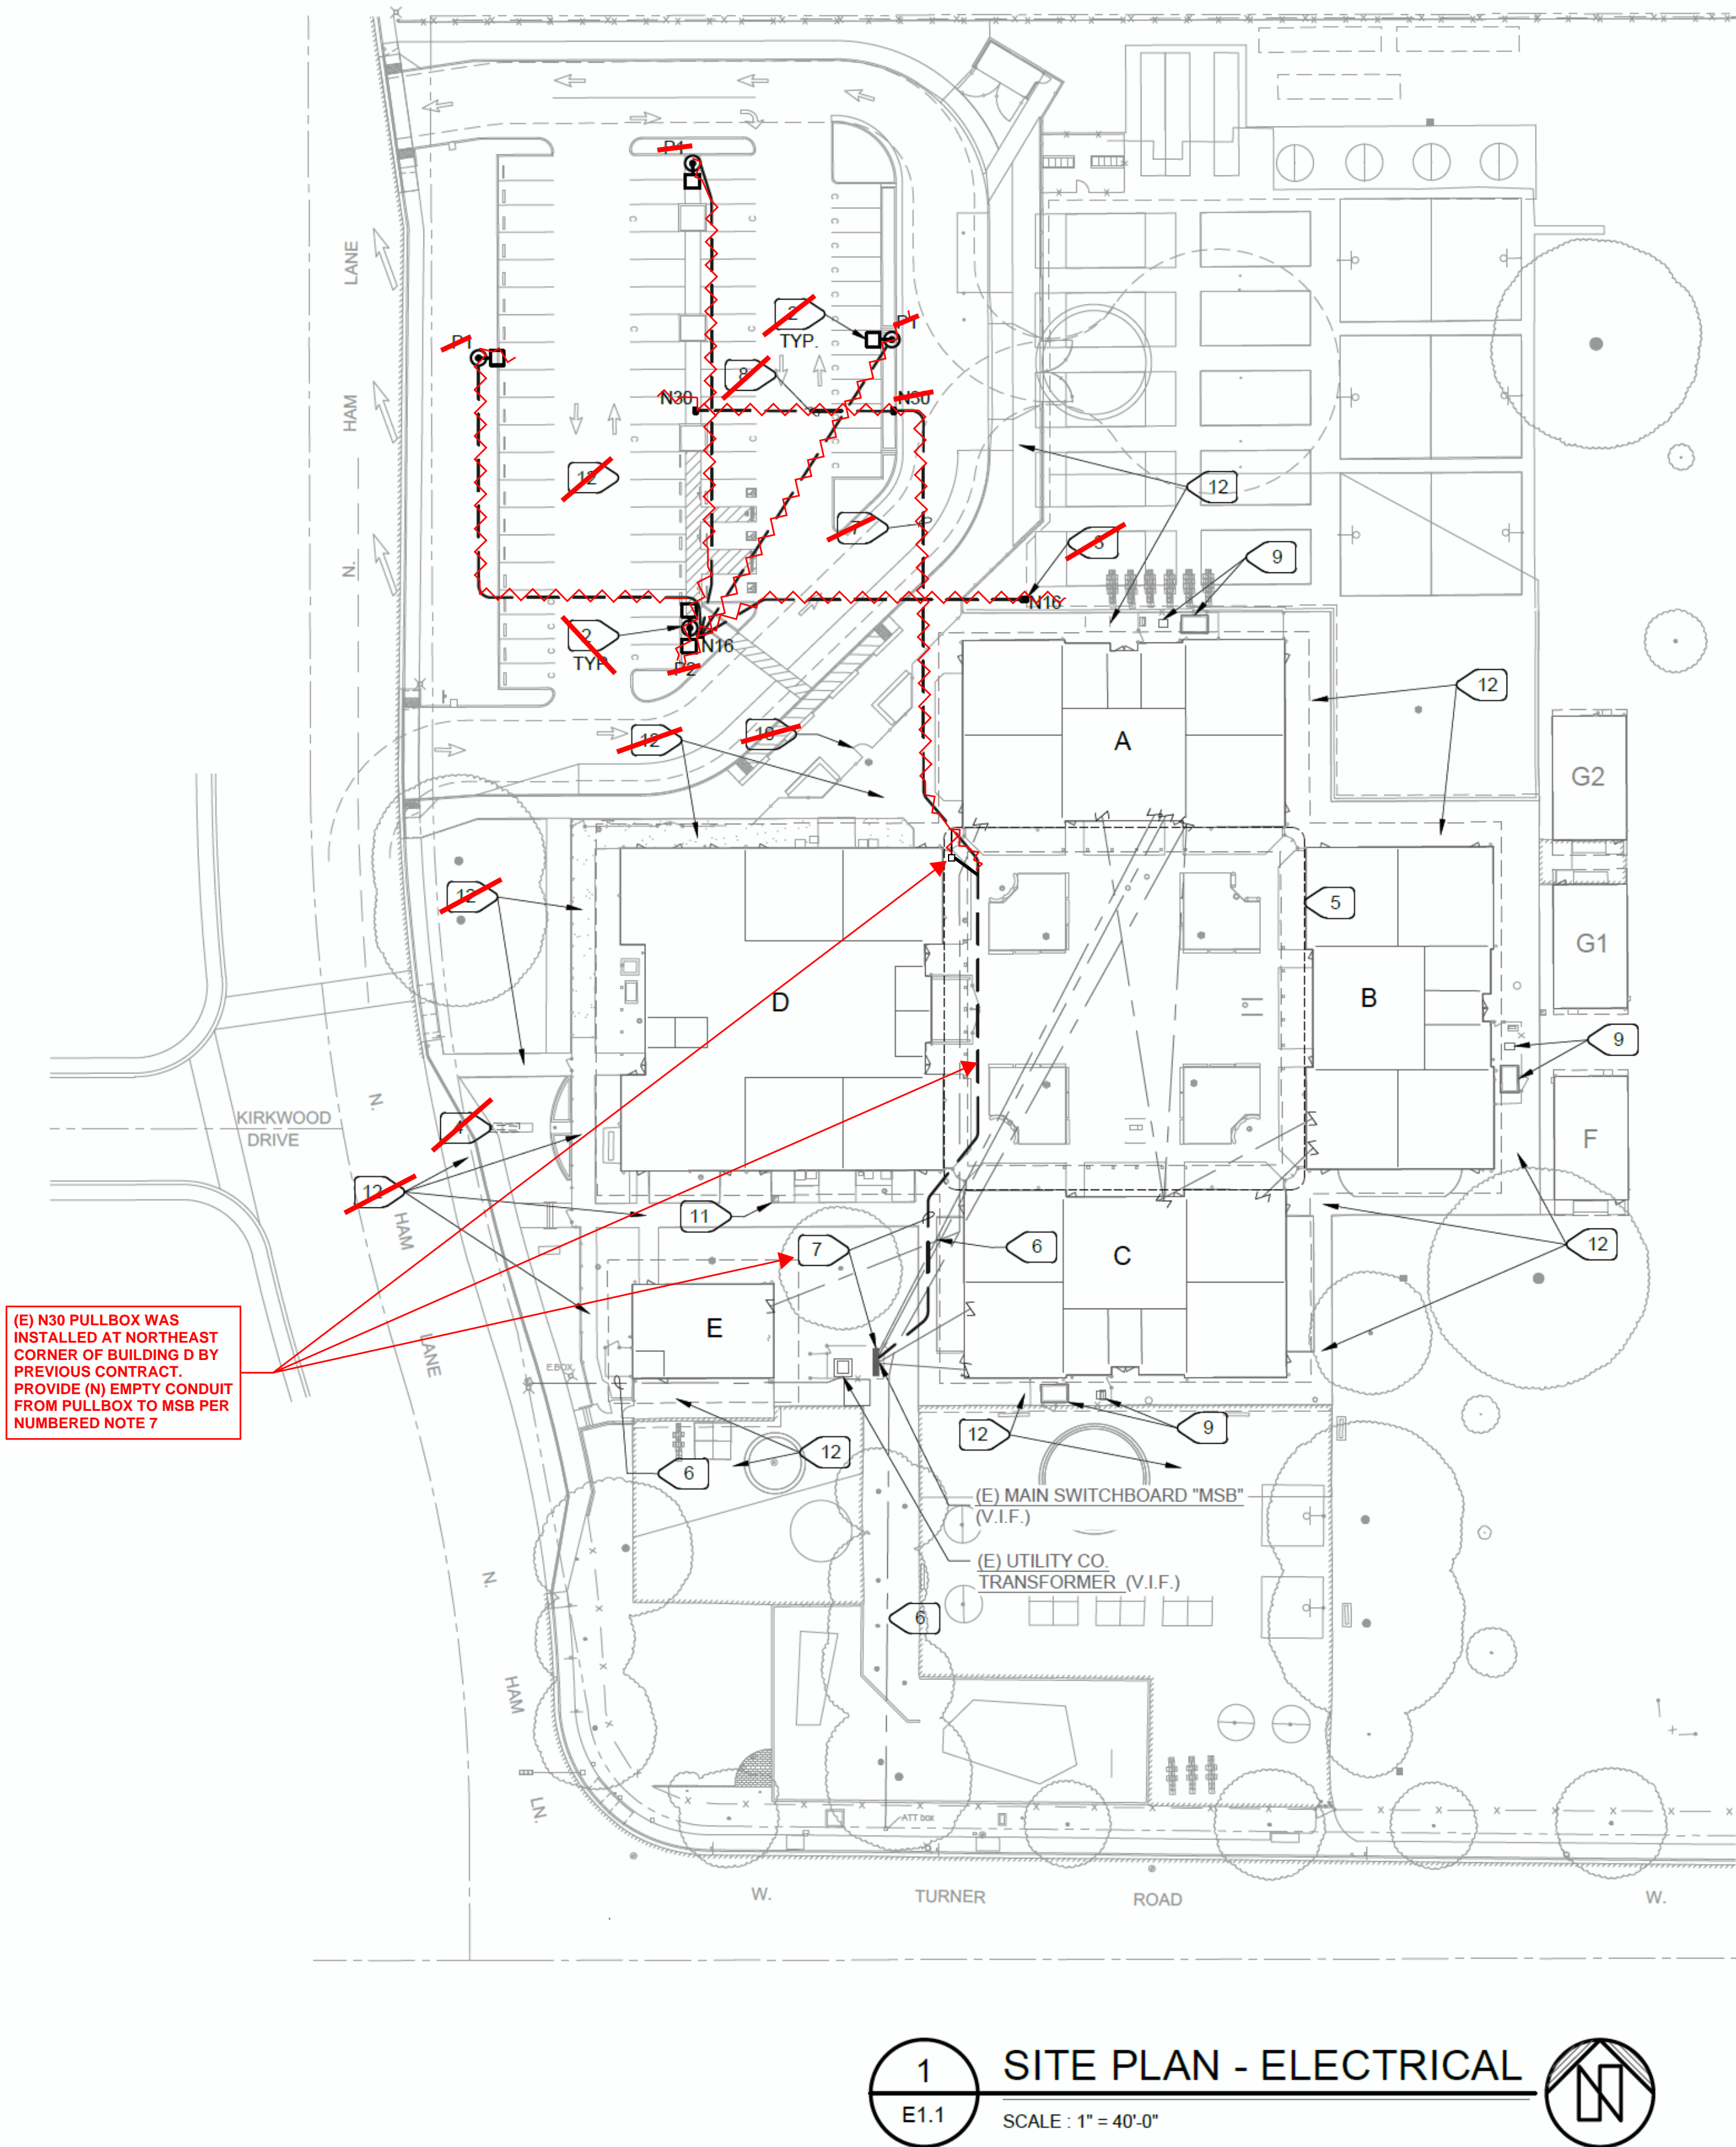

- ### NUMBERED NOTES
- ~~1 REMOVE (E) POLE LIGHT. REMOVE CONDUIT TO EXTENT OF DEMOLITION. REMOVE WIRING BACK TO BUILDING "A".~~
 - ~~2 POLE MOUNTED FIXTURE. SEE LUMINAIRE SCHEDULE. PROVIDE POLE PER 5/E4.1. TYPICAL FOR "P1" AND "P2" TYPE FIXTURE. CONTROLS TO BE INTEGRATED INTO PELICAN CONTROL SYSTEM AND SITE EMS.~~
 - ~~3 PROVIDE (N) PULLBOX OVER (E) CONDUIT. PROVIDE (N) #12 WIRING FROM BUILDING "A" (REFER TO NUMBERED NOTE 1). CONNECT (N) POLE LIGHTS TO (E) CIRCUIT. (E) LIGHTING CIRCUIT IS CONTROLLED BY (E) EMS SYSTEM. INSURE CORRECT WIRING & TEST (N) LIGHTING.~~
 - ~~4 (E) SCHOOL SIGN TO BE REMOVED. ELECTRICAL CONTRACTOR TO DISCONNECT AND TO PROTECT POWER/L.V. FOR REINSTALLATION BY OTHERS.~~
 - 5 (N) QUAD AREA. PROTECT (E) CONDUIT DURING DEMOLITION AND CONSTRUCTION. CONTRACTOR SHALL USA AREA BEFORE START OF DEMOLITION.
 - 6 (E) CONDUIT - PROTECT DURING DEMOLITION AND CONSTRUCTION. CONTRACTOR SHALL USA AREA BEFORE START OF DEMOLITION.
 - 7 (2) 3" O.D. FOR FUTURE E.V. CHARGERS, FROM MAIN SWITCHBOARD TO PULLBOXES AS SHOWN. PROVIDE PULL ROPE AND SEAL CONDUITS.
 - ~~8 3" O.D. FOR FUTURE E.V. CHARGERS. PROVIDE PULL ROPE AND SEAL CONDUIT.~~
 - 9 (E) HVAC UNIT. ELECTRICAL CONTRACTOR SHALL TEMPORARY SUPPORT (E) EXPOSED CONDUITS/CONDUCTORS TO UNITS TO ALLOW NEW CONCRETE WALKWAY TO BE INSTALLED. AFTER (N) CONCRETE IS IN PLACE REINSTALL (E) CONDUIT/CONDUCTORS TO NEW WALKWAY/CONCRETE.
 - ~~10 RELOCATED GATE. ELECTRICAL CONTRACTOR TO CAREFULLY DISCONNECT (E) CARD READER AND GATE OPENER. EXTEND (E) CONDUITS TO (N) GATE LOCATION AND REINSTALL (E) CARD READER AND GATE OPENER. CARD READER SHALL BE INSTALLED TO 48" MAX. A.G. PROVIDE (N) WIRING FROM (N) GATE LOCATION TO HEAD END OF CARD READER/GATE OPENER. NO UNDERGROUND SPLICING OF CARD READER/GATE OPENER WIRES.~~
 - 11 (E) PULLBOX. PROTECT DURING DEMOLITION AND ADJUST TO (N) CONCRETE WALKWAY GRADE. BOX SHALL BE FLUSH WITH (N) CONCRETE WALKWAY.
 - 12 SEE ARCHITECTURAL AND CIVIL DRAWINGS FOR (N) CONCRETE WALKWAYS AND (N) ASPHALTIC CONCRETE PAVING. ELECTRICAL CONTRACTOR SHALL USA THIS AREA BEFORE ANY DEMOLITION STARTS. IDENTIFY (E) U.G. INFRASTRUCTURE AND COORDINATE WITH DEMOLITION CONTRACTOR TO PROTECT (E) U.G. INFRASTRUCTURE. ANY DAMAGED CONDUITS/CONDUCTORS SHALL BE REPLACED WITH (N) AND AFFECTED ELECTRICAL SYSTEM SHALL BE TESTED AND BROUGHT TO COMPLETELY WORKING CONDITION. (E) PULLBOXES SHALL BE ADJUSTED TO BE FLUSH WITH (N) SURFACES.

PROJECT NO.	REVISIONS	BY
21-32-052		
DATE		
3/28/2022		
DRAWN		
MNE		
CHECKED		
SKL		
SCALE		
AS NOTED		
CADFILE		
UPDATED		
11/17/2022		
SHEET NO.		

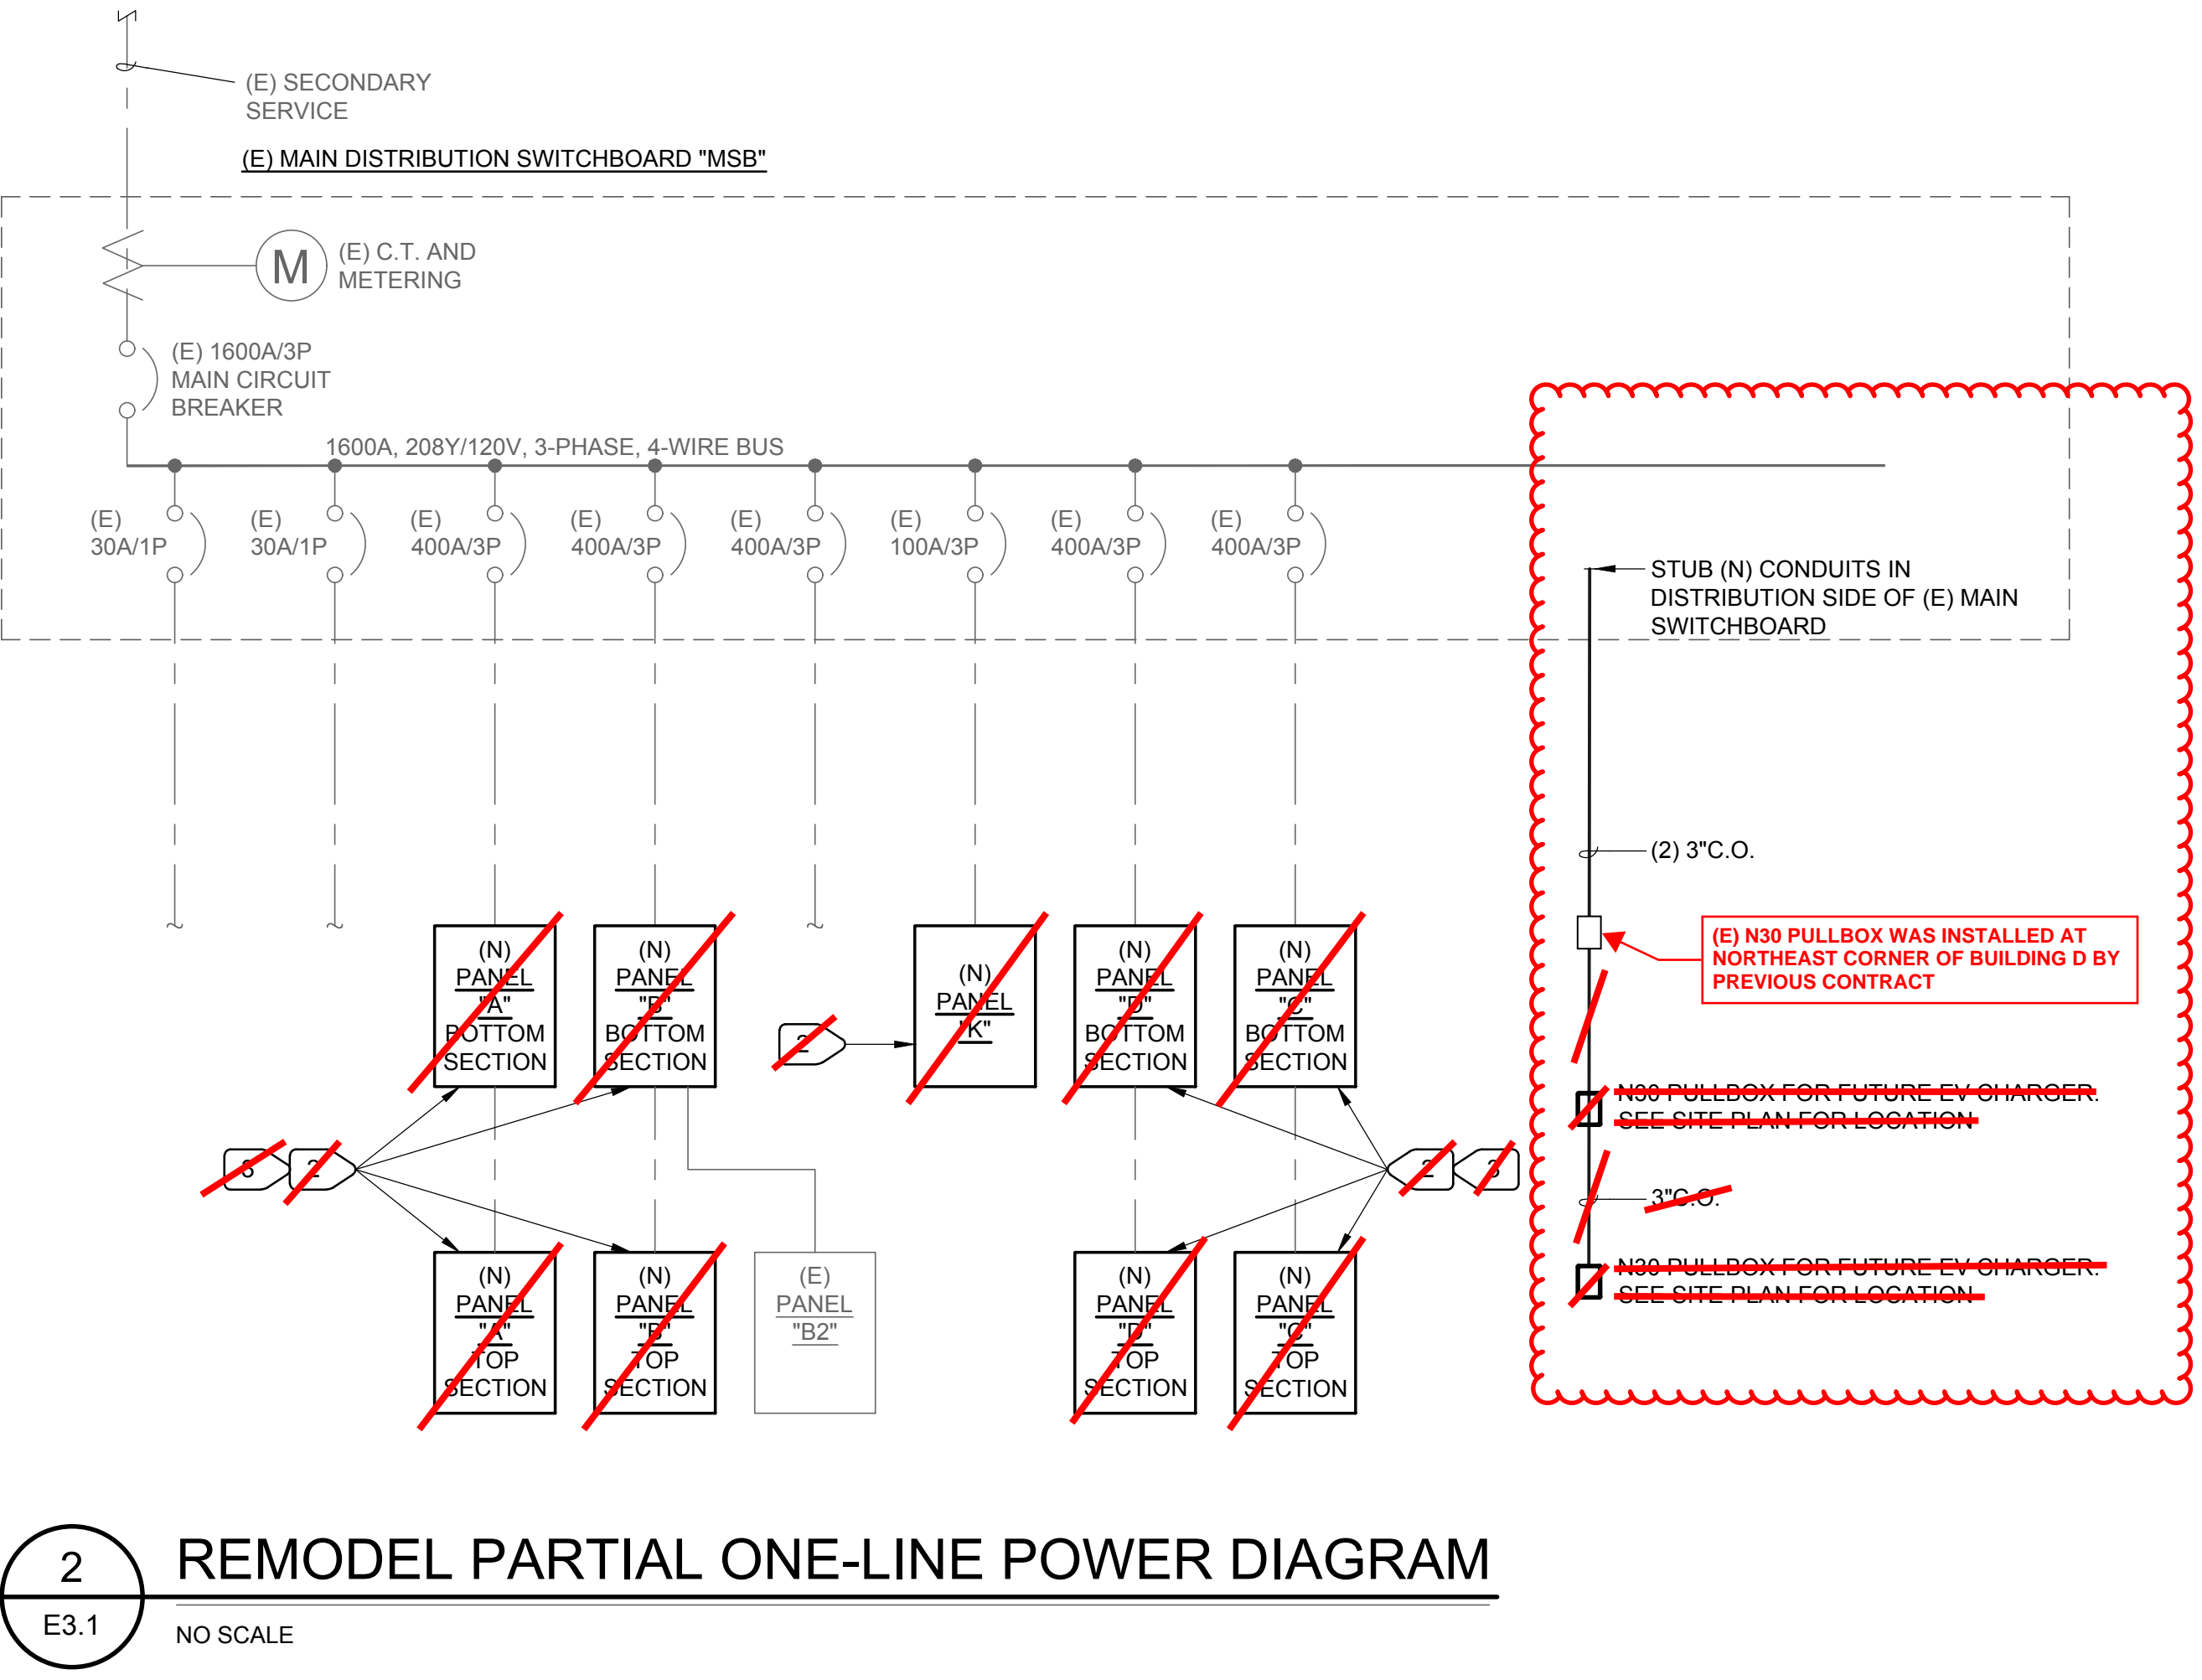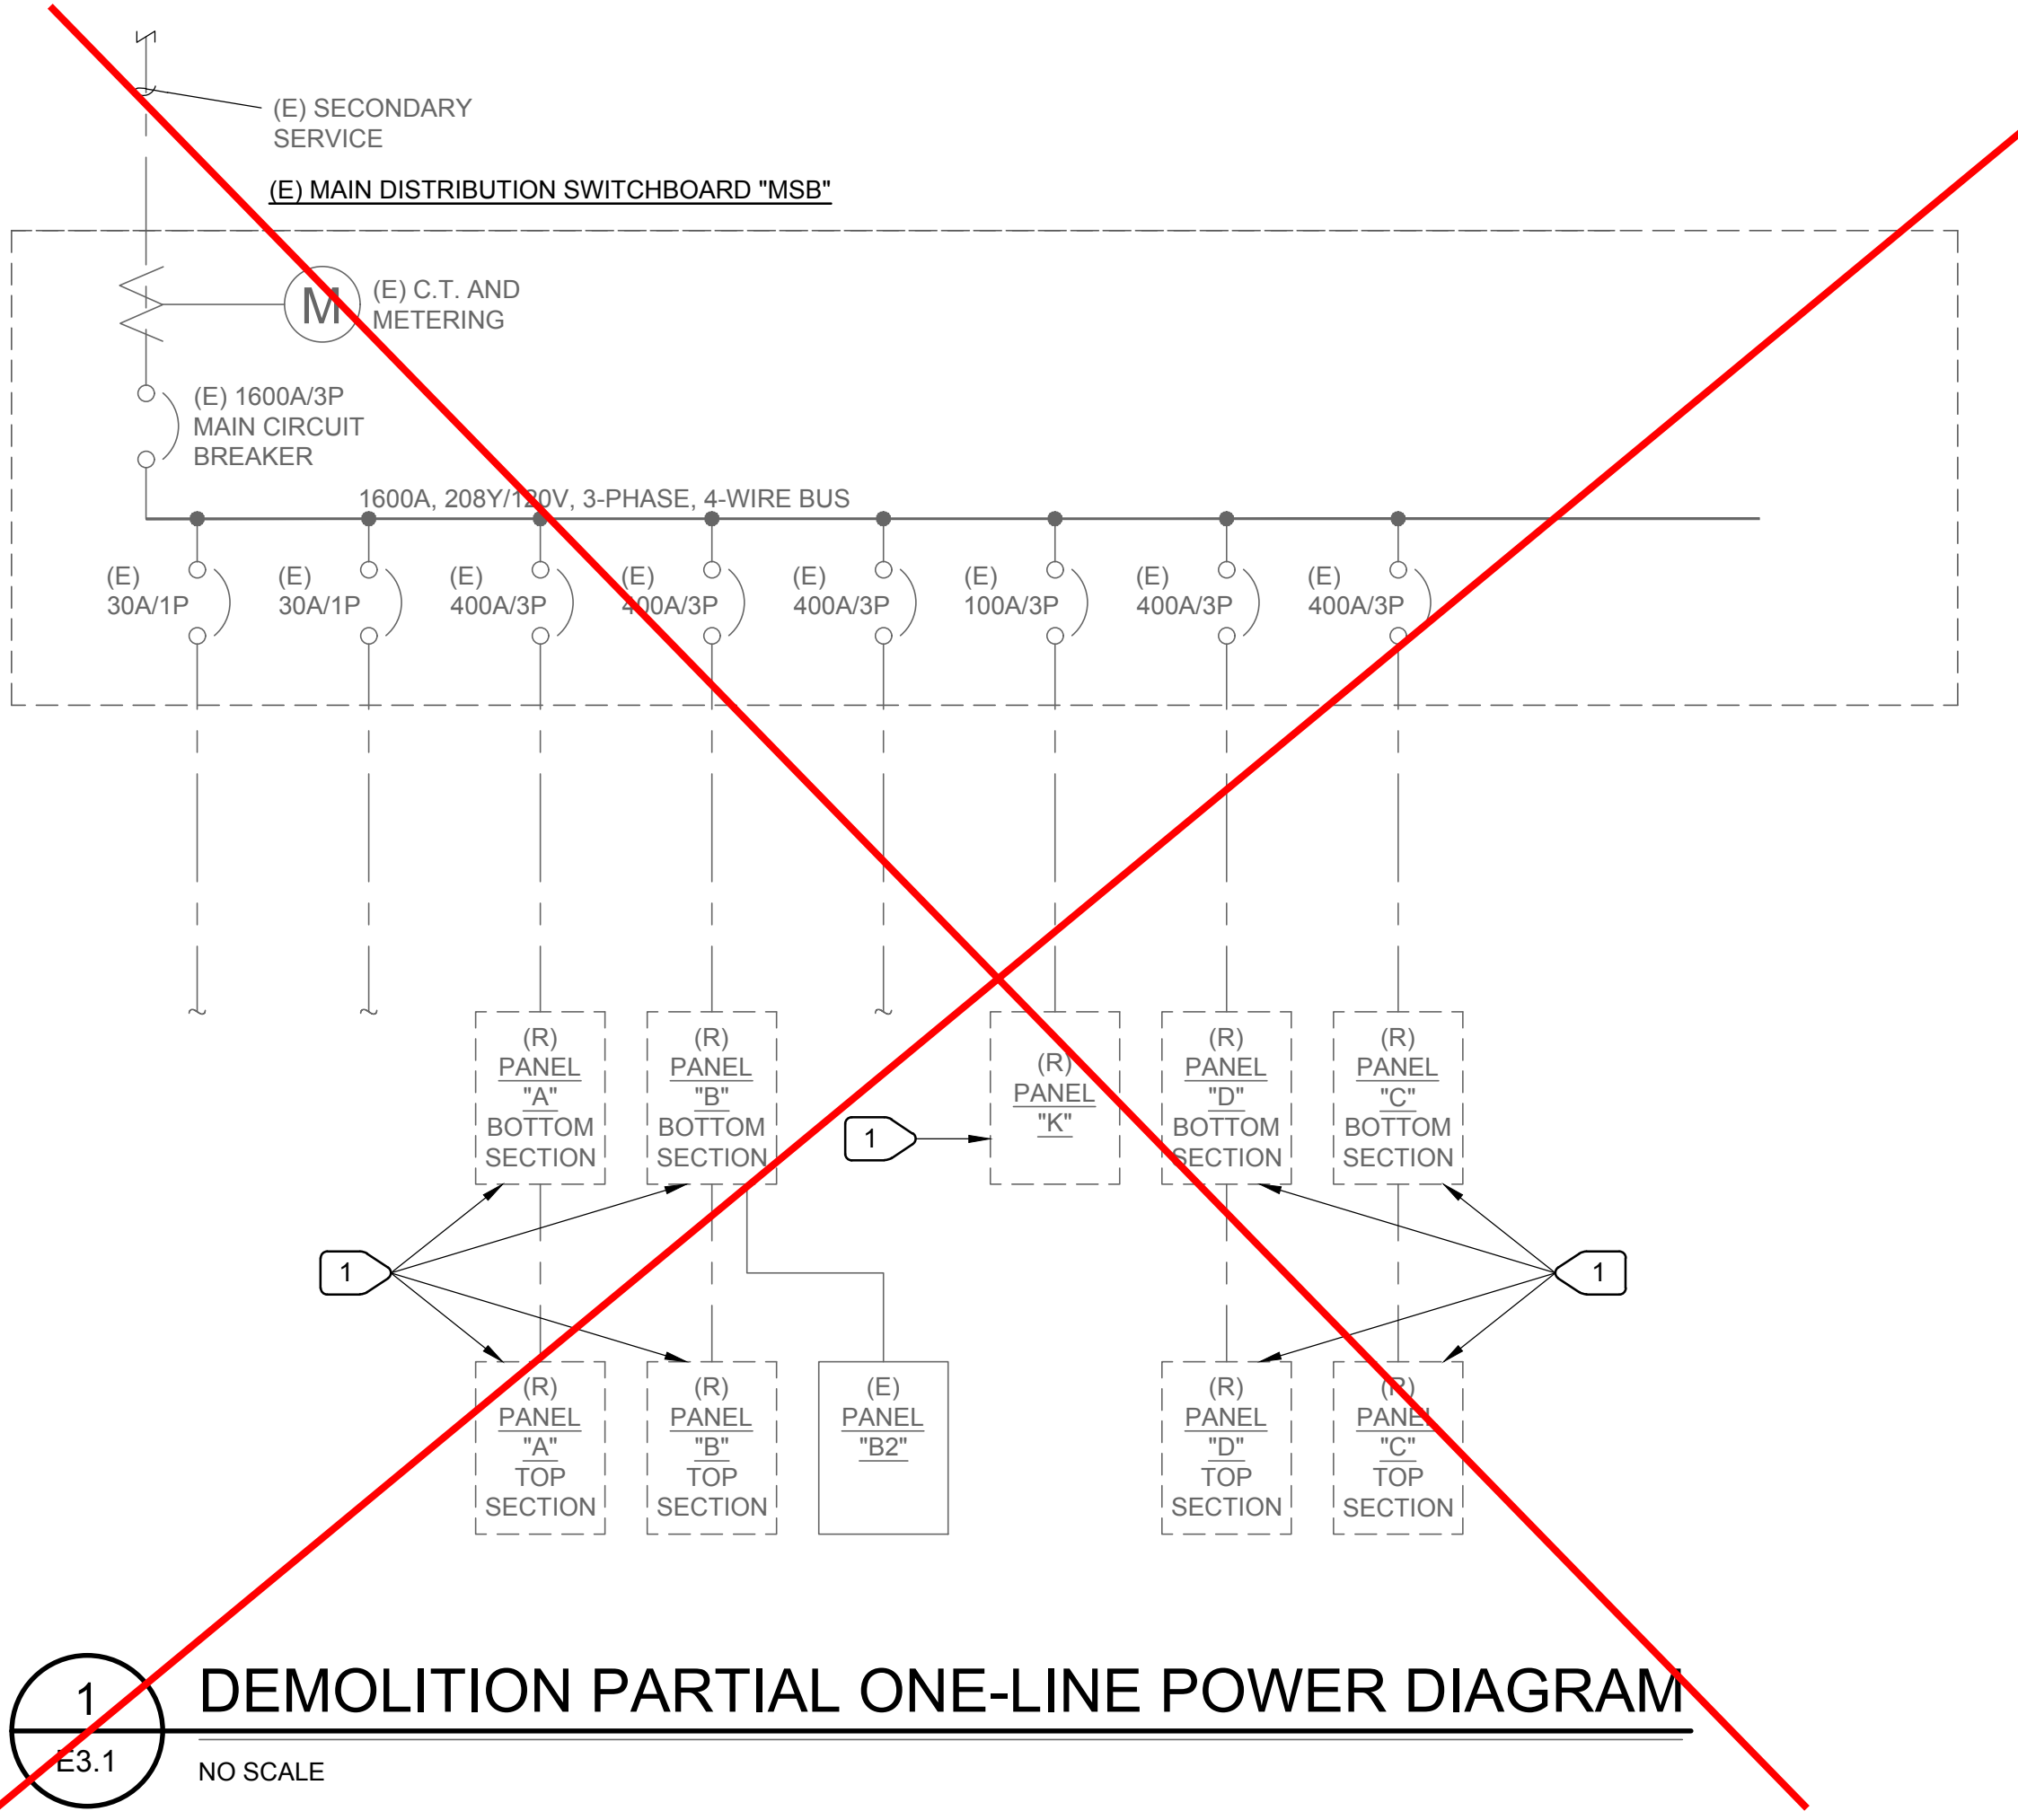

- NUMBERED NOTES
- 1

EXISTING WESTINGHOUSE PANEL TO BE REMOVED AND REPLACED WITH NEW SQUARE D PANEL. EXISTING SUPPLY FEEDER AND EXISTING LOAD SIDE CIRCUITRY AND CONDUITS TO BE REUSED. PROTECT EXISTING WIRING AND CONDUITS DURING PANEL REMOVAL.
- 2

NEW SQUARE D PANEL MATCH EXISTING PANEL CHARACTERISTICS. RECONNECT TO EXISTING SUPPLY FEEDER. RECONNECT ALL EXISTING LOAD CIRCUITS USING EXISTING CIRCUITRY. REFER TO PANEL SCHEDULE.
- 3

ELECTRICAL CONTRACTOR SHALL ENSURE THAT (N) PANELS ARE OF SIMILAR DIMENSIONS AS EXISTING REMOVED PANELS. ELECTRICAL CONTRACTOR SHALL WORK WITH SUPPLIER TO PROVIDE SIMILAR SIZE OF (N) PANELS BEFORE ORDERING (N) PANELS.

IDENTIFICATION STAMP
DIV. OF THE STATE ARCHITECT
APP: 02-120455 INC:
REVIEWED FOR
SS ☒ FLS ☒ ACS ☒
DATE: 01/12/2023

730 Howe Avenue, Suite 450
Sacramento, CA 95825
Phone: 916.921.2112
Fax: 916.921.2212

HENRY+
ASSOCIATES
ARCHITECTS

REGISTERED ARCHITECT
STEPHEN J. BASTIAN
C-22525
12/31/23
RENEWAL
DATE
STATE OF CALIFORNIA

MODERNIZATION LAKEWOOD
ELEMENTARY SCHOOL
PARTIAL ONE-LINE
POWER DIAGRAMS






CONSULTANT

REGISTERED PROFESSIONAL ENGINEER
JESSE U. BASTIAN
No. E20229
Exp. 03-31-23
ELECTRICAL
STATE OF CALIFORNIA

01/04/2023


PROJECT NO. 21-32-052	REVISIONS	BY
DATE 3/28/2022		
DRAWN MNE		
CHECKED SKL		
SCALE AS NOTED		
CADFILE		
UPDATED 11/17/2022		
SHEET NO.		

E3.1

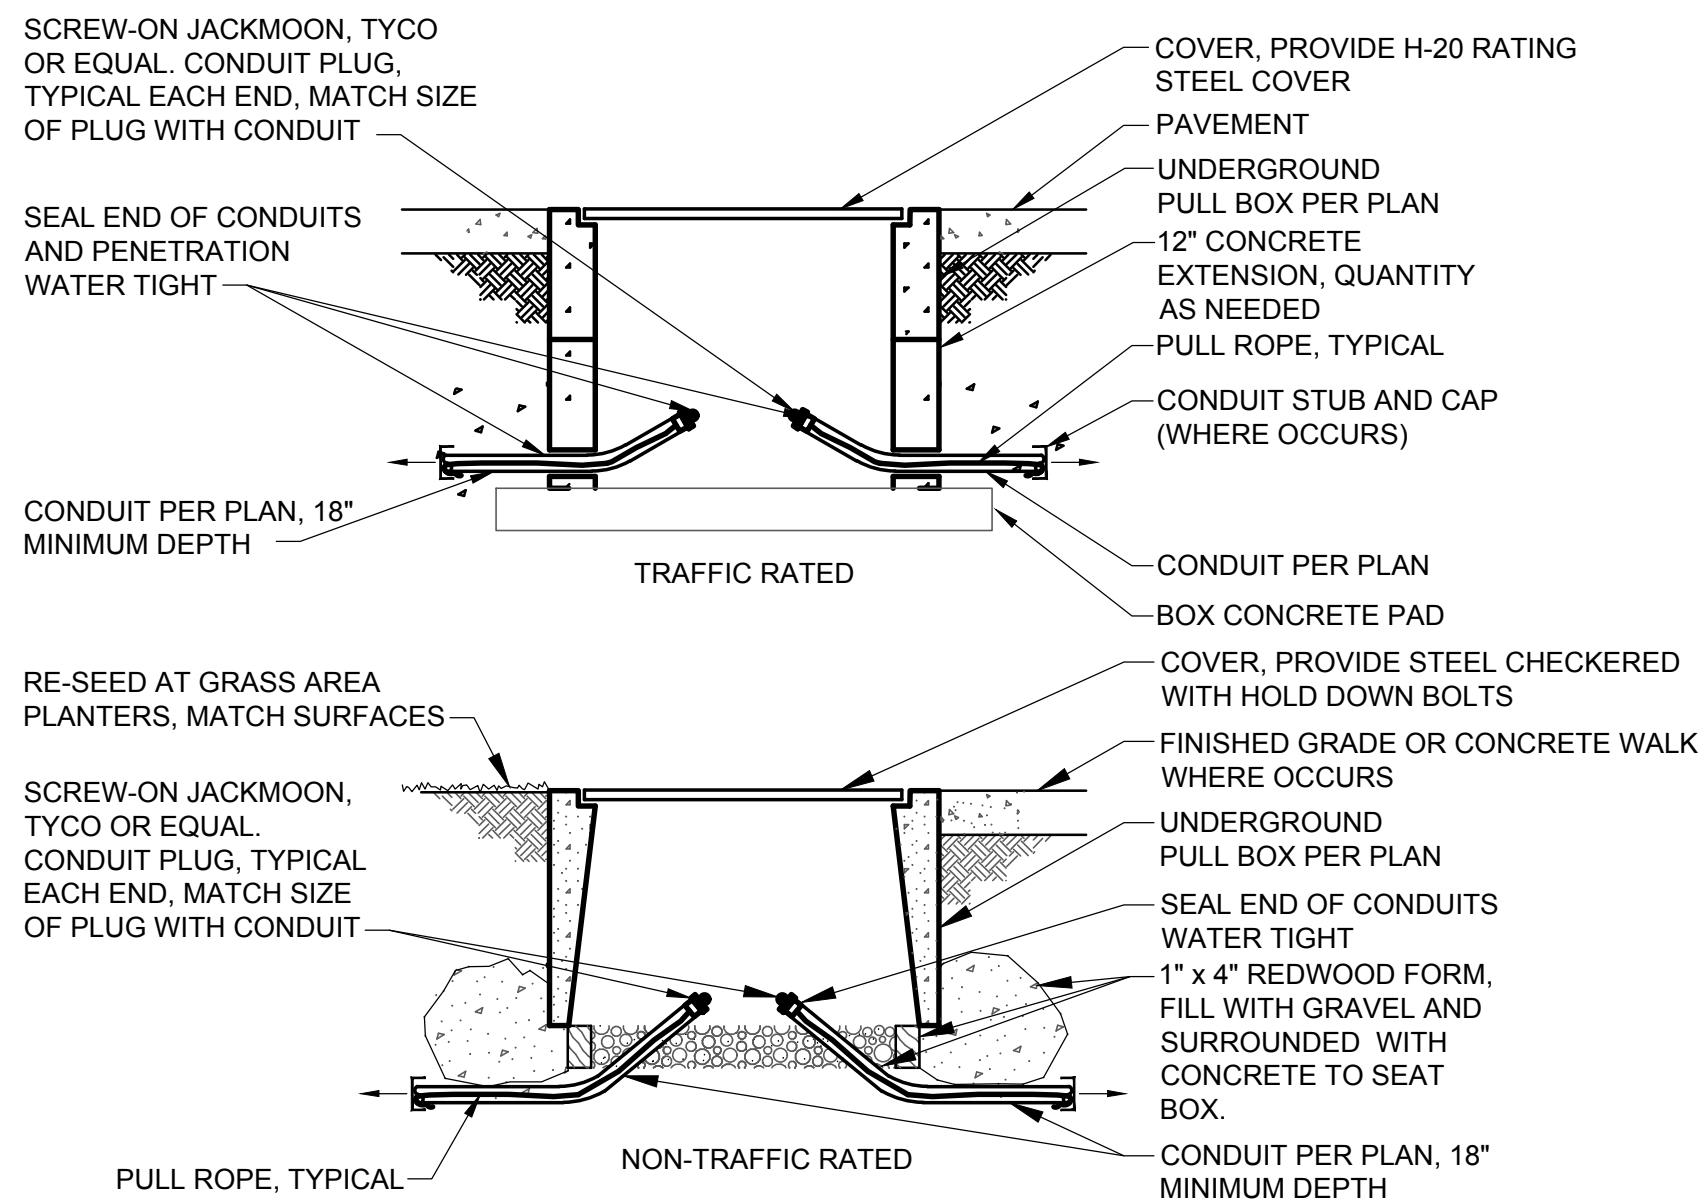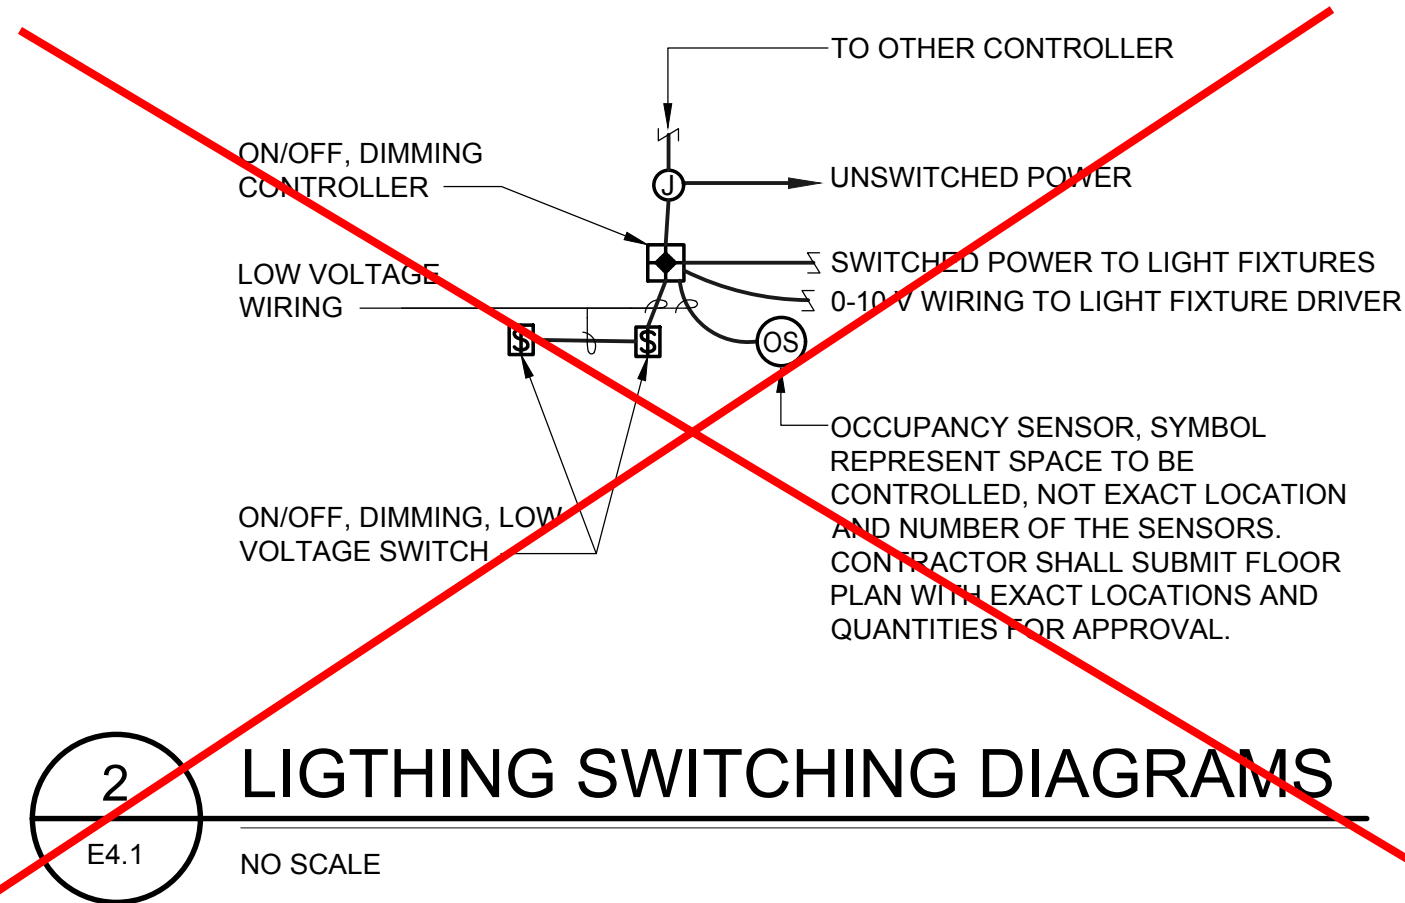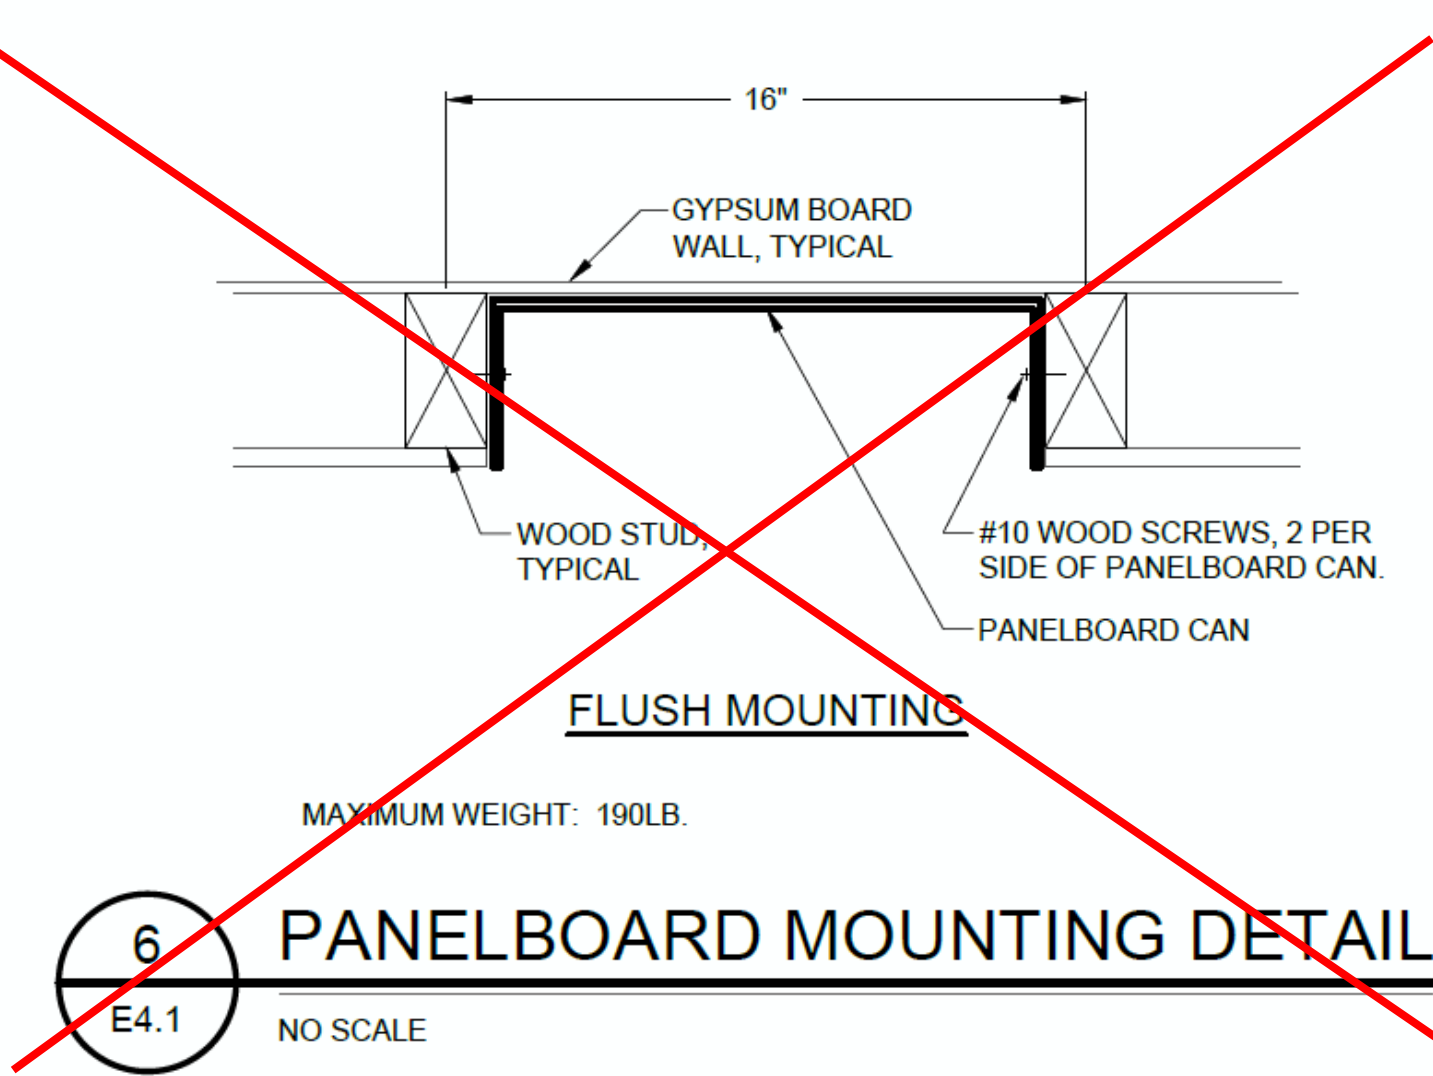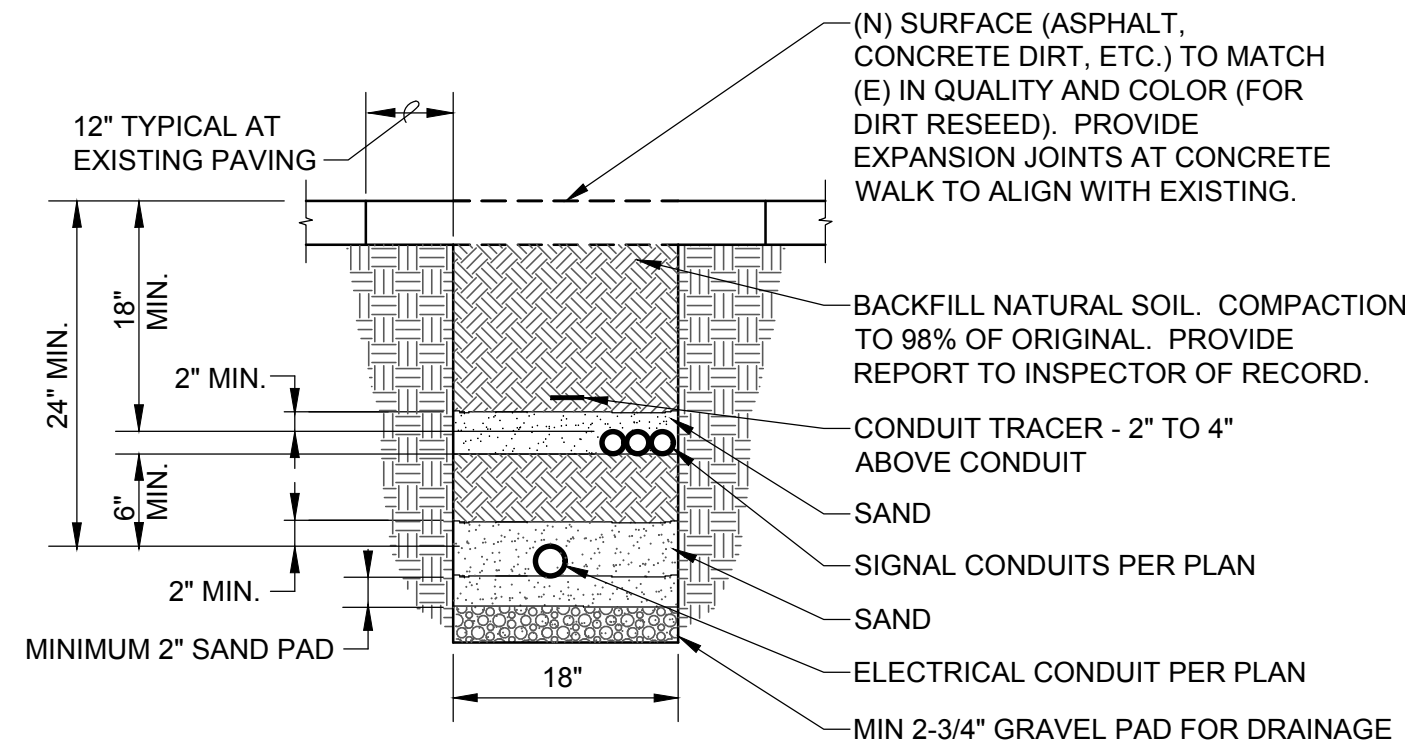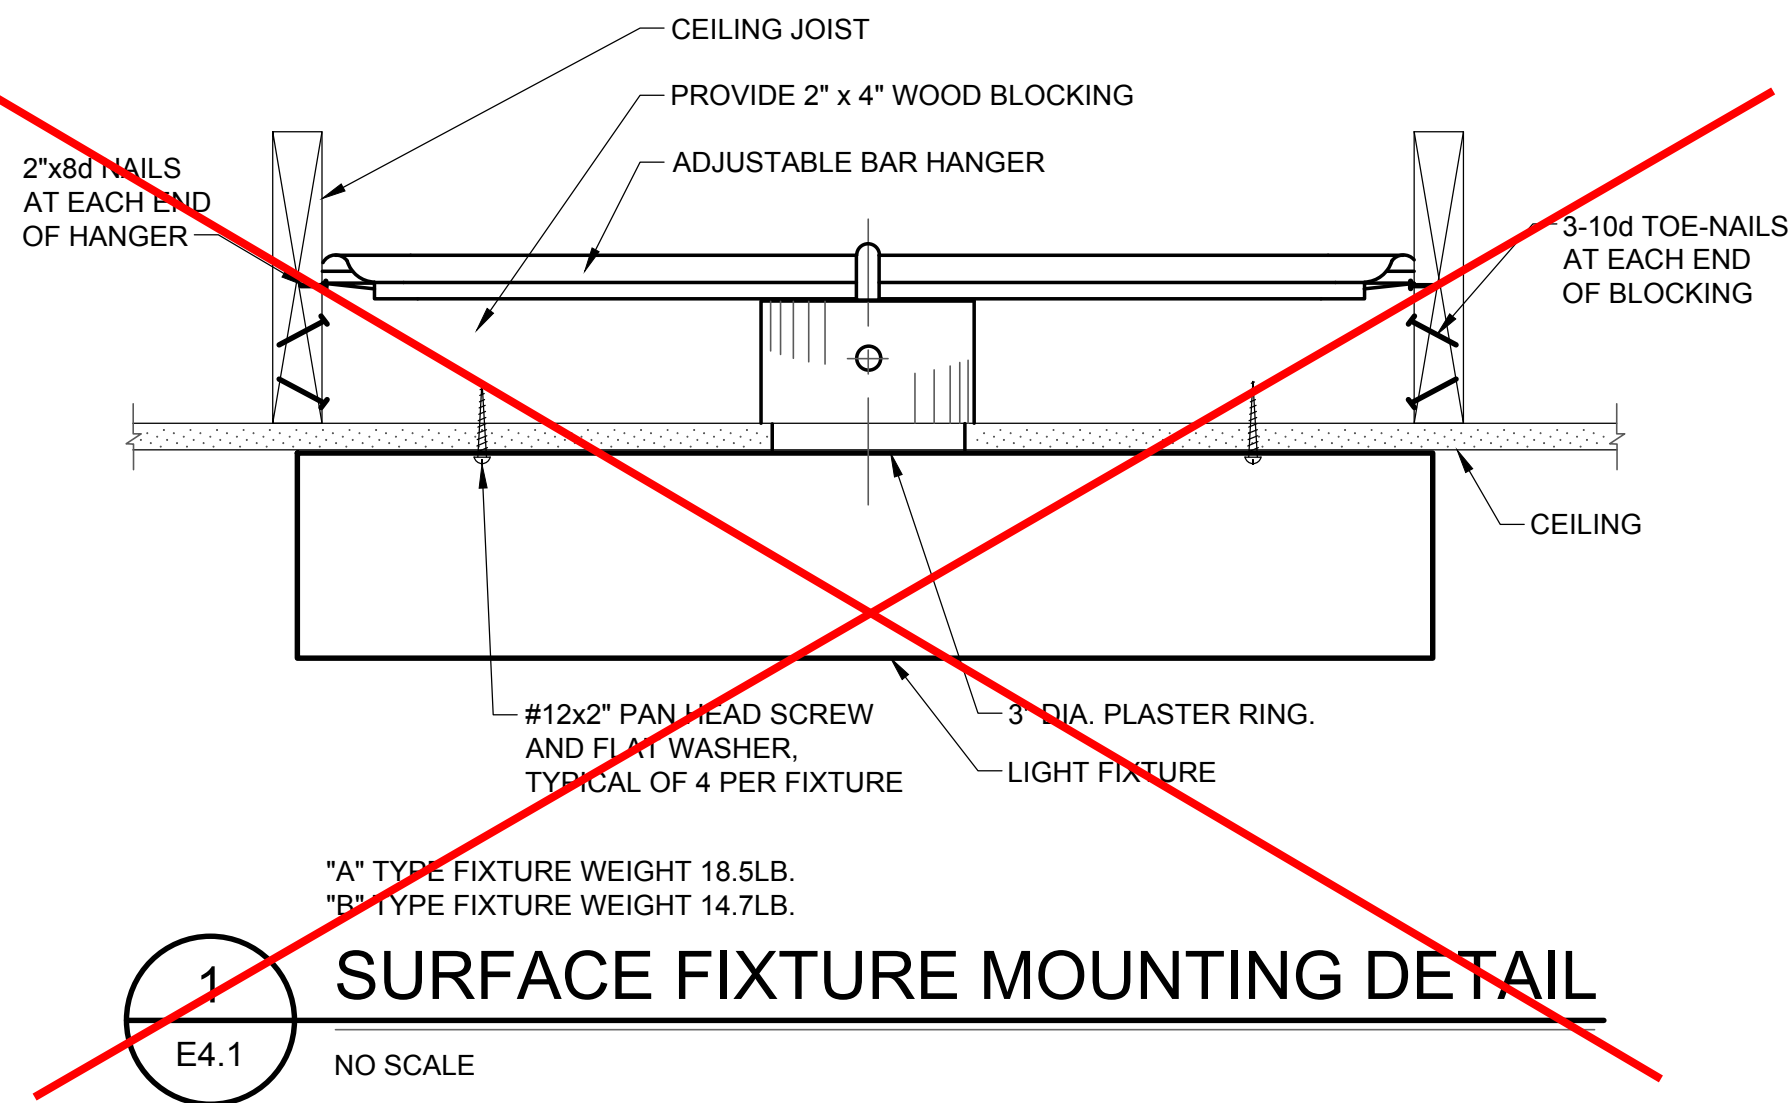


NOTES:


- PULL BOX SHALL BE TRAFFIC RATED (H-20) WHEN SUBJECT TO VEHICULAR TRAFFIC
- CLEAN 2" AND LARGER SPARE EMPTY CONDUITS WITH APPROPRIATE SIZE MANDREL PRIOR TO PLACING PULL ROPE AND PLUGGING EMPTY CONDUITS WITH CONDUIT PLUGS.
- PULL ROPE: TIE OFF EACH END TO DUCT PLUG TO PREVENT PULL ROPE LOSS IN CONDUIT.

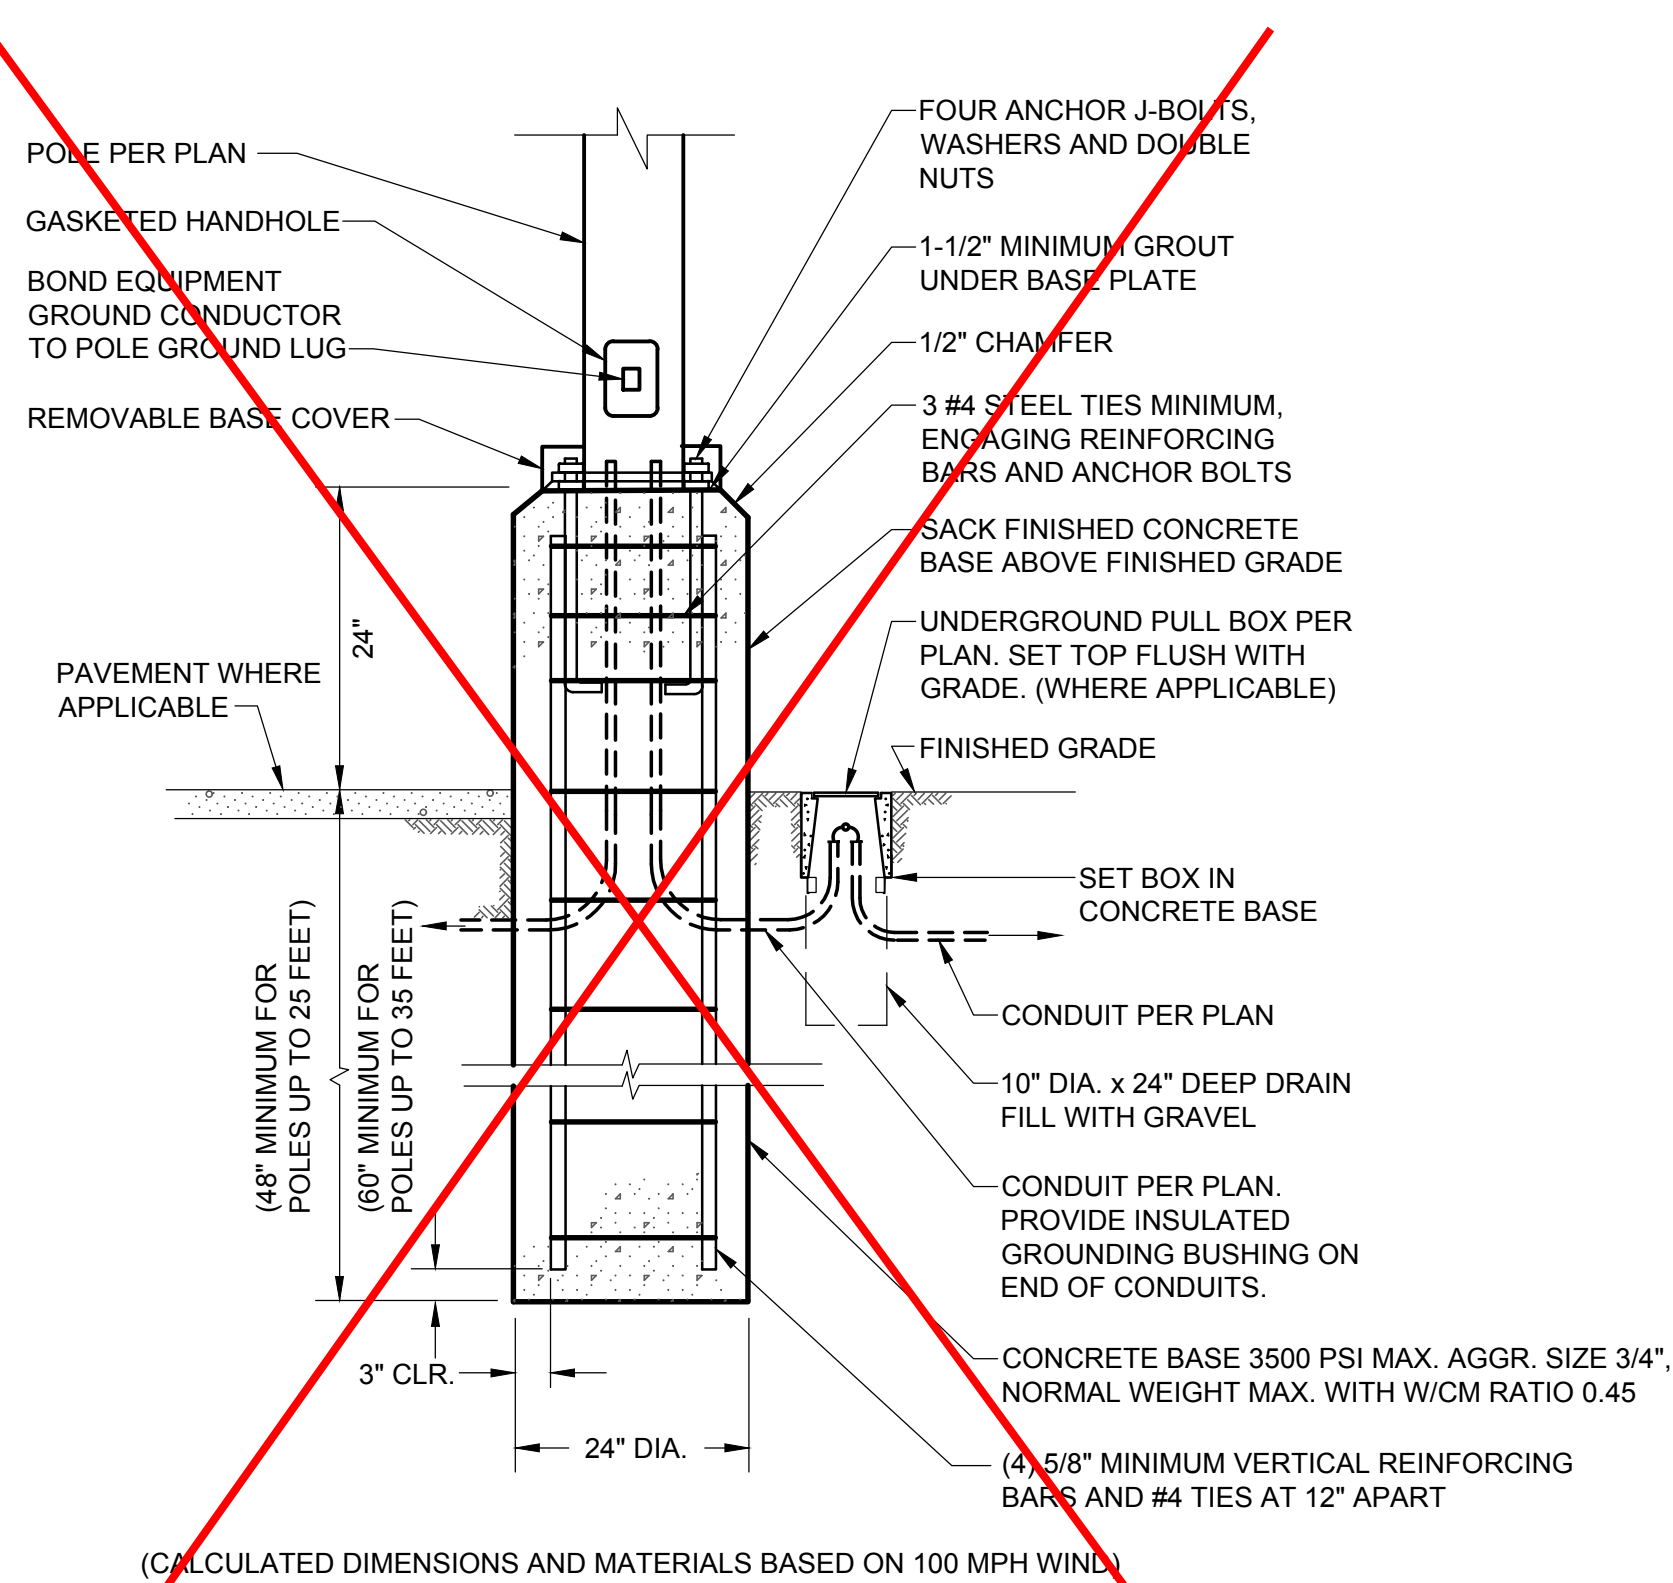


IDENTIFICATION STAMP
DIV. OF THE STATE ARCHITECT
APP: 02-120455 INC:
REVIEWED FOR
SS ☒ FLS ☒ ACS ☒
DATE: 01/12/2023

730 Howe Avenue, Suite 450
Sacramento, CA 95825
Phone: 916.921.2112
Fax: 916.921.2212

**HENRY+**
ASSOCIATES
ARCHITECTS



MODERNIZATION LAKEWOOD
ELEMENTARY SCHOOL
ELECTRICAL DETAILS

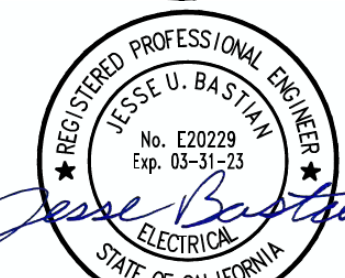CONSULTANT

01/04/2023

PROJECT NO.	REVISIONS	BY
21-32-052		
DATE 3/28/2022		
DRAWN MNE		
CHECKED SKL		
SCALE AS NOTED		
CADFILE		
UPDATED 11/17/2022		
SHEET NO.		

E4.1

GENERAL NOTES:

1. THE TYPES, LOCATIONS, SIZES, AND/OR DEPTHS OF EXISTING UNDERGROUND UTILITIES AS SHOWN ON THESE PLANS WERE OBTAINED FROM SOURCES OF VARYING RELIABILITY. THE CONTRACTOR IS CAUTIONED THAT ONLY ACTUAL EXCAVATION WILL REVEAL THE TYPES, EXTENT, SIZES, LOCATIONS AND DEPTHS OF SUCH UNDERGROUND UTILITIES. A REASONABLE EFFORT HAS BEEN MADE TO LOCATE AND DELINEATE ALL KNOWN UNDERGROUND UTILITIES. HOWEVER, WARREN CONSULTING ENGINEERS CAN ASSUME NO RESPONSIBILITY FOR THE COMPLETENESS OR ACCURACY OF ITS DELINEATION OF SUCH UNDERGROUND UTILITIES, NOR FOR THE EXISTENCE OF OTHER BURIED OBJECTS OR UTILITIES WHICH MAY BE ENCOUNTERED BUT WHICH ARE NOT SHOWN ON THESE PLANS. THE CONTRACTOR OR ANY SUBCONTRACTOR FOR THIS CONTRACT SHALL NOTIFY MEMBERS OF UNDERGROUND SERVICE ALERT (USA) TWO (2) WORKING DAYS IN ADVANCE OF PERFORMING ANY EXCAVATION WORK BY CALLING TOLL FREE 1-800-227-2600, OR 811.
2. WARREN CONSULTING ENGINEERS, INC. (WCE) ASSUMES NO RESPONSIBILITY FOR ERRORS IN PHYSICAL LOCATION OF IMPROVEMENTS, HORIZONTAL OR VERTICAL, IF STAKED BY OTHERS. IN ADDITION, ANY SUCH ERRORS IN PHYSICAL LOCATION MAY AFFECT THE INTENDED DESIGN OF SUCH IMPROVEMENTS AND WCE CANNOT BE HELD RESPONSIBLE FOR SUCH CONDITIONS WHICH ARE A RESULT OF ERRORS IN SURVEYING, OR IMPROPER CONSTRUCTION.
3. IF SUBSURFACE CULTURAL RESOURCES, REMAINS, AND/OR ARTIFACTS ARE UNCOVERED DURING PROJECT CONSTRUCTION, ALL WORK IN THE VICINITY SHALL BE STOPPED UNTIL SUCH ITEMS CAN BE ASSESSED BY AN APPROPRIATE MEMBER OF THE COUNTY ENVIRONMENTAL IMPACT SECTION STAFF.
4. CONTRACTOR AGREES THAT HE/SHE SHALL ASSUME SOLE AND COMPLETE RESPONSIBILITY FOR JOB SITE CONDITIONS DURING THE COURSE OF CONSTRUCTION OF THIS PROJECT, INCLUDING SAFETY OF ALL PERSONS AND PROPERTY; THAT THIS REQUIREMENT SHALL APPLY CONTINUOUSLY AND SHALL NOT BE LIMITED TO NORMAL WORKING HOURS; AND THAT THE CONTRACTOR SHALL DEFEND, INDEMNIFY AND HOLD THE OWNER AND ENGINEER HARMLESS FROM ANY AND ALL LIABILITY, REAL OR ALLEGED, IN CONNECTION WITH THE PERFORMANCE OF WORK ON THIS PROJECT, EXCEPTING FOR LIABILITY ARISING FROM THE SOLE NEGLIGENCE OF THE OWNER OR ENGINEER.
5. THE CONTRACTOR SHALL OBTAIN AN EXCAVATION PERMIT FROM THE STATE OF CALIFORNIA DEPARTMENT OF INDUSTRIAL SAFETY FOR ALL EXCAVATIONS OF 5 FEET OR MORE IN DEPTH.
6. IT SHALL BE THE CONTRACTOR'S RESPONSIBILITY TO MAKE NECESSARY PRE-CONSTRUCTION SITE REVIEWS TO DETERMINE NECESSARY MEANS AND METHODS TO COMPLETE THE IMPROVEMENTS SHOWN ON THESE PLANS.
7. WHERE IMPROVEMENTS LIE WITHIN AN EXISTING DEVELOPED AREA, CONTRACTOR SHALL USE CAUTION WHEN ACCESSING THE SITE THROUGH THESE EXISTING IMPROVEMENTS. IT IS THE CONTRACTORS RESPONSIBILITY TO PROTECT ANY SUCH EXISTING IMPROVEMENTS OUTSIDE THE PROJECT BOUNDARY, OR EXISTING IMPROVEMENTS WITHIN THE BOUNDARY WHICH ARE TO REMAIN. PROPER PRECAUTIONS SHALL BE PROVIDED AND MAINTAINED THROUGHOUT CONSTRUCTION. ANY DAMAGE SHALL BE REPAIRED OR REPLACED TO THE SATISFACTION OF THE OWNER.
8. IT IS THE RESPONSIBILITY OF THE CONTRACTOR TO KEEP DETAILED RECORDS OF MINOR CHANGES OR ADJUSTMENTS MADE DURING CONSTRUCTION (WHICH WERE NOT FORMALLY ISSUED). UPON PROJECT COMPLETION, THESE RECORDS AND/OR INFORMATION SHALL BE PROVIDED TO THE OWNER AND WARREN CONSULTING ENGINEERS, INC. UNLESS AN OFFICIAL "AS-BUILT" SET OF PLANS IS A REQUIREMENT OF THE CONTRACT. IF AS-BUILT PLANS ARE A REQUIREMENT OF THE CONTRACT, REFER TO SPECIFICATIONS FOR AS-BUILT DELIVERABLE REQUIREMENTS.
9. IN VEHICULAR PATHWAYS, EXISTING ASPHALTIC AND/OR CONCRETE SURFACES SHALL BE CUT TO A NEAT AND STRAIGHT LINE, PARALLEL OR PERPENDICULAR TO THE VEHICULAR TRAVELED PATH. THIS IS TYPICALLY THE ROADWAY CENTERLINE, BUT MAY VARY. THAT SAWCUT EDGE SHALL BE PROTECTED FROM DAMAGE DURING CONSTRUCTION SO A CLEAN EDGE REMAINS FOR PATCH BACK. IF EDGE IS DAMAGED, A NEW SAW CUT WILL BE REQUIRED. THE EXPOSED EDGE SHALL BE "TACKED" WITH EMULSION PRIOR TO PAVING.
10. NO BURNING OR BLASTING SHALL BE ALLOWED ONSITE UNLESS SPECIFICALLY ADDRESSED ON PLANS, OR 10. SPECIFICALLY APPROVED AND COORDINATED WITH THE ARCHITECT, ENGINEER, AND LOCAL AGENCY OR OTHER ADMINISTRATIVE AUTHORITY.
11. SUBGRADE AND RESULTING FINISHED GRADE SHALL BE CONSTRUCTED SMOOTH AND UNIFORM BETWEEN SPOT ELEVATIONS, CONTOURS OR OTHER STRUCTURE ELEVATIONS SHOWN ON GRADING OR OTHER PLANS. NO MOUNDS, RUTS, DEPRESSIONS OR OTHER GRADING DEFICIENCIES WILL BE ALLOWED UNLESS SPECIFICALLY SHOWN ON PLANS.



CIVIL ABBREVIATIONS AND LEGEND

ABBREVIATIONS	
NOTE: NOT ALL ABBREVIATIONS MAY BE USED ON THESE PLANS.	
AB	AGGREGATE BASE
AC	ASPHALTIC CONCRETE
AD	AREA DRAIN
APN	ASSESSOR'S PARCEL NUMBER
ARV	AIR RELEASE VALVE
ASB	AGGREGATE SUB-BASE
BO	BLOW-OFF VALVE
BV	BUTTERFLY VALVE
BW	BACK OF WALK
C/L	CENTERLINE
CB	CATCH BASIN
CL	CLASS
CMP	CORRUGATED METAL PIPE
CATV	CABLE TELEVISION
CO	CLEANOUT
COMM	COMMUNICATION
CONC.	CONCRETE
CONST.	CONSTRUCT
CR	CURB RETURN
CS	CONCRETE SURFACE
DC	DOUBLE CHECK VALVE
DDC	DOUBLE DETECTOR CHECK VALVE
DG	DECOMPOSED GRANITE
DI	DROP INLET
DIA	DIAMETER
DIP	DUCTILE IRON PIPE
DWG	DRAWING
DS	DOWNSPOUT
E	ELECTRIC
EP	EDGE OF PAVEMENT
ESMT	EASEMENT
EX	EXISTING
FS	FIRE SERVICE LINE
FDC	FIRE DEPARTMENT CONNECTION
FL	FLOWLINE
FM	SANITARY SEWER FORCE MAIN
FF	FINISHED FLOOR ELEVATION
FH	FIRE HYDRANT
G	GAS
GB	GRADE BREAK
GR	GRATE ELEVATION
GRD	GRADE ELEVATION
GV	GATE VALVE
HB	HOSE BIBB
HBD	HEADER BOARD
HDPE	HIGH DENSITY POLYETHYLENE PIPE
HP	HIGH POINT
INV	PIPE INVERT ELEVATION
JP	JOINT UTILITY POLE
LF	LINEAL FEET
LIP	LIP OF GUTTER
LT	LEFT
MS	MOWSTRIP
NTS	NOT TO SCALE
OH	OVERHEAD
PCC	PORTLAND CEMENT CONCRETE
PD	PLANTER DRAIN
PIV	POST INDICATOR VALVE
P/L	PROPERTY LINE
PP	POWER POLE
PUE	PUBLIC UTILITY EASEMENT
PVC	POLYVINYL CHLORIDE
RCP	REINFORCED CONCRETE PIPE
R	RADIUS
RIM	MANHOLE RIM ELEVATION (SOLID COVER)
RP	REDUCED PRESSURE BACKFLOW PREVENTER
RW	RIGHT OF WAY
SCH	SCHEDULE
SD	STORM DRAIN
SDMH	STORM DRAIN MANHOLE
SG	SUBGRADE ELEVATION
SS	SANITARY SEWER
SSMH	SANITARY SEWER MANHOLE
STD	STANDARD
S/W	SIDEWALK
T	TELEPHONE
TC	TOP OF CURB
TD	TRENCH DRAIN
TDCB	TRENCH DRAIN CATCH BASIN
TP	TELEPHONE POLE
TRW	TOP OF RETAINING WALL
TSW	TOP OF SEAT WALL
TW	TOP OF WALK ELEVATION
U	UTILITY
UG	UNDERGROUND
UCN	UNLESS OTHERWISE NOTED
VCP	VITRIFIED CLAY PIPE
W	WATER
W/	WITH
W/O	WITHOUT
WV	WATER VALVE

LEGEND	
NOTE: NOT ALL SYMBOLS MAY BE USED ON THESE PLANS.	
PROPOSED GRADING & DRAINAGE SYMBOLS:	
	STORM DRAIN LINE (SIZE AND FLOW SHOWN)
	STORM DRAIN MANHOLE (SDMH)
	CATCH BASIN (CB)
	DROP INLET (DI)
	AREA DRAIN (AD)
	PLANTER DRAIN (PD) OR FLOOR DRAIN (FD)
	STORM DRAIN CLEANOUT
	ELEVATION
	FF=100.00 FINISHED FLOOR ELEVATION
	PAD=99.33 BUILDING PAD ELEVATION
	CONCRETE SIDEWALK
	GRADED DIRECTION FOR DRAINAGE FLOW
	SWALE
	SLOPE
	TREE TO BE REMOVED

CIVIL SHEET INDEX

C0.1	CIVIL COVER SHEET
C0.2	PARTIAL TOPOGRAPHIC SURVEY
C0.3	PARTIAL TOPOGRAPHIC SURVEY
C1.1	PARTIAL CIVIL DEMOLITION PLAN
C1.2	PARTIAL CIVIL DEMOLITION PLAN
C2.1	PARTIAL GRADING PLAN
C2.2	PARTIAL GRADING PLAN
C3.1	PARTIAL UTILITY PLAN
C3.2	PARTIAL UTILITY PLAN
C4.1	PARTIAL PAVING PLAN
C4.2	PARTIAL PAVING PLAN
C4.3	STRIPING AND SIGNAGE PLAN
C4.4	STRIPING AND SIGNAGE PLAN AND DETAILS
C5.1	DETAILS
C5.2	DETAILS AND GEOTRONG
C6.1	EROSION CONTROL PLAN
C-1	COVER SHEET OFF SITE IMPROVEMENTS
C-2	GENERAL NOTES OFF SITE IMPROVEMENTS
C-3	IMPROVEMENT PLAN OFF SITE IMPROVEMENTS

UTILITY VERIFICATION NOTE
PRIOR TO THE START OF CONSTRUCTION, LOCATE AND POT HOLE ALL UTILITY POINTS OF CONNECTION FOR LOCATION, DEPTH, AND SIZE. IF CONFLICT IS FOUND, CONTACT THE ENGINEER IMMEDIATELY FOR DIRECTION.



IDENTIFICATION STAMP
DIV. OF THE STATE ARCHITECT
APP: 02-120455 INC:
REVIEWED FOR
SS ☒ FLS ☒ ACS ☒
DATE: 01/12/2023

730 Howe Avenue, Suite 450
Sacramento, CA 95825
Phone: 916.921.2112
Fax: 916.921.2212



MODERNIZATION LAKEWOOD
ELEMENTARY SCHOOL

CIVIL COVER SHEET

CONSULTANT

WCE
WARREN CONSULTING ENGINEERS, INC.
1117 WINFIELD WAY, SUITE 110
EL DORADO HILLS, CA 95762 | (916) 985-1870

PROJECT NO.	REVISIONS	BY
21-32-52		
DATE		
3/28/2022		
DRAWN		
ML/MG		
CHECKED		
MG		
SCALE		
AS NOTED		
CADFILE		
UPDATED		
11/17/2022		

SHEET NO.

C0.1

EXISTING UTILITIES

- 12"SD - STORM DRAIN LINE (SIZE + DIRECTION OF FLOW)
- 12"SD - STORM DRAIN LINE (RECORD INFORMATION)
- 12"SD - STORM DRAIN LINE (UNDERGROUND LOCATING)
- 12"SD - STORM DRAIN MANHOLE
- 12"SD - STORM DRAIN CLEANOUT
- 12"SD - DROP INLET
- 12"SD - AREA DRAIN
- 12"SD - RAIN WATER LEADER
- 12"SD - DOWNSPOUT
- 12"SS - SANITARY SEWER LINE (SIZE + DIRECTION OF FLOW)
- 12"SS - SANITARY SEWER LINE (RECORD INFORMATION)
- 12"SS - SANITARY SEWER LINE (UNDERGROUND LOCATING)
- 12"SS - SANITARY SEWER MANHOLE
- 12"SS - SANITARY SEWER CLEANOUT
- W - WATER LINE (SIZE INDICATED)
- W - WATER LINE RECORD INFORMATION
- W - WATER LINE UNDERGROUND LOCATING
- W - WATER MANHOLE
- W - WATER VALVE
- W - WATER METER
- W - WATER BOX
- W - IRRIGATION CONTROL VALVE
- W - FIRE HYDRANT
- W - BACKFLOW PREVENTER
- W - SPRINKLER
- W - HOSE BIBB
- OH-E - OVERHEAD ELECTRIC LINE
- E - UNDERGROUND ELECTRIC LINE
- E - UNDERGROUND ELECTRIC LINE (RECORD INFORMATION)
- E - UNDERGROUND ELECTRIC LINE (UNDERGROUND LOCATING)
- E - ELECTRIC MANHOLE
- E - UTILITY POLE (WITH GUY WIRE)
- E - ELECTRIC METER
- E - ELECTRIC BOX
- E - STREET LIGHTING BOX
- OR - LIGHT STANDARD
- OR - SIGNAL LIGHT
- OR - FLOOD LIGHT
- OR - ELECTRICAL OUTLET
- G - GAS LINE (SIZE INDICATED)
- G - GAS LINE RECORD INFORMATION
- G - GAS LINE UNDERGROUND LOCATING
- G - GAS MANHOLE
- G - GAS VALVE
- G - GAS METER
- T - TELEPHONE LINE
- T - TELEPHONE LINE (RECORD INFORMATION)
- T - TELEPHONE LINE (UNDERGROUND LOCATING)
- SD - STORM DRAIN BOX
- SS - TRAFFIC SIGNAL BOX

EXISTING TOPOGRAPHY

- PROPERTY LINE
- CENTERLINE
- EASEMENT
- PROPERTY CORNER FOUND AS NOTED
- PROPERTY CORNER NOTHING FOUND OR SET
- TEMPORARY BENCHMARK (SEE TBM LIST FOR INFO)
- SWALE OR DRAINAGE FLOW
- DRAINAGE FLOW
- FENCE (TYPE NOTED)
- TREE (SIZE/TYPE INDICATED)
- SLOPE
- CONTOUR
- CONCRETE SURFACE
- EDGE OF ASPHALT
- EDGE OF BUILDING
- SIGN
- POST OR DOLLARD
- GROUND ELEVATION
- HARD SURFACE ELEVATION

ABBREVIATIONS

NOTE: NOT ALL ABBREVIATIONS MAY BE USED ON THESE PLANS.

??	UNKNOWN	D	DEPTH	IC	IN CONCRETE	SB	SIGNAL BOX
ACC	ACCESSIBLE	DF	DOUBLE DETECTOR CHECK VALVE	ICV	IRRIGATION CONTROL VALVE	SD	STORM DRAIN
ACU	AIR CONDITIONING UNIT	DG	DRINKING FOUNTAIN	IN	PIPE INVERT ELEVATION	SDMH	STORM DRAIN MANHOLE
AD	ADJACENT	DI	DROP INLET	IR	IRRIGATION	SIG	SIGNAL
APN	ASSESSOR'S PARCEL NUMBER	DIA	DIAMETER	JP	JOINT UTILITY POLE	SLS	STREET LIGHT
APP	APPARATUS	DRWY	DRIVEWAY	JT	JOINT TRENCH	SLSB	STREET LIGHT BOX
BD	BASKETBALL POLE	DS	DOWNSPOUT	LF	LANDING FEET	SS	SANITARY SEWER
BCM	BRASS CAP MONUMENT	DWG	DRAWING	LDNG	LANDING	SSMH	SANITARY SEWER MANHOLE
BFP	BACK FLOW PREVENTER	E	ELECTRIC	M	METAL	STD	STANDARD
BLK	BLACK	EP	EDGE OF PAVEMENT	MH	METAL MANHOLE	STL	STEEL
BLDG	BUILDING	ESMT	EASEMENT	MS	METAL RAMP	T	TELEPHONE
BOL	BOLLARD	EV	ELECTRICAL VAULT	NTS	NOT TO SCALE	TBLL	TETHER BALL POLE
BOV	BLOW-OFF VALVE	FA	FIRE ALARM	OH	OVERHEAD	TBM	TEMPORARY BENCHMARK
BRIC	BRICK	FDC	FIRE DEPARTMENT CONNECTION	OVHNG	OVERHANG	TC	TOP OF CURB
DWF	DWARD WIRE FENCE	FTE	FINISHED FLOOR ELEVATION	OP	OPEN IRON PIPE	TOW	TOP OF WALL
C	CENTERLINE	FL	FLOWLINE	OSPH	OLD STEEL POST HOLE	TP	TOP OF RETAINING WALL
C/L	CENTERLINE	FL	FLOWLINE	P/L	PROPERTY LINE	UG	UNDERGROUND
CAB	CABINET	FOTG	FIBER OPTIC	PA	PLASTER AREA	UNK	UNKNOWN
CIP	CONCRETE IN PLACE	FP	FLAG POLE	PE	PEDESTAL	UNL	UNLESS OTHERWISE NOTED
CL	CLASS	FS	FIRE SERVICE	PH	POSTHOLE	UON	UNKNOWN
CL F	CHAIN LINK FENCE	G	GAS	PIV	POST INDICATOR VALVE	VBALL	VOLLEYBALL
COL	COLUMN	GB	GRADE BREAK	PP	POWER POLE	W	WATER
CONC	CONCRETE	GR	GRADE	PRKG	PARKING	W/O	WITHOUT
CONC	CONCRETE	GRB	GROUND ROD BOX	R	RUBBER	WO	WOOD
CONST	CONSTRUCT	GRD	GRADE ELEVATION	R	ROLLING GATE	WIF	WROUGHT IRON FENCE
CPT	CONTROL POINT FOUND	GROD	GROUND ROD	RM	RAINWATER MANHOLE	XWALK	CROSSWALK
CPS	CONTROL POINT SET	GV	GAS VALVE	ROW	RIGHT OF WAY		
CS	CONCRETE SURFACE	HDB	HEAD BOARD	RW	RETAINING WALL		
		HP	HIGH PRESSURE	RWD	REDWOOD		
		HR	HANDRAIL	RWL	RAIN WATER LEADER		
		HVE	HIGH VOLTAGE ELECTRIC				

MATCH LINE - SEE SHEET C0.3

TBM LIST

NUMBER	DESCRIPTION	NORTHING	EASTING	ELEVATION
1	CPS CHISELED **	4897.73	4890.21	48.97
2	CPFR CL HAM	4791.24	4958.33	48.74
3	CPFR CL HAM	4642.19	4980.89	49.41
4	CPFRINWELL AT C/LHAM	4855.77	4928.84	48.26
5	CPFR AT INT HAMKIRKWOOD	4659.83	4939.40	48.86
6	CPF BM202 EL-50.04	4639.53	5037.62	50.04
7	CPFR AT INT JUNEWOOD-KIRKWOOD	4659.36	4671.66	47.50
8	CPF 2 1/2" BRASS DISC	5224.78	4952.83	48.48
9	CPFS CHISELED **	5245.57	5038.70	50.41
10	CPFS CHISELED **	5175.06	5141.91	50.81
11	CPFS CHISELED **	5034.06	5128.05	51.20
12	CPFS CHISELED **	4964.98	5021.81	51.37
13	CPFS CHISELED **	4785.46	5021.76	51.09
14	CPFS CHISELED **	4845.05	5024.39	51.17
15	CPFS CHISELED **	4822.34	5128.12	51.8
16	CPFS CHISELED **	4555.55	5089.30	50.22
17	CPFS CHISELED **	5017.77	5026.65	50.77
18	CPFS CHISELED **	5055.67	5371.55	50.46
19	CPFS CHISELED **	5175.06	5141.91	50.80
20	CPFS CHISELED **	5178.31	5257.26	49.94
21	CPFS CHISELED **	4967.43	5137.65	51.51
22	CPFS CHISELED **	4923.64	5177.40	51.09
23	CPFS CHISELED **	4844.07	5260.16	51.8
24	CPFS CHISELED **	4974.64	5321.30	51.8
25	CPFS CHISELED **	4841.82	5329.16	51.37
26	CPFS CHISELED **	4689.76	5175.78	50.31

A.P.N.	039-100-120
BENCHMARK NO. 1202	ELEV. 50.044
NE CORNER TURNER RD. AND HAM LN. 14.8' E/ CL OF CURD RETURN 0.5' BEHIND DOC.	

BASIS OF BEARINGS:
IS MAPS 5

FEINIA INFORMATION:
THE SUBJECT PROPERTY IS LOCATED IN
"ZONE X (SHADED) - AREA OF 0.21 ANNUAL
CHANCE FLOOD HAZARD" PER FLOOD
INSURANCE RATE MAP 06077C068F DATED
OCTOBER 15, 2009

NOTE:
EXISTING UTILITIES BASED ON VISIBLE
STRUCTURES AND RECORD
INFORMATION



IDENTIFICATION STAMP
DIV. OF THE STATE ARCHITECT
APP: 02-120455 INC:
REVIEWED FOR
SS ☒ FLS ☒ ACS ☒
DATE: 01/12/2023

730 Howe Avenue, Suite 450
Sacramento, CA 95825
Phone: 916.921.2112
Fax: 916.921.2212



MODERNIZATION LAKEWOOD
ELEMENTARY SCHOOL

PARTIAL TOPOGRAPHIC SURVEY


CONSULTANT



WARREN CONSULTING ENGINEERS, INC.
1117 WINFIELD WAY, SUITE 110
EL DORADO HILLS, CA 95762 | (916) 985-1870

PROJECT NO.	REVISIONS	BY
21-32-52		
DATE	3/28/2022	
DRAWN	ML/MG	
CHECKED	MG	
SCALE	AS NOTED	
CADFILE		
UPDATED	11/17/2022	
SHEET NO.		

C0.2

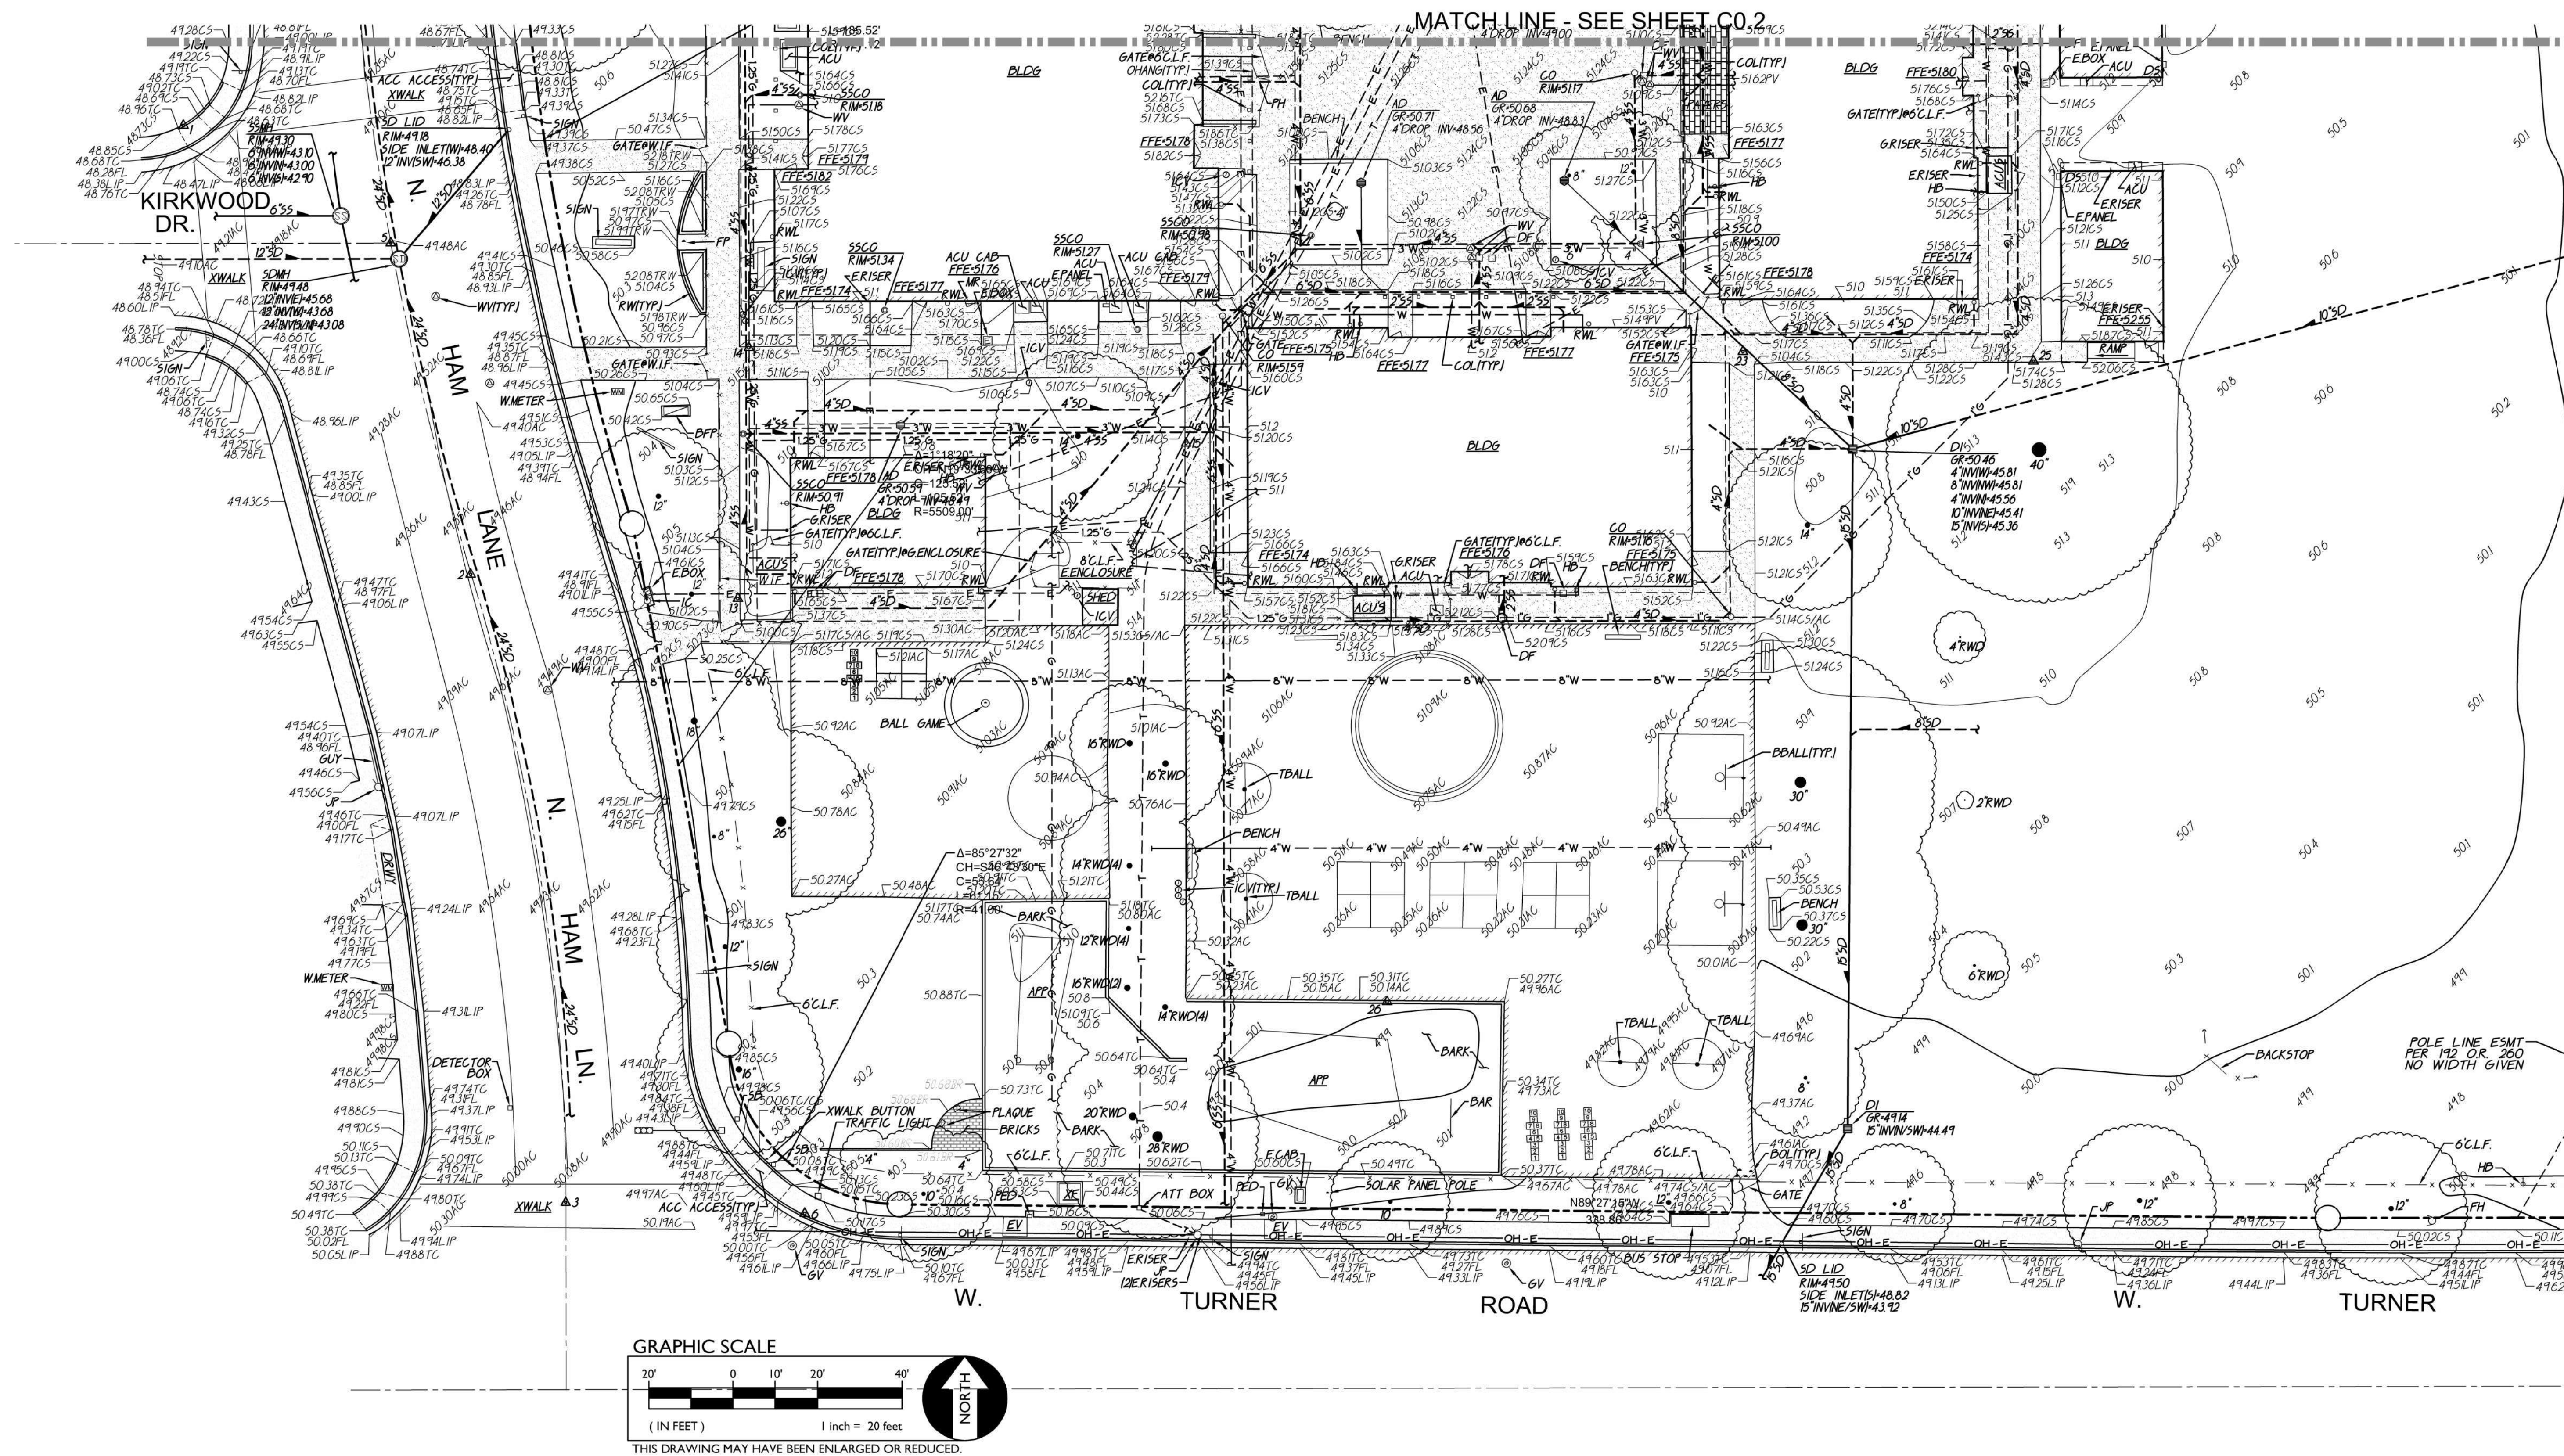

IDENTIFICATION STAMP
DIV. OF THE STATE ARCHITECT
APP: 02-120455 INC:
REVIEWED FOR
SS ☒ FLS ☒ ACS ☒
DATE: 01/12/2023

730 Howe Avenue, Suite 450
Sacramento, CA 95825
Phone: 916.921.2112
Fax: 916.921.2212



MODERNIZATION LAKEWOOD
ELEMENTARY SCHOOL

PARTIAL TOPOGRAPHIC SURVEY


CONSULTANT




WARREN CONSULTING ENGINEERS, INC.
1117 WINDFIELD WAY, SUITE 110
EL DORADO HILLS, CA 95762 | (916) 985-1870

PROJECT NO. 21-32-52	REVISIONS	B
DATE 3/28/2022		
DRAWN ML/MG		
CHECKED MG		
SCALE AS NOTED		
CADFILE		
UPDATED 11/17/2022		
SHEET NO.		

C0.3

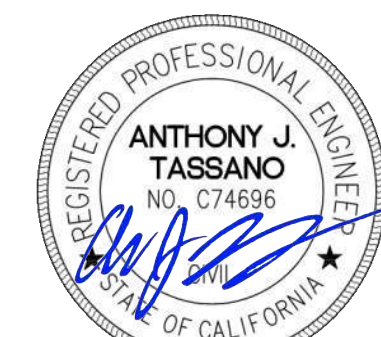


FILENAME: I: \21-014\CIVIL\DWG\21-014 C0.2-C0.3.DWG

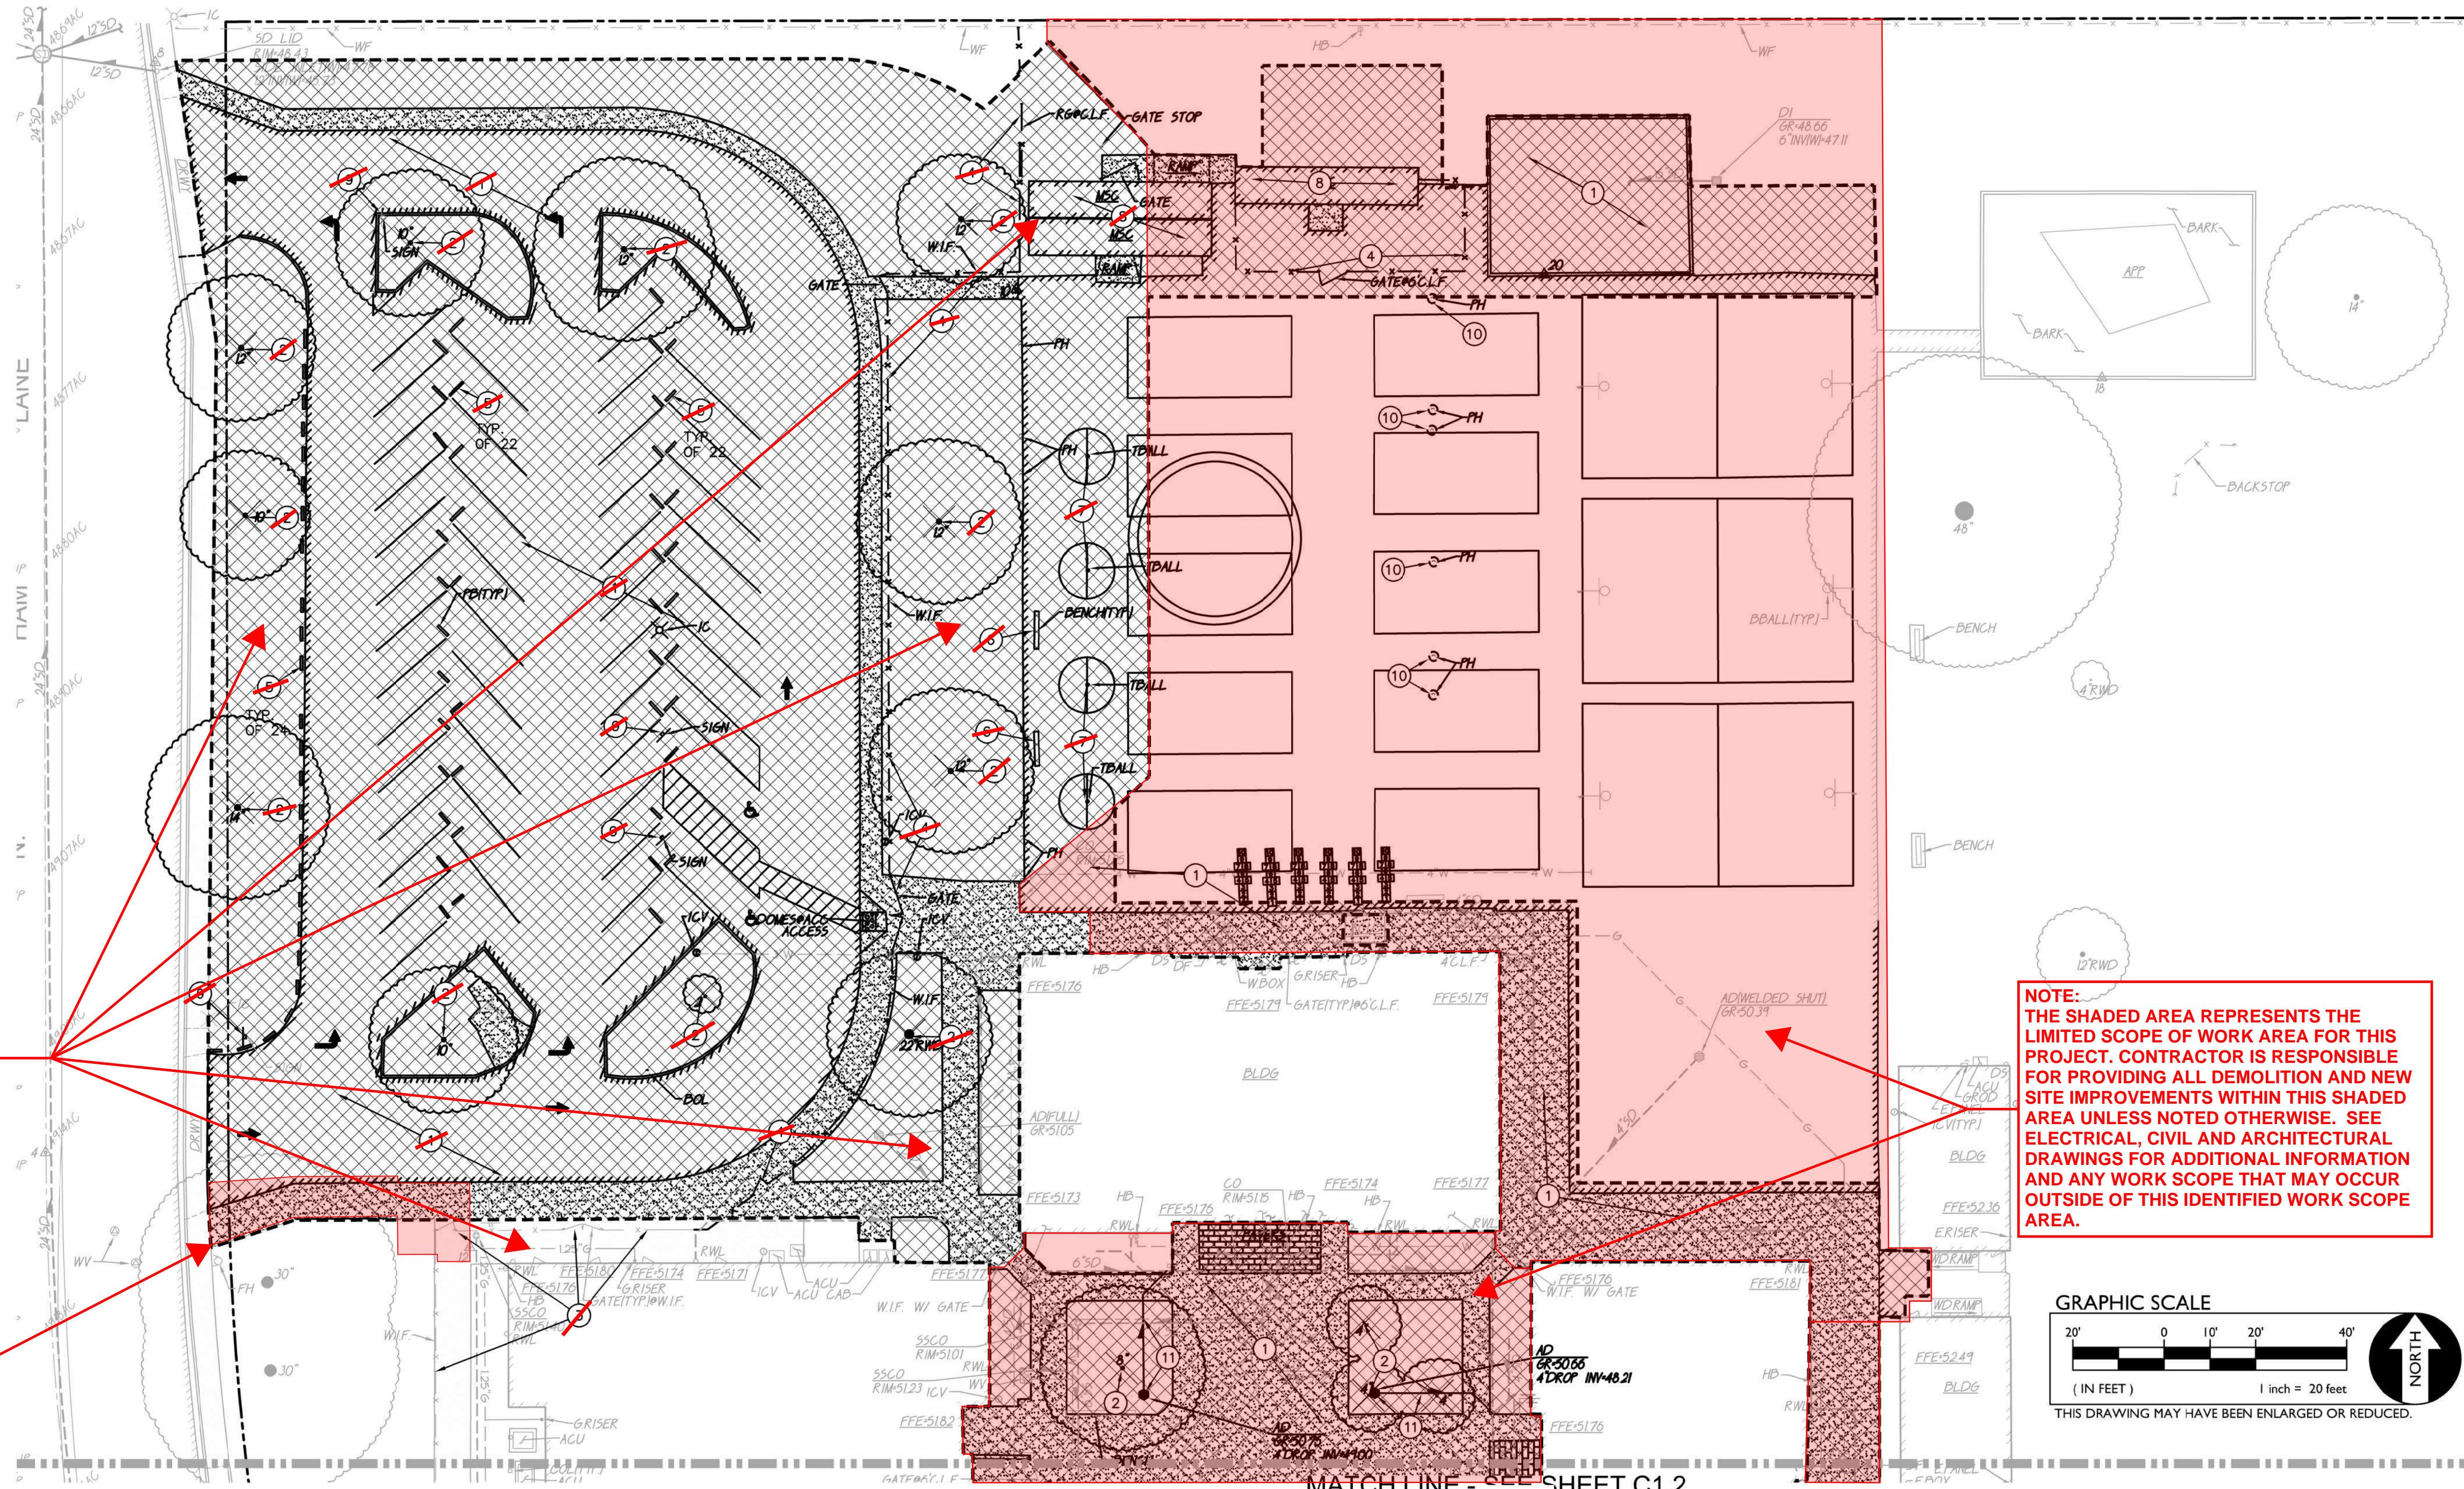

NOTE:
ANY SITE OR BUILDING
DEMOLITION OR IMPROVEMENTS
INDICATED OUTSIDE THE SHADED
AREA IS NOT A PART OF THIS
CONTRACT UNLESS NOTED
OTHERWISE

SEE GRADING PLAN
SHEET C2.1 FOR
PARTIAL REMOVAL
AND REPLACEMENT
OF WALKWAY, CURB
AND A.C.


NOTE:
THE SHADED AREA REPRESENTS THE
LIMITED SCOPE OF WORK AREA FOR THIS
PROJECT. CONTRACTOR IS RESPONSIBLE
FOR PROVIDING ALL DEMOLITION AND NEW
SITE IMPROVEMENTS WITHIN THIS SHADED
AREA UNLESS NOTED OTHERWISE. SEE
ELECTRICAL, CIVIL AND ARCHITECTURAL
DRAWINGS FOR ADDITIONAL INFORMATION
AND ANY WORK SCOPE THAT MAY OCCUR
OUTSIDE OF THIS IDENTIFIED WORK SCOPE
AREA.

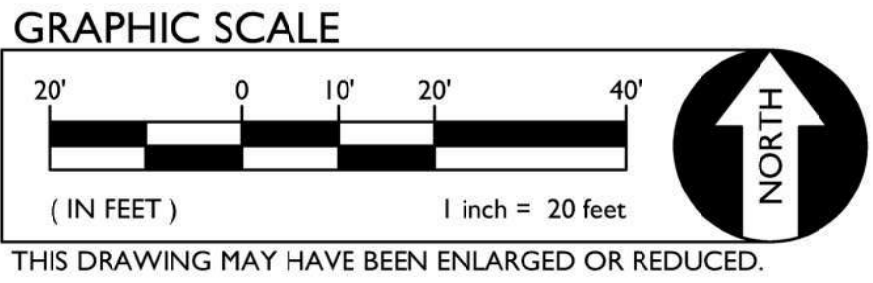

DEMOLITION GENERAL NOTES

1. REFER TO ARCHITECTURAL, LANDSCAPE, ELECTRICAL AND PLUMBING PLANS FOR ADDITIONAL DEMOLITION ITEMS.
2. IN THE EVENT THAT ANY UNUSUAL CONDITIONS NOT COVERED BY THE GEOTECHNICAL INVESTIGATION REPORT OR ARE ENCOUNTERED DURING GRADING OPERATIONS THE GEOTECHNICAL ENGINEER AND THE ARCHITECT SHALL BE IMMEDIATELY NOTIFIED FOR DIRECTIONS.
3. ADDITIONAL DEMOLITION INFORMATION MAY BE SHOWN ON THE GRADING, DRAINAGE, AND UTILITY PLANS, AND THOSE PLANS PREPARED BY OTHER DISCIPLINES FOR THIS PROJECT.
4. ALL DEMOLISHED ITEMS SHALL BE DISPOSED OF OFFSITE AT A SUITABLE, LEGAL, DUMP SITE OR OTHER FACILITY.
5. ALL DISPOSED OF MATERIALS SHALL BE RECYCLED IF POSSIBLE.
6. THE SCHOOL DISTRICT SHALL HAVE SALVAGE RIGHTS TO ANY DEMOLISHED ITEMS SHOWN HEREON. THE CONTRACTOR SHALL GIVE THE DISTRICT NOTICE 7 DAYS PRIOR TO THE START OF DEMOLITION. THE DISTRICT SHALL MOVE ANY RETAINED ITEMS OUT OF THE CONTRACTORS WORK AREA, UNLESS ANOTHER ARRANGEMENT IS MADE WITH THE CONTRACTOR. ANY REMAINING ITEMS BECOME THE PROPERTY OF THE CONTRACTOR AND SHALL BE REMOVED FROM THE SITE. ANY ITEMS NOT SHOWN FOR REMOVAL SHALL REMAIN AND SHALL BE PROTECTED FROM DAMAGE DURING CONSTRUCTION TO A REASONABLE EXTENT.
7. EXISTING UTILITY STRUCTURES IN AREAS OF NEW PAVING SHALL BE REMOVED AND REPLACED WITH NEW BOX/COVER AT NEW GRADE UNLESS SPECIFICALLY NOTED OTHERWISE.
8. ITEMS OUTSIDE THE LIMITS OF DEMOLITION SHALL REMAIN AND BE PROTECTED FROM DAMAGE DURING CONSTRUCTION.
9. EXISTING UTILITY STRUCTURES AND PIPING NOT SHOWN ON DEMOLITION PLAN TO BE REMOVED SHALL REMAIN AND BE PROTECTED.

10. SAWCUTS AND SUBSEQUENT PATCH BACK OF CONCRETE WALKS, SHALL BE TO THE EXISTING CONCRETE JOINT BEYOND THE NEAREST LOCATION OF DEMOLITION AS SHOWN. A REASONABLE EFFORT HAS BEEN MADE TO LOCATE, SHOW AND COORDINATE WITH EXISTING JOINTS, HOWEVER IF FIELD CONDITIONS ARE OTHERWISE, IT IS UNDERSTOOD TO REMOVE AND PATCH BACK TO THE NEAREST JOINTS BEYOND DEMOLITION.
11. PRIOR TO THE START OF CONSTRUCTION, VERIFY AND POTHOLE ALL UTILITY POINTS OF CONNECTION FOR LOCATION, DEPTH, AND SIZE. IF CONFLICT IS FOUND, CONTACT THE ENGINEER IMMEDIATELY FOR DIRECTION.
12. WITHIN LANDSCAPE AREAS TO BE DEMOLISHED THERE MAY BE EXISTING IRRIGATION LINES NOT SHOWN ON THIS PLAN. CONTRACTOR SHALL REMOVE LATERAL LINES AND HEADS ENCOUNTERED. MAIN LINES AND CONTROL WIRES MAY ONLY BE REMOVED PROVIDED THAT ROUTING IS KNOWN AND REMOVAL WILL NOT DEACTIVATE AN IRRIGATION SYSTEMS INTENDED TO REMAIN. IF CONFLICT IS FOUND, CONTACT THE ENGINEER FOR DIRECTION.
13. COORDINATE REMOVAL OF LANDSCAPE ITEMS WITH LANDSCAPE PLANS.

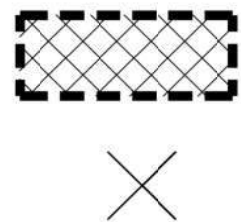

DEMOLITION NOTES (NOTE: NOT ALL NOTES MAY BE USED FOR THIS LIMITED SCOPE PROJECT)

1. WITHIN LIMITS SHOWN REMOVE ALL PAVEMENT, CURB, GUTTER, BASE MATERIAL AND LANDSCAPING. COORDINATE LIMITS OF REMOVAL WITH PLANS BY OTHERS. ADDITIONAL DEMOLITION ITEMS SHOWN ON ARCHITECTURAL, ELECTRICAL AND PLUMBING PLANS.
2. REMOVE TREE, STUMP AND ALL ROOTS.
3. FENCING AND GATES TO REMAIN.
4. REMOVE EXISTING FENCE, GATES, AND ASSOCIATED FOOTINGS. SALVAGE AND PROTECT EXISTING GATES, POSTS AND FENCE PANELS FOR REUSE, SEE ARCHITECTURAL PLANS.
5. SALVAGE WHEEL STOP FOR REUSE.
6. SALVAGE BENCH. COORDINATE WITH OWNER.
7. REMOVE TETHERBALL POLE AND FOOTING.
8. DISTRICT TO REMOVE EXISTING CONTAINERS.
9. REMOVE SIGN, POST AND FOOTING.
10. REMOVE SLEEVE AND FOOTING. SEE PAVING PLAN FOR PATCH BACK.
11. REMOVE DRAIN INLET AND PIPING. SEE DRAINAGE PLAN FOR LIMITS.



IDENTIFICATION STAMP
DIV. OF THE STATE ARCHITECT
APP: 02-120455 INC:
REVIEWED FOR
SS ☒ FLS ☒ ACS ☒
DATE: 01/12/2023

730 Howe Avenue, Suite 450
Sacramento, CA 95825
Phone: 916.921.2112
Fax: 916.921.2212



MODERNIZATION LAKEWOOD
ELEMENTARY SCHOOL


PARTIAL DEMOLITION PLAN

CONSULTANT




PROJECT NO.	REVISIONS	BY
21-32-52		
DATE		
3/28/2022		
DRAWN		
ML/MG		
CHECKED		
MG		
SCALE		
AS NOTED		
CADFILE		
UPDATED		
11/17/2022		
SHEET NO.		

C1.1

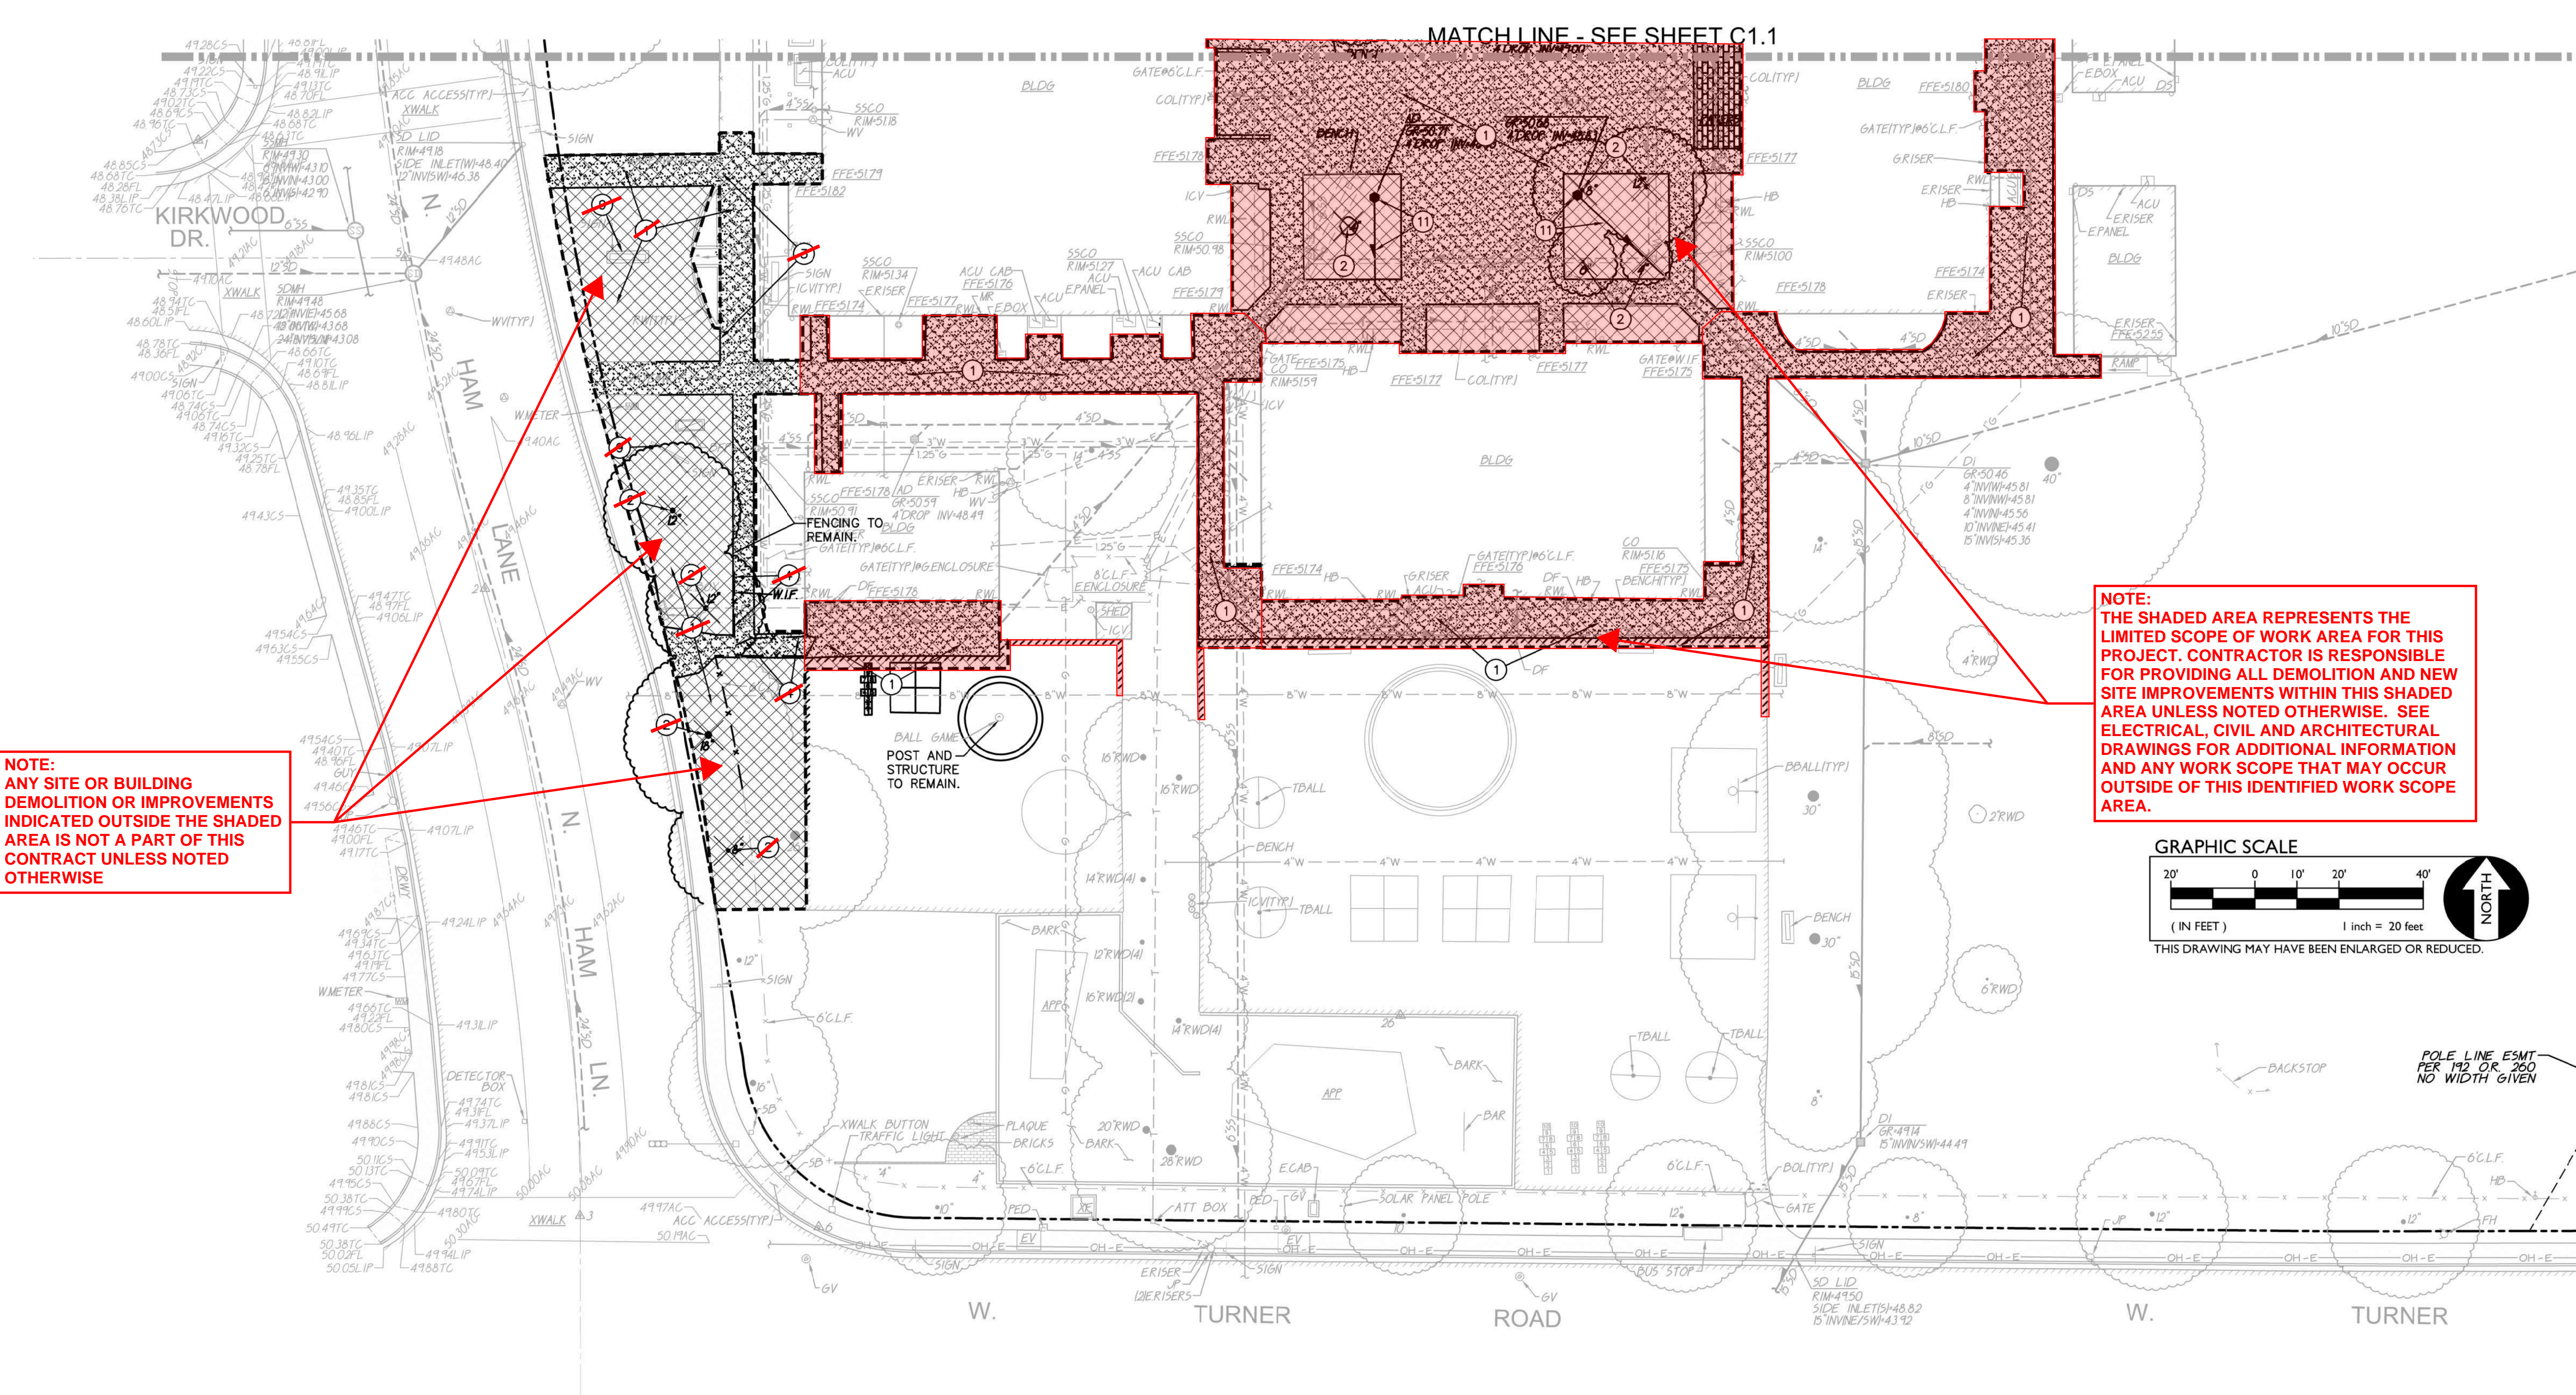

NOTE:
ANY SITE OR BUILDING
DEMOLITION OR IMPROVEMENTS
INDICATED OUTSIDE THE SHADED
AREA IS NOT A PART OF THIS
CONTRACT UNLESS NOTED
OTHERWISE

NOTE:
THE SHADED AREA REPRESENTS THE
LIMITED SCOPE OF WORK AREA FOR THIS
PROJECT. CONTRACTOR IS RESPONSIBLE
FOR PROVIDING ALL DEMOLITION AND NEW
SITE IMPROVEMENTS WITHIN THIS SHADED
AREA UNLESS NOTED OTHERWISE. SEE
ELECTRICAL, CIVIL AND ARCHITECTURAL
DRAWINGS FOR ADDITIONAL INFORMATION
AND ANY WORK SCOPE THAT MAY OCCUR
OUTSIDE OF THIS IDENTIFIED WORK SCOPE
AREA.

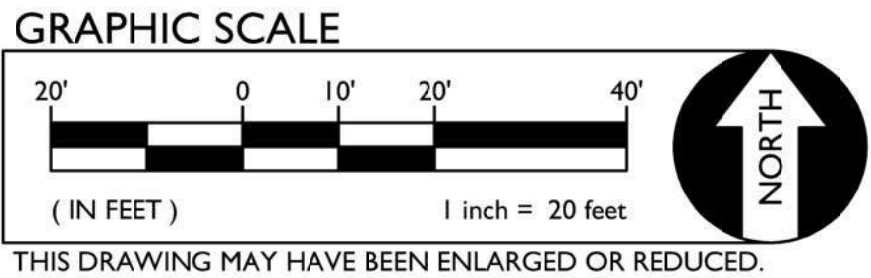

- (NOTE: NOT ALL NOTES MAY BE USED FOR THIS LIMITED SCOPE PROJECT)
- DEMOLITION NOTES
1. WITHIN LIMITS SHOWN REMOVE ALL PAVEMENT, CURB, GUTTER, BASE MATERIAL AND LANDSCAPING. COORDINATE LIMITS OF REMOVAL WITH PLANS BY OTHERS. ADDITIONAL DEMOLITION ITEMS SHOWN ON ARCHITECTURAL, ELECTRICAL AND PLUMBING PLANS.
 2. REMOVE TREE, STUMP AND ALL ROOTS.
 3. FENCING AND GATES TO REMAIN.
 4. REMOVE EXISTING FENCE, GATES, AND ASSOCIATED FOOTINGS. SALVAGE AND PROTECT EXISTING GATES, POSTS AND FENCE PANELS FOR REUSE, SEE ARCHITECTURAL PLANS
 5. SALVAGE WHEEL STOP FOR REUSE.
 6. SALVAGE BENCH. COORDINATE WITH OWNER.
 7. REMOVE TETHERBALL POLE AND FOOTING.
 8. RELOCATE EXISTING CONTAINER.
 9. REMOVE SIGN, POST AND FOOTING. SIGNE TO BE RELOCATED. SEE ARCHITECTURAL PLANS.



IDENTIFICATION STAMP
DIV. OF THE STATE ARCHITECT
APP: 02-120455 INC:
REVIEWED FOR
SS ☒ FLS ☒ ACS ☒
DATE: 01/12/2023

730 Howe Avenue, Suite 450
Sacramento, CA 95825
Phone: 916.921.2112
Fax: 916.921.2212



MODERNIZATION LAKEWOOD
ELEMENTARY SCHOOL

PARTIAL DEMOLITION PLAN

CONSULTANT

WCE
WARREN CONSULTING ENGINEERS, INC.
1117 WINFIELD WAY, SUITE 110
EL DORADO HILLS, CA 95762 | (916) 985-1870


PROJECT NO.	REVISIONS	BY
21-32-52		
DATE		
3/28/2022		
DRAWN		
ML/MG		
CHECKED		
MG		
SCALE		
AS NOTED		
CADFILE		
UPDATED		
11/17/2022		
SHEET NO.		

NOTE:
ANY SITE OR BUILDING
DEMOLITION OR IMPROVEMENTS
INDICATED OUTSIDE THE SHADED
AREA IS NOT A PART OF THIS
CONTRACT UNLESS NOTED
OTHERWISE

SEE SHEET C7.3 FOR
FRONTAGE IMPROVEMENTS

1
C2.1

GRAPHIC SCALE

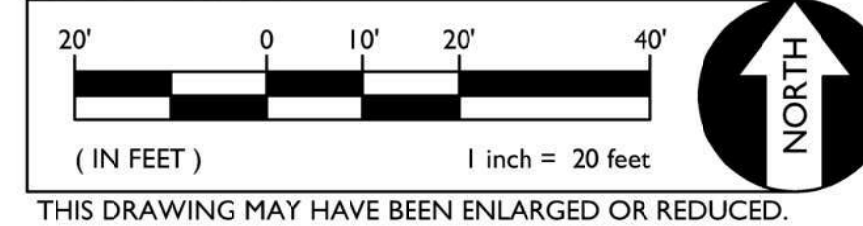

NOTE:
THE SHADED AREA REPRESENTS THE
LIMITED SCOPE OF WORK AREA FOR THIS
PROJECT. CONTRACTOR IS RESPONSIBLE
FOR PROVIDING ALL DEMOLITION AND NEW
SITE IMPROVEMENTS WITHIN THIS SHADED
AREA UNLESS NOTED OTHERWISE. SEE
ELECTRICAL, CIVIL AND ARCHITECTURAL
DRAWINGS FOR ADDITIONAL INFORMATION
AND ANY WORK SCOPE THAT MAY OCCUR
OUTSIDE OF THIS IDENTIFIED WORK SCOPE
AREA.

NOTE:
THE DISTRICT HAS REQUESTED THAT THESE PLANTER AREAS BE
POURED AS (N) CONCRETE WALKWAY ALONG WITH OTHER
ADJACENT WALKWAYS WITHIN THE QUAD AREA.

ACCESSIBILITY NOTES:

- FOR ACCESSIBLE PATH OF TRAVEL REQUIREMENTS SEE ARCHITECTURAL SHEETS.
- PERCENT OF SLOPE SHOWN ON ARROWS ARE MAXIMUM SLOPES AND NOT INTENDED TO SUPERCEDE SLOPES DEFINED BY SPOT ELEVATIONS.
- WITHIN THE LIMITS OF ACCESSIBLE PARKING AREA AND ACCESSIBLE DROP OFF ZONE THE SLOPE OF PAVEMENT SHALL NOT EXCEED 1.8% IN ANY DIRECTION.
- TRANSITIONS BETWEEN ASPHALT AND CONCRETE SHALL BE FLUSH UNLESS SEPARATED BY CURB OR NOTED OTHERWISE.


GENERAL NOTES:

- AT LIMITS OF NEW CONCRETE ADJACENT TO LANDSCAPING PROVIDE A 4:1 MAXIMUM TRANSITION TO EXISTING GRADE WITH TOPSOIL. ADJUST EXISTING IRRIGATION HEADS TO FINISH GRADE AND PROVIDE SOD IN GRASS AREAS TO RESTORE TO EXISTING CONDITION.
- ALL TRANSITIONS TO EXISTING PAVEMENT SHALL BE A SMOOTH AND LEVEL TRANSITION.
- WIDTH OF NEW SIDEWALKS SHALL MATCH WIDTH OF EXISTING, ADJACENT, SIDEWALKS.
- SEE ARCHITECTURAL PLANS FOR EXPANSION AND CONTROL JOINT LAYOUT.

GRADING NOTES

- MATCH EXISTING GRADE.
- PROPOSED SIDEWALK ELEVATION SHALL MEET FLUSH WITH EXISTING FINISH FLOOR.
- CONSTRUCT SWALE.
- GRADE UNIFORMLY TO SWALE AND/OR INLET.
- ADJUST EXISTING STRUCTURE TO FINISH GRADE.
- CONSTRUCT CONCRETE CURB PER 3 C5.1
- CONSTRUCT CONCRETE VALLEY CUTTER PER 3 C5.1
- CONSTRUCT ROLLED CURB PER 3 C5.1
- PROVIDE 10' TRANSITIONS FROM VERTICAL TO ROLLED CURB
- CONSTRUCT CURB OPENINGS PER 3 C5.1
- CONSTRUCT FLUSH CONCRETE CURB PER 3 C5.1
- CONSTRUCT CUTTER PER 3 C5.1
- PROVIDE 2:1 TRANSITION FROM VERTICAL CURB TO FLUSH

- CONSTRUCT SEAT WALL PER 3 C5.1
- CONSTRUCT MONUMENT AT BASE OF FENCE PER 3 C5.1
- CONSTRUCT BIOSWALE PER 3 C5.1
- CONSTRUCT DROP OFF PER 3 C5.1
- CONSTRUCT STAIRS PER 3 C5.1

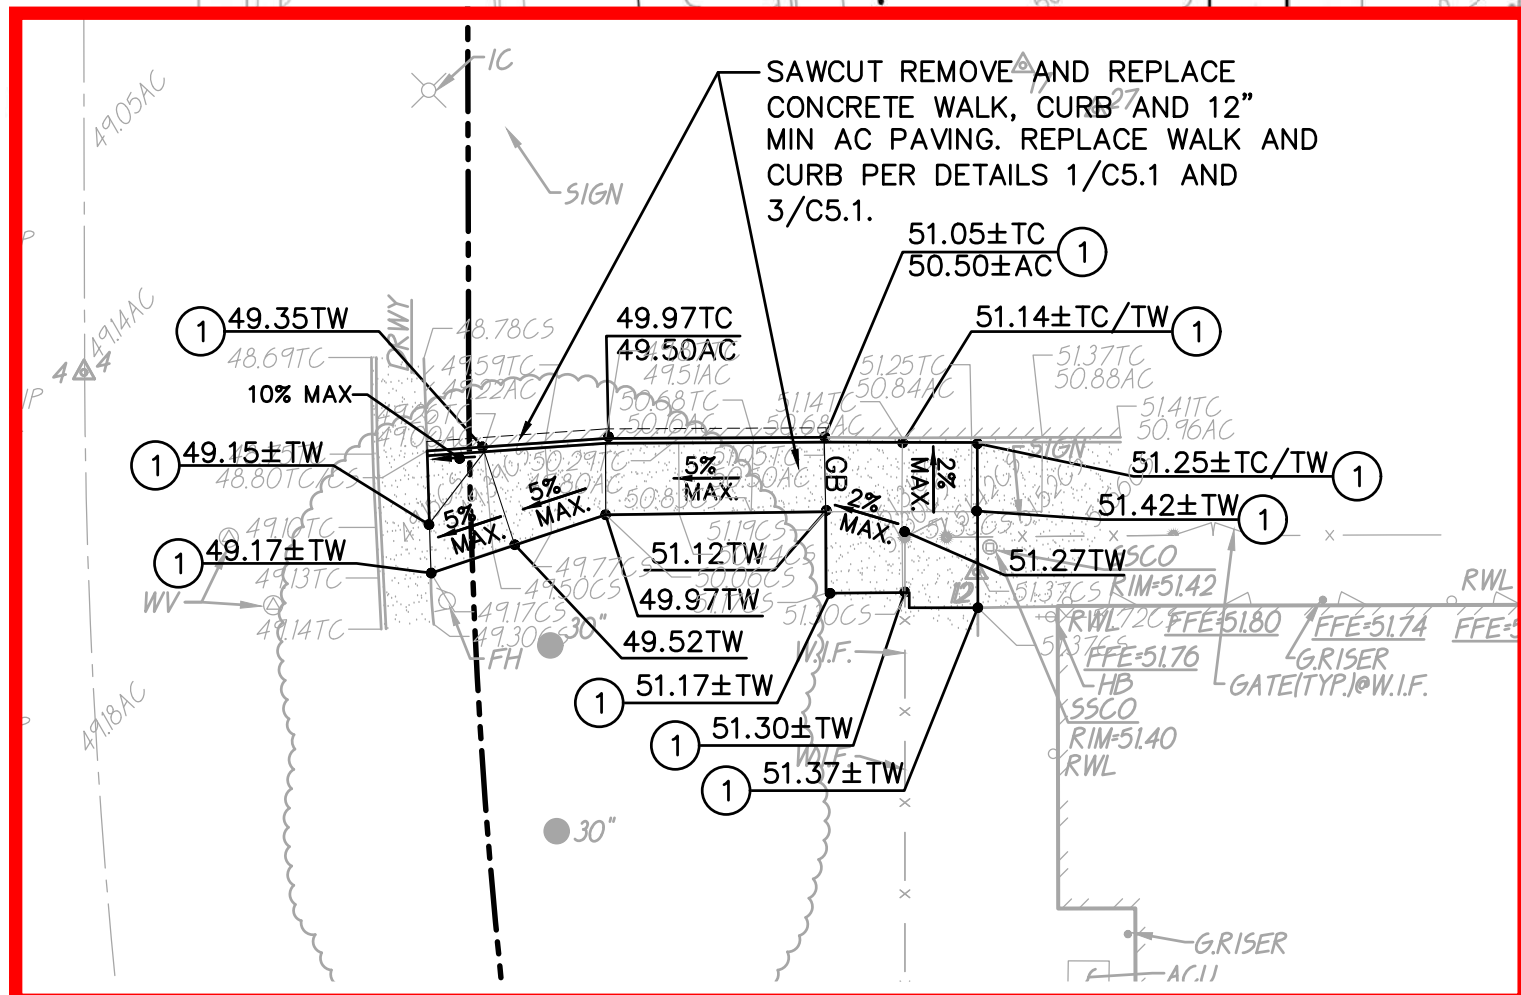

NOTE:
ANY SITE OR BUILDING
DEMOLITION OR IMPROVEMENTS
INDICATED OUTSIDE THE SHADED
AREA IS NOT A PART OF THIS
CONTRACT UNLESS NOTED
OTHERWISE

NOTE:
THE DISTRICT HAS REQUESTED THAT THESE PLANTER
AREAS BE POURED AS (N) CONCRETE WALKWAY
ALONG WITH OTHER ADJACENT WALKWAYS WITHIN
THE QUAD AREA.

NOTE:
THE SHADED AREA REPRESENTS THE
LIMITED SCOPE OF WORK AREA FOR THIS
PROJECT. CONTRACTOR IS RESPONSIBLE
FOR PROVIDING ALL DEMOLITION AND NEW
SITE IMPROVEMENTS WITHIN THIS SHADED
AREA UNLESS NOTED OTHERWISE. SEE
ELECTRICAL, CIVIL AND ARCHITECTURAL
DRAWINGS FOR ADDITIONAL INFORMATION
AND ANY WORK SCOPE THAT MAY OCCUR
OUTSIDE OF THIS IDENTIFIED WORK SCOPE
AREA.

SEE SHEET C2.3 FOR
FRONTAL IMPROVEMENTS

MATCH LINE - SEE SHEET C2.1

ACCESSIBILITY NOTES:

- FOR ACCESSIBLE PATH OF TRAVEL REQUIREMENTS SEE ARCHITECTURAL SHEETS.
- PERCENT OF SLOPE SHOWN ON ARROWS ARE MAXIMUM SLOPES AND NOT INTENDED TO SUPERCEDE SLOPES DEFINED BY SPOT ELEVATIONS.
- WITHIN THE LIMITS OF ACCESSIBLE PARKING AREA AND ACCESSIBLE DROP OFF ZONE THE SLOPE OF PAVEMENT SHALL NOT EXCEED 1.8% IN ANY DIRECTION.
- TRANSITIONS BETWEEN ASPHALT AND CONCRETE SHALL BE FLUSH UNLESS SEPARATED BY CURB OR NOTED OTHERWISE.

GENERAL NOTES:


- AT LIMITS OF NEW CONCRETE ADJACENT TO LANDSCAPING PROVIDE A 4:1 MAXIMUM TRANSITION TO EXISTING GRADE WITH TOPSOIL. ADJUST EXISTING IRRIGATION HEADS TO FINISH GRADE AND PROVIDE SOD IN GRASS AREAS TO RESTORE TO EXISTING CONDITION.
- ALL TRANSITIONS TO EXISTING PAVEMENT SHALL BE A SMOOTH AND LEVEL TRANSITION.
- WIDTH OF NEW SIDEWALKS SHALL MATCH WIDTH OF EXISTING, ADJACENT, SIDEWALKS.
- SEE ARCHITECTURAL PLANS FOR EXPANSION AND CONTROL JOINT LAYOUT.

GRADING NOTES

- MATCH EXISTING GRADE.
- PROPOSED SIDEWALK ELEVATION SHALL MEET FLUSH WITH EXISTING FINISH FLOOR.
- CONSTRUCT SWALE.
- GRADE UNIFORMLY TO SWALE AND/OR INLET.
- ADJUST EXISTING STRUCTURE TO FINISH GRADE.
- CONSTRUCT CONCRETE CURB PER ~~C5.1~~
- CONSTRUCT CONCRETE VALLEY CUTTER PER ~~C5.1~~
- CONSTRUCT ROLLED CURB PER ~~C5.1~~
- PROVIDE 10' TRANSITIONS FROM VERTICAL TO ROLLED CURB.
- CONSTRUCT CURB OPENINGS PER ~~C5.1~~
- CONSTRUCT FLUSH CONCRETE CURB PER ~~C5.1~~
- CONSTRUCT OUTER PER ~~C5.1~~
- PROVIDE 2:1 TRANSITION FROM VERTICAL CURB TO FLUSH.

- CONSTRUCT SEAT WALL PER ~~C5.1~~
- CONSTRUCT MONSTRIP AT BASE OF FENCE PER ~~C5.1~~
- CONSTRUCT BICOVILE PER ~~C5.1~~
- CONSTRUCT DROP OFF PER ~~C5.1~~
- CONSTRUCT STAIRS PER ~~C5.1~~

GRAPHIC SCALE

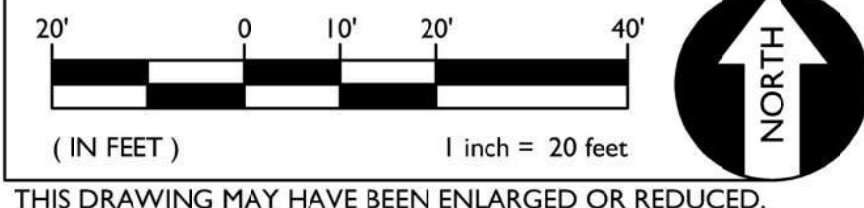

IDENTIFICATION STAMP
DIV. OF THE STATE ARCHITECT
APP: 02-120455 INC:
REVIEWED FOR
SS ☒ FLS ☒ ACS ☒
DATE: 01/12/2023

730 Howe Avenue, Suite 450
Sacramento, CA 95825
Phone: 916.921.2112
Fax: 916.921.2212



MODERNIZATION LAKEWOOD
ELEMENTARY SCHOOL


PARTIAL GRADING PLAN

CONSULTANT

WCE
WARREN CONSULTING ENGINEERS, INC.
1117 WINFIELD WAY, SUITE 110
EL DORADO HILLS, CA 95762 | (916) 985-1870

PROJECT NO.	REVISIONS	BY
21-32-52		
DATE		
3/28/2022		
DRAWN		
ML/MG		
CHECKED		
MG		
SCALE		
AS NOTED		
CADFILE		
UPDATED		
11/17/2022		
SHEET NO.		

C2.2

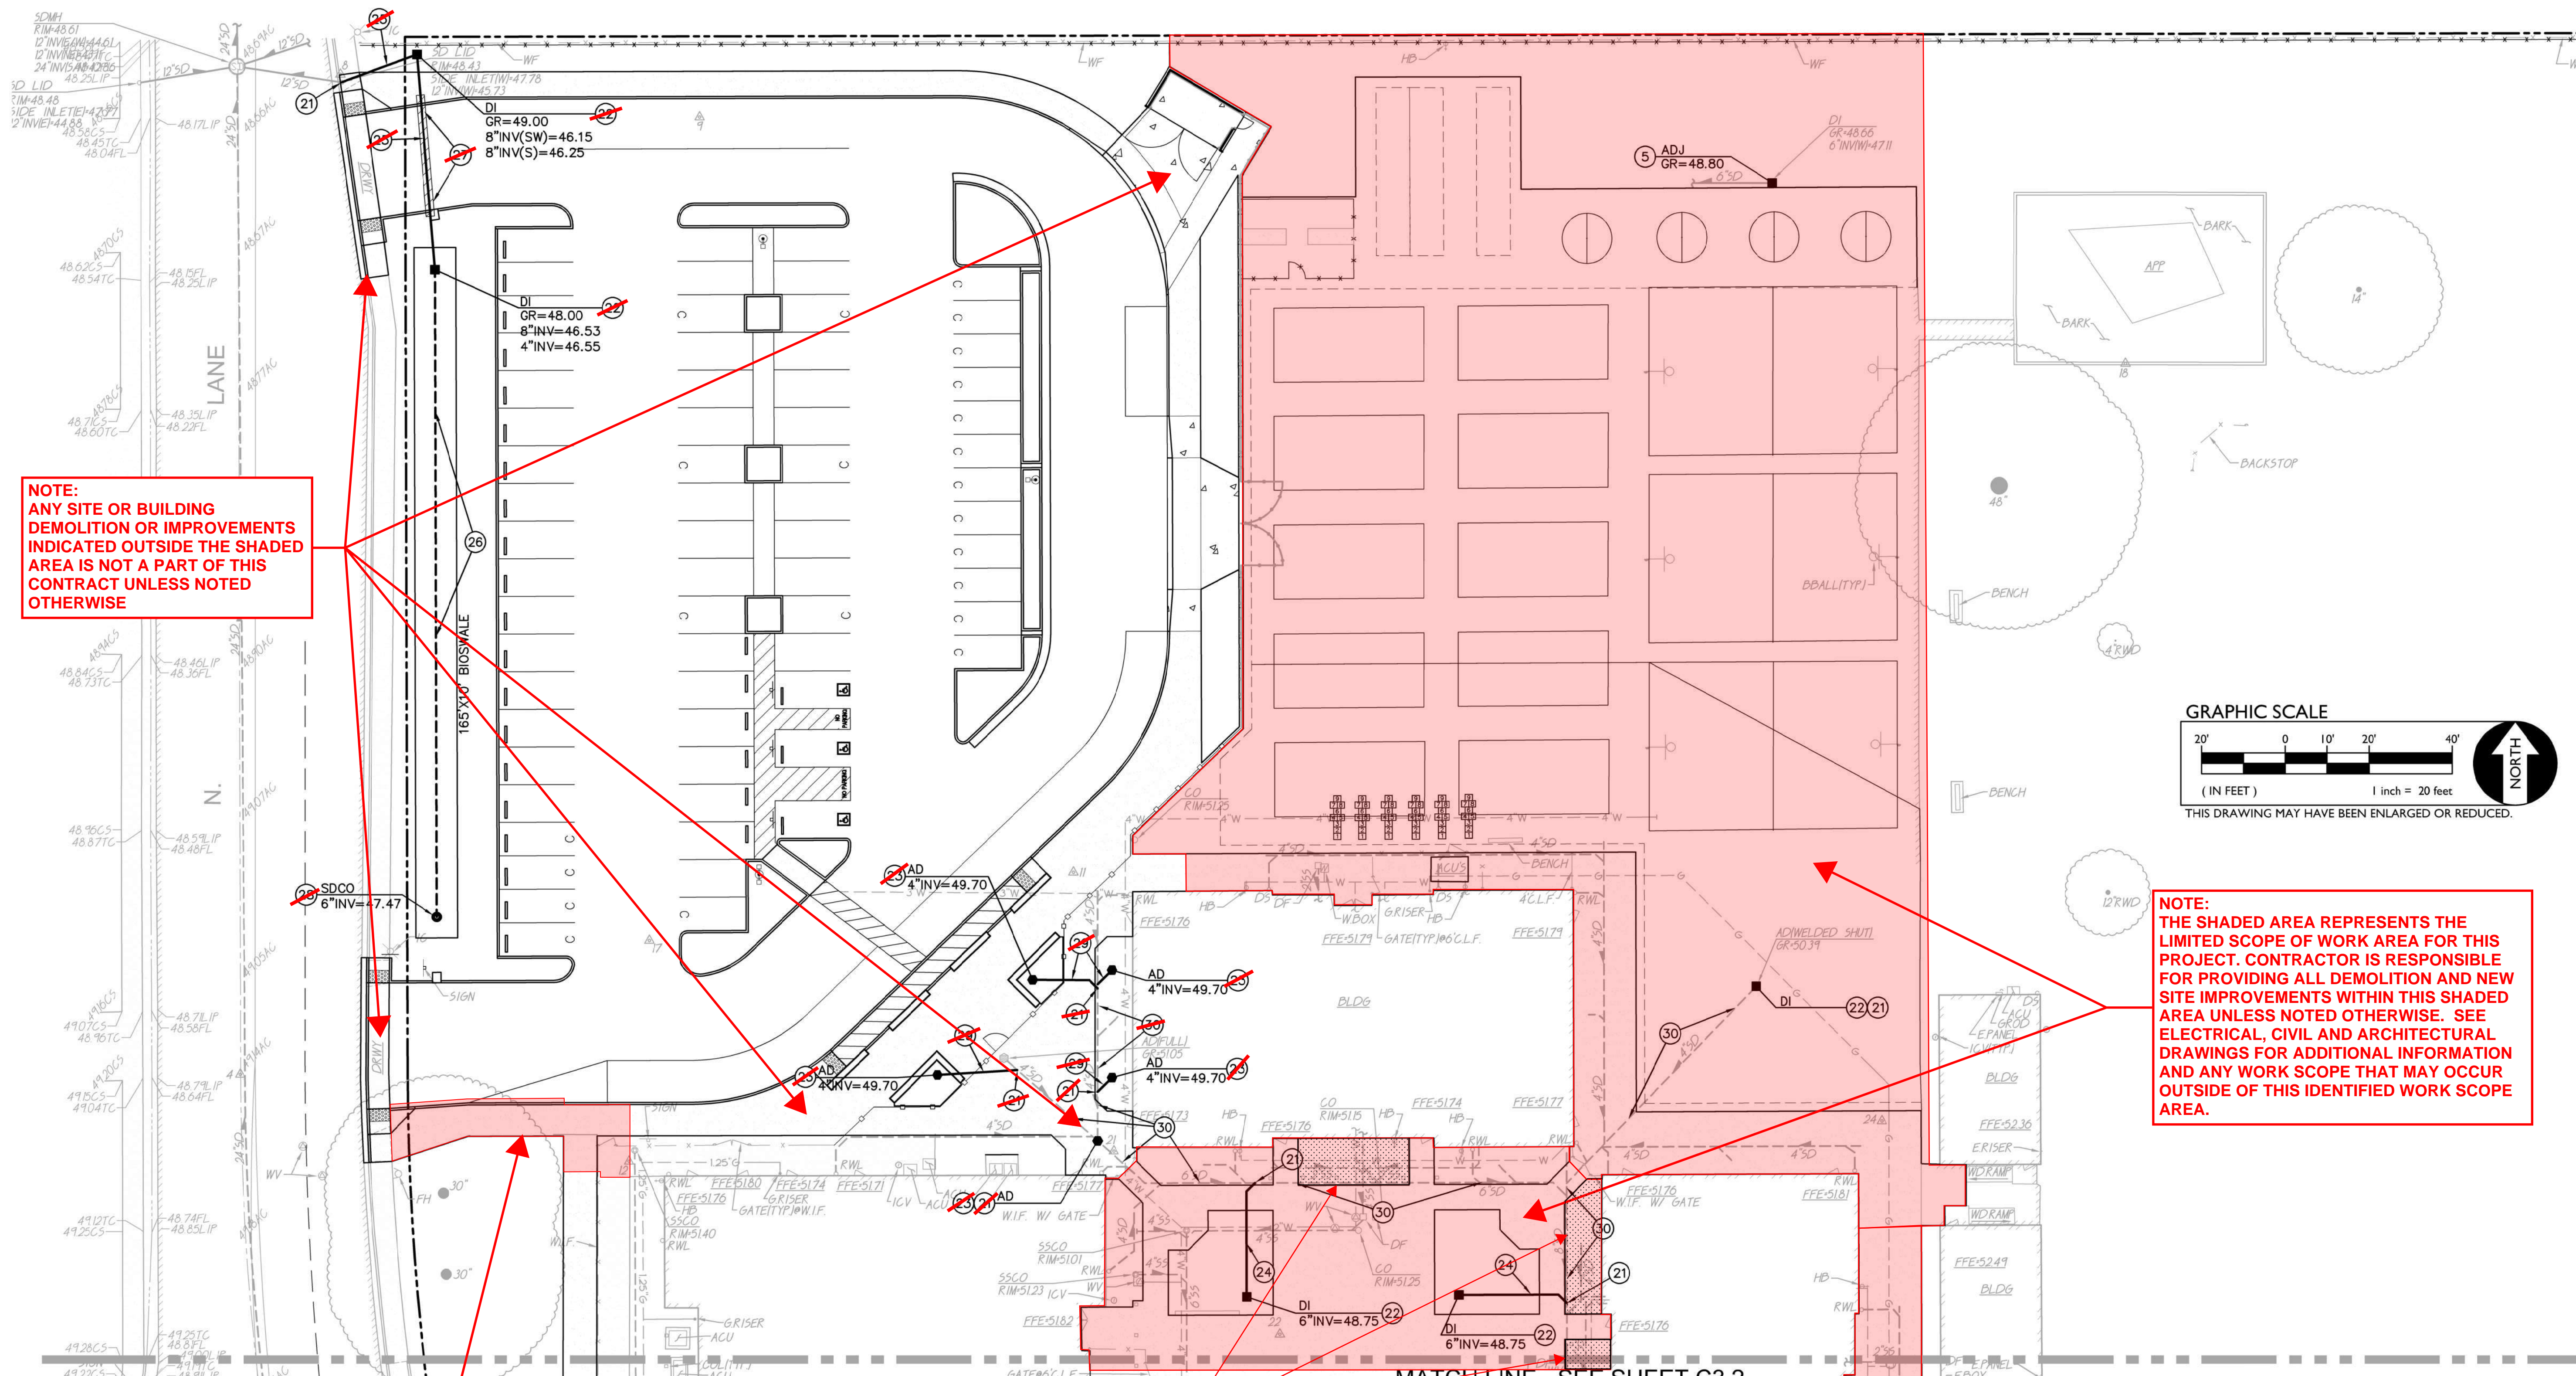

NOTE:
ANY SITE OR BUILDING
DEMOLITION OR IMPROVEMENTS
INDICATED OUTSIDE THE SHADED
AREA IS NOT A PART OF THIS
CONTRACT UNLESS NOTED
OTHERWISE

SEE GRADING PLAN
SHEET C2.1 FOR
PARTIAL REMOVAL
AND REPLACEMENT
OF WALKWAY, CURB
AND A.C.

NOTE:
THE DISTRICT HAS REQUESTED THAT THESE PLANTER
AREAS BE POURED AS (N) CONCRETE WALKWAY
ALONG WITH OTHER ADJACENT WALKWAYS WITHIN
THE QUAD AREA.

NOTE:
THE SHADED AREA REPRESENTS THE
LIMITED SCOPE OF WORK AREA FOR THIS
PROJECT. CONTRACTOR IS RESPONSIBLE FOR
PROVIDING ALL DEMOLITION AND NEW
SITE IMPROVEMENTS WITHIN THIS SHADED
AREA UNLESS NOTED OTHERWISE. SEE
ELECTRICAL, CIVIL AND ARCHITECTURAL
DRAWINGS FOR ADDITIONAL INFORMATION
AND ANY WORK SCOPE THAT MAY OCCUR
OUTSIDE OF THIS IDENTIFIED WORK SCOPE
AREA.

MATCH LINE - SEE SHEET C3.2

DRAINAGE NOTES

- CONNECT TO EXISTING STORM DRAIN PIPING. POTHOLE AND FIELD VERIFY DEPTH AND LOCATION.
- PROVIDE DROP INLET PER

9
C5.1
- PROVIDE AREA DRAIN PER


10
C5.1
- PLACE 6" STORM DRAIN PER SLOPE AT 0.010 MIN.

11
C5.1
- ~~PLACE 8" STORM DRAIN PER SLOPE AT 0.005 MIN.~~
- ~~PLACE 4" SUBDRAIN PER SLOPE AT 0.005 MIN.~~
- ~~PROVIDE 2 BAGG CLURRY BACKFILL TO 6" OVER TOP OF PIPE.~~
- ~~PROVIDE STORM DRAIN CLEANOUT PER

12
C5.1
- PLACE 4" STORM DRAIN PER SLOPE AT 0.020 MIN.

11
C5.1
- CLEAN AND FLUSH EXISTING STORM DRAIN PIPING TO LIMITS NOTED ON PLAN. PUMP ALL DEBRIS FROM SYSTEM.

GRAPHIC SCALE

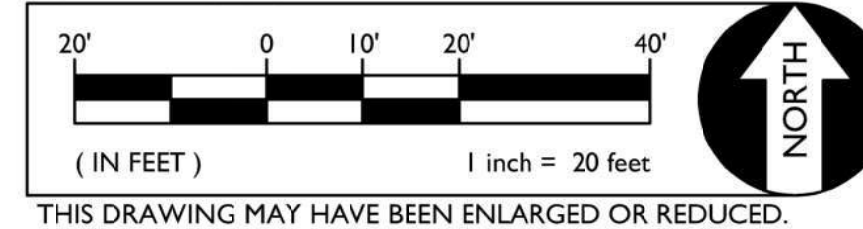

THIS DRAWING MAY HAVE BEEN ENLARGED OR REDUCED.



IDENTIFICATION STAMP
DIV. OF THE STATE ARCHITECT
APP: 02-120455 INC:
REVIEWED FOR
SS ☒ FLS ☒ ACS ☒
DATE: 01/12/2023

730 Howe Avenue, Suite 450
Sacramento, CA 95825
Phone: 916.921.2112
Fax: 916.921.2212



MODERNIZATION LAKEWOOD
ELEMENTARY SCHOOL

PARTIAL UTILITY PLAN


CONSULTANT



WARREN CONSULTING ENGINEERS, INC.
1117 WINFIELD WAY, SUITE 110
EL DORADO HILLS, CA 95762 | (916) 985-1870

PROJECT NO.	REVISIONS	BY
21-32-52		
DATE		
3/28/2022		
DRAWN		
ML/MG		
CHECKED		
MG		
SCALE		
AS NOTED		
CADFILE		
UPDATED		
11/17/2022		
SHEET NO.		

C3.1

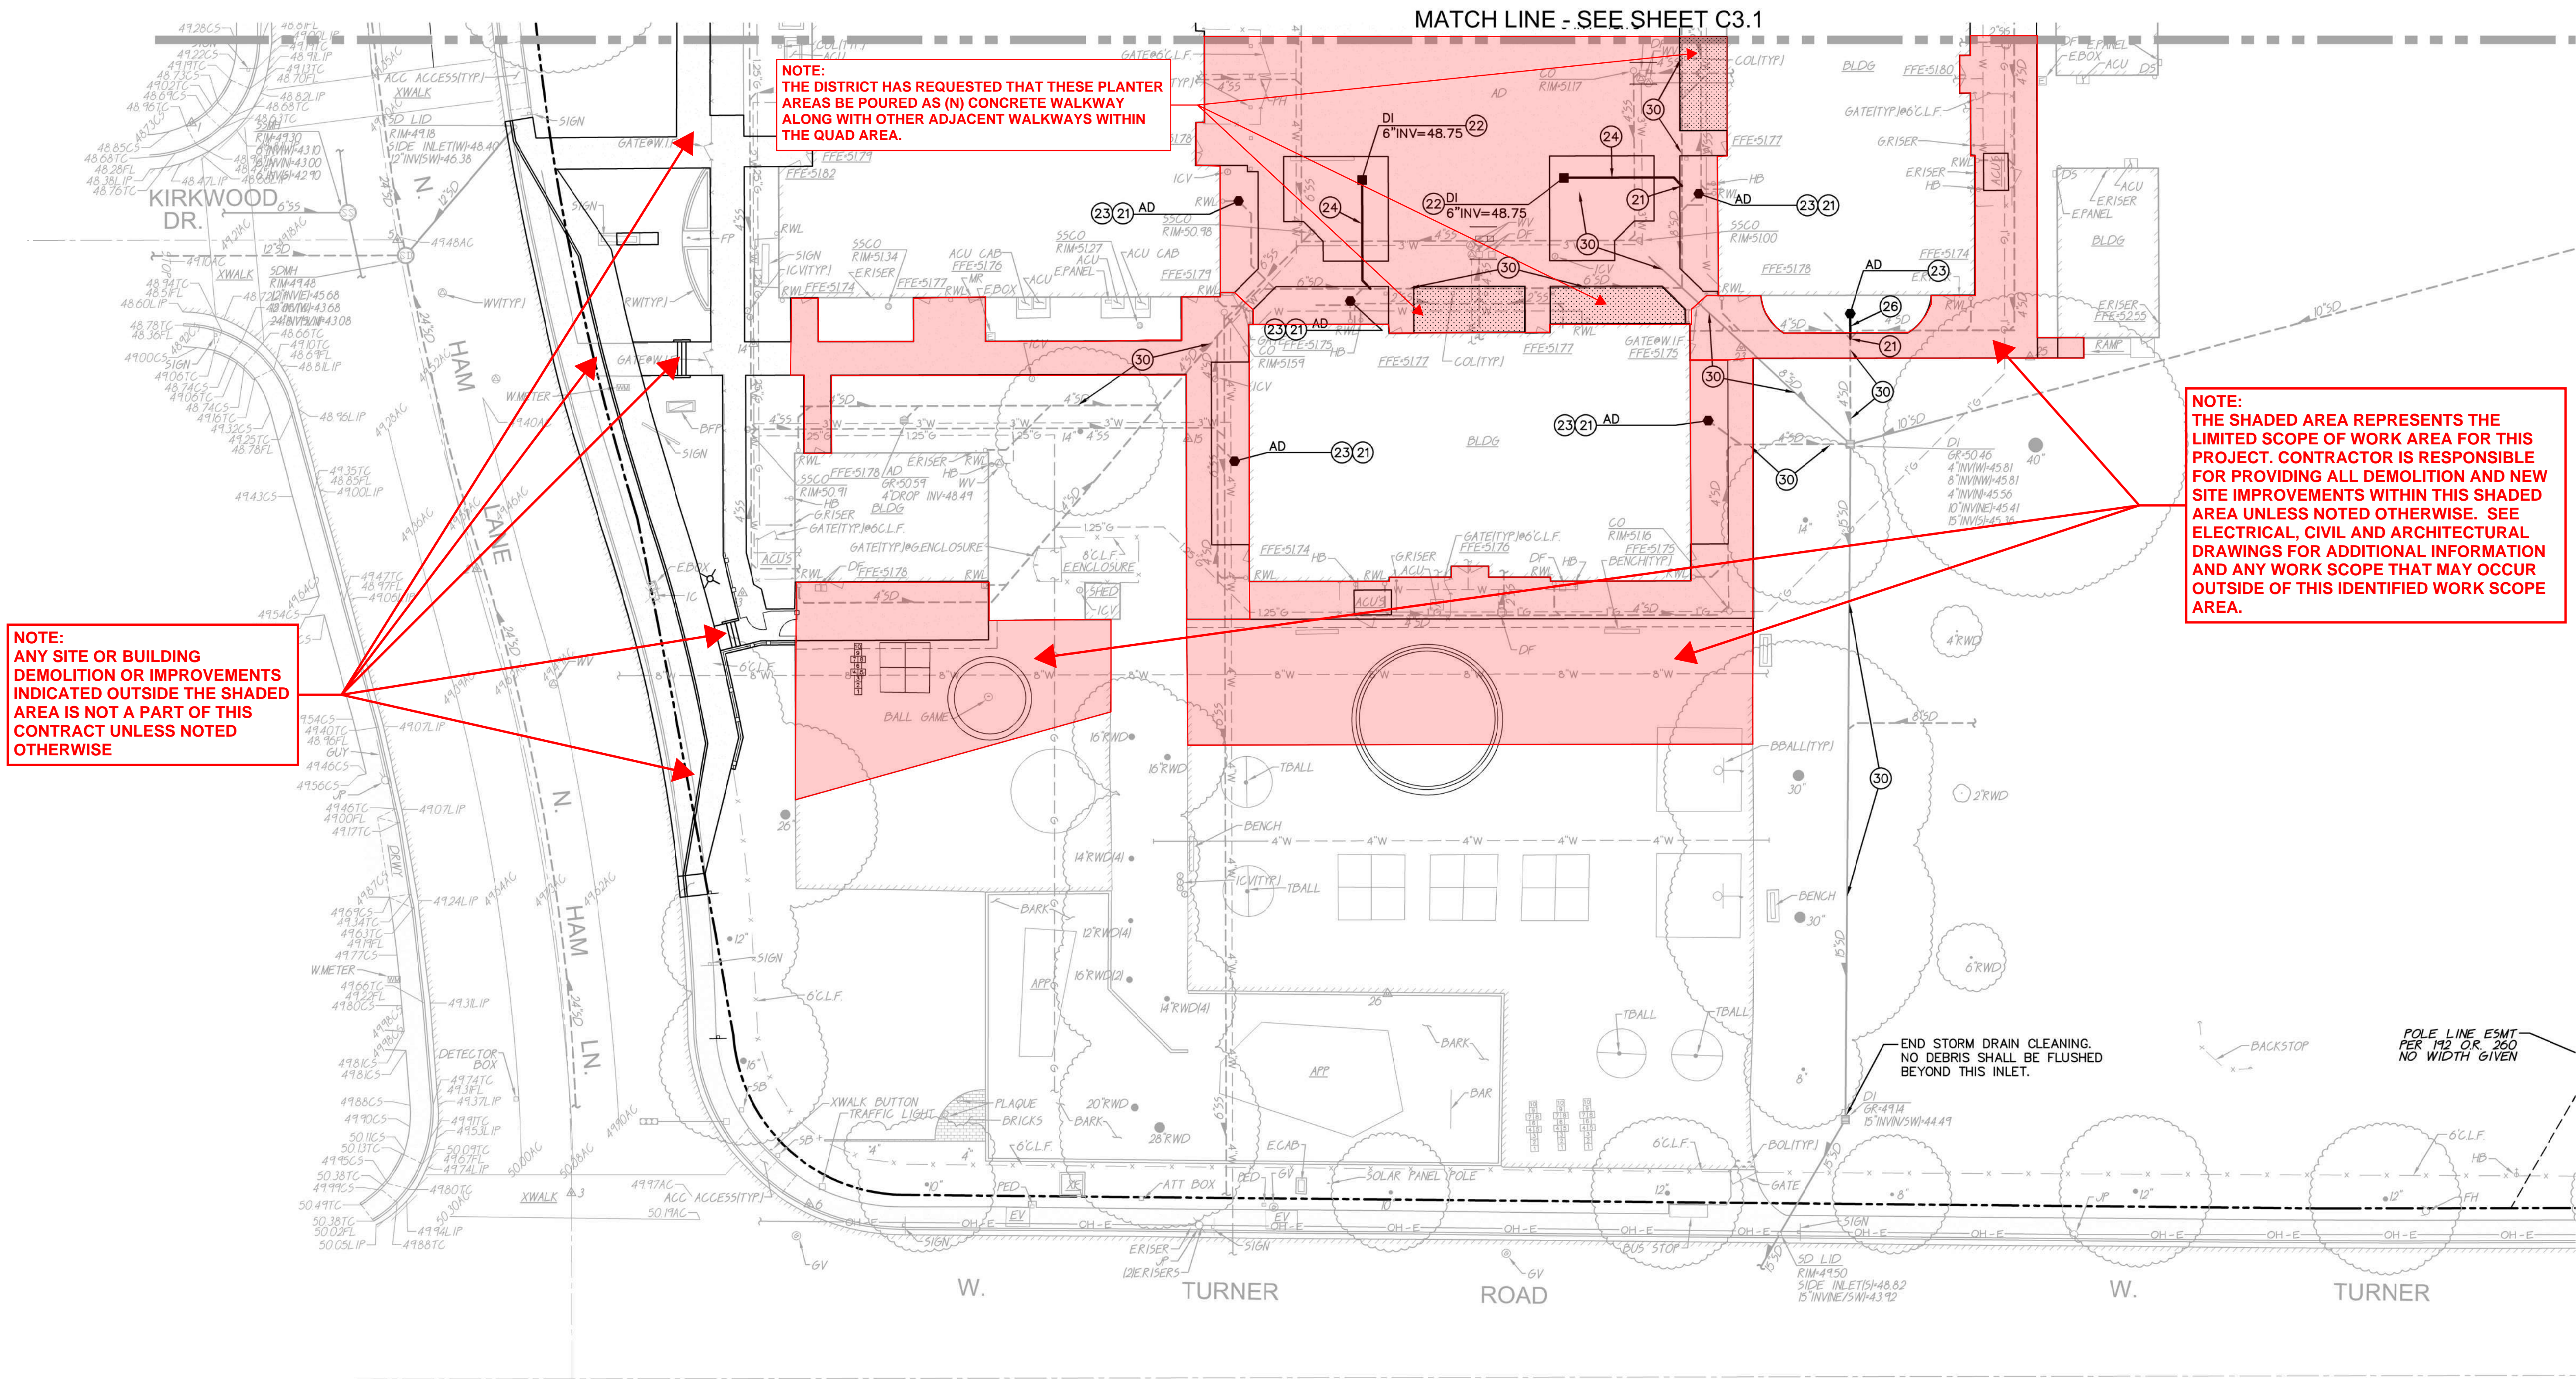

NOTE:
THE DISTRICT HAS REQUESTED THAT THESE PLANTER
AREAS BE POURED AS (N) CONCRETE WALKWAY
ALONG WITH OTHER ADJACENT WALKWAYS WITHIN
THE QUAD AREA.


NOTE:
ANY SITE OR BUILDING
DEMOLITION OR IMPROVEMENTS
INDICATED OUTSIDE THE SHADED
AREA IS NOT A PART OF THIS
CONTRACT UNLESS NOTED
OTHERWISE

NOTE:
THE SHADED AREA REPRESENTS THE
LIMITED SCOPE OF WORK AREA FOR THIS
PROJECT. CONTRACTOR IS RESPONSIBLE
FOR PROVIDING ALL DEMOLITION AND NEW
SITE IMPROVEMENTS WITHIN THIS SHADED
AREA UNLESS NOTED OTHERWISE. SEE
ELECTRICAL, CIVIL AND ARCHITECTURAL
DRAWINGS FOR ADDITIONAL INFORMATION
AND ANY WORK SCOPE THAT MAY OCCUR
OUTSIDE OF THIS IDENTIFIED WORK SCOPE
AREA.

DRAINAGE NOTES

- CONNECT TO EXISTING STORM DRAIN PIPING. POTHOLE AND FIELD VERIFY DEPTH AND LOCATION.
- PROVIDE DROP INLET PER 9 C5.1
- PROVIDE AREA DRAIN PER 10 C5.1
- PLACE 6" STORM DRAIN PER 11 C5.1
SLOPE AT 0.010 MIN.
- ~~PLACE 8" STORM DRAIN PER 11 C5.1
SLOPE AT 0.005 MIN.~~
- ~~PLACE 12" SUBDRAIN PER 11 C5.1
SLOPE AT 0.005 MIN.~~
- ~~PROVIDE 2 BAGG SLURRY BACKFILL TO 6" OVER TOP OF PIPE.~~
- ~~PROVIDE STORM DRAIN CLEANOUT PER 11 C5.1~~
- PLACE 4" STORM DRAIN PER 11 C5.1
SLOPE AT 0.020 MIN.
- CLEAN AND FLUSH EXISTING STORM DRAIN PIPING TO LIMITS NOTED ON PLAN. PUMP ALL DEBRIS FROM SYSTEM.

GRAPHIC SCALE

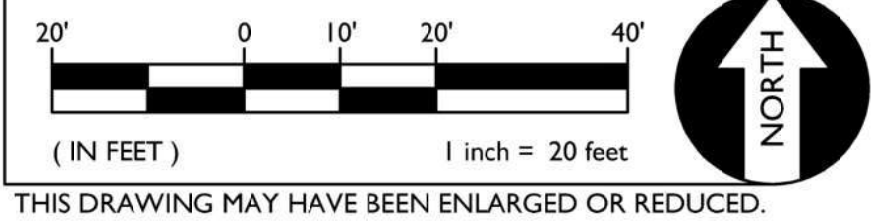

IDENTIFICATION STAMP
DIV. OF THE STATE ARCHITECT
APP: 02-120455 INC:
REVIEWED FOR
SS ☒ FLS ☒ ACS ☒
DATE: 01/12/2023

730 Howe Avenue, Suite 450
Sacramento, CA 95825
Phone: 916.921.2112
Fax: 916.921.2212



MODERNIZATION LAKEWOOD
ELEMENTARY SCHOOL

PARTIAL UTILITY PLAN

CONSULTANT



PROJECT NO.	REVISIONS	BY
21-32-52		
DATE		
3/28/2022		
DRAWN		
ML/MG		
CHECKED		
MG		
SCALE		
AS NOTED		
CADFILE		
UPDATED		
11/17/2022		
SHEET NO.		



C3.2

NOTE:
ANY SITE OR BUILDING
DEMOLITION OR IMPROVEMENTS
INDICATED OUTSIDE THE SHADED
AREA IS NOT A PART OF THIS
CONTRACT UNLESS NOTED
OTHERWISE

SEE GRADING PLAN
SHEET C2.1 FOR
PARTIAL REMOVAL
AND REPLACEMENT
OF WALKWAY, CURB
AND A.C.

NOTE:
THE DISTRICT HAS REQUESTED THAT THESE PLANTER
AREAS BE POURED AS (N) CONCRETE WALKWAY
ALONG WITH OTHER ADJACENT WALKWAYS WITHIN
THE QUAD AREA.

NOTE:
THE SHADED AREA REPRESENTS THE
LIMITED SCOPE OF WORK AREA FOR THIS
PROJECT. CONTRACTOR IS RESPONSIBLE FOR
PROVIDING ALL DEMOLITION AND NEW
SITE IMPROVEMENTS WITHIN THIS SHADED
AREA UNLESS NOTED OTHERWISE. SEE
ELECTRICAL, CIVIL AND ARCHITECTURAL
DRAWINGS FOR ADDITIONAL INFORMATION
AND ANY WORK SCOPE THAT MAY OCCUR
OUTSIDE OF THIS IDENTIFIED WORK SCOPE
AREA.

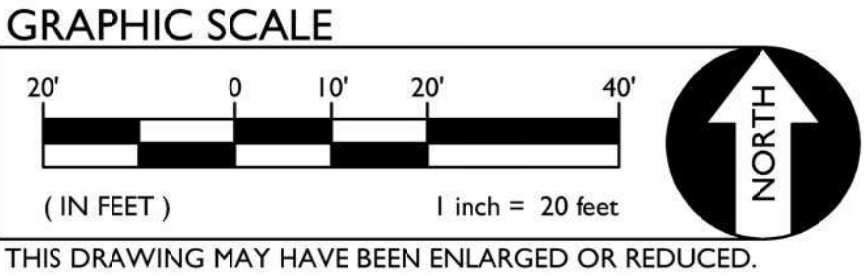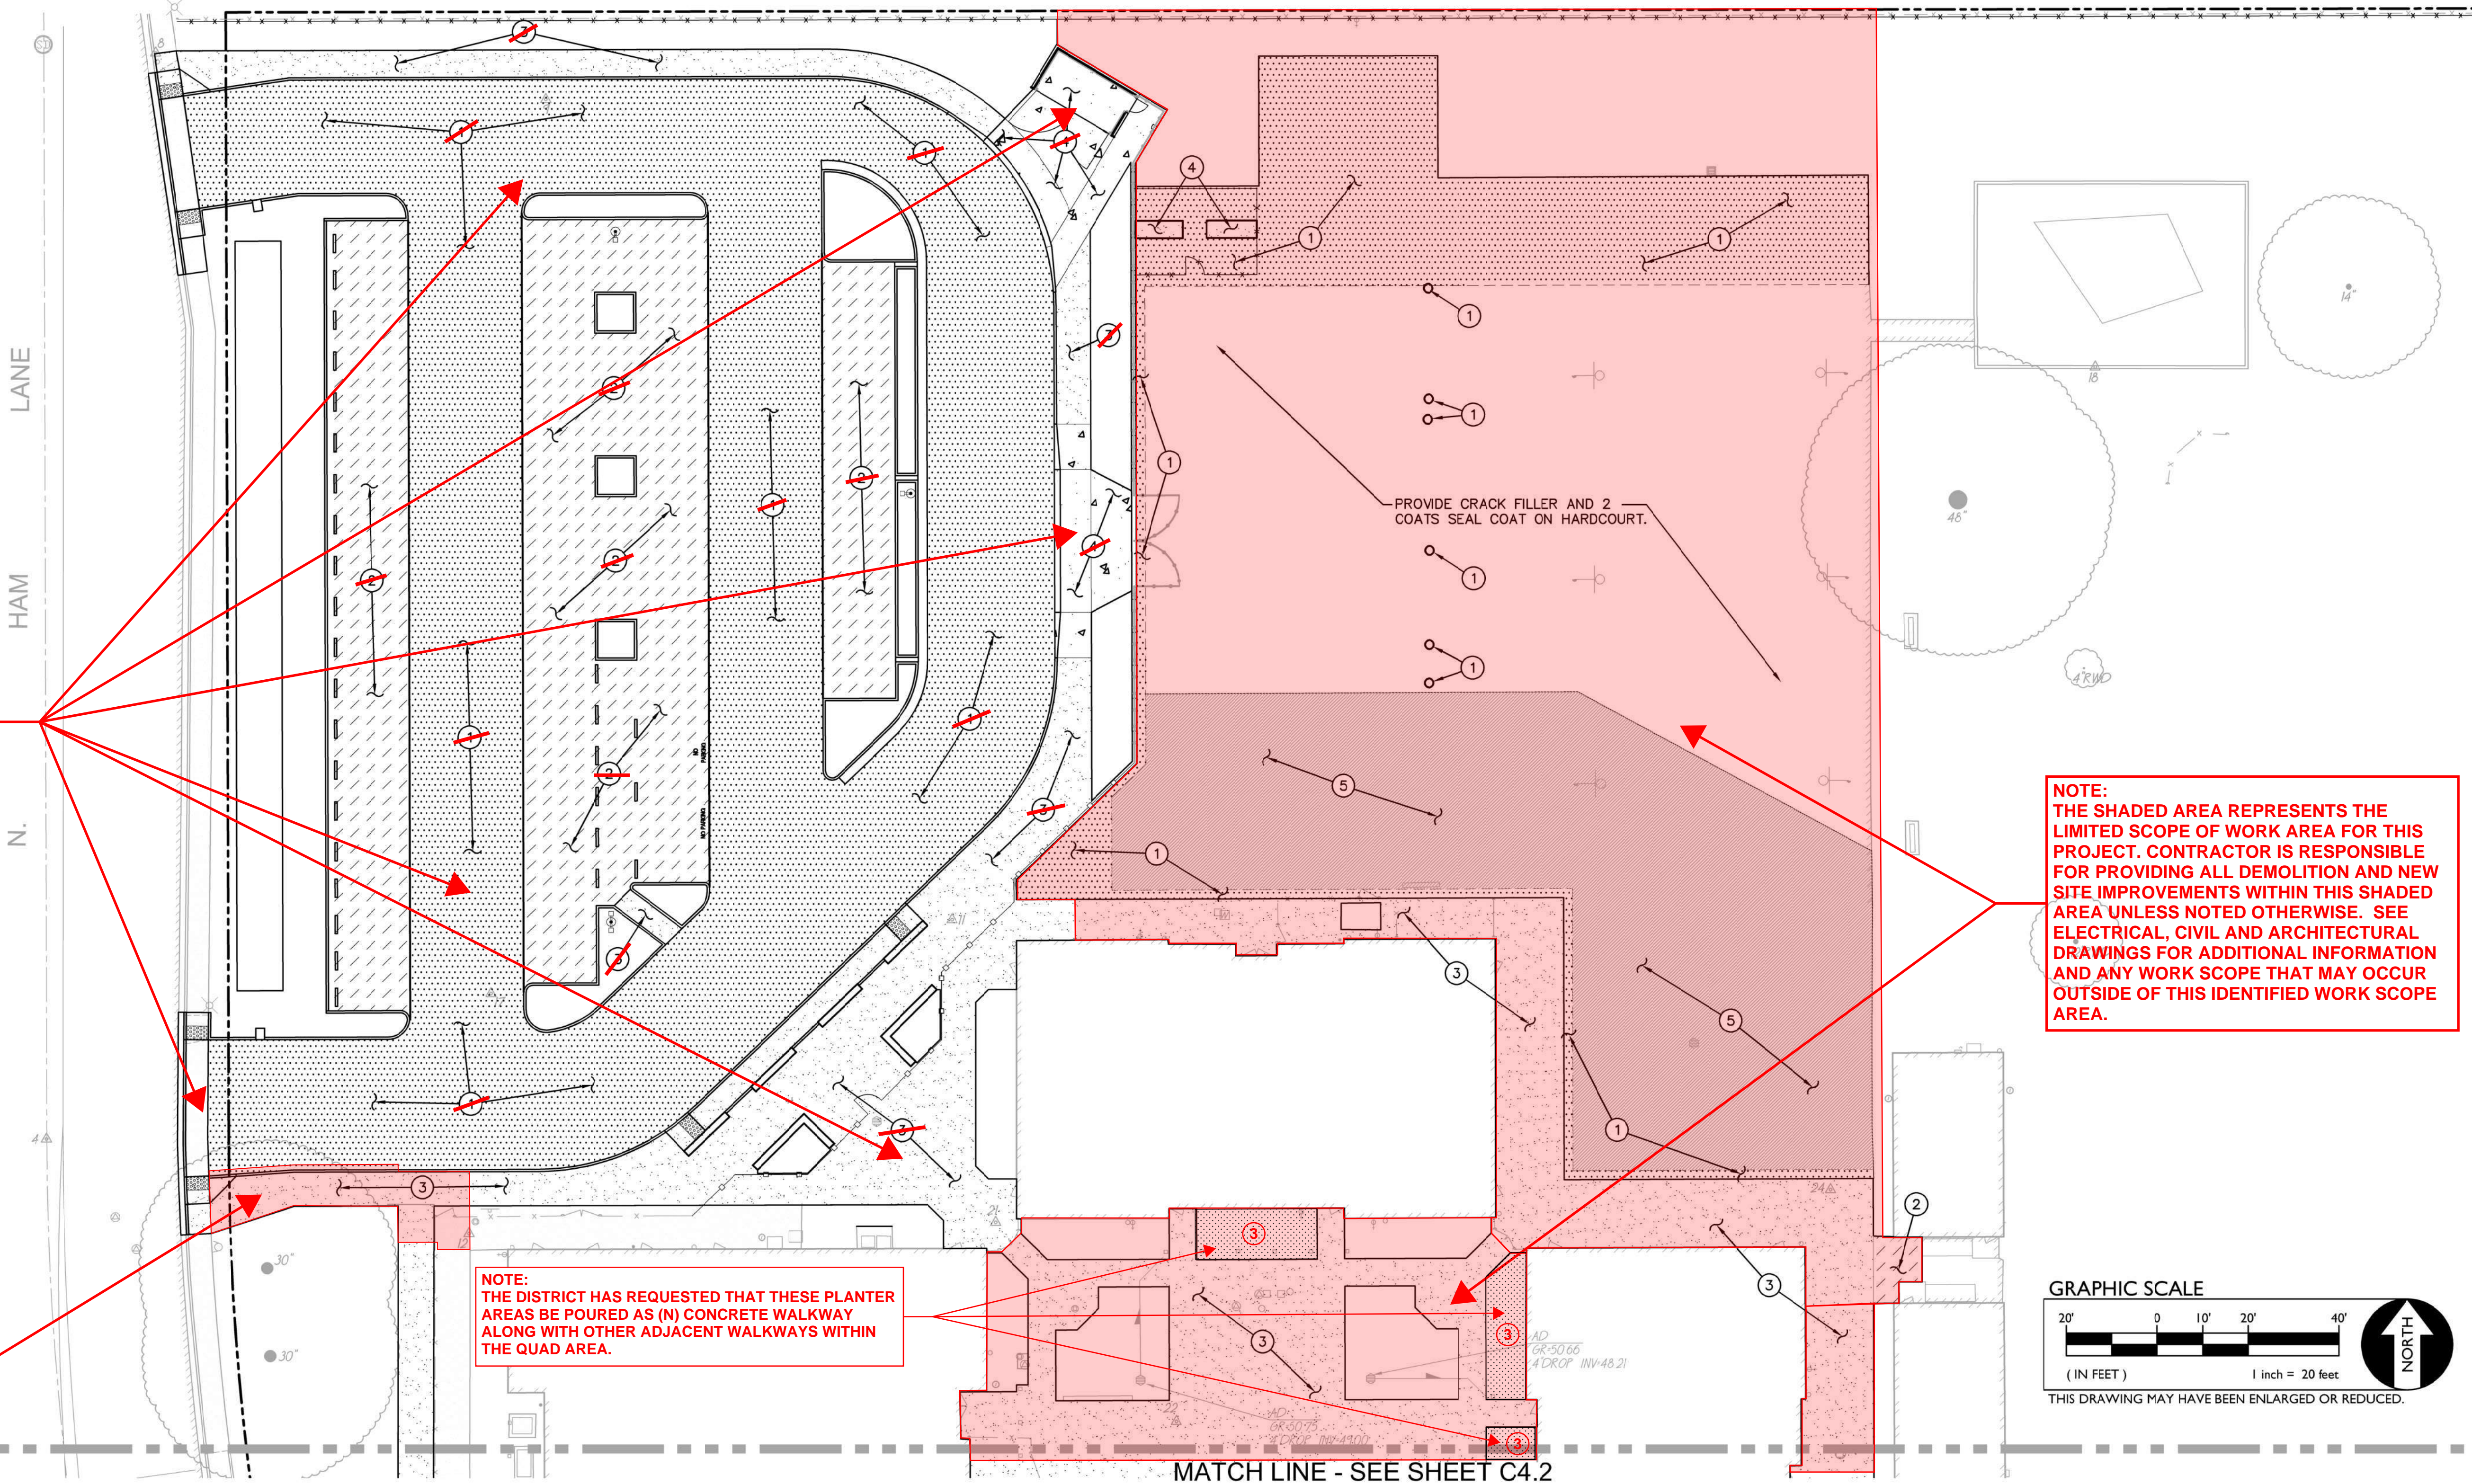

PAVING GENERAL NOTES:

1. REFER TO ARCHITECTURAL PLANS FOR STRIPING LAYOUT.
2. ALL NEW ASPHALT PAVING TO BE PROVIDED WITH SEALCOAT PER SPECIFICATIONS.
3. REFER TO ARCHITECTURAL PLANS FOR CONTROL AND EXPANSION JOINTS, AND CONCRETE FINISH.
4. PRIOR TO NEW SEALCOAT ON EXISTING ASPHALT SURFACES, FILL ALL CRACKS 1/4" INCHES OR WIDER WITH AN APPROVED CRACK FILLER.
5. SLOPE IN ACCESSIBLE STALLS AND UNLOAD ZONES SHALL NOT EXCEED 1.9% IN ANY DIRECTION.
6. SLOPE OF FINISHED PAVING TO BE 1% MINIMUM FOR ASPHALT, 0.5% MINIMUM FOR CONCRETE AND THE MAXIMUM SLOPE SHALL BE AS FOLLOWS:

CROSS SLOPE PERPENDICULAR TO PATH OF TRAVEL - 1.9%
DIRECTION OF TRAVEL - 4.9%
RAMP IN DIRECTION OF TRAVEL - 8.0%
PLAZA 1.9% - IN ANY DIRECTION
6. ALL EXPOSED ASPHALT EDGES SHALL HAVE HEADER BOARDS WHETHER SHOWN OR NOT.
7. ADJUST TO FINISH GRADE ALL UTILITY BOXES, FRAMES, COVERS SLEEVES, POST HOLES GRATES, ETC. FOUND IN AREA OF WORK, WHETHER SHOWN OR NOT. CLEAN OR REPLACE AS NECESSARY TO ENSURE PROPER SEATING.

PAVING LEGEND

- | | |
|--|--|
| | 1. PLACE 3.5" AC OVER 4" AB COMPACTED TO 95% MIN. ON SUBGRADE PER SPECIFICATIONS. |
| | 2. PLACE 2.5" AC OVER 4" AB COMPACTED TO 95% MIN. ON SUBGRADE PER SPECIFICATIONS. |
| | 3. PLACE 4" PCC WITH NO. 3 BARS AT 18" O.C. EACH WAY OVER 4" MIN. AB COMPACTED TO 95% ON SUBGRADE PER SPECIFICATIONS. 1
C5.1 |
| | 4. PLACE 6" PCC WITH NO. 3 BARS AT 18" O.C. EACH WAY OVER 6" MIN. AB COMPACTED TO 95% ON SUBGRADE PER SPECIFICATIONS. 1
C5.1 |
| | 5. PROVIDE 1.5" MIN. AC OVERLAY. GRIND AT LIMITS TO PROVIDE MINIMUM SECTION. |



IDENTIFICATION STAMP
DIV. OF THE STATE ARCHITECT
APP: 02-120455 INC:
REVIEWED FOR
SS ☒ FLS ☒ ACS ☒
DATE: 01/12/2023

730 Howe Avenue, Suite 450
Sacramento, CA 95825
Phone: 916.921.2112
Fax: 916.921.2212



MODERNIZATION LAKEWOOD
ELEMENTARY SCHOOL

PARTIAL PAVING PLAN

CONSULTANT

WCE
WARREN CONSULTING ENGINEERS, INC.
1117 WINDFIELD WAY, SUITE 110
EL DORADO HILLS, CA 95762 | (916) 985-1870



















PROJECT NO.	REVISIONS	BY
21-32-52		
DATE		
3/28/2022		
DRAWN		
ML/MG		
CHECKED		
MG		
SCALE		
AS NOTED		
CADFILE		
UPDATED		
11/17/2022		

SHEET NO.

C4.1



-
- REGISTERED PROFESSIONAL ENGINEER
ANTHONY J. TASSANO
 NO. C74696
 STATE OF CALIFORNIA

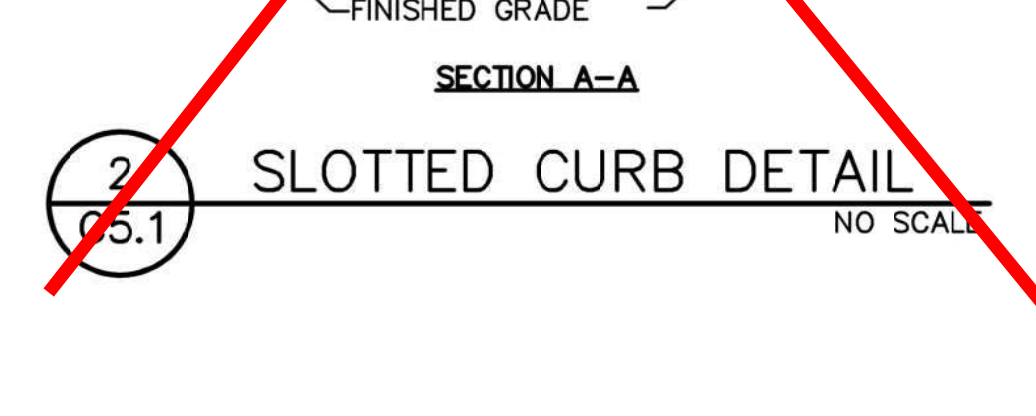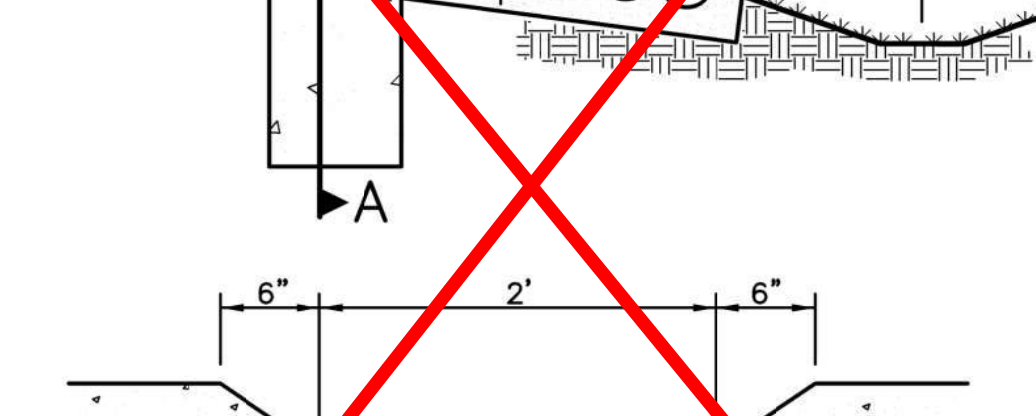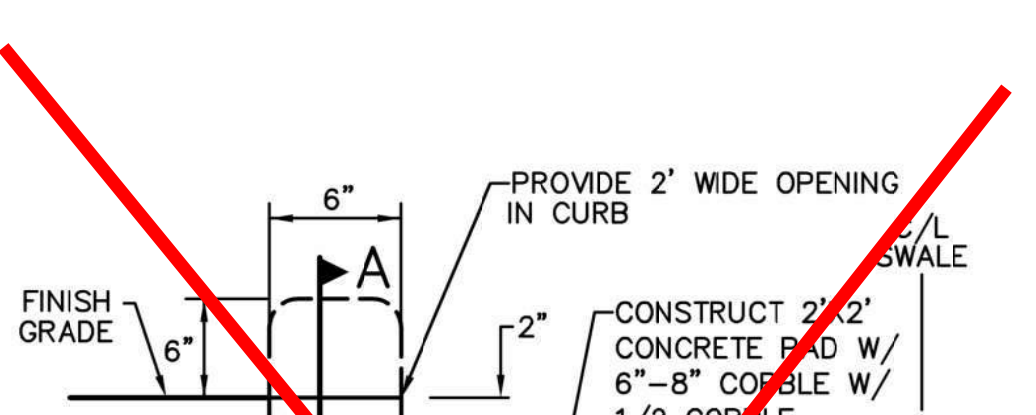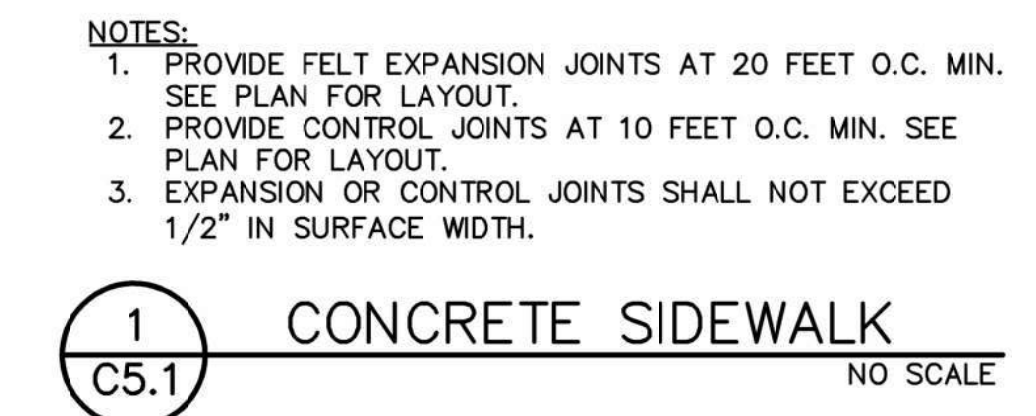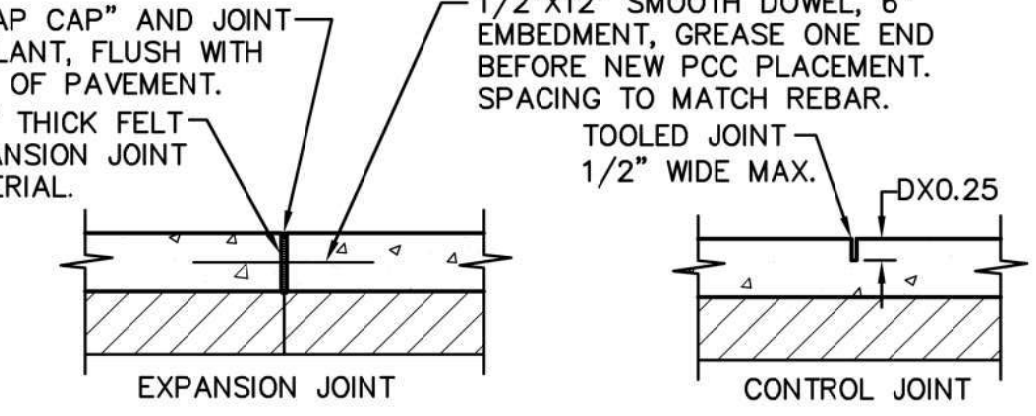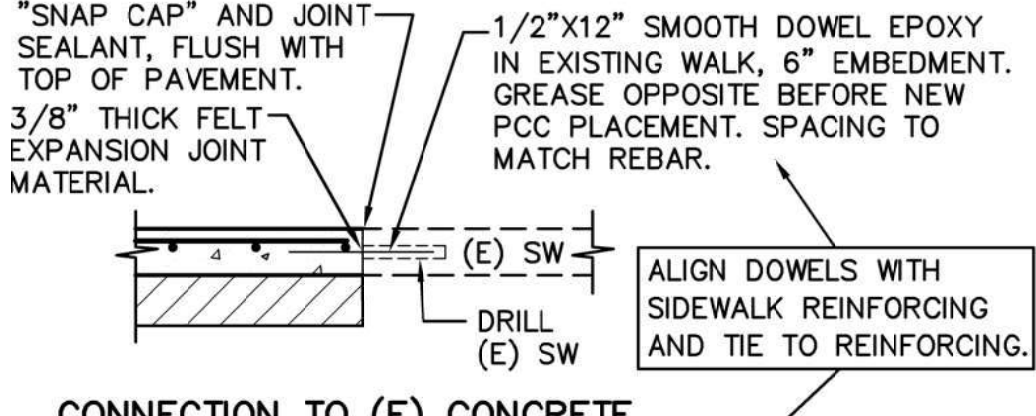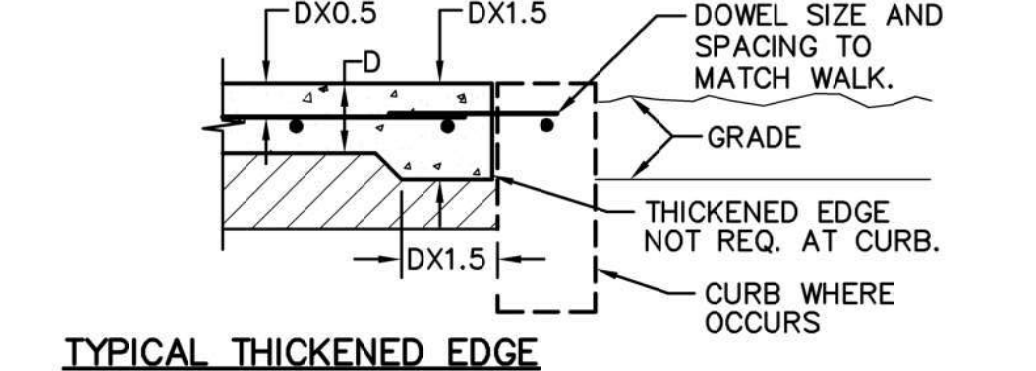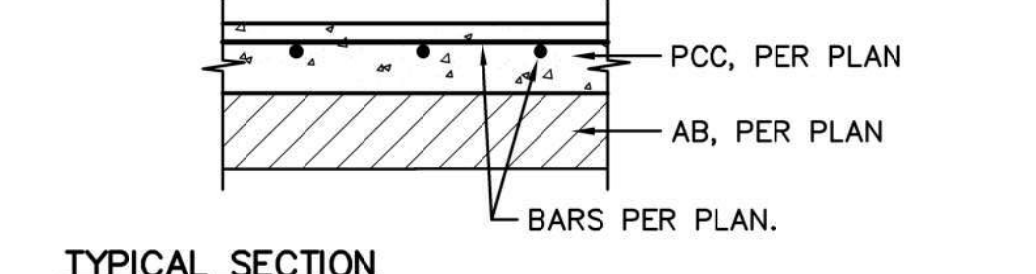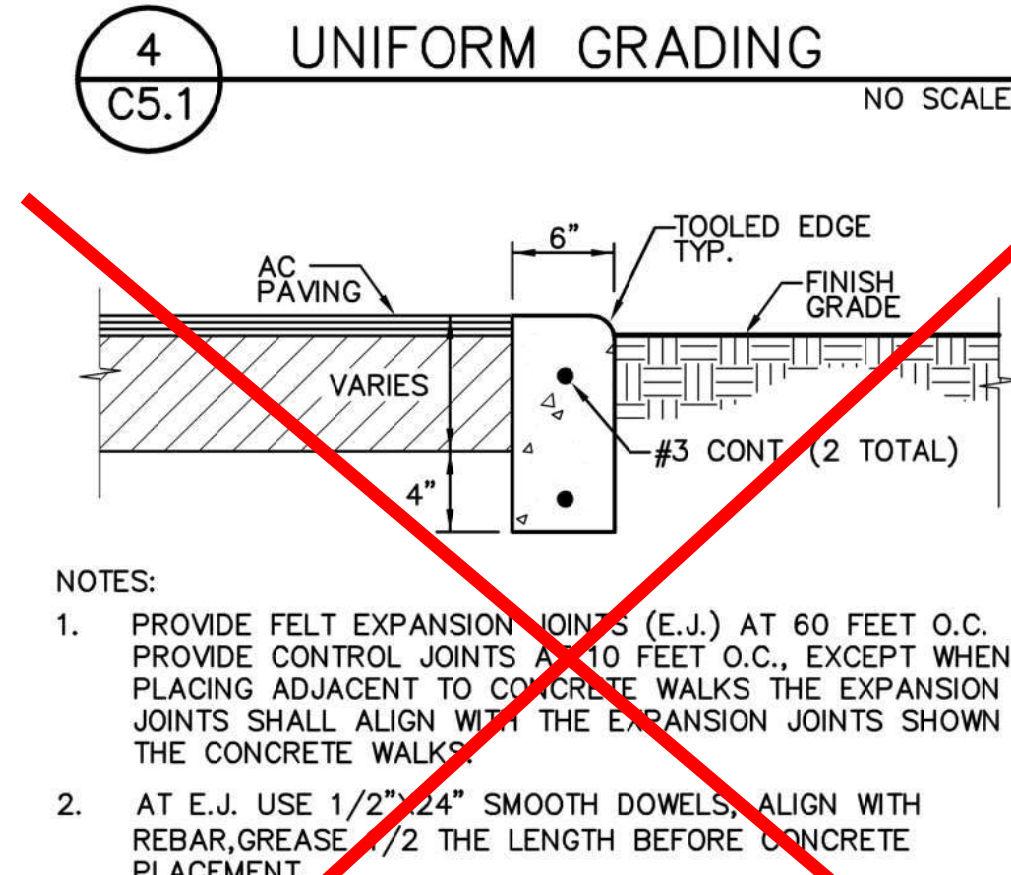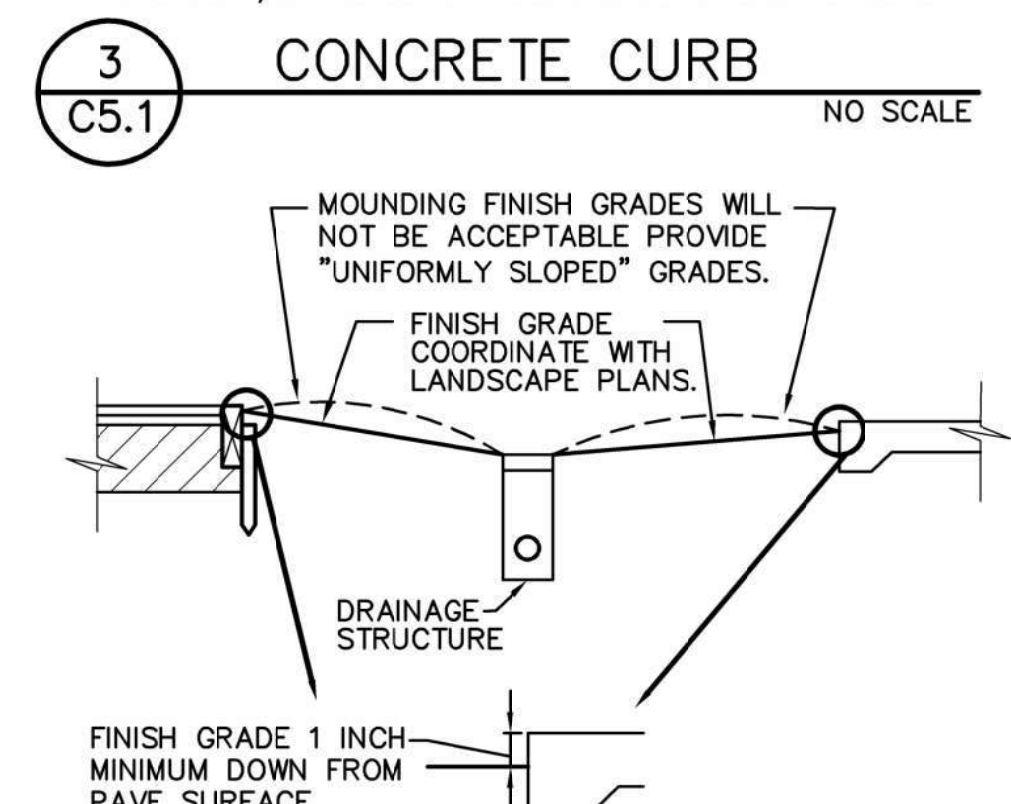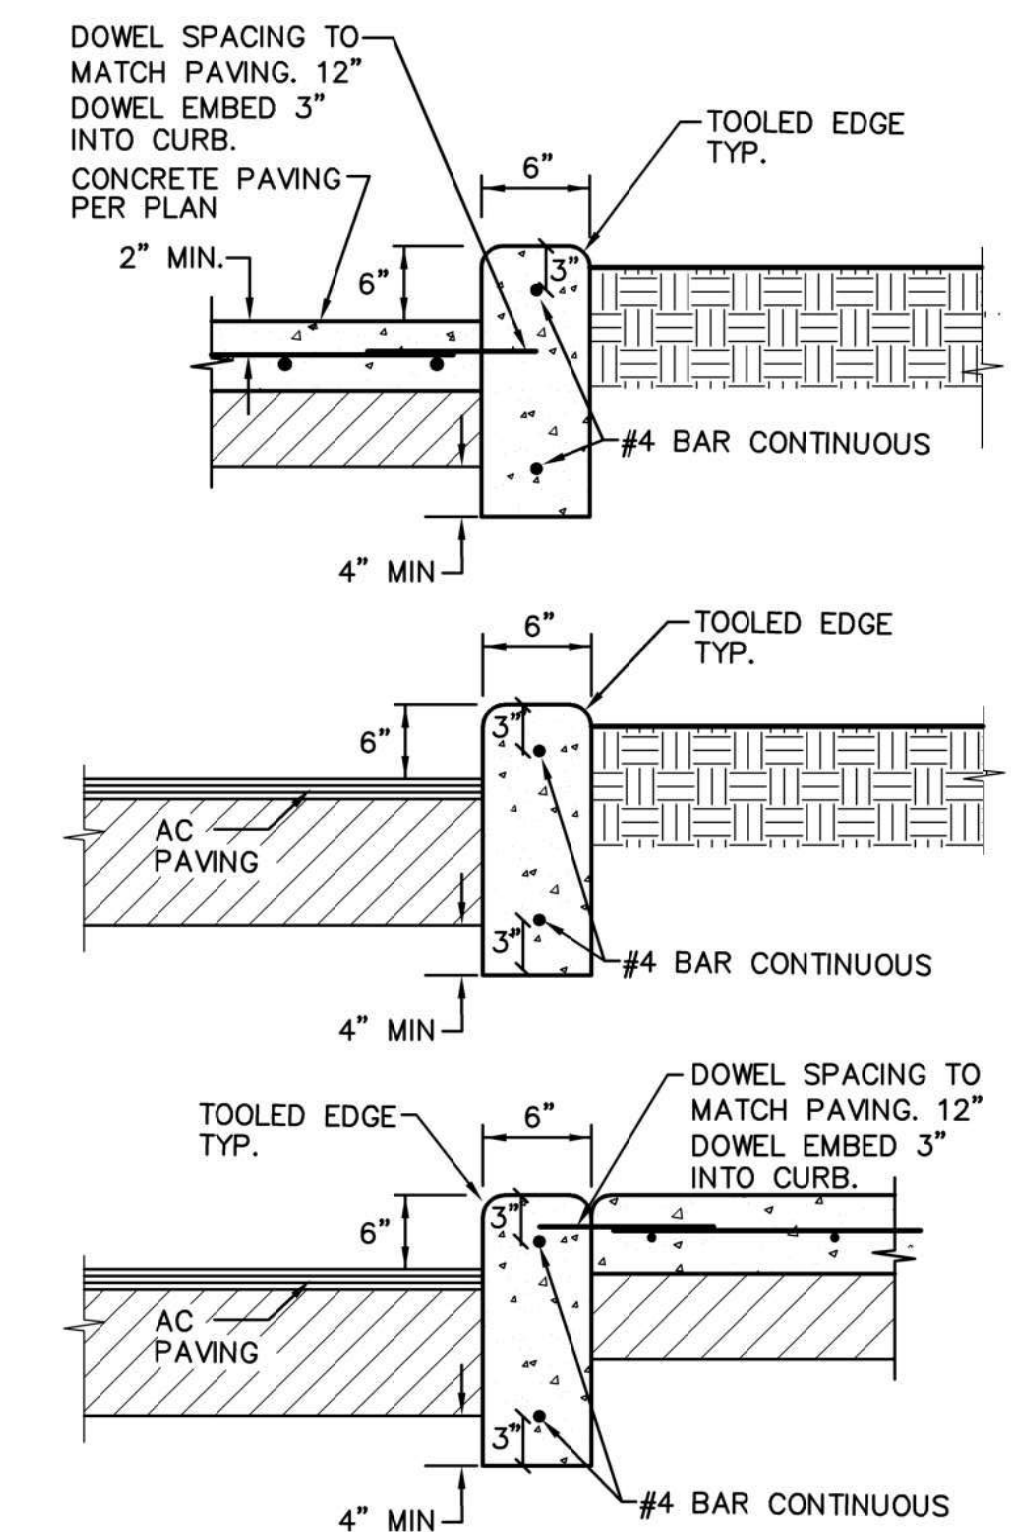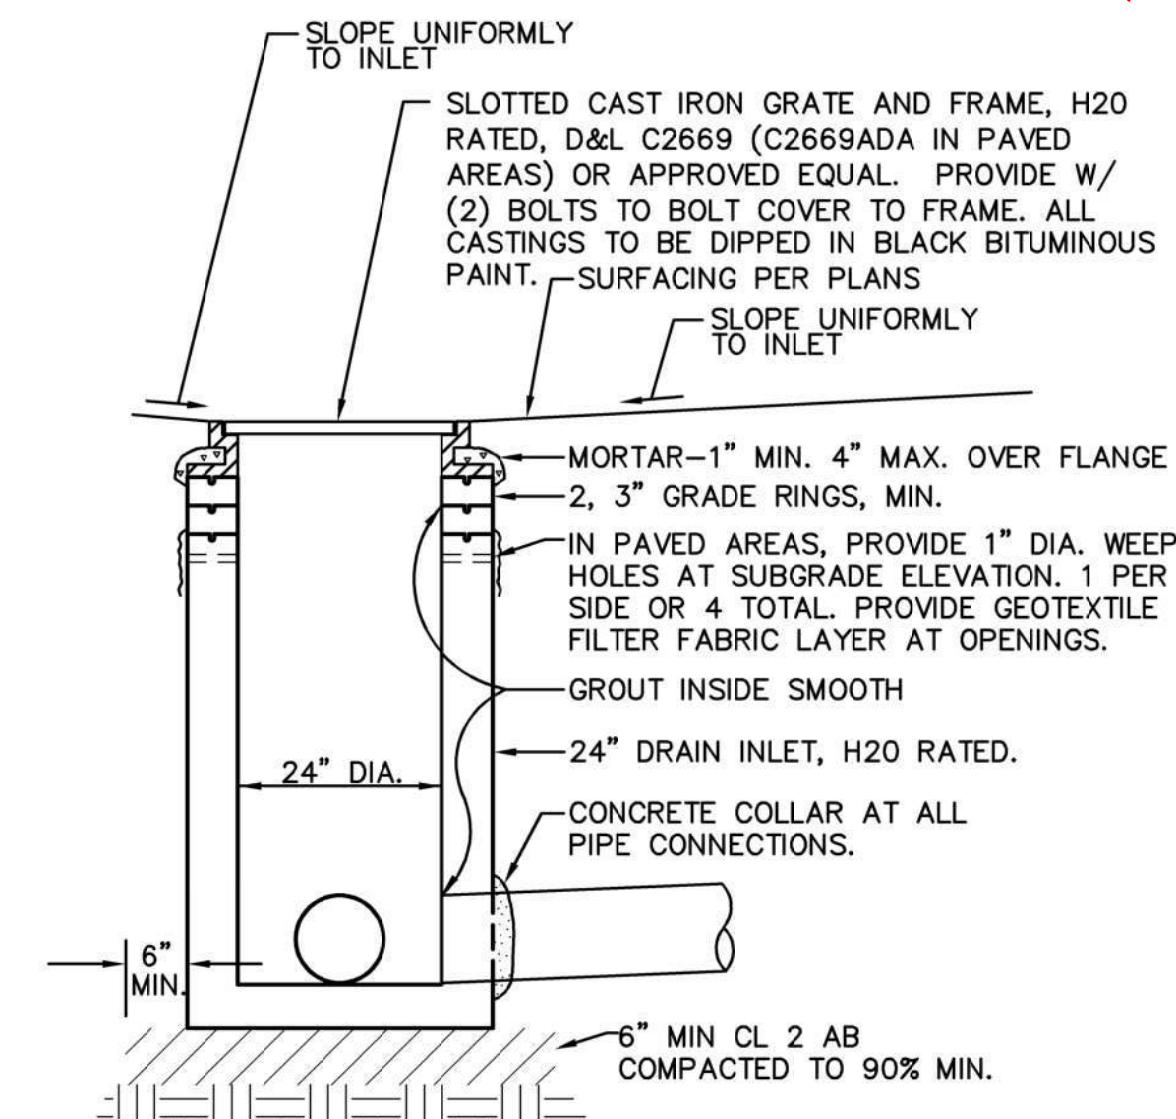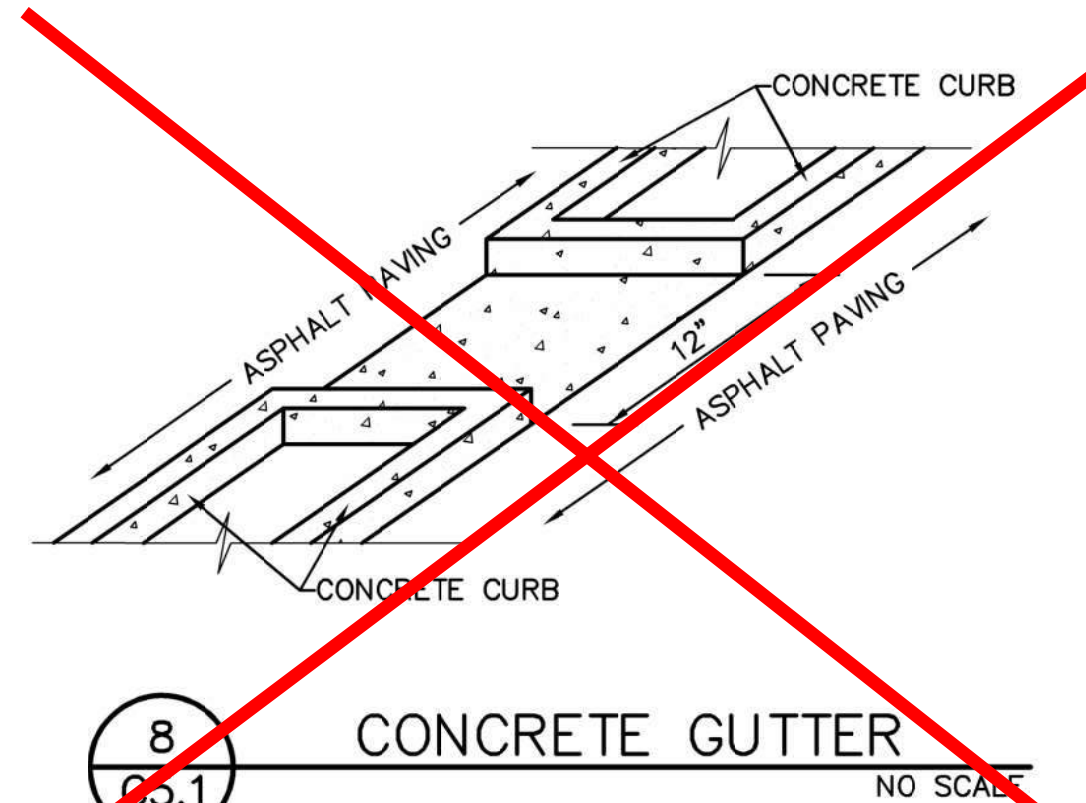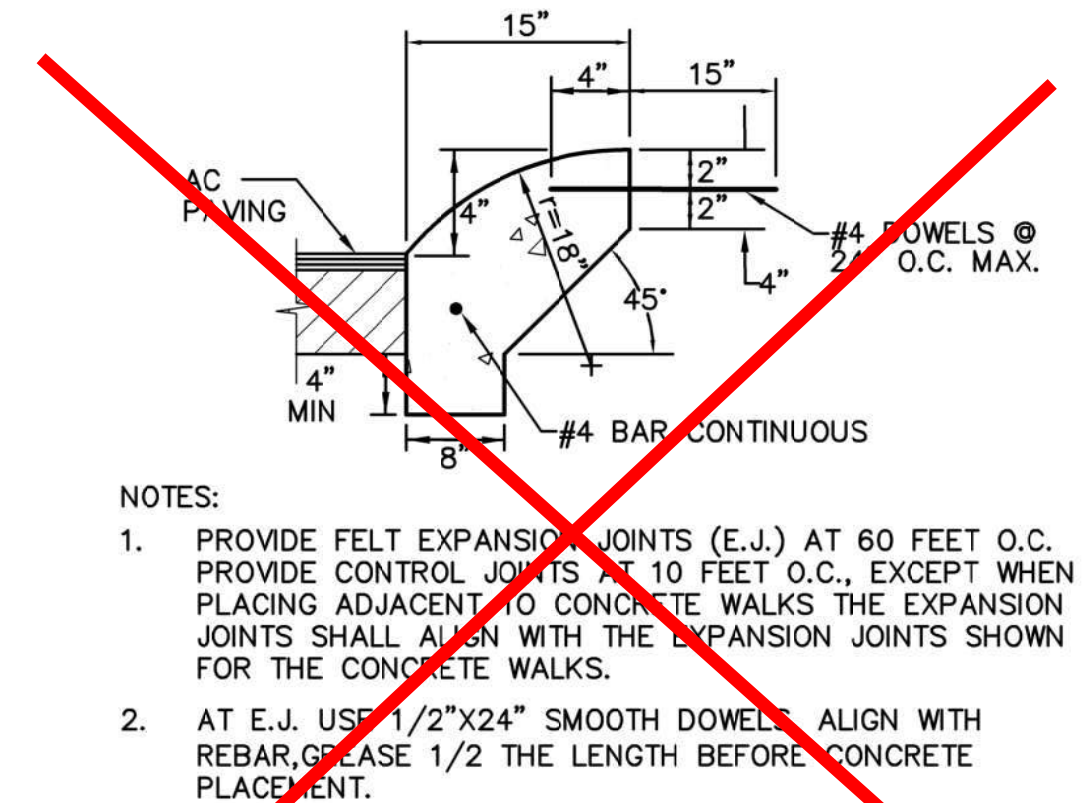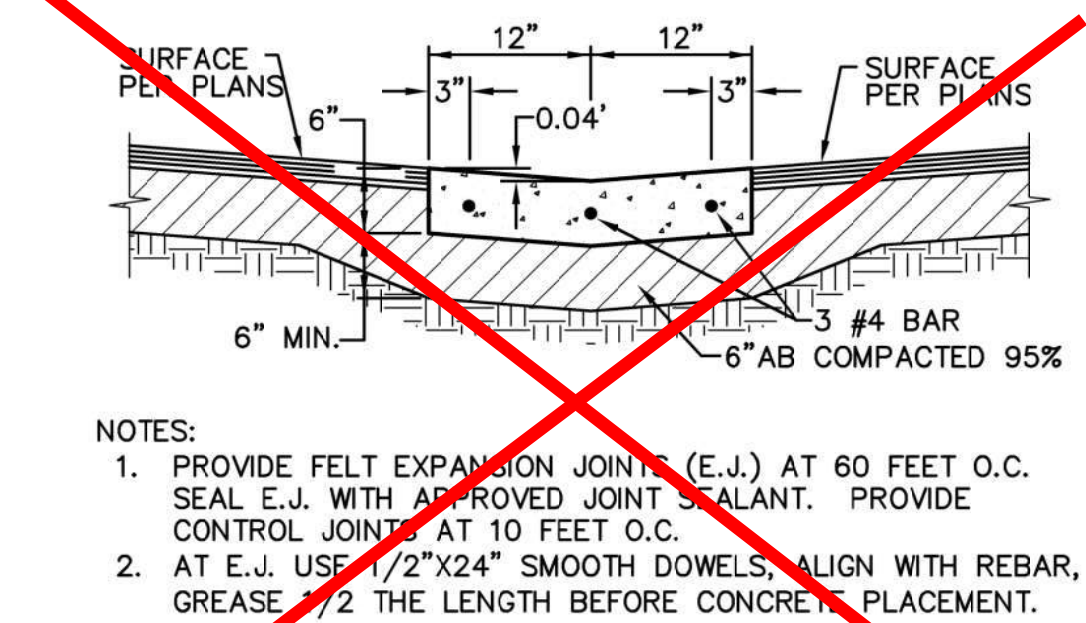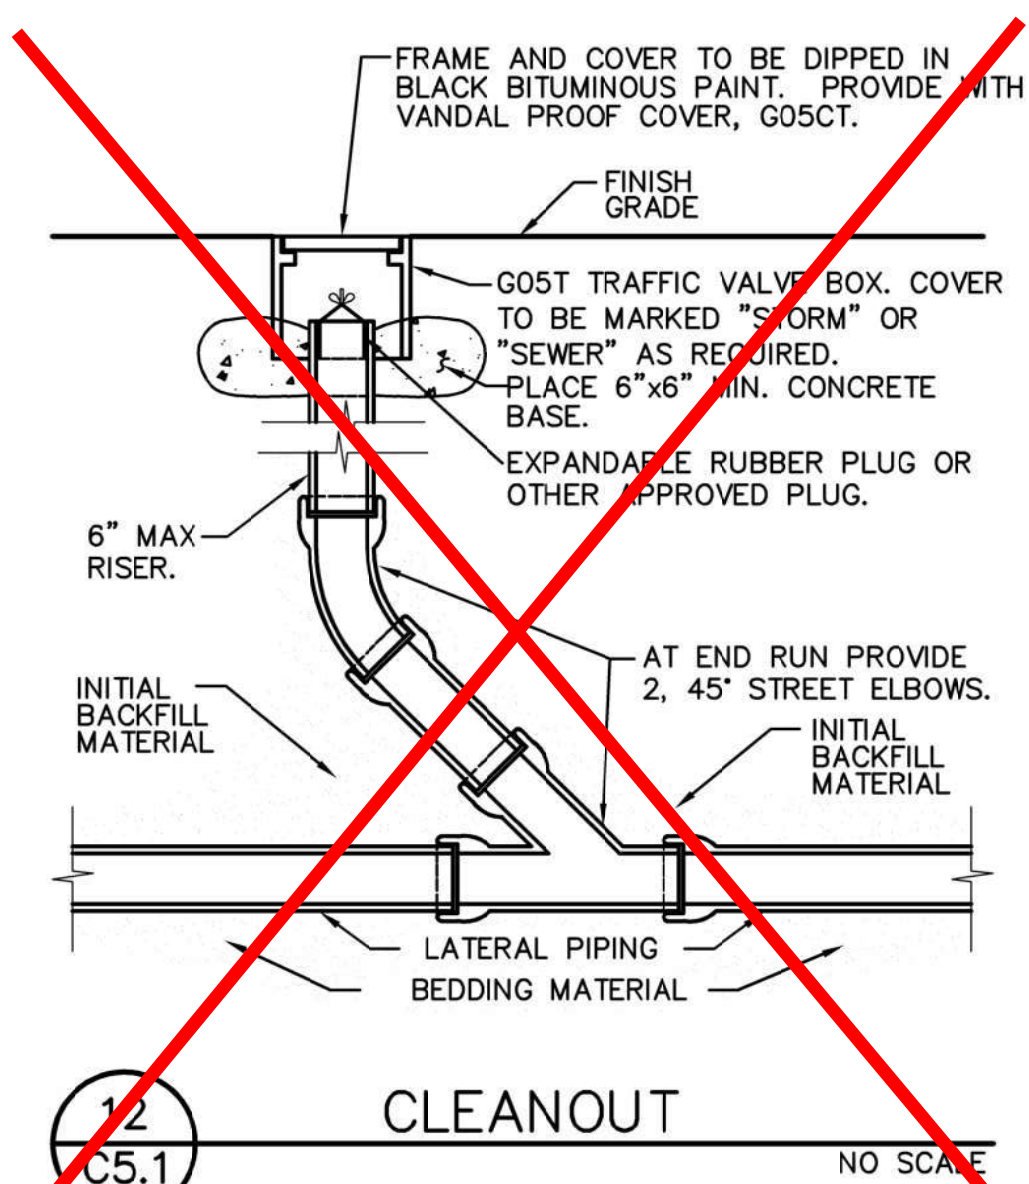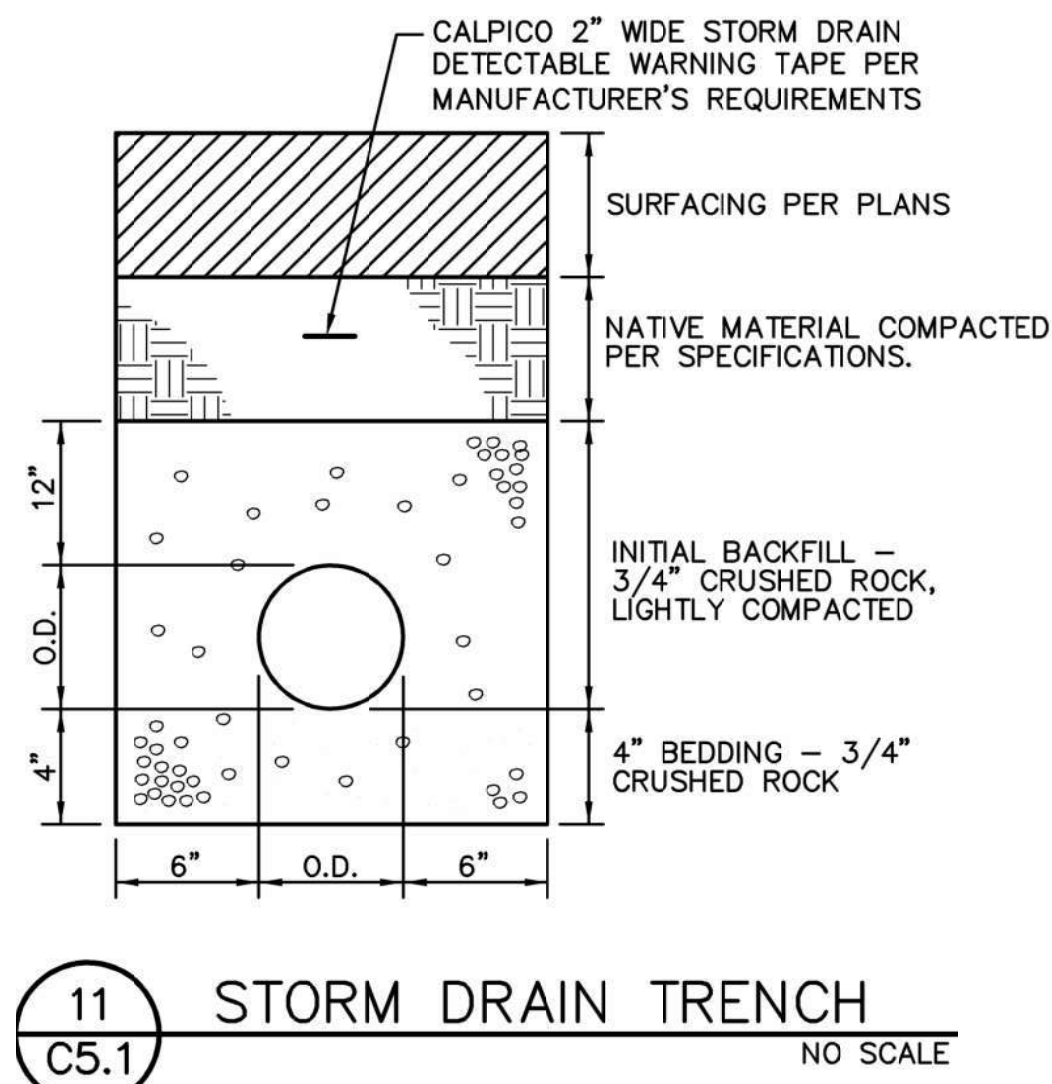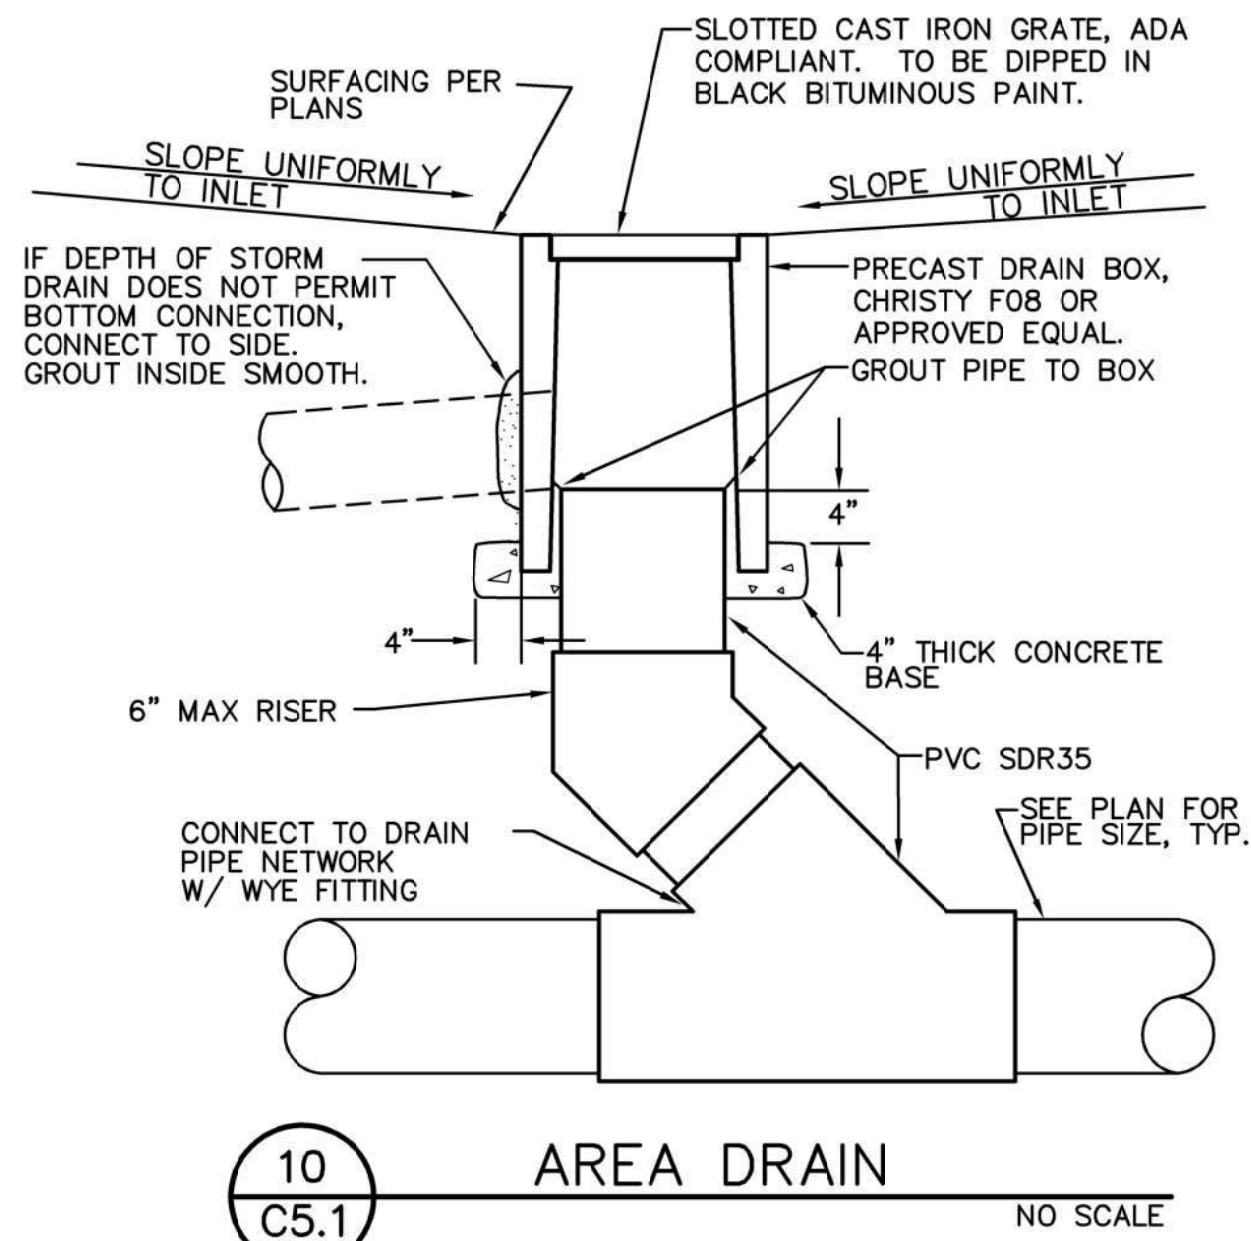

IDENTIFICATION STAMP
DIV. OF THE STATE ARCHITECT
APP: 02-120455 INC:
REVIEWED FOR
SS ☒ FLS ☒ ACS ☒
DATE: 01/12/2023

730 Howe Avenue, Suite 450
Sacramento, CA 95825
Phone: 916.921.2112
Fax: 916.921.2212

HENRY+ ASSOCIATES ARCHITECTS


ANTHONY J. TASSANO
No. C74686
STATE OF CALIFORNIA
12/31/23
RENEWAL DATE

MODERNIZATION LAKEWOOD ELEMENTARY SCHOOL
DETAILS
CONSULTANT
WCE
WARREN CONSULTING ENGINEERS, INC.
1117 WINFIELD WAY, SUITE 110
EL DORADO HILLS, CA 95762 | (916) 985-1870

PROJECT NO.	REVISIONS	BY
21-32-52		
DATE		
3/28/2022		
DRAWN		
ML/MG		
CHECKED		
MG		
SCALE		
AS NOTED		
CADFILE		
UPDATED		
11/17/2022		
SHEET NO.		

C5.1


NOTE:
ANY SITE OR BUILDING
DEMOLITION OR IMPROVEMENTS
INDICATED OUTSIDE THE SHADED
AREA IS NOT A PART OF THIS
CONTRACT UNLESS NOTED
OTHERWISE

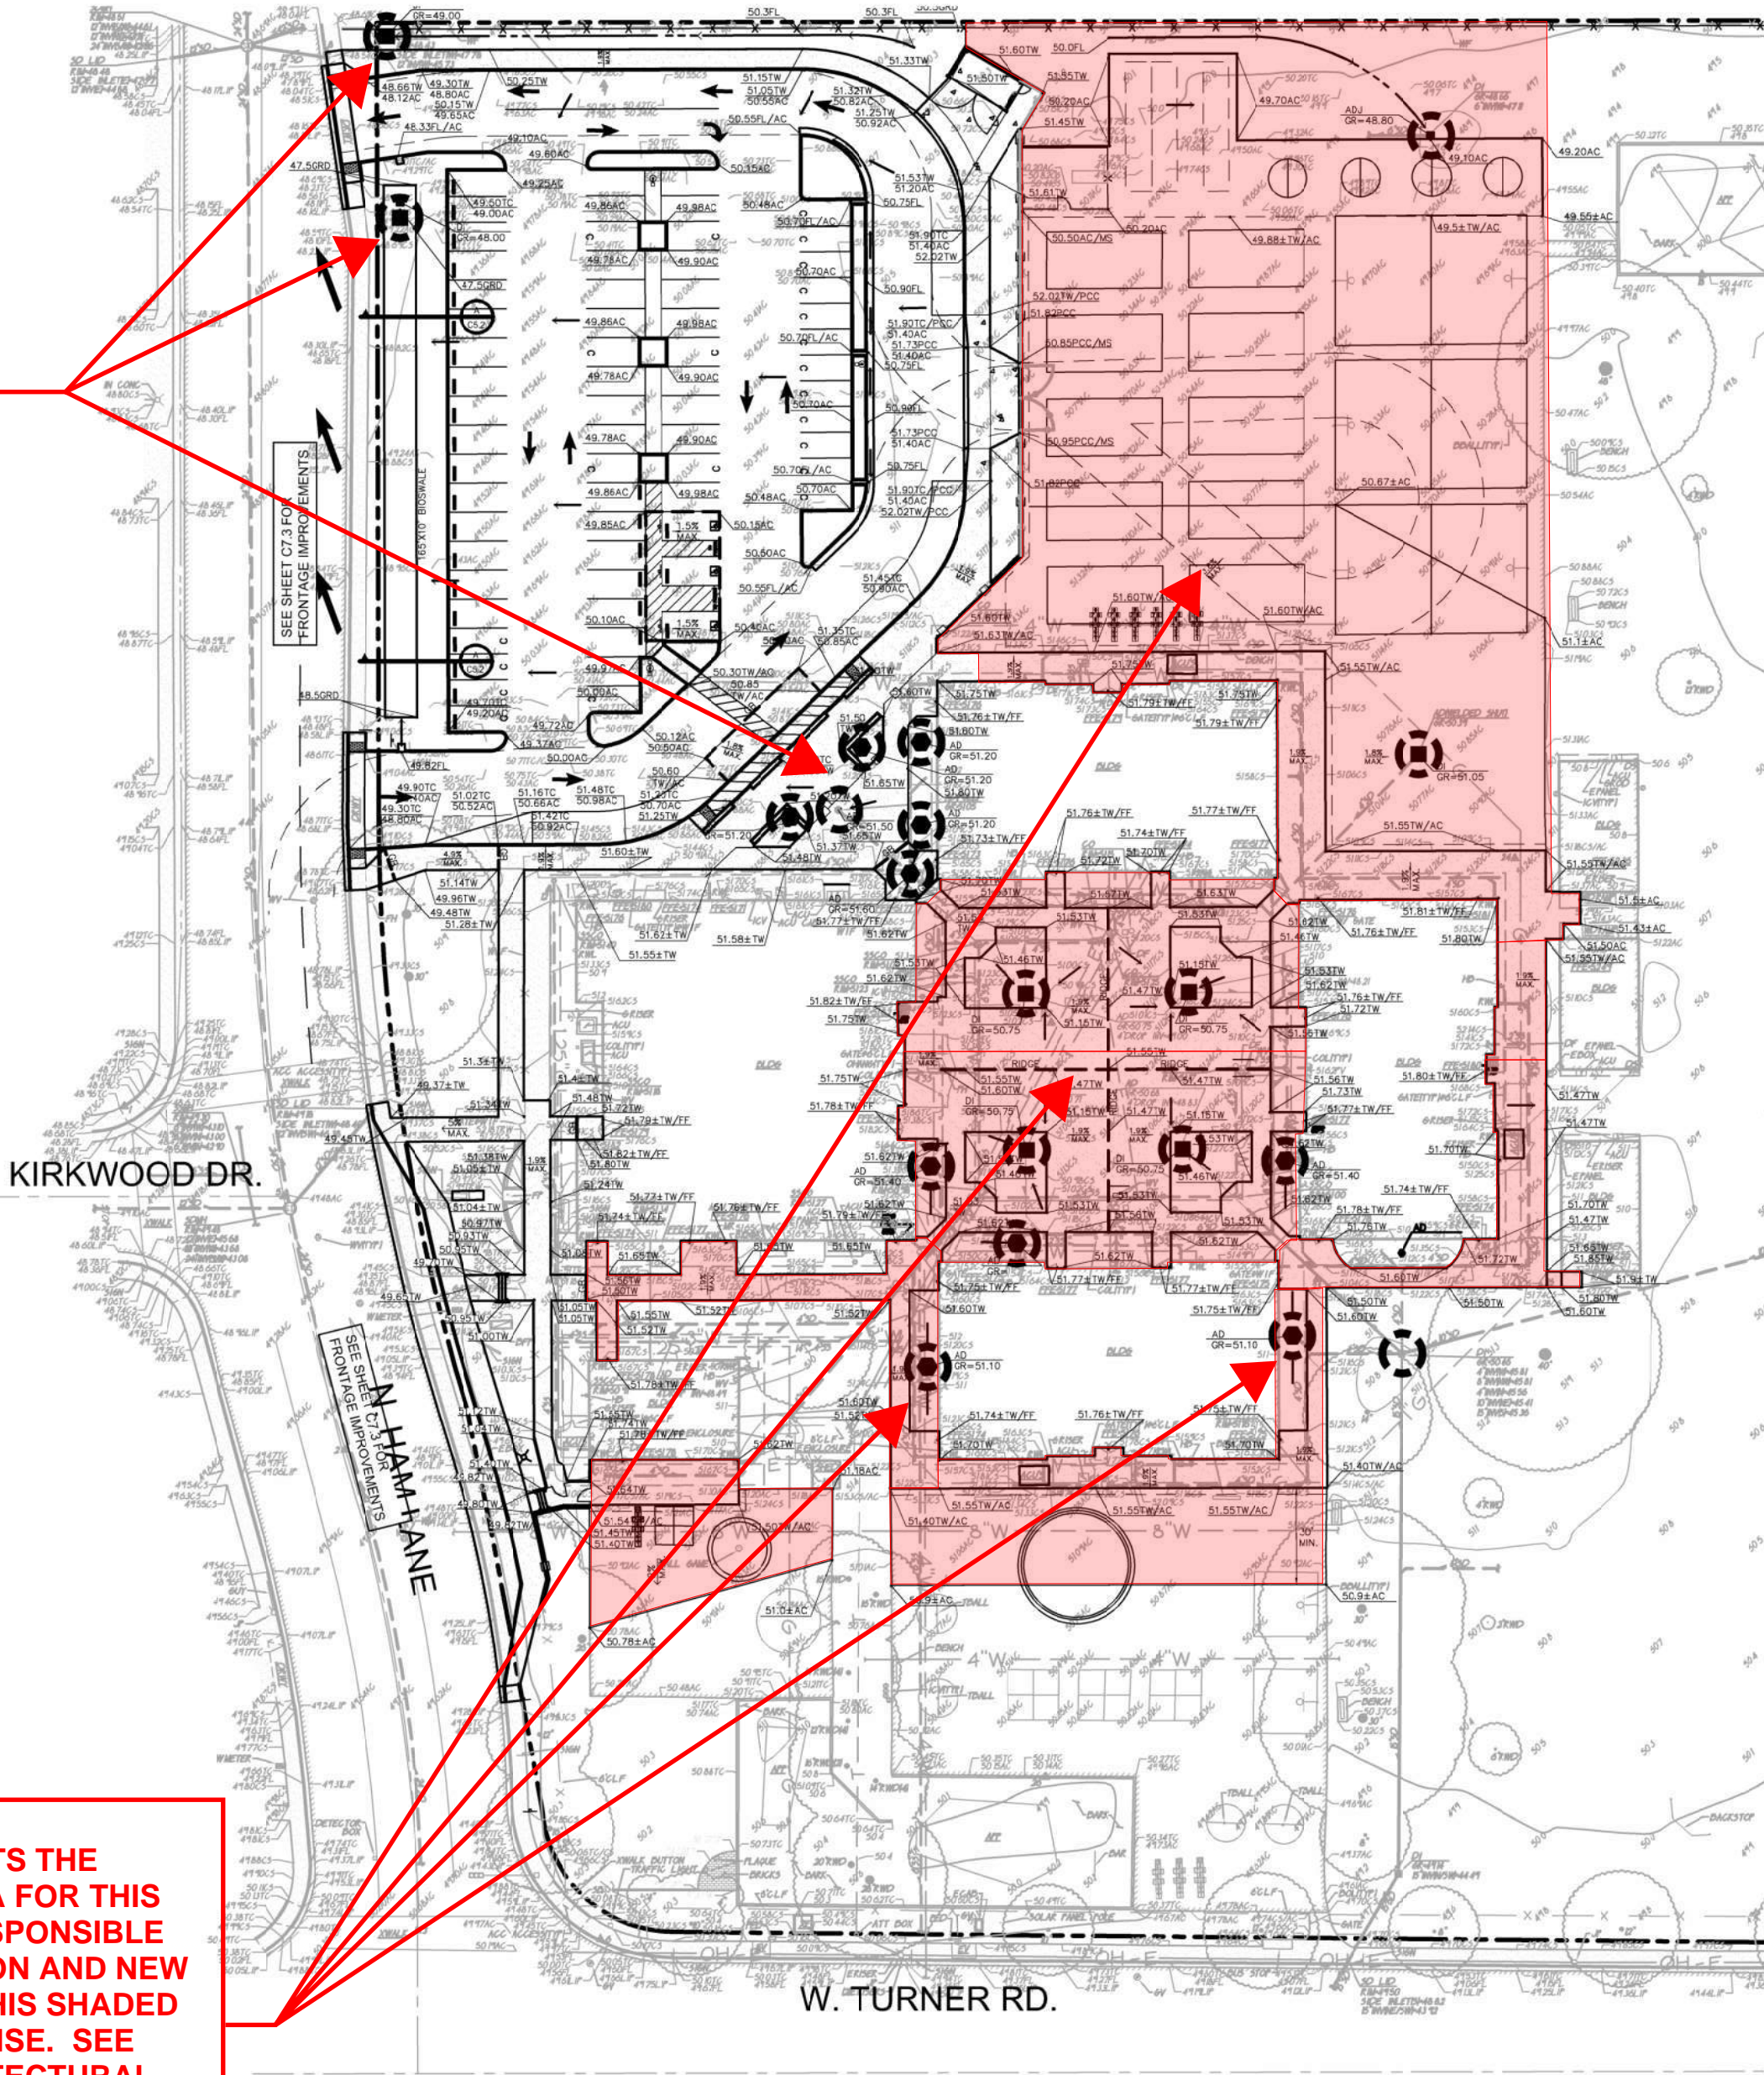

NOTE:
THE SHADED AREA REPRESENTS THE
LIMITED SCOPE OF WORK AREA FOR THIS
PROJECT. CONTRACTOR IS RESPONSIBLE
FOR PROVIDING ALL DEMOLITION AND NEW
SITE IMPROVEMENTS WITHIN THIS SHADED
AREA UNLESS NOTED OTHERWISE. SEE
ELECTRICAL, CIVIL AND ARCHITECTURAL
DRAWINGS FOR ADDITIONAL INFORMATION
AND ANY WORK SCOPE THAT MAY OCCUR
OUTSIDE OF THIS IDENTIFIED WORK SCOPE
AREA.

PHASE OF CONSTRUCTION	EROSION AND SEDIMENT CONTROL MEASURES														
	WET SEASON					WET & DRY SEASON									
	HYDRO-SEEDING	STRAW MULCHING/TACTIFIER	SOIL BINDERS	PRESERVATION OF EXISTING VEGETATION	BLANKETS MATS & GEOTEXTILES	FIBER ROLLS	DUST CONTROL	OUTLET PROTECTION	SILT FENCING	SAND/GRAVEL BAG BARRIERS	STORM DRAIN INLET PROTECTION	SEDIMENT BASIN	SEDIMENT TRAP	DEWATERING	STABILIZED CONSTRUCTION ENTRANCE
PRE-GRADING	X	X		X			X					N/A	N/A		
CUT-FILL ACTIVITIES	X	X	X	X	X	X	X			X	X		X	X	X
UNDERGROUND WORK	X	X	X	X	X	X	X	X		X	X		X	X	X
STORM IMPROVEMENTS	X		X	X	X	X	X	X		X	X		X	X	X
CURB AND GUTTER	N/A		X	X	X	X	X	X		X	X			X	X
STREET IMPROVEMENTS				X	X	X	X	X		X	X			X	X
PAVE OUT					X	X	X	X		X	X			X	X
POST CONSTRUCTION				X	X	X									
MAINTENANCE SCHEDULE															
DAILY*															
WEEKLY*		X	X			X	X		X		X			X	X
MONTHLY*															
BEFORE RAIN		X	X			X	X			X	X				
DURING RAIN		X	X			X	X			X	X				
AFTER RAIN		X	X			X	X			X	X				
AS NEEDED				X			X							X	


* = WHEN RAIN EVENT INSPECTIONS OCCURS, THEY MAY QUALIFY AS A DAILY, WEEKLY, OR MONTHLY INSPECTION AS APPLIES.

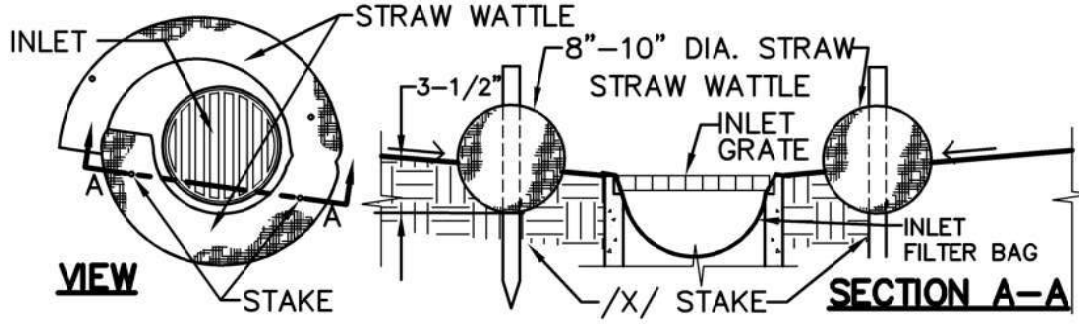

NOTE: STRAW WATTLE INSTALLATION REQUIRES THE PLACEMENT AND SECURE STAKING OF THE WATTLE IN A TRENCH, 3-1/2" DEEP, DUG ON CONTOUR. RUNOFF MUST NOT BE ALLOWED TO RUN UNDER OR AROUND ROLL.

1 STRAW WATTLE INLET FILTER


C6.1 NO SCALE

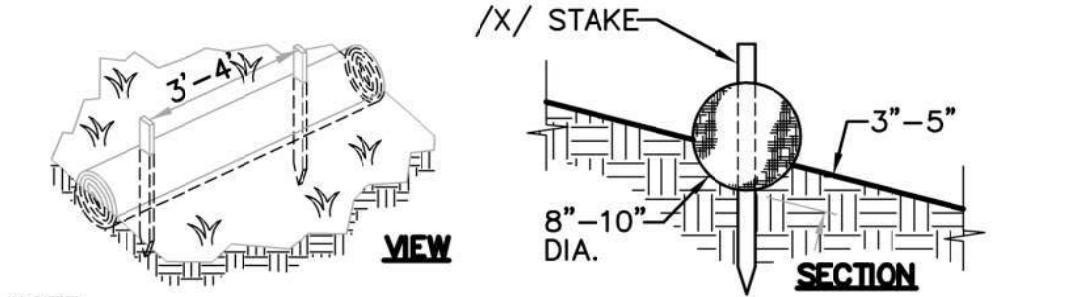

NOTE: STRAW ROLL INSTALLATION REQUIRES THE PLACEMENT AND SECURE STAKING OF THE ROLL IN A TRENCH, 3-5" DEEP, DUG ON CONTOUR. RUNOFF MUST NOT BE ALLOWED TO RUN UNDER OR AROUND ROLL.

2 STRAW ROLLS

C6.1 NO SCALE

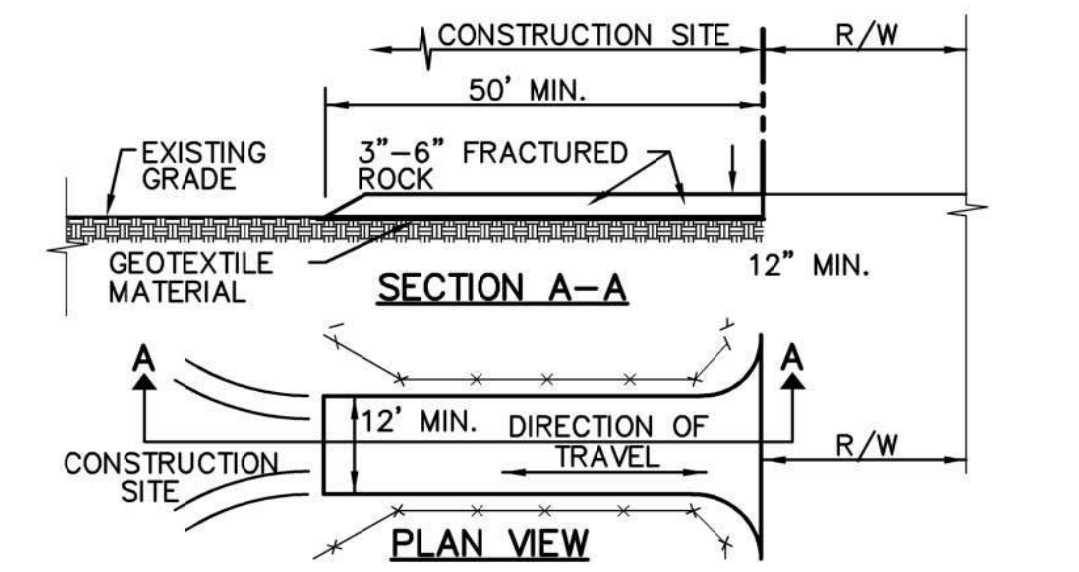

- NOTES:
1. STABILIZED CONSTRUCTION SITE ACCESS SHALL BE CONSTRUCTED OF 3"-6" ANGULAR ROCK MATERIAL CONFORMING TO SECTION 26 OF STATE SPECIFICATIONS PLACED OVER GEOTEXTILE MATERIAL. ROCK SHALL BE PLACED TO A MINIMUM THICKNESS OF SIX INCHES. THE METHOD OF PLACING, SPREADING AND COMPACTING ROCK SHALL CONFORM TO SECTION 26 OF THE STATE SPECIFICATIONS.
 2. LENGTH OF SITE ACCESS SHALL BE A MINIMUM LENGTH OF FIFTY FEET. WIDTH SHALL BE A MINIMUM WIDTH OF TWELVE FEET OR AS NECESSARY TO COVER ALL VEHICULAR INGRESS AND EGRESS.
 3. THE SITE ACCESS SHALL BE KEPT IN GOOD CONDITION BY OCCASIONAL TOP DRESSING.

3 STABILIZED CONSTRUCTION SITE ACCESS

C6.1 NO SCALE


EROSION AND SEDIMENT CONTROL GENERAL NOTES

1. IF CERTAIN SOIL TYPES (E.G. COLLOIDAL SOILS) ARE DETECTED, THE CONTRACTOR SHALL IMPLEMENT ADDITIONAL TREATMENT MEASURES PRIOR TO DISCHARGE.
2. CONTRACTOR IS RESPONSIBLE FOR THE DEWATERING AND REMOVAL OF ALL TEMPORARY EROSION CONTROL DEVICES JUST PRIOR TO THE COMMENCING OF THE FINAL GRADING AND PAVING OPERATIONS.
3. CONTRACTOR SHALL BE RESPONSIBLE FOR WATERING THE SITE TO MINIMIZE DUST CREATED DURING CONSTRUCTION.
4. PRIOR TO PLACEMENT OF HYDRO SEEDING, REMOVE TEMPORARY EROSION CONTROL MEASURES (STRAW WATTLE FENCE AND TRACKED LOOSE STRAW).
5. CONTRACTOR SHALL ASSUME SOLE RESPONSIBILITY FOR COMPLIANCE WITH STATE WATER RESOURCES CONTROL BOARD REQUIREMENTS.
6. ALL MATERIALS STORED ON-SITE SHALL HAVE PROPER ENCLOSURES AND/OR COVERINGS.
7. CONTRACTOR SHALL MAINTAIN ALL WATTLE OR SILT FENCES AND OTHER STORM WATER POLLUTION PREVENTION DEVICES THROUGHOUT CONSTRUCTION. CONTRACTOR SHALL INSPECT ALL EROSION CONTROL DEVICES WEEKLY AS WELL AS BEFORE, DURING, AND AFTER A STORM EVENT. CONTRACTOR SHALL REMOVE ALL EROSION CONTROL AND POLLUTION PREVENTION DEVICES AT THE END OF CONSTRUCTION AS REQUIRED. REFER TO SPECIFICATIONS AND ADDITIONAL REQUIREMENTS.
8. CONTRACTOR SHALL PROVIDE AND MAINTAIN CONSTRUCTION FENCING THROUGHOUT THE PROJECT. THIS FENCING SHALL DETER PEDESTRIANS AND NON-CONSTRUCTION RELATED PERSONNEL FROM ENTERING THE CONSTRUCTION SITE AREA TO THE GREATEST POSSIBLE EXTENT. THE CONTRACTOR SHALL COORDINATE THIS FENCING LAYOUT WITH SCHOOL DISTRICT PERSONNEL PRIOR TO ANY FENCING PLACEMENT SO AS TO NOT SIGNIFICANTLY INTERFERE WITH SCHOOL OPERATION.
9. CONTRACTOR SHALL ADEQUATELY PREVENT EXCESSIVE AMOUNTS OF MUD, SAND, DIRT, AND OTHER DEBRIS FROM BEING TRACKED ONTO THE STREET FROM CONSTRUCTION VEHICLE MOVEMENT. PROVIDE WASHING FACILITIES AT CONSTRUCTION ENTRANCE IF NECESSARY.
10. CONTRACTOR SHALL ADEQUATELY PREVENT EXCESSIVE AMOUNTS OF MUD, SAND, DIRT, AND OTHER DEBRIS FROM BEING TRACKED ONTO THE STREET FROM CONSTRUCTION VEHICLE MOVEMENT. PROVIDE WASHING FACILITIES AT CONSTRUCTION ENTRANCE IF NECESSARY.

- LEGEND
- ① EROSION CONTROL NOTES
- NOTE: EXACT LOCATION WILL BE COORDINATED BY CONTRACTOR AND PROJECT QSP.
1. CONTRACTOR SHALL PROVIDE STRAW WATTLE BARRIER AT ALL INLETS (NEW AND/OR EXIST.) IN AREAS OF ON-SITE WORK PER THE DETAIL PROVIDED. IN ADDITION TO WATTLE, PROVIDE FILTER BAG AT EACH INLET. STRAW WATTLES NOT REQUIRED AT INLETS IN PAVED AREAS, ONLY FILTER BAG.
 2. CONTRACTOR SHALL PROVIDE STRAW WATTLES AT PERIMETER OF SITE PER DETAIL.
 3. CONTRACTOR SHALL PROVIDE STABILIZED CONSTRUCTION SITE ACCESS PER DETAIL.
 4. CONTRACTOR SHALL CONSTRUCT AND UTILIZE A STAGING AREA IN ACCORDANCE WITH ALL APPLICABLE REQUIREMENTS IN SECTION 4 OF THE CALIFORNIA STORMWATER QUALITY ASSOCIATION BMP HANDBOOK. SIZE AS NEEDED. AFTER CONSTRUCTION COMPLETE, RETURN AREA TO NATURAL CONDITION.

ADD TO MAP AS LOCATED IN THE FIELD

- CONSTRUCTION TRAILER.
- VEHICLE/EQUIPMENT MAINTENANCE AND FUELING AREA.
- COVERED WASTE STORAGE (DUMPSTERS).
- STAGING AREA
- MATERIAL STORAGE
- SOIL STOCKPILES.
- CONCRETE WASHOUT.

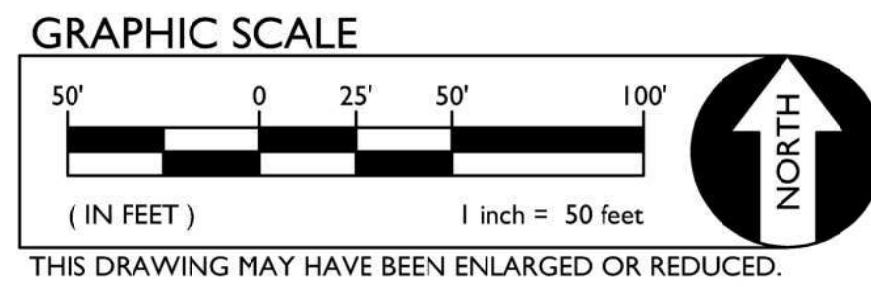

- ### MONITORING SCHEDULE
1. WITHIN 2 BUSINESS DAYS (48 HOURS) PRIOR TO EACH QUALIFYING RAIN EVENT.
 2. EVERY 24 HOURS DURING A QUALIFYING RAIN EVENT.
 3. WITHIN 2 BUSINESS DAYS (48 HOURS) AFTER EACH QUALIFYING RAIN EVENT RESULTING IN 0.50 INCHES OF RAIN OR MORE.
 4. RECORD THE TIME, DATE AND RAIN GAUGE READING OF ALL QUALIFYING RAIN EVENTS.
 5. QUARTERLY NON-STORM WATER DISCHARGE INSPECTIONS.
 6. WEEKLY INSPECTIONS.

ANY CHANGES MADE TO THE SWPPP IN THE FIELD MUST BE SHOWN ON THE MAP. UPDATE MAP TO REFLECT CHANGES.

MAINTENANCE/REPAIRS OF BMP FAILURE SHALL BEGIN WITHIN 72 HOURS OF IDENTIFICATION AND CHANGES SHALL BE COMPLETED PRIOR TO THE NEXT RAIN EVENT.

STORM DRAINAGE OUTFALL BMP'S REFER TO PROTECT CONSTRUCTION PLAN DETAILS FOR SPECIFIC POST CONSTRUCTION BMP MEASURES AT OUTFALL STRUCTURES.

SEDIMENT AND EROSION CONTROL MEASURES ON SWPPP MAP ARE MINIMUM BMP'S RECOMMENDED FOR COMPLIANCE. CONSTRUCTION SITE MUST BE MONITORED AND BMP'S SHALL BE MODIFIED DEPENDING ON CONSTRUCTION SCHEDULE AND RAIN EVENTS.

PROJECT INFORMATION

PARCEL AREA - ACRES
TOTAL DISTURBED AREA - ACRES
S.W.P.P.P. REQUIRED? NO



IDENTIFICATION STAMP
DIV. OF THE STATE ARCHITECT
APP: 02-120455 INC:
REVIEWED FOR
SS ☒ FLS ☒ ACS ☒
DATE: 01/12/2023

730 Howe Avenue, Suite 450
Sacramento, CA 95825
Phone: 916.921.2112
Fax: 916.921.2212



MODERNIZATION LAKEWOOD
ELEMENTARY SCHOOL


EROSION CONTROL PLAN

CONSULTANT

WCE
WARREN CONSULTING ENGINEERS, INC.
1117 WINDFIELD WAY, SUITE 110
EL DORADO HILLS, CA 95762 | (916) 985-1870

PROJECT NO.	REVISIONS	BY
21-32-52		
DATE		
3/28/2022		
DRAWN		
ML/MG		
CHECKED		
MG		
SCALE		
AS NOTED		
CADFILE		
UPDATED		
11/17/2022		
SHEET NO.		

C6.1

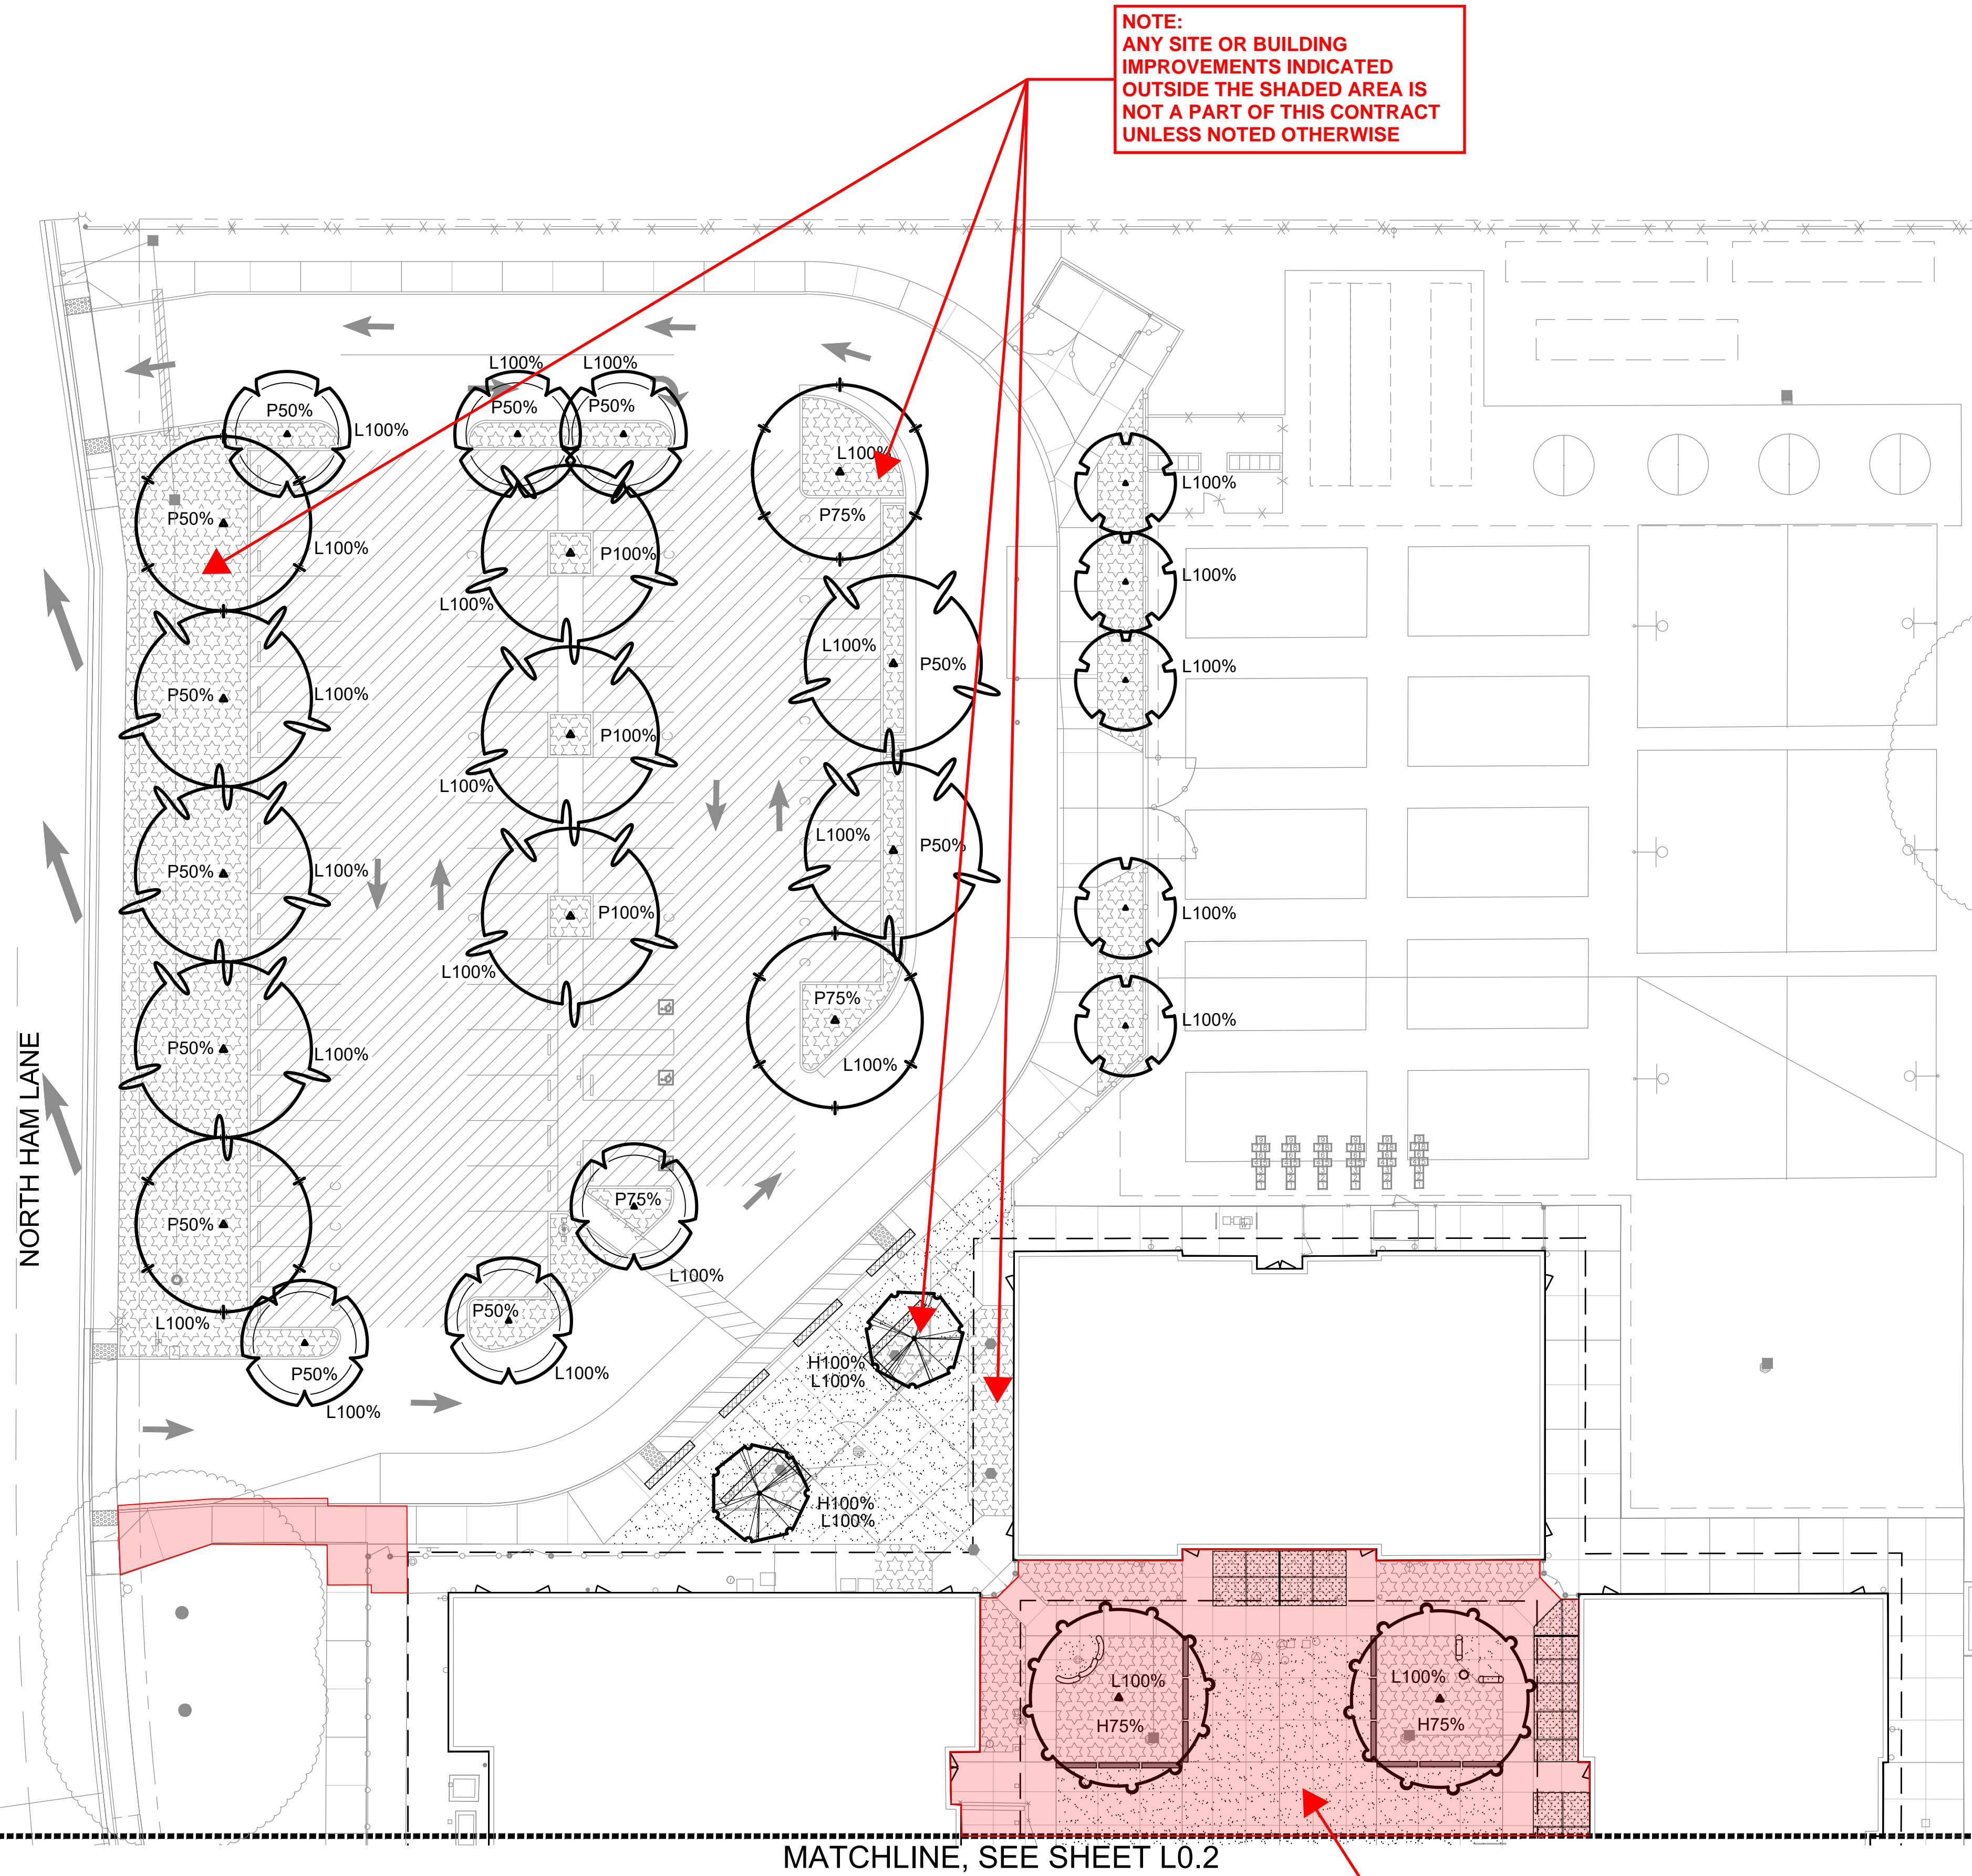

KEY

TREE SHADING LEGEND

TREES - NOT ALL SYMBOLS SHOWN
WITH TREE SHADING CANOPY PERCENTAGE
NOTE: COORDINATE UTILITY LINE LOCATIONS WITH TREE PLACEMENTS

SHADE PERCENTAGE: PARKING
SHADE PERCENTAGE: HARDSCAPE
SHADE PERCENTAGE: LANDSCAPE

AREA USED AS 'TOTAL PARKING AREA'


AREA USED AS 'TOTAL HARDSCAPE AREA'

AREA USED AS 'TOTAL LANDSCAPE AREA'

PARKING LOT SHADING (50% WITHIN 15 YEARS)				
TREES	100%	75%	50%	25%
35'	3 (962) = 2,886 S.F.	2 (722) = 1,444 S.F.	7 (481) = 3,367 S.F.	0 (240) = X S.F.
30'	0 (706) = X S.F.	0 (530) = X S.F.	0 (354) = X S.F.	0 (177) = X S.F.
25'	0 (491) = X S.F.	1 (368) = 368 S.F.	5 (246) = 1,230 S.F.	0 (123) = X S.F.
20'	0 (314) = X S.F.	0 (236) = X S.F.	0 (157) = X S.F.	0 (79) = X S.F.
SUB-TOTALS	2,886 S.F.	1,812 S.F.	4,597 S.F.	0 S.F.
TOTAL PARKING LOT AREA = 17,998 S.F. (8,999 S.F. NEEDED)				
TOTAL SHADED AREA = 9,295 S.F.				
PERCENTAGE OF SHADE = 51.6%				


HARDSCAPE SHADING (20% WITHIN 15 YEARS)				
TREES	100%	75%	50%	25%
35'	0 (962) = X S.F.	4 (722) = 2,888 S.F.	0 (481) = X S.F.	0 (240) = X S.F.
30'	0 (706) = X S.F.	0 (530) = X S.F.	0 (354) = X S.F.	0 (177) = X S.F.
25'	0 (491) = X S.F.	0 (368) = X S.F.	0 (246) = X S.F.	0 (123) = X S.F.
20'	2 (314) = 628 S.F.	0 (236) = X S.F.	0 (157) = X S.F.	0 (79) = X S.F.
SUB-TOTALS	628 S.F.	2,888 S.F.	0 S.F.	0 S.F.
TOTAL PAVED AREA = 8,100 S.F. (1,620 S.F. NEEDED)				
TOTAL SHADED AREA = 3,516 S.F.				
PERCENTAGE OF SHADE = 43.4%				

LANDSCAPE SHADING (20% WITHIN 15 YEARS)				
TREES	100%	75%	50%	25%
30'	16 (707) = 11,312 S.F.	00 (530) = 0000 S.F.	00 (354) = 0000 S.F.	00 (177) = 0000 S.F.
20'	8 (314) = 2,512 S.F.	00 (236) = 0000 S.F.	00 (157) = 0000 S.F.	00 (79) = 0000 S.F.
SUB-TOTALS	13,824 S.F.	0 S.F.	0 S.F.	0000 S.F.
LANDSCAPE AREA = 12,821 S.F. (2,564 S.F. NEEDED)				
TOTAL SHADED AREA = 13,824 S.F.				
PERCENTAGE OF SHADE = 107.8%				

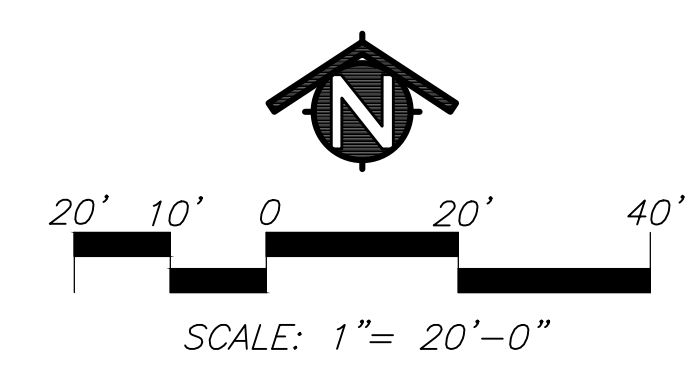


IDENTIFICATION STAMP
DIV. OF THE STATE ARCHITECT
APP: 02-120455 INC:
REVIEWED FOR
SS ☒ FLS ☒ ACS ☒
DATE: 01/12/2023

730 Howe Avenue, Suite 450
Sacramento, CA 95825
Phone: 916.921.2112
Fax: 916.921.2212

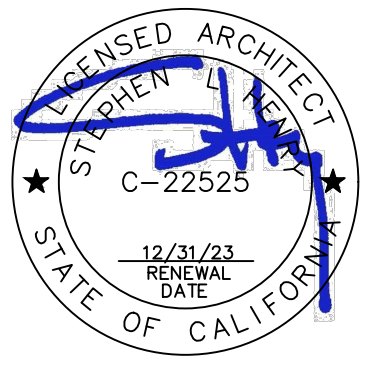

MODERNIZATION LAKEWOOD
ELEMENTARY SCHOOL


TREE
SHADING PLAN

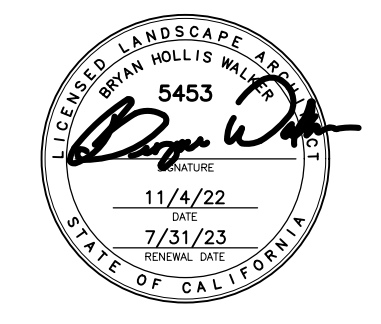

Bryan Hollis Walker C-5453

PROJECT NO.	REVISIONS	BY
21-32-052		
DATE		
3/28/2022		
DRAWN		
MS		
CHECKED		
JCBS		
SCALE		
CADFILE		
UPDATED		
11/17/2022		
SHEET NO.		

L0.1

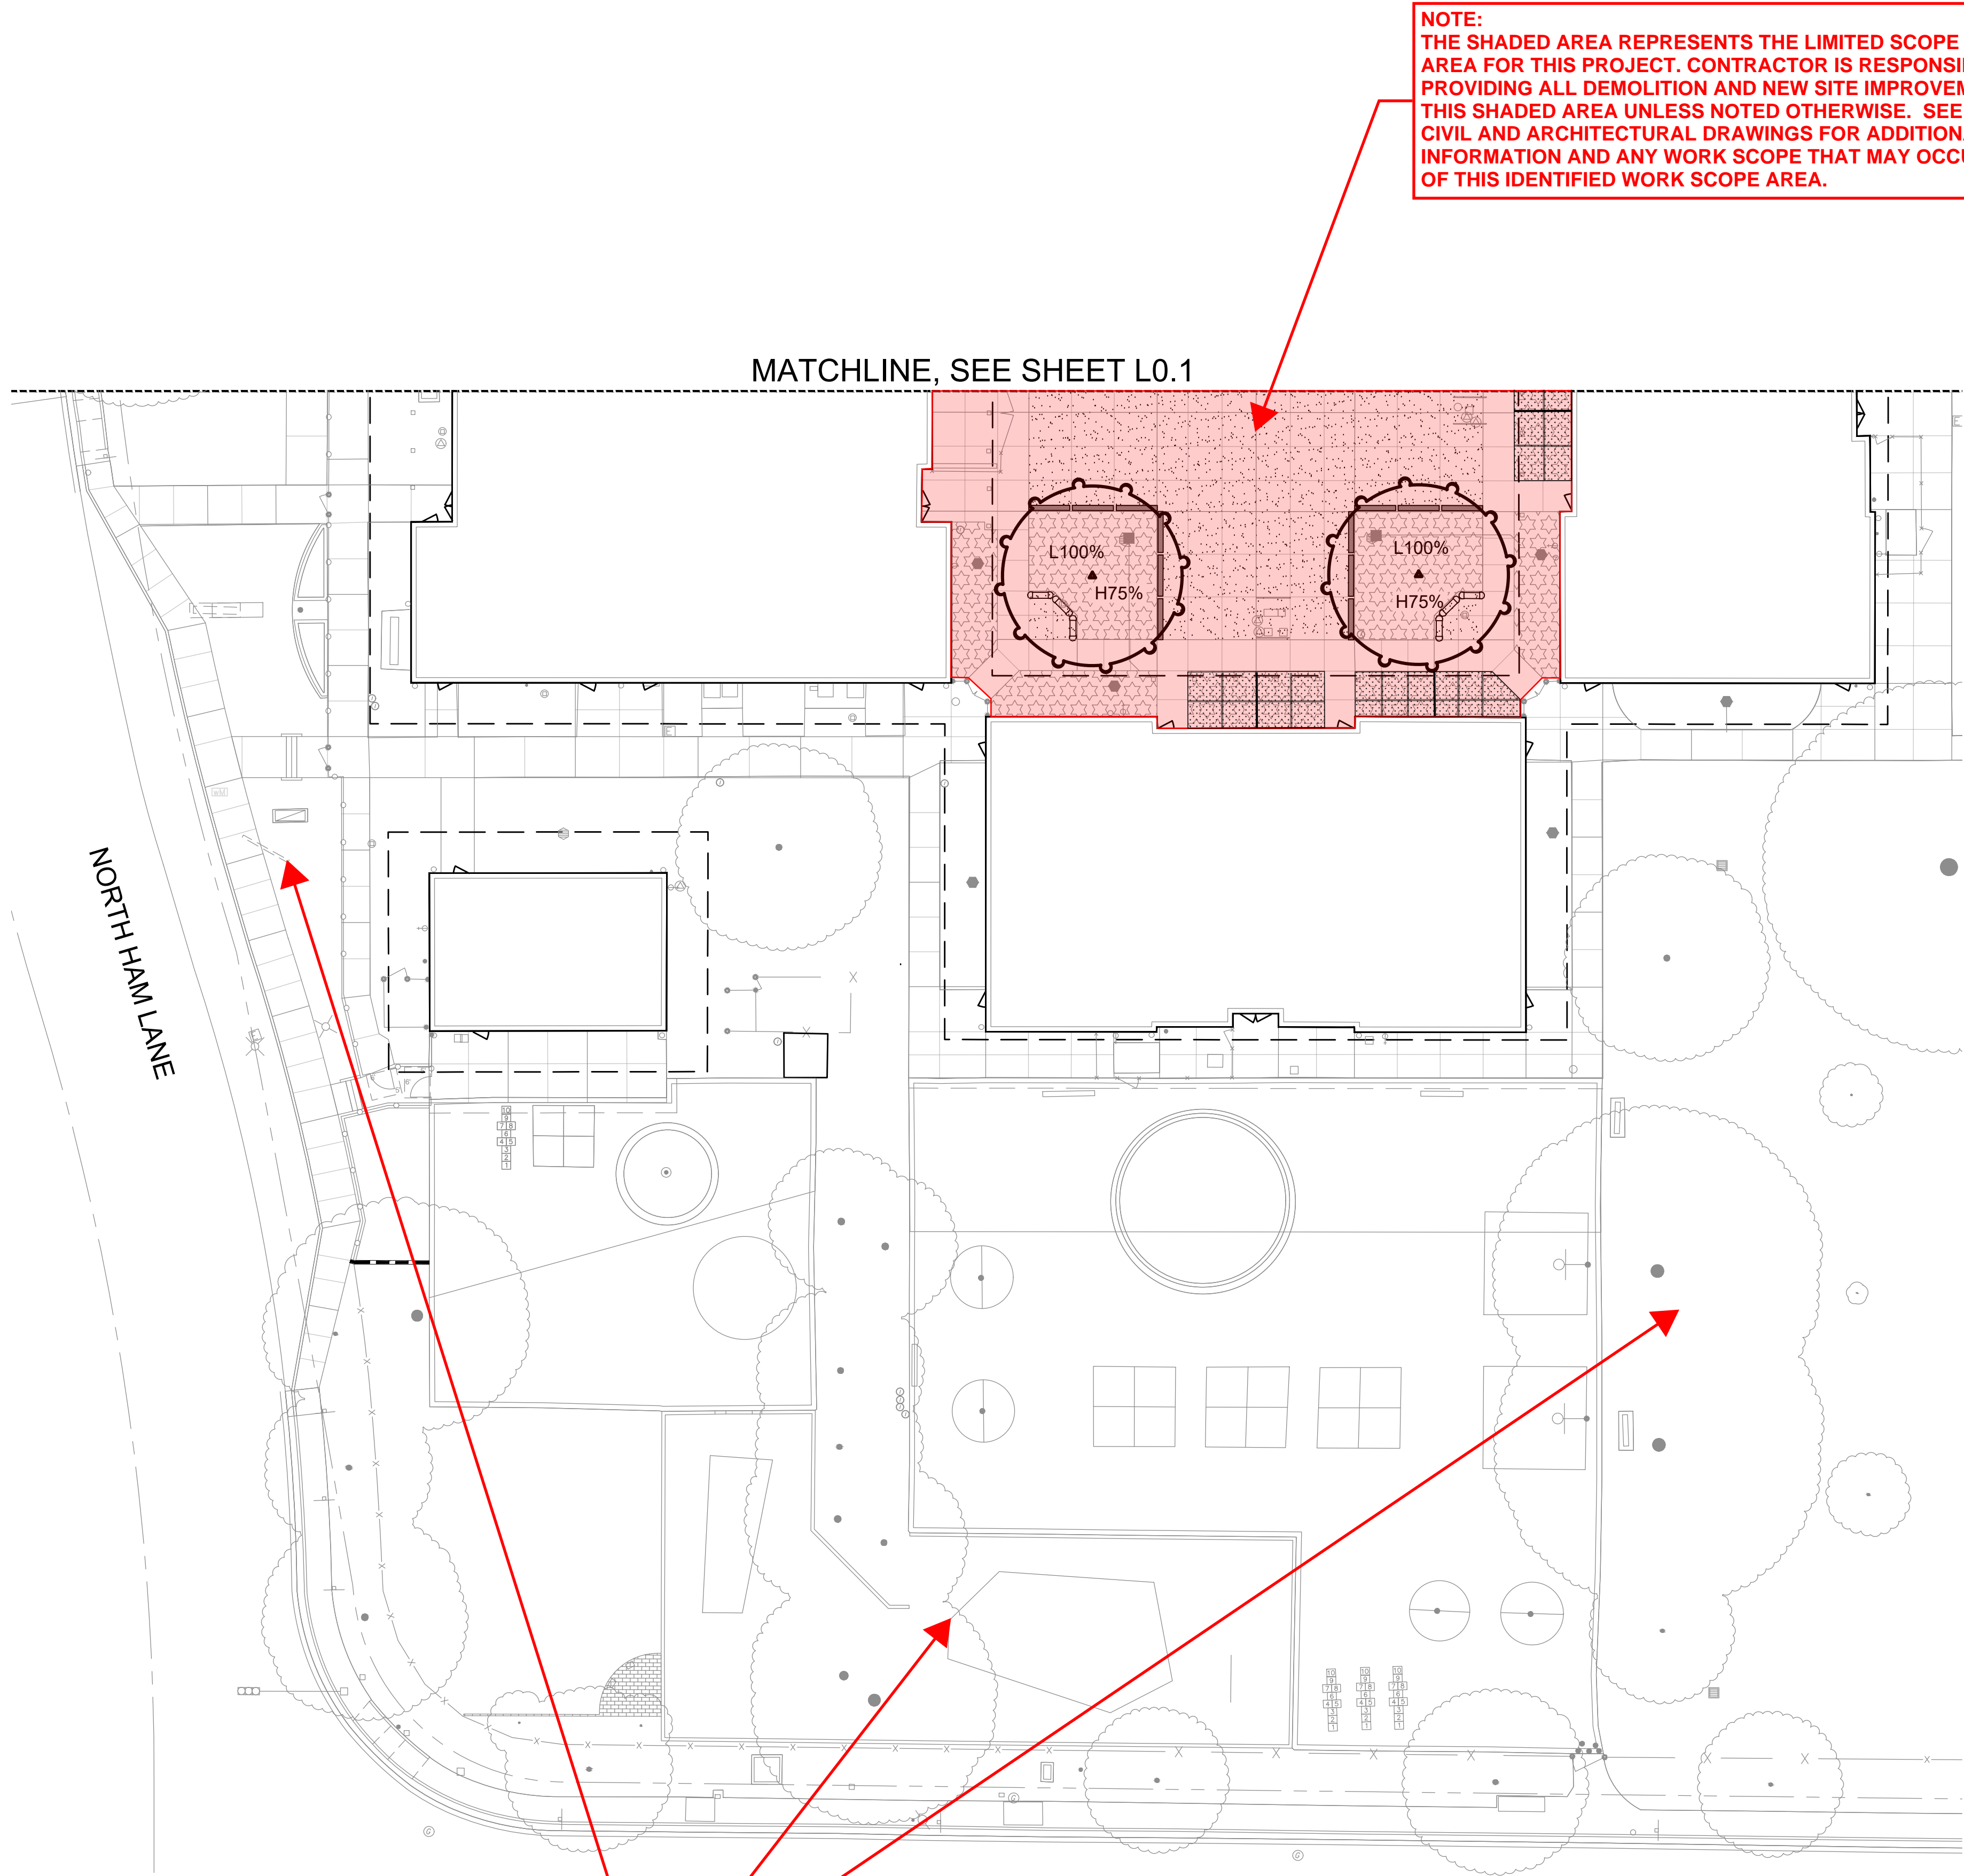

NOTE:
THE SHADED AREA REPRESENTS THE LIMITED SCOPE OF WORK
AREA FOR THIS PROJECT. CONTRACTOR IS RESPONSIBLE FOR
PROVIDING ALL DEMOLITION AND NEW SITE IMPROVEMENTS WITHIN
THIS SHADED AREA UNLESS NOTED OTHERWISE. SEE ELECTRICAL,
CIVIL AND ARCHITECTURAL DRAWINGS FOR ADDITIONAL
INFORMATION AND ANY WORK SCOPE THAT MAY OCCUR OUTSIDE
OF THIS IDENTIFIED WORK SCOPE AREA.

KEY

AREA USED AS 'TOTAL PARKING AREA'

AREA USED AS 'TOTAL HARDSCAPE AREA'

AREA USED AS 'TOTAL LANDSCAPE AREA'

TREE SHADING LEGEND


TREES - NOT ALL SYMBOLS SHOWN
WITH TREE SHADING CANOPY PERCENTAGE
NOTE: COORDINATE UTILITY LINE LOCATIONS WITH TREE PLACEMENTS

SHADE PERCENTAGE: PARKING
SHADE PERCENTAGE: HARDSCAPE
SHADE PERCENTAGE: LANDSCAPE

PARKING LOT SHADING (50% WITHIN 15 YEARS)				
TREES	100%	75%	50%	25%
35'	3 (962) = 2,886 S.F.	2 (722) = 1,444 S.F.	7 (481) = 3,367 S.F.	0 (240) = X S.F.
30'	0 (706) = X S.F.	0 (530) = X S.F.	0 (354) = X S.F.	0 (177) = X S.F.
25'	0 (491) = X S.F.	1 (368) = 368 S.F.	5 (246) = 1,230 S.F.	0 (123) = X S.F.
20'	0 (314) = X S.F.	0 (236) = X S.F.	0 (157) = X S.F.	0 (79) = X S.F.
SUB-TOTALS	2,886 S.F.	1,812 S.F.	4,597 S.F.	0 S.F.
TOTAL PARKING LOT AREA = 17,998 S.F. (8,999 S.F. NEEDED)				
TOTAL SHADED AREA = 9,295 S.F.				
PERCENTAGE OF SHADE = 51.6%				

HARDSCAPE SHADING (20% WITHIN 15 YEARS)				
TREES	100%	75%	50%	25%
35'	0 (962) = X S.F.	4 (722) = 2,888 S.F.	0 (481) = X S.F.	0 (240) = X S.F.
30'	0 (706) = X S.F.	0 (530) = X S.F.	0 (354) = X S.F.	0 (177) = X S.F.
25'	0 (491) = X S.F.	0 (368) = X S.F.	0 (246) = X S.F.	0 (123) = X S.F.
20'	2 (314) = 628 S.F.	0 (236) = X S.F.	0 (157) = X S.F.	0 (79) = X S.F.
SUB-TOTALS	628 S.F.	2,888 S.F.	0 S.F.	0 S.F.
TOTAL PAVED AREA = 8,100 S.F. (1,620 S.F. NEEDED)				
TOTAL SHADED AREA = 3,516 S.F.				
PERCENTAGE OF SHADE = 43.4%				

LANDSCAPE SHADING (20% WITHIN 15 YEARS)				
TREES	100%	75%	50%	25%
30'	16 (707) = 11,312 S.F.	00 (530) = 0000 S.F.	00 (354) = 0000 S.F.	00 (177) = 0000 S.F.
20'	8 (314) = 2,512 S.F.	00 (236) = 0000 S.F.	00 (157) = 0000 S.F.	00 (79) = 0000 S.F.
SUB-TOTALS	13,824 S.F.	0 S.F.	0 S.F.	0000 S.F.
LANDSCAPE AREA = 12,821 S.F. (2,564 S.F. NEEDED)				
TOTAL SHADED AREA = 13,824 S.F.				
PERCENTAGE OF SHADE = 107.8%				

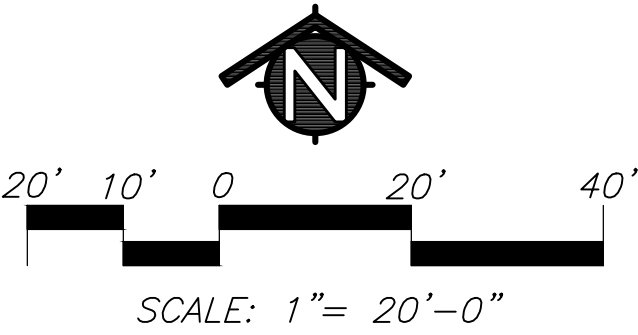


IDENTIFICATION STAMP
DIV. OF THE STATE ARCHITECT
APP: 02-120455 INC:
REVIEWED FOR
SS ☒ FLS ☒ ACS ☒
DATE: 01/12/2023

730 Howe Avenue, Suite 450
Sacramento, CA 95825
Phone: 916.921.2112
Fax: 916.921.2212



MODERNIZATION LAKEWOOD
ELEMENTARY SCHOOL


TREE
SHADING PLAN

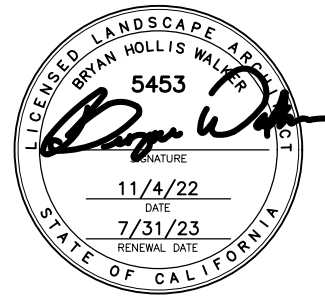

CONSULTANT
Bryan Hollis Walker C-5453

PROJECT NO.	REVISIONS	BY
21-32-052		
DATE		
3/28/2022		
DRAWN		
MS		
CHECKED		
JCBS		
SCALE		
CADFILE		
UPDATED		
11/17/2022		
SHEET NO.		

L0.2

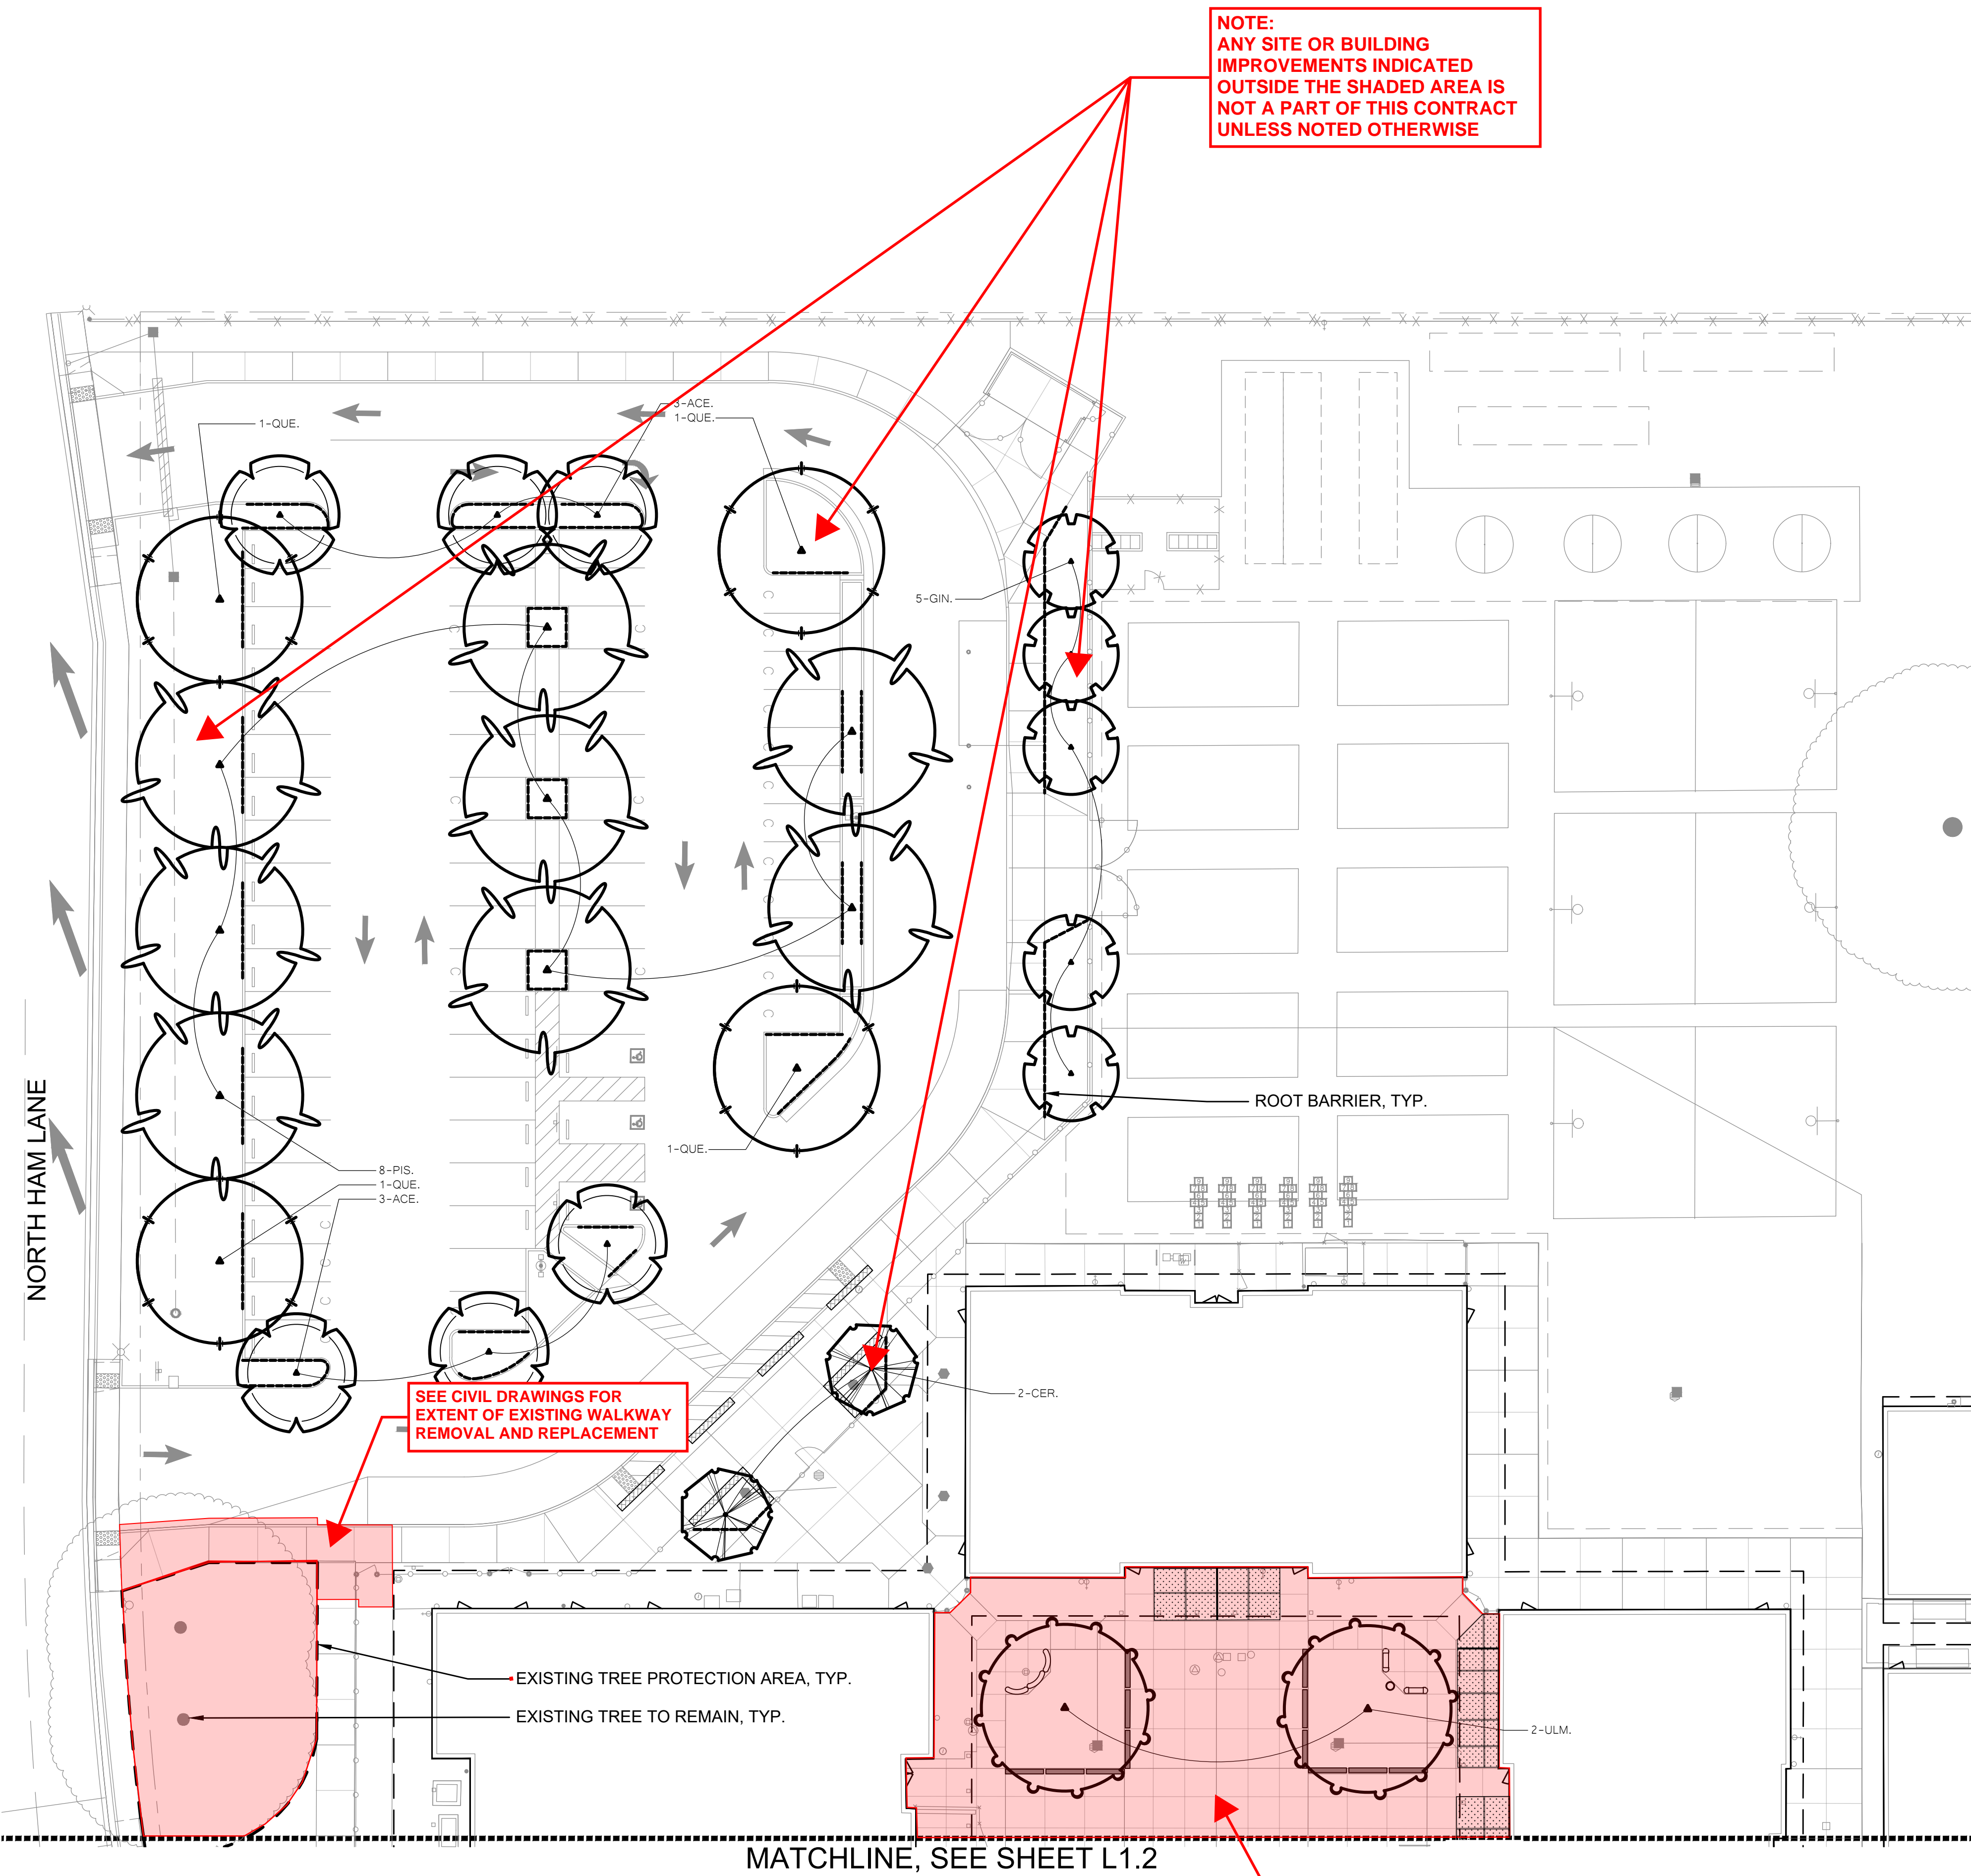

NOTE:
ANY SITE OR BUILDING
IMPROVEMENTS INDICATED
OUTSIDE THE SHADED AREA IS
NOT A PART OF THIS CONTRACT
UNLESS NOTED OTHERWISE

SEE CIVIL DRAWINGS FOR
EXTENT OF EXISTING WALKWAY
REMOVAL AND REPLACEMENT

NOTE:
THE SHADED AREA REPRESENTS THE LIMITED SCOPE OF WORK
AREA FOR THIS PROJECT. CONTRACTOR IS RESPONSIBLE FOR
PROVIDING ALL DEMOLITION AND NEW SITE IMPROVEMENTS WITHIN
THIS SHADED AREA UNLESS NOTED OTHERWISE. SEE ELECTRICAL,
CIVIL AND ARCHITECTURAL DRAWINGS FOR ADDITIONAL
INFORMATION AND ANY WORK SCOPE THAT MAY OCCUR OUTSIDE
OF THIS IDENTIFIED WORK SCOPE AREA.

KEY

LANDSCAPE LEGEND

TREES - NOT ALL SYMBOLS SHOWN

EXISTING TREE TO REMAIN

EXISTING TREE PROTECTION AREA
SEE TREE PROTECTION DETAILS L4.1-1 AND L4.1-2 FOR OPERATIONS
UNDERNEATH TREE DRIP LINES. SEE TREE PROTECTION SPECIFICATIONS.

NOTE:
CONTRACTOR TO IRRIGATE ALL TREES BY HAND DURING CONSTRUCTION PROCESS

ROOT BARRIER, INSTALL WHERE SHOWN ON PLANS
SEE DETAIL L4.1-4

PLANT QUANTITY

PLANT KEY

CONCRETE MOWSTRIP
SEE DETAIL L4.1-5

TREE MATERIAL LIST					
SIZE	QTY.	KEY	BOTANICAL NAME ... COMMON NAME		WATER USE
			TREES:		
24" BOX	6	ACE.	ACER BUERGERIANUM ... TRIDENT MAPLE		MEDIUM
24" BOX	2	CER.	CERCIS CANADENSIS VAR. TEXENSIS ... TEXAS REDBUD		LOW
24" BOX	5	GIN.	GINKGO BILOBA "PRINCETON SENTRY" ... PRINCETON SENTRY GINKGO (NON-FRUITING)		MEDIUM
24" BOX	8	PIS.	PISTACHIA CHINENSIS "KEITH DAVEY" ... CHINESE PISTACHE (NON-FRUITING)		LOW
24" BOX	4	QUE.	QUERCUS ILEX ... HOLLY OAK		LOW
24" BOX	4	ULM.	ULMUS PARVIFOLIA "TRUE GREEN" ... TRUE GREEN CHINESE ELM		MEDIUM

GENERAL LANDSCAPE REQUIREMENTS/NOTES

- NO PLANTING SHALL BE STARTED UNTIL SPRINKLER IRRIGATION SYSTEM HAS BEEN TESTED BY CONTRACTOR IN PRESENCE OF OWNER'S REPRESENTATIVE AND NOTED DEFICIENCIES CORRECTED.
- NO PLANTING SHALL BE STARTED UNTIL SOIL PREPARATION AND FINISH GRADING OPERATIONS HAVE BEEN COMPLETED AND APPROVED BY THE OWNER'S REPRESENTATIVE.
- QUANTITIES SHOWN ON PLANT MATERIAL LIST ARE APPROXIMATE. PROVIDE QUANTITIES INDICATED ON LANDSCAPE PLAN.
- PLANT MATERIAL IS SUBJECT TO APPROVAL OF OWNER'S REPRESENTATIVE.
- SEE SHEET L4.1 FOR PLANTING INSTALLATION DETAILS.

ENVIRONMENTAL REQUIREMENTS:

GENERAL: PROCEED WITH WORK IN ORDERLY AND TIMELY MANNER TO COMPLETE INSTALLATION OF LANDSCAPING WITHIN CONTRACT LIMITS.

PROTECTION:

EXISTING CONSTRUCTION: EXECUTE WORK IN AN ORDERLY AND CAREFUL MANNER TO PROTECT NEW CONCRETE WALKS, WORK OF OTHER TRADES, AND OTHER IMPROVEMENTS.

EXISTING UTILITIES: DETERMINE LOCATION OF UNDERGROUND UTILITIES AND PERFORM WORK IN A MANNER WHICH WILL AVOID POSSIBLE DAMAGE. HAND EXCAVATE, AS REQUIRED, TO MINIMIZE POSSIBILITY OF DAMAGE TO UNDERGROUND UTILITIES. MAINTAIN GRADE STAKES SET BY OTHERS UNTIL REMOVAL IS MUTUALLY AGREED UPON BY ALL PARTIES CONCERNED. BE RESPONSIBLE FOR PROTECTION OF EXISTING UTILITIES WITHIN CONSTRUCTION AREA; REPAIR DAMAGE TO UTILITIES THAT OCCUR AS A RESULT OF OPERATIONS OF THIS WORK.

LANDSCAPING: PROTECT LANDSCAPE WORK AND MATERIALS FROM DAMAGE DUE TO LANDSCAPE OPERATIONS, OPERATIONS BY OTHER CONTRACTORS AND TRADES AND TRESPASSERS. MAINTAIN PROTECTION DURING INSTALLATION AND MAINTENANCE PERIODS. TREAT, REPAIR OR REPLACE DAMAGED LANDSCAPE WORK AS DIRECTED AT NO ADDITIONAL COST TO CONTRACT.

ADVERSE CONDITIONS: WHEN CONDITIONS DETRIMENTAL TO SOD OR PLANT GROWTH ARE ENCOUNTERED, SUCH AS RUBBLE FILL, ADVERSE DRAINAGE CONDITIONS, OR OBSTRUCTIONS, NOTIFY OWNER'S REPRESENTATIVE BEFORE STARTING WORK.

PLANTING AND TURF INSTALLATION SEASONS AND CONDITIONS

NO WORK SHALL BE DONE WHEN GROUND IS FROZEN, SNOW COVERED, TOO WET OR IN AN OTHERWISE UNSUITABLE CONDITION FOR AMENDING SOIL, FINISH GRADING OR PLANTING.

SOIL TESTING/SOIL IMPROVEMENT:

SEE SPECIFICATIONS 32 90 00, SECTION 3.02 SOIL TESTING AND SECTION 3.03 PREPARATION.

SOIL PERCOLATION


EXCAVATE TREE PITS. FILL EXCAVATED PLANTING PITS WITH WATER TO 1/2 DEPTH OF PIT. PITS SHOULD DRAIN WITHIN 4 HOURS. IF PLANTING PITS DO NOT DRAIN, NOTIFY INSPECTOR IMMEDIATELY. PLANTING SHALL NOT BE STARTED UNTIL OWNER'S REPRESENTATIVE HAS RESOLVED A METHOD TO REMEDY DRAINAGE ISSUE.

PLANT MATERIAL STANDARDS

PLANTS SHALL BE IN ACCORDANCE WITH AMERICAN NATIONAL STANDARDS INSTITUTE (ANSI) ANSI Z60.1-AMERICAN STANDARD FOR NURSERY STOCK, EXCEPT AS OTHERWISE STATED IN SPECIFICATIONS OR SHOWN ON DRAWINGS. WHERE DRAWINGS OR SPECIFICATIONS ARE IN CONFLICT WITH ANSI Z60.1, DRAWINGS AND SPECIFICATIONS SHALL PREVAIL. PRUNE, THIN OUT AND SHAPE TREES IN ACCORDANCE WITH ANSI STANDARD HORTICULTURAL PRACTICE. PRUNE TREES TO RETAIN REQUIRED HEIGHT AND SPREAD, UNLESS OTHERWISE DIRECTED BY LANDSCAPE ARCHITECT. DO NOT CUT TREE LEADERS, AND REMOVE ONLY INJURED OR DEAD BRANCHES FROM FLOWERING TREES.

EXISTING LANDSCAPE AND SPRINKLER IRRIGATION SYSTEM

WORK LIMITS OF THIS PROJECT EXTEND INTO AREAS THAT WERE PREVIOUSLY DEVELOPED UNDER OTHER CONTRACTS. PRIOR TO START OF WORK, CONTRACTOR SHALL MEET WITH OWNER'S REPRESENTATIVE TO LOCATE ALL CONNECTIONS CALLED FOR ON DRAWINGS. WORK LIMITS/FENCING SHALL BE LAID OUT BY CONTRACTOR AND VERIFIED BY OWNER'S REPRESENTATIVE. FENCE TO BE INSTALLED AND IRRIGATION SYSTEM SHALL BE TESTED WITH CONTRACTOR, INSPECTOR, AND OWNER'S REPRESENTATIVE PRESENT. DEFICIENCIES SHALL BE NOTED AT THIS TIME AND ARE THE RESPONSIBILITY OF OWNER. AT COMPLETION OF WORK, SYSTEM WILL AGAIN BE TESTED. DEFICIENCIES NOTED AT THIS TIME THAT WERE NOT NOTED PREVIOUSLY WILL BE RESPONSIBILITY OF CONTRACTOR. EXISTING LANDSCAPE THAT HAS BEEN DAMAGED DUE TO CONSTRUCTION SHALL BE RESTORED TO ORIGINAL CONDITION BY CONTRACTOR AT NO ADDITIONAL COST TO OWNER. PRIOR TO MAKING ANY CONNECTION TO MAIN LINE, CONTRACTOR SHALL NOTIFY OWNER 1 WEEK IN ADVANCE SO ADJUSTMENTS TO EXISTING WATERING PROGRAMS CAN BE MADE.

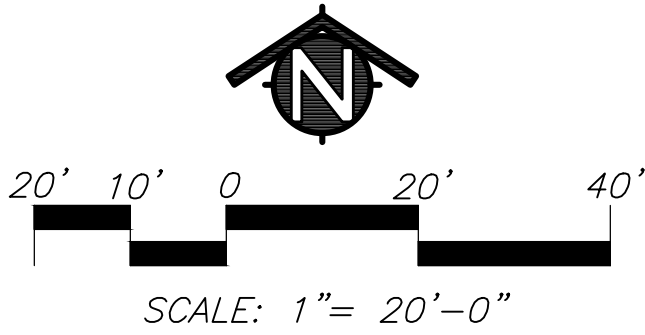

IDENTIFICATION STAMP
DIV. OF THE STATE ARCHITECT
APP: 02-120455 INC:
REVIEWED FOR
SS ☒ FLS ☒ ACS ☒
DATE: 01/12/2023


730 Howe Avenue, Suite 450
Sacramento, CA 95825
Phone: 916.921.2112
Fax: 916.921.2212



MODERNIZATION LAKEWOOD
ELEMENTARY SCHOOL

TREE
PLANTING PLAN


CONSULTANT

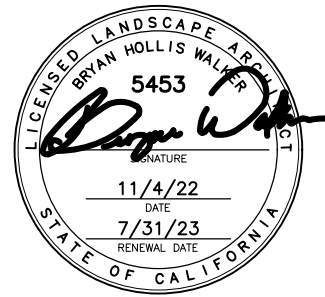

Bryan Hollis Walker C-5453

PROJECT NO.	REVISIONS	BY
21-32-052		
DATE		
3/28/2022		
DRAWN		
MS		
CHECKED		
JCBS		
SCALE		
CADFILE		
UPDATED		
11/17/2022		
SHEET NO.		

L1.1

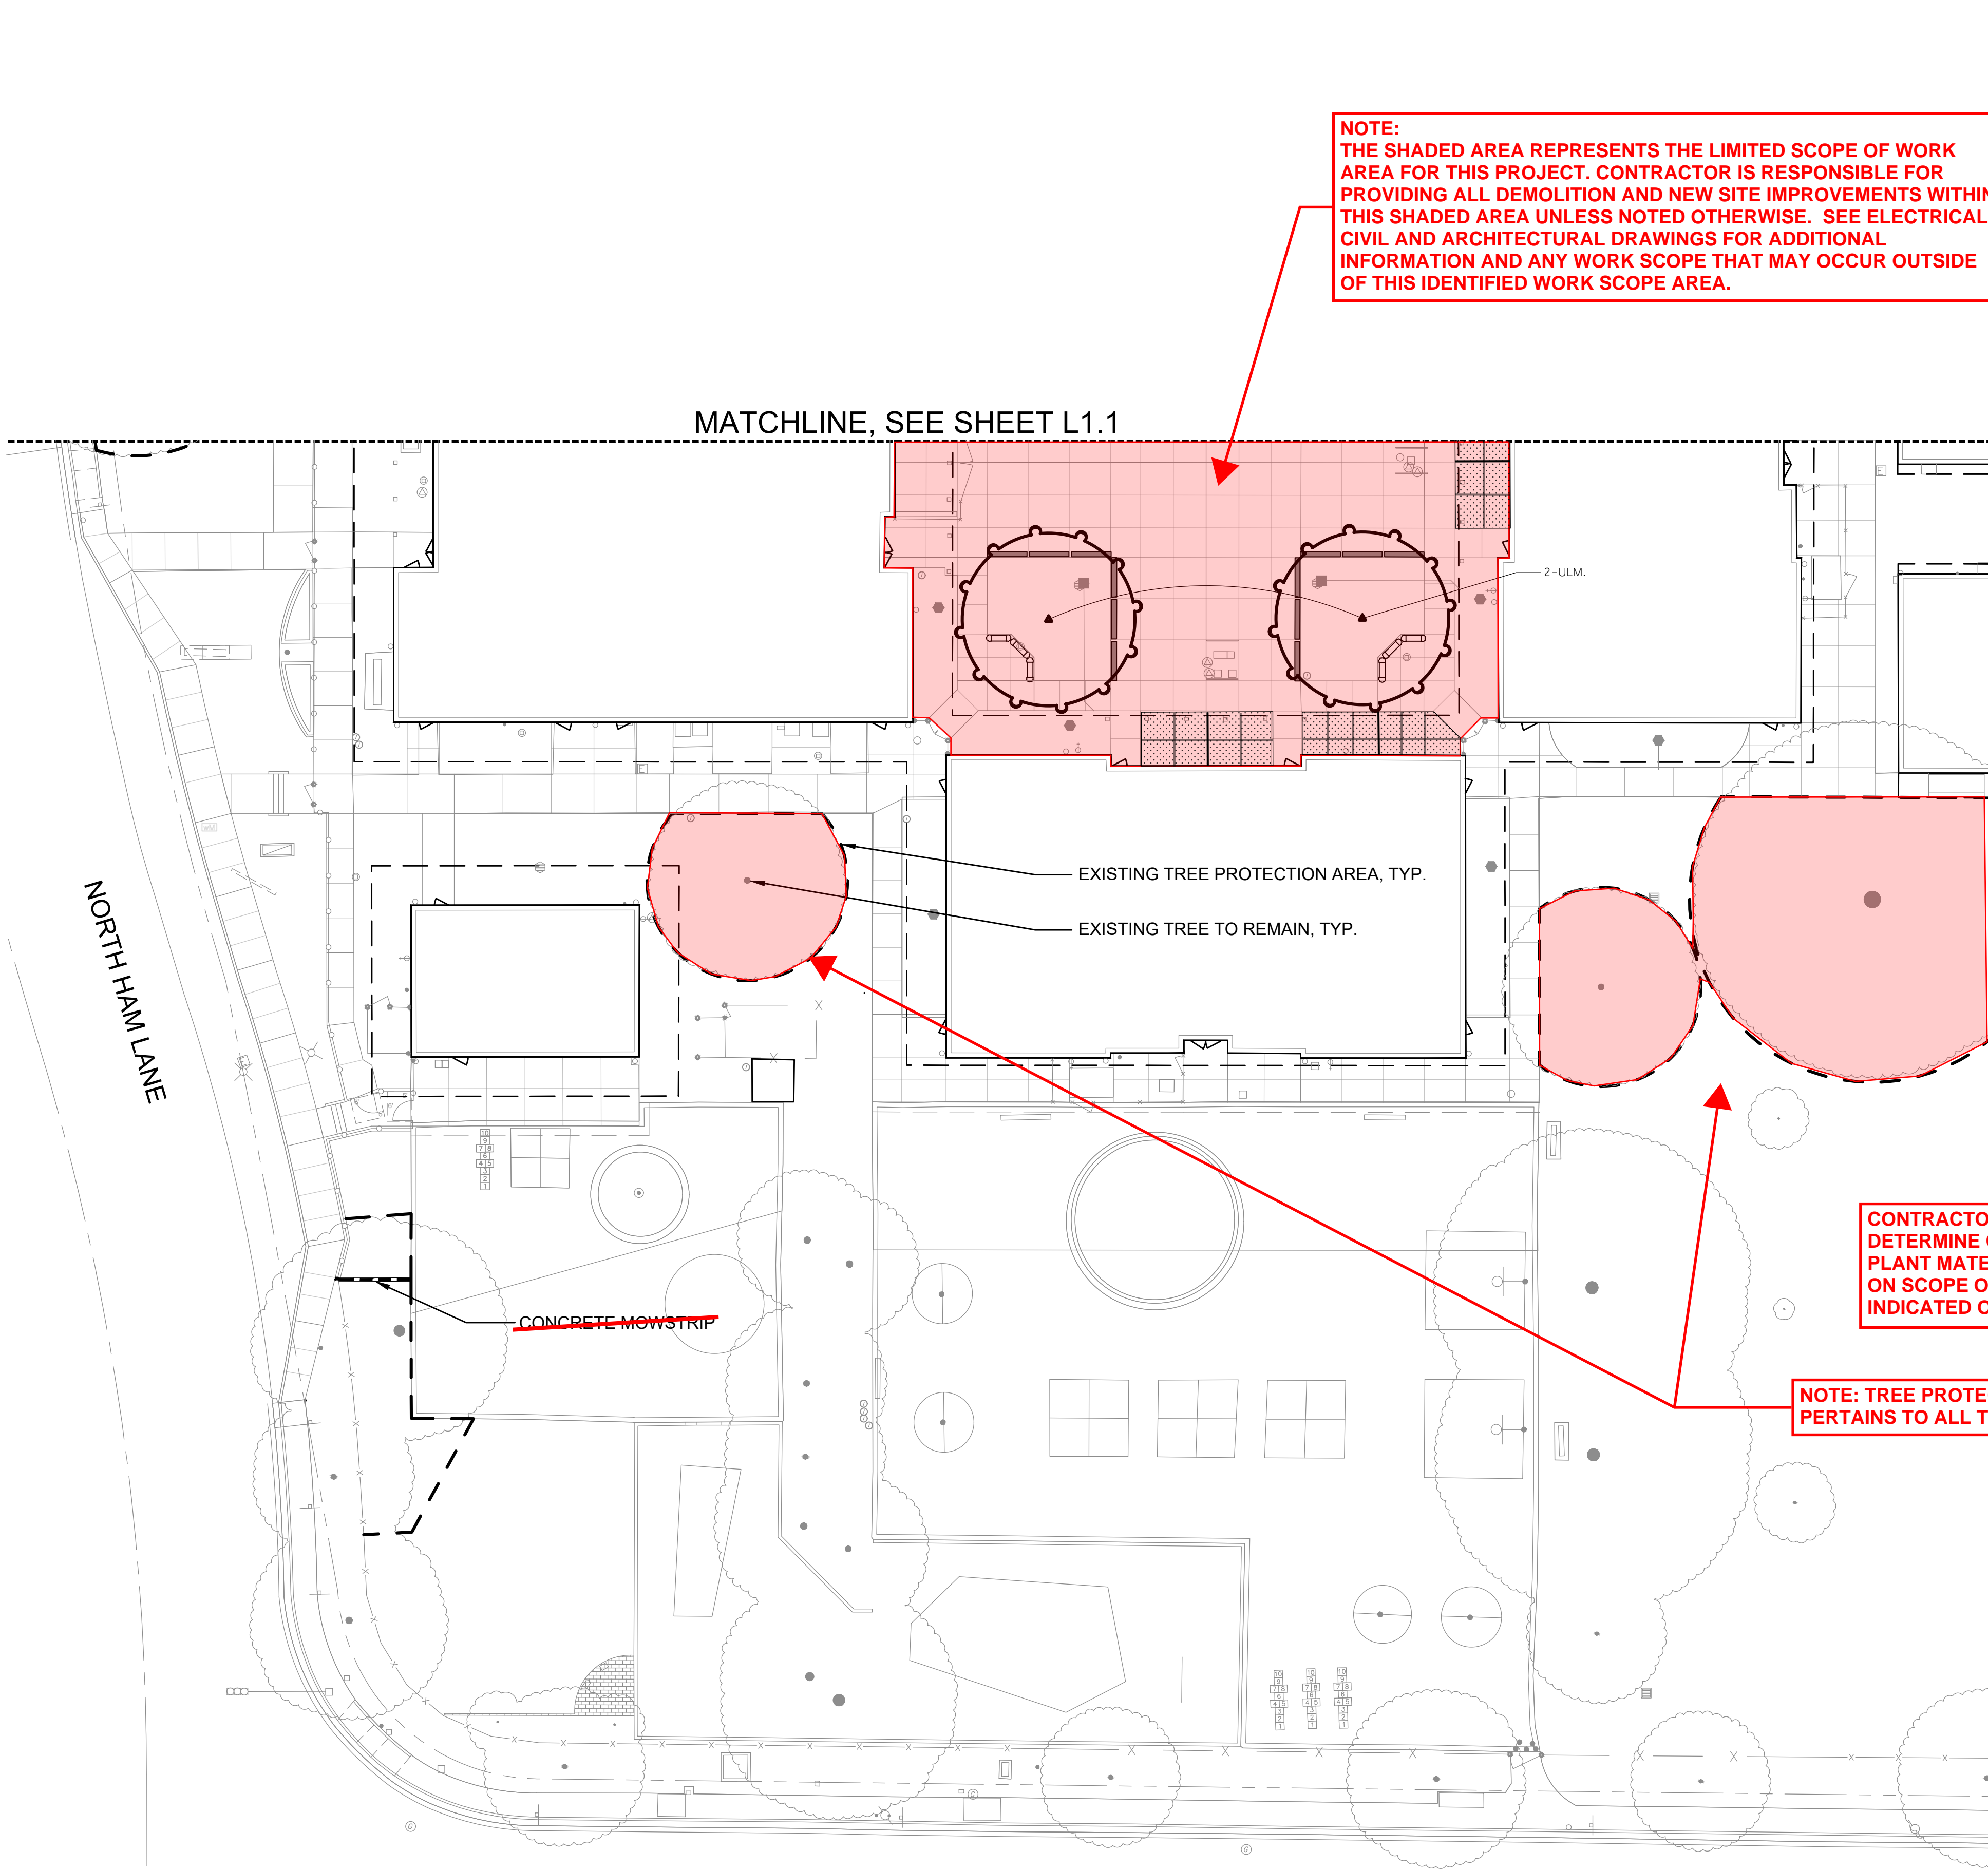

KEY

TREES - NOT ALL SYMBOLS SHOWN

EXISTING TREE TO REMAIN

EXISTING TREE PROTECTION AREA
SEE TREE PROTECTION DETAILS L4.1-1 AND L4.1-2 FOR OPERATIONS UNDERNEATH TREE DRIP LINES. SEE TREE PROTECTION SPECIFICATIONS.

NOTE:
CONTRACTOR TO IRRIGATE ALL TREES BY HAND DURING CONSTRUCTION PROCESS

ROOT BARRIER, INSTALL WHERE SHOWN ON PLANS
SEE DETAIL L4.1-4

PLANT QUANTITY

PLANT KEY

CONCRETE MOWSTRIP
SEE DETAIL L4.1-5

LANDSCAPE LEGEND

TREE MATERIAL LIST					
SIZE	QTY.	KEY	BOTANICAL NAME ... COMMON NAME		WATER USE
			TREES:		
24" BOX	6	ACE.	ACER BUERGERIANUM ... TRIDENT MAPLE		MEDIUM
24" BOX	2	CER.	CERCIS CANADENSIS VAR. TEXENSIS ... TEXAS REDBUD		LOW
24" BOX	5	GIN.	GINKGO BILOBA "PRINCETON SENTRY" ... PRINCETON SENTRY GINKGO (NON-FRUITING)		MEDIUM
24" BOX	8	PIS.	PISTACHIA CHINENSIS "KEITH DAVEY" ... CHINESE PISTACHE (NON-FRUITING)		LOW
24" BOX	4	QUE.	QUERCUS ILEX ... HOLLY OAK		LOW
24" BOX	4	ULM.	ULMUS PARVIFOLIA "TRUE GREEN" ... TRUE GREEN CHINESE ELM		MEDIUM

GENERAL LANDSCAPE REQUIREMENTS/NOTES

- NO PLANTING SHALL BE STARTED UNTIL SPRINKLER IRRIGATION SYSTEM HAS BEEN TESTED BY CONTRACTOR IN PRESENCE OF OWNER'S REPRESENTATIVE AND NOTED DEFICIENCIES CORRECTED.
- NO PLANTING SHALL BE STARTED UNTIL SOIL PREPARATION AND FINISH GRADING OPERATIONS HAVE BEEN COMPLETED AND APPROVED BY THE OWNER'S REPRESENTATIVE.
- QUANTITIES SHOWN ON PLANT MATERIAL LIST ARE APPROXIMATE. PROVIDE QUANTITIES INDICATED ON LANDSCAPE PLAN.
- PLANT MATERIAL IS SUBJECT TO APPROVAL OF OWNER'S REPRESENTATIVE.
- SEE SHEET L4.1 FOR PLANTING INSTALLATION DETAILS.

ENVIRONMENTAL REQUIREMENTS:

GENERAL: PROCEED WITH WORK IN ORDERLY AND TIMELY MANNER TO COMPLETE INSTALLATION OF LANDSCAPING WITHIN CONTRACT LIMITS.

PROTECTION:

EXISTING CONSTRUCTION: EXECUTE WORK IN AN ORDERLY AND CAREFUL MANNER TO PROTECT NEW CONCRETE WALKS, WORK OF OTHER TRADES, AND OTHER IMPROVEMENTS.

EXISTING UTILITIES: DETERMINE LOCATION OF UNDERGROUND UTILITIES AND PERFORM WORK IN A MANNER WHICH WILL AVOID POSSIBLE DAMAGE. HAND EXCAVATE, AS REQUIRED, TO MINIMIZE POSSIBILITY OF DAMAGE TO UNDERGROUND UTILITIES. MAINTAIN GRADE STAKES SET BY OTHERS UNTIL REMOVAL IS MUTUALLY AGREED UPON BY ALL PARTIES CONCERNED. BE RESPONSIBLE FOR PROTECTION OF EXISTING UTILITIES WITHIN CONSTRUCTION AREA; REPAIR DAMAGE TO UTILITIES THAT OCCUR AS A RESULT OF OPERATIONS OF THIS WORK.

LANDSCAPING: PROTECT LANDSCAPE WORK AND MATERIALS FROM DAMAGE DUE TO LANDSCAPE OPERATIONS, OPERATIONS BY OTHER CONTRACTORS AND TRADES AND TRESPASSERS. MAINTAIN PROTECTION DURING INSTALLATION AND MAINTENANCE PERIODS. TREAT, REPAIR OR REPLACE DAMAGED LANDSCAPE WORK AS DIRECTED AT NO ADDITIONAL COST TO CONTRACT.

ADVERSE CONDITIONS: WHEN CONDITIONS DETRIMENTAL TO SOD OR PLANT GROWTH ARE ENCOUNTERED, SUCH AS RUBBLE FILL, ADVERSE DRAINAGE CONDITIONS, OR OBSTRUCTIONS, NOTIFY OWNER'S REPRESENTATIVE BEFORE STARTING WORK.

PLANTING AND TURF INSTALLATION SEASONS AND CONDITIONS

NO WORK SHALL BE DONE WHEN GROUND IS FROZEN, SNOW COVERED, TOO WET OR IN AN OTHERWISE UNSUITABLE CONDITION FOR AMENDING SOIL, FINISH GRADING OR PLANTING.

SOIL TESTING/SOIL IMPROVEMENT:

SEE SPECIFICATIONS 32 90 00, SECTION 3.02 SOIL TESTING AND SECTION 3.03 PREPARATION.

SOIL PERCOLATION


EXCAVATE TREE PITS. FILL EXCAVATED PLANTING PITS WITH WATER TO 1/2 DEPTH OF PIT. PITS SHOULD DRAIN WITHIN 4 HOURS. IF PLANTING PITS DO NOT DRAIN, NOTIFY INSPECTOR IMMEDIATELY. PLANTING SHALL NOT BE STARTED UNTIL OWNER'S REPRESENTATIVE HAS RESOLVED A METHOD TO REMEDY DRAINAGE ISSUE.

PLANT MATERIAL STANDARDS

PLANTS SHALL BE IN ACCORDANCE WITH AMERICAN NATIONAL STANDARDS INSTITUTE (ANSI) ANSI Z60.1-AMERICAN STANDARD FOR NURSERY STOCK, EXCEPT AS OTHERWISE STATED IN SPECIFICATIONS OR SHOWN ON DRAWINGS. WHERE DRAWINGS OR SPECIFICATIONS ARE IN CONFLICT WITH ANSI Z60.1, DRAWINGS AND SPECIFICATIONS SHALL PREVAIL. PRUNE, THIN OUT AND SHAPE TREES IN ACCORDANCE WITH ANSI STANDARD HORTICULTURAL PRACTICE. PRUNE TREES TO RETAIN REQUIRED HEIGHT AND SPREAD, UNLESS OTHERWISE DIRECTED BY LANDSCAPE ARCHITECT. DO NOT CUT TREE LEADERS, AND REMOVE ONLY INJURED OR DEAD BRANCHES FROM FLOWERING TREES.

EXISTING LANDSCAPE AND SPRINKLER IRRIGATION SYSTEM

WORK LIMITS OF THIS PROJECT EXTEND INTO AREAS THAT WERE PREVIOUSLY DEVELOPED UNDER OTHER CONTRACTS. PRIOR TO START OF WORK, CONTRACTOR SHALL MEET WITH OWNER'S REPRESENTATIVE TO LOCATE ALL CONNECTIONS CALLED FOR ON DRAWINGS. WORK LIMITS/FENCING SHALL BE LAID OUT BY CONTRACTOR AND VERIFIED BY OWNER'S REPRESENTATIVE. FENCE TO BE INSTALLED AND IRRIGATION SYSTEM SHALL BE TESTED WITH CONTRACTOR, INSPECTOR, AND OWNER'S REPRESENTATIVE PRESENT. DEFICIENCIES SHALL BE NOTED AT THIS TIME AND ARE THE RESPONSIBILITY OF OWNER. AT COMPLETION OF WORK, SYSTEM WILL AGAIN BE TESTED. DEFICIENCIES NOTED AT THIS TIME THAT WERE NOT NOTED PREVIOUSLY WILL BE RESPONSIBILITY OF CONTRACTOR. EXISTING LANDSCAPE THAT HAS BEEN DAMAGED DUE TO CONSTRUCTION SHALL BE RESTORED TO ORIGINAL CONDITION BY CONTRACTOR AT NO ADDITIONAL COST TO OWNER. PRIOR TO MAKING ANY CONNECTION TO MAIN LINE, CONTRACTOR SHALL NOTIFY OWNER 1 WEEK IN ADVANCE SO ADJUSTMENTS TO EXISTING WATERING PROGRAMS CAN BE MADE.

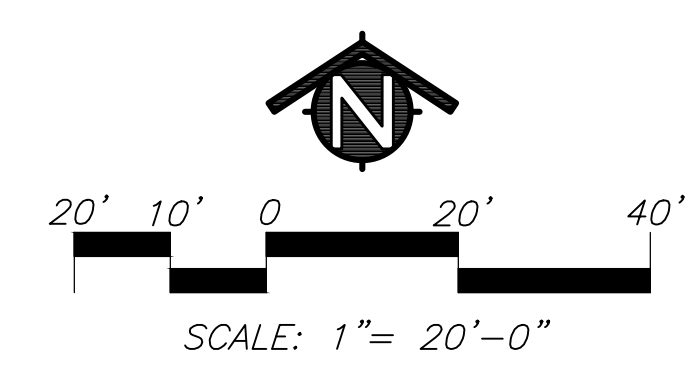

IDENTIFICATION STAMP
DIV. OF THE STATE ARCHITECT
APP: 02-120455 INC:
REVIEWED FOR
SS ☒ FLS ☒ ACS ☒
DATE: 01/12/2023

730 Howe Avenue, Suite 450
Sacramento, CA 95825
Phone: 916.921.2112
Fax: 916.921.2212

**HENRY+
ASSOCIATES**
ARCHITECTS

STEPHEN WALKER
C-22525
12/31/23
7/31/23
STATE OF CALIFORNIA

**MODERNIZATION LAKEWOOD
ELEMENTARY SCHOOL**

**TREE
PLANTING PLAN**


CONSULTANT

BRYAN HOLLIS WALKER
C-5453
11/4/22
7/31/23
STATE OF CALIFORNIA

Bryan Hollis Walker C-5453

PROJECT NO.	REVISIONS	BY
21-32-052		
DATE		
3/28/2022		
DRAWN		
MS		
CHECKED		
JCBS		
SCALE		
CADFILE		
UPDATED		
11/17/2022		
SHEET NO.		

L1.2

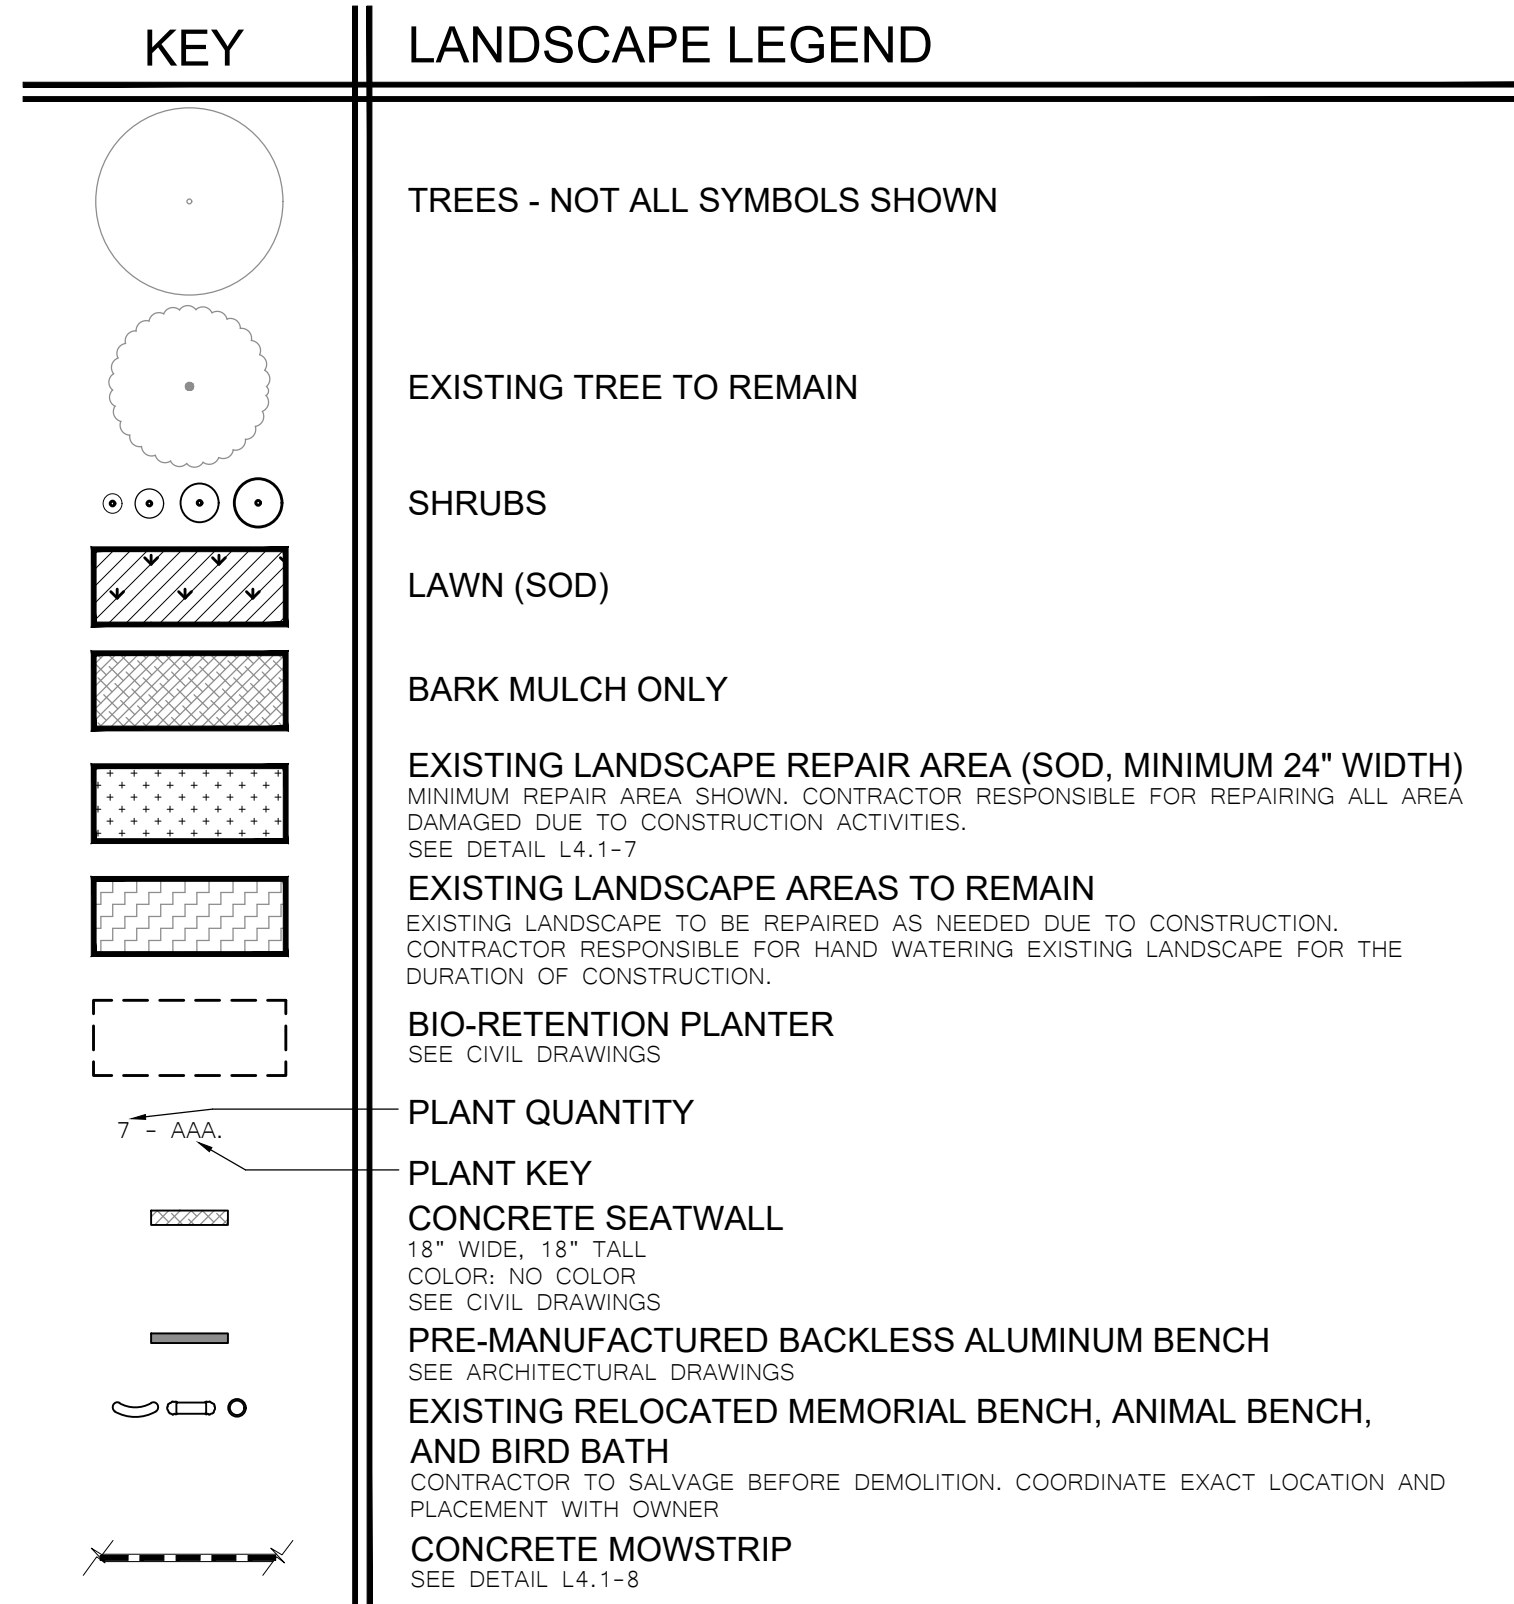

1. NO PLANTING SHALL BE STARTED UNTIL SPRINKLER IRRIGATION SYSTEM HAS BEEN TESTED BY CONTRACTOR IN PRESENCE OF OWNER'S REPRESENTATIVE AND NOTED DEFICIENCIES CORRECTED.
2. NO PLANTING SHALL BE STARTED UNTIL SOIL PREPARATION AND FINISH GRADING OPERATIONS HAVE BEEN COMPLETED AND APPROVED BY THE OWNER'S REPRESENTATIVE.
3. QUANTITIES SHOWN ON PLANT MATERIAL LIST ARE APPROXIMATE. PROVIDE QUANTITIES INDICATED ON LANDSCAPE PLAN.
4. PLANT MATERIAL IS SUBJECT TO APPROVAL OF OWNER'S REPRESENTATIVE.
5. SEE SHEET L4.1 FOR PLANTING INSTALLATION DETAILS.

GENERAL: PROCEED WITH WORK IN ORDERLY AND TIMELY MANNER TO COMPLETE INSTALLATION OF LANDSCAPING WITHIN CONTRACT LIMITS.

EXISTING CONSTRUCTION: EXECUTE WORK IN AN ORDERLY AND CAREFUL MANNER TO PROTECT NEW CONCRETE WALKS, WORK OF OTHER TRADES, AND OTHER IMPROVEMENTS.

EXISTING UTILITIES: DETERMINE LOCATION OF UNDERGROUND UTILITIES AND PERFORM WORK IN A MANNER WHICH WILL AVOID POSSIBLE DAMAGE. HAND EXCAVATE, AS REQUIRED, TO MINIMIZE POSSIBILITY OF DAMAGE TO UNDERGROUND UTILITIES. MAINTAIN GRADE STAKES SET BY OTHERS UNTIL REMOVAL IS MUTUALLY AGREED UPON BY ALL PARTIES CONCERNED. BE RESPONSIBLE FOR PROTECTION OF EXISTING UTILITIES WITHIN CONSTRUCTION AREA; REPAIR DAMAGE TO UTILITIES THAT OCCUR AS A RESULT OF OPERATIONS OF THIS WORK.

LANDSCAPING: PROTECT LANDSCAPE WORK AND MATERIALS FROM DAMAGE DUE TO LANDSCAPE OPERATIONS, OPERATIONS BY OTHER CONTRACTORS AND TRADES AND TRESPASSERS. MAINTAIN PROTECTION DURING INSTALLATION AND MAINTENANCE PERIODS. TREAT, REPAIR OR REPLACE DAMAGED LANDSCAPE WORK AS DIRECTED AT NO ADDITIONAL COST TO CONTRACT.

ADVERSE CONDITIONS: WHEN CONDITIONS DETRIMENTAL TO SOD OR PLANT GROWTH ARE ENCOUNTERED, SUCH AS RUBBLE FILL, ADVERSE DRAINAGE CONDITIONS, OR OBSTRUCTIONS, NOTIFY OWNER'S REPRESENTATIVE BEFORE STARTING WORK.

NO WORK SHALL BE DONE WHEN GROUND IS FROZEN, SNOW COVERED, TOO WET OR IN AN OTHERWISE UNSUITABLE CONDITION FOR AMENDING SOIL, FINISH GRADING OR PLANTING.

SEE SPECIFICATIONS 32 90 00, SECTION 3.02 SOIL TESTING AND SECTION 3.03 PREPARATION.

EXCAVATE TREE PITS. FILL EXCAVATED PLANTING PITS WITH WATER TO 1/2 DEPTH OF PIT. PITS SHOULD DRAIN WITHIN 4 HOURS. IF PLANTING PITS DO NOT DRAIN, NOTIFY INSPECTOR IMMEDIATELY. PLANTING SHALL NOT BE STARTED UNTIL OWNER'S REPRESENTATIVE HAS RESOLVED A METHOD TO REMEDY DRAINAGE ISSUE.


PLANTS SHALL BE IN ACCORDANCE WITH AMERICAN NATIONAL STANDARDS INSTITUTE (ANSI) ANSI Z60.1- AMERICAN STANDARD FOR NURSERY STOCK, EXCEPT AS OTHERWISE STATED IN SPECIFICATIONS OR SHOWN ON DRAWINGS, WHERE DRAWINGS OR SPECIFICATIONS ARE IN CONFLICT WITH ANSI Z60.1, DRAWINGS AND SPECIFICATIONS SHALL PREVAIL. PRUNE, THIN OUT AND SHAPE TREES IN ACCORDANCE WITH ANSI STANDARD Z60.1-1.2. PRUNING SHALL BE DONE TO RETAIN REQUIRED HEIGHT AND SPREAD, UNLESS OTHERWISE DIRECTED BY LANDSCAPE ARCHITECT, DO NOT CUT TREE LEADERS, AND REMOVE ONLY INJURED OR DEAD BRANCHES FROM FLOWERING TREES.

WORK LIMITS OF THIS PROJECT EXTEND INTO AREAS THAT WERE PREVIOUSLY DEVELOPED UNDER OTHER CONTRACTS. PRIOR TO START OF WORK, CONTRACTOR SHALL MEET WITH OWNER'S REPRESENTATIVE TO LOCATE ALL CONNECTIONS CALLED FOR ON DRAWINGS. WORK LIMITS/FENCING SHALL BE LAID OUT BY CONTRACTOR. CONTRACTOR SHALL BE RESPONSIBLE FOR OBTAINING ALL NECESSARY PERMITS AND SHALL BE RESPONSIBLE FOR BEING TESTED WITH CONTRACTOR, INSPECTOR, AND OWNER'S REPRESENTATIVE PRESENT. DEFICIENCIES SHALL BE NOTED AT THIS TIME AND ARE THE RESPONSIBILITY OF OWNER. AT COMPLETION OF WORK, SYSTEM WILL BE TESTED WITH CONTRACTOR, INSPECTOR, AND OWNER'S REPRESENTATIVE PRESENT. CONTRACTOR SHALL BE RESPONSIBLE FOR CONTRACTOR, EXISTING LANDSCAPE THAT HAS BEEN DAMAGED DUE TO CONSTRUCTION SHALL BE RESTORED TO ORIGINAL CONDITION BY CONTRACTOR AT NO ADDITIONAL COST TO OWNER. CONTRACTOR SHALL ADVISE OWNER OF ANY DAMAGE TO EXISTING LANDSCAPE OR TO ANY ADJACENT PROPERTY. CONTRACTOR SHALL ADVISE OWNER SO ADJUSTMENTS TO EXISTING WATERING PROGRAMS CAN BE MADE.


WATER USE	SIZE	QUANTITY	KEY	BOTANICAL NAME ... COMMON NAME
				SHRUBS:
LOW	5 G.C.	36	ACA.	ACACIA COGNATA 'COUSIN ITT' ... COUSIN ITT ACACIA
LOW	1 G.C.	48	ACH.	ACHILLEA MILLEFOLIUM 'SONOMA COAST' ... SONOMA COAST YARROW
LOW	5 G.C.	28	ANI.	ANIGOSANTHOS 'YELLOW GEM' ... YELLOW GEM KANGAROO PAW
LOW	5 G.C.	30	ASP.	ASPIDISTRA ELATOR ... CAST IRON PLANT
LOW	1 G.C.	34	BUL.	BULBINE FRUTESCENS 'HALLMARK' ... ORANGE STALKED BULBINE
LOW	5 G.C.	56	CIS.	CISTUS HYBRIDUS 'MICKIE' ... MICKIE ROCKROSE
LOW	1 G.C.	53	DIA.	DIANELLA REVOLUTA 'CLARITY BLUE' ... CLARITY BLUE DIANELLA
LOW	1 G.C.	130	DIE.	DIEYES GRANDIFOLIA 'VARIEGATA' ... STRIPED FORTNIGHT LILY
LOW	5 G.C.	50	EUM.	EUMYRSUM FORTUNEI 'EMERALD GAITY' ... EMERALD GAITY WINTERCREEPER
LOW	5 G.C.	33	NAN.	NANDINA DOMESTICA 'OBSESSION' ... OBSESSION HEAVENLY BAMBOO
LOW	5 G.C.	8	LAV.	LAVERANDULA X GINGINSII 'GOODWIN CREEK GRAY' ... GOODWIN CREEK LAVENDER
LOW	5 G.C.	12	PER.	PEROVSKIA ATROPICIFOLIA ... RUSSIAN SAGE
LOW	5 G.C.	15	PHO.	PHORMIUM 'EVENING GLOW' ... EVENING GLOW PHORMIUM
LOW	5 G.C.	31	RHA.	RHAMNUS CALIFORNICA 'MOUND SAN BRUNO' ... SAN BRUNO COFFEEBERRY
LOW	5 G.C.	10	ROS.	ROSA 'MEISENTAL' ... LEMON DRIFT CARPET ROSE
LOW	1 G.C.	75	TEU.	TEUCRIUM CHAMAEDRYX ... WALL GERMANDER
				GROUNDCOVER:
LOW	5 G.C.	27	ARC.	ARCSTOSTAPHYLOS 'EMERALD CARPET' ... EMERALD CARPET MANZANITA
LOW	5 G.C.	145	WES.	WESTRINGIA FRUTICOSA 'MUNDI' ... MUNDI WESTRINGIA
				ORNAMENTAL GRASSES:
LOW	1 G.C.	24	BOU.	BOUTELOUA GRACILIS 'BLONDE AMBITION' ... BLONDE AMBITION GRAMMA GRASS
LOW	1 G.C.	34	FES.	FESTUCA GAUCIA 'ELUOH BLUE' ... ELUOH BLUE FESCUE
LOW	5 G.C.	12	MUH.	MUHLENBERGIA RIGENS ... DEER GRASS
				BIO-RETENTION PLANTING
LOW	5 G.C.	42	CAR.	CAREX DIVULSA ... EUROPEAN GRAY SEDGE
LOW	5 G.C.	36	CHO.	CHONDROPOLATUM TECTORUM ... SMALL CAPE RUSH
MEDIUM	5 G.C.	28	JUN.	JUNCUS PATENS ... CALIFORNIA GRAY RUSH

CONTRACTOR TO DETERMINE QUANTITY OF PLANT MATERIAL BASED ON SCOPE OF WORK INDICATED ON PLAN.

SEE CIVIL FOR EXTENT OF WALKWAY
REPAIR. CONTRACTOR TO REPAIR
LANDSCAPE AND IRRIGATION DAMAGED
DURING CONSTRUCTION OF NEW
WALKWAY. EXISTING TREES TO REMAIN,
SEE SHEET L1.1 AND TREE PROTECTION
SPECIFICATIONS. ALL LAWN DAMAGED
DURING CONSTRUCTION SHALL BE
REPLACED WITH SOD. IRRIGATION TO
LAWN AND EXISTING TREES SHALL NOT
BE PAUSED FOR MORE THAN 96 HOURS.
CONTRACTOR RESPONSIBLE TO
REPLACE ALL TURF IN EXISTING LAWN
AREAS THAT ARE LEFT WITHOUT WATER
FOR MORE THAN 96 HOURS. REPAIR
SHALL BE WITH SOD.

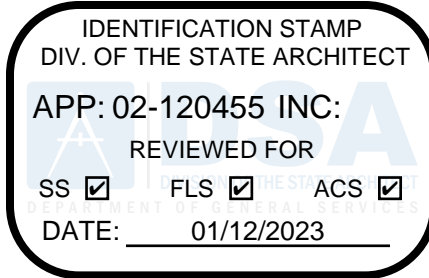


730 Howe Avenue, Suite 450
Sacramento, CA 95825
Phone: 916.921.2112
Fax: 916.921.2212

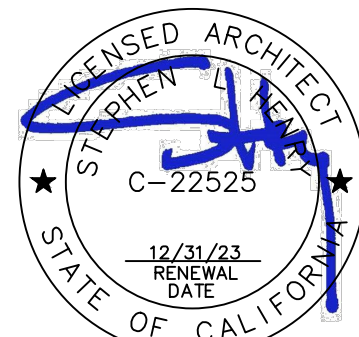

MODERNIZATION LAKEWOOD
ELEMENTARY SCHOOL

SHRUB PLANTING PLAN

CONSULTANT

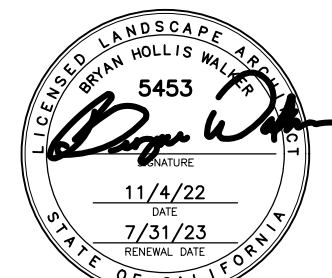



Bryan Hollis Walker

C-5453

PROJECT NO. 21-32-052	REVISIONS	BY
DATE 3/28/2022		
DRAWN MS		
CHECKED JCBS		
SCALE		
CADFILE		
UPDATED 11/17/2022		
SHEET NO.		

L2.1

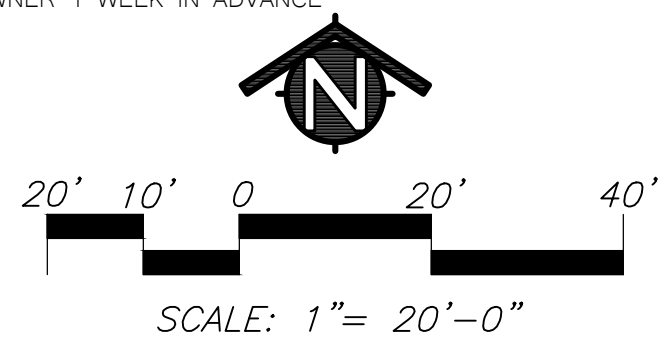

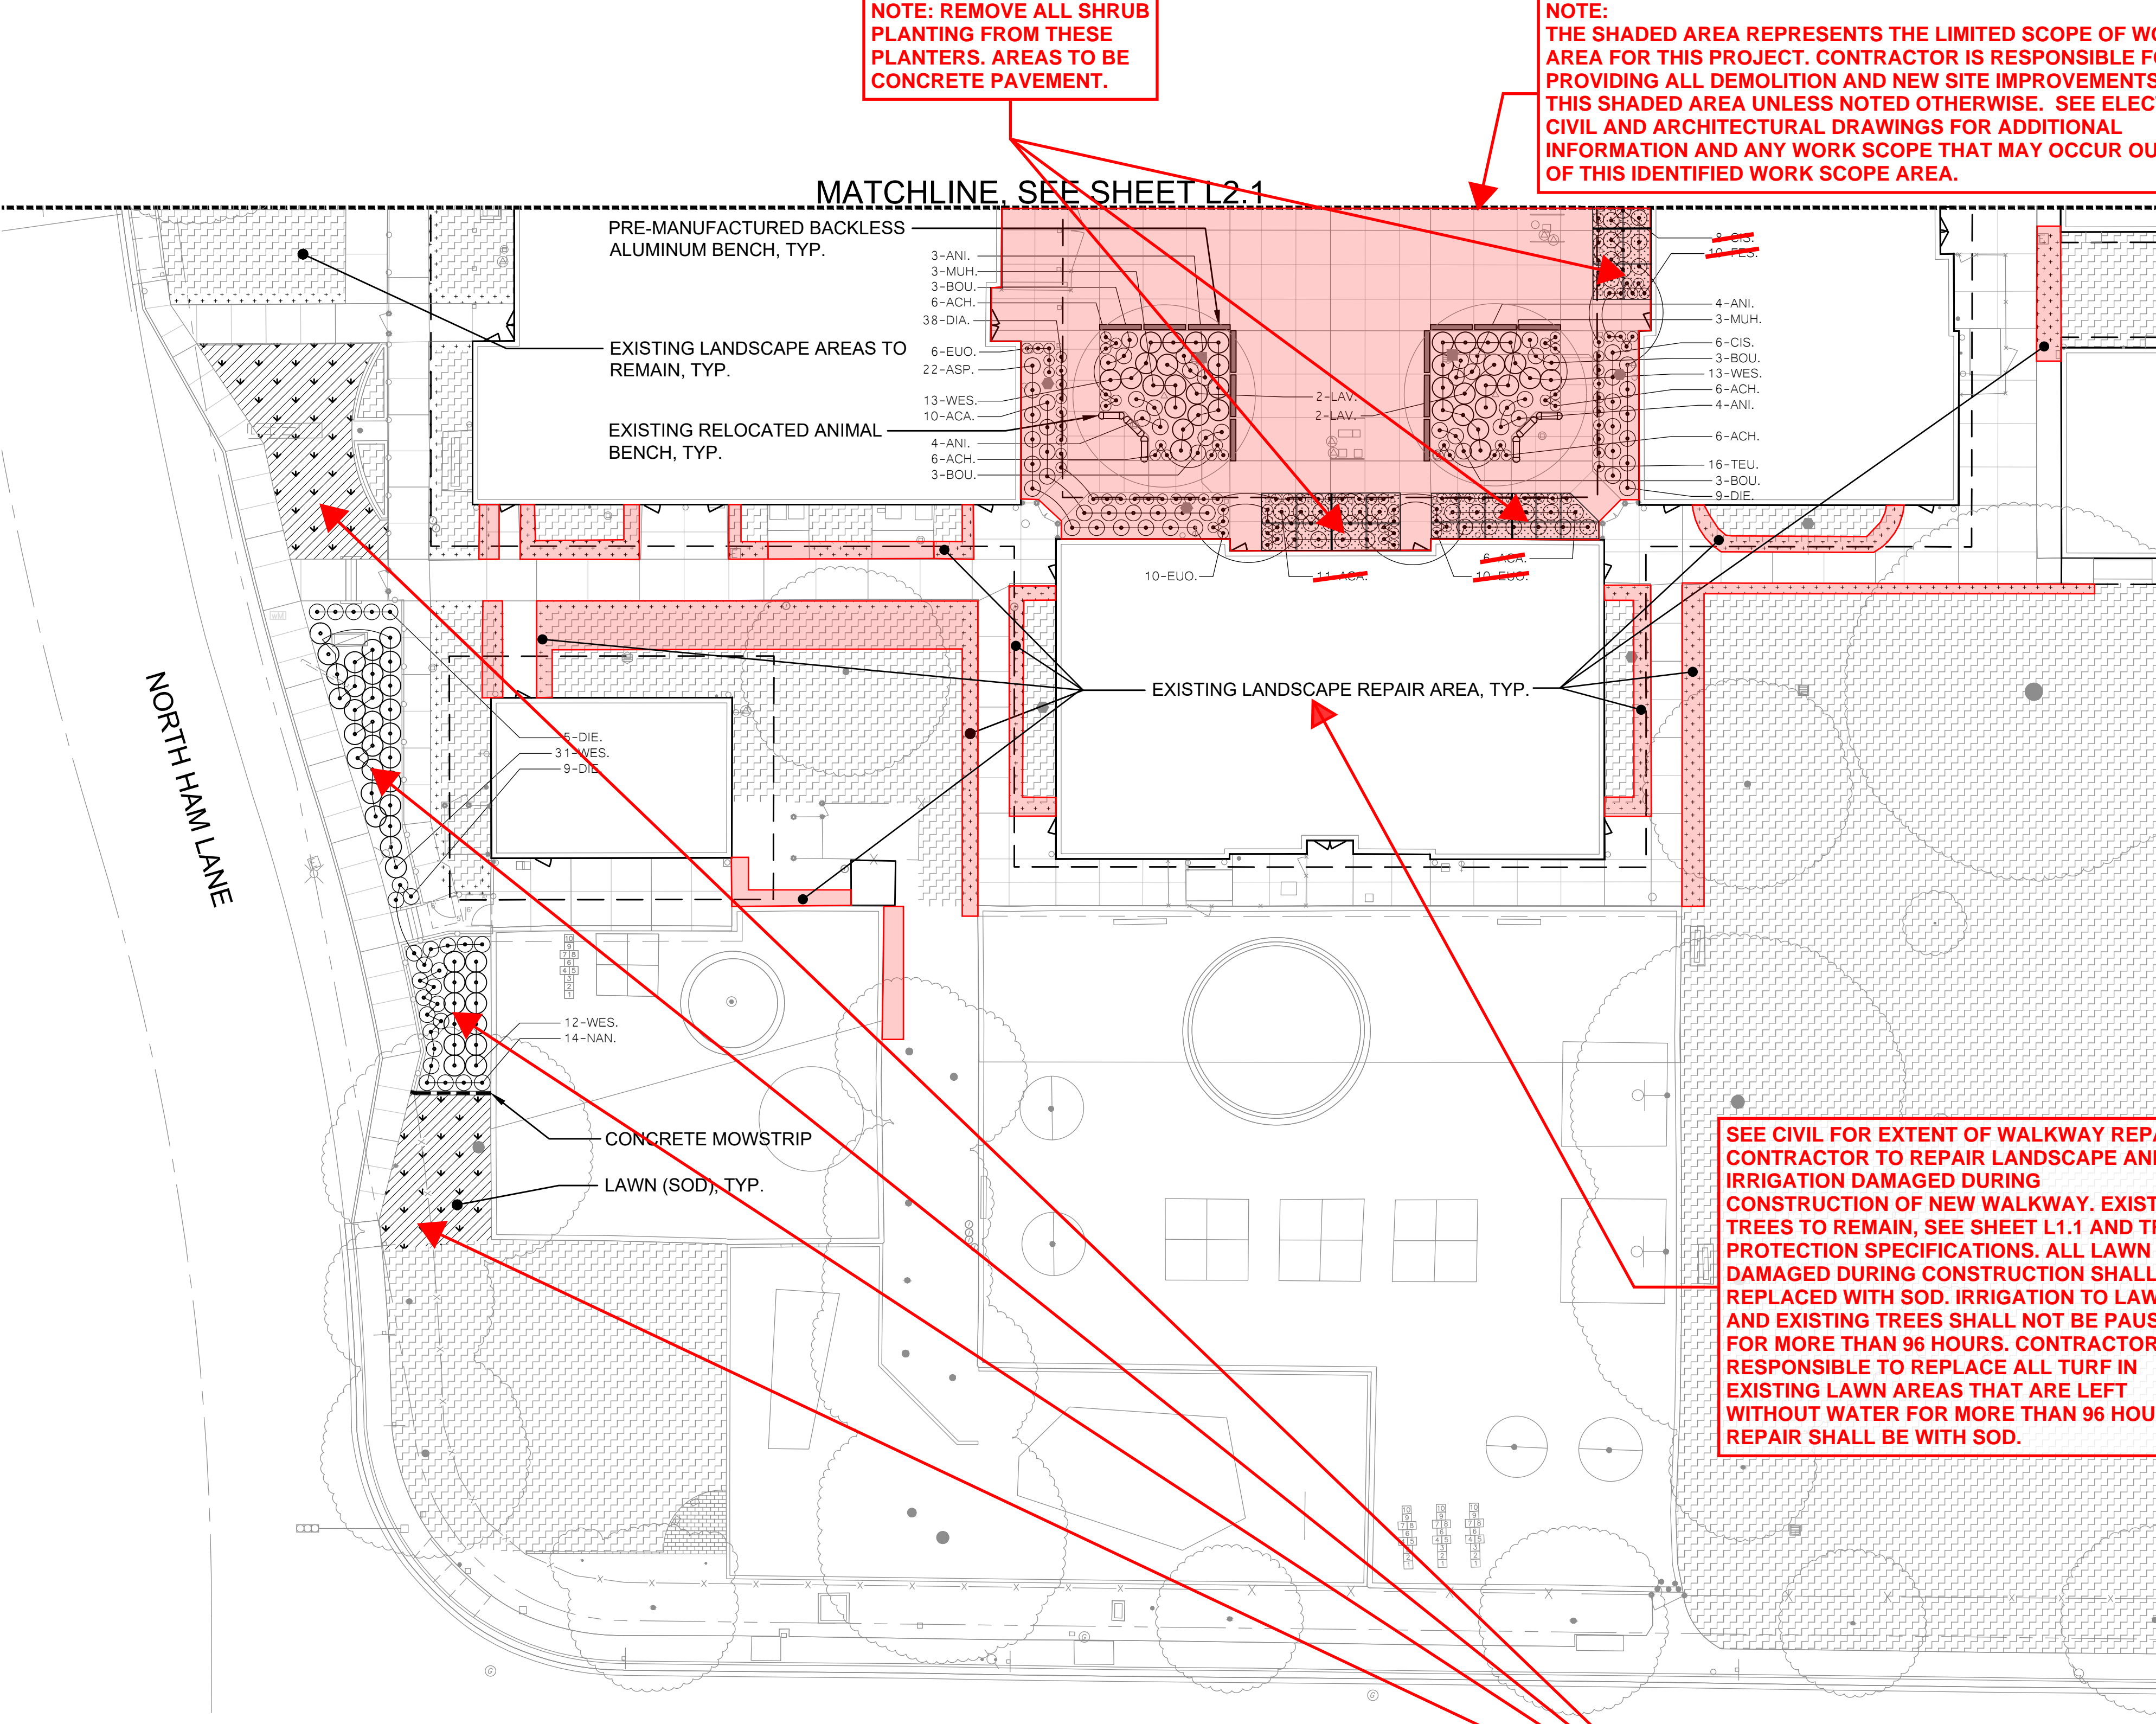

NOTE: REMOVE ALL SHRUB PLANTING FROM THESE PLANTERS. AREAS TO BE CONCRETE PAVEMENT.

NOTE: THE SHADED AREA REPRESENTS THE LIMITED SCOPE OF WORK AREA FOR THIS PROJECT. CONTRACTOR IS RESPONSIBLE FOR PROVIDING ALL DEMOLITION AND NEW SITE IMPROVEMENTS WITHIN THIS SHADED AREA UNLESS NOTED OTHERWISE. SEE ELECTRICAL, CIVIL AND ARCHITECTURAL DRAWINGS FOR ADDITIONAL INFORMATION AND ANY WORK SCOPE THAT MAY OCCUR OUTSIDE OF THIS IDENTIFIED WORK SCOPE AREA.

MATCHLINE SEE SHEET L2.1

SEE CIVIL FOR EXTENT OF WALKWAY REPAIR. CONTRACTOR TO REPAIR LANDSCAPE AND IRRIGATION DAMAGED DURING CONSTRUCTION OF NEW WALKWAY. EXISTING TREES TO REMAIN, SEE SHEET L1.1 AND TREE PROTECTION SPECIFICATIONS. ALL LAWN DAMAGED DURING CONSTRUCTION SHALL BE REPLACED WITH SOD. IRRIGATION TO LAWN AND EXISTING TREES SHALL NOT BE PAUSED FOR MORE THAN 96 HOURS. CONTRACTOR RESPONSIBLE TO REPLACE ALL TURF IN EXISTING LAWN AREAS THAT ARE LEFT WITHOUT WATER FOR MORE THAN 96 HOURS. REPAIR SHALL BE WITH SOD.

NOTE: ANY SITE OR BUILDING IMPROVEMENTS INDICATED OUTSIDE THE SHADED AREA IS NOT A PART OF THIS CONTRACT UNLESS NOTED OTHERWISE

PLANT MATERIAL LIST

WATER USE	SIZE	QUANTITY	KEY	BOTANICAL NAME ... COMMON NAME
SHRUBS:				
LOW	5 G.C.	36	ACA.	ACACIA COGNATA 'COUSIN ITT' ... COUSIN ITT ACACIA
LOW	1 G.C.	48	ACH.	ACHILLEA MILLEFOLIUM 'SONOMA COAST' ... SONOMA COAST YARROW
LOW	5 G.C.	28	ANI.	ANIGOSANTHOS 'YELLOW GEM' ... YELLOW GEM KANGAROO PAW
LOW	5 G.C.	30	ASP.	ASPIDISTRA BLATOR ... CAST IRON PLANT
LOW	1 G.C.	34	BUL.	BULBINE FRUTESCENS 'HALLMARK' ... ORANGE STALKED BULBINE
LOW	5 G.C.	56	CIS.	CISTUS HYBRIDUS 'MICKIE' ... MICKIE ROCKROSE
LOW	1 G.C.	53	DIA.	DIANELLA REVOLUTA 'CLARITY BLUE' ... CLARITY BLUE DIANELLA
LOW	1 G.C.	130	DIE.	DIETES GRANDIFLORA 'VARIEGATA' ... STRIPED FORTNIGHT LILY
LOW	1 G.C.	30	EUO.	EUONYMUS FORTUNEI 'EMERALD GAIETY' ... EMERALD GAIETY WINTERCREEPER
LOW	5 G.C.	53	NAN.	NANDINA DOMESTICA 'OBSESSION' ... OBSESSION HEAVENLY BAMBOO
LOW	5 G.C.	8	LAV.	LAVANDULA X GINGINII 'GOODWIN CREEK GRAY' ... GOODWIN CREEK LAVENDER
LOW	5 G.C.	12	PER.	PEROVSKIA ATRIPLICIFOLIA ... RUSSIAN SAGE
LOW	5 G.C.	15	PHO.	PHORMIUM 'EVENING GLOW' ... EVENING GLOW PHORMIUM
LOW	5 G.C.	31	RHA.	RHAMNUS CALIFORNICA 'MOUND SAN BRUNO' ... SAN BRUNO COFFEEBERRY
LOW	5 G.C.	10	ROS.	ROSA 'MEISENTMIL' ... LEMON DRIFT CARPET ROSE
LOW	1 G.C.	75	TEU.	TEUCRIUM CHAMAEDRYS ... WALL GERMANDER
GROUND COVER:				
LOW	5 G.C.	27	ARC.	ARCSTOSTAPHYLOS 'EMERALD CARPET' ... EMERALD CARPET MANZANITA
LOW	5 G.C.	145	WES.	WESTRINGIA FRUTICOSA 'MUNDI' ... MUNDI WESTRINGIA
ORNAMENTAL GRASSES:				
LOW	1 G.C.	24	BOU.	BOUTELOUA GRACILIS 'BLONDE AMBITION' ... BLONDE AMBITION GRAMMA GRASS
LOW	1 G.C.	94	FES.	FESTUCA GLAUCA 'ELIJAH BLUE' ... ELIJAH BLUE FESCUE
LOW	5 G.C.	12	MUH.	MUHLENBERGIA RIGENS ... DEER GRASS
BIO-RETENTION PLANTING				
LOW	5 G.C.	42	CAR.	CAREX DIVULSA ... EUROPEAN GRAY SEDGE
LOW	5 G.C.	36	CHO.	CHONDRPETALUM TECTORUM ... SMALL CAPE RUSH
MEDIUM	5 G.C.	28	JUN.	JUNCUS PATENS ... CALIFORNIA GRAY RUSH

CONTRACTOR TO DETERMINE QUANTITY OF PLANT MATERIAL BASED ON SCOPE OF WORK INDICATED ON PLAN.

KEY

LANDSCAPE LEGEND

TREES - NOT ALL SYMBOLS SHOWN

EXISTING TREE TO REMAIN

SHRUBS

LAWN (SOD)

BARK MULCH ONLY

EXISTING LANDSCAPE REPAIR AREA (SOD, MINIMUM 24" WIDTH)
MINIMUM REPAIR AREA SHOWN. CONTRACTOR RESPONSIBLE FOR REPAIRING ALL AREA DAMAGED DUE TO CONSTRUCTION ACTIVITIES.
SEE DETAIL L4.1-7

EXISTING LANDSCAPE AREAS TO REMAIN
EXISTING LANDSCAPE TO BE REPAIRED AS NEEDED DUE TO CONSTRUCTION.
CONTRACTOR RESPONSIBLE FOR HAND WATERING EXISTING LANDSCAPE FOR THE DURATION OF CONSTRUCTION.

BIO-RETENTION PLANTER
SEE CIVIL DRAWINGS

PLANT QUANTITY

PLANT KEY
CONCRETE SEATWALL
18" WIDE, 18" TALL
COLOR: NO COLOR
SEE CIVIL DRAWINGS

PRE-MANUFACTURED BACKLESS ALUMINUM BENCH
SEE ARCHITECTURAL DRAWINGS

EXISTING RELOCATED MEMORIAL BENCH, ANIMAL BENCH, AND BIRD BATH
CONTRACTOR TO SALVAGE BEFORE DEMOLITION. COORDINATE EXACT LOCATION AND PLACEMENT WITH OWNER.

CONCRETE MOWSTRIP
SEE DETAIL L4.1-8

GENERAL LANDSCAPE REQUIREMENTS/NOTES

- NO PLANTING SHALL BE STARTED UNTIL SPRINKLER IRRIGATION SYSTEM HAS BEEN TESTED BY CONTRACTOR IN PRESENCE OF OWNER'S REPRESENTATIVE AND NOTED DEFICIENCIES CORRECTED.
- NO PLANTING SHALL BE STARTED UNTIL SOIL PREPARATION AND FINISH GRADING OPERATIONS HAVE BEEN COMPLETED AND APPROVED BY THE OWNER'S REPRESENTATIVE.
- QUANTITIES SHOWN ON PLANT MATERIAL LIST ARE APPROXIMATE. PROVIDE QUANTITIES INDICATED ON LANDSCAPE PLAN.
- PLANT MATERIAL IS SUBJECT TO APPROVAL OF OWNER'S REPRESENTATIVE.
- SEE SHEET L4.1 FOR PLANTING INSTALLATION DETAILS.

ENVIRONMENTAL REQUIREMENTS:
GENERAL: PROCEED WITH WORK IN ORDERLY AND TIMELY MANNER TO COMPLETE INSTALLATION OF LANDSCAPING WITHIN CONTRACT LIMITS.

PROTECTION:
EXISTING CONSTRUCTION: EXECUTE WORK IN AN ORDERLY AND CAREFUL MANNER TO PROTECT NEW CONCRETE WALKS, WORK OF OTHER TRADES, AND OTHER IMPROVEMENTS.

EXISTING UTILITIES: DETERMINE LOCATION OF UNDERGROUND UTILITIES AND PERFORM WORK IN A MANNER WHICH WILL AVOID POSSIBLE DAMAGE, HAND EXCAVATE, AS REQUIRED, TO MINIMIZE POSSIBILITY OF DAMAGE TO UNDERGROUND UTILITIES. MAINTAIN GRADE STAKES SET BY OTHERS UNTIL REMOVAL IS MUTUALLY AGREED UPON BY ALL PARTIES CONCERNED. BE RESPONSIBLE FOR PROTECTION OF EXISTING UTILITIES WITHIN CONSTRUCTION AREA; REPAIR DAMAGE TO UTILITIES THAT OCCUR AS A RESULT OF OPERATIONS OF THIS WORK.

LANDSCAPING: PROTECT LANDSCAPE WORK AND MATERIALS FROM DAMAGE DUE TO LANDSCAPE OPERATIONS, OPERATIONS BY OTHER CONTRACTORS AND TRADES AND TRESPASSERS. MAINTAIN PROTECTION DURING INSTALLATION AND MAINTENANCE PERIODS. TREAT, REPAIR OR REPLACE DAMAGED LANDSCAPE WORK AS DIRECTED AT NO ADDITIONAL COST TO CONTRACT.

ADVERSE CONDITIONS: WHEN CONDITIONS DETRIMENTAL TO SOD OR PLANT GROWTH ARE ENCOUNTERED, SUCH AS RUBBLE FILL, ADVERSE DRAINAGE CONDITIONS, OR OBSTRUCTIONS, NOTIFY OWNER'S REPRESENTATIVE BEFORE STARTING WORK.


PLANTING AND TURF INSTALLATION SEASONS AND CONDITIONS
NO WORK SHALL BE DONE WHEN GROUND IS FROZEN, SNOW COVERED, TOO WET OR IN AN OTHERWISE UNSUITABLE CONDITION FOR AMENDING SOIL, FINISH GRADING OR PLANTING.

SOIL TESTING/SOIL IMPROVEMENT:
SEE SPECIFICATIONS 32 90 00, SECTION 3.02 SOIL TESTING AND SECTION 3.03 PREPARATION.

SOIL PERCOLATION
EXCAVATE TREE PITS. FILL EXCAVATED PLANTING PITS WITH WATER TO 1/2 DEPTH OF PIT. PITS SHOULD DRAIN WITHIN 4 HOURS. IF PLANTING PITS DO NOT DRAIN, NOTIFY INSPECTOR IMMEDIATELY. PLANTING SHALL NOT BE STARTED UNTIL OWNER'S REPRESENTATIVE HAS RESOLVED A METHOD TO REMEDY DRAINAGE ISSUE.


PLANT MATERIAL STANDARDS
PLANTS SHALL BE IN ACCORDANCE WITH AMERICAN NATIONAL STANDARDS INSTITUTE (ANSI) ANSI Z60.1- AMERICAN STANDARD FOR NURSERY STOCK, EXCEPT AS OTHERWISE STATED IN SPECIFICATIONS OR SHOWN ON DRAWINGS. WHERE DRAWINGS OR SPECIFICATIONS ARE IN CONFLICT WITH ANSI Z60.1, DRAWINGS AND SPECIFICATIONS SHALL PREVAIL. PRUNE, THIN OUT AND SHAPE TREES IN ACCORDANCE WITH ANSI STANDARD HORTICULTURAL PRACTICE. PRUNE TREES TO RETAIN REQUIRED HEIGHT AND SPREAD. UNLESS OTHERWISE DIRECTED BY LANDSCAPE ARCHITECT, DO NOT CUT TREE LEADERS, AND REMOVE ONLY INJURED OR DEAD BRANCHES FROM FLOWERING TREES.

EXISTING LANDSCAPE AND SPRINKLER IRRIGATION SYSTEM
WORK LIMITS OF THIS PROJECT EXTEND INTO AREAS THAT WERE PREVIOUSLY DEVELOPED UNDER OTHER CONTRACTS. PRIOR TO START OF WORK, CONTRACTOR SHALL MEET WITH OWNER'S REPRESENTATIVE TO LOCATE ALL CONNECTIONS CALLED FOR ON DRAWINGS. WORK LIMITS/FENCING SHALL BE LAID OUT BY CONTRACTOR AND VERIFIED BY OWNER'S REPRESENTATIVE. FENCE TO BE INSTALLED AND IRRIGATION SYSTEM SHALL BE TESTED WITH CONTRACTOR, INSPECTOR, AND OWNER'S REPRESENTATIVE PRESENT. DEFICIENCIES SHALL BE NOTED AT THIS TIME AND ARE THE RESPONSIBILITY OF OWNER. AT COMPLETION OF WORK, SYSTEM WILL AGAIN BE TESTED. DEFICIENCIES NOTED AT THIS TIME THAT WERE NOT NOTED PREVIOUSLY WILL BE RESPONSIBILITY OF CONTRACTOR. EXISTING LANDSCAPE THAT HAS BEEN DAMAGED DUE TO CONSTRUCTION SHALL BE RESTORED TO ORIGINAL CONDITION BY CONTRACTOR AT NO ADDITIONAL COST TO OWNER. PRIOR TO MAKING ANY CONNECTION TO MAIN LINE, CONTRACTOR SHALL NOTIFY OWNER 1 WEEK IN ADVANCE SO ADJUSTMENTS TO EXISTING WATERING PROGRAMS CAN BE MADE.

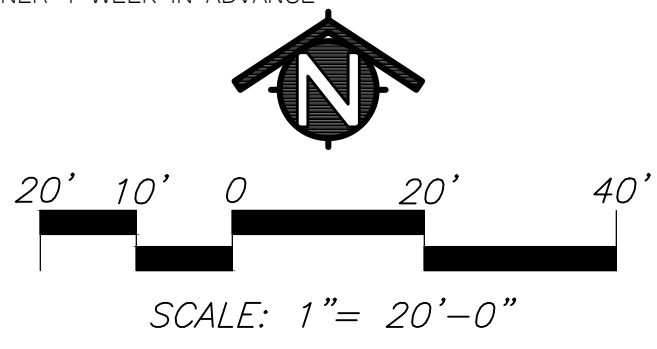

IDENTIFICATION STAMP
DIV. OF THE STATE ARCHITECT
APP: 02-120455 INC:
REVIEWED FOR
SS ☒ FLS ☒ ACS ☒
DATE: 01/12/2023


730 Howe Avenue, Suite 450
Sacramento, CA 95825
Phone: 916.921.2112
Fax: 916.921.2212

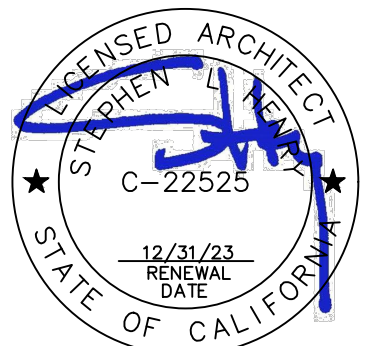

MODERNIZATION LAKEWOOD
ELEMENTARY SCHOOL

SHRUB
PLANTING PLAN


CONSULTANT

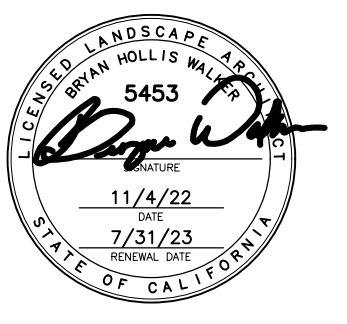

Bryan Hollis Walker C-5453

PROJECT NO.	REVISIONS	BY
21-32-052		
DATE		
3/28/2022		
DRAWN		
MS		
CHECKED		
JCBS		
SCALE		
CADFILE		
UPDATED		
11/17/2022		
SHEET NO.		

L2.2

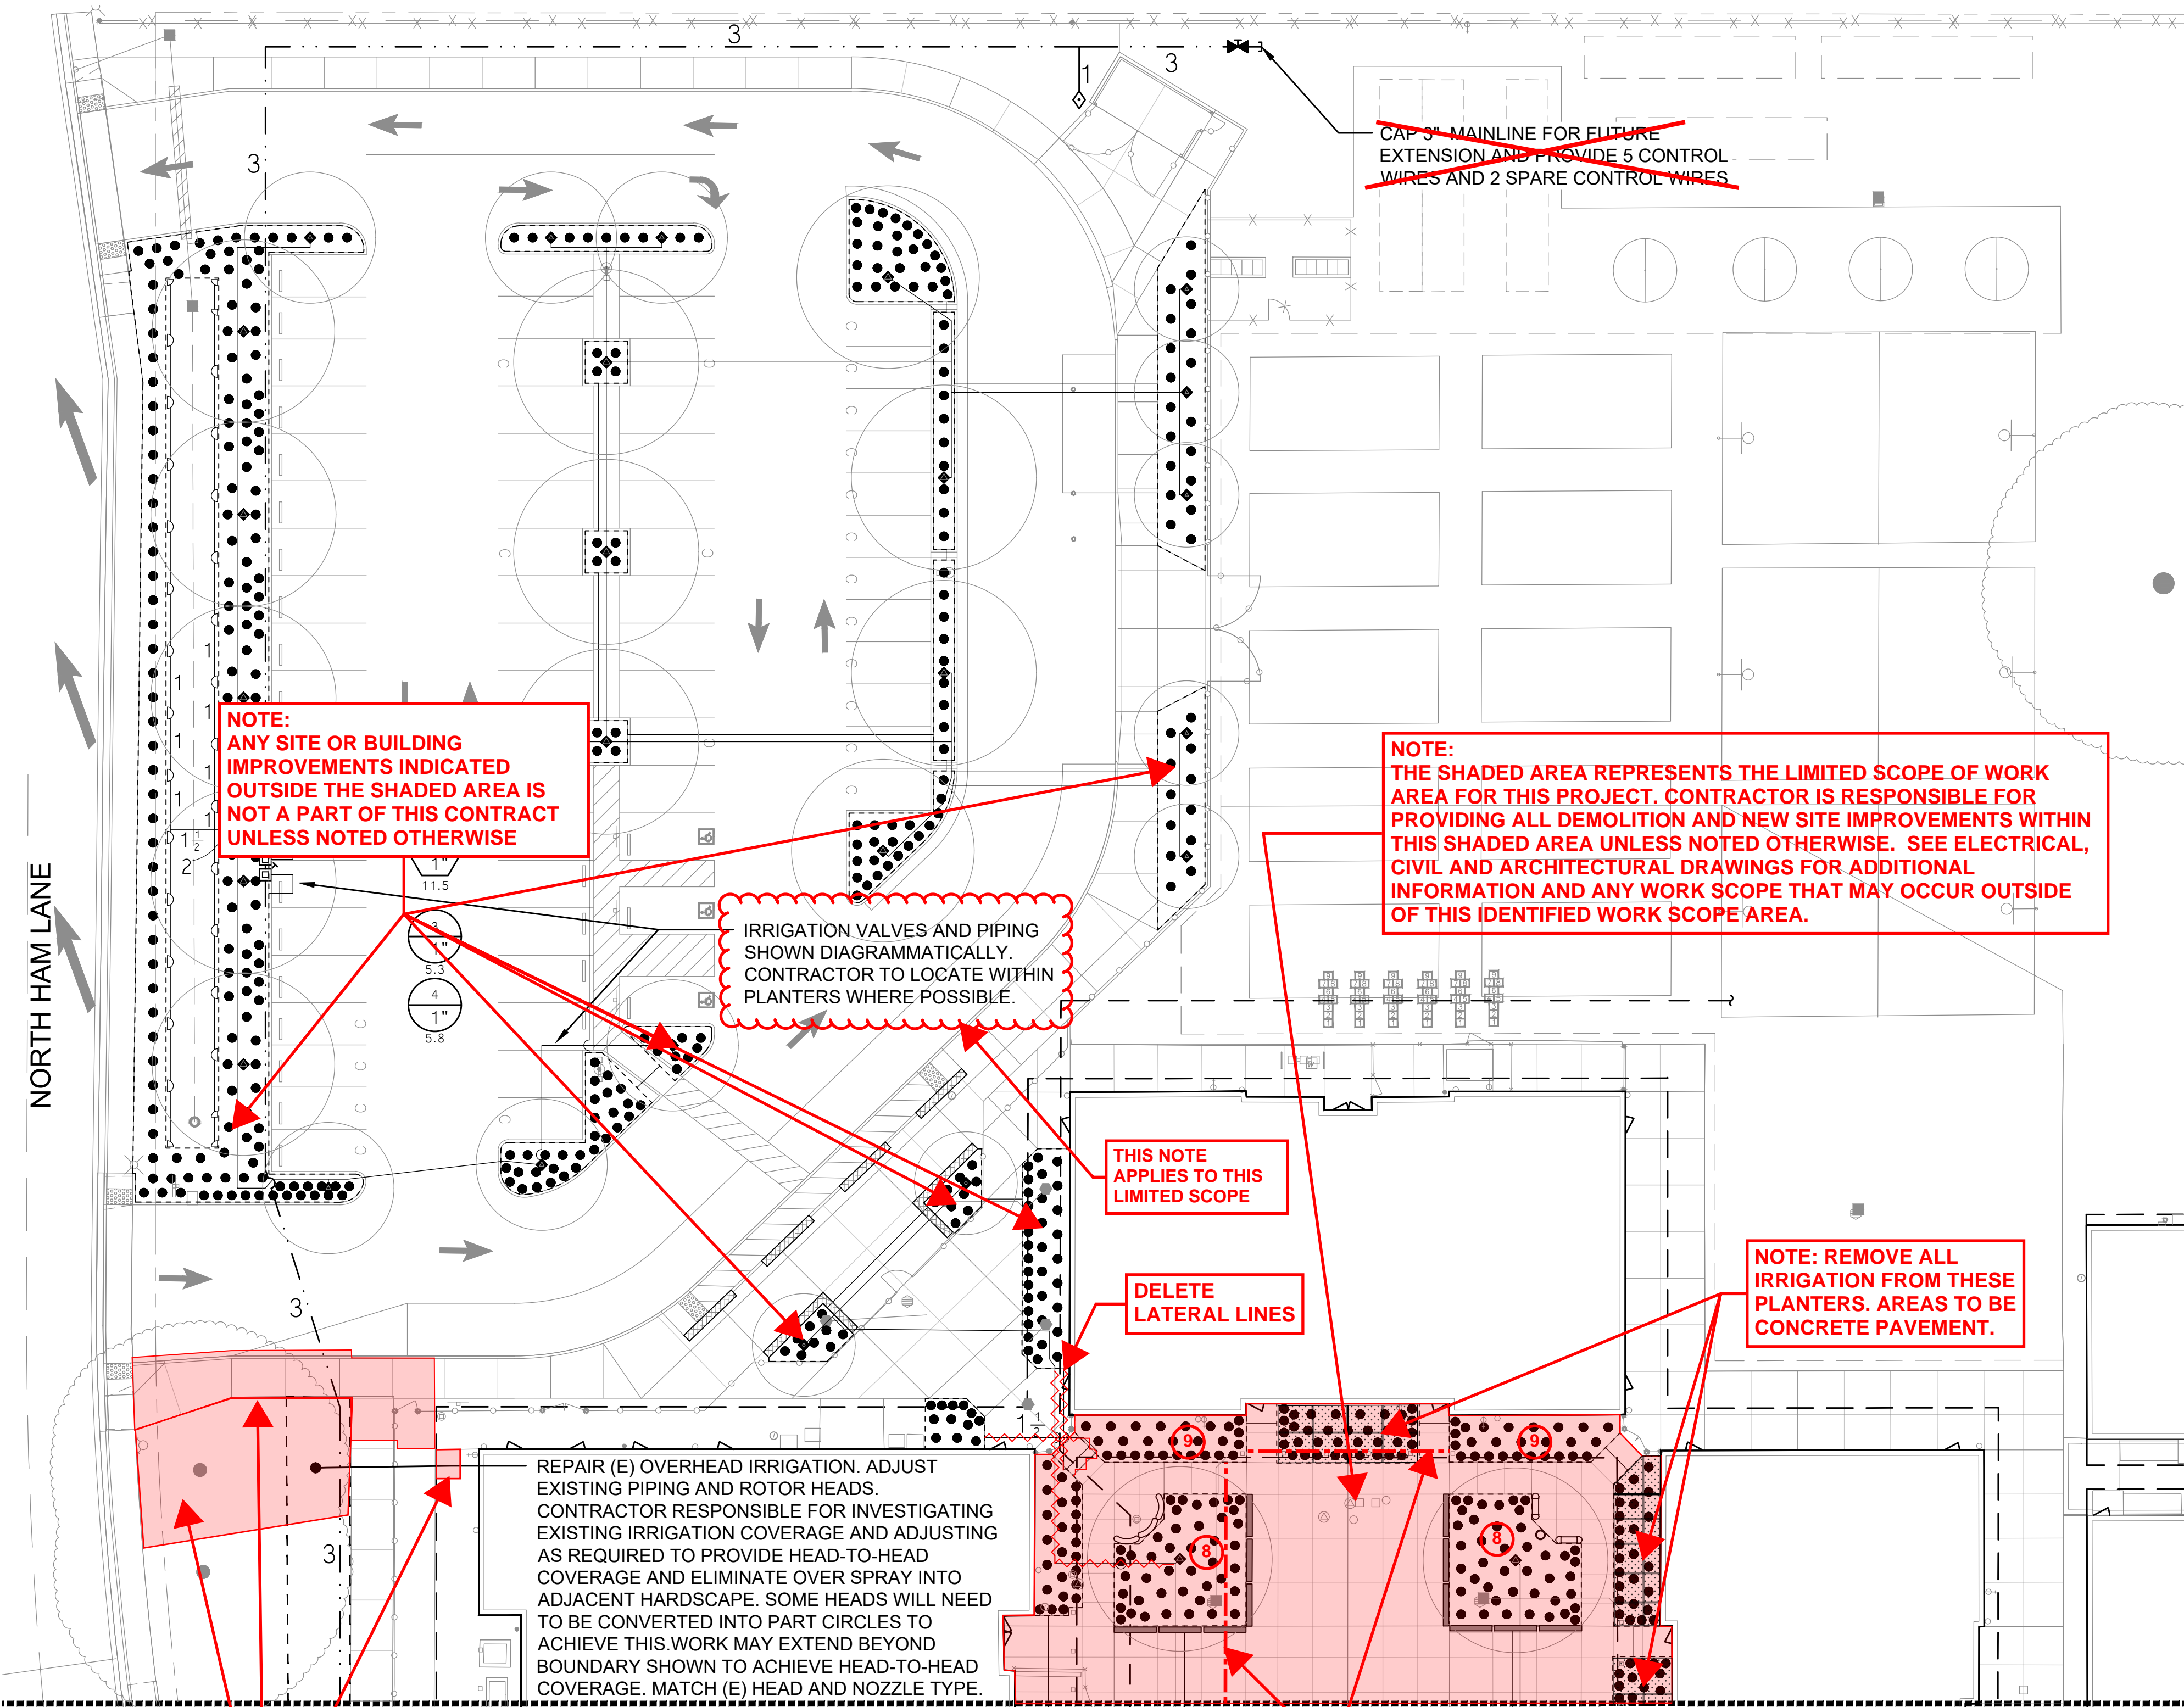

MATCHLINE, SEE SHEET L3.2

SPRINKLER IRRIGATION NOTES

- COMPOSITE BASE SHEET: PROPOSED IMPROVEMENTS SHOWN ON DRAWINGS ARE SUPERIMPOSED ON A COMPOSITE BASE SHEET. THE COMPOSITE BASE SHEET IS A COMPILATION OF ARCHITECTURAL, ENGINEERING, AND OTHER DATA THAT IS PROVIDED. THE LANDSCAPE ARCHITECT SHALL NOT BE HELD LIABLE FOR CHANGES, INACCURACIES, OMISSIONS, OR ERRORS PERTAINING TO THE COMPOSITE BASE SHEET. CONTRACTOR SHALL BE RESPONSIBLE FOR REVIEWING THESE DOCUMENTS. ANY DISCREPANCIES NEED TO BE BROUGHT TO THE ATTENTION OF THE DESIGN TEAM AND RESOLVED PRIOR TO CONTINUATION OF WORK.
- DESIGN PRESSURE SHOWN ON PLANS HAS BEEN FURNISHED BY WATER COMPANY OR WATER DISTRICT SERVING SITE. VERIFY PRESSURE ON-SITE PRIOR TO THE INSTALLATION OF ANY SPRINKLER IRRIGATION EQUIPMENT. IF THERE IS A DISCREPANCY, NOTIFY OWNER'S REPRESENTATIVE IMMEDIATELY IN WRITING SO ADJUSTMENTS CAN BE MADE BY LANDSCAPE ARCHITECT. FAILURE TO REPORT DISCREPANCIES AND CONTINUANCE OF WORK WILL RESULT IN ALL RE-DESIGN COSTS BEING CHARGED TO CONTRACTOR.
- DETERMINE LOCATION OF UNDERGROUND UTILITIES. DAMAGE CAUSED BY INSTALLATION OF THIS WORK SHALL BE REPAIRED TO SATISFACTION OF GOVERNING AGENCY OR OWNER AT NO ADDITIONAL COST TO THE CONTRACT.
- SPRINKLER OVER SPRAY SHALL NOT BE ALLOWED ON PUBLIC SIDEWALKS, BUILDING WALLS OR FENCES. MINIMUM OVERSPRAY MAY OCCUR IN PARKING AREAS. USE ADJUSTABLE NOZZLES WHENEVER POSSIBLE TO CONTROL SPRINKLER OVERSPRAY.
- ALL LOCAL CODES AND ORDINANCES SHALL BE COMPLIED WITH. IF THERE IS A CONFLICT, NOTIFY OWNER'S REPRESENTATIVE IMMEDIATELY.
- TESTING:
 - PRESSURE TEST ALL UNDERGROUND PIPING AS FOLLOWS:
 - SYSTEMS WITH BOOSTER PUMP:
 - MAIN LINE - AT 100 PSI FOR 4 HOURS.
 - LATERAL LINES - AT 100 PSI FOR 2 HOURS.
 - SYSTEMS WITH OUT BOOSTER PUMP:
 - MAIN LINE - AT STATIC PSI FOR 4 HOURS.
 - LATERAL LINES - AT STATIC PSI FOR 2 HOURS.
 - COVERAGE TEST: NOTE: PRIOR TO REQUESTING COVERAGE TEST, INSURE ALL HEADS ARE SET PLUMB, NOZZLES ARE ADJUSTED PROPERLY AND SYSTEM HAS BEEN CHECKED FOR AUTOMATION. REQUEST OWNER'S REPRESENTATIVES PRESENCE ON-SITE WHEN SPRINKLER SYSTEM IS COMPLETELY INSTALLED AND FULLY AUTOMATIC. PROVIDE ADEQUATE PERSONNEL AT THIS MEETING TO ADJUST AND FINE TUNE SYSTEM TO SATISFACTION OF OWNER'S REPRESENTATIVE.
- LAYOUT ALL WORK PRIOR TO TRENCHING OPERATIONS TO DETERMINE IF MINOR MODIFICATIONS OR ADJUSTMENTS WILL BE REQUIRED.
- INSTALL ALL SPRINKLER HEADS PERPENDICULAR TO SLOPES OR GRADE.
- CONTROL WIRE SHALL BE UF-14, COLOR FOR LEAD AND WHITE FOR COMMON. SPLICES SHALL BE PERMITTED AT VALVE BOX LOCATIONS ONLY.
- PROVIDE AND INSTALL AUTOMATIC CONTROLLER AND UF-14 CONTROL WIRE. ELECTRICAL SUBCONTRACTOR SHALL PROVIDE 110V SERVICE AND SERVICE HOOKUP FROM POWER SOURCE TO AUTOMATIC CONTROLLER.
- COORDINATE ALL WORK WITH OTHER TRADES SO PROGRESS OF WORK IS NOT INTERRUPTED AND CAN BE COMPLETED IN A TIMELY MANNER.
- NO PLANTING SHALL BE STARTED UNTIL ALL SPRINKLER WORK HAS BEEN TESTED AND APPROVED IN PRESENCE OF OWNER'S REPRESENTATIVE.
- FOR SPRINKLER IRRIGATION INSTALLATION DETAILS, SEE SHEET NO. L4.2.

SEE CIVIL FOR EXTENT OF WALKWAY REPAIR. CONTRACTOR TO REPAIR LANDSCAPE AND IRRIGATION DAMAGED DURING CONSTRUCTION OF NEW WALKWAY. EXISTING TREES TO REMAIN, SEE SHEET L1.1 AND TREE PROTECTION SPECIFICATIONS. ALL LAWN DAMAGED DURING CONSTRUCTION SHALL BE REPLACED WITH SOD. IRRIGATION TO LAWN AND EXISTING TREES SHALL NOT BE PAUSED FOR MORE THAN 96 HOURS. CONTRACTOR RESPONSIBLE TO REPLACE ALL TURF IN EXISTING LAWN AREAS THAT ARE LEFT WITHOUT WATER FOR MORE THAN 96 HOURS. REPAIR SHALL BE WITH SOD.

~~CAP 3" MAINLINE FOR FUTURE EXTENSION AND PROVIDE 5 CONTROL WIRES AND 2 SPARE CONTROL WIRES~~

NOTE: ANY SITE OR BUILDING IMPROVEMENTS INDICATED OUTSIDE THE SHADED AREA IS NOT A PART OF THIS CONTRACT UNLESS NOTED OTHERWISE

NOTE: THE SHADED AREA REPRESENTS THE LIMITED SCOPE OF WORK AREA FOR THIS PROJECT. CONTRACTOR IS RESPONSIBLE FOR PROVIDING ALL DEMOLITION AND NEW SITE IMPROVEMENTS WITHIN THIS SHADED AREA UNLESS NOTED OTHERWISE. SEE ELECTRICAL, CIVIL AND ARCHITECTURAL DRAWINGS FOR ADDITIONAL INFORMATION AND ANY WORK SCOPE THAT MAY OCCUR OUTSIDE OF THIS IDENTIFIED WORK SCOPE AREA.

IRRIGATION VALVES AND PIPING SHOWN DIAGRAMMATICALLY. CONTRACTOR TO LOCATE WITHIN PLANTERS WHERE POSSIBLE.


THIS NOTE APPLIES TO THIS LIMITED SCOPE

DELETE LATERAL LINES

NOTE: REMOVE ALL IRRIGATION FROM THESE PLANTERS. AREAS TO BE CONCRETE PAVEMENT.


ADD LATERAL LINES FOR VALVE 9

KEY	SPRINKLER IRRIGATION LEGEND
	AUTOMATIC CONTROLLER: RAINBIRD: ESP-12LXMEF, 12-STATION CONTROLLER WITH FLOW SMART MODULE, IQ COMMUNICATION CARTRIDGE, AND LXMMPED STAINLESS STEEL CABINET AND PEDESTAL. COORDINATE 110V SERVICE AND POWER CONNECTION WITH ELECTRICAL SUB-CONTRACTOR. COORDINATE ETHERNET CONNECTION WITH THE ELECTRICAL SUB-CONTRACTOR.
	POINT OF CONNECTION: STATIC WATER PRESSURE PRIOR TO WATER METER: 55 PSI THIS IRRIGATION SYSTEM IS DESIGNED TO OPERATE AT 40 PSI MAXIMUM FLOW IS 33.6 GPM CONTRACTOR SHALL LOCATE EXISTING 2.5" BACKFLOW PREVENTION DEVICE INDICATED ON CIVIL SHEETS. CONNECT UPSTREAM AND EXTEND AS INDICATED ON DRAWINGS. DESIGN PRESSURE SHOWN ON PLANS IS BASED ON FLOW INFORMATION RECEIVED FROM THE DISTRICT ON 8/24/22. IF THERE IS A DISCREPANCY, NOTIFY OWNER'S REPRESENTATIVE IMMEDIATELY SO ADJUSTMENTS CAN BE MADE BY LANDSCAPE ARCHITECT. FAILURE TO REPORT DISCREPANCIES AND CONTINUANCE OF WORK WILL RESULT IN ALL RE-DESIGN COSTS BEING CHARGED TO CONTRACTOR.
	GATE VALVE: TYPE: NIBCO NO T-113 WITH A NON-RISING STEM AND HANDWHEEL. GATE VALVE INSTALLED IN A VALVE BOX WITH TOP OF BOX SET FLUSH TO FINISH GRADE. GATE VALVE TO BE LINE SIZE.
	MASTER VALVE ASSEMBLY: COMPONENTS: FLOW SENSOR • BADGER 200SS, 2.5" SIZE INSERT IN SADDLE. MASTER VALVE • 2.5" NORMALLY CLOSED GRISWOLD #2000M. TO BE CONNECTED TO AUTOMATIC CONTROLLER WITH UF-14 WIRE IN 1" CONDUIT.
	REDUCED PRESSURE BACKFLOW PREVENTION DEVICE: WILKINS MODEL NO. 975XL 1" SIZE. PROVIDE CONCRETE SLAB AND ENCLOSURE. PIPE STAND, AND ALL INCIDENTAL WORK. COORDINATE EXACT LOCATION IN FIELD.
	EXISTING MAIN LINE TO REMAIN:
	PRESSURE MAIN LINE: TYPE: ASTM D1785, PVC SCHEDULE 40. TRENCH DEPTH: IN PLANTED AREAS: 24" MINIMUM COVER. UNDER PAVED AREAS: 24" MINIMUM COVER. PVC SCHEDULE 40 SLEEVES ARE REQUIRED FOR ALL PIPING UNDER PAVEMENT.
	LATERAL LINE: TYPE: ASTM D1785, PVC SCHEDULE 40, SOLVENT WELD ALL UNSIZED PIPE SHALL BE 3/4" SIZE. TRENCH DEPTH: IN PLANTED AREAS: POP-UP SPRAY HEADS - 12" MINIMUM COVER. BUBBLER HEADS: - 12" MINIMUM COVER. UNDER PAVED AREAS: 24" MINIMUM COVER. PVC SCHEDULE 40 SLEEVES ARE REQUIRED FOR ALL PIPING UNDER PAVEMENT.
	QUICK COUPLER VALVE: RAINBIRD 44NP OR APPROVED EQUAL. VALVES SHALL HAVE LOCKING RUBBER COVERS. INSTALLED IN VALVE BOXES. TOP OF VALVE BOX SHALL HAVE BOLT DOWN LID AND TOP SET LEVEL TO FINISH GRADE.
	AUTOMATIC CONTROL VALVE: RAINBIRD PEB-PRS-D SERIES VALVE SHALL HAVE PRESSURE REGULATION OPTION FOR FLOW RANGES OF 6 GPM AND ABOVE.
	SHRUB POP-UP SPRAY HEADS: RAINBIRD: RD-06-S-P-45 SERIES BODY WITH RAINBIRD HE-VAN 10 SERIES NOZZLES. HALF AND QUARTER SPRAY PATTERNS.
	SHRUB POP-UP SPRAY HEADS: RAINBIRD: RD-06-S-P-45 SERIES BODY WITH RAINBIRD HE-VAN 12 SERIES NOZZLES. HALF AND QUARTER SPRAY PATTERNS.
	TREE BUBBLER HEADS (TWO PER SYMBOL): RAINBIRD: RWS-M-B-C-1401 WITH INLINE CHECK VALVE
	AUTOMATIC DRIP IRRIGATION VALVE/FILTER/PRESSURE REGULATOR: RAINBIRD CONTROL ZONE KIT MODEL XCZ-100-PRB-COM
	DRIP IRRIGATION: EMITTER TO BE RAINBIRD XBT-20-6 (2 GPH) WITH PC DIFFUSER CAP AND IPS FLEXIBLE PVC TUBING. IPS TUBING TO BE BURIED A MINIMUM DEPTH OF 3" BELOW GRADE. EXTENSION TO EACH BUBBLER NOT SHOWN. SEE DETAIL L4.2-6 FOR INSTALLATION. PVC SCHEDULE 40 LATERAL LINES SHOWN ON PLAN. UNSIZED PIPE TO BE 3/4" SIZE. PVC SCHEDULE 40 SLEEVES ARE REQUIRED FOR ALL PIPING UNDER PAVEMENT. LIMITS OF SHRUB BUBBLER PLACEMENT PVC SCH 40 LATERAL LINE
	INDICATES CONTROL VALVE AND STATION NUMBER
	INDICATES CONTROL VALVE SIZE
	INDICATES GALLONS PER MINUTE
	EXISTING IRRIGATION REPAIR AREA:

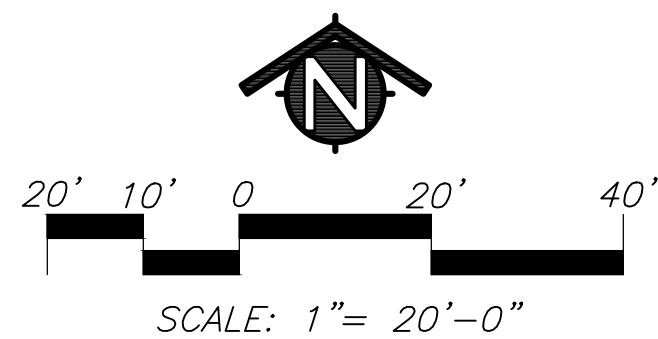

IDENTIFICATION STAMP
DIV. OF THE STATE ARCHITECT
APP: 02-120455 INC:
REVIEWED FOR
SS ☒ FLS ☒ ACS ☒
DATE: 01/12/2023


730 Howe Avenue, Suite 450
Sacramento, CA 95825
Phone: 916.921.2112
Fax: 916.921.2212

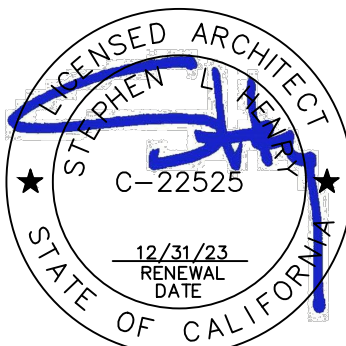

MODERNIZATION LAKEWOOD
ELEMENTARY SCHOOL

LANDSCAPE
IRRIGATION PLAN


CONSULTANT

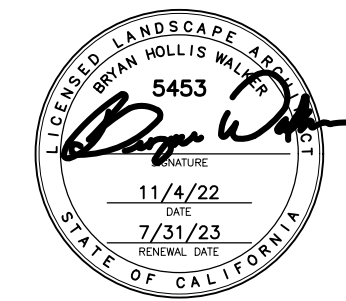

Bryan Hollis Walker C-5453

PROJECT NO.	REVISIONS	BY
21-32-052		
DATE		
3/28/2022		
DRAWN		
MS		
CHECKED		
JCBS		
SCALE		
CADFILE		
UPDATED		
11/17/2022		
SHEET NO.		

L3.1

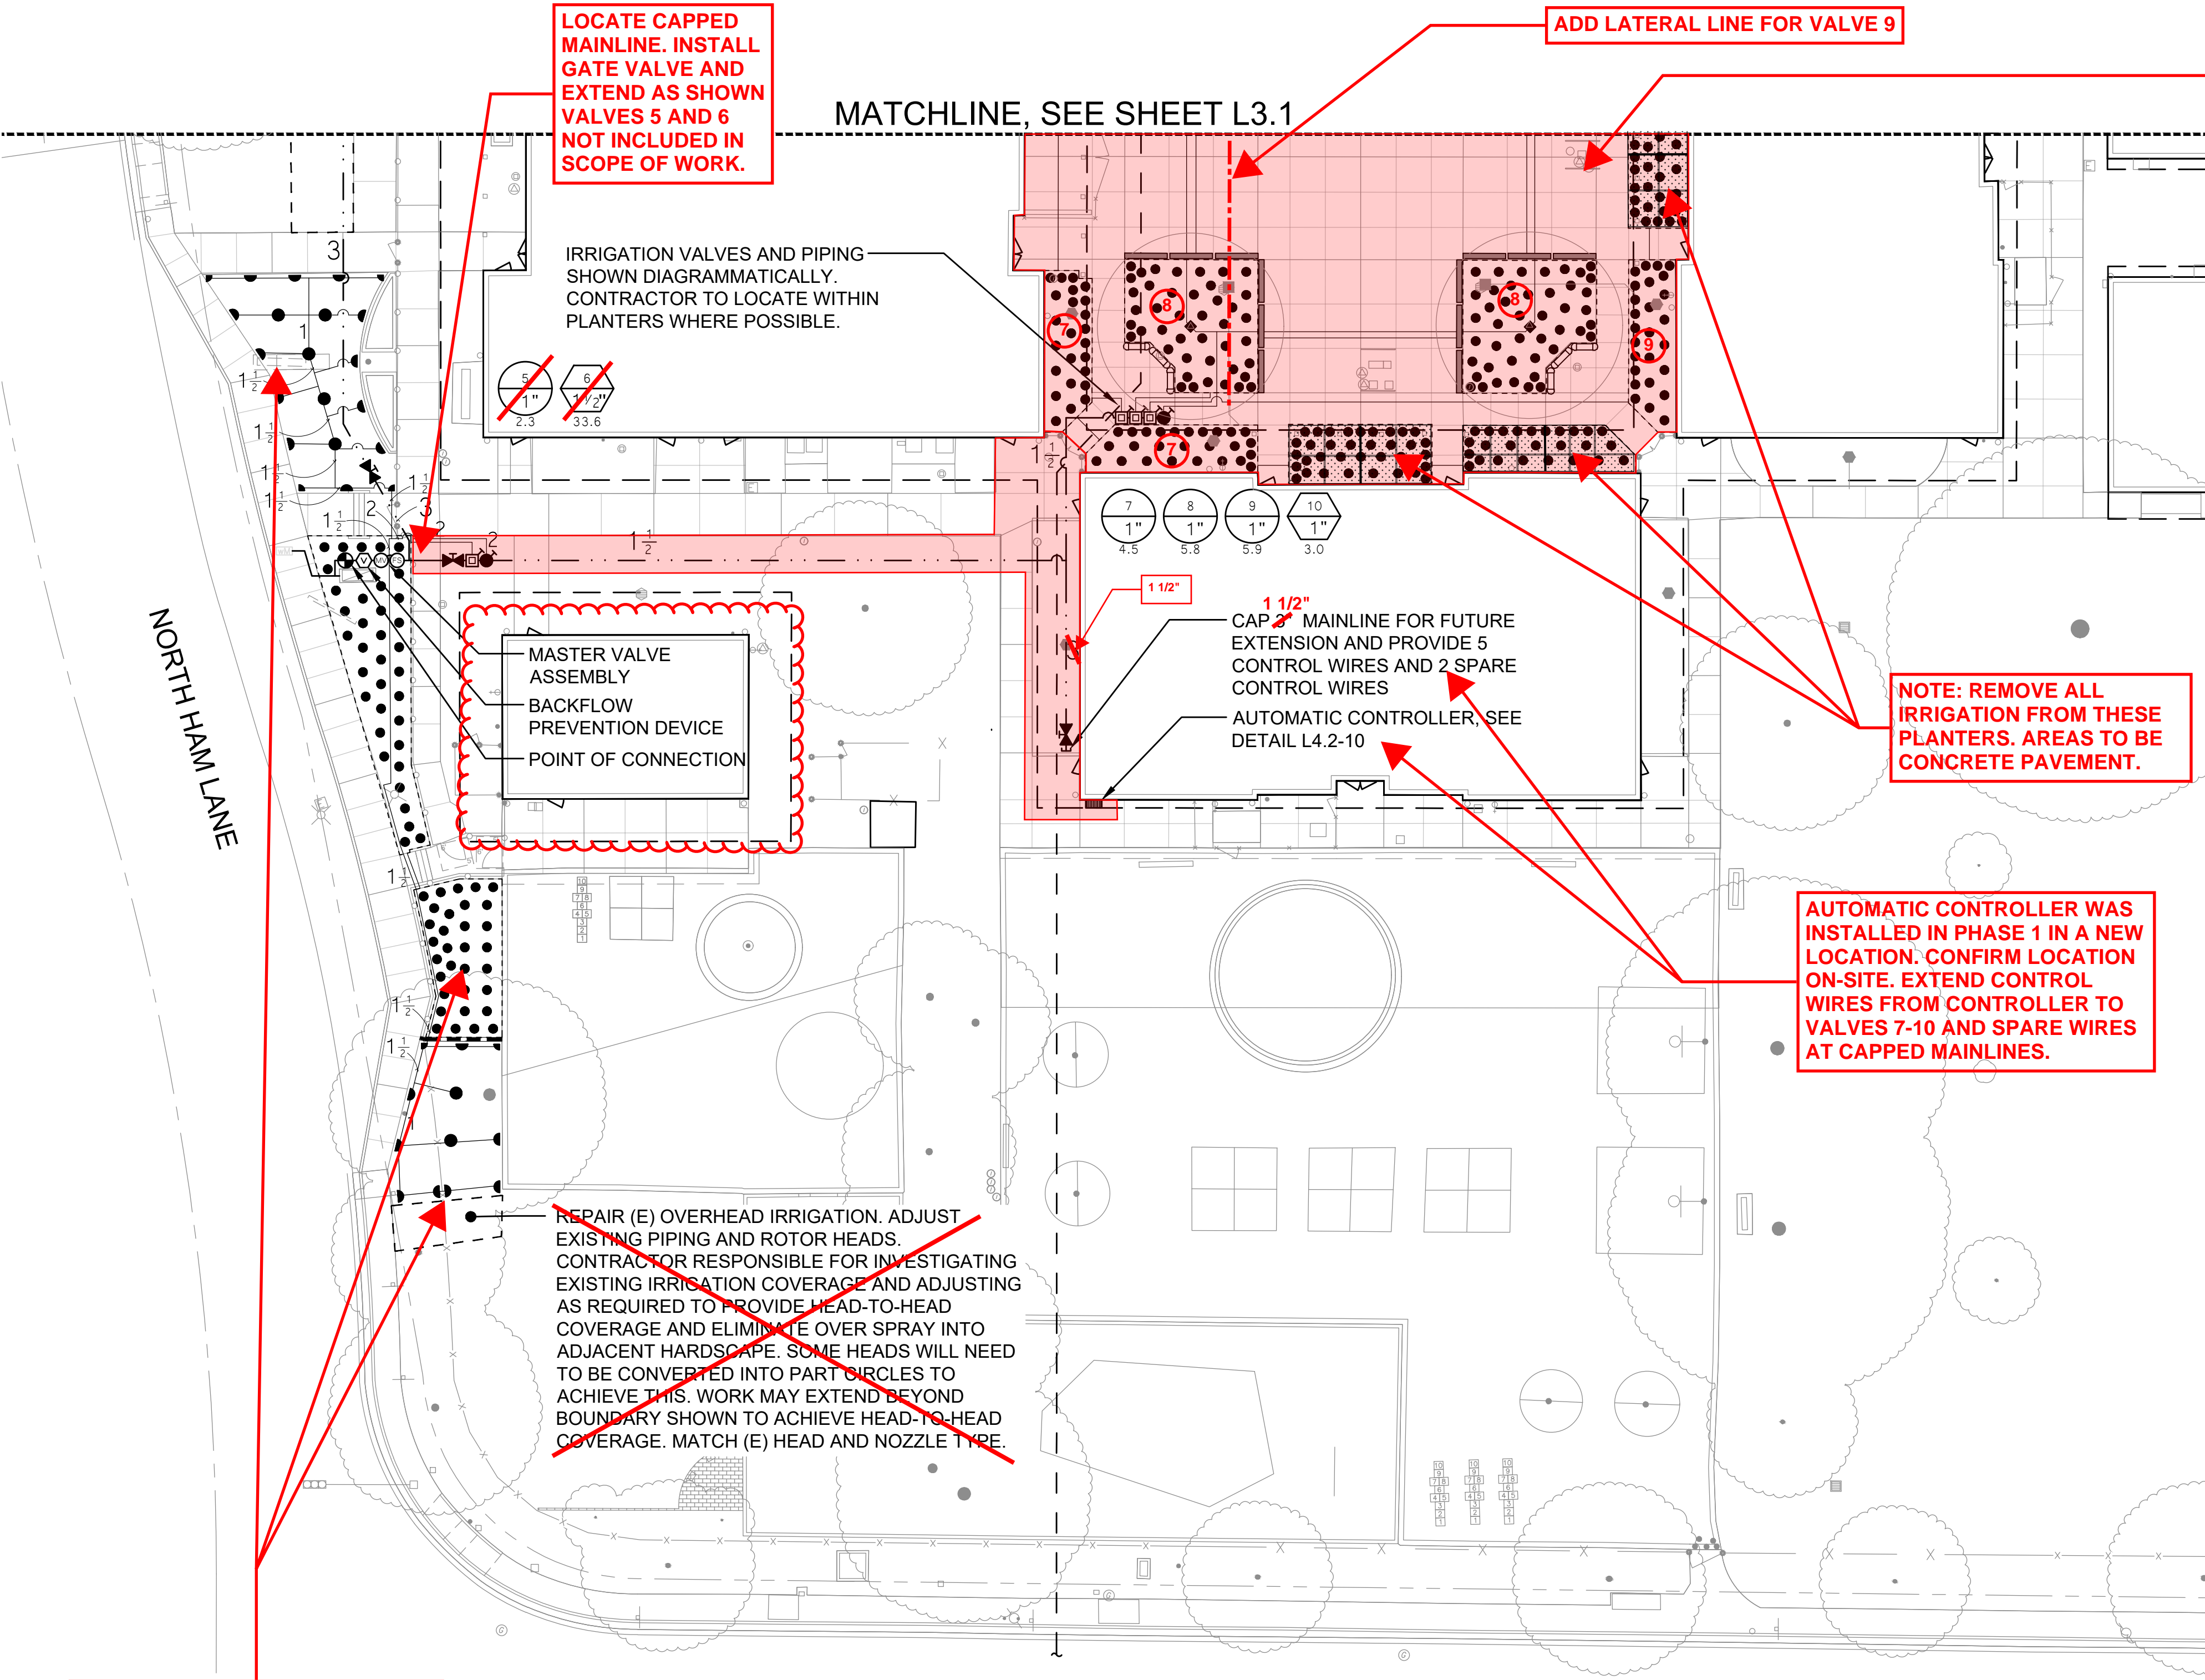

LOCATE CAPPED MAINLINE. INSTALL GATE VALVE AND EXTEND AS SHOWN VALVES 5 AND 6 NOT INCLUDED IN SCOPE OF WORK.

ADD LATERAL LINE FOR VALVE 9

MATCHLINE, SEE SHEET L3.1

IRRIGATION VALVES AND PIPING SHOWN DIAGRAMMATICALLY. CONTRACTOR TO LOCATE WITHIN PLANTERS WHERE POSSIBLE.

MASTER VALVE ASSEMBLY
BACKFLOW PREVENTION DEVICE
POINT OF CONNECTION

1 1/2" CAP 2" MAINLINE FOR FUTURE EXTENSION AND PROVIDE 5 CONTROL WIRES AND 2 SPARE CONTROL WIRES
AUTOMATIC CONTROLLER, SEE DETAIL L4.2-10

NOTE: REMOVE ALL IRRIGATION FROM THESE PLANTERS. AREAS TO BE CONCRETE PAVEMENT.

AUTOMATIC CONTROLLER WAS INSTALLED IN PHASE 1 IN A NEW LOCATION. CONFIRM LOCATION ON-SITE. EXTEND CONTROL WIRES FROM CONTROLLER TO VALVES 7-10 AND SPARE WIRES AT CAPPED MAINLINES.

REPAIR (E) OVERHEAD IRRIGATION. ADJUST EXISTING PIPING AND ROTOR HEADS. CONTRACTOR RESPONSIBLE FOR INVESTIGATING EXISTING IRRIGATION COVERAGE AND ADJUSTING AS REQUIRED TO PROVIDE HEAD-TO-HEAD COVERAGE AND ELIMINATE OVER SPRAY INTO ADJACENT HARDSCAPE. SOME HEADS WILL NEED TO BE CONVERTED INTO PART CIRCLES TO ACHIEVE THIS. WORK MAY EXTEND BEYOND BOUNDARY SHOWN TO ACHIEVE HEAD-TO-HEAD COVERAGE. MATCH (E) HEAD AND NOZZLE TYPE.


NOTE: ANY SITE OR BUILDING IMPROVEMENTS INDICATED OUTSIDE THE SHADED AREA IS NOT A PART OF THIS CONTRACT UNLESS NOTED OTHERWISE

NOTE: THE SHADED AREA REPRESENTS THE LIMITED SCOPE OF WORK AREA FOR THIS PROJECT. CONTRACTOR IS RESPONSIBLE FOR PROVIDING ALL DEMOLITION AND NEW SITE IMPROVEMENTS WITHIN THIS SHADED AREA UNLESS NOTED OTHERWISE. SEE ELECTRICAL, CIVIL AND ARCHITECTURAL DRAWINGS FOR ADDITIONAL INFORMATION AND ANY WORK SCOPE THAT MAY OCCUR OUTSIDE OF THIS IDENTIFIED WORK SCOPE AREA.


KEY	SPRINKLER IRRIGATION LEGEND
	AUTOMATIC CONTROLLER: RAINBIRD: ESP-12LXMEF, 12-STATION CONTROLLER WITH FLOW SMART MODULE, IQ COMMUNICATION CARTRIDGE, AND LXMPED STAINLESS STEEL CABINET AND PEDESTAL. COORDINATE 110V SERVICE AND POWER CONNECTION WITH ELECTRICAL SUB-CONTRACTOR. COORDINATE ETHERNET CONNECTION WITH THE ELECTRICAL SUB-CONTRACTOR.
	POINT OF CONNECTION: STATIC WATER PRESSURE PRIOR TO WATER METER: 55 PSI THIS IRRIGATION SYSTEM IS DESIGNED TO OPERATE AT 40 PSI MAXIMUM FLOW IS 33.6 GPM CONTRACTOR SHALL LOCATE EXISTING 2.5" BACKFLOW PREVENTION DEVICE INDICATED ON CIVIL SHEETS. CONNECT UPSTREAM AND EXTEND AS INDICATED ON DRAWINGS. DESIGN PRESSURE SHOWN ON PLANS IS BASED ON FLOW INFORMATION RECEIVED FROM THE DISTRICT ON 8/24/22. IF THERE IS A DISCREPANCY, NOTIFY OWNER'S REPRESENTATIVE IMMEDIATELY SO ADJUSTMENTS CAN BE MADE BY LANDSCAPE ARCHITECT. FAILURE TO REPORT DISCREPANCIES AND CONTINUANCE OF WORK WILL RESULT IN ALL RE-DESIGN COSTS BEING CHARGED TO CONTRACTOR.
	GATE VALVE: TYPE: NIBCO NO T-113 WITH A NON-RISING STEM AND HANDWHEEL. GATE VALVE INSTALLED IN A VALVE BOX WITH TOP OF BOX SET FLUSH TO FINISH GRADE. GATE VALVE TO BE LINE SIZE.
	MASTER VALVE ASSEMBLY: COMPONENTS: FLOW SENSOR = BADGER 200SS, 2.5" SIZE INSERT IN SADDLE. MASTER VALVE = 2.5" NORMALLY CLOSED GRISWOLD #2000M. TO BE CONNECTED TO AUTOMATIC CONTROLLER WITH UF-14 WIRE IN 1" CONDUIT.
	REDUCED PRESSURE BACKFLOW PREVENTION DEVICE: WILKINS MODEL NO. 975XL 1" SIZE. PROVIDE CONCRETE SLAB AND ENCLOSURE, PIPE STAND, AND ALL INCIDENTAL WORK. COORDINATE EXACT LOCATION IN FIELD.
	EXISTING MAIN LINE TO REMAIN:
	PRESSURE MAIN LINE: TYPE: ASTM D1785, PVC SCHEDULE 40. TRENCH DEPTH: IN PLANTED AREAS: 24" MINIMUM COVER. UNDER PAVED AREAS: 24" MINIMUM COVER. PVC SCHEDULE 40 SLEEVES ARE REQUIRED FOR ALL PIPING UNDER PAVEMENT.
	LATERAL LINE: TYPE: ASTM D1785, PVC SCHEDULE 40, SOLVENT WELD ALL UNSIZED PIPE SHALL BE 3/4" SIZE. TRENCH DEPTH: IN PLANTED AREAS: POP-UP SPRAY HEADS - 12" MINIMUM COVER. BUBBLER HEADS: - 12" MINIMUM COVER. UNDER PAVED AREAS: 24" MINIMUM COVER. PVC SCHEDULE 40 SLEEVES ARE REQUIRED FOR ALL PIPING UNDER PAVEMENT.
	QUICK COUPLER VALVE: RAINBIRD 44NP OR APPROVED EQUAL. VALVES SHALL HAVE LOCKING RUBBER COVERS. INSTALLED IN VALVE BOXES. TOP OF VALVE BOX SHALL HAVE BOLT DOWN LID AND TOP SET LEVEL TO FINISH GRADE.
	AUTOMATIC CONTROL VALVE: RAINBIRD PEB-PRS-D SERIES VALVE SHALL HAVE PRESSURE REGULATION OPTION FOR FLOW RANGES OF 6 GPM AND ABOVE.
	SHRUB POP UP SPRAY HEADS: RAINBIRD: RD-06-S-P-45 SERIES BODY WITH RAINBIRD HE-VAN 10 SERIES NOZZLES. HALF AND QUARTER SPRAY PATTERNS.
	SHRUB POP UP SPRAY HEADS: RAINBIRD: RD-06-S-P-45 SERIES BODY WITH RAINBIRD HE-VAN 12 SERIES NOZZLES. HALF AND QUARTER SPRAY PATTERNS.
	TREE BUBBLER HEADS (TWO PER SYMBOL): RAINBIRD: RWS-M-B-C-1401 WITH INLINE CHECK VALVE
	AUTOMATIC DRIP IRRIGATION VALVE/FILTER/PRESSURE REGULATOR: RAINBIRD CONTROL ZONE KIT MODEL XCZ-100-PRB-COM
	DRIP IRRIGATION: EMITTER TO BE RAINBIRD XBT-20-6 (2 GPH) WITH PC DIFFUSER CAP AND IPS FLEXIBLE PVC TUBING. IPS TUBING TO BE BURIED A MINIMUM DEPTH OF 3" BELOW GRADE. EXTENSION TO EACH BUBBLER NOT SHOWN. SEE DETAIL L4.2-6 FOR INSTALLATION. PVC SCHEDULE 40 LATERAL LINES SHOWN ON PLAN. UNSIZED PIPE TO BE 3/4" SIZE. PVC SCHEDULE 40 SLEEVES ARE REQUIRED FOR ALL PIPING UNDER PAVEMENT. LIMITS OF SHRUB BUBBLER PLACEMENT PVC SCH 40 LATERAL LINE
	INDICATES CONTROL VALVE AND STATION NUMBER
	INDICATES CONTROL VALVE SIZE
	INDICATES GALLONS PER MINUTE
	EXISTING IRRIGATION REPAIR AREA:

SPRINKLER IRRIGATION NOTES

- COMPOSITE BASE SHEET: PROPOSED IMPROVEMENTS SHOWN ON DRAWINGS ARE SUPERIMPOSED ON A COMPOSITE BASE SHEET. THE COMPOSITE BASE SHEET IS A COMPILATION OF ARCHITECTURAL, ENGINEERING, AND OTHER DATA THAT IS PROVIDED. THE LANDSCAPE ARCHITECT SHALL NOT BE HELD LIABLE FOR CHANGES, INACCURACIES, OMISSIONS, OR ERRORS PERTAINING TO THE COMPOSITE BASE SHEET. CONTRACTOR SHALL BE RESPONSIBLE FOR REVIEWING THESE DOCUMENTS. ANY DISCREPANCIES NEED TO BE BROUGHT TO THE ATTENTION OF THE DESIGN TEAM AND RESOLVED PRIOR TO CONTINUATION OF WORK.
- DESIGN PRESSURE SHOWN ON PLANS HAS BEEN FURNISHED BY WATER COMPANY OR WATER DISTRICT SERVING SITE. VERIFY PRESSURE ON-SITE PRIOR TO THE INSTALLATION OF ANY SPRINKLER IRRIGATION EQUIPMENT. IF THERE IS A DISCREPANCY, NOTIFY OWNER'S REPRESENTATIVE IMMEDIATELY IN WRITING SO ADJUSTMENTS CAN BE MADE BY LANDSCAPE ARCHITECT. FAILURE TO REPORT DISCREPANCIES AND CONTINUANCE OF WORK WILL RESULT IN ALL RE-DESIGN COSTS BEING CHARGED TO CONTRACTOR.
- DETERMINE LOCATION OF UNDERGROUND UTILITIES. DAMAGE CAUSED BY INSTALLATION OF THIS WORK SHALL BE REPAIRED TO SATISFACTION OF GOVERNING AGENCY OR OWNER AT NO ADDITIONAL COST TO THE CONTRACT.
- SPRINKLER OVER SPRAY SHALL NOT BE ALLOWED ON PUBLIC SIDEWALKS, BUILDING WALLS OR FENCES. MINIMUM OVERSPRAY MAY OCCUR IN PARKING AREAS. USE ADJUSTABLE NOZZLES WHENEVER POSSIBLE TO CONTROL SPRINKLER OVERSPRAY.
- ALL LOCAL CODES AND ORDINANCES SHALL BE COMPLIED WITH. IF THERE IS A CONFLICT, NOTIFY OWNER'S REPRESENTATIVE IMMEDIATELY.
- TESTING:
 - PRESSURE TEST ALL UNDERGROUND PIPING AS FOLLOWS:
SYSTEMS WITH BOOSTER PUMP:
MAIN LINE - AT 100 PSI FOR 4 HOURS.
LATERAL LINES - AT 100 PSI FOR 2 HOURS.
SYSTEMS WITH OUT BOOSTER PUMP:
MAIN LINE - AT STATIC PSI FOR 4 HOURS.
LATERAL LINES - AT STATIC PSI FOR 2 HOURS.
 - COVERAGE TEST: NOTE: PRIOR TO REQUESTING COVERAGE TEST, INSURE ALL HEADS ARE SET PLUMB, NOZZLES ARE ADJUSTED PROPERLY AND SYSTEM HAS BEEN CHECKED FOR AUTOMATION. REQUEST OWNER'S REPRESENTATIVES PRESENCE ON-SITE WHEN SPRINKLER SYSTEM IS COMPLETELY INSTALLED AND FULLY AUTOMATIC. PROVIDE ADEQUATE PERSONNEL AT THIS MEETING TO ADJUST AND FINE TUNE SYSTEM TO SATISFACTION OF OWNER'S REPRESENTATIVE.
- LAYOUT ALL WORK PRIOR TO TRENCHING OPERATIONS TO DETERMINE IF MINOR MODIFICATIONS OR ADJUSTMENTS WILL BE REQUIRED.
- INSTALL ALL SPRINKLER HEADS PERPENDICULAR TO SLOPES OR GRADE.
- CONTROL WIRE SHALL BE UF-14, COLOR FOR LEAD AND WHITE FOR COMMON. SPLICES SHALL BE PERMITTED AT VALVE BOX LOCATIONS ONLY.
- PROVIDE AND INSTALL AUTOMATIC CONTROLLER AND UF-14 CONTROL WIRE. ELECTRICAL SUBCONTRACTOR SHALL PROVIDE 110V SERVICE AND SERVICE HOOKUP FROM POWER SOURCE TO AUTOMATIC CONTROLLER.
- COORDINATE ALL WORK WITH OTHER TRADES SO PROGRESS OF WORK IS NOT INTERRUPTED AND CAN BE COMPLETED IN A TIMELY MANNER.
- NO PLANTING SHALL BE STARTED UNTIL ALL SPRINKLER WORK HAS BEEN TESTED AND APPROVED IN PRESENCE OF OWNER'S REPRESENTATIVE.
- FOR SPRINKLER IRRIGATION INSTALLATION DETAILS, SEE SHEET NO. L4.2.

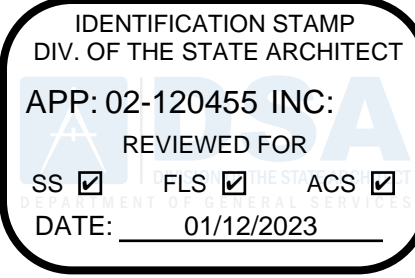


730 Howe Avenue, Suite 450
Sacramento, CA 95825
Phone: 916.921.2112
Fax: 916.921.2212

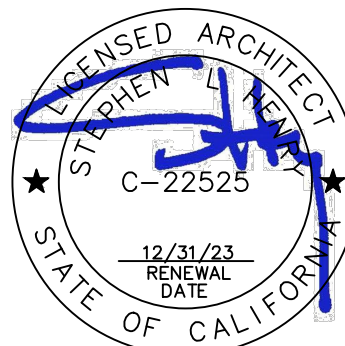

MODERNIZATION LAKEWOOD
ELEMENTARY SCHOOL

LANDSCAPE
IRRIGATION PLAN


CONSULTANT

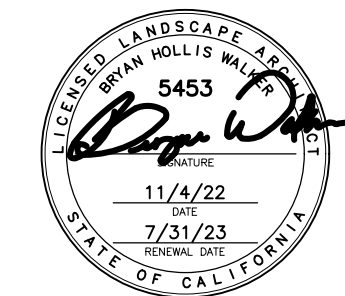


Bryan Hollis Walker C-5453

PROJECT NO.	REVISIONS	BY
21-32-052		
DATE		
3/28/2022		
DRAWN		
MS		
CHECKED		
JCBS		
SCALE		
CADFILE		
UPDATED		
11/17/2022		
SHEET NO.		


L3.2

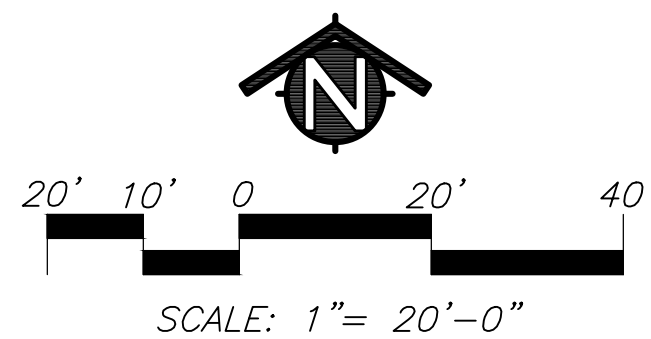

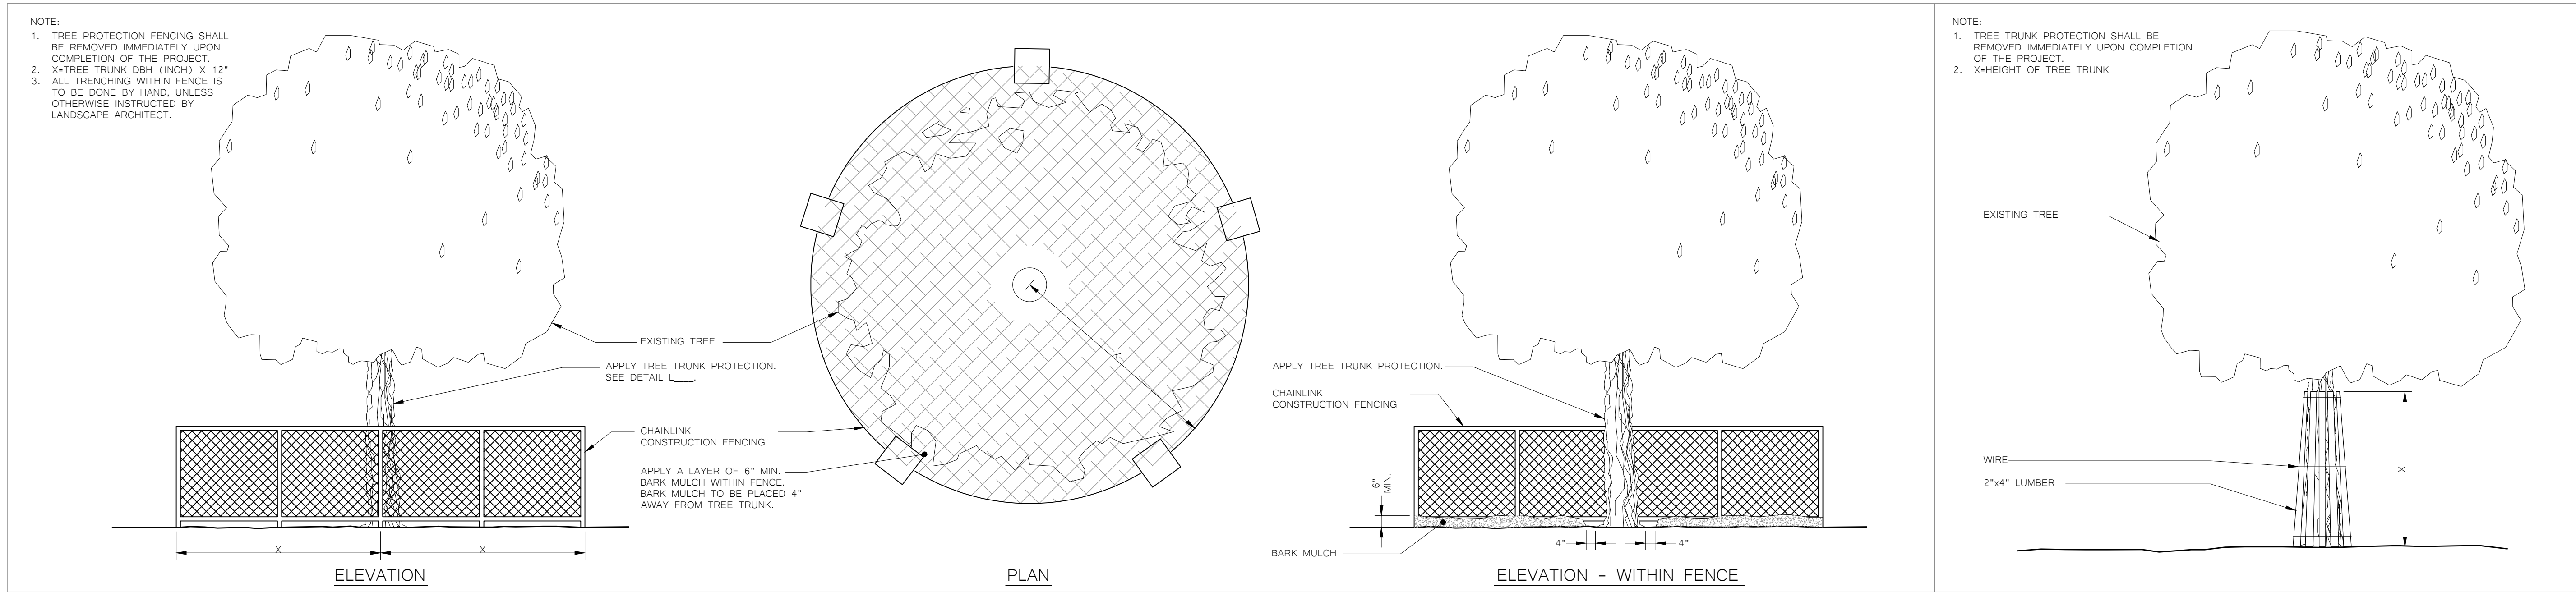

1 TREE PROTECTION FENCING DETAIL


2 TREE TRUNK PROTECTION DETAIL

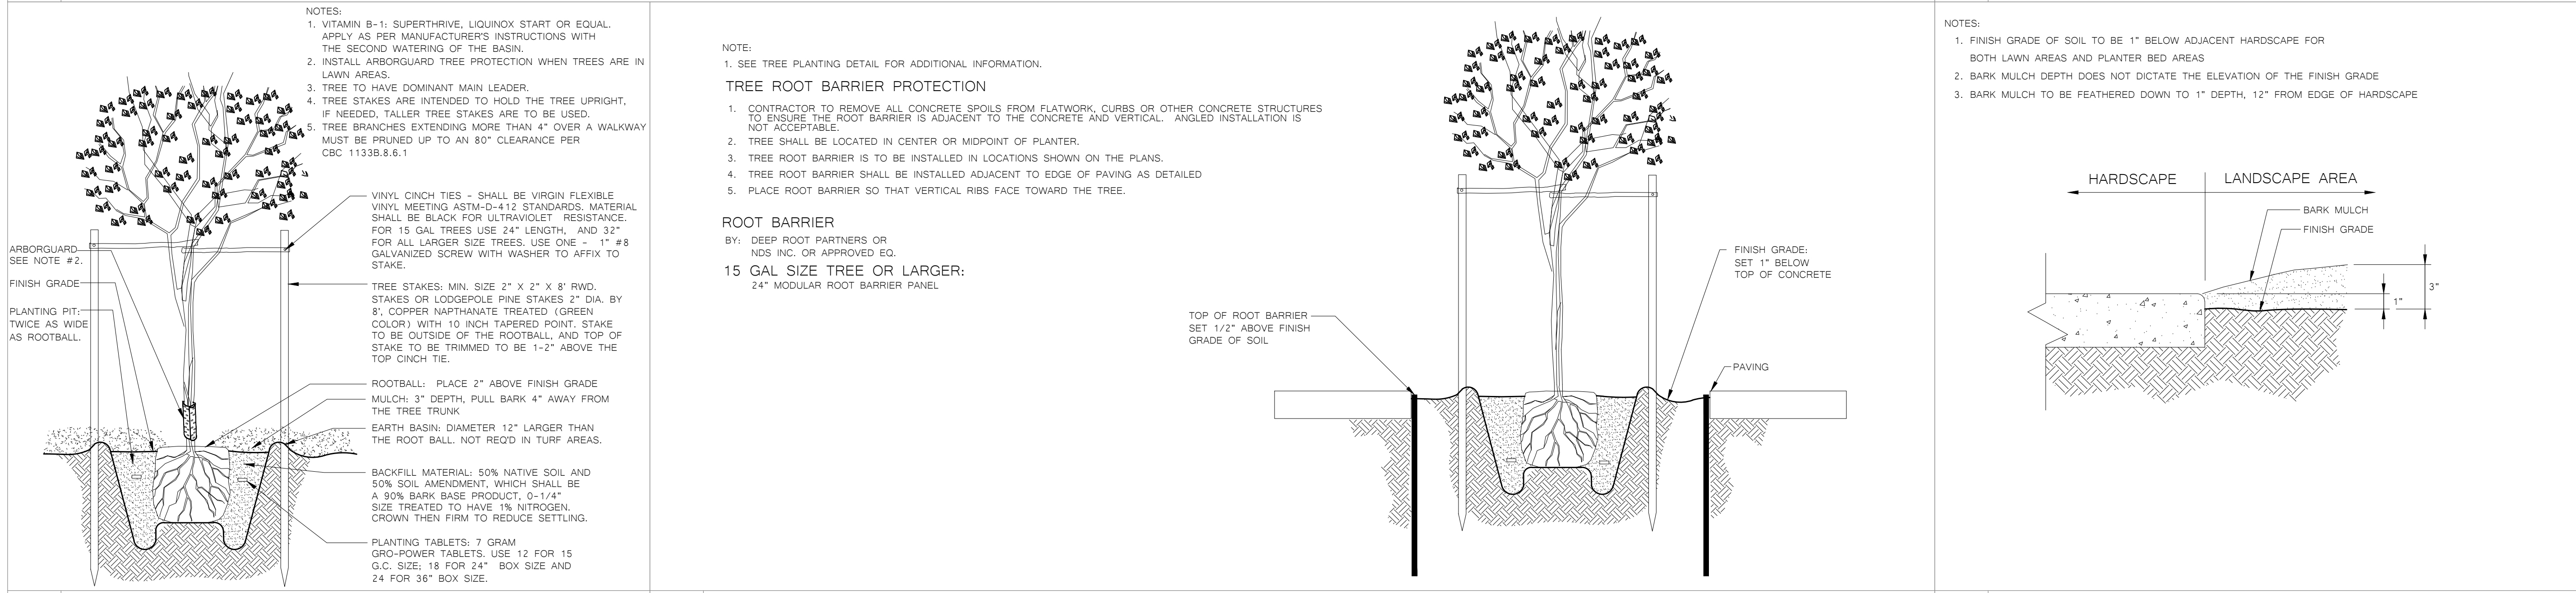

3 TREE PLANTING AND STAKING DETAIL

4 ROOT BARRIER CONTROL DETAIL

5 LANDSCAPE GRADE ADJACENT TO HARDSCAPE DETAIL

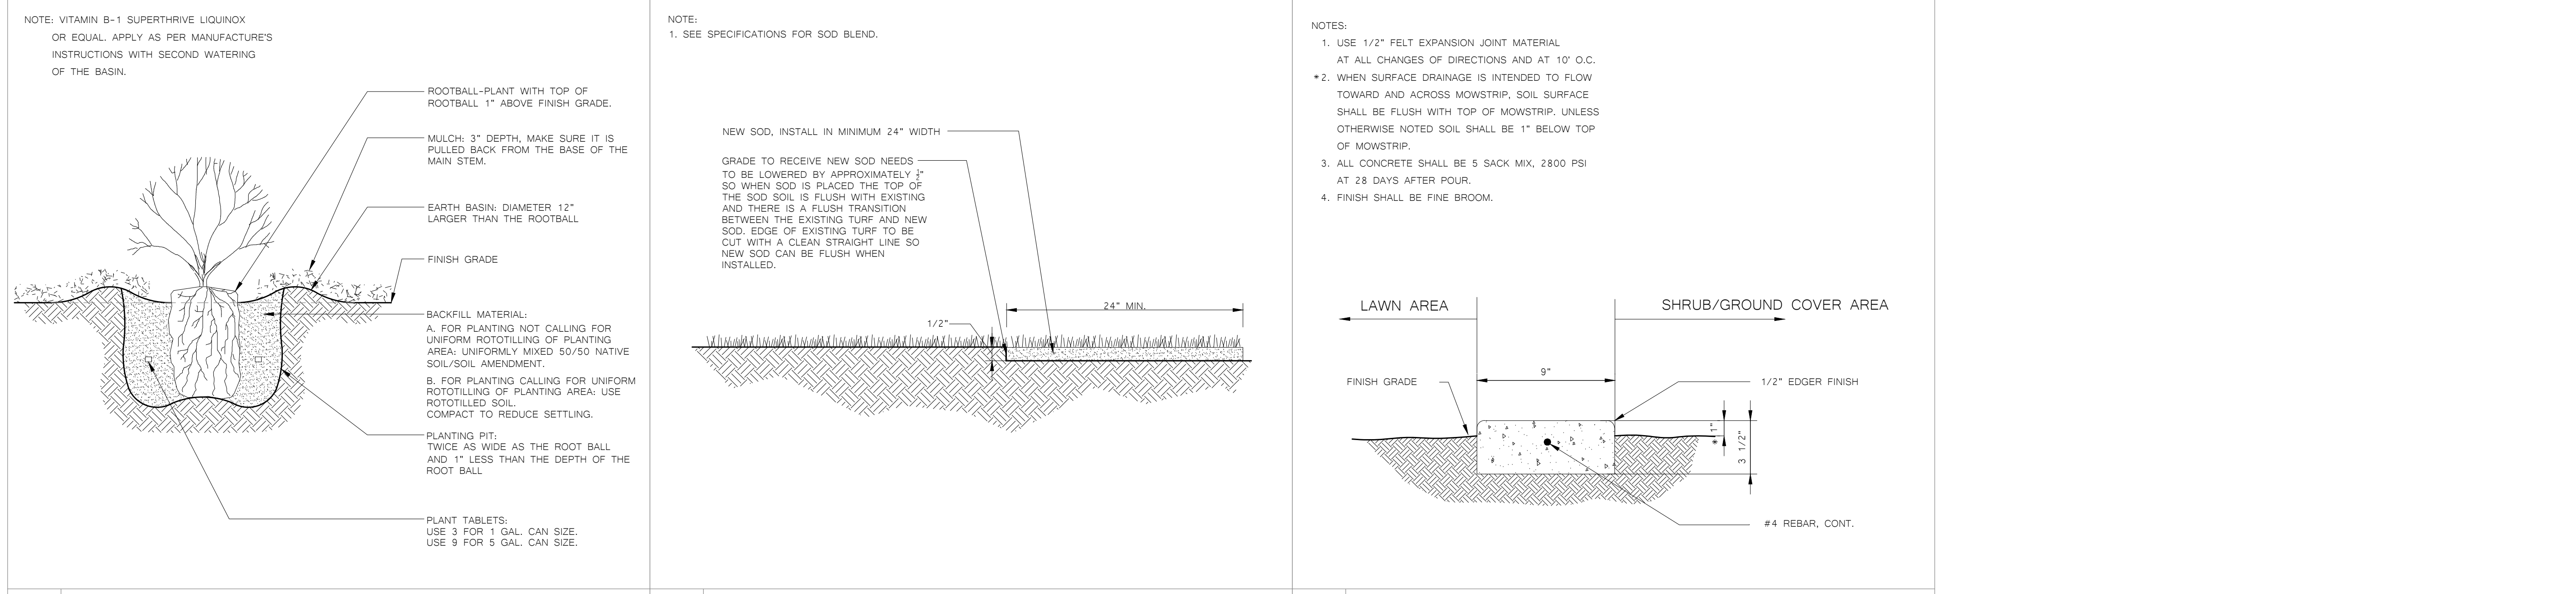

6 SHRUB PLANTING DETAIL

7 TURF REPAIR WITH SOD DETAIL

8 CONCRETE MOWSTRIP DETAIL

IDENTIFICATION STAMP
DIV. OF THE STATE ARCHITECT
APP: 02-120455 INC:
REVIEWED FOR
SS ☒ FLS ☒ ACS ☒
DATE: 01/12/2023

730 Howe Avenue, Suite 450
Sacramento, CA 95825
Phone: 916.921.2112
Fax: 916.921.2212

HENRY+ASSOCIATES
ARCHITECTS

STEPHEN WALKER
C-22525
12/31/23
RENEWAL DATE
STATE OF CALIFORNIA













MODERNIZATION LAKEWOOD
ELEMENTARY SCHOOL
LANDSCAPE
PLANTING DETAILS




CONSULTANT

Bryan Hollis Walker
C-5453
11/4/22
RENEWAL DATE
STATE OF CALIFORNIA

PROJECT NO.	REVISIONS	BY
21-32-052		
DATE		
3/28/2022		
DRAWN		
MS		
CHECKED		
JCBS		
SCALE		
CADFILE		
UPDATED		
11/17/2022		
SHEET NO.		

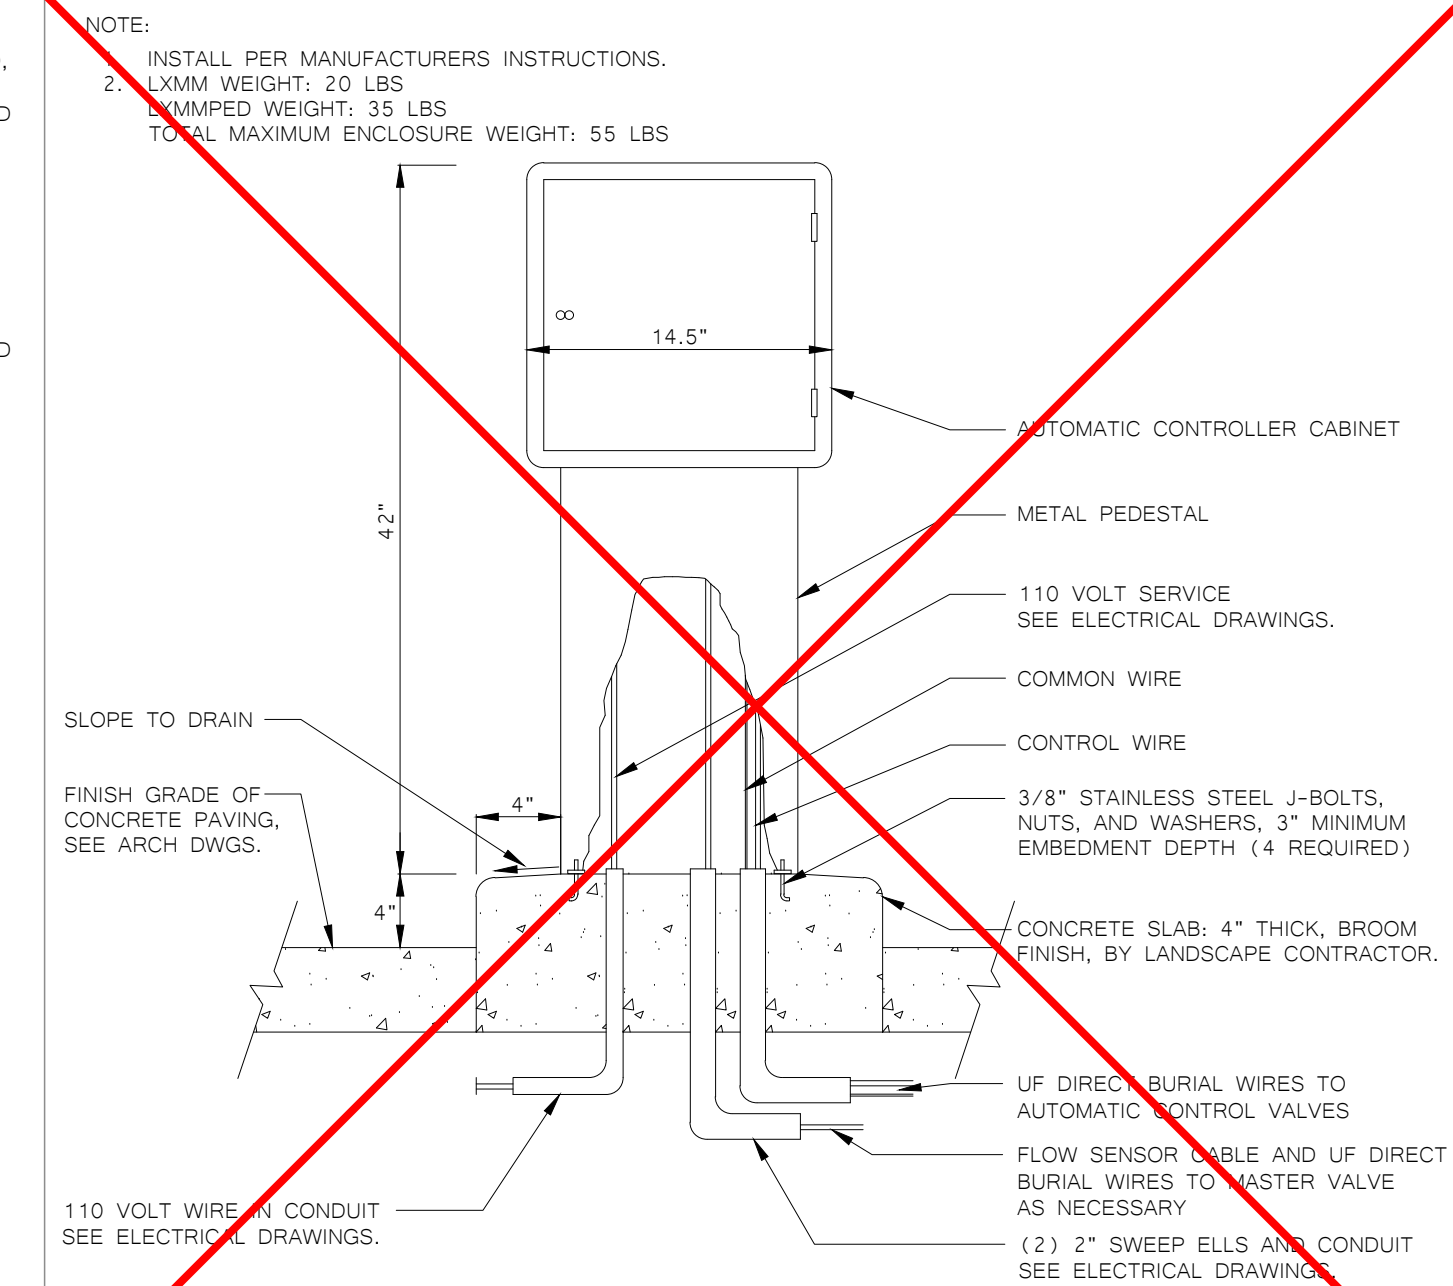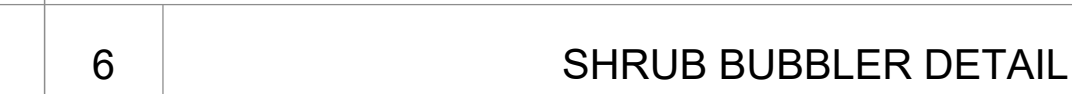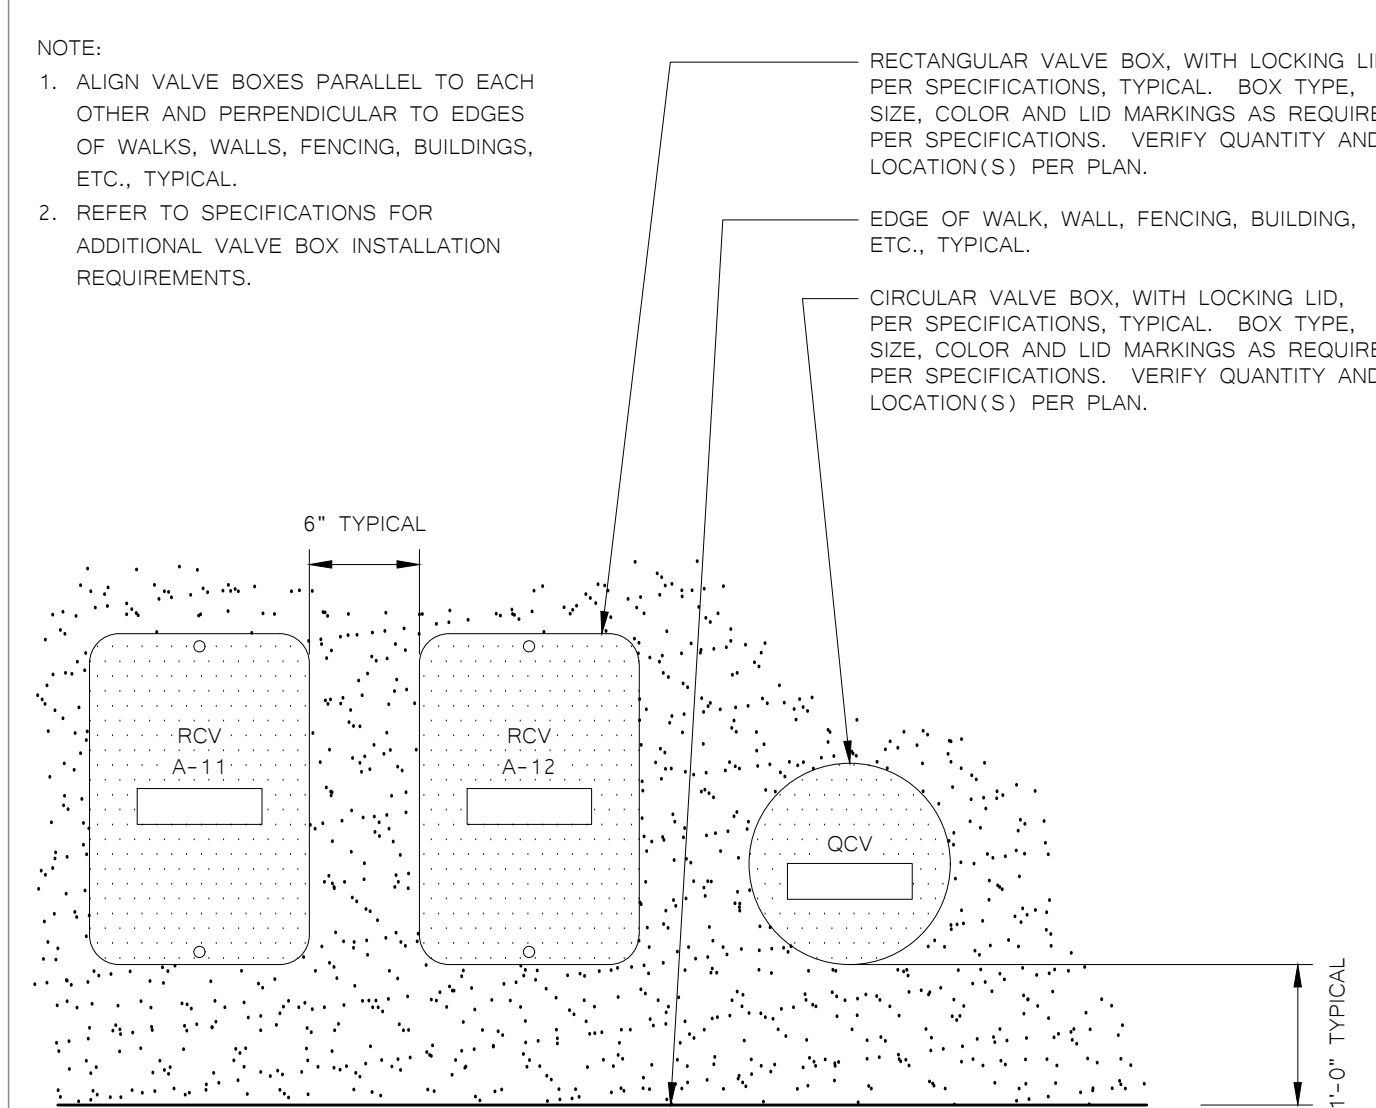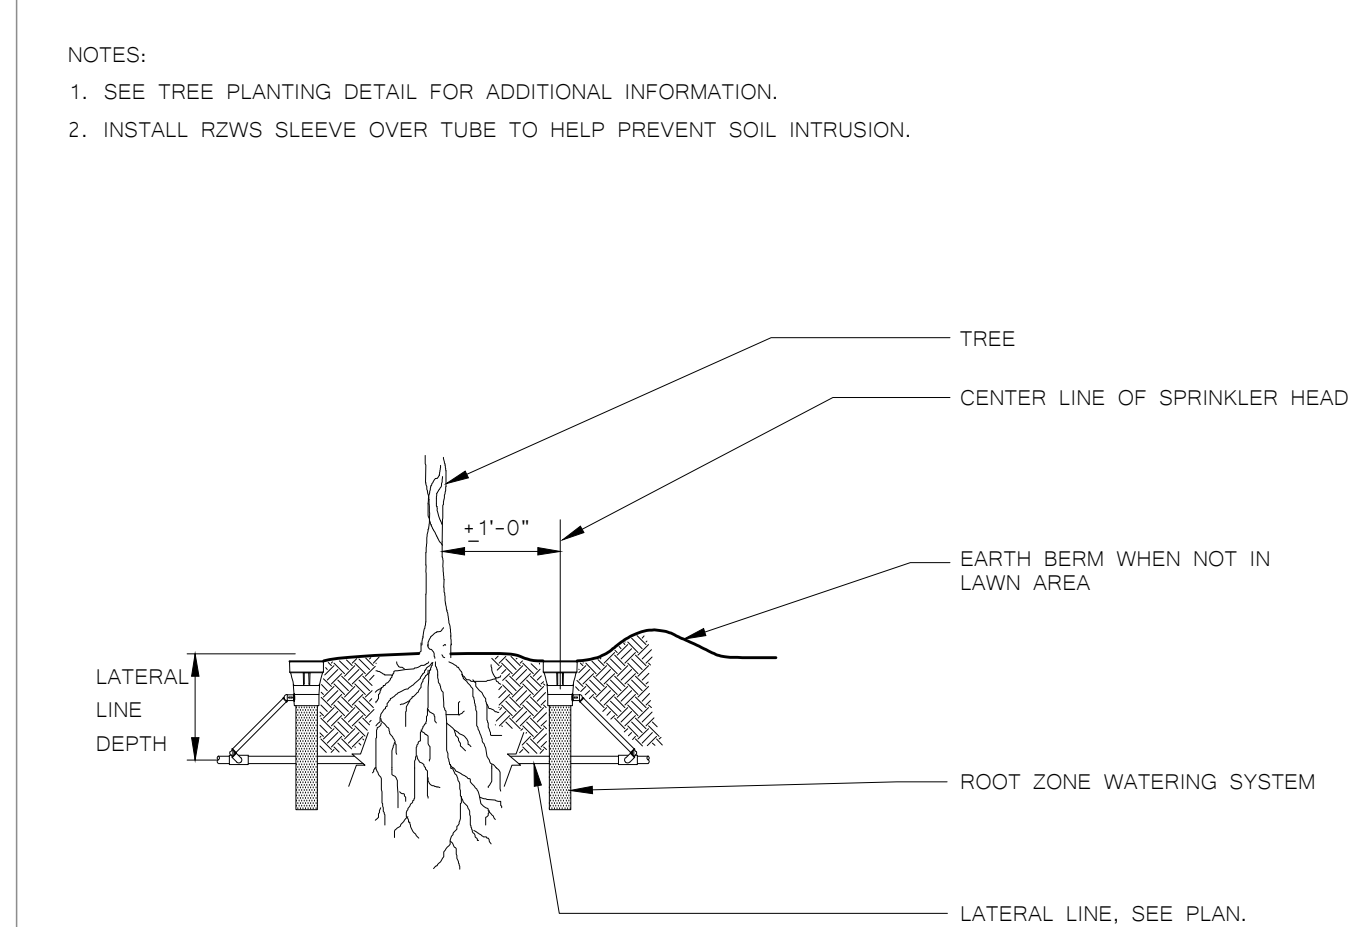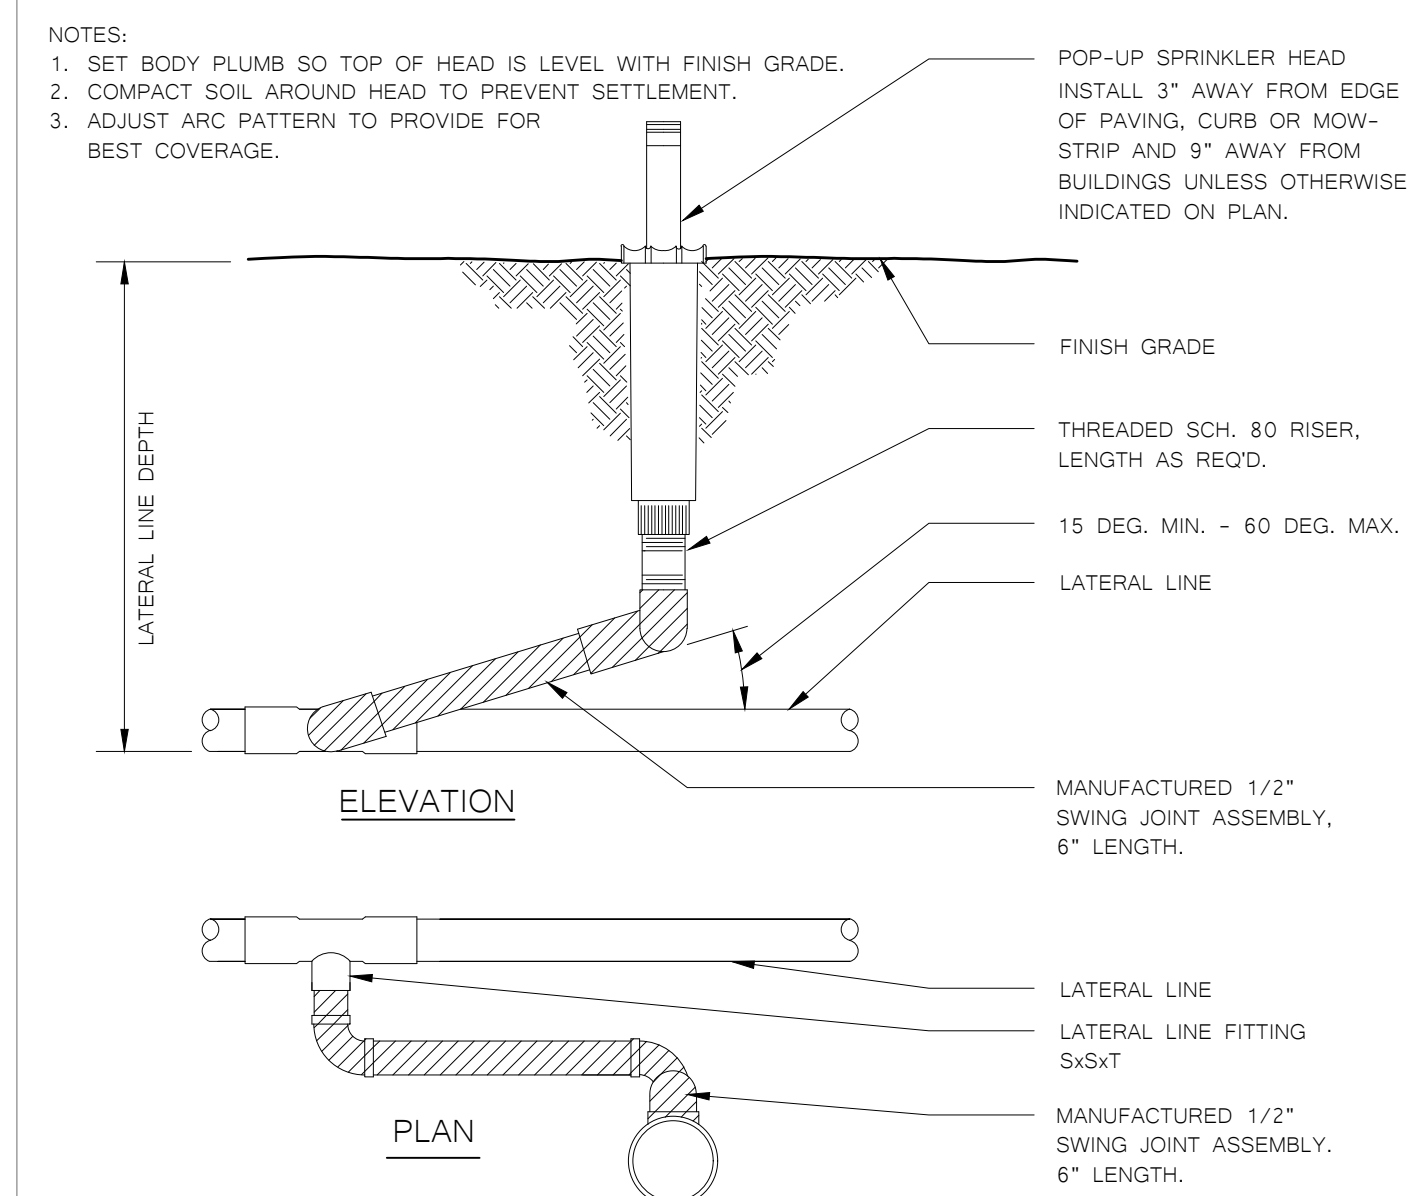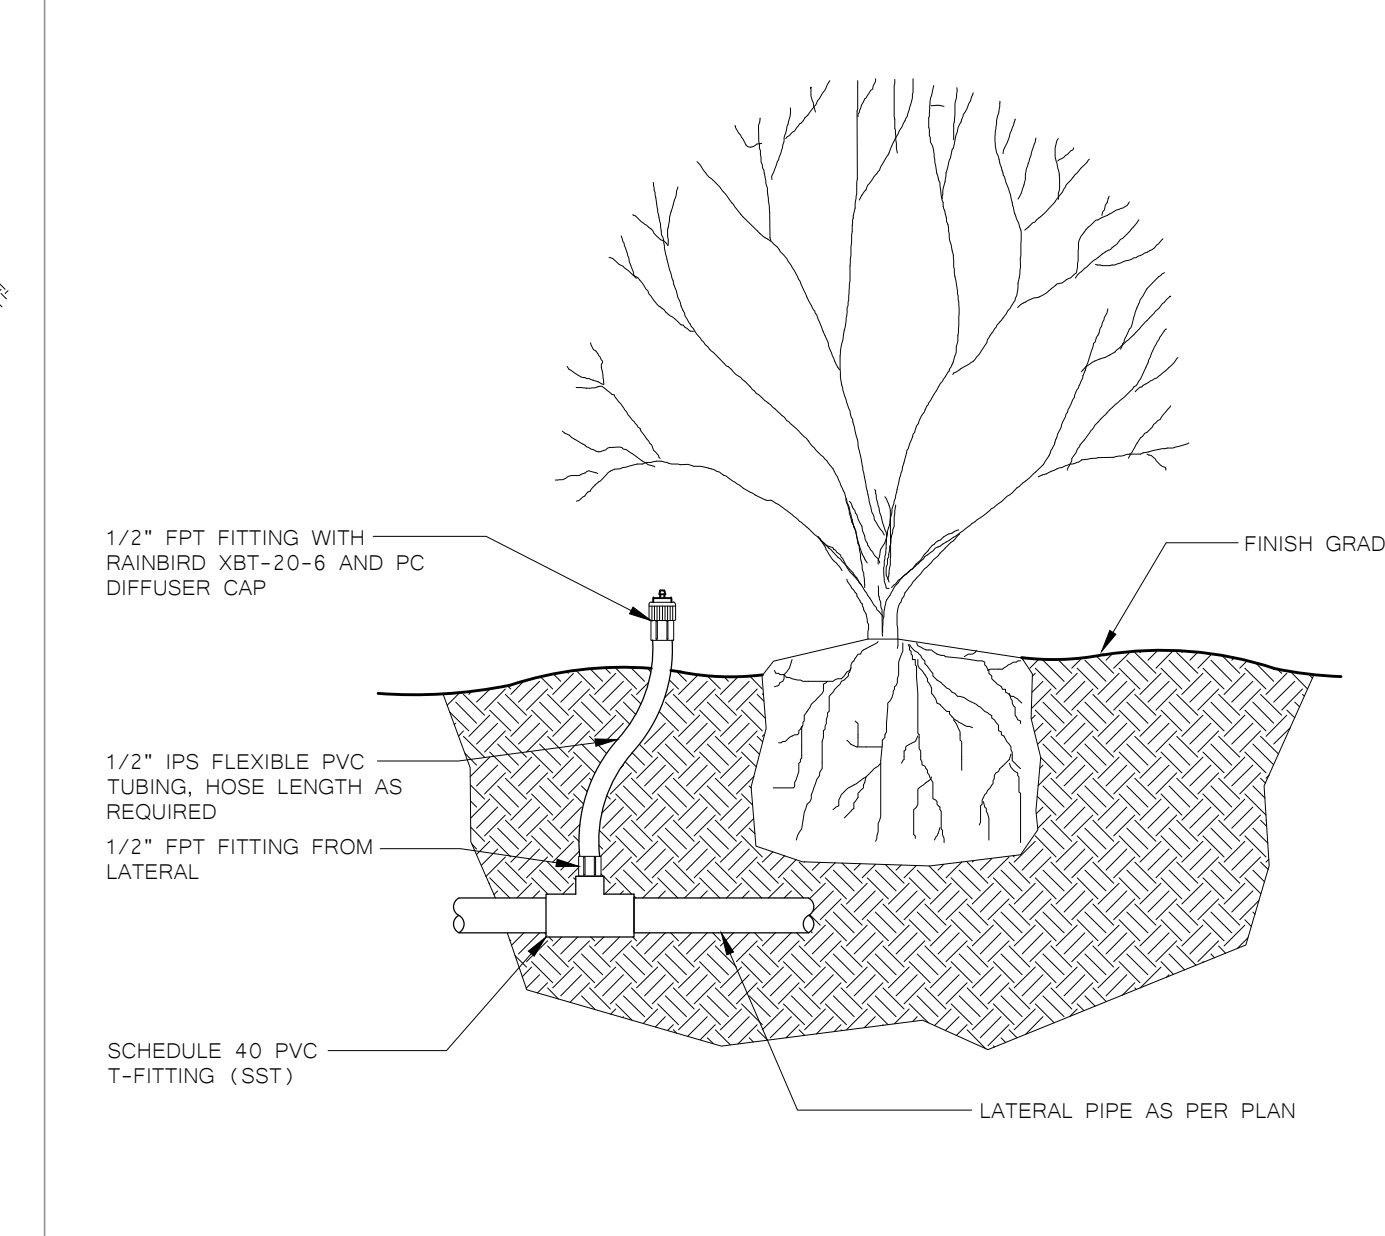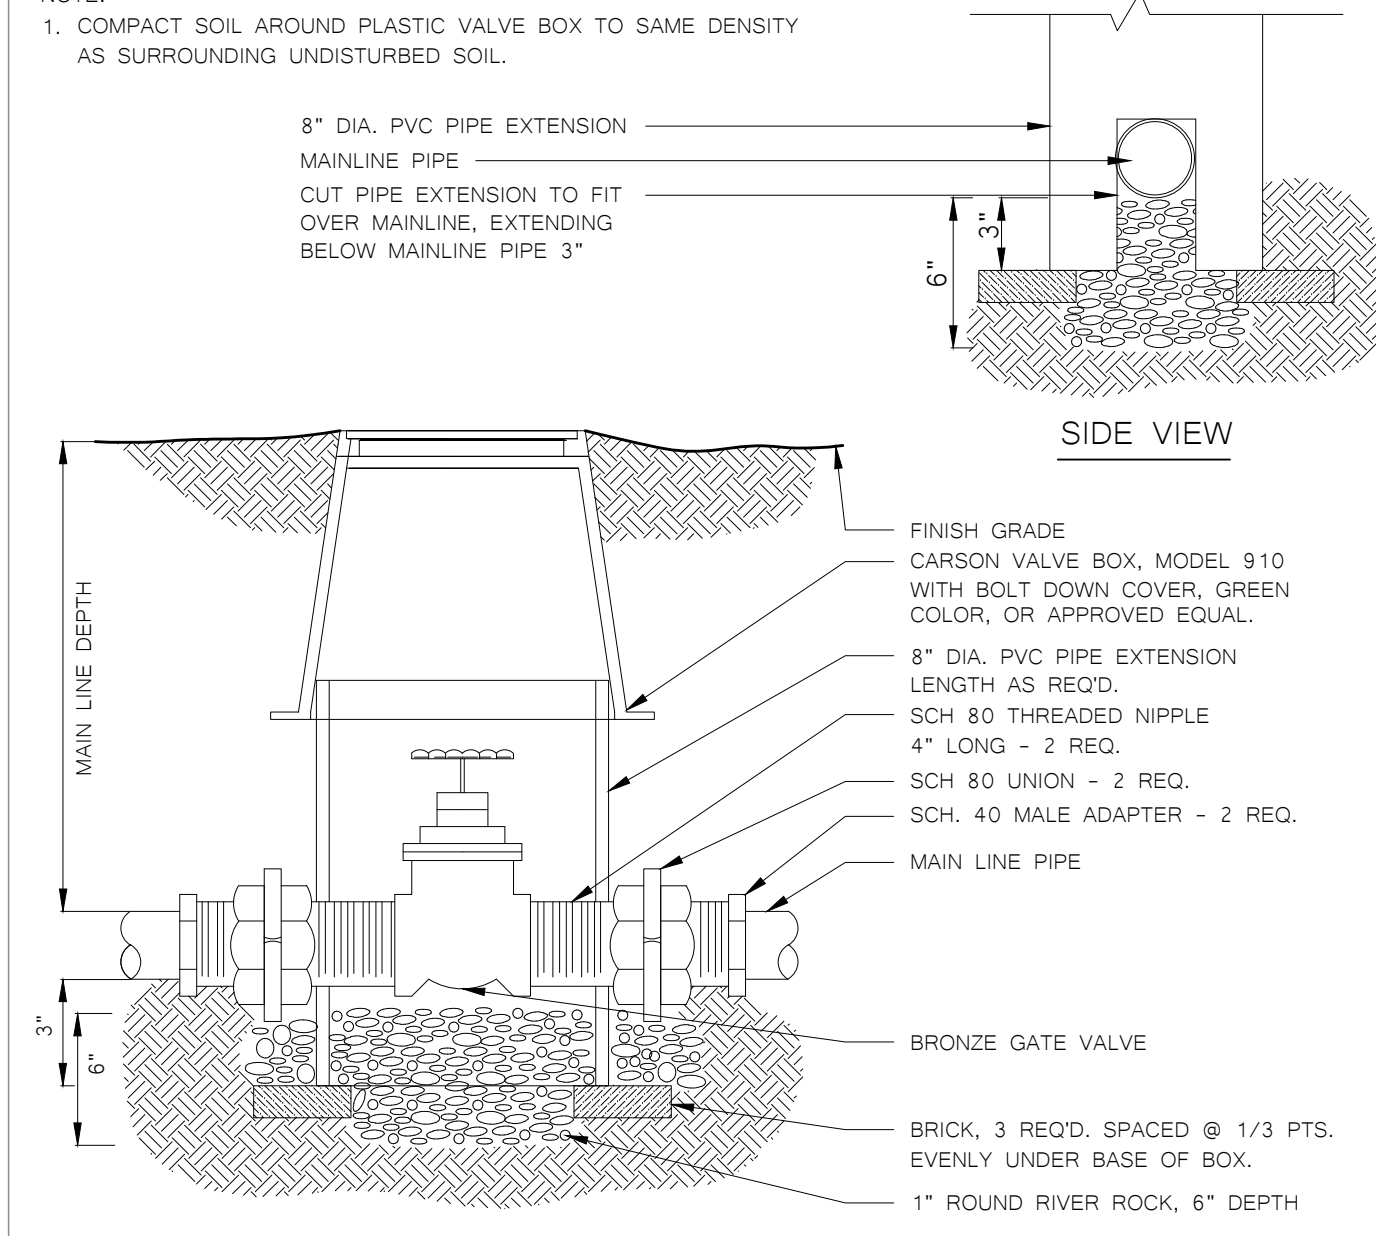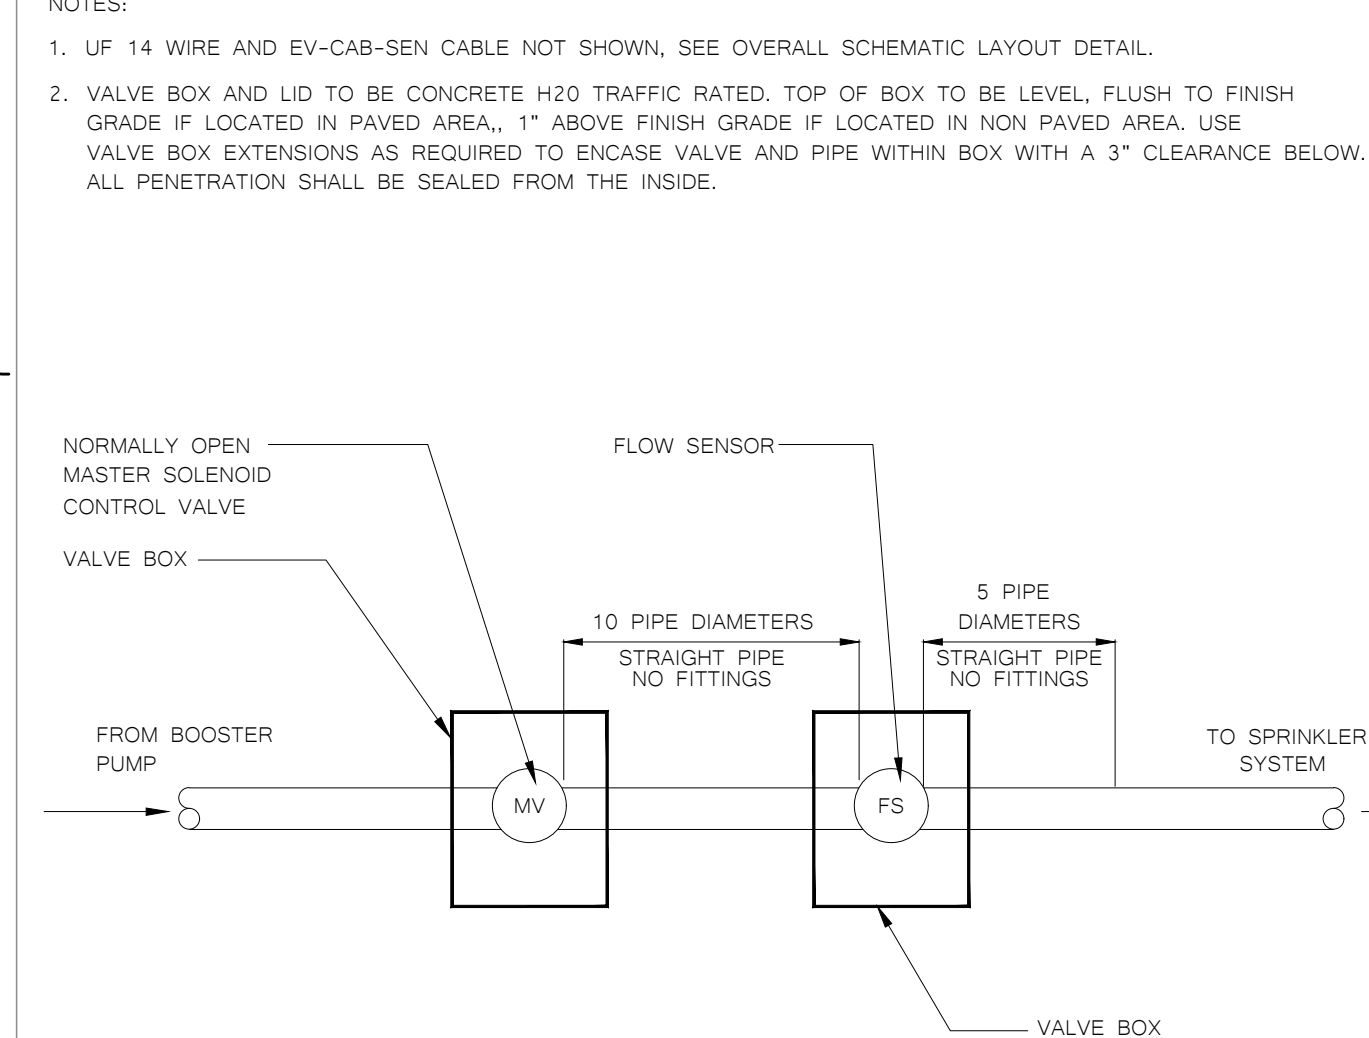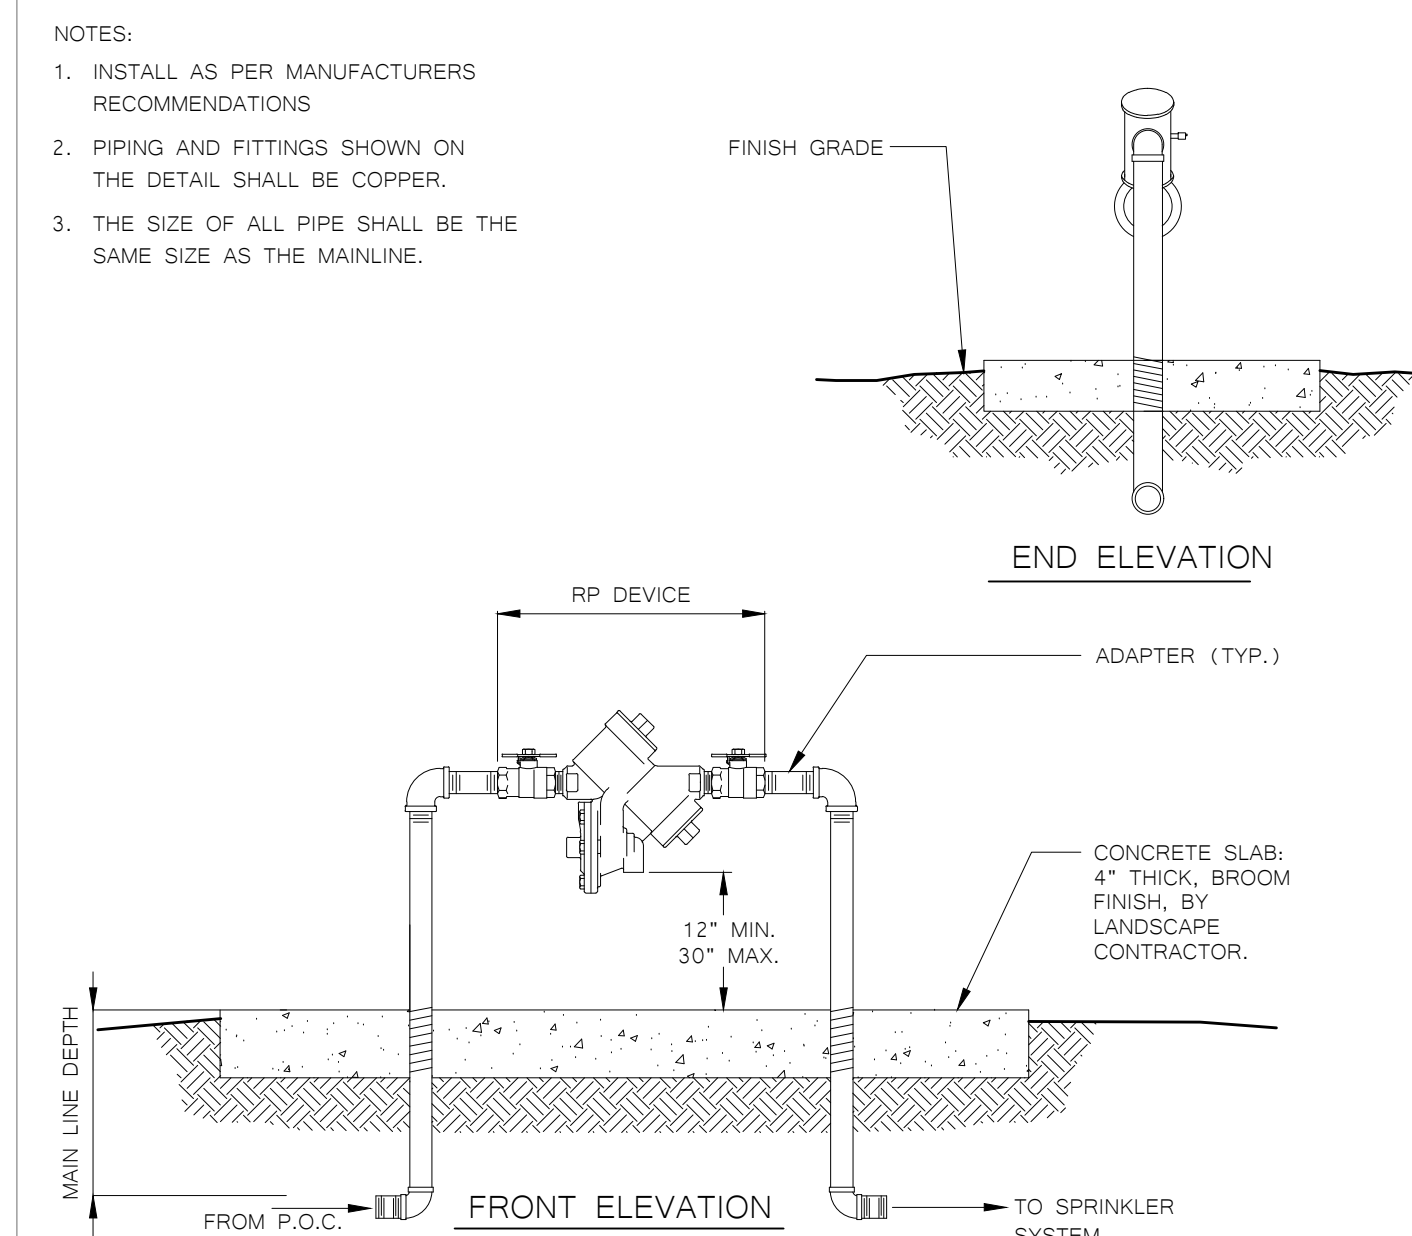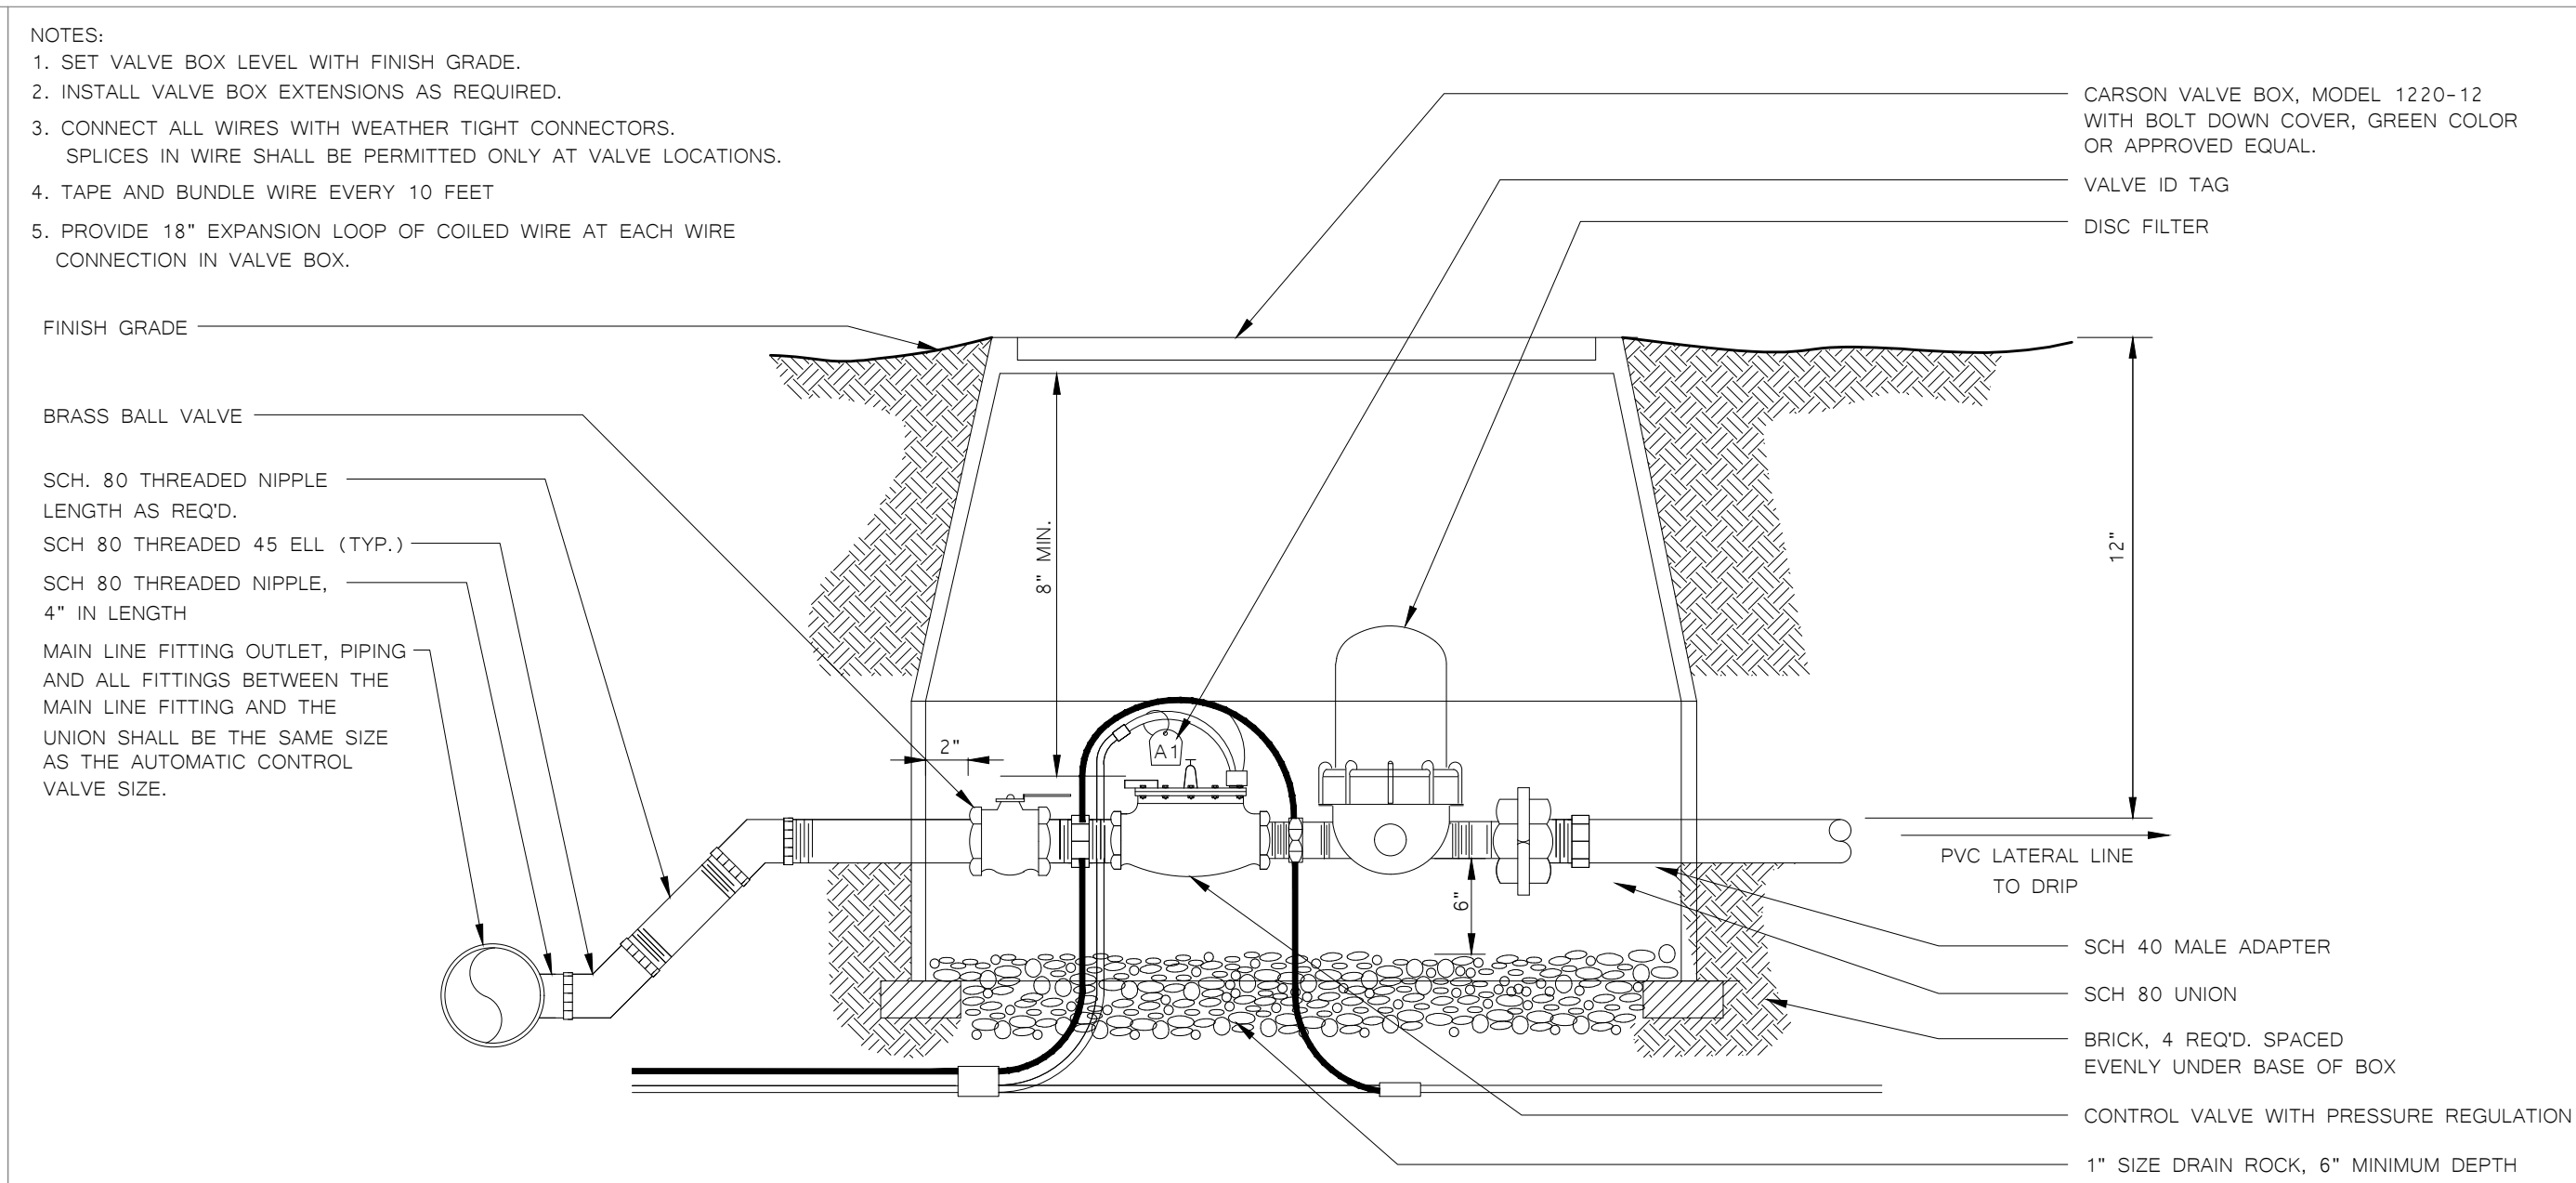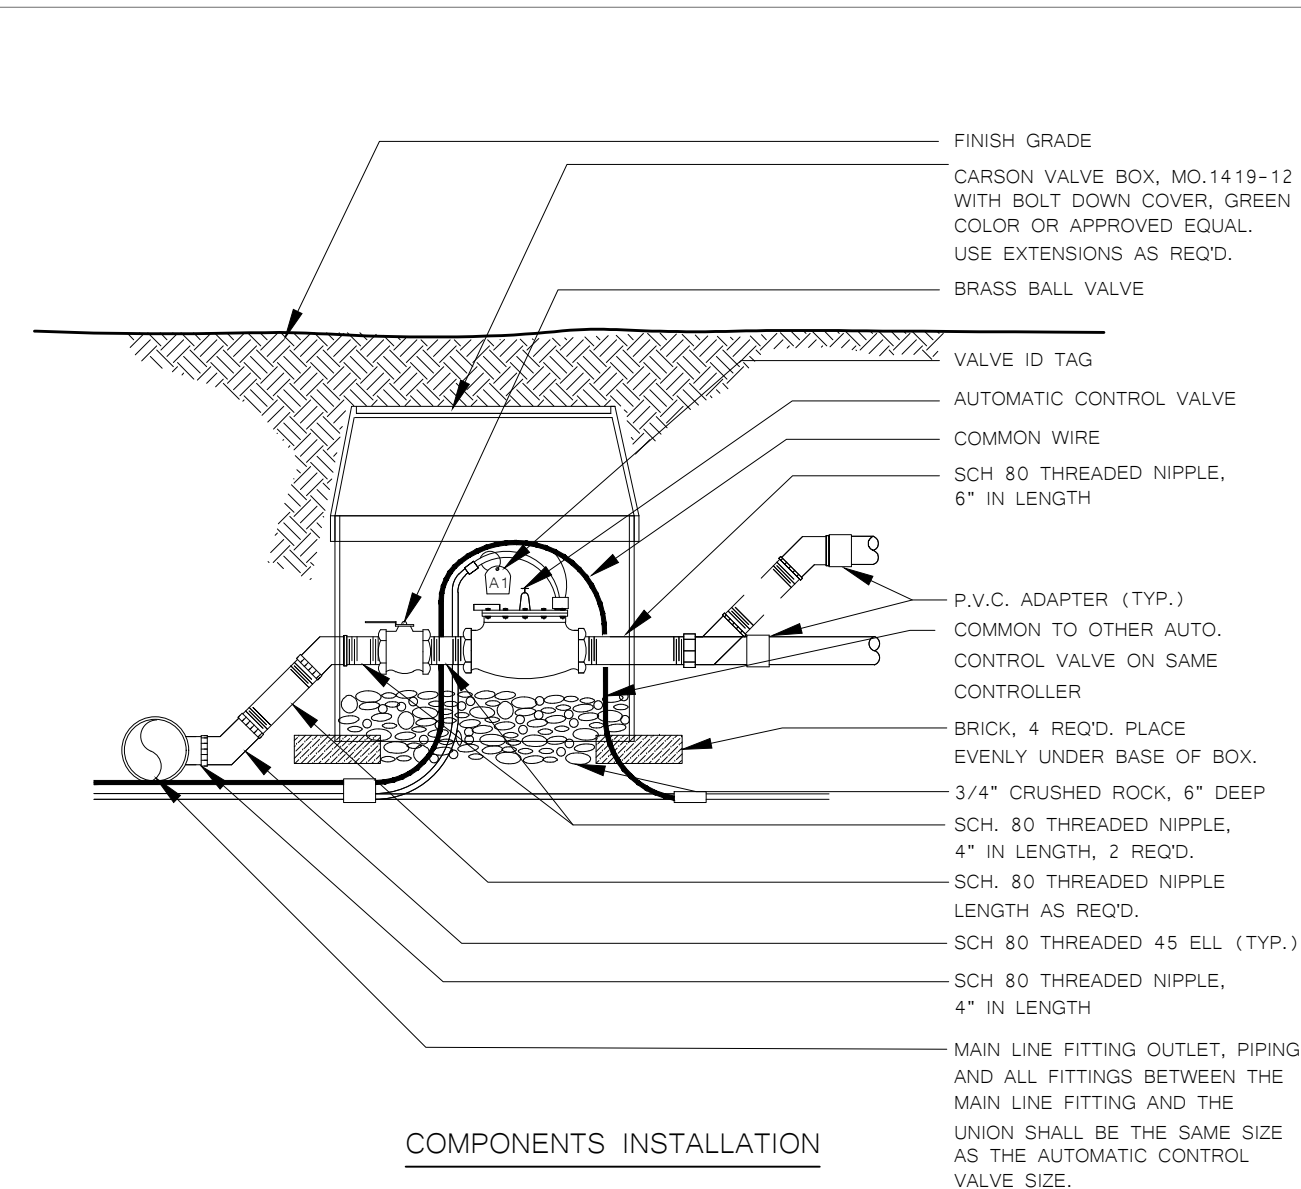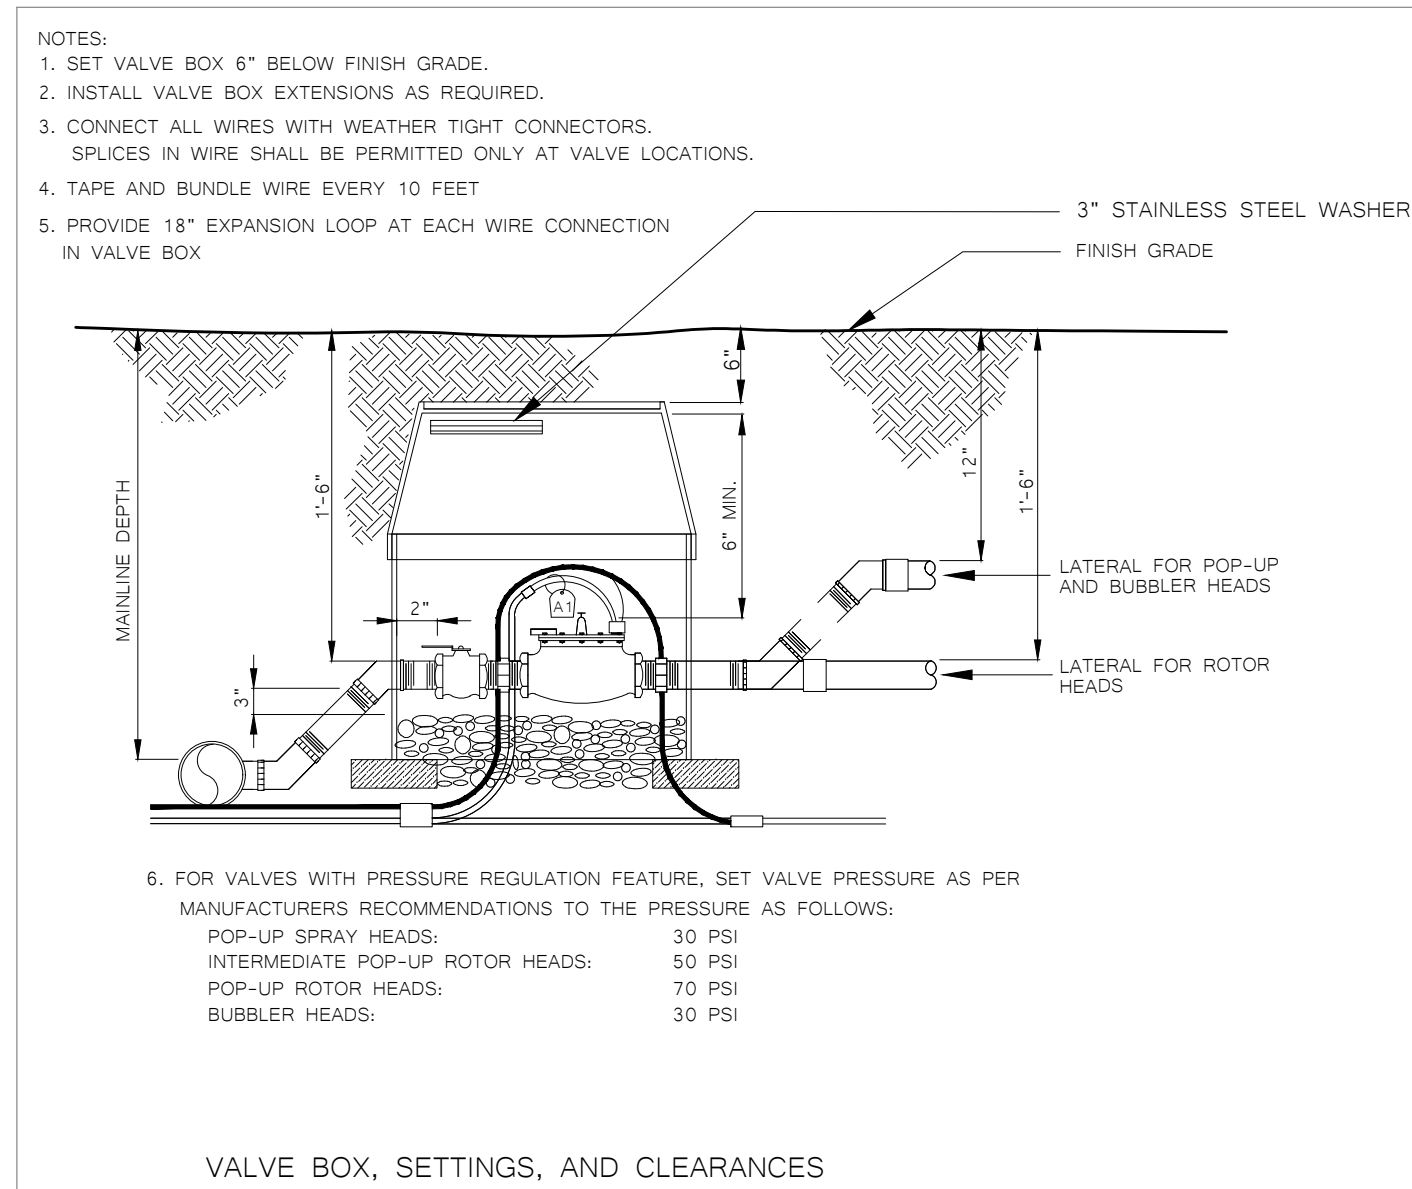L4.1



<div style="border: 2px solid black; border-radius: 15px; padding: 10px; text-align: center; margin-bottom: 10px;"> IDENTIFICATION STAMP DIV. OF THE STATE ARCHITECT APP: 02-120455 INC: REVIEWED FOR SS <input checked="" type="checkbox"/> FLS <input checked="" type="checkbox"/> ACS <input checked="" type="checkbox"/> DATE: 01/12/2023 </div> <div style="text-align: right; padding-right: 10px;"> 730 Howe Avenue, Suite 450 Sacramento, CA 95825 Phone: 916.921.2112 Fax: 916.921.2212 </div>		
 <div style="display: inline-block; transform: rotate(90deg); transform-origin: center; white-space: nowrap;"> HENRY+ ASSOCIATES ARCHITECTS </div>		
		
<div style="display: flex; justify-content: space-between;"> <div style="writing-mode: vertical-rl; transform: rotate(180deg);"> MODERNIZATION LAKEWOOD ELEMENTARY SCHOOL </div> <div style="writing-mode: vertical-rl; transform: rotate(180deg);"> LANDSCAPE IRRIGATION DETAILS </div> </div>		
CONSULTANT		
		
Bryan Hollis Walker C-5453		
PROJECT NO. 21-32-052	REVISIONS	BY
DATE 3/28/2022		
DRAWN MS		
CHECKED JCBS		
SCALE		
CADFILE		
UPDATED 11/17/2022		
SHEET NO.		
<div style="font-size: 48px; font-weight: bold; letter-spacing: 10px;">L4.2</div>		

