



Troy School District

**RFP #2425-09 - Addendum #1
BP#2B High School Athletics - Phase #2
January 21st, 2025**

Content Included in this Addendum:

**Cover Page (1 Page)
Barton Malow Write Up (6 Pages)
TMP Architecture Addendum #1 Write-Up (44 Pages)
Pre-Bid Walk Through Sign-In Sheet (1 Page)**

TOTAL PAGES: 52 Pages

January 21, 2025

Troy Schools District – RFP #2425-09 BP#2B High School Athletics Renovations - Phase #2

Addendum #1 Bidder Clarifications

A. General Clarifications

- Project bid due date has been extended 1 week. **The new bid due date is 1/28/25 @ 2PM.** No change to the bid submittal process and location.
- **Construction Milestones for Project**
 - Troy High School
 - Tennis Courts: **May 19th-September 1st**
 - Parking lot, sidewalks, concessions building, tickets building, existing toilet building: **March 12th-August 8th**
 - Athens High School
 - Dirt and artificial turf fields and connecting concourses: **June 2nd-September 19th**
 - Track and Field: **June 2nd-August 8th**
- Reference Note #8 on Drawing C-3.0 for Athens High School and correlating G2 report for geotechnical investigation report.
- Below is the schedule for post bid interviews. If BMB chooses your company for this process, you must have a representative available during this day/time.
-

CATEGORY	DATE	TIME
SITework	1/29	9AM
GENERAL TRADES	1/29	10AM
ELECTRICAL	1/29	1PM
MECHANICAL	1/29	2PM
FOOD SERVICE EQUIP.	1/29	3PM

B. Clarifications and Additions to Work Scopes

- **Site Work scope**
 - Added Alternate No 2
 - Removal of furnishing (6) poles for 20' protective netting around new schools at Athens. Price still to include installation but poles will be provided by Troy School District.
- Refer to TMP Architecture write-up.

C. RFI Responses

Q: Per the drawings the refer to Allowance, are we to include the quantities provided in base bid or are those recommendations that you have included in the \$100,000.00 allowance.

A: The \$100,000 allowance noted in **SPECIAL CONSIDERATIONS** in the sitework contractors' scope of work is in addition to any and all allowances noted on the drawings.

Q: Permits and tap fees I assume are part of our \$100,000.00 allowance

A: Any/all permits and tap fees included in the contractors' scope of work is not included in the **SPECIAL CONSIDERATIONS** allowances in the Project Manual.

Q: Confirm that the turf is being furnished and installed by the owner.

A: Yes, all turf is being furnished and installed by the district's representative.

Q: Will there be a schedule released for this project?

A: Yes. Refer to the **PROCUREMENT TIMETABLE** in Section 000102 for desired start and completion dates. In addition to this a construction schedule will be provided regularly throughout the process once contracts are awarded.

Q: Will there be a logistics plan released for this project?

A: Yes. A logistics plan will be discussed and distributed by Barton Malow before construction begins.

Q: Undercuts for poor or unsuitable underlaying soils handled through the \$100,000.00 allowance

A: This is at the contractor's discretion. Include allowances for undercutting noted on drawings. Specifically allowances and Note #8 on Drawing C-3.0 for Athens High School.

Q: Site furnishings furnish and installed benches, bike racks, etc. by Architectural/General trades per their scope?

A: Site furnishings and installation are to be provided by Sitework Contractor.

Q: Please confirm foundations are part of the Architectural/General trades scope?

A: All foundations are part of the Sitework Contractors scope of work.

Q: Foundation spoils and backfill required are by Architectural/General trades scope?

A: Foundation spoils and backfill are part of the Sitework Contractors scope of work.

Q: Are wash stations really required? Can a track off mat or rumble mate suffice?

A: Provide pricing as specified. Alternative means and methods can be discussed and addressed after awarded contracts. In addition, all voluntary alternates should be provided on bid documents.

Q: Does the turf contractor have final grading? Will they furnish and install fines for final grading?

A: All final grading is under the sitework contractor's scope.

Q: Are you willing to extend the due date for this project by 1 week?

A: Yes. The new bid due date is 1/28/25 @ 2pm.

Q: Please provide model numbers for the security fixtures in spec section 22-4600.

A: Model numbers are not provided as there are multiple approved manufacturers for this specification.

Q: Electrical scope includes the removal and reinstallation of existing scoreboards with an alternate for new scoreboards. Is there a structural detail for the steel framing need to mount the existing? Also if replacing with new is there a structural detail for the new scoreboards?

A: Refer to Drawing LD1.01 for Scoreboard elevation details. Also refer to Section 11 6842 - Scoreboard in the specifications for new and existing scoreboard basis of design.

Q: It is mentioned in the project manual that electrical is to provide and install the fire alarm system. I can not find the specs or manufacture that we should use in the spec book.

A: Disregard instructions for Electrical Contractor to provide and install Fire Alarm systems. There is no Fire alarm systems for this project.

Q: Sheet C6.0 is showing an allowance for 48" CMP of 201 lineal feet and 48" end section of 1 – is this work part of base bid?

A: Yes.

Q: Sheet C3.0 is showing an allowance for subgrade undercut of 2040 cyd and 4" drain tile of 2000 lft – is this work part of base bid?

A: Yes, include cost in base bid.

Q: Sheet C2.0 is showing an allowance to remove storm pipe of 200 lineal foot – is this work part of base bid?

A: Yes, include cost in base bid.

Q: Who is responsible for the concrete stoop caps?

A: Sitework contractor is responsible for all concrete stoops complete.

Q: Not seeing the heights for the dimensional letters for the exterior of the building. Please advise

A: Refer to detail 1/A1.1 and Sign elevation detail 13/S6.1.

Q: Who is the specified controls contractor?


A: MCM.

Q: For the Athens track, the specs say to install the leveling at 2.5" but the plans say 2". Please clarify.

A: Leveling course shall be 2-1/2" depth as specified.

Q: At Athens HS C3.0 Shows the 4' High Fence on the east side of the track extending north 108 LF past the 8' Double Gate then taking a 90 degree turn east to an existing building. This same line is not shown on the Foresite Drawings L1.00 or L1.02. Please advise if this fence is to be installed.

A: The 4' fence noted on the civil sheets is to be removed and reflected as shown on the Landscape drawings. Contractor shall install new 4' fence east from end of track fence and terminate/but next to existing building.

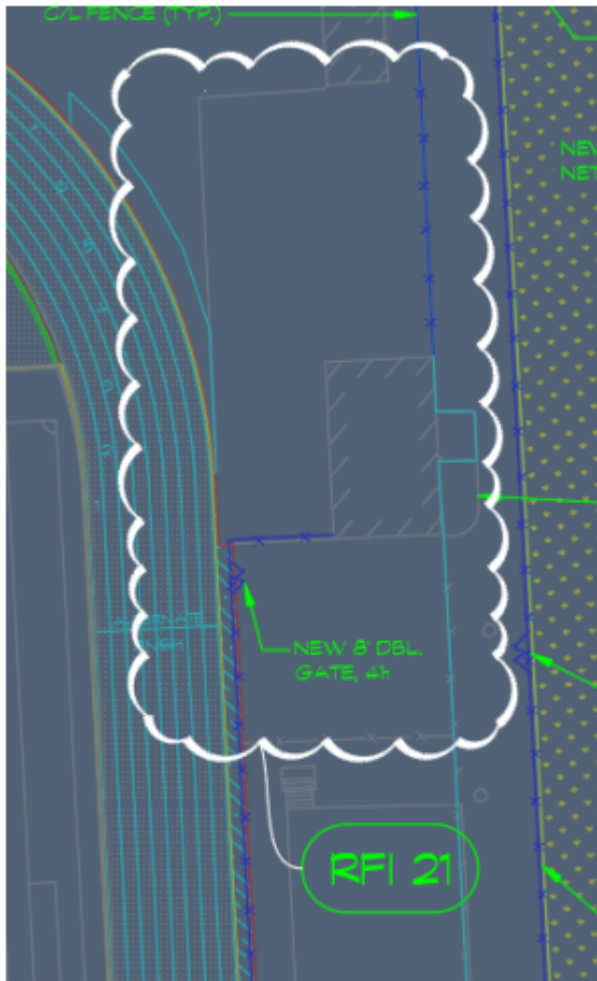

Q: At Troy High School C3.1 calls out GUARDRAIL in the northwest corner of the drawing and refers us to C9.0 for detail, no Guardrail detail is shown. Is this intended to be handrail as the detail shows, or W-Beam Highway Guardrail?

A: Contractor is to install MDOT type 'B' guardrail along the west side of the parking lot.

Q: Sheet L1.02 is showing the fence at the east of the site going south stopping, should this continue South and connect to new fence?

A: Yes, corrected in Addendum #1. East fence line now connects to corner of varsity baseball left field fence.

Q: Sheet C6.0 is showing an allowance for 48" CMP of 201 lineal feet and 48" end section of 1 – where is it located on the plans?

A: The contractor is to provide an "allowance" for the potential installation of the CMP. It may become necessary during construction.

Q: Sheet C2.0 is showing an allowance to remove storm pipe of 200 lineal foot - where is this located on the plans?

A: The revised construction documents issued in Addendum #1 show the storm sewers which are being removed on the demolition plan. Reference Addendum #1

Q: Does the fence lines at both the JV baseball & softball fields require a curb or concrete maintenance strip. The grading plan gives us T.O.C. elevations. Please clarify.

A: At JV bullpens, the chainlink fence surrounding the bullpen shall include a curb on all sides. There is no curb required for fence beyond limits of bullpen. Refer to Sheet LD1.09 and LD1.10. Reference to Addendum #1.

Q: Please clarify the difference between the 4" & 6" concrete walks/ pavement at Troy Athens High School. I assume that it is the line shown on C3.0 but the legend does not designate the difference.

A: Reference Addendum #1. The limits were defined and provided details of the pavement cross section.

Q: Is there a detail for the precast storage buildings. Do they require a concrete pad?

A: Yes, see sheet LD1.16 (Addendum #1). Our detail calls out 4" concrete floor provided by mfr on top of 8" 21AA Limestone compacted base.

Q: Please clarify what areas that require turf curbs. Do we need to include a turf curb in front of the poured in place wall that is shown on C3.0 and detailed on C9.0 (Troy Athens High School)?

A: All turf athletic fields will require a concrete turf anchor at perimeter. Refer to Sheet LD1.10, Detail #9 issued with Addendum #1.

Q: Is there a detail for the backstop walls at the Varsity baseball and softball fields?

A: Backstop "wall" is a pre-manufactured backer board & pad system. Refer to Sheet LD1.07.

Q: Is there exterior signage needed indicating the concessions and ticket booth windows?

A: Signage in question is not needed. Proceed per the documents.

Q: Item #27 on FSE drawings for Troy High is specified to be by Avantco #SH-1H. We are being told this model number is not valid. Please advise.

A: Manufacturer's model number has changed to HDC-36.

Q: Drawings E1.0 for Troy High only show 2 power pedestals at the tennis courts, both located on the north end. Should there be power pedestals for the south courts also?

A: Additional pedestals not required for south courts.

Q: Can they confirm for Section 08 3323, they are wanting an insulated coiling door to act as a counter shutter. If not a Model 651 is a Stainless Steel counter shutter that would work. Please confirm if acceptable.

A: Insulation is not needed.

Q: Is it in the MC's scope of work to provide the electrical heating units?

A: Yes.

Q: They have a spec for both schools for the flagpole. But, only Athens shows a location for a flagpole. Troy High doesn't show any location for flagpole. Is there one?

A: No, a new flagpole is only needed at Athens High School.

Q: In Architectural/General Trades Scope of works, Exclusions, it states to exclude storage and toilet room footings and building pad. With excluding this, what concrete does GT have?

A: General Trade Contractor scope of work includes toilet and storage building slab on grade concrete. The exclusion is for the soil building pad and footings, which is under the site contractor's scope of work. In addition refer to Scope B/#94 on providing engineered fill, dirt, and sand for slab-on-grade.

Q: Electrical scope includes the removal and reinstallation of existing scoreboards with an alternate for new scoreboards. Is there a structural detail for the steel framing need to mount the existing? Also if replacing with new is there a structural detail for the new scoreboards?

A: Refer to Drawing LD1.01 for Scoreboard elevation details. Also refer to Section 11 6842 - Scoreboard in the specifications for new and existing scoreboard basis of design.

Q: It is mentioned in the project manual that electrical is to provide and install the fire alarm system. I can not find the specs or manufacture that we should use in the spec book.

A: Disregard instructions for Electrical Contractor to provide and install Fire Alarm systems. There is no Fire alarm systems for this project.

Q: Who is responsible for the concrete stoop caps?

A: Sitework contractor is responsible for all concrete stoops – complete.

Q: Not seeing the heights for the dimensional letters for the exterior of the building. Please advise

A: Refer to detail 1/A1.1 and Sign elevation detail 13/S6.1



Addendum

Date January 14, 2025
Project Name Troy School District – Athens High School Athletics & Troy High School Athletics
TMP Project No. 22103D, 22104E
Bid Package No. 02B
Addendum No. One (1)

The Bidding Documents are modified, supplemented, or augmented as follows and the Addendum is hereby made a part of the proposed Contract Documents.

The following Drawing(s) and Attachment(s) are issued with this Addendum:

Drawing No(s): 22103D – Athens HS: TS.1, C2.0, C3.0, C4.0, C4.1, C4.2, C5.0, C5.1, C6.0, C6.1, C7.0, C7.1, C9.0, L1.00, L1.01, L1.02, L1.03, L1.04, LD1.01, LD1.02, LD1.04, LD1.05, LD1.08, LD1.10, LD1.11, LD1.12, LD1.16
22104E – Troy HS: AD.2, A1.1, A4.1
Attachment(s): Specification Section(s): 05 5000, 33 4416

Item No.	Specification Changes
SC-1	Refer to Section No. 05 5000 – METAL FABRICATIONS (reissued): A. Added paragraph 1.01.D. B. Added paragraphs 2.09 and 2.10 and all associated sub-paragraphs.
SC-2	Refer to Section No. 33 4416 – UTILITY TROUGH DRAIN (reissued): A. Added landscape trough drain as indicated.

22103D – Athens High School Athletics

Item No.	Civil Drawing Changes
CD-1	Refer to Drawing No. C2.0 (reissued): A. Added items to be protected/removed at the south end of the project limits as indicated. B. Added boundary to the “remove vegetation, topsoil, and subgrade” hatch as indicated.
CD-2	Refer to Drawing No. C3.0 (reissued): A. Added note referencing chain link fence at baseball outfield as indicated.

January 14, 2025

Troy School District – Athens High School Athletics and Troy High School Athletics

TMP Project No(s). 22103D, 22104E

Bid Package No. 02B

Addendum No. One (1)

Page 2 of 6

- B. Removed synthetic turf markings for varsity softball field (not bubbled).
- C. Revised location of flagpole as indicated.
- D. Added seat wall around flagpole as indicated.

- CD-3 Refer to Drawing No. C4.0 (reissued):
- A. Revised spot elevations in plaza area between softball fields as indicated.
 - B. Removed synthetic turf markings for varsity softball fields (not bubbled).
- CD-4 Refer to Drawing No. C4.1 (reissued):
- A. Revised grading around berm near varsity softball left field foul pole as indicated.
 - B. Revised grading at retaining walls between varsity baseball/practice field and concrete sidewalk as indicated.
 - C. Added spot elevations around flagpole seat wall as indicated.
- CD-5 Refer to Drawing No. C4.2 (reissued):
- A. Revised grading at retaining wall between practice field and concrete sidewalk as indicated.
- CD-6 Refer to Drawing No. C5.0 (reissued):
- A. Added contour labels to the mass grading contours as indicated.
- CD-7 Refer to Drawing No. C5.1 (reissued):
- A. Revised limits of earth disruption at the north end of the site as indicated.
- CD-8 Refer to Drawing No. C6.0 (reissued):
- A. Revised storm sewer piping around JV softball dugout (CB-14A to CB-14) as indicated.
 - B. Revised storm sewer piping around MH-4 and location of STUB-102 as indicated.
 - C. Added note referencing underdrain in practice field as indicated.
 - D. Added STUB-104 and piping from flagpole seat wall to CB-3 as indicated.
- CD-9 Refer to Drawing No. C6.1 (reissued):
- A. Revised storm structure table to reflect revised information as indicated.

January 14, 2025

Troy School District – Athens High School Athletics and Troy High School Athletics

TMP Project No(s). 22103D, 22104E

Bid Package No. 02B

Addendum No. One (1)

Page 3 of 6

CD-10 Refer to Drawing No. C7.0 (reissued):
 A. Revised profiles to account for plan adjustments as indicated.

CD-11 Refer to Drawing No. C7.1 (reissued):
 A. Revised rim elevation labels for clean outs as indicated.

CD-12 Refer to Drawing No. C9.0 (reissued):
 A. Revised Pour in Place Wall with Fence detail as indicated.

Item No. Athletic Drawing Changes

LD-1 Refer to Drawing No. L1.00 (reissued):
 A. Revised size of pre-cast storage buildings to 10'x12' as indicated.
 B. Revised layout of flag pole focal point as indicated.

LD-2 Refer to Drawing No. L1.01 (reissued):
 A. Revised various detail callouts to be coordinated with subsequent details as indicated.
 B. Added detail callouts to further communicate intent as indicated.
 C. Added dimensions to new flag pole focal point layout as indicated.

LD-3 Refer to Drawing No. L1.02 (reissued):
 A. Added enlarged plan views of dugout fencing conditions to further communicate layout intent as indicated.
 B. Added fence at each of varsity baseball to complete coordination as indicated.

LD-4 Refer to Drawing No. L1.03 (reissued):
 A. Added section detail callouts to be coordinated with various finish grade conditions between athletic fields and site grading as indicated.

LD-5 Refer to Drawing No. L1.04 (reissued):
 A. Revised Utility Legend as indicated.
 B. Added detail callouts to further communicate intent as indicated.
 C. Added invert elevations to JV Softball field drain tile as indicated.
 D. Added top of trench elevations for synthetic turf fields as indicated.
 E. Revised Varsity Softball field outlet location to be coordinated with latest civil utility plan as indicated.
 F. Added note indicating existing utility boxes within the running track.
 G. Revised bullpen drain tile sizes and lengths as indicated.

January 14, 2025

Troy School District – Athens High School Athletics and Troy High School Athletics

TMP Project No(s). 22103D, 22104E

Bid Package No. 02B

Addendum No. One (1)

Page 4 of 6

- H. Added trough drain to northeast side of new flag pole focal point layout as indicated.

- LD-6 Refer to Drawing No. LD1.01 (reissued):
 - A. Added details to further communicate JV ballfield design intent as indicated.
 - B. Revised details; moved scoreboard details and flag pole detail to a different LD sheet as indicated.
- LD-7 Refer to Drawing No. LD1.02 (reissued):
 - A. Revised shot put detail to show a concrete curb border as indicated.
 - B. Revised discus detail note to callout as indicated.
- LD-8 Refer to Drawing No. LD1.04 (reissued):
 - A. Added note clarifying the intent for post sizes on gates larger than 12' as indicated.
- LD-9 Refer to Drawing No. LD1.05 (reissued):
 - A. Added note clarifying the intent for post sizes on gates larger than 12' as indicated.
- LD-10 Refer to Drawing No. LD1.08 (reissued):
 - A. Revised details; moved JV dugout details from different LD sheet onto sheet as indicated.
 - B. Revised details; backstop detail numbers are reordered as indicated.
- LD-11 Refer to Drawing No. LD1.09 (not reissued):
 - A. Revised bullpen drain tile diameter to 6".
- LD-12 Refer to Drawing No. LD1.10 (reissued):
 - A. Added section details for various finish grade conditions between athletic fields and site grading as indicated.
- LD-13 Refer to Drawing No. LD1.11 (reissued):
 - A. Deleted dimensional references to fence as indicated.
 - B. Added notes for expansion joints as indicated.

January 14, 2025

Troy School District – Athens High School Athletics and Troy High School Athletics

TMP Project No(s). 22103D, 22104E

Bid Package No. 02B

Addendum No. One (1)

Page 5 of 6

- LD-14 Refer to Drawing No. LD1.12 (reissued):
- A. Revised details; moved JV dugout details to different LD sheet as indicated.
 - B. Revised details; moved scoreboard details and flag pole details from different LD sheet onto sheet as indicated.
 - C. Added synthetic turf graphics detail for flag pole area as indicated.
 - D. Revised name of detail sheet to correspond with the details as indicated.
 - E. Revised flag pole focal point section in its entirety as indicated.

- LD-15 Refer to Drawing No. LD1.16 (new):
- A. Added drawing sheet for design intent of storage buildings as indicated.

Item No. Architectural Drawing Changes

- AD-1 Refer to Drawing No. TS.1 (reissued):
- A. Added sheet LD1.16 to Drawing Index as indicated.

22104E – Troy High School Athletics

Item No. Architectural Drawing Changes

- AD-2 Refer to Drawing No. AD.2 (reissued):
- A. Added detail No. 10 as indicated.
- AD-3 Refer to Drawing No. A1.1 (reissued):
- A. Added detail tag No. 10 as indicated.
- AD-4 Refer to Drawing No. A4.1 (reissued):
- A. Revised Wall Section no. 1, top of wall coping and coordinated awning framing as indicated.
 - B. Revised Wall Section no. 2, top of wall coping and coordinated awning and canopy framing as indicated.
 - C. Added Detail Tag no. 5 as indicated.
 - D. Revised Roof Edge Detail no. 3, top of wall coping and coordinated awning and canopy framing as indicated.
 - E. Added Base of Wall Detail no. 5 as indicated.

January 14, 2025

Troy School District – Athens High School Athletics and Troy High School Athletics

TMP Project No(s). 22103D, 22104E

Bid Package No. 02B

Addendum No. One (1)

Page 6 of 6

END OF ADDENDUM NO. 1 - BID PACKAGE NO. 02B

SECTION 05 5000 - METAL FABRICATIONS**PART 1 GENERAL****1.01 SECTION INCLUDES**

- A. Shop fabricated steel items, including:
 - 1. Loose steel lintels.
 - 2. Steel framing supports for the following:
 - a. Roof openings.
 - b. Mechanical and electrical equipment.
 - c. Applications where framing and supports are not specified in other Sections.
 - d. Other items as indicated on Drawings.
 - 3. Other items as indicated on Drawings.
- B. Downspout boots.
- C. Slotted channel framing.
- D. Shop fabricated aluminum brake metal trim. ****ADD1****

1.02 REFERENCE STANDARDS

- A. ANSI A14.3 - American National Standard for Ladders -- Fixed -- Safety Requirements; 2008 (Reaffirmed 2018).
- B. ASTM A36/A36M - Standard Specification for Carbon Structural Steel; 2019.
- C. ASTM A48/A48M - Standard Specification for Gray Iron Castings; 2022.
- D. ASTM A53/A53M - Standard Specification for Pipe, Steel, Black and Hot-Dipped, Zinc-Coated, Welded and Seamless; 2022.
- E. ASTM A123/A123M - Standard Specification for Zinc (Hot-Dip Galvanized) Coatings on Iron and Steel Products; 2017.
- F. ASTM A153/A153M - Standard Specification for Zinc Coating (Hot-Dip) on Iron and Steel Hardware; 2023.
- G. ASTM A283/A283M - Standard Specification for Low and Intermediate Tensile Strength Carbon Steel Plates; 2018.
- H. ASTM A307 - Standard Specification for Carbon Steel Bolts, Studs, and Threaded Rod 60 000 PSI Tensile Strength; 2021.
- I. ASTM A653/A653M - Standard Specification for Steel Sheet, Zinc-Coated (Galvanized) or Zinc-Iron Alloy-Coated (Galvannealed) by the Hot-Dip Process; 2023.
- J. ASTM C1107/C1107M - Standard Specification for Packaged Dry, Hydraulic-Cement Grout (Nonshrink); 2020.
- K. AWS A2.4 - Standard Symbols for Welding, Brazing, and Nondestructive Examination; 2020.
- L. AWS D1.1/D1.1M - Structural Welding Code - Steel; 2020, with Errata (2022).
- M. SSPC-Paint 15 - Steel Joist Shop Primer/Metal Building Primer; 2004.
- N. SSPC-SP 2 - Hand Tool Cleaning; 2018.

1.03 SUBMITTALS

- A. See Section 01 3000 - Administrative Requirements, for submittal procedures.
- B. Shop Drawings: Indicate profiles, sizes, connection attachments, reinforcing, anchorage, size and type of fasteners, and accessories. Include erection drawings, elevations, and details where applicable.
 - 1. Indicate welded connections using standard AWS A2.4 welding symbols. Indicate net weld lengths.
 - 2. Design data: Submit drawings and supporting calculations, signed and sealed by a qualified professional structural engineer.
- C. Welders' Certificates: Submit certification for welders employed on the project, verifying AWS qualification within the previous 12 months.
- D. Designer's Qualification Statement.

E. Fabricator's Qualification Statement.

1.04 QUALITY ASSURANCE

- A. Design metal fabrications under direct supervision of a Professional Structural Engineer experienced in design of this Work and licensed in the State in which the Project is located.
- B. Fabricator: Company specializing in performing the work of this section with minimum 5 years of documented experience.

PART 2 PRODUCTS

2.01 MATERIALS - STEEL

- A. Steel Sections: ASTM A36/A36M.
- B. Steel Tubing: ASTM A500/A500M, Grade B, cold-formed or ASTM A501/A501M hot-formed structural tubing.
- C. Plates: ASTM A283/A283M.
- D. Pipe: ASTM A53/A53M, Grade B Schedule 40, black and hot-dip galvanized finish, as indicated.
- E. Slotted Channel Framing:
 - 1. Slotted Channel Framing: ASTM A653/A653M Grade 33.
 - a. Channel Size: 1-5/8 by 1-5/8 inches.
 - b. Thickness: 0.060 inch (16 gage), minimum.
 - c. Finish: Galvanized, G90 coating.
 - 2. Fittings and Fasteners: Manufacturer's standard fittings and fasteners; finished to match slotted channel framing.
- F. Bolts, Nuts, and Washers: ASTM A307, Grade A, galvanized to ASTM A153/A153M where connecting galvanized components.
- G. Welding Materials: AWS D1.1/D1.1M; type required for materials being welded.
- H. Shop and Touch-Up Primer: SSPC-Paint 15, complying with VOC limitations of authorities having jurisdiction.
- I. Touch-Up Primer for Galvanized Surfaces: SSPC-Paint 20, complying with VOC limitations of authorities having jurisdiction.
- J. Nonshrink, Nonmetallic Grout: Factory-packaged, nonstaining, noncorrosive, nongaseous grout complying with ASTM C1107/C1107M. Provide grout specifically recommended by manufacturer for interior and exterior applications.

2.02 FABRICATION - GENERAL

- A. Fit and shop assemble items in largest practical sections, for delivery to site.
- B. Fabricate items with joints tightly fitted and secured.
- C. Continuously seal joined members by continuous welds.
- D. Grind exposed joints flush and smooth with adjacent finish surface. Make exposed joints butt tight, flush, and hairline. Ease exposed edges to small uniform radius.
- E. Exposed Mechanical Fastenings: Flush countersunk screws or bolts; unobtrusively located; consistent with design of component, except where specifically noted otherwise.
- F. Supply components required for anchorage of fabrications. Fabricate anchors and related components of same material and finish as fabrication, except where specifically noted otherwise.

2.03 LOOSE STEEL LINTELS

- A. General:
 - 1. Fabricate loose steel lintels from steel angles, plates, and other shapes as indicated.
 - a. Weld adjoining members together to form a single unit.
 - 2. Size loose steel lintels to provide bearing length at each side of openings equal to 1/12 of clear span but not less than 8 inches, unless otherwise indicated.

3. Galvanize loose steel lintels located in exterior walls.
 4. Prime loose steel lintels located in interior walls.
 5. Provide lintels at openings for all equipment and ductwork.
- B. See Structural Drawings and/or Specifications for masonry and loose steel lintel schedules.

2.04 MISCELLANEOUS FRAMING AND SUPPORTS

- A. General: Provide steel framing and supports not specified in other Sections as needed to complete the Work.
- B. Fabricate to sizes, shapes, and profiles indicated and as necessary to receive adjacent construction.
1. Fabricate units from slotted channel framing where indicated.
- C. Finish: Prime painted unless otherwise indicated or at an exterior location.
- D. Fabricate support for suspended toilet partitions as follows:
1. Beams: Continuous steel shapes of size required to limit deflection to L/360 between hangers, but use not less than C8x11.5 channels or another shape with equivalent structural properties.
 2. Hangers: Steel rods, 1/2 inch in diameter, spaced not more than 36 inches o.c.
 - a. Thread rods to receive anchor and stop nuts.
 - b. Fit hangers with wedge shape washers for full bearing on sloping flanges of support beam.
 3. Braces and Angles: Steel angles of size required to rigidly brace and support beams.
- E. Roof Openings: Unless otherwise indicated, provide steel support framing for roof openings as follows:
1. Provide steel support framing around entire perimeter of roof opening; span support framing between primary framing or purlins.
 2. Size steel framing not less than the following for spans indicated:
 - a. Up to 5 feet: C4x5.4 or L4x4x1/4.
 - b. 5 to 7 feet: C5x6.7 or L5x3-1/2x1/4 (LLV).
 - c. 7 to 10 feet: C6x8.2 or L6x3-1/2x5/16 (LLV).
 - d. Refer to Drawings for conditions other than those listed above.
 3. Limit deflection to L/240.

2.05 DOWNSPOUT BOOTS

- A. Downspout Boots: Smooth interior without boxed corners or choke points; include integral lug slots, integral cleanout, cleanout cover, and tamper proof fasteners.
1. Configuration: Angular.
 2. Material: Cast iron; ASTM A48/A48M; casting thickness 3/8 inch (9.5 mm), minimum.

2.06 MISCELLANEOUS

- A. Protective Coating: Zinc molybdate alkyd.
- B. Shop and Touch-Up Primer: SSPC-Paint 15, complying with VOC limitations of authorities having jurisdiction.

2.07 FINISHES - STEEL

- A. Prepare surfaces to be primed in accordance with SSPC-SP2.
- B. Clean surfaces of rust, scale, grease, and foreign matter prior to finishing.
- C. Prime Painting: One coat.
1. Provide at all fabrications except at galvanized locations and where otherwise indicated.
- D. Where indicated, galvanizing of Structural Steel Members: Galvanize after fabrication to ASTM A123/A123M requirements. Provide minimum 1.7 oz/sq ft galvanized coating.
1. Locations: All exterior locations and elsewhere as indicated.
- E. Where indicated, galvanizing of Non-structural Items: Galvanize after fabrication to ASTM A123/A123M requirements. Provide minimum 1.7 oz/sq ft galvanized coating.
1. Locations: All exterior locations and elsewhere as indicated.

2.08 FABRICATION TOLERANCES

- A. Squareness: 1/8 inch maximum difference in diagonal measurements.
- B. Maximum Offset Between Faces: 1/16 inch.
- C. Maximum Misalignment of Adjacent Members: 1/16 inch.
- D. Maximum Bow: 1/8 inch in 48 inches.
- E. Maximum Deviation From Plane: 1/16 inch in 48 inches.

2.09 MATERIALS – ALUMINUM **ADD1**

- A. Sheet Aluminum: ASTM B209, 5052 alloy, H32 or H22 temper.
- B. Welding Materials: AWS D1.2/D1.2M; type required for materials being welded.
- C. Provide sheet metal without pitting, seam marks, roller marks, stains, discolorations, or other imperfections exposed to view on finished units.

2.10 ALUMINUM BRAKE METAL TRIM **ADD1**

- A. General: Fabricate sheet metal trim to comply with recommendations in SMACNA's "Architectural Sheet Metal Manual" that apply to design, dimensions, metal, and other characteristics of item indicated. Shop fabricate items where practicable. Obtain field measurements for accurate fit before shop fabrication.
- B. Fabricate sheet metal trim in thickness or weight needed to comply with performance requirements, but not less than that specified for each application and metal.
- C. Fabricate sheet metal trim without excessive oil canning, buckling, and tool marks and true to line and levels indicated, with exposed edges folded back to form hems.
 - 1. Seams for Aluminum: Fabricate nonmoving seams with flat-lock seams. Form seams and seal with epoxy seam sealer. Rivet joints for additional strength.
- D. Sealed Joints: Form nonexpansion but movable joints in metal to accommodate elastomeric sealant to comply with SMACNA recommendations.
- E. Expansion provisions: Where lapped or bayonet-type expansion provisions in the Work cannot be used, form expansion joints of intermeshing hooked flanges, not less than 1 inch deep, filled with elastomeric sealant concealed within joints.
- F. Conceal fasteners and expansion provisions where possible on exposed-to-view sheet metal trim, unless otherwise indicated.
- G. Fabricate cleats and attachment devices from same material as accessory being anchored or from compatible, noncorrosive metal.
 - 1. Thickness: As recommended by SMACNA's "Architectural Sheet Metal Manual" for application but not less than thickness of metal being secured.
- H. Finishes:
 - 1. Class I Color Anodized Finish: AAMA 611 AA-M12C22A42 Integrally colored anodic coating not less than 0.7 mils thick.
 - 2. Touch-Up materials: As recommended by coating manufacturer for field application.

PART 3 EXECUTION**3.01 EXAMINATION**

- A. Verify that field conditions are acceptable and are ready to receive work.

3.02 PREPARATION

- A. Clean and strip primed steel items to bare metal where site welding is required.
- B. Supply setting templates to the appropriate entities for steel items required to be cast into concrete or embedded in masonry.

3.03 INSTALLATION - GENERAL

- A. Install items plumb and level, accurately fitted, free from distortion or defects.
- B. Provide for erection loads, and for sufficient temporary bracing to maintain true alignment until completion of erection and installation of permanent attachments.

- C. Field weld components as indicated on shop drawings.
- D. Perform field welding in accordance with AWS D1.1/D1.1M.
- E. Obtain approval prior to site cutting or making adjustments not scheduled.
- F. After erection, prime welds, abrasions, and surfaces not shop primed or galvanized, except surfaces to be in contact with concrete.

3.04 MISCELLANEOUS FRAMING AND SUPPORTS

- A. Install framing and supports to comply with requirements of items being supported, including manufacturers' written instructions and requirements indicated on Shop Drawings.

3.05 TOLERANCES

- A. Maximum Variation From Plumb: 1/4 inch per story, non-cumulative.
- B. Maximum Offset From True Alignment: 1/4 inch.
- C. Maximum Out-of-Position: 1/4 inch.

END OF SECTION

SECTION 33 4416 – UTILITY TROUGH DRAIN SYSTEM

PART 1 - GENERAL

1.1 SUMMARY

- A. This Section is a part of the entire set of Contract Documents and shall be coordinated with the applicable provisions of the other parts.
- B. Related Sections:
 - 1. Section 03 3005 Cast In Place Concrete
 - 2. Section 33 4605 Subdrainage Systems
 - 3. Section 33 4615 Subdrainage Systems – Turf Drintile

1.2 SCOPE

- A. The work under this section of the specifications shall include all materials, labor and equipment necessary to install a pre-cast, chemical-resistant polyester concrete trough drainage systems as specified, and as shown on the Contract Documents.

1.3 QUALITY ASSURANCE

- A. Manufacturer shall certify that the polymer concrete used meets the strength values of Section 2.1 B.

1.4 SUBMITTALS

- A. Manufacturer will submit, when required, shop drawings showing a schematic plan of the total drainage system listing all parts being provided with exact center-line dimensions suitable for installation. Copies of the manufacturer's recommended method of installation, and assembly shall be submitted for review. Contractor shall obtain arc radius units where they apply.
- B. Manufacturer shall submit a list of projects installed locally during the past five years.

PART 2 - PRODUCTS

2.1 TROUGH DRAIN - TRACK

- A. Manufacturer shall be one of the following or (approved equal):

<u>Manufacturer:</u>	<u>Model:</u>
1. ACO Polymer Products, Inc. Chagrin Falls, Ohio (216) 247-2033	System 4000 Grate Color: Black
2. SportsField Specialities Delhi, NY (888) 975-3343	Sport 4000 Grate Color: Black
3. SportsEdge Troutman, NC (800) 334-6057	Pro "S" Trench Drain Grate Color: Black
- B. Product shall be a one piece polymer concrete grated drain incorporating anti-slip, ADA compatible locking grate. Trench drain channels shall be pre-cast, and interlocking, incorporating either polyester or vinyl ester resins and formulated aggregate.

Overall Width	-	6.1 in
Internal Width	-	4.0 in
Unit Depth	-	6.0 in (nominal)
Compressive Strength	-	14,000 - 14,500 PSI
Flexural Strength	-	3,600 - 4,500 PSI

Tensile Strength - 1,500 PSI

2.2 TROUGH DRAIN – LANDSCAPE **ADD1**

- A. Manufacturer shall be one of the following or (approved equal):

Manufacturer:

Model:

4. ACO Polymer Products, Inc.
Chagrin Falls, Ohio
(216) 247-2033

System: KlassikDrain
Grate Color: Black

- B. Product shall be a one piece polymer concrete grated drain incorporating anti-slip, ADA compatible locking grate. Trench drain channels shall be pre-cast, and interlocking, incorporating either polyester or vinyl ester resins and formulated aggregate.

Internal Width - 4.0 in

Load Class - A

Grate: Black Plastic Longitudinal, ADA

PART 3 - EXECUTION

3.1 SITE PREPARATION

- A. Excavate the area for channel placement wide and deep enough to accommodate the channel size and a minimum of 4 inch concrete encasement (channels require a minimum of 4 inches of concrete support and top of grate must be evenly aligned to the surface of the surrounding slab) on both sides as well as underneath the channel.

3.2 INSTALLATION

- A. Channel sections are installed from the outlet end of the system, working from either catch basins or other outlets. Insert channels to interlock ends. Channel sections shall be placed on brick, rebar basket, or low slump concrete slurry, to obtain correct finished elevation. Cutting will be made if required, by masonry or concrete saw. Saw cut relief joints at every third (3rd) section channel (± 10). Install drain system in strict accordance with manufacturer's recommendations and shop drawings.


3.3 CONCRETE PLACEMENT

- A. Protect the top of the channel against the concrete or other abutting materials during setting. Place concrete in a manner that will not dislodge the channels. Concrete shall be at finished level with the top of the grate to ensure efficient drainage and adequate grate edge protection.

3.4 FINISHING AND CLEAN-UP

- A. Following final set of concrete, remove channel protection, if used.

END OF SECTION

			<div><p>ARCHITECTURE</p><p>T M P ARCHITECTURE I N C</p><p>1191 WEST SQUARE LAKE ROAD · BLOOMFIELD HILLS · MICHIGAN · 48302</p><p>PH · 248.338.4561 FX · 248.338.0223 EM · INFO @TMP-ARCHITECTURE.COM</p></div>						
<div>ATHENS HIGH SCHOOL ATHLETIC FIELDS</div> <div>TROY SCHOOL DISTRICT - TROY, MICHIGAN 48098</div>									
<div>2022 BOND PROGRAM - BID PACKAGE NO. 02A</div> <div>PROJECT NUMBER 22103D</div> <div>CONSTRUCTION DOCUMENTS</div>									
<div>CONSULTANTS:</div> <div>CIVIL ENGINEER</div> <div>PEA GROUP CONSULTING ENGINEERS</div> <div>1849 POND RUN AUBURN HILLS, MICHIGAN 48326 PHONE: (248) 889-9090</div> <div>LANDSCAPE ARCHITECT</div> <div>FORESITE DESIGN, INC. LANDSCAPE ARCHITECTS</div> <div>3269 COOLIDGE HIGHWAY BERKLEY, MICHIGAN 48072 PHONE: (248) 547-7757 FAX: (248) 547-0218</div>		<div>LIST OF DRAWINGS</div> <div>GENERAL INFORMATION</div> <div>TS.1 COVER SHEET</div> <div>TG.1 GENERAL INFORMATION</div> <div>CIVIL</div> <div>C-1.0 TOPOGRAPHIC SURVEY</div> <div>C-2.0 DEMOLITION PLAN</div> <div>C-3.0 DIMENSION AND PAVING PLAN</div> <div>C-4.0 GRADING PLAN - NORTH</div> <div>C-4.1 GRADING PLAN - EAST</div> <div>C-4.2 GRADING PLAN - SOUTH</div> <div>C-5.0 SOIL EROSION AND CONTROL PLAN</div> <div>C-5.1 PHASE II SECC PLAN</div> <div>C-6.0 UTILITY PLAN</div> <div>C-6.1 BASIN CALCS AND STRUCTURE TABLE</div> <div>C-7.0 UTILITY PROFILES</div> <div>C-7.1 UTILITY PROFILES</div> <div>C-8.0 DRAINAGE MAP</div> <div>C-9.0 NOTES AND DETAILS</div> <div>STANDARD SANITARY SEWER DETAILS (1 of 2)</div> <div>STANDARD SANITARY SEWER DETAILS (2 of 2)</div> <div>STANDARD SOIL EROSION CONTROL DETAILS</div> <div>STANDARD STORM SEWER DETAILS</div>	<div>ATHLETIC FIELDS</div> <div>L1.00 ATHLETICS SITE PLAN</div> <div>L1.01 ATHLETICS DIMENSION PLAN</div> <div>L1.02 ATHLETICS FENCE PLAN</div> <div>L1.03 ATHLETICS GRADING PLAN</div> <div>L1.04 ATHLETICS DRAINAGE PLAN</div> <div>L1.05 ATHLETICS SCHEMATIC IRRIGATION PLAN</div> <div>LD1.01 SITE DETAILS</div> <div>LD1.02 TRACK AND FIELD EVENT DETAILS</div> <div>LD1.03 TRACK AND FIELD EVENT DETAILS</div> <div>LD1.04 SYNTHETIC TURF FENCE DETAILS</div> <div>LD1.05 GENERAL FENCE DETAILS</div> <div>LD1.06 NETTING DETAILS</div> <div>LD1.07 VARSITY BACKSTOP DETAILS</div> <div>LD1.08 J.V. BACKSTOP DETAILS</div> <div>LD1.09 BULLPEN DETAILS</div> <div>LD1.10 BATTING CAGE DETAILS</div> <div>LD1.11 VARSITY DUGOUTS DETAILS</div> <div>LD1.12 J.V. DUGOUT DETAIL</div> <div>LD1.13 BASEBALL AND SOFTBALL TURF DETAILS</div> <div>LD1.14 BASEBALL TURF DETAILS</div> <div>LD1.15 BASEBALL TURF DETAILS</div> <div>LD1.16 STORAGE BUILDING DETAILS</div>	<div>STRUCTURAL</div> <div>S0.0 STRUCTURAL GENERAL NOTES</div> <div>S1.0 STRUCTURAL PLANS</div> <div>S4.1 CONCRETE DETAILS</div> <div>SS.1 MASONRY DETAILS</div>	<div>ARCHITECTURAL</div> <div>A0.1 DOOR AND FRAME SCHEDULE</div> <div>A1.1 FIRST LEVEL FLOOR PLAN</div> <div>A3.1 EXTERIOR ELEVATIONS AND SECTIONS</div> <div>A4.1 WALL SECTIONS</div> <div>A8.1 MASONRY DETAILS</div>	<div>MECHANICAL</div> <div>M0.1 MECHANICAL STANDARDS AND DRAWING INDEX</div> <div>M0.2 MECHANICAL NEW WORK SITE PLAN</div> <div>M2.0 STORAGE BUILDING UNDERGROUND PLUMBING PLAN</div> <div>M2.1 STORAGE BUILDING PLUMBING PLAN</div> <div>M4.1 STORAGE BUILDING SHEET METAL PLAN</div> <div>M6.1 MECHANICAL DETAILS</div> <div>M7.1 MECHANICAL SCHEDULES</div> <div>M7.2 MECHANICAL SCHEDULES</div> <div>M8.1 TEMPERATURE CONTROL STANDARDS AND GENERAL NOTES</div>	<div>ELECTRICAL</div> <div>E0.1 ELECTRICAL STANDARDS AND DRAWING INDEX</div> <div>E0.2 ELECTRICAL STANDARD SCHEDULES</div> <div>E0.3 ELECTRICAL NEW WORK SITE PLAN</div> <div>E2.1 STORAGE BUILDING LIGHTING PLAN</div> <div>E3.1 STORAGE BUILDING POWER AND AUXILIARY SYSTEMS PLAN</div> <div>ES.1 ONE LINE DIAGRAM AND PANEL SCHEDULES</div> <div>E7.1 ELECTRICAL DETAILS AND DIAGRAMS</div>	<div>PROJECT DATA:</div> <div>LOCATION MAP</div> <div>TO I-75</div> <div>E. LONG LAKE ROAD</div> <div>ROCHESTER ROAD</div> <div>ATHENS HS</div> <div>JOHN R. ROAD</div> <div>E. WATILES ROAD</div> <div>TROY, MI.</div> <div>NO SCALE</div> <div>N</div> <div>ADDRESS: ATHENS HIGH SCHOOL</div> <div>4333 JOHN R ROAD</div> <div>TROY, MICHIGAN 48085</div> <div>BUILDING:</div> <div>BUILDING AREA = 1,384 SQ. FT. (NEW)</div> <div>CODE:</div> <div>GOVERNING CODES:</div> <div>- 2016 SCHOOL FIRE SAFETY RULES</div> <div>(2012 Life Safety Code, plus amendments)</div> <div>- 2015 MICHIGAN BUILDING CODE</div> <div>- 2015 MICHIGAN REHABILITATION CODE FOR EXISTING BUILDINGS</div> <div>- 2018 MICHIGAN PLUMBING CODE</div> <div>- 2015 MICHIGAN MECHANICAL CODE</div> <div>- 2015 MICHIGAN UNIFORM ENERGY CODE</div> <div>(ANSI/ASHRAE/IES Standard 90.1-2013)</div> <div>- 2017 MICHIGAN ELECTRICAL CODE (2017 NEC, plus Part 8 Rules)</div> <div>- 2010 MICHIGAN ELEVATOR RULES</div> <div>(ASME A17.1-2010, ASME A18.1-2011)</div> <div>- MICHIGAN BARRIER FREE CODE</div> <div>(Michigan Building Code 2015 and ICC A117.1-2009)</div> <div>- 2013 MICHIGAN BOILER CODE RULES</div> <div>(ASME Boiler and Pressure Vessel Code, 2019 edition)</div> <div>(National Board Inspection Code [NBIC], 2019 edition)</div> <div>CONSTRUCTION CLASSIFICATION : V-B (MBC) V(000) (LSC)</div> <div>USE GROUP CLASSIFICATION : S-1 MODERATE-HAZARD STORAGE</div> <div>11-14-2025 ADDENDUM NO. 1</div> <div>12-10-2024 CONSTRUCTION DOCUMENTS</div> <div>DATE ISSUED FOR:</div>	
<div>LICENSEE'S STATEMENT:</div> <div>This Document has been prepared under the supervision of the Architect, as the person in Responsible Charge with the firm of TMP ARCHITECTURE, INC. An original embossed or rubber stamp seal and original signature of the Architect is required and shall be affixed to any copy of this Document submitted to a governmental agency for approval or record. This is in conformance with the State of Michigan's PA 299, Article 20 and the General Rules of the Board of Architects.</div> <div>The Architect's seal provided hereon does not take responsibility for certain portions of the Documentation or project requiring the services of a licensed Professional Engineer or other design professional. An original embossed or rubber stamp seal and original signature of the Professional Engineer is required and shall be affixed to any copy of this or other Document submitted to a governmental agency for approval or record. The engineering firms associated with this document are listed above as Consultants.</div>	<div>REGISTRATION SEALS</div>					<div>COPYRIGHT</div> <div>© The "architectural work" displayed on these documents is owned exclusively by TMP Architecture, Inc. and may not be used for any purpose without their involvement or express written consent.</div>	<div>PROJECT TITLE</div> <div>Athens High School Athletic Fields</div> <div>PROJECT NO.</div> <div>22103D</div> <div>DRAWING NO.</div> <div>TS.1</div>		



PROJECT TITLE

**Athens High School
Athletic Fields
Bld Package No. 02B**

Troy School District
Troy, Michigan

DRAWING TITLE
DEMOLITION PLAN

ISSUE DATES

01-14-2025	ADDENDUM NO. 1
12-10-2024	CONSTRUCTION DOCUMENTS

DATE: ISSUED FOR:

DRAWN JW

CHECKED	TD
---------	----


APPROVED	TD
----------	----

PROJECT NO.

22103D

DRAWING NO.

C-2.0

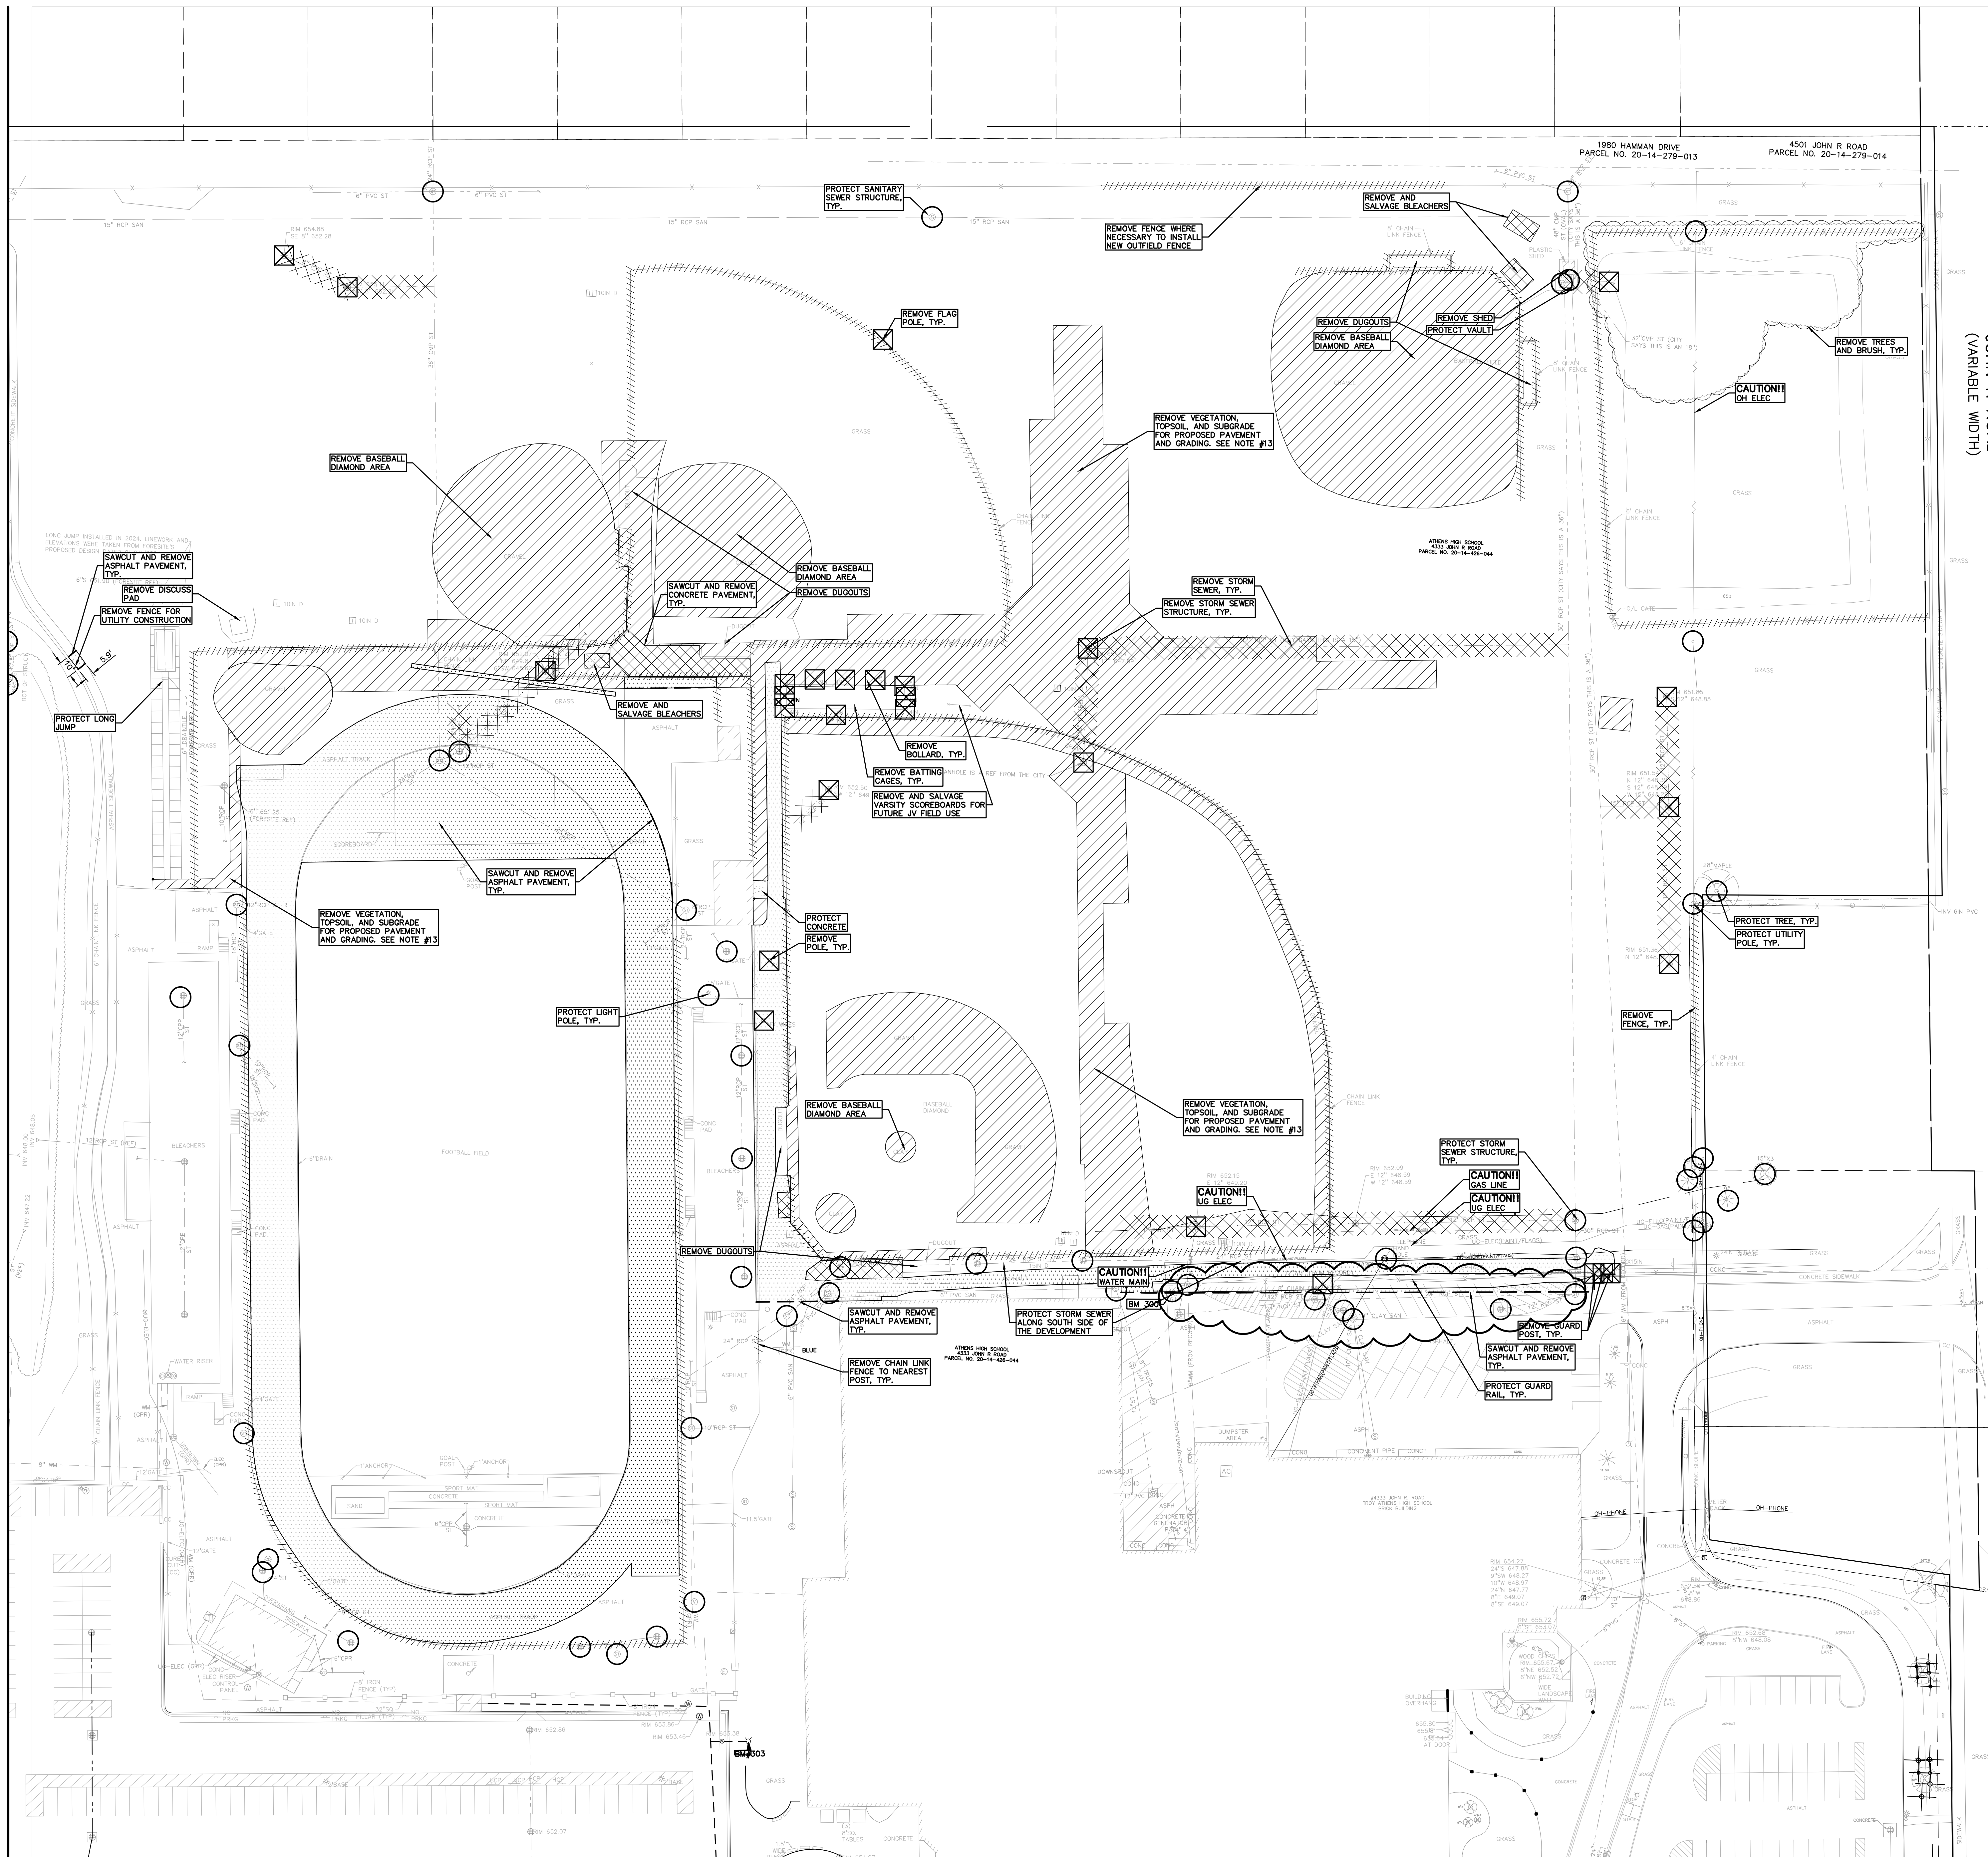

DEMOLITION LEGEND

ITEM TO BE PROTECTED

ITEM TO BE REMOVED

CURB/FENCE REMOVAL

CONCRETE PAVEMENT AND
SIDEWALK REMOVAL

AREA OR ITEMS TO
BE REMOVED

UTILITY REMOVAL

ABANDON UTILITY

ASPHALT REMOVAL

TREE REMOVAL

SAWCUT LINE

GENERAL DEMOLITION NOTES:

THESE NOTES APPLY TO ALL CONSTRUCTION ACTIVITIES ON THIS PROJECT:

1. ALL MATERIAL TO BE REMOVED, WHETHER SPECIFICALLY NOTED IN THE PLANS OR NOT, SHALL BE REMOVED FROM THE SITE BY THE CONTRACTOR AND DISPOSED OF AT AN OFFICIAL LANDFILL. NO ON-SITE BURY OR BURN PITS SHALL BE ALLOWED.
2. ALL DEMOLITION WORK SHALL CONFORM TO ALL LOCAL CODES AND ORDINANCES.
3. STAGING/PHASING OF DEMOLITION AND CONSTRUCTION TO BE COORDINATED WITH THE OWNER AND THE CONTRACTOR PRIOR TO CONSTRUCTION.
4. SPECIFIC DEMOLITION ITEMS HAVE BEEN INDICATED ON THE PLANS AS A GUIDE TO THE GENERAL SCOPE OF WORK. IT IS INTENDED THAT ALL SUCH ITEMS WILL BE COMPLETELY REMOVED BY THE CONTRACTOR ABOVE AND BELOW GROUND, UNLESS SPECIFICALLY NOTED OTHERWISE AND THAT THE CONTRACTOR SHALL BUT WILL NOT NECESSARILY BE LIMITED TO THESE ITEMS. THE CONTRACTOR SHALL MAINTAIN RECORD OF EXISTING CONDITIONS AND EXTENTS OF THE DEMOLITION THAT WILL BE REQUIRED PRIOR TO SUBMITTING A BID.
5. REMOVE ALL STRUCTURES DESIGNATED FOR REMOVAL ACCORDING TO THE LOCAL CODES. THIS INCLUDES FOUNDATIONS, CONCRETE, ASPHALT, TREES, ETC.
6. THE CONTRACTOR SHALL, AS A MINIMUM, PROVIDE TREE PROTECTION FENCING AROUND EXISTING TREES TO BE REMOVED AND WITHIN THE TREE PROTECTION ZONE FOR ACTIVITIES AND AS INDICATED IN THE PLANS OR PER LOCAL AGENCY REQUIREMENTS.
7. THE CONTRACTOR SHALL BE RESPONSIBLE FOR CLEAN UP AND RESTORE JUST CLOSURE OF THE SITE AND HOURS OF OPERATION IN ACCORDANCE WITH THE LOCAL CODES.
8. THE CONTRACTOR SHALL PROVIDE ALL NECESSARY EQUIPMENT, INCLUDING SIGNAGE, LIGHTS AND OTHER TRAFFIC CONTROL DEVICES TO PROTECT THE WORK ZONE AND SAFELY MAINTAIN TRAFFIC PER AGENCY REQUIREMENTS AND IN ACCORDANCE WITH THE LATEST EDITION OF THE STATE MANUAL OF UNIFORM TRAFFIC CONTROL DEVICES.
9. THE CONTRACTOR IS RESPONSIBLE FOR THE REMOVAL OF ALL REMNANTS OF SIGNS AND SUPPORTS WITHIN THE WORK AREA, AS NECESSARY TO FACILITATE THE CONTRACTOR'S WORK AND TO PREVENT THE WORK OR STOCKPILED FOR REUSE AS SPECIFIED IN THE PLANS OR AS REQUIRED BY THE AGENCY HAVING JURISDICTION OF THE PROJECT SITE. THE CONTRACTOR SHALL OWN, MAINTAIN AND SUPPORTS AT NO ADDITIONAL COST TO OWNER.
10. THE CONTRACTOR SHALL CONTACT THE APPROPRIATE UTILITY COMPANIES TO CONFIRM THAT UTILITY LEADS HAVE BEEN TAKEN OUT OF SERVICE PRIOR TO DEMOLITION.
11. THE CONTRACTOR SHALL NOTIFY THE APPROPRIATE 811/ONE CALL UTILITY LOCATING CENTER, PRIVATE UTILITY LOCATOR, THE CITY ENGINEER AND/OR THE AUTHORITY HAVING JURISDICTION 3 BUSINESS DAYS PRIOR TO THE BEGINNING OF CONSTRUCTION.
12. CONTRACTOR SHALL REFER TO THE "REPORT ON GEOTECHNICAL INVESTIGATION" PREPARED BY G2 CONSULTING GROUP DATED 11/7/2024 AND "REPORT ON GEOTECHNICAL INVESTIGATION" PREPARED BY G2 CONSULTING GROUP DATED 11/24/2024.
13. TOPSOIL REMOVED DURING DEMOLITION/MASS GRADING OPERATIONS SHALL BE STORED AT THE OWNER, 3RD PARTY TESTING COMPANY, AND/OR ENGINEER TO BE STOCKPILED ON SITE AND REUSED FOR OTHER PROJECT AREAS.

DEMOLITION QUANTITIES:

REMOVE ASPHALT	68,629 S
SAWCUT PAVEMENT	528 LF
REMOVE DUGOUTS	1 EA
REMOVE GUARD POST	13 EA
REMOVE VEGETATION, TOPSOIL, AND SUBGRADE	50,108 S
REMOVE FENCE	5,182 LF
REMOVE FLAG POLE	1 EA
REMOVE GRAVEL	56,930 S
REMOVE STORM SEWER PIPE	1,159 LF
REMOVE STORM STRUCTURES	12 EA
REMOVE SHED	1 EA

ALLOWANCE:	
REMOVE STORM SEWER PIPE	200 LF





PROJECT TITLE
**Athens High School
Athletic Fields
Bld Package No. 02B**

Troy School District
Troy, Michigan

DRAWING TITLE
**DIMENSION AND
PAVING PLAN**

ISSUE DATES

01-14-2025	ADDENDUM NO. 1
------------	----------------

DATE: ISSUED FOR:


DRAWN JW

CHECKED	TD
---------	----

PROJECT NO.
22103D

DRAWING NO.

C-3.0

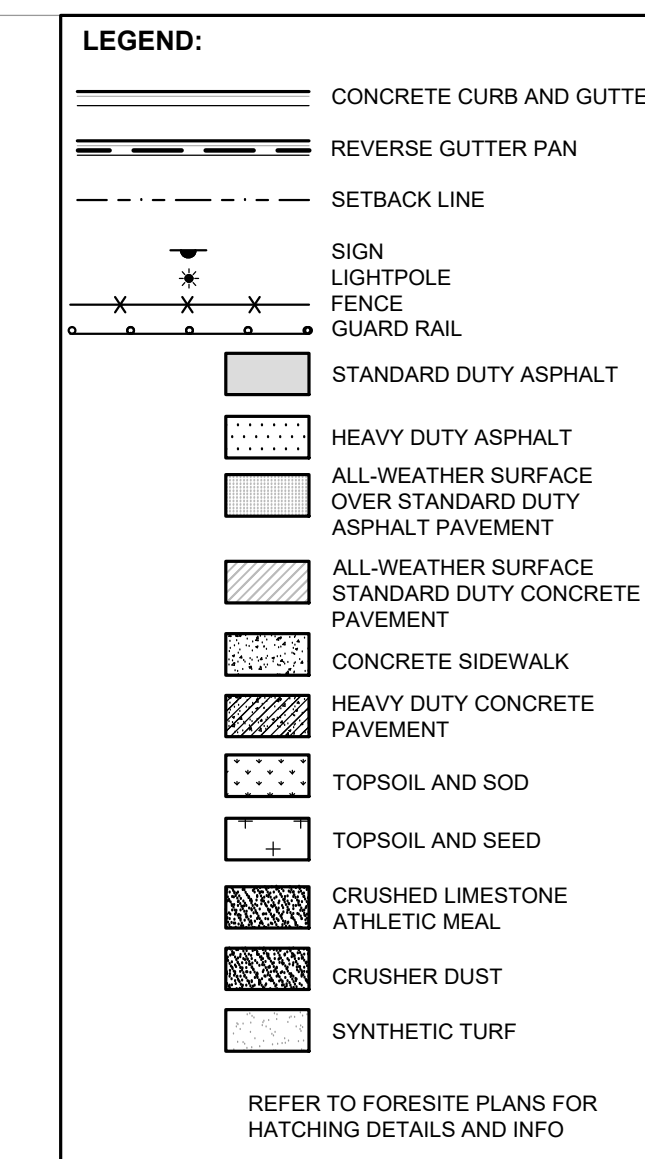


PAYEMENT PREPARATION NOTES

1. PAVEMENT PREPARATION SHALL FOLLOW THE PROCESS SUMMARIZED BELOW:
 - 1.1. PART OF THE EXISTING REMOVAL, REMOVE THE EXISTING PAVEMENT AND AGGREGATE BASE REQUIRED FOR THE PROPOSED THICKNESS OF ASPHALT/CONCRETE PAVEMENT TO BE PLACED. ANY REMAINING EXISTING PAVEMENT TO REMAIN ABOVE THE ELEVATION WILL BE PART OF THE EARTHWORKS FOR THE PAWING OPERATION, WILL NOT BE PAID FOR AND WILL BE RE-USED IN THE SUBGRADE.
 - 1.2. THE SUBGRADE UNDERCUTTING PAY ITEM AND WILL BE INCLUDED IN THE BASE BID FOR THE WORK.
 - 1.3. ANY OF THE EXISTING AGGREGATE BASE SHALL BE REMOVED, THEREFORE THE PROPOSED PAVEMENT, AS DESCRIBED IN ITEM 1.1, AND DEEMED ACCEPTABLE BY A QUALIFIED ENGINEER, SHALL BE RE-USED AND COMPRISED FOR RE-USE IN THE PAVEMENT OPERATION.
- 1.3. PROOF ROLL EXISTING BASE AND SUBGRADE PER PLANS, SPECIFICATIONS AND GEOTECH REPORT.
- 1.4. DETERMINE AREAS THAT FAIL THE PROOF ROLL TESTS AND DETERMINE THE EXTENT OF REQUIRED ENGINEERING TECHNICIAN TO DETERMINE IF SUBGRADE STABILIZATION IS NECESSARY. DRAIN THE AREA AND RE-USE EXISTING AGGREGATE BASE AND CONNECTED TO THE CLOSEST CATCH BASIN TO PREVENT GROUNDWATER FROM POOLING WITHIN THE AREA. THE AREA IS NOT TO BE CREATING "BATHTUBS" IN THE COHESIVE SOLS.
- 1.5. TO MINIMIZE INSTABILITY AND UNDERCUTS, THE AGGREGATE BASE SHALL NOT BE LEFT EXPOSED TO WEATHER FOR MORE THAN 30 DAYS. STABILIZATION SHOULD BE PERFORMED DURING THE SUMMER MONTHS TO ENSURE DRY, WARM, WEATHER. ADDITIONAL STABILIZATION WILL BE REQUIRED IF UNSTABLE UNDER REPEATED LOADING OF CONSTRUCTION TRAFFIC; THEREFORE, CONSTRUCTION EQUIPMENT SHOULD BE LIMITED ON THE EXPOSED SUBGRADE.


PAVING QUANTITIES:	
VALLEY GUTTER PAV	347 LF
STANDARD UTILITY ASPHALT PAVEMENT	17,631
(THIS DOES NOT INCLUDE PAVEMENT IN TRACK AREA)	
CONCRETE SIDEWALK	29,670
STANDARD UTILITY CONCRETE	22,630
BUTT JOINT	700 LF
CONCRETE CURB SPILLWAY	1 EA
POUR IN PLACE WALL WITH FENCE AND 6" CURB	635 LF
 ALLOWANCE:	
SUBGRADE UNDERCUT ALLOWANCE	2,040 CY
SUBGRADE UNDERCUT DRAIN TILE (4")	
ALLOWANCE	2,000 LF

NOTES:

1. CONTRACTOR TO VERIFY ALL QUANTITIES SHOWN ON THE PLANS, AND DEVIATIONS THE PLAN QUANTITIES SHALL BE PROVIDED TO THE ATTENTION OF THE DISTRICT AND PEA GROUP, IN WRITING PRIOR TO THE BID PACKAGE, FOR VERIFICATION PRIOR TO BIDDING.
2. ALL DIMENSIONS SHOWN ARE TO BACK OF CURB, FACE OF SIDEWALK, CENTER OF MANHOLE/CATCH BASIN UNLESS OTHERWISE NOTED.
3. DOWEL INTO EXISTING CURB AND GUTTER WITH EPOXY COATED #4 BAR CONTINUOUSLY BETWEEN EXISTING PRECAST CURBS.
4. CONTRACTOR TO FIELD VERIFY ALL UNDERGROUND UTILITIES PRIOR TO CONSTRUCTION INCLUDING, BUT NOT LIMITED TO: SITE LIGHTING, FIBER LINES, ETC.
5. REFER TO NOTES AND DETAIL SHEETS FOR ON SITE PAVING DETAILS.
6. FOR THE FOUR (4) CATCH BASINS IN THE WORK AREA, BIDDERS ARE TO INCLUDE RECONSTRUCTION OF EXISTING CURBS (GREATER THAN 12-INCHES IN DEPTH FOR RM ELEVATION) AND REPAIR OF THE BASE BID. THE SUCCESSFUL BIDDER SHALL BE PAID FOR REPAIRING EACH OF THE STRUCTURE BASED ON THE ACTUAL DEPTH OF REPAIR WITH EITHER STRUCTURAL ADJUSTMENT (WITHIN 12-INCHES OF RM ELEVATION) OR STRUCTURAL RECONSTRUCTION (DEPTHS GREATER THAN 12-INCHES IN DEPTH) PER THE UNIT PRICE PROVIDED IN THE BID PACKAGE AND THE SCOPE OF WORKS DERIVED FROM THE APPROVED REPORT TO THE WORK COMMITTEE. REPLACEMENT OF THE ENTIRE STRUCTURE SHALL BE INCLUDED IN THE UNIT PRICE FOR BOTH STRUCTURAL ADJUSTMENT AND STRUCTURAL RECONSTRUCTION.
7. ALL PROPOSED ADA RAMPS SHALL HAVE TRUNCATED DOMES. EITHER PLASTIC OR METAL STYLE DOMES ARE BOTH ACCEPTABLE.
8. CONTRACTOR SHALL REFER TO THE "REPORT ON GEOTECHNICAL INVESTIGATION" PREPARED BY G2 CONSULTING GROUP DATED 11/07/2024 AND THE "REPORT ON GEOTECHNICAL INVESTIGATION" PREPARED BY G2 CONSULTING GROUP DATED 11/28/2024.

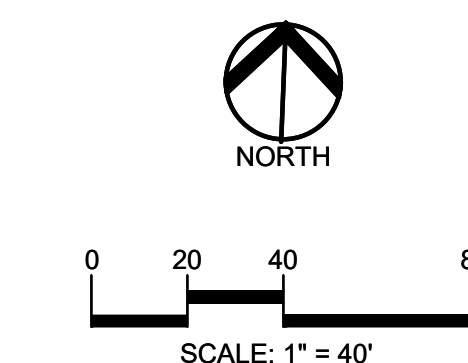

Drawing File: S:\PROJECTS\2023\23-031 Troy Schools 2022 BIDDING\CONSTRUCTION\Troy Athletics\Troy Athletics - 2025\G-4\GRADE-23-031-nh.dwg
Jan 14, 2025 - 10:53am

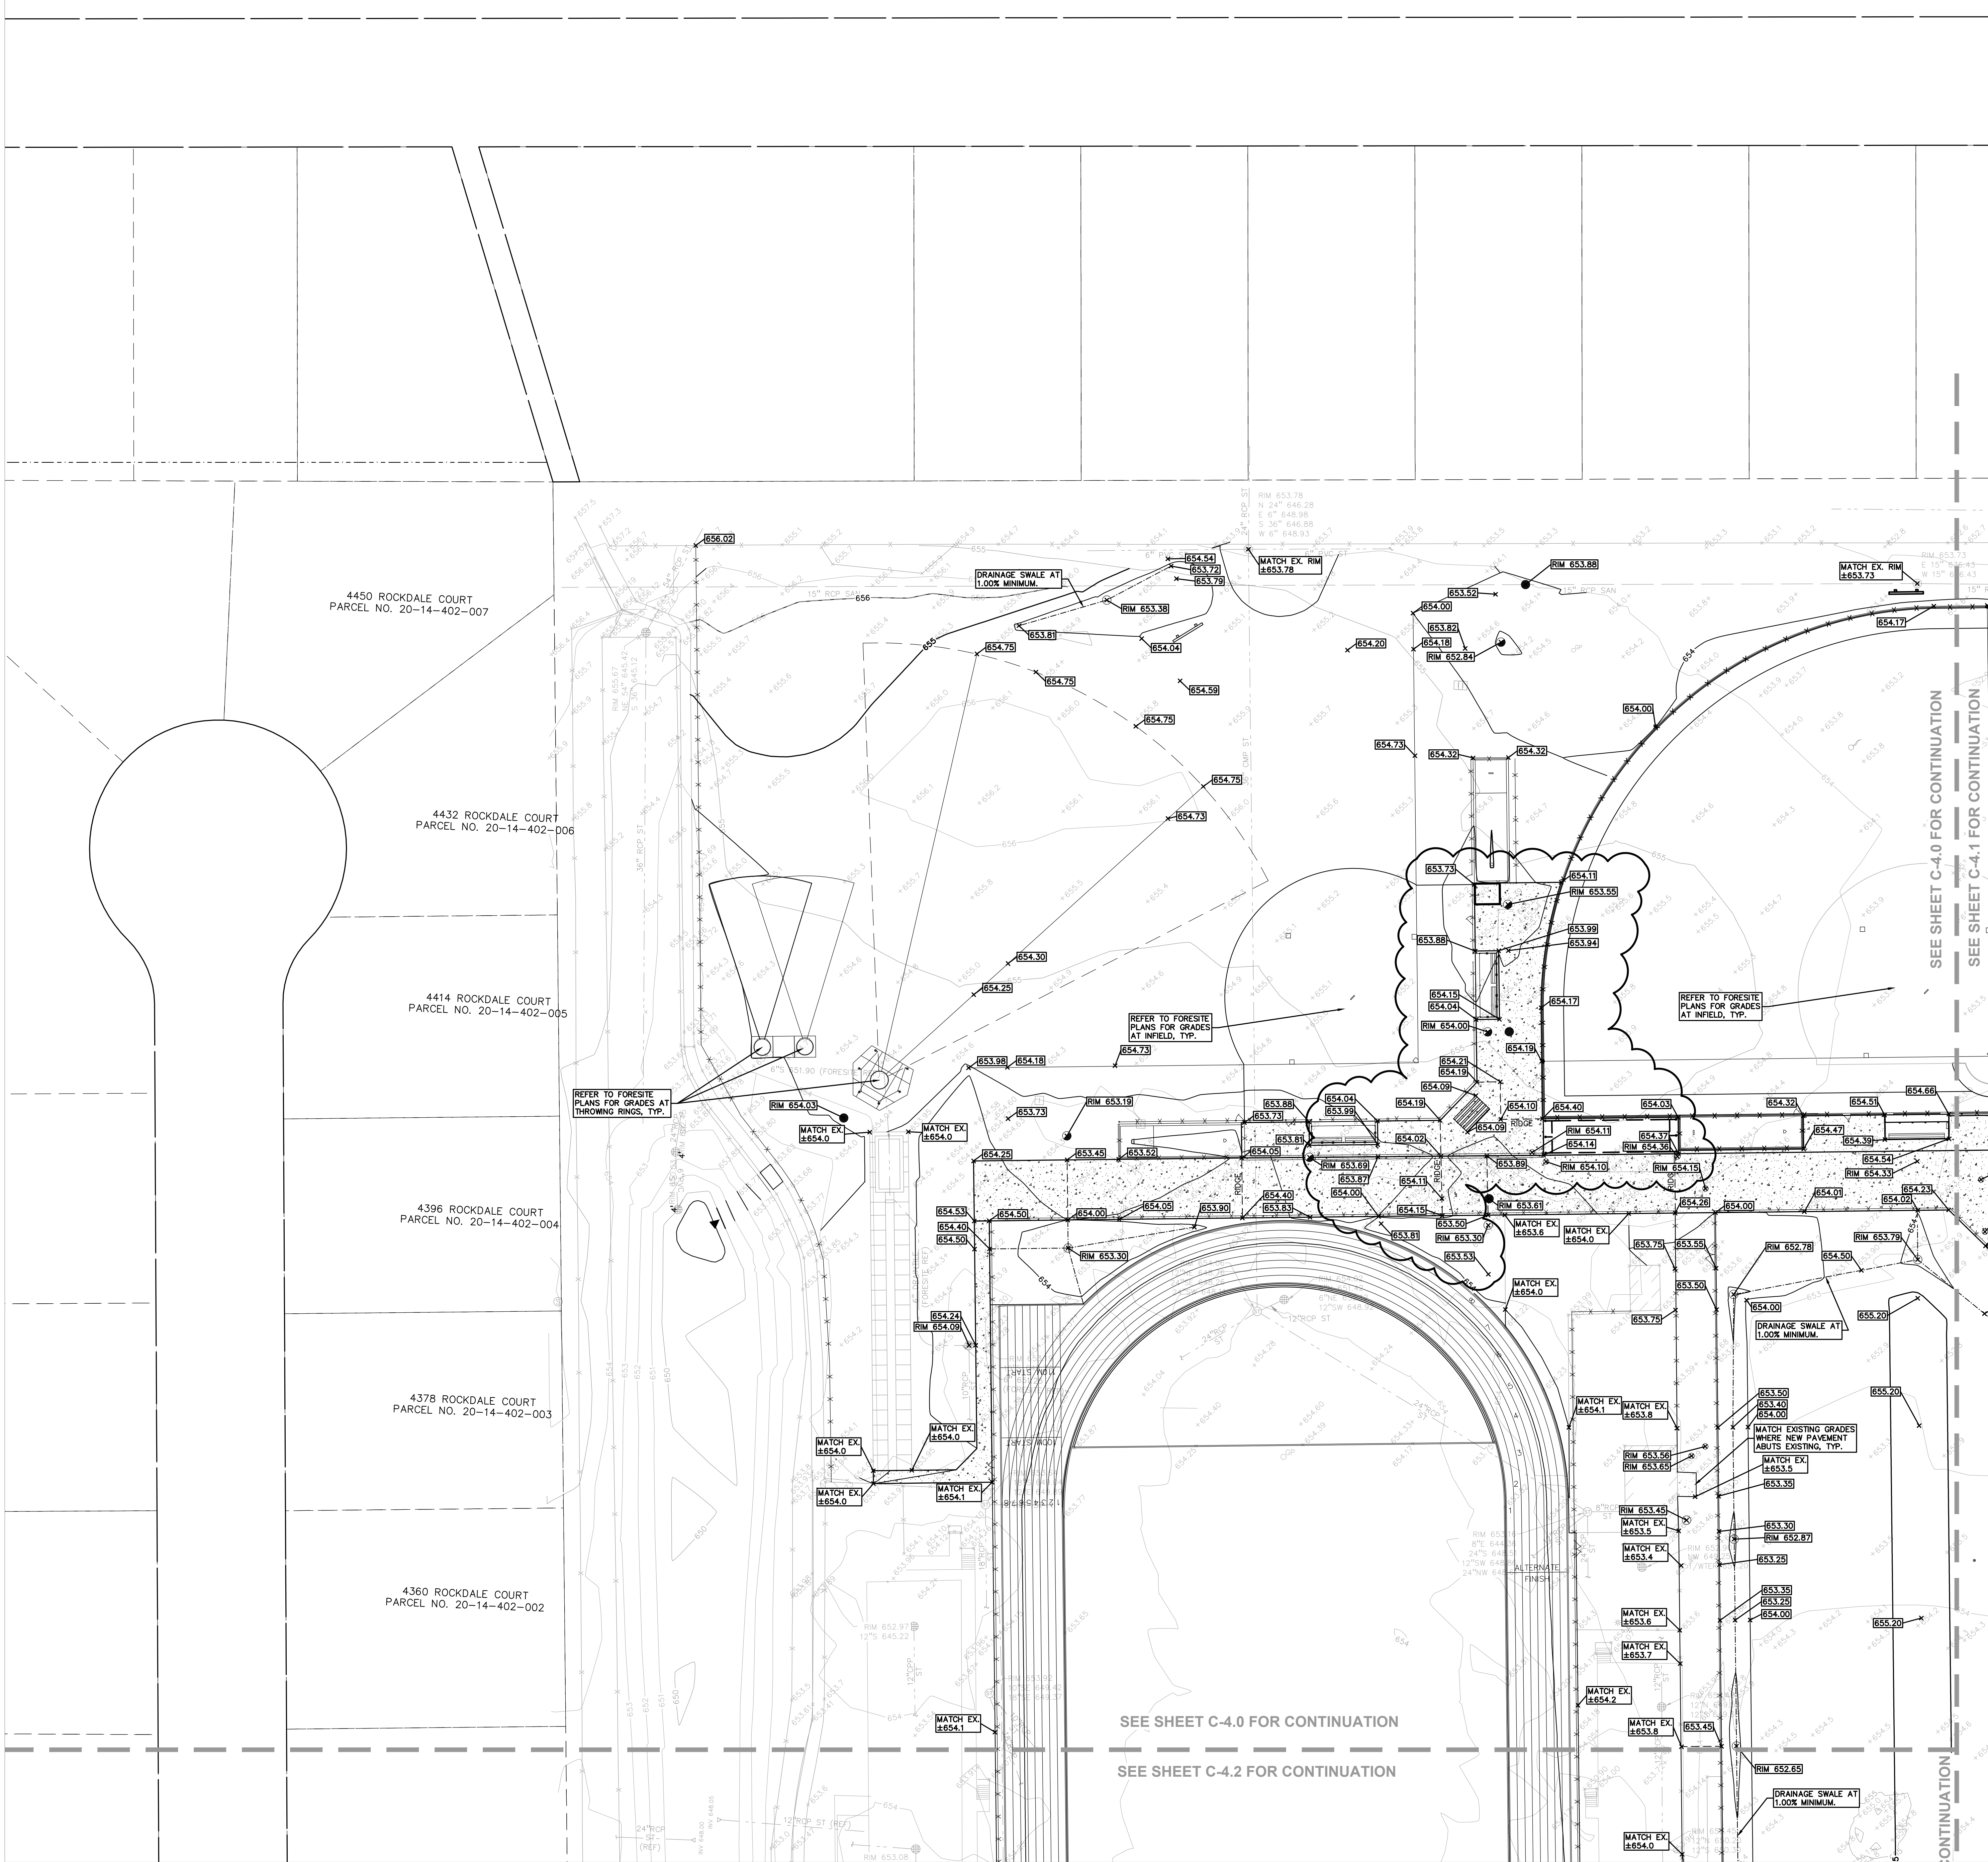

GRADING LEGEND:

EXISTING SPOT ELEVATION
PROPOSED SPOT ELEVATION:
TYPICALLY TOP OF PAVEMENT
IN PAVED AREAS, GUTTER GRADE
IN CURB LINES
EXISTING CONTOUR
PROPOSED CONTOUR
PROPOSED REVERSE GUTTER PAN
PROPOSED RIDGE LINE
PROPOSED SWALE/DITCH

ABBREVIATIONS

T/C = TOP OF CURB
T/P = TOP OF PAVEMENT
T/S = TOP OF SIDEWALK
T/W = TOP OF WALL
G = GUTTER GRADE
F.G. = FINISH GRADE
RIM = RIM ELEVATION
BW = BOTTOM OF WALL
REFER TO GRADING NOTES ON SHEET C-8.0.

RETAINING WALL NOTE:

TOP OF WALL (T/W) AND BOTTOM OF WALL (B/W) GRADES ARE THE FINISH GRADE AT THE TOP AND BOTTOM OF THE RETAINING WALL, NOT ACTUAL TOP AND BOTTOM OF THE WALL STRUCTURE.

EARTHWORK BALANCING NOTE:

THE CONTRACTOR SHALL BE RESPONSIBLE FOR IMPORTING OR EXPORTING ALL MATERIALS AS REQUIRED TO PROPERLY GRADE THIS PROJECT TO THE FINISHED ELEVATIONS SHOWN ON THE APPROVED PLANS. THE CONTRACTOR SHALL MAKE THEIR OWN DETERMINATION OF CUT AND FILL QUANTITIES AND ALLOW FOR REMOVAL OF EXCESS OR IMPORTATION OF ADDITIONAL MATERIAL AT NO ADDITIONAL COST TO THE OWNER.

BENCHMARKS
(GPS DERIVED - NAVD88)

BM#300
ARROW ON HYDRANT IN FRONT OF SCHOOL BUILDING, ±30' EAST NORTHEAST OF THE NORTHEAST CORNER OF BUILDING
ELEV. = 658.04

BM#301
ARROW ON HYDRANT IN THE NORTHWEST CORNER OF THE NORTHWEST PARKING LOT ±5 FEET SOUTH OF THE 8 FOOT CHAIN LINK FENCE, ±40 FEET EAST NORTHEAST OF THE BUILDING CORNER
ELEV. = 657.14

BM#302
ARROW ON DIMPLE ON A HYDRANT LOCATED APPROX. 109'± SOUTH OF THE SCHOOL AUDITORIUM, ON THE NORTH SIDE OF ENTRANCE DRIVE TO THE STUDENT PARKING LOT, APPROX. 680'± WEST OF THE CENTERLINE OF JOHN R ROAD.
ELEV. = 655.46

BM#303
ARROW ON DIMPLE ON A HYDRANT LOCATED SOUTHEAST OF THE FOOTBALL FIELD/TRACK, APPROX. 36.5'± WEST OF THE BUILDING, NORTH OF THE AUDITORIUM ENTRANCE.
ELEV. = 656.70



TMP ARCHITECTURE INC
1191 WEST SQUARE LAKE ROAD
BLOOMFIELD HILLS - MICHIGAN - 48302
PH - 248.338.4561 FX - 248.338.0223
EM - INFO@TMP-ARCHITECTURE.COM



CONSULTANT

PEA GROUP
t: 844.813.2949
www.peagroup.com

PROJECT TITLE
**Athens High School
Athletic Fields
Bld Package No. 02B**

**Troy School District
Troy, Michigan**

DRAWING TITLE
**GRADING PLAN -
NORTH**

ISSUE DATES

01-14-2025 ADDENDUM NO. 1

12-10-2024 CONSTRUCTION DOCUMENTS

DATE ISSUED FOR:

DRAWN JW

CHECKED TD

APPROVED TD


PROJECT NO.

22103D

DRAWING NO.

C-4.0

Drawing File: S:\PROJECTS\2023\03-031 TROY SCHOOL DISTRICT 2022 BIDDING\CONSTRUCTION\TROY ATHLETIC FIELDS - 2023\03-031\03-031-001-001-001.dwg
Jan 14, 2025 - 10:53am

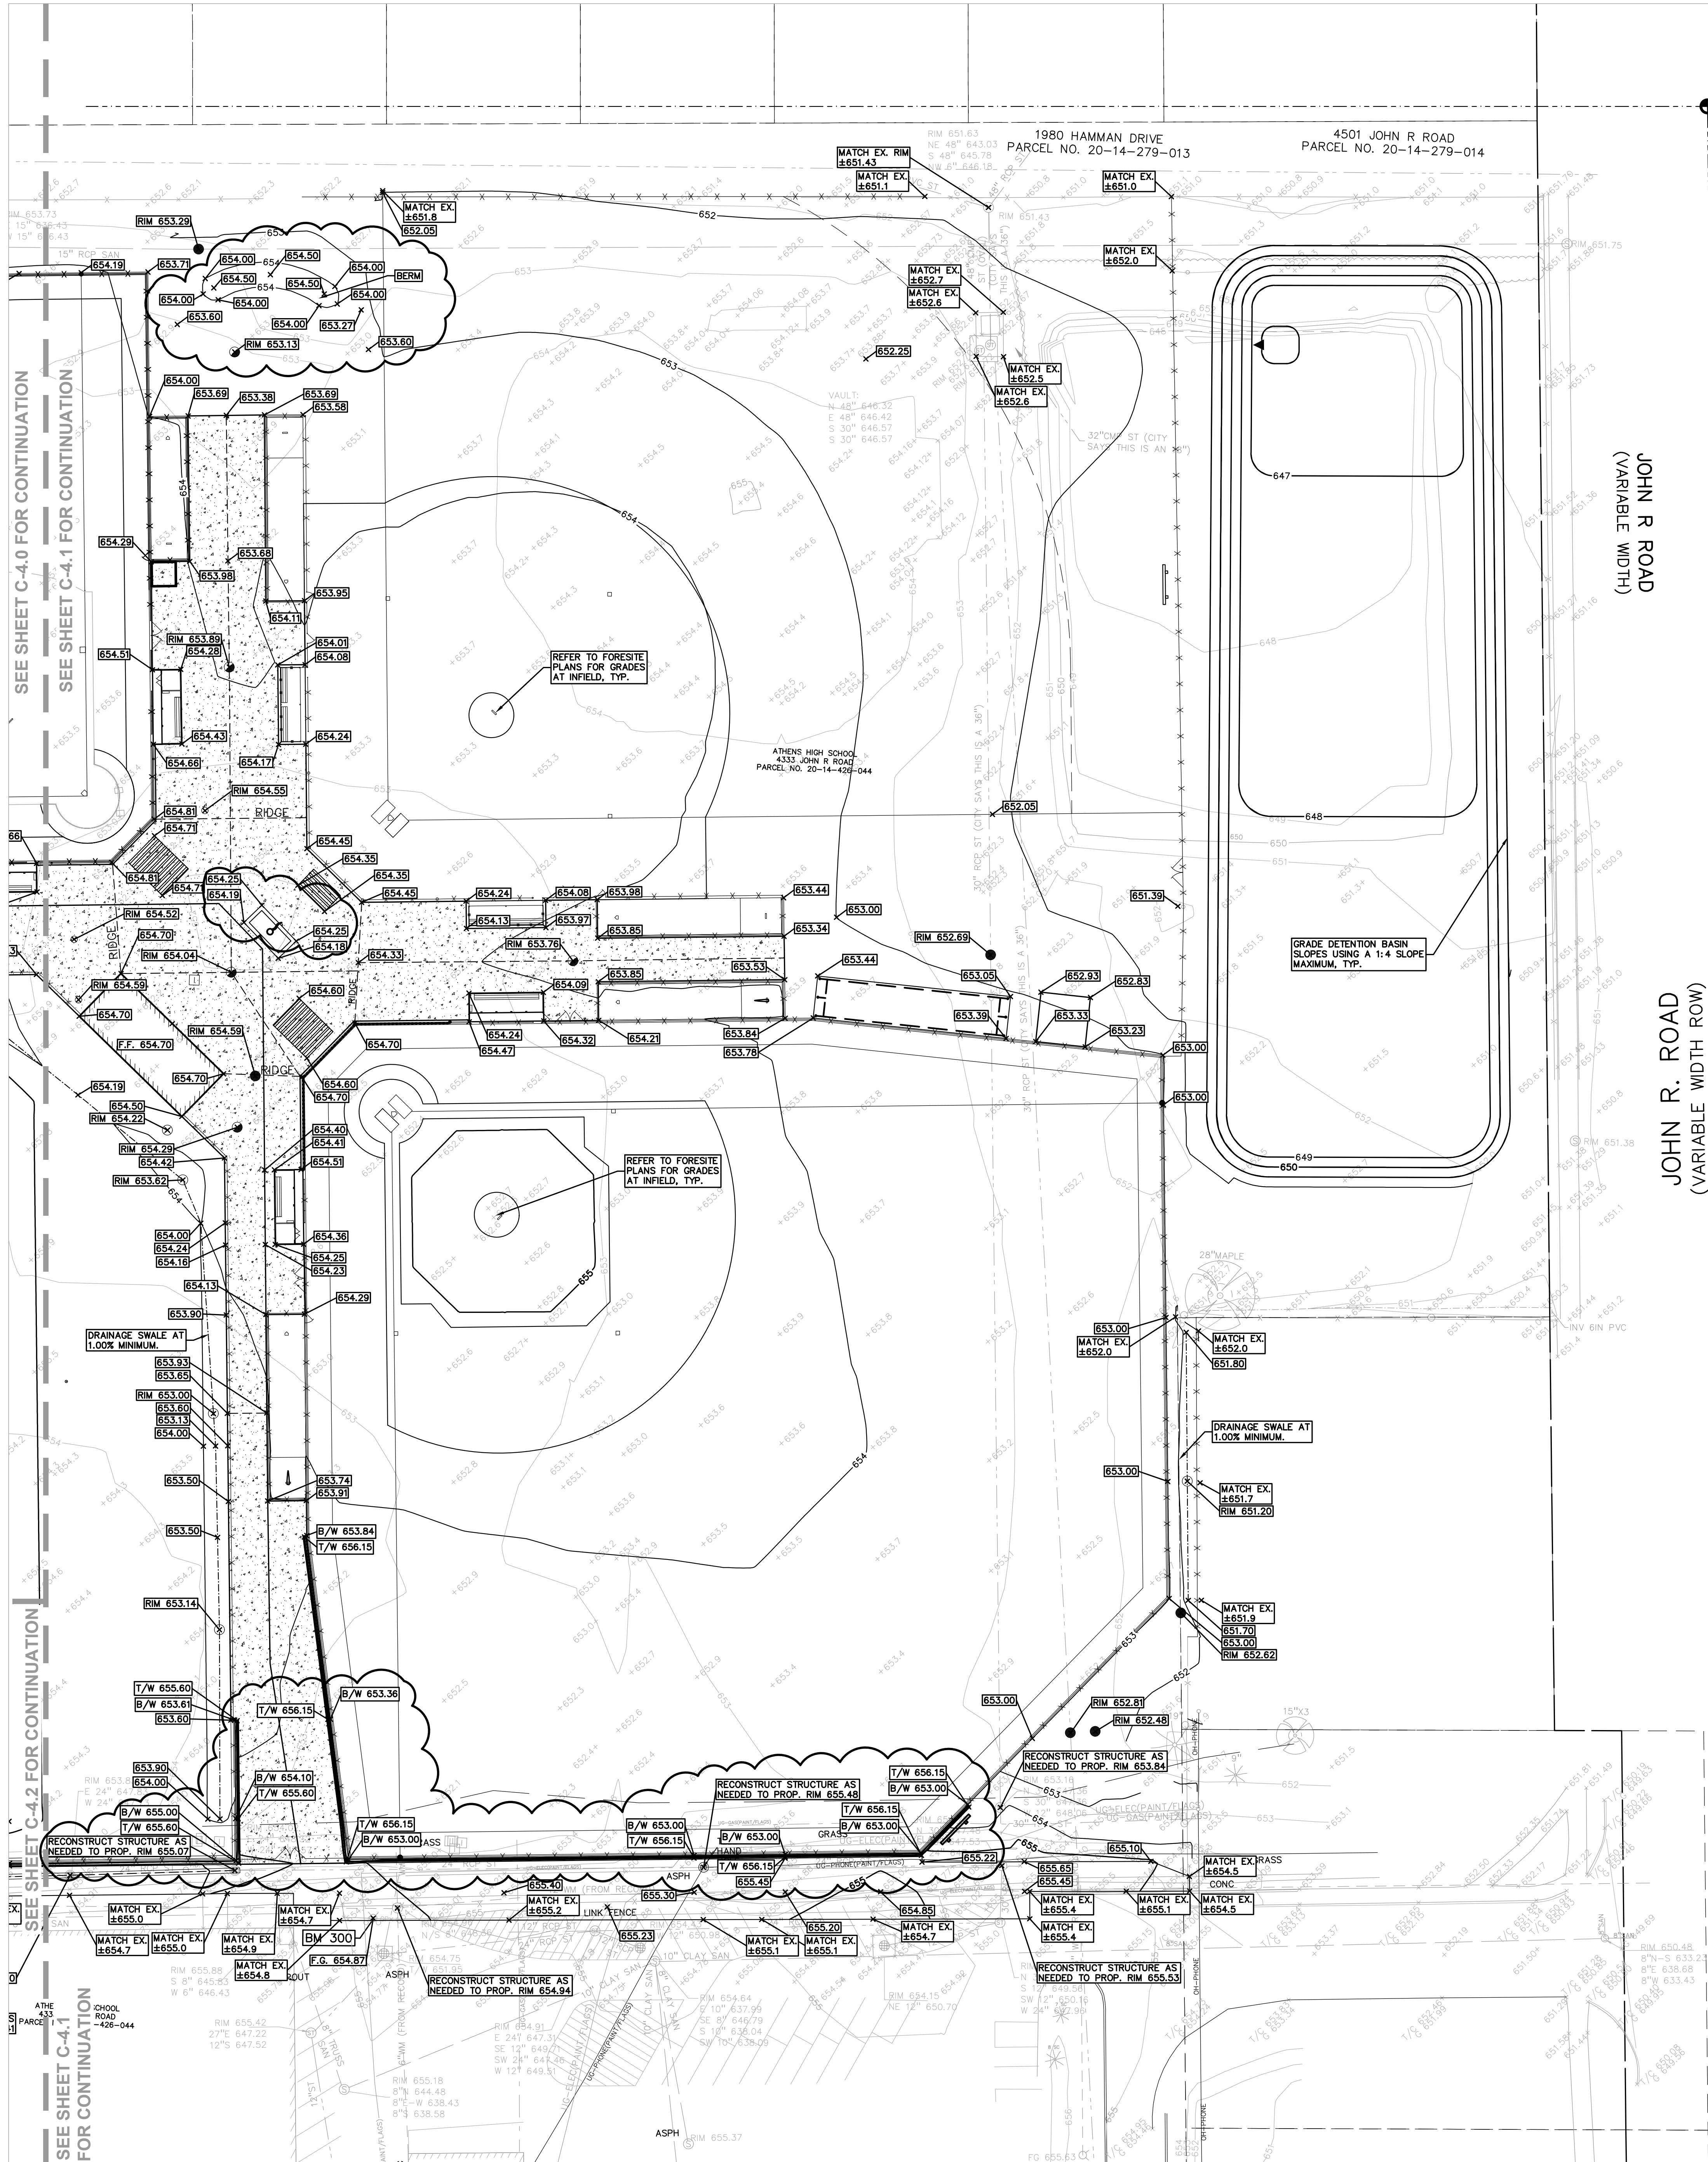

GRADING LEGEND:

- EXISTING SPOT ELEVATION
- PROPOSED SPOT ELEVATION: TYPICALLY TOP OF PAVEMENT IN PAVED AREAS, GUTTER GRADE IN CURB LINES
- EXISTING CONTOUR
- PROPOSED CONTOUR
- PROPOSED REVERSE GUTTER PAN
- PROPOSED RIDGE LINE
- PROPOSED SWALE/DITCH

ABBREVIATIONS

T/C = TOP OF CURB	G = GUTTER GRADE
T/P = TOP OF PAVEMENT	F.G. = FINISH GRADE
T/S = TOP OF SIDEWALK	RM = RIM ELEVATION
T/W = TOP OF WALL	B/W = BOTTOM OF WALL

REFER TO GRADING NOTES ON SHEET C-8.0.

RETAINING WALL NOTE:

TOP OF WALL (TW) AND BOTTOM OF WALL (BW) GRADES ARE THE FINISH GRADE AT THE TOP AND BOTTOM OF THE RETAINING WALL, NOT ACTUAL TOP AND BOTTOM OF THE WALL STRUCTURE.

EARTHWORK BALANCING NOTE:

THE CONTRACTOR SHALL BE RESPONSIBLE FOR IMPORTING OR EXPORTING ALL MATERIALS AS REQUIRED TO PROPERLY GRADE THIS PROJECT TO THE FINISHED ELEVATIONS SHOWN ON THE APPROVED PLANS. THE CONTRACTOR SHALL MAKE THEIR OWN DETERMINATION OF CUT AND FILL QUANTITIES AND ALLOW FOR REMOVAL OF EXCESS OR IMPORTATION OF ADDITIONAL MATERIAL AT NO ADDITIONAL COST TO THE OWNER.

BENCHMARKS
(GPS DERIVED) - NAVD83

BM#300
ARROW ON HYDRANT IN FRONT OF SCHOOL BUILDING, ±30' EAST NORTHEAST OF THE NORTHEAST CORNER OF BUILDING
ELEV. - 655.04

BM#301
ARROW ON HYDRANT IN THE NORTHWEST CORNER OF THE NORTHWEST PARKING LOT ±5 FEET SOUTH OF THE 8 FOOT CHAIN LINK FENCE, ±40 FEET EAST NORTHEAST OF THE BUILDING CORNER
ELEV. - 657.14

BM#302
ARROW ON DIMPLE ON A HYDRANT LOCATED APPROX. 100'± SOUTH OF THE SCHOOL AUDITORIUM, ON THE NORTH SIDE OF ENTRANCE DRIVE TO THE STUDENT PARKING LOT, APPROX. 680'± WEST OF THE CENTERLINE
ELEV. - 655.46

BM#303
ARROW ON DIMPLE ON A HYDRANT LOCATED SOUTHEAST OF THE FOOTBALL FIELD/TRACK, APPROX. 36.5'± WEST OF THE BUILDING, NORTH OF THE AUDITORIUM ENTRANCE.
ELEV. - 656.70



TMP ARCHITECTURE INC
1191 WEST SQUARE LAKE ROAD
BLOOMFIELD HILLS - MICHIGAN - 48302
PH - 248.338.4561; FX - 248.338.0223
EM - INFO@TMP-ARCHITECTURE.COM



CONSULTANT

PEA GROUP
t: 844.813.2949
www.peagroup.com

PROJECT TITLE
**Athens High School
Athletic Fields
Bld Package No. 02B**

**Troy School District
Troy, Michigan**

DRAWING TITLE
**GRADING PLAN -
EAST**

ISSUE DATES


01-14-2025	ADDENDUM NO. 1
12-10-2024	CONSTRUCTION DOCUMENTS
DATE:	ISSUED FOR:
DRAWN:	JW
CHECKED:	TD
APPROVED:	TD

PROJECT NO.
22103D

DRAWING NO.
C-4.1



Drawing File: S:\PROJECTS\2023\23-0301 TROY SCHOOL 2022 BIDDING\3. CONSTRUCTION\Troy Athens\Troy Athens - 2023\C-5.0\SESC-23-0301-A44 2025.rvt
Jun 14, 2025 10:54am

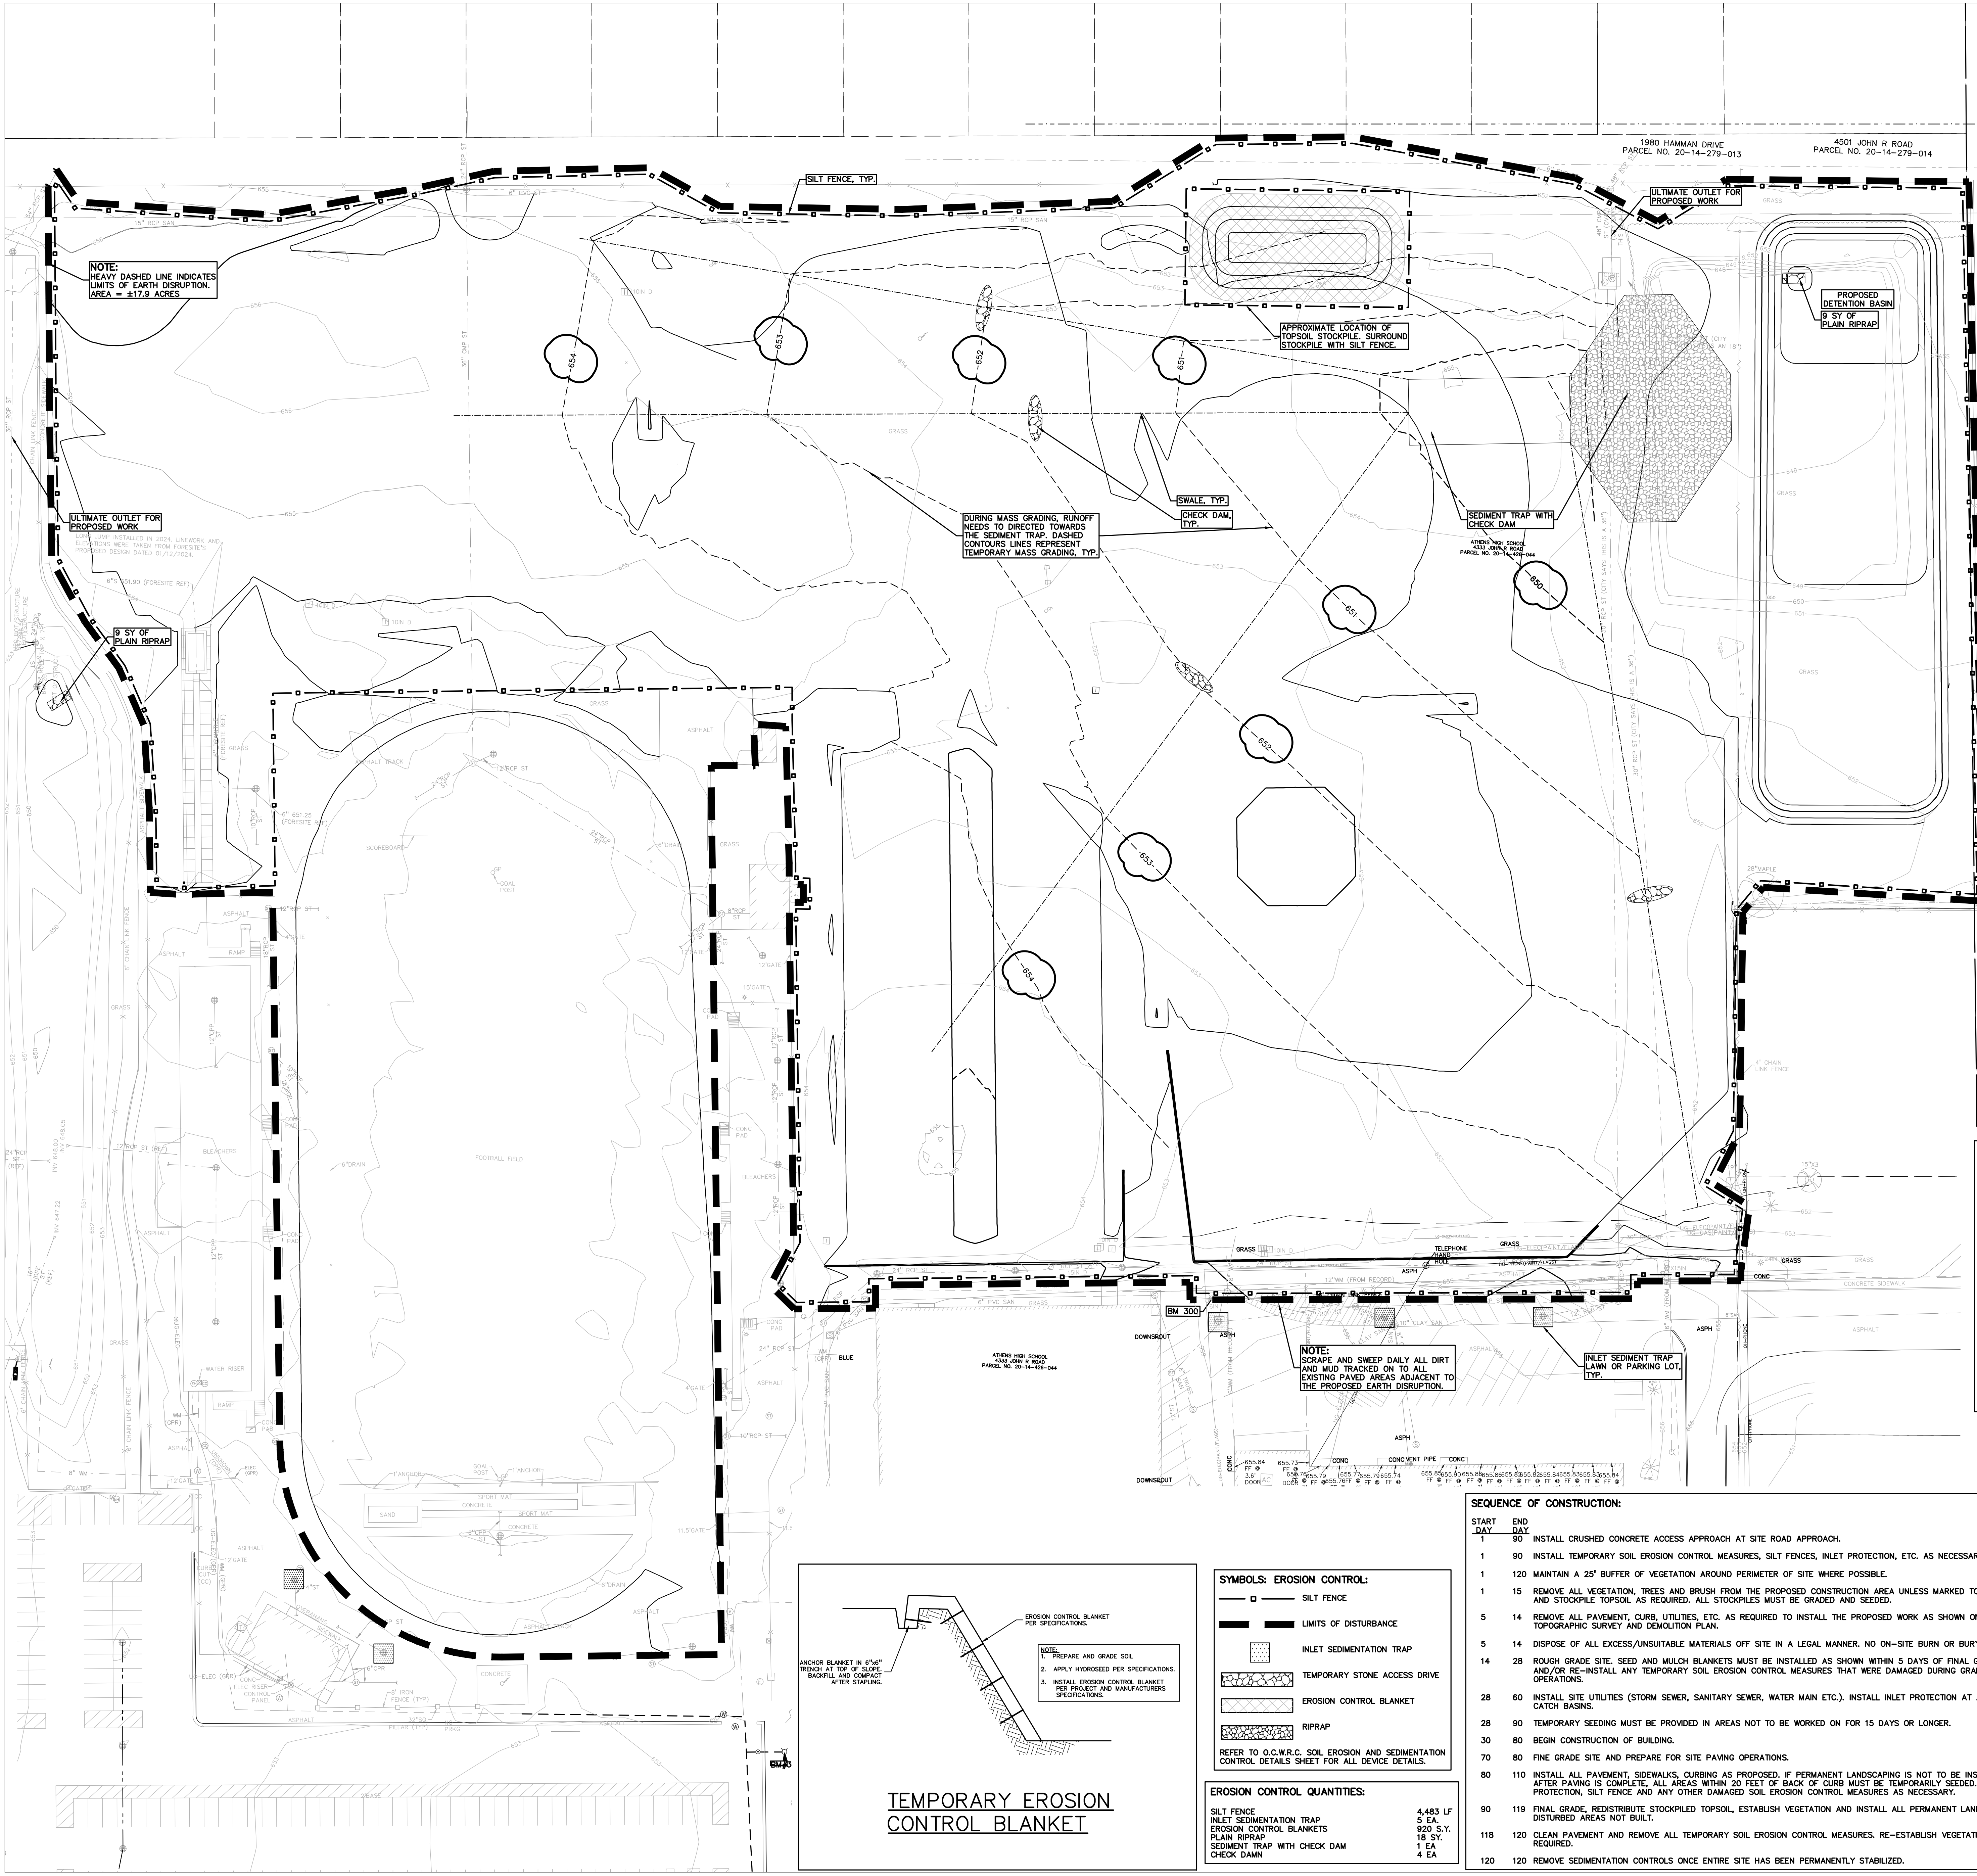


- SOIL EROSION AND SEDIMENTATION CONTROL SEQUENCE OF CONSTRUCTION**
1. SEE CITY OF TROY SOIL EROSION AND SEDIMENTATION CONTROL DETAILS SHEET FOR ALL SOIL EROSION CONTROL RELATED DETAILS.
 2. PLACE SILT FENCE & INSTALL INLET FILTERS ON EXISTING STORM SEWER STRUCTURES, ACCORDING TO PLANS.
 3. INSTALL TEMPORARY CRUSHED CONCRETE ACCESS DRIVE AT ALL CONSTRUCTION ENTRANCES (80"x24"x8" W/MINIMUM OF 1"-3" CRUSHED CONCRETE - NO FINES).
 4. REMOVE CURBS, PAVEMENT, TREES, ETC. AS DIRECTED ON THE DEMOLITION PLAN.
 5. STRIP AND STOCKPILE TOPSOIL FOR RESTORATION REQUIREMENTS.
 6. DISPOSE OF ALL EXCESS, UNSUITABLE MATERIALS OFF SITE IN A LEGAL MANNER. NO BURN OR BURY PITS ALLOWED.
 7. UNSUITABLE MATERIALS CONSIST OF, BUT ARE NOT NECESSARILY LIMITED TO THE FOLLOWING: CONCRETE, ASPHALT, TREES, BRUSH, STUMPS, ROOTS, OR OTHER MISCELLANEOUS DEBRIS OR TRASH.
 8. MASS GRADE THE SITE IN ACCORDANCE WITH THE PLANS.
 9. INSTALL HYDROSEED AS SHOWN ON THE PLAN WITHIN 5 DAYS OF COMPLETION OF MASS GRADING OR WHENEVER DISTURBED AREAS WILL REMAIN UNCHANGED FOR 30 DAYS OR GREATER. MINIMUM 3"-4" TOPSOIL WILL BE USED WHERE VEGETATION IS REQUIRED.
 10. COMPLETE ROUGH GRADING OF SITE. PLACE INLET FILTERS AT ALL INLETS AND CATCH BASINS, AS SHOWN.
 11. FINISH GRADE AND PAVE SITE AS PROPOSED TO DRAIN TO STORM SEWER SYSTEM. REPAIR INLET FILTERS AS REQUIRED.
 12. APPLY TOPSOIL, HYDROSEED TO ALL DISTURBED AREAS UPON COMPLETION OF GRADING. THE CONTRACTOR SHALL STAGE CONSTRUCTION ACTIVITIES IN ORDER TO MINIMIZE THE EXPOSURE OF UNSTABILIZED AREAS.
 13. CLEAN PAVEMENT AND STORM SEWERS. REMOVE SILT FENCE AND TREE PROTECTION FENCE, AND INLET FILTERS ONCE VEGETATION HAS BEEN ESTABLISHED.
 14. ALL DIRT AND MUD TRACKED ONTO PUBLIC ROADS SHALL BE REMOVED DAILY.
 15. INLETS/CATCH BASINS TO BE CLEANED AFTER WEARING COURSE OF ASPHALT AND STRIPING HAS BEEN PLACED.

- SOIL EROSION MAINTENANCE SCHEDULE AND NOTES:**
1. THE SOIL EROSION CONTROLS WILL BE MAINTAINED WEEKLY AND AFTER EVERY STORM EVENT BY:
BARTON MALOW
 2. IF ANY DAMAGE HAS OCCURRED AS A RESULT OF STORM WATER DISCHARGE FROM THE SITE, THE FOLLOWING STEPS SHALL BE IMPLEMENTED.
 3. ANY DEBRIS OR DIRT ON ANY PAVED AREA RESULTING FROM CONSTRUCTION TRAFFIC SHALL BE CLEANED IN A PROMPT MANNER BY THE CONTRACTOR. THE CONSTRUCTION DRIVE SHALL BE CLEANED AT THE END OF EACH DAY.
 4. ALL DIRT AND MUD TRACKED ONTO PAVED AREAS SHALL BE REMOVED BY THE CONTRACTOR DAILY BY SCRAPING. STREET SWEEPING IS REQUIRED WEEKLY.
 5. SILT FENCE MAINTENANCE SHALL INCLUDE THE REMOVAL OF ANY BUILT UP SEDIMENT WHEN THE SEDIMENT HEIGHT ACCUMULATES TO 1/3 TO 1/2 OF THE HEIGHT OF THE FENCE. THE CONTRACTOR IS RESPONSIBLE TO REMOVE, REPLACE, RETRENCH OR REBACKFILL. THE SILTATION FENCE SHOULD IF FALL OR BE DAMAGED DURING CONSTRUCTION.
 6. INLET FILTER MAINTENANCE SHALL INCLUDE THE REMOVAL OF ANY ACCUMULATED SILT OR OTHER DEBRIS. THE REMOVAL OF SILT SHOULD BE WITH THE USE OF A STIFF BRISTLE BROOM OR SQUARE POINT SHOVEL. IF INLET FILTERS CAN NOT BE CLEANED OR ARE DAMAGED, THEN THE FABRIC MUST BE REPLACED.
 7. CONTRACTOR SHALL PROVIDE WATER TRUCK TO WATER DOWN THE SITE ON A DAILY BASIS AS REQUIRED TO MAINTAIN DUST CONTROL.
 8. IF HIGH GROUNDWATER IS ANTICIPATED OR ENCOUNTERED DURING CONSTRUCTION A DETERMINING PLAN MUST BE SUBMITTED TO THE CITY ENGINEERING DIVISION FOR REVIEW.

- GENERAL SITE CONDITIONS:**
1. TOTAL DISTURBED AREA = ±17.9 ACRES
 2. N.P.D.E.S. NOTICE OF COVERAGE IS REQUIRED
 3. DISTANCE TO NEAREST LAKE, STREAM, POND, OPEN DRAIN, OR WETLAND = BIG BEAVER CREEK - NORTH PROPERTY LINE

- NOTE:**
1. PER THE 'SOIL EROSION AND SEDIMENTATION CONTROL SEQUENCE OF CONSTRUCTION' NOTES THE SUCCESSFUL BIDDER TO THE CLEAN THE STORM SEWER. THIS CLEANING SHALL INCLUDE CLEANING OUT THE STRUCTURES AND ENTIRE SEWER RUNS BETWEEN STRUCTURES USING HYDRAULICALLY PROPELLED, HIGH-VELOCITY JET, OR MECHANICALLY POWERED EQUIPMENT. SELECTION OF THE EQUIPMENT USED SHALL BE BASED ON THE CONDITIONS OF LINES AT THE TIME THE WORK COMMENCES. THE EQUIPMENT AND METHODS SELECTED SHALL BE SATISFACTORY TO THE SCHOOL DISTRICT'S REPRESENTATIVE. THE EQUIPMENT SHALL BE CAPABLE OF REMOVING DIRT, GREASE, ROCKS, SAND, AND OTHER MATERIALS AND OBSTRUCTIONS FROM THE SEWER LINES AND MANHOLES. IF CLEANING OF AN ENTIRE SECTION CANNOT BE SUCCESSFULLY PERFORMED FROM ONE MANHOLE, THE EQUIPMENT SHALL BE SET UP ON THE OTHER MANHOLE AND CLEANING AGAIN ATTEMPTED. IF, AGAIN, SUCCESSFUL CLEANING CANNOT BE PERFORMED OR THE EQUIPMENT FAILS TO TRAVERSE THE ENTIRE MANHOLE SECTION, IT WILL BE ASSUMED THAT A MAJOR BLOCKAGE EXISTS AND THE CLEANING EFFORT SHALL BE ABANDONED.
 2. PER THE PROJECT SPECIFICATIONS: PRIOR TO THE PLACEMENT OF TOPSOIL THE SUCCESSFUL BIDDER TO SCHEDULE AN INSPECTION BY THE SCHOOL DISTRICT OR PEA GROUP TO CONFIRM THAT THE GRADE IS AT THE PROPER ELEVATION WHERE THE MINIMUM DEPTH OF TOPSOIL CAN BE PLACED THROUGHOUT THE AREA.
 3. CONTRACTOR TO FIELD VERIFY ALL UNDERGROUND UTILITIES PRIOR TO CONSTRUCTION INCLUDING BUT NOT LIMITED TO: SITE LIGHTING, FIBER LINES, ETC.

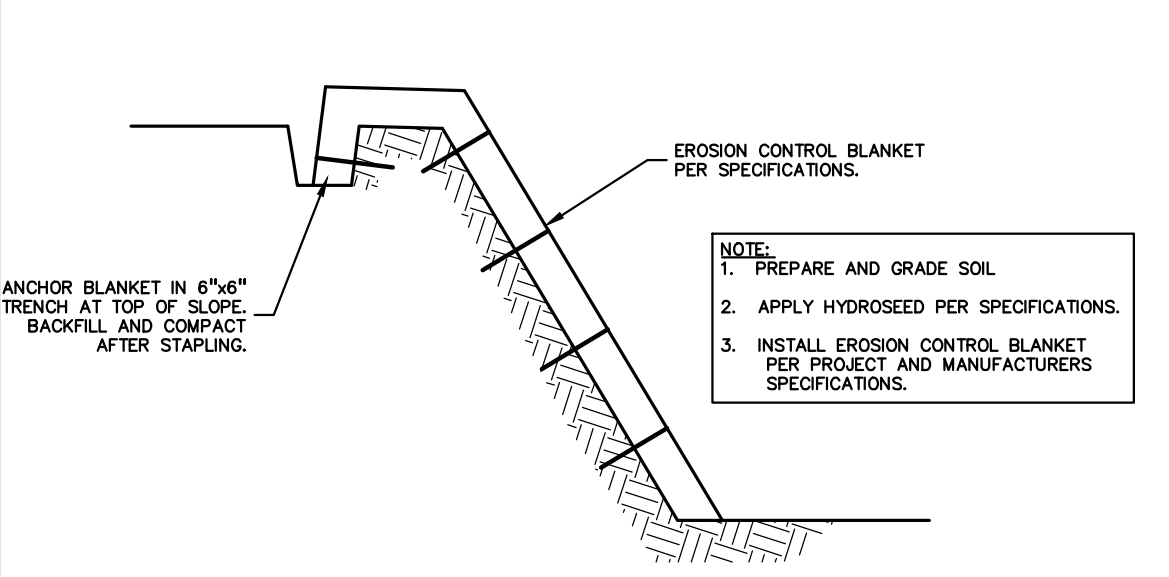


TEMPORARY EROSION CONTROL BLANKET

- SYMBOLS: EROSION CONTROL:**
- □ — SILT FENCE
 - — — LIMITS OF DISTURBANCE
 - INLET SEDIMENTATION TRAP
 - TEMPORARY STONE ACCESS DRIVE
 - EROSION CONTROL BLANKET
 - RIPRAP
- REFER TO O.C.W.R.C. SOIL EROSION AND SEDIMENTATION CONTROL DETAILS SHEET FOR ALL DEVICE DETAILS.

EROSION CONTROL QUANTITIES:

SILT FENCE	4,483 LF
INLET SEDIMENTATION TRAP	5 EA
EROSION CONTROL BLANKETS	920 S.Y.
PLAIN RIPRAP	18 S.Y.
SEDIMENT TRAP WITH CHECK DAM	1 EA
CHECK DAM	4 EA

- SEQUENCE OF CONSTRUCTION:**
- | START DAY | END DAY | DESCRIPTION |
|-----------|---------|---------------------------------------------------------------------------------------------------------------------------------------------------------------------------------------------------------------------------------------------------------------------------------------------------------|
| 1 | 90 | INSTALL CRUSHED CONCRETE ACCESS APPROACH AT SITE ROAD APPROACH. |
| 1 | 90 | INSTALL TEMPORARY SOIL EROSION CONTROL MEASURES, SILT FENCES, INLET PROTECTION, ETC. AS NECESSARY. |
| 1 | 120 | MAINTAIN A 25' BUFFER OF VEGETATION AROUND PERIMETER OF SITE WHERE POSSIBLE. |
| 1 | 15 | REMOVE ALL VEGETATION, TREES AND BRUSH FROM THE PROPOSED CONSTRUCTION AREA UNLESS MARKED TO REMAIN. STRIP AND STOCKPILE TOPSOIL AS REQUIRED. ALL STOCKPILES MUST BE GRADED AND SEEDED. |
| 5 | 14 | REMOVE ALL PAVEMENT, CURBS, UTILITIES, ETC. AS REQUIRED TO INSTALL THE PROPOSED WORK AS SHOWN ON THE TOPOGRAPHIC SURVEY AND DEMOLITION PLAN. |
| 14 | 14 | DISPOSE OF ALL EXCESS/UNSUITABLE MATERIALS OFF SITE IN A LEGAL MANNER. NO ON-SITE BURN OR BURY PITS ALLOWED. |
| 28 | 60 | ROUGH GRADE SITE. SEED AND MULCH BLANKETS MUST BE INSTALLED AS SHOWN WITHIN 5 DAYS OF FINAL GRADE. REPAIR AND/OR RE-INSTALL ANY TEMPORARY SOIL EROSION CONTROL MEASURES THAT WERE DAMAGED DURING GRADING OPERATIONS. |
| 28 | 60 | INSTALL SITE UTILITIES (STORM SEWER, SANITARY SEWER, WATER MAIN ETC.). INSTALL INLET PROTECTION AT ALL PROPOSED CATCH BASINS. |
| 28 | 90 | TEMPORARY SEEDING MUST BE PROVIDED IN AREAS NOT TO BE WORKED ON FOR 15 DAYS OR LONGER. |
| 30 | 80 | BEGIN CONSTRUCTION OF BUILDING. |
| 70 | 80 | FINE GRADE SITE AND PREPARE FOR SITE PAVING OPERATIONS. |
| 80 | 110 | INSTALL ALL PAVEMENT, SIDEWALKS, CURBING AS PROPOSED. IF PERMANENT LANDSCAPING IS NOT TO BE INSTALLED SOON AFTER PAVING IS COMPLETE, ALL AREAS WITHIN 20 FEET OF CURB MUST BE TEMPORARILY SEEDED. REPAIR INLET PROTECTION, SILT FENCE AND ANY OTHER DAMAGED SOIL EROSION CONTROL MEASURES AS NECESSARY. |
| 80 | 119 | FINAL GRADE, REDISTRIBUTE STOCKPILED TOPSOIL, ESTABLISH VEGETATION AND INSTALL ALL PERMANENT LANDSCAPING IN ALL DISTURBED AREAS NOT BUILT. |
| 118 | 120 | CLEAN PAVEMENT AND REMOVE ALL TEMPORARY SOIL EROSION CONTROL MEASURES, RE-ESTABLISH VEGETATION AS REQUIRED. |
| 120 | 120 | REMOVE SEDIMENTATION CONTROLS ONCE ENTIRE SITE HAS BEEN PERMANENTLY STABILIZED. |

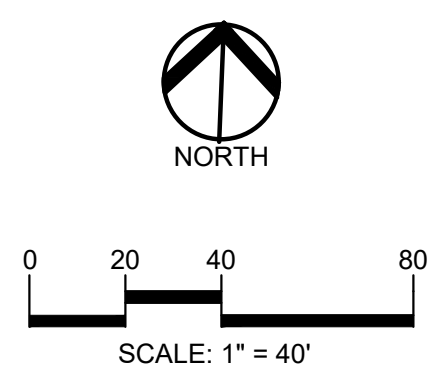

TMP ARCHITECTURE INC
1191 WEST SQUARE LAKE ROAD
BLOOMFIELD HILLS • MICHIGAN • 48302
PH : 248.338.4561 FX : 248.338.0223
EM : INFO@TMP-ARCHITECTURE.COM



CONSULTANT



PROJECT TITLE
Athens High School Athletic Fields Bld Package No. 02B


Troy School District Troy, Michigan
DRAWING TITLE
PHASE I SESC PLAN

ISSUE DATES

01-14-2025	ADDENDUM NO. 1
12-10-2024	CONSTRUCTION DOCUMENTS
DATE	ISSUED FOR:
DRAWN	JW
CHECKED	TD
APPROVED	TD

PROJECT NO.
22103D
DRAWING NO.
C-5.0

Drawing File: S:\PROJECTS\2023\23-0301 TROY SCHOOL DISTRICT 2022 BIDDING\CONSTRUCTION\TROY ATHLETICS\TROY ATHLETICS - 2023\C-5 SESC-23-0301-AUG 2023.dwg
Jun 14, 2025 - 10:54am

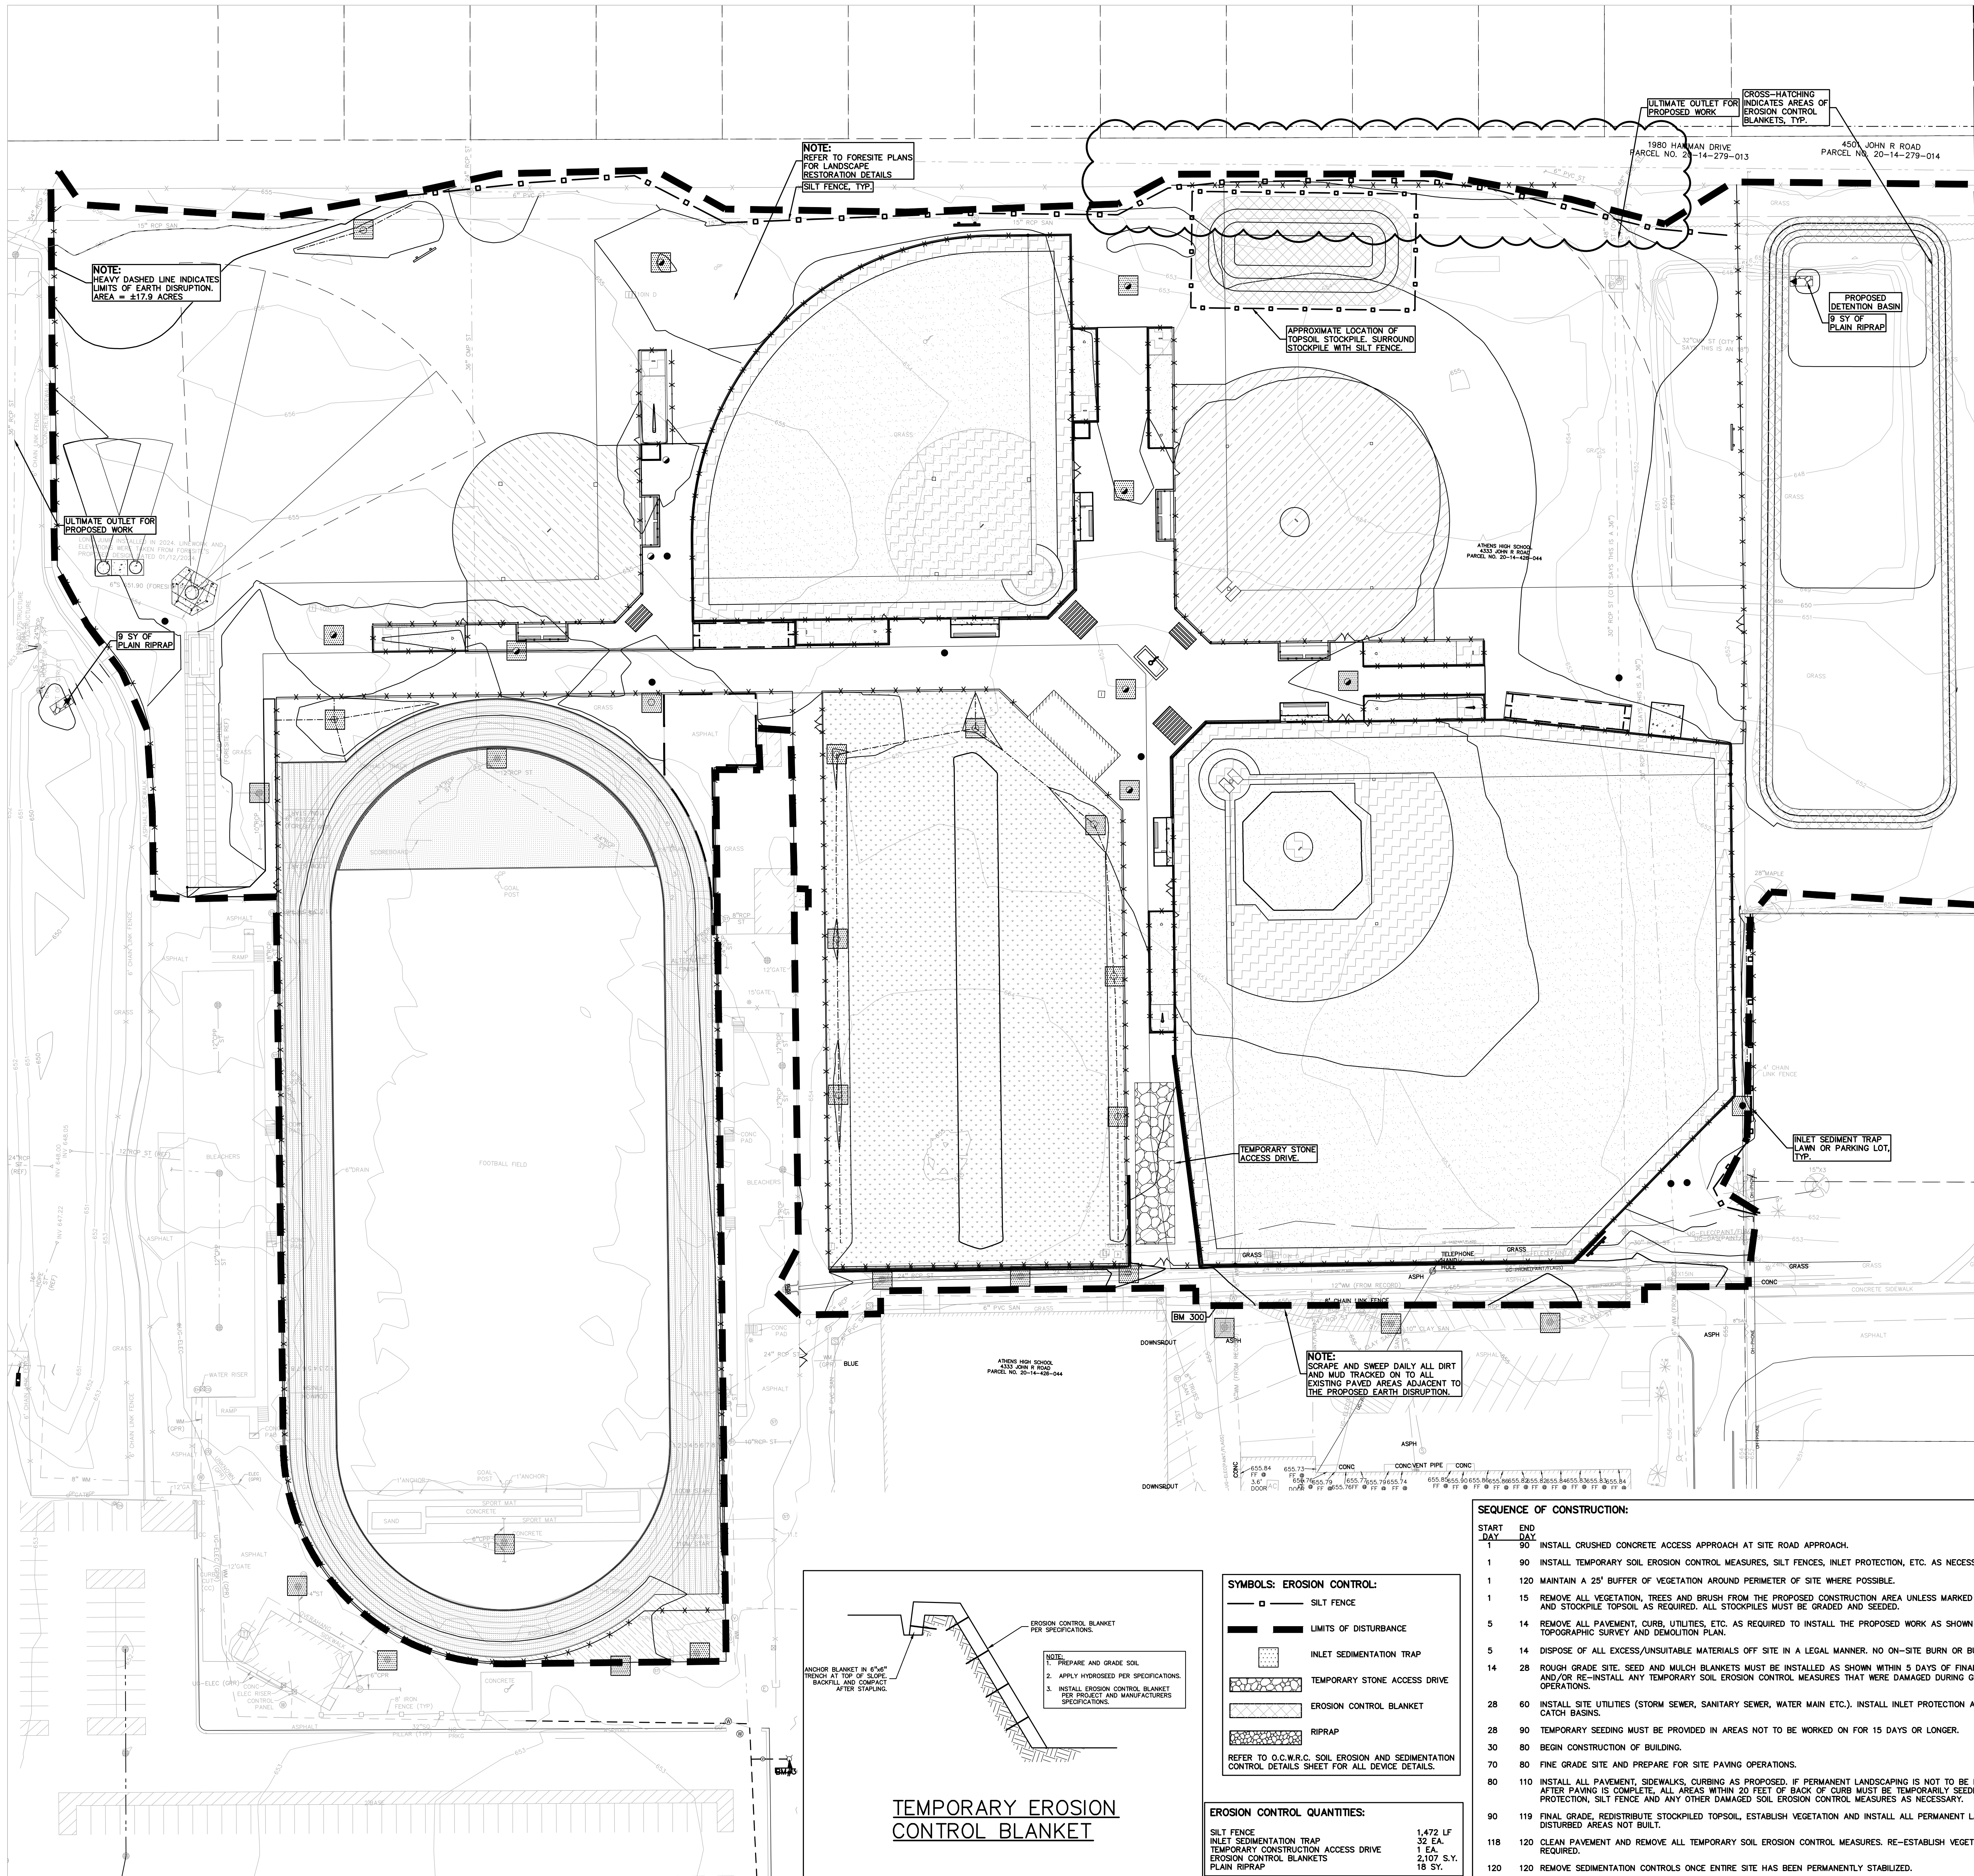

- SOIL EROSION AND SEDIMENTATION CONTROL SEQUENCE OF CONSTRUCTION**
1. SEE CITY OF TROY SOIL EROSION AND SEDIMENTATION CONTROL DETAILS SHEET FOR ALL SOIL EROSION CONTROL RELATED DETAILS.
 2. PLACE SILT FENCE & INSTALL INLET FILTERS ON EXISTING STORM SEWER STRUCTURES, ACCORDING TO PLANS.
 3. INSTALL TEMPORARY CRUSHED CONCRETE ACCESS DRIVE AT ALL CONSTRUCTION ENTRANCES (80'x24'x8" W/MINIMUM OF 1"-3" CRUSHED CONCRETE - NO FINES).
 4. REMOVE CURBS, PAVEMENT, TREES, ETC. AS DIRECTED ON THE DEMOLITION PLAN.
 5. STRIP AND STOCKPILE TOPSOIL FOR RESTORATION REQUIREMENTS.
 6. DISPOSE OF ALL EXCESS, UNSUITABLE MATERIALS OFF SITE IN A LEGAL MANNER. NO BURN OR BURY PITS ALLOWED.
 7. UNSUITABLE MATERIALS CONSIST OF, BUT ARE NOT NECESSARILY LIMITED TO THE FOLLOWING: CONCRETE, ASPHALT, TREES, BRUSH, STUMPS, ROOTS, OR OTHER MISCELLANEOUS DEBRIS OR TRASH.
 8. MASS GRADE THE SITE IN ACCORDANCE WITH THE PLANS.
 9. INSTALL HYDROSEED AS SHOWN ON THE PLAN WITHIN 5 DAYS OF COMPLETION OF MASS GRADING OR WHENEVER DISTURBED AREAS WILL REMAIN UNCHANGED FOR 30 DAYS OR GREATER. MINIMUM 3"-4" TOPSOIL WILL BE USED WHERE VEGETATION IS REQUIRED.
 10. COMPLETE ROUGH GRADING OF SITE. PLACE INLET FILTERS AT ALL INLETS AND CATCH BASINS, AS SHOWN.
 11. FINISH GRADE AND PAVE SITE AS PROPOSED TO DRAIN TO STORM SEWER SYSTEM. REPAIR INLET FILTERS AS REQUIRED.
 12. APPLY TOPSOIL, HYDROSEED TO ALL DISTURBED AREAS UPON COMPLETION OF GRADING. THE CONTRACTOR SHALL STAGE CONSTRUCTION ACTIVITIES IN ORDER TO MINIMIZE THE EXPOSURE OF UNSTABILIZED AREAS.
 13. CLEAN PAVEMENT AND STORM SEWERS. REMOVE SILT FENCE AND TREE PROTECTION FENCE, AND INLET FILTERS ONCE VEGETATION HAS BEEN ESTABLISHED.
 14. ALL DIRT AND MUD TRACKED ONTO PUBLIC ROADS SHALL BE REMOVED DAILY.
 15. INLETS/CATCH BASINS TO BE CLEANED AFTER WEARING COURSE OF ASPHALT AND STRIPING HAS BEEN PLACED.

- SOIL EROSION MAINTENANCE SCHEDULE AND NOTES:**
1. THE SOIL EROSION CONTROLS WILL BE MAINTAINED WEEKLY AND AFTER EVERY STORM EVENT BY:
BARTON MALOW
 2. IF ANY DAMAGE HAS OCCURRED AS A RESULT OF STORM WATER DISCHARGE FROM THE SITE, THE FOLLOWING STEPS SHALL BE IMPLEMENTED:
3. ANY DEBRIS OR DIRT ON ANY PAVED AREA RESULTING FROM CONSTRUCTION TRAFFIC SHALL BE CLEANED IN A PROMPT MANNER BY THE CONTRACTOR. THE CONSTRUCTION DRIVE SHALL BE CLEANED AT THE END OF EACH DAY.
 4. ALL DIRT AND MUD TRACKED ONTO PAVED AREAS SHALL BE REMOVED BY THE CONTRACTOR DAILY BY SCRAPING. STREET SWEEPING IS REQUIRED WEEKLY.
 5. SILT FENCE MAINTENANCE SHALL INCLUDE THE REMOVAL OF ANY BUILT UP SEDIMENT WHEN THE SEDIMENT HEIGHT ACCUMULATES TO 1/3 TO 1/2 OF THE HEIGHT OF THE FENCE. THE CONTRACTOR IS RESPONSIBLE TO REMOVE, REPLACE, RETRENCH OR REBUILT. THE SILTATION FENCE SHOULD IT FALL OR BE DAMAGED DURING CONSTRUCTION.
 6. INLET FILTER MAINTENANCE SHALL INCLUDE THE REMOVAL OF ANY ACCUMULATED SILT OR OTHER DEBRIS. THE REMOVAL OF SILT SHOULD BE WITH THE USE OF A STIFF BRISTLE BROOM OR SQUARE POINT SHOVEL. IF INLET FILTERS CAN NOT BE CLEANED OR ARE DAMAGED, THEN THE FABRIC MUST BE REPLACED.
 7. CONTRACTOR SHALL PROVIDE WATER TRUCK TO WATER DOWN THE SITE ON A DAILY BASIS AS REQUIRED TO MAINTAIN DUST CONTROL.
 8. IF HIGH GROUNDWATER IS ANTICIPATED OR ENCOUNTERED DURING CONSTRUCTION A Dewatering PLAN MUST BE SUBMITTED TO THE CITY ENGINEERING DIVISION FOR REVIEW.

- GENERAL SITE CONDITIONS:**
1. TOTAL DISTURBED AREA = ±17.9 ACRES
 2. N.P.D.E.S. NOTICE OF COVERAGE IS REQUIRED
 3. DISTANCE TO NEAREST LAKE, STREAM, POND, OPEN DRAIN, OR WETLAND = BIG BEAVER CREEK - NORTH PROPERTY LINE

- NOTE:**
1. PER THE 'SOIL EROSION AND SEDIMENTATION CONTROL SEQUENCE OF CONSTRUCTION' NOTES THE SUCCESSFUL BIDDER TO CLEAN THE STORM SEWER, THIS CLEANING SHALL INCLUDE CLEANING OUT THE STRUCTURES AND ENTIRE SEWER RUNS BETWEEN STRUCTURES USING HYDRAULICALLY PROPELLED, HIGH-VELOCITY JET, OR MECHANICALLY POWERED EQUIPMENT. SELECTION OF THE EQUIPMENT USED SHALL BE BASED ON THE CONDITIONS OF LINES AT THE TIME THE WORK COMMENCES. THE EQUIPMENT AND METHODS SELECTED SHALL BE SATISFACTORY TO THE SCHOOL DISTRICT'S REPRESENTATIVE. THE EQUIPMENT SHALL BE CAPABLE OF REMOVING DIRT, GREASE, ROCKS, SAND, AND OTHER MATERIALS AND OBSTRUCTIONS FROM THE SEWER LINES AND MANHOLES. IF CLEANING OF AN ENTIRE SECTION CANNOT BE SUCCESSFULLY PERFORMED FROM ONE MANHOLE, THE EQUIPMENT SHALL BE SET UP ON THE OTHER MANHOLE AND CLEANING AGAIN ATTEMPTED. IF, AGAIN, SUCCESSFUL CLEANING CANNOT BE PERFORMED OR THE EQUIPMENT FAILS TO TRAVERSE THE ENTIRE MANHOLE SECTION, IT WILL BE ASSUMED THAT A MAJOR BLOCKAGE EXISTS AND THE CLEANING EFFORT SHALL BE ABANDONED.
 2. PER THE PROJECT SPECIFICATIONS: PRIOR TO THE PLACEMENT OF TOPSOIL THE SUCCESSFUL BIDDER TO SCHEDULE AN INSPECTION BY THE SCHOOL DISTRICT OR PEA GROUP TO CONFIRM THAT THE GRADE IS AT THE PROPER ELEVATION WHERE THE MINIMUM DEPTH OF TOPSOIL CAN BE PLACED THROUGHOUT THE AREA.
 3. CONTRACTOR TO FIELD VERIFY ALL UNDERGROUND UTILITIES PRIOR TO CONSTRUCTION INCLUDING BUT NOT LIMITED TO: SITE LIGHTING, FIBER LINES, ETC.

SEQUENCE OF CONSTRUCTION:

START DAY	END DAY	DESCRIPTION
1	90	INSTALL CRUSHED CONCRETE ACCESS APPROACH AT SITE ROAD APPROACH.
1	90	INSTALL TEMPORARY SOIL EROSION CONTROL MEASURES, SILT FENCES, INLET PROTECTION, ETC. AS NECESSARY.
1	120	MAINTAIN A 25' BUFFER OF VEGETATION AROUND PERIMETER OF SITE WHERE POSSIBLE.
1	15	REMOVE ALL VEGETATION, TREES AND BRUSH FROM THE PROPOSED CONSTRUCTION AREA UNLESS MARKED TO REMAIN. STRIP AND STOCKPILE TOPSOIL AS REQUIRED. ALL STOCKPILES MUST BE GRADED AND SEEDED.
1	14	REMOVE ALL PAVEMENT, CURBS, UTILITIES, ETC. AS REQUIRED TO INSTALL THE PROPOSED WORK AS SHOWN ON THE TOPOGRAPHIC SURVEY AND DEMOLITION PLAN.
1	14	DISPOSE OF ALL EXCESS/UNSUITABLE MATERIALS OFF SITE IN A LEGAL MANNER. NO ON-SITE BURN OR BURY PITS ALLOWED.
14	28	ROUGH GRADE SITE. SEED AND MULCH BLANKETS MUST BE INSTALLED AS SHOWN WITHIN 5 DAYS OF FINAL GRADE. REPAIR AND/OR RE-INSTALL ANY TEMPORARY SOIL EROSION CONTROL MEASURES THAT WERE DAMAGED DURING GRADING OPERATIONS.
28	60	INSTALL SITE UTILITIES (STORM SEWER, SANITARY SEWER, WATER MAIN ETC.). INSTALL INLET PROTECTION AT ALL PROPOSED CATCH BASINS.
28	90	TEMPORARY SEEDING MUST BE PROVIDED IN AREAS NOT TO BE WORKED ON FOR 15 DAYS OR LONGER.
30	80	BEGIN CONSTRUCTION OF BUILDING.
70	80	FINE GRADE SITE AND PREPARE FOR SITE PAVING OPERATIONS.
80	110	INSTALL ALL PAVEMENT, SIDEWALKS, CURBING AS PROPOSED. IF PERMANENT LANDSCAPING IS NOT TO BE INSTALLED SOON AFTER PAVING IS COMPLETE, ALL AREAS WITHIN 20 FEET OF BACK OF CURB MUST BE TEMPORARILY SEEDED. REPAIR INLET PROTECTION, SILT FENCE AND ANY OTHER DAMAGED SOIL EROSION CONTROL MEASURES AS NECESSARY.
80	119	FINAL GRADE, REDISTRIBUTE STOCKPILED TOPSOIL, ESTABLISH VEGETATION AND INSTALL ALL PERMANENT LANDSCAPING IN ALL DISTURBED AREAS NOT BUILT.
118	120	CLEAN PAVEMENT AND REMOVE ALL TEMPORARY SOIL EROSION CONTROL MEASURES, RE-ESTABLISH VEGETATION AS REQUIRED.
120	120	REMOVE SEDIMENTATION CONTROLS ONCE ENTIRE SITE HAS BEEN PERMANENTLY STABILIZED.

- SYMBOLS: EROSION CONTROL:**
- □ — SILT FENCE
 - LIMITS OF DISTURBANCE
 - INLET SEDIMENTATION TRAP
 - TEMPORARY STONE ACCESS DRIVE
 - EROSION CONTROL BLANKET
 - RIPRAP
- REFER TO O.C.W.R.C. SOIL EROSION AND SEDIMENTATION CONTROL DETAILS SHEET FOR ALL DEVICE DETAILS.

EROSION CONTROL QUANTITIES:

SILT FENCE	1,472 LF
INLET SEDIMENTATION TRAP	32 EA
TEMPORARY CONSTRUCTION ACCESS DRIVE	1 EA
EROSION CONTROL BLANKETS	2,107 S.Y.
PLAIN RIPRAP	18 S.Y.



TMP ARCHITECTURE INC
1191 WEST SQUARE LAKE ROAD
BLOOMFIELD HILLS • MICHIGAN • 48302
PH: 248.338.4561 FX: 248.338.0223
EM: INFO@TMP-ARCHITECTURE.COM



CONSULTANT



PROJECT TITLE
Athens High School Athletic Fields Bld Package No. 02B

Troy School District Troy, Michigan

DRAWING TITLE
PHASE II SESC PLAN

ISSUE DATES

01-14-2025	ADDENDUM NO. 1
12-10-2024	CONSTRUCTION DOCUMENTS
DATE	ISSUED FOR:
DRAWN	JW
CHECKED	TD
APPROVED	TD

PROJECT NO.
22103D

DRAWING NO.
C-5.1



1191 WEST SQUARE LAKE ROAD
BLOOMFIELD HILLS • MICHIGAN • 48302
PH • 248.338.4561 FX • 248.338.0223
EM • INFO@TMP-ARCHITECTURE.COM



PROJECT TITLE

**Athens High School
Athletic Fields
Bld Package No. 02B**

Troy School District
Troy, Michigan

DRAWING TITLE
UTILITY PLAN

ISSUE DATES



	*
*	*
*	*
* 01-14-2025	ADDENDUM NO. 1
12-10-2024	CONSTRUCTION DOCUMENTS
DATE:	ISSUED FOR:
DRAWN	JW
CHECKED	TD
APPROVED	TD

PROJECT NO.

22103D

DRAWING NO.

C-6.0

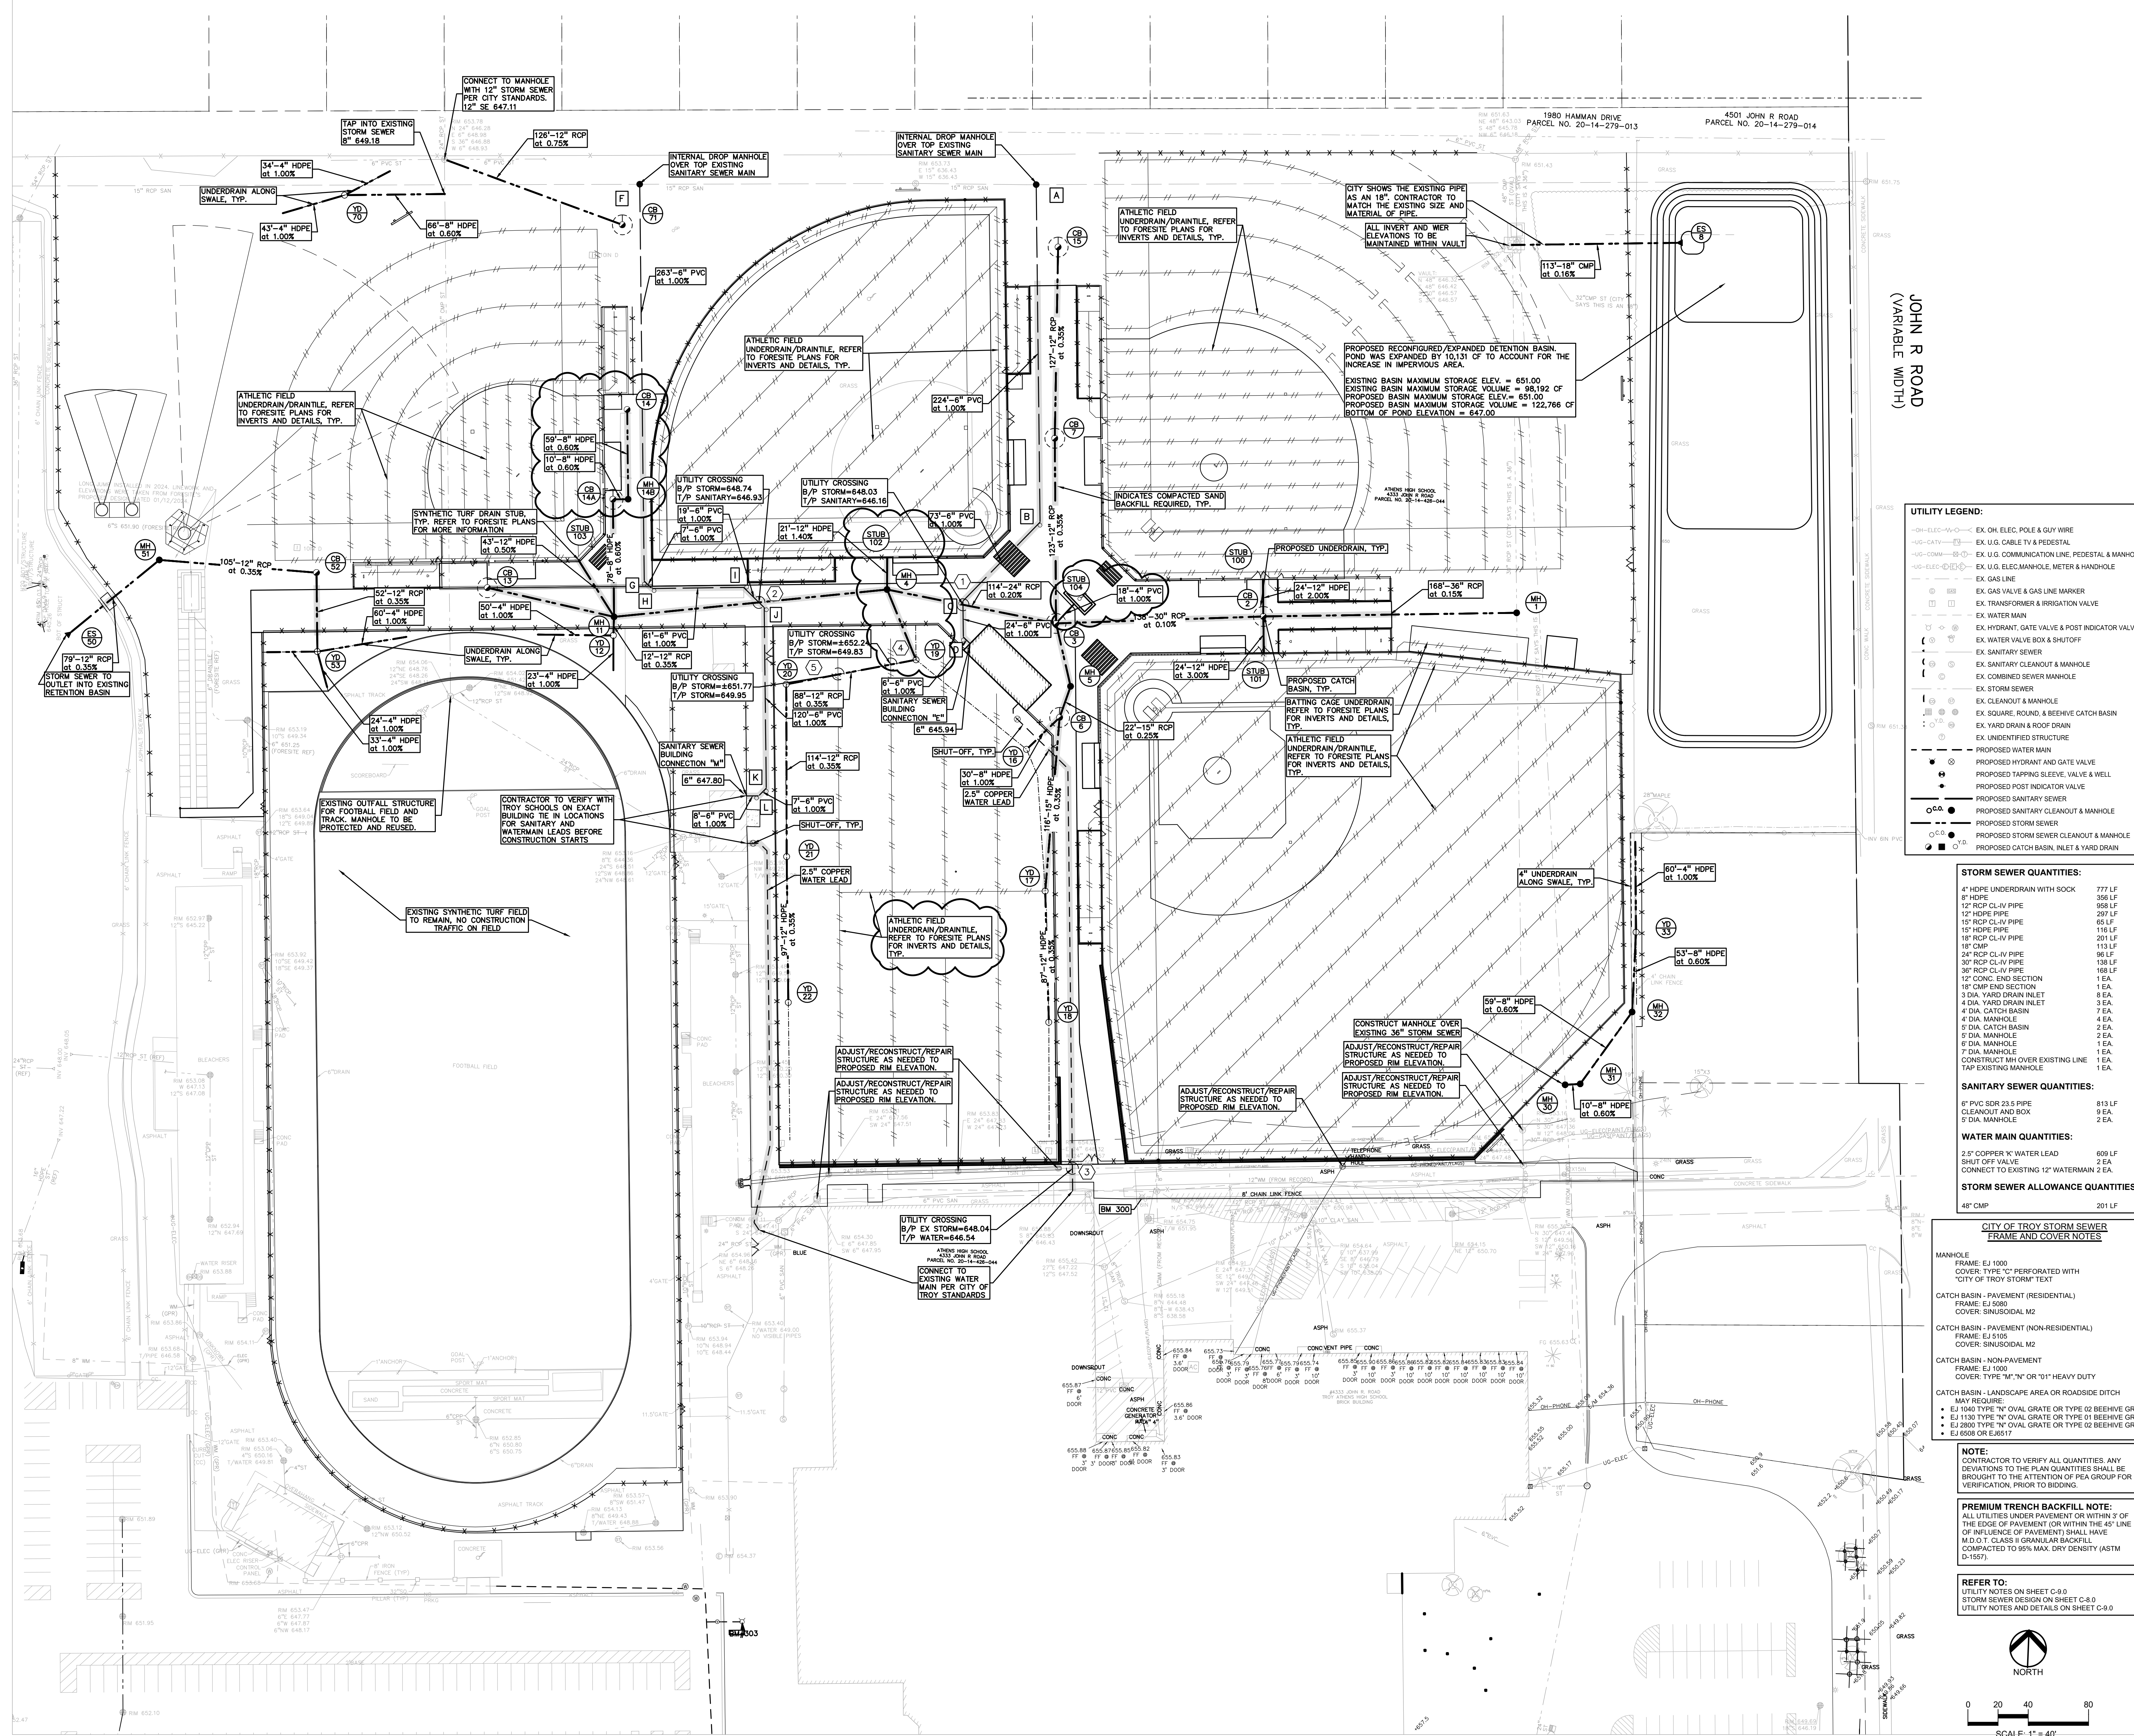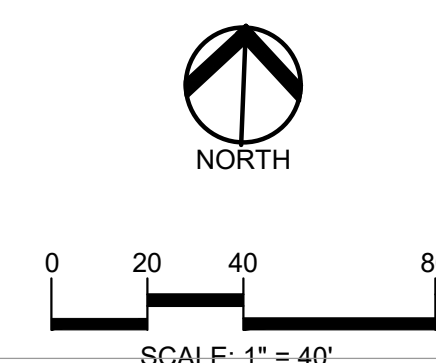

Drawing File: S:\PROJECTS\2023\23-0301 TROY SCHOOLS 2022 BOND\DWG\3_CONSTRUCTION\TROY ATHLETICS - 2025\(\C-6.0)\TJL-23-0301-AHA 2025.dwg

Site Drainage Data			
Select County:	Oakland		
Existing			
Natural Greenspace area:	4.60 acre	C =	0.30
Select NCRS Soil type:	D		
Improved Greenspace area:	acre	C =	0.30
Select NCRS Soil type:	D		
Wooded Area:	acre	C =	0.30
Select NCRS Soil type:	D		
Imperious Area:			
	0.00 acre	C =	0.95
Greenbelt Area:			
	4.60 acre	C =	0.30
Total Area (A):			
	4.60 acre		
Weighted Coefficient of Runoff (C):			
	0.30		
Proposed			
Natural Greenspace area:	0.00 acre	C =	0.30
Select NCRS Soil type:	D		
Improved Greenspace area:	0.00 acre	C =	0.30
Select NCRS Soil type:	D		
Turf/Clay/Sand Area:	4.47 acre	C =	0.63
Select NCRS Soil type:	D		
Imperious Area:			
	0.13 acre	C =	0.95
Greenbelt Area:			
	4.47 acre	C =	0.63
Total Area (A):			
	4.60 acre		
Weighted Coefficient of Runoff (C):			
	0.63		
Rainfall Intensity			
Flood Control Time of Concentration, Tc =	20.00 minutes		
Rainfall Intensity			
12/18/2024 Datafile 12/12			
Time of Concentration (Tc)	20.00 min		
Since 15<Tc<60, use intensity equation			
I = 30.2 / (T + 9.17)^.81	1.97 in/hr		
I10 = 50.12 / [(T + 9.17)^.81]	3.26 in/hr		
I100 = 83.3 / [(T + 9.17)^.81]	5.42 in/hr		
CPVC: Channel Protection Volume Control Volume			
Vcpgc = (4719)CA	13,676 cf		
CPRC: Channel Protection Rate Control Volume: Extended Detention			
Ved= (6897)CA	19,988 cf		
Qved = Ved / (48*60*60)	0.12 cfs		
Forebay Calculations			
Forebay Volume = (545)CA	1,579 cf		
Forebay Release Rate: QVF = VF/(48*60*60)	0.01 cfs		
100-Year Allowable Outlet Rate			
Since 2<A<100, Qvr = 1.1055-0.206xln(A)			
Qvrr =	0.79 cfs/ac		
100-Year Peak Allowable Discharge			
Area, A =	4.60 ac		
Q100p = Qvrr(A)	3.64 cfs		
100-Year Runoff Volume			
V100R = (18,985)CA	55,019 cf		
100-Year Peak Inflow			
Q100p = C(I100)A	15.71 cfs		
Storage Curve Factor (Vs/Vr)			
R = 0.206-0.15 x ln(Q100P/Q100R)	0.425		
100-Year Storage Volume			
Vs = R(V100R)	23,383 cf		
No infiltration will be provided, so no CPVC deduction is taken.			
V100D = Vs	23,383 cf		
V100D must be larger or equal to Ved:			
Is V100D>= Ved ?	Yes		
V100D =			
	23,383 cf		

STORM WATER NARRATIVE:						
THE MODIFICATIONS TO THE SITE ASSOCIATED WITH THIS PROJECT WILL BRING ABOUT A SLIGHT INCREASE IN THE IMPERVIOUS SURFACE FOR THE DRAINAGE AREA. CALCULATIONS WERE PERFORMED TO DETERMINE THE INCREASE IN STORAGE VOLUME REQUIRED BY THIS INCREASE IN IMPERVIOUS SURFACE AND THE DETENTION BASIN WILL BE REGRADED TO PROVIDE THE ADDITIONAL VOLUME NECESSARY.						
THE PROPOSED SITE DEVELOPMENT ADDS AN ADDITIONAL 0.13 ACRES OF IMPERVIOUS AREA AND 4.47 ACRES OF TURF/CLAY/SAND ATHLETICS FIELDS. THE VAST MAJORITY OF THE PROPOSED IMPERVIOUS AREA WILL DRAIN TO THE EXISTING NORTHEAST BASIN. THE REQUIRED POND EXPANSION IS BASED ON THE OAKLAND COUNTY DESIGN METHOD FOR THE 100-YEAR STORM EVENT, WHICH CAN BE SEEN ON THIS SHEET. THE POND WILL NEED TO INCLUDE AN ADDITIONAL 23,383 CUBIC FEET. THE MAXIMUM STORAGE OF THE EXISTING BASIN IS 98,192 CUBIC FEET AND ADDING IN THE REQUIRED 100-YEAR ADDITIONAL IMPERVIOUS VOLUME, THE TOTAL POND WILL BE EXPANDED TO 122,766 CUBIC FEET. THE DETENTION POND REGRADE WILL INCORPORATE A TOTAL INCREASE IN VOLUME OF 24,574 CUBIC FEET. A COMPARISON OF THE EXISTING AND PROPOSED DEPTH/VOLUME RELATIONSHIP IS SHOWN BELOW.						
CONTOUR	EXISTING CONDITION			PROPOSED CONDITION		
	AREA SF	VOLUME CF	TOTAL CF	AREA SF	VOLUME CF	TOTAL CF
647	137		0	6,434		0
648	16,189	8,163	8,163	20,322	13,378	13,378
649	27,869	22,029	30,192	36,768	28,545	41,923
650	32,282	30,076	60,268	40,396	38,582	80,505
651	43,566	37,924	98,192	44,125	42,261	122,766
MAXIMUM WATER SURFACE ELEVATION (WSEL): 651.00						
EXISTING STORAGE VOLUME AT MAXIMUM WSEL: 98,192						
PROPOSED STORAGE VOLUME AT MAXIMUM WSEL: 122,766						
INCREASE IN STORAGE VOLUME: 24,574						

STORM STRUCTURES		
MH	1	(6" DIA./0' SUMP) RIM = 652.69 36" S 646.96 36" N 646.86
CB	2	(3" DIA./0' SUMP) RIM = 653.76 30" W 647.61 12" N 648.81 12" S 648.65 36" E 647.21
CB	3	(5" DIA./0' SUMP) RIM = 654.04 24" W 648.15 12" N 648.25 15" S 648.25 4" NE 650.00 30" E 647.75
MH	4	(5" DIA./2' SUMP) RIM = 654.29 15" S 648.36 15" N 648.36
MH	5	(4" DIA./2' SUMP) RIM = 654.59 15" S 648.36 15" N 648.36
CB	6	(4" DIA./2' SUMP) RIM = 654.29 15" S 648.41 8" SW 648.88 15" N 648.41
CB	7	(4" DIA./2' SUMP) RIM = 653.89 12" N 648.68 12" S 648.68
MH	11	(7" DIA./0' SUMP) RIM = 653.61 12" S 649.44 12" NW 649.54 8" N 649.24 12" W 649.54 18" E 649.10
YD	12	(4" DIA./2' SUMP) RIM = 653.30 4" W 649.59 4" S 649.59 12" N 649.49
CB	13	(4" DIA./2' SUMP) RIM = 653.69 12" E 649.84
MH	14B	(4" DIA./0' SUMP) RIM = 654.14 8" N 649.97 8" W 649.87
CB	14	(4" DIA./2' SUMP) RIM = 653.55 8" S 650.32
CB	14A	(4" DIA./2' SUMP) RIM = 654.00 8" E 649.81 8" S 649.71
CB	15	(4" DIA./2' SUMP) RIM = 653.13 12" S 649.12
YD	16	(3" DIA./1' SUMP) RIM = 653.62 8" NE 649.16
YD	17	(4" DIA./2' SUMP) RIM = 653.00 12" S 649.02 15" N 648.82
YD	18	(3" DIA./2' SUMP) RIM = 653.14 12" N 649.32
YD	19	(3" DIA./2' SUMP) RIM = 653.79 12" W 648.60 12" NW 648.62
YD	20	(3" DIA./2' SUMP) RIM = 652.78 12" S 648.91 12" E 648.91
YD	21	(3" DIA./2' SUMP) RIM = 652.87 12" S 649.31 12" N 649.31
YD	22	(3" DIA./2' SUMP) RIM = 652.65 12" N 649.65
MH	30	(5" DIA./0' SUMP) RIM = 652.81 30" S 647.38 8" E 647.85 36" N 647.38
MH	31	(4" DIA./0' SUMP) RIM = 652.49 8" NE 647.81 8" W 647.91
MH	32	(4" DIA./1' SUMP) RIM = 652.62 8" N 648.16
YD	33	(3" DIA./1' SUMP) RIM = 651.20 4" N 648.58 8" S 648.48
MH	51	(4" DIA./0' SUMP) RIM = 654.03 12" E 649.28 12" SW 649.28
CB	52	(4" DIA./0' SUMP) RIM = 653.19 12" S 649.64 12" W 649.64
YD	53	(4" DIA./0' SUMP) RIM = 653.30 4" E 649.92 4" W 649.92 4" S 649.92 12" N 649.83
YD	70	(3" DIA./2' SUMP) RIM = 653.38 4" W 649.68 4" NE 649.68 8" E 649.58
CB	71	12" W 647.94
STUB	100	12" S 649.30
STUB	101	12" N 649.37
STUB	102	
STUB	103	12" SE 649.76
STUB	104	4" SW 650.18

END SECTIONS		
B	END SECTION 18" 646.24	END SECTION MATERIAL: CMP
50	END SECTION 12" 649.00	END SECTION MATERIAL: RCP
SANITARY STRUCTURES		
A	MH (5" DIA.) RIM = 653.39 15" W 636.19 6" S 642.66 15" E 636.19	
F	MH (5" DIA.) RIM = 653.88 15" W 637.00 6" S 642.95 15" E 637.00	
INTERNAL DROP MANHOLE		
SANITARY CLEANOUTS		
K	C.O. IN BOX RIM = 653.57 INV. 647.65	
L	C.O. IN BOX RIM = 653.63 INV. 647.72	
H	C.O. IN BOX RIM = 654.11 INV. 645.65	
G	C.O. IN BOX RIM = 654.14 INV. 645.58	
J	C.O. IN BOX RIM = 654.17 INV. 646.45	
I	C.O. IN BOX RIM = 654.35 INV. 646.28	
B	C.O. IN BOX RIM = 654.53 INV. 644.91	
C	C.O. IN BOX RIM = 654.54 INV. 645.64	
D	C.O. IN BOX RIM = 654.56 INV. 645.88	



TMP ARCHITECTURE INC
1191 WEST SQUARE LAKE ROAD
BLOOMFIELD HILLS • MICHIGAN • 48302
PH : 248.338.4561 FX : 248.338.0223
EM : INFO@TMP-ARCHITECTURE.COM



CONSULTANT



PROJECT TITLE
**Athens High School
Athletic Fields
Bid Package No. 02B**

**Troy School District
Troy, Michigan**

DRAWING TITLE
**BASIN CALCS
AND STRUCTURE
TABLE**

ISSUE DATES

-	-
-	-
01-14-2025	ADDENDUM NO. 1
12-10-2024	CONSTRUCTION DOCUMENTS
DATE:	ISSUED FOR:
DRAWN:	JW
CHECKED:	TD
APPROVED:	TD

PROJECT NO.
22103D

DRAWING NO.
C-6.1



PROJECT TITLE
**Athens High School
Athletic Fields
Bld Package No. 02B**

Troy School District
Troy, Michigan

DRAWING TITLE
UTILITY PROFILES

ISSUE DATES

01-14-2025	ADDENDUM NO. 1
------------	----------------

DATE: ISSUED FOR:

DRAWN JW

CHECKED	TD
---------	----


APPROVED TD

PROJECT NO.


22103D

DRAWING NO.


C-7.0

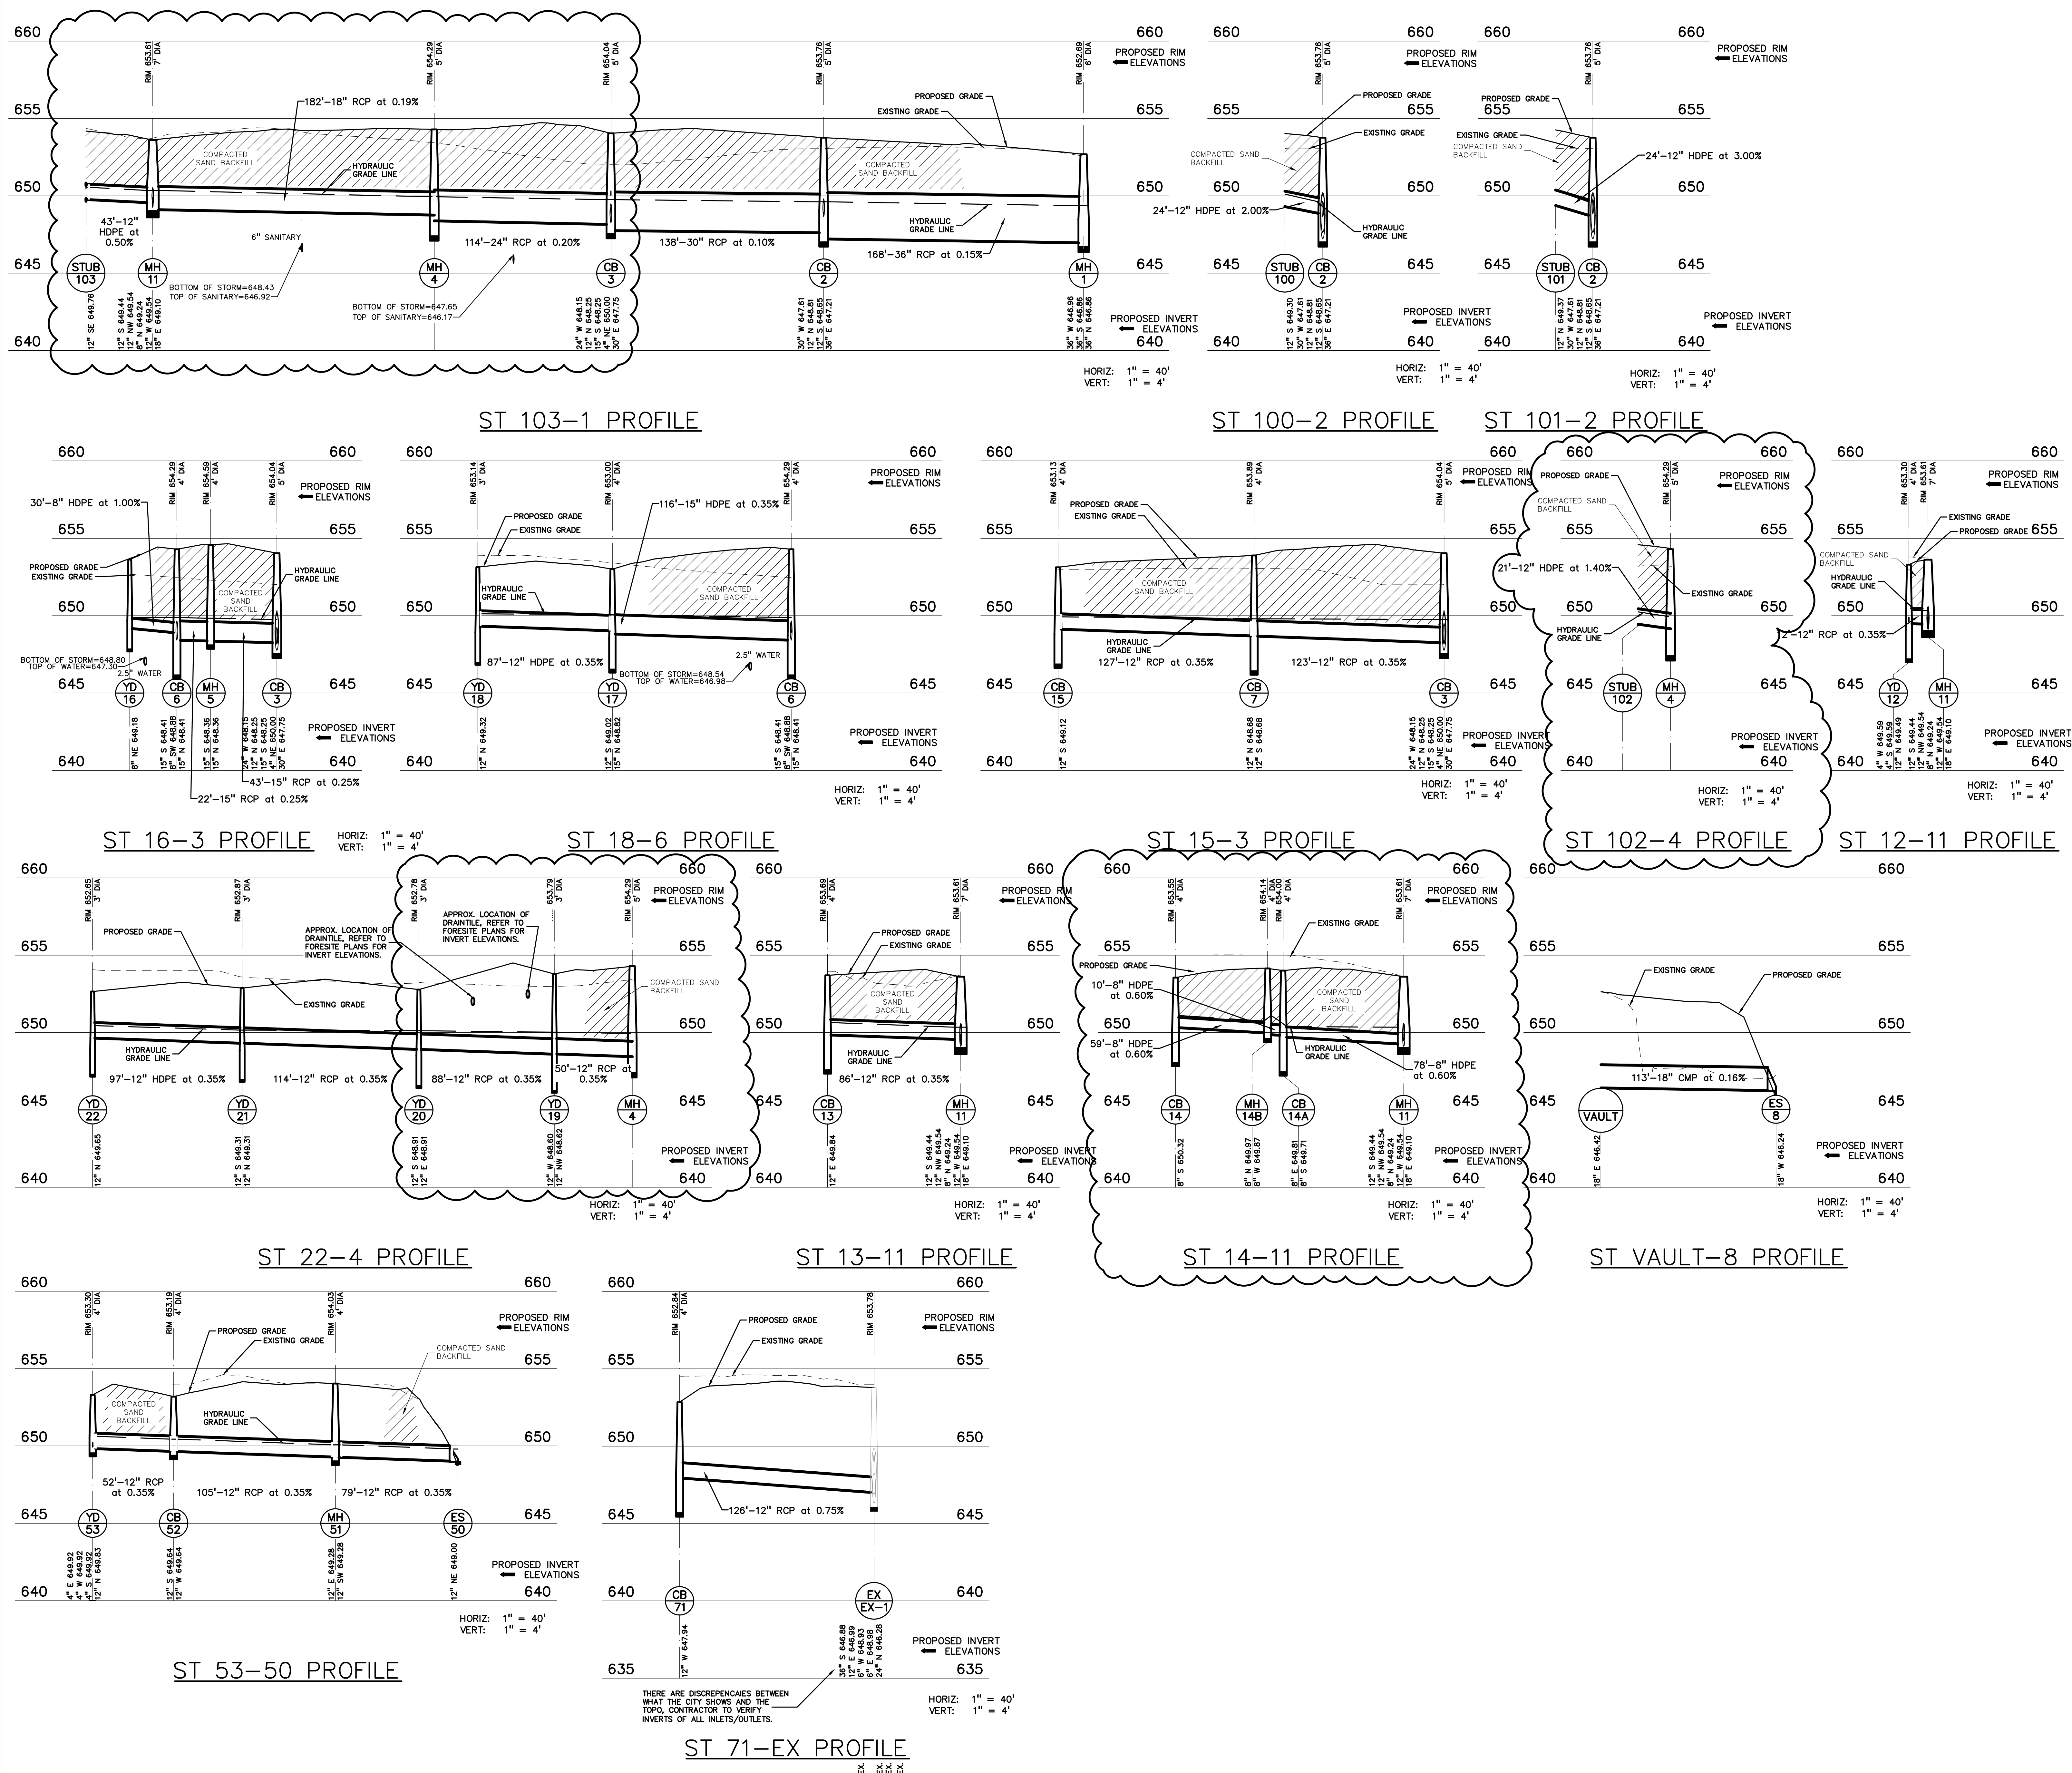

Drawing File: S:\PROJECTS\2023\23-0301 TROY SCHOOLS 2022 BIDDING\3.CONSTRUCTION\TROY ATHLETICS\TROY ATHLETICS - 2025\G-7.0\PROF-23-0301-ATH. 2025.dwg
Jan 14, 2025 10:54am

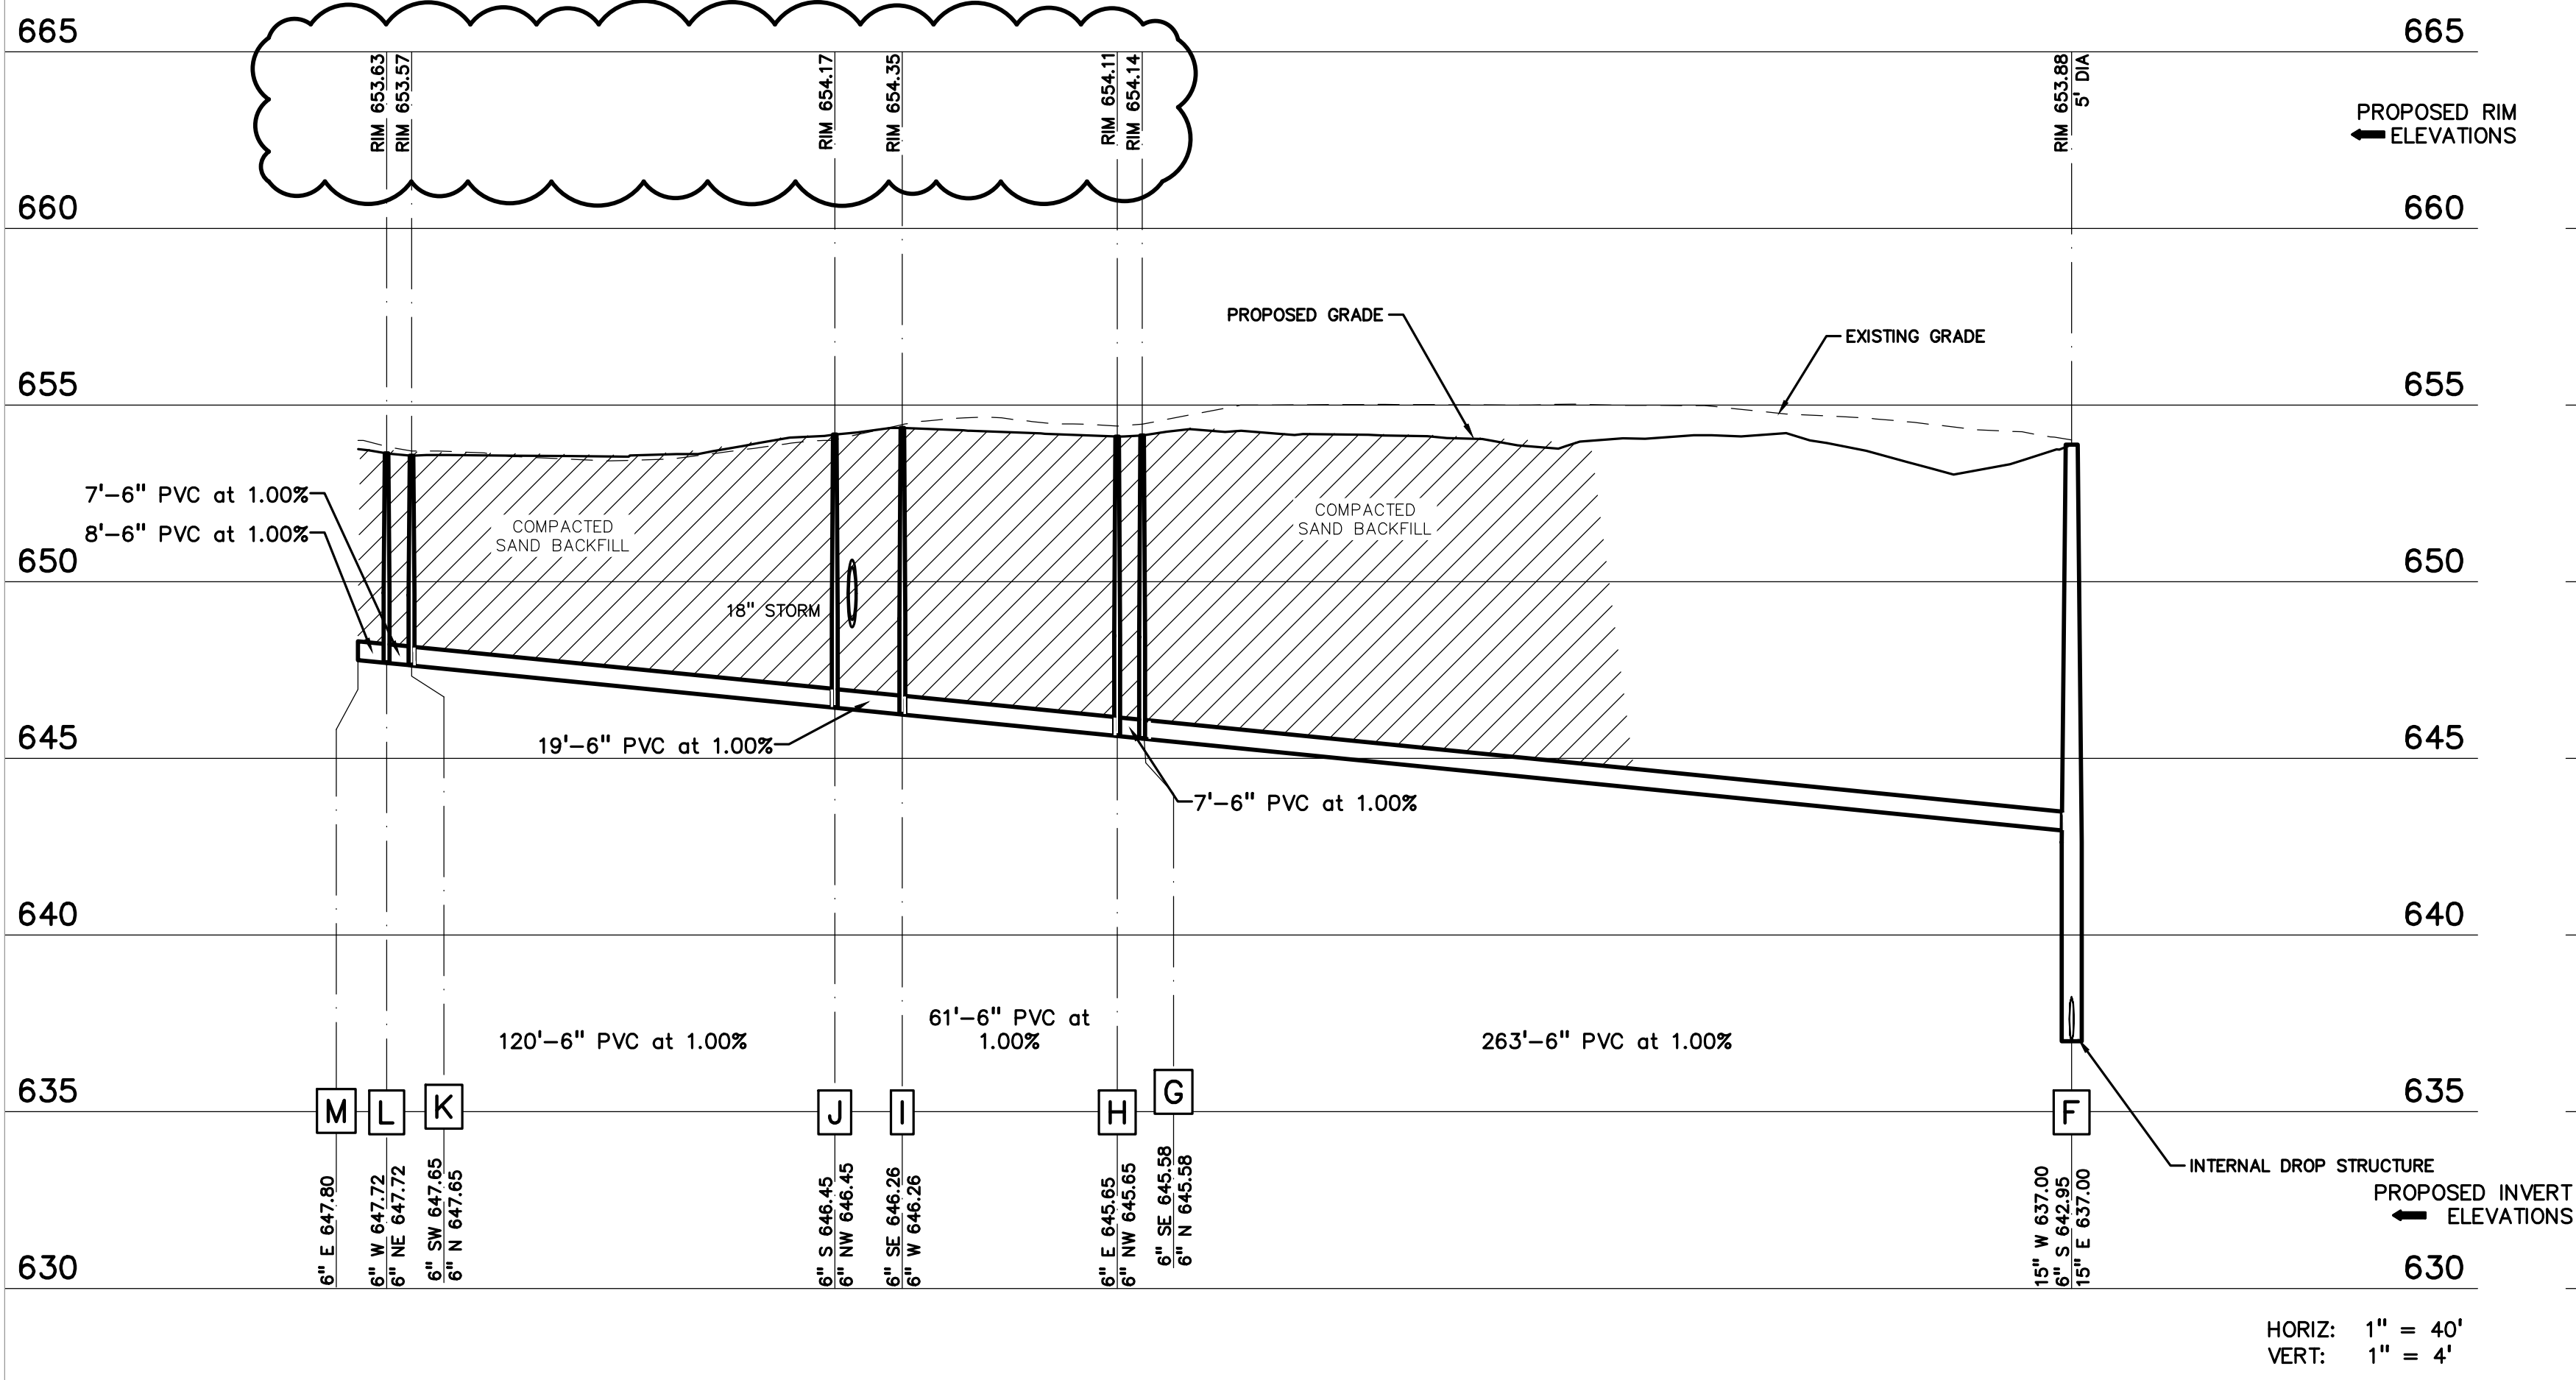

EXISTING SHED SANITARY SEWER PROFILE

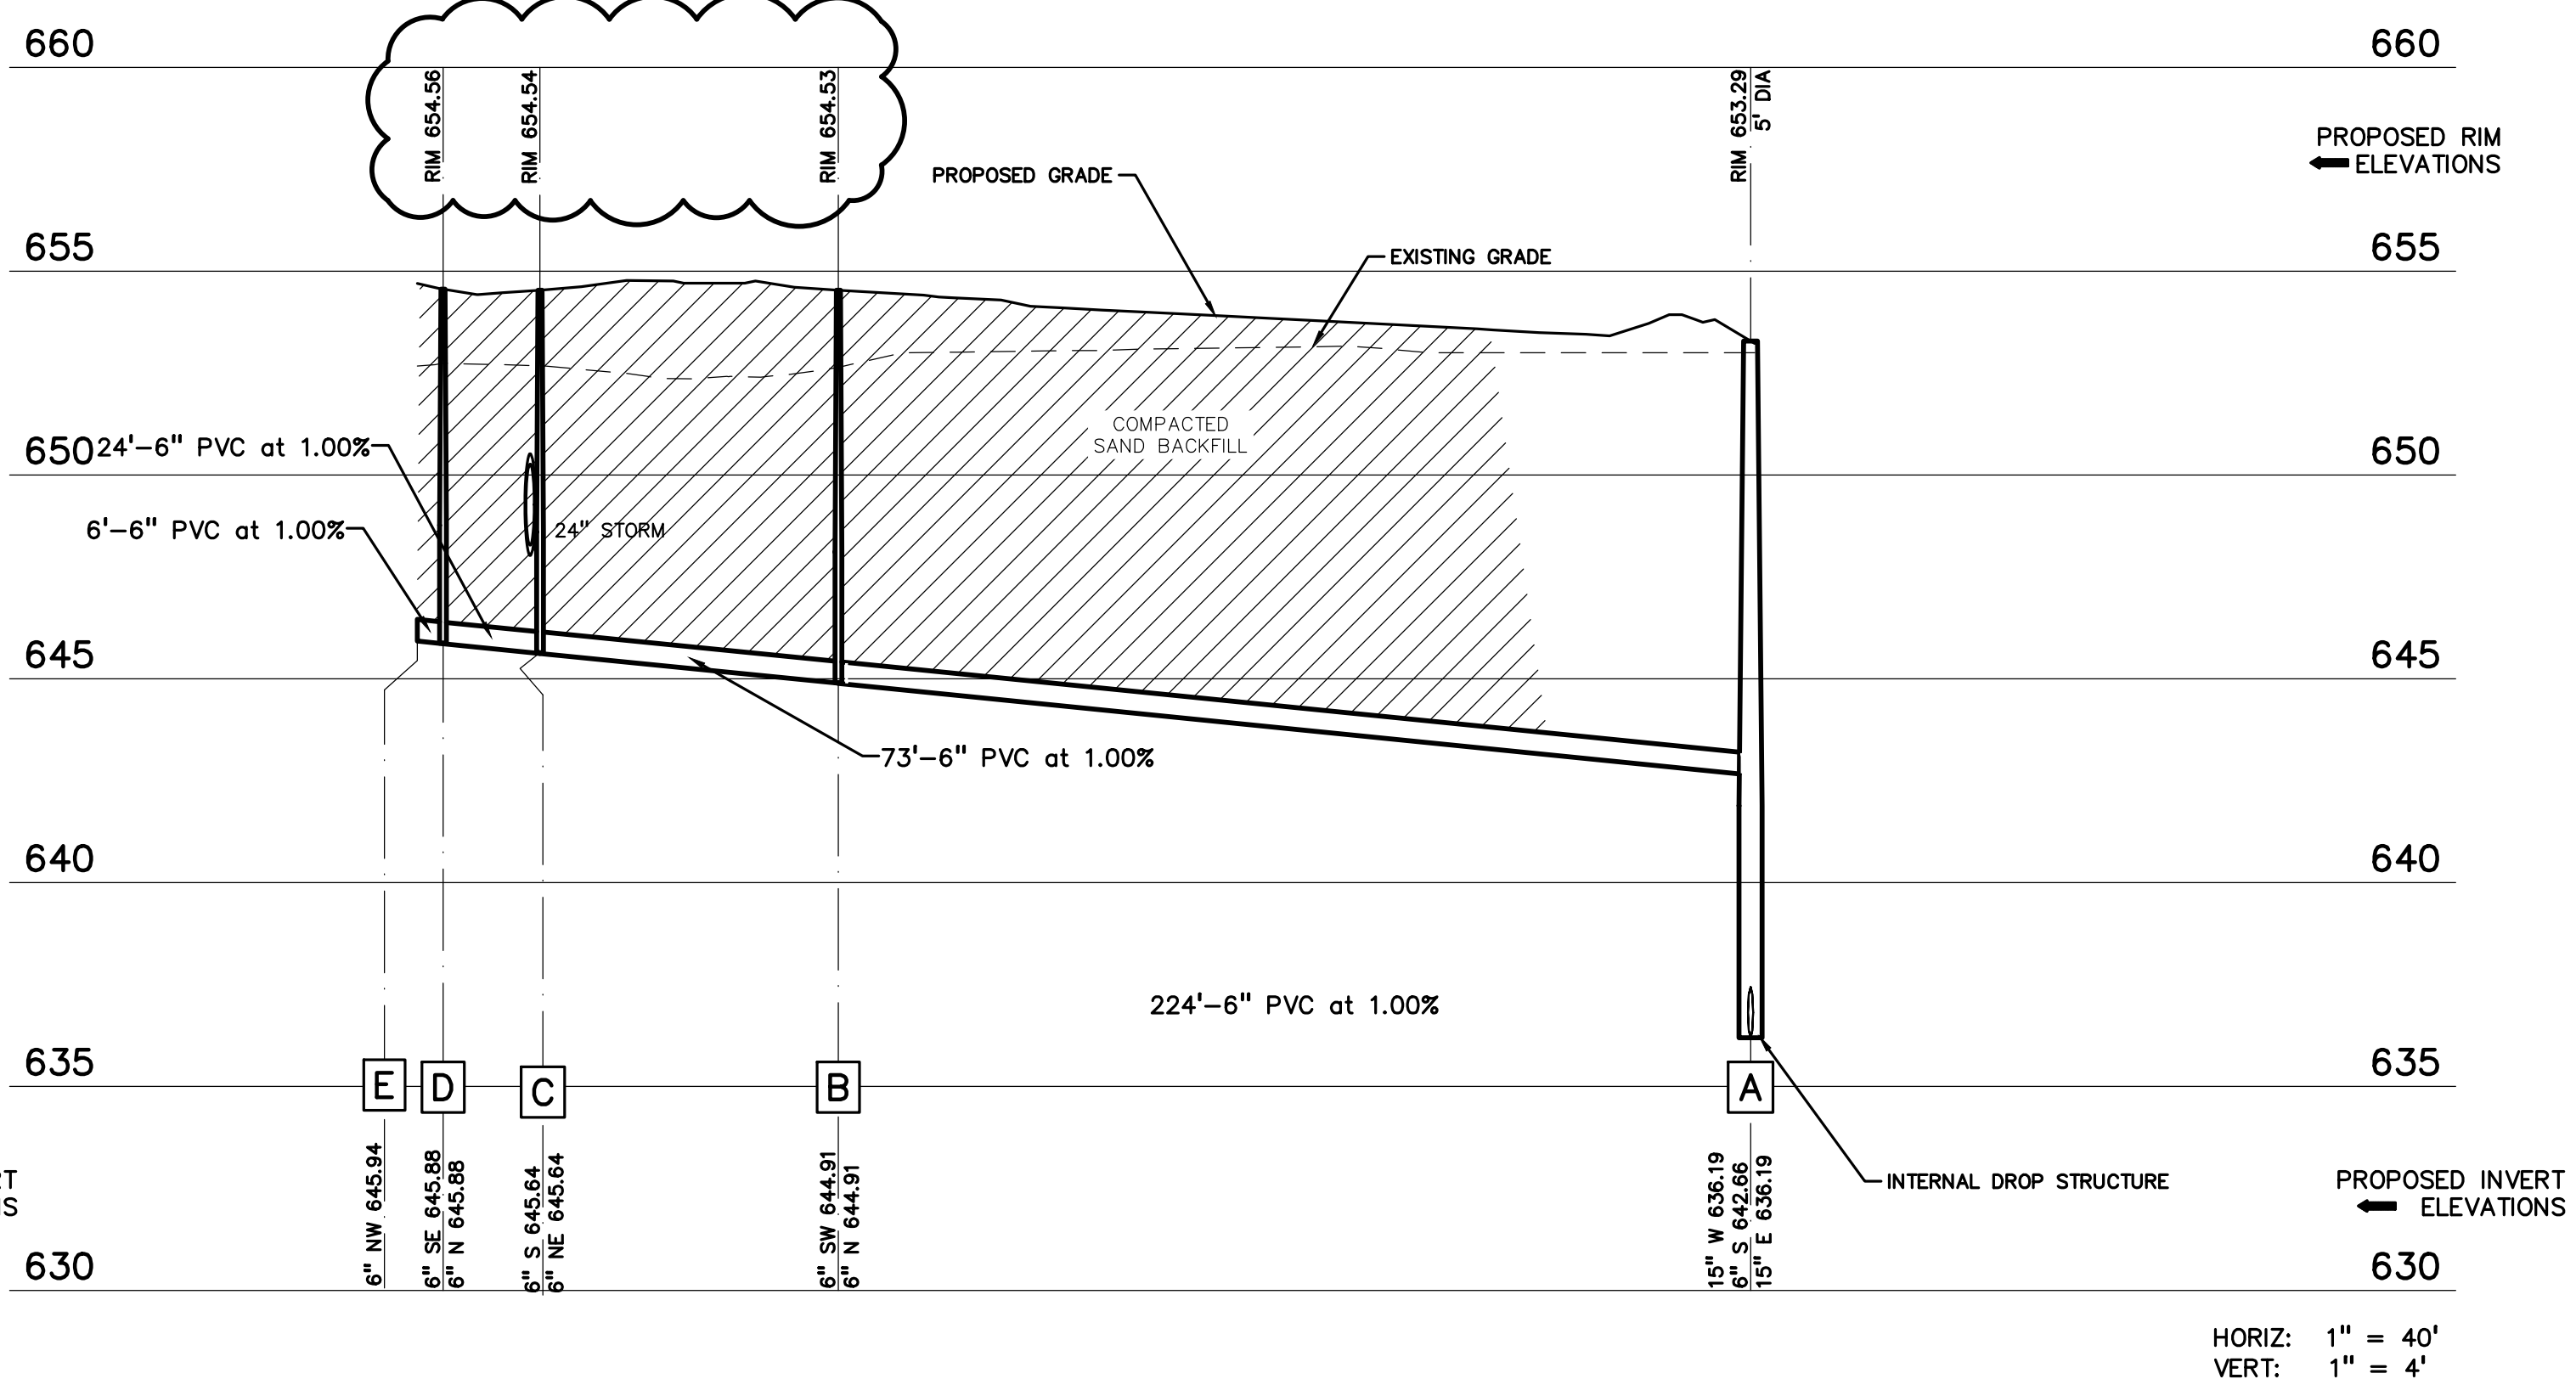

PROPOSED BUILDING SANITARY SEWER PROFILE



TMP ARCHITECTURE INC
1191 WEST SQUARE LAKE ROAD
BLOOMFIELD HILLS • MICHIGAN • 48302
PH • 248.338.4561 FX • 248.338.0223
EM • INFO@TMP-ARCHITECTURE.COM



CONSULTANT



PROJECT TITLE
**Athens High School
Athletic Fields
Bid Package No. 02B**

**Troy School District
Troy, Michigan**

DRAWING TITLE
UTILITY PROFILES

ISSUE DATES

.	.
.	.
01-14-2025	ADDENDUM NO. 1
12-10-2024	CONSTRUCTION DOCUMENTS


DATE:	ISSUED FOR:
DRAWN	JW
CHECKED	TD
APPROVED	TD

PROJECT NO.

22103D

DRAWING NO.

C-7.1

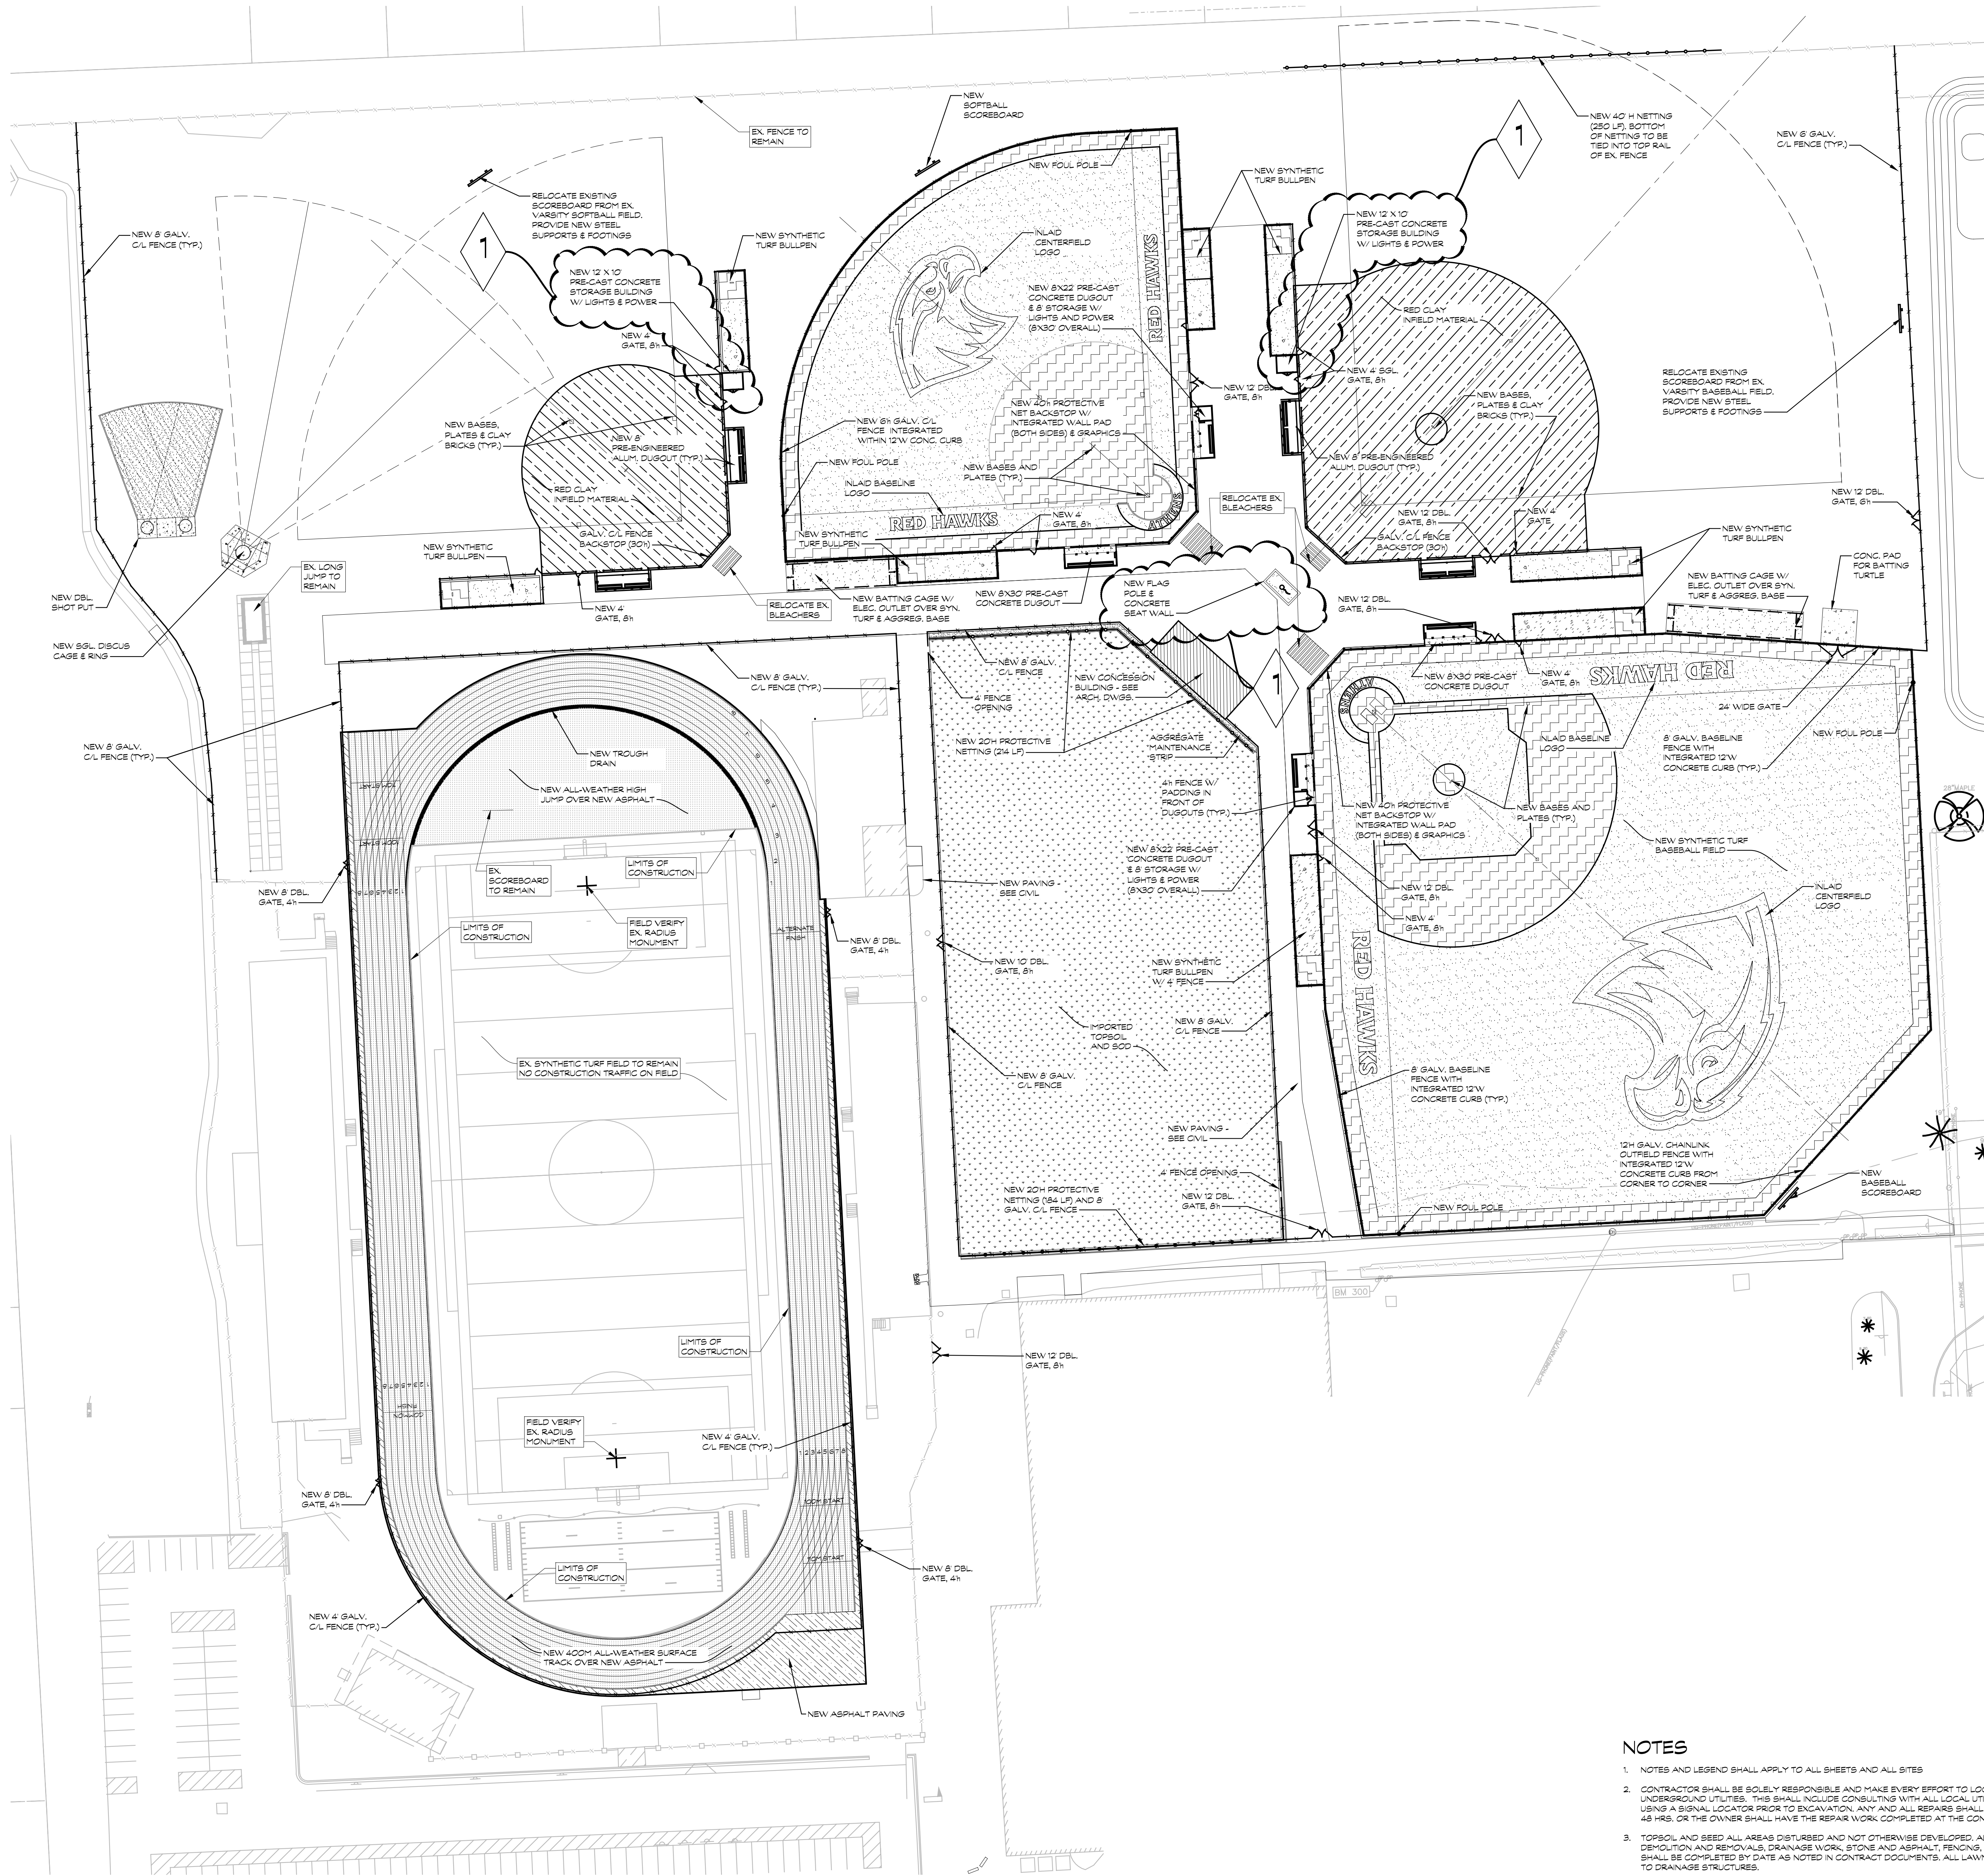

LEGEND

EXISTING

SPOT ELEVATION

FENCE

DRAINAGE STRUCTURE

STORM DRAIN

ELECTRICAL

WATER

TELEPHONE

SANITARY

GAS

PROPOSED

SPOT GRADE

TOP OF TRENCH ELEVATION

TOP OF CURB ELEVATION

TOP OF WALL ELEVATION

DRAINAGE SWALE

FENCE - SEE PLANS FOR HT.

DRAINAGE STRUCTURE

12" ATHLETIC STORM PIPE

FLAT DRAIN

4" PERFORATED DRAIN TILE

6" PERFORATED DRAIN TILE

LIGHT POLE

ELECTRICAL

WATER

TELEPHONE

IRRIGATION

LIMITS OF CONSTRUCTION

ALL-WEATHER SURFACE
OVER ATHLETIC VIRGIN
ASPHALT (2 LIFTS)
OVER 21AA LIMESTONE BASE

ATHLETIC VIRGIN ASPHALT (2 LIFTS)
OVER 21AA LIMESTONE BASE

ALL-WEATHER SURFACE
OVER REINFORCED CONCRETE
OVER COMPACTED SAND BASE

NON-REINFORCED CONCRETE
OVER COMPACTED SAND BASE

REINFORCED CONCRETE
OVER 21AA LIMESTONE BASE

DEMOLITION

TOPSOIL AND SOD

TOPSOIL AND SEED

CRUSHED LIMESTONE
ATHLETIC MEAL

CRUSHER DUST


SYNTHETIC TURF

- NOTES
1. NOTES AND LEGEND SHALL APPLY TO ALL SHEETS AND ALL SITES.

2. CONTRACTOR SHALL BE SOLELY RESPONSIBLE AND MAKE EVERY EFFORT TO LOCATE EXISTING UNDERGROUND UTILITIES. THIS SHALL INCLUDE CONSULTING WITH ALL LOCAL UTILITY COMPANIES AND USING A SIGNAL LOCATOR PRIOR TO EXCAVATION. ANY AND ALL REPAIRS SHALL BE COMPLETED WITHIN 48 HRS. OR THE OWNER SHALL HAVE THE REPAIR WORK COMPLETED AT THE CONTRACTORS EXPENSE.

3. TOPSOIL AND SEED ALL AREAS DISTURBED AND NOT OTHERWISE DEVELOPED. ALL WORK (IE. DEMOLITION AND REMOVALS, DRAINAGE WORK, STONE AND ASPHALT, FENCES, TRACK SURFACE, ETC. SHALL BE COMPLETED BY DATE AS NOTED IN CONTRACT DOCUMENTS. ALL LAWN AREAS SHALL SLOPE TO DRAINAGE STRUCTURES.

4. ALL CONTOURS AND SPOT GRADES REFER TO FINISH GRADE OF LAWN, ASPHALT, OR CONCRETE. DO NOT FACTOR IN THE ACRYLIC COATING DEPTH.

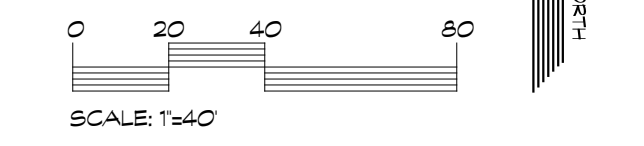

TMP ARCHITECTURE INC
1191 WEST SQUARE LAKE ROAD
BLOOMFIELD HILLS - MICHIGAN - 48302
PH - 248.338.4561 FX - 248.338.0023
EM - INFO@TMPARCHITECTURE.COM

REGISTRATION SEAL

CONSULTANT

PROJECT TITLE

Athens High School
Athletic Fields
Bid Package No. 02B

Troy School District
Troy, Michigan

DRAWING TITLE

Athletics Site Plan

ISSUE DATES

01-14-2025	ADDENDUM NO.1
12-10-2024	CONSTRUCTION DOCUMENTS

DATE:

ISSUED FOR:

DRAWN

JB

CHECKED

HD

APPROVED


MDS

PROJECT NO.

22103D

DRAWING NO.


L1.00

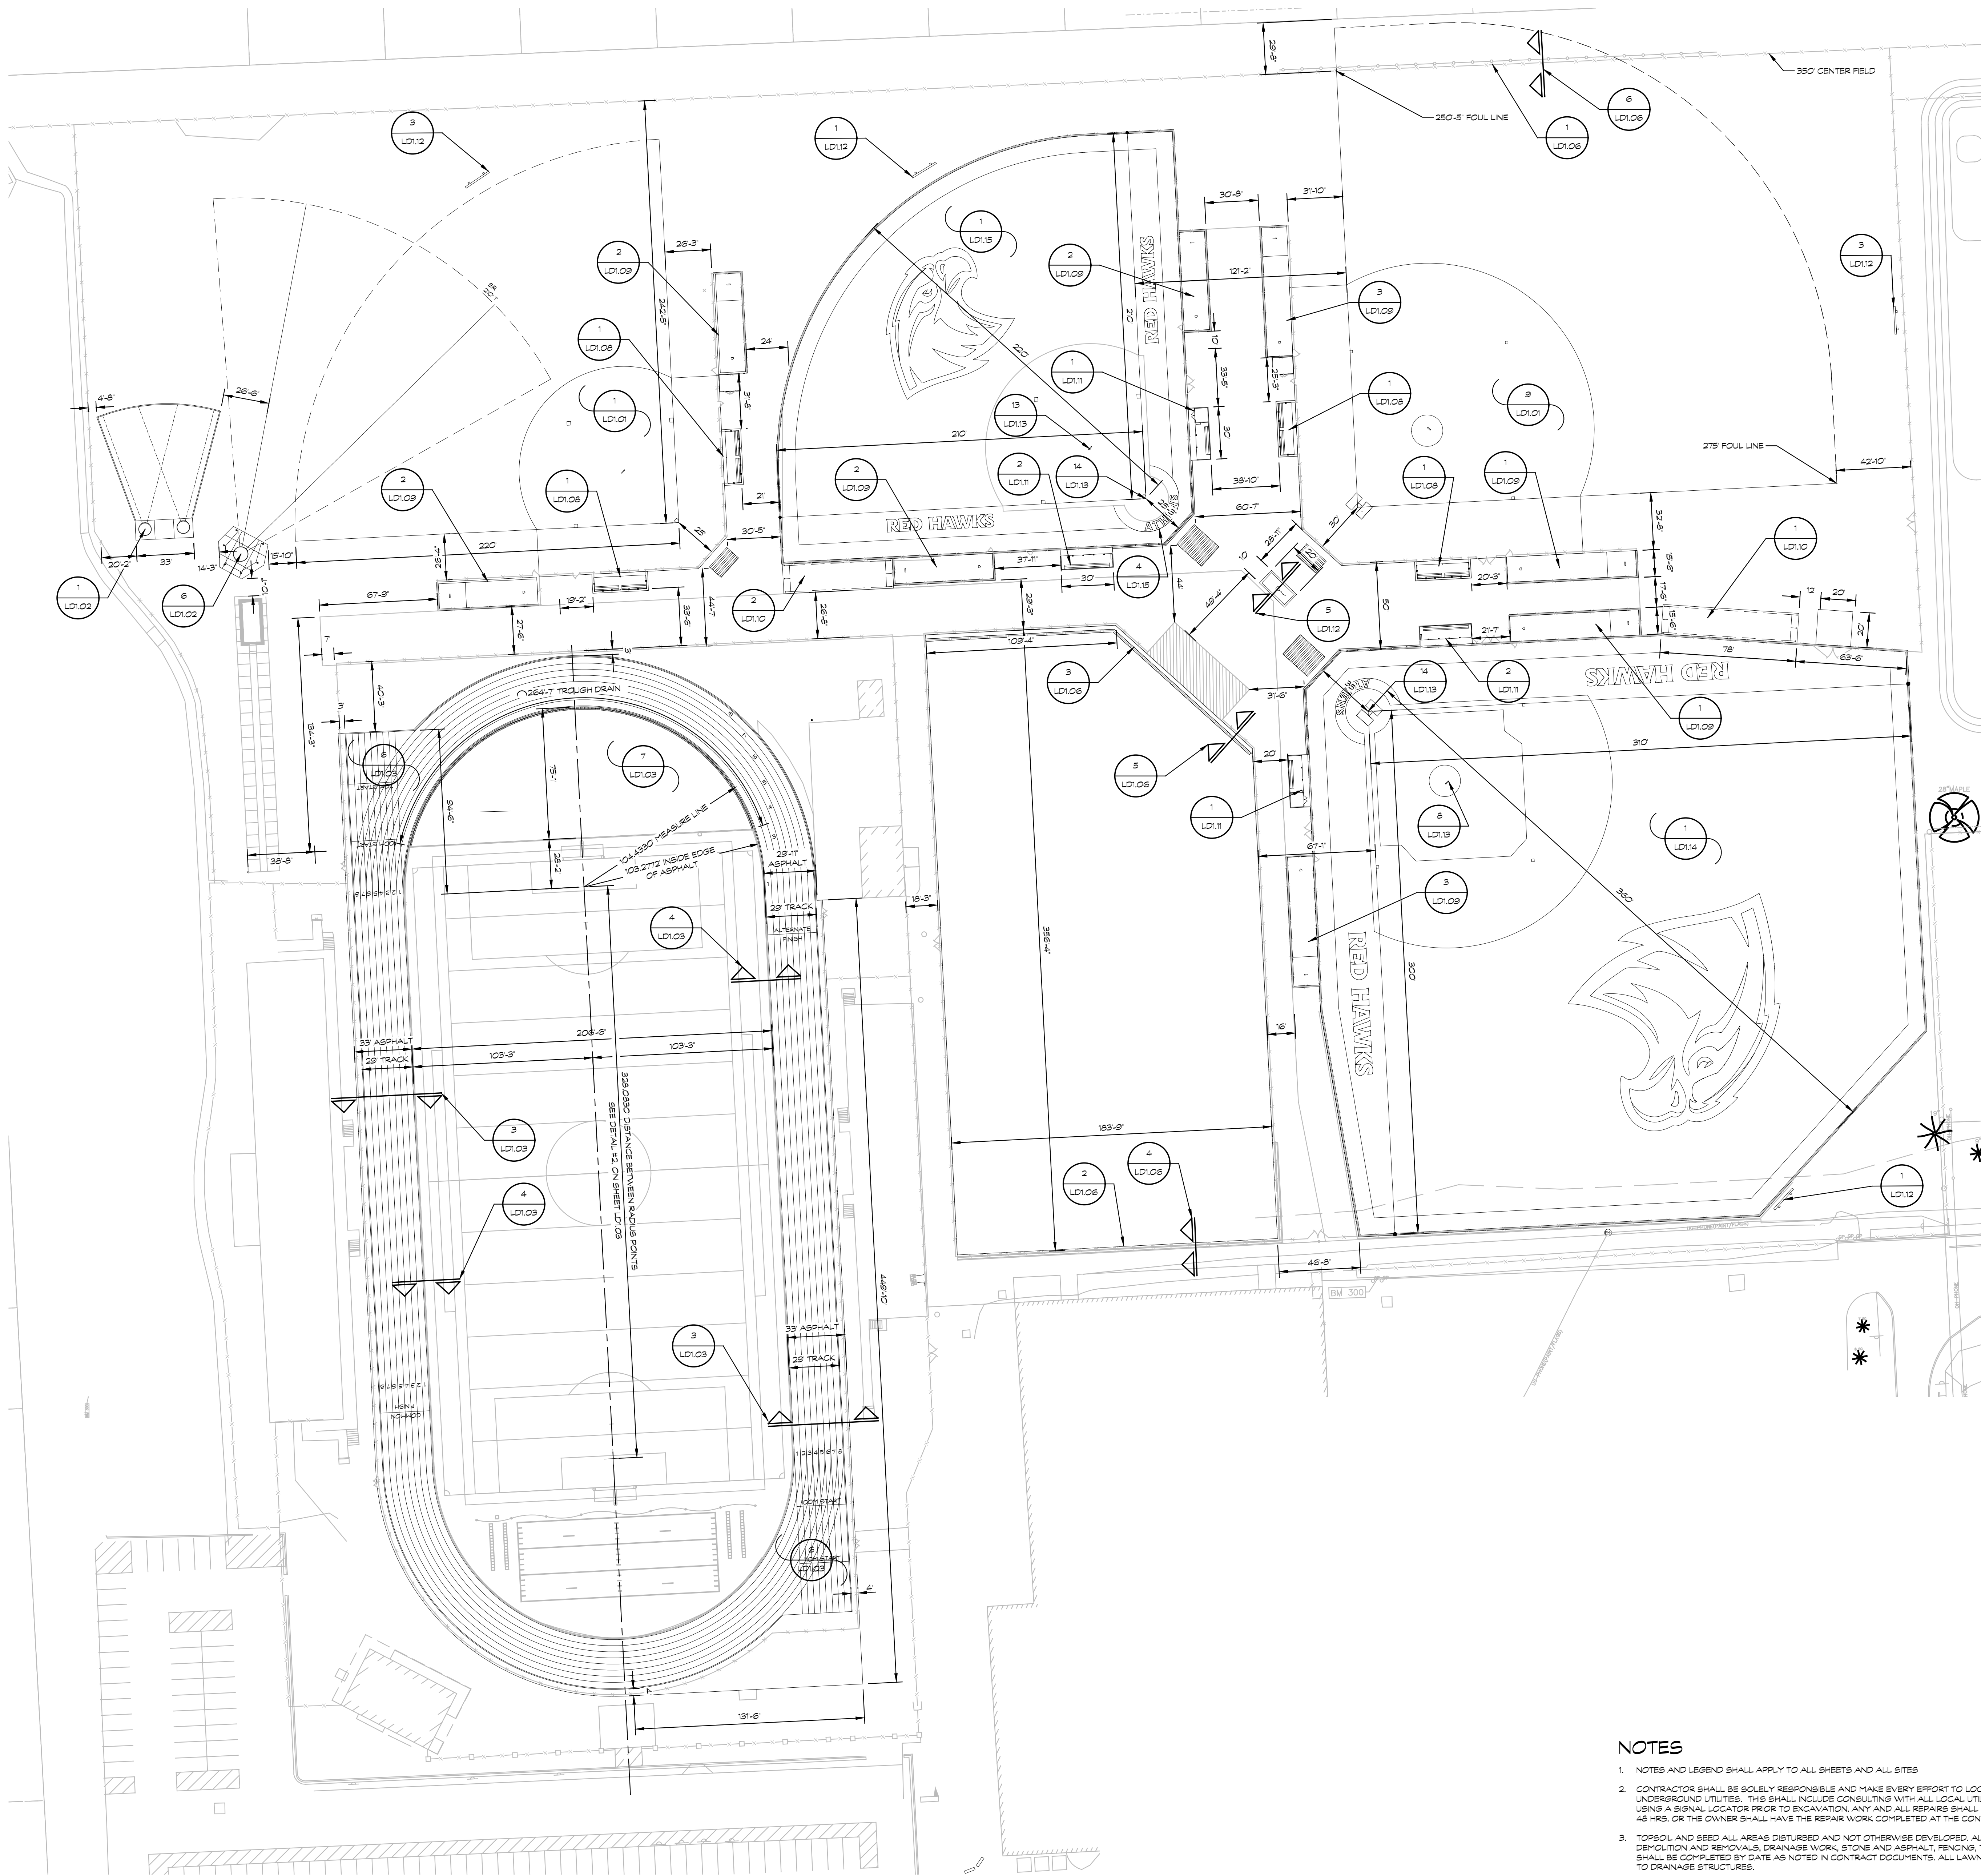

LEGEND
EXISTING
1.00 SPOT ELEVATION
FENCE
DRAINAGE STRUCTURE
STORM DRAIN
ELECTRICAL
WATER
TELEPHONE
SANTARY
GAS

PROPOSED
100.00 SPOT GRADE
TOP OF TRENCH ELEVATION
TOP OF CURB ELEVATION
TOP OF WALL ELEVATION
DRAINAGE SWALE
FENCE - SEE PLANS FOR HT.
DRAINAGE STRUCTURE
12" ATHLETIC STORM PIPE
FLAT DRAIN
4" PERFORATED DRAIN TILE
6" PERFORATED DRAIN TILE
LIGHT POLE
ELECTRICAL
WATER
TELEPHONE
IRRIGATION
LIMITS OF CONSTRUCTION
ALL-WEATHER SURFACE OVER ATHLETIC VIRGIN ASPHALT (2 LIFTS) OVER Z1AA LIMESTONE BASE
ATHLETIC VIRGIN ASPHALT (2 LIFTS) OVER Z1AA LIMESTONE BASE
ALL-WEATHER SURFACE OVER REINFORCED CONCRETE OVER COMPACTED SAND BASE
NON-REINFORCED CONCRETE OVER COMPACTED SAND BASE
REINFORCED CONCRETE OVER Z1AA LIMESTONE BASE
DEMOLITION
TOPSOIL AND SOG
TOPSOIL AND SEED
CRUSHED LIMESTONE ATHLETIC MEAL
CRUSHER DUST
SYNTHETIC TURF

- NOTES**
- NOTES AND LEGEND SHALL APPLY TO ALL SHEETS AND ALL SITES
 - CONTRACTOR SHALL BE SOLELY RESPONSIBLE AND MAKE EVERY EFFORT TO LOCATE EXISTING UNDERGROUND UTILITIES. THIS SHALL INCLUDE CONSULTING WITH ALL LOCAL UTILITY COMPANIES AND USING A SIGNAL LOCATOR PRIOR TO EXCAVATION. ANY AND ALL REPAIRS SHALL BE COMPLETED WITHIN 48 HRS. OR THE OWNER SHALL HAVE THE REPAIR WORK COMPLETED AT THE CONTRACTORS EXPENSE.
 - TOPSOIL AND SEED ALL AREAS DISTURBED AND NOT OTHERWISE DEVELOPED. ALL WORK (IE. DEMOLITION AND REMOVALS, DRAINAGE WORK, STONE AND ASPHALT, FENCING, TRACK SURFACE, ETC. SHALL BE COMPLETED BY DATE AS NOTED IN CONTRACT DOCUMENTS. ALL LAWN AREAS SHALL SLOPE TO DRAINAGE STRUCTURES.
 - ALL CONTOURS AND SPOT GRADES REFER TO FINISH GRADE OF LAWN, ASPHALT, OR CONCRETE. DO NOT FACTOR IN THE ACRYLIC COATING DEPTH.

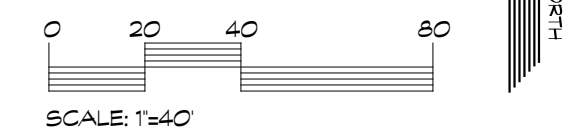

TMP ARCHITECTURE INC
1191 WEST SQUARE LAKE ROAD
BLOOMFIELD HILLS - MICHIGAN - 48302
PH - 248.338.4561 FX - 248.338.0233
EM - INFO@TMPARCHITECTURE.COM

REGISTRATION SEAL

CONSULTANT



PROJECT TITLE
**Athens High School
Athletic Fields
Bid Package No. 02B**

Troy School District
Troy, Michigan


DRAWING TITLE
Athletics Dimension Plan

ISSUE DATES

01-14-2025	ADDENDUM NO.1
12-10-2024	CONSTRUCTION DOCUMENTS
DATE:	ISSUED FOR:
DRAWN	JB
CHECKED	HD
APPROVED	MDS

PROJECT NO.
22103D
DRAWING NO.
L1.01

1

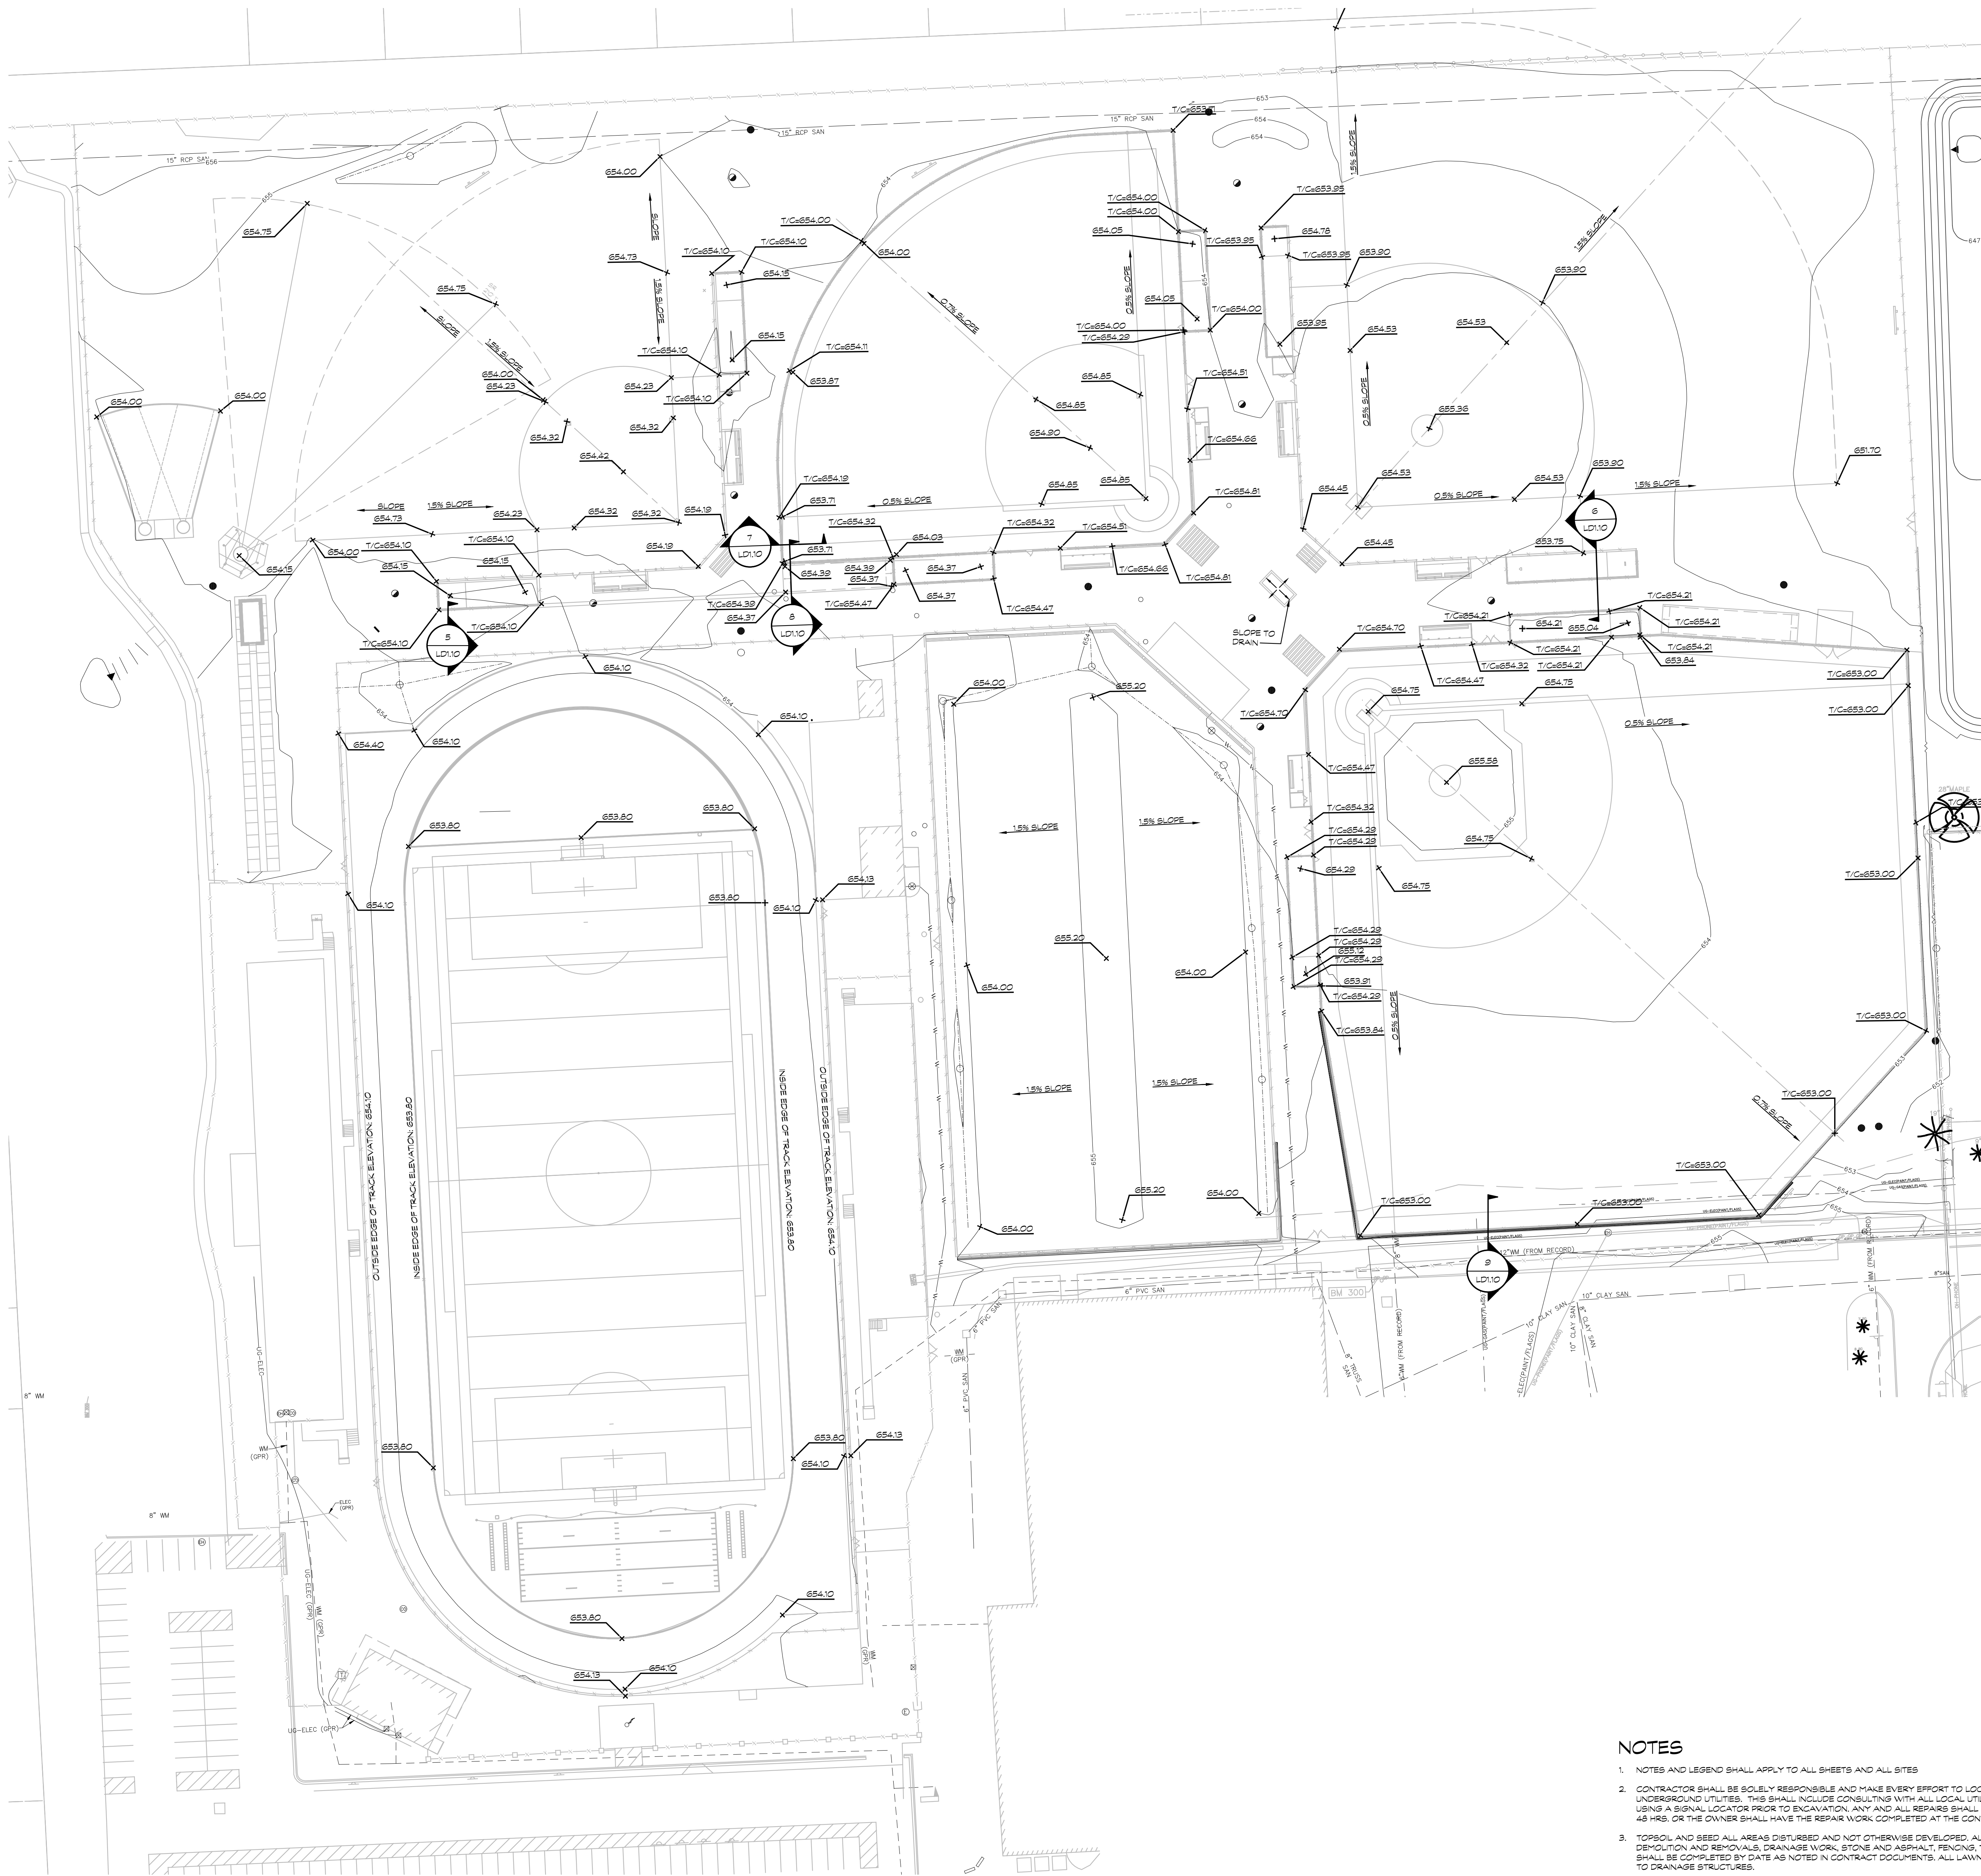

LEGEND

EXISTING

100.00

SPOT ELEVATION

FENCE

DRAINAGE STRUCTURE

STORM DRAIN

ELECTRICAL

WATER

TELEPHONE

SANITARY

GAS

PROPOSED

100.00

SPOT GRADE

T/C 100.00

TOP OF TRENCH ELEVATION

T/C 100.00

TOP OF CURB ELEVATION

T/W 100.00

TOP OF WALL ELEVATION

DRAINAGE SWALE

FENCE - SEE PLANS FOR HT.

DRAINAGE STRUCTURE

12" ATHLETIC STORM PIPE

FLAT DRAIN

4" PERFORATED DRAIN

6" PERFORATED DRAIN

LIGHT POLE

ELECTRICAL

WATER

TELEPHONE

IRRIGATION

LIMITS OF CONSTRUCTION

ALL-WEATHER SURFACE
OVER ATHLETIC VIRGIN
ASPHALT (2 LIFTS)
OVER Z1AA LIMESTONE BASE

ATHLETIC VIRGIN ASPHALT (2 LIFTS)
OVER Z1AA LIMESTONE BASE

ALL-WEATHER SURFACE
OVER REINFORCED CONCRETE
OVER COMPACTED SAND BASE

NON-REINFORCED CONCRETE
OVER COMPACTED SAND BASE

REINFORCED CONCRETE
OVER Z1AA LIMESTONE BASE

DEMOLITION

TOPSOIL AND SOD

TOPSOIL AND SEED

CRUSHED LIMESTONE
ATHLETIC MEAL

CRUSHER DUST

SYNTHETIC TURF

NOTES

1. NOTES AND LEGEND SHALL APPLY TO ALL SHEETS AND ALL SITES.

2. CONTRACTOR SHALL BE SOLELY RESPONSIBLE AND MAKE EVERY EFFORT TO LOCATE EXISTING UNDERGROUND UTILITIES. THIS SHALL INCLUDE CONSULTING WITH ALL LOCAL UTILITY COMPANIES AND USING A SIGNAL LOCATOR PRIOR TO EXCAVATION. ANY AND ALL REPAIRS SHALL BE COMPLETED WITHIN 48 HRS. OR THE OWNER SHALL HAVE THE REPAIR WORK COMPLETED AT THE CONTRACTORS EXPENSE.

3. TOPSOIL AND SEED ALL AREAS DISTURBED AND NOT OTHERWISE DEVELOPED. ALL WORK, I.E. DEMOLITION AND REPAIRS, DRAINAGE WORK, STONE AND ASPHALT, FENCING, TRACK SURFACE, ETC. SHALL BE COMPLETED BY DATE AS NOTED IN CONTRACT DOCUMENTS. ALL LAWN AREAS SHALL SLOPE TO DRAINAGE STRUCTURES.

4. ALL CONTOURS AND SPOT GRADES REFER TO FINISH GRADE OF LAWN, ASPHALT, OR CONCRETE. DO NOT FACTOR IN THE ACRYLIC COATING DEPTH.

TMP ARCHITECTURE INC
1191 WEST SQUARE LAKE ROAD
BLOOMFIELD HILLS, MICHIGAN 48302
PH: 248.338.4561 FX: 248.338.0233
EM: INFO@TMPARCHITECTURE.COM

REGISTRATION SEAL

CONSULTANT

PROJECT TITLE
**Athens High School
Athletic Fields
Bid Package No. 02B**

Troy School District
Troy, Michigan

DRAWING TITLE
Athletics Grading Plan

ISSUE DATES

01-14-2025	ADDENDUM NO.1
12-10-2024	CONSTRUCTION DOCUMENTS
DATE:	ISSUED FOR:
DRAWN	J.B
CHECKED	HD
APPROVED	MDS

PROJECT NO.
22103D
DRAWING NO.
L1.03

1



LEGEND

EXISTING

PROPOSED

1/2" SPOT ELEVATION

FENCE

DRAINAGE STRUCTURE

STORM DRAIN

0+0 LIGHT POLE

ELECTRICAL

WATER

TELEPHONE

SANITARY

GAS

100.00 SPOT GRADE

T/100.00 TOP OF TRENCH ELEVATION

T/100.00 TOP OF CURB ELEVATION

T/100.00 TOP OF WALL ELEVATION

DRAINAGE SWALE

FENCE - SEE PLANS FOR HT.

DRAINAGE STRUCTURE

12" ATHLETIC STORM PIPE

FLAT DRAIN

4" PERFORATED DRAIN

6" PERFORATED DRAIN

LIGHT POLE

ELECTRICAL

WATER

TELEPHONE

IRRIGATION

LIMITS OF CONSTRUCTION

ALL-WEATHER SURFACE OVER ATHLETIC VIRGIN ASPHALT (2 LIFTS) OVER 2" LIMESTONE BASE

ATHLETIC VIRGIN ASPHALT (2 LIFTS) OVER 2" LIMESTONE BASE

ALL-WEATHER SURFACE OVER REINFORCED CONCRETE OVER COMPACTED SAND BASE

NON-REINFORCED CONCRETE OVER COMPACTED SAND BASE

REINFORCED CONCRETE OVER 2" LIMESTONE BASE

DEMOLITION

TOPSOIL AND SOG

TOPSOIL AND SEED

CRUSHED LIMESTONE

ATHLETIC MEAL

CRUSHER DUST

SYNTHETIC TURF

UTILITY LEGEND:

1

2

3

4

5

6

7

8

NEW 12" HDPE PERFORATED DRAIN AT 0.5% SLOPE

NEW 12" CORRUGATED FLAT DRAIN

NEW 17" X 30" X 12" RECTANGULAR, QUARTZ POLYMER CONCRETE UTILITY ENCLOSURE BOX FOR CONDUIT. BOXES SHALL ABUT EDGE OF ASPHALT. COORDINATE LOCATION WITH ELECTRICAL DRAWINGS AND COORDINATE IN THE FIELD. SEE DETAIL FIG. SHEET L1.02.

NEW 6" PERFORATED DRAIN W/ PEASTONE BACKFILL (MIN. 18" COVER)

NEW 4" FINE SLOTTED DRAIN W/ SAND BACKFILL (MIN. 18" COVER)

FIELD CONNECT DRAIN TO DRAINAGE STRUCTURE OR STORM DRAIN. REFER TO CIVIL ENG. DRAWINGS FOR OVERALL SITE STORM WATER MANAGEMENT

NEW SCOREBOARD, STEEL, AND FOOTINGS. COORDINATE ALL UTILITY WORK WITH ELECTRICAL DRAWINGS

RELOCATED SCOREBOARD WITH NEW STEEL AND FOOTINGS. COORDINATE ALL UTILITY WORK WITH ELECTRICAL DRAWINGS


NOTES

1. NOTES AND LEGEND SHALL APPLY TO ALL SHEETS AND ALL SITES

2. CONTRACTOR SHALL BE SOLELY RESPONSIBLE AND MAKE EVERY EFFORT TO LOCATE EXISTING UNDERGROUND UTILITIES. THIS SHALL INCLUDE CONSULTING WITH ALL LOCAL UTILITY COMPANIES AND USING A SIGNAL LOCATOR PRIOR TO EXCAVATION. ANY AND ALL REPAIRS SHALL BE COMPLETED WITHIN 48 HRS. OR THE OWNER SHALL HAVE THE REPAIR WORK COMPLETED AT THE CONTRACTOR'S EXPENSE.

3. TOPSOIL AND SEED ALL AREAS DISTURBED AND NOT OTHERWISE DEVELOPED. ALL WORK, IE. DEMOLITION AND REMOVALS, DRAINAGE WORK, STONE AND ASPHALT, FENCING, TRACK SURFACE, ETC. SHALL BE COMPLETED BY DATE AS NOTED IN CONTRACT DOCUMENTS. ALL LAWN AREAS SHALL SLOPE TO DRAINAGE STRUCTURES.


4. ALL CONTOURS AND SPOT GRADES REFER TO FINISH GRADE OF LAWN, ASPHALT, OR CONCRETE. DO NOT FACTOR IN THE ACRYLIC COATING DEPTH.

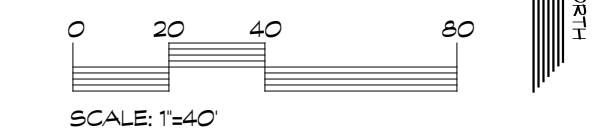

TMP ARCHITECTURE INC
1191 WEST SQUARE LAKE ROAD
BLOOMFIELD HILLS, MICHIGAN 48302
PH: 248.338.4561 FX: 248.338.0233
EM: INFO@TMPARCHITECTURE.COM

REGISTRATION SEAL

CONSULTANT

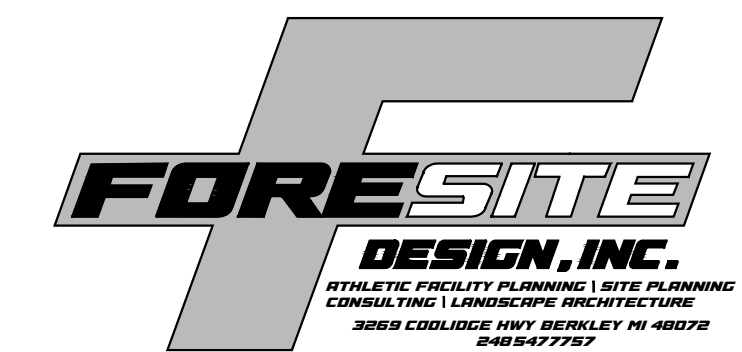

PROJECT TITLE
**Athens High School
Athletic Fields
Bid Package No. 02B**

Troy School District
Troy, Michigan

DRAWING TITLE
Athletics Drainage Plan

ISSUE DATES

DATE:	ISSUED FOR:
01-14-2025	ADDENDUM NO.1
12-10-2024	CONSTRUCTION DOCUMENTS
DRAWN	JB
CHECKED	HD
APPROVED	MDS

PROJECT NO.
22103D
DRAWING NO.
L1.04


1



TMP ARCHITECTURE INC
1191 WEST SQUARE LAKE ROAD
BLOOMFIELD HILLS - MICHIGAN - 48302
PH - 248.338.6561 FX - 248.338.0323
EM - INFO@TMP-ARCHITECTURE.COM

REGISTRATION SEAL

CONSULTANT

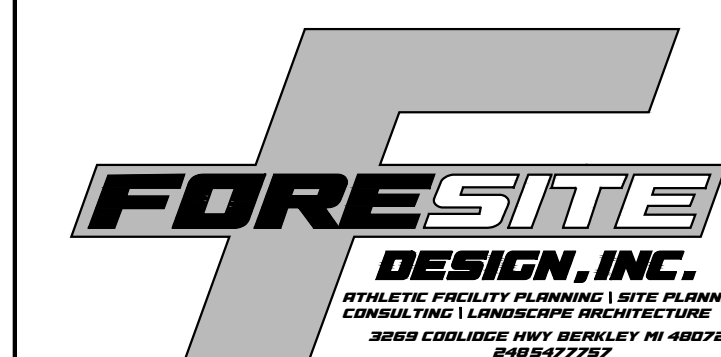

PROJECT TITLE
**Athens High School
Athletic Fields
Bid Package No. 02B**

Troy School District
Troy, Michigan

DRAWING TITLE
Site Details

ISSUE DATES

DATE:	ISSUED FOR:
01-14-2025	ADDENDUM NO.1
12-10-2024	CONSTRUCTION DOCUMENTS


DRAWN J.B.
CHECKED HD
APPROVED MDS

PROJECT NO.


22103D

DRAWING NO.


LD1.01

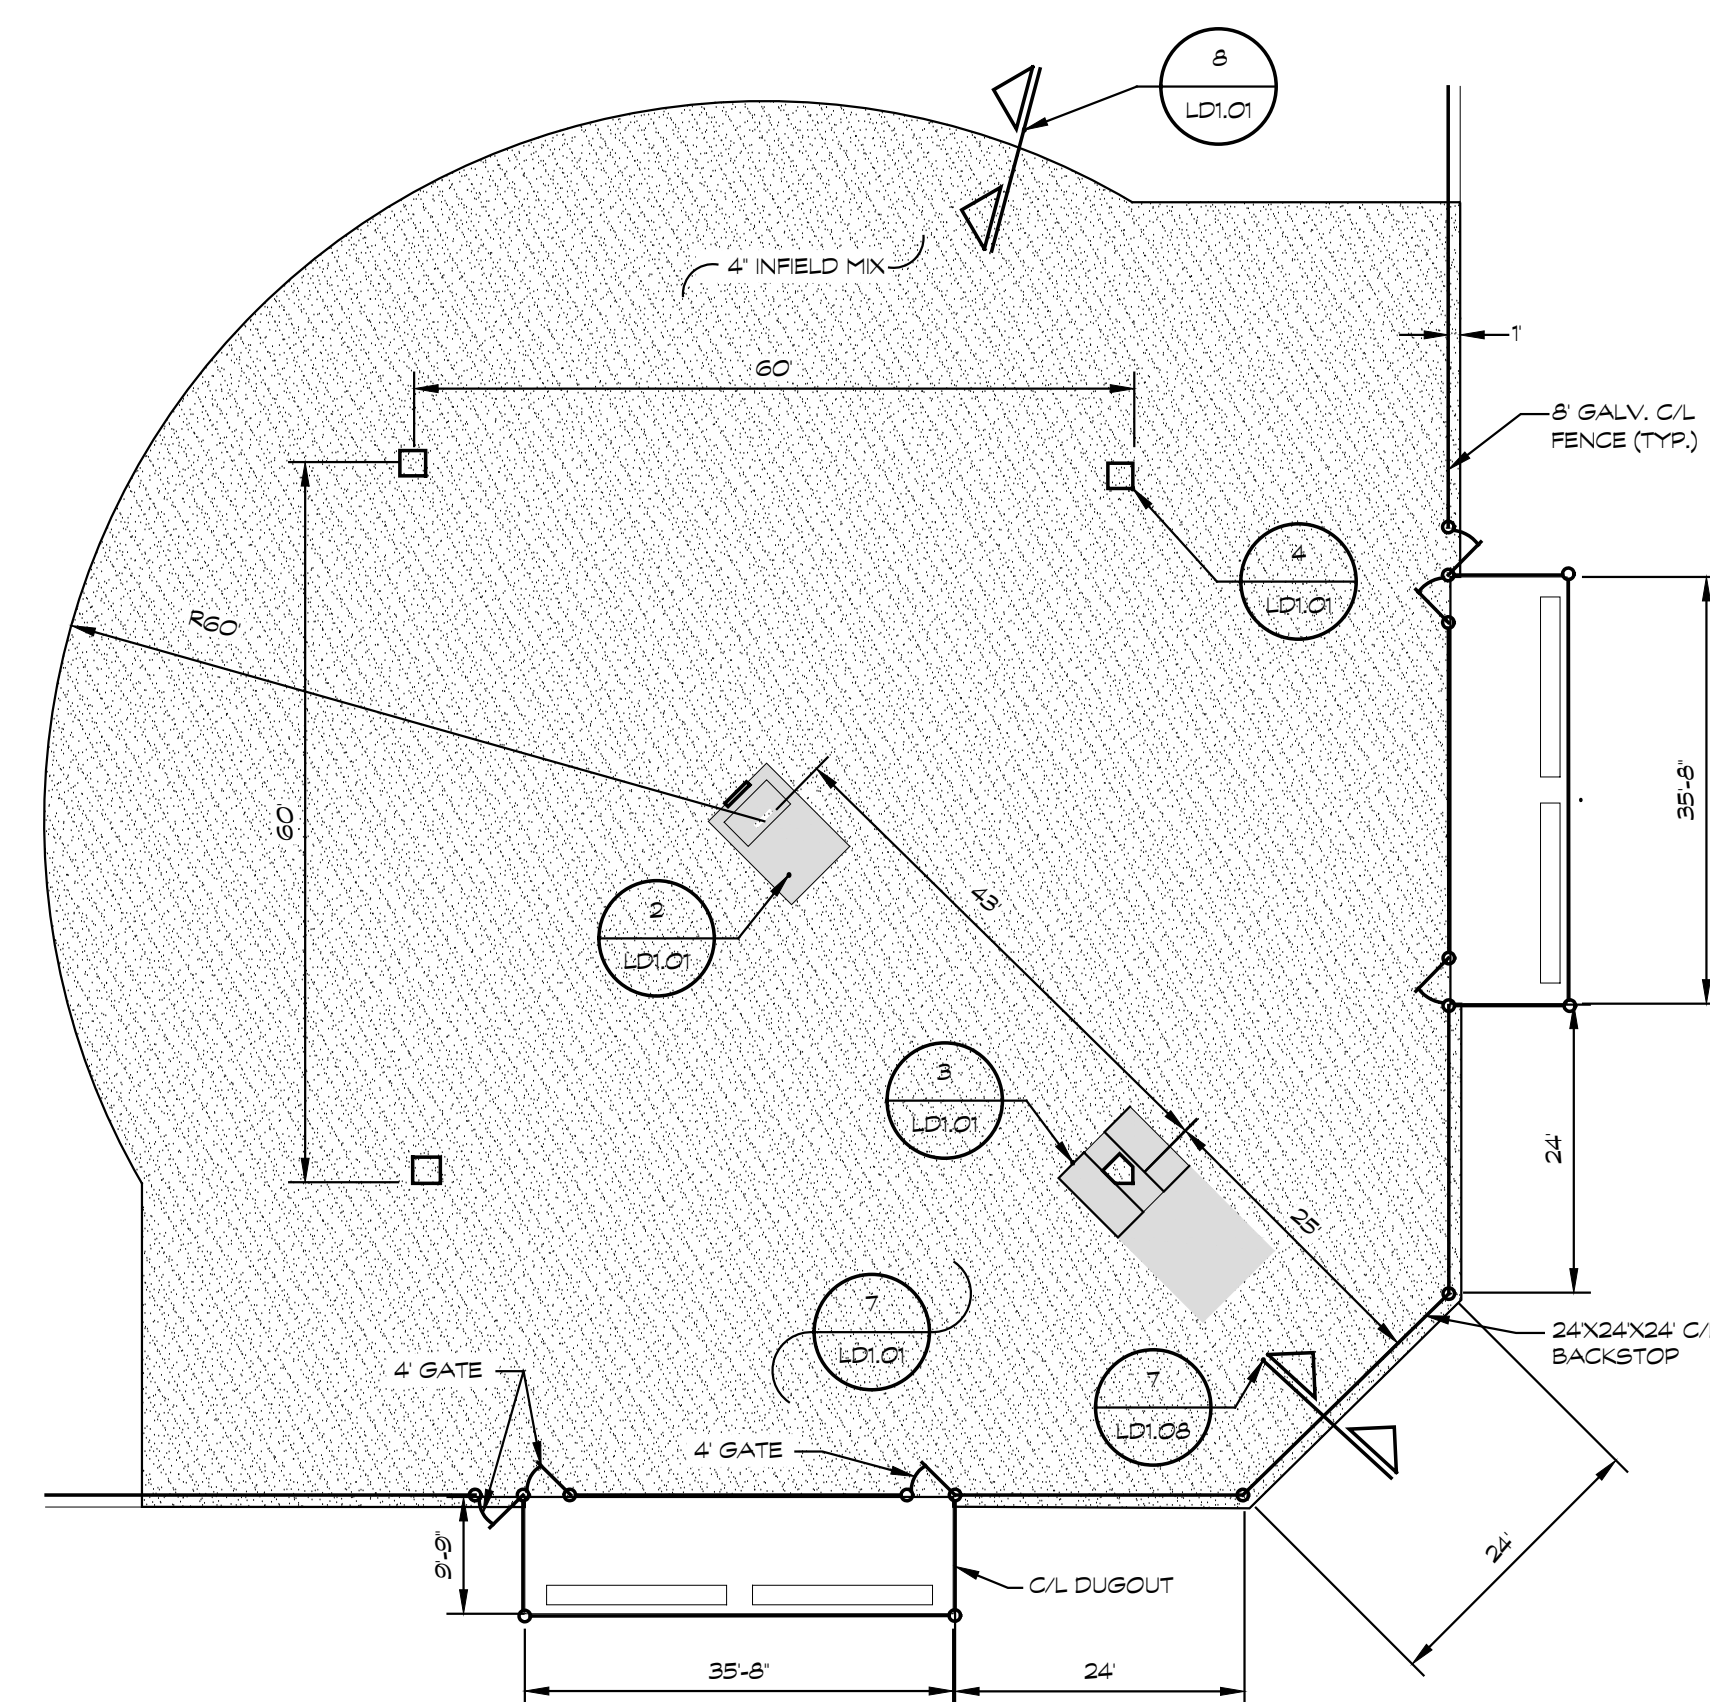


1 SOFTBALL FIELD LAYOUT
SCALE 1/16\"/>

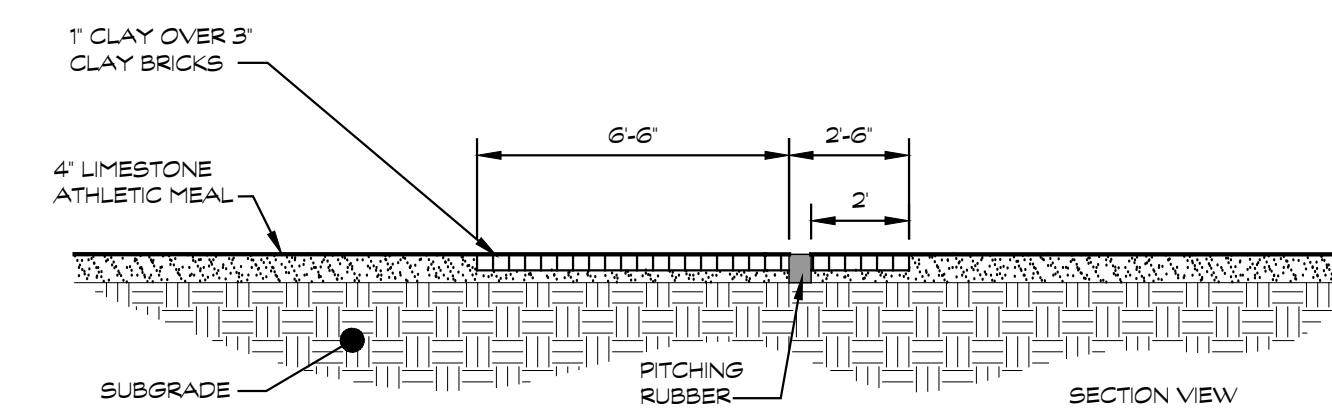


2 SOFTBALL PITCHER'S PLATE
SCALE 1/4\"/>

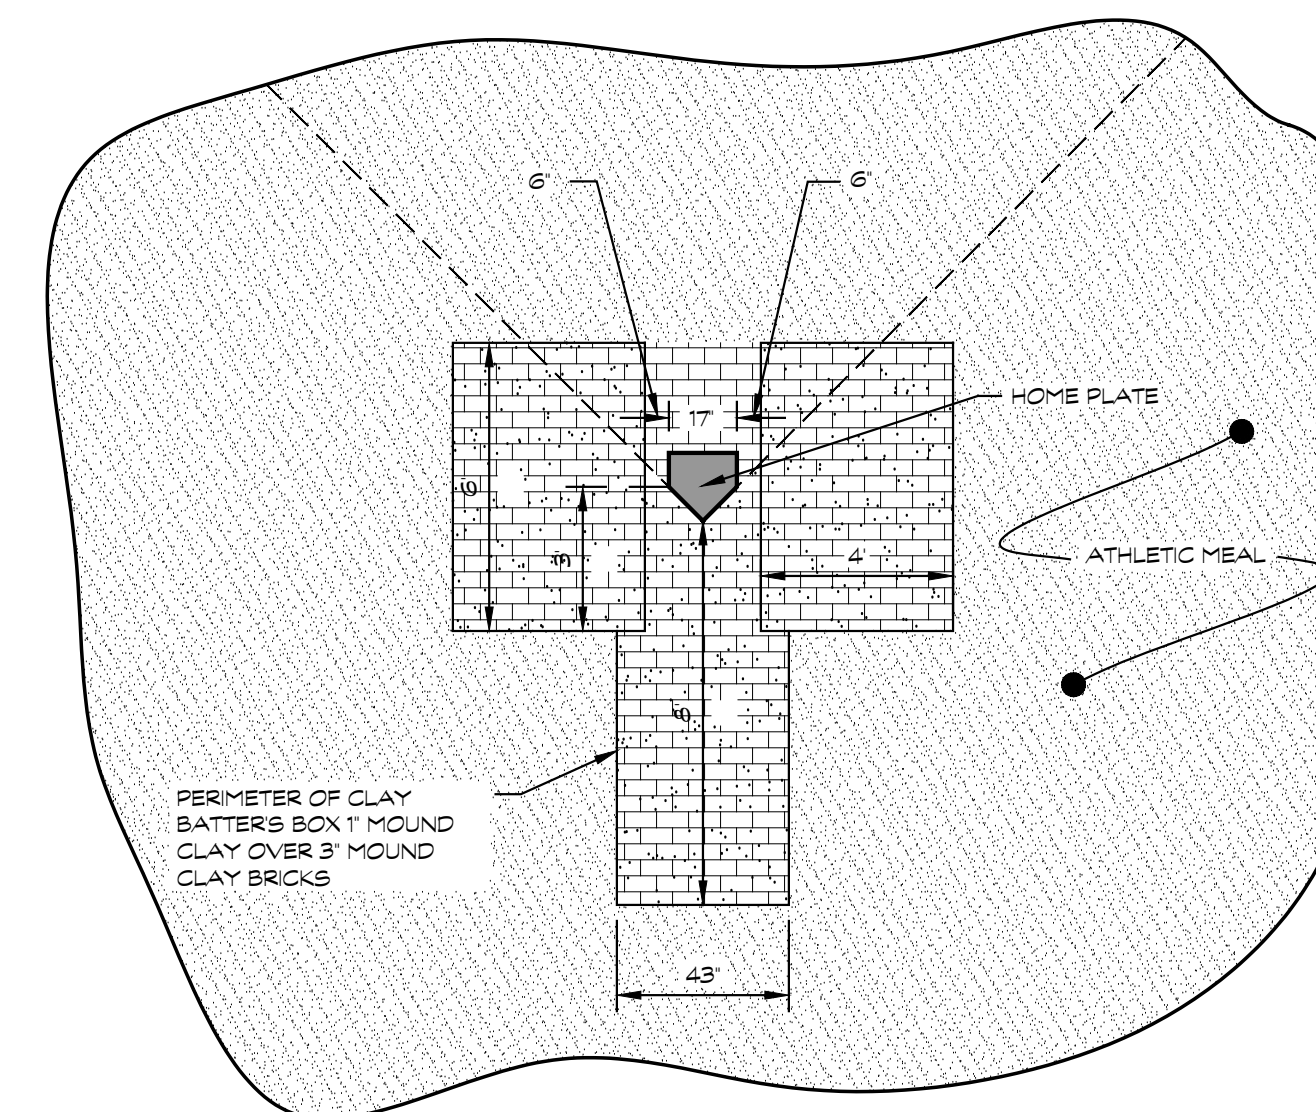


3 SOFTBALL BATTER'S BOX
SCALE 1/4\"/>

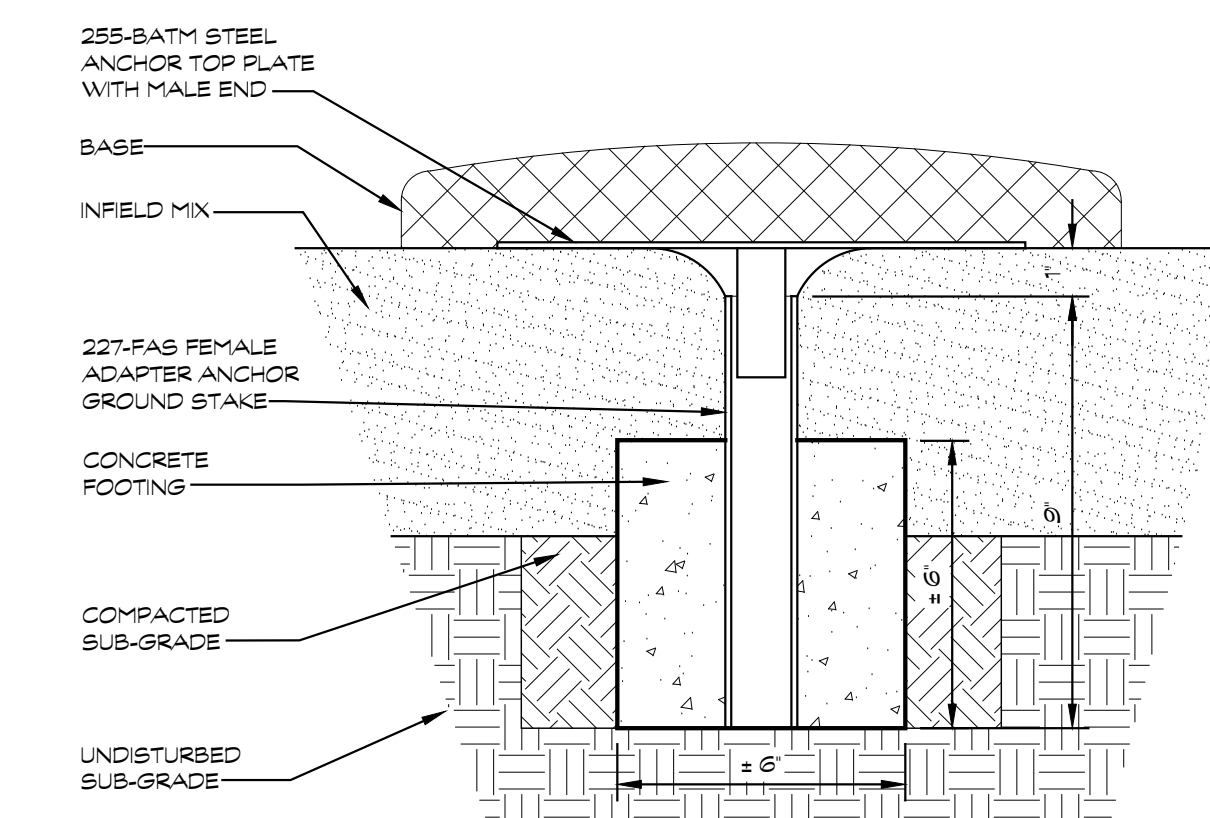


4 BASE PLATE & ANCHOR CONNECTION
SCALE 3/16\"/>

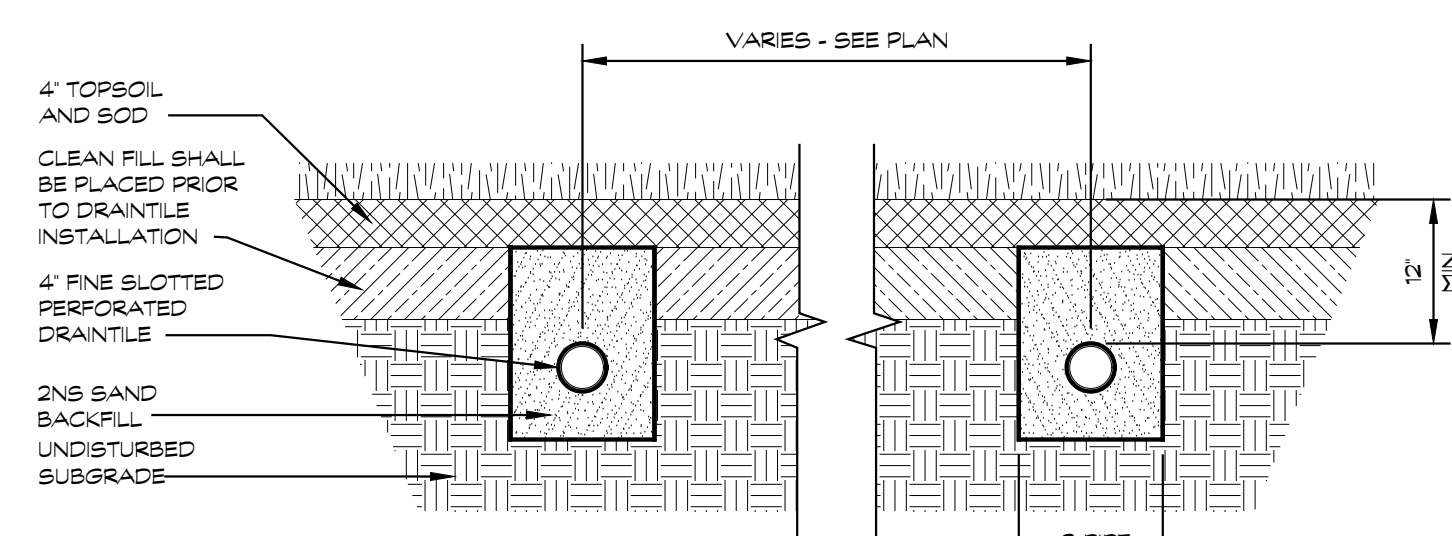


5 4\"/>

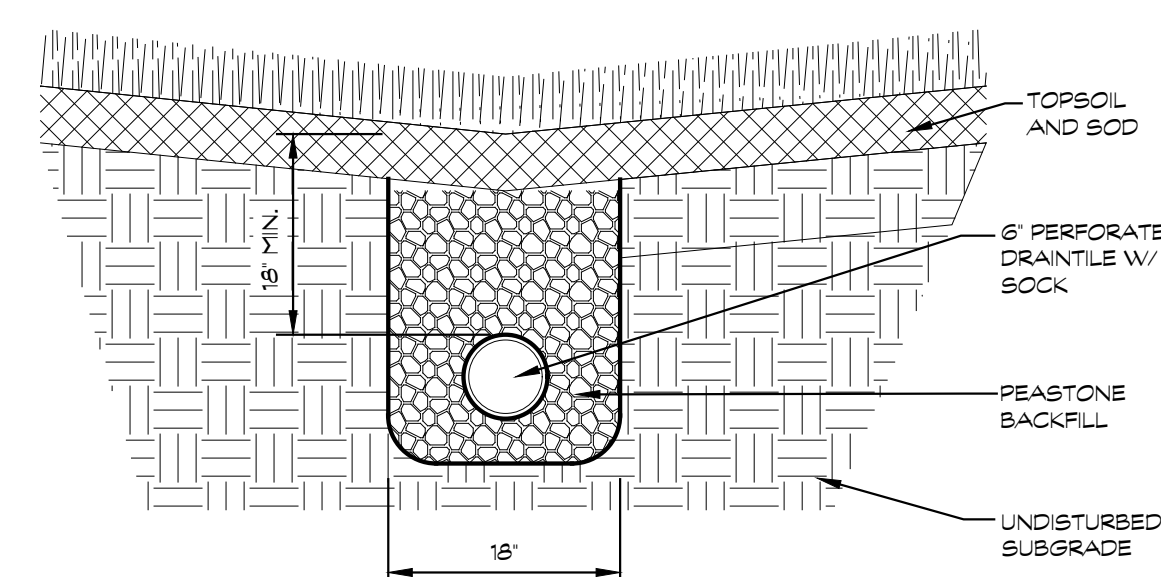


6 6\"/>

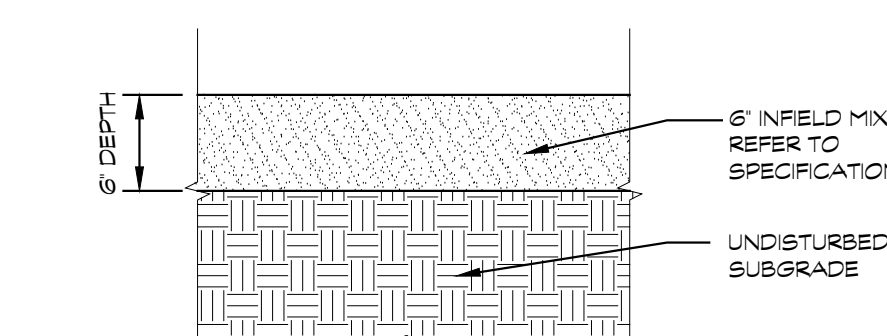


7 INFELD MIX SECTION
SCALE 1/2\"/>

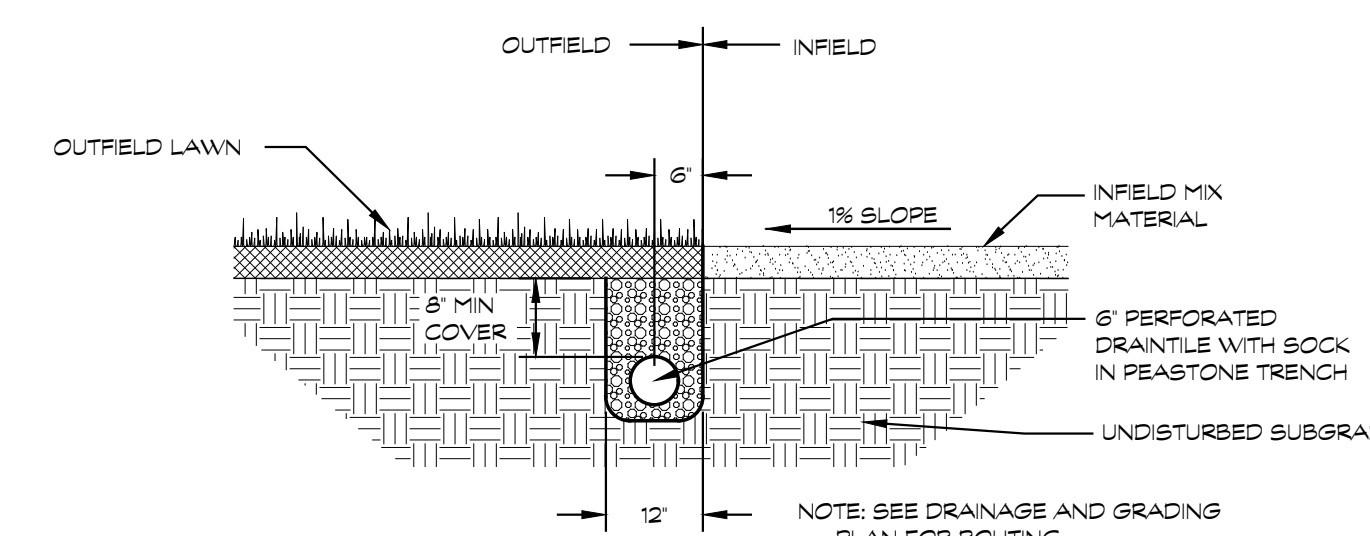


8 INFELD/OUTFIELD DRAIN SECTION
SCALE 1/2\"/>

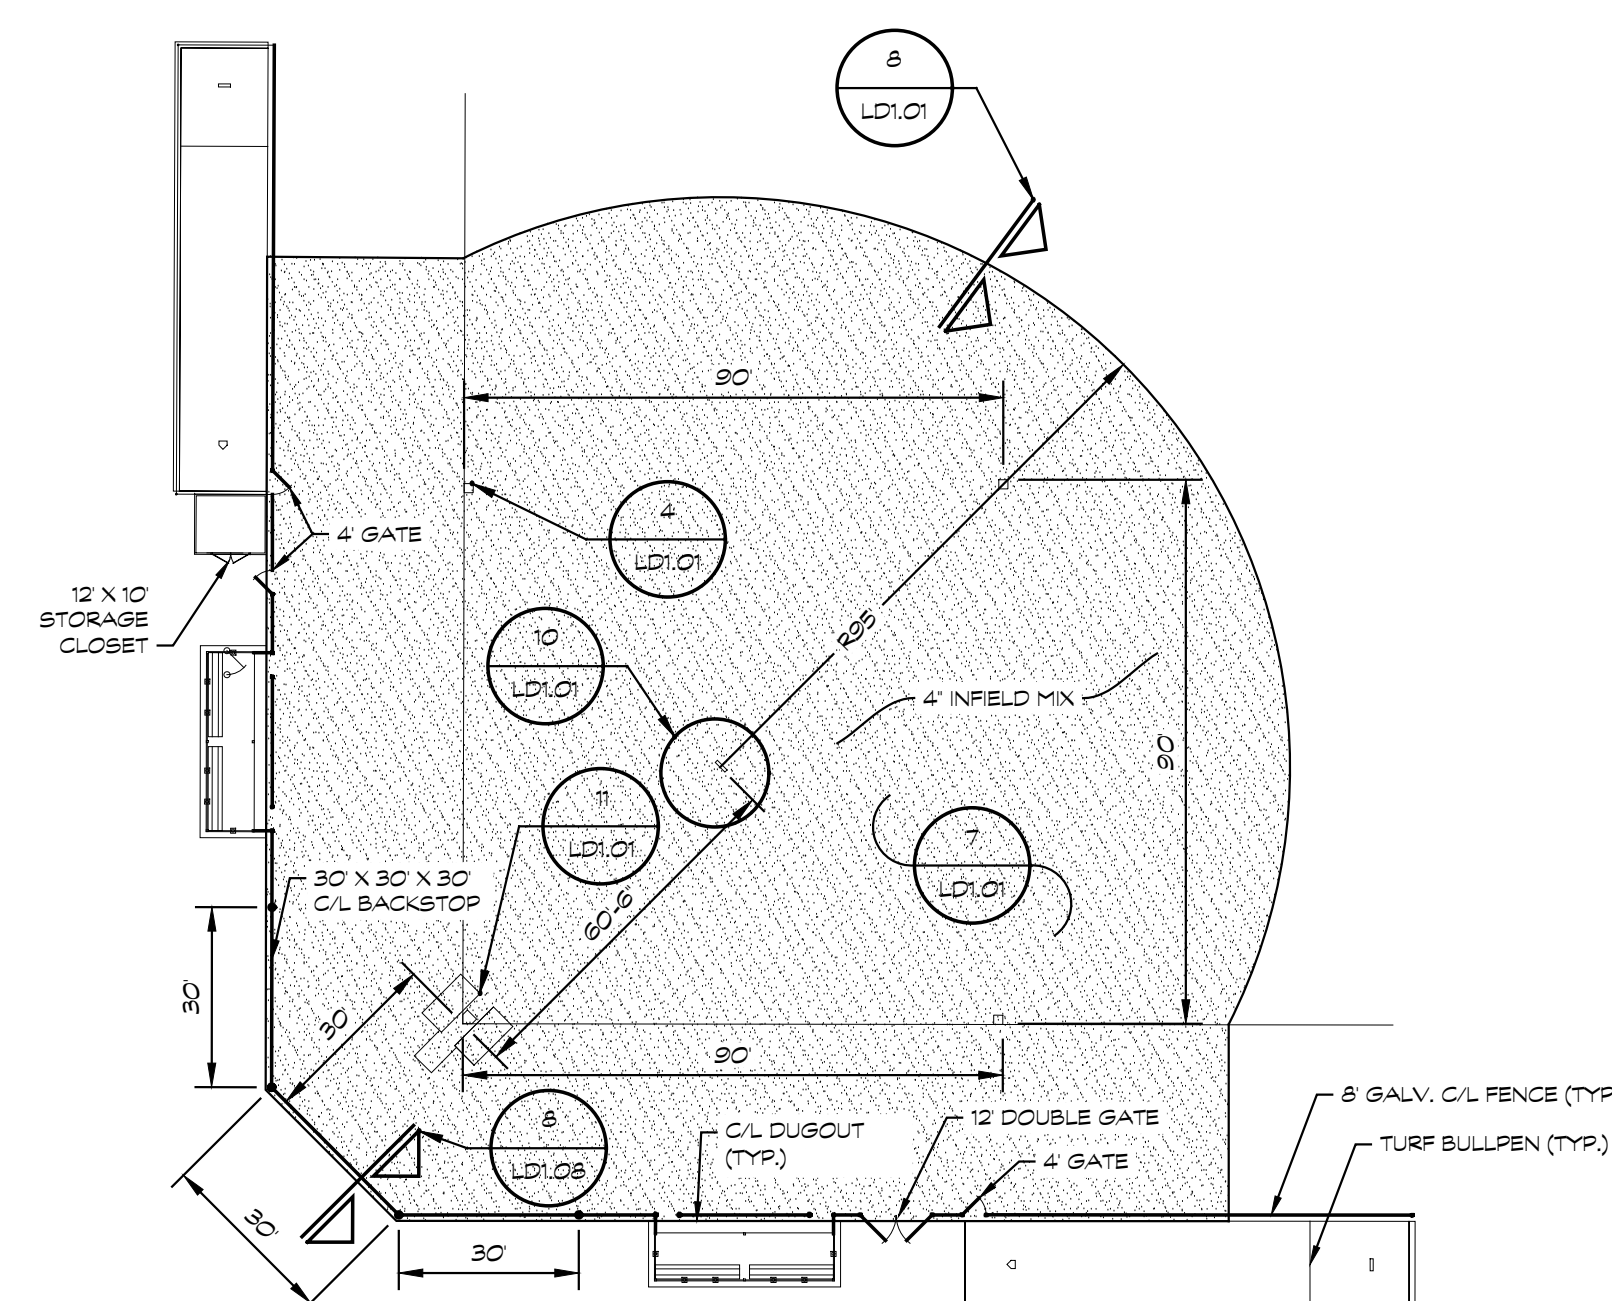

9 BASEBALL INFELD LAYOUT
SCALE 1/32\"/>








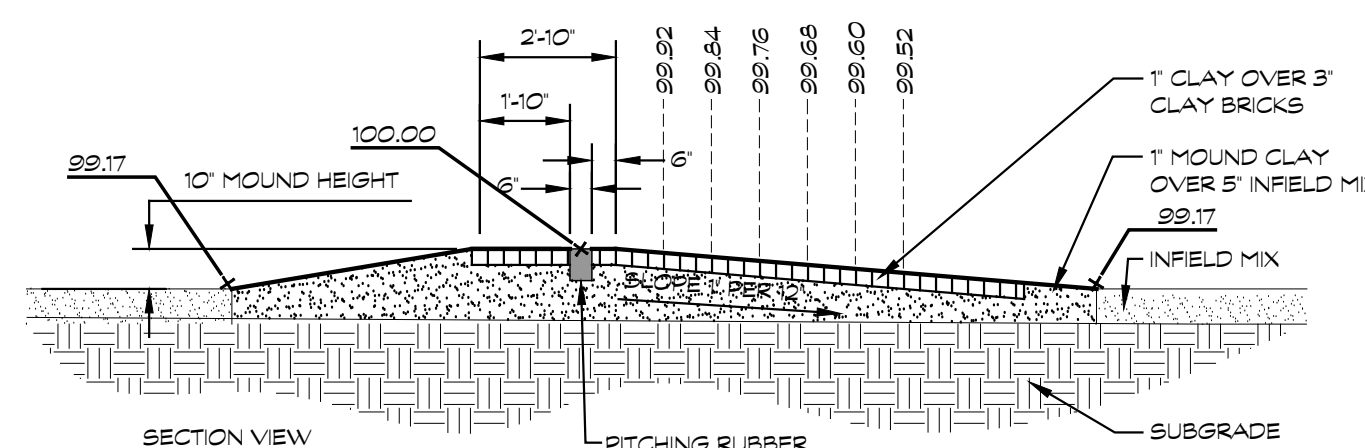



10 BASEBALL PITCHER'S MOUND
SCALE 1/4\"/>

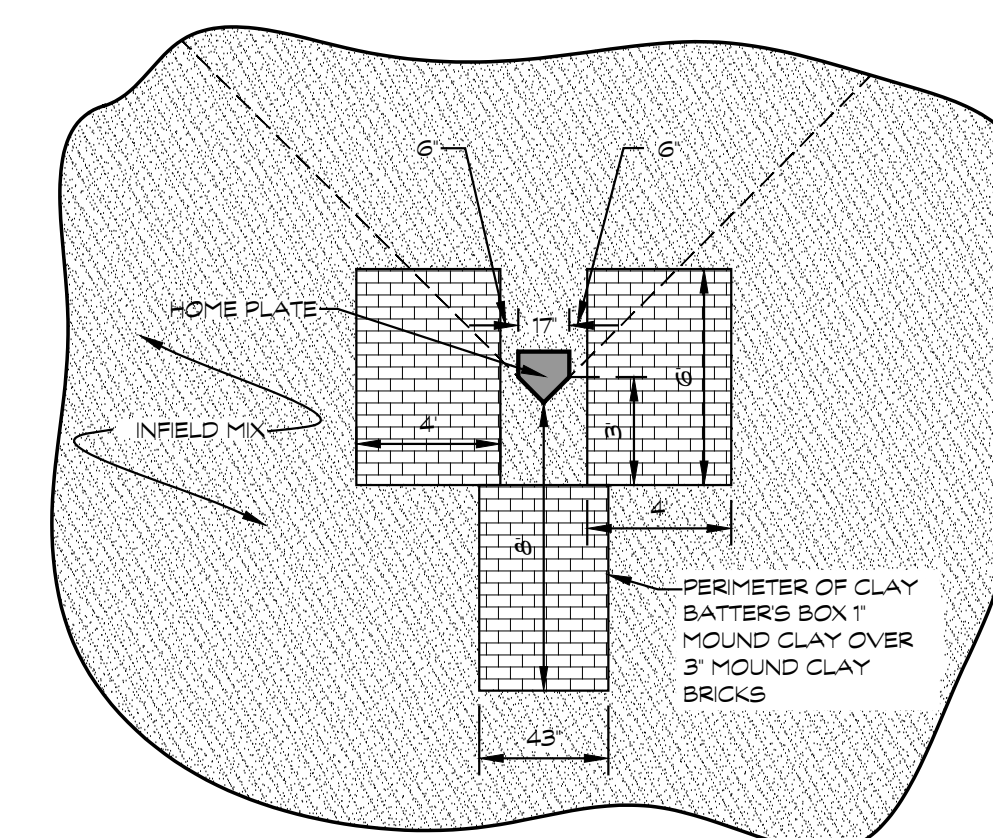


11 BASEBALL BATTER'S BOX
SCALE 3/16\"/>

1

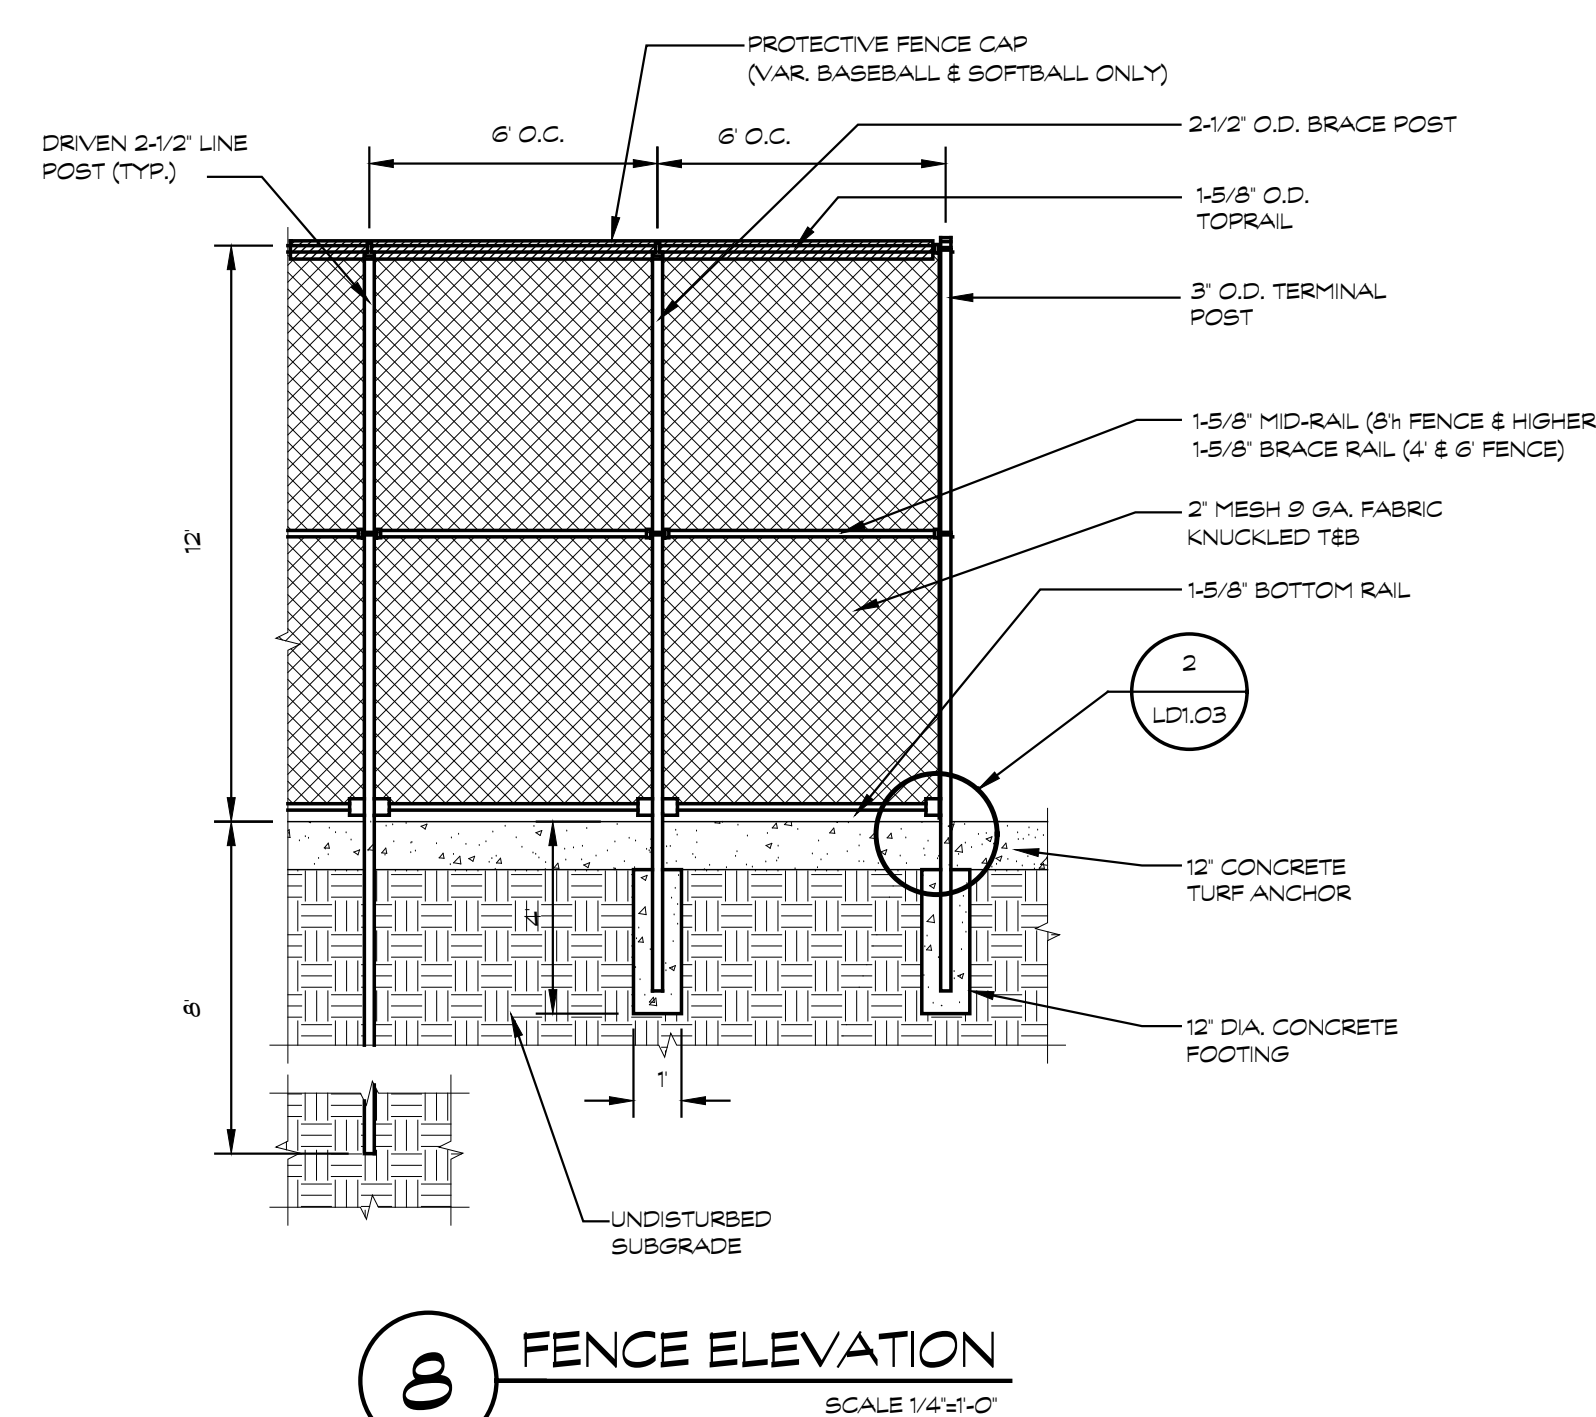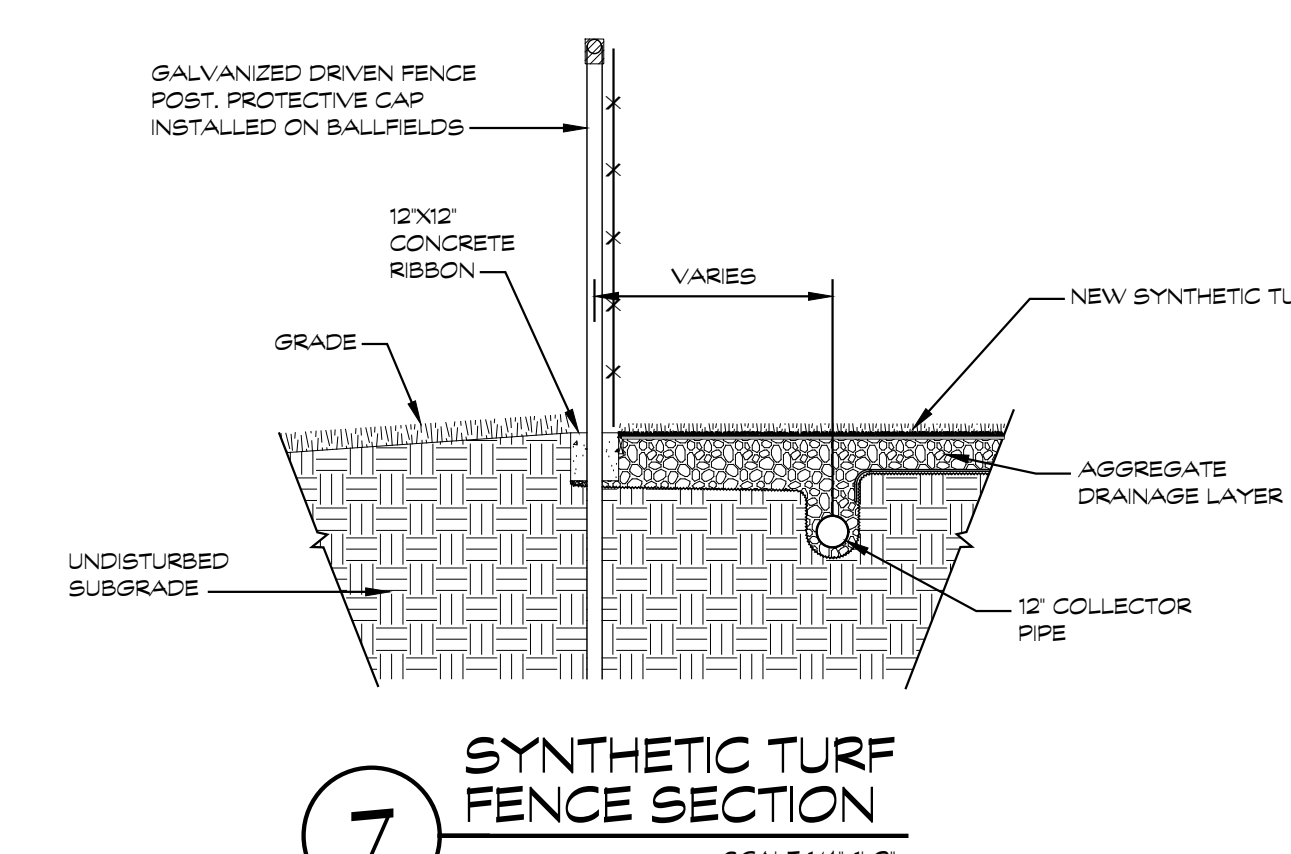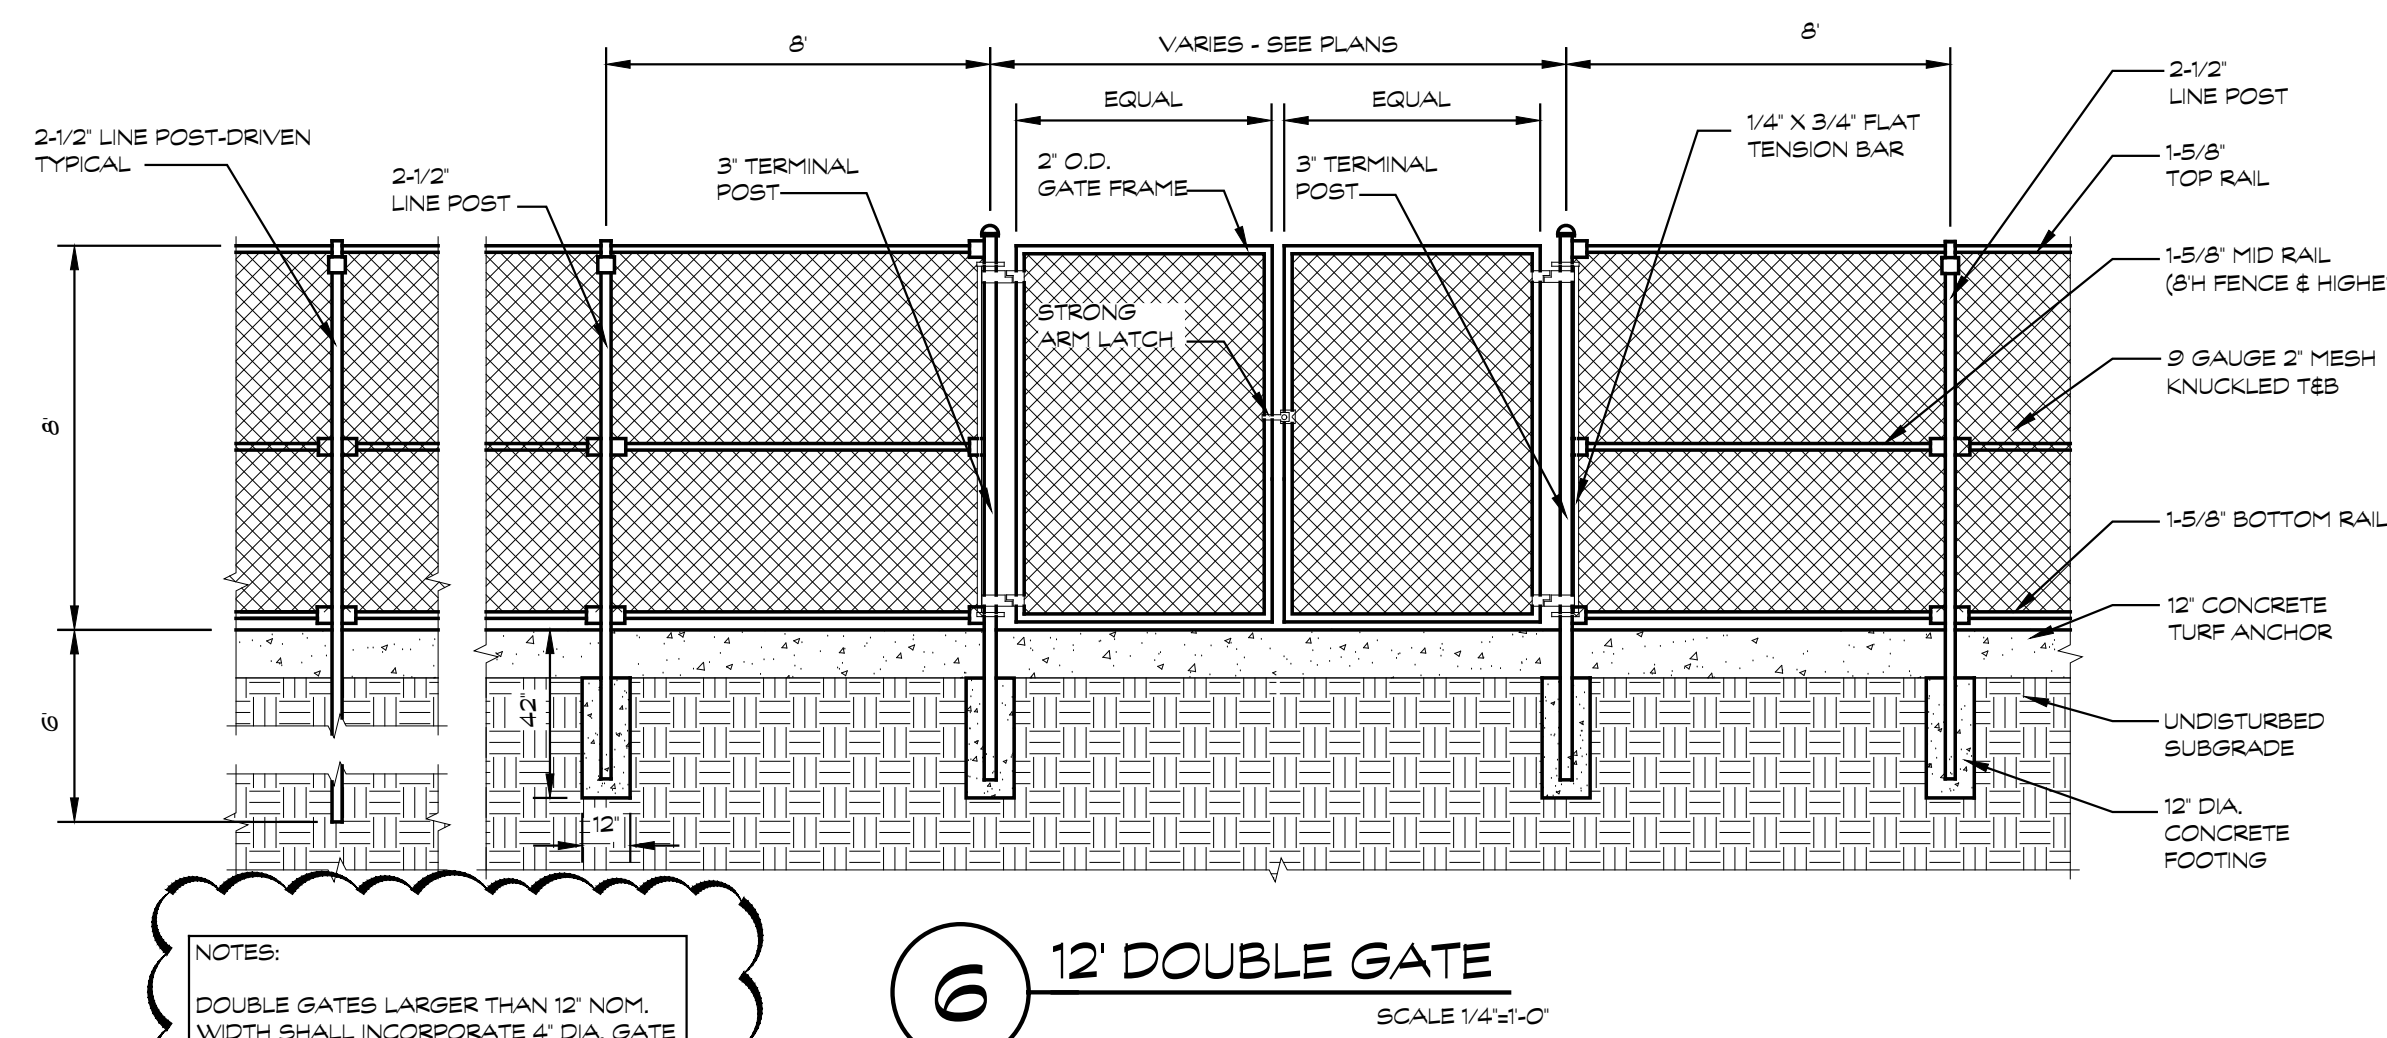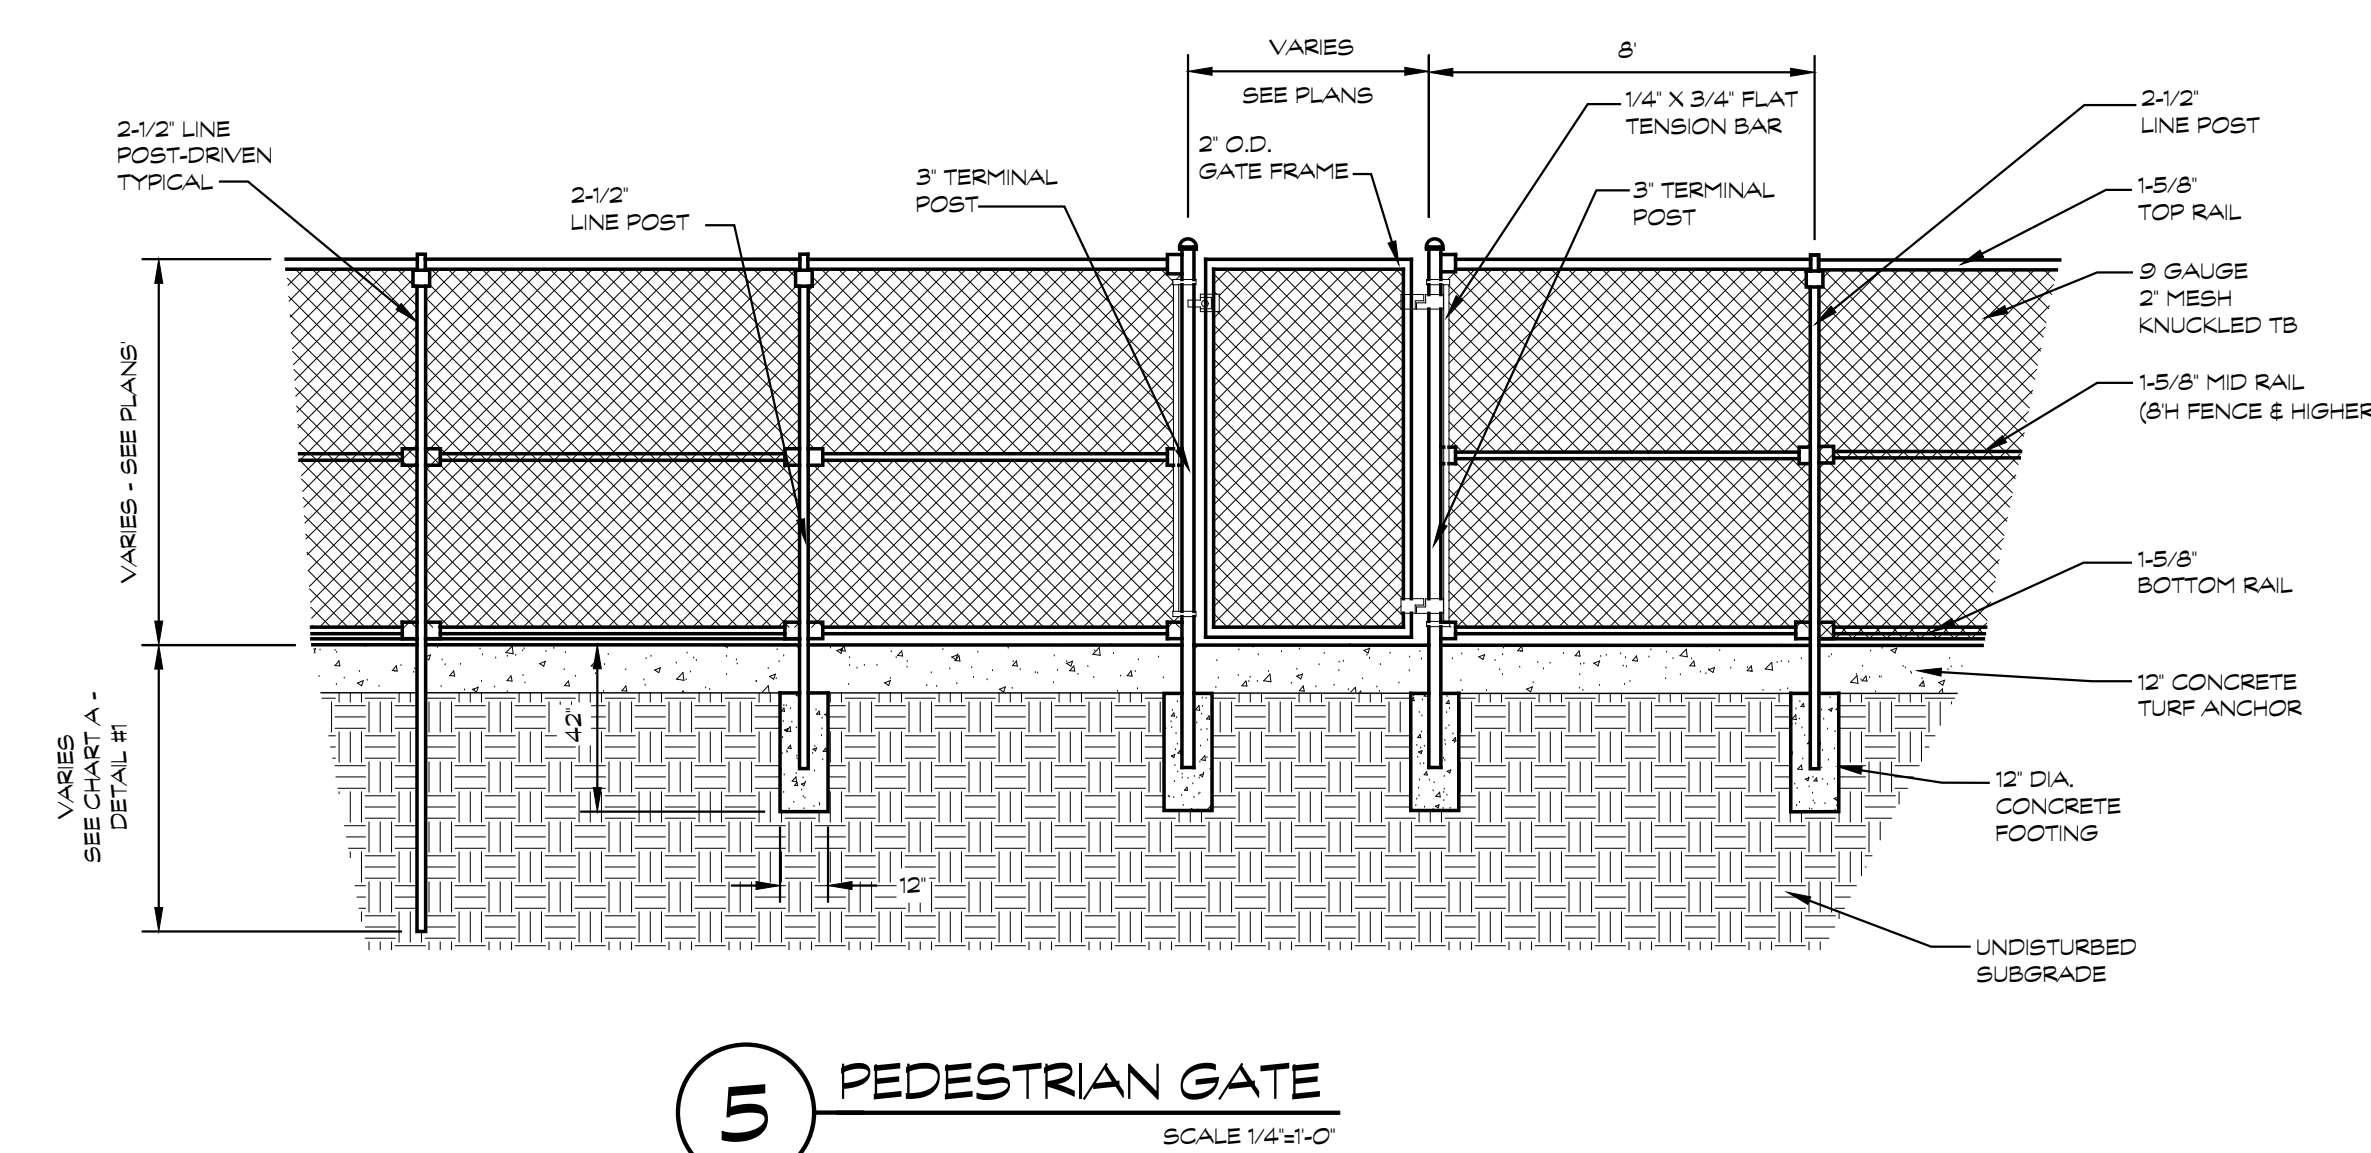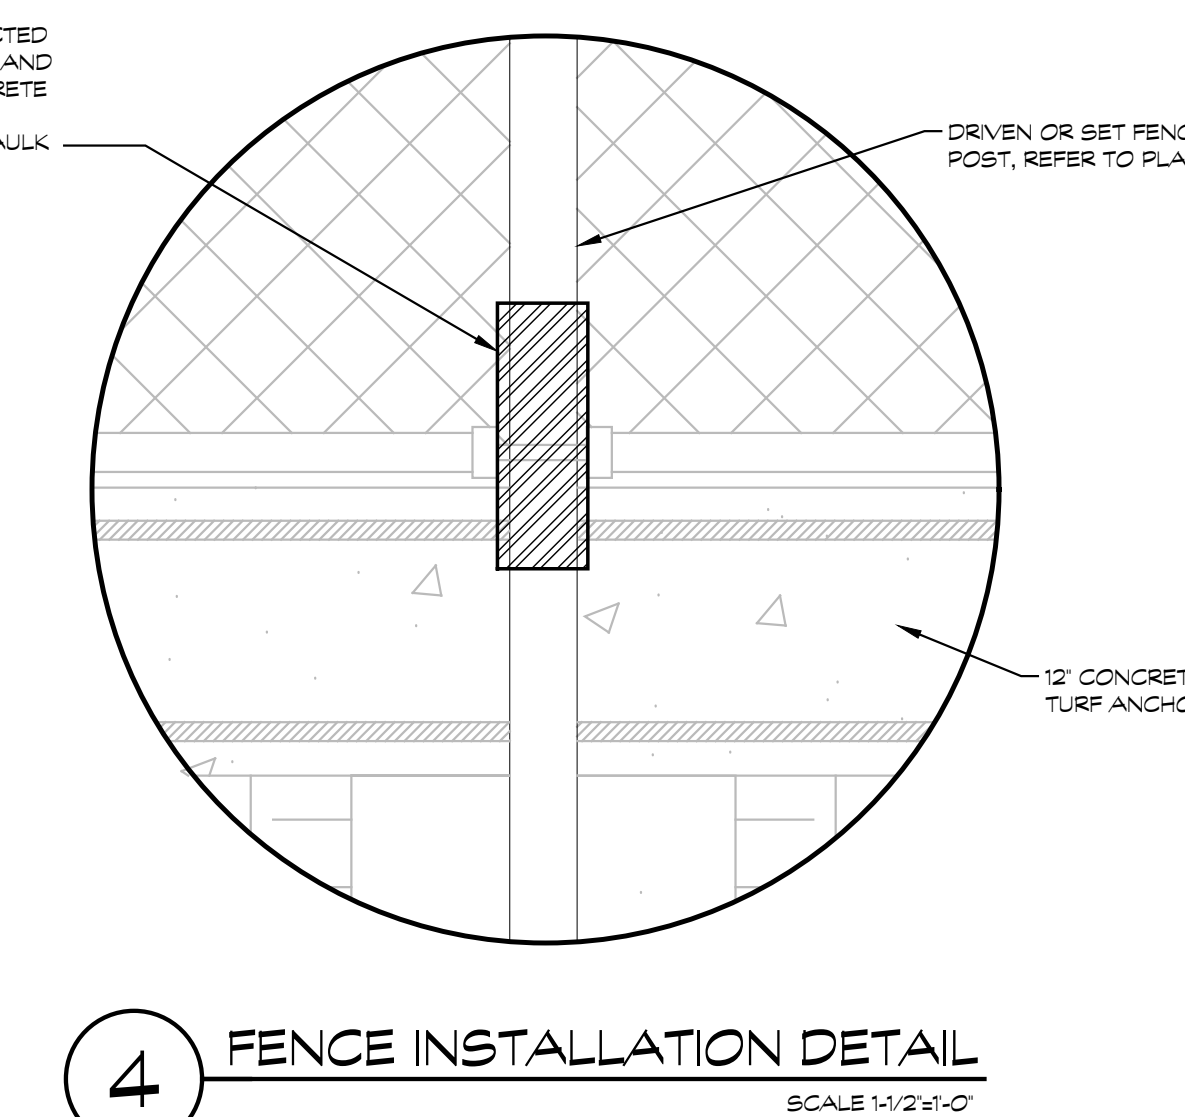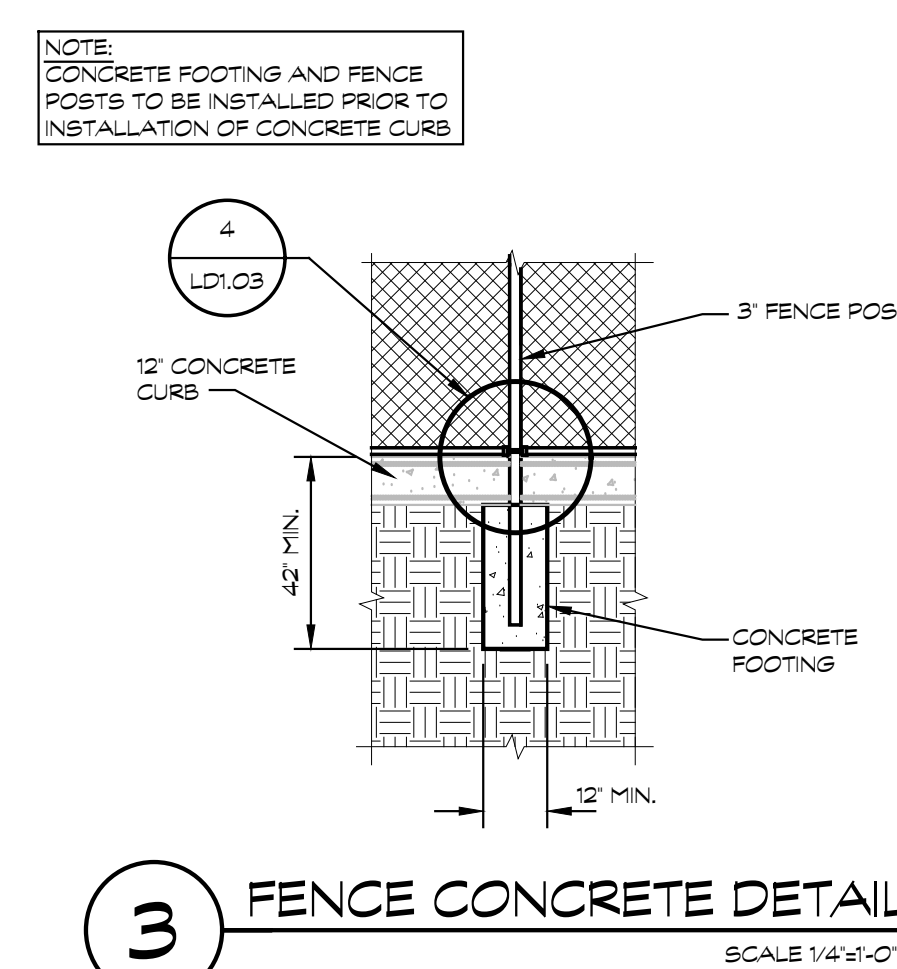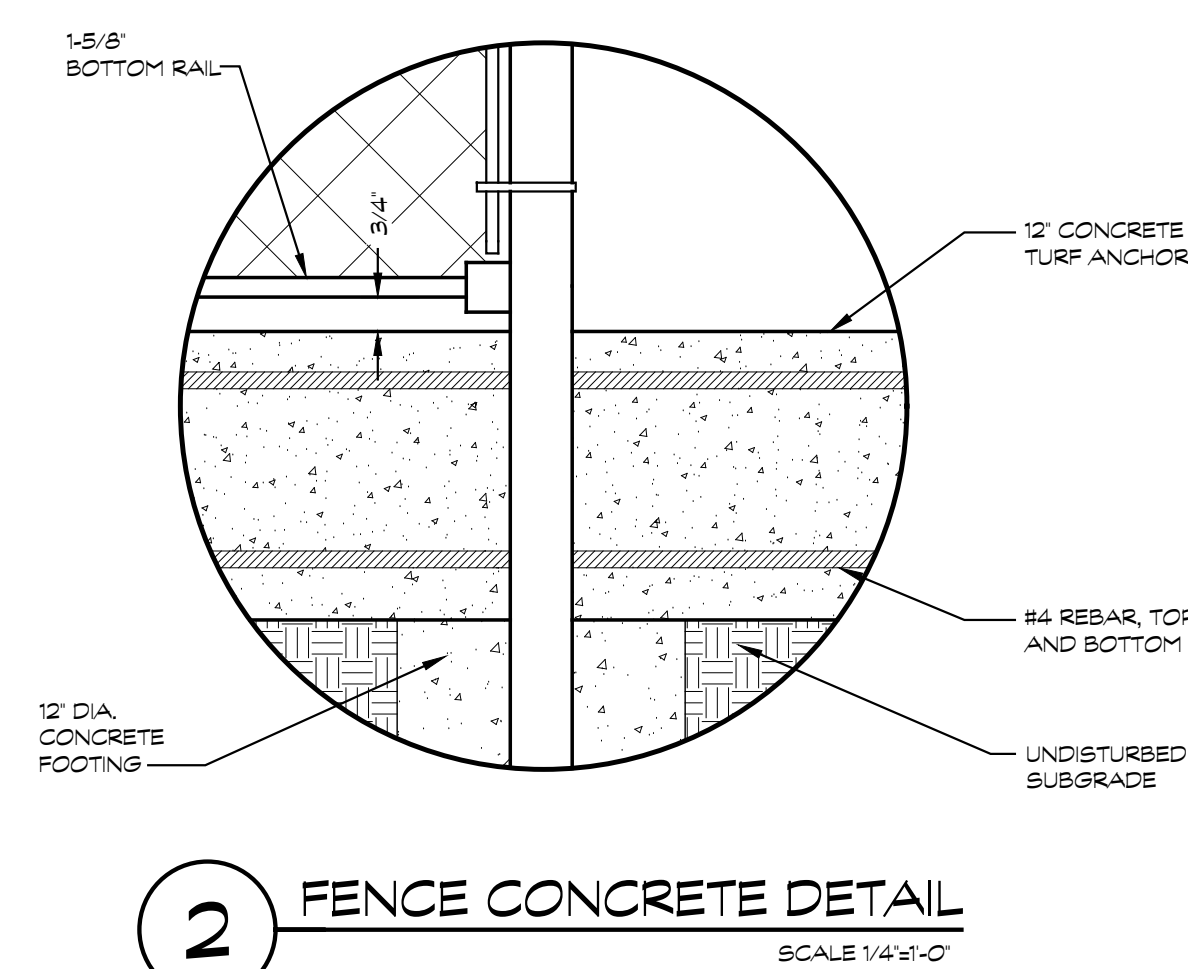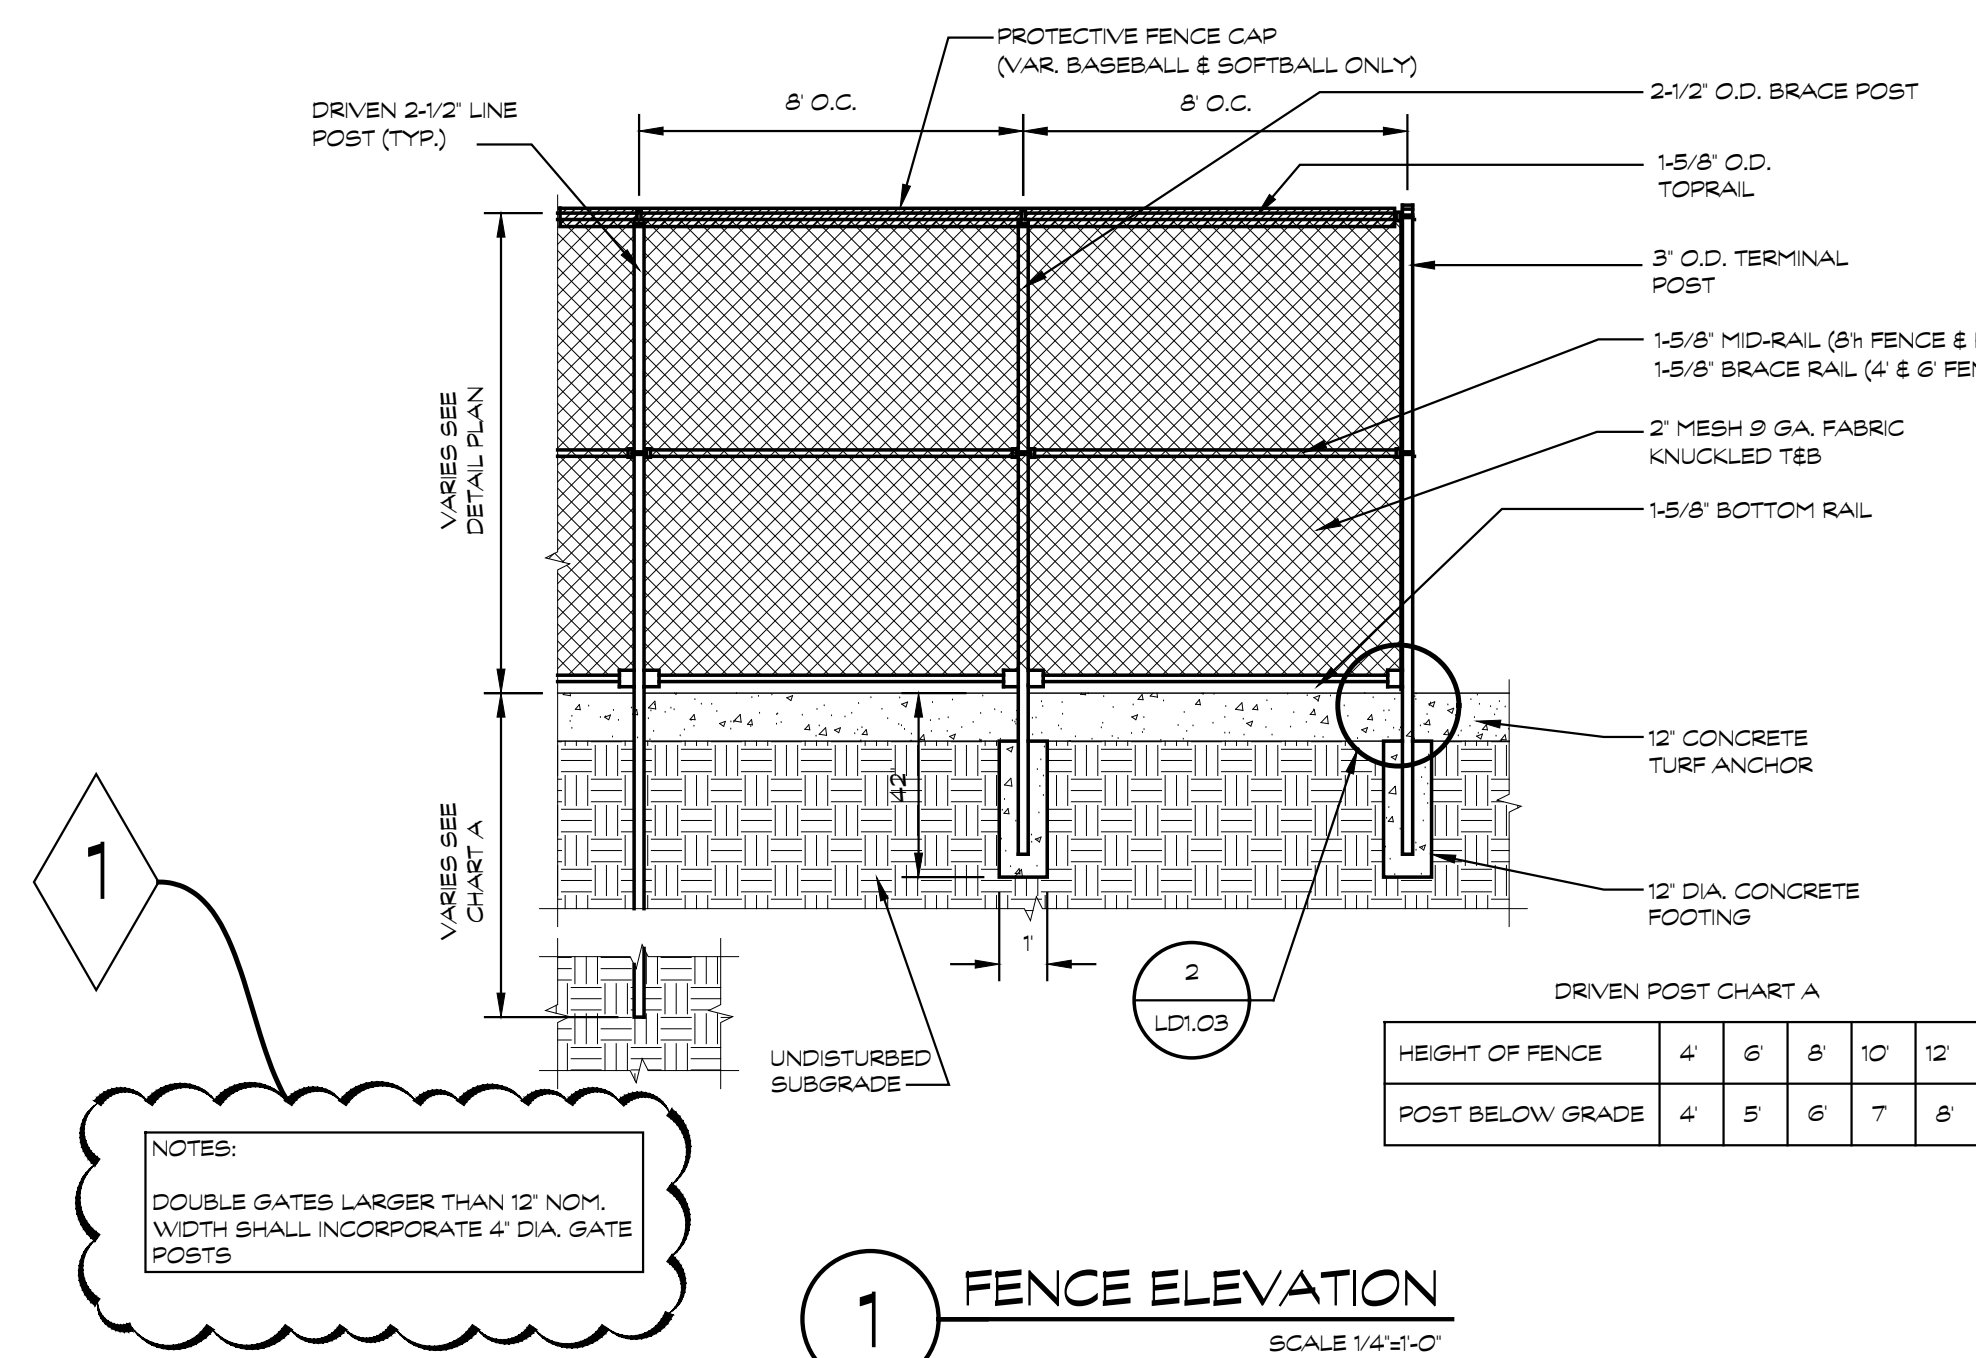


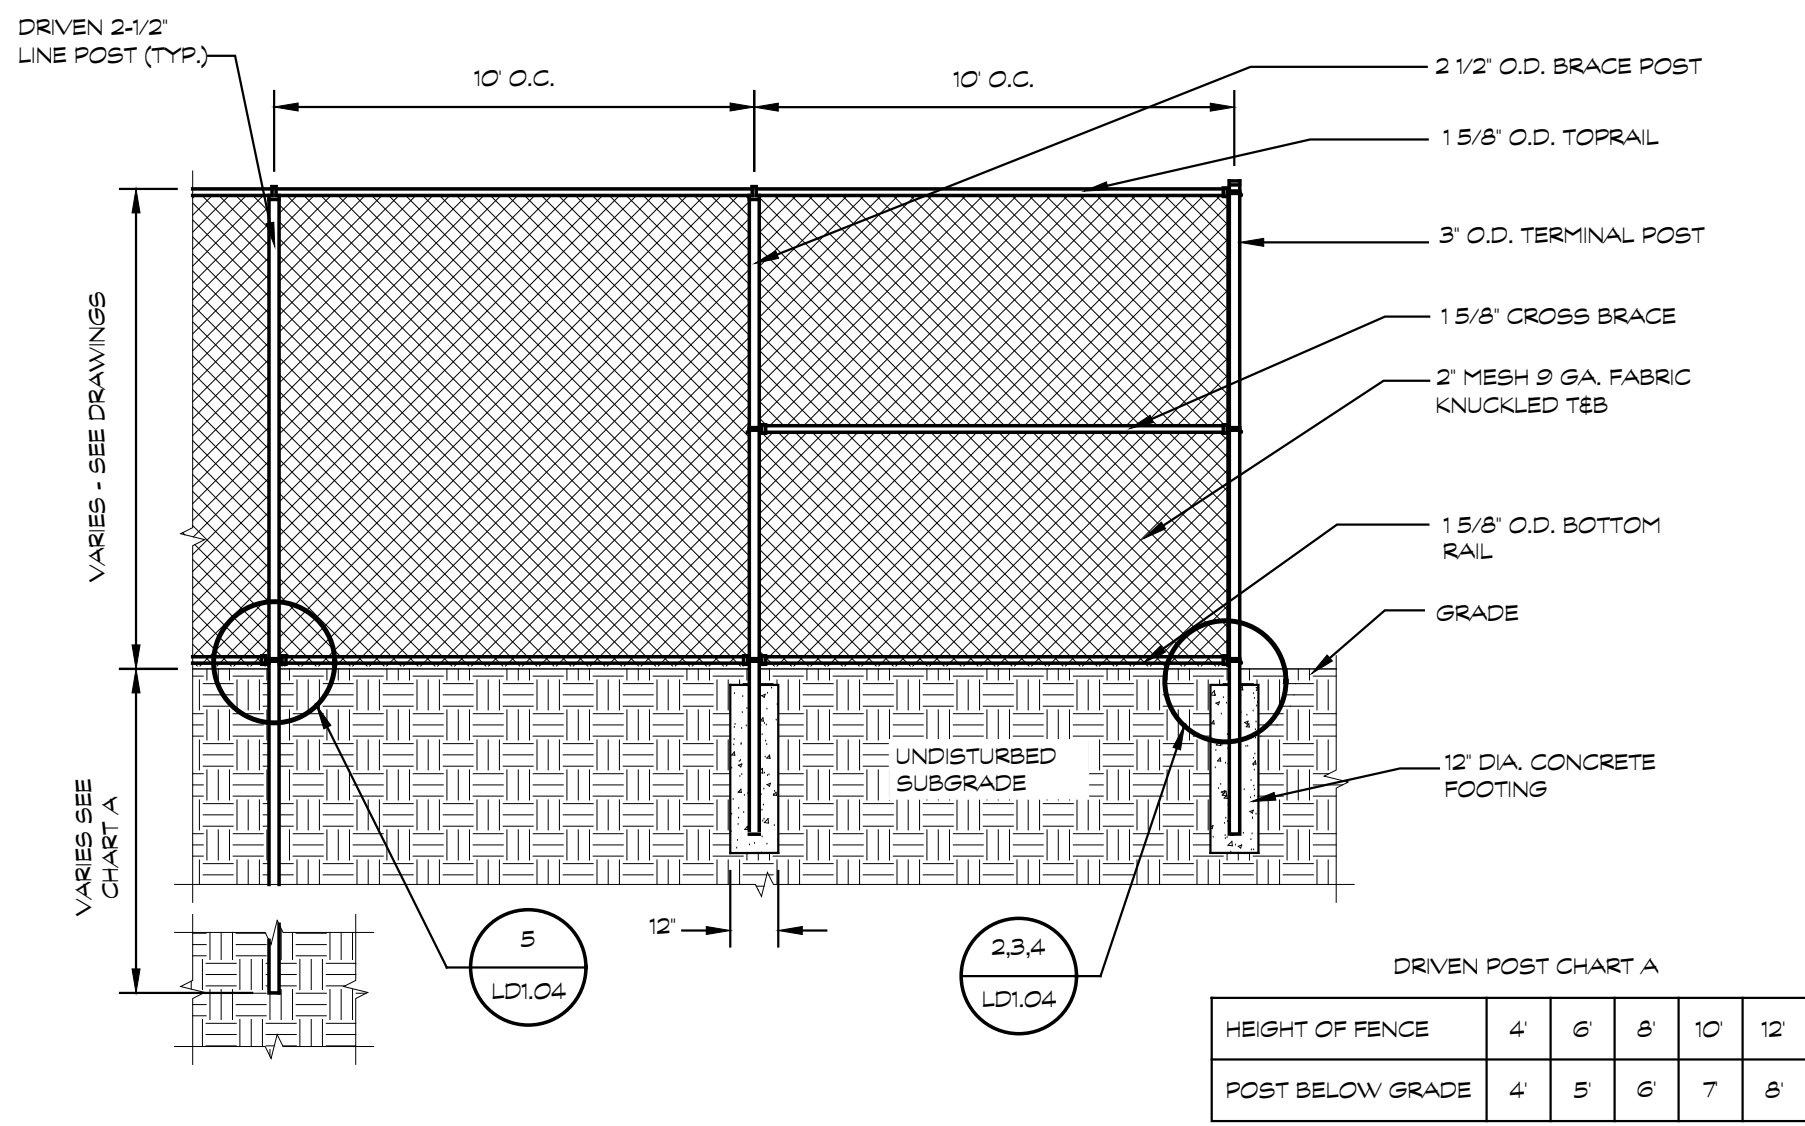


1 FENCE ELEVATION
SCALE 1/4\"/>

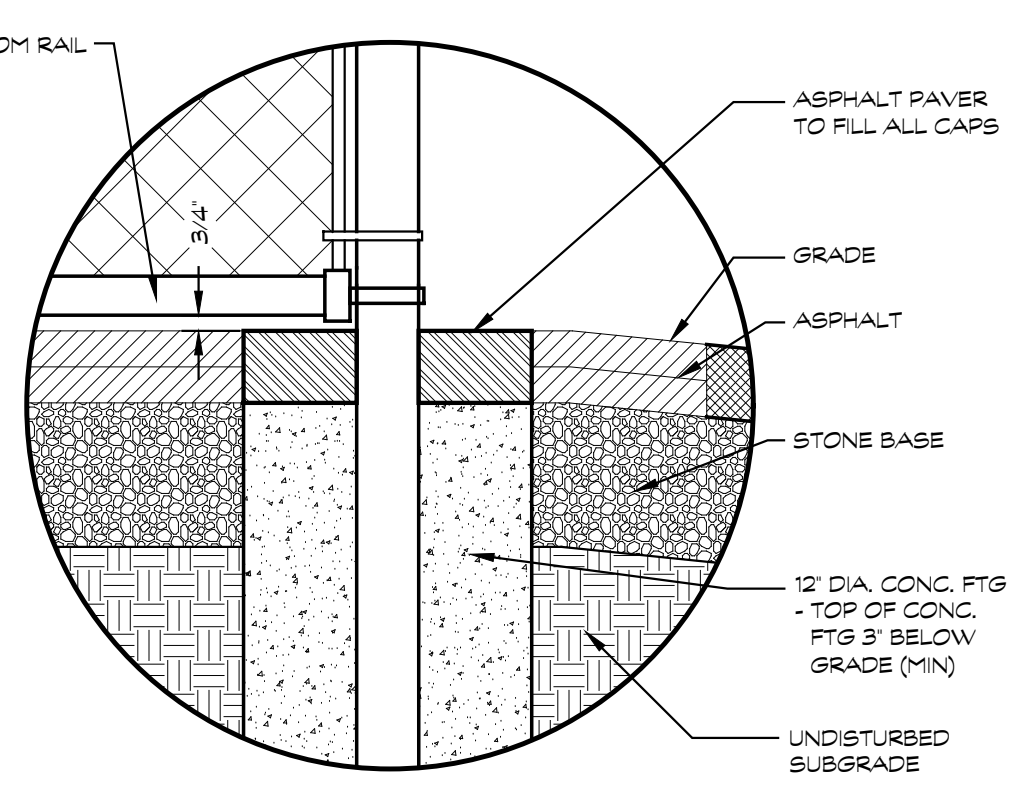

2 FENCE PAVEMENT DETAIL
SCALE 1/4\"/>

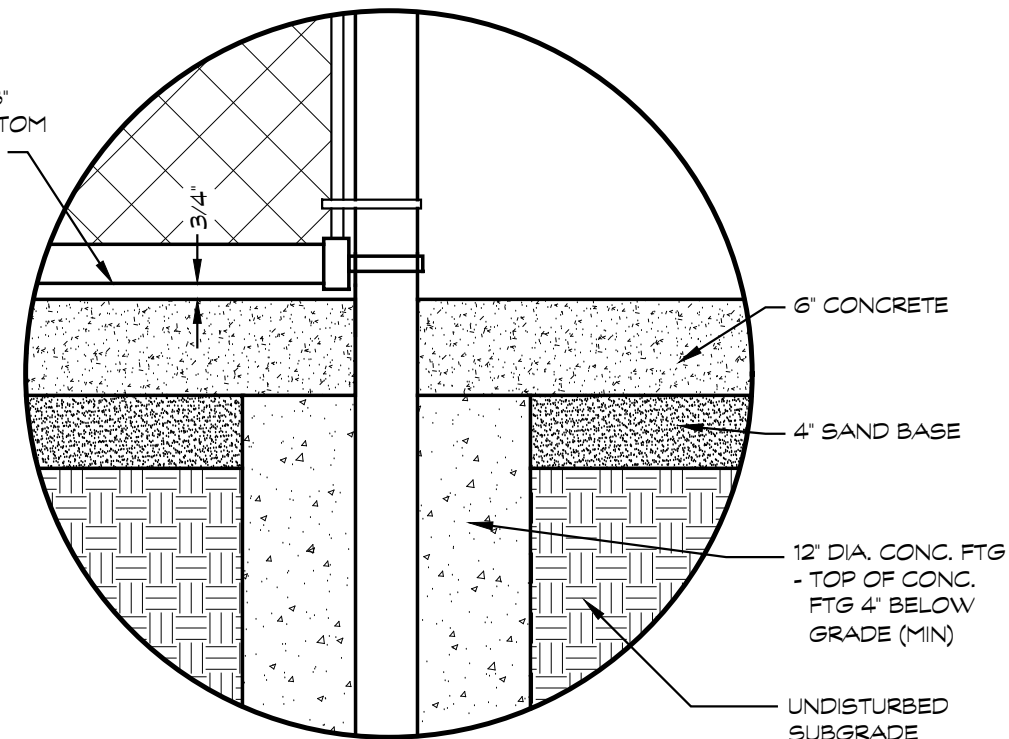


3 FENCE CONCRETE DETAIL
SCALE 1/4\"/>

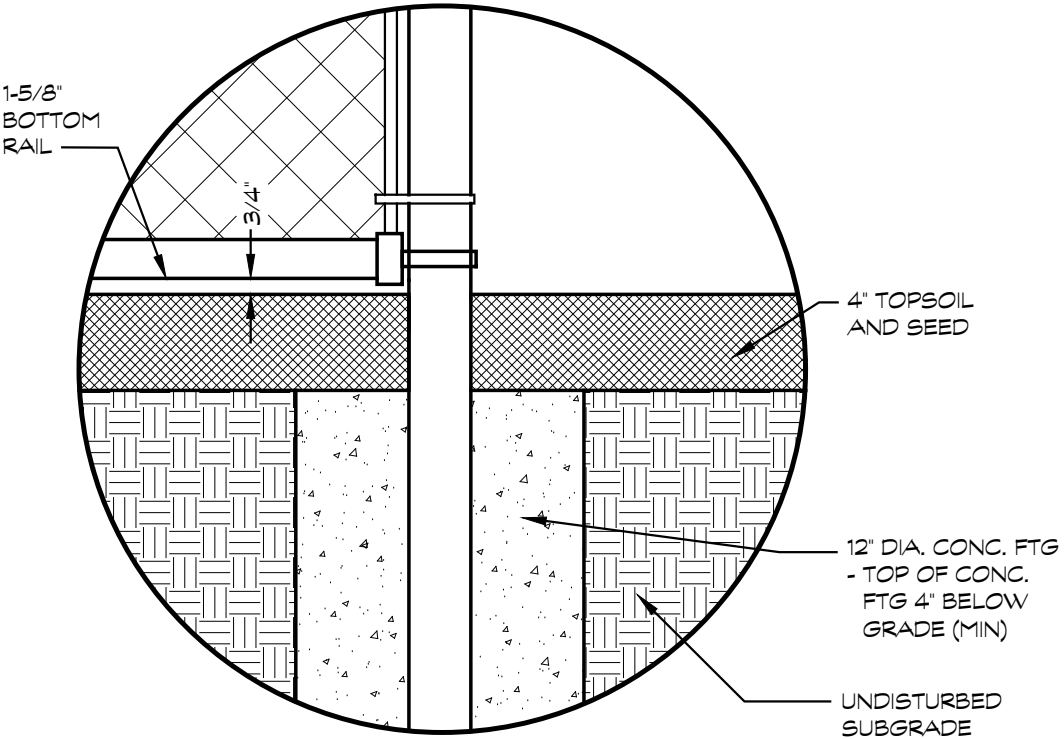


4 FENCE LAWN DETAIL
SCALE 1/4\"/>


NOTES:
DOUBLE GATES LARGER THAN 12' NOM.
WIDTH SHALL INCORPORATE 4\"/>

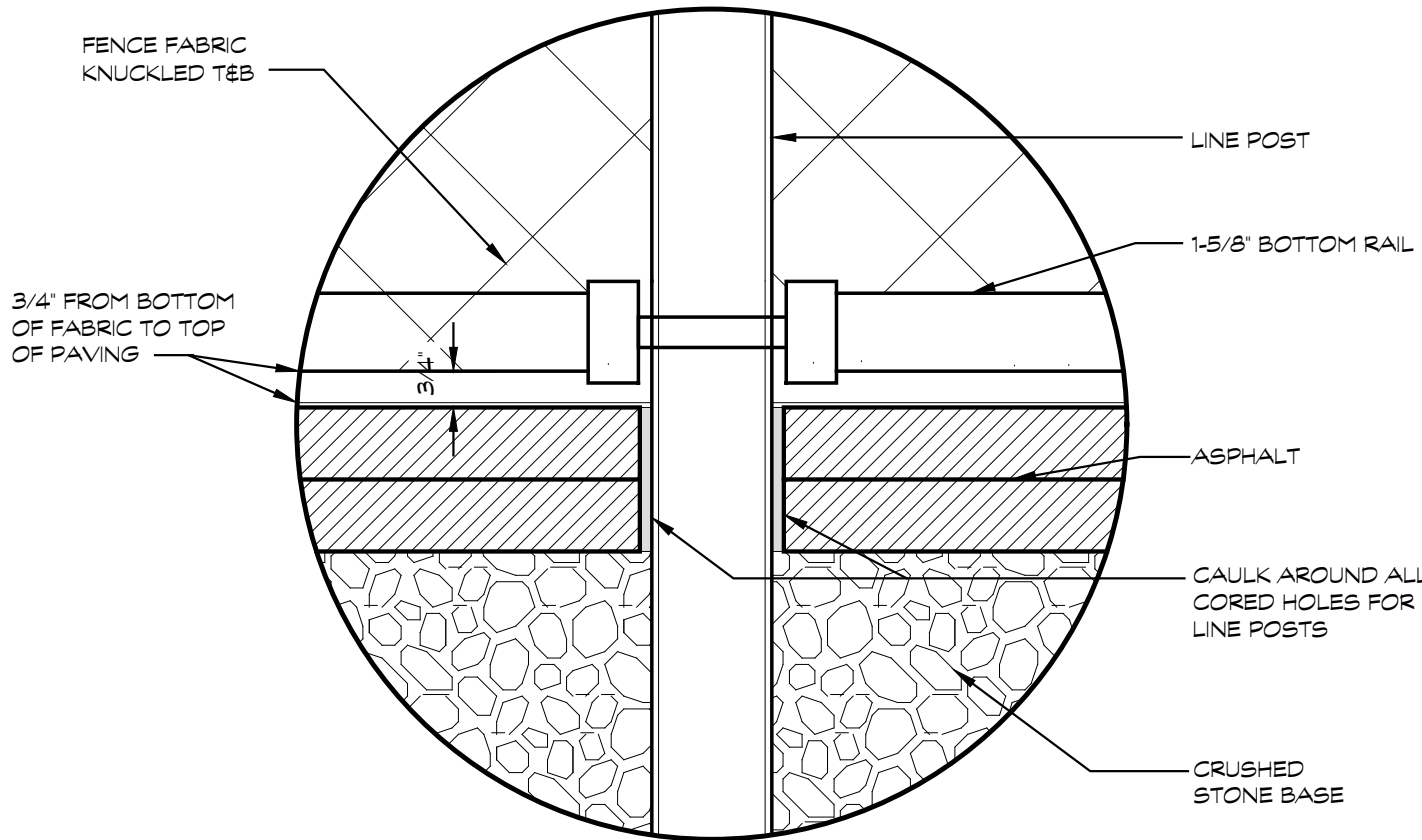


5 DRIVEN FENCE POST CAULKING
SCALE 3\"/>

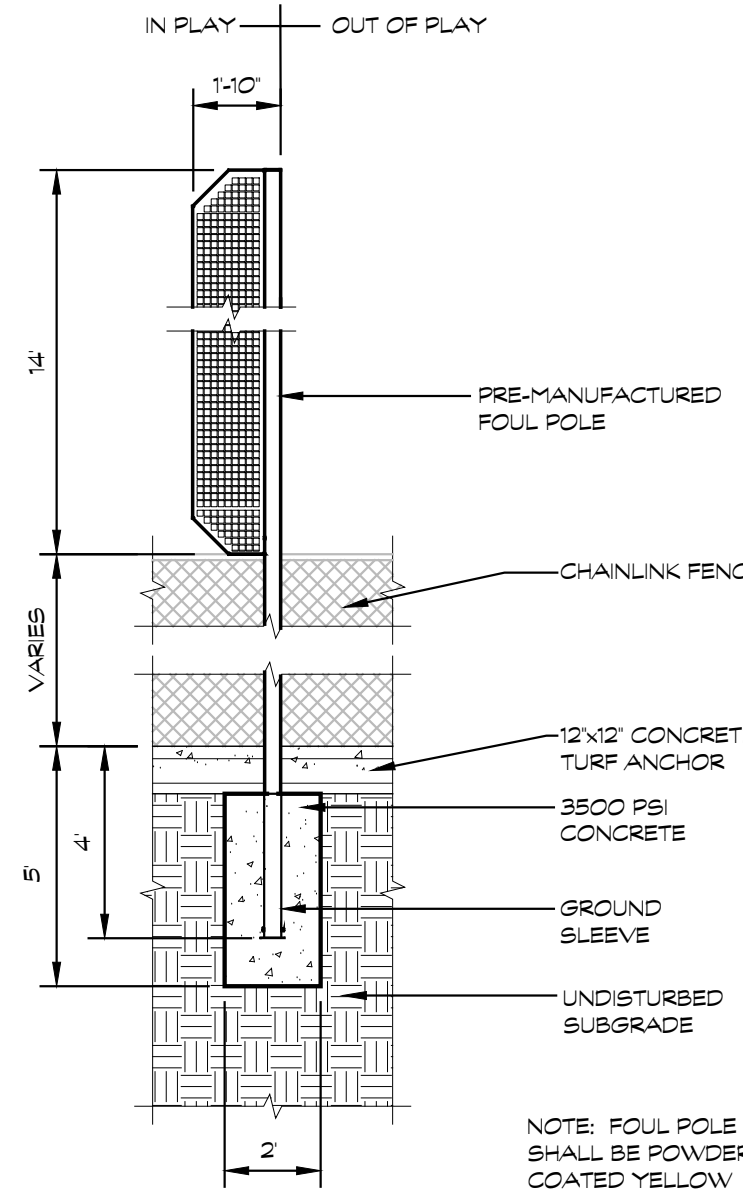


6 FOUL POLE
SCALE 1/4\"/>

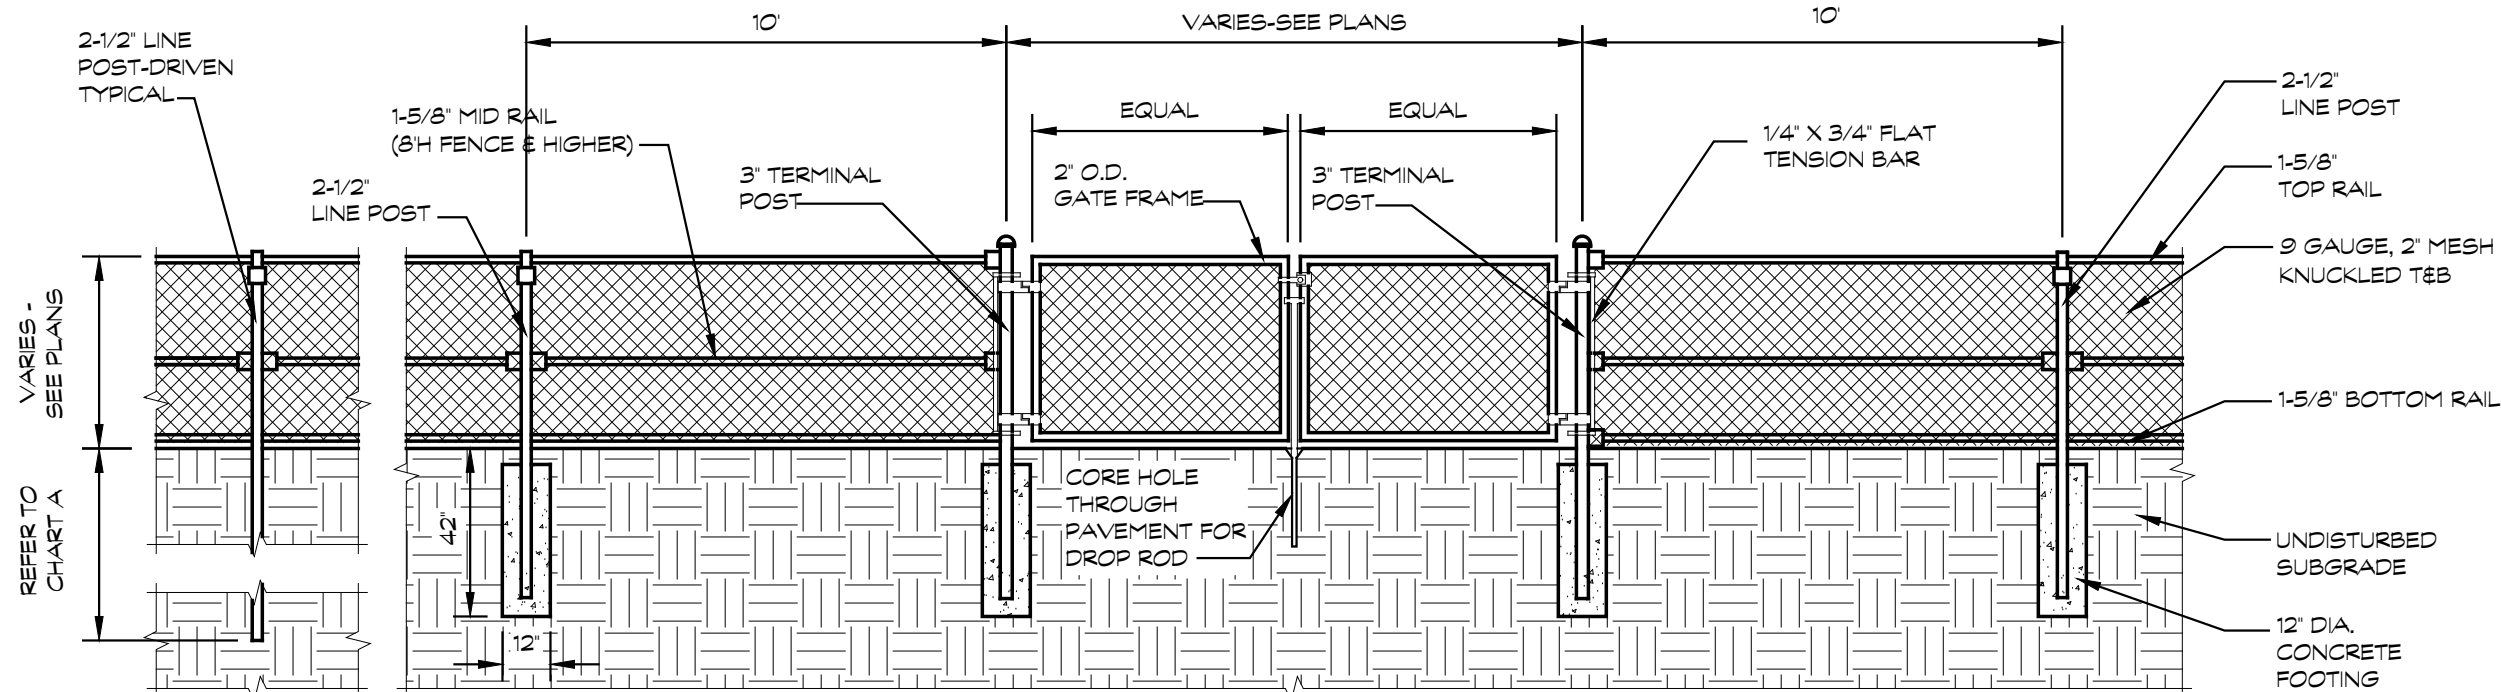

7 DOUBLE GATE DETAIL
SCALE 1/4\"/>

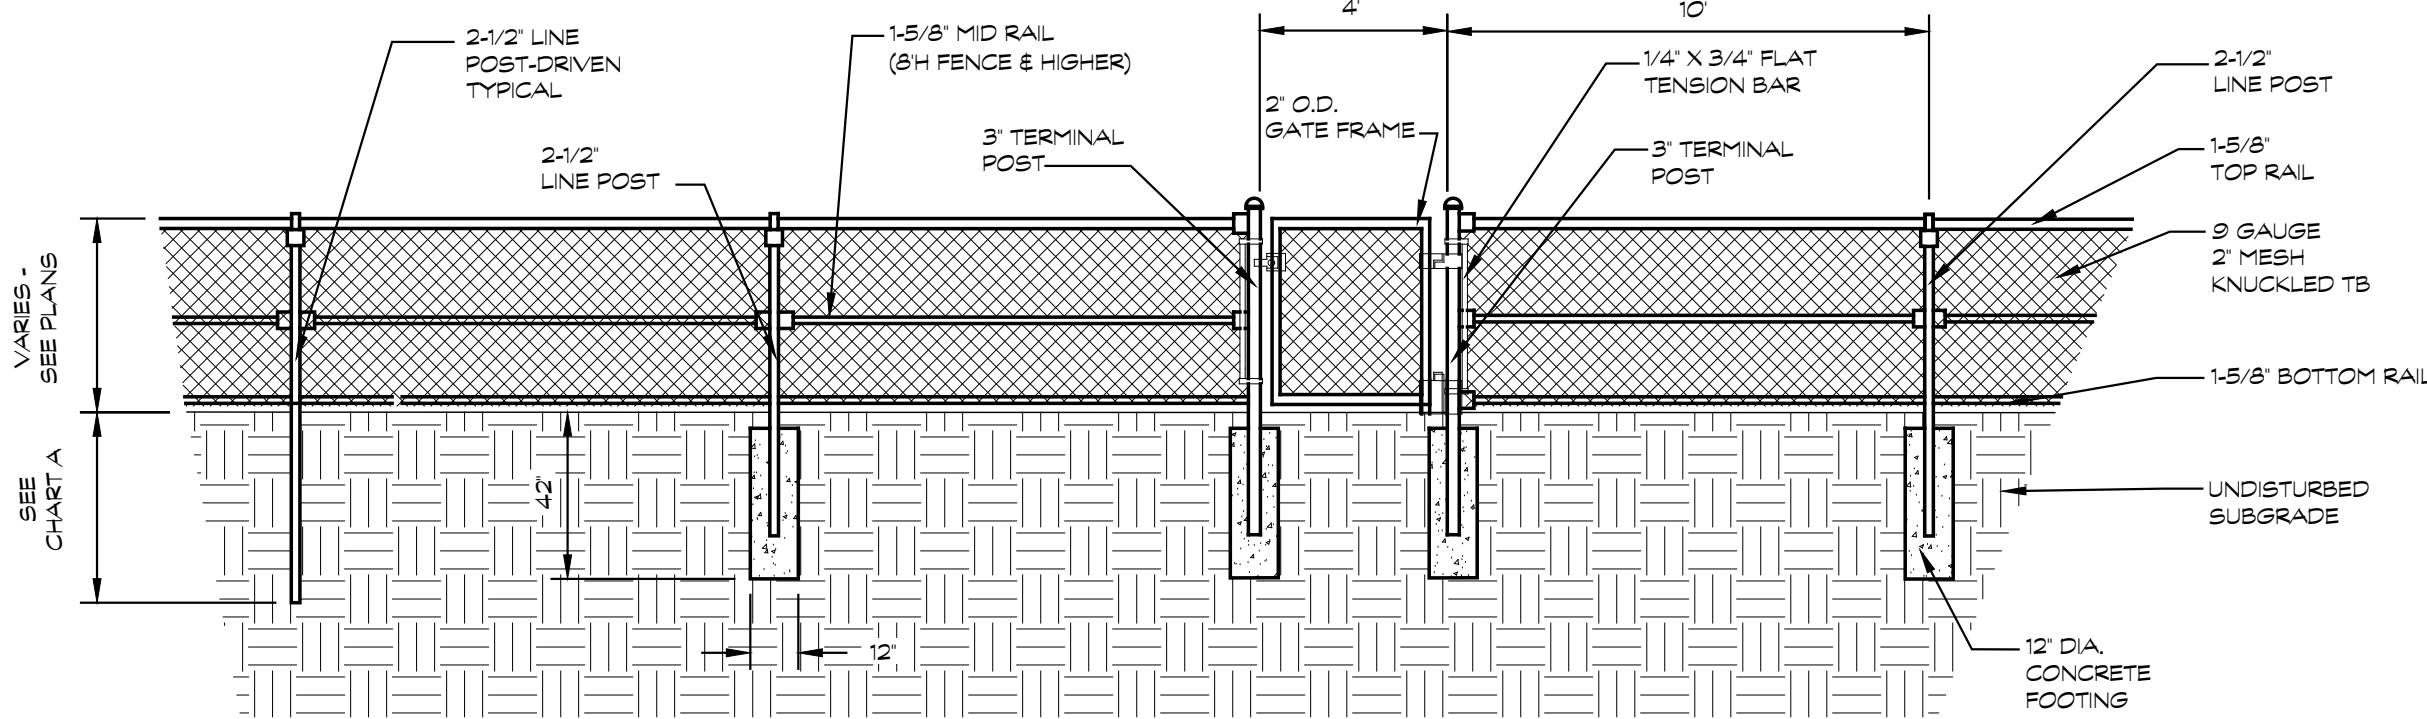

8 PEDESTRIAN GATE
SCALE 1/4\"/>

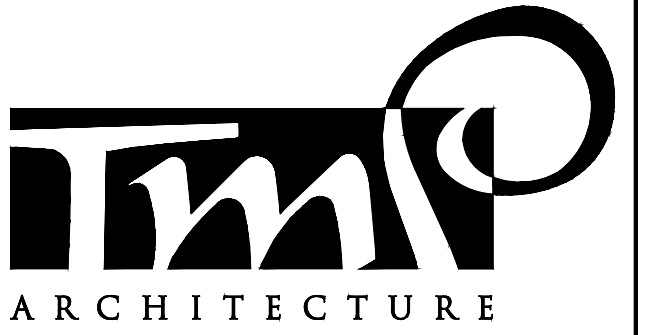

TMP ARCHITECTURE INC
1191 WEST SQUARE LAKE ROAD
BLOOMFIELD HILLS - MICHIGAN - 48302
PH - 248.338.4561 FX - 248.338.0023
EM - INFO@TMPARCHITECTURE.COM

REGISTRATION SEAL

CONSULTANT



PROJECT TITLE
**Athens High School
Athletic Fields
Bid Package No. 02B**

Troy School District
Troy, Michigan

DRAWING TITLE
**General Fence
Details**

ISSUE DATES








01-14-2025	ADDENDUM NO.1
12-10-2024	CONSTRUCTION DOCUMENTS

DATE: ISSUED FOR:

DRAWN	J.B
CHECKED	HD
APPROVED	MDS

PROJECT NO.
22103D


DRAWING NO.
LD1.05

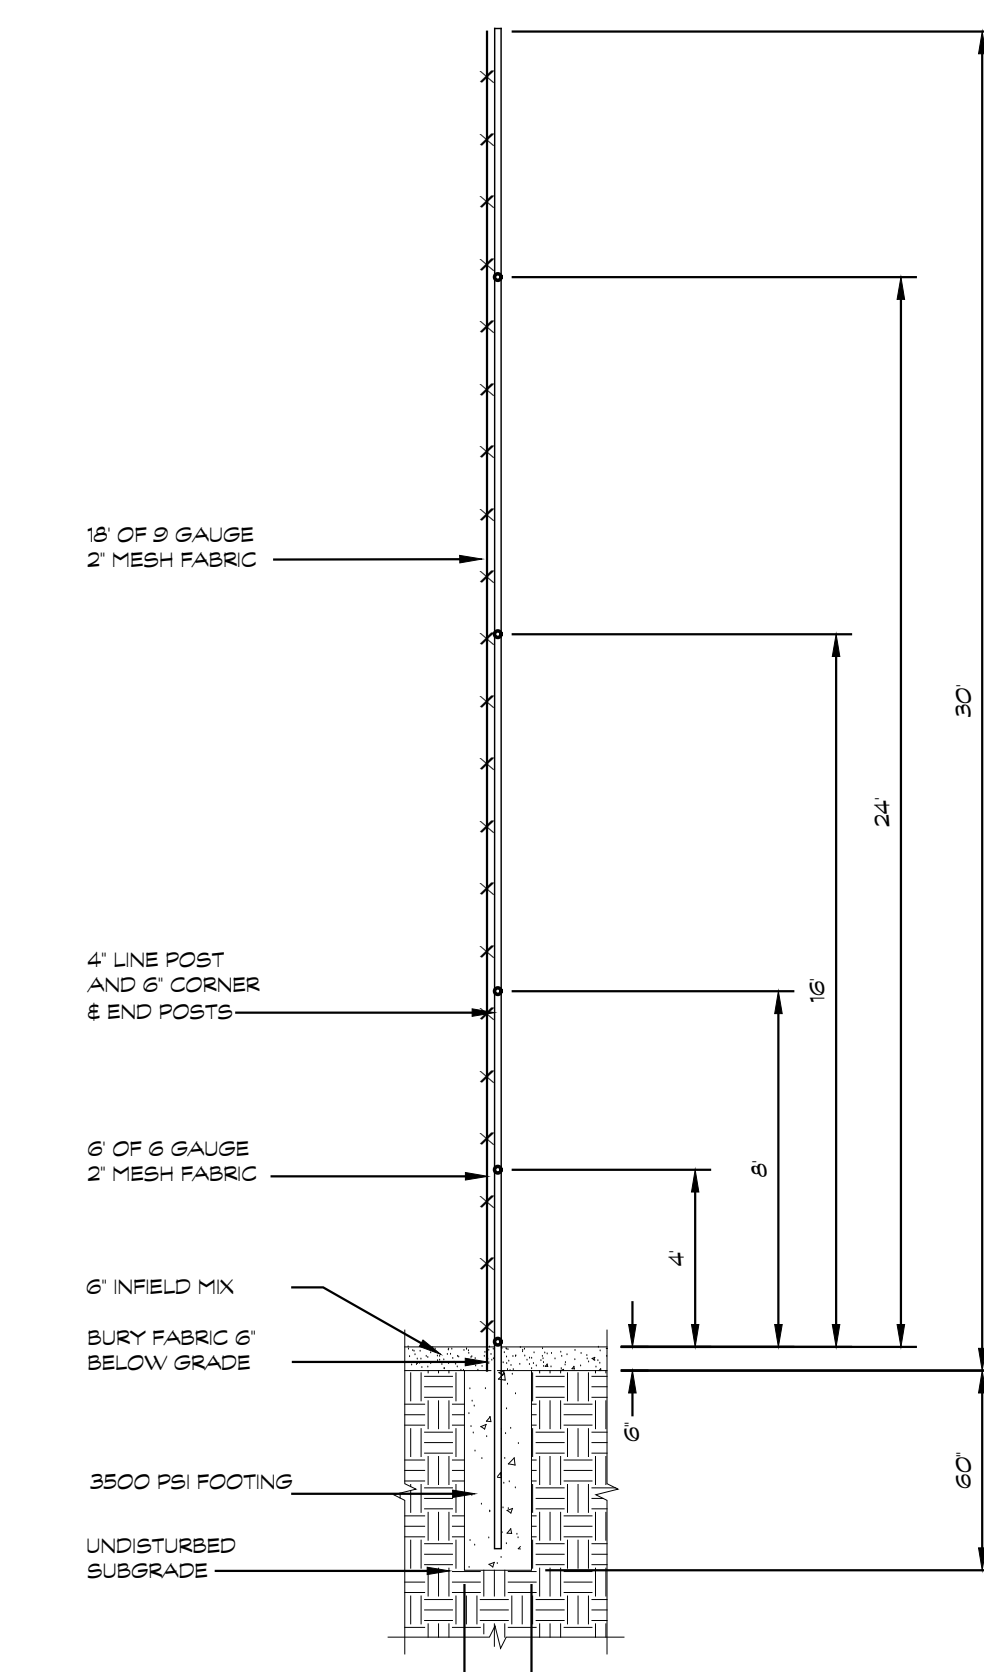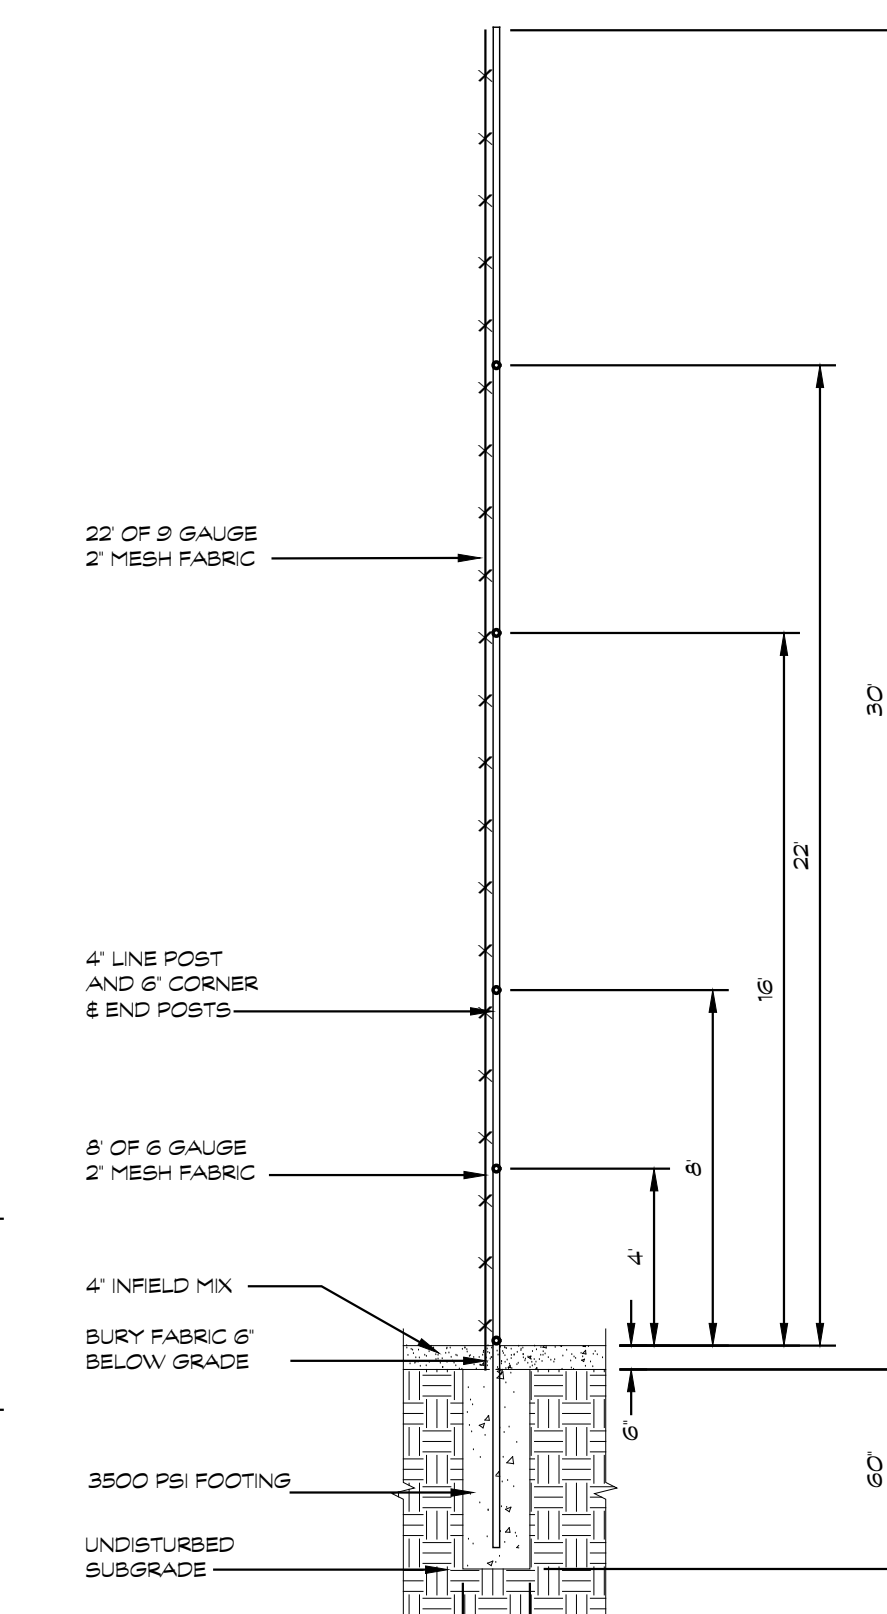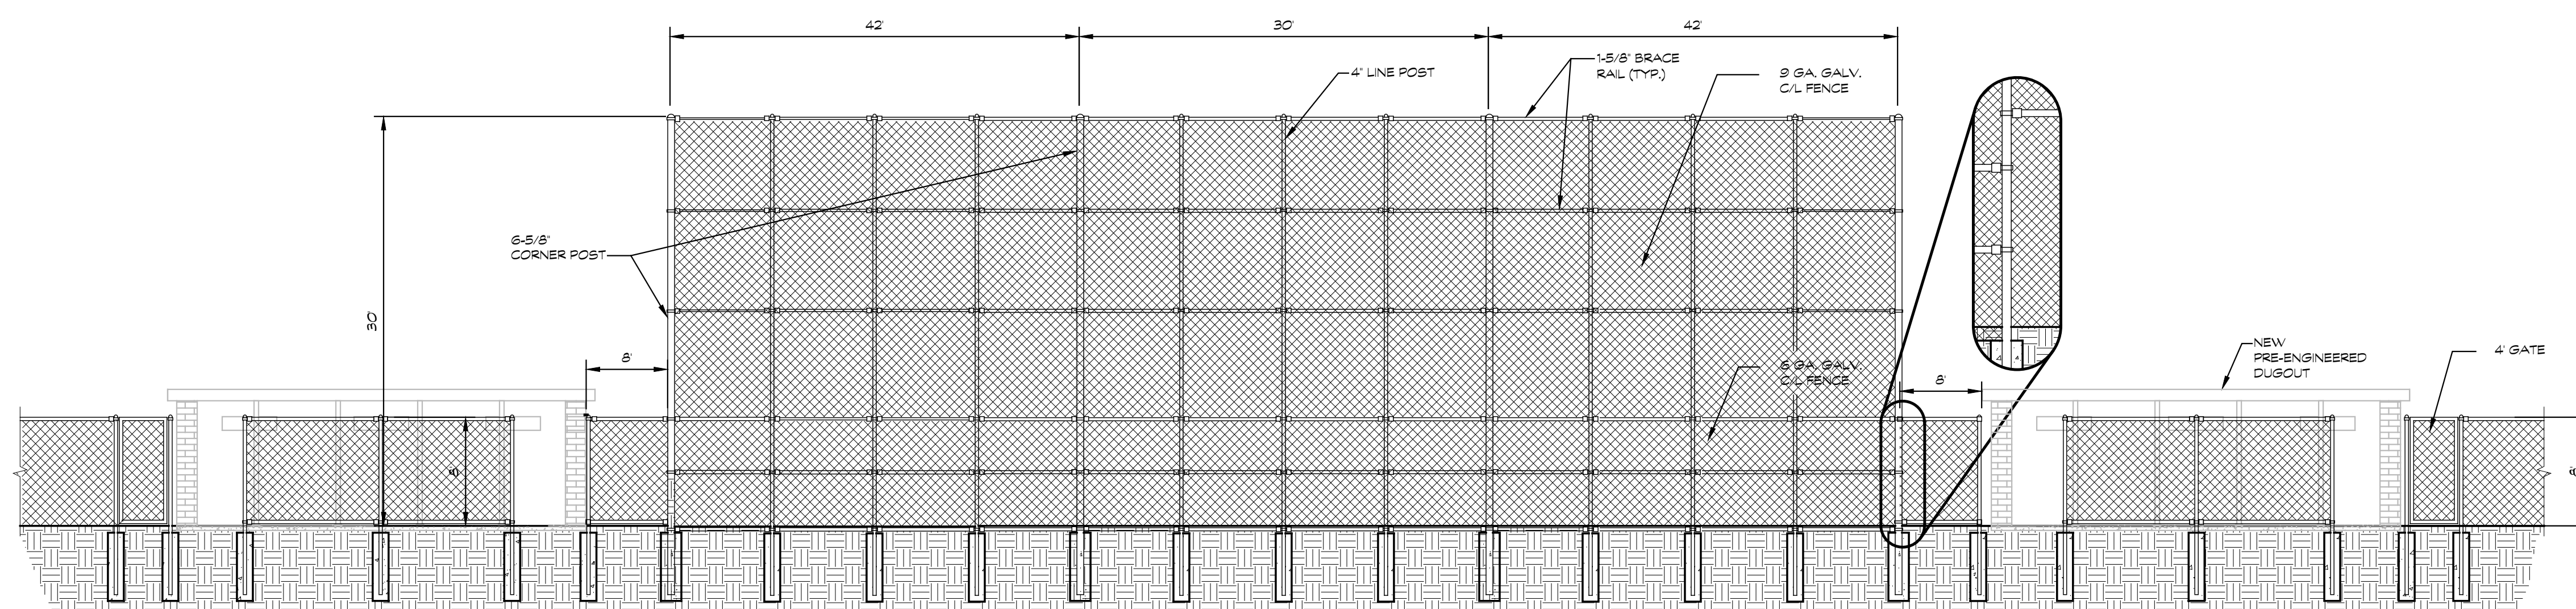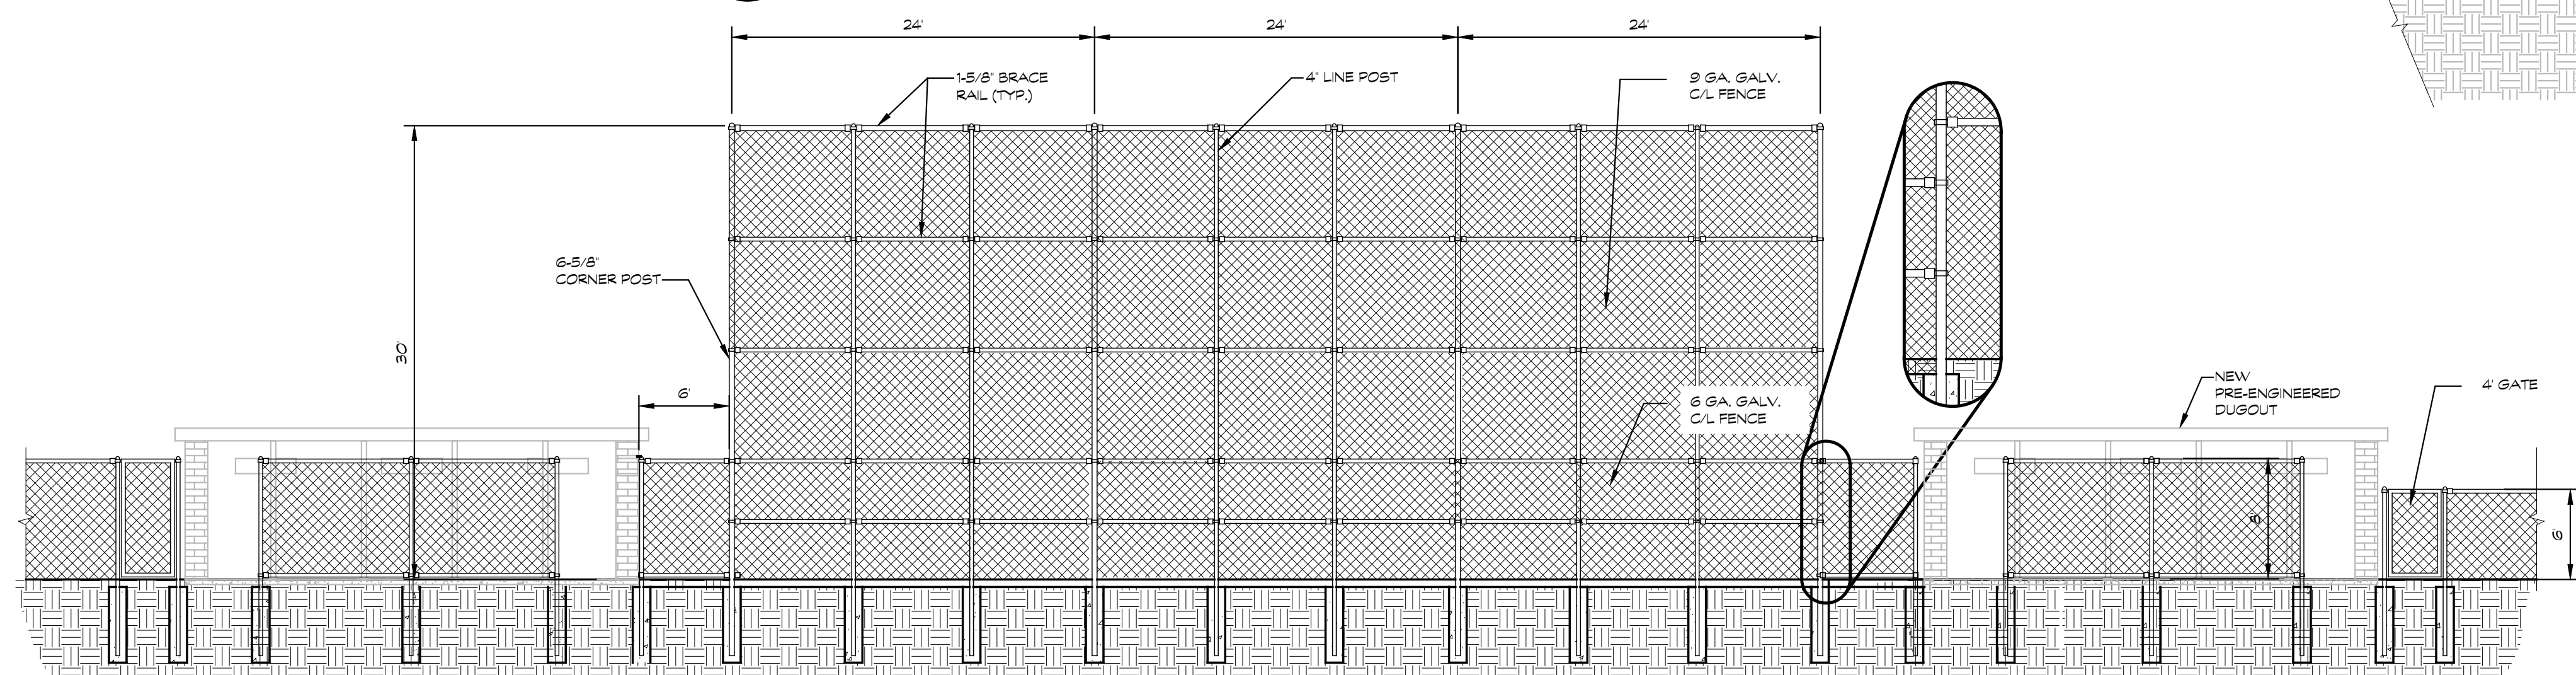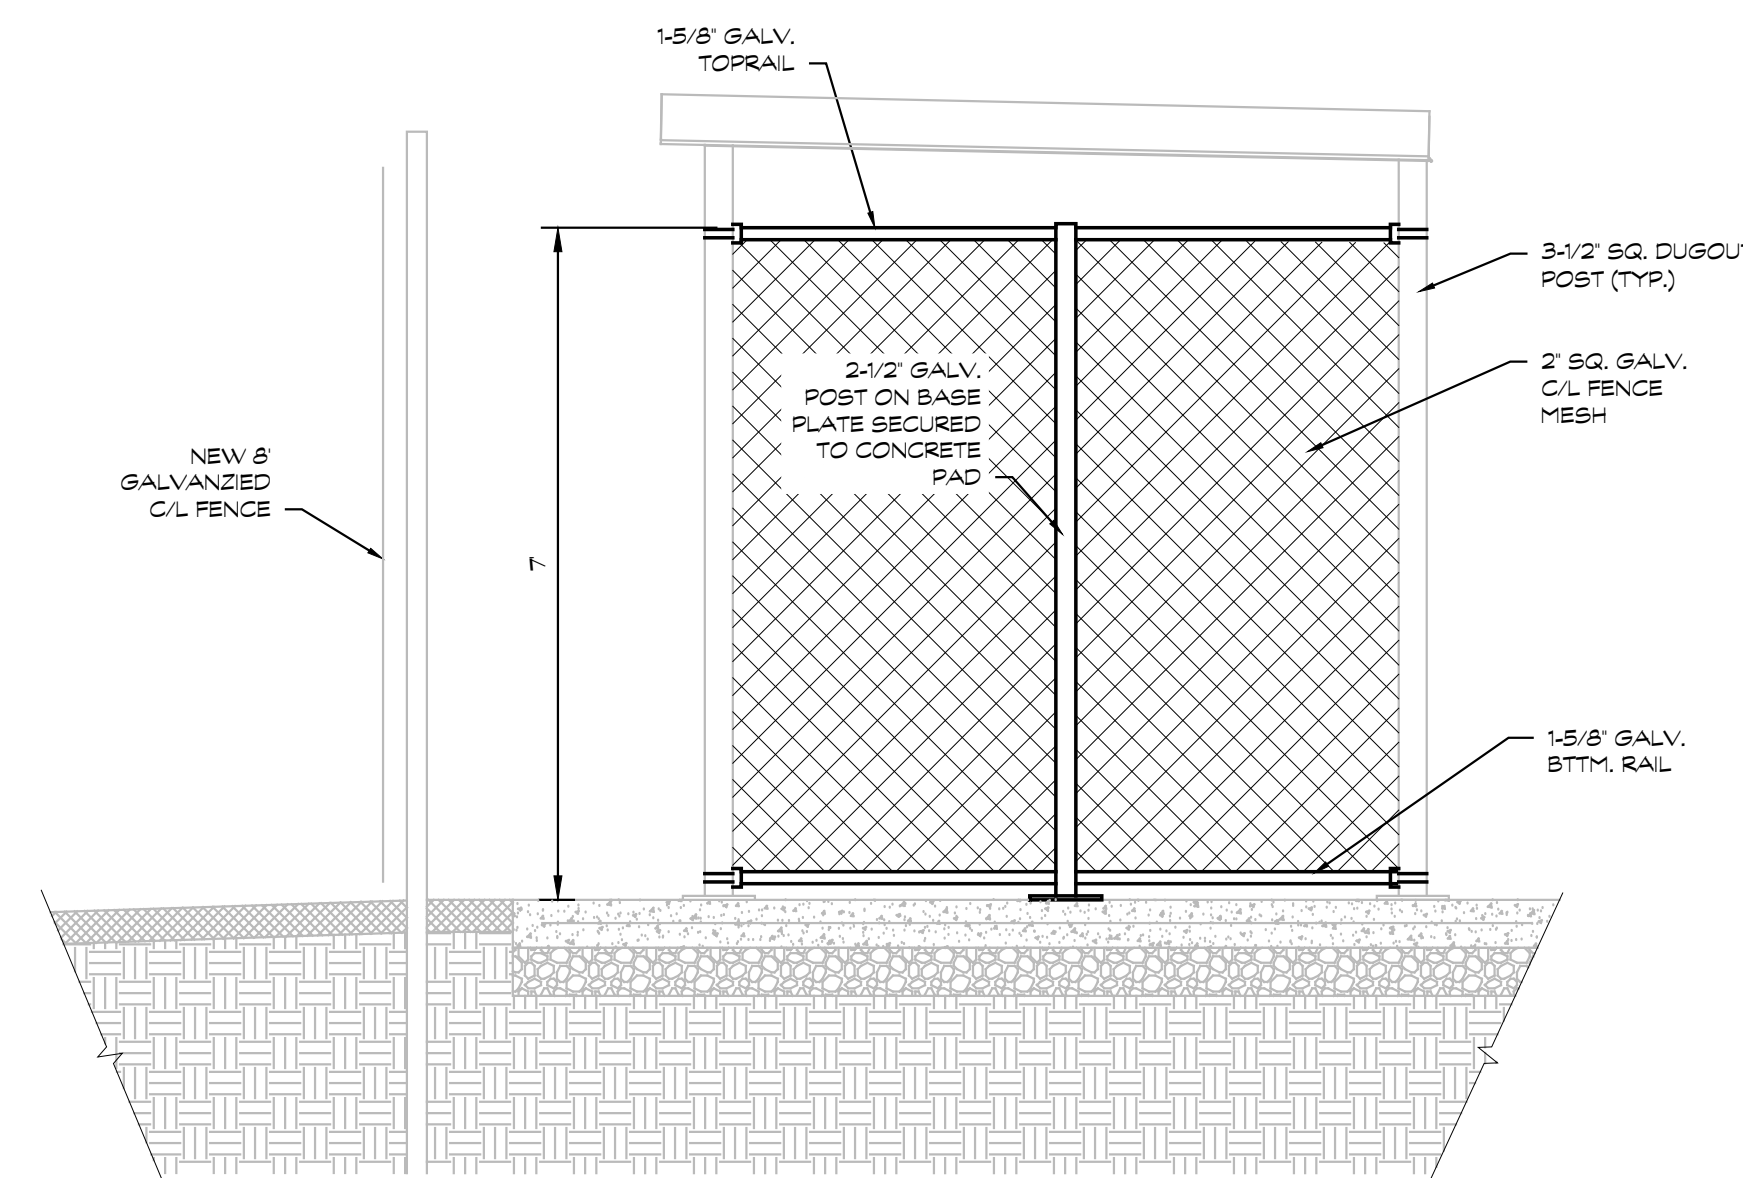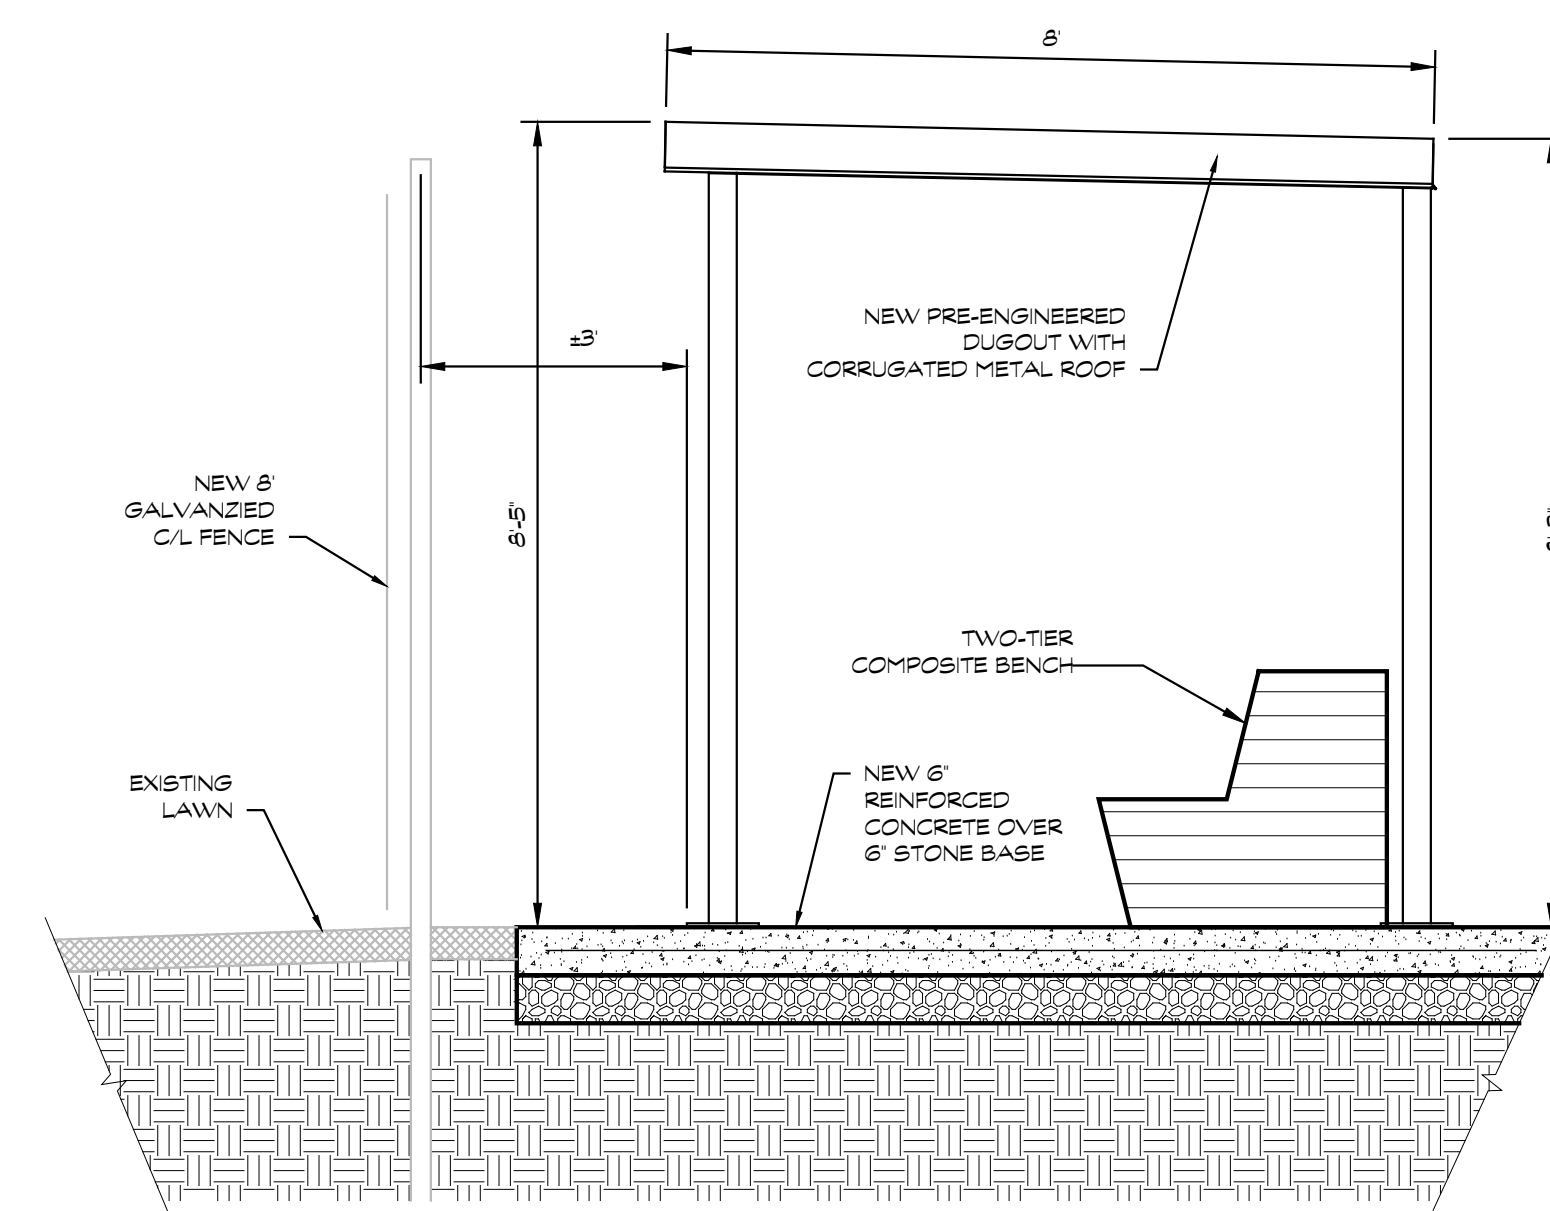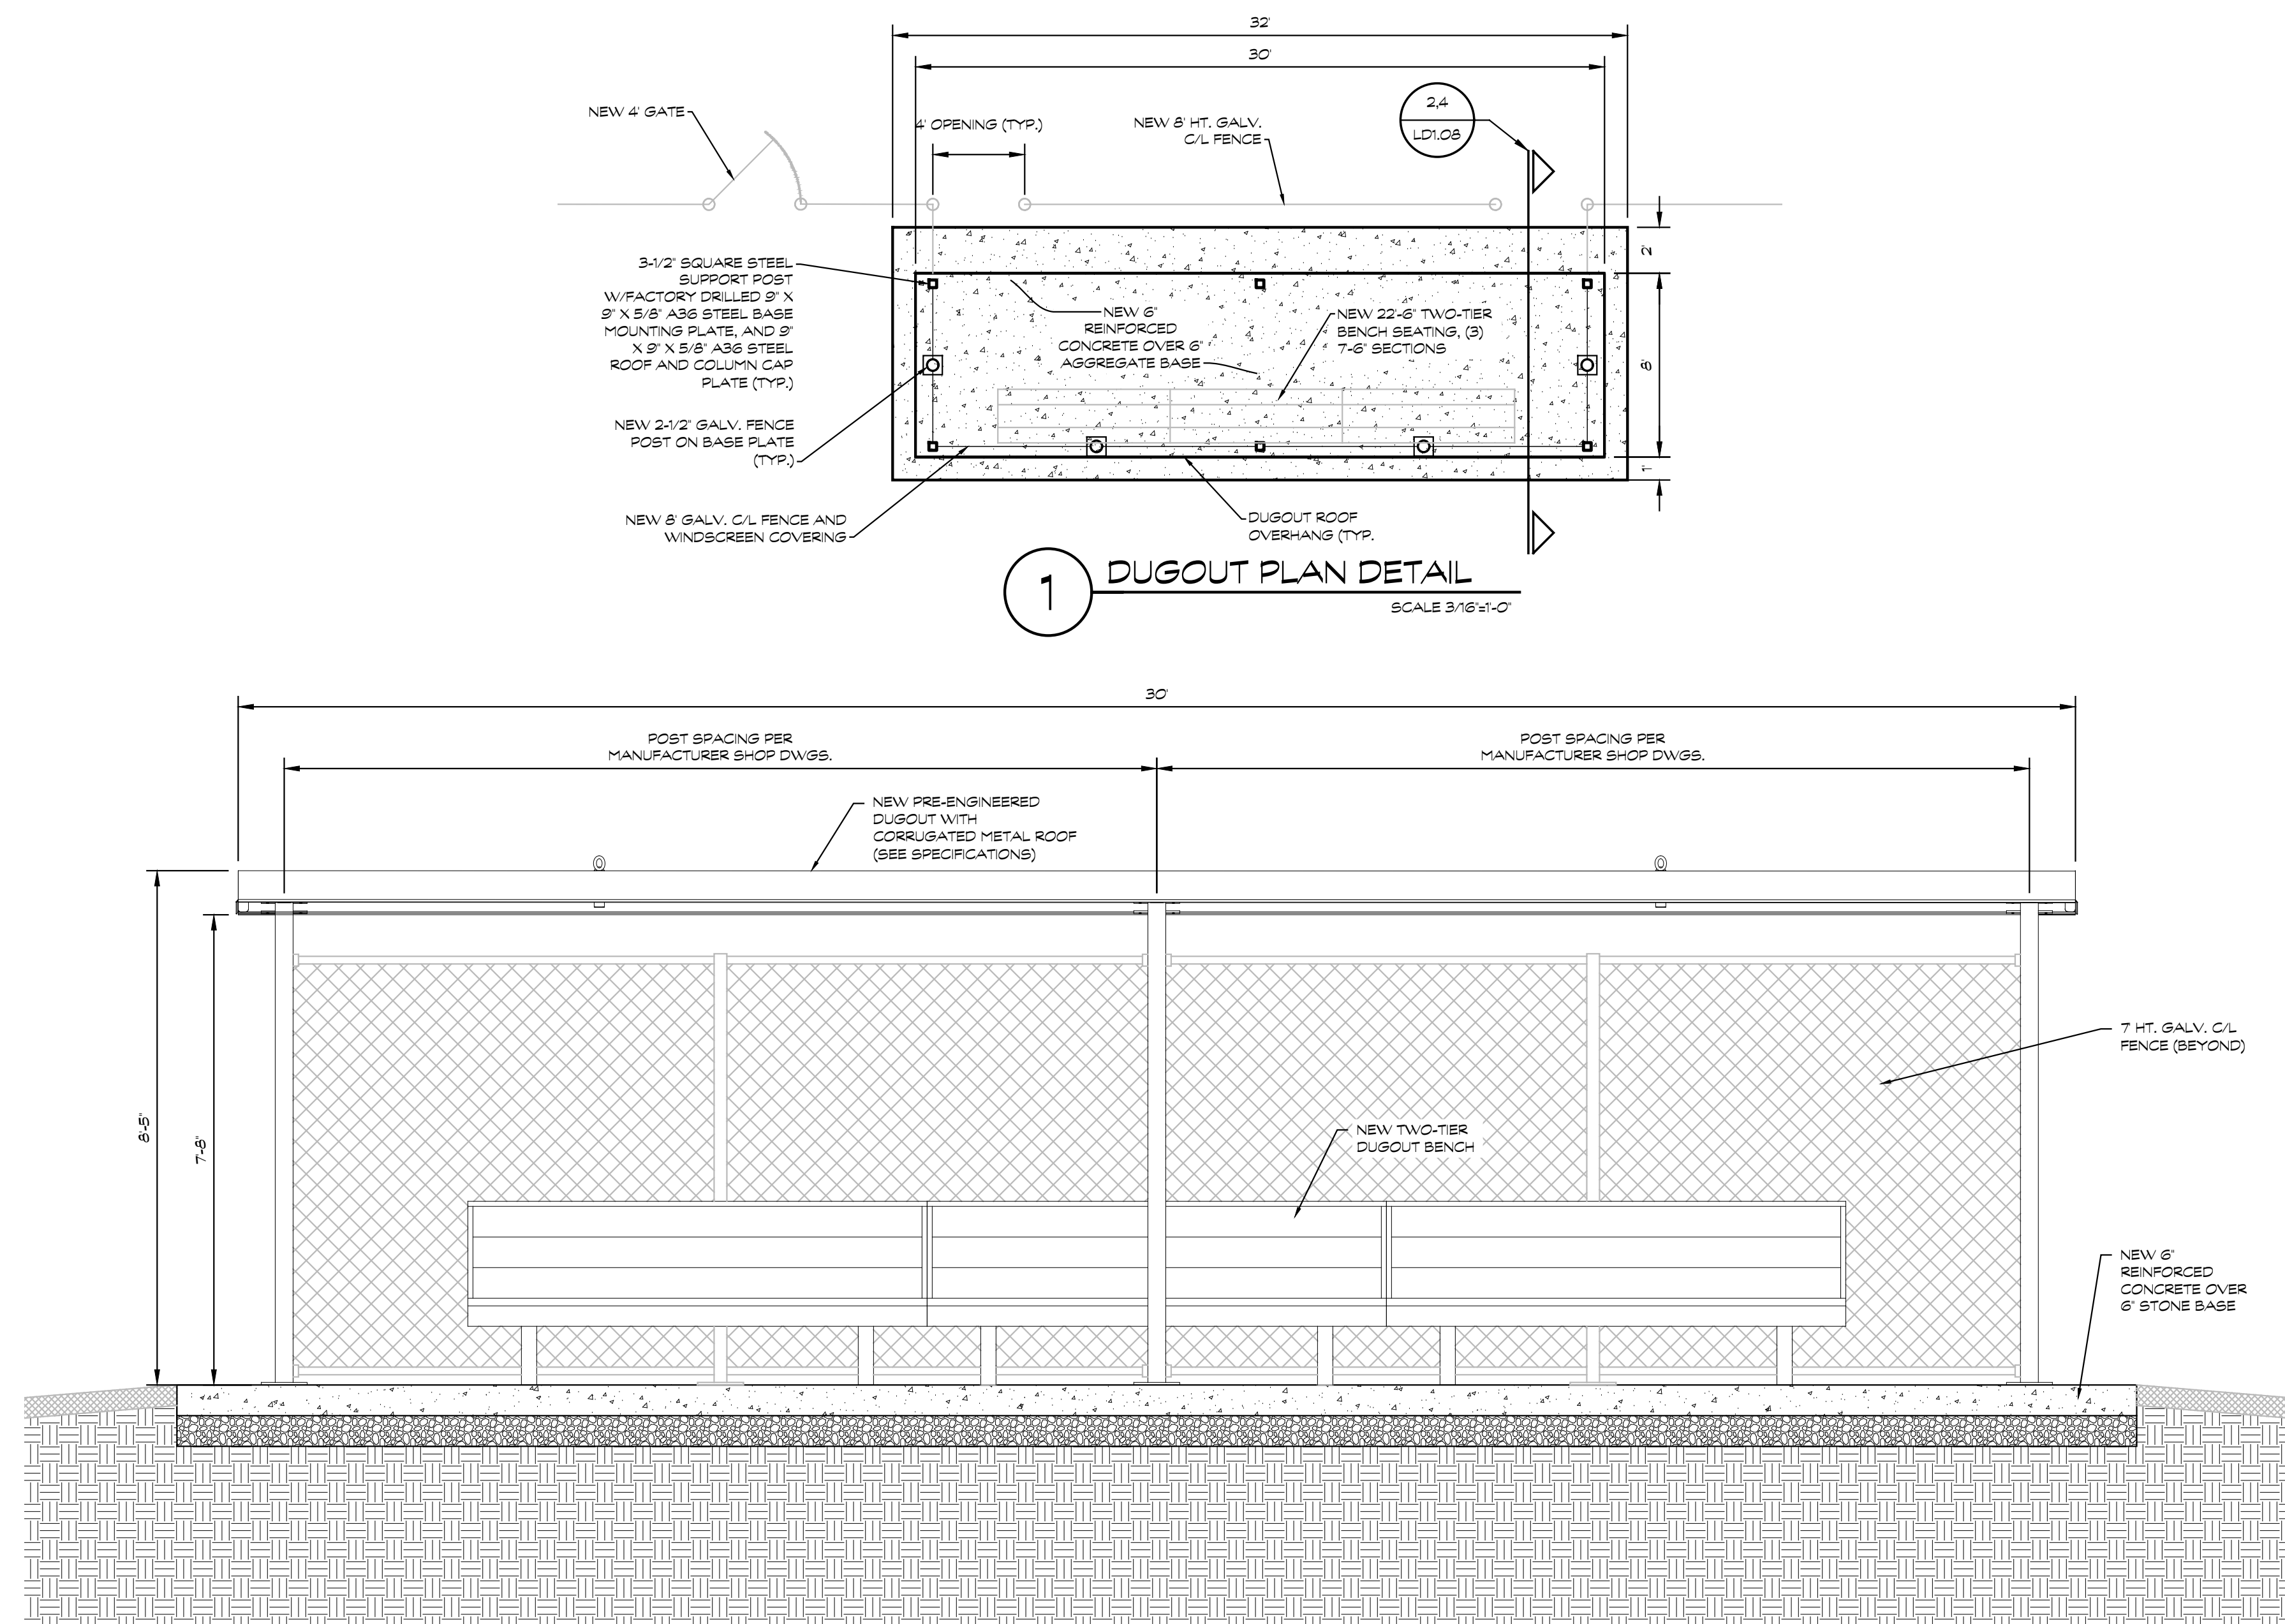

TMP ARCHITECTURE INC
1191 WEST SQUARE LAKE ROAD
BLOOMFIELD HILLS • MICHIGAN • 48302
PH • 248.338.4561 FX • 248.338.0023
EM • INFO@TMPARCHITECTURE.COM

REGISTRATION SEAL

CONSULTANT

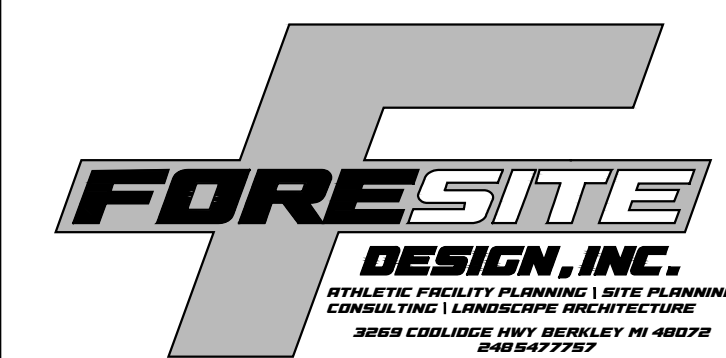

PROJECT TITLE
**Athens High School
Athletic Fields
Bid Package No. 02B**

Troy School District
Troy, Michigan

DRAWING TITLE
**J.V Backstop
Details**

ISSUE DATES

01-14-2025 ADDENDUM NO.1
12-10-2024 CONSTRUCTION DOCUMENTS

DATE: ISSUED FOR:

DRAWN: JB

CHECKED: HD










APPROVED: MDS

PROJECT NO.

22103D

DRAWING NO.


LD1.08

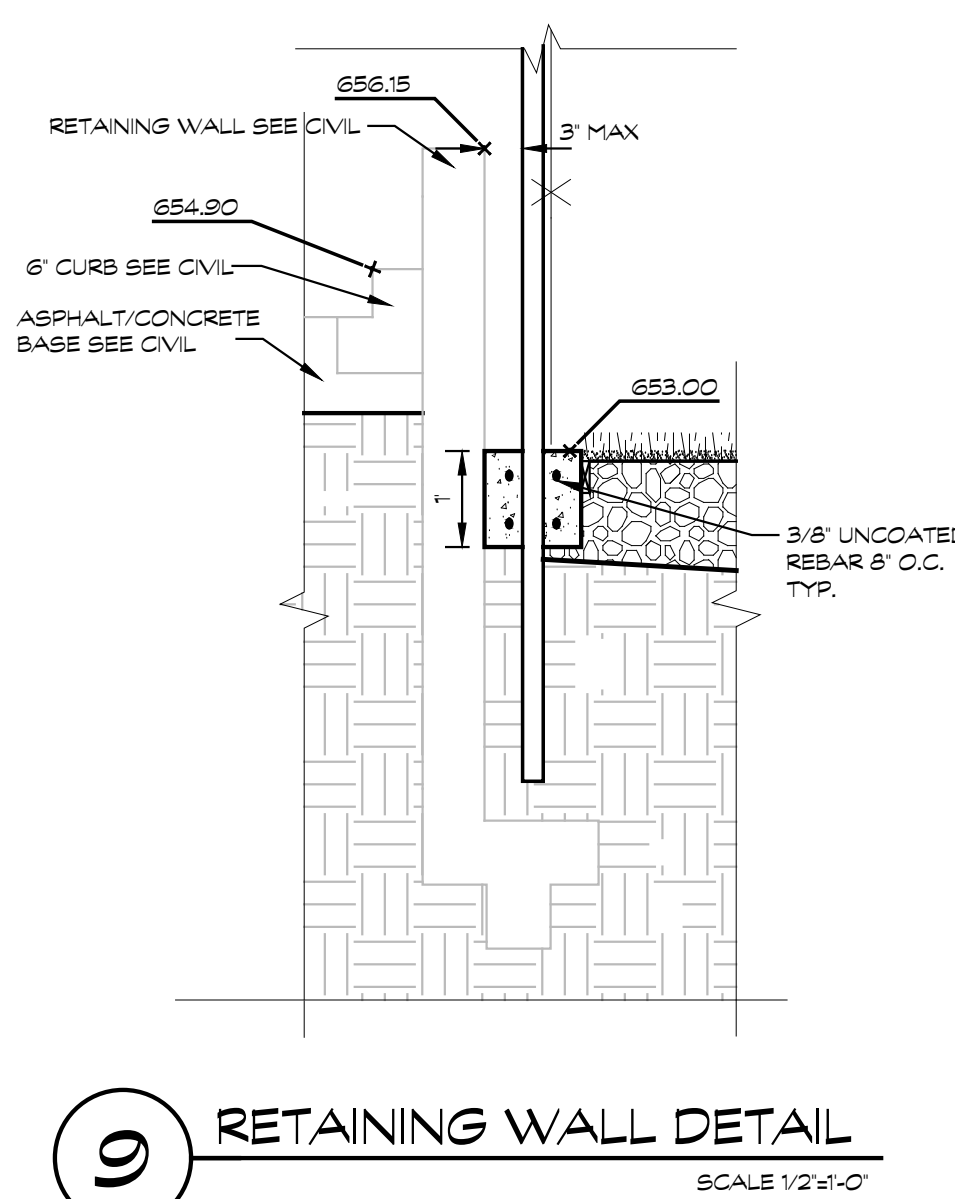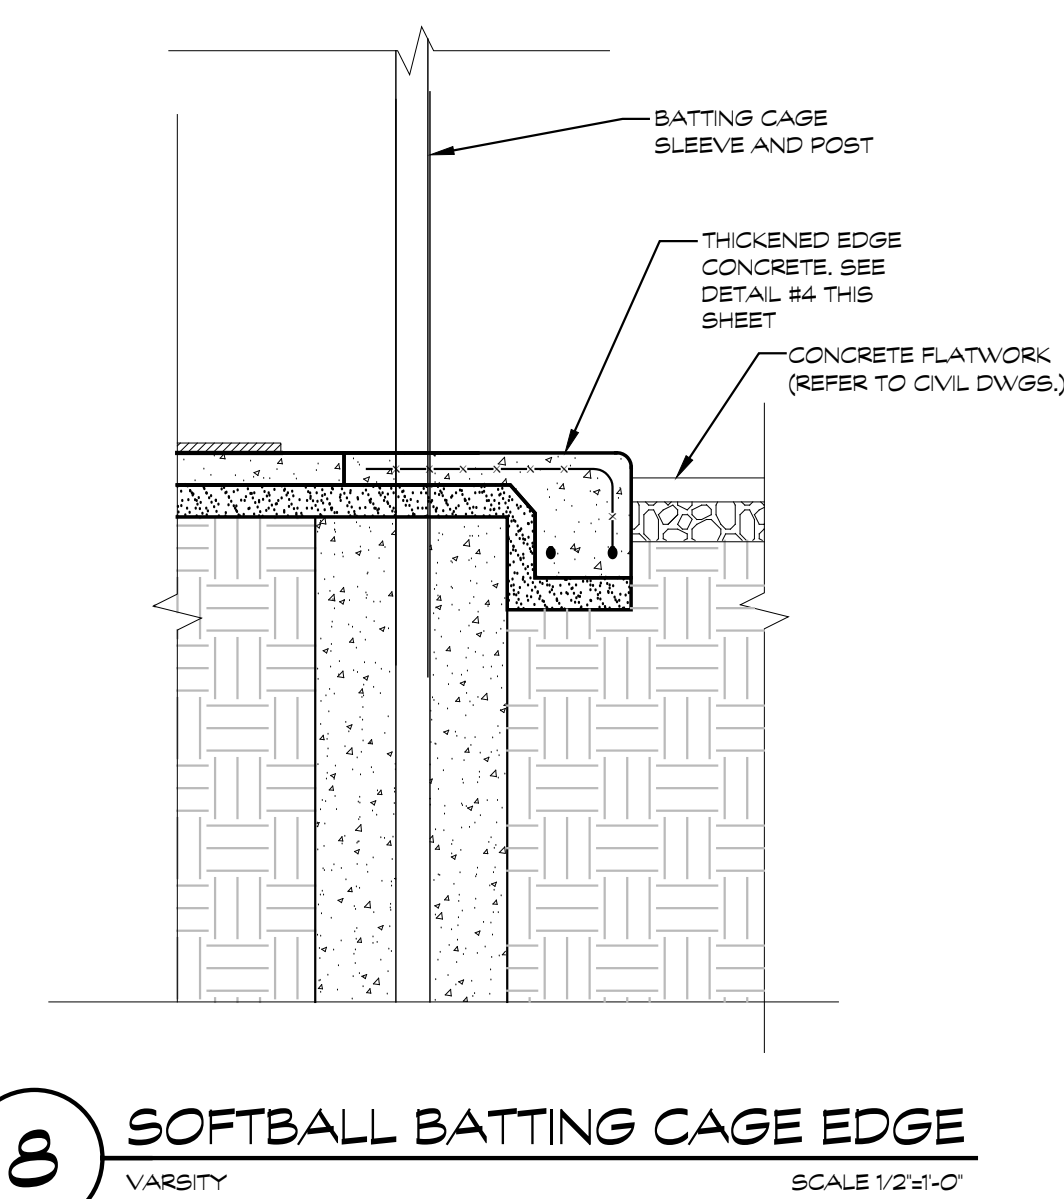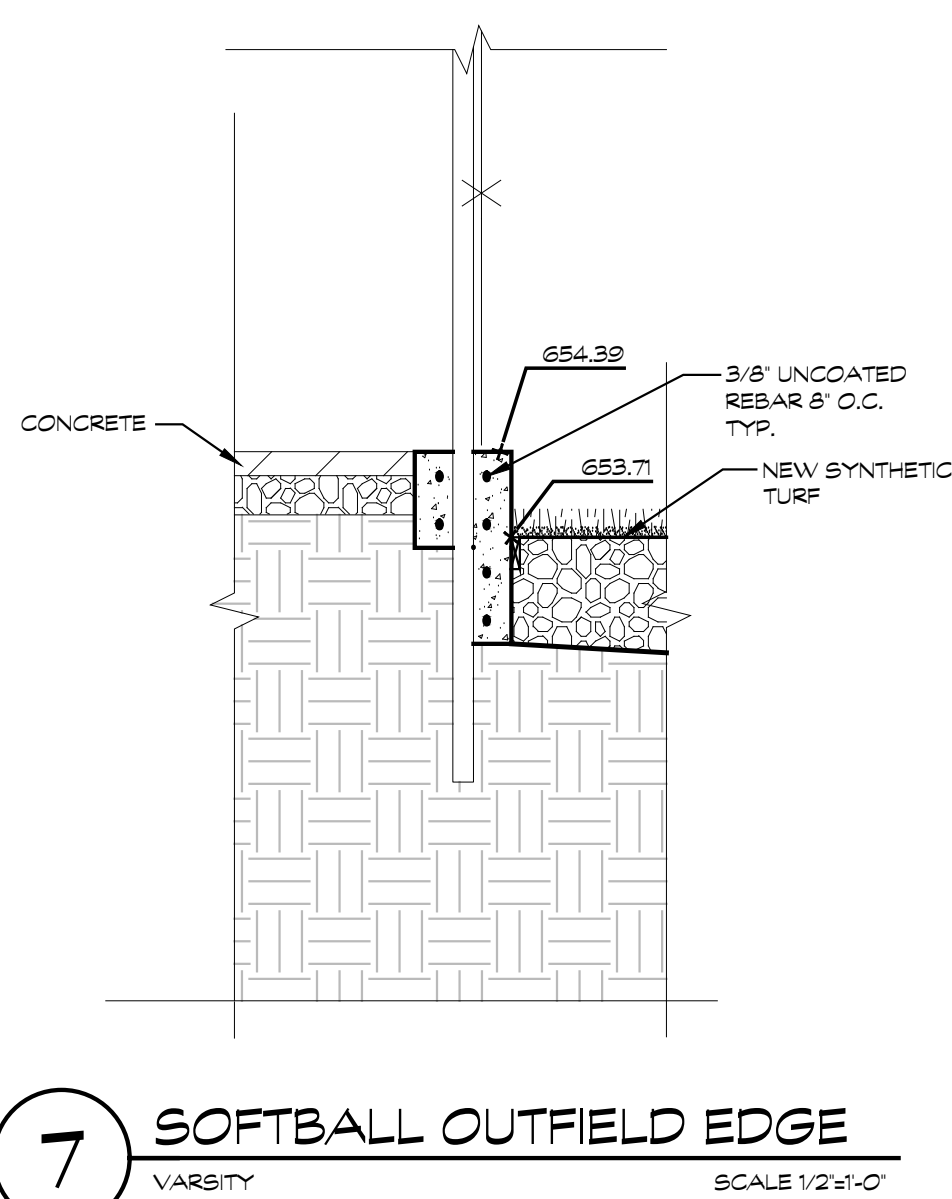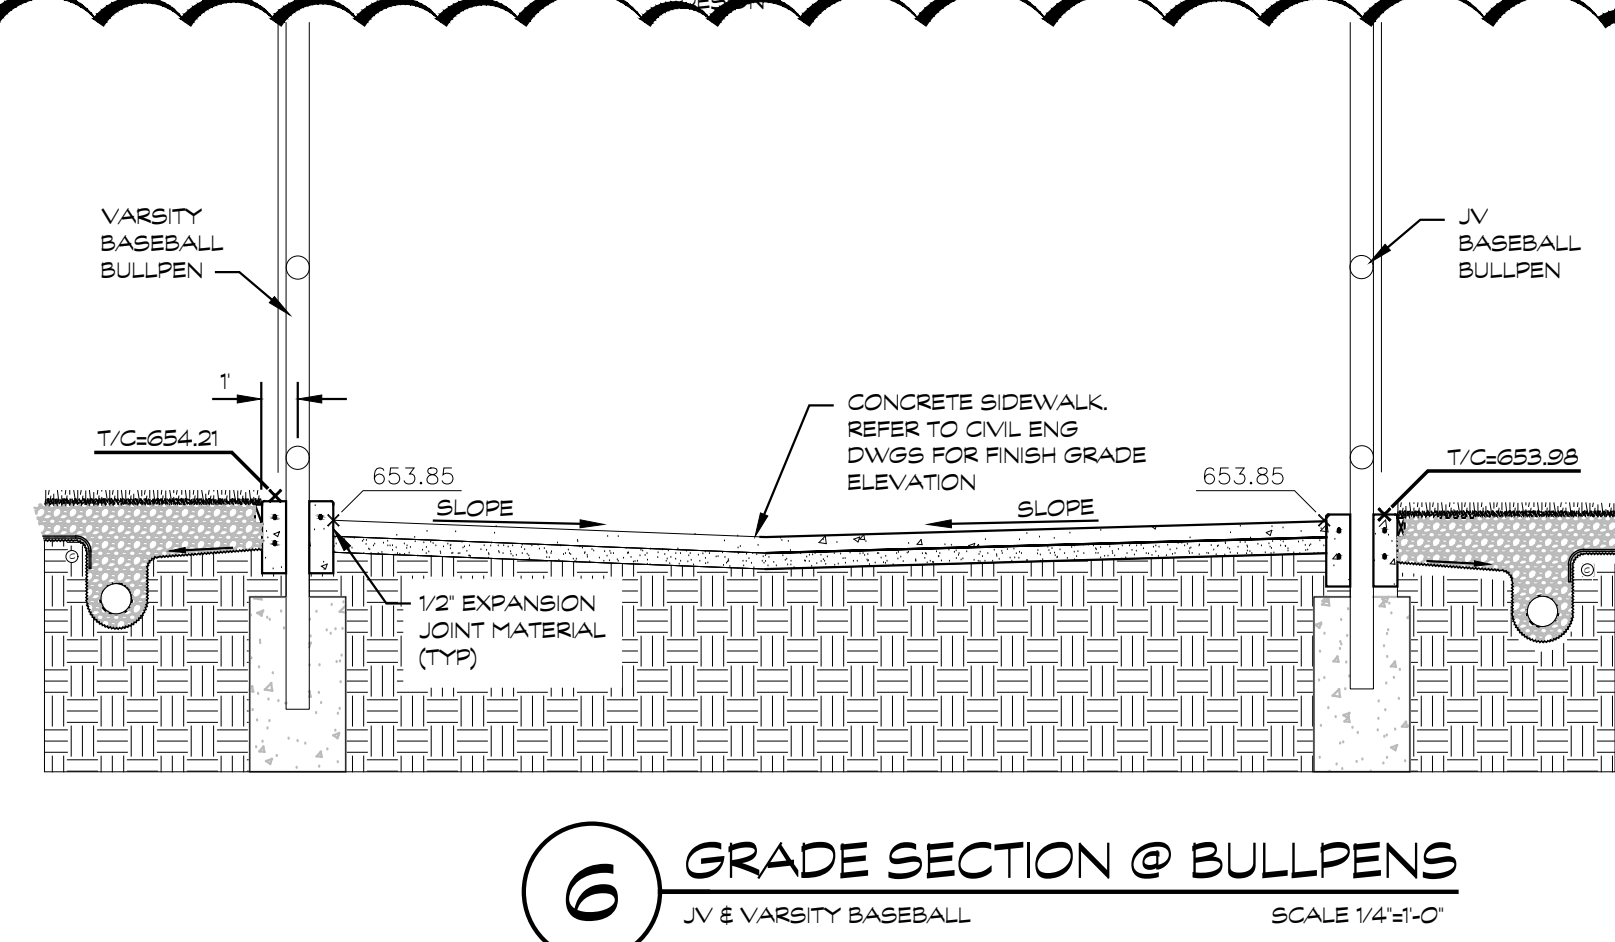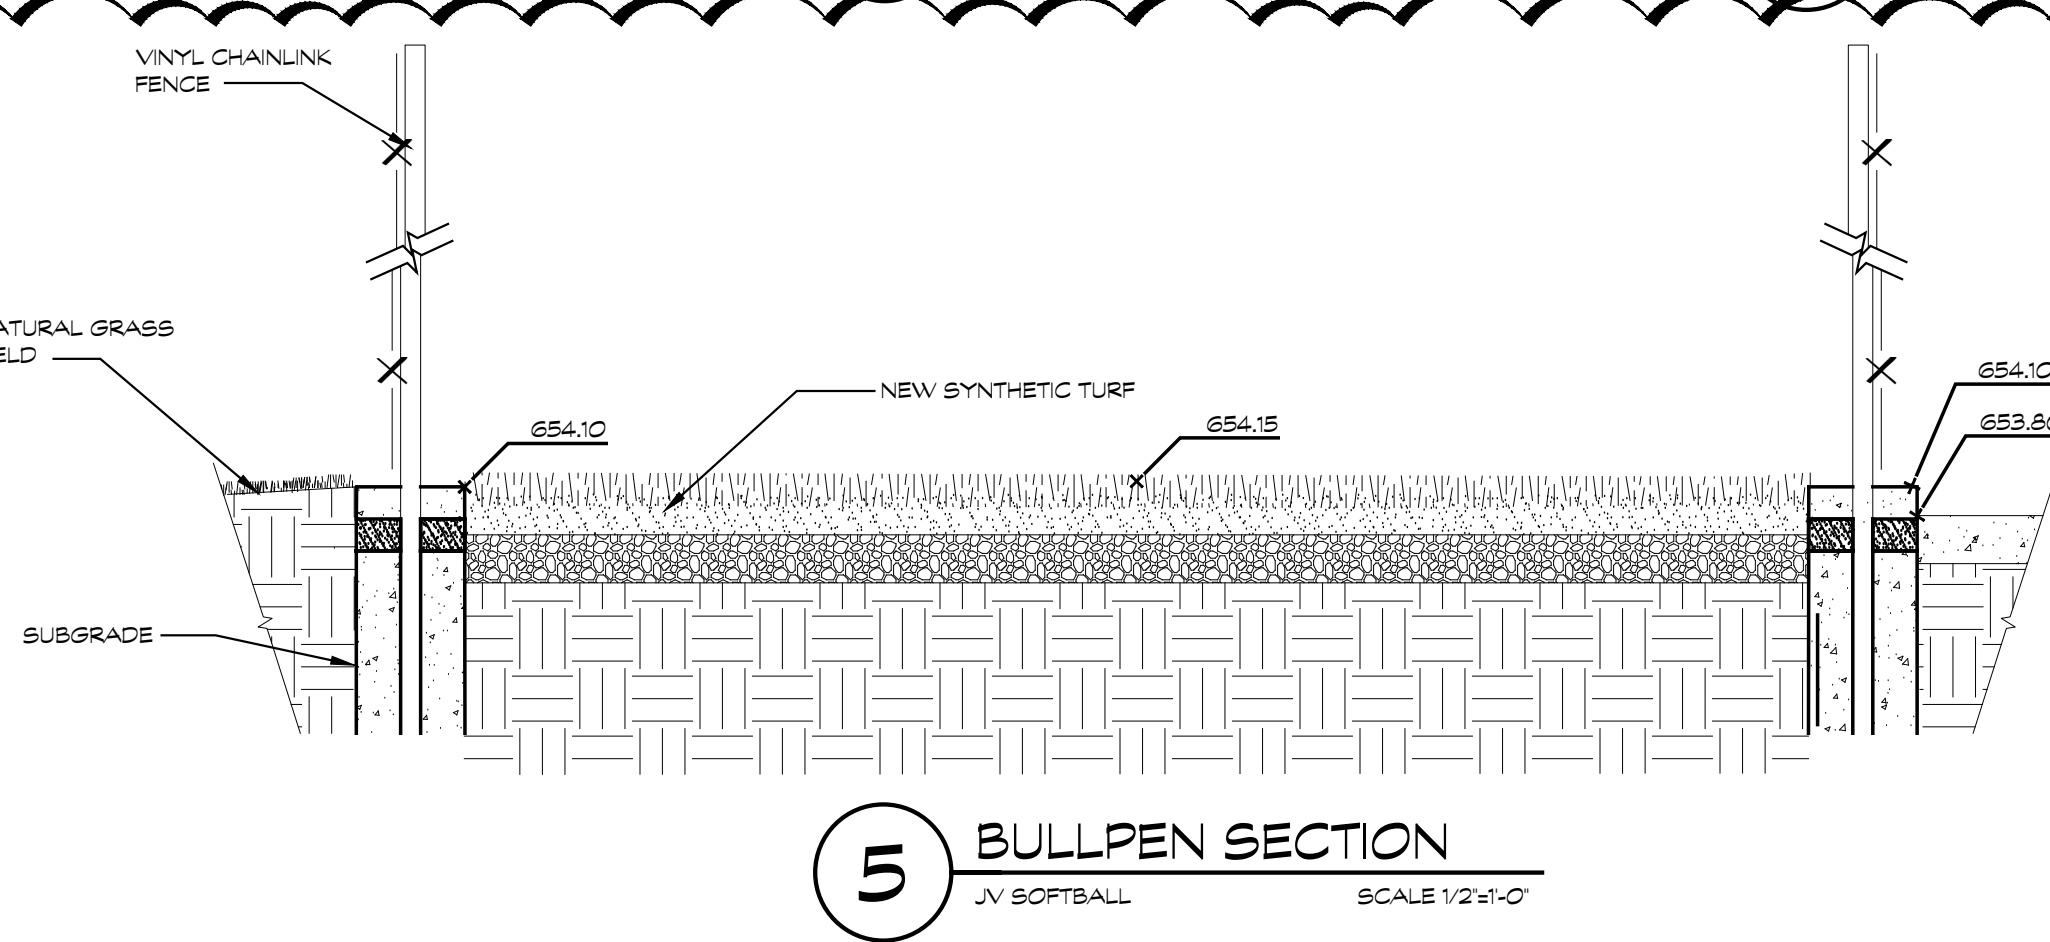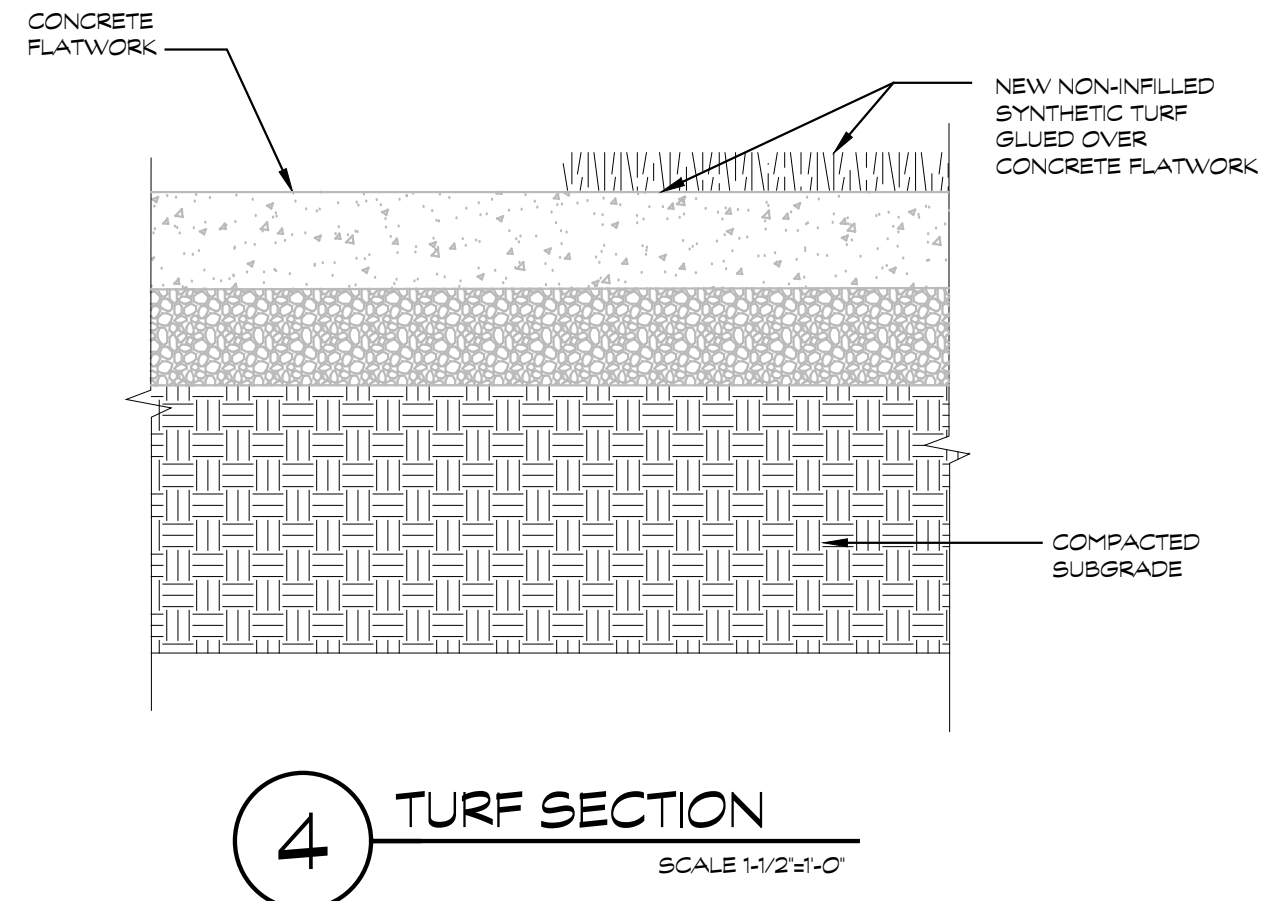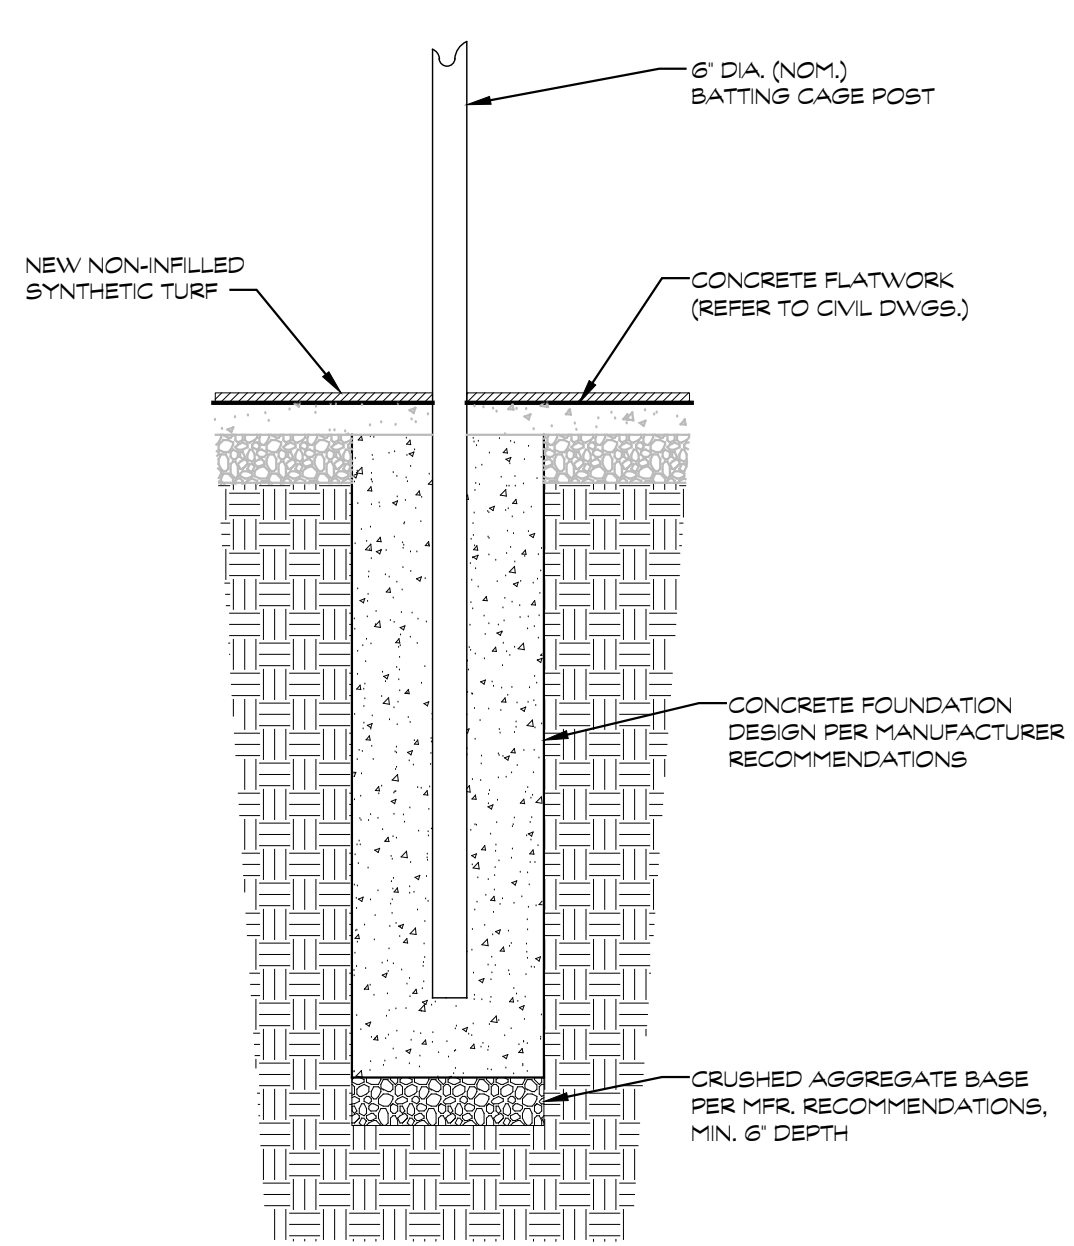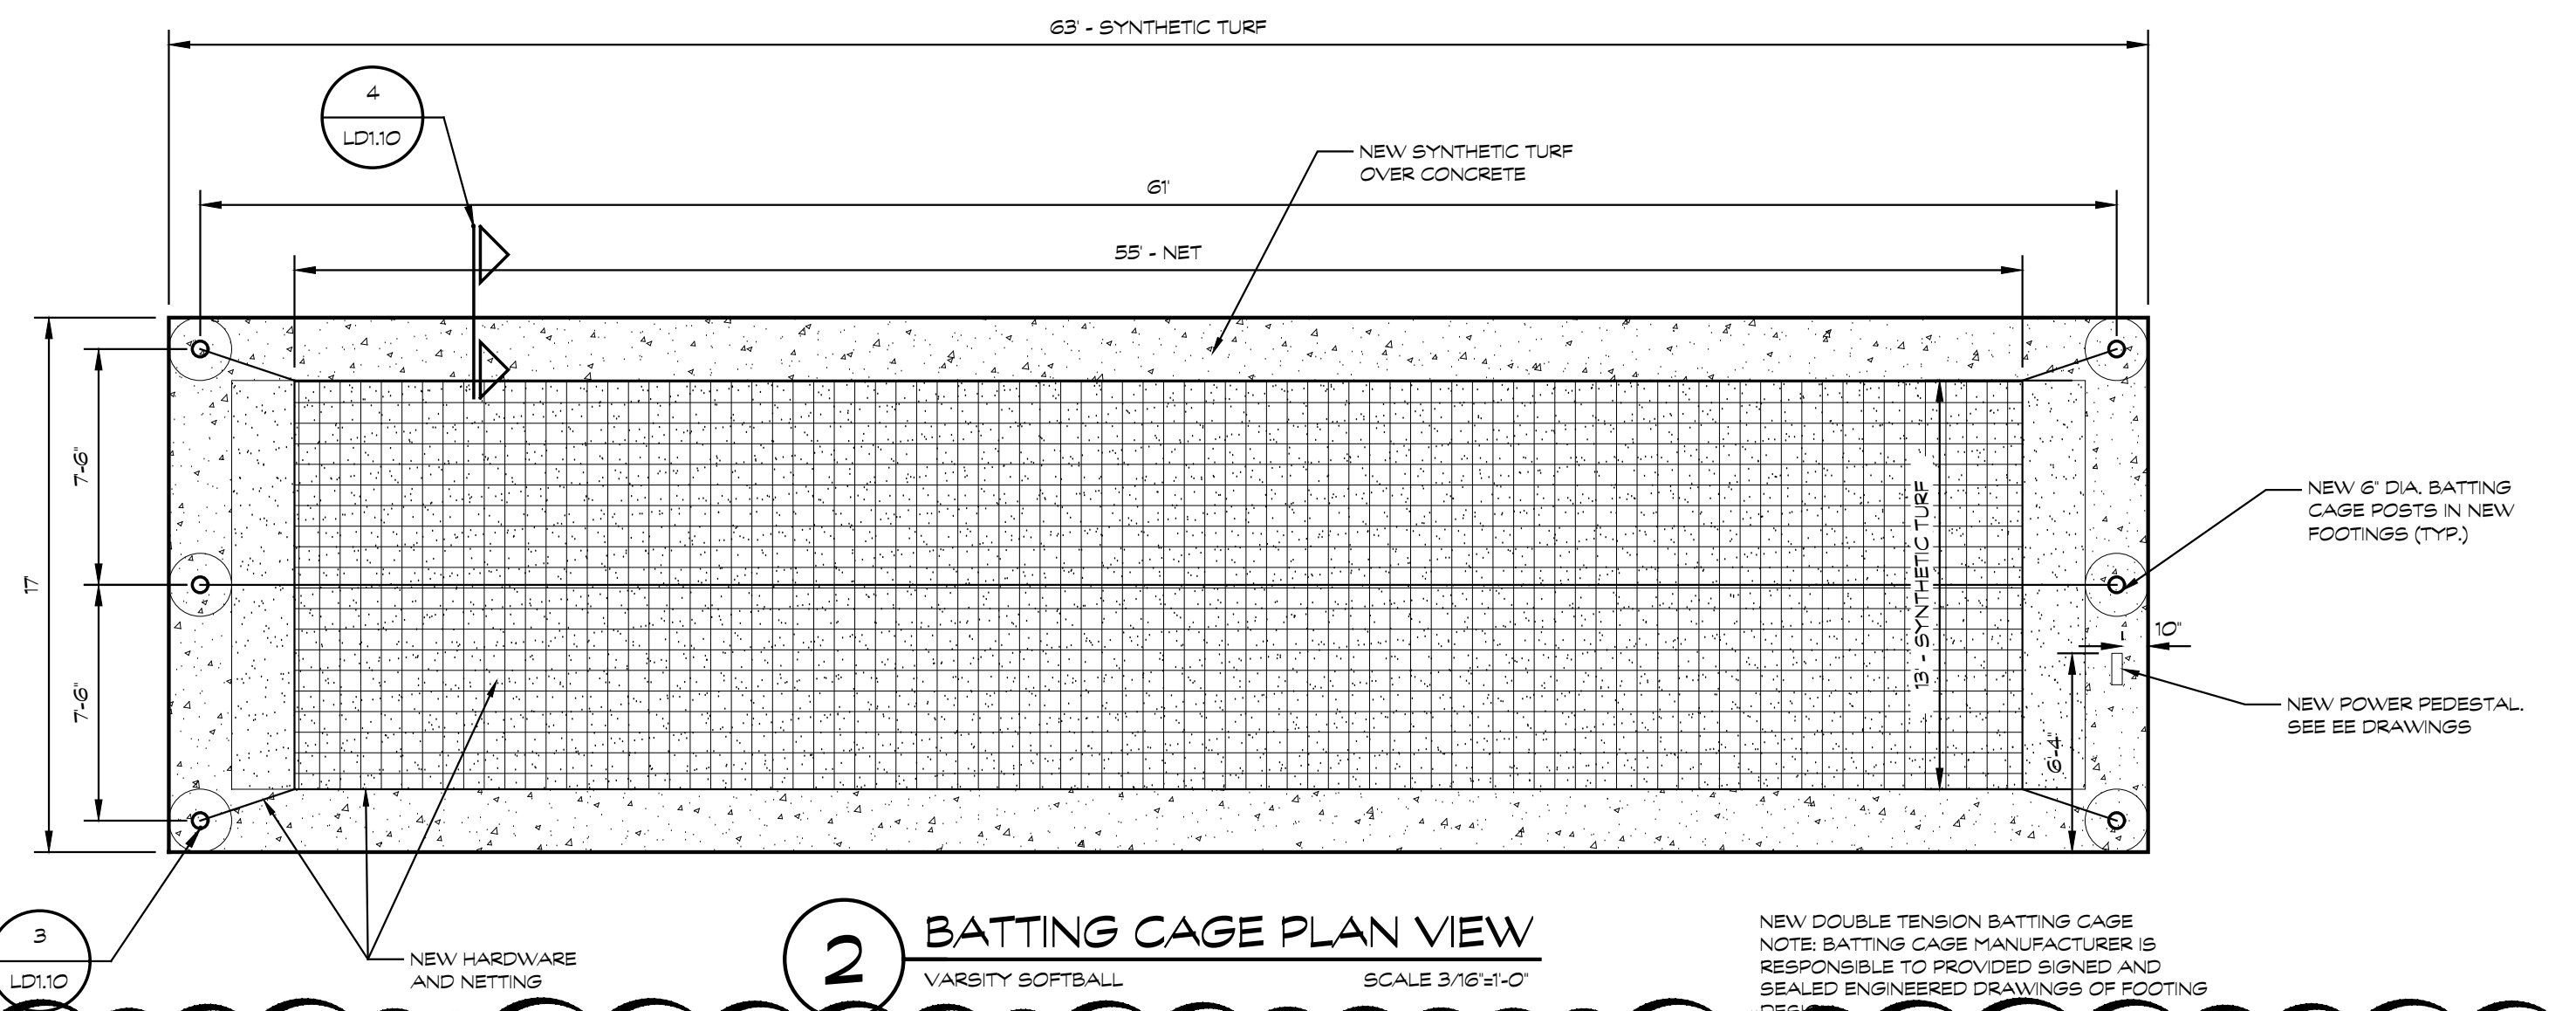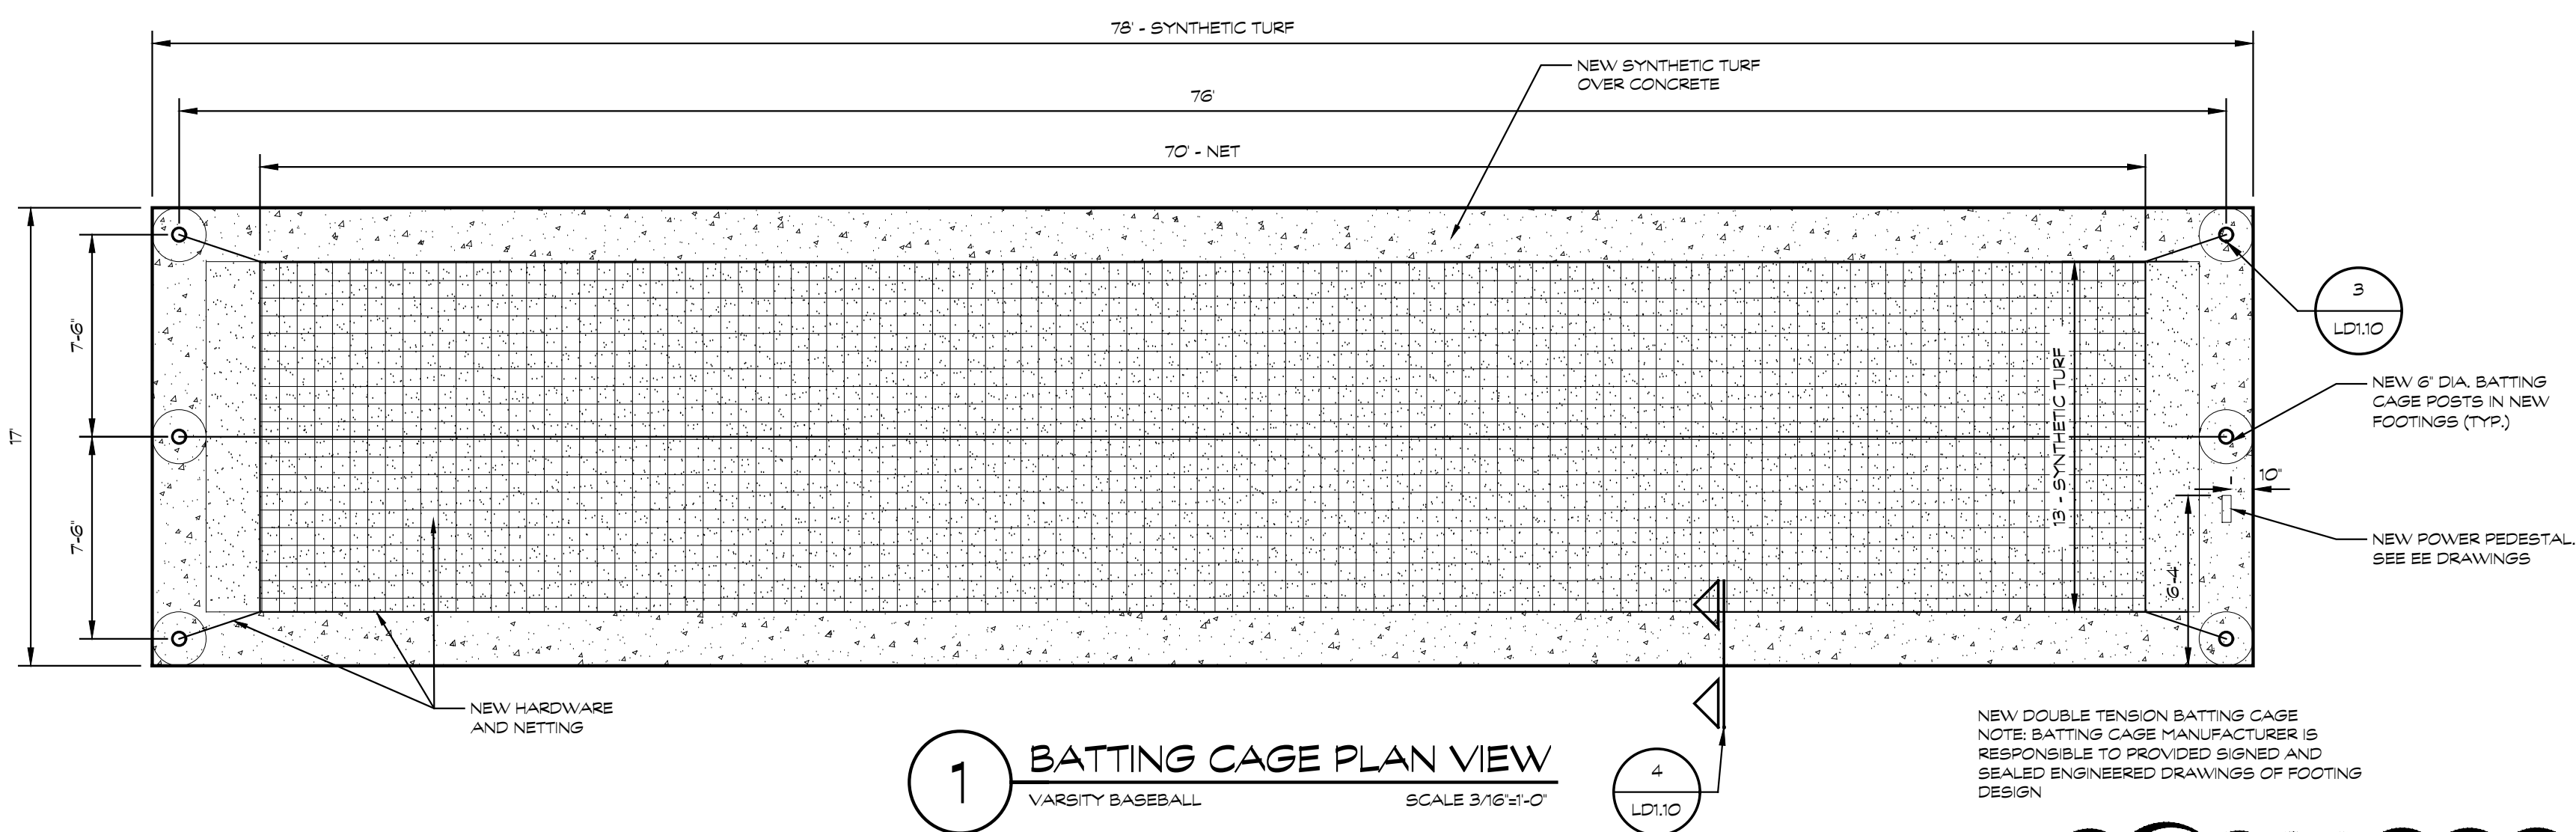

TMP ARCHITECTURE INC
1191 WEST SQUARE LAKE ROAD
BIGWOMFIELD HILLS - MICHIGAN - 48302
PH - 248.338.4561 FX - 248.338.0233
EM - INFO@TMPARCHITECTURE.COM

REGISTRATION SEAL

CONSULTANT

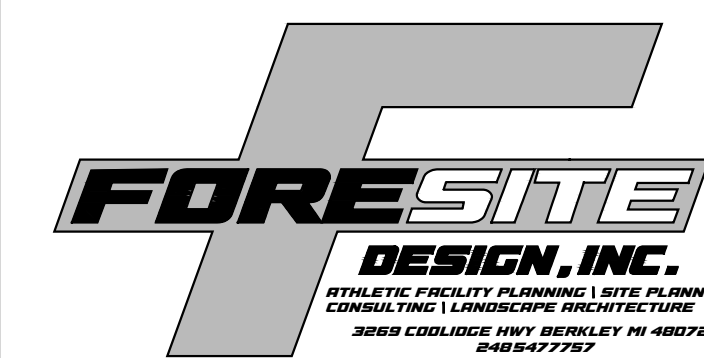

PROJECT TITLE
**Athens High School
Athletic Fields
Bid Package No. 02B**

Troy School District
Troy, Michigan


DRAWING TITLE
**Batting Cage
Details**

ISSUE DATES


01-14-2025	ADDENDUM NO.1
12-10-2024	CONSTRUCTION DOCUMENTS
DATE:	ISSUED FOR:

DRAWN	J.B
CHECKED	HD
APPROVED	MDS


PROJECT NO.
22103D
DRAWING NO.
LD1.10

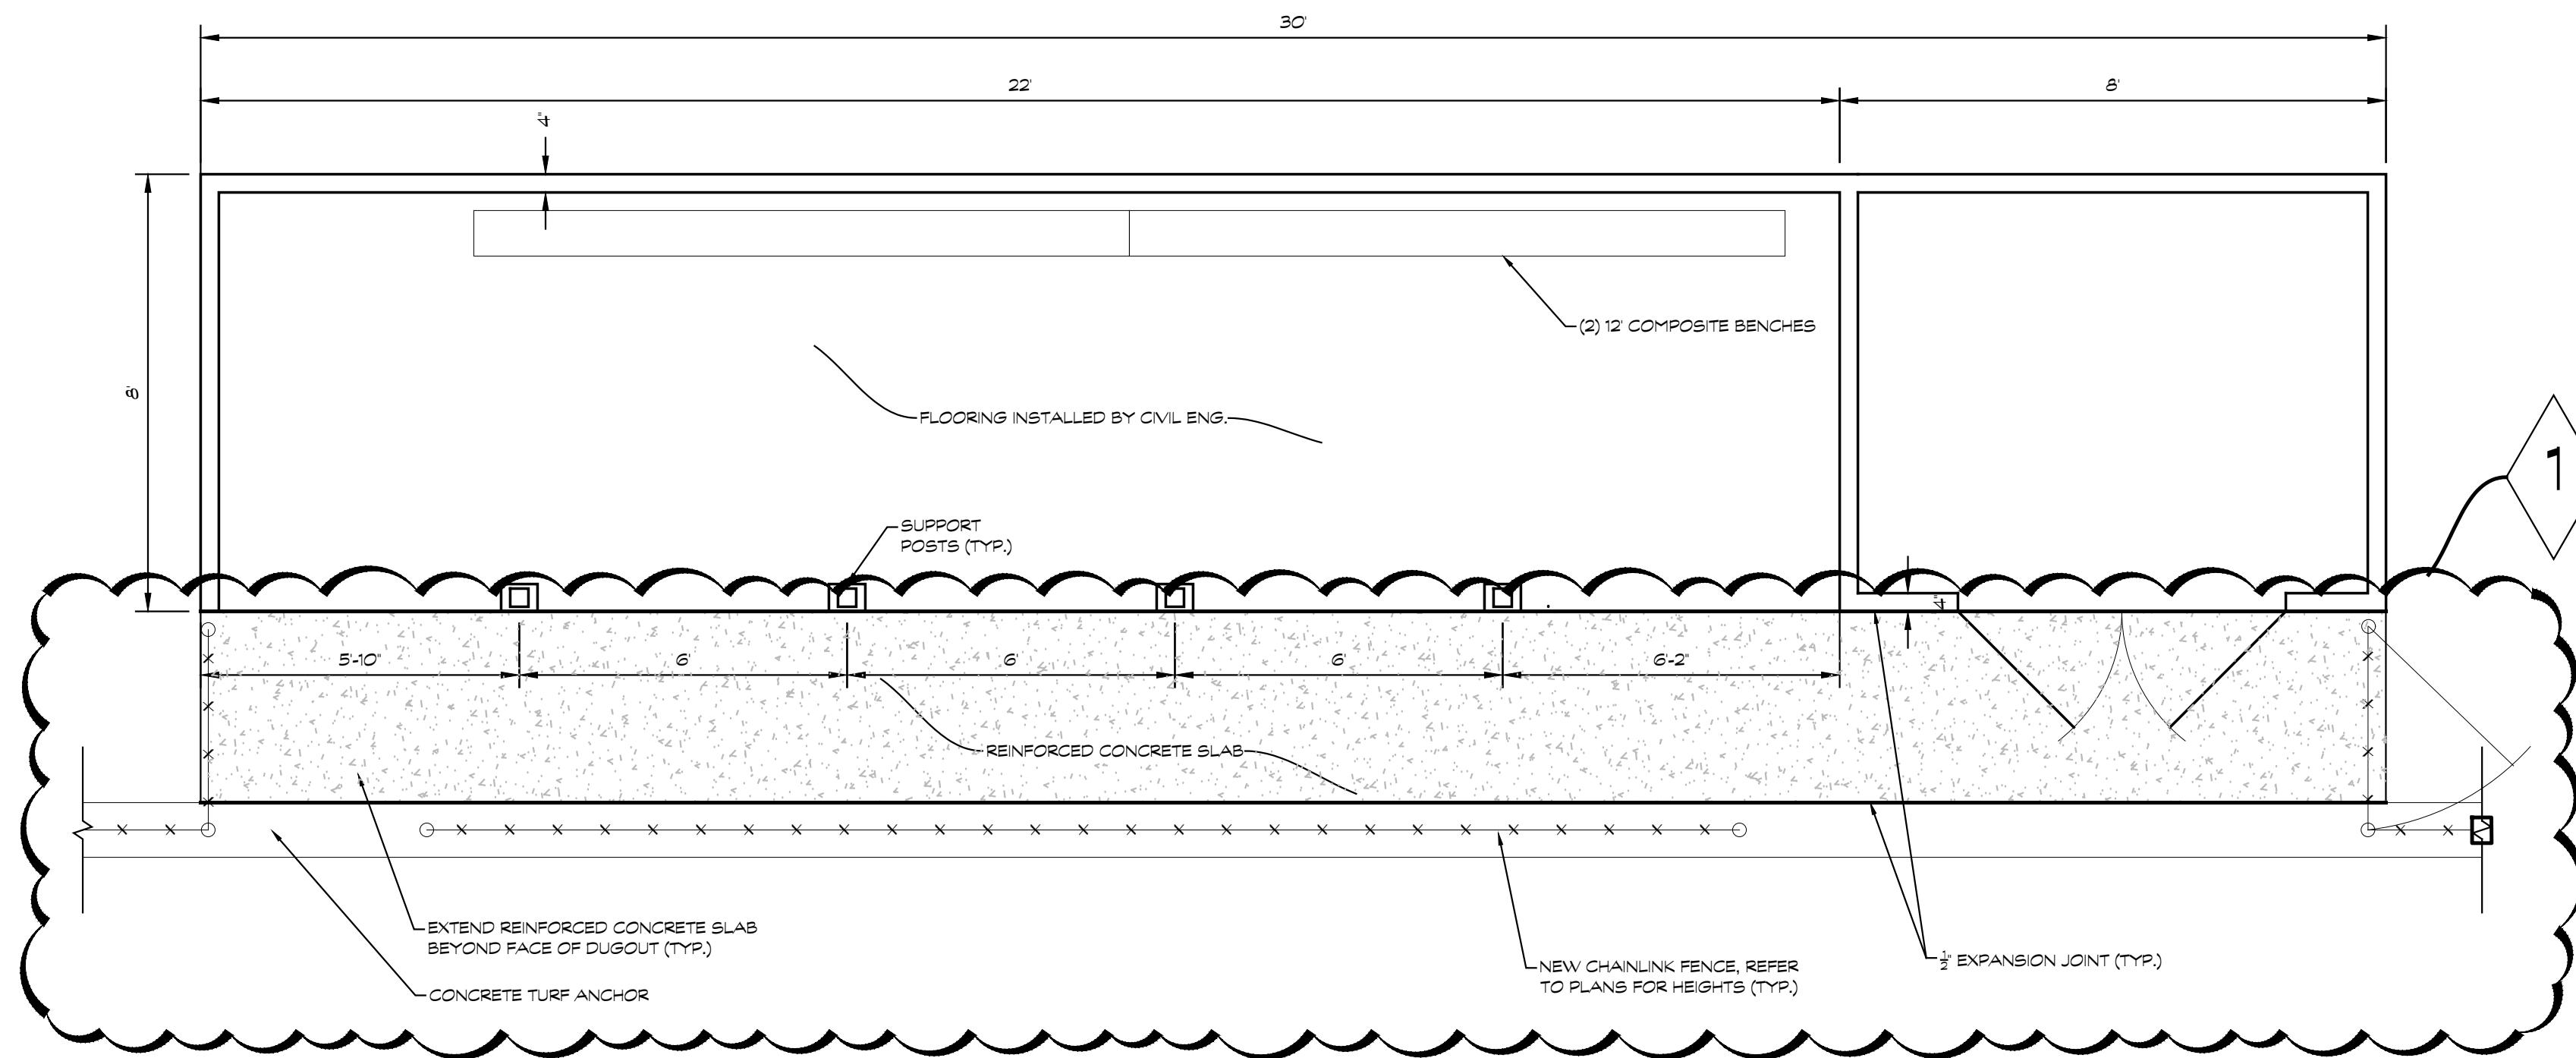


1 VISITOR DUGOUT FLOOR PLAN
SCALE 3/8"=1'-0"

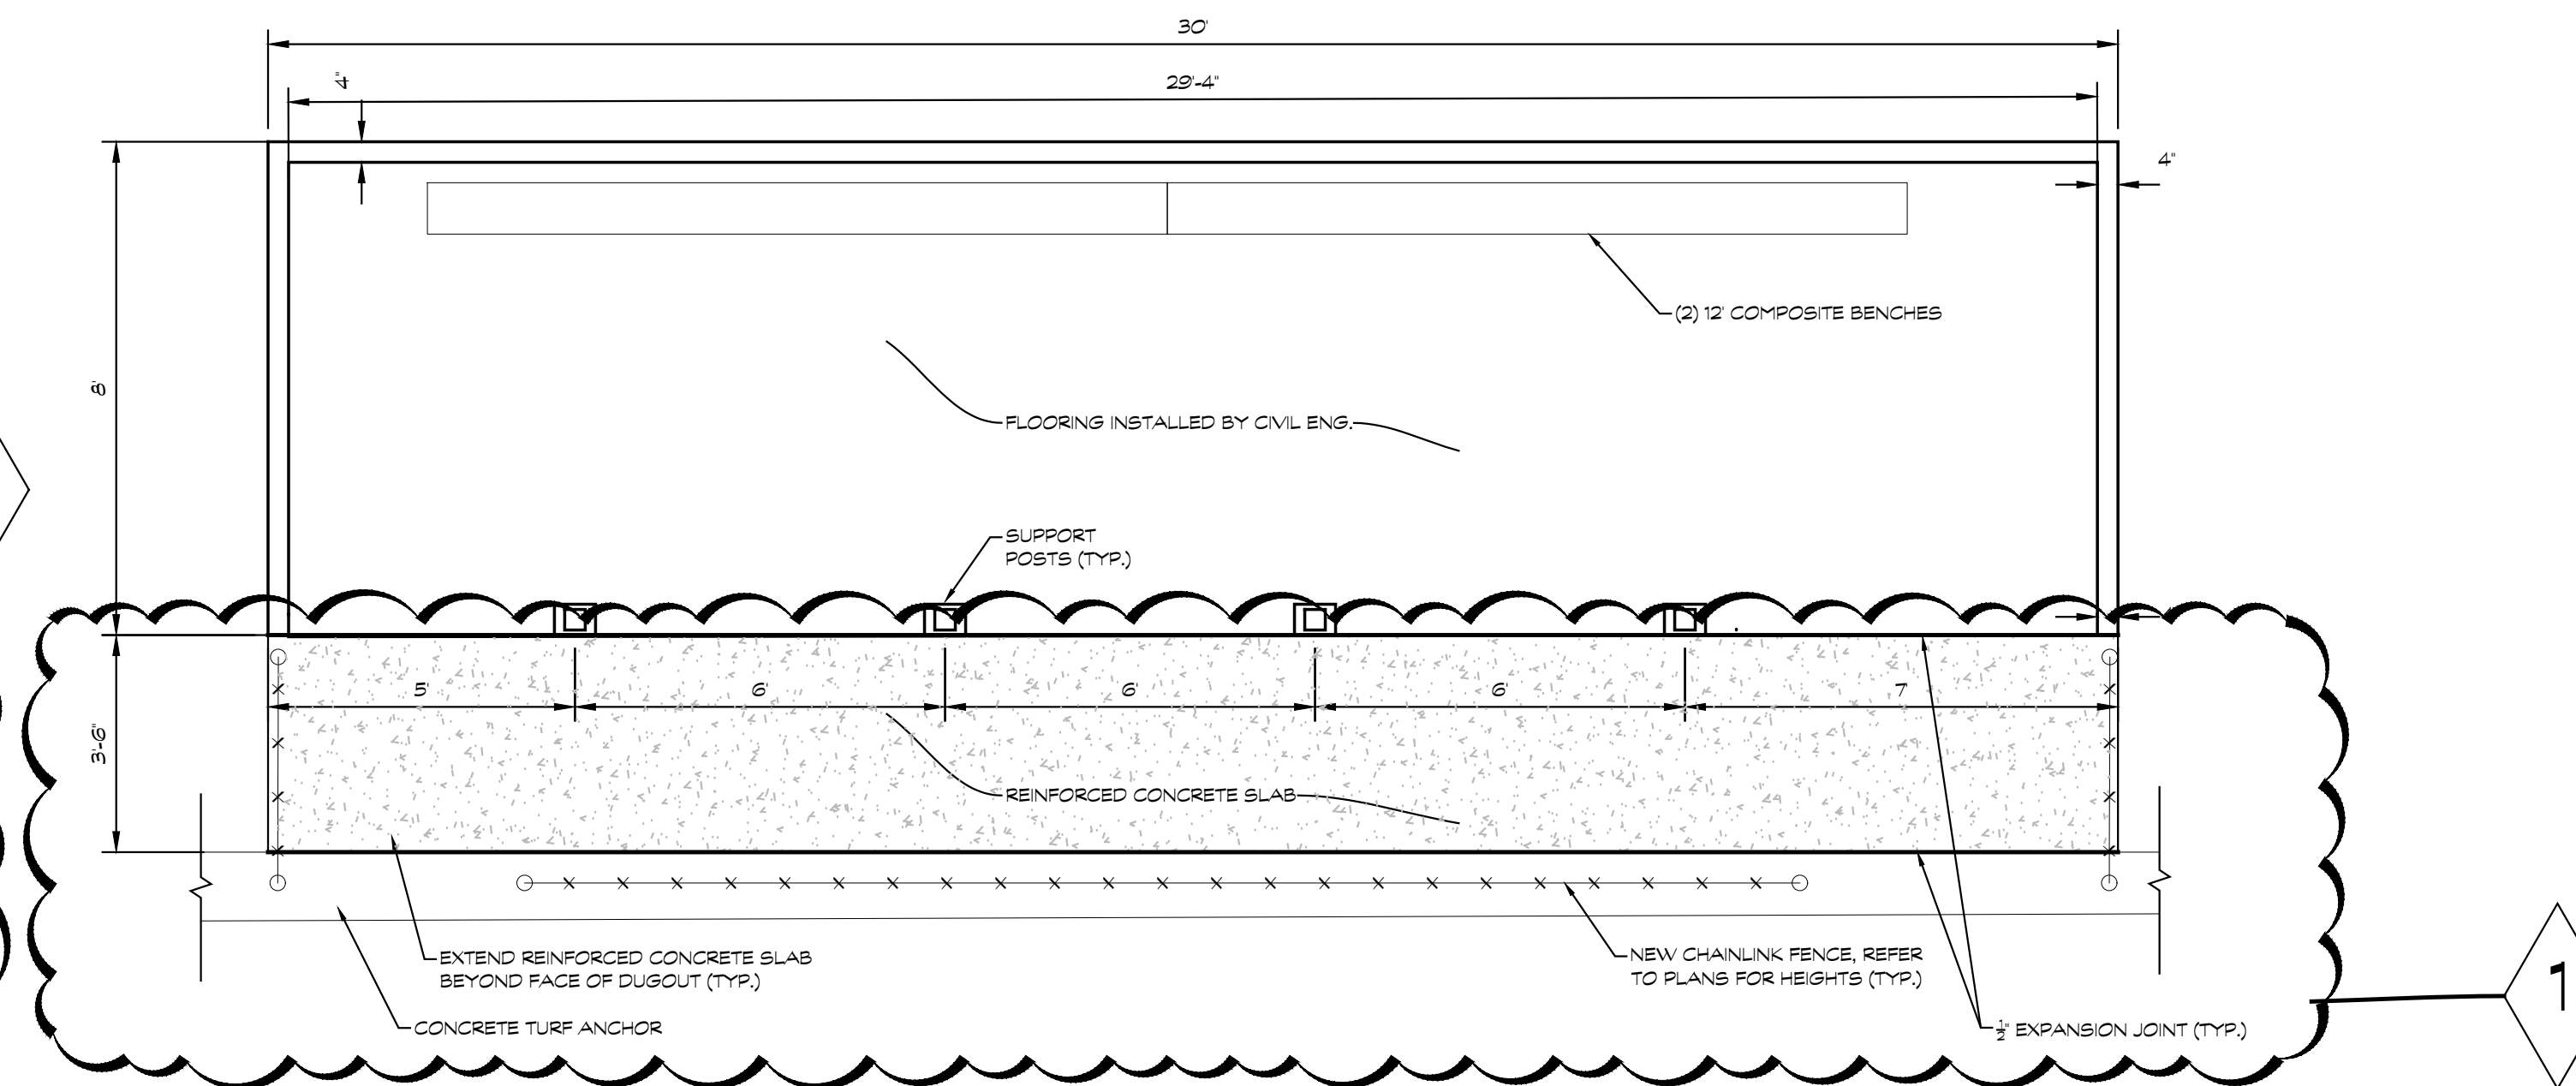


2 HOME DUGOUT FLOOR PLAN
SCALE 3/8"=1'-0"

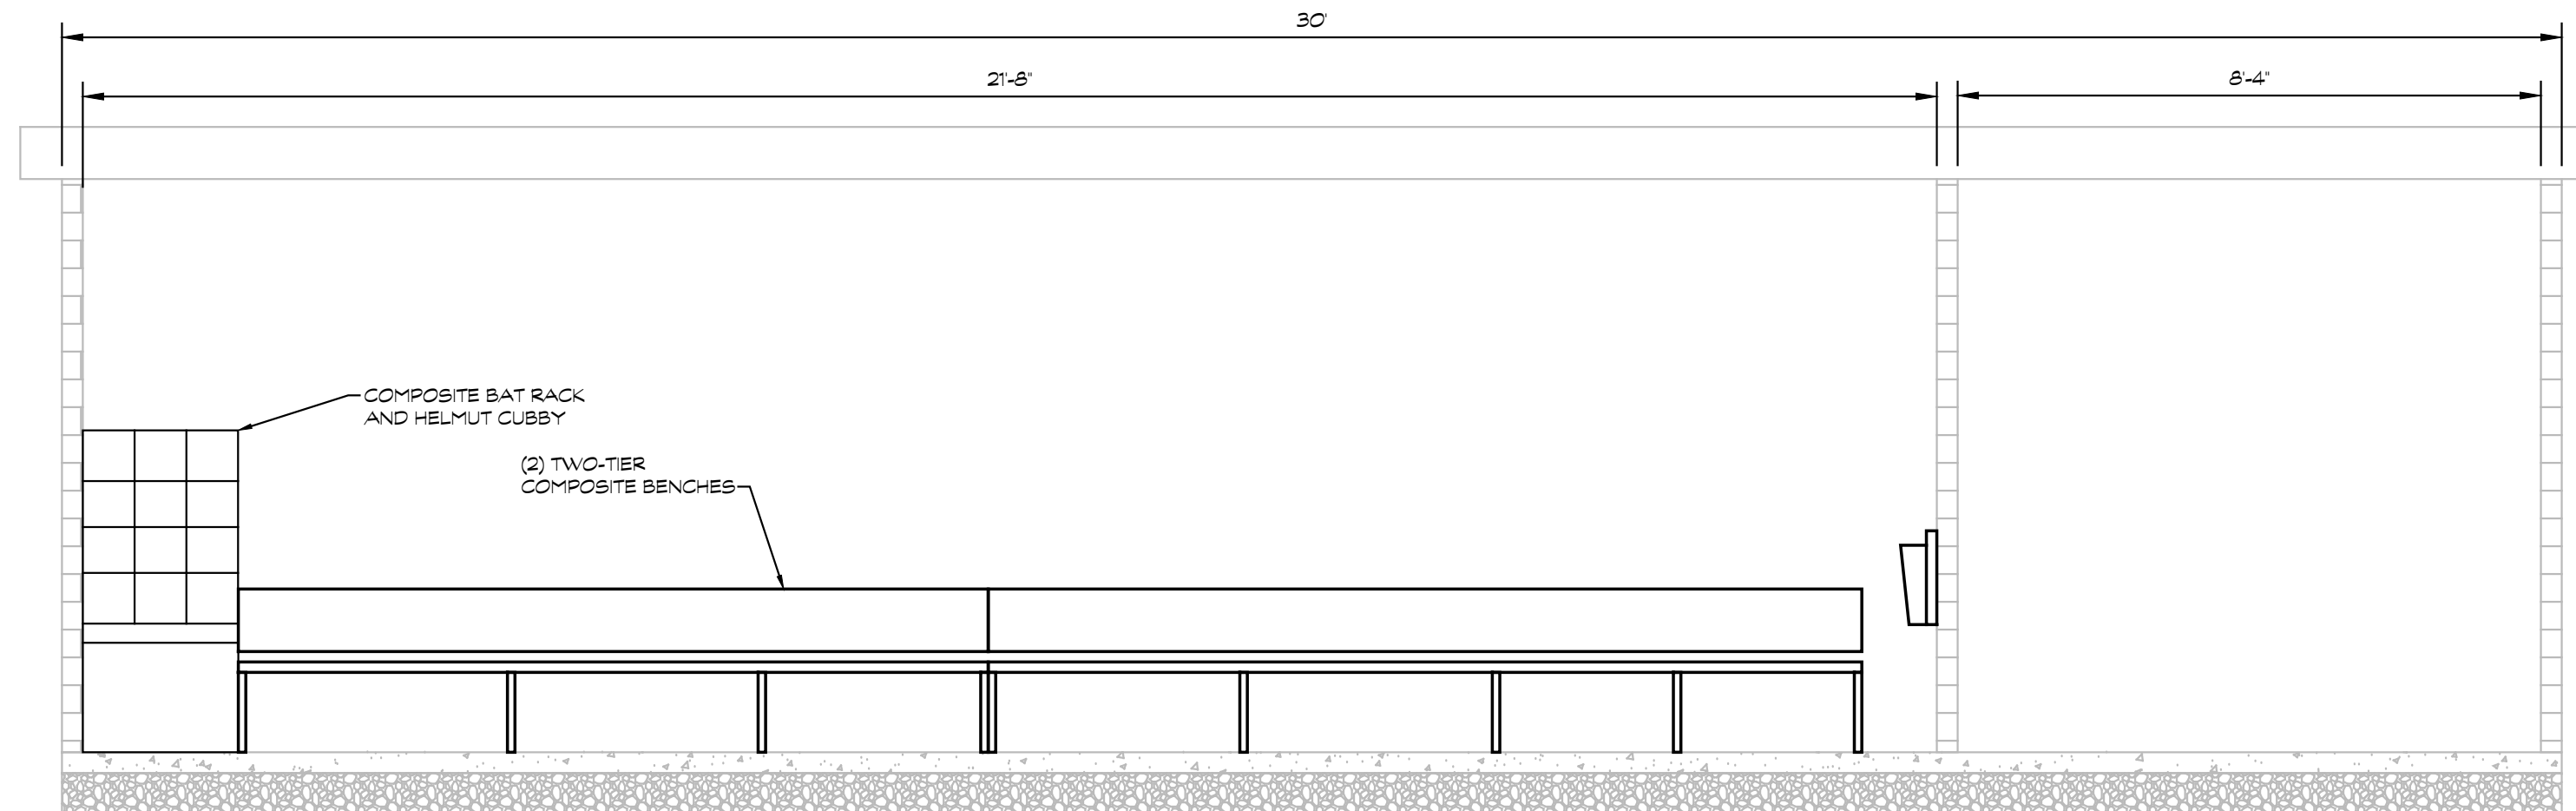


3 VISITOR DUGOUT EQUIPMENT ELEVATION
SCALE 3/8"=1'-0"

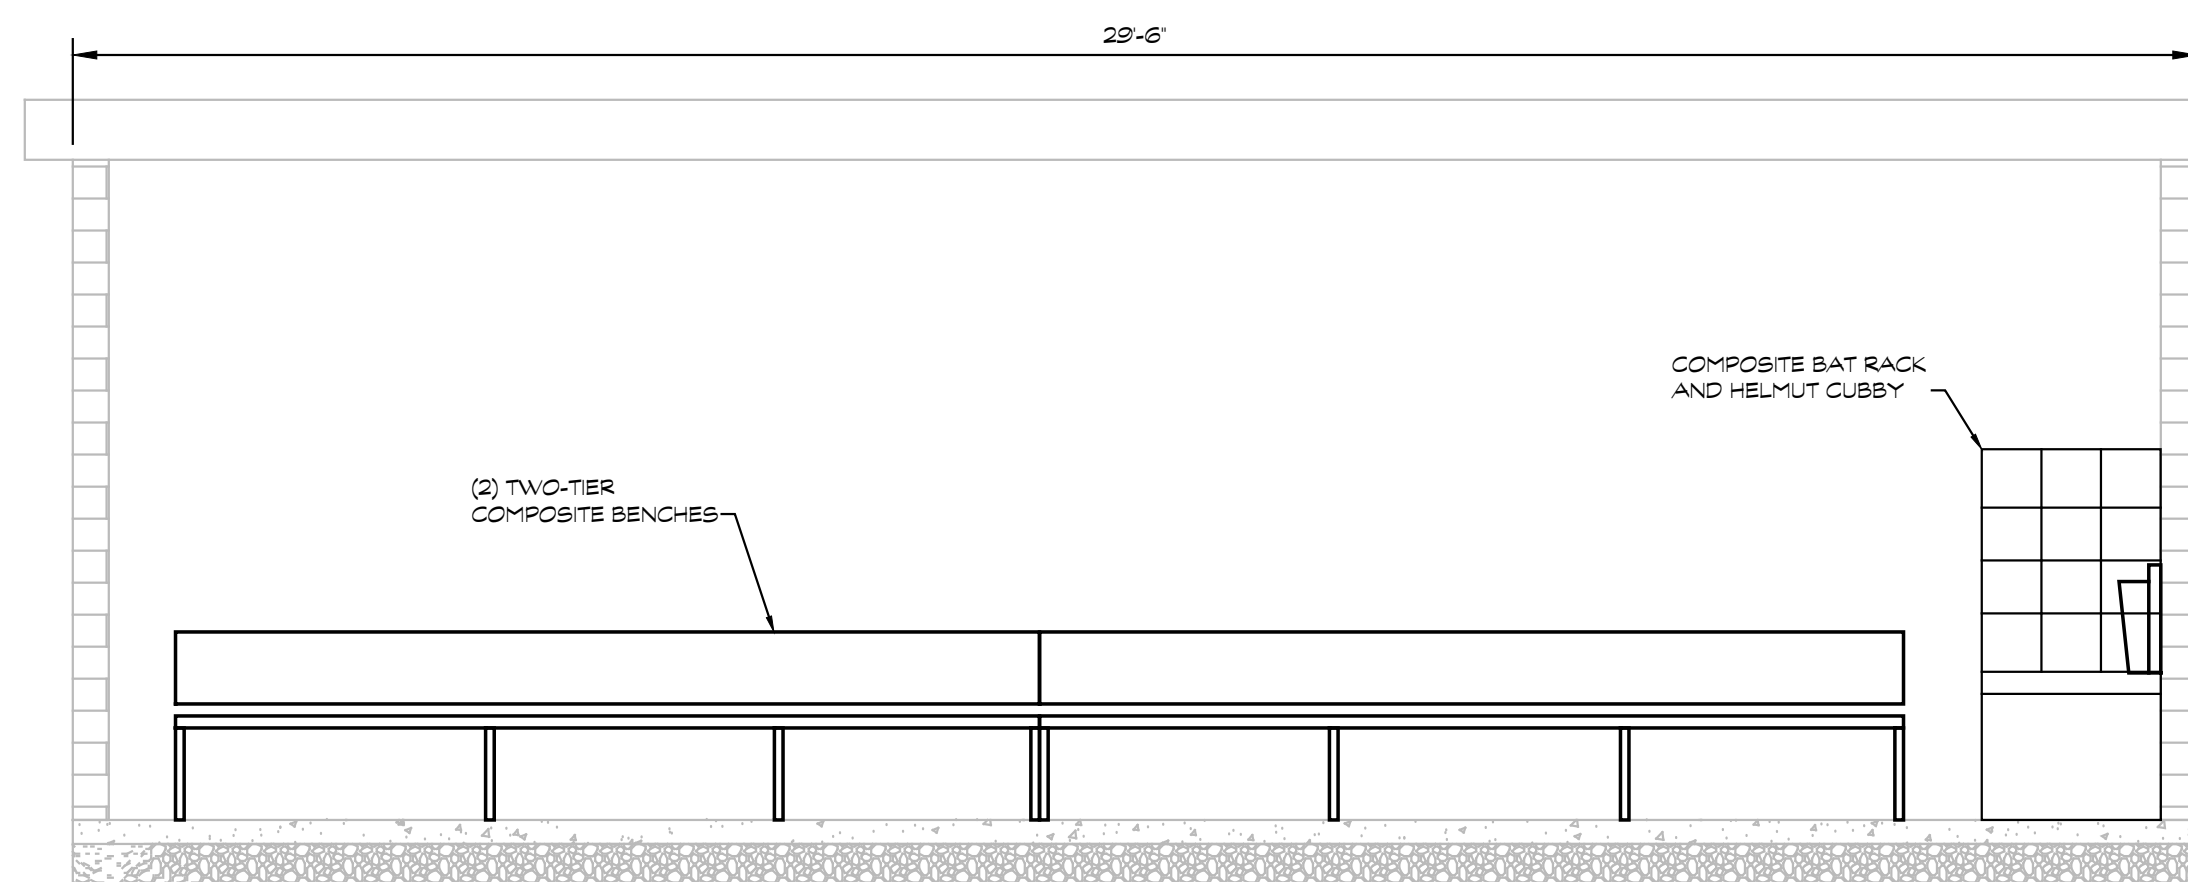


4 HOME DUGOUT EQUIPMENT ELEVATION
SCALE 3/8"=1'-0"

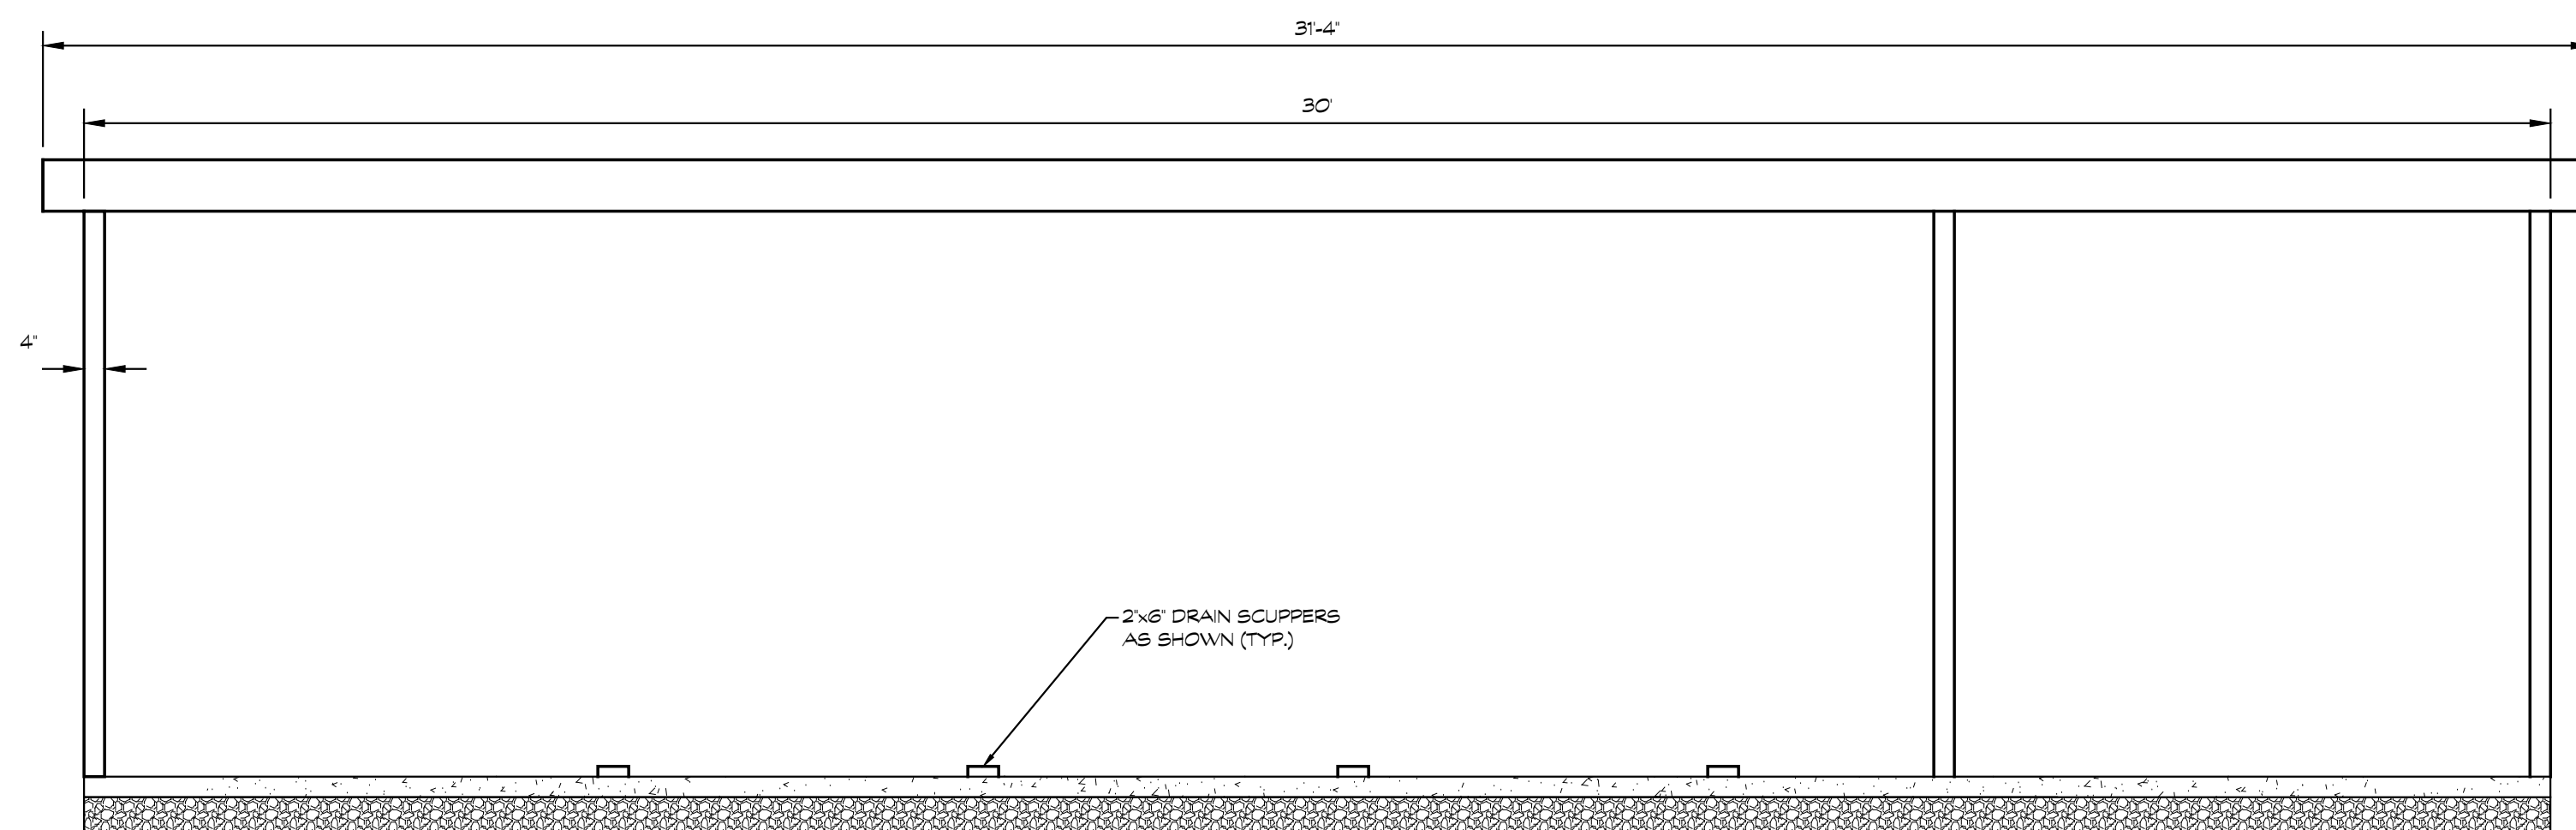


5 VISITOR DUGOUT REAR ELEVATION
SCALE 3/8"=1'-0"

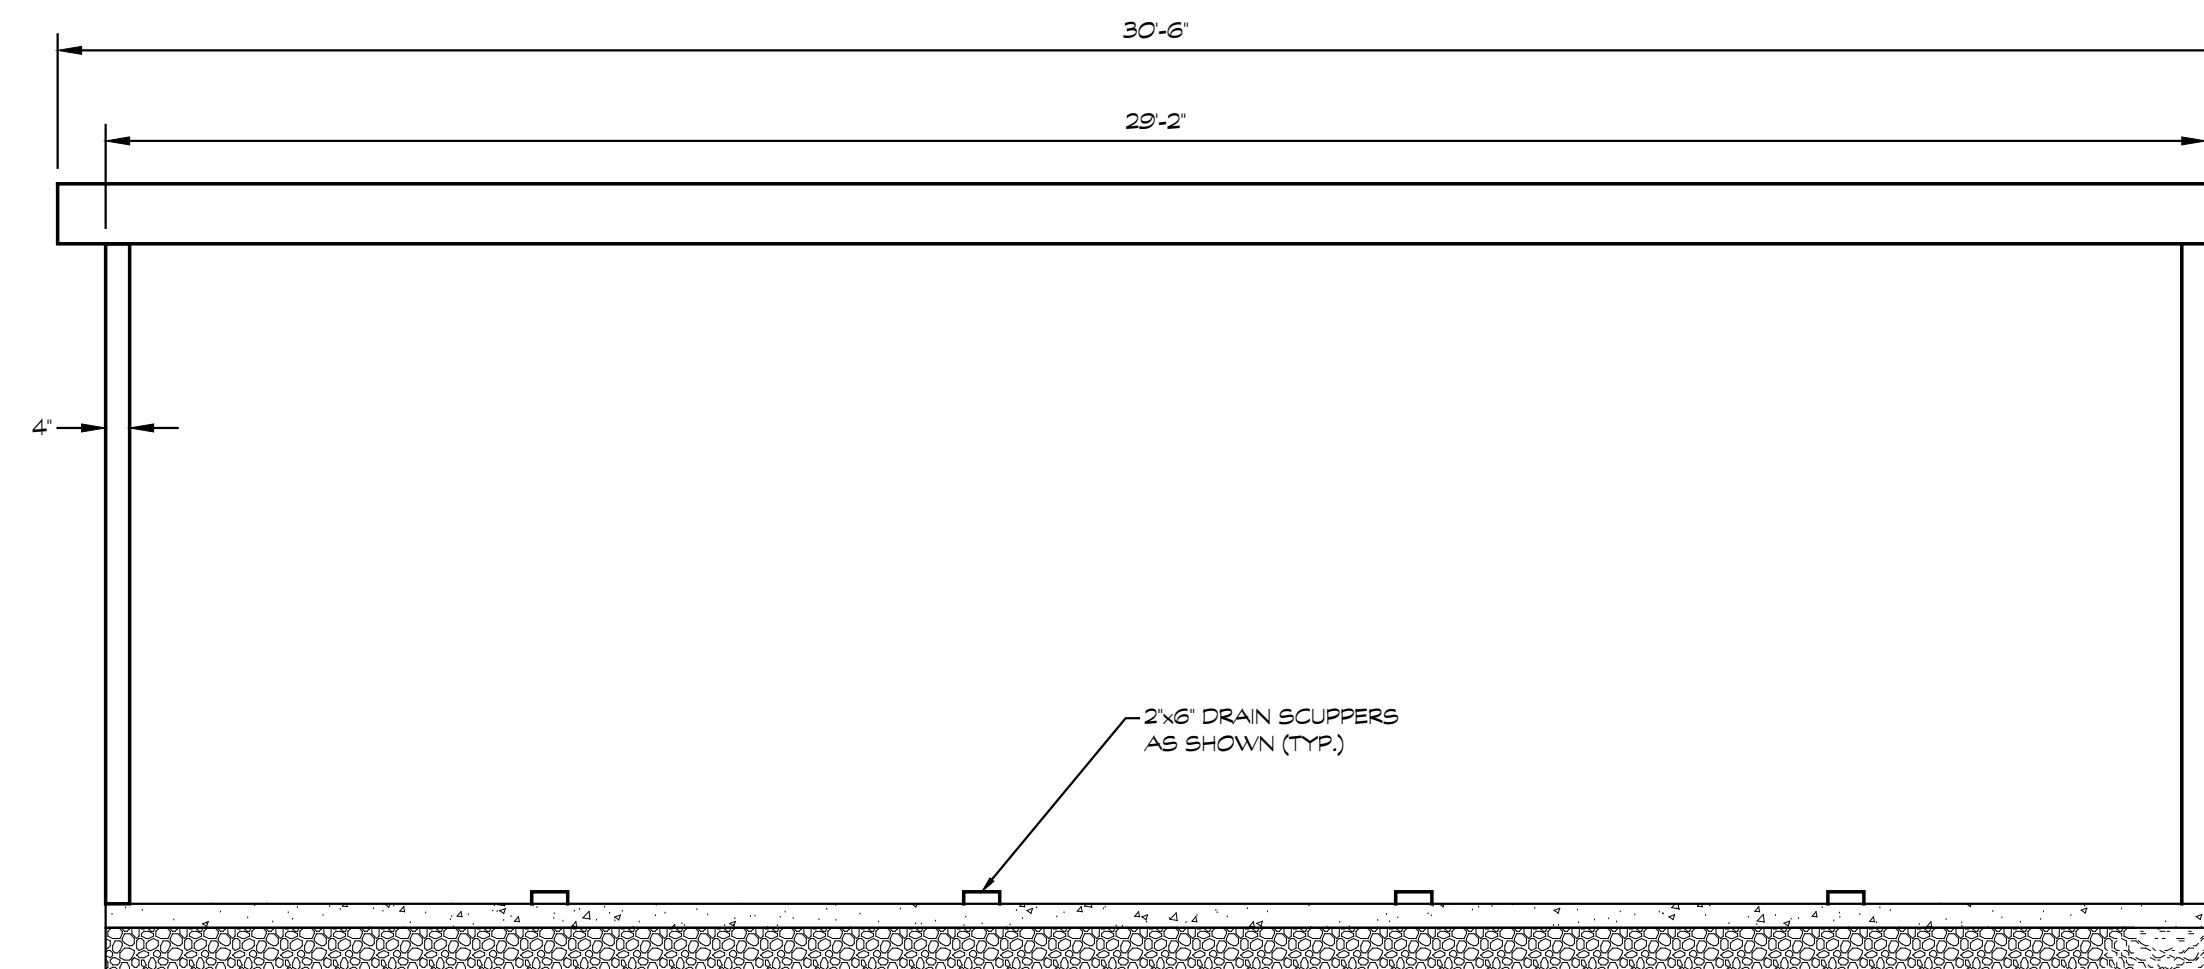

6 HOME DUGOUT REAR ELEVATION
SCALE 3/8"=1'-0"

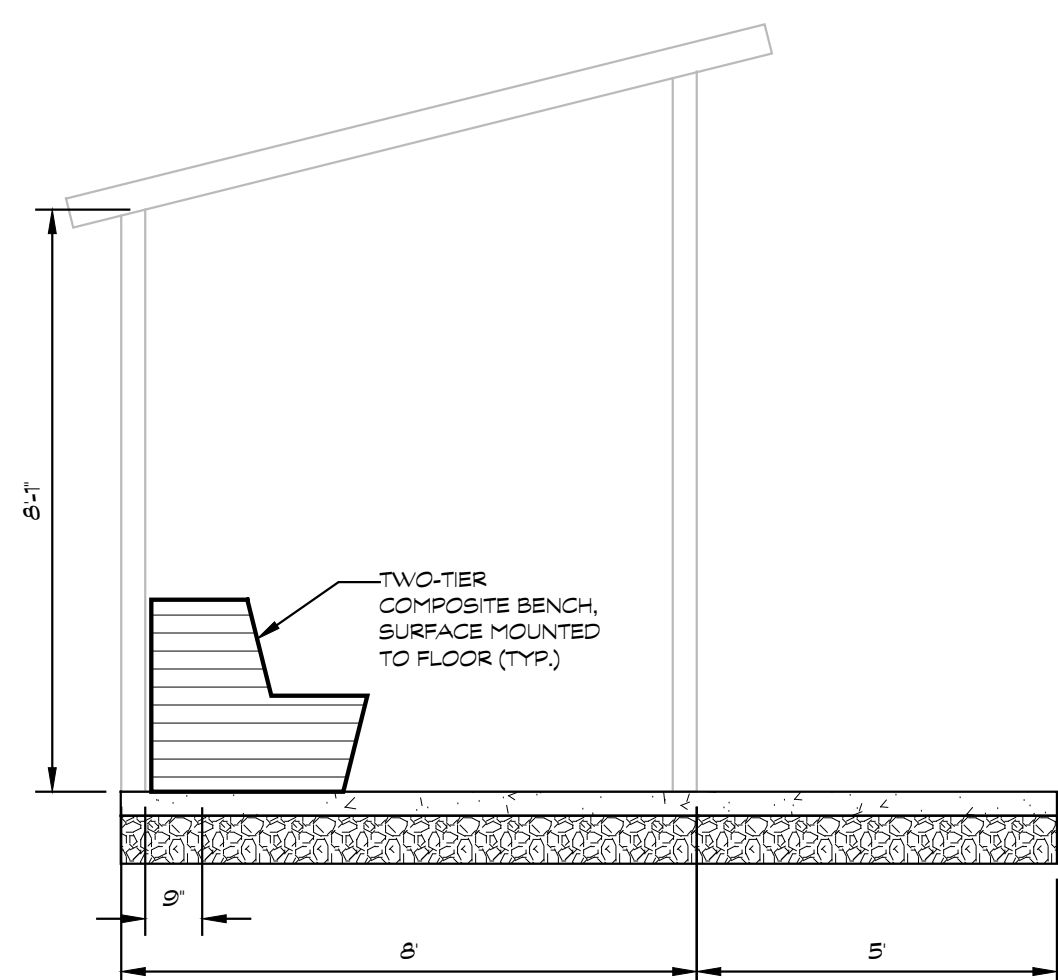

7 HOME & VISITOR SIDE ELEVATION
SCALE 3/8"=1'-0"

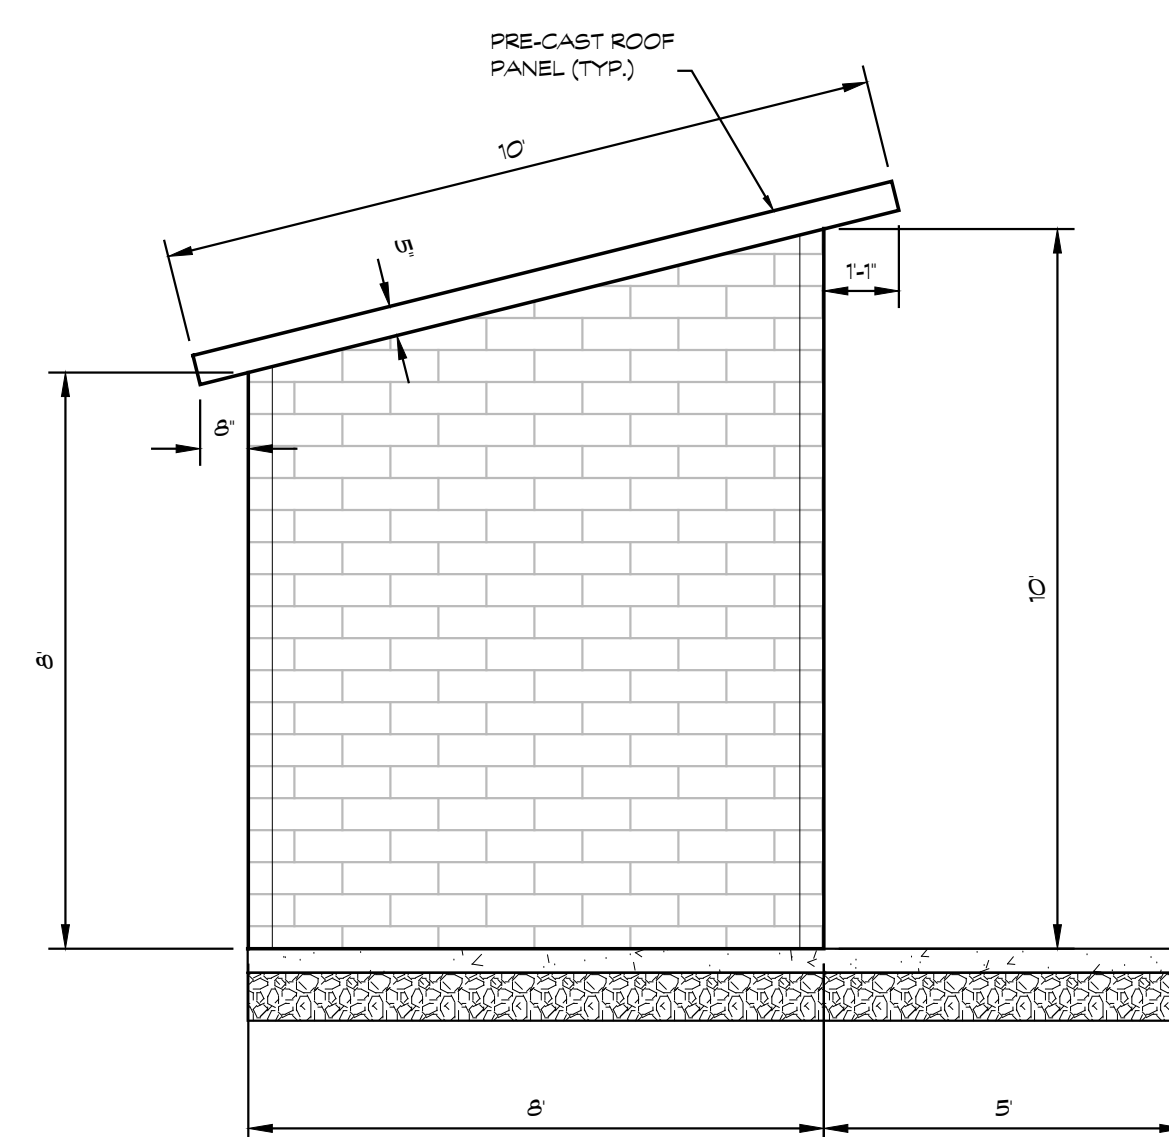

8 HOME & VISITOR SIDE ELEVATION
SCALE 3/8"=1'-0"

- NOTES:**
- DUGOUT MANUFACTURER IS RESPONSIBLE TO PROVIDE SIGNED AND SEALED ENGINEERED DRAWINGS.
 - BUILDING FINISHES:
 - a) EXTERIOR FINISH:
 - 8' X 16' SPLIT FACE BRICK FORM
 - b) FINISH COLORS:
 - EXTERIOR WALL, ACCENT, AND DOOR COLOR: FACTORY PAINTED BY BUILDING MANUFACTURER, COLOR TO BE SELECTED BY OWNER



TMP ARCHITECTURE INC
1091 WEST SQUARE LAKE ROAD
BLOOMFIELD HILLS - MICHIGAN - 48302
PH - 248.338.4561 FX - 248.338.0223
EM - INFO@TMPARCHITECTURE.COM

REGISTRATION SEAL

CONSULTANT



PROJECT TITLE
**Athens High School
Athletic Fields
Bid Package No. 02B**

Troy School District
Troy, Michigan

DRAWING TITLE
**Varsity Dugouts
Details**

ISSUE DATES

01-14-2025	ADDENDUM NO.1
12-10-2024	CONSTRUCTION DOCUMENTS

DATE:	ISSUED FOR:
DRAWN	JB
CHECKED	HD
APPROVED	MDS


PROJECT NO.
22103D
DRAWING NO.
LD1.11



TMP ARCHITECTURE INC
1191 WEST SQUARE LAKE ROAD
BLOOMFIELD HILLS - MICHIGAN - 48302
PH - 248.338.4561 FX - 248.338.0233
EM - INFO@TMPARCHITECTURE.COM

REGISTRATION SEAL

CONSULTANT

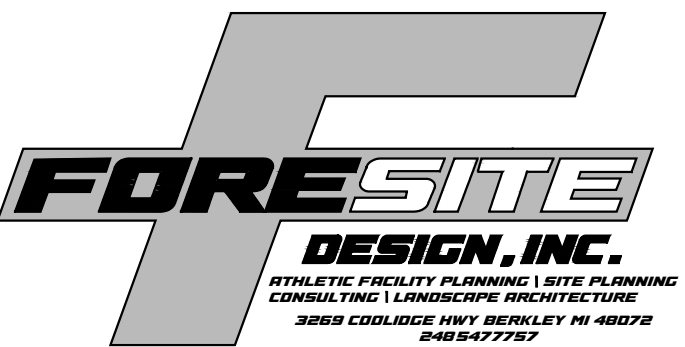

PROJECT TITLE
**Athens High School
Athletic Fields
Bid Package No. 02B**

Troy School District
Troy, Michigan

DRAWING TITLE
**Scoreboard &
Flag Pole Details**


ISSUE DATES

DATE:	ISSUED FOR:
DRAWN	J.B
CHECKED	HD
APPROVED	MDS


PROJECT NO.

22103D


DRAWING NO.
LD1.12

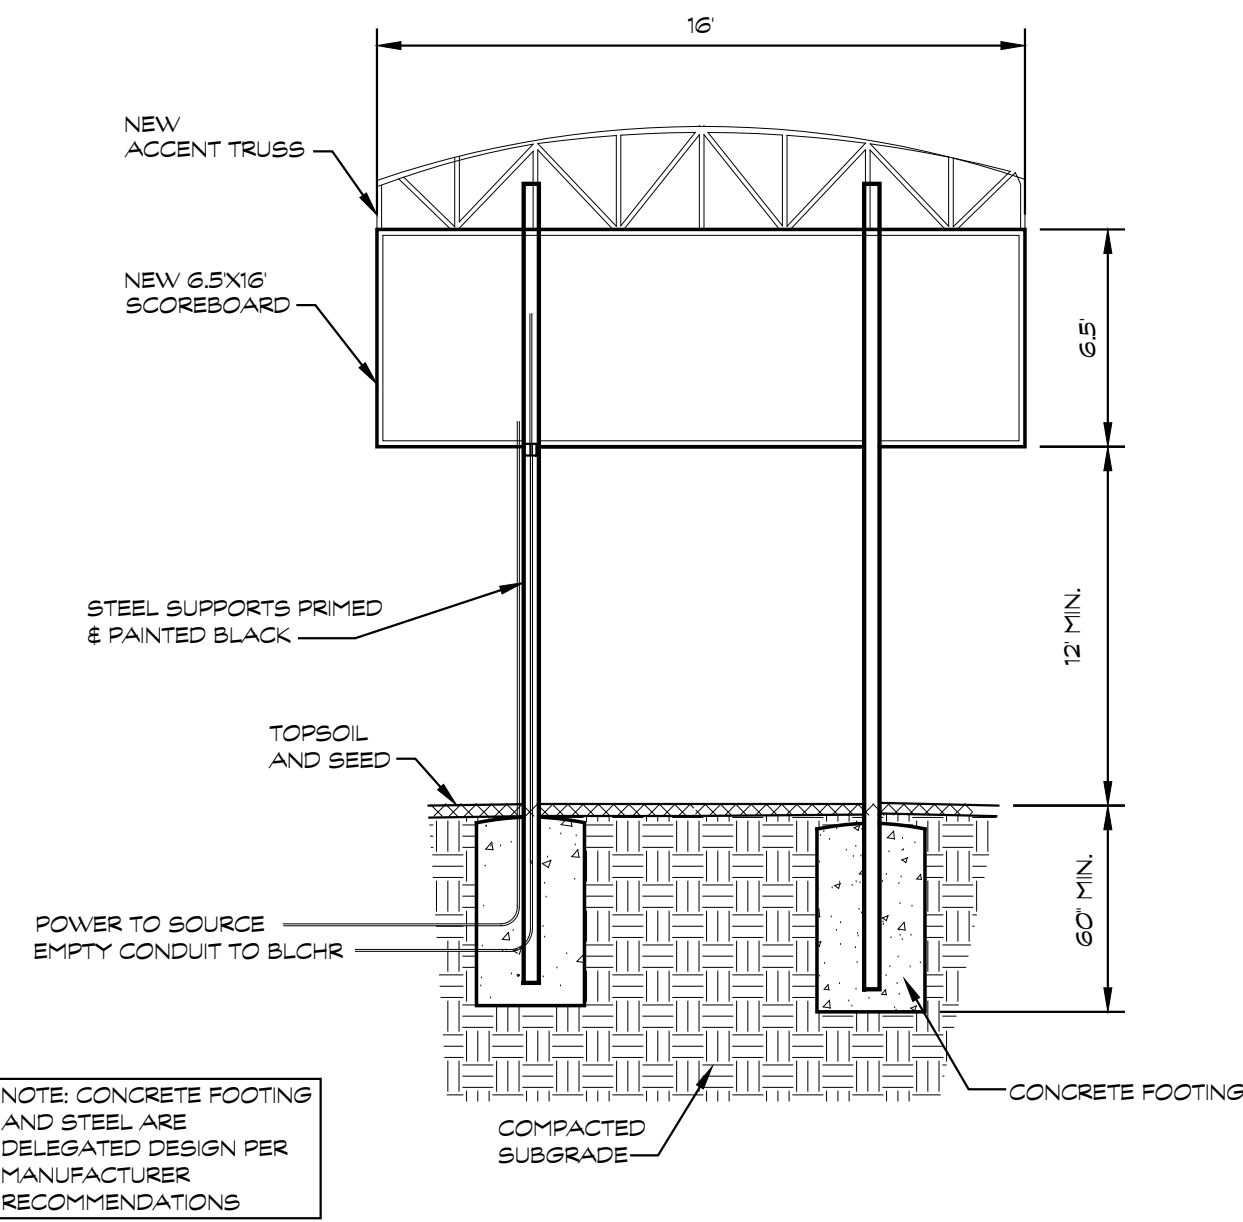


1 SCOREBOARD ELEVATION DETAIL
Varsity Baseball and Softball
SCALE 3/8"=1'-0"

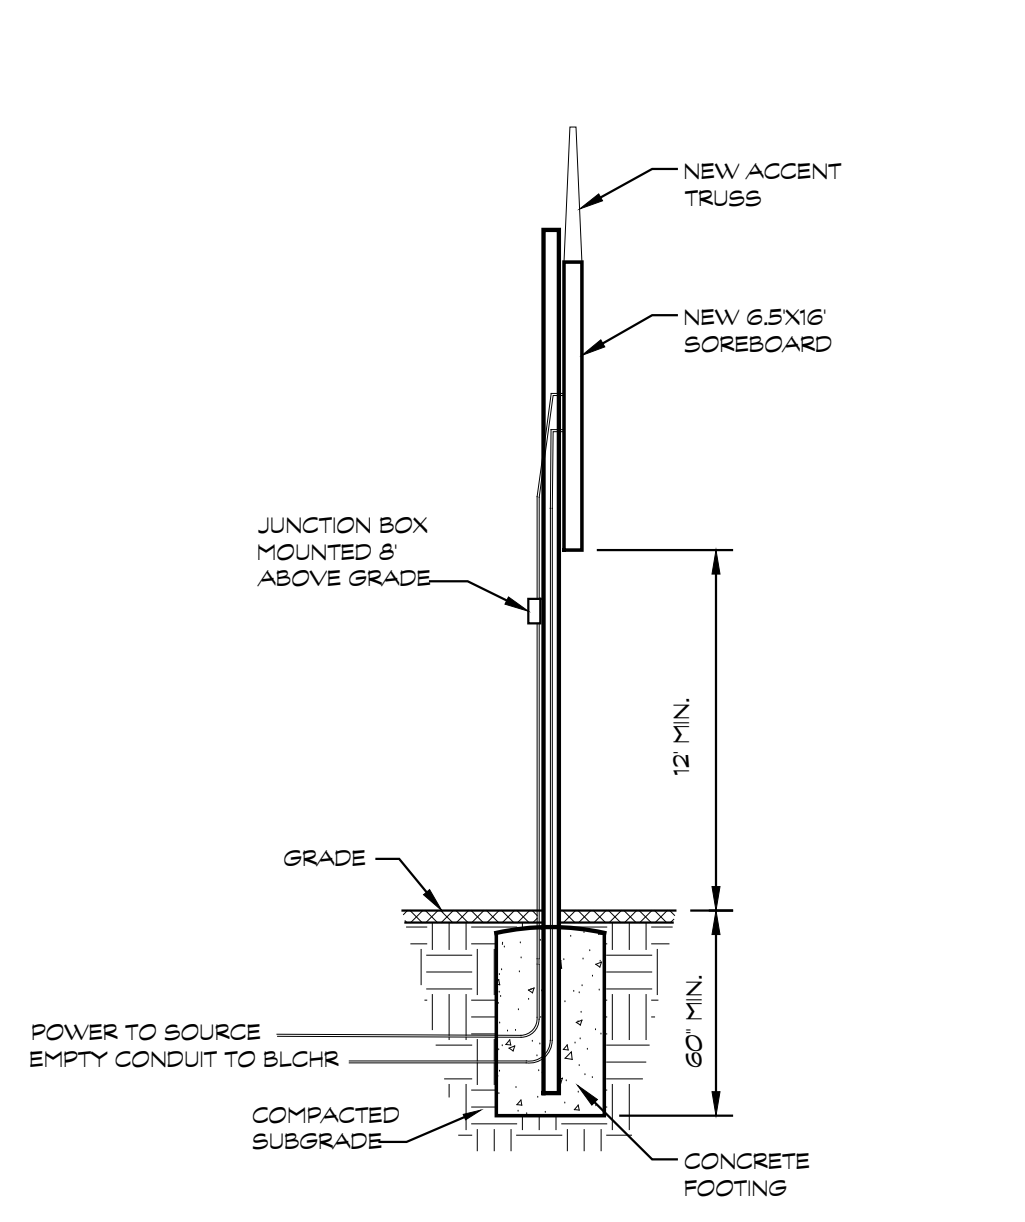


2 SCOREBOARD SECTION DETAIL
Varsity Baseball and Softball
SCALE 3/8"=1'-0"

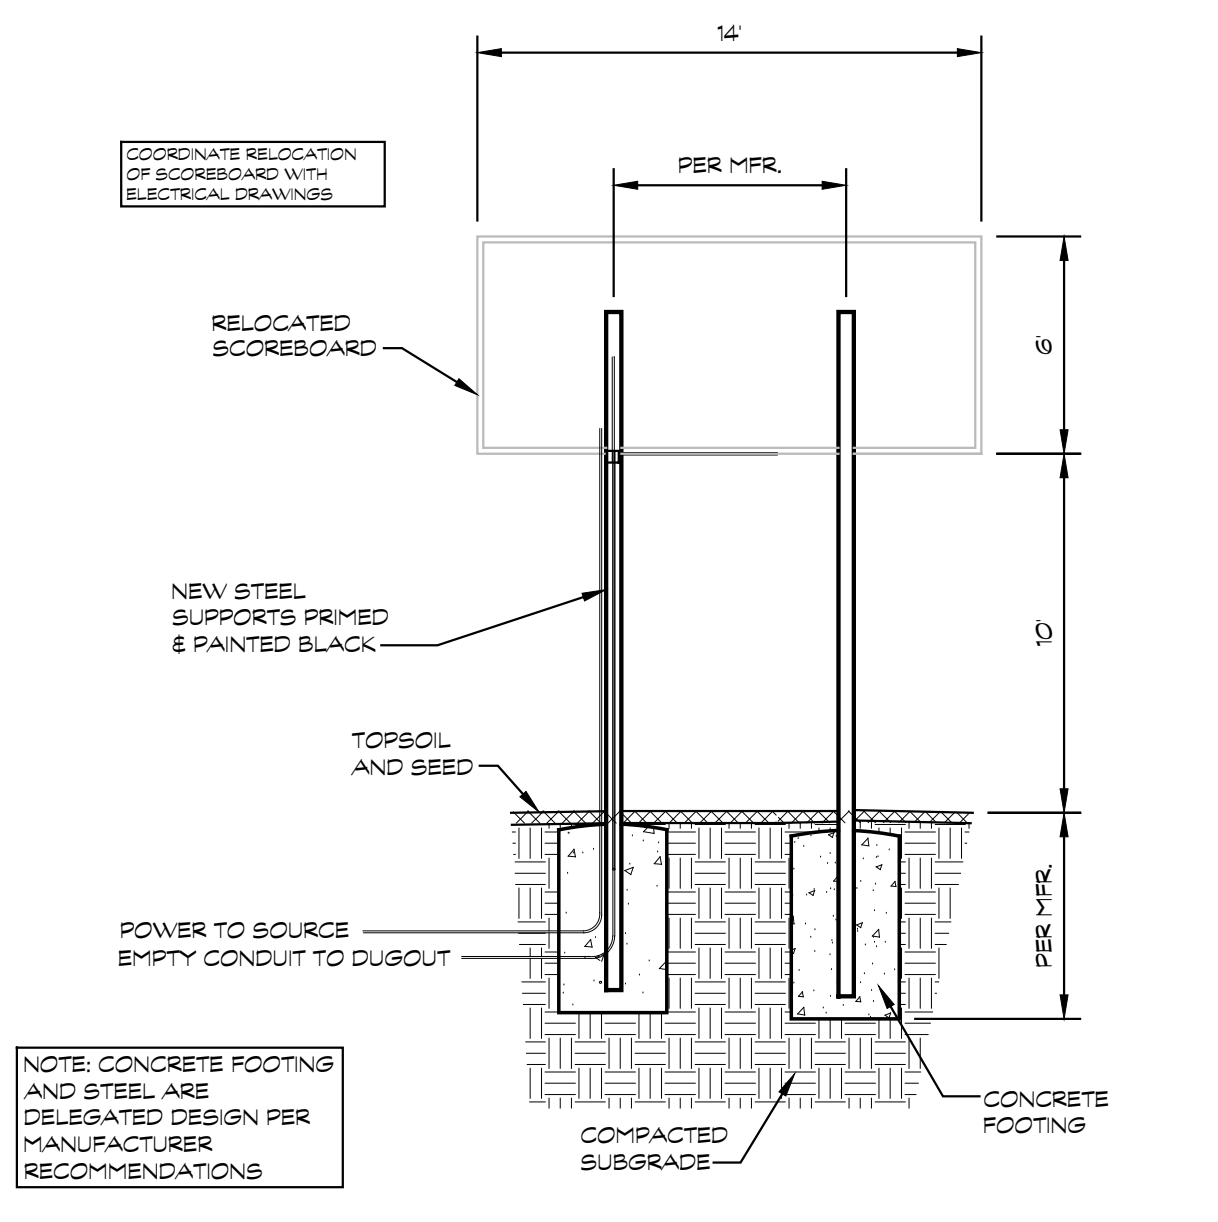


3 RELOCATED SCOREBOARD
JV Baseball and Softball
SCALE 3/8"=1'-0"

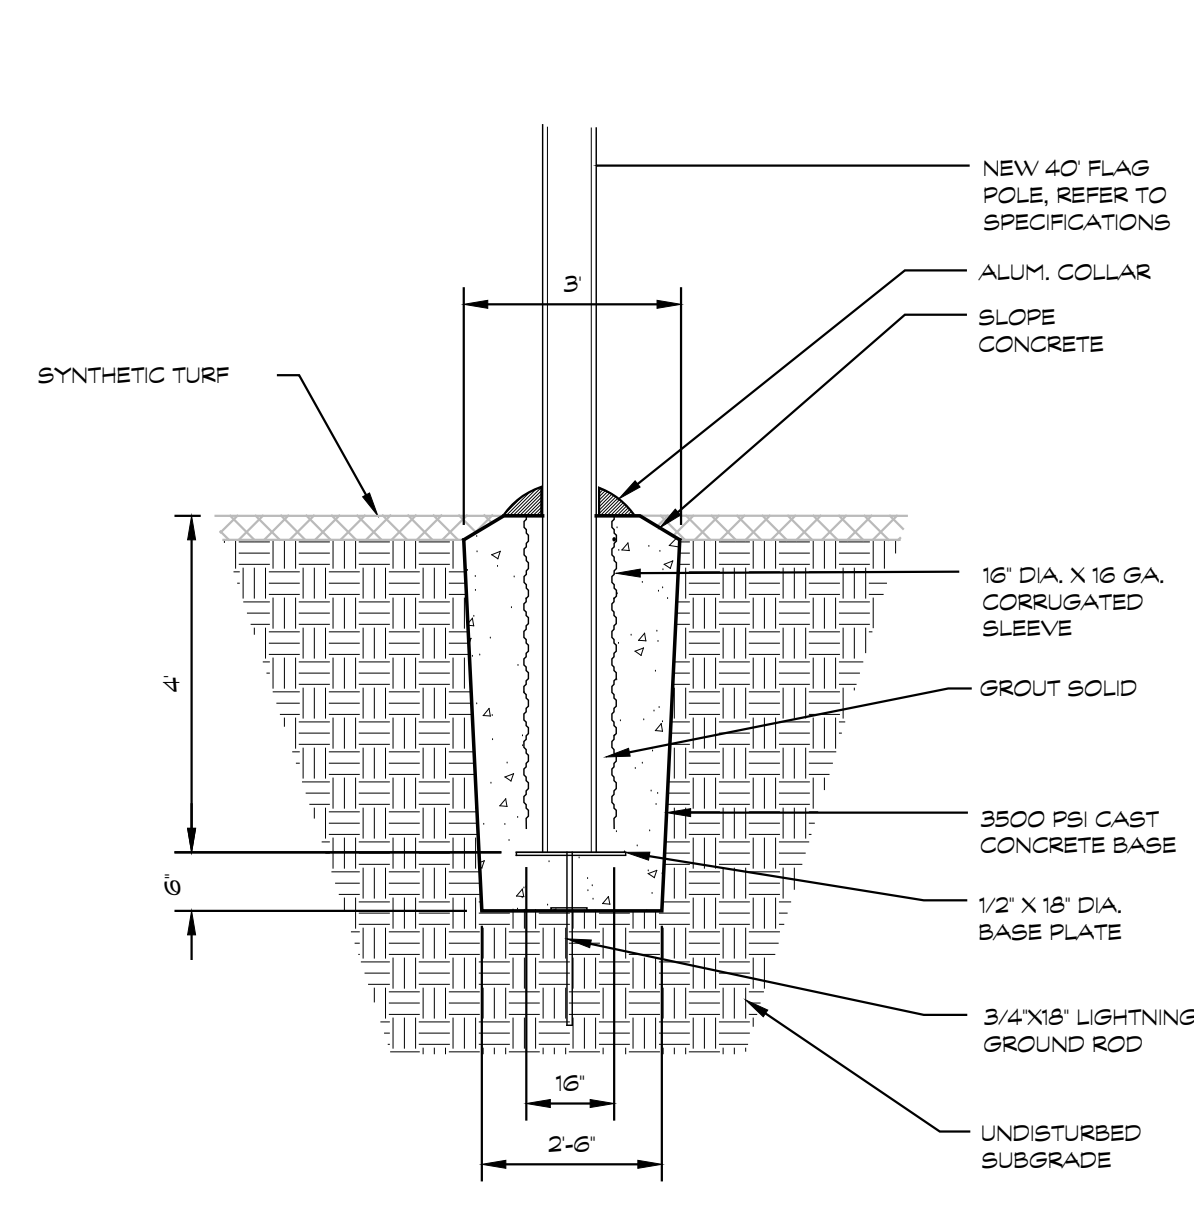

4 FLAG POLE FOUNDATION
N.T.S.

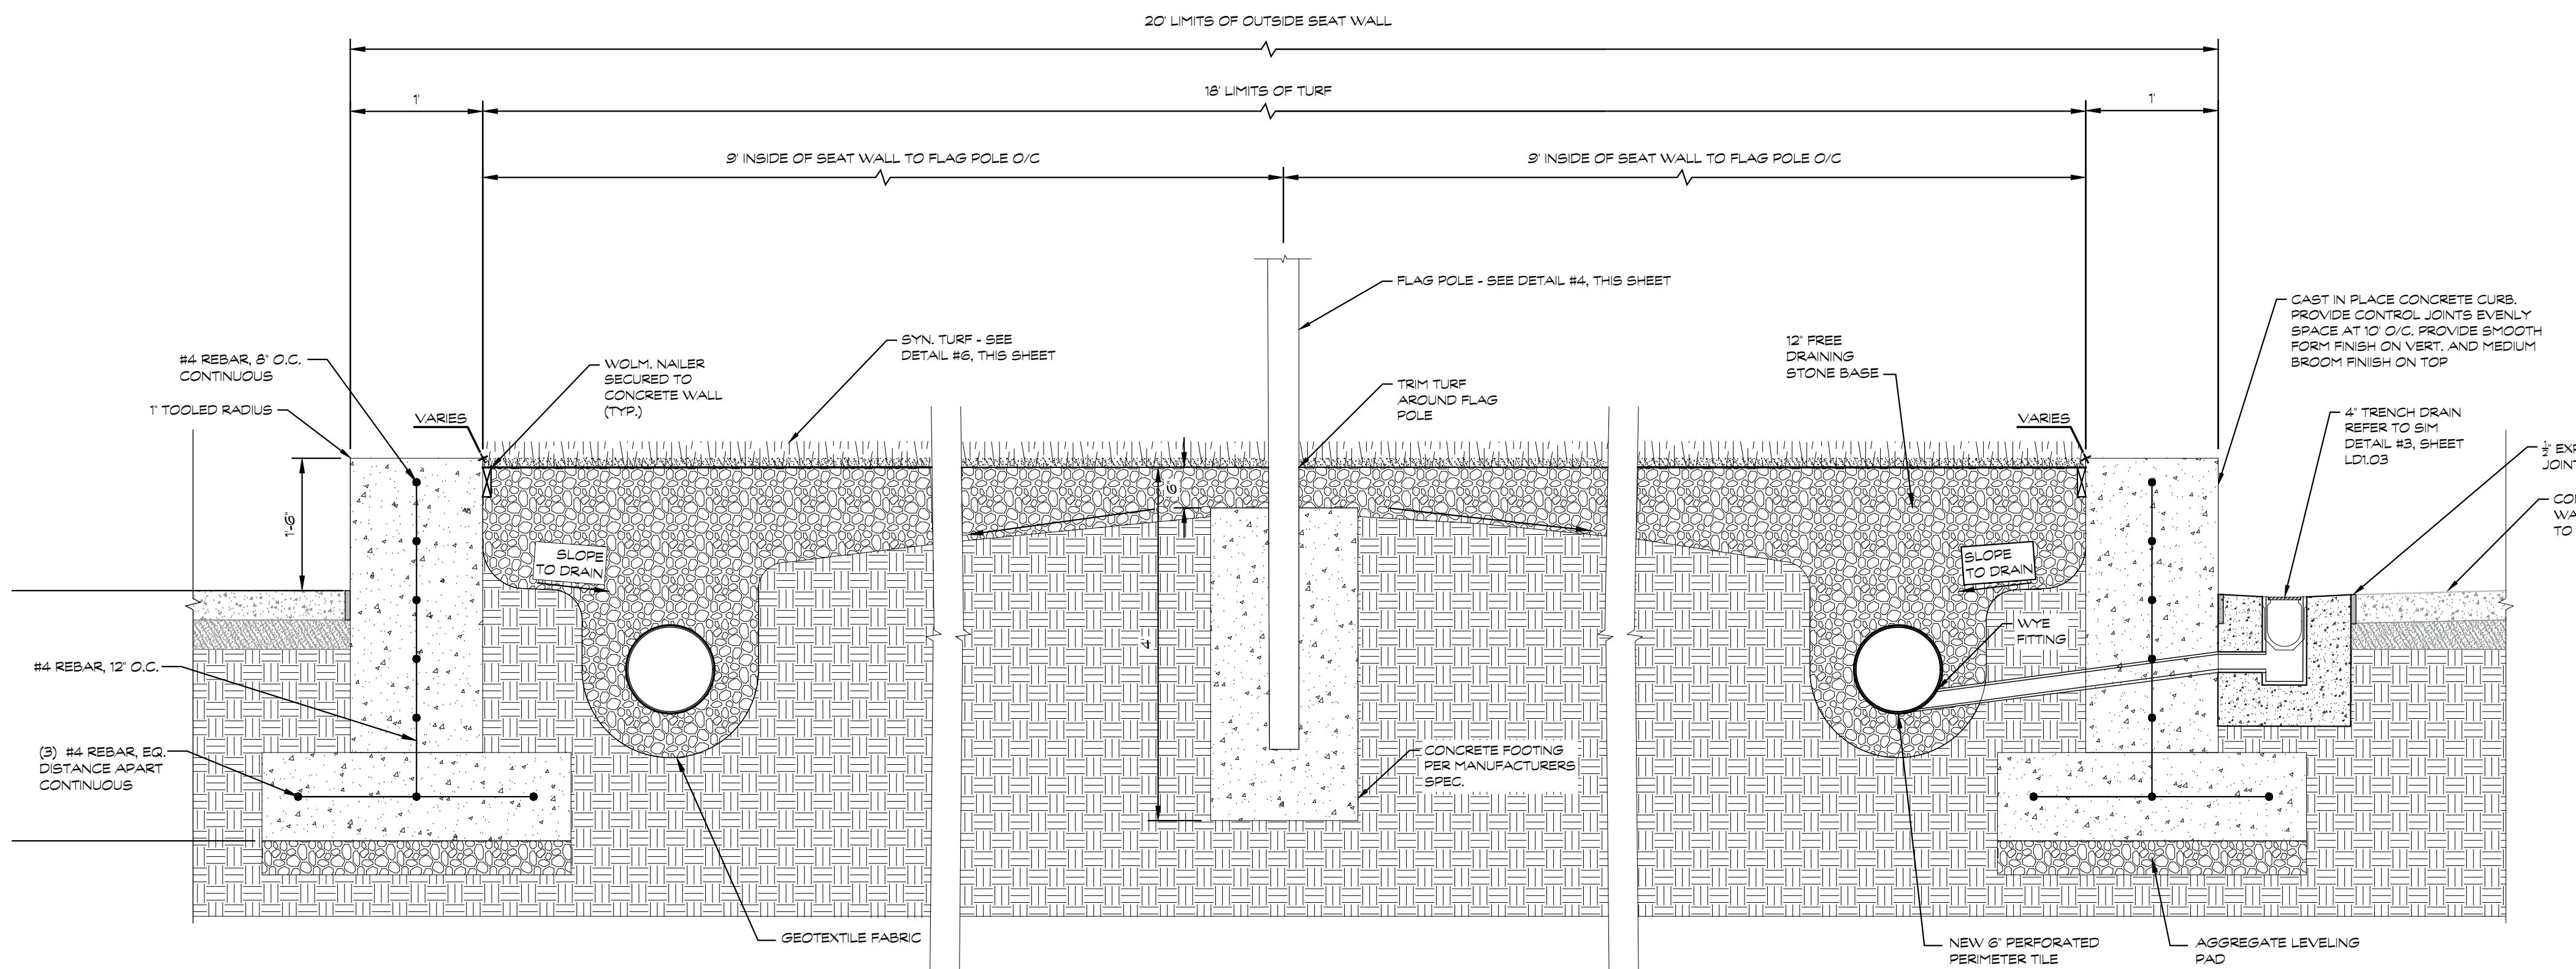


5 FLAG POLE FOCAL POINT SECTION
N.T.S.

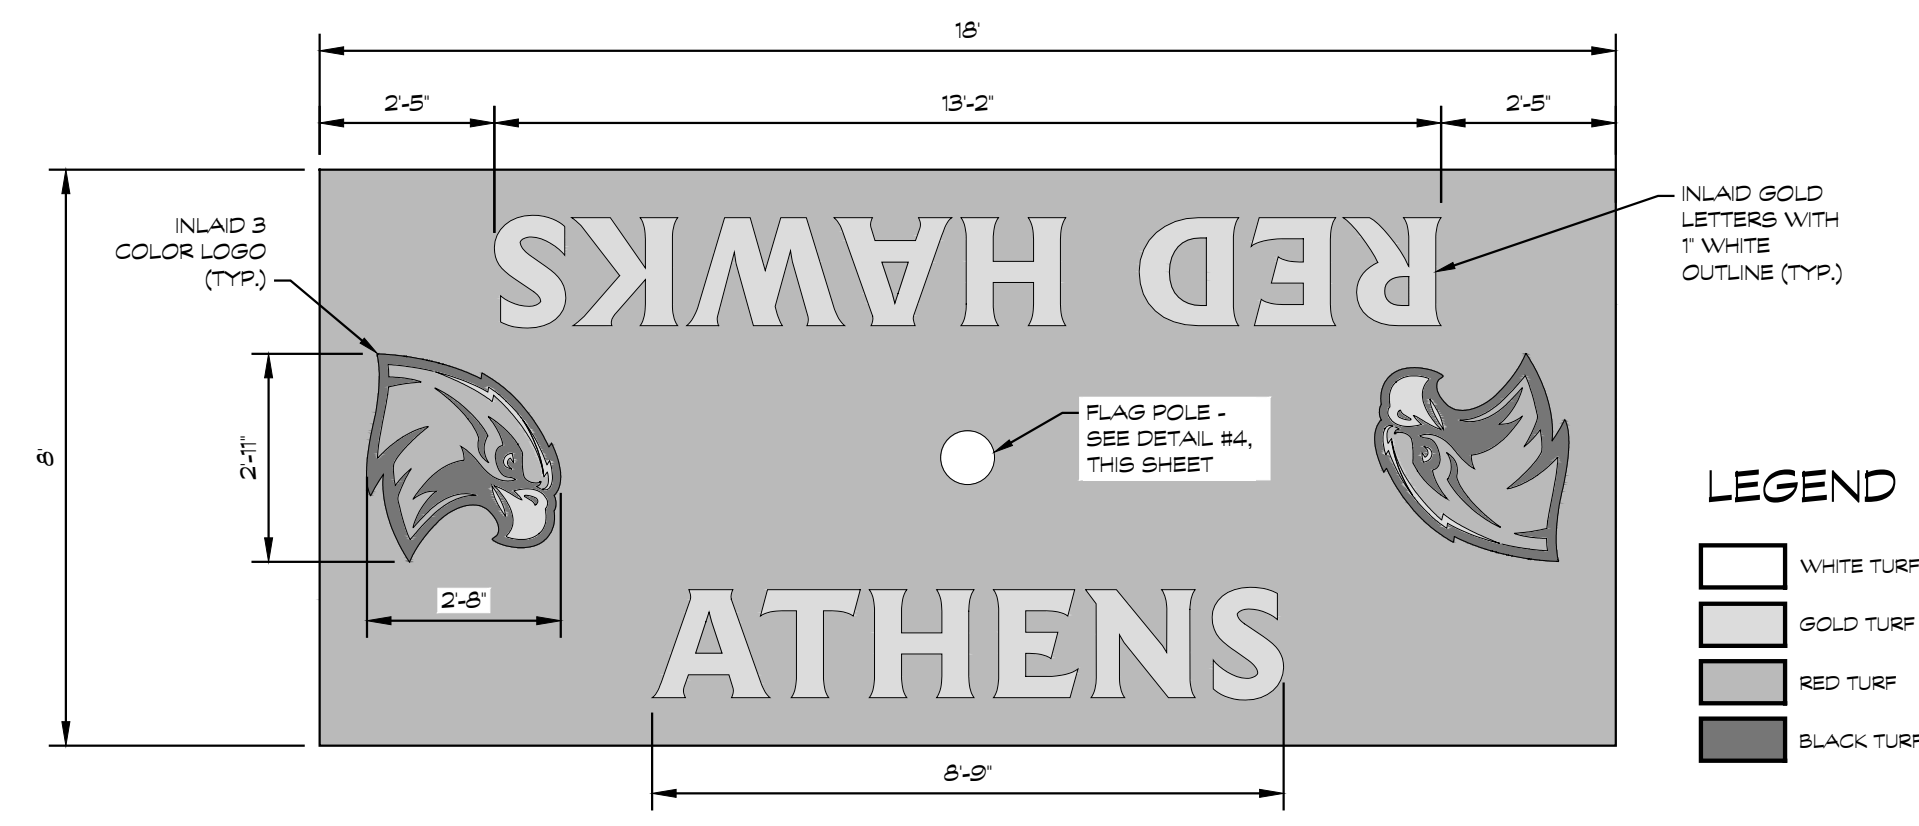


6 FLAG POLE FOCAL POINT TURF DETAIL
SCALE 3/8"=1'-0"


LEGEND	
WHITE TURF	
GOLD TURF	
RED TURF	
BLACK TURF	

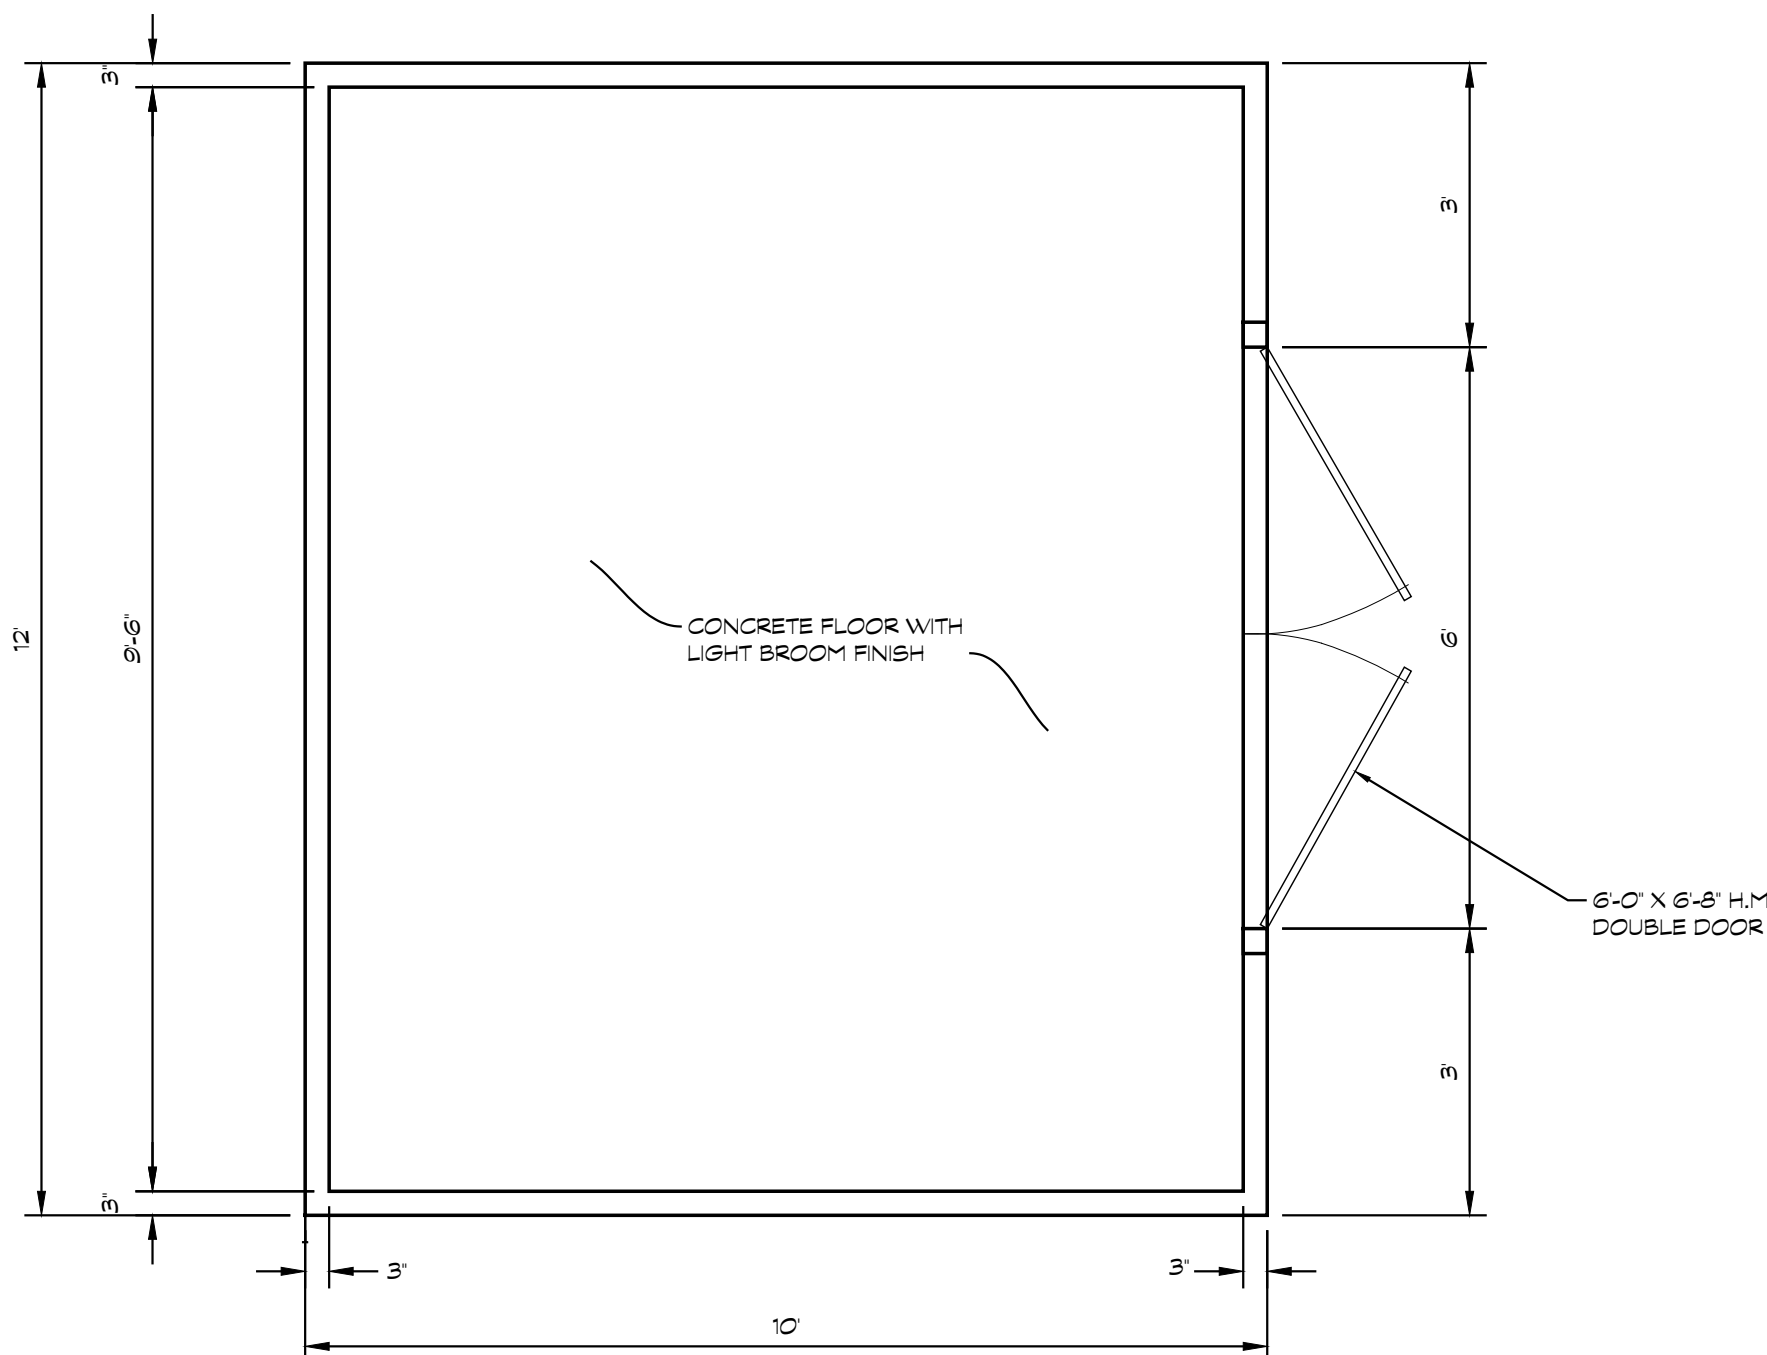

1 BUILDING FLOOR PLAN
SCALE 1/2"=1'-0"

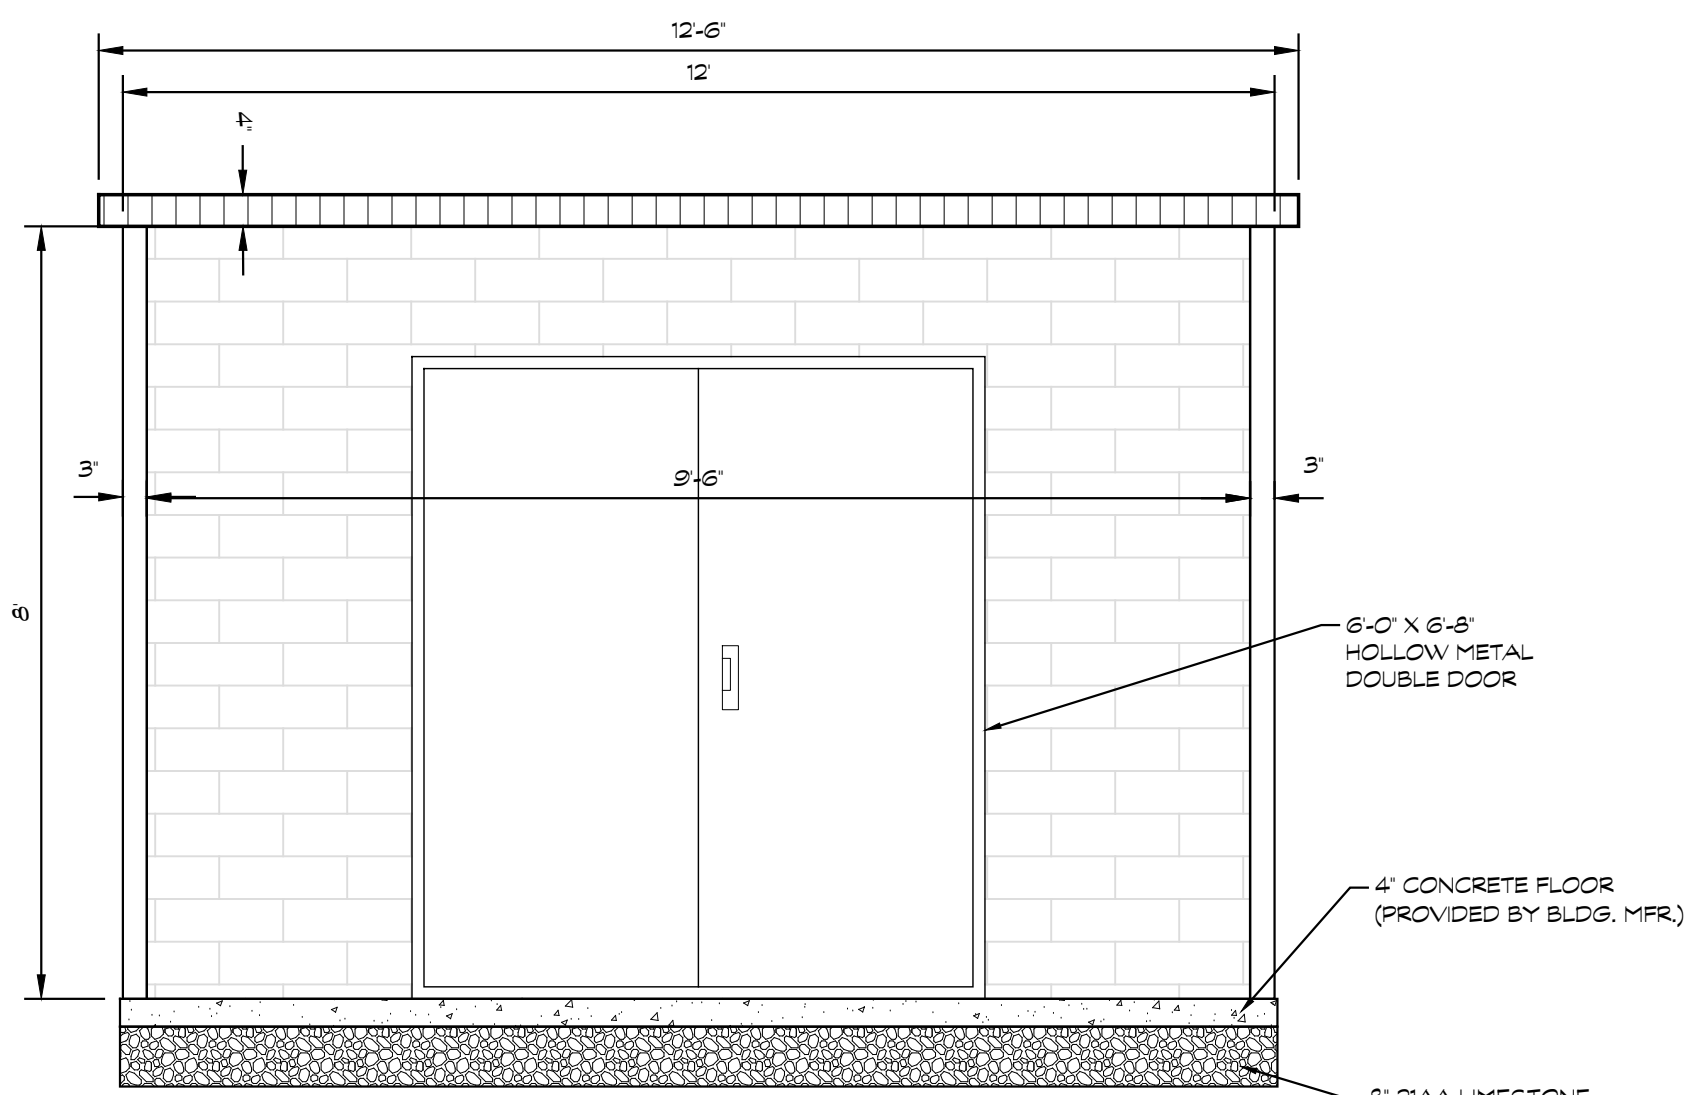

2 FRONT BUILDING SECTION
12' X 10' BUILDING
SCALE 1/2"=1'-0"

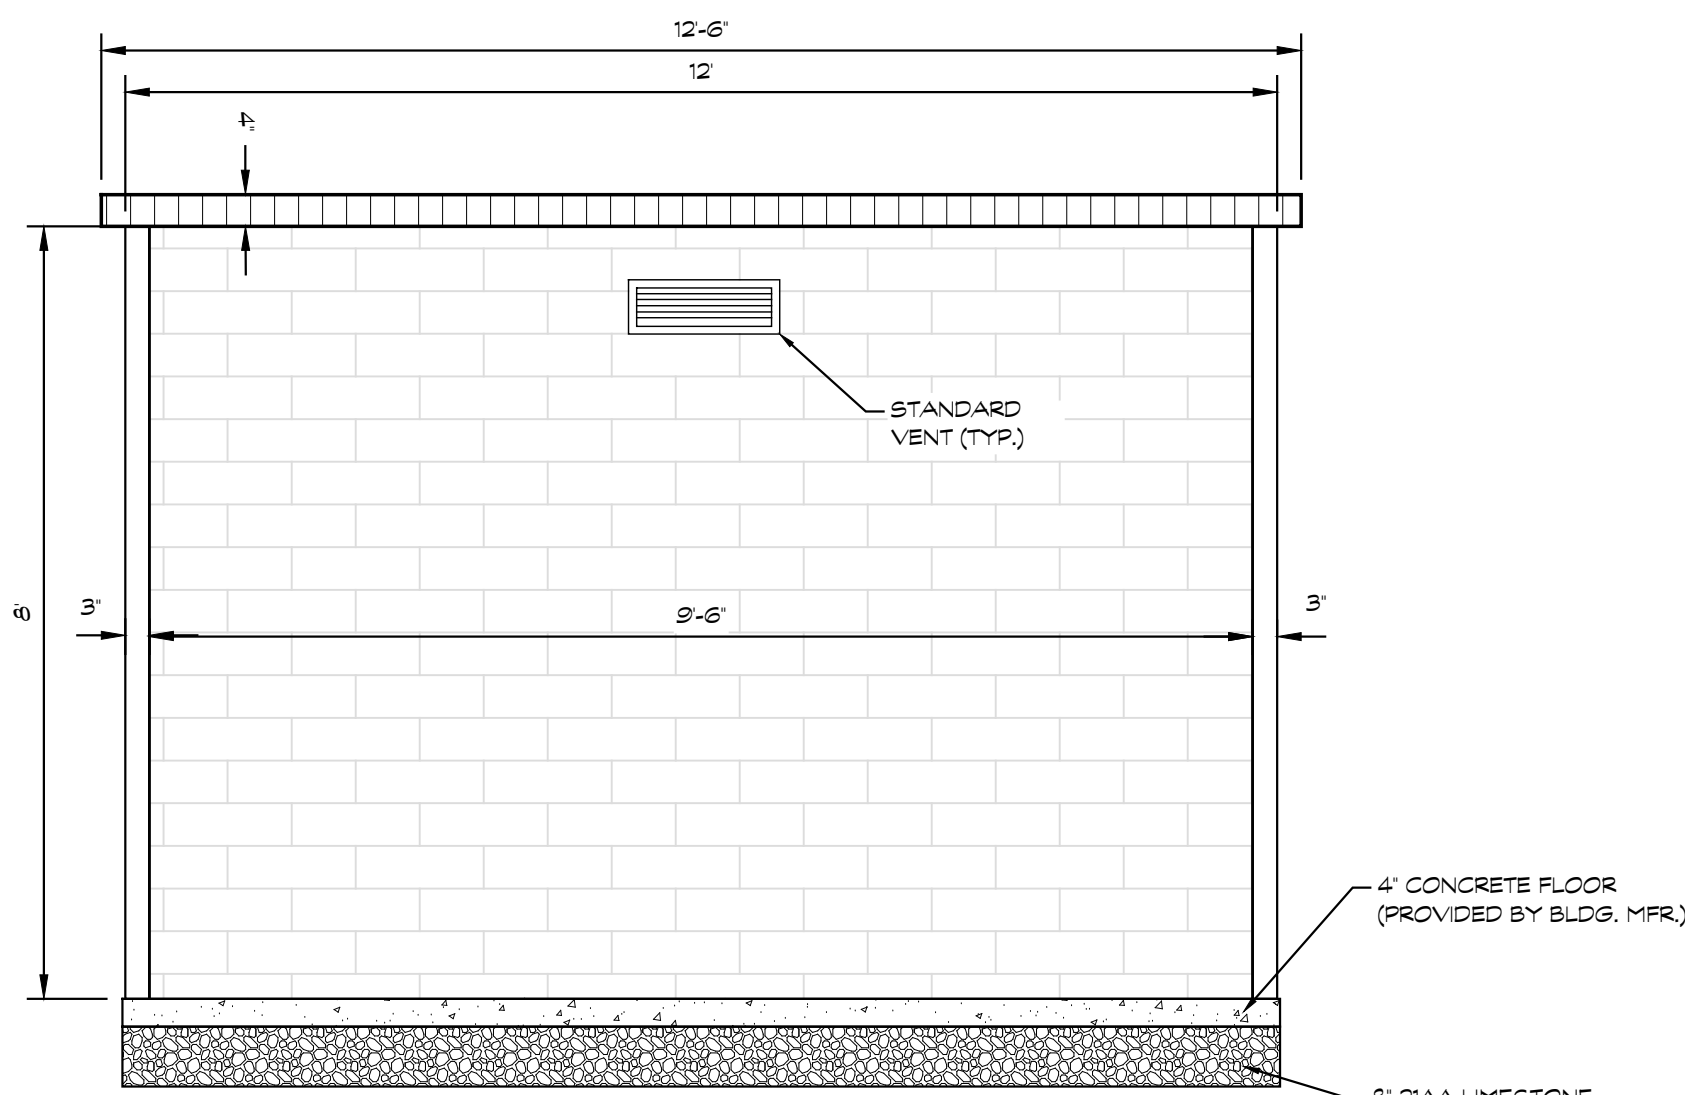


3 REAR BUILDING SECTION
12' X 10' BUILDING
SCALE 1/2"=1'-0"



TMP ARCHITECTURE INC
1191 WEST SQUARE LAKE ROAD
BLOOMFIELD HILLS • MICHIGAN • 48302
PH • 248.338.4561 FX • 248.338.0223
EM • INFO@TMP-ARCHITECTURE.COM

REGISTRATION SEAL

CONSULTANT

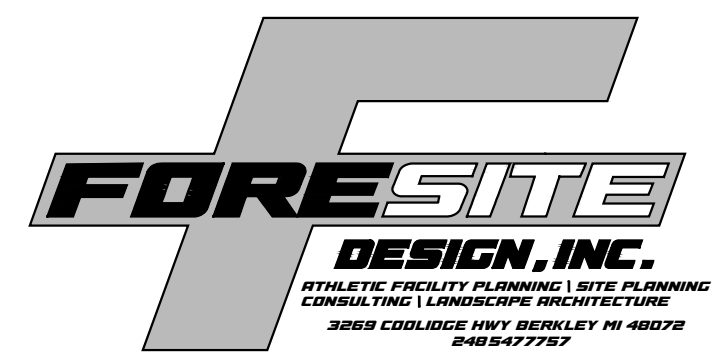

PROJECT TITLE
**Athens High School
Athletic Fields
Bid Package No. 02B**

Troy School District
Troy, Michigan

DRAWING TITLE
**Storage Building
Details**

ISSUE DATES














01-14-2025	ADDENDUM NO.1
12-10-2024	CONSTRUCTION DOCUMENTS

DATE:	ISSUED FOR:
DRAWN	JB
CHECKED	HD
APPROVED	MDS

PROJECT NO.
22103D

DRAWING NO.
LD1.16

NOTE: NOT ALL DETAILS SHOWN ARE USED.
SEE SHEET AD.1 FOR DOOR SCHEDULE
ABBREVIATIONS AND NOTES, GLAZING TYPES,
DOOR TYPES, AND FRAME TYPES, TYP.

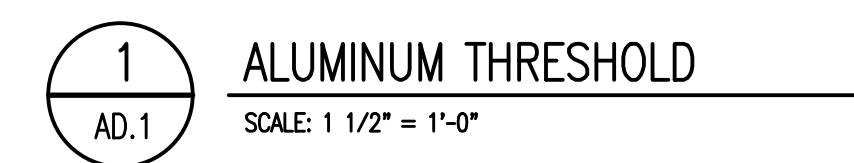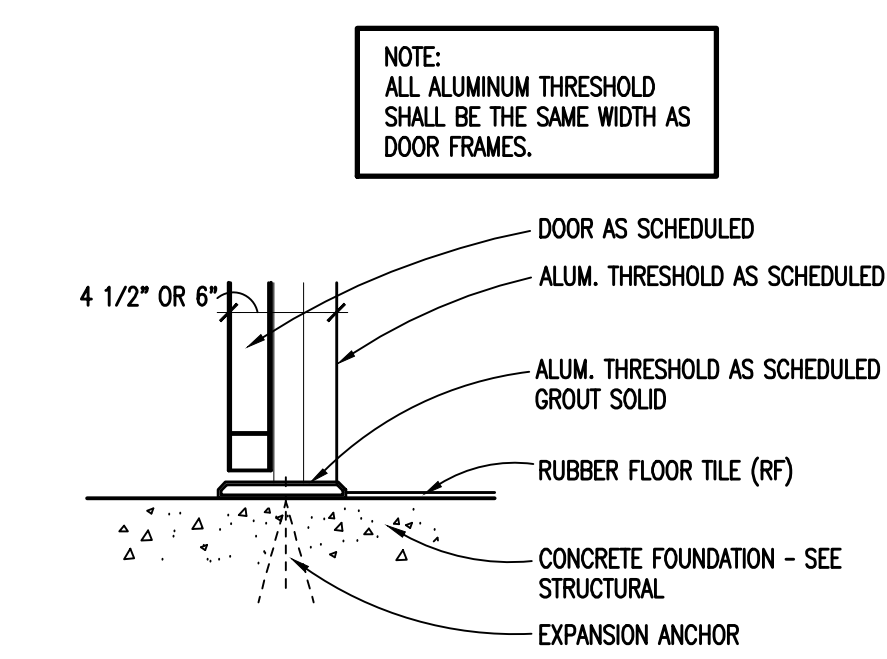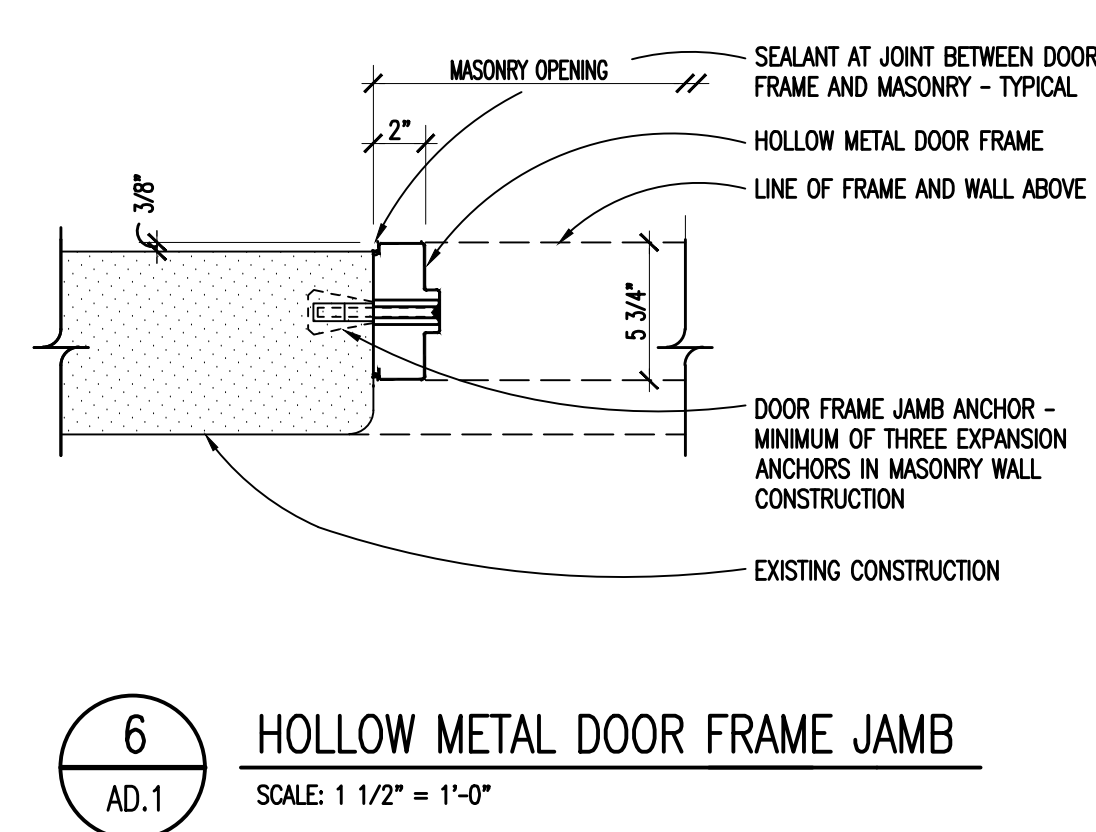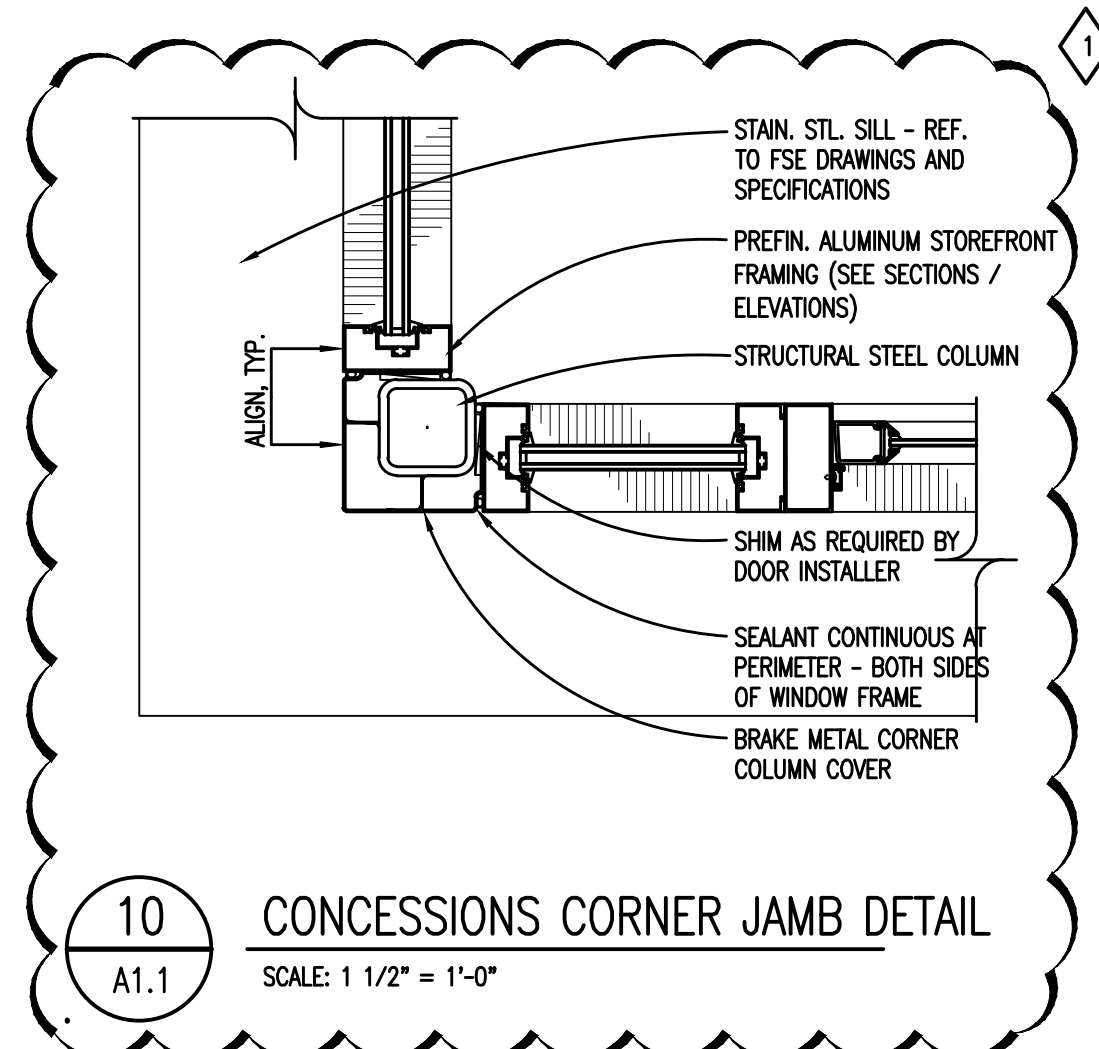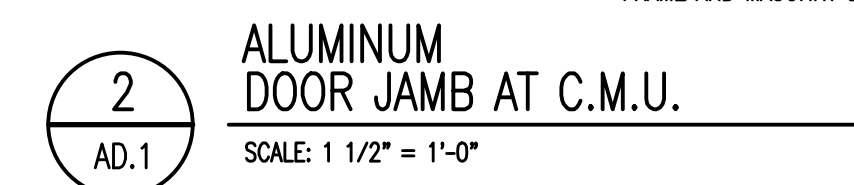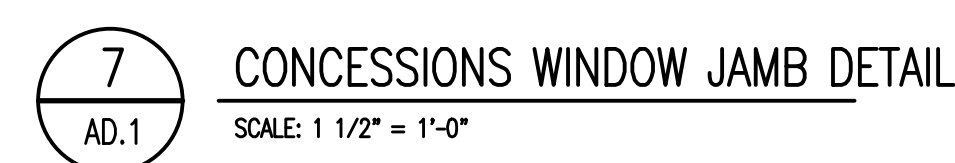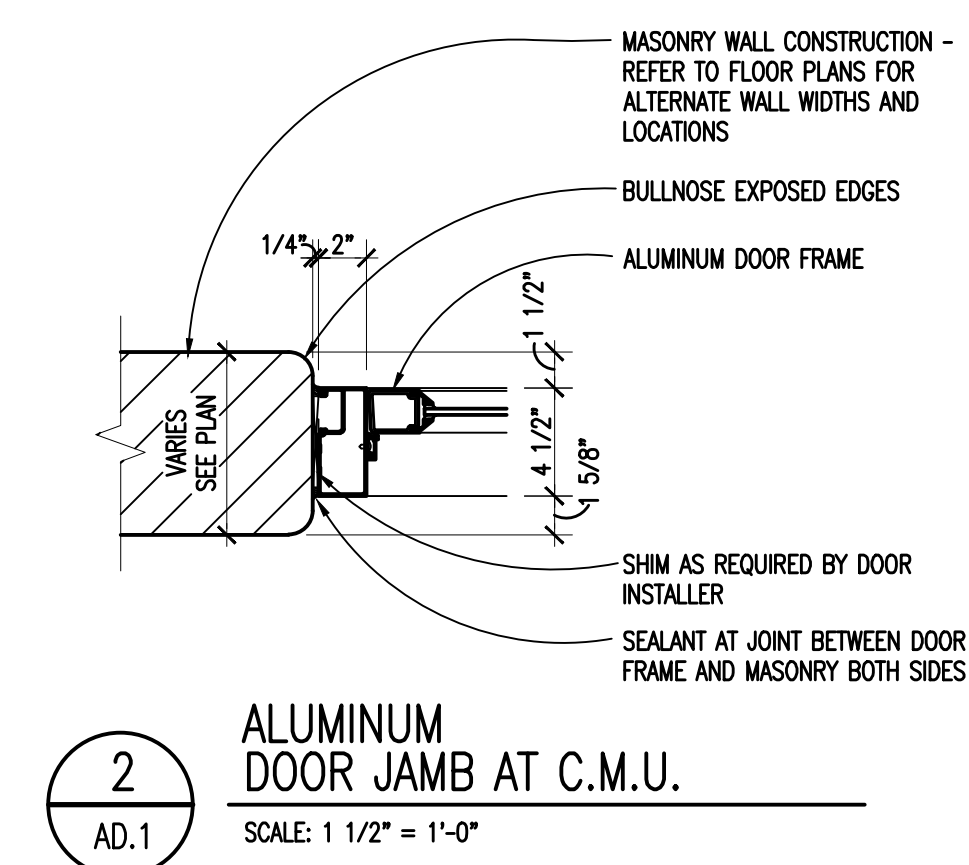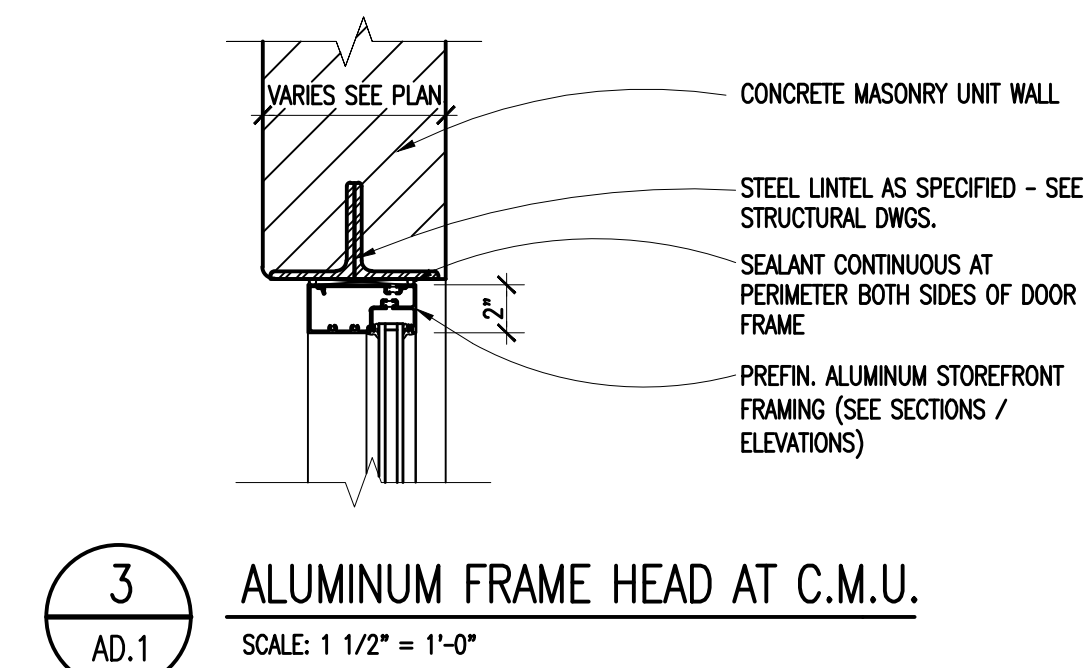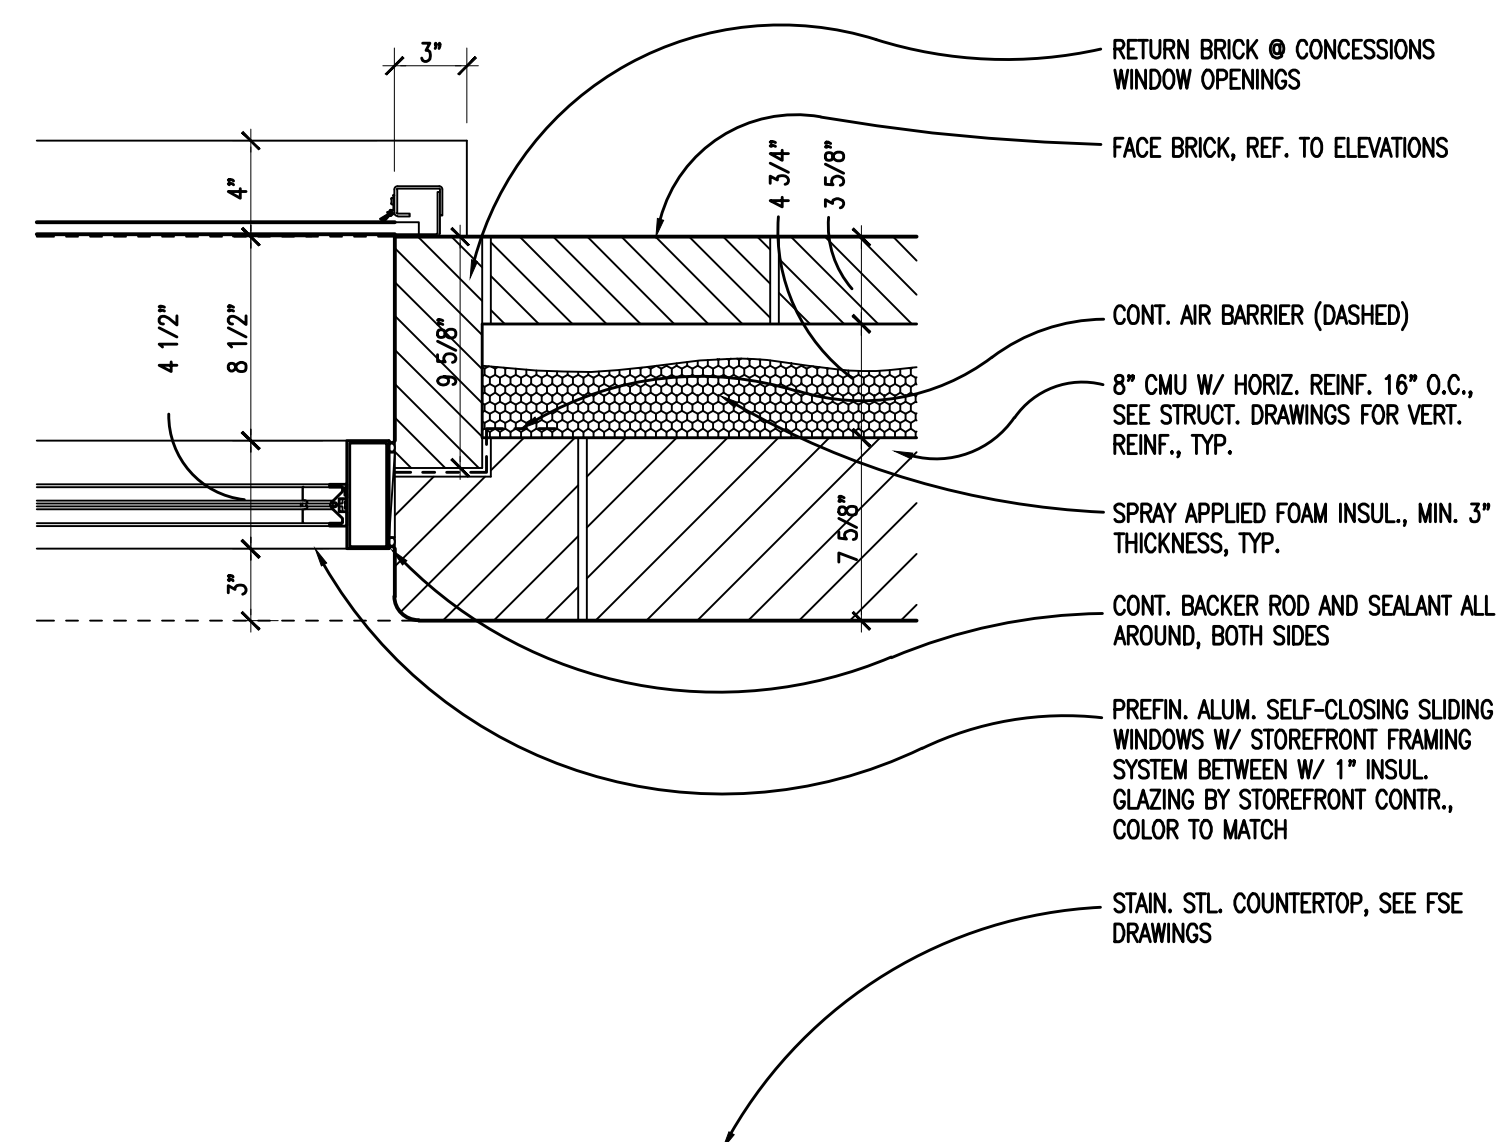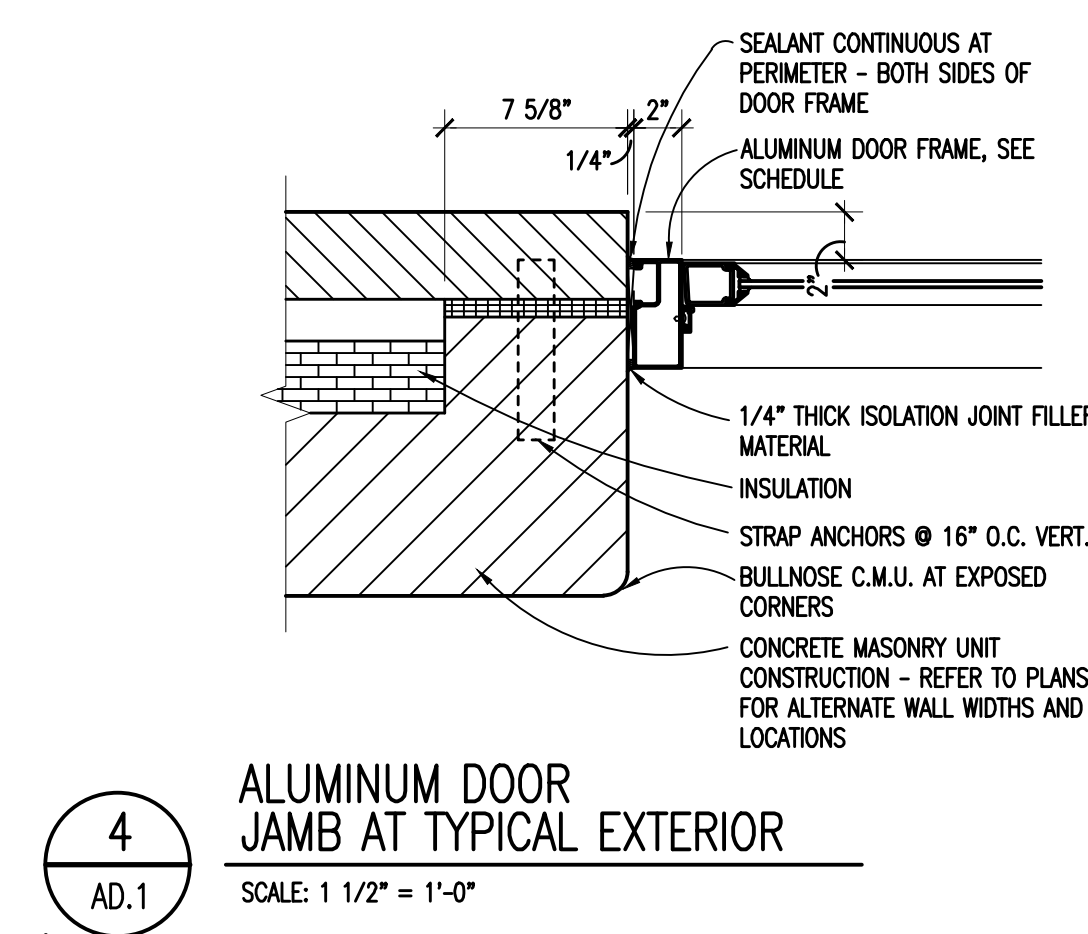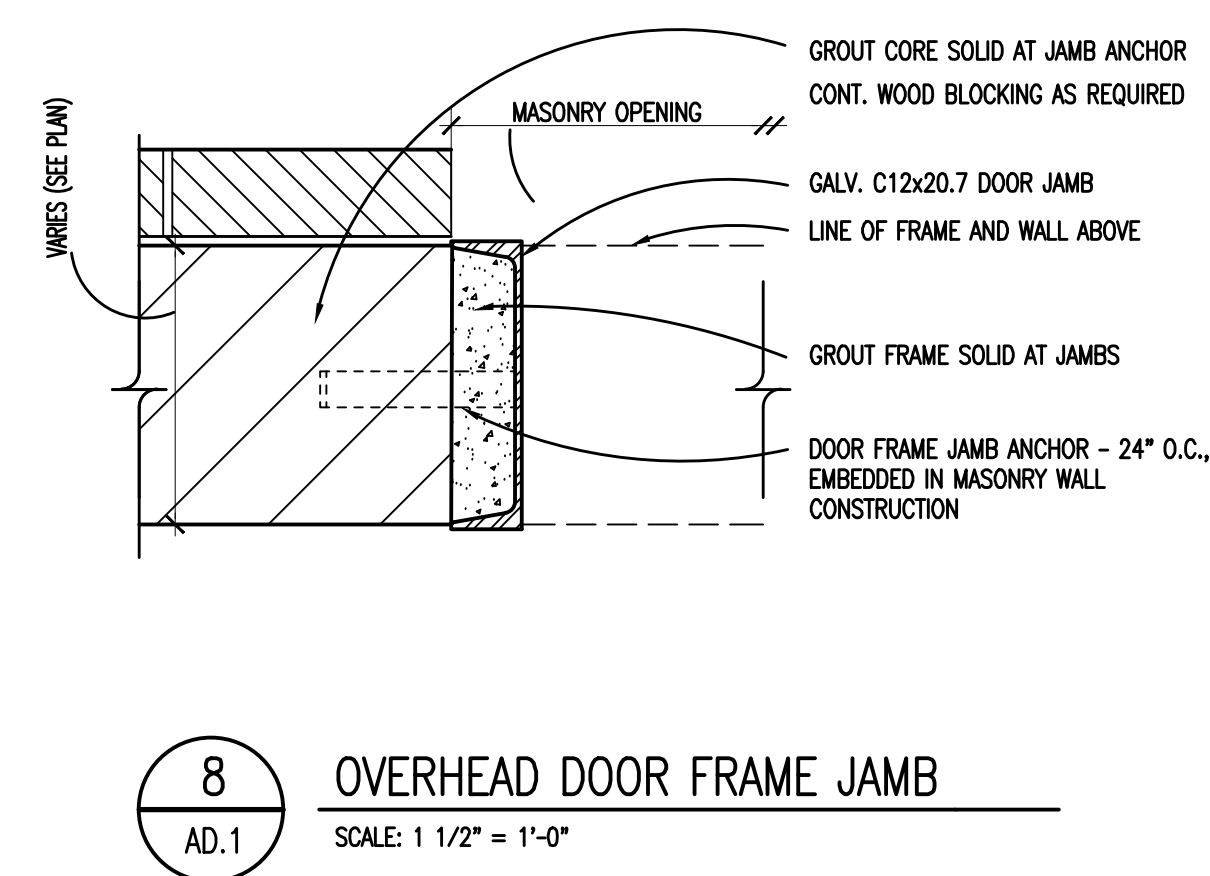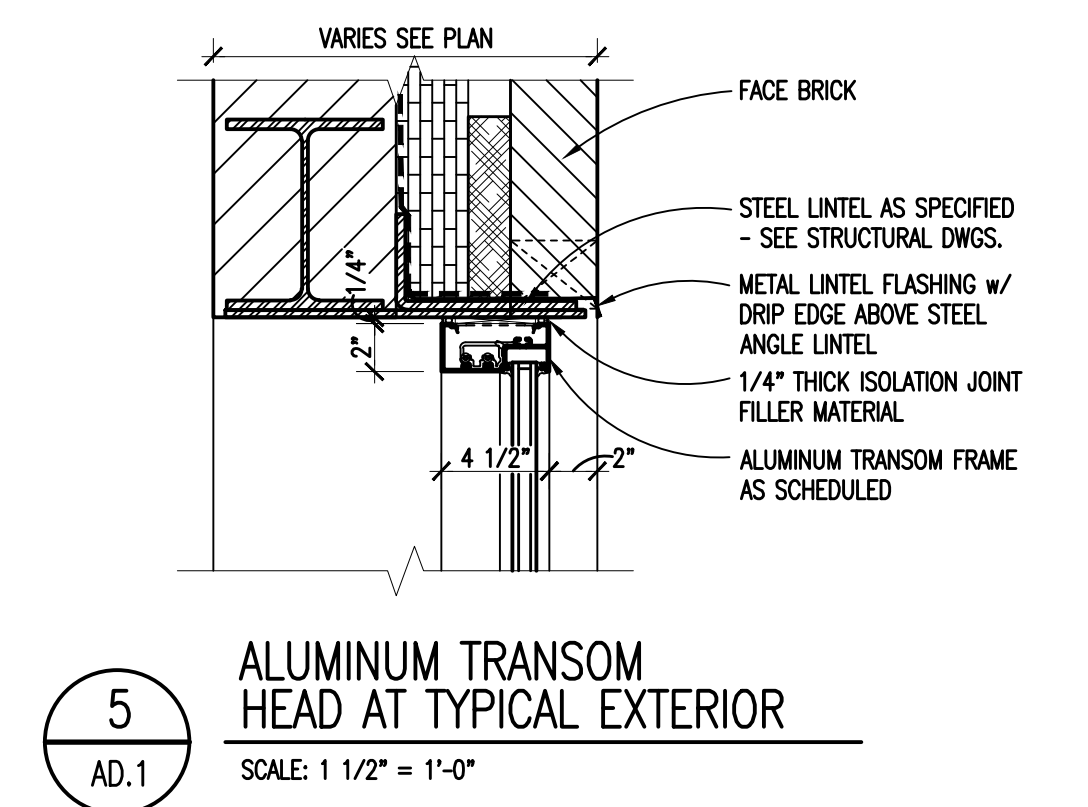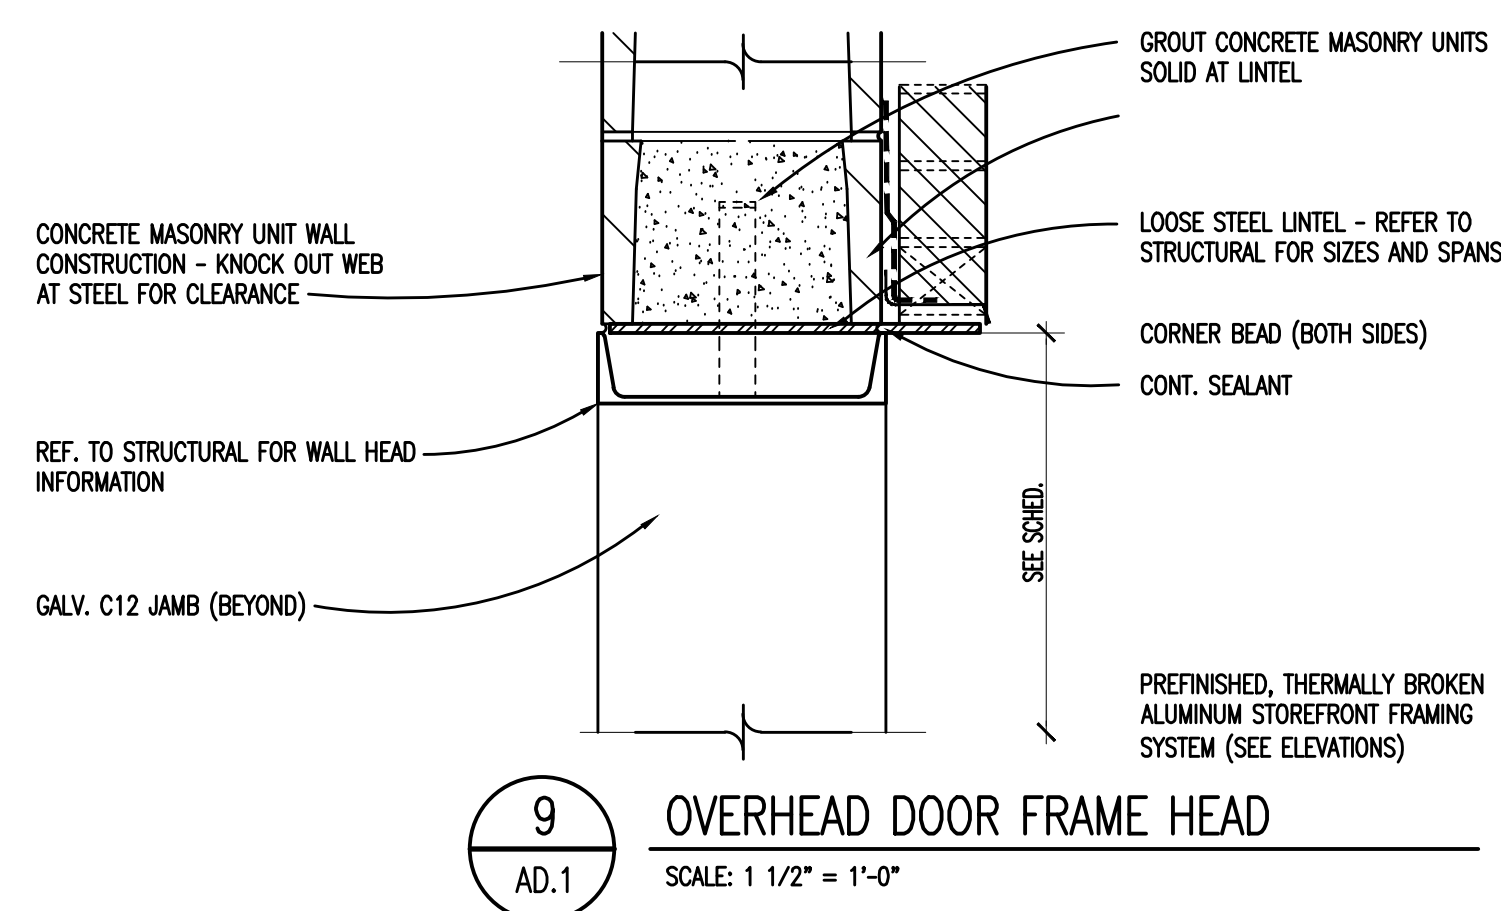

A 1 1



GISTRATION SEAL

CONSULTANT

PROJECT TITLE
**Troy High School
Athletic Fields
Bid Package No. 02B**

Troy School District
Troy, Michigan

DRAWING TITLE
**THS Stadium Entrance
Details**

ISSUE DATES

01-14-2025	ADDENDUM NO. 1
12-10-2024	CONSTRUCTION DOCUMENTS

DATE: ISSUED FOR:

DATE: ISSUED FOR:

DRAWN

DRAWN

CHECKED

CHECKED

APPROVED





APPROVED

PROJECT NO.

22104E

DRAWING NO.

A4.1

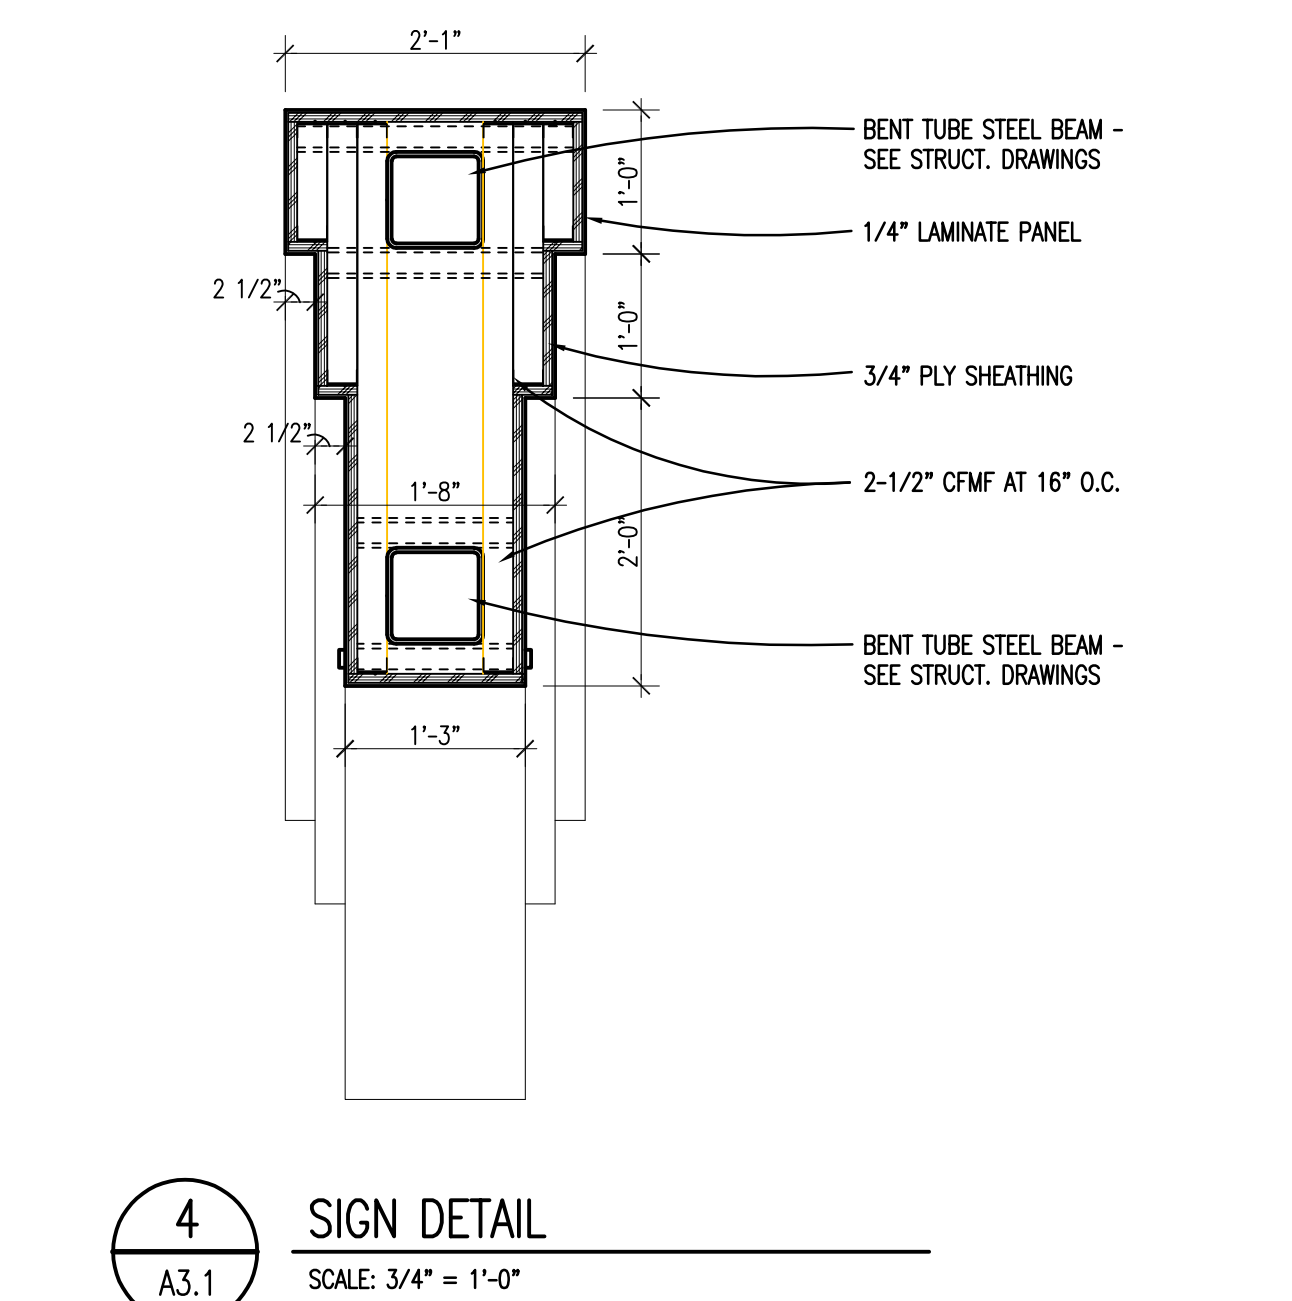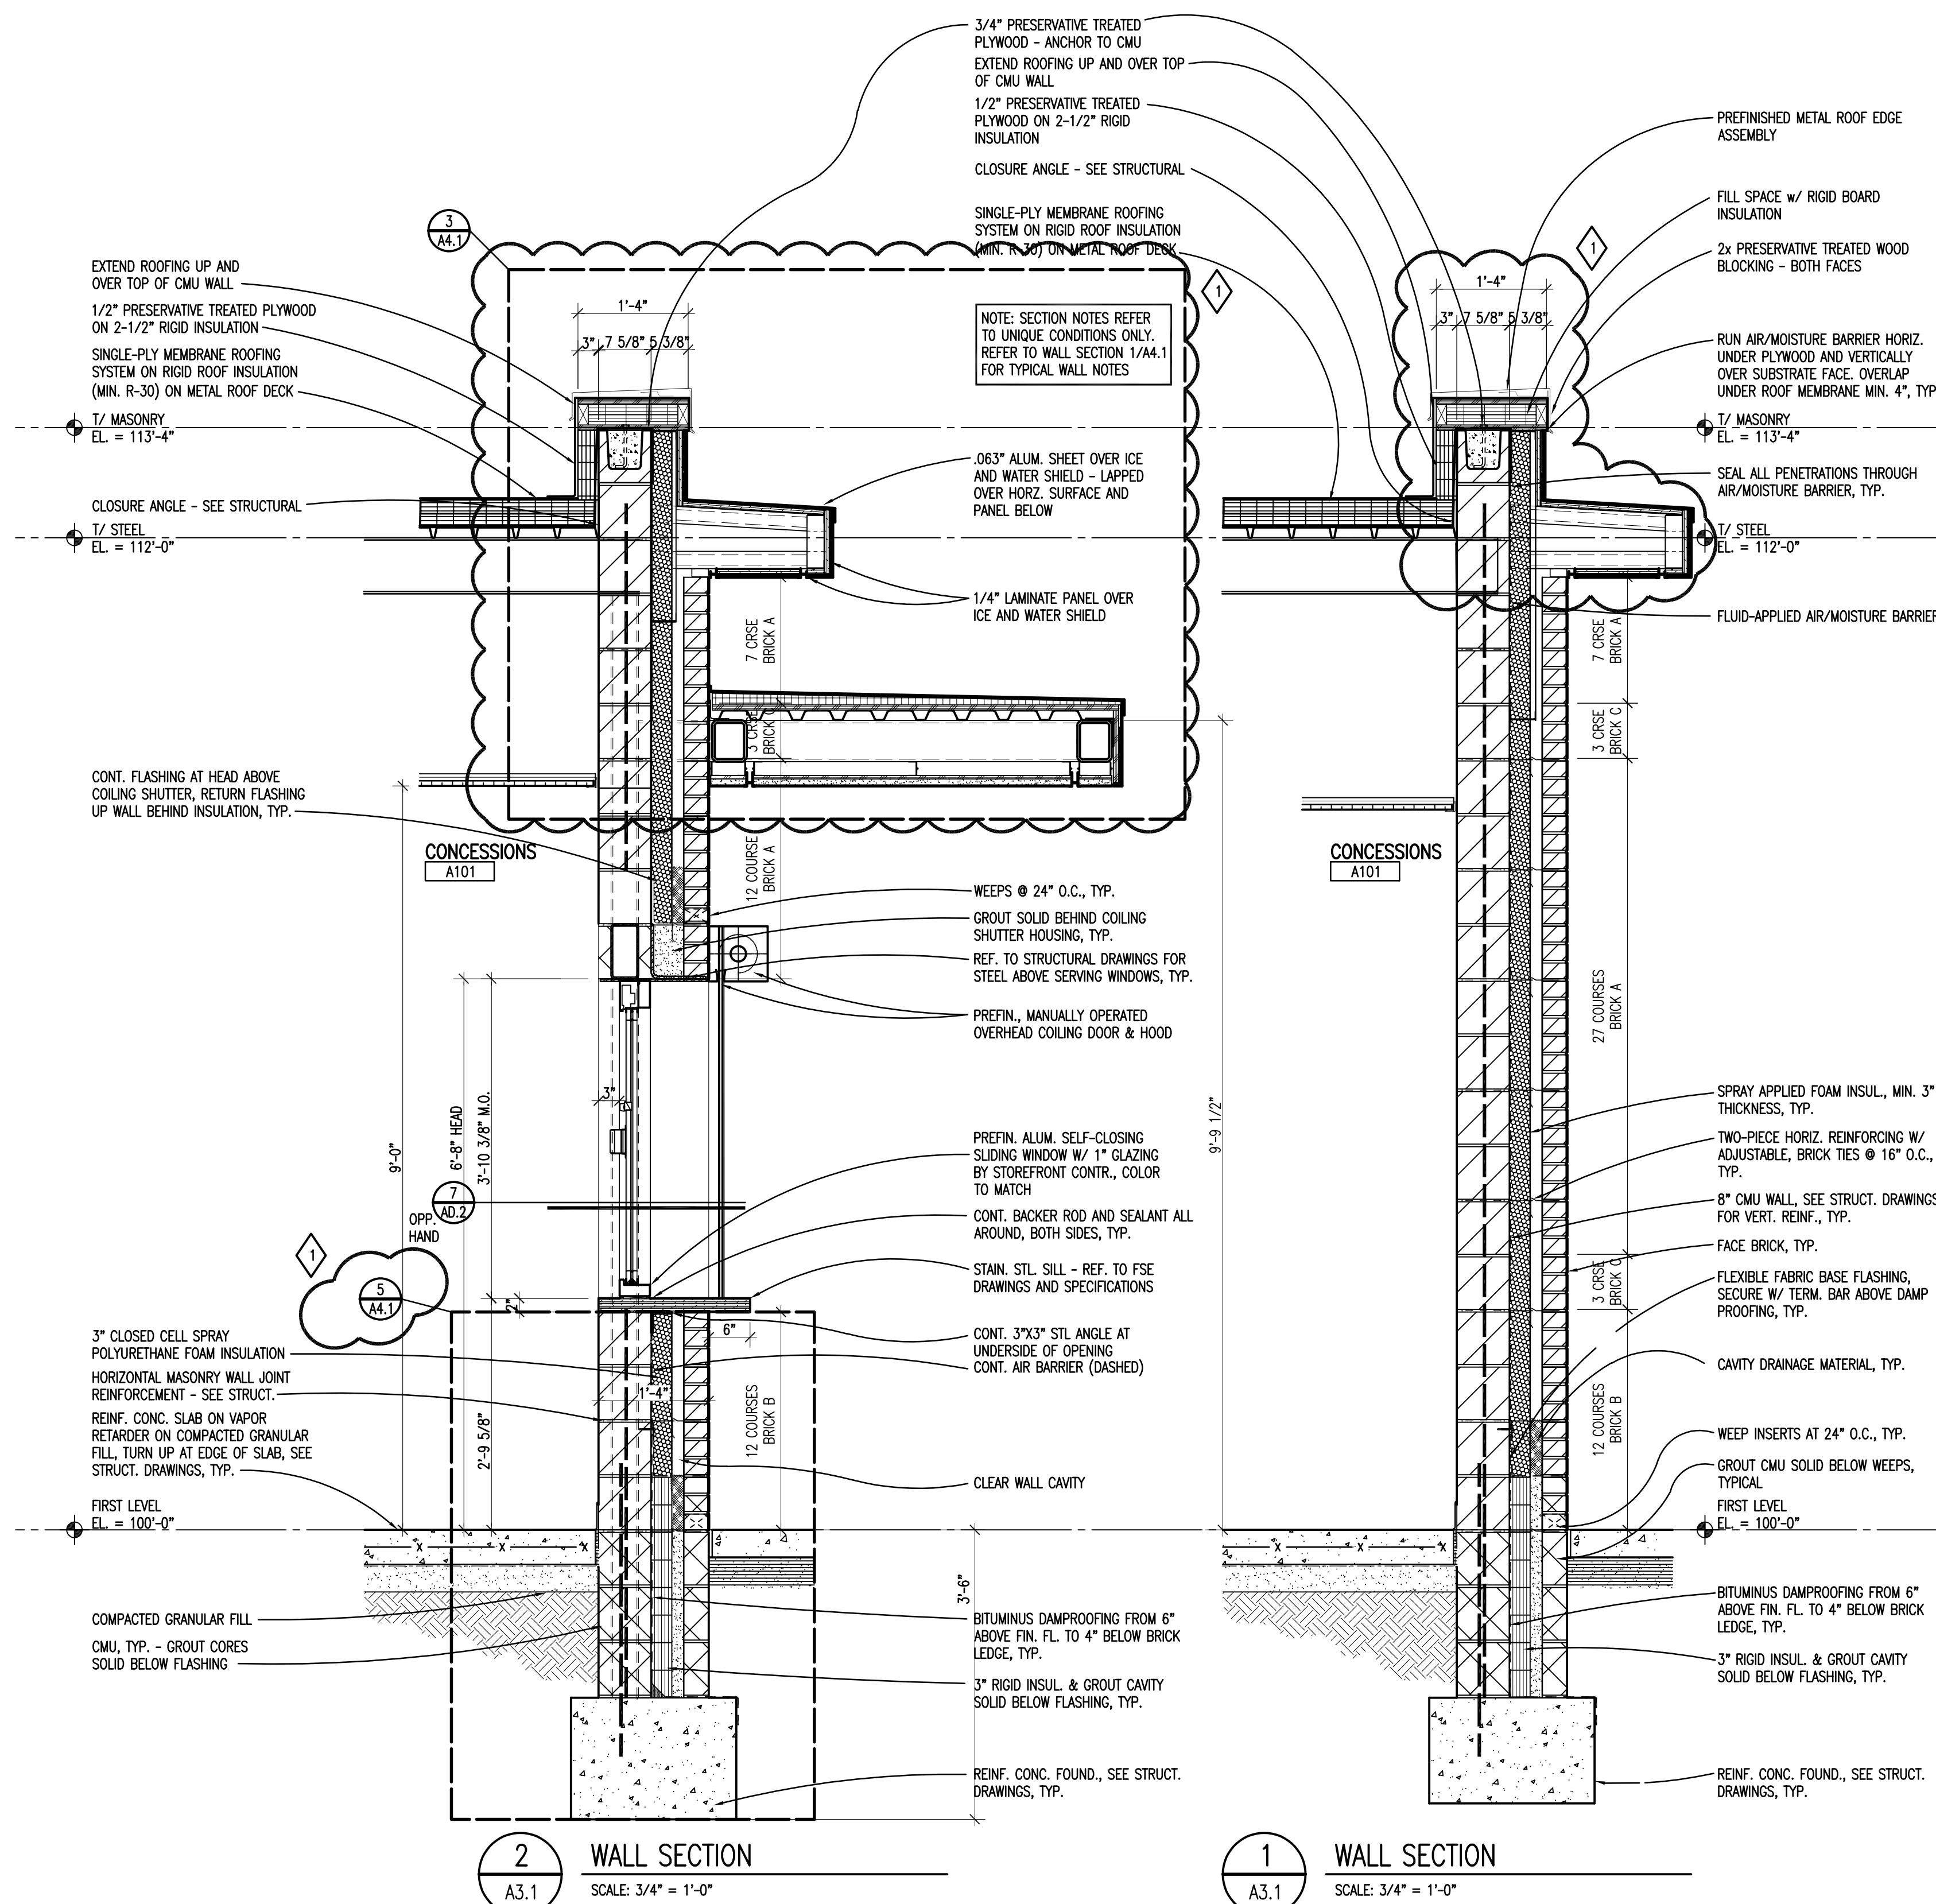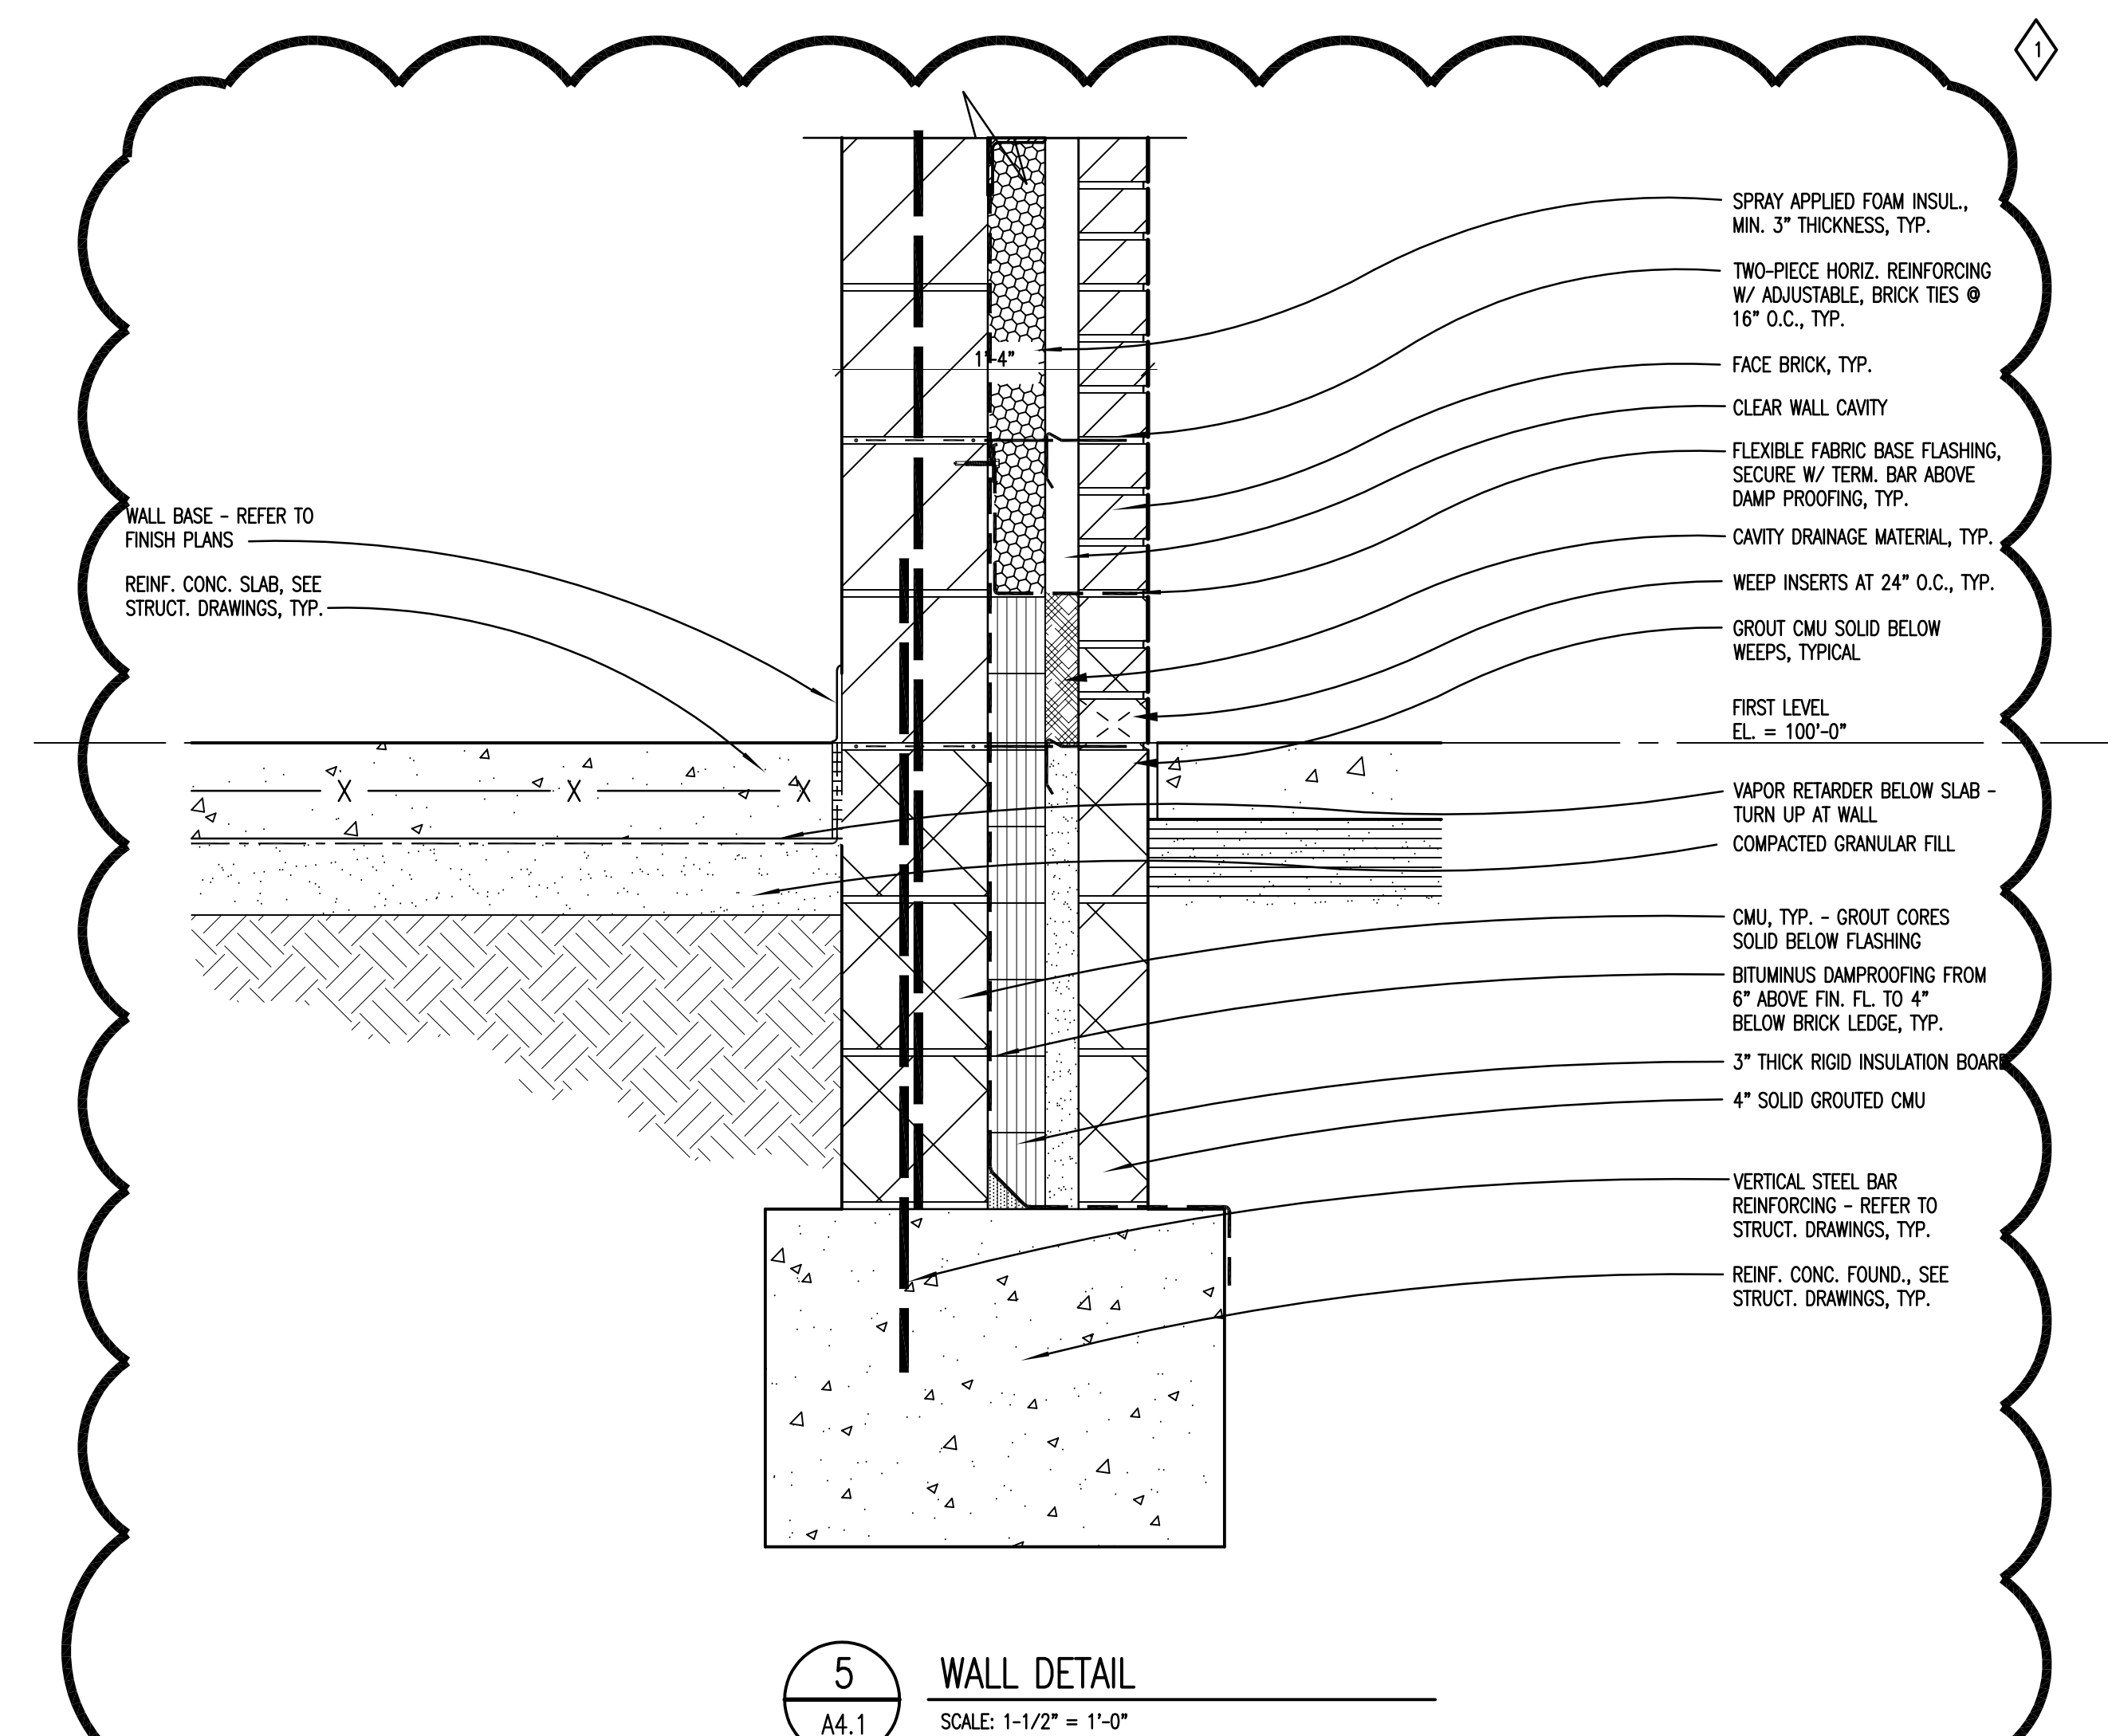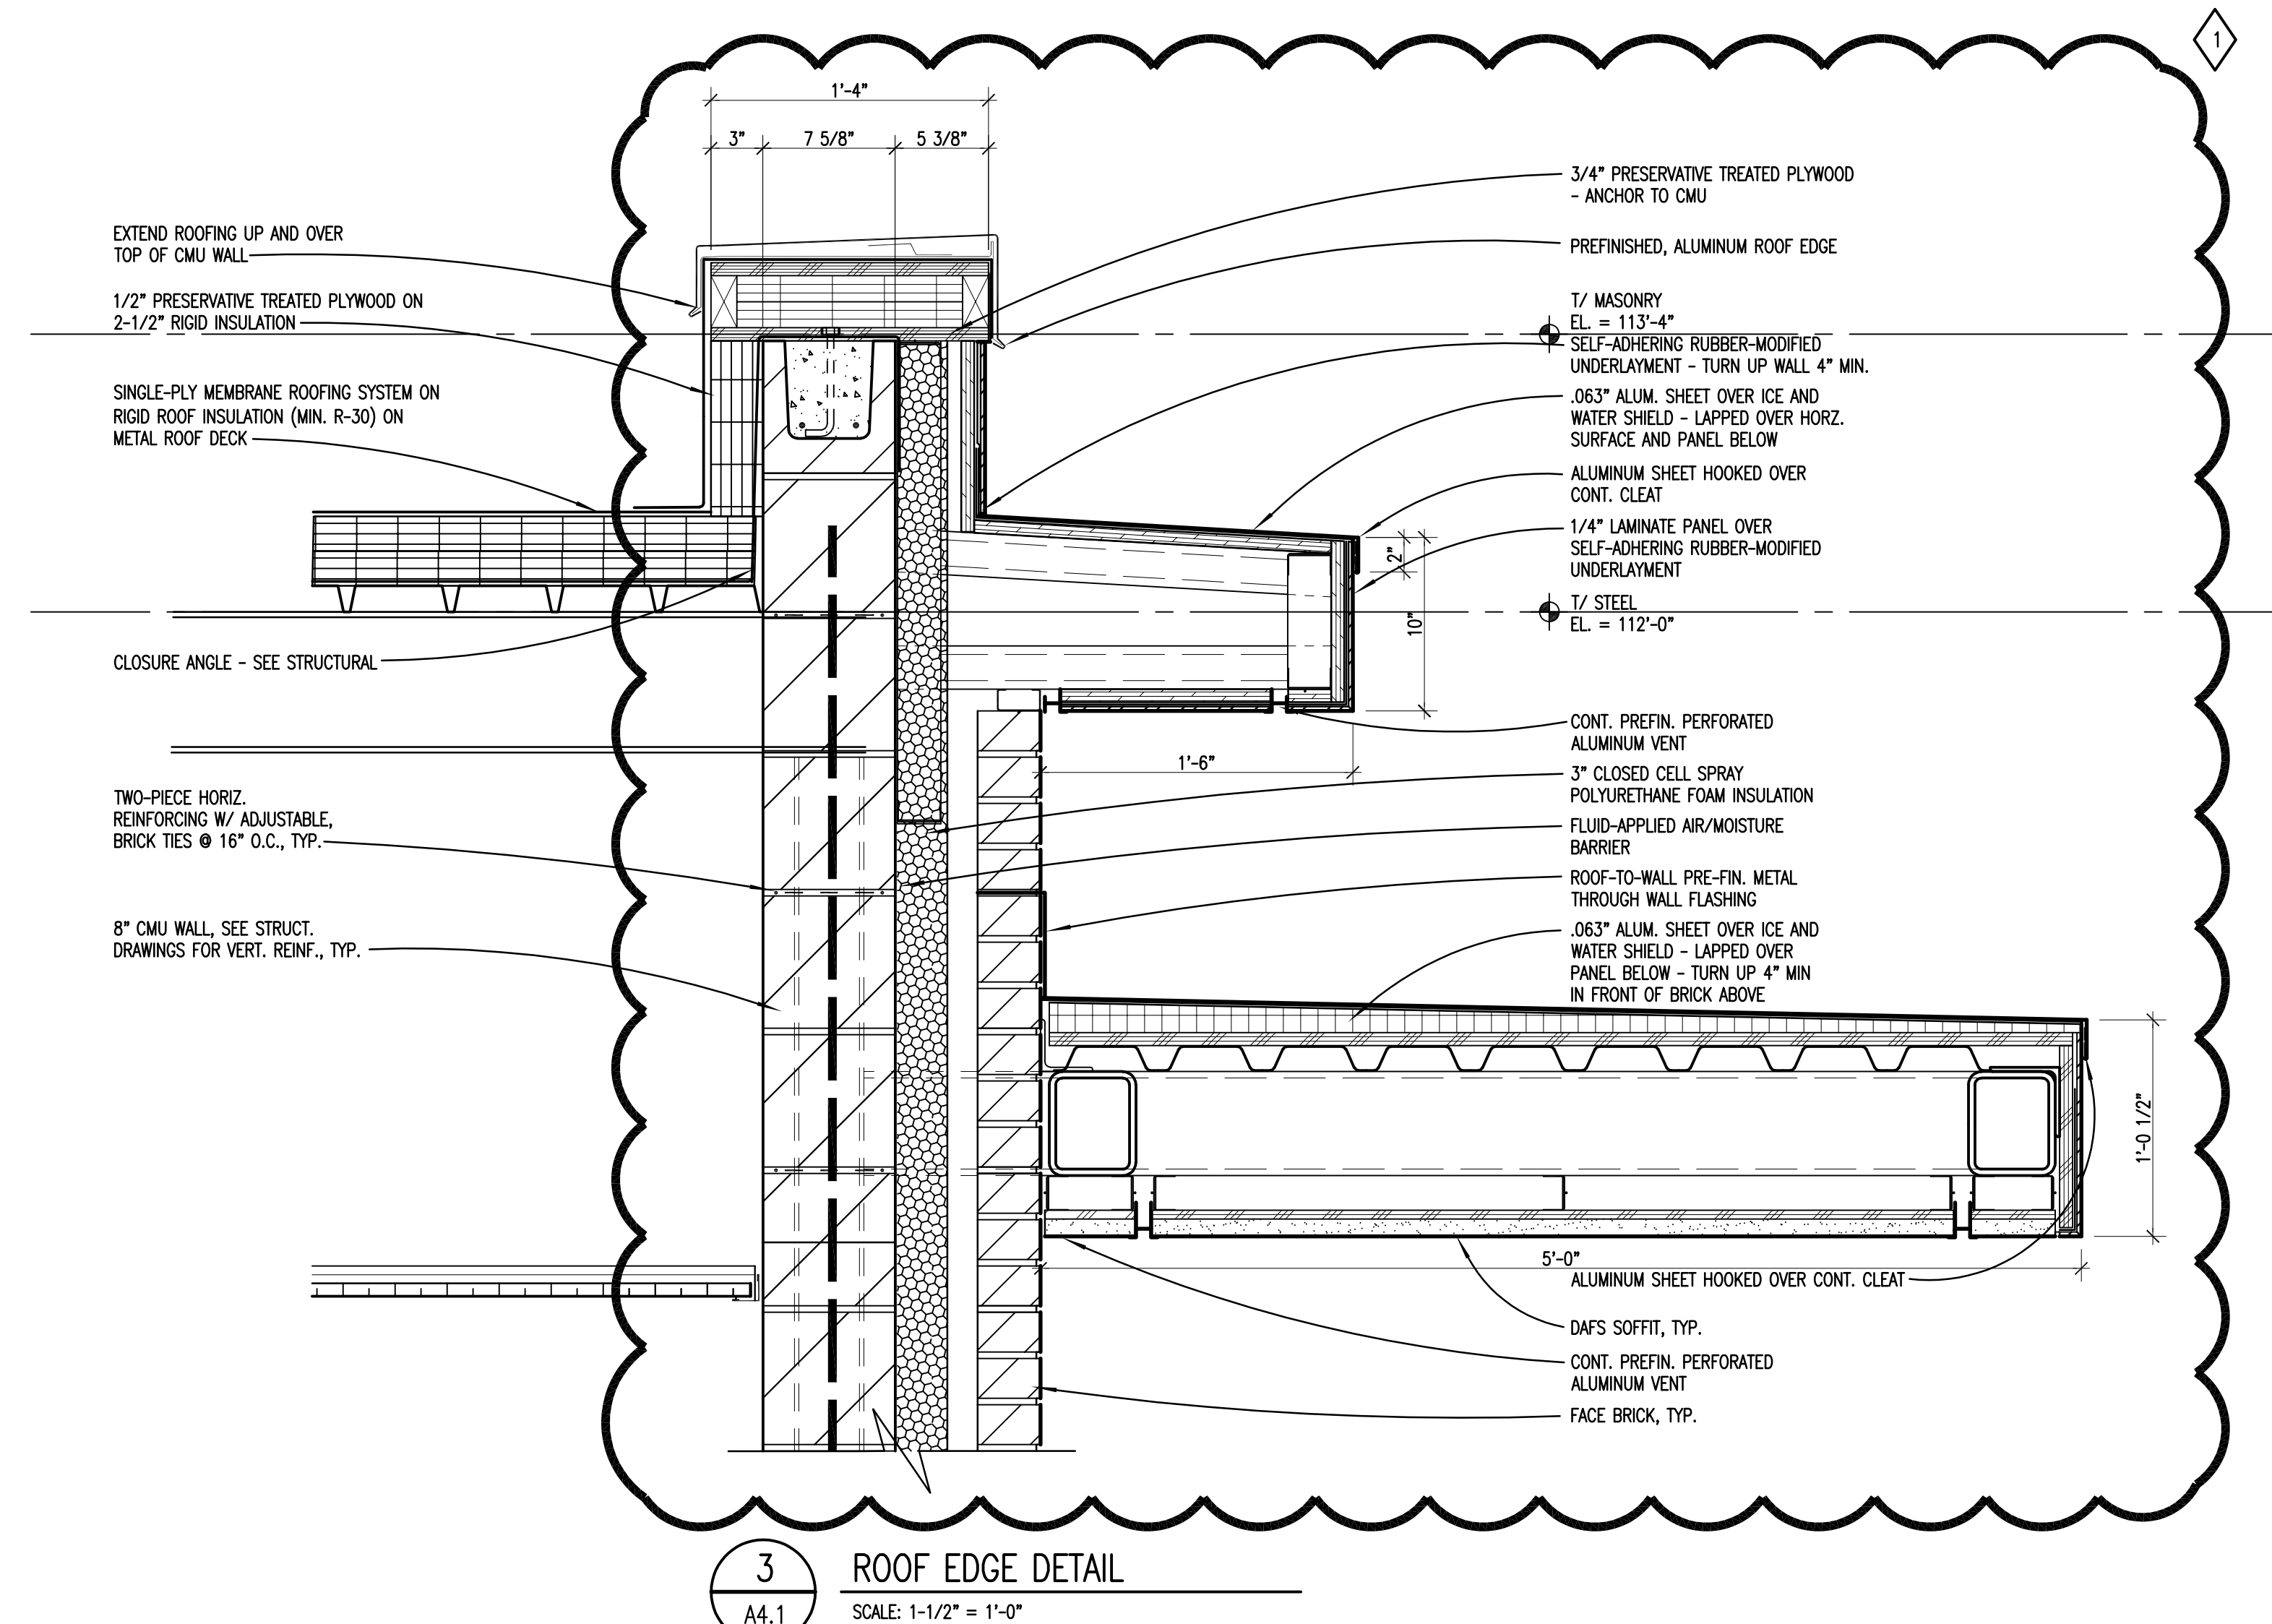



MEETING SIGN-IN SHEET

DATE: 1/8/2025 PROJECT: BP#2B TROY ATHLETICS RENOVATIONS PHASE #2
TIME: 10:00AM
LOCATION: ATHENS HIGH SCHOOL/TROY HIGH SCHOOL SUBJECT: PRE-BID MEETING

ATTENDEES (Please print legibly)	COMPANY	CATEGORY BIDDING	TELEPHONE	E-MAIL ADDRESS
Justin Sherman	Barton Malow Builders			
Jon Johnson	Barton Malow Builders			
Adam Lewis	Barton Malow Builders			
John Girardot	Nagle Paving			johng@naglepaving.com
Matt Webb	Ainsworth Mechanical			Matthew.webb@ainsworth.com
Austin Moore	Nationwide Construction Group			amoore@nationwidecos.com
Todd Underhill	Innovated Energy Controls			tunderhill@ieccompany.com
Travis Guaresimo	Santoro Services			travis@detroitssnow.net
Jacob Steller	Simone			jacob@simonecompanies.com
Rob Johnson	Cortis Brothers			rob@cortisbros.com