


LS3P ARCHITECTS • 24 NORTH MARKET STREET • CHARLESTON • SC • 29401 • 803-722-4789 • FAX 803-577-4444 • MEMBERS OF THE AMERICAN INSTITUTE OF ARCHITECTS • ALL RIGHTS RESERVED • DRAWINGS MAY NOT BE REPRODUCED IN ANY FORM WITHOUT WRITTEN PERMISSION

COPYRIGHT © 1994

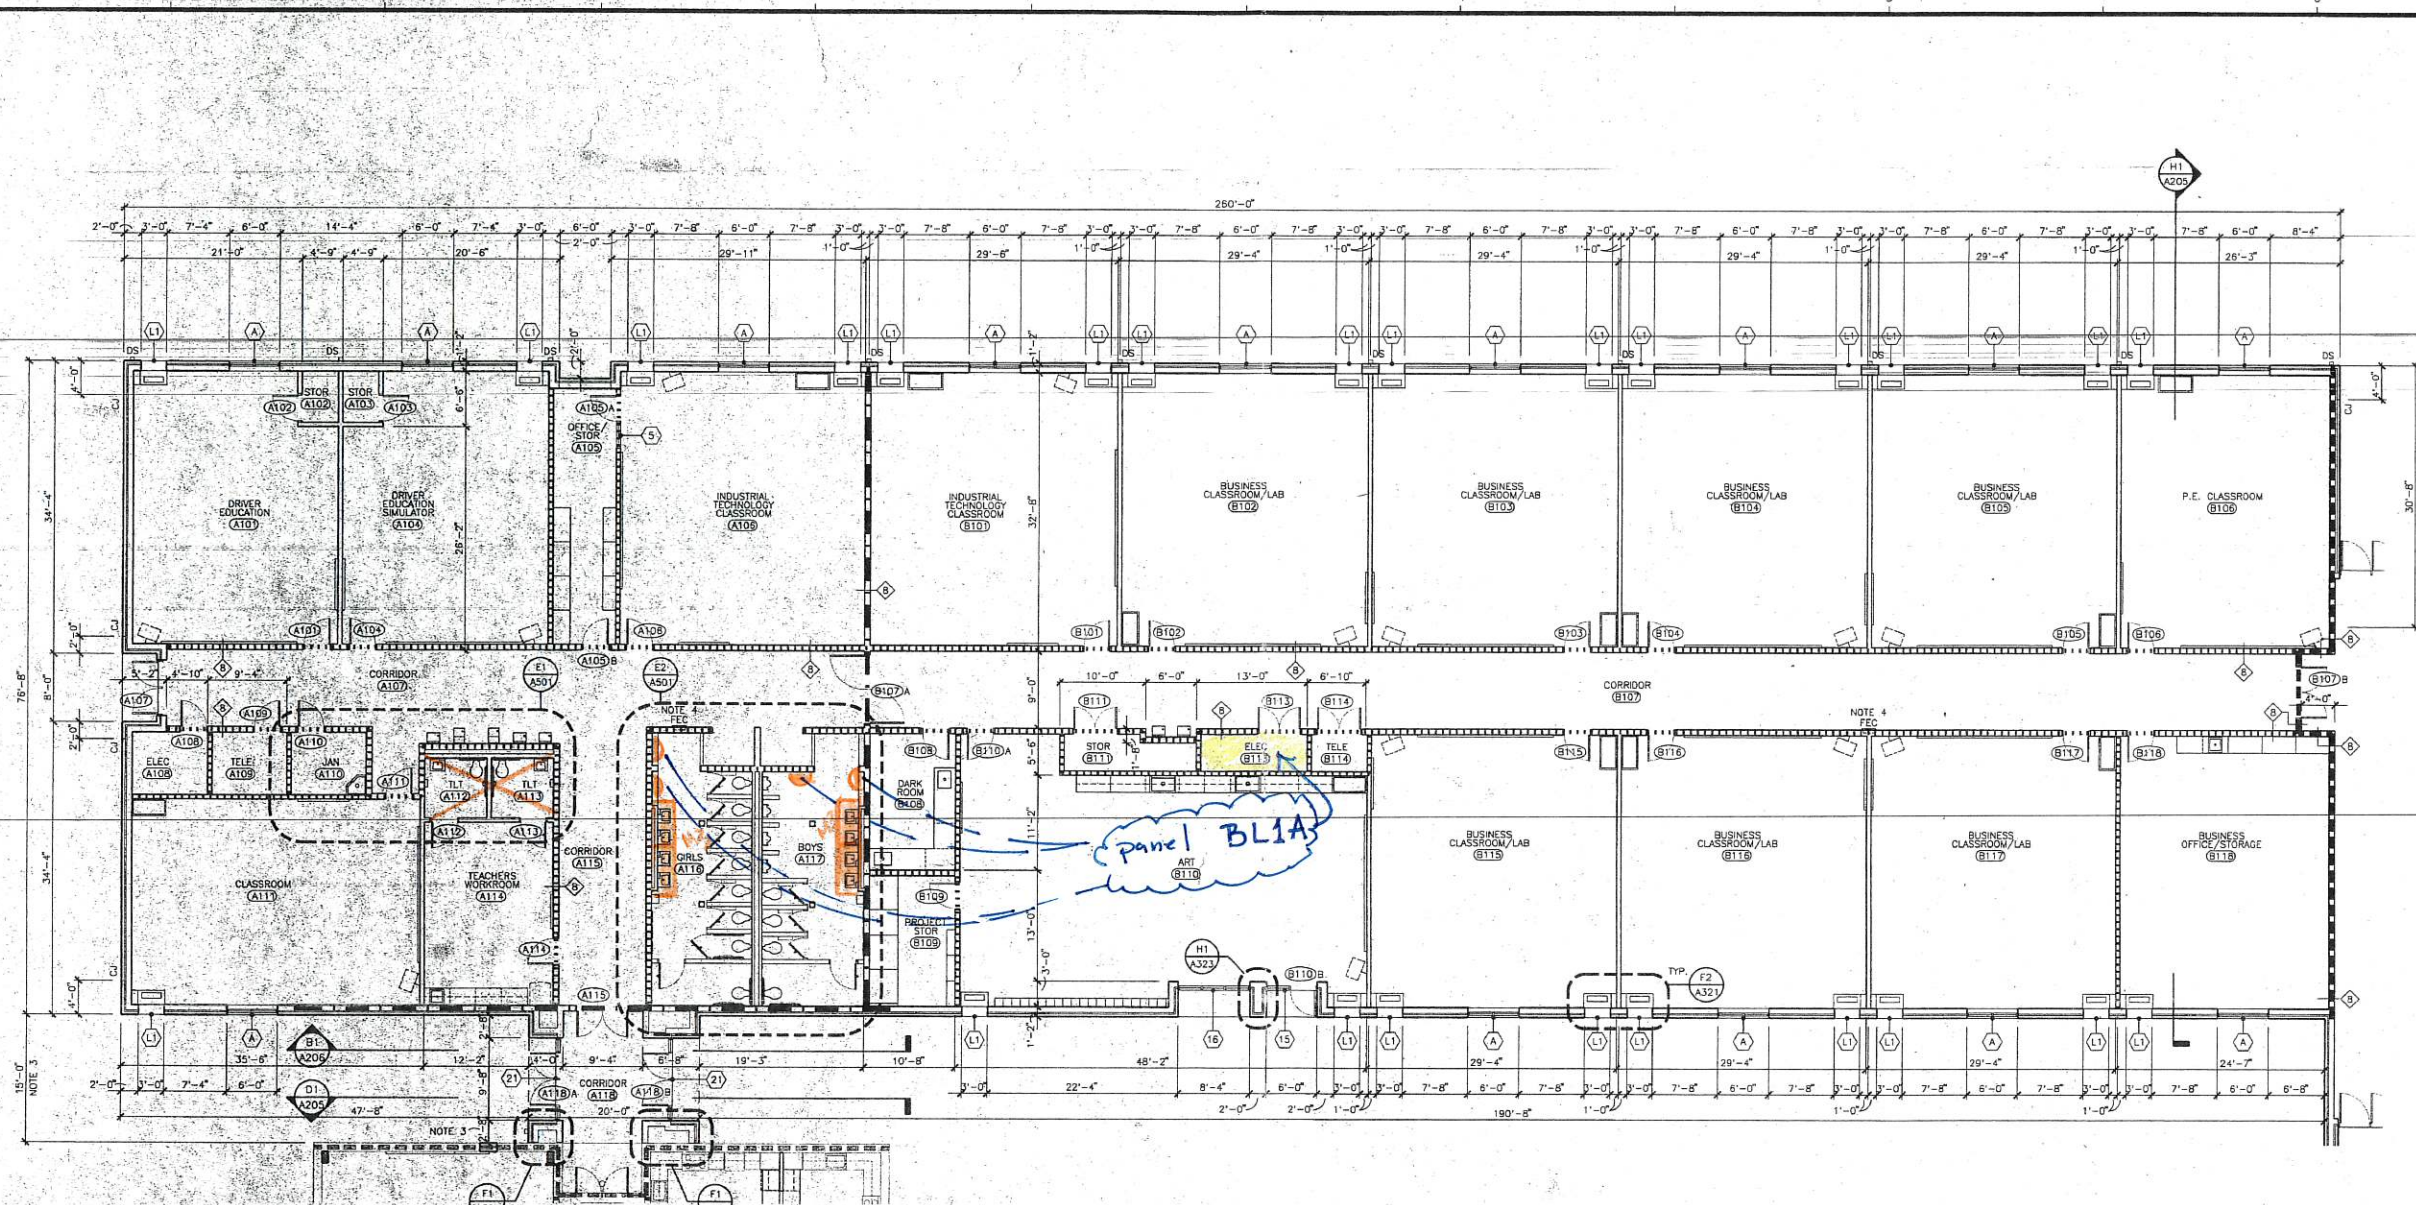

C1 PARTIAL 1ST FLOOR PLAN - AREAS A & B
1/8" = 1'-0"



MATERIALS KEYING LEGEND


LEGENDS

NOTES

KEY PLAN

- EXISTING CONSTRUCTION
- NEW CONSTRUCTION
- NEW REINFORCED SEISMIC SUPPORTS
- WALL RATING LEGEND
- EXISTING 4 HOUR RATED WALL
8" CMU & 4" BRICK (UNO)
- EXISTING 2 HOUR RATED WALL
8" CMU (UNO)
- EXISTING 1 HOUR RATED WALL
8" CMU (UNO)
- NEW 4 HOUR RATED WALL
8" CMU UL U 901 (UNO)
- NEW 2 HOUR RATED WALL
8" CMU UL U 906 (UNO)
- NEW 1 HOUR RATED WALL
8" CMU SIM UL U 906 (UNO)

1. ALL NEW INTERIOR PARTITIONS SHALL BE PARTITION TYPE UNLESS NOTED OTHERWISE. SEE SHEET A601 FOR PARTITION TYPE LEGEND.
2. SEE SHEET A601 FOR LOCATION AND IDENTIFICATION OF CASEWORK, MARKERBOARDS, TACKBOARDS, LOCKERS, ETC.
3. VERIFY DIMENSION IN FIELD.
4. MAINTAIN RATING BEHIND FIRE EXTINGUISHER CABINETS IN RATED WALLS.

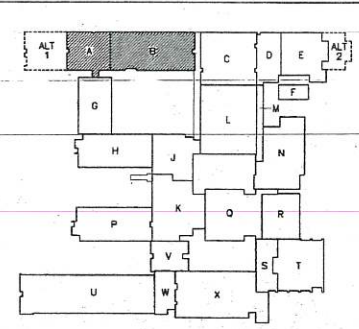

SHEET A101: Make the following revisions:
a. Add concrete splash blocks at all down spouts on east side of Areas A & B.


DATE
2-21-96
DRAWN
VINZANI
CHECKED
BAKER
REVISION

SUMMERVILLE HIGH SCHOOL
EXPANSION & RENOVATIONS
SUMMERVILLE, SOUTH CAROLINA

APPROVED
COMMISSION
94071.05

PARTIAL 1ST
FLOOR PLAN
AREAS A
& B

A101

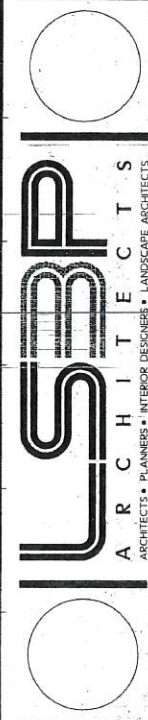

ENCL. A - MARKUP Asbuilts

DATE
2-21-96
DRAWN
VINZANI
CHECKED
BAKER
REVISION

APPROVED


COMMISSION

94071.05

██████████

PARTIAL 1ST
FLOOR PLAN
AREAS C
& ALT 1

A102

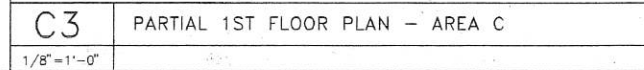

NOTES


1. ALL INTERIOR PARTITIONS SHALL BE PARTITION TYPE 6 UNLESS NOTED OTHERWISE. SEE SHEET A001 FOR PARTITION TYPE LEGEND.

2. SHEET A602 FOR LOCATION AND IDENTIFICATION OF CASEWORK, REARBOARDS, TACKBOARDS, LOCKERS, ETC.

3. ROLL-FORMED ALUMINUM CANOPY.


4. NEW MASONRY WITH EDGE OF EXISTING MASONRY.

5. RATING BEHIND FIRE EXTINGUISHER CABINETS IN RATED WALLS.

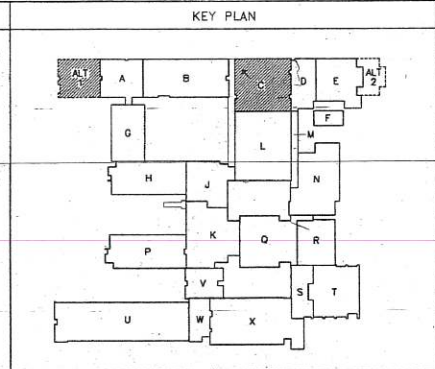


LS9P ARCHITECTS • 24 NORTH MARKET STREET • CHARLESTON • SC • 29401 • 803-577-4444 • FAX 803-722-4789 • MEMBERS OF THE AMERICAN INSTITUTE OF ARCHITECTS • ALL RIGHTS RESERVED • DRAWINGS MAY NOT BE REPRODUCED IN ANY FORM WITHOUT WRITTEN PERMISSION

COPYRIGHT © 1994

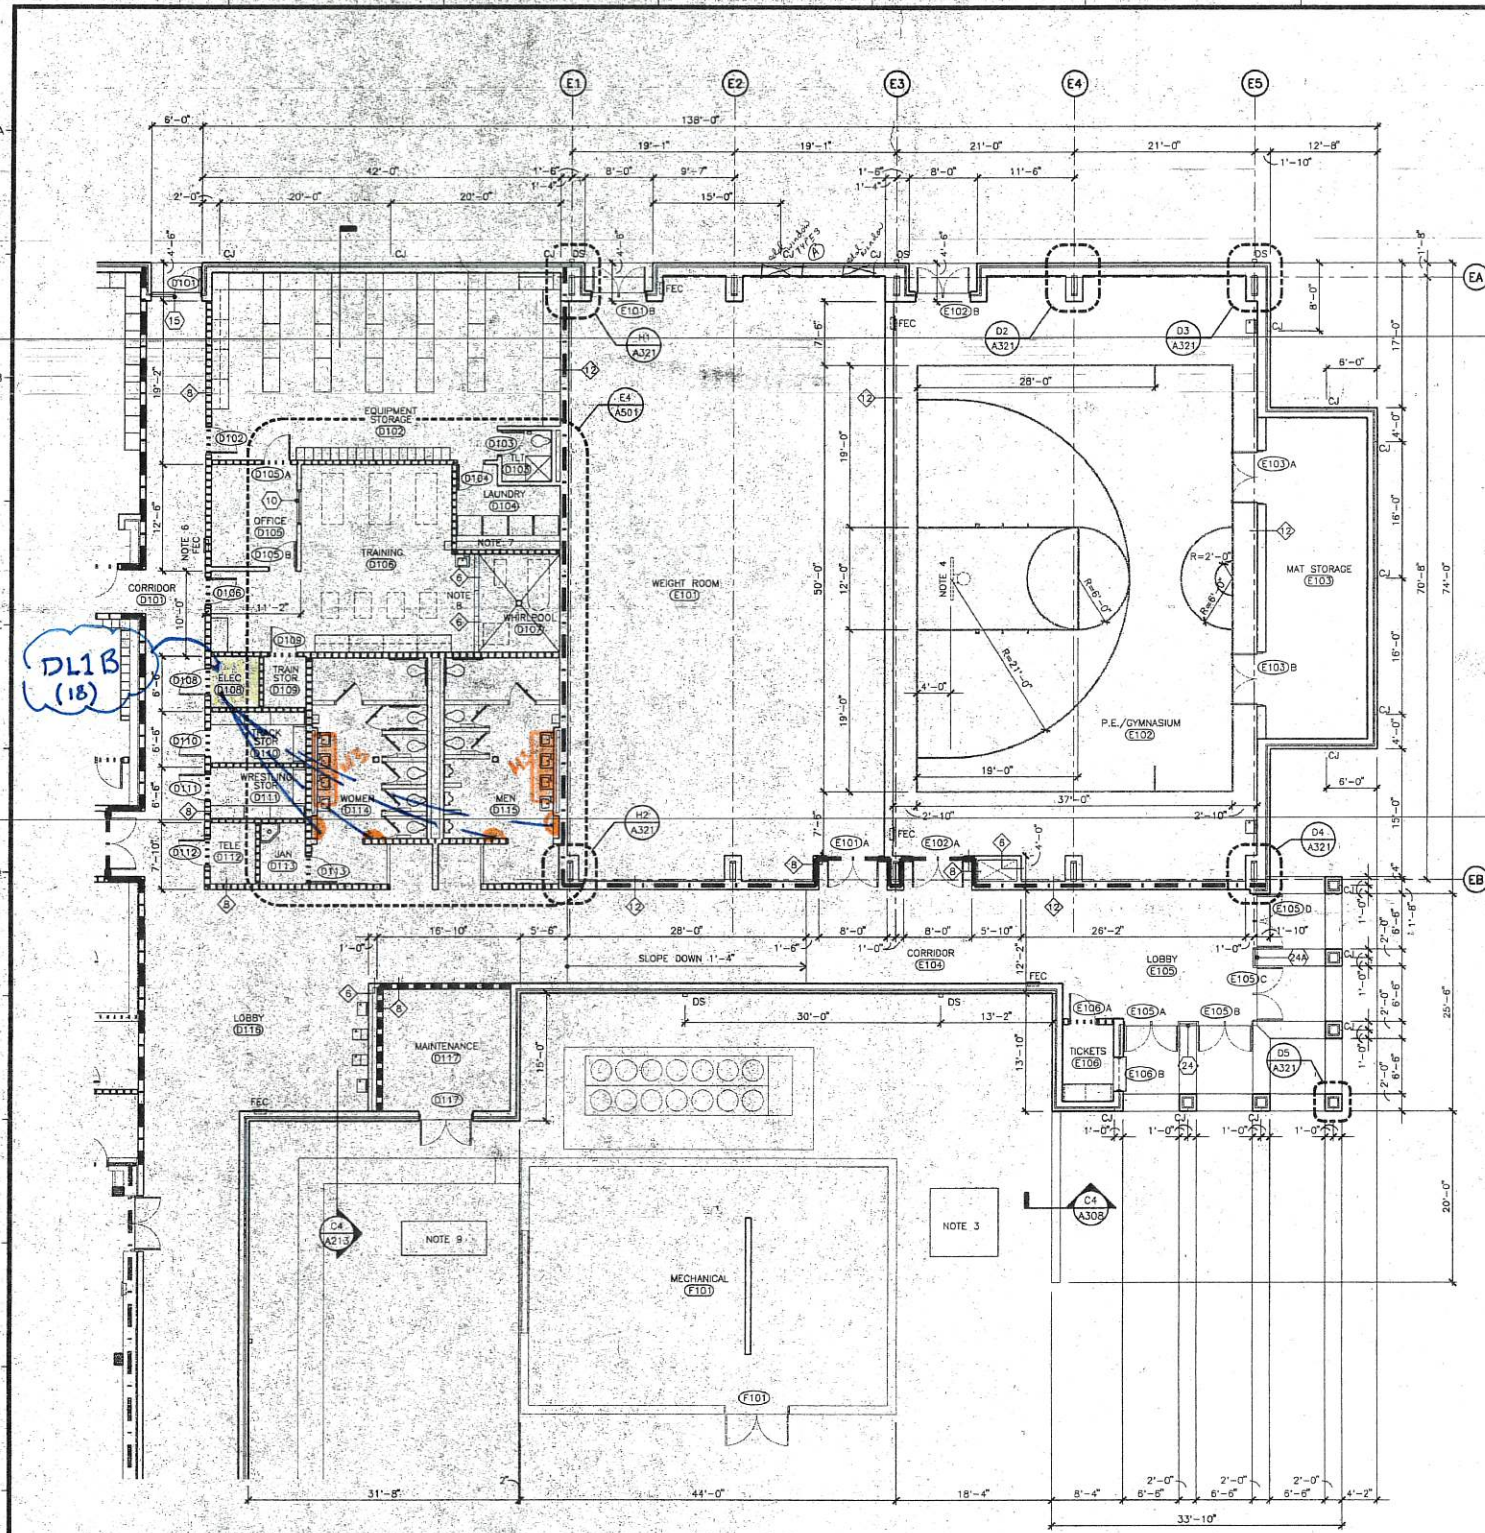

C1 PARTIAL 1ST FLOOR PLAN - AREAS D, E & F
1/8"=1'-0"


MATERIALS KEYING LEGEND	
	EXISTING CONSTRUCTION
	NEW CONSTRUCTION
	NEW REINFORCED SEISMIC SUPPORTS
WALL RATING LEGEND	
	EXISTING 4 HOUR RATED WALL 8" CMU & 4" BRICK (UNO)
	EXISTING 2 HOUR RATED WALL 8" CMU (UNO)
	EXISTING 1 HOUR RATED WALL 8" CMU (UNO)
	NEW 4 HOUR RATED WALL 8" CMU UL U 901 (UNO)
	NEW 2 HOUR RATED WALL 8" CMU UL U 906 (UNO)
	NEW 1 HOUR RATED WALL 8" CMU SIM UL U 906 (UNO)

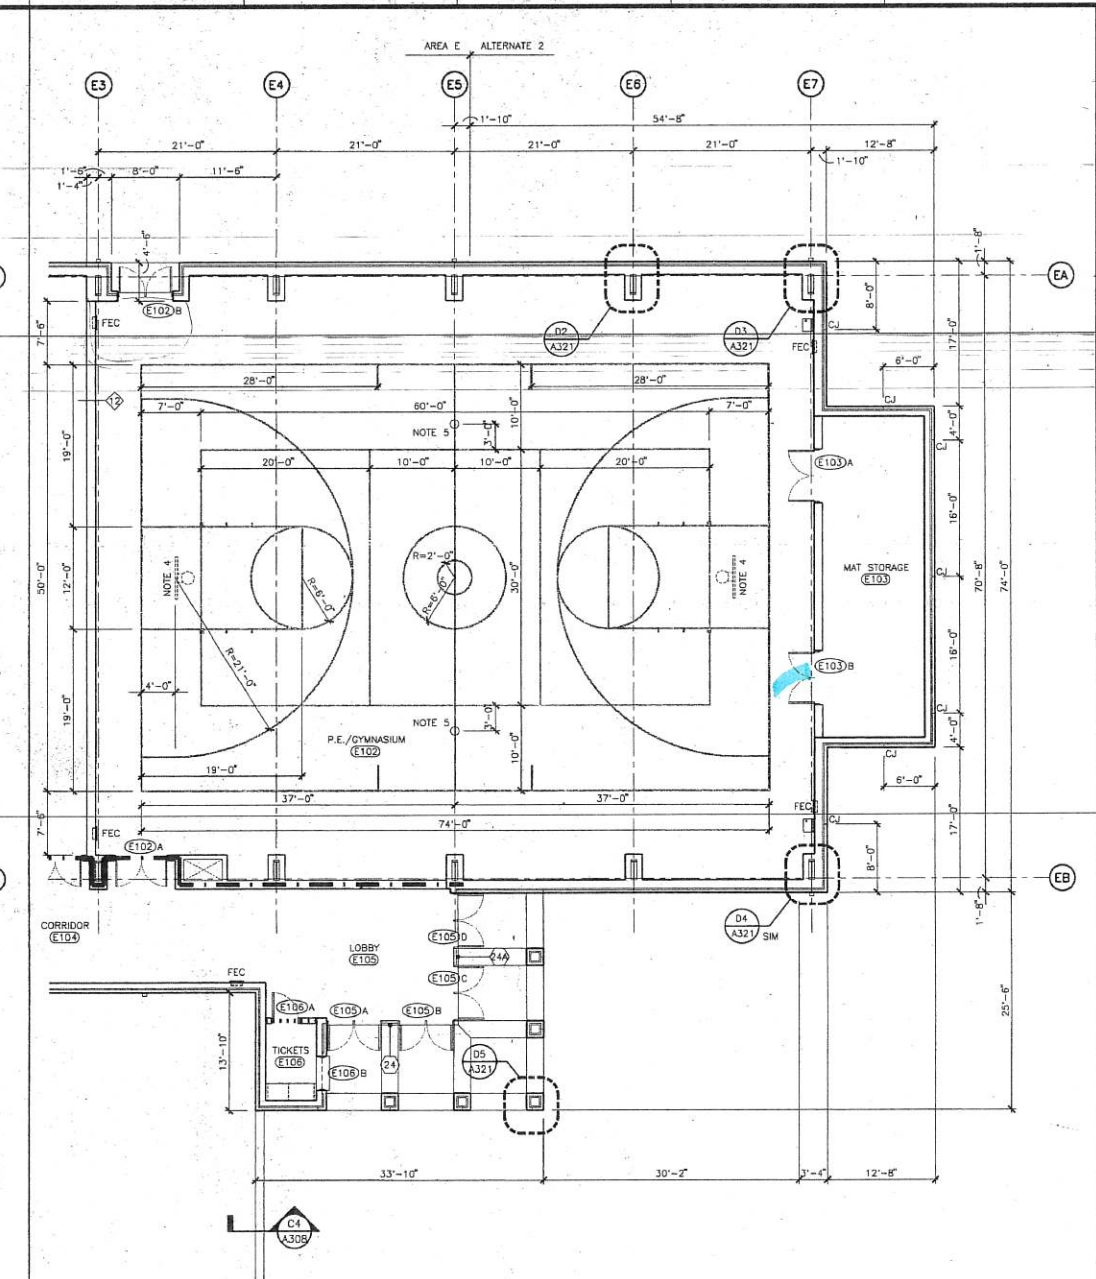

C4 PARTIAL 1ST FLOOR PLAN - ALTERNATE 2
1/8"=1'-0"

LEGENDS	NOTES
	EXISTING CONSTRUCTION
	NEW CONSTRUCTION
	NEW REINFORCED SEISMIC SUPPORTS
WALL RATING LEGEND	
	EXISTING 4 HOUR RATED WALL 8" CMU & 4" BRICK (UNO)
	EXISTING 2 HOUR RATED WALL 8" CMU (UNO)
	EXISTING 1 HOUR RATED WALL 8" CMU (UNO)
	NEW 4 HOUR RATED WALL 8" CMU UL U 901 (UNO)
	NEW 2 HOUR RATED WALL 8" CMU UL U 906 (UNO)
	NEW 1 HOUR RATED WALL 8" CMU SIM UL U 906 (UNO)

NOTES	
1.	ALL NEW INTERIOR PARTITIONS SHALL BE PARTITION TYPE 4 UNLESS NOTED OTHERWISE. SEE SHEET A001 FOR PARTITION TYPE LEGEND.
2.	SEE SHEET A003 FOR LOCATION AND IDENTIFICATION OF CASEWORK, MARKERBOARDS, TACKBOARDS, LOCKER, ETC.
3.	NEW UTILITY TRANSFORMER; SEE ELECTRICAL DRAWINGS.
4.	BASKETBALL BACKBOARD.
5.	VOLLEYBALL FLOOR SLEEVE SYSTEM. SEE DETAIL B1/A511.
6.	MAINTAIN RATING BEHIND FIRE EXTINGUISHER CABINETS IN RATED WALLS.
7.	TRENCH DRAIN.
8.	TOP OF LOW WALL AT 4'-0" A.F.F.
9.	NEW GENERATOR. SEE ELECTRICAL DRAWINGS.

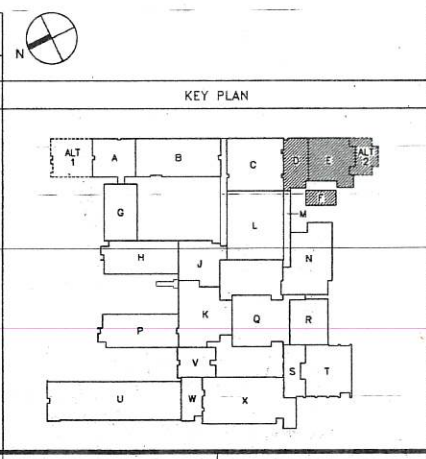

SHEET A103: Make the following revisions:

- Add 6" clear x 6" clear chase (partition type 4) in Northeast corner of Training D106.
- Detail C4 - add 2'-6" x 4'-4" clear chase adjacent to DOOR E102 B (partition type 6) in PE Gymnasium E102 (Alt. 2 only).
- Clarify new partition at MECH. F101 as partition type 5 and top of wall as 7'-4".
- Add concrete splash blocks at all down spouts on east side of Area E and Alternate 2.

LS9P ARCHITECTS
ARCHITECTS • PLANNERS • INTERIOR DESIGNERS • LANDSCAPE ARCHITECTS


SUMMERVILLE HIGH SCHOOL
EXPANSION & RENOVATIONS
SUMMERVILLE, SOUTH CAROLINA

DATE
2-21-96
DRAWN
VINZANI
CHECKED
BAKER
REVISION

APPROVED
COMMISSION
94071.05

PARTIAL 1ST
FLOOR PLAN
AREAS D,
E, F &
ALT 2
A103

COPYRIGHT © 1994 LSP ARCHITECTS • 24 NORTH MARKET STREET • CHARLESTON • SC • 29401 • 803-577-4444 • FAX 803-722-4789 • MEMBERS OF THE AMERICAN INSTITUTE OF ARCHITECTS • ALL RIGHTS RESERVED • DRAWINGS MAY NOT BE REPRODUCED IN ANY FORM WITHOUT WRITTEN PERMISSION

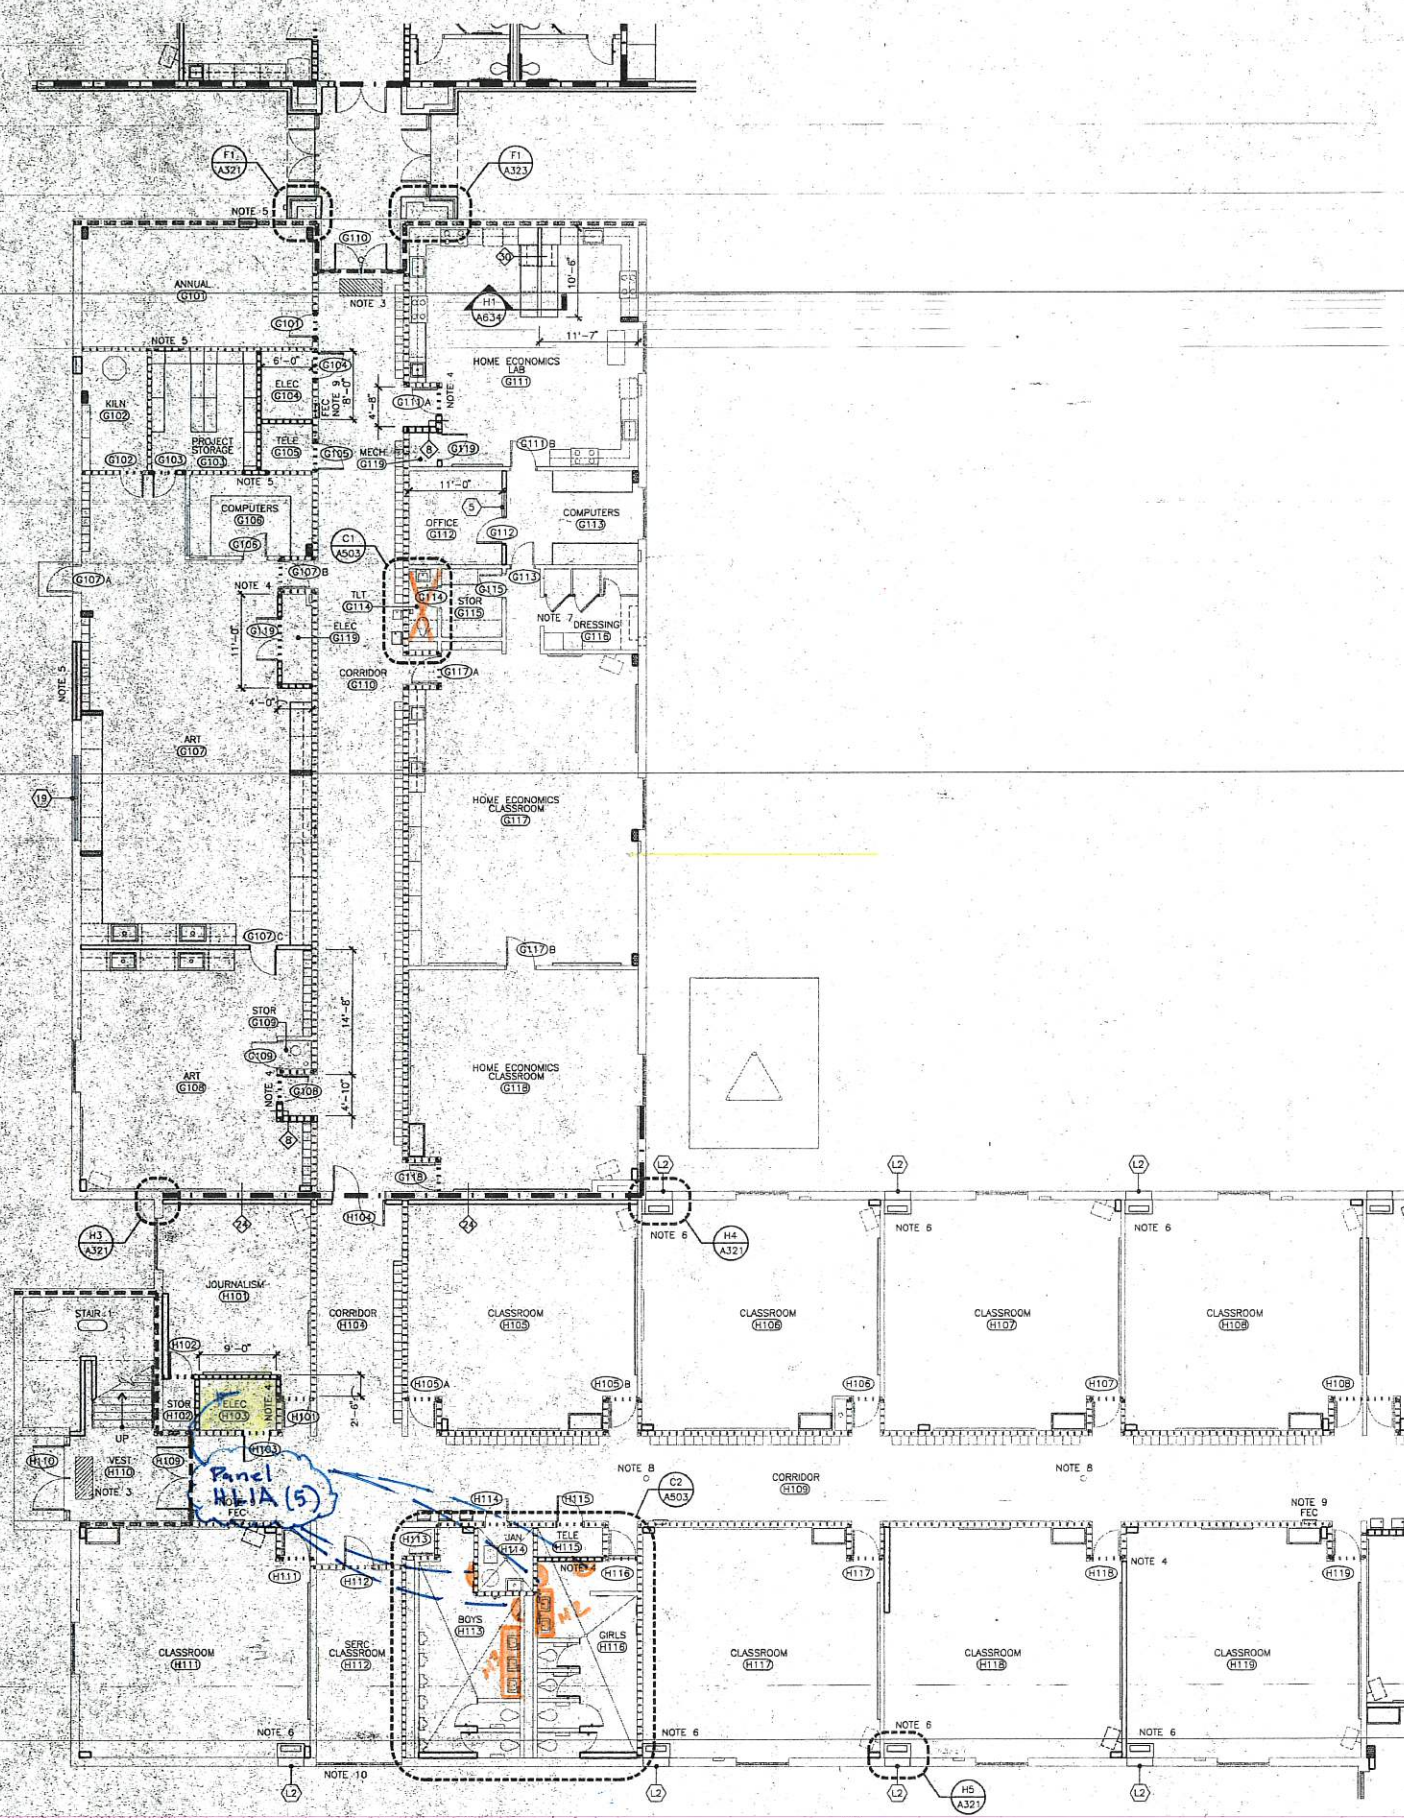

H1 PARTIAL 1ST FLOOR PLAN - AREAS G & H
1/8" = 1'-0"

MATERIALS KEYING LEGEND

SHEET A104: Make the following revisions:
b. Show floor drain in MECH. G119 to coordinate with plumbing.



LEGENDS

- EXISTING CONSTRUCTION
NEW CONSTRUCTION
NEW REINFORCED SEISMIC SUPPORTS
- WALL RATING LEGEND
EXISTING 4 HOUR RATED WALL
8" CMU & 5" BRICK (UNO)
EXISTING 2 HOUR RATED WALL
8" CMU (UNO)
EXISTING 1 HOUR RATED WALL
8" CMU (UNO)
NEW 4 HOUR RATED WALL
8" CMU UL U 901 (UNO)
NEW 2 HOUR RATED WALL
8" CMU UL U 906 (UNO)
NEW 1 HOUR RATED WALL
8" CMU SIM UL U 906 (UNO)

NOTES

- ALL NEW INTERIOR PARTITIONS SHALL BE PARTITION TYPE 6 UNLESS NOTED OTHERWISE. SEE SHEET A001 FOR PARTITION TYPE LEGEND.
- SEE SHEET A004 FOR LOCATION AND IDENTIFICATION OF CASEWORK, MARKERBOARDS, TACKBOARDS, LOCKERS, ETC.
- FILL FOOT GRILLE RECESS WITH CONCRETE TO MATCH EXISTING FLOOR ELEVATION.
- ALIGN NEW MASONRY WITH EDGE OF EXISTING MASONRY.
- INFILL MASONRY OPENING TO MATCH EXISTING.
- NEW THRU-WALL MECHANICAL UNIT - SEE DETAIL H5/A321 FOR TYPICAL DIMENSIONS AND LOCATION IN REFERENCE TO EXISTING INTERIOR PARTITIONS. CUT NEW OPENING IN EXISTING EXTERIOR WALL TO ALIGN WITH EXISTING BRICK COURSING.
- NEW PLYWOOD DOORS TO DRESSING ROOMS. SEE DETAIL A6/A412.
- EXISTING FLOOR CLEAN OUT TO REMAIN.
- NEW FIRE EXTINGUISHER CABINETS TO BE LOCATED IN EXISTING WALL OPENINGS WHERE EVER POSSIBLE. MAINTAIN RATING BEHIND FIRE EXTINGUISHER CABINETS IN RATED WALLS.
- REPAIR FRAME AND REGLAZE WINDOW TO MATCH EXISTING WHERE THROUGH WALL AIR CONDITIONER WAS REMOVED.

KEY PLAN

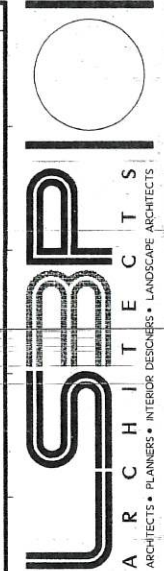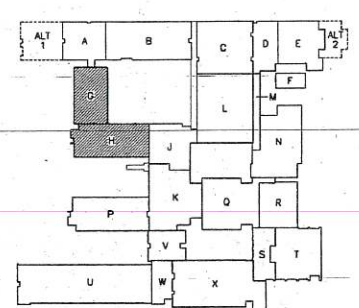


SUMMERVILLE HIGH SCHOOL
EXPANSION & RENOVATIONS
SUMMERVILLE, SOUTH CAROLINA

DATE
2-21-96
DRAWN
VINZANI
CHECKED
BAKER
REVISION

APPROVED
COMMISSION
94071.05
PARTIAL 1ST
FLOOR PLAN
AREAS G
& H
A104

Copyright © 1994
SFP Architects • 24 North Market Street • Charleston • SC • 29401 • 803-577-4444 • FAX 803-722-4789 • MEMBERS OF THE AMERICAN INSTITUTE OF ARCHITECTS • ALL RIGHTS RESERVED • DRAWINGS MAY NOT BE REPRODUCED IN ANY FORM WITHOUT WRITTEN PERMISSION

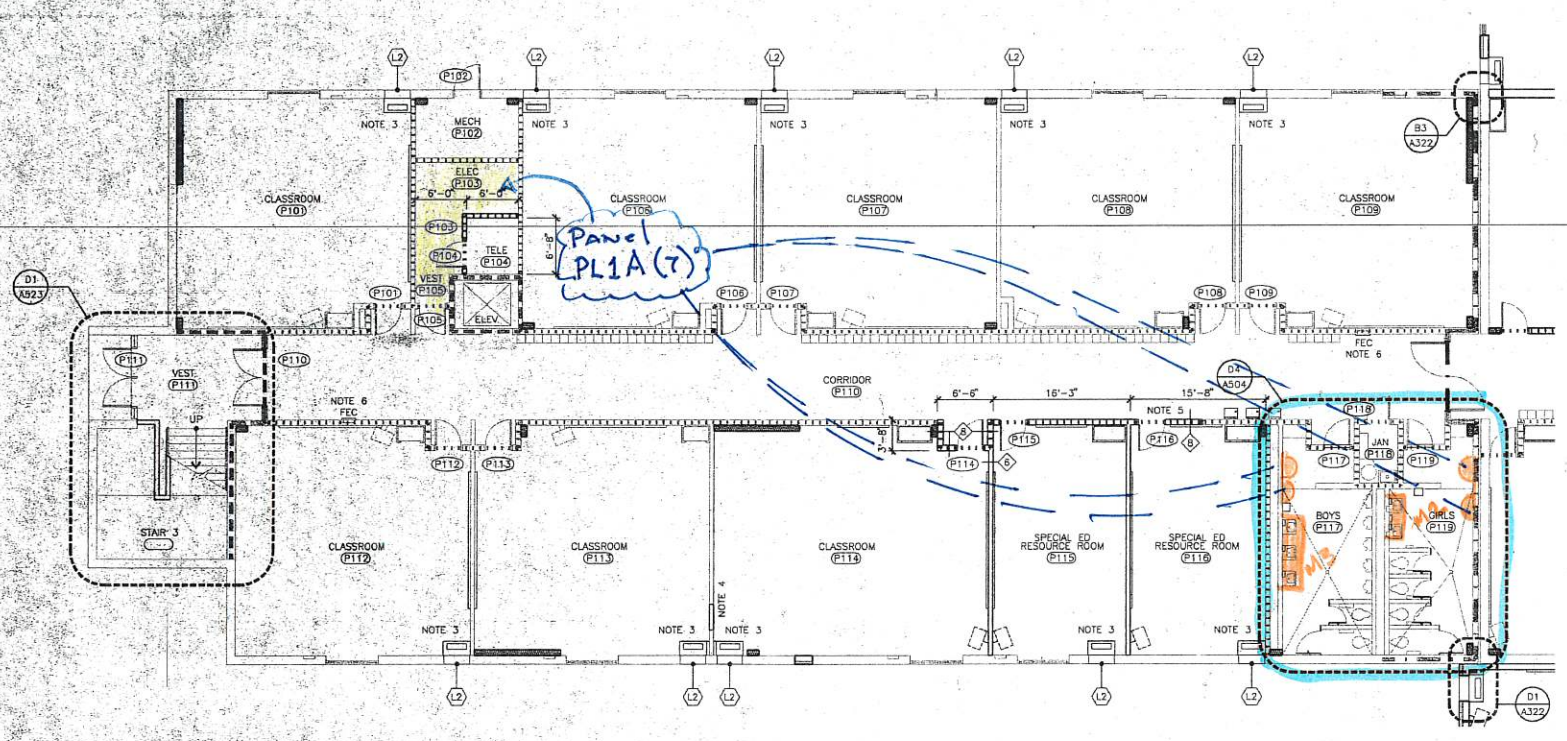


MATERIALS KEYING LEGEND

- LEGENDS
- EXISTING CONSTRUCTION
- NEW CONSTRUCTION
- NEW REINFORCED SEISMIC SUPPORTS
- WALL RATING LEGEND
- EXISTING 4 HOUR RATED WALL 8" CMU & 4" BRICK (UNO)
 - EXISTING 2 HOUR RATED WALL 8" CMU (UNO)
 - EXISTING 1 HOUR RATED WALL 8" CMU (UNO)
 - NEW 4 HOUR RATED WALL 8" CMU UL U 901 (UNO)
 - NEW 2 HOUR RATED WALL 8" CMU UL U 906 (UNO)
 - NEW 1 HOUR RATED WALL 8" CMU SIM UL U 906 (UNO)

- NOTES
- ALL NEW INTERIOR PARTITIONS SHALL BE PARTITION TYPE UNLESS NOTED OTHERWISE. SEE SHEET A001 FOR PARTITION TYPE LEGEND.
 - SEE SHEET A007 FOR LOCATION AND IDENTIFICATION OF CASEWORK, MARKERBOARDS, TACKBOARDS, LOCKERS, ETC.
 - NEW THRU-WALL MECHANICAL UNIT - SEE DETAIL H5/A321 FOR TYPICAL DIMENSIONS AND LOCATION IN REFERENCE TO EXISTING INTERIOR PARTITIONS. CUT NEW OPENING IN EXISTING EXTERIOR WALL TO ALIGN WITH EXISTING BRICK COURSING.
 - INFILL MASONRY OPENING TO MATCH EXISTING.
 - ALIGN NEW MASONRY WITH EDGE OF EXISTING MASONRY.
 - NEW FIRE EXTINGUISHER CABINETS TO BE LOCATED IN EXISTING WALL OPENINGS WHERE EVER POSSIBLE. MAINTAIN RATING BEHIND FIRE EXTINGUISHER CABINETS IN RATED WALLS.

KEY PLAN

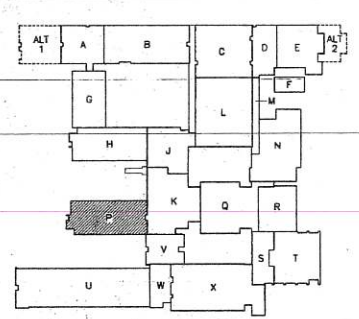


APPROVED
COMMISSION
94071.05

PARTIAL 1ST FLOOR PLAN
AREA P


A107

SUMMERVILLE HIGH SCHOOL
EXPANSION & RENOVATIONS
SUMMERVILLE, SOUTH CAROLINA

DATE
2-21-98
DRAWN
VINZANI
CHECKED
BAKER
REVISION

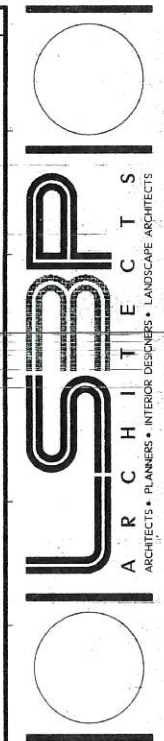


CSAP ARCHITECTS • 24 NORTH MARKET STREET • CHARLESTON • SC • 29401 • 803-577-4444 • FAX 803-722-4799 • MEMBERS OF THE AMERICAN INSTITUTE OF ARCHITECTS • ALL RIGHTS RESERVED • DRAWINGS MAY NOT BE REPRODUCED IN ANY FORM WITHOUT WRITTEN PERMISSION

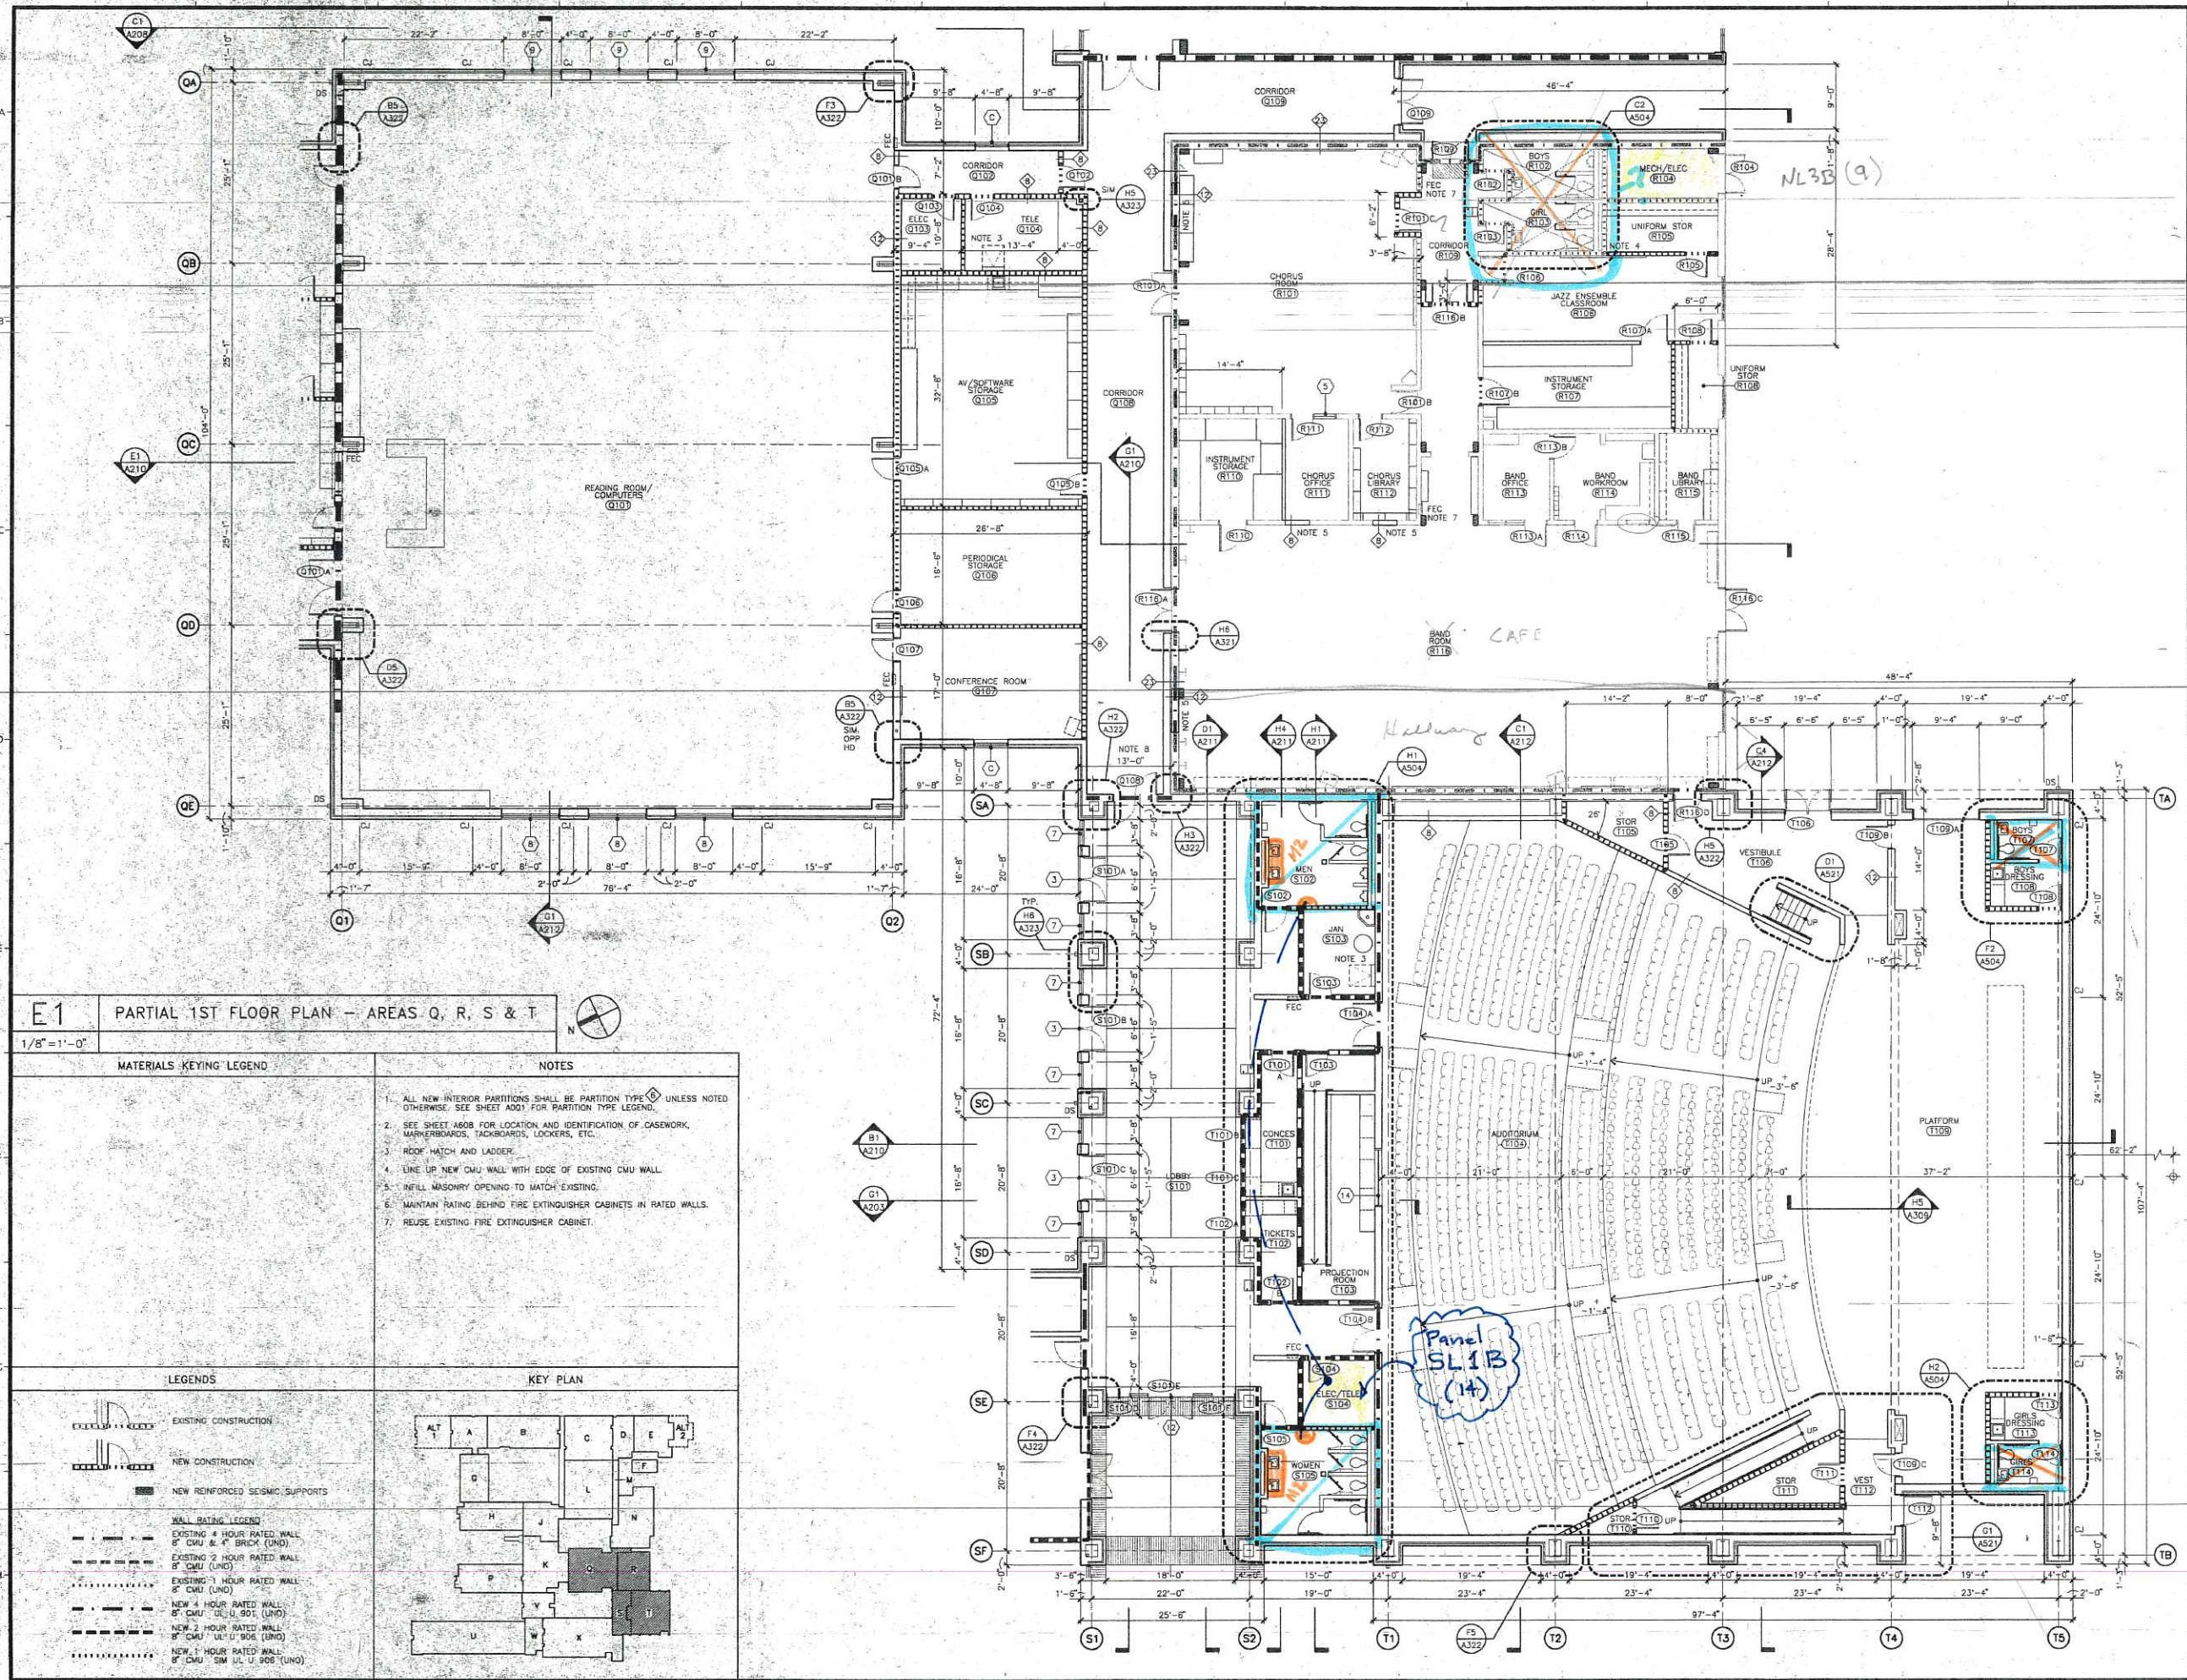

E1 PARTIAL 1ST FLOOR PLAN - AREAS Q, R, S & T
1/8" = 1'-0"

MATERIALS KEYING LEGEND		NOTES
		- ALL NEW INTERIOR PARTITIONS SHALL BE PARTITION TYPE 10 UNLESS NOTED OTHERWISE. SEE SHEET A001 FOR PARTITION TYPE LEGEND. - SEE SHEET A008 FOR LOCATION AND IDENTIFICATION OF CASEWORK, MARKERBOARDS, TACKBOARDS, LOCKERS, ETC. - ROOF HATCH AND LADDER. - LINE UP NEW CMU WALL WITH EDGE OF EXISTING CMU WALL. - INSTALL MASONRY OPENING TO MATCH EXISTING. - MAINTAIN RATING BEHIND FIRE EXTINGUISHER CABINETS IN RATED WALLS. - REUSE EXISTING FIRE EXTINGUISHER CABINET.
LEGENDS		KEY PLAN

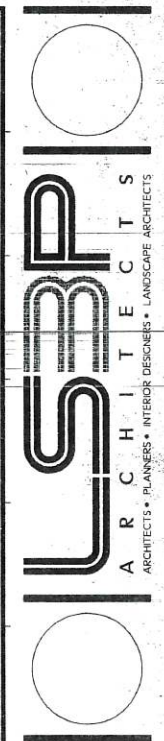

SUMMERVILLE HIGH SCHOOL
EXPANSION & RENOVATIONS
SUMMERVILLE, SOUTH CAROLINA

DATE
2-21-96
DRAWN
VINZANI
CHECKED
BAKER
REVISION

APPROVED
COMMISSION
94071.05
PARTIAL 1ST
FLOOR PLAN
AREAS Q,
R, S & T
A108


SUMMERVILLE HIGH SCHOOL
EXPANSION & RENOVATIONS
SUMMERVILLE, SOUTH CAROLINA

DATE
2-21-96
DRAWN
VINZANI
CHECKED
BAKER
REVISION

APPROVED
COMMISSION
94071.05

PARTIAL 1ST
FLOOR PLAN
AREAS V,
W & X

A110

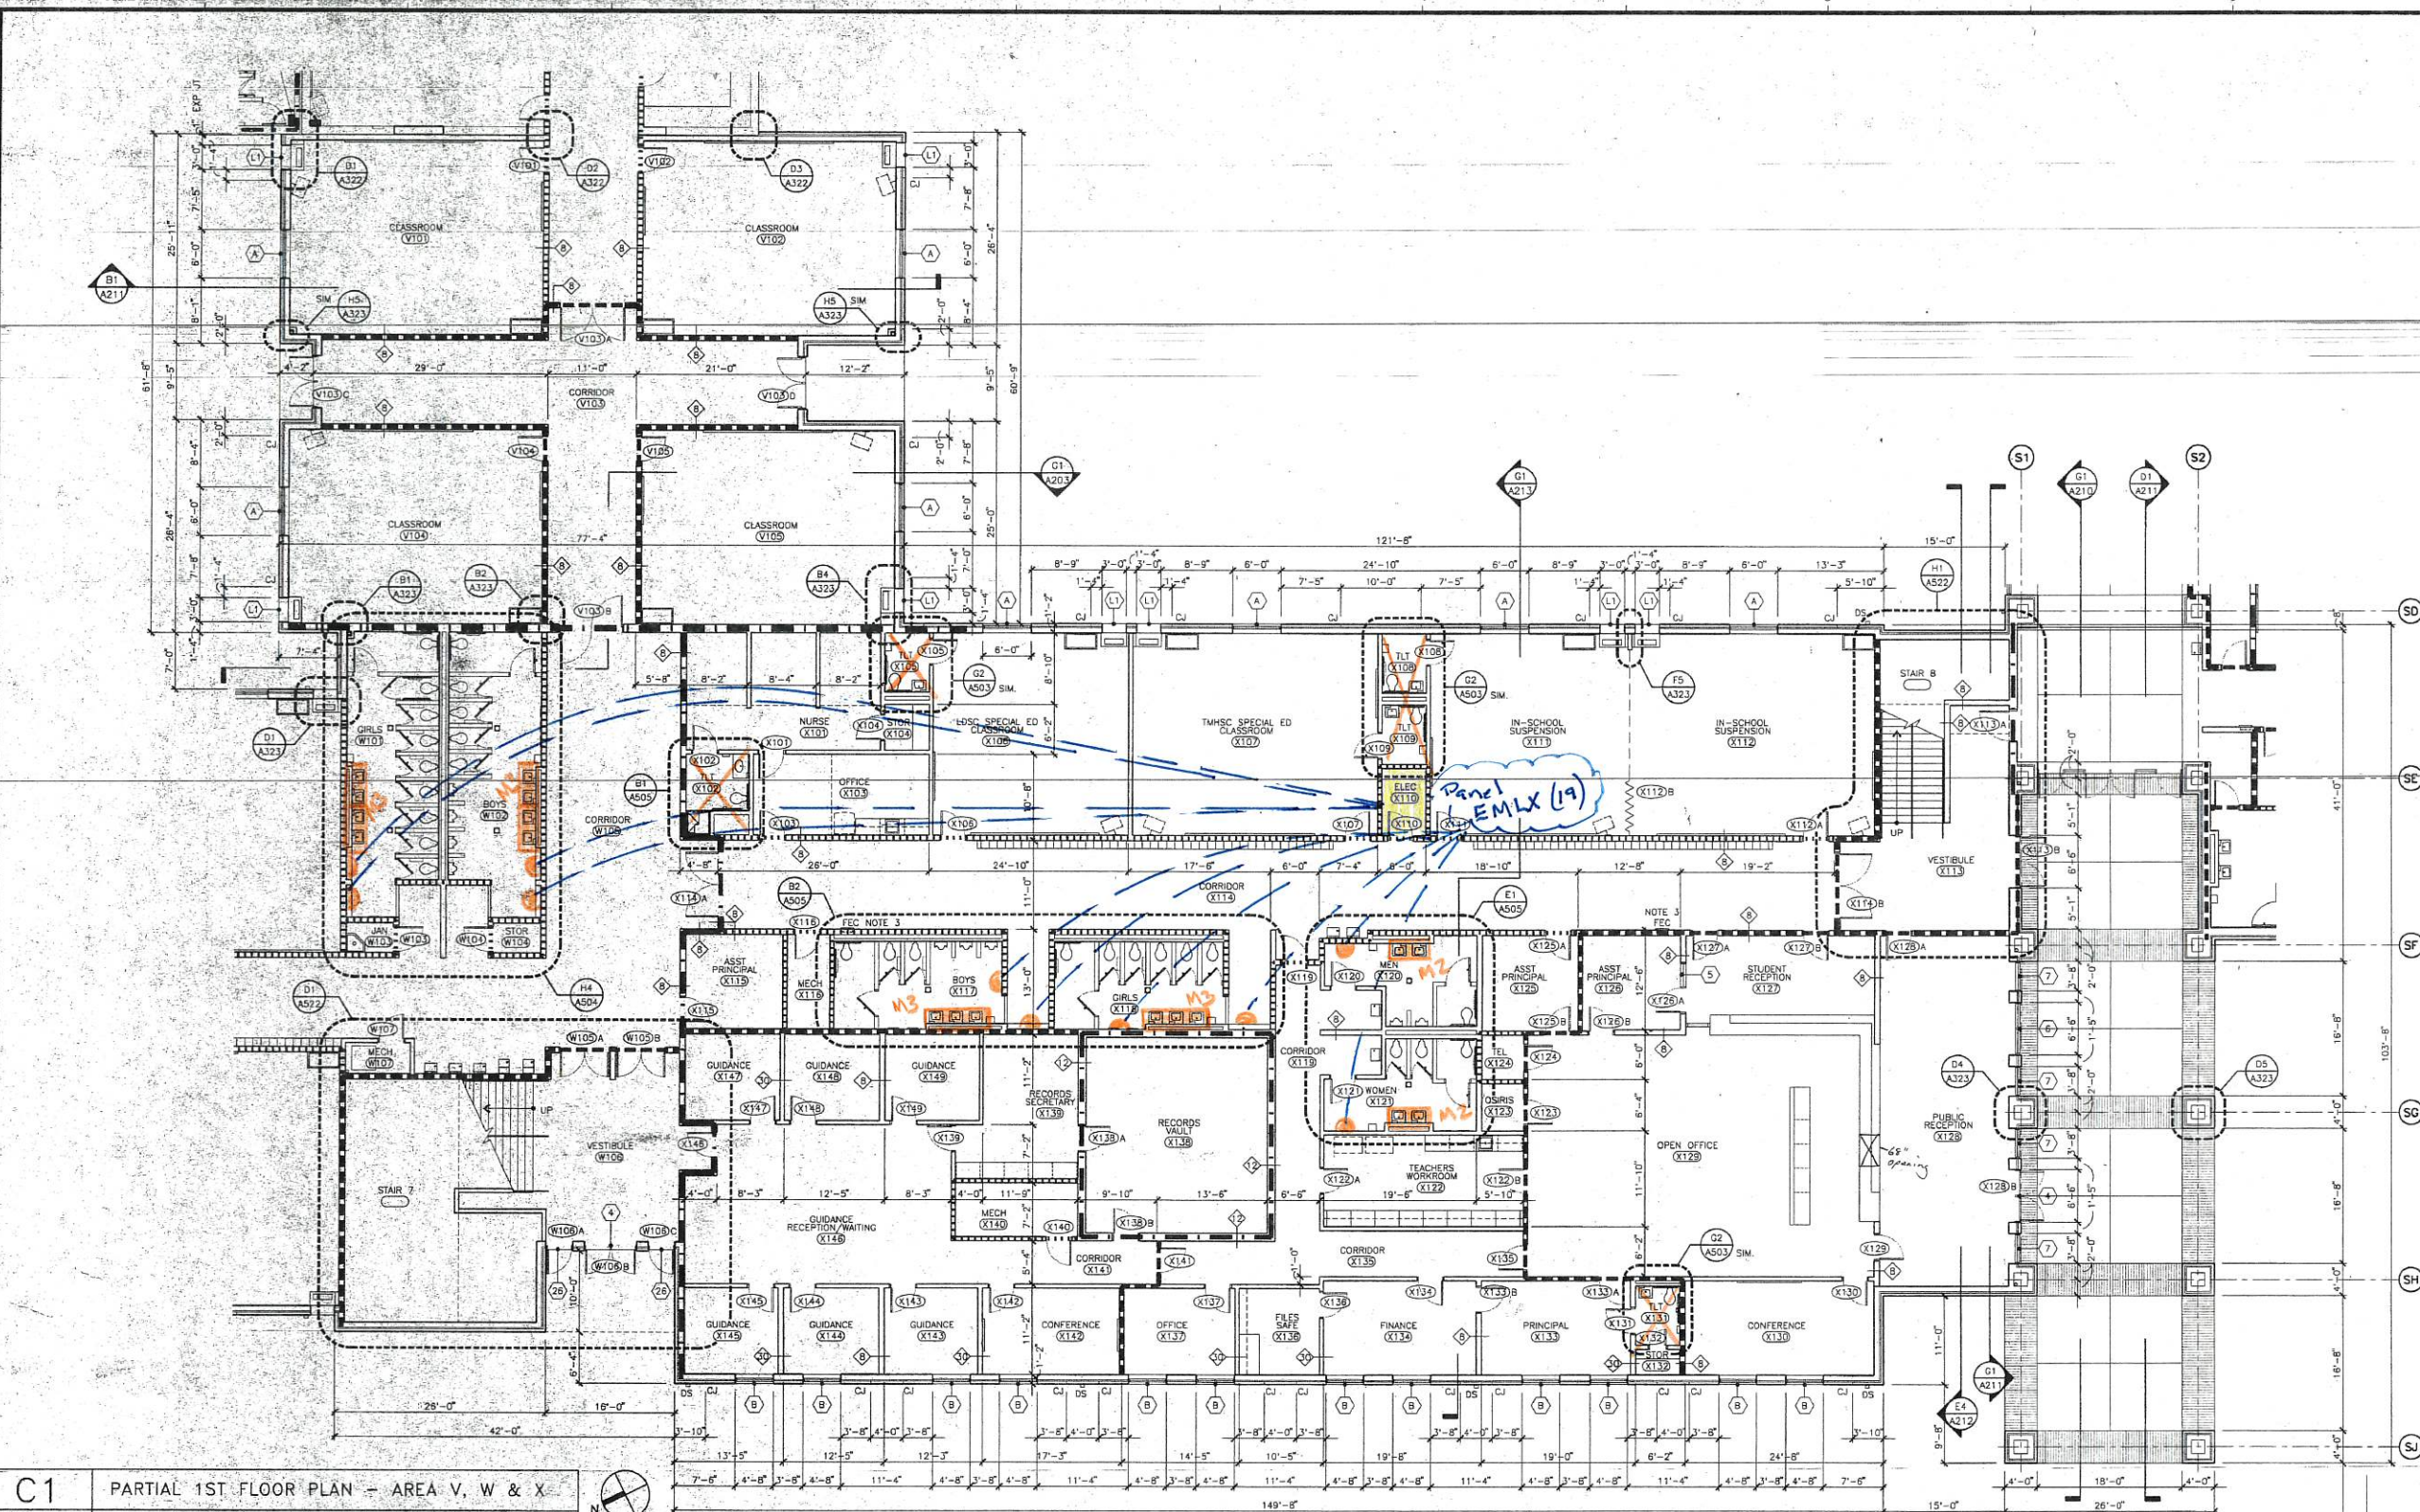


C1 PARTIAL 1ST FLOOR PLAN - AREA V, W & X

1/8" = 1'-0"

MATERIALS KEYING LEGEND

LEGENDS

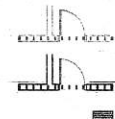


EXISTING CONSTRUCTION

NEW CONSTRUCTION

NEW REINFORCED SEISMIC SUPPORTS

WALL RATING LEGEND

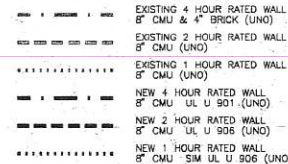

EXISTING 4 HOUR RATED WALL
8" CMU & 4" BRICK (UND)

EXISTING 2 HOUR RATED WALL
8" CMU (UND)

EXISTING 1 HOUR RATED WALL
8" CMU (UND)

NEW 4 HOUR RATED WALL
8" CMU UL U 901 (UND)


NEW 2 HOUR RATED WALL
8" CMU UL U 906 (UND)

NEW 1 HOUR RATED WALL
8" CMU SIM UL U 906 (UND)

NOTES

- ALL NEW INTERIOR PARTITIONS SHALL BE PARTITION TYPE 1 UNLESS NOTED OTHERWISE. SEE SHEET A001 FOR PARTITION TYPE LEGEND.
- SEE SHEET A510 FOR LOCATION AND IDENTIFICATION OF CASEWORK, MARKERBOARDS, TACKBOARDS, LOCKERS, ETC.
- MAINTAIN RATING BEHIND FIRE EXTINGUISHER CABINETS IN RATED WALLS.

KEY PLAN

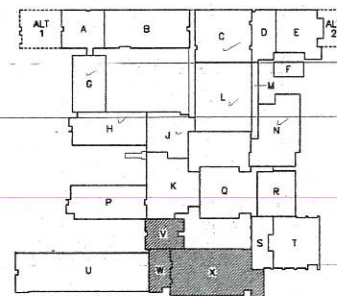

Copyright © 1994 LSP Architects • 24 North Market Street • Charleston, SC • 29401 • 803-577-4444 • FAX 803-722-4789 • MEMBERS OF THE AMERICAN INSTITUTE OF ARCHITECTS • ALL RIGHTS RESERVED • DRAWINGS MAY NOT BE REPRODUCED IN ANY FORM WITHOUT WRITTEN PERMISSION



H1 PARTIAL 2ND FLOOR PLAN - AREAS 2H & 2P
1/8" = 1'-0"




MATERIALS KEYING LEGEND

- LEGENDS
- EXISTING CONSTRUCTION
- NEW CONSTRUCTION
- NEW REINFORCED SEISMIC SUPPORTS
- WALL RATING LEGEND
- EXISTING 4 HOUR RATED WALL
8" CMU & 4" BRICK (UNO)
- EXISTING 2 HOUR RATED WALL
8" CMU (UNO)
- EXISTING 1 HOUR RATED WALL
8" CMU (UNO)
- NEW 4 HOUR RATED WALL
8" CMU UL U 901 (UNO)
- NEW 2 HOUR RATED WALL
8" CMU UL U 906 (UNO)
- NEW 1 HOUR RATED WALL
8" CMU SIM UL U 906 (UNO)

- NOTES
1. ALL NEW INTERIOR PARTITIONS SHALL BE PARTITION TYPE $\diamond$ UNLESS NOTED OTHERWISE. SEE SHEET A511 FOR PARTITION TYPE LEGEND.
 2. SEE SHEET A511 FOR LOCATION AND IDENTIFICATION OF CASEWORK, MARKERBOARDS, TACKBOARDS, LOCKERS, ETC.
 3. NEW THRU-WALL MECHANICAL UNIT - SEE DETAIL H5/A321 FOR TYPICAL DIMENSIONS AND LOCATION IN REFERENCE TO EXISTING INTERIOR PARTITIONS. CUT NEW OPENING IN EXISTING EXTERIOR WALL TO ALIGN WITH EXISTING BRICK COURSEING.
 4. FIRE SHUTTER.
 5. INFILL MASONRY OPENING TO MATCH EXISTING.
 6. NEW FIRE EXTINGUISHER CABINETS TO BE LOCATED IN EXISTING WALL OPENINGS WHERE EVER POSSIBLE. MAINTAIN RATING BEHIND FIRE EXTINGUISHER CABINETS IN RATED WALLS.
 7. REPAIR FRAME AND REGLAZE WINDOW TO MATCH EXISTING WHERE THROUGH WALL AIR CONDITIONER WAS REMOVED.
 8. AREA OF REFUGE.

KEY PLAN

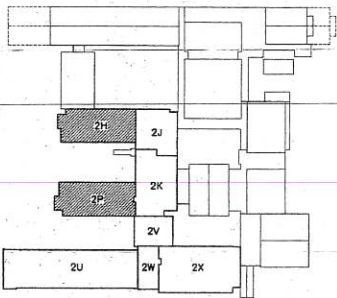

SUMMERVILLE HIGH SCHOOL
EXPANSION & RENOVATIONS
SUMMERVILLE, SOUTH CAROLINA

DATE
2-21-96
DRAWN
VINZANI
CHECKED
BAKER
REVISION


APPROVED
COMMISSION
94071.05

PARTIAL 2ND
FLOOR PLAN
AREAS 2H
& 2P

A111

LSP ARCHITECTS • 24 NORTH MARKET STREET • CHARLESTON • SC • 29401 • 803-577-4444 • FAX 803-722-4789 • MEMBERS OF THE AMERICAN INSTITUTE OF ARCHITECTS • ALL RIGHTS RESERVED • DRAWINGS MAY NOT BE REPRODUCED IN ANY FORM WITHOUT WRITTEN PERMISSION

COPYRIGHT © 1994

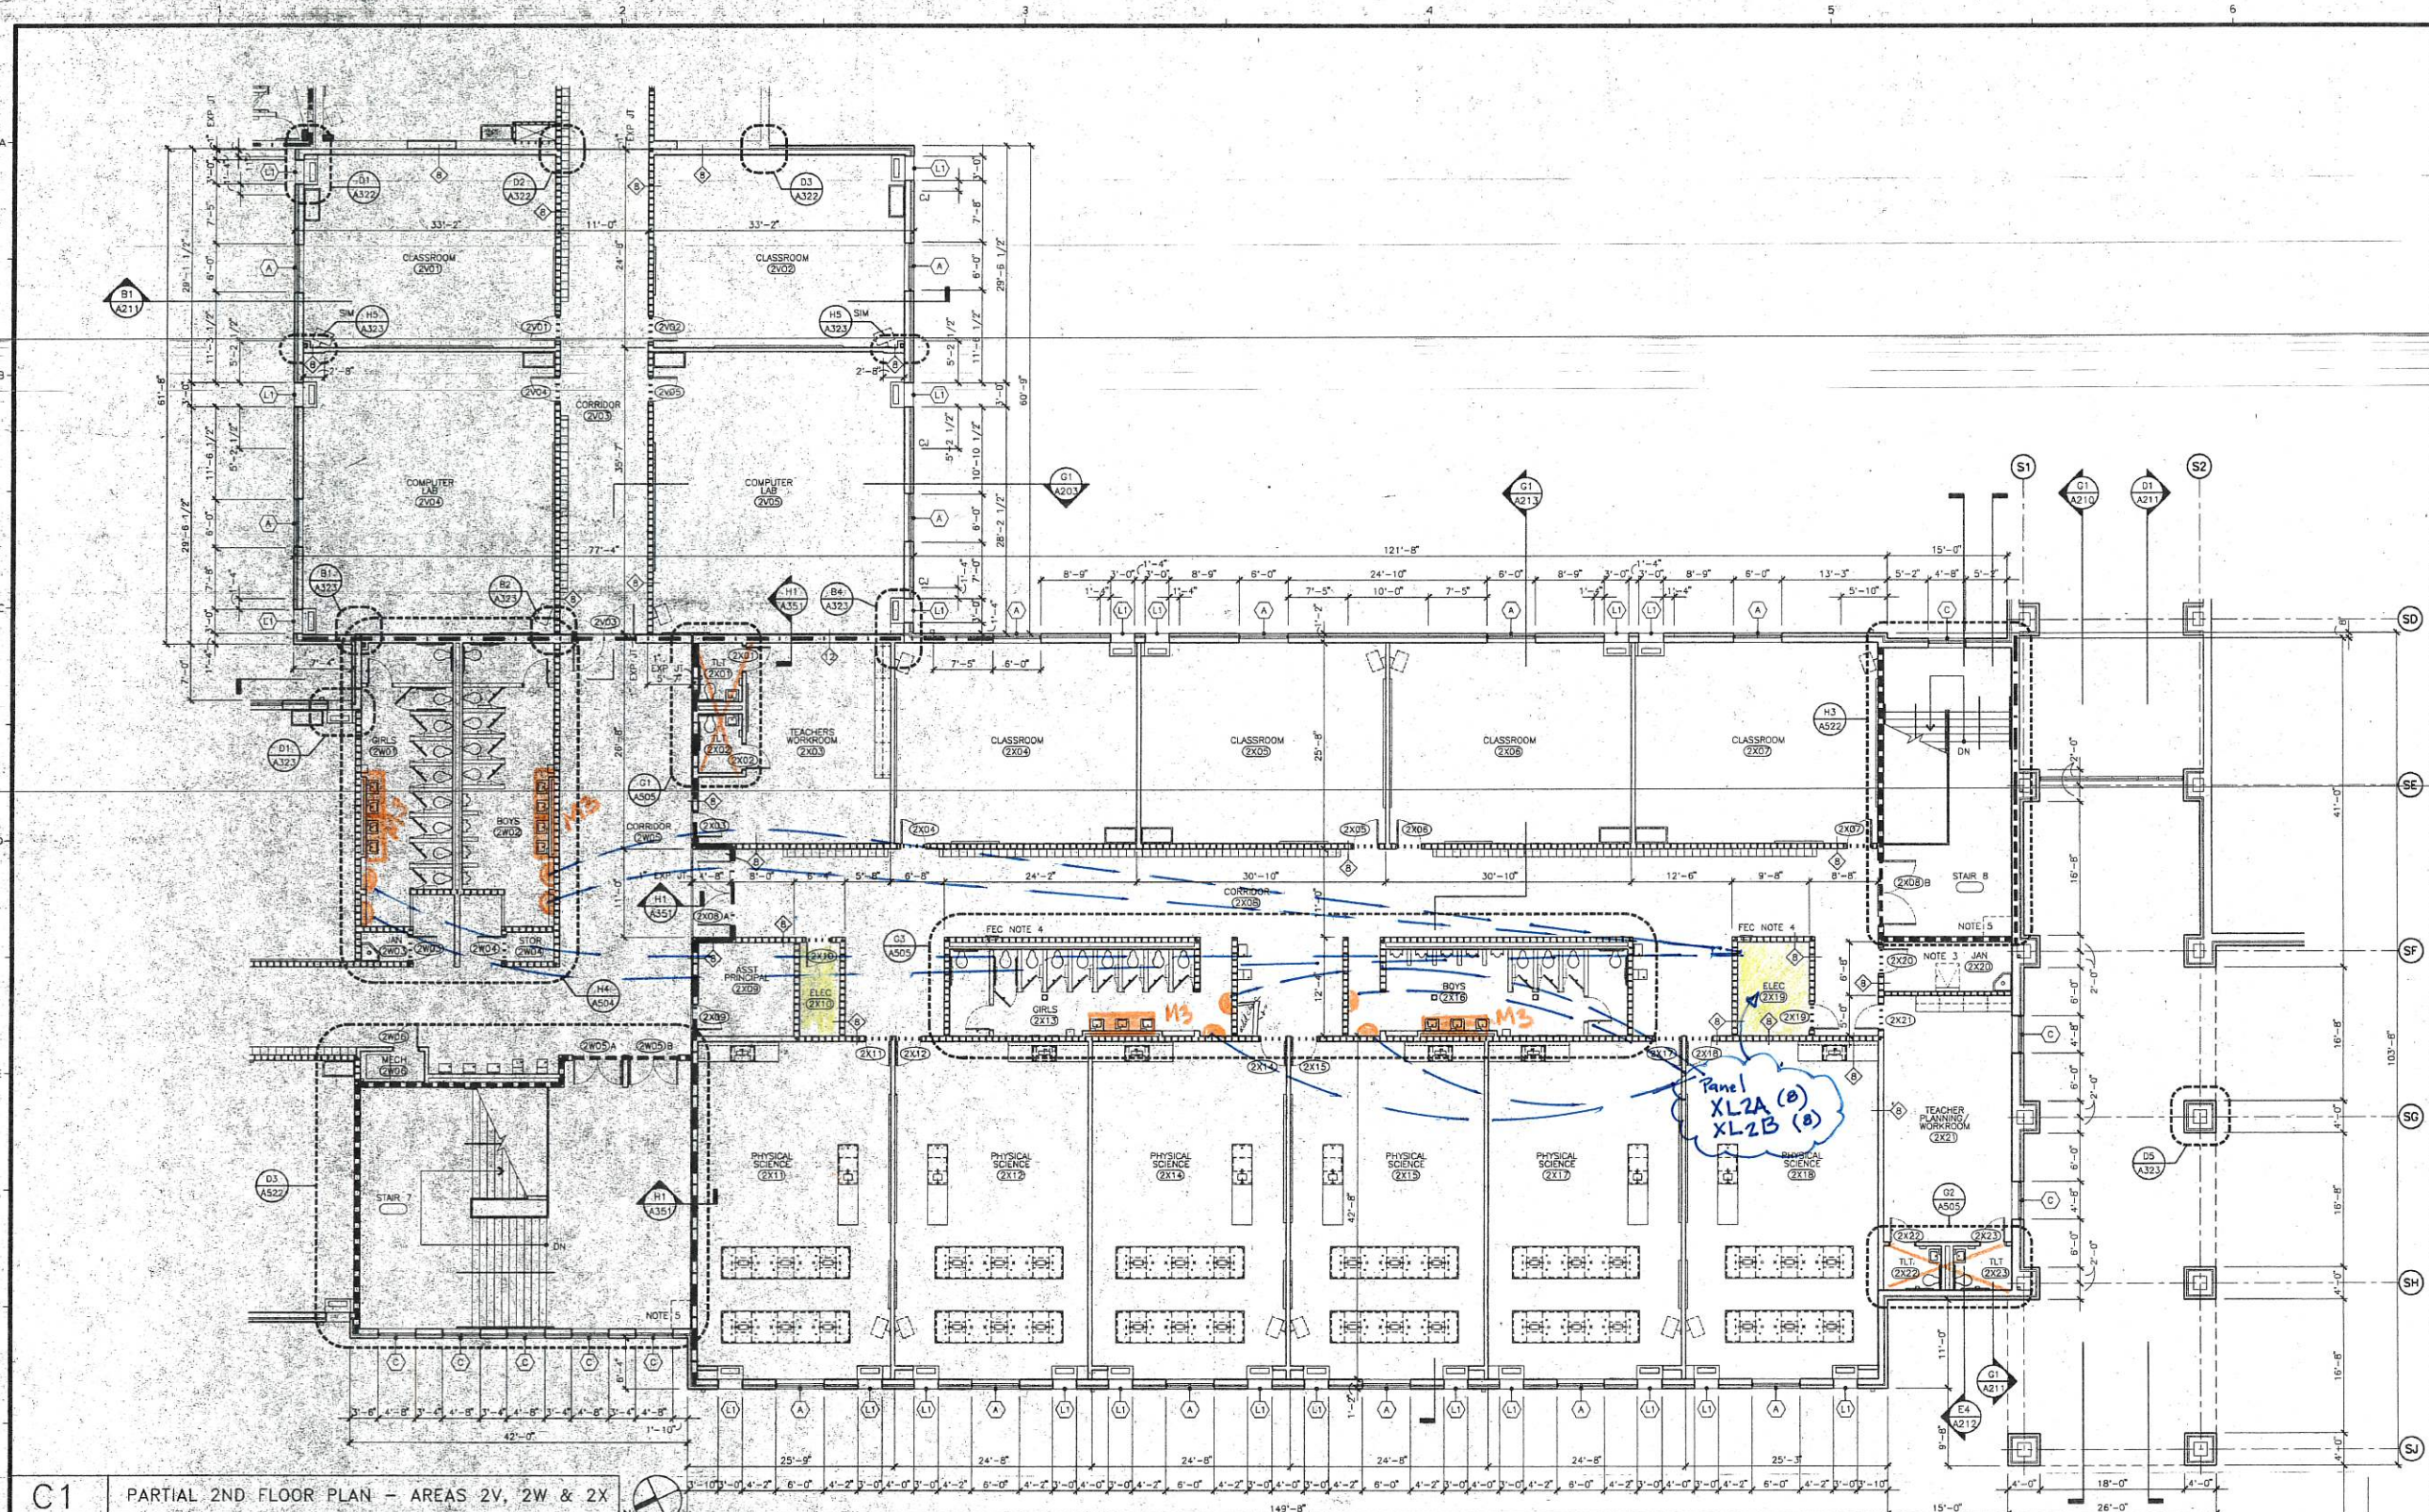

C1 PARTIAL 2ND FLOOR PLAN - AREAS 2V, 2W & 2X

1/8"=1'-0"

MATERIALS KEYING LEGEND		LEGENDS	NOTES	KEY PLAN
		EXISTING CONSTRUCTION NEW CONSTRUCTION NEW REINFORCED SEISMIC SUPPORTS WALL RATING LEGEND EXISTING 4 HOUR RATED WALL 8" CMU & 4" BRICK (UNO) EXISTING 2 HOUR RATED WALL 8" CMU (UNO) EXISTING 1 HOUR RATED WALL 8" CMU (UNO) NEW 4 HOUR RATED WALL 8" CMU UL U 901 (UNO) NEW 2 HOUR RATED WALL 8" CMU UL U 906 (UNO) NEW 1 HOUR RATED WALL 8" CMU SM UL U 906 (UNO)	1. ALL NEW INTERIOR PARTITIONS SHALL BE PARTITION TYPE ⑥ UNLESS NOTED OTHERWISE. SEE SHEET A001 FOR PARTITION TYPE LEGEND. 2. SEE SHEET A014 FOR LOCATION AND IDENTIFICATION OF CASEWORK, MARKERBOARDS, TACKBOARDS, LOCKERS, ETC. 3. ROOF-HATCH-AND-LADDER. 4. MAINTAIN RATING BEHIND FIRE EXTINGUISHER CABINETS IN RATED WALLS. 5. AREA OF REFUGE.	

ARCHITECTS • PLANNERS • INTERIOR DESIGNERS • LANDSCAPE ARCHITECTS

SUMMERVILLE HIGH SCHOOL
EXPANSION & RENOVATIONS
SUMMERVILLE, SOUTH CAROLINA

DATE
2-21-98
DRAWN
VINZANI
CHECKED
BAKER
REVISION

APPROVED
COMMISSION
94071.05

PARTIAL 2ND FLOOR PLAN
AREAS 2V,
2W & 2X

A114

LS3P ASSOCIATES LTD.
24 NORTH MARKET STREET SUITE 300
CHARLESTON, SOUTH CAROLINA 29401
TEL. 843.577.4444 FAX 843.722.4789
[HTTP://WWW.LS3P.COM](http://www.ls3p.com)

KEYNOTES

- ① PROVIDE CONNECTION TO FIRE ALARM SYSTEM FOR COILING DOOR.

Note:
THE HAND DYERS IN THIS
GROUP RESTROOM ARE EXIST!

MEMBERS OF THE AMERICAN INSTITUTE OF ARCHITECTS
COPYRIGHT 2000 ALL RIGHTS RESERVED
PRINTED OR ELECTRONIC DRAWINGS AND
DOCUMENTATION MAY NOT BE REPRODUCED
IN ANY FORM WITHOUT WRITTEN PERMISSION
FROM LS3P ASSOCIATES LTD.


REVISIONS:

PROJECT: 1201-000350
DATE: AUGUST 18, 2000
DRAWN BY: RAC
CHECKED BY: JTH

PARTIAL
FLOOR
PLAN
AREAS "Z" & "T"
SPECIAL SYSTEMS

E302

KEYPLA

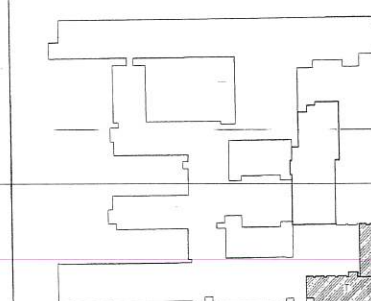

SOLUTIONS THROUGH LISTENING

SERVICE HYDRAULIC

H1	PARTIAL FLOOR PLAN - AREA "Z" - SPECIAL SYSTEMS
----	---

3/32"=1'-0"	E202
-------------	------