



VENTURA UNIFIED SCHOOL DISTRICT

STADIUM SCOREBOARD REPLACEMENT AT BUENA HIGH SCHOOL

BID # E8-24

September 16th, 2024

ADDENDUM #02

NOTICE TO BIDDERS:

The following revisions and/or clarifications shall be made to the bidding requirements and contract documents. Revise and amend the documents for the above-named project in accordance with this addendum. The bid shall reflect these addendum changes and each bidder shall refer in their bid to this addendum.

All bidding requirements and contract documents shall apply to this addendum as originally indicated in the applicable portions of the contract documents, unless otherwise modified by this addendum.

Contractors shall acknowledge this addendum at the space provided on the Bid Proposal.

REVISIONS, CLARIFICATIONS, & RESPONSES:

1. Please see attached Pre-Bid RFI Question and Answer Sheet dated 9/16/2024.
2. Please see attached RNT Addendum 2 Document dated 9/16/2024.

REVISIONS TO THE PLANS: AS1.0, AS1.1, EB-2.0

REVISIONS TO THE SPECIFICATIONS: Not Applicable

END OF ADDENDUM #1

Addendum: 1 pages


ENCLOSURES: 5 Pages

Total Number of Pages: 6

Buena HS E8-24 Scoreboard Pre-Bid RFI Log

Date: 09/16/2024

RFI #	Question	Response
1	Is the Contractor going to hand off the existing scoreboard to the District adjacent to its current location? Or is the Contractor expected to move it to another location on or off campus? Please provide this location.	Coordinate with District to move to offsite location within County of Ventura.
2	The Special Conditions state the Contractor must provide a hardcopy daily report before midnight each day. Can this be a digital report that is emailed considering it will be difficult to deliver a hardcopy after hours.	Yes, digital copies are acceptable.
3	Sheet SB0.2 Structural Note #15 states the steel is to be hot dip galvanized OR primed and painted. Please provide which finish the District wants for the steel.	District preference to paint per notes on SB0.2
4	Is the hardware (bolts, l brackets, etc) needed for installation included with the scoreboard?	The hardware for installation is included with the video board with the exception of the Unistrut, laterals and the l-beams. The bolts and brackets are included.
5	Under Special Conditions Note #19 there is a restriction on when we can perform "noisy" work. Other than jackhammering what is considered noisy work? If heavy equipment operating and compaction are considered noisy, this will severely impede the timely progress of the job.	All work including jackhammering and compaction is approved during working hours. Work location is far enough from classroom activities.
6	What is the minimum acceptable cure time for the concrete footings before we can install the new scoreboard?	72 hours and 70% of design strength
7	Is this project subject to PLA or CWA?	No.
8	What is the engineer's estimate for this project?	No engineer estimate at this time.
9	Instead of a rented container for the storage of the new scoreboard, is it acceptable to keep the scoreboard in its original packaging within the Contractor's fenced in staging area?	No, storage container is required for protection against vandalism and weather.
10	Sheet AS1.2 shows the expansion foam ~4.5' deep on the side of the retaining wall. Is it acceptable to place the expansion foam only along the top 4" where the footing will meet asphalt?	Place the expansion joint at the retained height ~4.5ft to prevent surcharge of the scoreboard pier on the retaining wall.
11	The electrical trenching shows a buried path adjacent to the district maintenance office which has many obstacles in the way (another pedestal, A/C unit). Is it acceptable to run conduits along the wall of the building to avoid these obstructions?	Acceptable by District. RNT to provide updated plans.
12	The scoreboard bonding detail shows the grounding rod in between the two scoreboard columns which will require additional AC demo. Is it acceptable to ground just to one of the footings?	Price to provide grounding per plan, including any required demolition and patchback.
13	Given the fact that football season would be over (or very close to finished) by the time construction starts - would the district consider increasing the contract duration from 32 days, to 90 days? We feel this project would require more time due to time it takes for DSA requirements such as concrete cure time for the footings, and various additional DSA inspections prior to construction such material ID, fabrication inspections. We feel that DSA inspections, and overall scope of the project would present a challenge to meet a 32 day deadline.	We do recognize that DSA projects require additional testing and requirements that can be a factor with project timelines. We feel comfortable with this timeline given the scope of the work. If the contractor encounters unforeseen conditions, lab testing delays or conflict with athletics that cause delays we will take that into consideration and provide an extension if the contractor has shown the ability follow the project schedule.
14	Referring to the planset provided, there is no current information regarding wiring for the communication for the scoreboard. How will this be controlled? Will it be wireless? If it is not wireless and requires wiring, it appears that the per plan pathway is not complete? Has this pathway been verified as being adequate from the groundbox to the press box?	The 24' x 4' strip scoreboard will run wirelessly from the pressbox with our W-7 controller. The strip scoreboard will have a receiver attached and run that way. The video will and sound will run from fiber optic cable. Your team will need to install a conduit run from the board to the point of use...which we will assume is the pressbox. Your team is also responsible for power at the board.

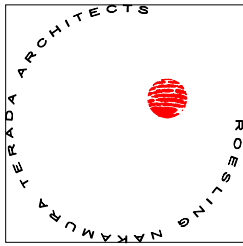

ADDENDUM TO BID DOCUMENTS

Ventura Union School District

Buena High School Scoreboard:

Bid Addendum 2

DATE: September 16, 2024

NOTE: ALL PLANS, SPECIFICATIONS AND CONTRACT DOCUMENTS REMAIN UNCHANGED EXCEPT SECTIONS OR PARTS ADDED TO, REVISED, DELETED OR CLARIFIED BY THIS ADDENDUM.

THIS ADDENDUM CONSISTS OF (9) ITEMS. THE PURPOSE OF THIS ADDENDUM IS TO RECORD THE REVISIONS TO THE DSA APPROVED PLANS. NOTE THAT ALL THE ITEMS WERE INCORPORATED INTO THE CONTRACT DOCUMENTS.

Addendum 2 Sheet total:

Drawing sheets – 3

CHANGES TO DRAWINGS

ARCHITECTURAL


- Item 1.** AS-1.0: Rerouted trench for electrical conduit & added section of wall mounted conduit to existing maintenance building.
- Item 2.** AS-1.0: Added keynote 26-01.
- Item 3.** AS-1.0: Added new pullbox and keynote 26-02.
- Item 4.** AS-1.0: Added dim. note on asphalt area.
- Item 5.** AS-1.0: Updated trenching note on Legend.
- Item 6.** AS-1.1: Added detail 16.
- Item 7.** AS-1.1: Updated keynote 02-01.

ELECTRICAL

- Item 8.** EB-2.0: Rerouted trench for electrical conduit & added section of wall mounted conduit to existing maintenance building.
- Item 9.** EB-2.0: Added new pullbox.

END OF ADDENDUM 2

BM 360/1016 - VUSD Scoreboard ReplacementBuena High School Stadium Scoreboard Replacement.rvt
All ideas, arrangements and plans indicated or represented by this drawing are owned by, and the property of, Roesling Nakamura Terada Architects, Inc. and were created, evolved, and developed for use on and in connection with the project. None of such ideas, arrangements, or plans shall be used by or disclosed to any person, firm, or corporation for any purpose whatsoever without the written permission of Roesling Nakamura Terada Architects, Inc. Filing of these drawings or applications with any public agency is not a publication of same. No reproduction is therefore permissible without the written consent of RNT.

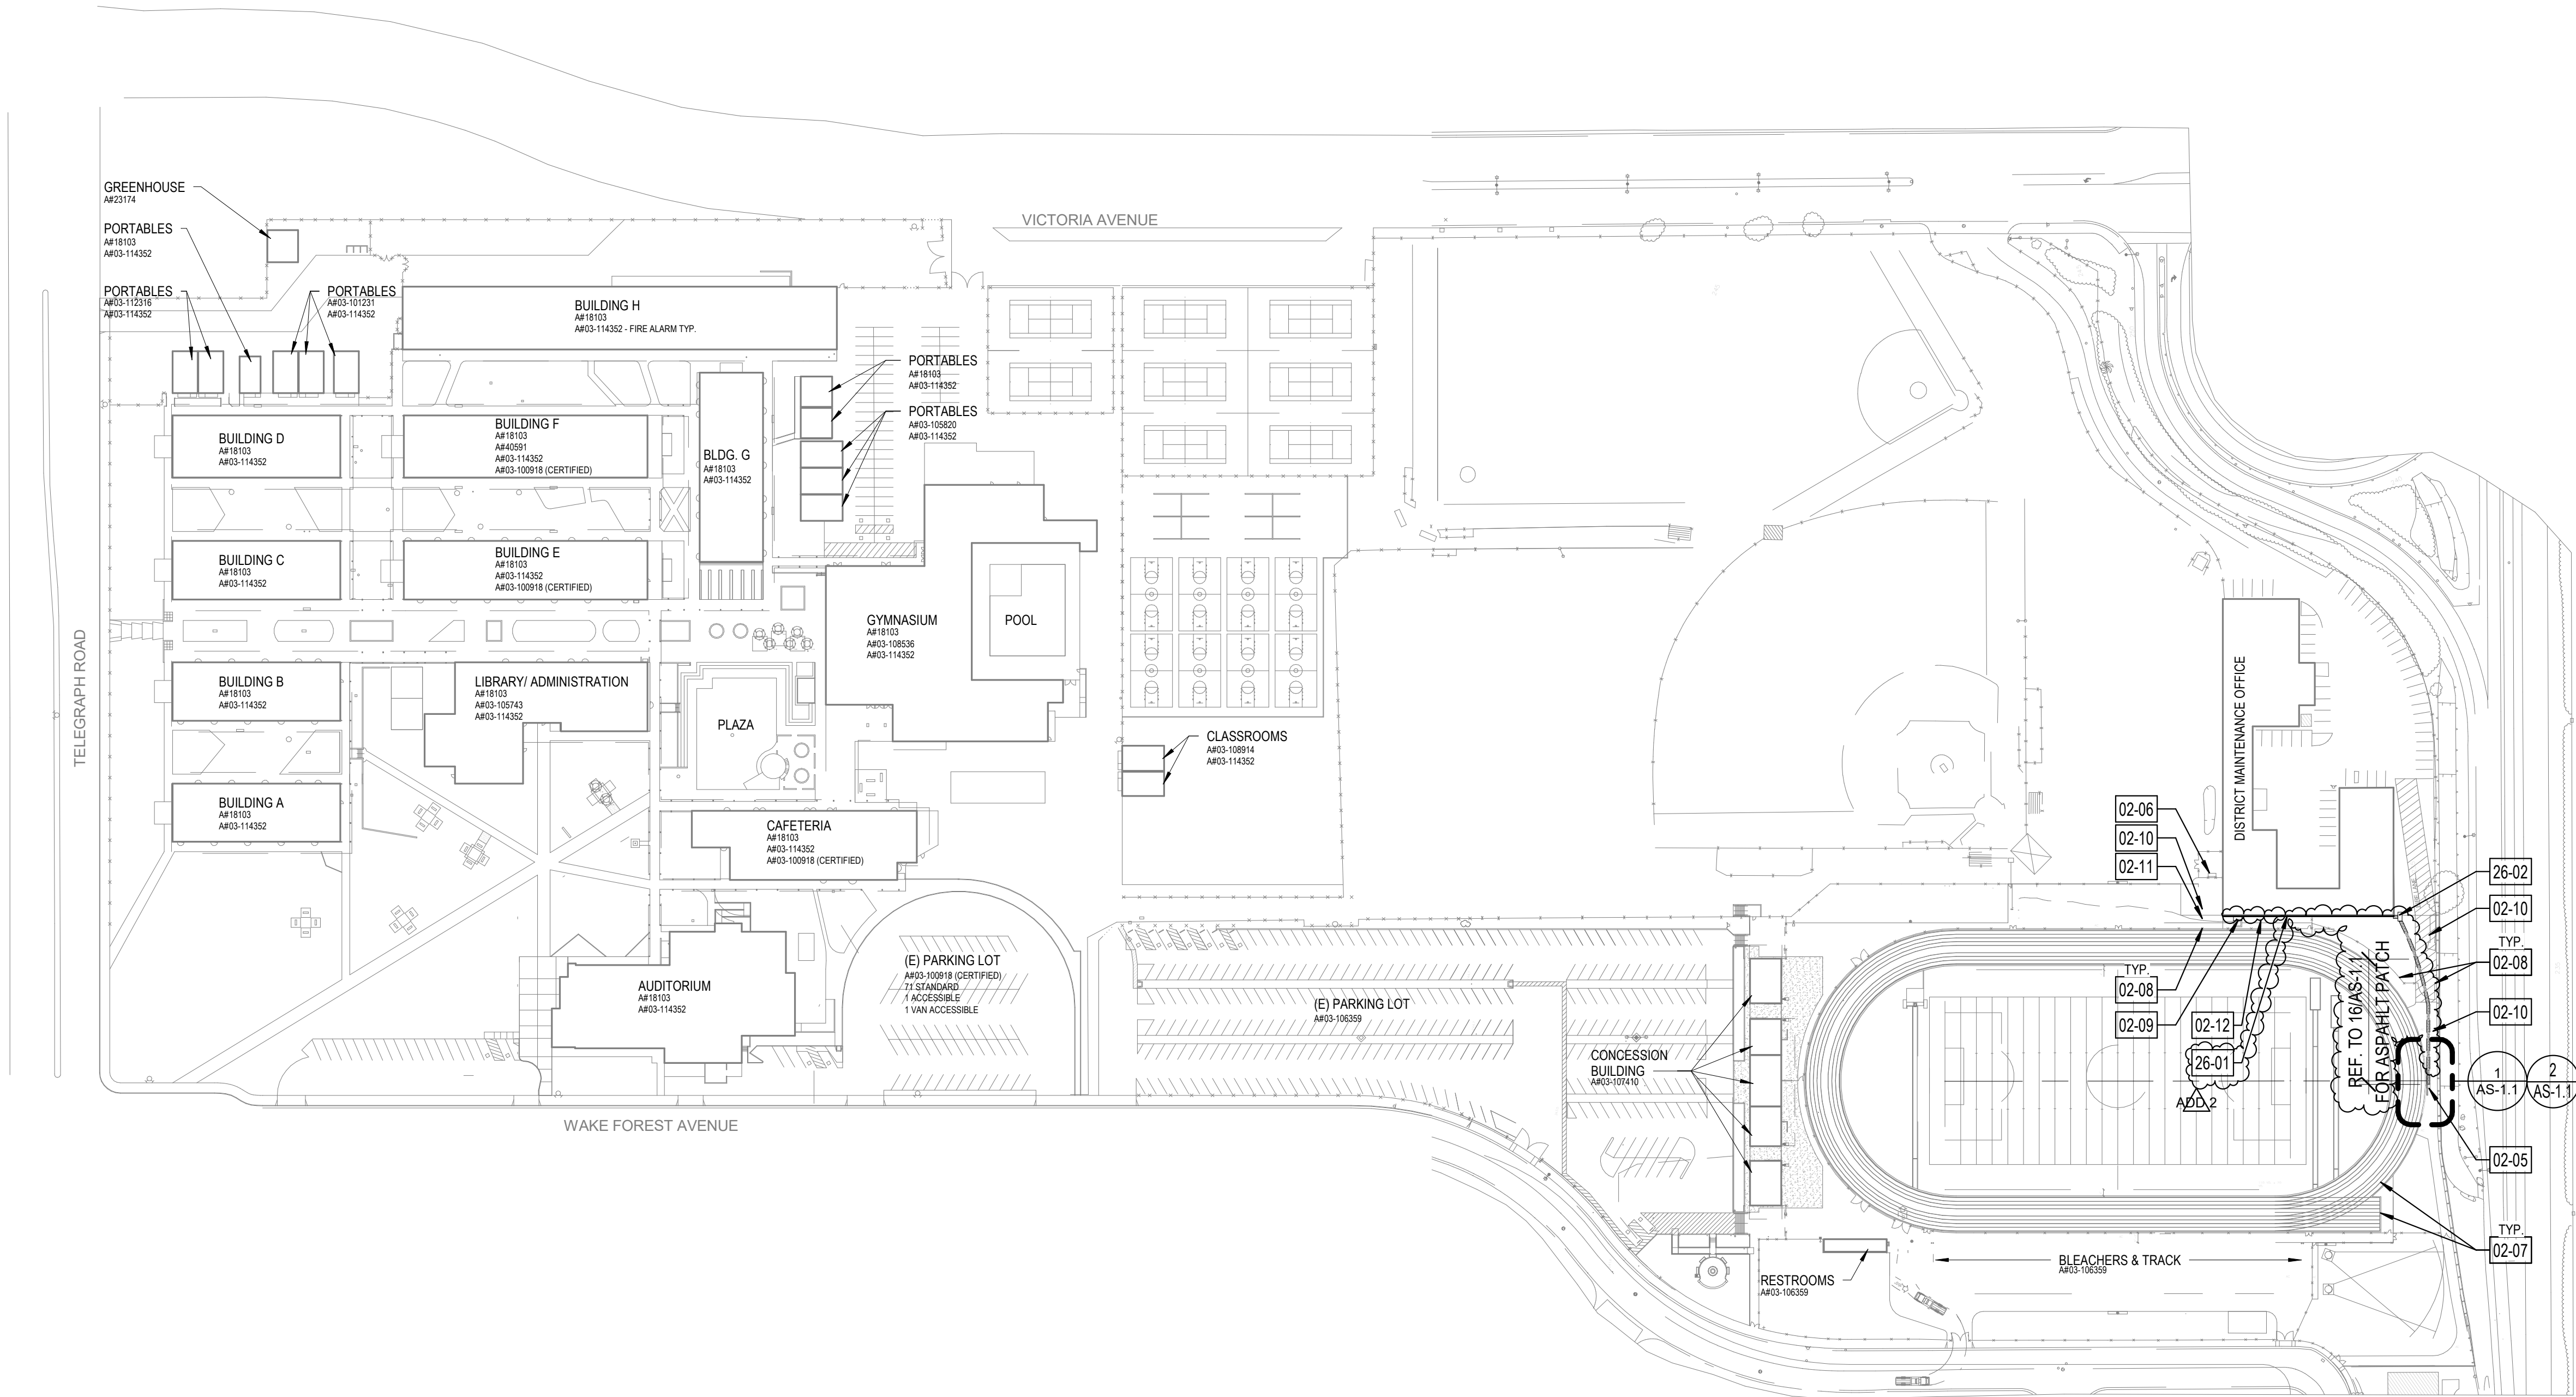

① OVERALL SITE PLAN
1" = 100'-0"

GENERAL NOTES

1. CONTRACTOR SHALL NOTIFY DIG ALERT (1-800-422-4133) AT LEAST (2) DAYS PRIOR TO STARTING WORK AND SHALL COORDINATE ALL WORK WITH UTILITY COMPANIES.
2. THE CONTRACTOR SHALL LOCATE EXISTING ELECTRICAL, FIRE WATER, WATER, IRRIGATION, SEWER & STORM WATER WITHIN PROJECT BOUNDARIES AND ADVISE AS TO FEASIBILITY OF RELOCATION AND/OR REMOVAL.
3. ALL ITEMS ARE CONSIDERED NEW UNLESS NOTED AS (E) EXISTING.
4. IF SHEET IS LESS THAN 24"x36" IT IS A REDUCED PRINT SCALED REDUCED ACCORDINGLY.
5. ITEMS MARKED (E) ARE TO REMAIN AND BE PROTECTED IN PLACE.
6. CONTRACTOR TO PROTECT ALL EXISTING TURF, TRACK, CONCRETE AND ASPHALT DURING SCOREBOARD DELIVERY AND DURING CONSTRUCTION.

LEGEND

- EXISTING BUILDING
- TRENCH. SEE ELECTRICAL DRAWINGS. REMOVE, DISPOSE AND REPLACE (E) PORTION OF ASPHALT (LANDSCAPE OR CONCRETE PAVEMENT WHERE OCCURS) MATCH ADJACENT SURFACES. REFER TO DETAILS 16 & 17 / AS-1.1 FOR ASPHALT PATCHBACK DETAIL.


KEYNOTE LIST

- 02-05 (E) FLUSH PULLBOX, REFER TO EB-2.0 FOR ADD'L INFO.
02-06 (E) DISTRIBUTION PANEL, REFER TO EB-2.0 FOR ADD'L INFO.
02-07 PROTECT IN PLACE (E) TRACK
02-08 PROTECT IN PLACE (E) CHAIN LINK FENCE
02-09 PROTECT IN PLACE (E) EQUIPMENT, VERIFY LOCATION IN FIELD.
02-10 (E) ASPHALT
02-11 (E) CONCRETE
02-12 (E) HARDSCAPE
26-01 SURFACE MOUNTED CONDUIT, REFER EB-2.0 FOR CONDUIT LOCATION.
26-02 NEW PULLBOX, REFER EB-2.0 FOR ADDITIONAL DETAILS.



Roesling Nakamura
Terada Architects

285 N Ventura Ave #102
Ventura, CA 93001
P805.626.5330
F805.626.5330
www.RNTarchitects.com

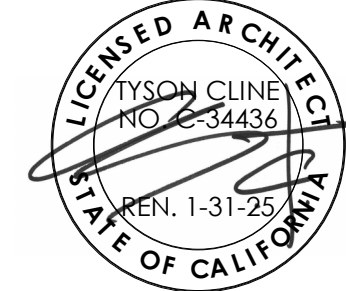

VENTURA
UNIFIED
SCHOOL
DISTRICT

BUENA HIGH
SCHOOL
STADIUM
SCOREBOARD
REPLACEMENT

5670 TELEGRAPH RD,
VENTURA, CA 93003

No.	Description	Date
ADD 2	BID ADDENDUM 2	9/16/2024


Sheet Name

OVERALL
SITE PLAN


RNT Project No. 241016
Date 09/16/2024
Drawn by CLD
Checked by CS
Sheet Number

AS-1.0



BM 360/1016 - VUSD Scoreboard ReplacementBuena High School Stadium Scoreboard Replacement.rvt
All ideas, arrangements and plans indicated or represented by this drawing are owned by, and the property of, Roesling Nakamura Terada Architects, Inc. and were created, evolved, and developed for use on and in connection with the project. None of such ideas, arrangements, or plans shall be used by or disclosed to any other person, firm, or corporation without the written permission of Roesling Nakamura Terada Architects, Inc. Filing of these drawings or applications with any public agency is not a publication of same. No reproduction is therefore permissible without the written consent of RNT.

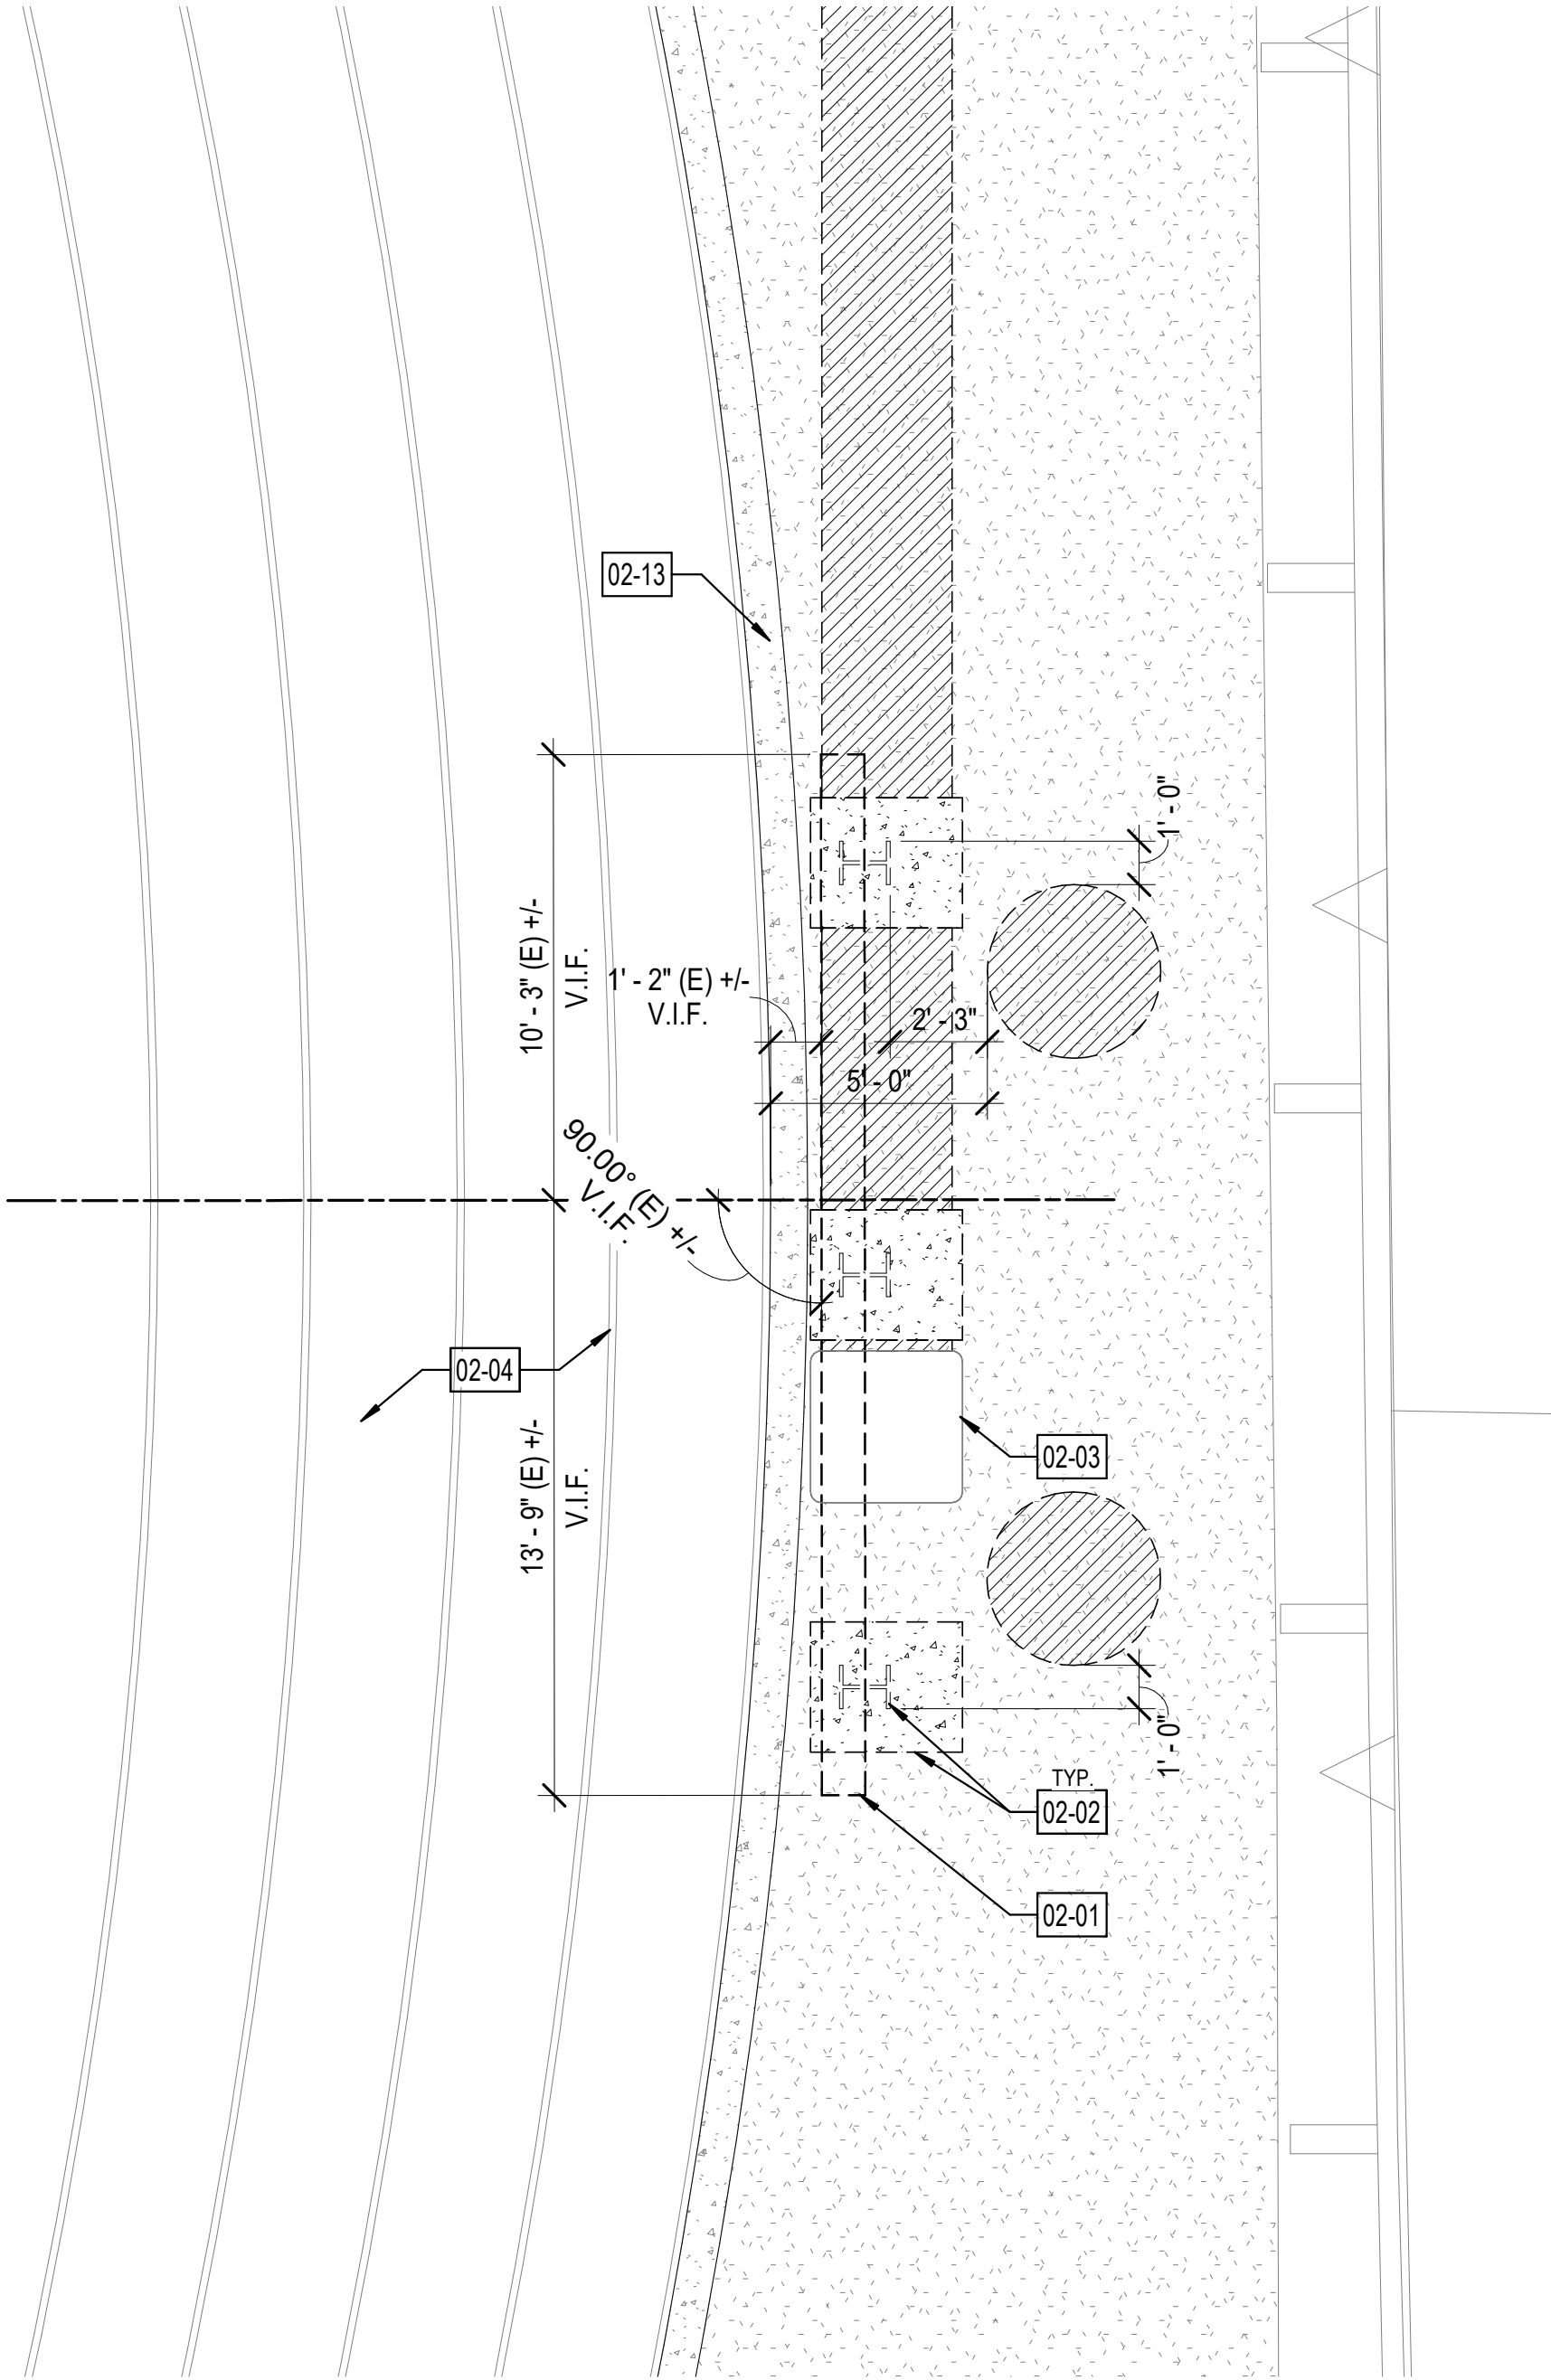

1 DEMOLITION FLOOR PLAN
1/4" = 1'-0"

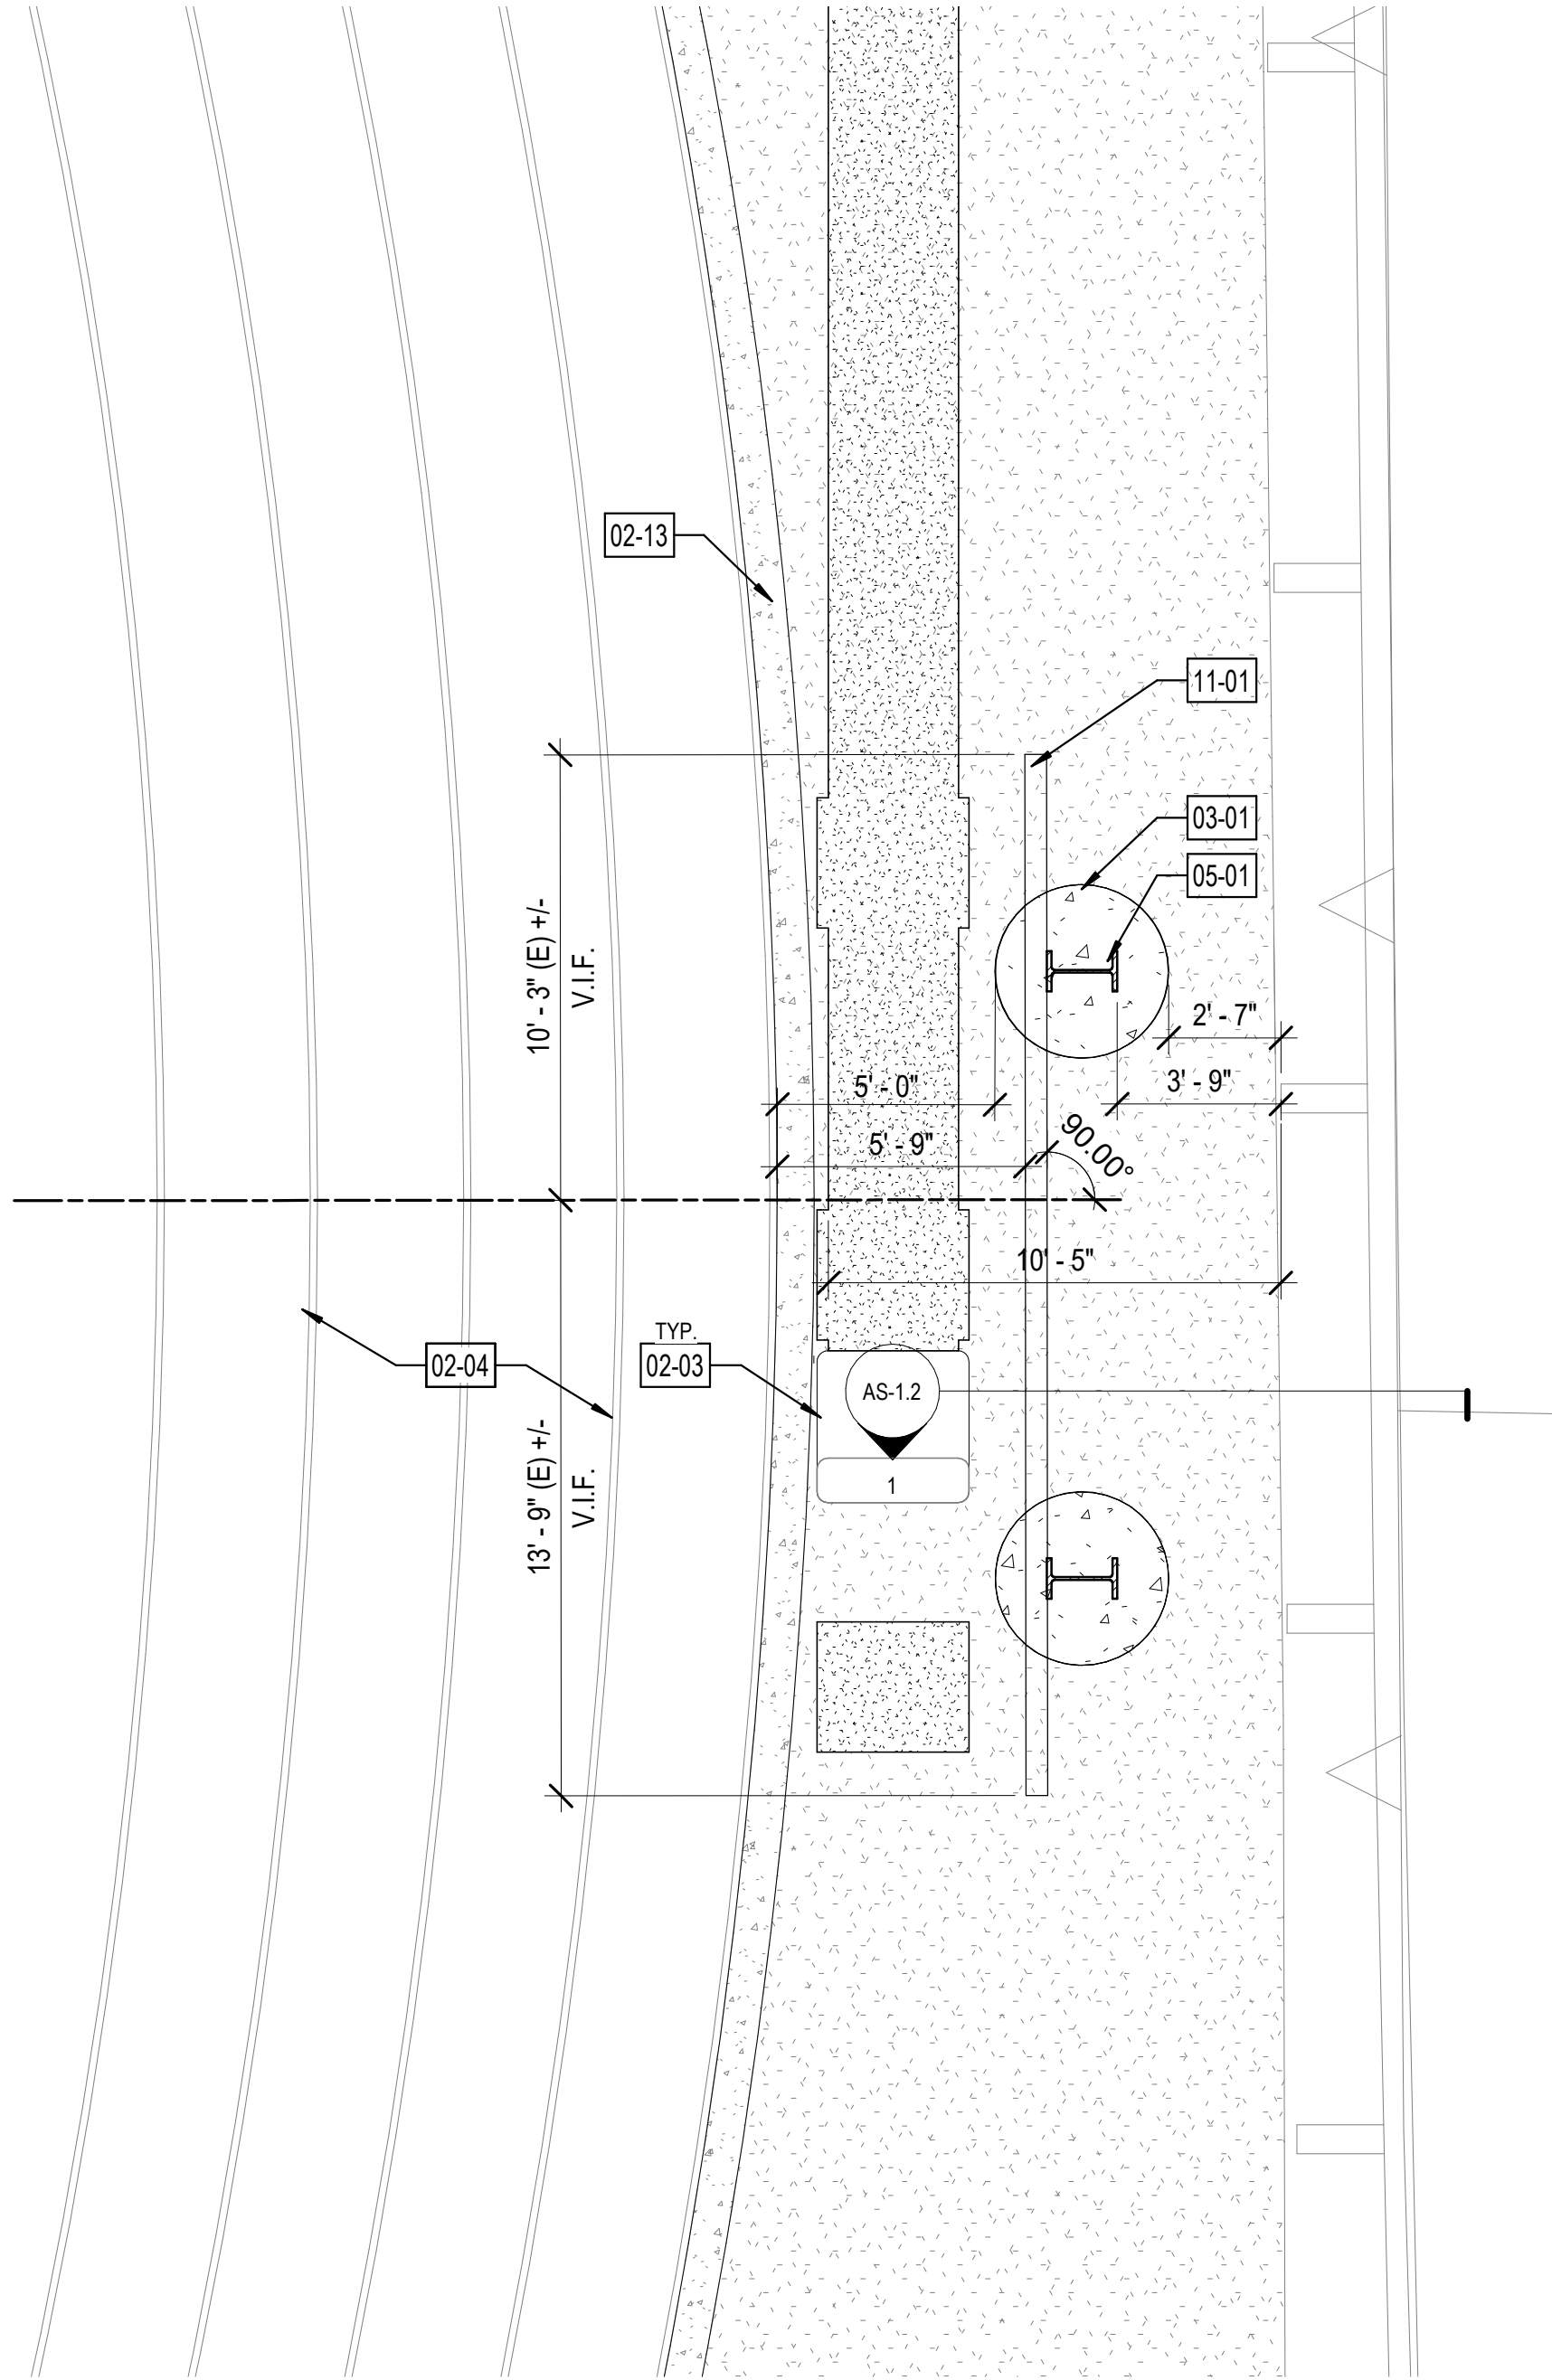

2 FLOOR PLAN
1/4" = 1'-0"

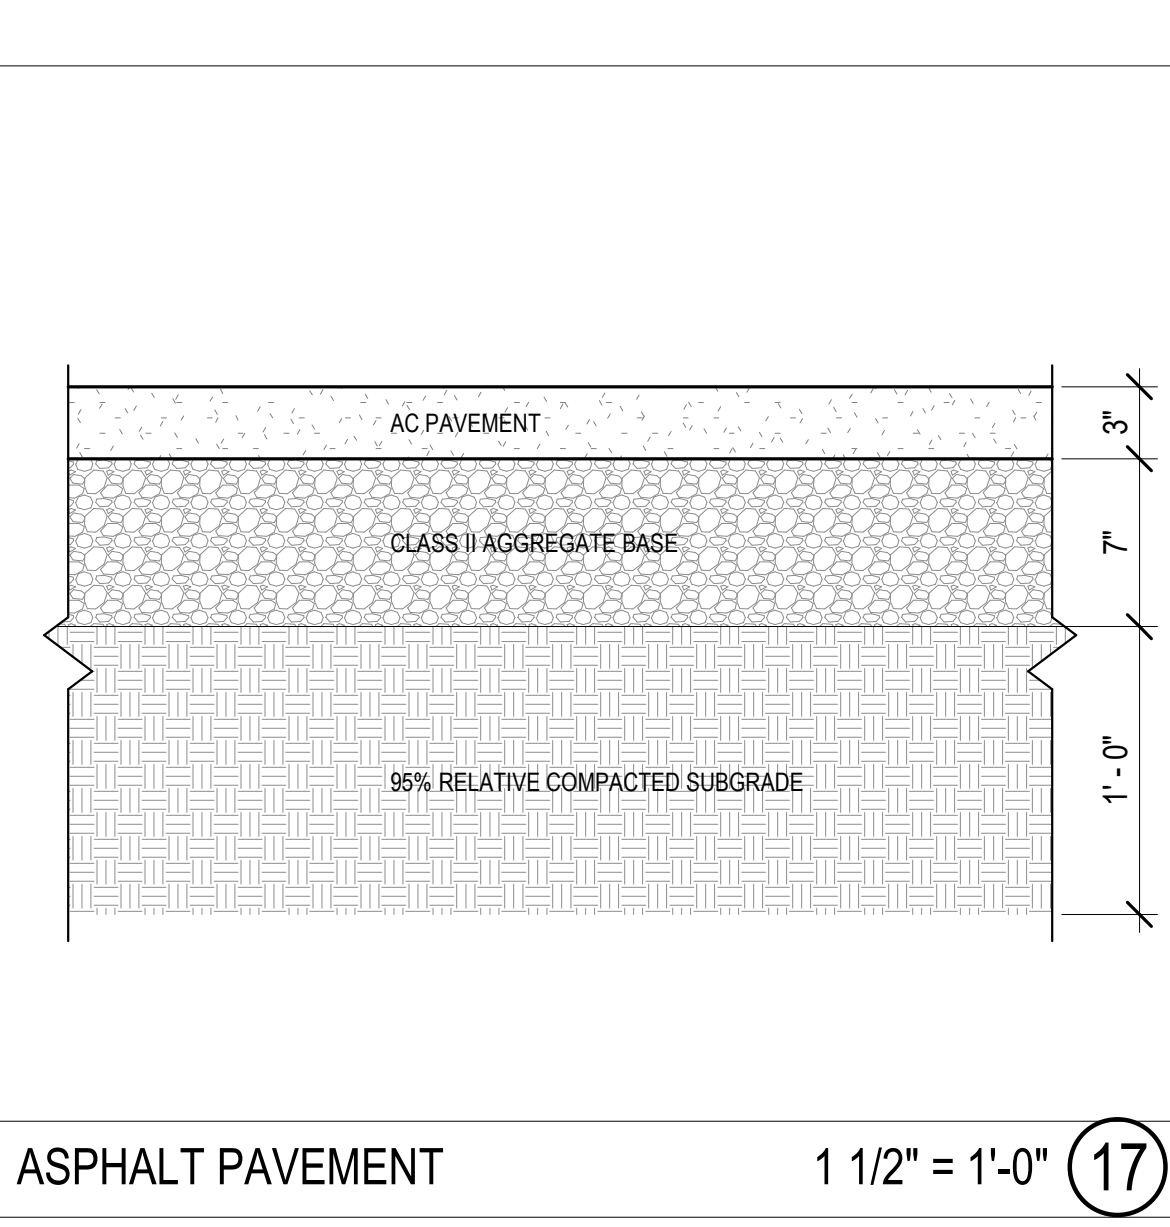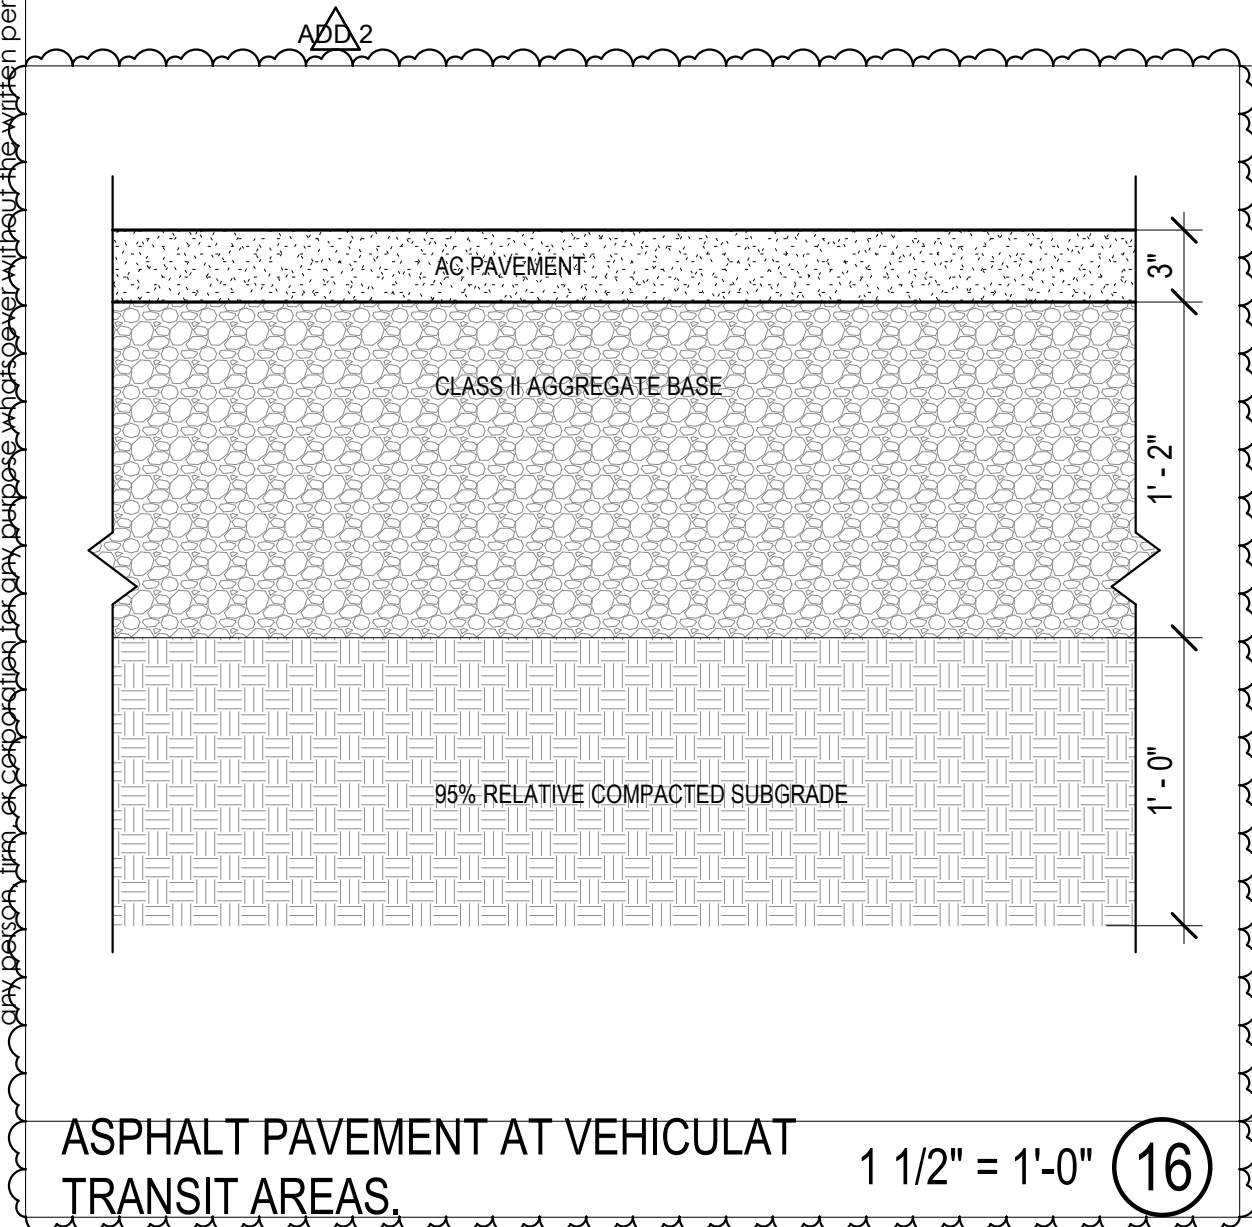

GENERAL NOTES

- COORDINATE EXTENT OF DEMO W/ ELEC. PLANS FOR INSTALLATION OF NEW ELEC. WORK, REPAIR AND REPLACE FINISHES TO MATCH RECONSTRUCTION PLANS.
- VERIFY ALL DIMENSIONS WITH NEW WORK.
- REMOVE OR SMOOTH ROUGH OR PROTRUDING ITEMS SUCH AS BROKEN CONCRETE AND NAILS THAT COULD NEGATIVELY IMPACT CONSTRUCTION OR FUTURE WORK.
- REFER TO SHEET T-1.0 FOR GENERAL NOTES AND STANDARDS.
- REFER TO SHEET T-2.0 FOR ARCHITECTURAL SYMBOLS, ABBREVIATIONS AND DIMENSIONING STANDARDS.
- ALL ITEMS ARE CONSIDERED NEW UNLESS NOTED AS (E) EXISTING. IF SHEET IS LESS THAN 24"x36" IT IS A REDUCED PRINT SCALED REDUCED ACCORDINGLY.
-

LEGEND

- PROTECT IN PLACE EXISTING CONCRETE
- PROTECT IN PLACE EXISTING ASPHALT
- DEMOLISH (E) ASPHALT
- (N) ASPHALT
- (N) CONCRETE


KEYNOTE LIST

- 02-01 REMOVE, SALVAGE AND RETURN TO DISTRICT (E) SCOREBOARD (COORDINATE WITH DISTRICT)
- 02-02 REMOVE AND DISPOSE OF (E) STEEL COLUMN. ABANDON IN PLACE (E) CONCRETE FOOTING. PATCH AND REPAIR (E) ASPHALT PER DETAIL 17/AS-1.1
- 02-03 PROTECT IN PLACE (E) ELECTRICAL BOX.
- 02-04 PROTECT (E) TRACK SURFACE
- 02-13 PROTECT IN PLACE (E) CONCRETE CURB, PATCH AND REPAIR WHERE REQUIRED
- 02-14 PROTECT IN PLACE (E) TURF
- 03-01 CONCRETE PIER FOOTING. REFER TO A/SB-2.1
- 05-01 STEEL COLUMN. REFER TO A/SB-2.1
- 11-01 OWNER FURNISHED, CONTRACTOR INSTALLED SCOREBOARD. REFERENCE DSA P.C. 04-122317.



Roesling Nakamura
Terada Architects

285 N Ventura Ave #102
Ventura, CA 93001
P805.626.5330
F805.626.5330
www.RNTarchitects.com

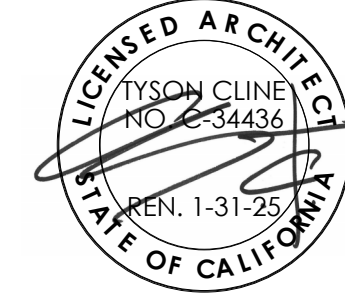

VENTURA
UNIFIED
SCHOOL
DISTRICT

BUENA HIGH
SCHOOL
STADIUM
SCOREBOARD
REPLACEMENT

5670 TELEGRAPH RD,
VENTURA, CA 93003

No.	Description	Date
ADD 2	BID ADDENDUM 2	9/16/2024


Sheet Name

ENLARGED
SITE PLANS

RNT Project No.	241016
Date	09/16/2024
Drawn by	CLD
Checked by	CS
Sheet Number	

AS-1.1

BM 360/1016 - VUSD Scoreboard Replacement/Buena High School Stadium Scoreboard Replacement.rvt
All ideas, arrangements and plans indicated or represented by the drawing are owned by, and the property of, Roesling Nakamura Terada Architects, Inc. and were created, evolved, and developed for use on and in connection with the project. None of such ideas, arrangements, or plans shall be used by or disclosed to any person, firm, or corporation without the written permission of Roesling Nakamura Terada Architects, Inc. Filing of these drawings or application with any public agency is not a publication of same. No reproduction is therefore permitted without the written consent of RNT.

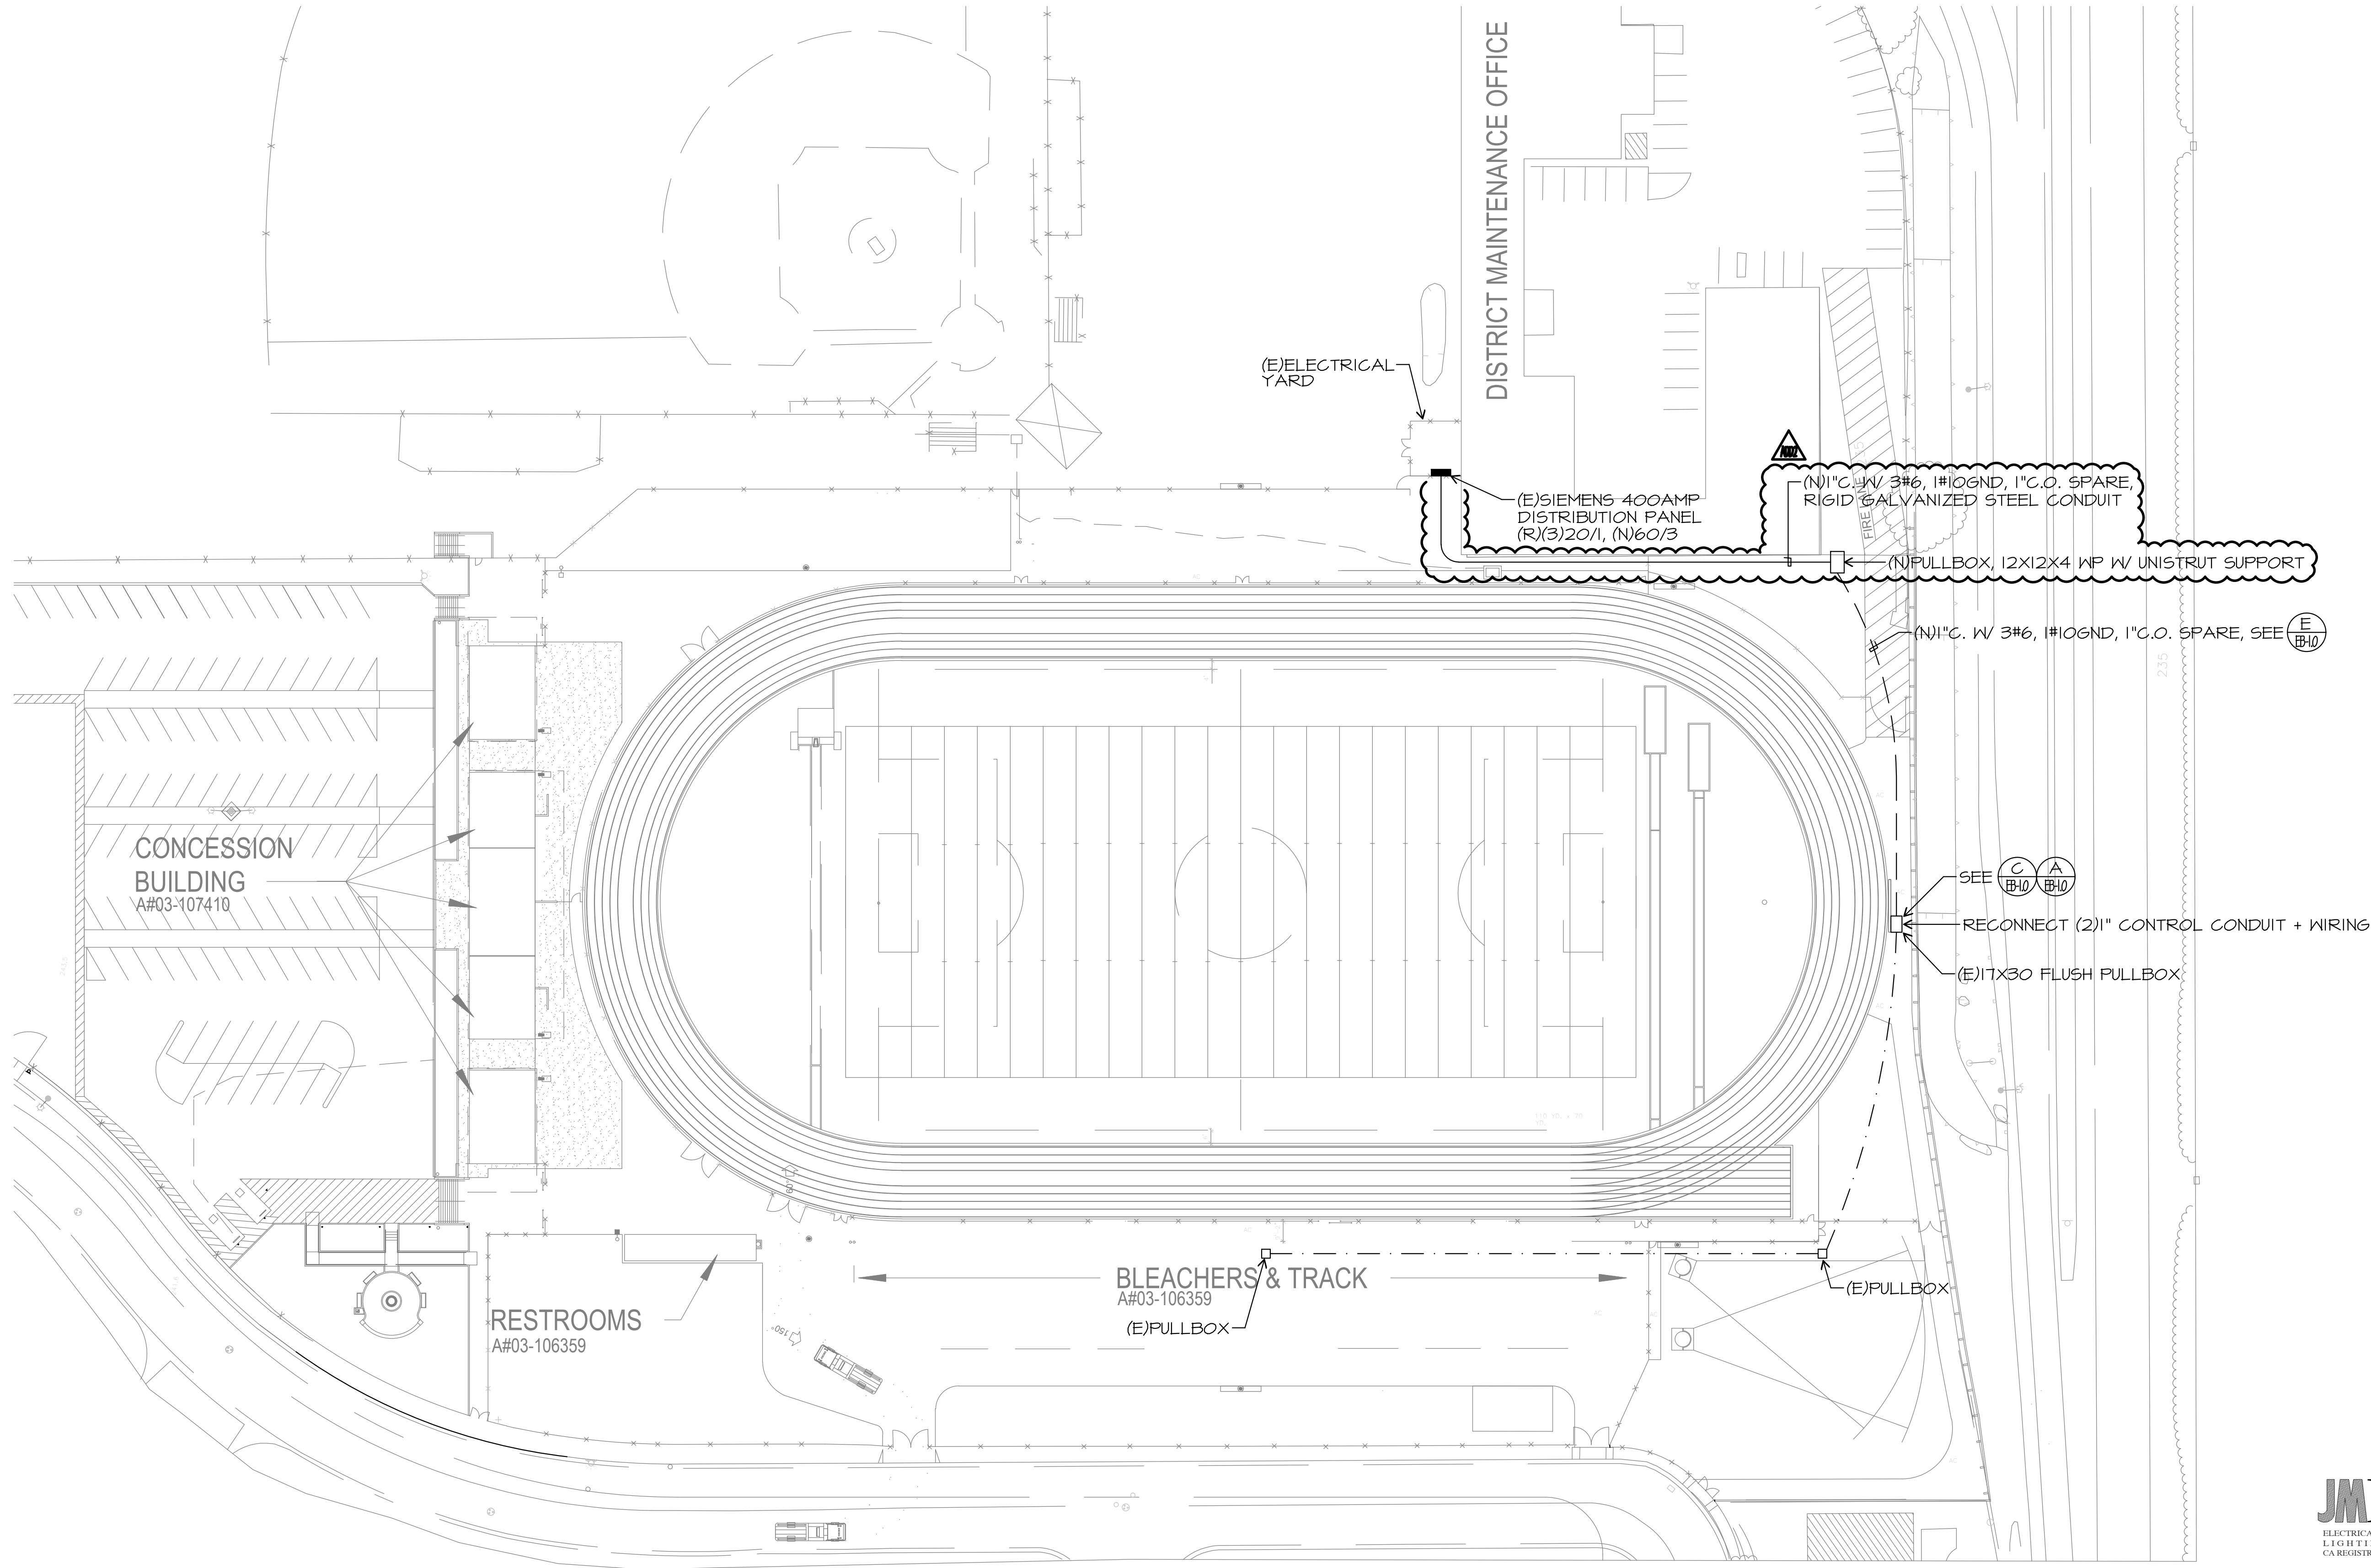

JMPE
ELECTRICAL ENGINEERING
LIGHTING DESIGN
CA REGISTRATION NO E13083


607 OLIVE STREET
SANTA BARBARA, CA 93101
(805) 569-6916
FAX: (805) 569-3405
email: maloney@jmpe.net
www.jmpe.net

24030



ELECTRICAL SITE PLAN

SCALE: 1" = 40'-0"

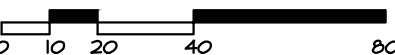

NORTH



**Roesling Nakamura
Terada Architects**

285 N Ventura Ave #102
Ventura, CA 93001
P805.626.5330
F805.626.5350
www.RNTarchitects.com



VENTURA UNIFIED SCHOOL DISTRICT

BUENA HIGH SCHOOL STADIUM SCOREBOARD REPLACEMENT

5670 TELEGRAPH RD,
VENTURA, CA 93003

No.	Description	Date
▲	BID ADDENDUM 2	09/16/2024

Sheet Name

ELECTRICAL SITE PLAN

RNT Project No. 21936.00.

Date 01/31/2024

Drawn by CLD

Checked by CS

Sheet Number

EB-2.0