

ADDENDUM #5

FROM : ARCHITECTNICA
555 W. BENJAMIN HOLT DRIVE
SUITE 423
STOCKTON, CA 95207
(209) 952-5850 FAX (209) 952-2442

PROJECT: Bridge Classroom Portable at Woodbridge ES
Lodi Unified School District

LOCATION : Woodbridge ES, 1290 Lilac St, Lodi, CA 95242

REF. # : ARCH PROJ. No. 2025-03
District Project No. 2600-4402-942-26
DSA FILE # 39-50
DSA APPL. 02-123435
PTN: 68686-283

OPSC NO. : n/a

OWNER : Lodi Unified School District
1305 East Vine Street
Lodi, CA 95240

DATE : October 23, 2025

NOTICE TO ALL BIDDERS

IT IS THE PURPOSE AND INTENT OF THIS ADDENDUM TO MODIFY AND/OR CLARIFY THE DRAWINGS AND SPECIFICATIONS FOR THIS PROJECT AND THIS ADDENDUM SHALL BECOME A PART OF THE CONTRACT DOCUMENTS. THESE CHANGES AND/OR INTERPRETATIONS SHALL BE INCORPORATED INTO YOUR BID.

REFER TO PROJECT PLANS AND SPECIFICATIONS PREPARED BY ARCHITECTNICA, DSA APPROVED SEPTEMBER 2, 2025

ITEM 1 Irrigation Drawings

We found limited information on the existing irrigation system in the District archives. Attached is drawing L2.1 from DSA #02-107659 for the project area. The drawing doesn't show any revisions to the existing irrigation system in that area. Please comply with the instructions given by Demolition Notes 1 on sheet C1.1 in the DSA approved plans.

ADDENDUM #5

ITEM 2 Existing Site Drawings

Existing Site Drawings for Woodbridge are available at the enclosed link:
[Woodbridge ES - Existing Drawings](#)


ITEM 3 Ramp Revisions

With regards to the Ramp, please follow the existing drawings in the DSA approved plans.

END OF ADDENDUM #5



ARCHITECTURICA

By

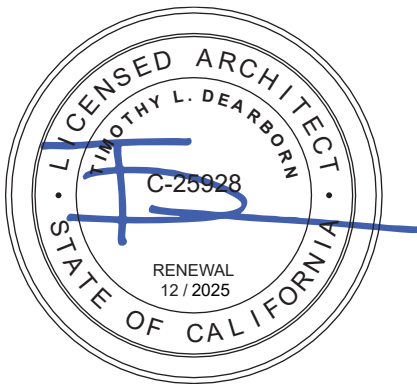

Timothy Dearborn, AIA
Architect

Attachments: L2.1 from DSA #02-107659

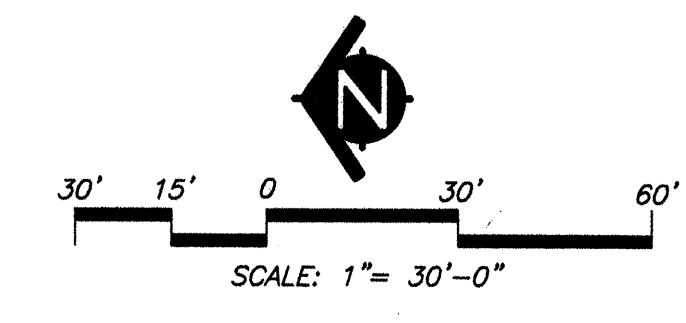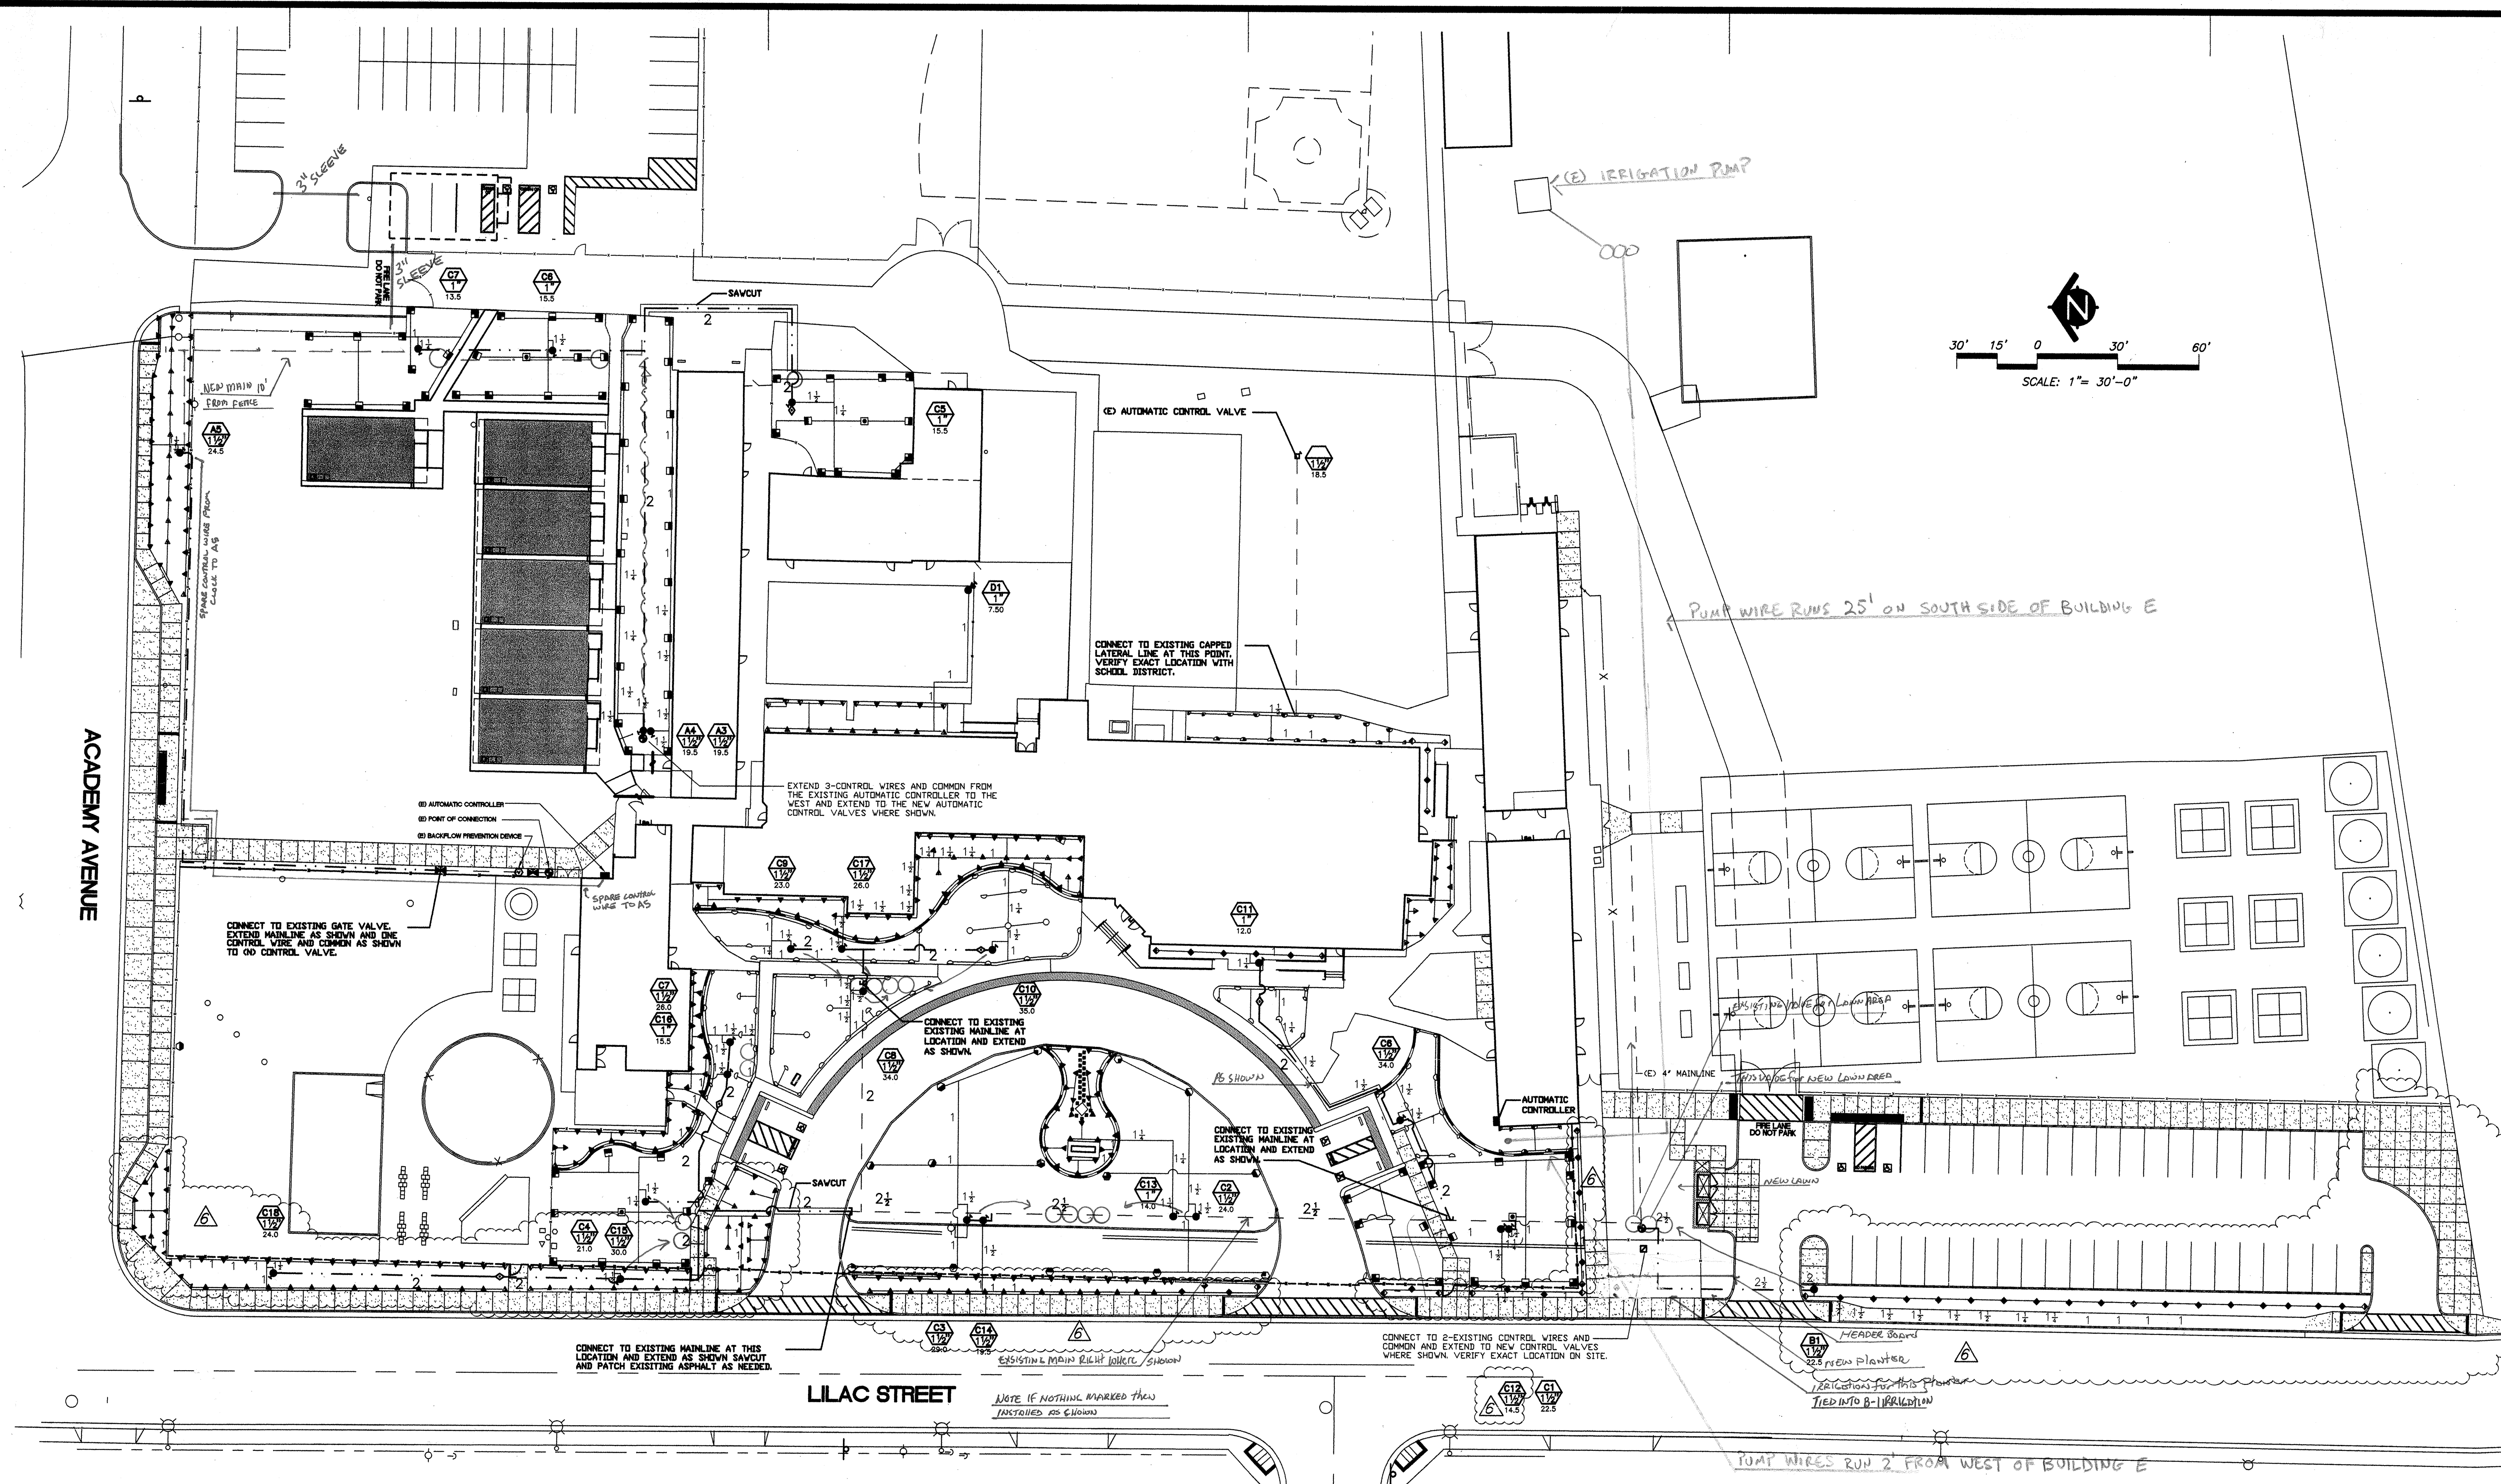

KEY	SPRINKLER IRRIGATION LEGEND
■	AUTOMATIC CONTROLLER IRITROL MC PLUS-B SERIES (WALL MOUNTED) CONTROLLER 16-18 STATIONS COORDINATE 110V SERVICE AND POWER CONNECTION WITH ELECTRICAL SUB-CONTRACTOR.
●	(E) POINT OF CONNECTION: VERIFY EXACT LOCATION AND SIZE ON SITE
---	(E) PRESSURE MAIN LINE VERIFY EXACT LOCATION AND SIZE ON SITE
---	(N) PRESSURE MAIN LINE: TYPE: 3" SIZE AND SMALLER: ASTM D1785, PVC SCH 40. TRENCH DEPTH: IN PLANTED AREAS: ROTOR HEADS: - 18" MINIMUM COVER. POP-UP SPRAY HEADS: - 12" MINIMUM COVER. UNDER PAVED AREAS: 24" MINIMUM COVER. PVC SCHEDULE 40 SLEEVES ARE REQUIRED FOR ALL PIPING UNDER PAVEMENT.
---	LATERAL LINE: TYPE: PVC CLASS 200, SOLVENT WELD ALL UNSIZED PIPE SHALL BE 3/4" SIZE. TRENCH DEPTH: IN PLANTED AREAS: ROTOR HEADS: - 18" MINIMUM COVER. POP-UP SPRAY HEADS: - 12" MINIMUM COVER. UNDER PAVED AREAS: 24" MINIMUM COVER. PVC SCHEDULE 40 SLEEVES ARE REQUIRED FOR ALL PIPING UNDER PAVEMENT.
●	(E) AUTOMATIC CONTROL VALVE TO REMAIN
●	AUTOMATIC CONTROL VALVE: RAINBIRD PEB SERIES, SIZE AS INDICATED ON DRAWINGS.
●	QUICK COUPLER VALVE: RAINBIRD 44NP, BUCKNER QB44NP10, TORO 474-24 OR APPROVED EQUAL. VALVES SHALL HAVE LOCKING RUBBER COVERS, INSTALLED IN VALVE BOXES. TOP OF VALVE BOX SHALL HAVE BOLT DOWN LGD AND TOP SET LEVEL TO FINISH GRADE.

KEY	SPRINKLER IRRIGATION LEGEND
■	(E) GATE VALVE
■	BATTERY OPERATED CONTROLLER/ VALVE TORO: DDOWP-2-9V BATTERY POWERED CONTROLLER TORO: PP220-26-9-4 1" VALVE W/ SOLENOID ASSEMBLY
●	LAWN POP-UP ROTOR HEADS: RAINBIRD: (FALCON 6504) T4-PC-SS-4 THREE QUARTER, HALF (NOZZLE 5.0), AND QUARTER (NOZZLE 3.0) SPRAY PATTERNS.
●	LAWN POP-UP ROTOR HEADS: RAINBIRD: (3500 SERIES) 3504-PC-SAM FULL, HALF (NOZZLE 2.0), AND QUARTER (NOZZLE 1.0) SPRAY PATTERNS.
●	LAWN POP-UP SPRAY HEADS: (15') RAINBIRD 1804-SAM WITH 15-SERIES NOZZLES. FULL, HALF AND QUARTER PATTERNS.
●	SHRUB POP-UP SPRAY HEADS: (8') RAINBIRD 1806-SAM WITH 8-SERIES NOZZLES. HALF PATTERNS.
●	SHRUB POP-UP SPRAY HEADS: (10') RAINBIRD 1806-SAM WITH 10-SERIES NOZZLES. HALF PATTERNS.
●	SHRUB STRIP SPRAY HEADS: RAINBIRD 1806-SAM WITH 15-SERIES SIDE STRIP. SST, LOS AND RCS PATTERNS.
●	INDICATES CONTROL VALVE AND STATION NUMBER
●	INDICATES CONTROL VALVE SIZE
●	INDICATES GALLONS PER MINUTE


MURRAY & DOWNS
AIA-ARCHITECTS INC.
3025 SACRAMENTO STREET
PLACERVILLE, CA 95667
PHONE (530) 636-1810 FAX (530) 636-1831

CONSULTANT **MTWgroup**
MURRAY & DOWNS
3025 SACRAMENTO STREET
PLACERVILLE, CA 95667
LANDSCAPE ARCHITECTURE
AND PLANNING
10411 Old Placerville Road
Suite 205
Sacramento, CA 95827
916 369-3990
2006-48

OWNER
LODI UNIFIED SCHOOL DISTRICT
1305 E. VINE STREET
LODI, CA 95240
WILLIAM HUETT
SUPERINTENDENT

PROJECT
**WOODBRIDGE
CONVERSION**

As-Built Wood Bridge

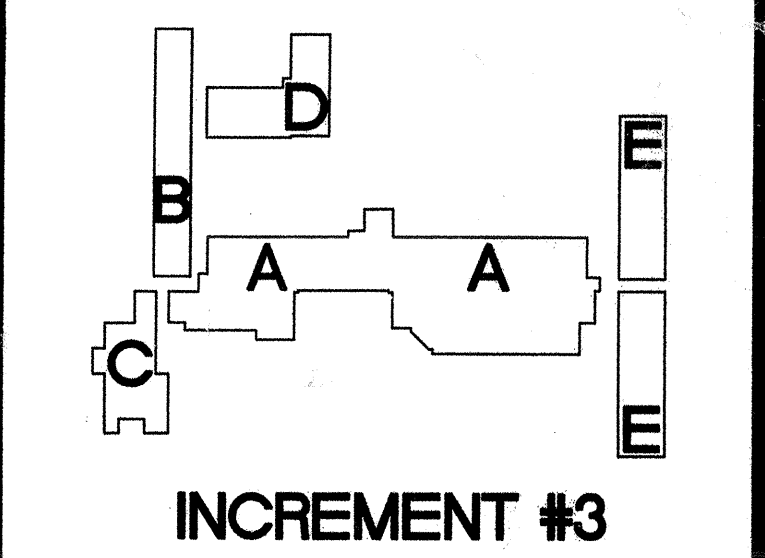

IDENTIFICATION STAMP
DIV. OF THE STATE ARCHITECT
OFFICE OF REGULATION SERVICES
68585-40 02-107659 39-50
PROJECT TRACKING APPLICATION NUMBER FILE NUMBER
DATE 5-2-07

REVISIONS	
Δ REVISIONS	
CHECKED: ST	DRAWN BY: DP
DATE: 12/15/2006	PROJECT: 03-043

SPRINKLER IRRIGATION PLAN
DRAWING NUMBER
L2.1
DWGS IN SET