



Addendum 01

Page 1 of 4

PROJECT:

MCSD Bid No.: 2025-3
Fremont ES, Hoover MS, Muir ES
Perimeter Fencing Projects

Date: November 13, 2025
TETER Project No.: 25-13173, 25-13360

CLIENT:

Merced City School District
444 W. 23rd St.
Merced, CA 95340

Client Project No.: Bid 2025-3
DSA File No.: 24-35

The following additions, deletions and revisions to the plans, specifications and Addenda shall become a part of the plans and specifications. It is the responsibility of the General Contractor to submit the information contained in this addendum to all subcontractors and suppliers. The Bidder shall acknowledge receipt of the Addendum in the Bid Proposal.

(Addendum number of pages: 4 pages + 7 attachment = 11 total pages).

PROCEDURAL:

1 - 01: DOCUMENT ACCESS, in addition to the Exchanges listed on the Notice to Bidders, Bidding documents can be access at the following link: <https://bit.ly/MCSD2025-3>

1 - 02: MANDATORY PRE-BID CONFERENCE, sign-in sheet is attached (2 pages).

DRAWINGS – HOOVER MS (#02-123702):

1 - 03: DRAWINGS, SHEET A100 – SITE PLAN, is to be replaced with the attached drawing A100 in its entirety (1 page).

1 - 04: DRAWINGS, SHEET A102 – ENLARGED SITE PLANS, is to be replaced with the attached drawing A102 in its entirety (1 page).

DRAWINGS – MUIR ES (#02-123703):

1 - 05: DRAWINGS, SHEET A100 – SITE PLAN, is to be replaced with the attached drawing A100 in its entirety (1 page).

1 - 06: DRAWINGS, SHEET A101 – ENLARGED SITE PLANS, is to be replaced with the attached drawing A100 in its entirety (1 page).

1 - 07: DRAWINGS, SHEET A112 –SITE DETAILS, is to be replaced with the attached drawing A112 in its entirety (1 page).

CLARIFICATIONS:

1 - 08: PRE-BID RFI

A. **Question:** Are manufactured fencing systems acceptable as a substitution to the specified fencing materials?

Answer: Manufactured systems are acceptable, as long as they meet the material, product and installation requirements and specifications of the Contract Documents.

- B. **Question:** Will you please clarify what you would like us to put for the classification on the subcontractors list?'
Answer: Classification refers to the type of Contractors License, where applicable.
- C. **Question:** Specs call for hot-dipped galvanized. Is the use of pre-galvanized materials acceptable?
Answer: Fencing panels shall be hot dipped once assemblies. Posts and large members for fabricating vehicle gates may use pre-galvanized materials.
- D. **Question:** Does the district have irrigation as-builts? Or will put in a line item into the bid form for it (so all contractors are only bidding/pricing the fence work?
Answer: Irrigation as-builts are not available at this time. Per General Notes 5, 6 & 8, irrigation systems are to be modified and repaired as needed for fencing and mow-strip installation.
- E. **Question:** Can cut flush existing posts at grade for demo'd fence and fill with non shrink grout, where the posts is too close to asphalt edge to be safely removed?
Answer: Existing posts may be cut flush to the top of the existing post foundation when removal of the complete foundation would damage existing concrete or asphalt surfacing. All other fencing systems to be removed shall be removed completely and holes filed.
- F. **Question:** Will the district provide staking / survey of fence gates and corner locations?
Answer: Any surveying/staking needed by the Contractor shall be provided by the Contractor.
- G. **Question:** Gate sizes Vary from what's existing to what's on plans please confirm new gate sizes?
Answer: New gates are to be sized per the plans, unless specifically noted as "Match Existing".
- H. **Question:** Fence spec calls for this? will welds need to be xray? (which full penetration welds typically require this)
Answer: X-ray inspection will not be required.
- I. **Question:** Will Knox box be required at any gates?
Answer: See Keynote 10.61 on Sheet A100/A101 for each project site for the locations of Knox Boxes.
- J. **Question:** It was stated the lowest bid wins, is that lowest base bid or lowest base bid + add alternates?
Answer: Bid shall be awarded based upon lowest Base Bid, which is inclusive of the Base Bid for all three project site locations.
- K. **Question:** All signage is remove and reinstall confirm, no new signage is required?
Answer: Existing signage shall be removed. Any new signage required by the Contractor is indicated on the Site Plan, Enlarged Site Plan or Details for each project site location.
- L. **Question:** Please confirm we are okay & expected to be working on all 3 sites at once.
Answer: Correct.

- M. **Question:** Is there an engineer's estimate on cost for the project?
Answer: Per the Notice to Bidders, the engineer's estimate is \$1,870,000 (inclusive of all three sites).
- N. **Question:** On sheet A100 there is a keynote 10.11 but nothing stating what that key note means?
Answer: On Sheet A100 for the John Muir ES project site, Keynote 10.11 is included in the Keynote Legend and states: "ACCESSIBLE PARKING LOT ENTRANCE TOW-AWAY SIGN, SEE 9/A110".
- O. **Question:** Detail 7/A101, there is a 6"W swing gate with no ID and is not in gate schedule. Please confirm this gate is in scope.
Answer: Gate G17 has been added to the Enlarged Site Plan and Gate Schedule. See revised Gate Schedule on sheet **A100** and **7/A101** for the John Muir ES project site.
- P. **Question:** On details 7/A101& 8/A101, there are some dimensions that do not match the scaled values. Please confirm if we are to base our quantities on the dimension values shown on scaled distances. See attachment for dimensions in question.
Answer: See revised sheet **A101** for the John Muir ES project site.
- Q. **Question:** Detail 2/A110 calls for a 2"x12" gate frame. We believe this is a typo and should be a 2"x2" gate frame. Please confirm.
Answer: Gate frame is to be 2"x2".
- R. **Question:** On the ornamental iron fence, is there a particular vendor(s) you will allow us to use? Ameristar? Fortress?
Answer: Manufactured systems are acceptable, as long as they meet the material, product and installation requirements and specifications of the Contract Documents.
- S. **Question:** On the ornamental iron fence, are these panels welded to post or bracketed?
Answer: Either attachment type is acceptable.
- T. **Question:** Detail 2/A110, are there any specification requirements for the pull hardware and lock?
Answer: Please see Specification Section 323123 (.01, .02, .03), Part 2.3.
- U. **Question:** Detail 2/A112 calls for a 2"x15" horizontal rail. Is this meant to be a 2"x15" HSS or two 2"x2" rails with a 15"x11ga push plate?
Answer: A 2"x15" HSS or fabricated section are to be used behind the egress hardware.
- V. **Question:** Regarding the Scope of work at Fremont ES: Portions of the existing fencing to be removed have existing signage. How is the existing signage to be addressed?
Answer: Existing signage shall be removed. Any new signage required by the Contractor is indicated on the Site Plan, Enlarged Site Plan or Details for each project site location.
- W. **Question:** Regarding Scope of Work at Hoover MS: Is the proposed new fencing along the east property line to be 2' away from existing residential wood fence or 2' away from existing campus chain link fence?
Answer: The new Decorative Metal fencing is to be installed 2'-0" away from the existing wood fence. See revised Sheet **A102** for the Hoover MS project

- X. **Question:** Regarding Scope of Work at Hoover MS: For the existing chain link fence at the west side of the property, there is a note to replace that mesh. What is the height of that fence?
Answer: The height of the existing fence is approximately 6'-0", please verify in field.
- Y. **Question:** Regarding Scope of Work at Hoover MS: For the new 6' tall chain link fence, do you want that to be 1" mesh as well?
Answer: No, 1" no-climb fabric will be indicated by the keynote call-out where required. Other fencing areas shall be standard 2" fabric, coating and color per specifications.
- Z. **Question:** Regarding the Scope of work at Muir ES: At the 100 year old school you mentioned match the new gate that is there with a header - But that's not the detail shown on the plans please confirm that's what will be required at Muir?
Answer: Gate GE1 at the John Muir ES Project site is to include a tube steel header to match the existing gate. See revised Gate Schedule on sheet **A100** and post attachment detail **15/A112** for the John Muir ES project site.
- AA. **Question:** Regarding the Scope of work at Muir ES: Please clarify that there is no accessible signage required at John Muir ES. Detail 2/A112 doesn't call out the "8"x8"x16 GA PLATE WELDED TO PICKETS -FOR ACCESSIBLE SIGNAGE, SEE" on the Ornamental Swing Gate - Accessible detail like Herbert Hoover MS and John Fremont ES does but shows the outline on the push side.
Answer: ISA signage is only required where indicated for gate GE1. See revised Gate Schedule on sheet **A100** and post attachment detail **4/A112** for the John Muir ES project site.
- BB. **Question:** Regarding the Scope of work at Muir ES: Please clarify that there are no Knox Boxes required at John Muir ES, the site plan doesn't show any.
Answer: A Knox Box is required at the new gate G16. See Keynote 10.61 on the revised Sheet A100 for the John Muir ES project site.
- CC. **Question:** Regarding the Scope of work at Muir ES: At gate GE1 is showing as existing but you on the walk mentioned having it replaced to match the new one next to it. Please confirm and or add that to our scope in the addenda.
Answer: Gate GE1 at the John Muir ES Project site is to include a tube steel header to match the existing gate. See revised Gate Schedule on sheet **A100** and post attachment detail **15/A112** for the John Muir ES project site.

END OF ADDENDUM NO. 01


Chris Nikkel
 Architect

Attachment(s): [7 pages]

MANDATORY PRE-BID CONFERENCE ATTENDEE SHEET, (2 pages)

HOOVER MS – A100 – SITE PLAN, (1 page, rev 1, 11/13/25)

HOOVER MS – A102 – ENLARGED SITE PLANS, (1 page, rev 1, 11/13/25)

MUIR ES - A100 – SITE PLAN, (1 page, rev 1, 11/13/25)

MUIR ES - A101 – ENLARGED SITE PLANS, (1 page, rev 1, 11/13/25)

MUIR ES - A112 – SITE DETAILS, (1 page, rev 1, 11/13/25)

PROJECT:

MCSD Bid No.: 2025-3
 Fremont ES, Hoover MS, Muir ES
 Perimeter Fencing Projects
 Merced City School District

Date: November 4, 2025
 Time: 9:00 AM
 TETER Project No.: 25-13173, 25-13360

MANDATORY PRE-BID JOB WALK ATTENDEE SHEET:

Company Name:	Ranch Fence ✓✓	Phone:	(209) 640-9233
Name:	Hillary Fryer	Email:	estimating@RanchFenceInc.com
Company Name:	Ranch Fence ✓✓	Phone:	(209) 966-5914
Name:	Jarrod Twiss	Email:	estimating@RanchFenceInc.com
Company Name:	Marko Construction ✓✓	Phone:	559-351-1453
Name:	Paul Gong	Email:	pkgong@markoconstruction.com
Company Name:	Golden Bay Fence ✓✓	Phone:	(209) 944-9754
Name:	William Moreno	Email:	wmoreno@goldenbayfence.com
Company Name:	JLC ✓✓	Phone:	209 406 9006
Name:	John Belo	Email:	john@joeslc.com
Company Name:	Joe's Landscaping ✓✓	Phone:	209 597-2135
Name:	Joe Garcia	Email:	joe@joeslc.com
Company Name:	Louis Kingston ✓✓	Phone:	209 384 8424
Name:	TBS Contractors	Email:	Estimating@taylorboskhor.com
Company Name:	Coelio Lopez B2 ✓✓	Phone:	(209) 531 12 52
Name:	B2 Construcción	Email:	MZIMORA@B2constu.com
Company Name:	Marvulli, Inc. ✓✓	Phone:	(209) 233-1336
Name:	Joe Rose	Email:	joe@marvulli.com
Company Name:	ROEBBELEN CONTRACTING ✓✓	Phone:	(916) 413-4000
Name:	RICHARD CHAVEZ	Email:	ESTIMATING@ROEBBELEN.com



Pre-Bid Job Walk Attendees

Page 2 of 2


PROJECT:

MCSD Bid No.: 2025-3
Fremont ES, Hoover MS, Muir ES
Perimeter Fencing Projects
Merced City School District

Date: November 4, 2025
Time: 9:00 AM
TETER Project No.: 25-13173, 25-13360

MANDATORY PRE-BID JOB WALK ATTENDEE SHEET:

Company Name:	NTS	Phone:	(559) 908-8426
Name:	Mark Cameron	Email:	markcameronentsafety.com
Company Name:	Pisor Fence Division Inc. ✓	Phone:	916-755-8803
Name:	Jeremiah Alexander	Email:	jalexander@pisorfence.net
Company Name:	United Inspection Inc. ✓	Phone:	209 605-6872
Name:	John Hill	Email:	inspectorjohn@aol.com
Company Name:		Phone:	
Name:		Email:	
Company Name:		Phone:	
Name:		Email:	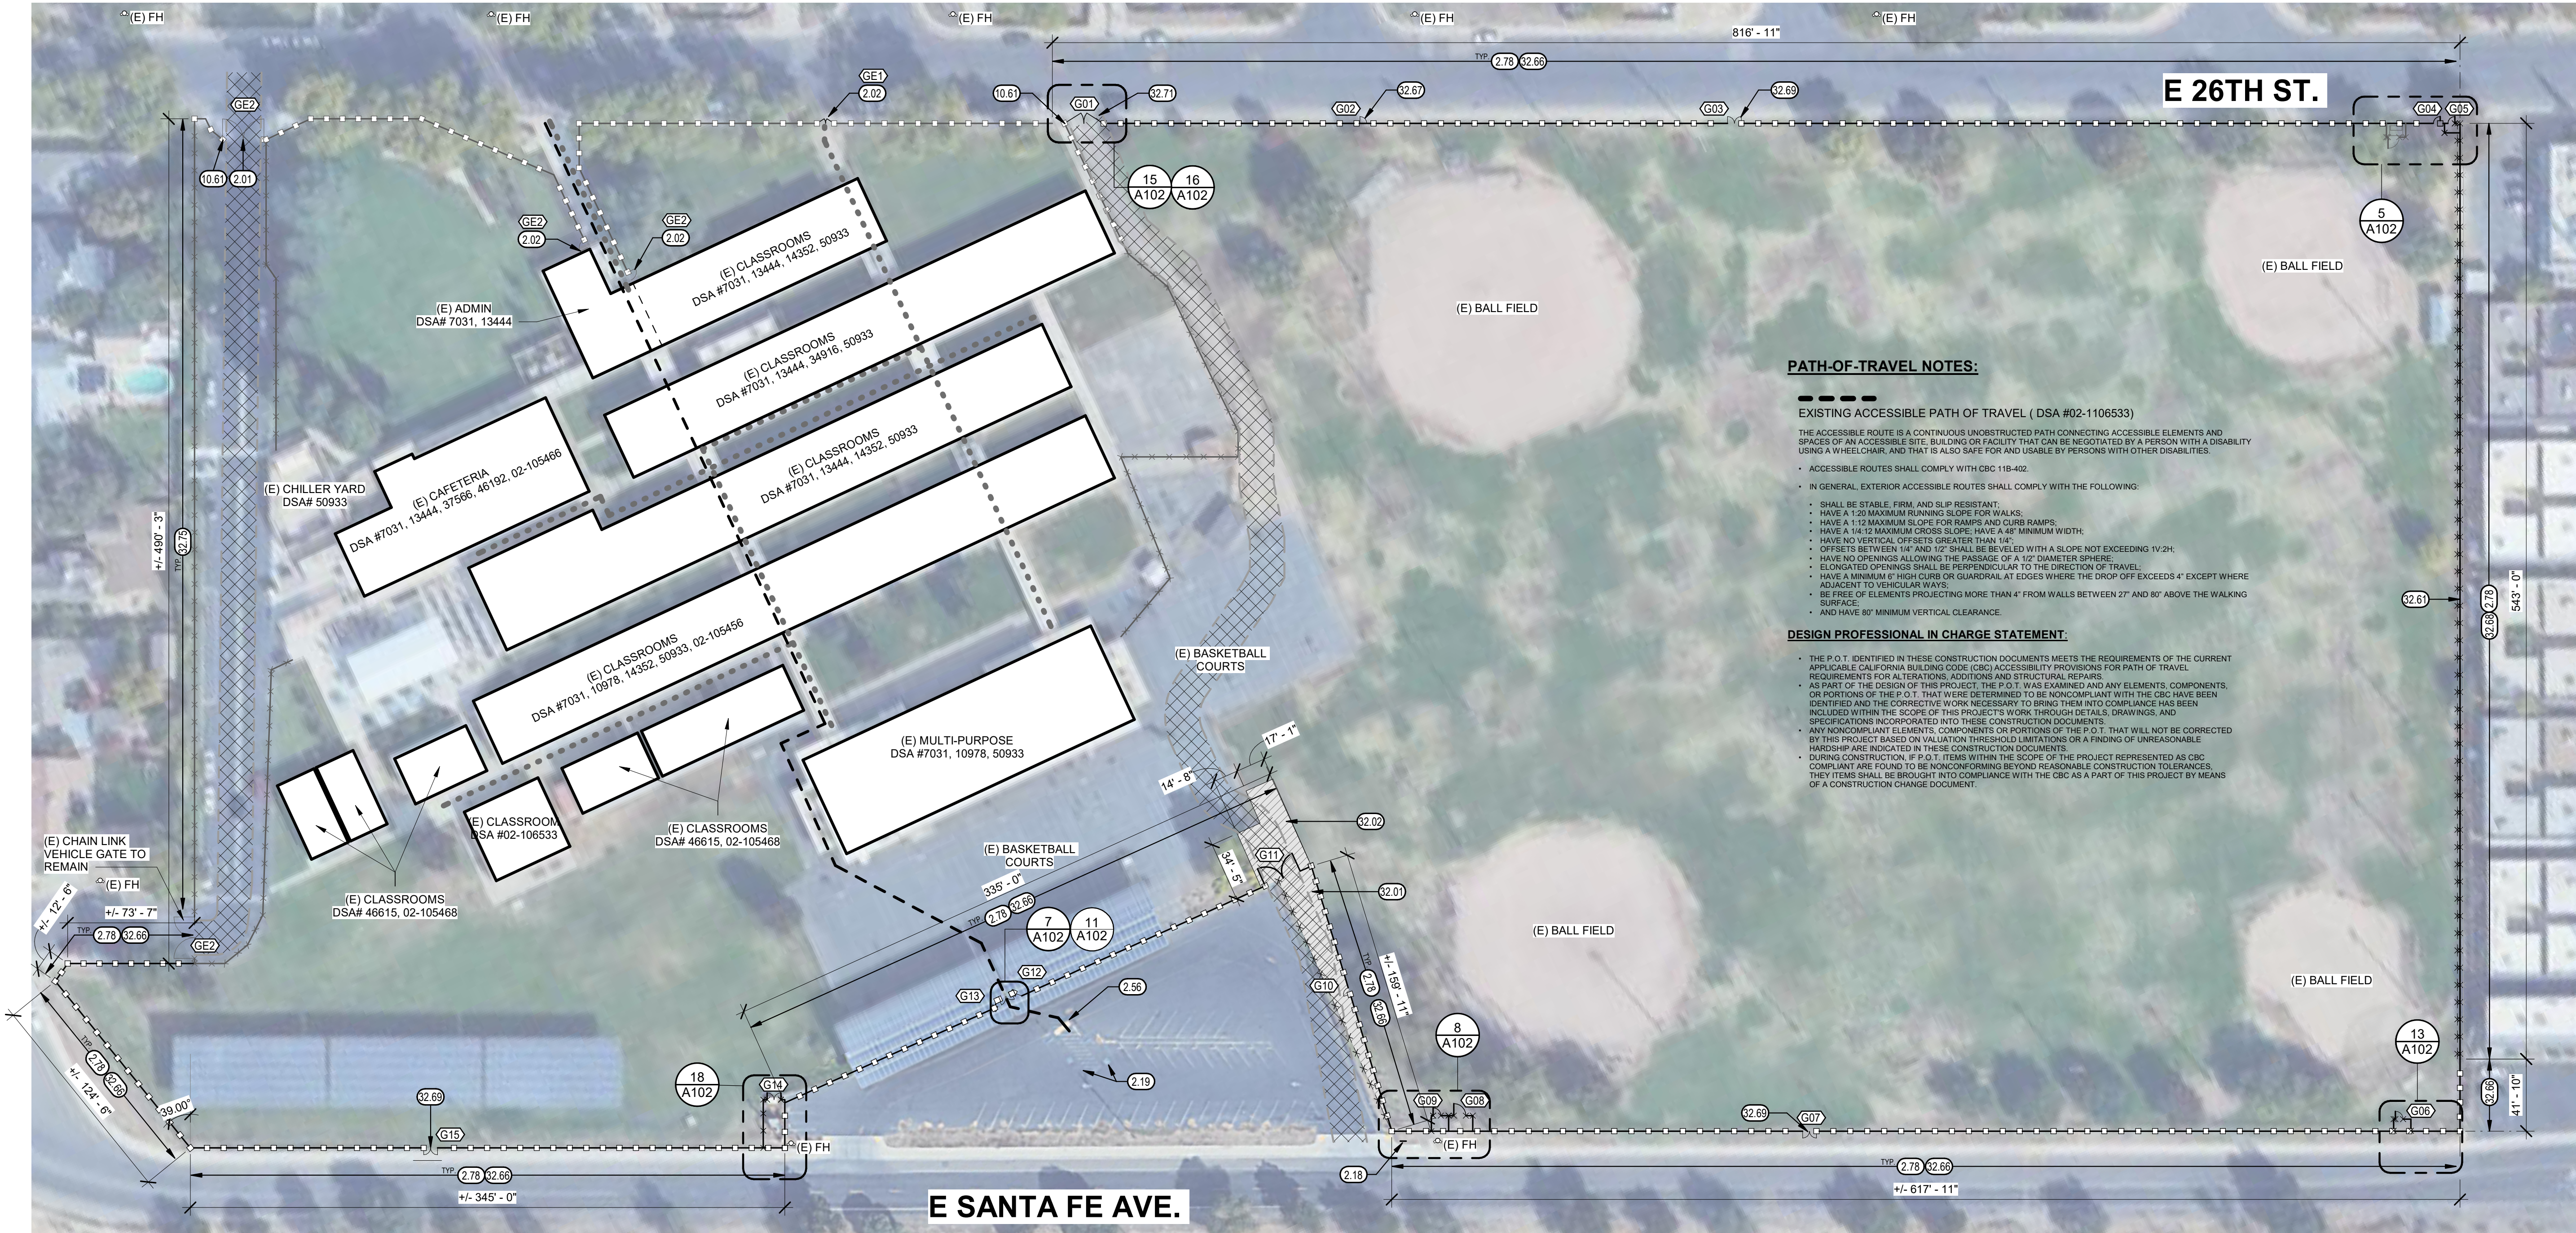
PATH-OF-TRAVEL NOTES:

EXISTING ACCESSIBLE PATH OF TRAVEL (DSA #02-1106533)

THE ACCESSIBLE ROUTE IS A CONTINUOUS UNOBSTRUCTED PATH CONNECTING ACCESSIBLE ELEMENTS AND SPACES OF AN ACCESSIBLE SITE, BUILDING OR FACILITY THAT CAN BE NEGOTIATED BY A PERSON WITH A DISABILITY USING A WHEELCHAIR, AND THAT IS ALSO SAFE FOR AND USABLE BY PERSONS WITH OTHER DISABILITIES.

- ACCESSIBLE ROUTES SHALL COMPLY WITH CBC 11B-402.
- IN GENERAL, EXTERIOR ACCESSIBLE ROUTES SHALL COMPLY WITH THE FOLLOWING:
 - SHALL BE STABLE, FIRM, AND SLIP RESISTANT;
 - HAVE A 1:20 MAXIMUM RUNNING SLOPE FOR WALKS;
 - HAVE A 1:12 MAXIMUM SLOPE FOR RAMPS AND CURB RAMPS;
 - HAVE A 1/4" MAXIMUM CROSS SLOPE; HAVE A 48" MINIMUM WIDTH;
 - HAVE NO VERTICAL OFFSETS GREATER THAN 1/4";
 - OFFSETS BETWEEN 1/4" AND 1/2" SHALL BE BEVELED WITH A SLOPE NOT EXCEEDING 1V:2H;
 - HAVE NO OPENINGS ALLOWING THE PASSAGE OF A 1/2" DIAMETER SPHERE;
 - ELONGATED OPENINGS SHALL BE PERPENDICULAR TO THE DIRECTION OF TRAVEL;
 - HAVE A MINIMUM 6" HIGH CURB OR GUARDRAIL AT EDGES WHERE THE DROP OFF EXCEEDS 4" EXCEPT WHERE ADJACENT TO VEHICULAR WAYS;
 - BE FREE OF ELEMENTS PROJECTING MORE THAN 4" FROM WALLS BETWEEN 27" AND 80" ABOVE THE WALKING SURFACE;
 - AND HAVE 80" MINIMUM VERTICAL CLEARANCE.

DESIGN PROFESSIONAL IN CHARGE STATEMENT:

- THE P.O.T. IDENTIFIED IN THESE CONSTRUCTION DOCUMENTS MEETS THE REQUIREMENTS OF THE CURRENT APPLICABLE CALIFORNIA BUILDING CODE (CBC) ACCESSIBILITY PROVISIONS FOR PATH OF TRAVEL REQUIREMENTS FOR ALTERATIONS, ADDITIONS AND STRUCTURAL REPAIRS.
- AS PART OF THE DESIGN OF THIS PROJECT, THE P.O.T. WAS EXAMINED AND ANY ELEMENTS, COMPONENTS, OR PORTIONS OF THE P.O.T. THAT WERE DETERMINED TO BE NONCOMPLIANT WITH THE CBC HAVE BEEN IDENTIFIED AND THE CORRECTIVE WORK NECESSARY TO BRING THEM INTO COMPLIANCE HAS BEEN INCLUDED WITHIN THE SCOPE OF THIS PROJECT'S WORK THROUGH DETAILS, DRAWINGS, AND SPECIFICATIONS INCORPORATED INTO THESE CONSTRUCTION DOCUMENTS.
- ANY NONCOMPLIANT ELEMENTS, COMPONENTS OR PORTIONS OF THE P.O.T. THAT WILL NOT BE CORRECTED BY THIS PROJECT BASED ON VALUATION THRESHOLD LIMITATIONS OR A FINDING OF UNREASONABLE HARSHNESS ARE INDICATED IN THESE CONSTRUCTION DOCUMENTS.
- DURING CONSTRUCTION, IF P.O.T. ITEMS WITHIN THE SCOPE OF THE PROJECT REPRESENTED AS CBC COMPLIANT ARE FOUND TO BE NONCONFORMING BEYOND REASONABLE CONSTRUCTION TOLERANCES, THEY ITEMS SHALL BE BROUGHT INTO COMPLIANCE WITH THE CBC AS A PART OF THIS PROJECT BY MEANS OF A CONSTRUCTION CHANGE DOCUMENT.

EXISTING PARKING LOT SUMMARY

REGULAR STALLS: 33
ACCESSIBLE STALLS REQUIRED: 2 (1 VAN)
ACCESSIBLE STALLS PROVIDED: 2 (1 VAN)

SITE PLAN

1" = 50'-0"

3

ABBREVIATIONS
D.M. = DECORATIVE METAL
C.L. = CHAIN LINK
PR = PAIR
SGL = SINGLE

- NOTES**
1. EXISTING EGRESS GATE PER DSA A# 02-106533, OPERATION TO REMAIN UNALTERED.
 2. EXISTING SERVICE GATE PER DSA A# 02-106533, OPERATION TO REMAIN UNALTERED.

NO.	MATERIAL	TYPE	GATE OPENING	GATE LEAF			FUNCTION	DETAIL
				WIDTH	HEIGHT	PR/SGL		
GE1	D.M.	SWING	EXIST	EXIST.	EXIST.	EXIST.	(E) *EGRESS	NOTE 1
GE2	D.M.	SWING	EXIST	EXIST.	EXIST.	EXIST.	(E) SERVICE	NOTE 2
G01	D.M.	SWING	22' - 0"	11' - 0"	6' - 0"	PR	SERVICE	16 / A111
G02	D.M.	SWING	4' - 0"	4' - 0"	6' - 0"	SGL	SERVICE	2 / A110
G03	D.M.	SWING	8' - 0"	4' - 0"	6' - 0"	PR	SERVICE	3 / A110
G04	D.M.	SWING	4' - 0"	4' - 0"	6' - 0"	SGL	SERVICE	2 / A110
G05	D.M.	SWING	4' - 0"	4' - 0"	6' - 0"	SGL	SERVICE	2 / A110
G06	C.L.	SWING	4' - 6"	4' - 6"	6' - 0"	SGL	SERVICE	4 / A111
G07	D.M.	SWING	8' - 0"	4' - 0"	6' - 0"	PR	SERVICE	3 / A110
G08	C.L.	SWING	7' - 0"	7' - 0"	6' - 0"	SGL	SERVICE	4 / A111
G09	C.L.	SWING	4' - 6"	4' - 6"	6' - 0"	SGL	SERVICE	4 / A111
G10	D.M.	SWING	4' - 0"	4' - 0"	6' - 0"	SGL	SERVICE w/ EXIT	2 / A112
G11	D.M.	SWING	22' - 0"	11' - 0"	6' - 0"	PR	SERVICE	16 / A111
G12	D.M.	SWING	4' - 0"	4' - 0"	6' - 0"	SGL	SERVICE w/ EXIT	2 / A112
G13	D.M.	SWING	4' - 0"	4' - 0"	6' - 0"	SGL	SERVICE	2 / A110
G14	C.L.	SWING	8' - 0"	4' - 0"	6' - 0"	PR	SERVICE	8 / A111
G15	D.M.	SWING	8' - 0"	4' - 0"	6' - 0"	PR	SERVICE	3 / A110

GENERAL NOTES

1. CONCRETE FENCE POST FOOTINGS SHALL NOT ENCR OACH INTO PUBLIC RIGHT OF WAY.
2. CONTRACTOR SHALL PROTECT IMPROVEMENTS WITHIN THE PUBLIC RIGHT-OF-WAY FROM DAMAGE DURING CONSTRUCTION ACTIVITIES.
3. CONTRACTOR SHALL OBTAIN AN ENCROACHMENT PERMIT BEFORE PERFORMING ANY WORK OR REPAIRS WITHIN THE CITY RIGHT-OF-WAY.
4. ANY WORK OR REPAIRS WITHIN THE CITY RIGHT-OF-WAY SHALL BE PER CITY OF MERCED STANDARDS.
5. CONTRACTOR SHALL MODIFY, REPAIR AND ADJUST (E) IRRIGATION SYSTEM TO ENSURE PROPER IRRIGATION COVERAGE TO (E) MODIFIED TURF AREAS.
6. CONTRACTOR SHALL REPLACE AND/OR REPAIR ANY DAMAGED IRRIGATION, OR TURF AREAS DISTURBED DURING THE COURSE OF CONSTRUCTION.
7. CONTRACTOR TO FIELD VERIFY ALL DIMENSIONS AND SITE CONDITIONS PRIOR TO SUBMITTING THEIR BID
8. MODIFY IRRIGATION PIPING AND SPRAY HEADS AS NEEDED FOR LANDSCAPE ADJUSTMENTS, FENCING INSTALLATION, AND/OR CONCRETE MOWSTRIP

LEGEND

- (E) DECORATIVE METAL FENCE TO REMAIN
- (E) CHAINLINK FENCE TO REMAIN
- PROPOSED 6'-0" DECORATIVE METAL FENCE, BLACK, SEE 2 / A111
- PROPOSED CHAIN LINK FENCE. HEIGHT VARIES PER LOCATION
- GATE DESIGNATION
- (E) BUILDING, NO WORK
- (E) 20'-0" FIRE LANE PER DSA# 02-14807
- (E) ACCESSIBLE PATH OF TRAVEL PER DSA #02-106533
- (E) PATH OF EMERGENCY EGRESS PER DSA #02-106533
- (E) FH EXISTING FIRE HYDRANT
- NEW ASPHALT PAVING PER SPECIFICATIONS

KEYNOTES

- 2.01 (E) VEHICLE GATE TO REMAIN
- 2.02 (E) METAL GATE TO REMAIN
- 2.18 EXISTING ACCESSIBLE PARKING LOT ENTRANCE TOW-AWAY SIGN (DSA A# 02-106533)
- 2.19 EXISTING ACCESSIBLE PARKING STALLS (QTY 2), SIGNAGE AND ACCESS AISLE TO REMAIN (DSA A# 02-114807)
- 2.56 REMOVE EXISTING DETECTABLE WARNING STRIP
- 2.78 REMOVE EXISTING CHAIN LINK FENCE
- 10.61 KNOX BOX, EMERGENCY SERVICES KEY STORAGE
- 32.01 INFILL AC PAVING UP TO CONC. MOW STRIP
- 32.61 INSTALL NEW FENCING 2' FROM EXISTING RESIDENTIAL FENCE
- 32.66 6'-0" FT HIGH, BLACK DECORATIVE METAL FENCING. SEE 2 / A111
- 32.67 DECORATIVE METAL SERVICE GATE, SEE 2 / A110
- 32.68 10'-0" FT HIGH, CHAIN LINK FENCING W/ NO CLIMB FABRIC, SEE 12 / A110
- 32.69 DECORATIVE METAL PAIR OF SWING SERVICE GATES, SEE 3 / A110
- 32.71 DECORATIVE METAL FIRE ACCESS GATE, SEE 16 / A111
- 32.75 NEW NO-CLIMB CHAIN LINK FABRIC, BLACK

MERCED CITY SCHOOL DISTRICT
NEW PERIMETER FENCING
HERBERT HOOVER MIDDLE
MERCED, CA


PROJECT NO.

24-13173.02

DRAWING

A100

TETER, INC.
FRESNO HEADQUARTERS
VISALIA | BAKERSFIELD | MODESTO | SAN LUIS OBISPO
ARCHITECTS ENGINEERS CONNECTED

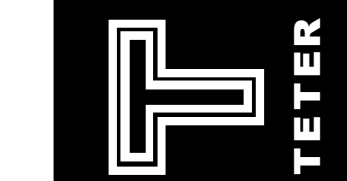

DRAWING TITLE
SITE PLAN

Teter, Inc. expressly reserves its common law copyright and other property rights in these plans. This document, the ideas and designs incorporated herein, as an instrument of professional service, is not to be used for any other project without prior written authorization.

1

11/13/25 ADDENDUM NO. 01

MARK



DATE

DESCRIPTION

A

10/07/25

DSA SUBMITTAL

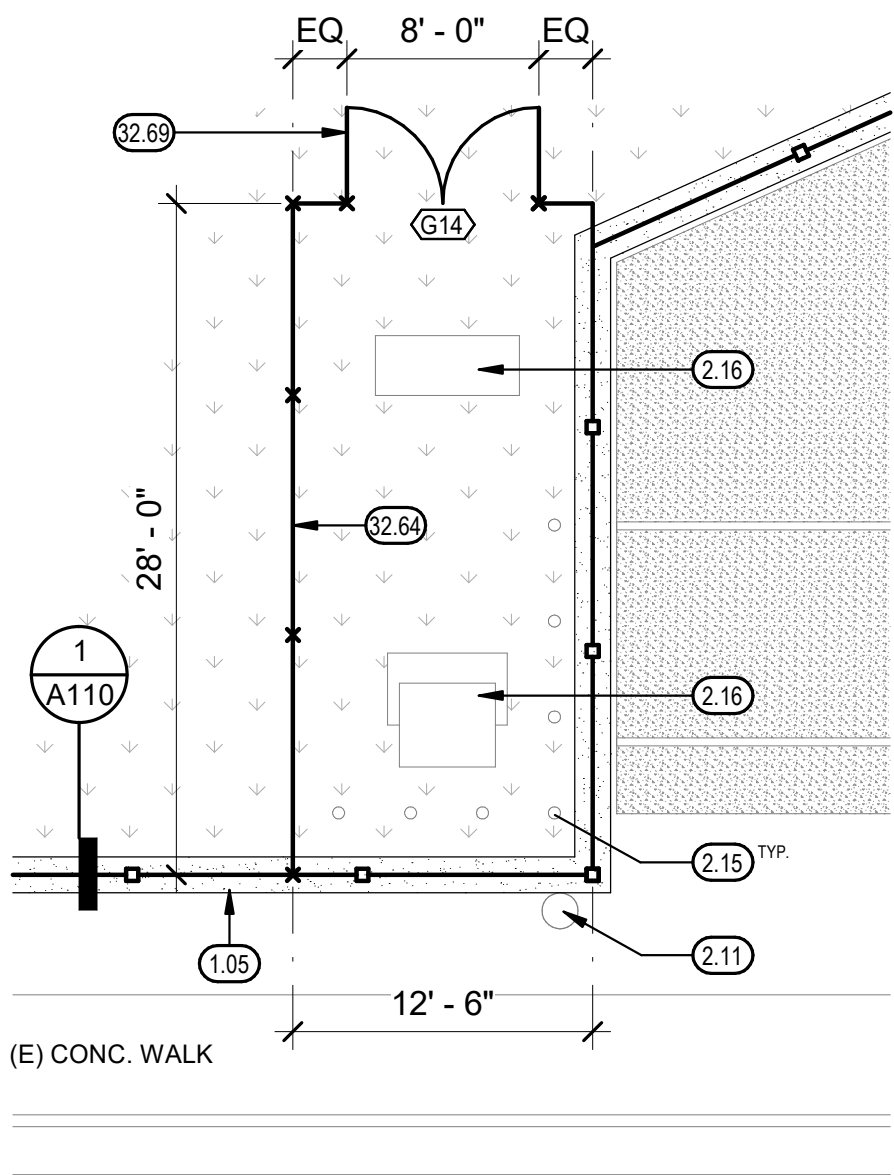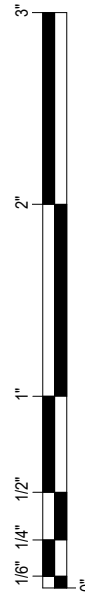


E SANTA FE AVE.



ENLARGED SITE PLAN

1/8" = 1'-0"

18

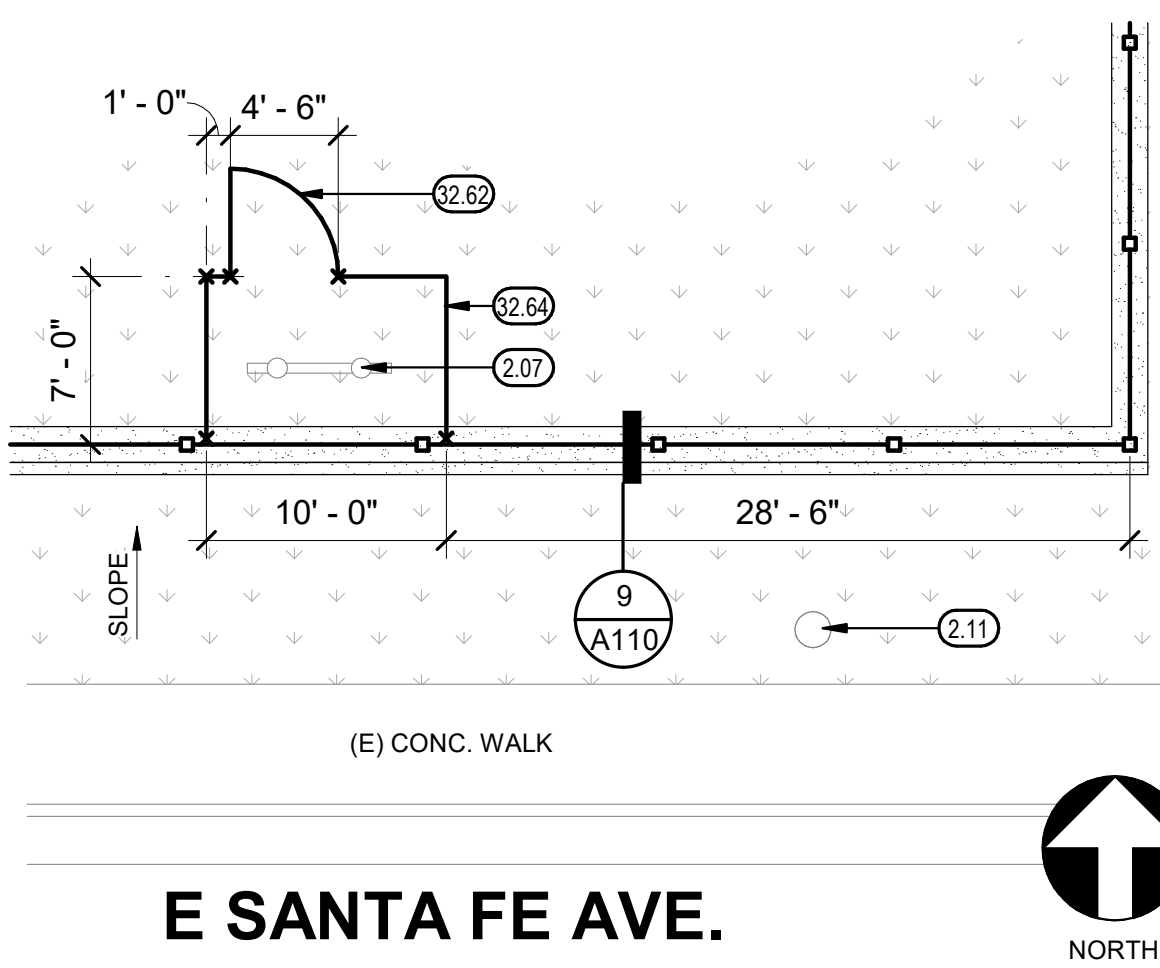


E SANTA FE AVE.



ENLARGED SITE PLAN

1/8" = 1'-0"

13

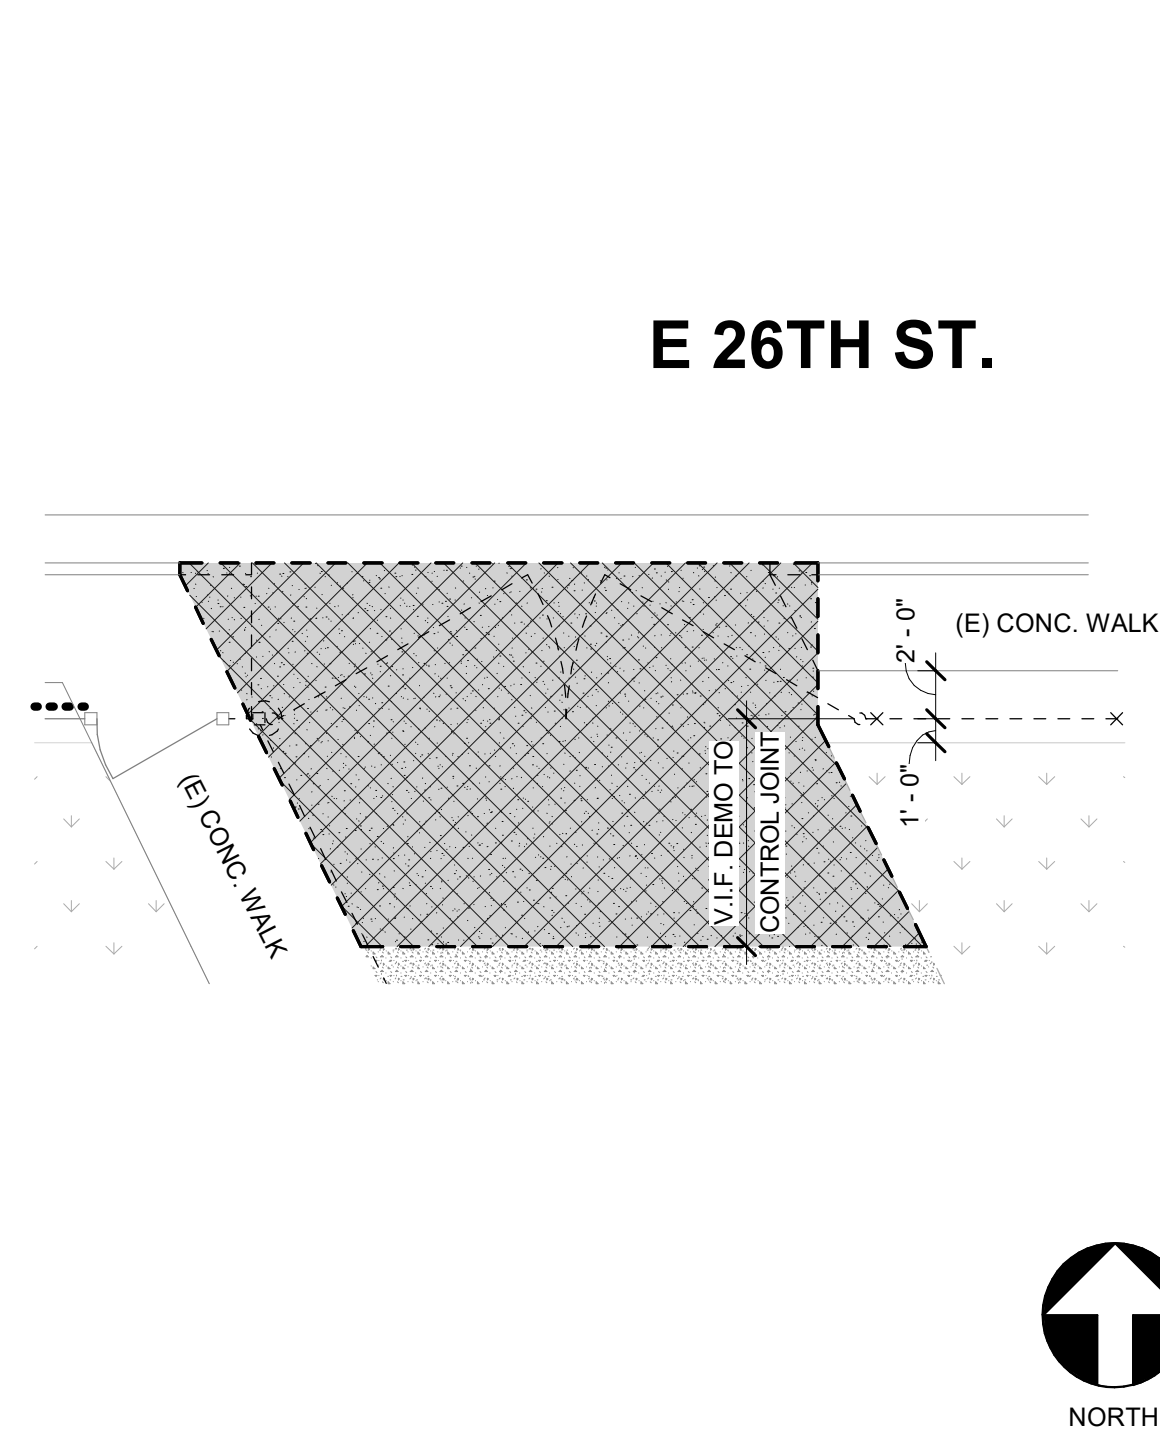


E 26TH ST.



DEMO ENLARGED SITE PLAN

1/8" = 1'-0"

15

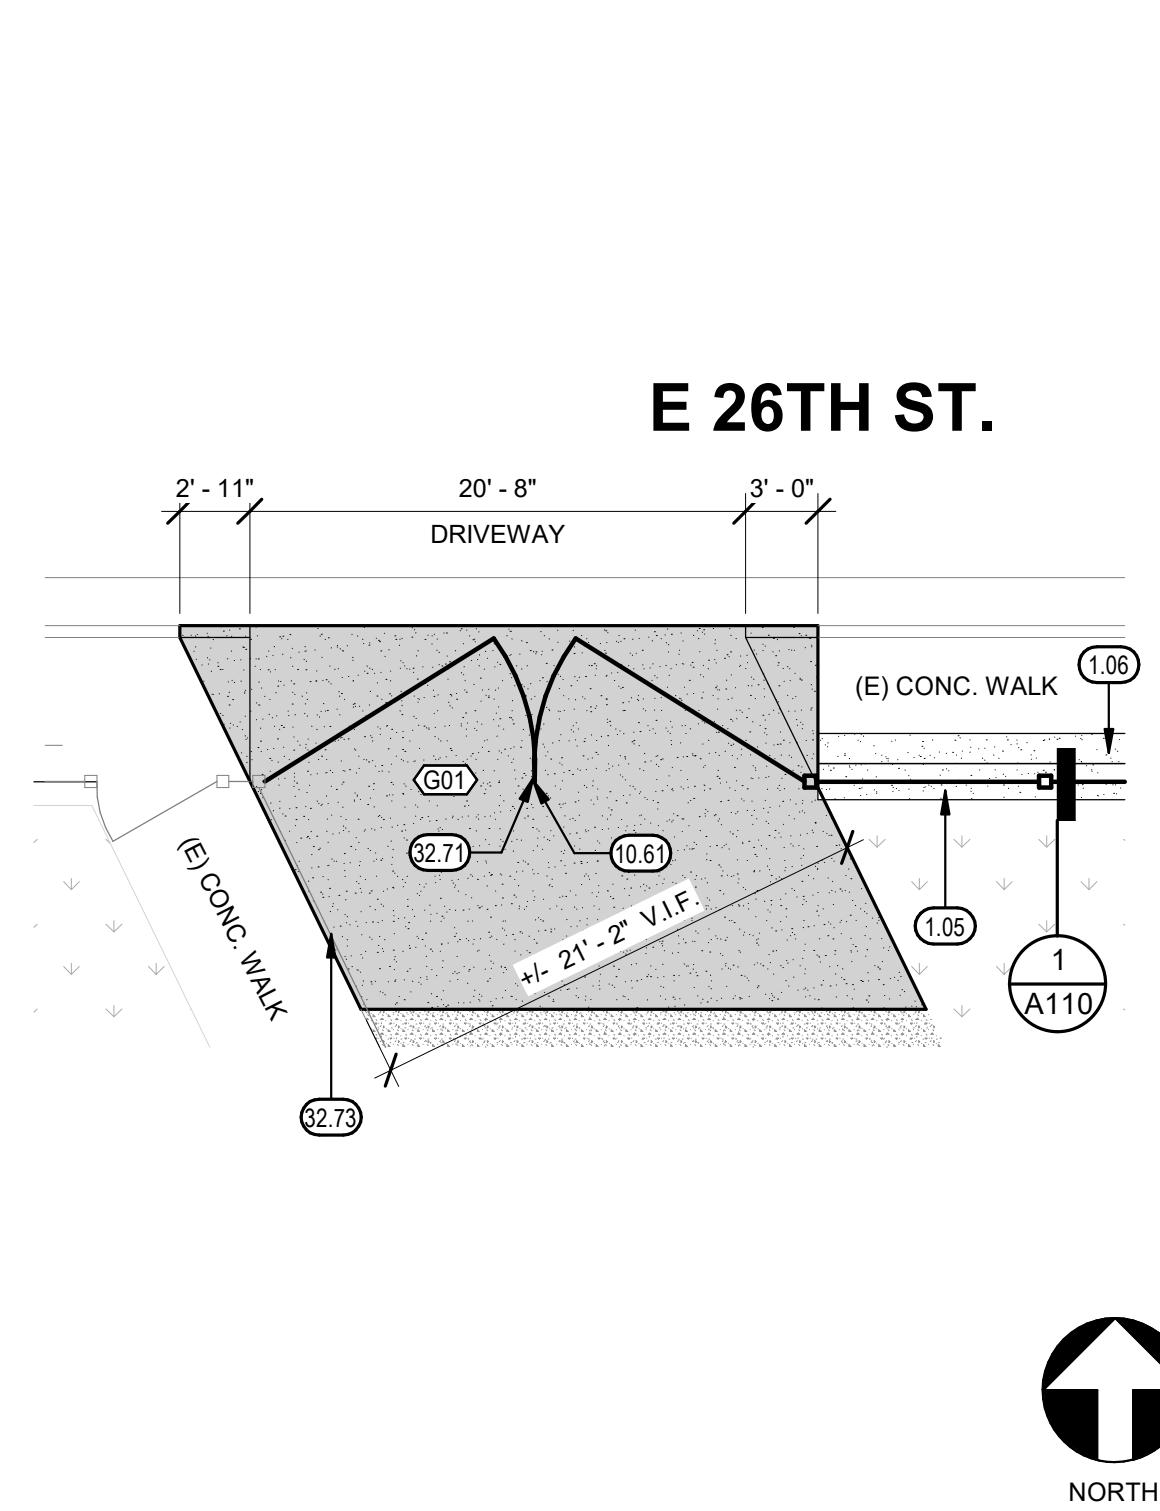


E 26TH ST.



ENLARGED SITE PLAN

1/8" = 1'-0"


16

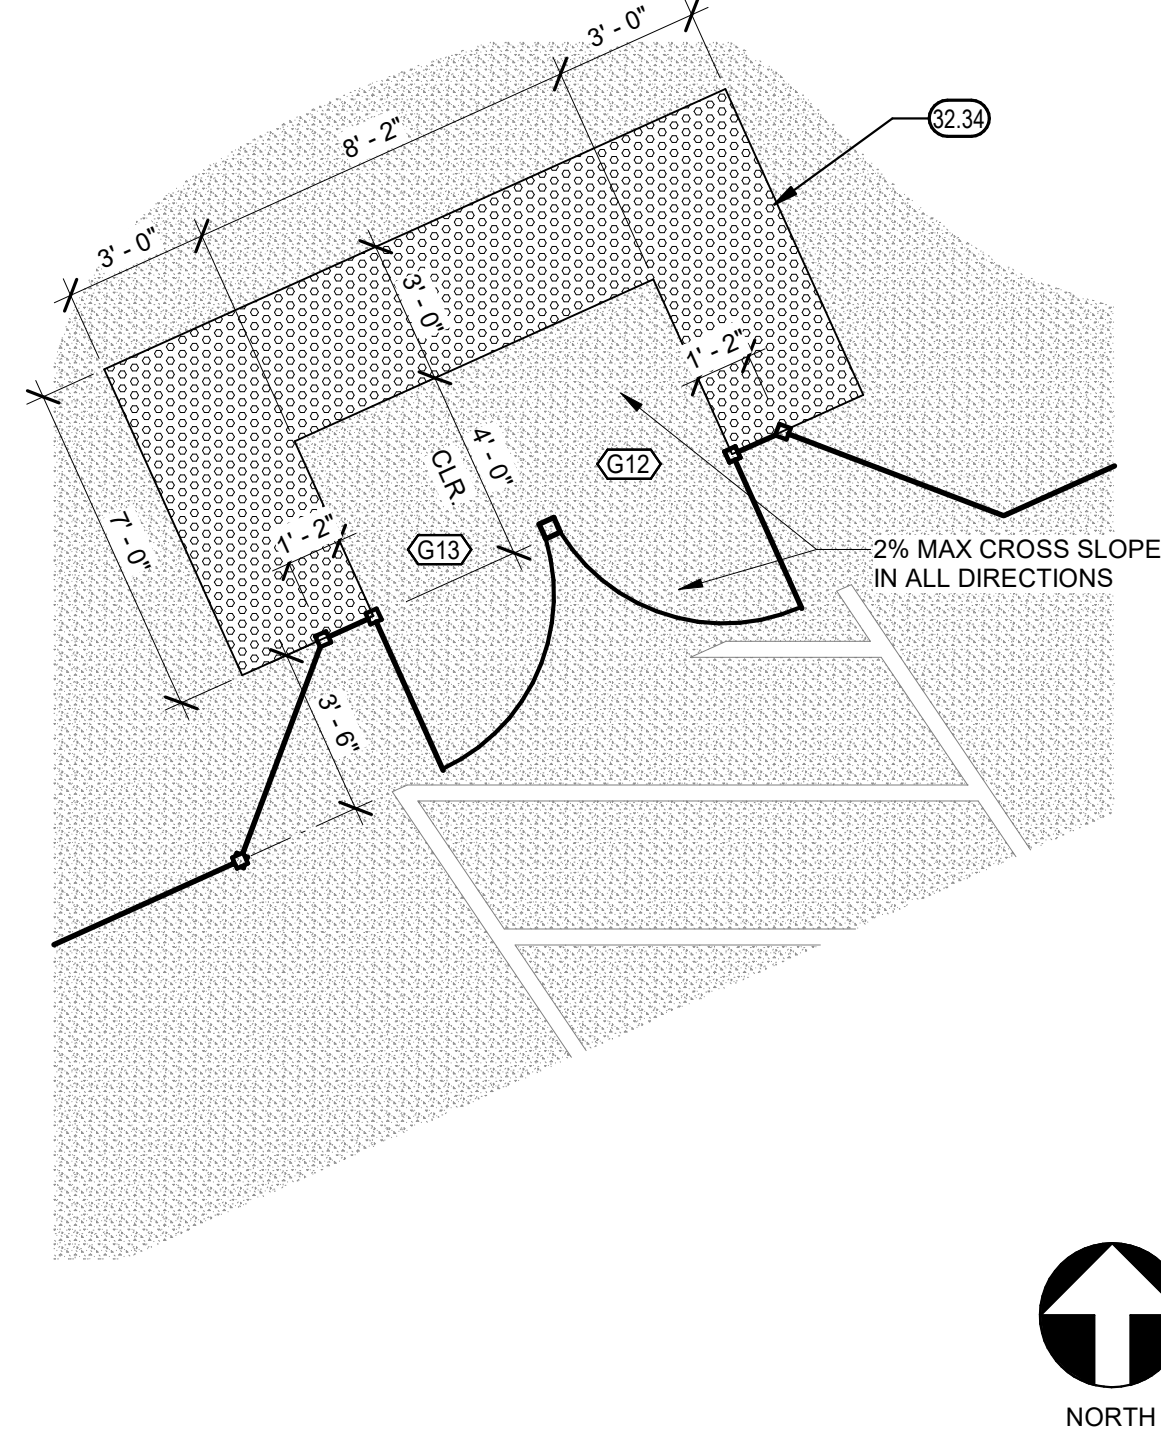

ENLARGED SITE PLAN

1/4" = 1'-0"

11

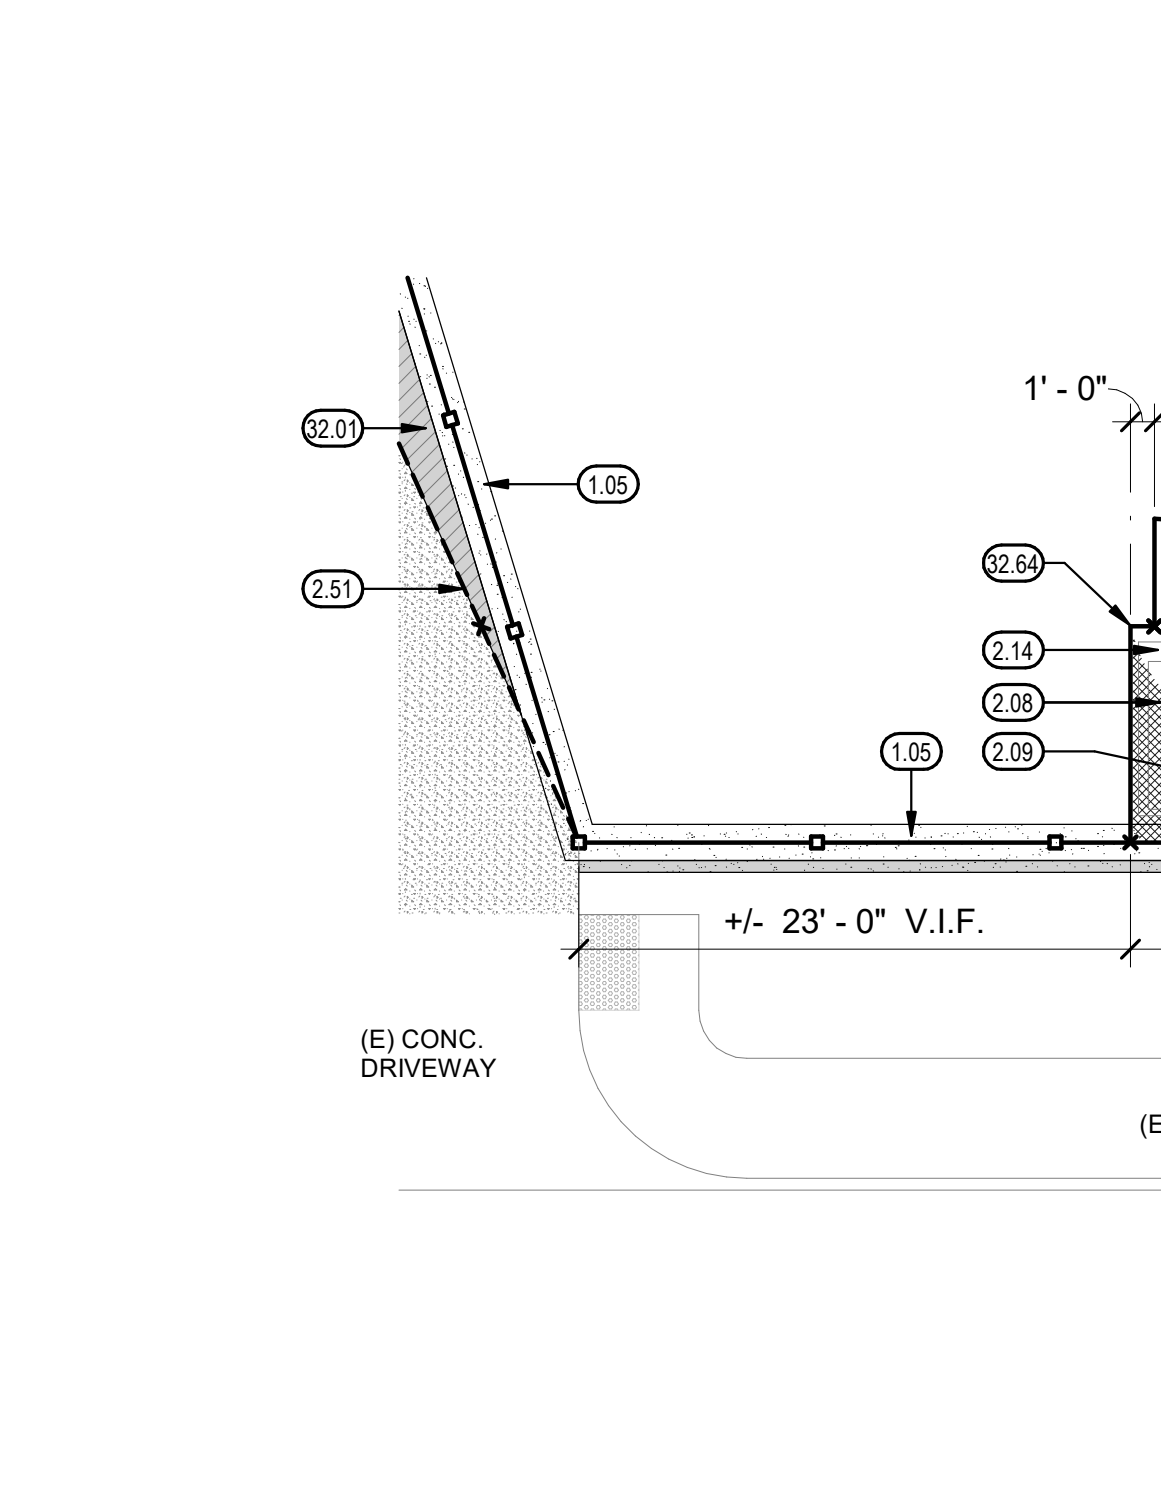


E 26TH ST.



ENLARGED SITE PLAN

1/8" = 1'-0"


5

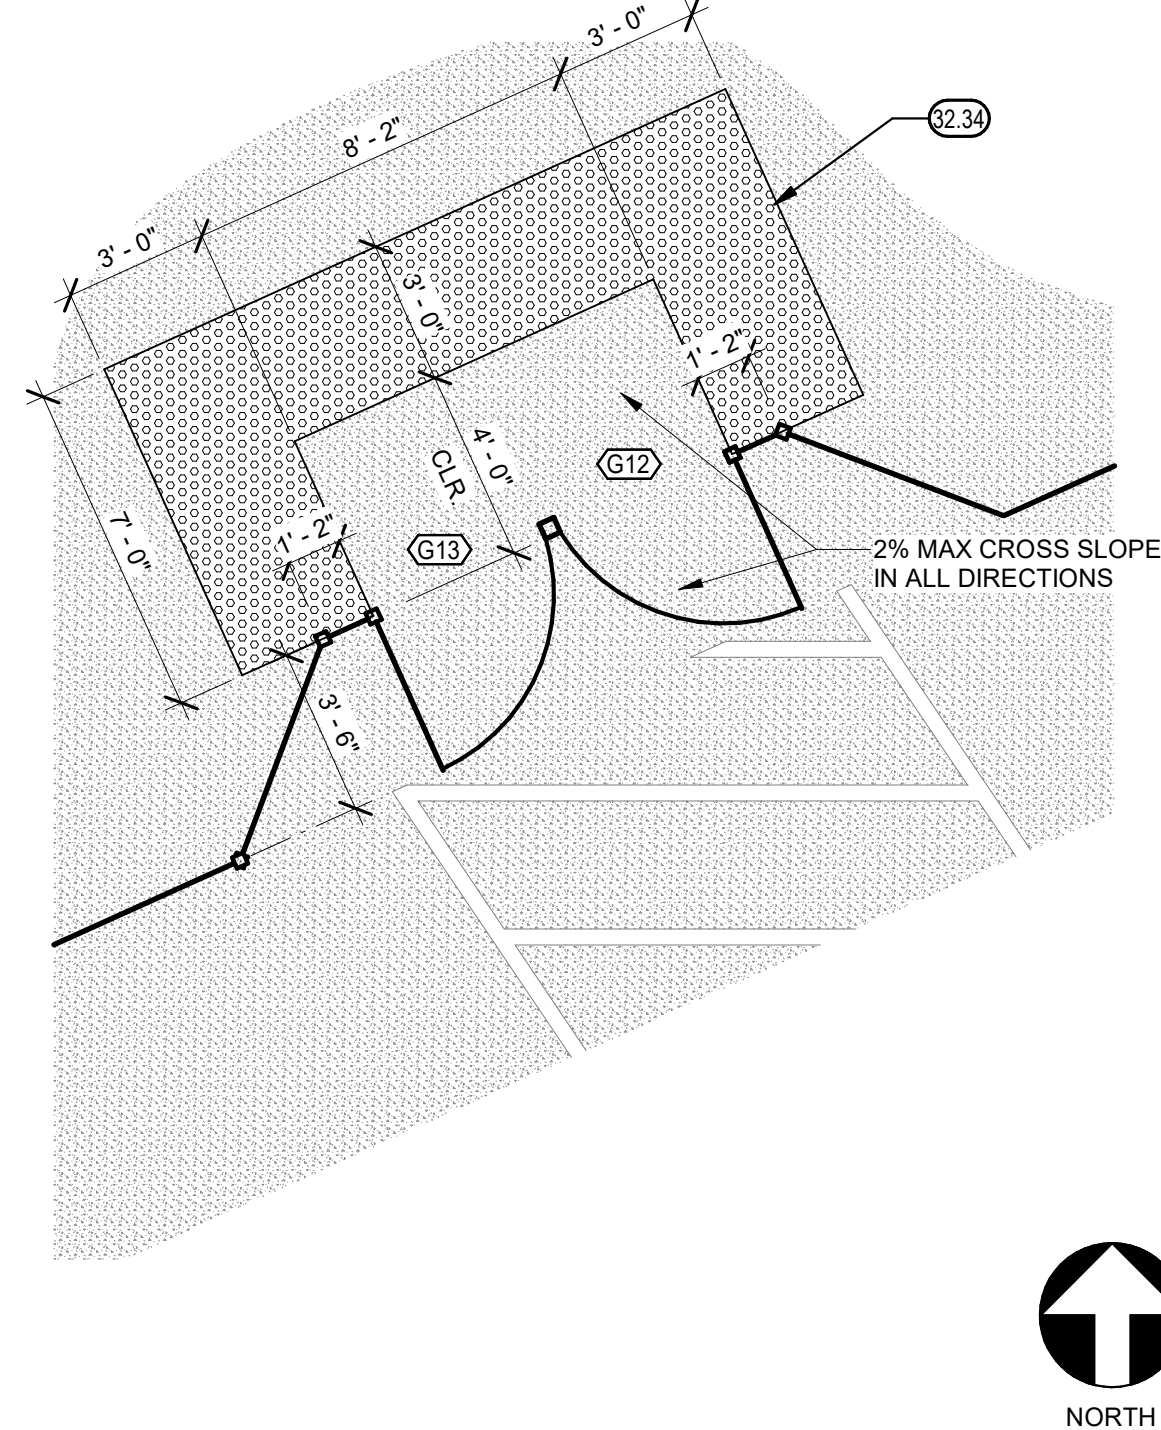

ENLARGED SITE PLAN

1/4" = 1'-0"


11

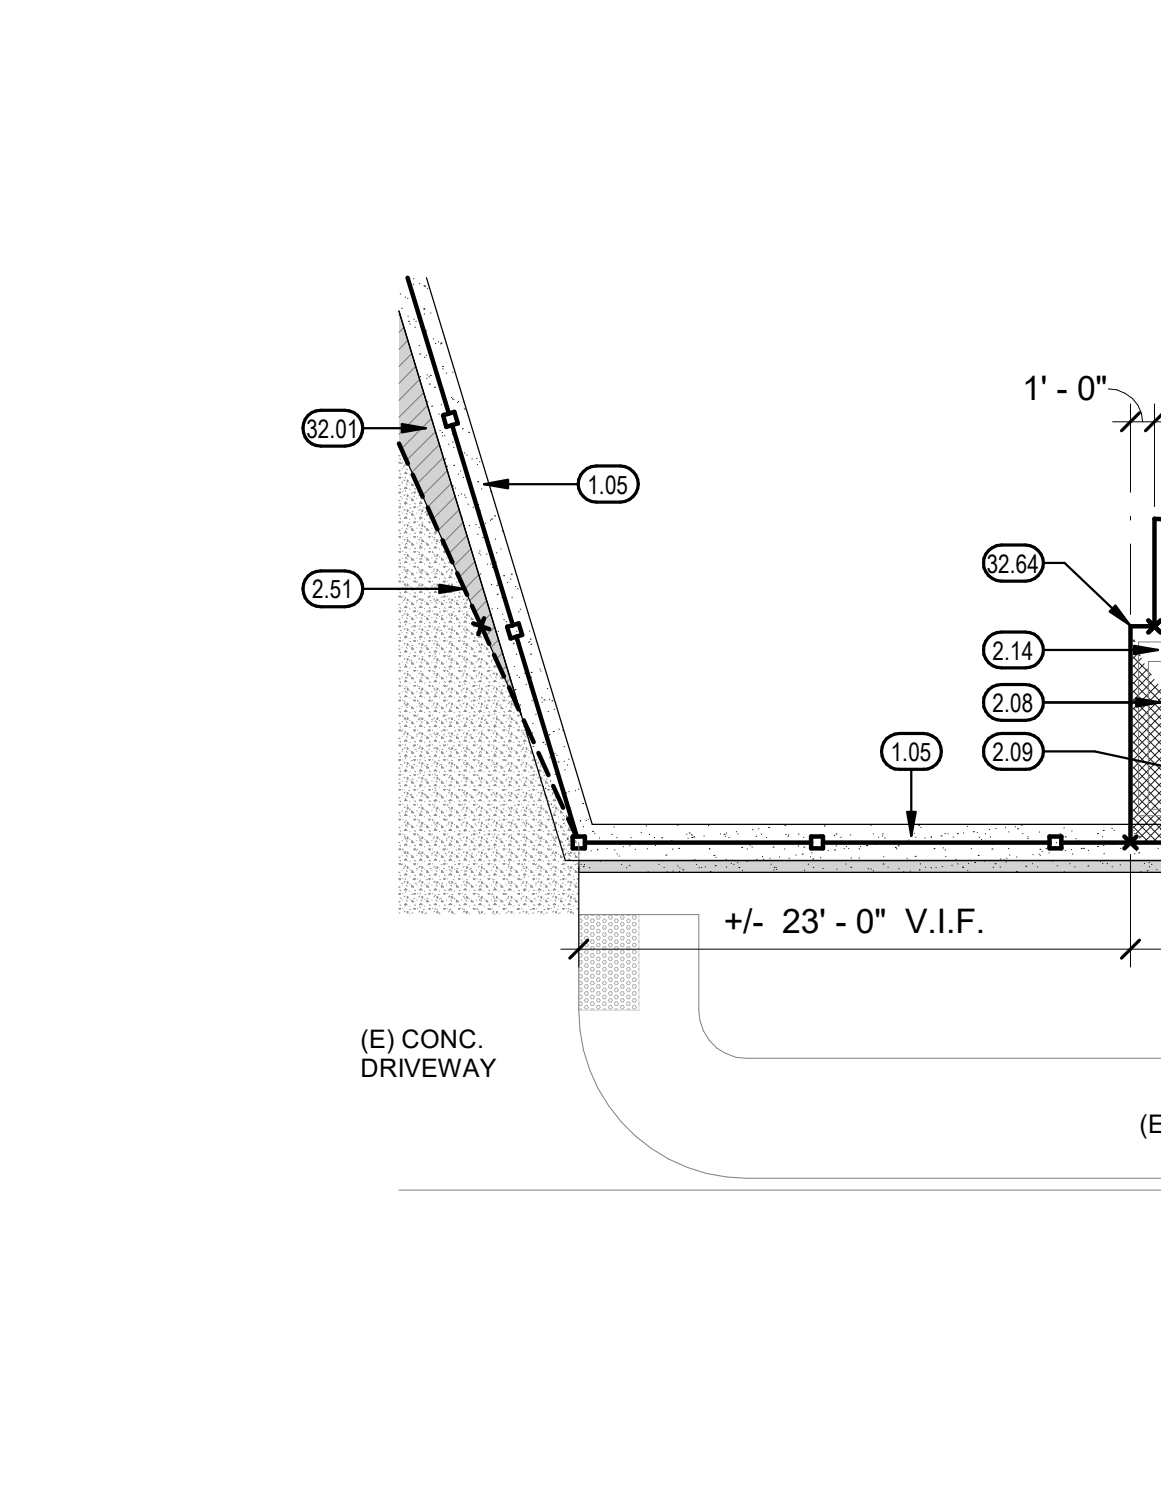

ENLARGED SITE PLAN

1/4" = 1'-0"


11

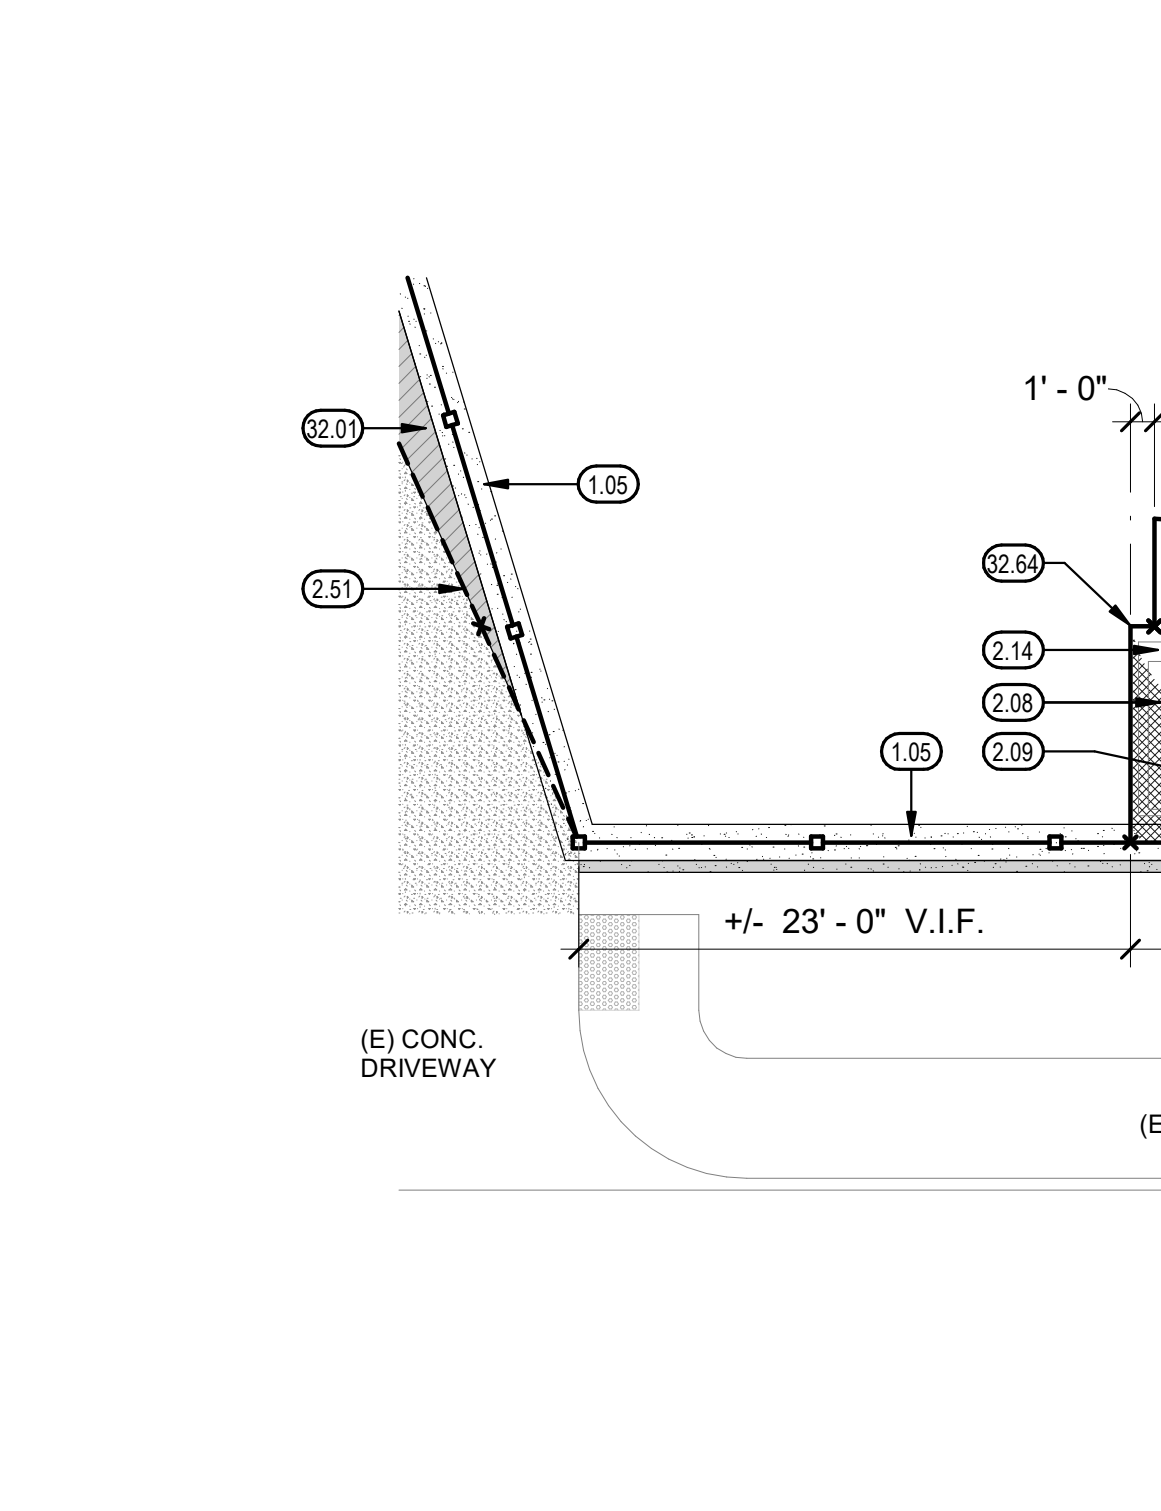

ENLARGED SITE PLAN

1/4" = 1'-0"


11

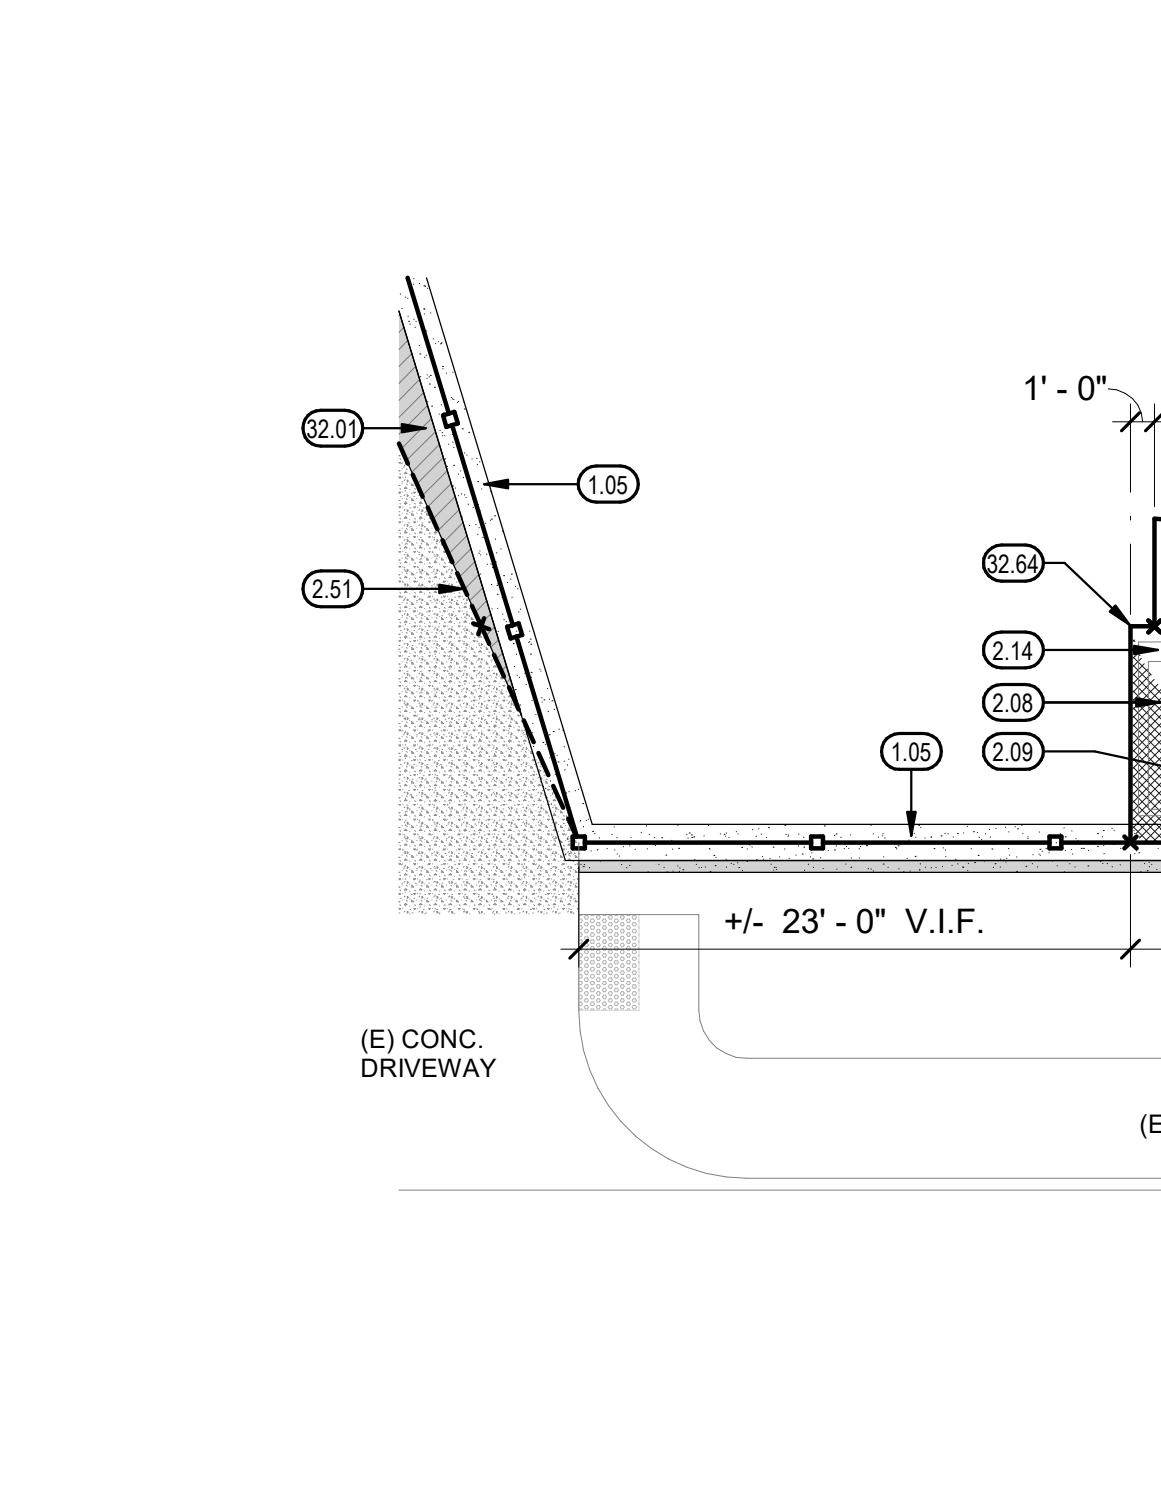

ENLARGED SITE PLAN

1/4" = 1'-0"


11

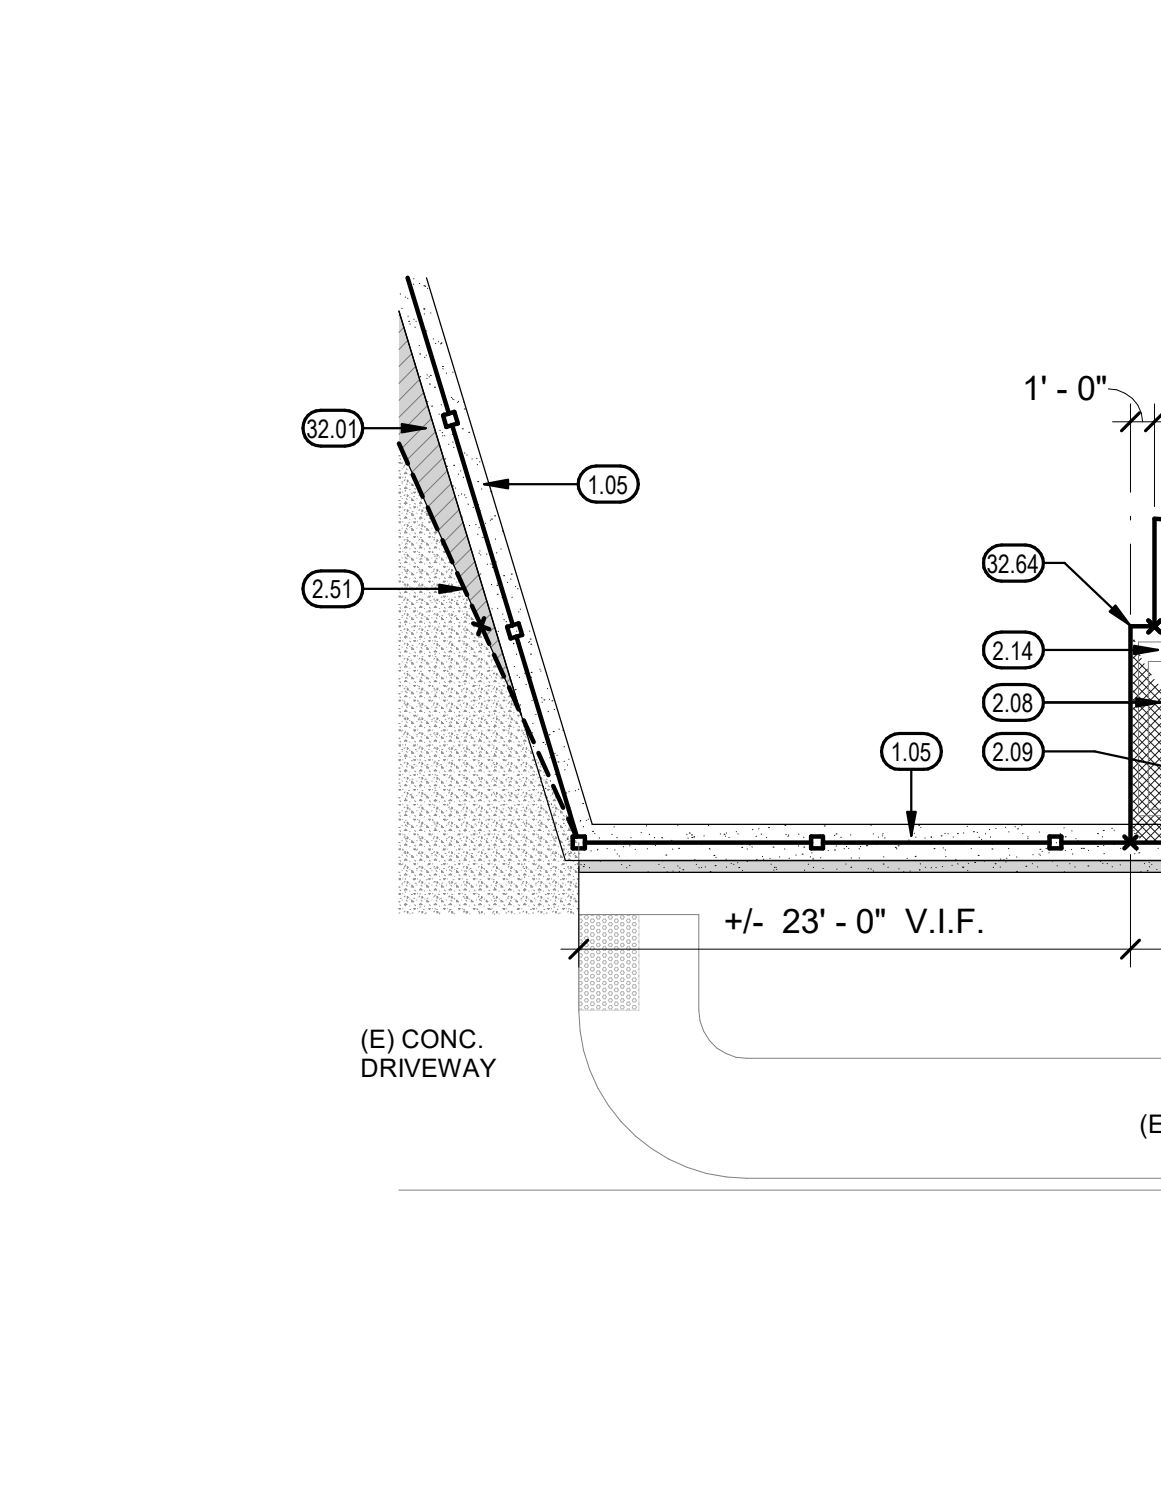

ENLARGED SITE PLAN

1/4" = 1'-0"


11

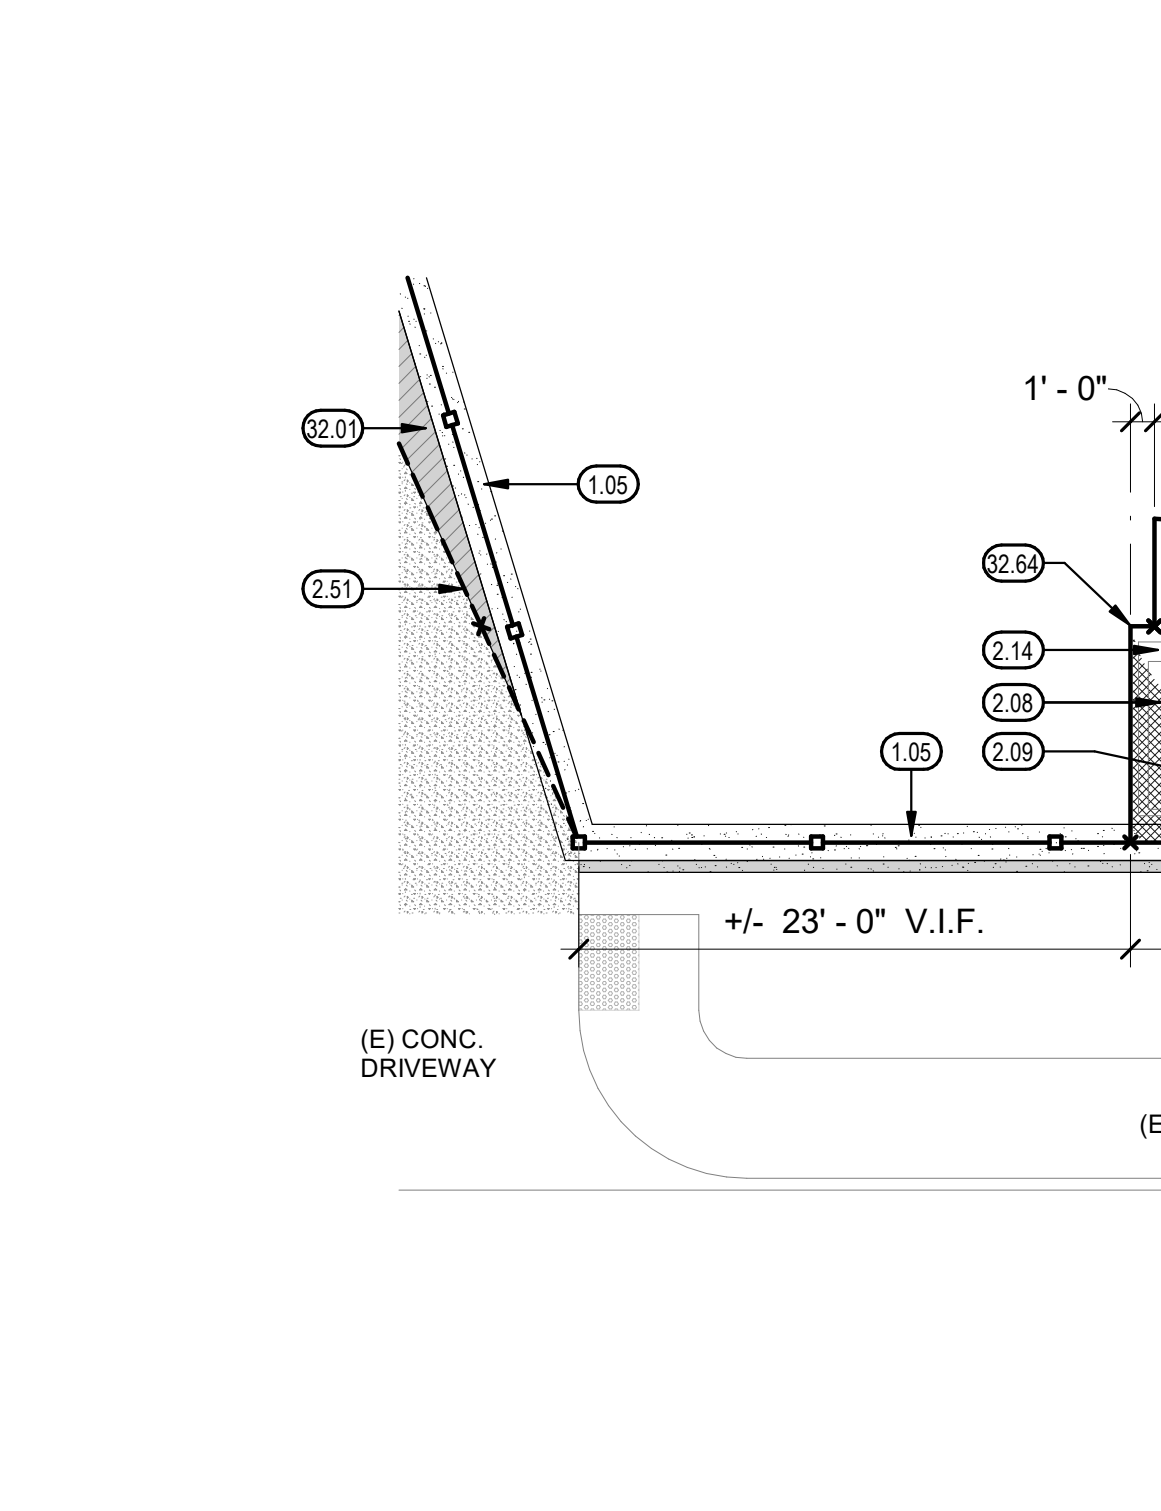

ENLARGED SITE PLAN

1/4" = 1'-0"


11

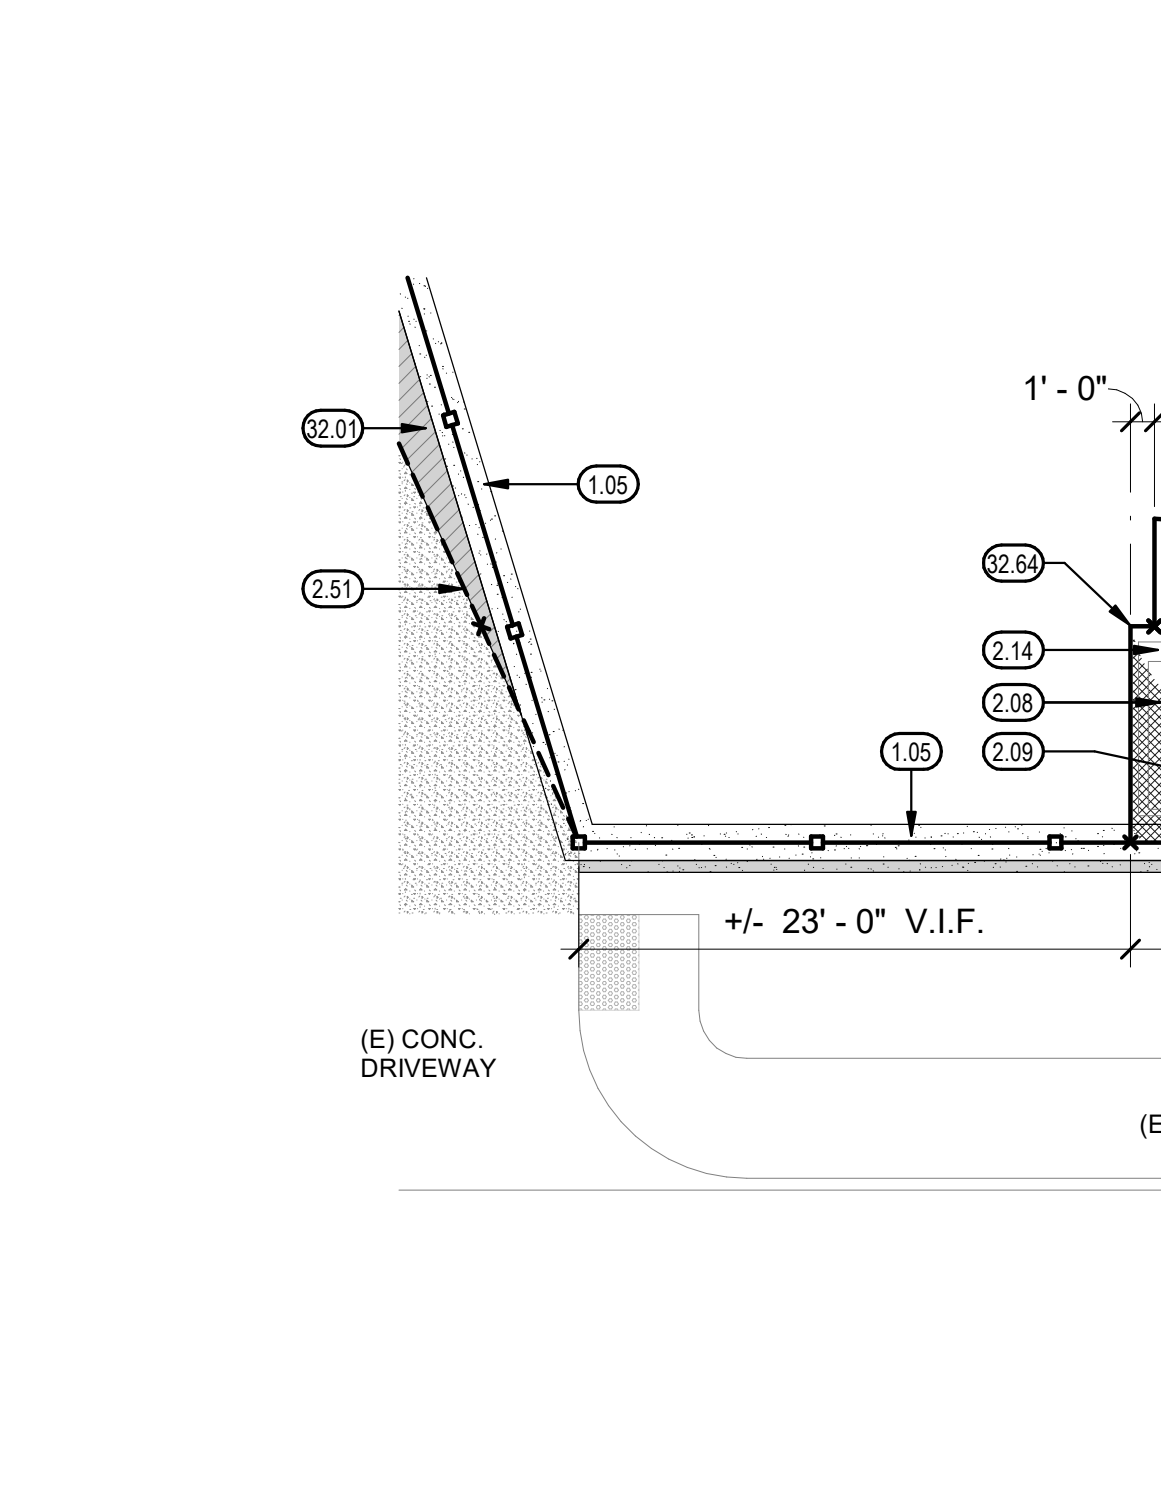

ENLARGED SITE PLAN

1/4" = 1'-0"


11

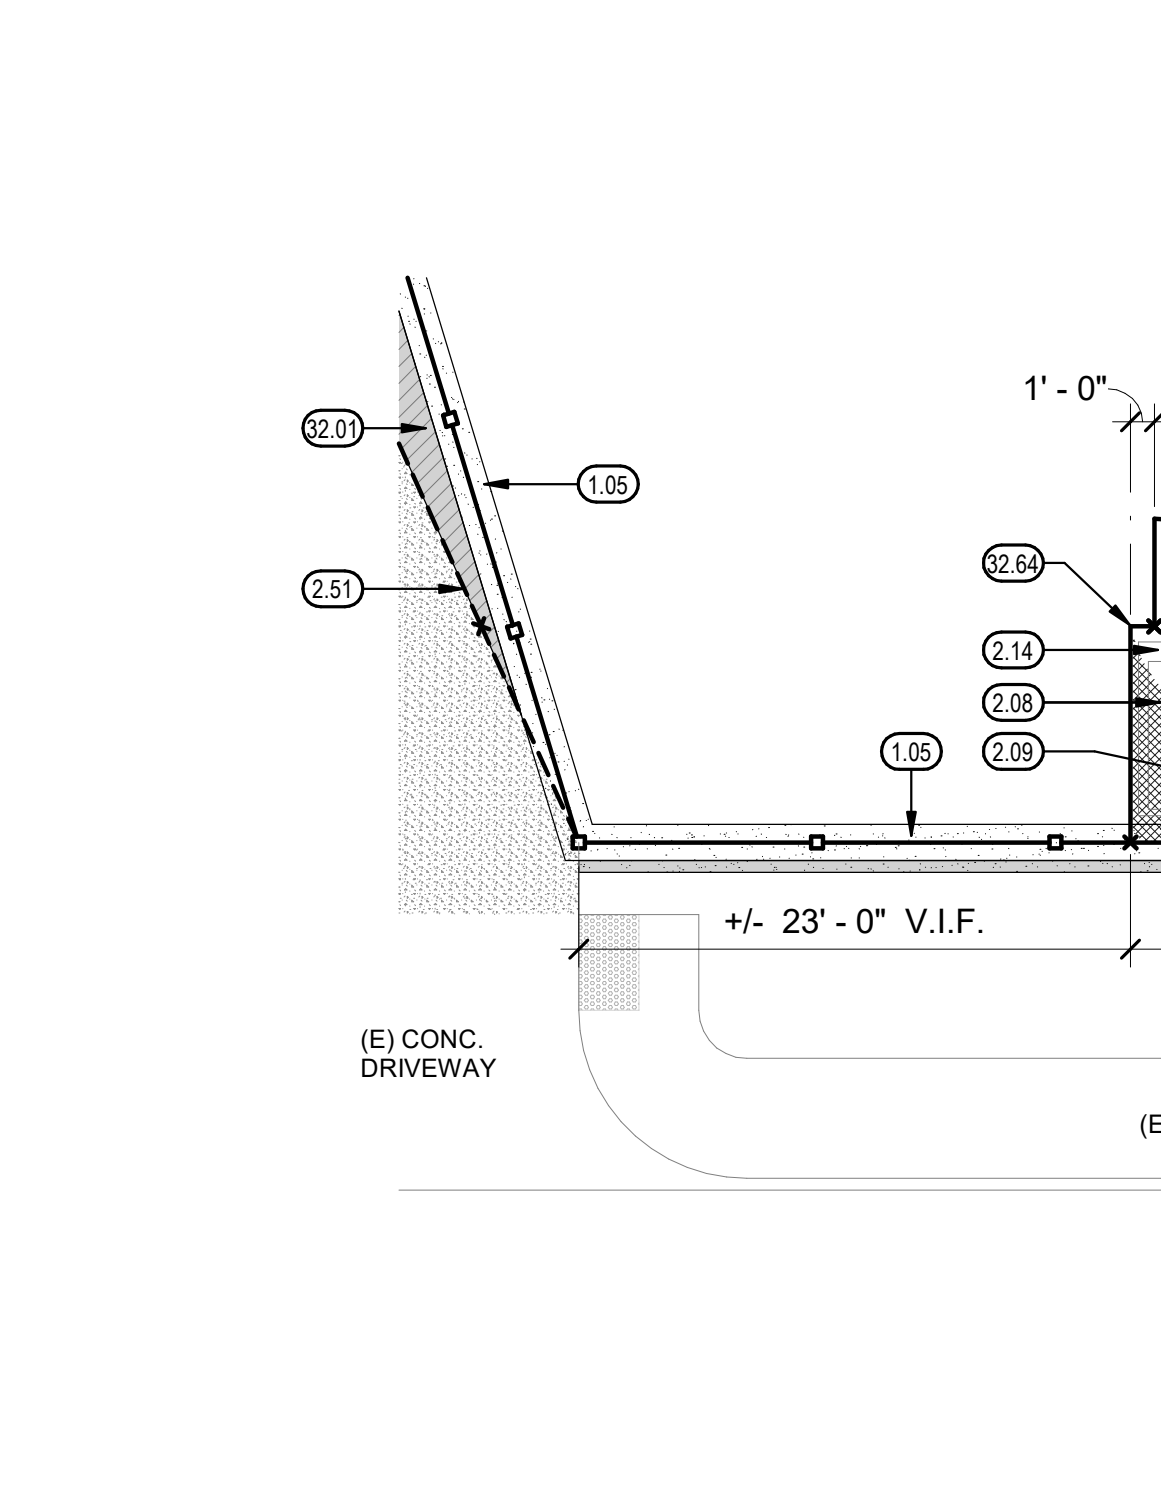

ENLARGED SITE PLAN

1/4" = 1'-0"


11

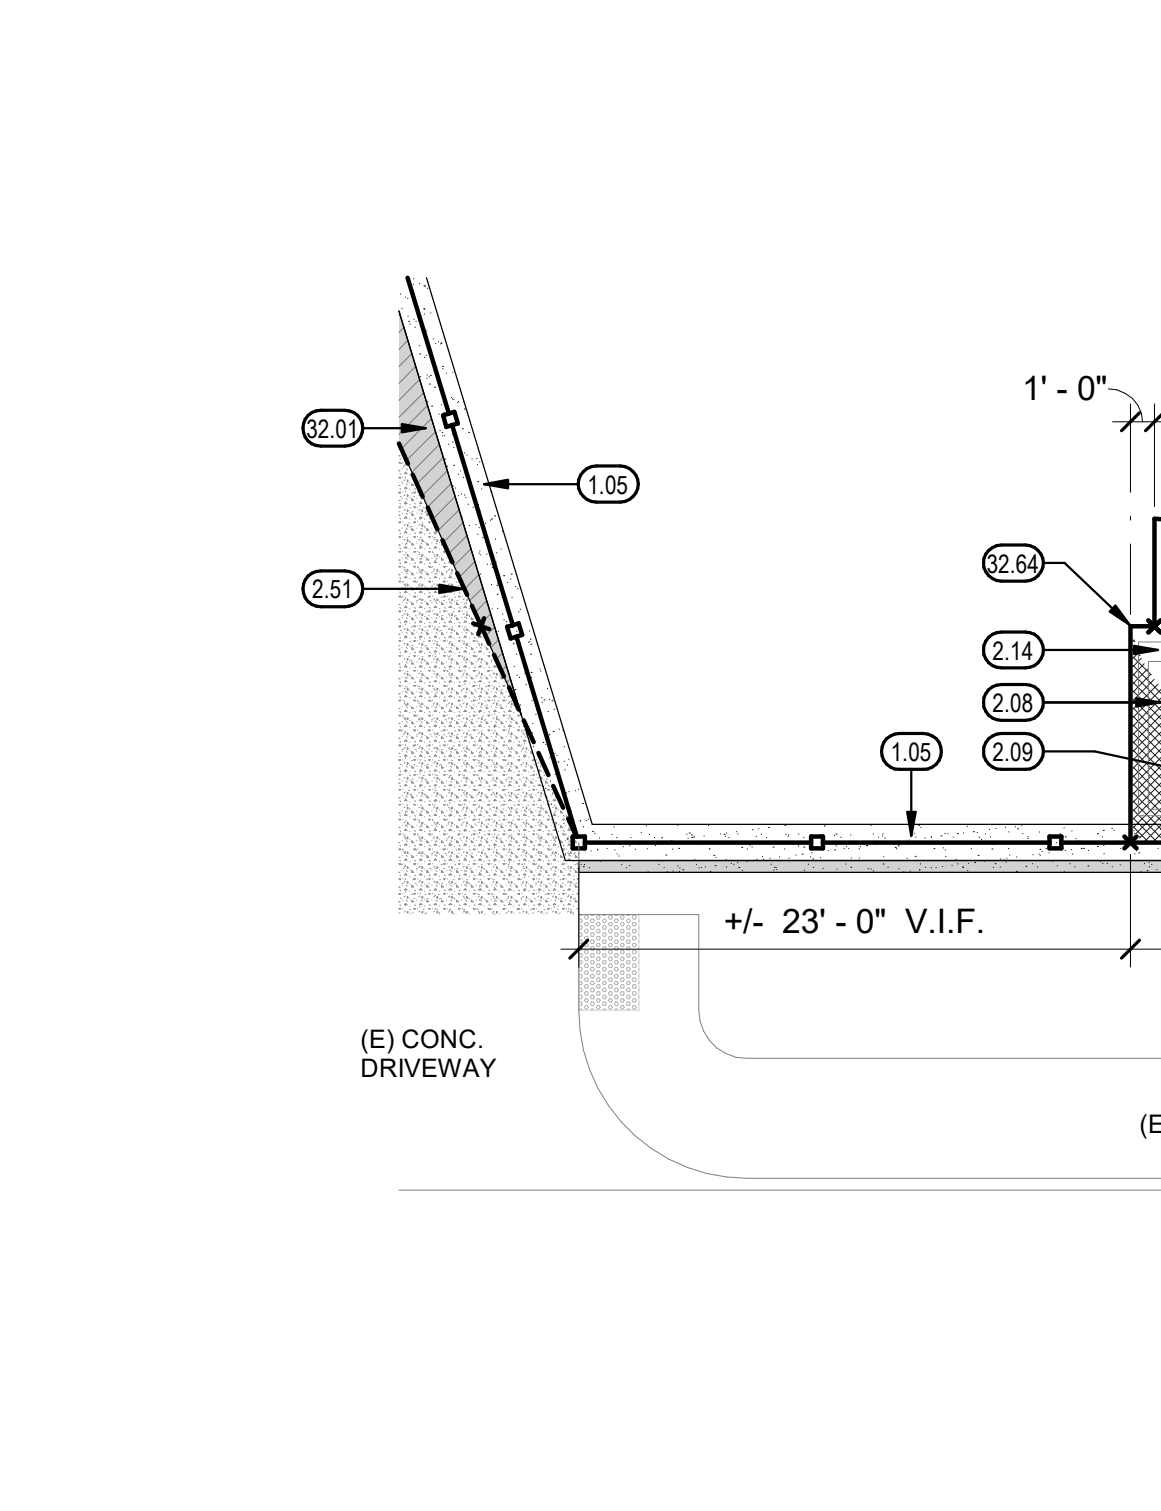

ENLARGED SITE PLAN

1/4" = 1'-0"


11

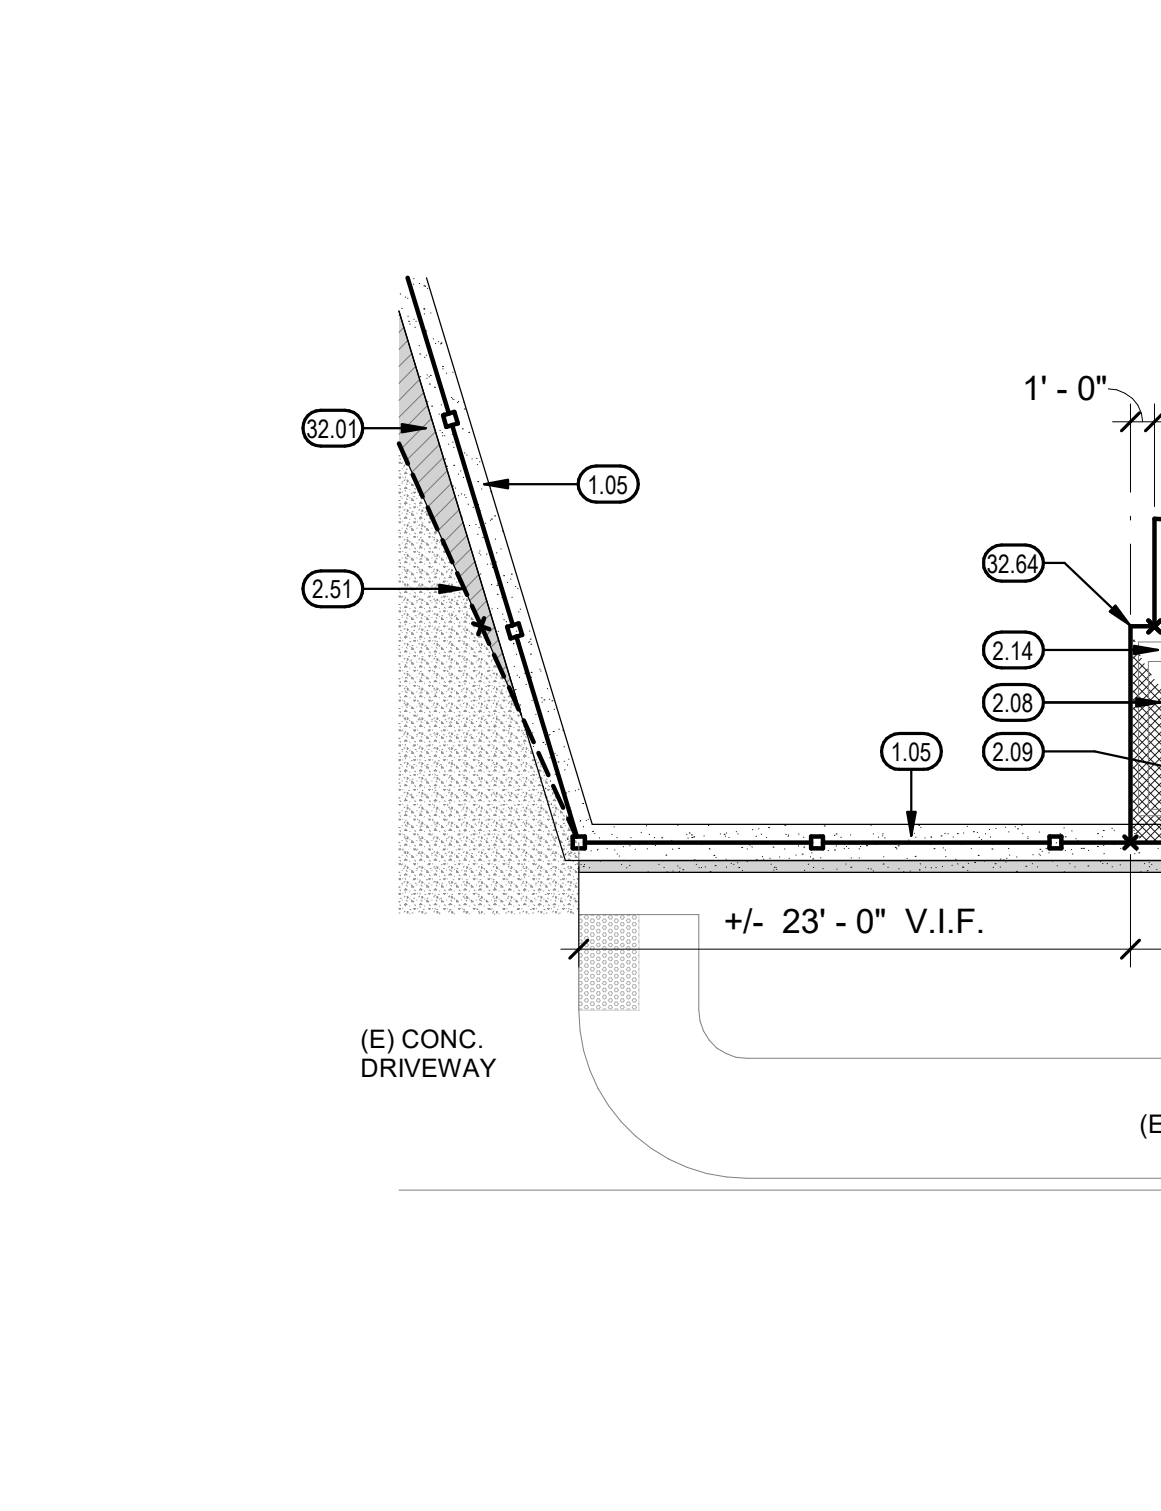

ENLARGED SITE PLAN

1/4" = 1'-0"


11

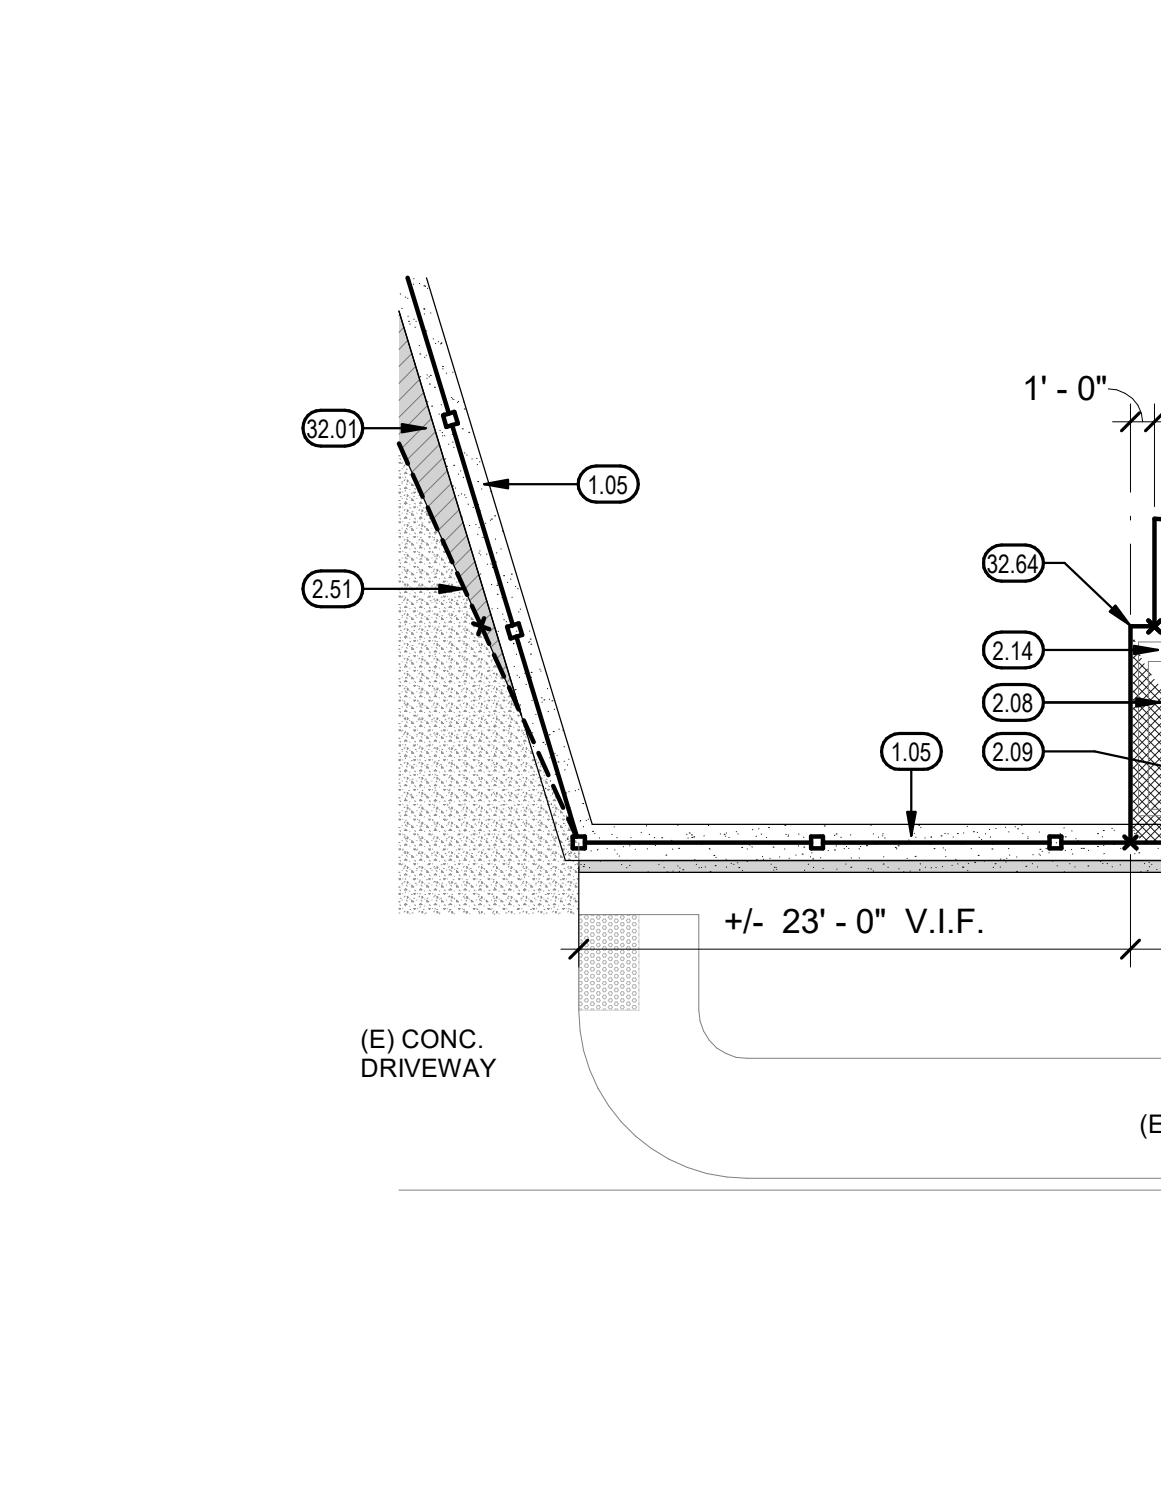

ENLARGED SITE PLAN

1/4" = 1'-0"


11

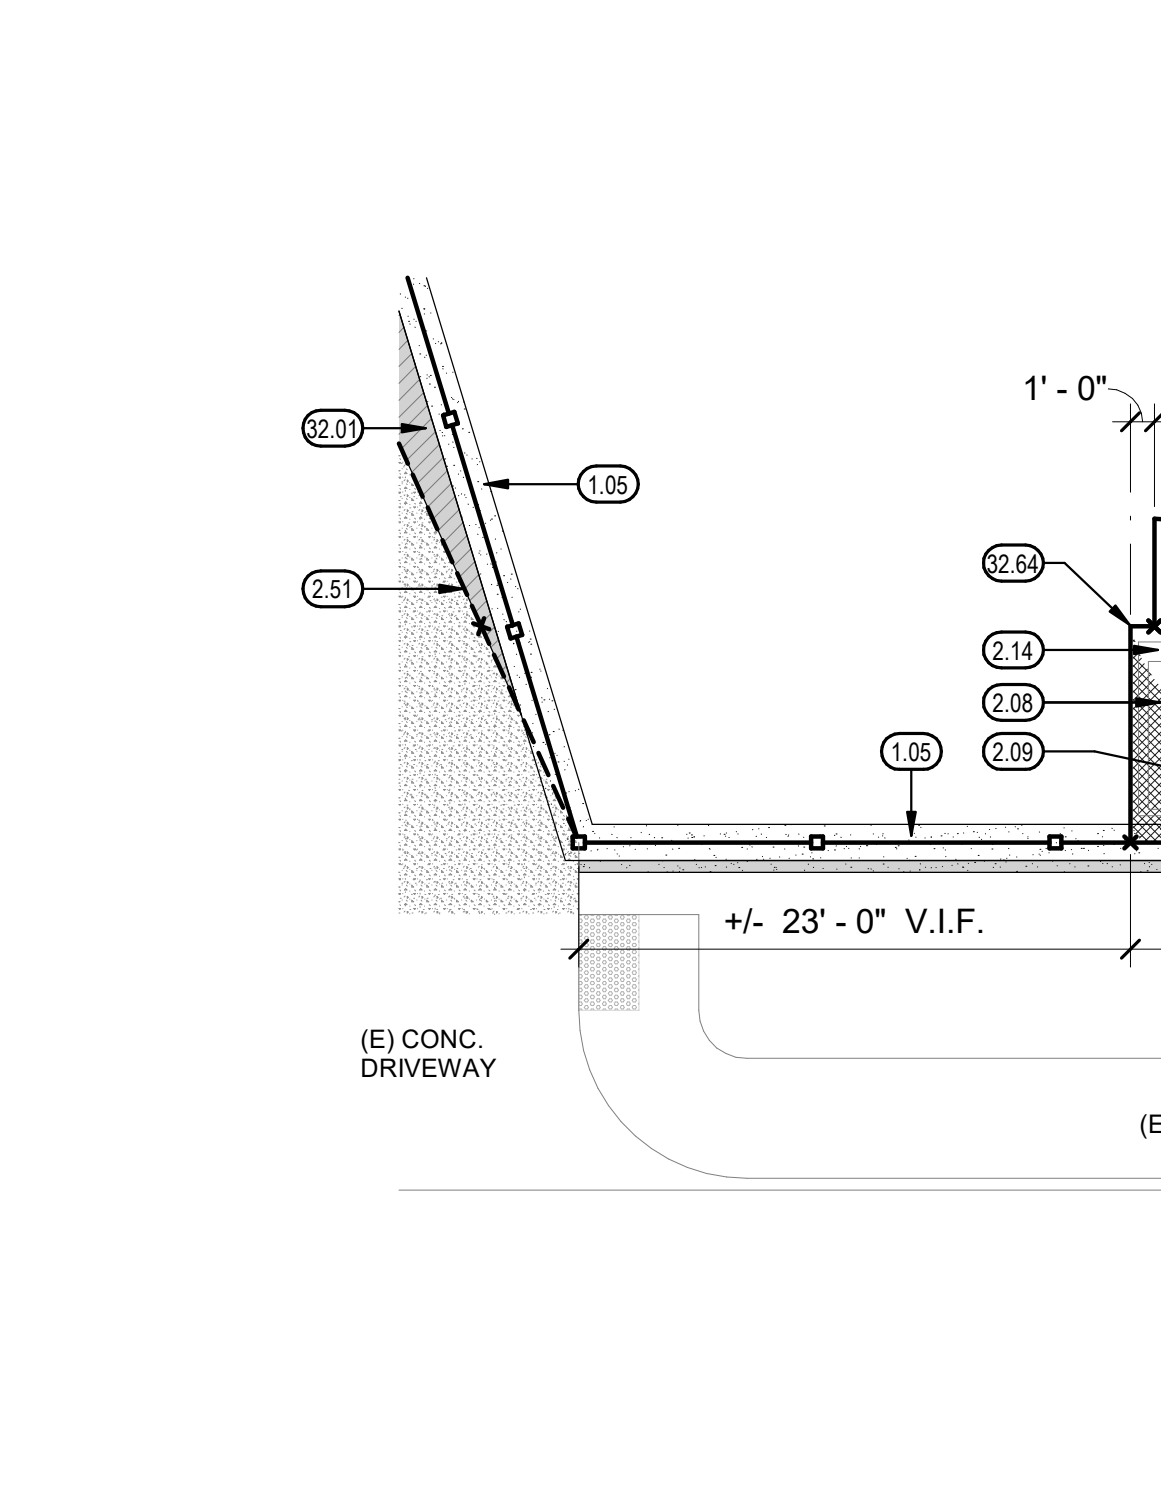

ENLARGED SITE PLAN

1/4" = 1'-0"


11

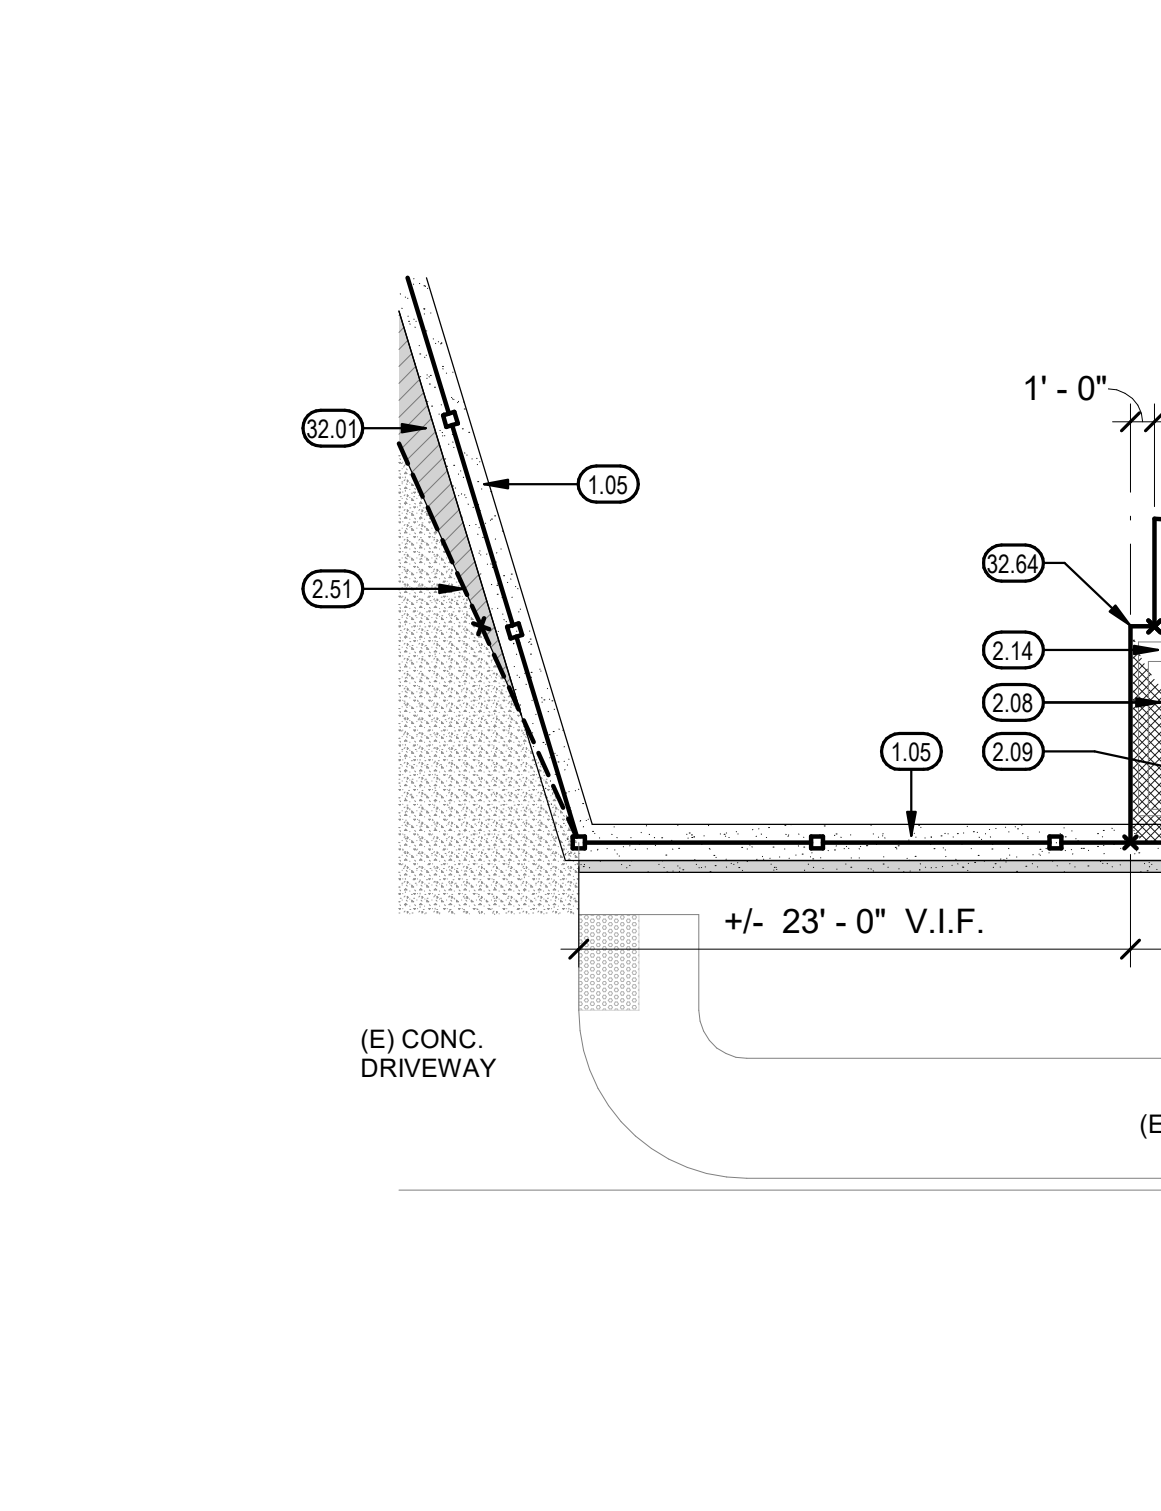

ENLARGED SITE PLAN

1/4" = 1'-0"


11

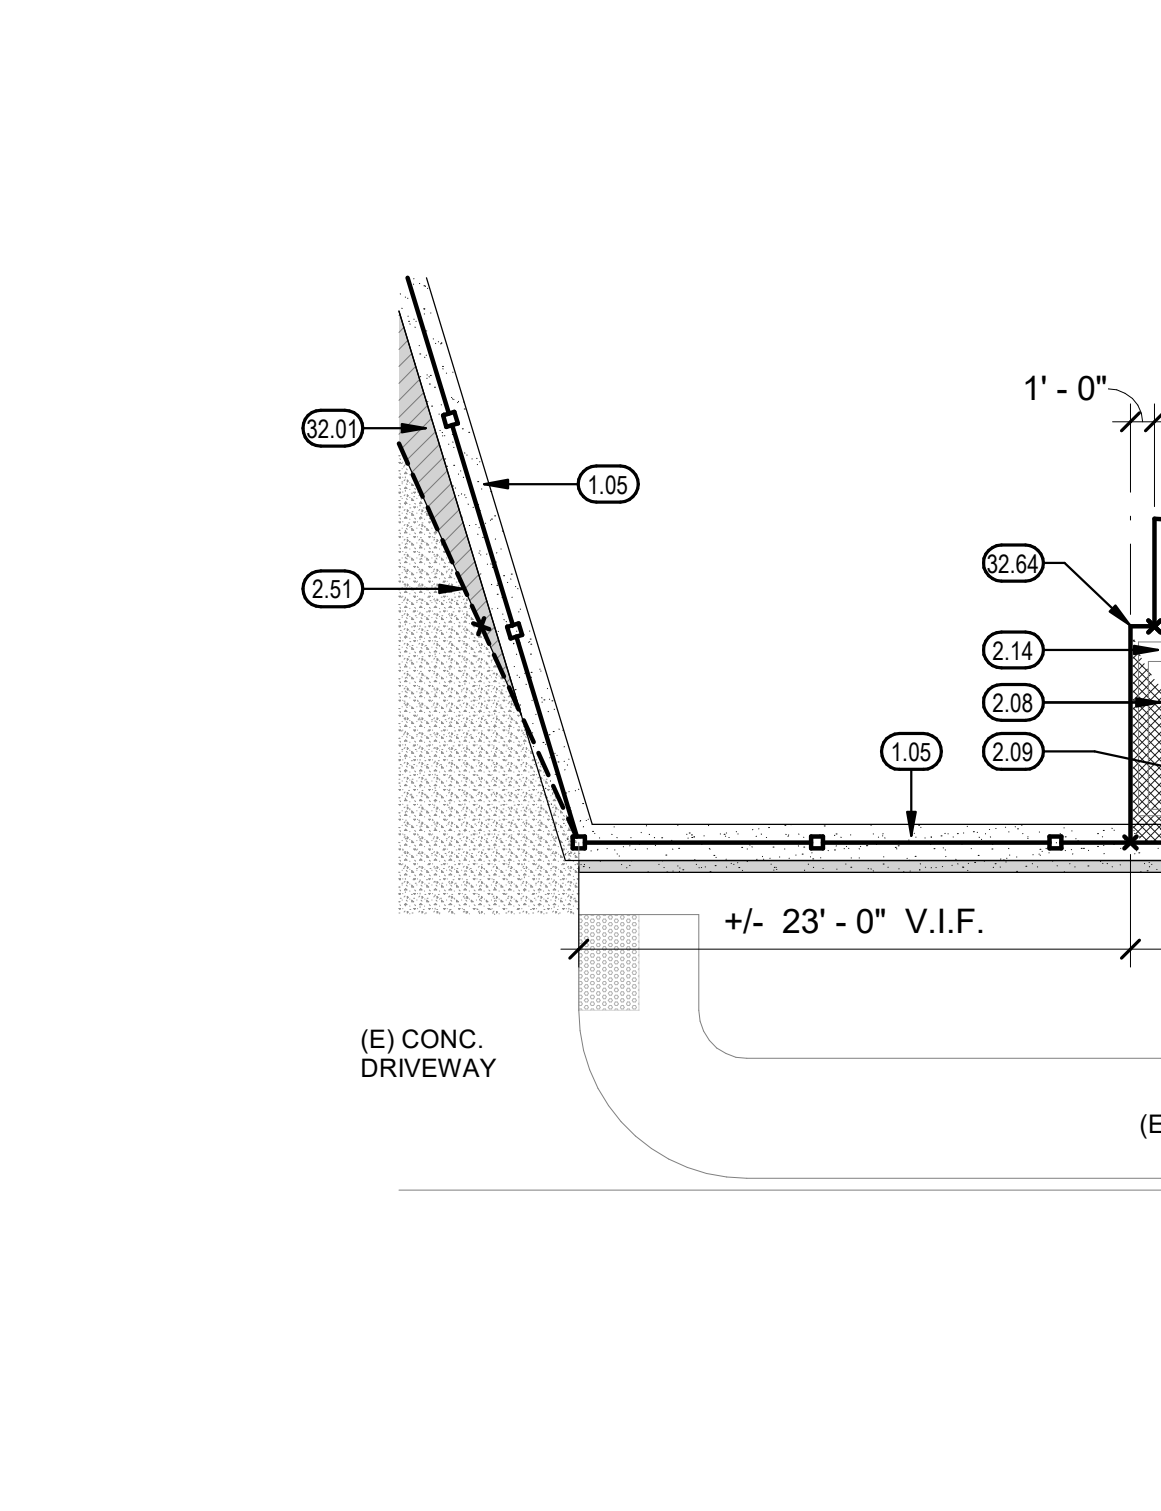

ENLARGED SITE PLAN

1/4" = 1'-0"


11

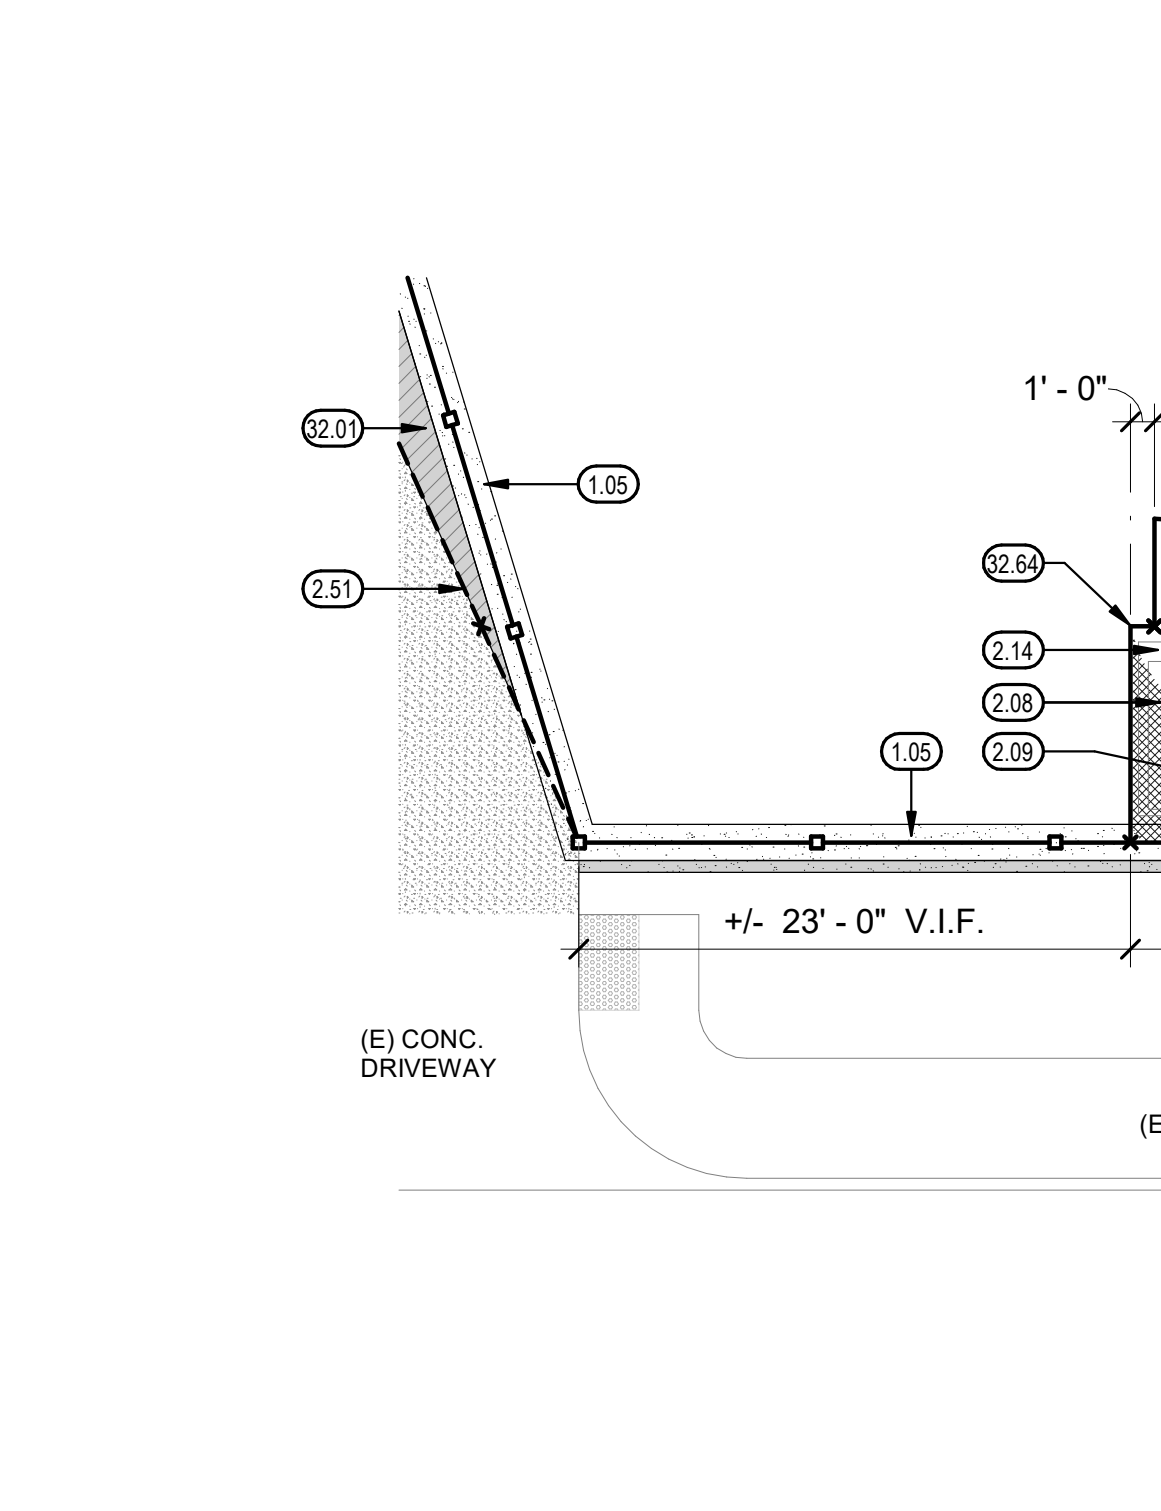

ENLARGED SITE PLAN

1/4" = 1'-0"


11

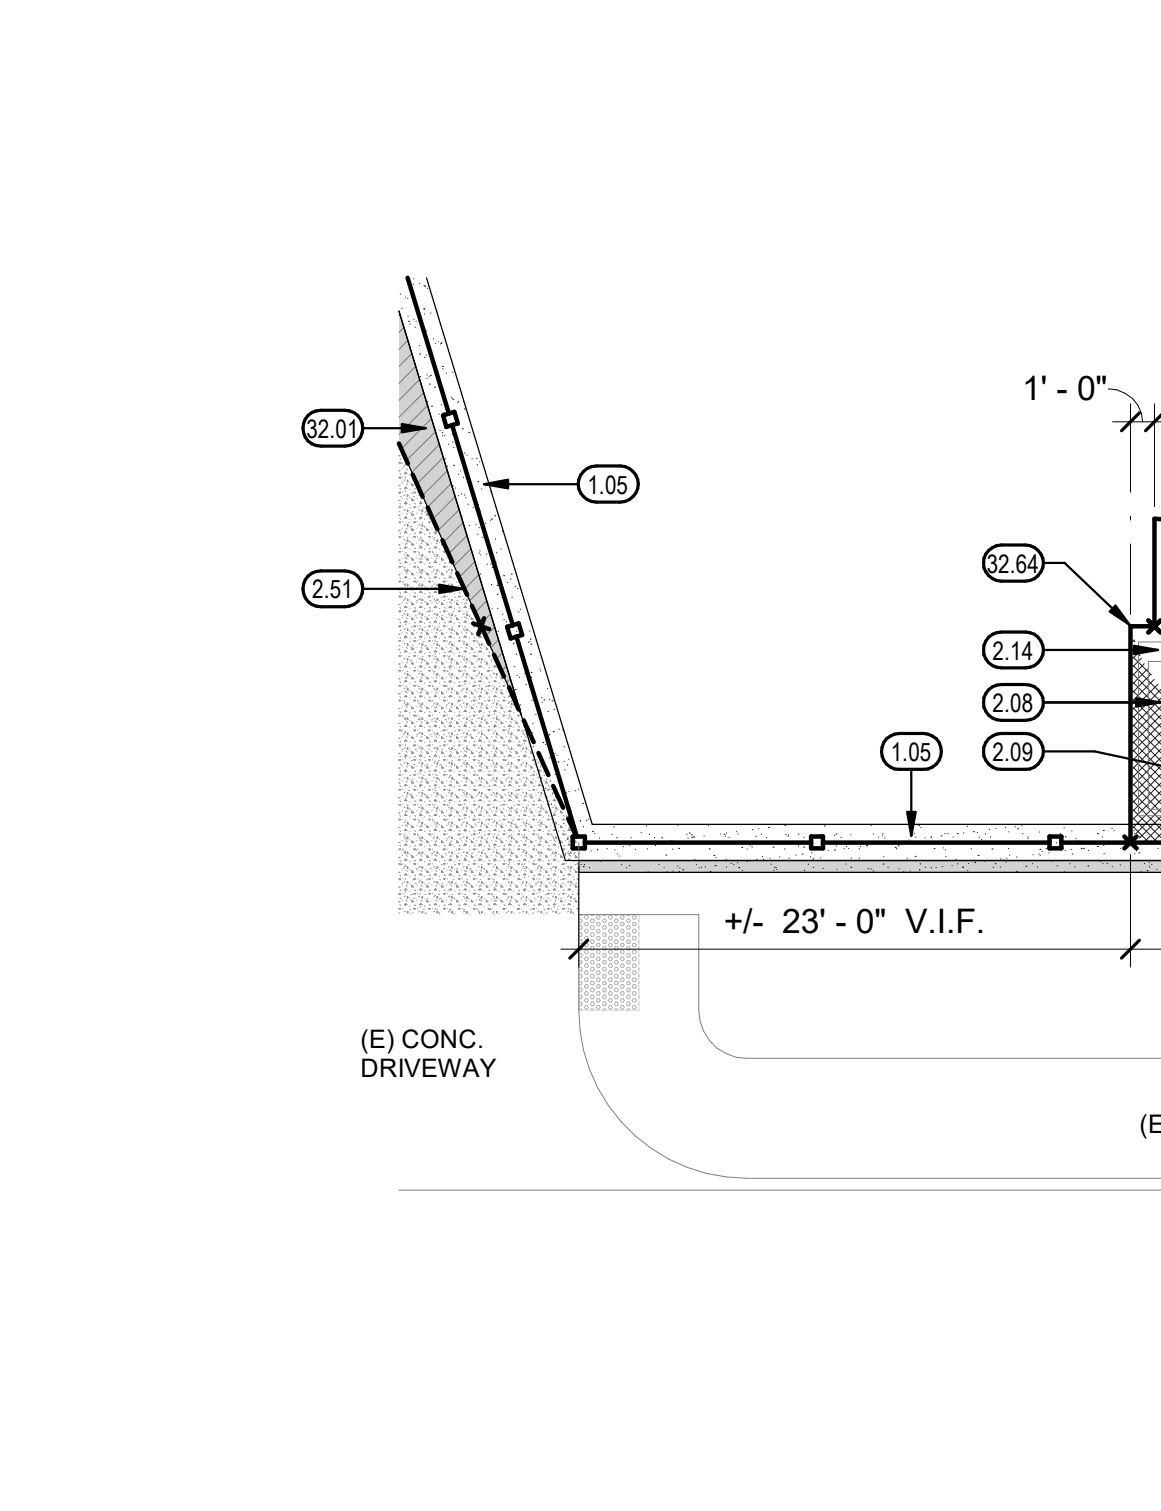

ENLARGED SITE PLAN

1/4" = 1'-0"


11

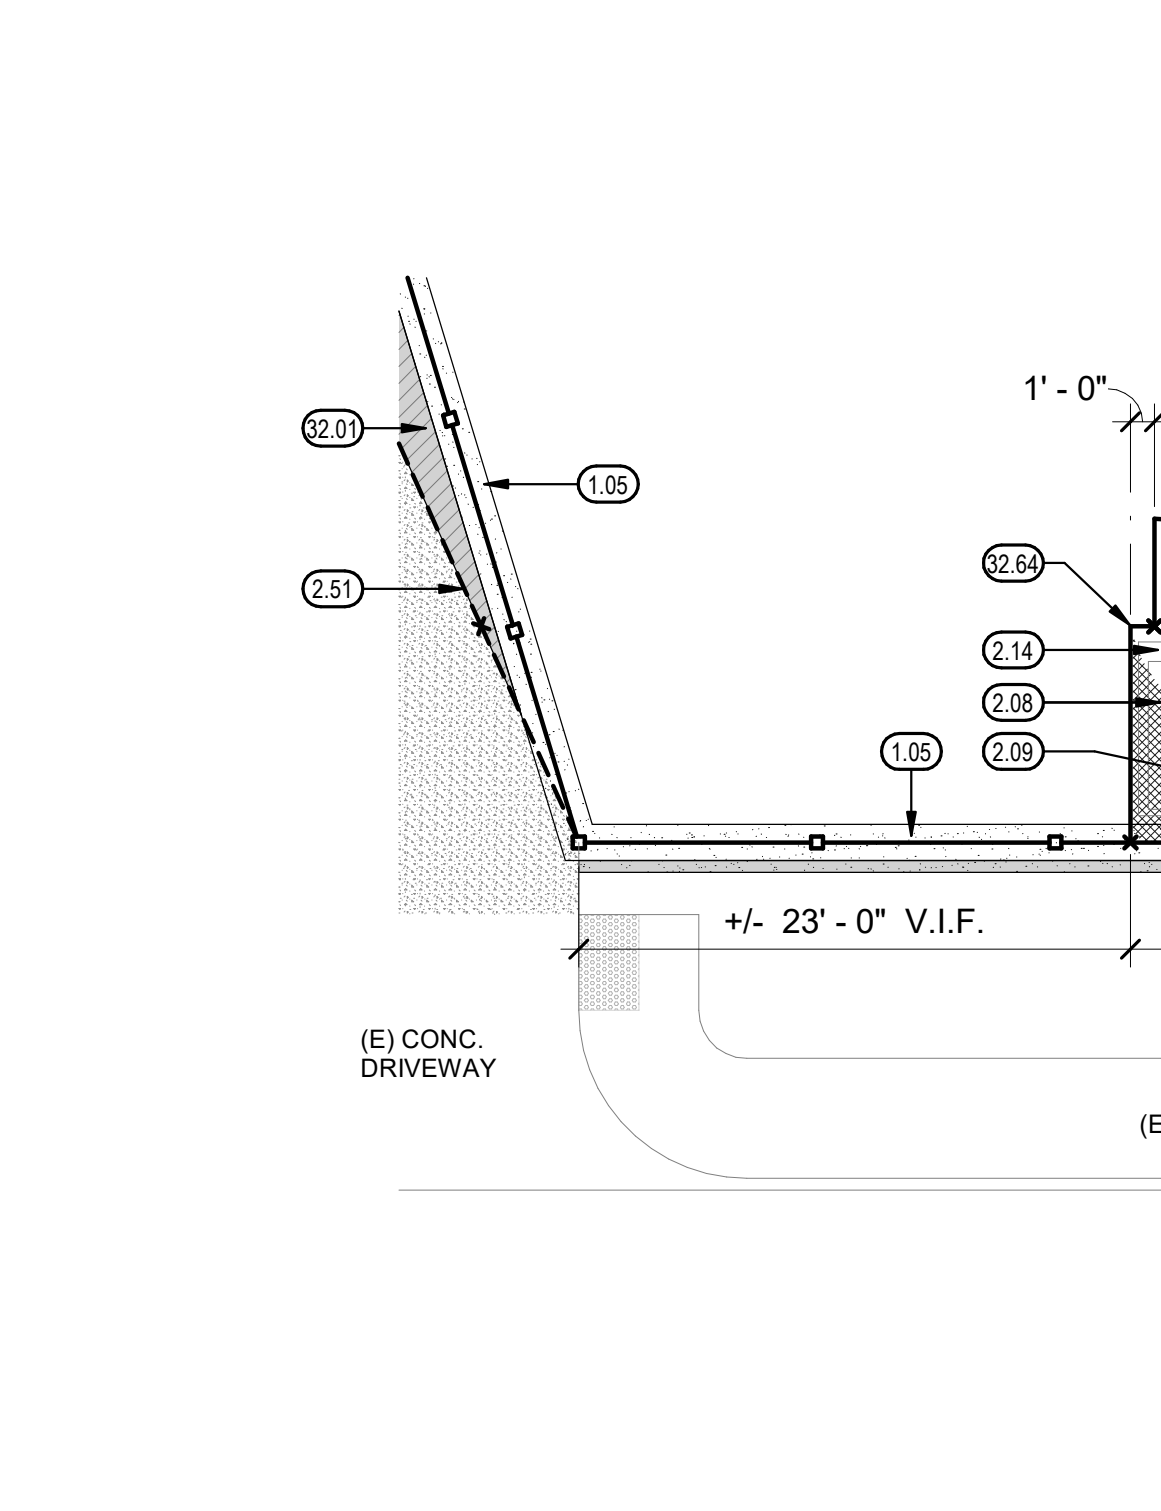

ENLARGED SITE PLAN

1/4" = 1'-0"


11

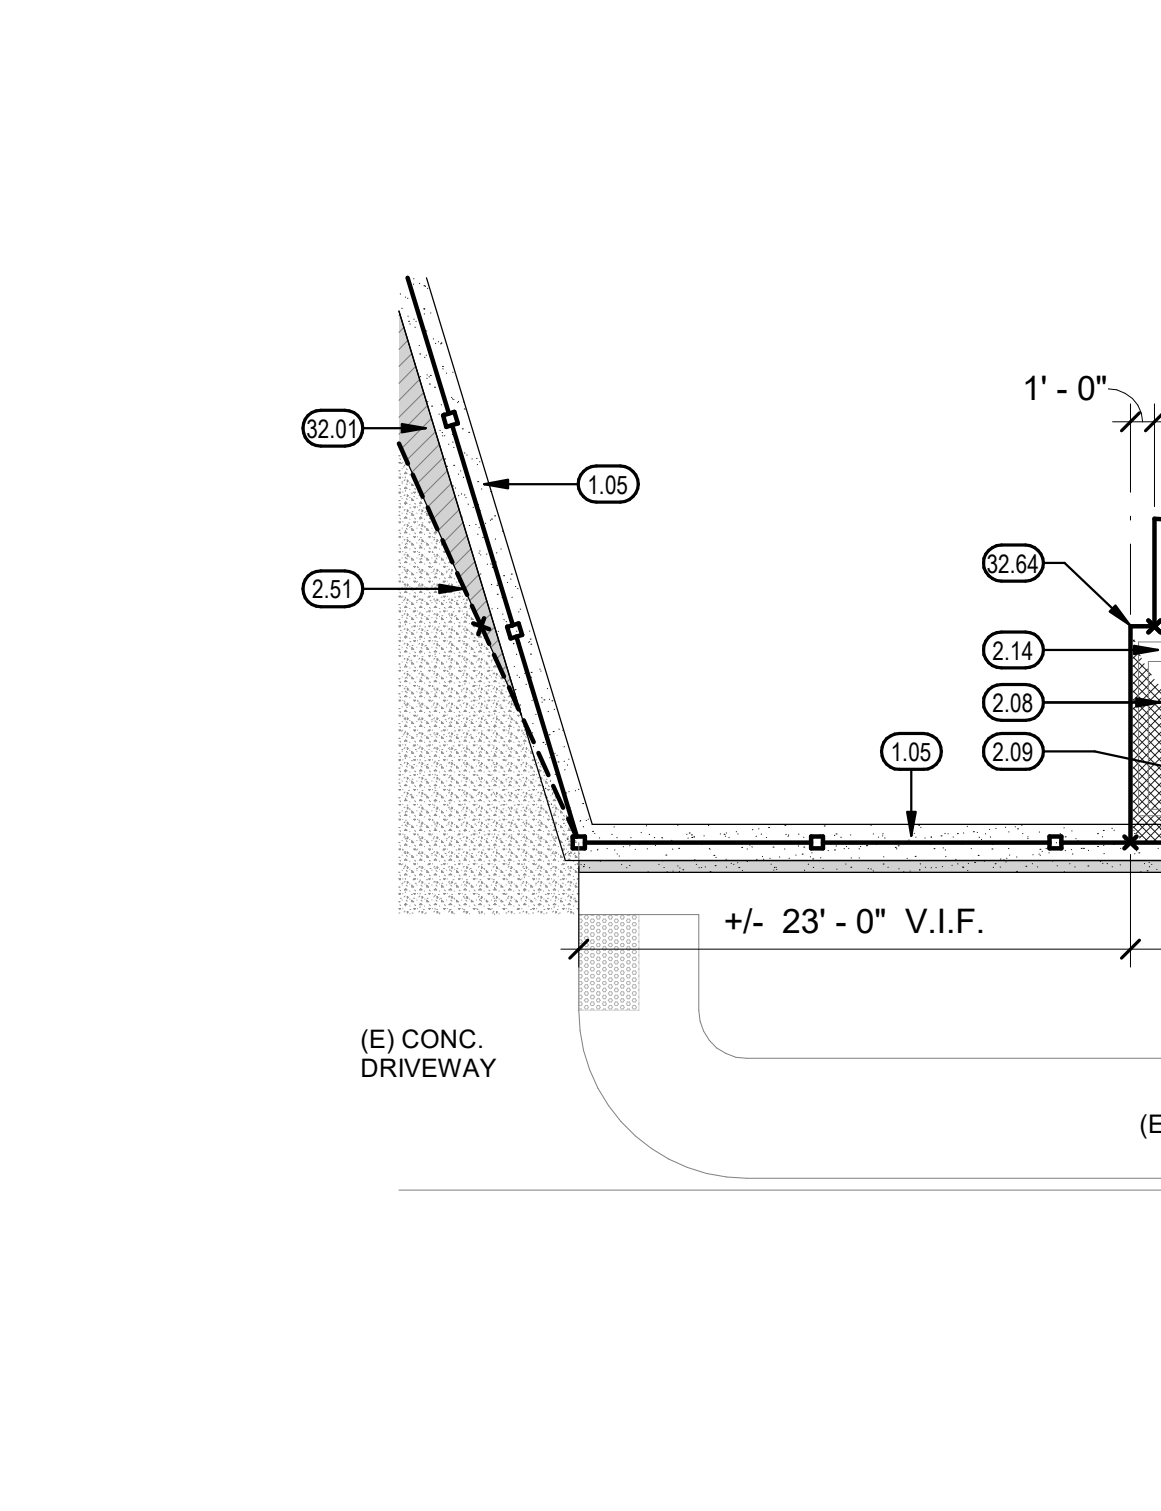

ENLARGED SITE PLAN

1/4" = 1'-0"


11

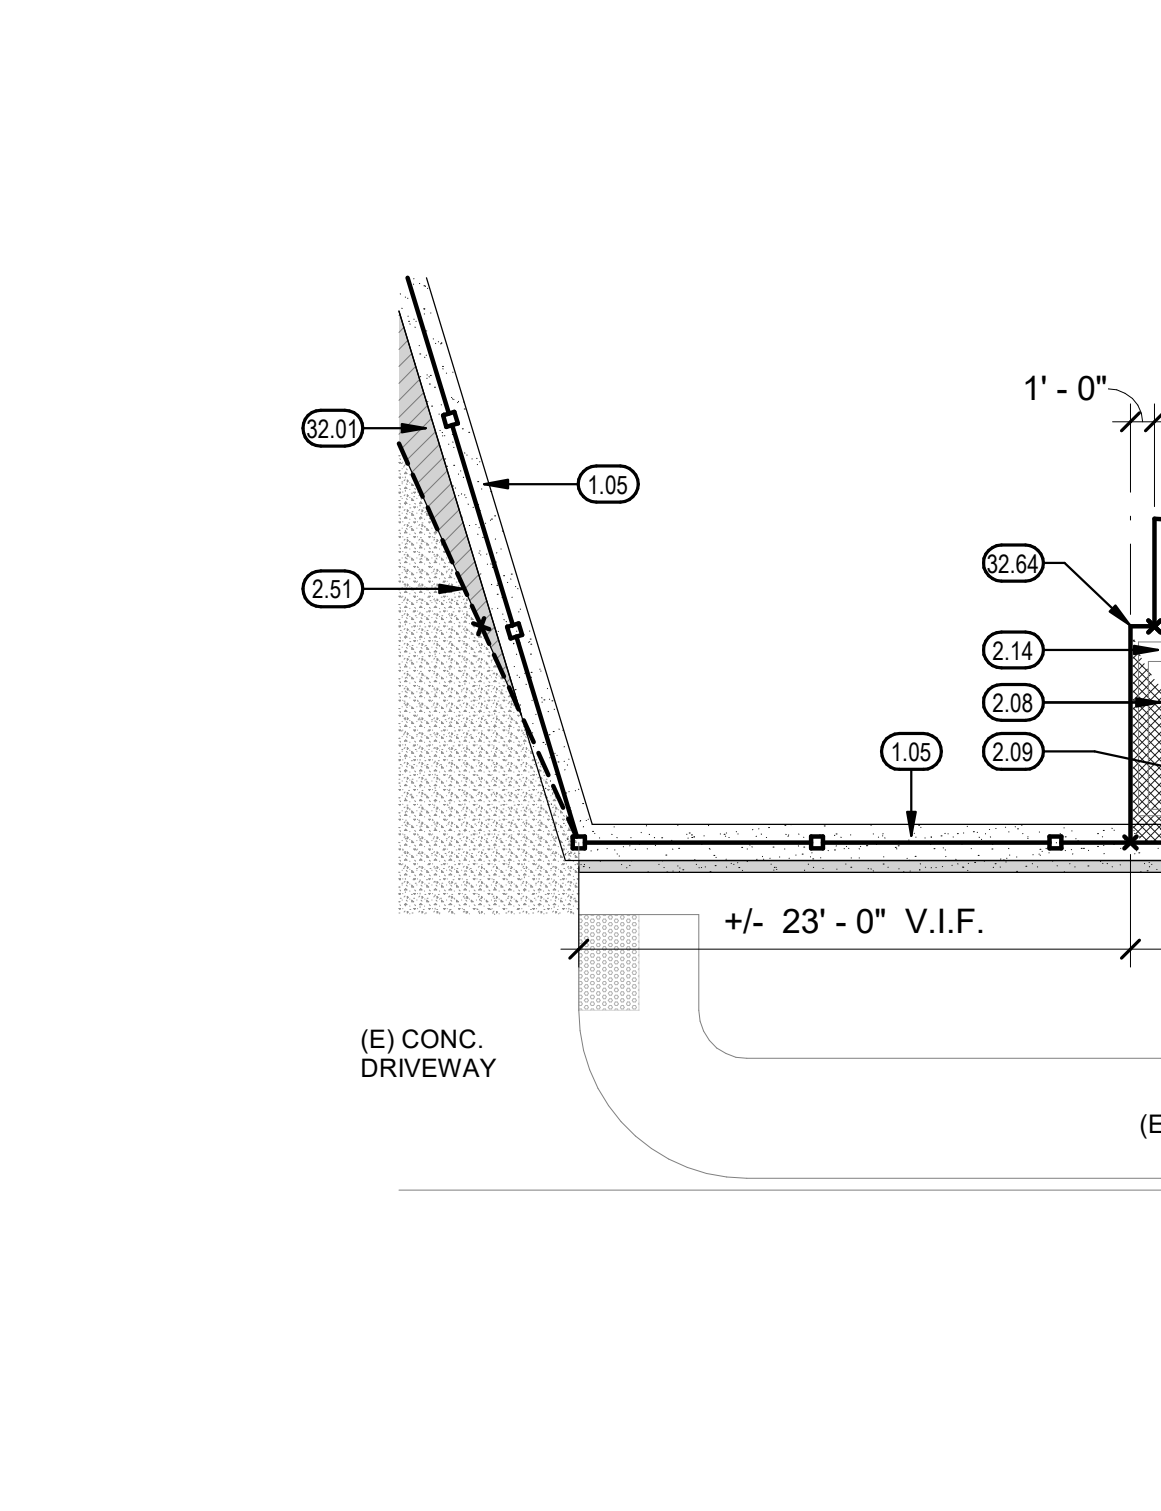

ENLARGED SITE PLAN

1/4" = 1'-0"


11

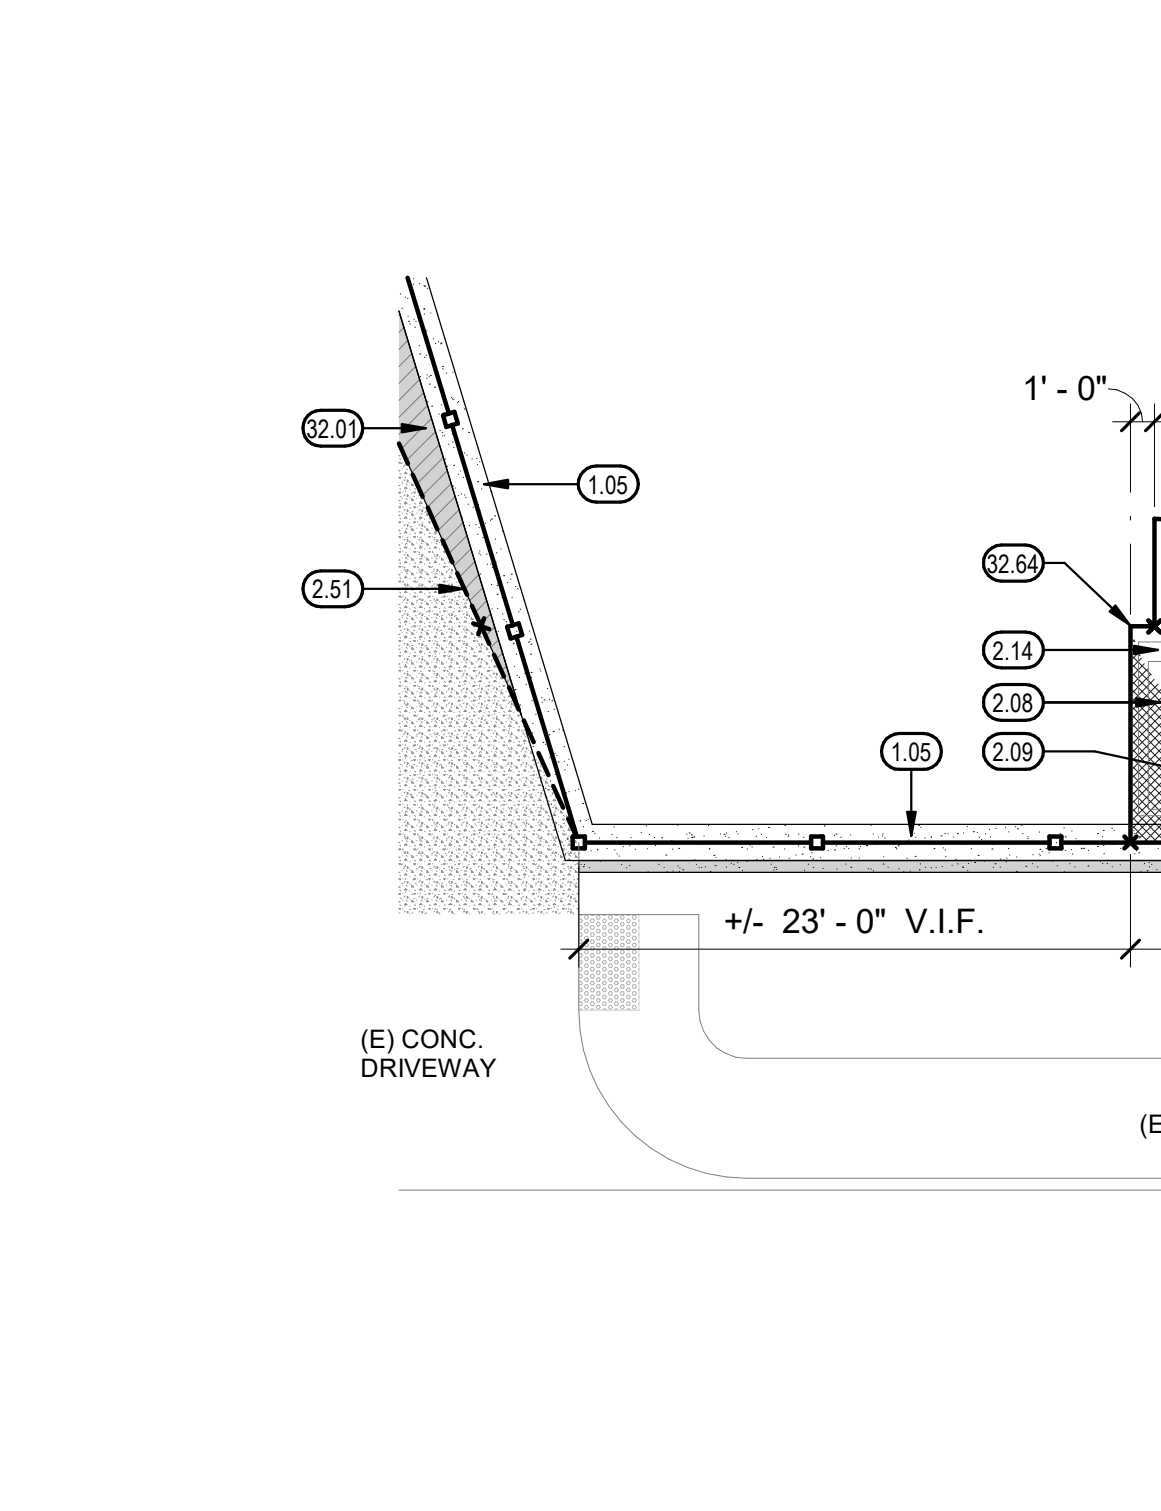

ENLARGED SITE PLAN

1/4" = 1'-0"


11

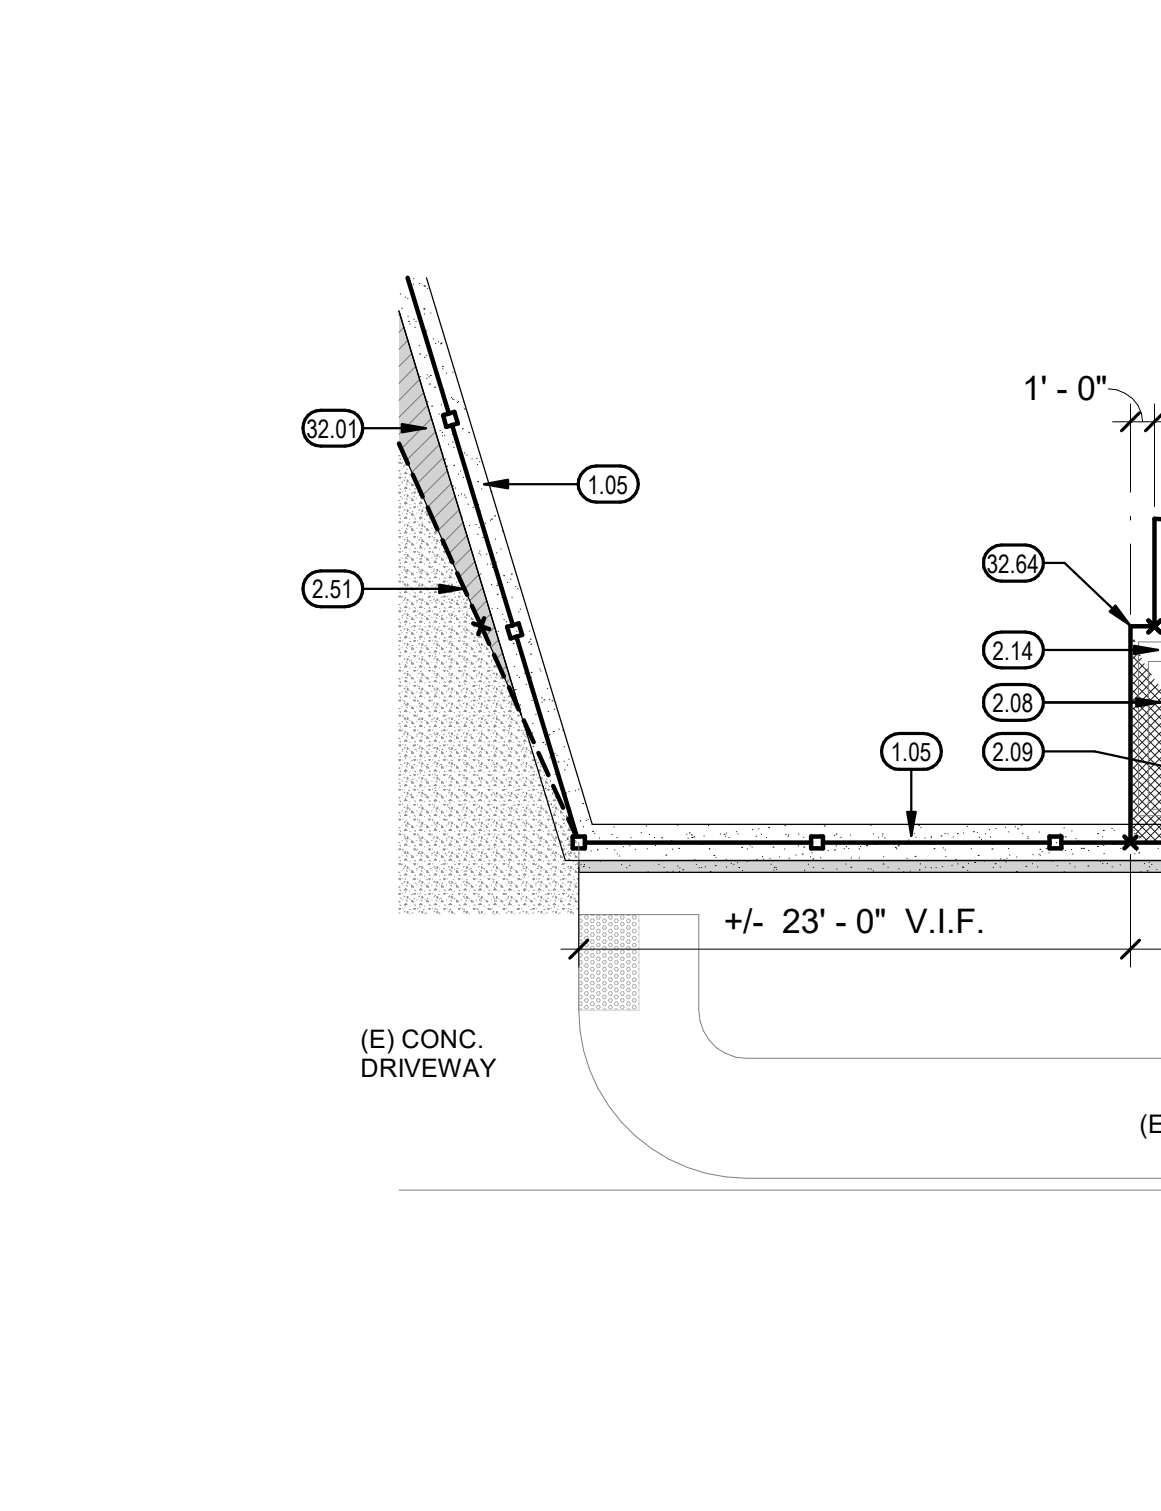

ENLARGED SITE PLAN

1/4" = 1'-0"


11

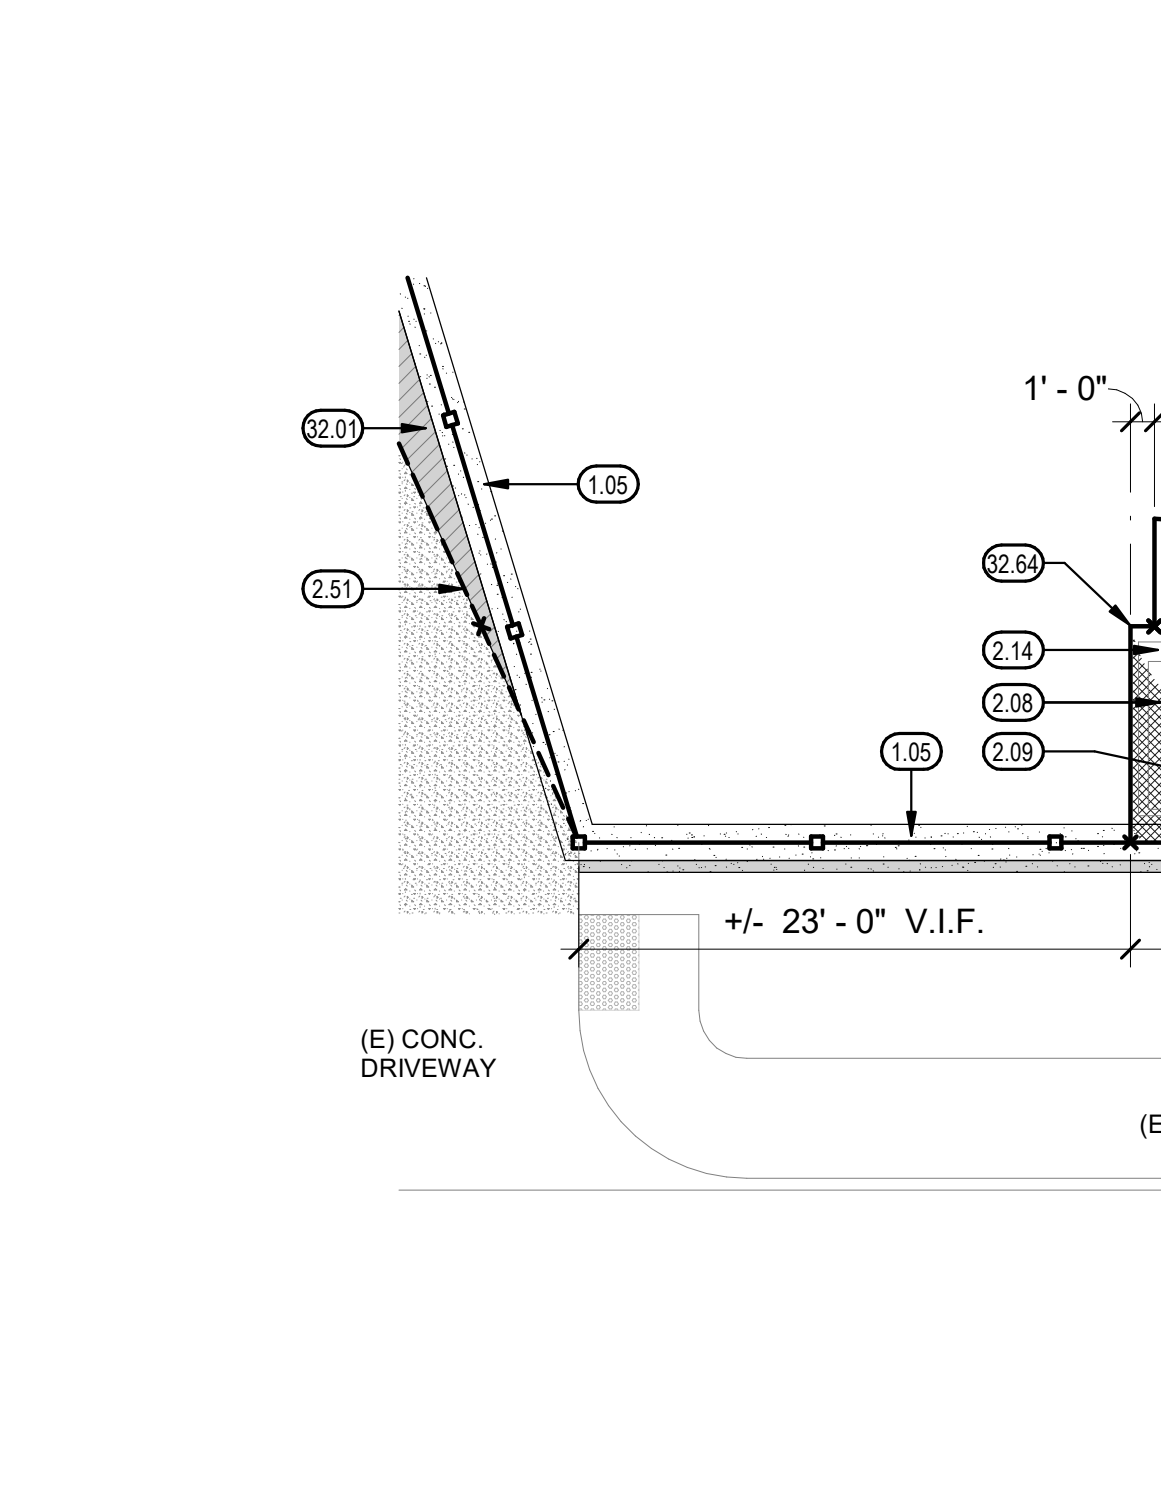

ENLARGED SITE PLAN

1/4" = 1'-0"


11

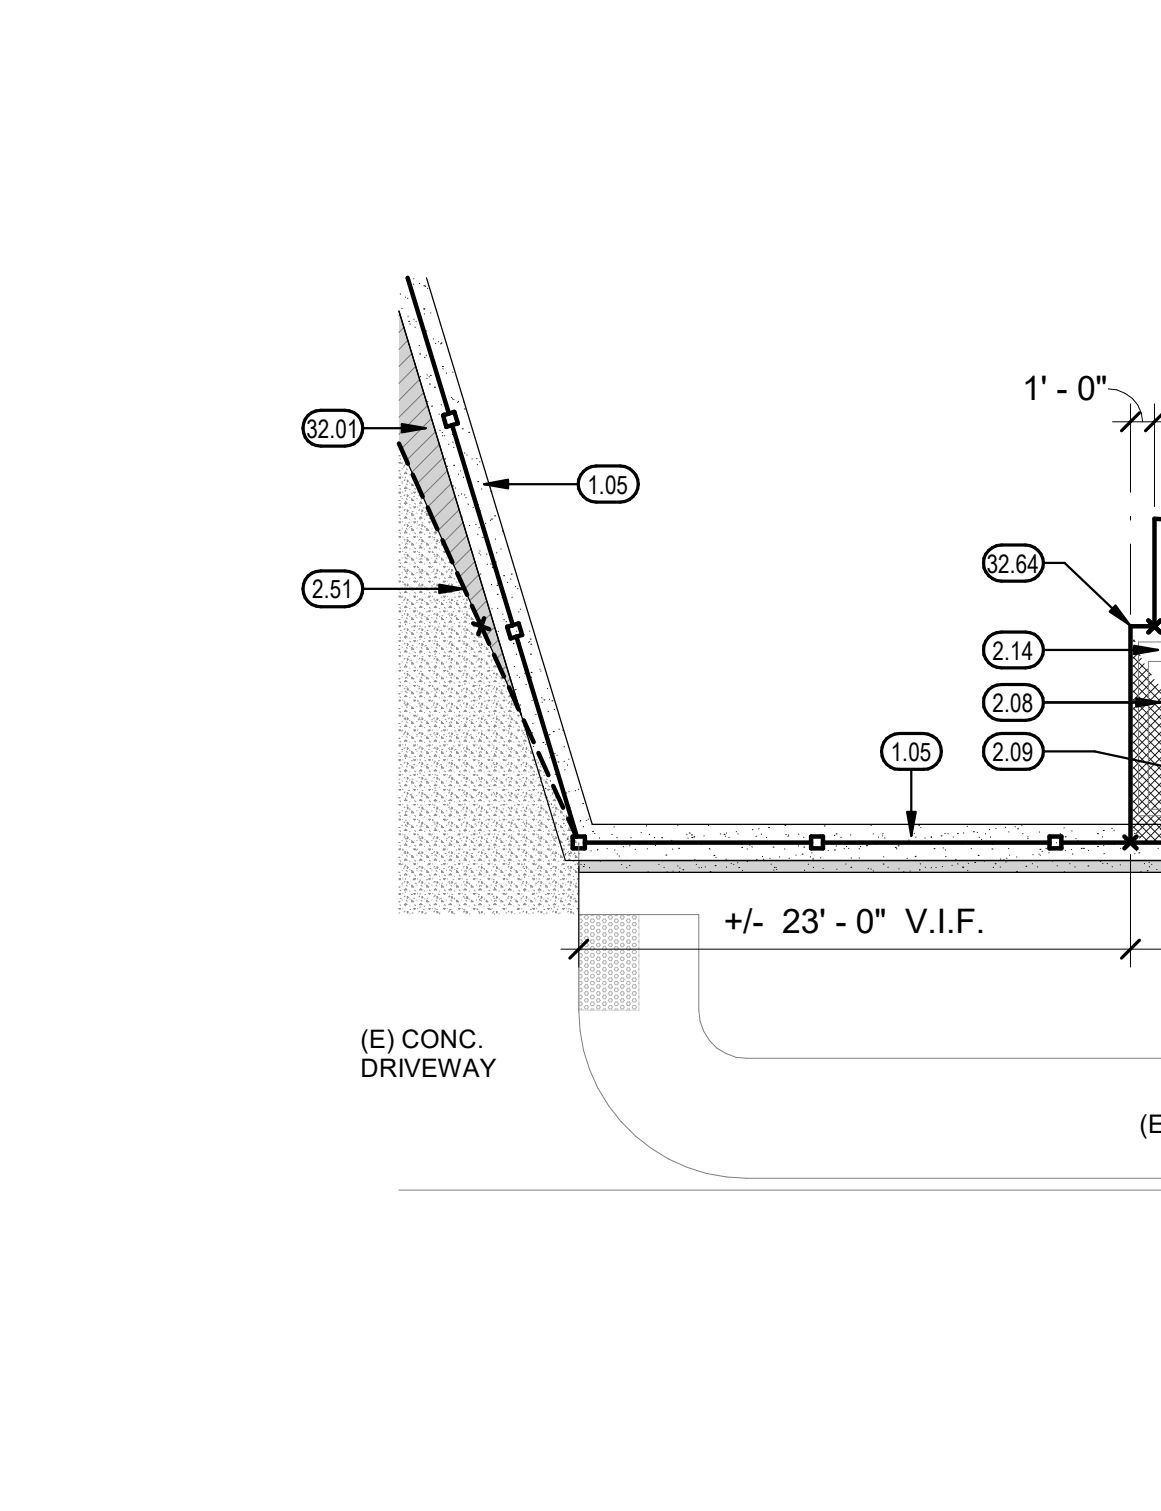

ENLARGED SITE PLAN

1/4" = 1'-0"


11

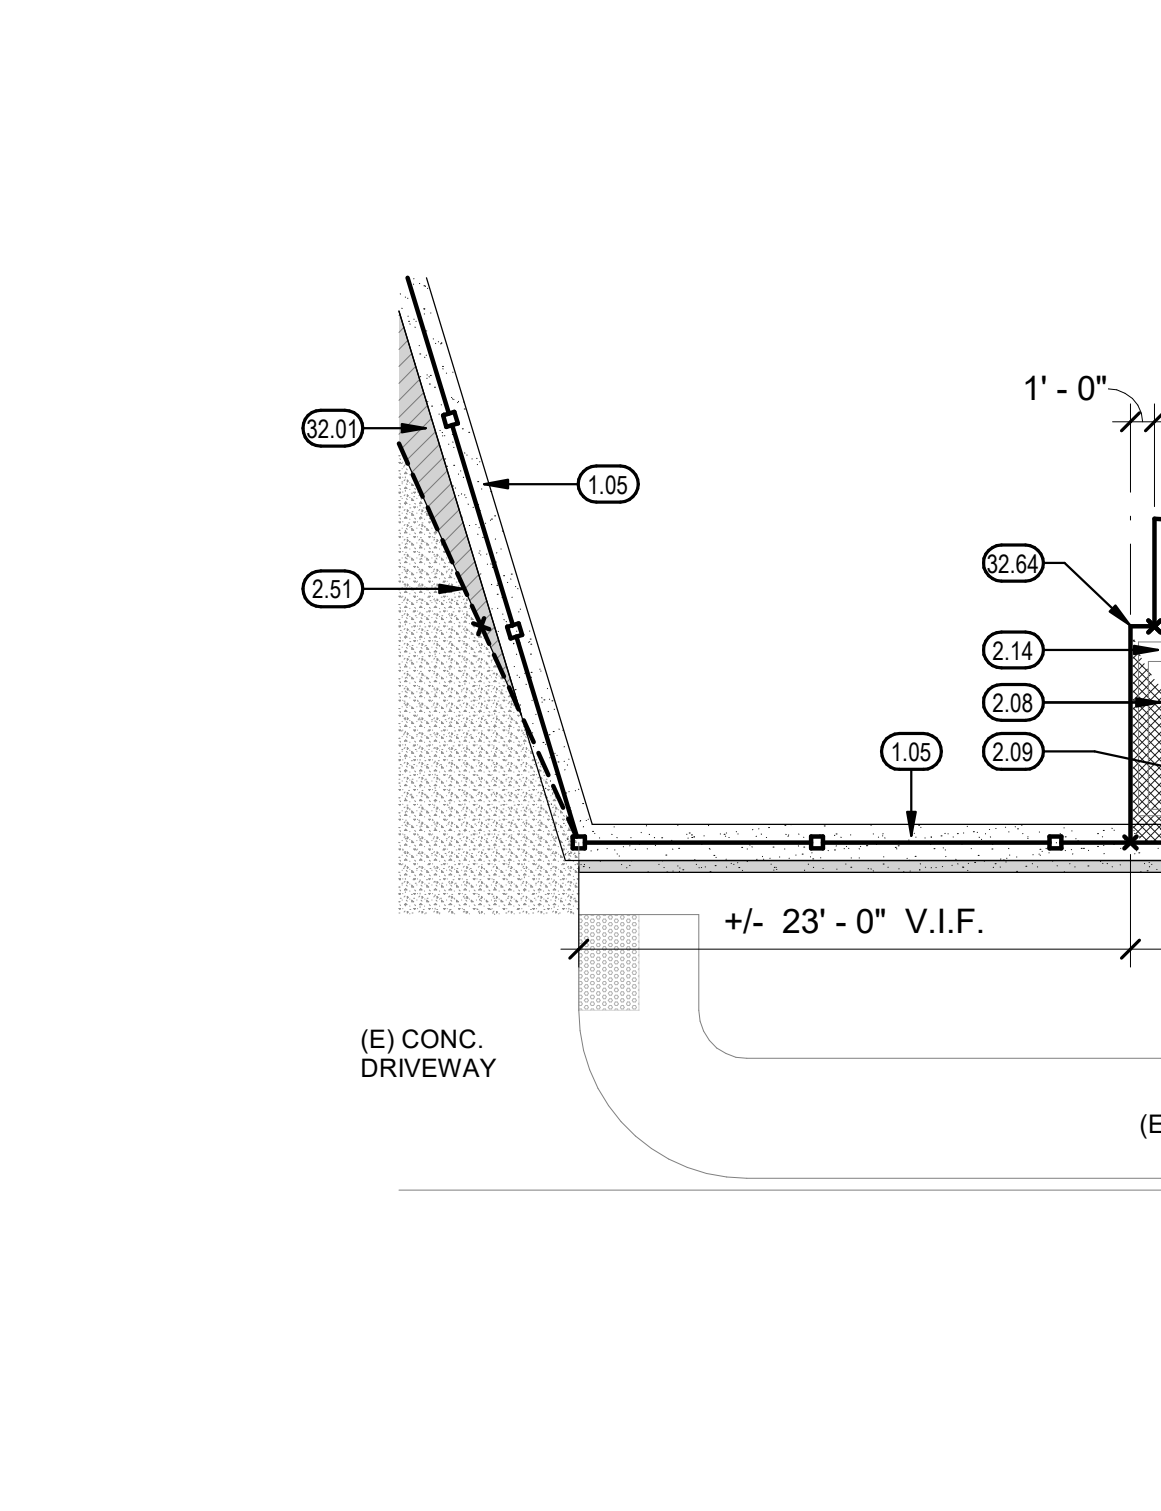

ENLARGED SITE PLAN

1/4" = 1'-0"


11

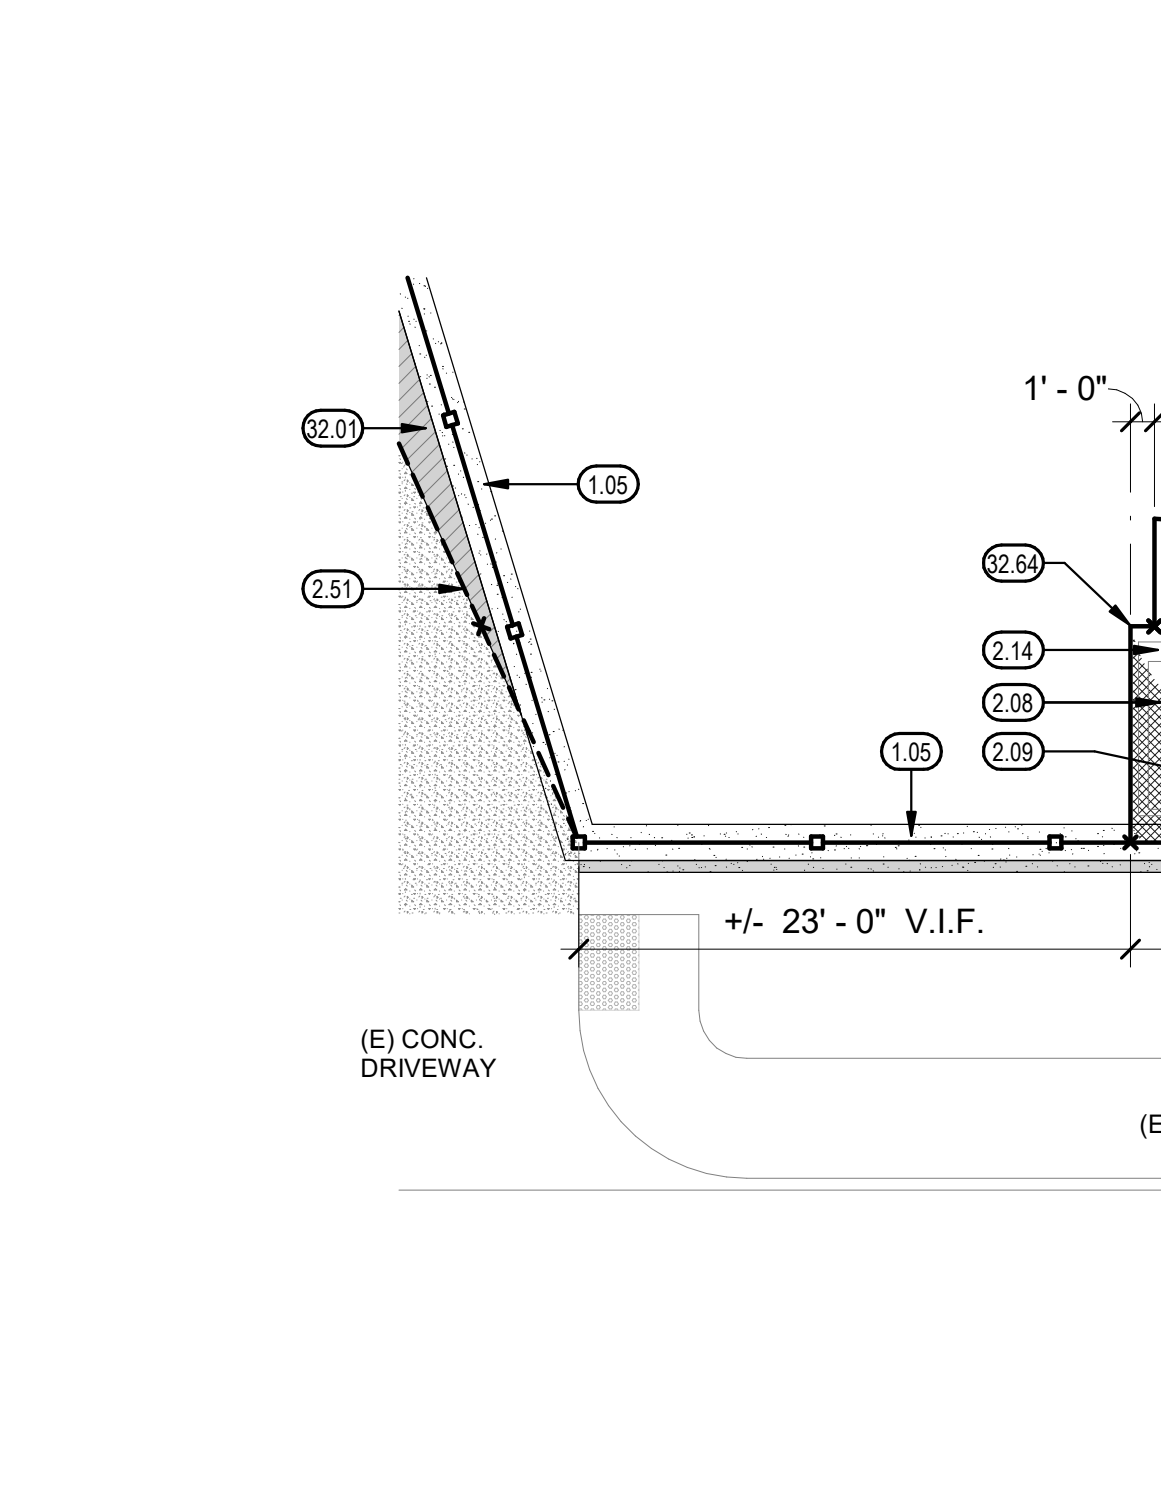

ENLARGED SITE PLAN

1/4" = 1'-0"


11

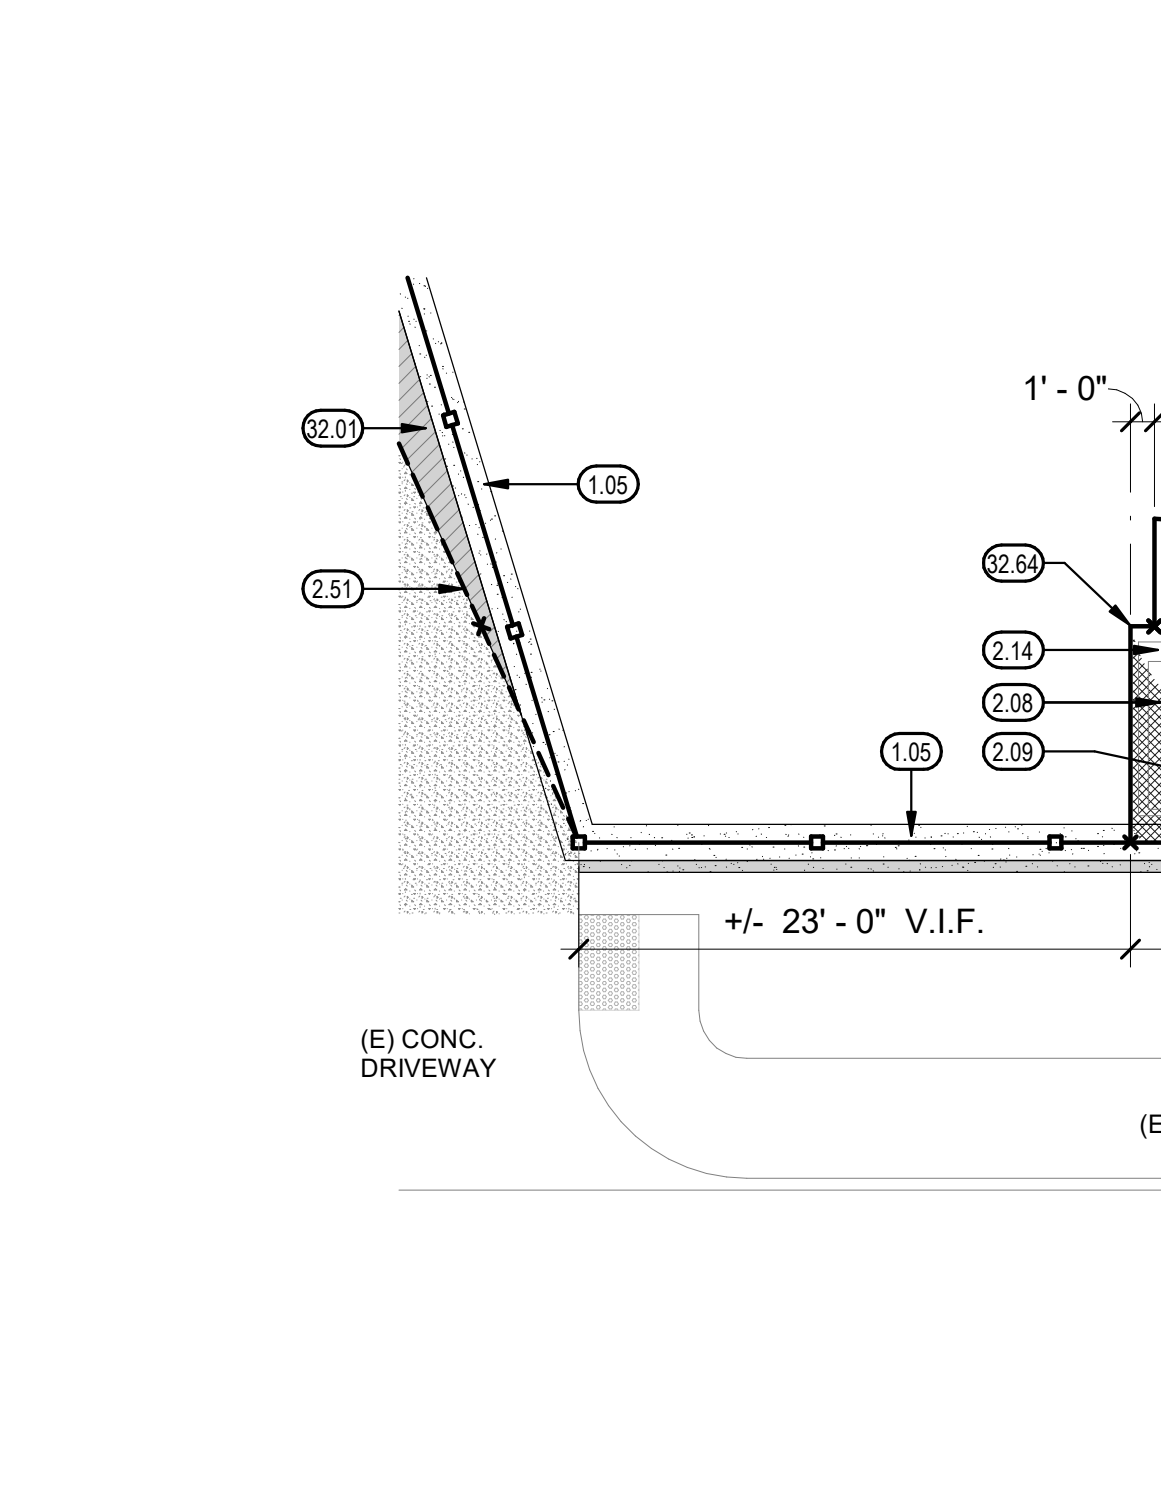

ENLARGED SITE PLAN

1/4" = 1'-0"


11

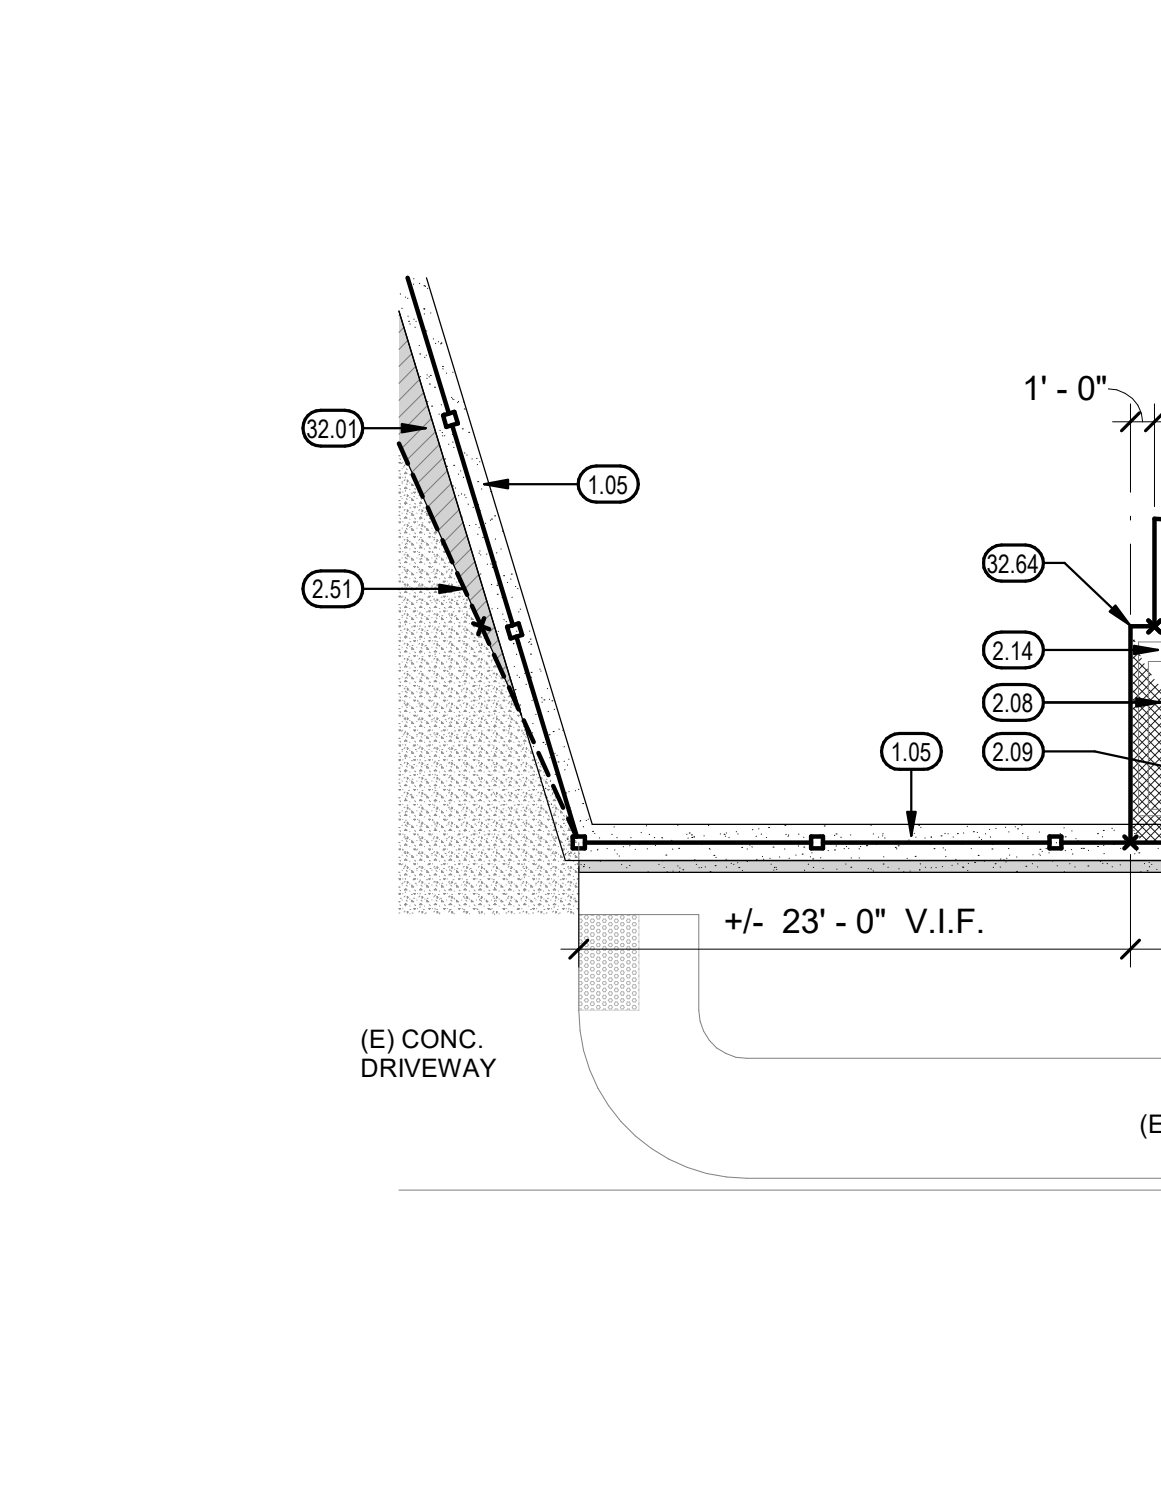

ENLARGED SITE PLAN

1/4" = 1'-0"


11

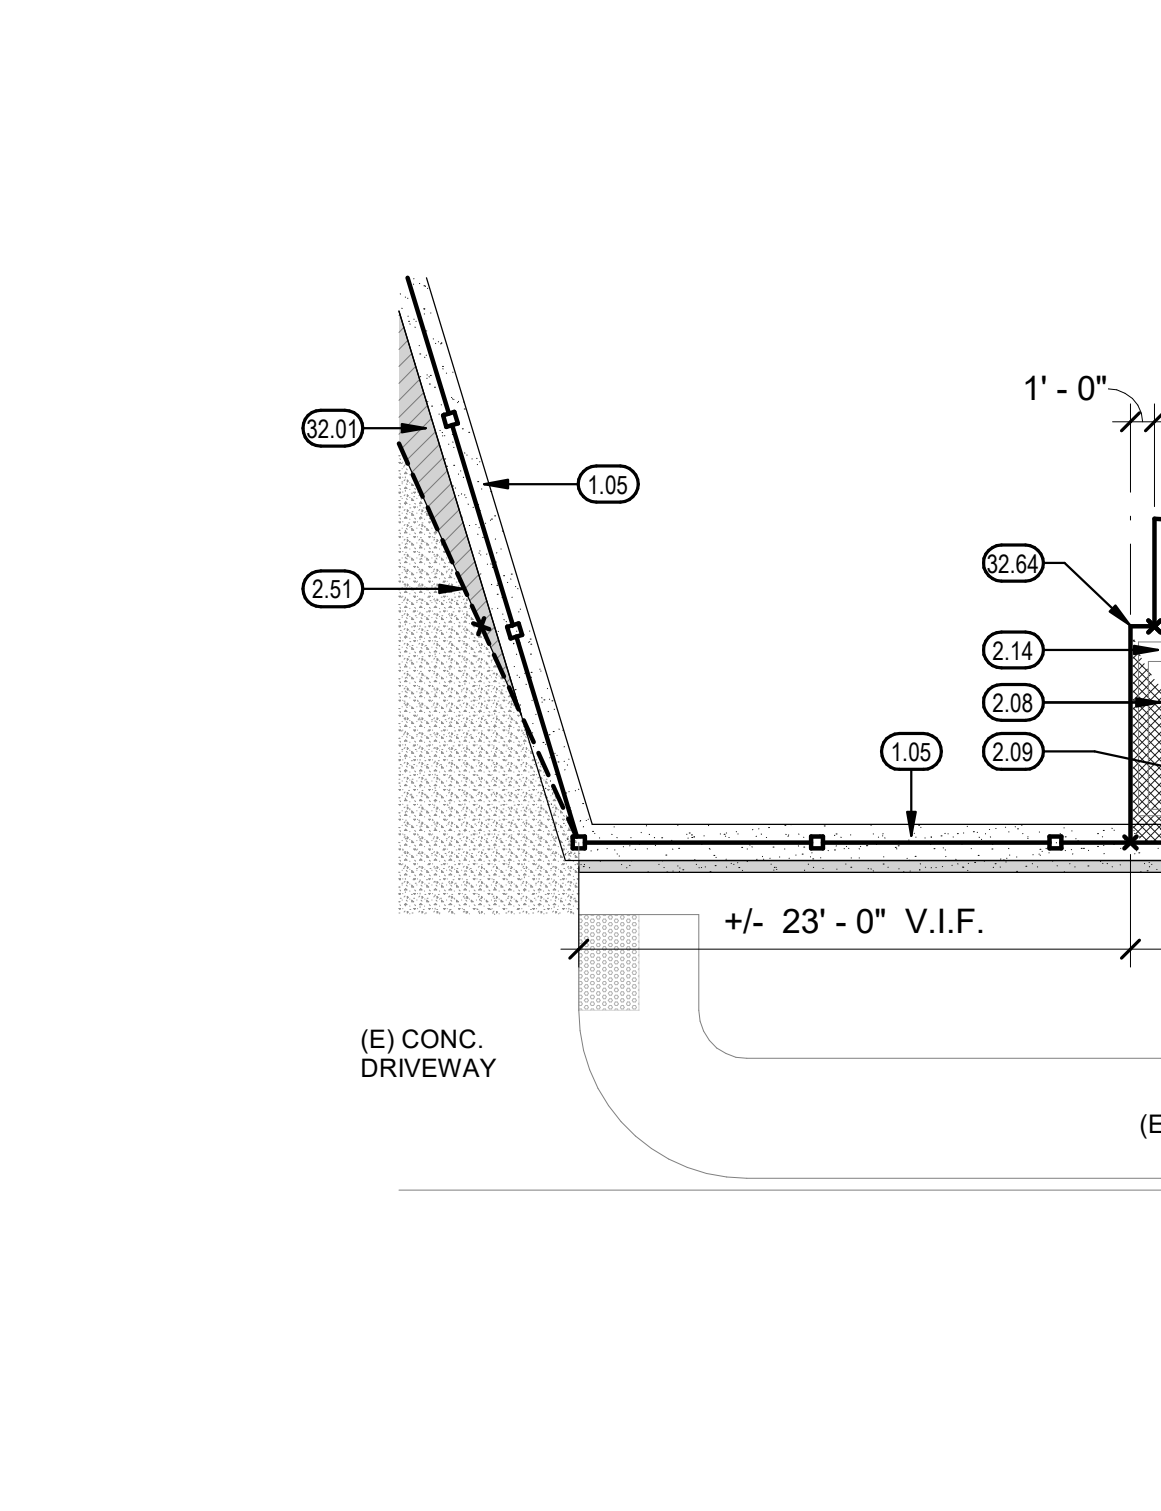

ENLARGED SITE PLAN

1/4" = 1'-0"


11

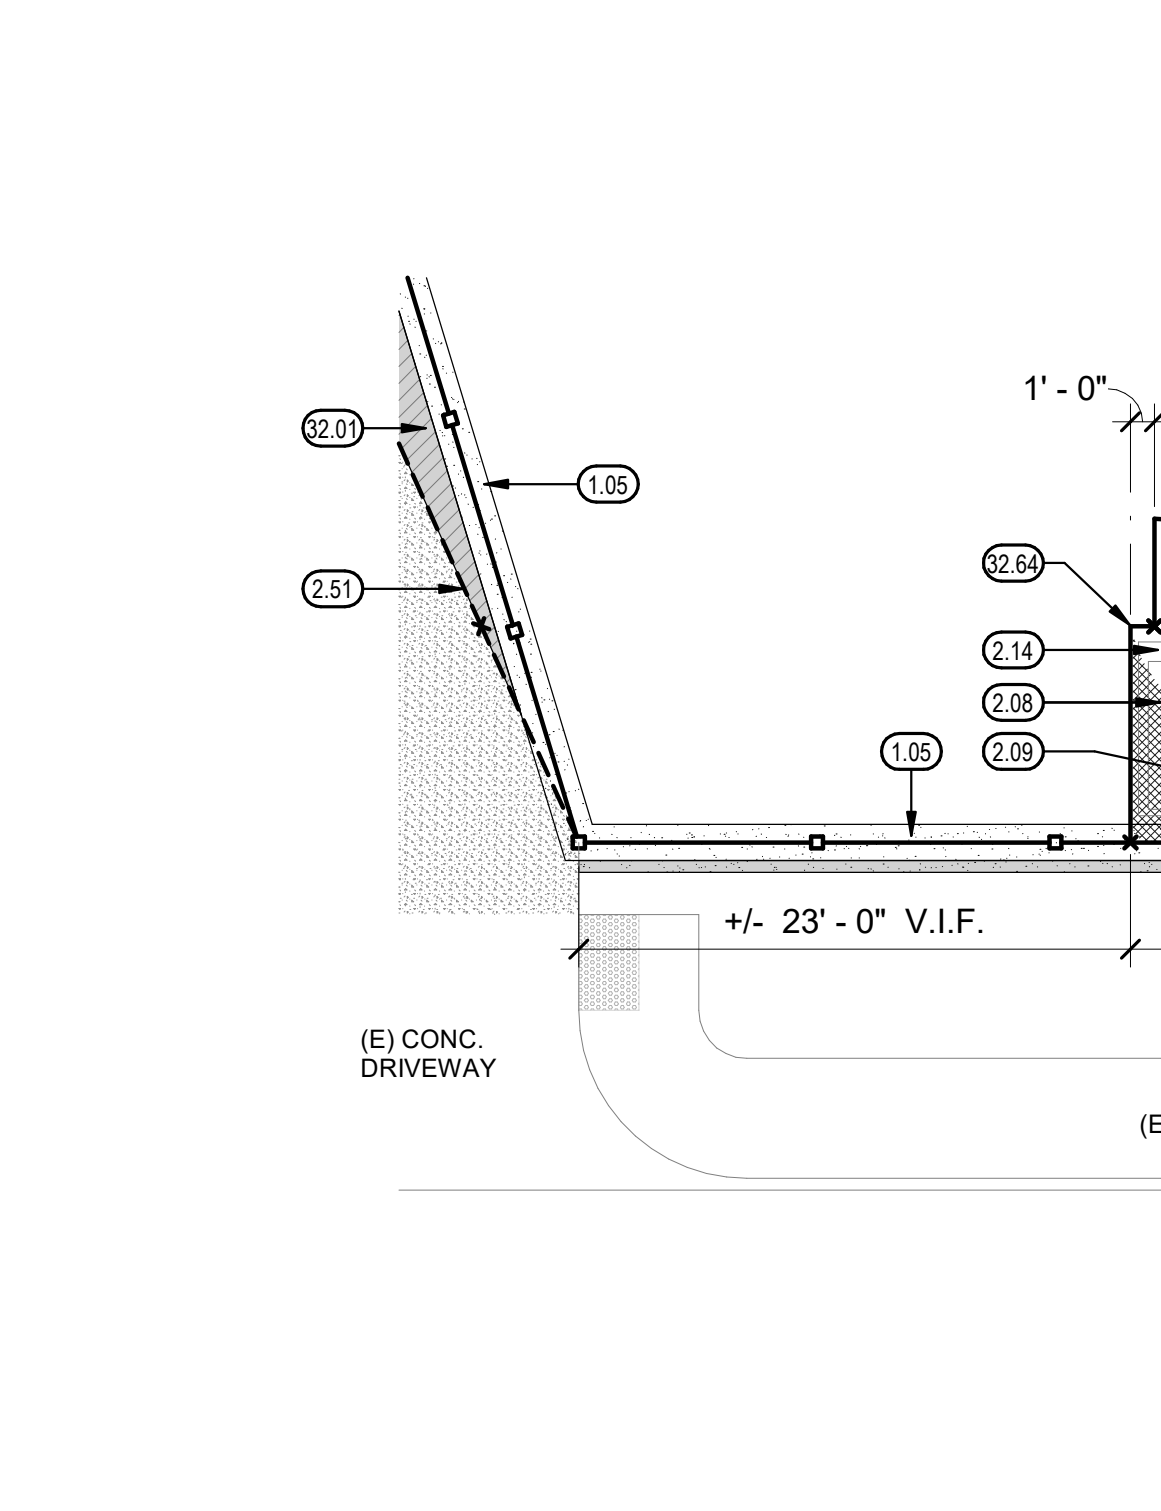

ENLARGED SITE PLAN

1/4" = 1'-0"


11

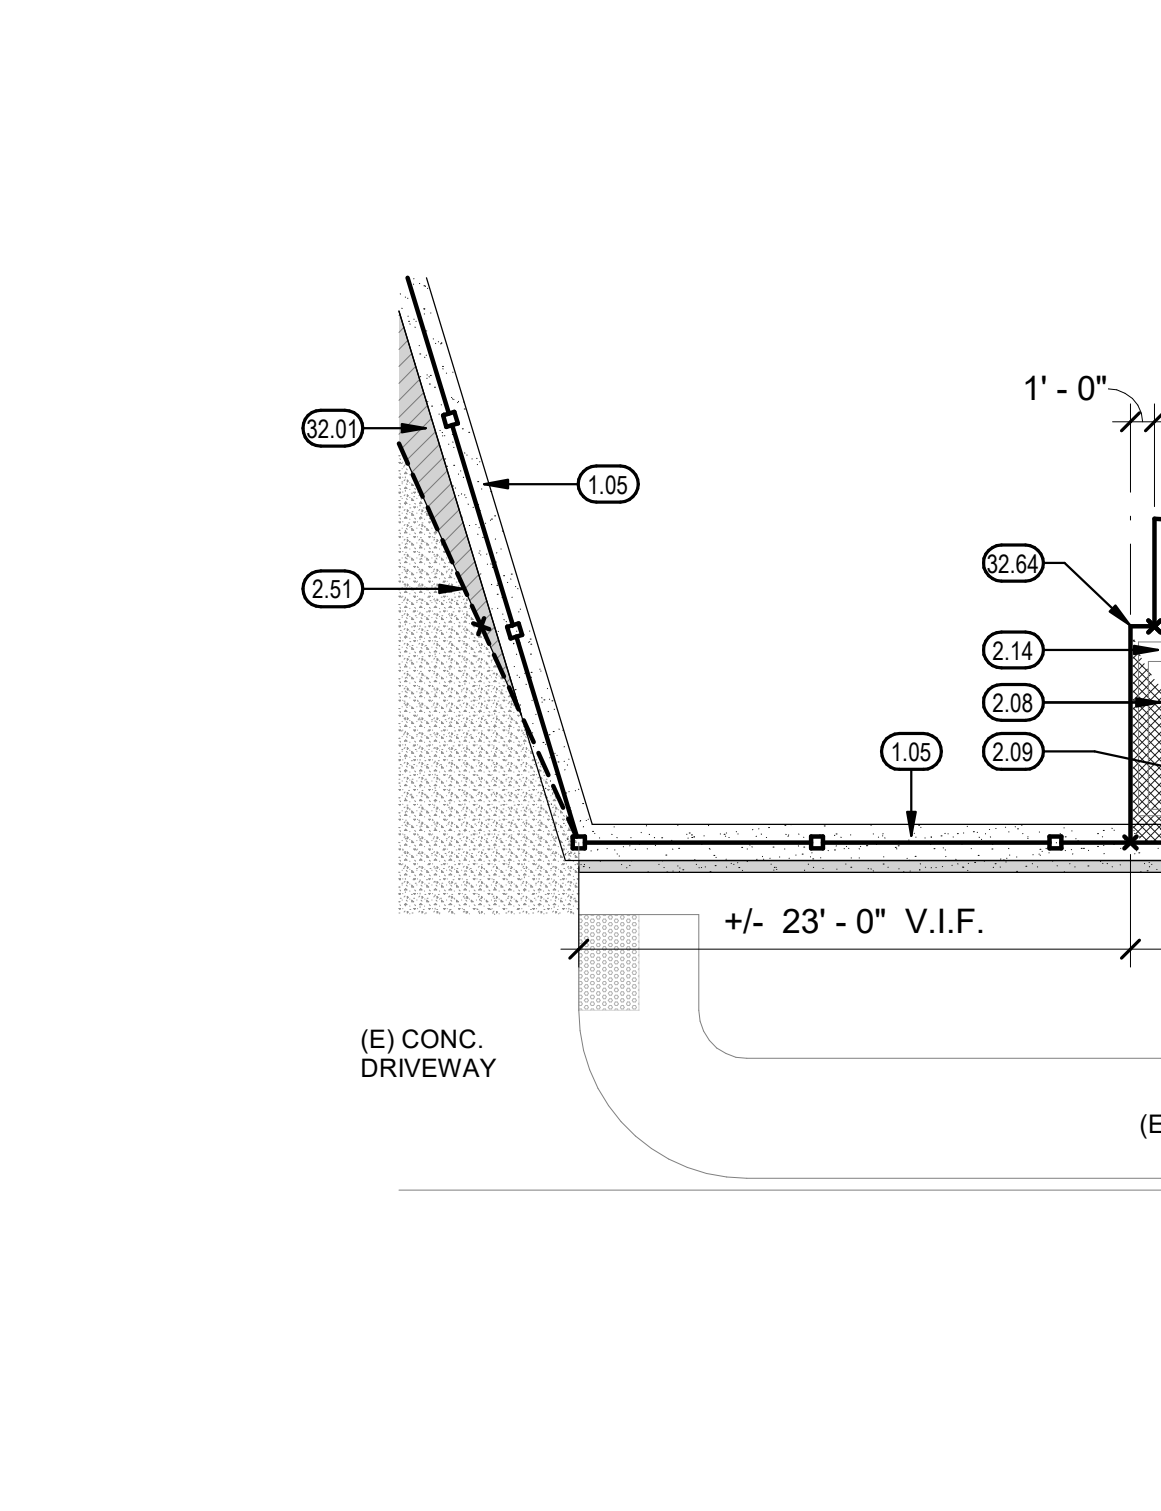

ENLARGED SITE PLAN

1/4" = 1'-0"


11

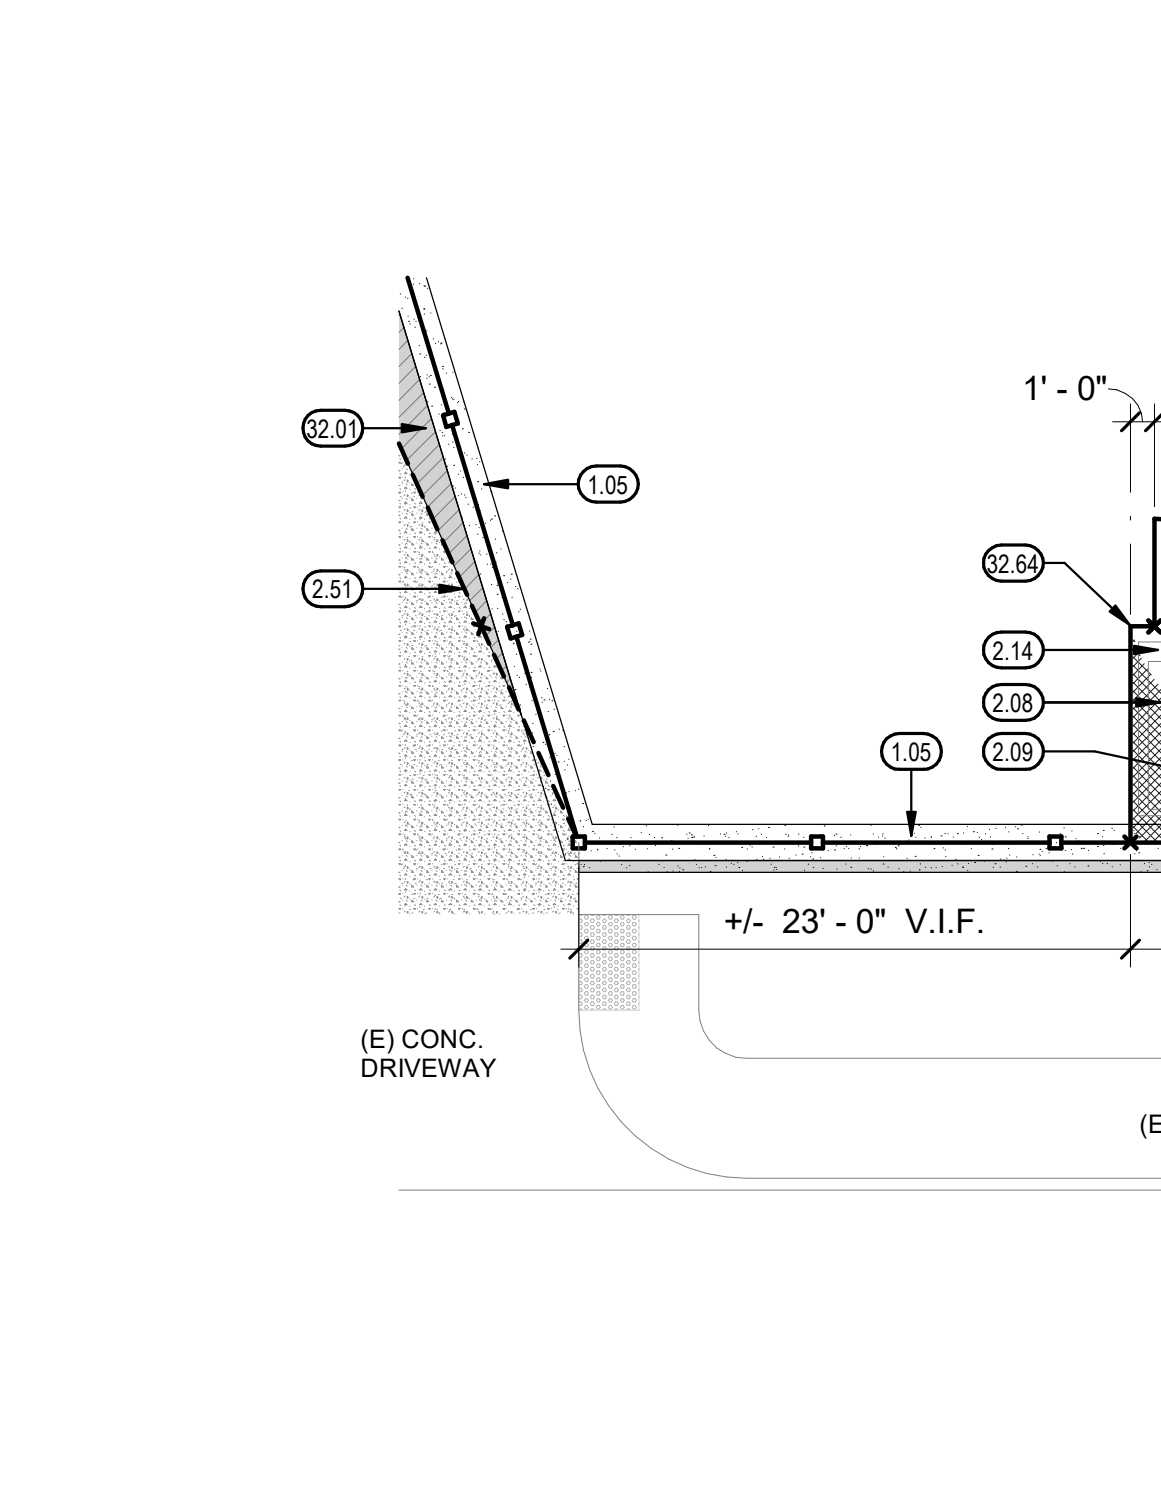

ENLARGED SITE PLAN

1/4" = 1'-0"


11

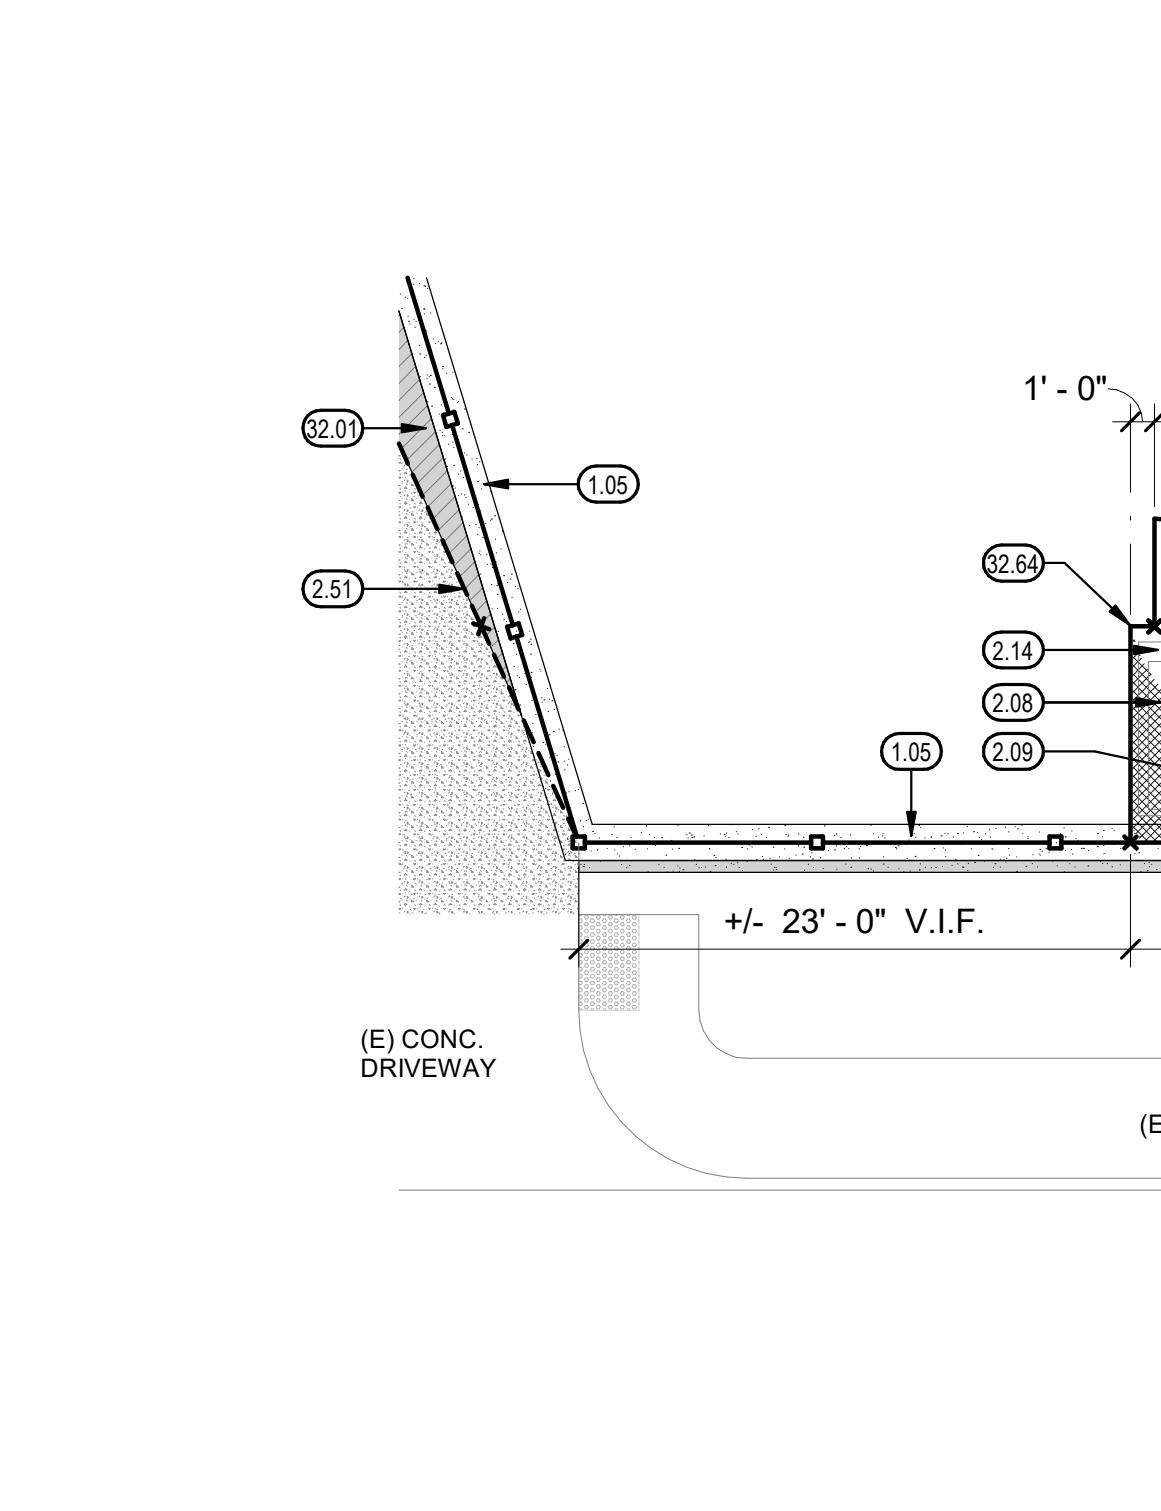

ENLARGED SITE PLAN

1/4" = 1'-0"


11

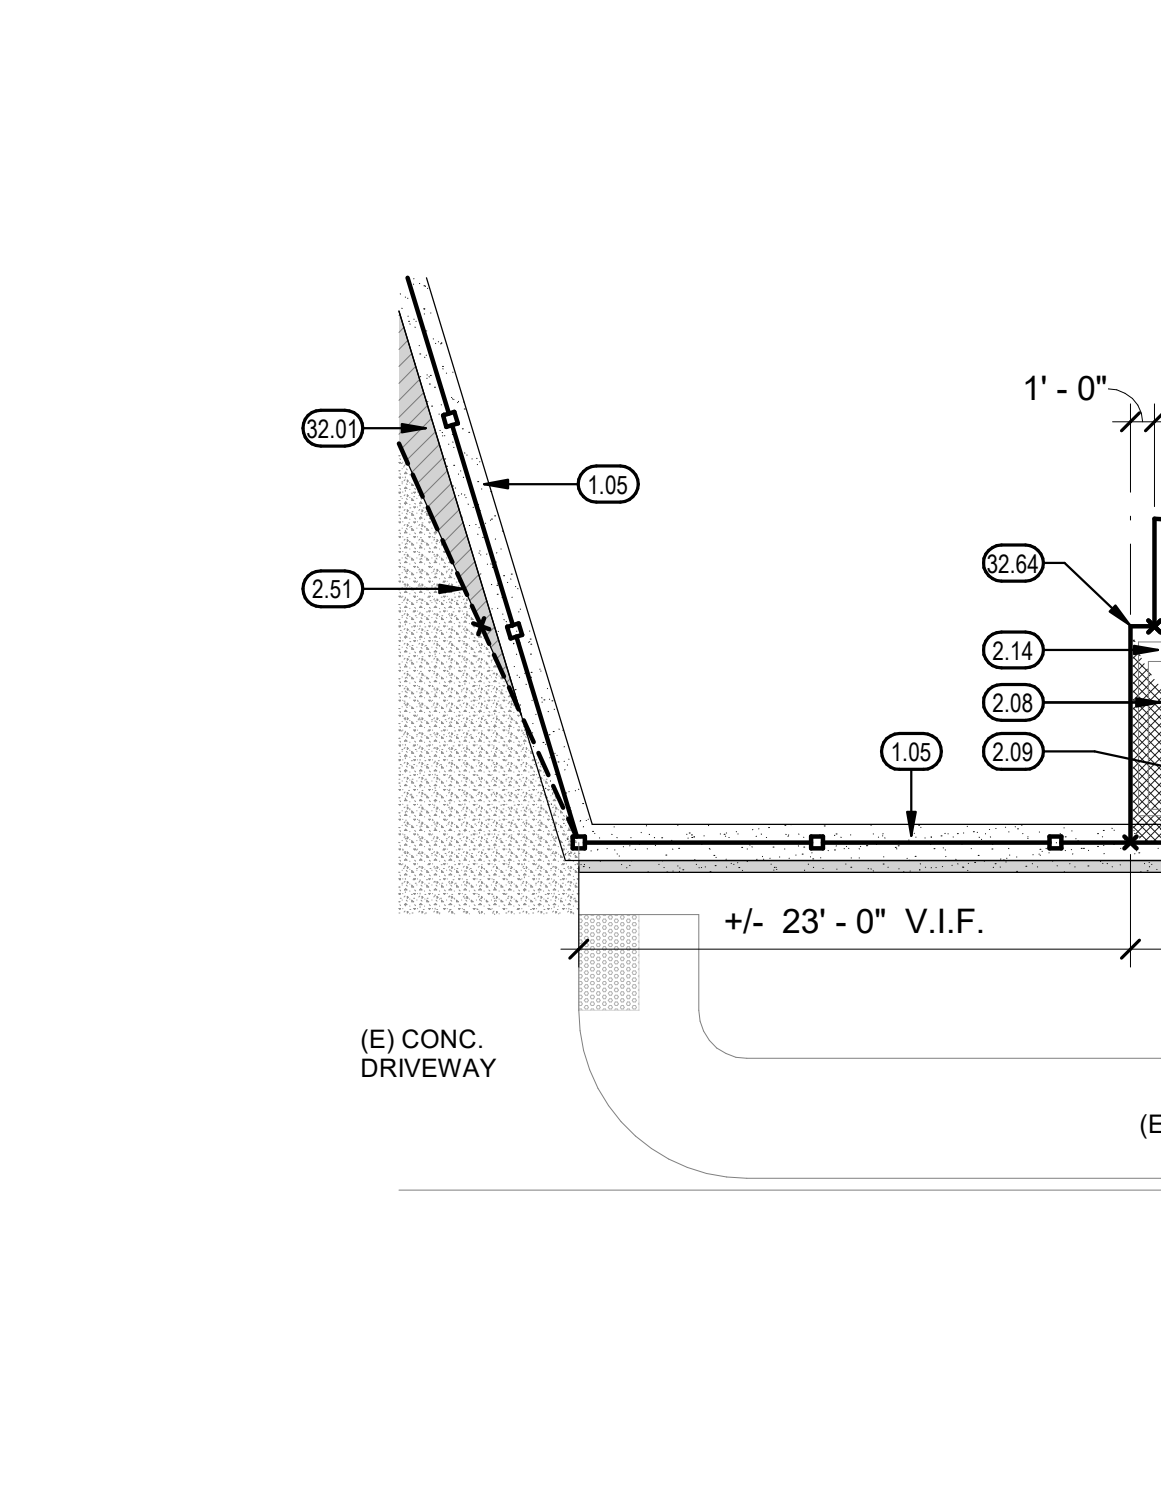

ENLARGED SITE PLAN

1/4" = 1'-0"


11

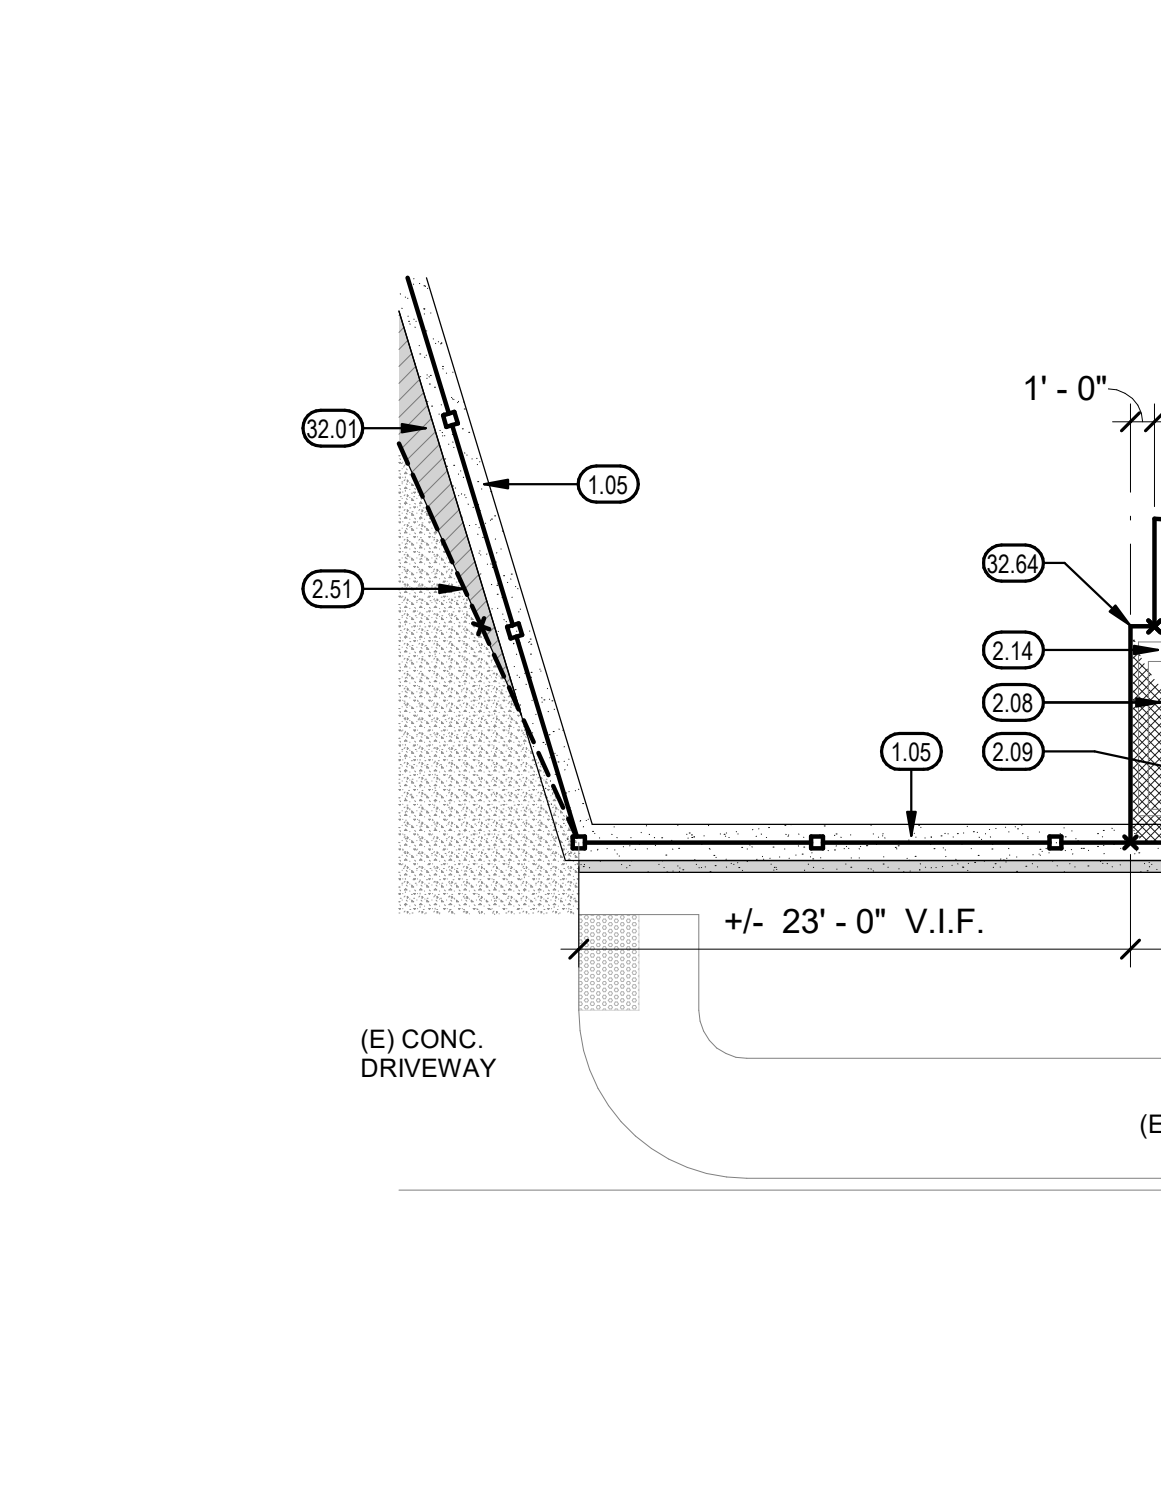

ENLARGED SITE PLAN

1/4" = 1'-0"


11

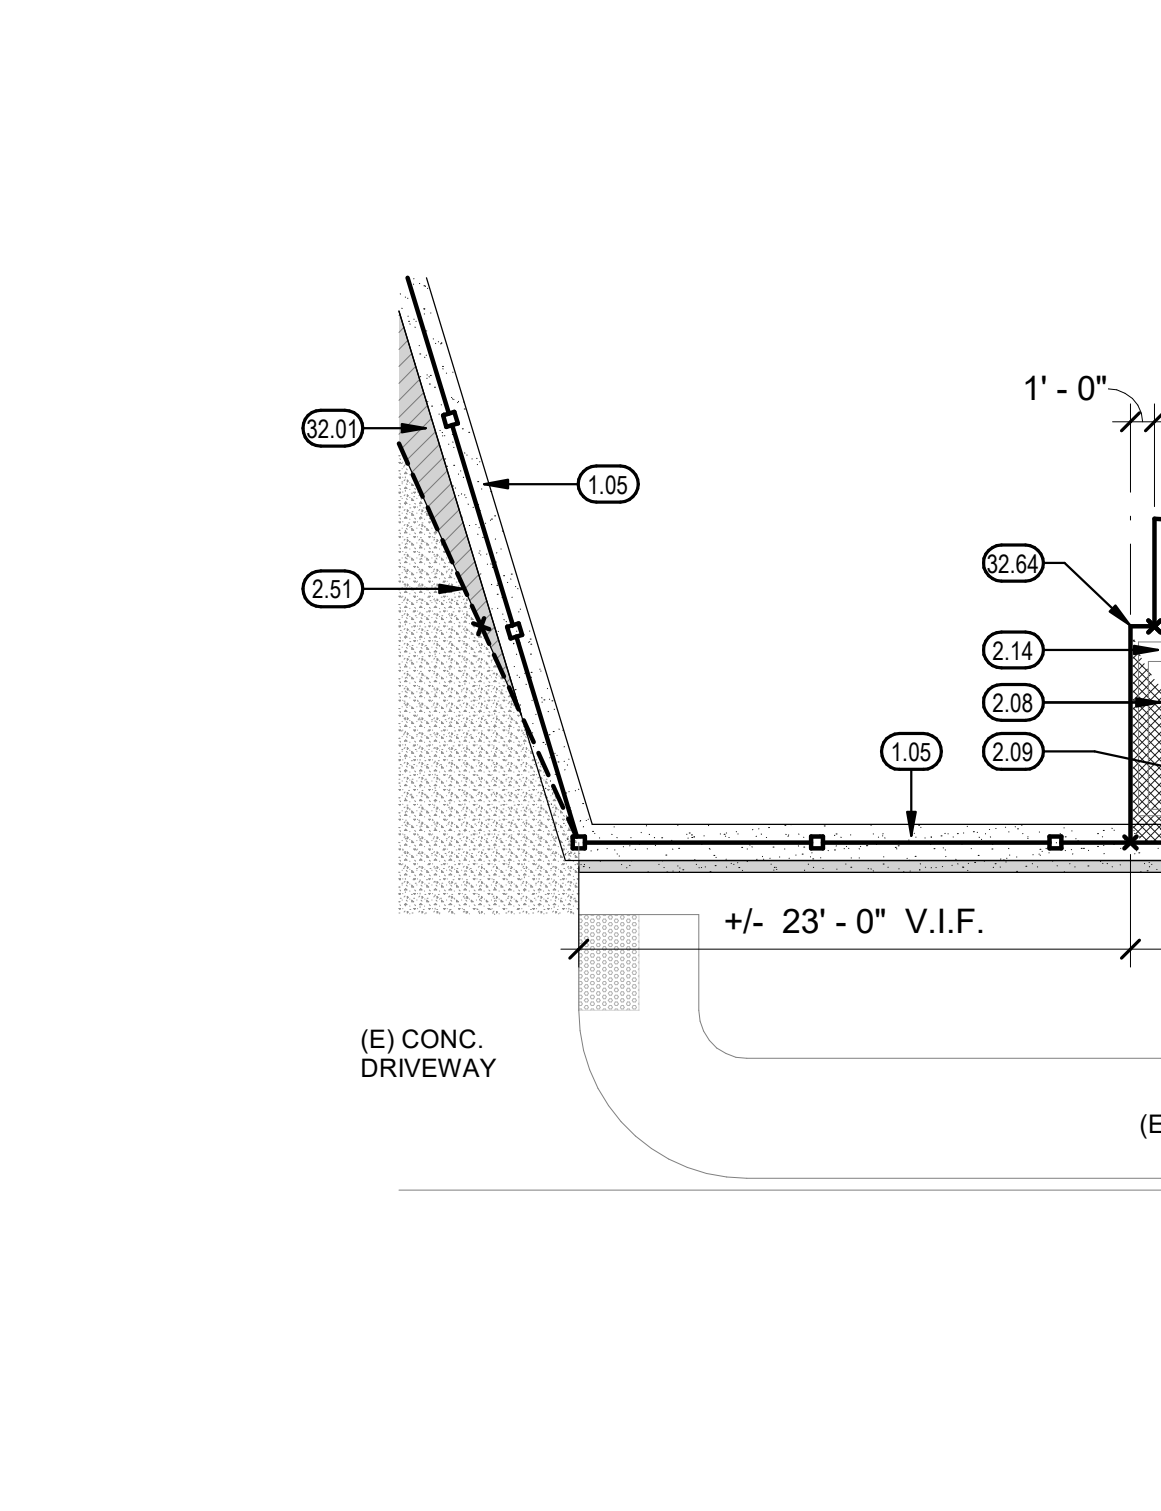

ENLARGED SITE PLAN

1/4" = 1'-0"


11

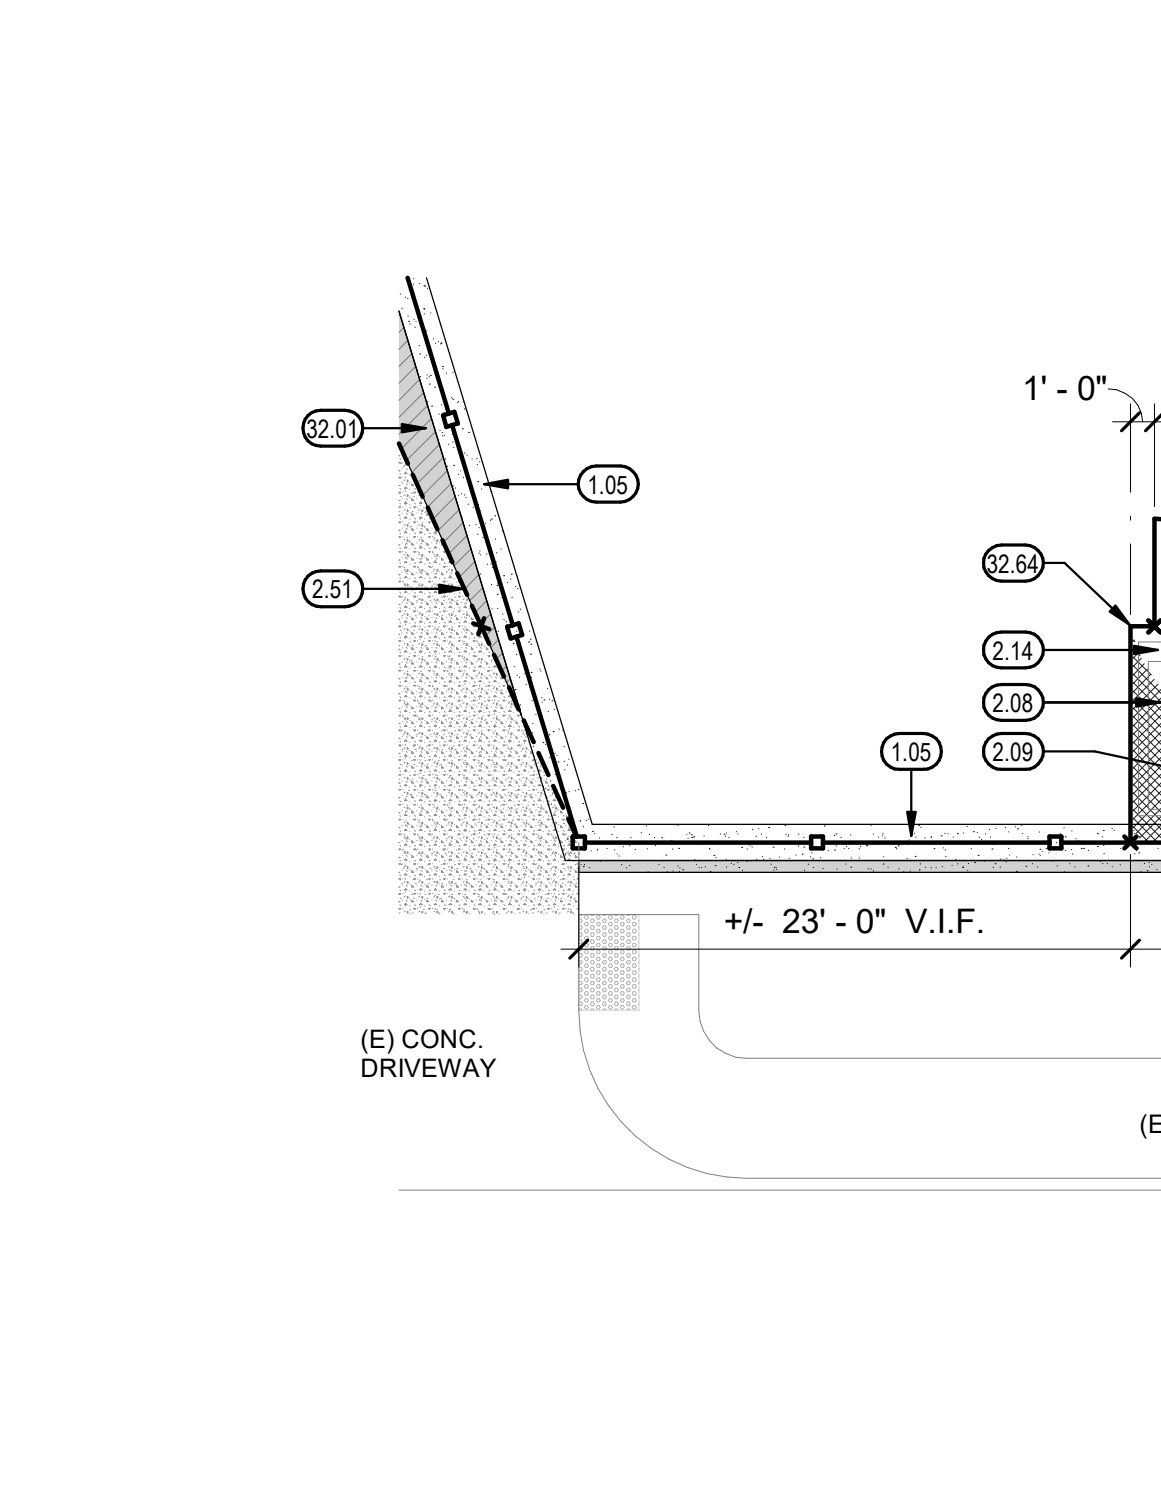

ENLARGED SITE PLAN

1/4" = 1'-0"


11

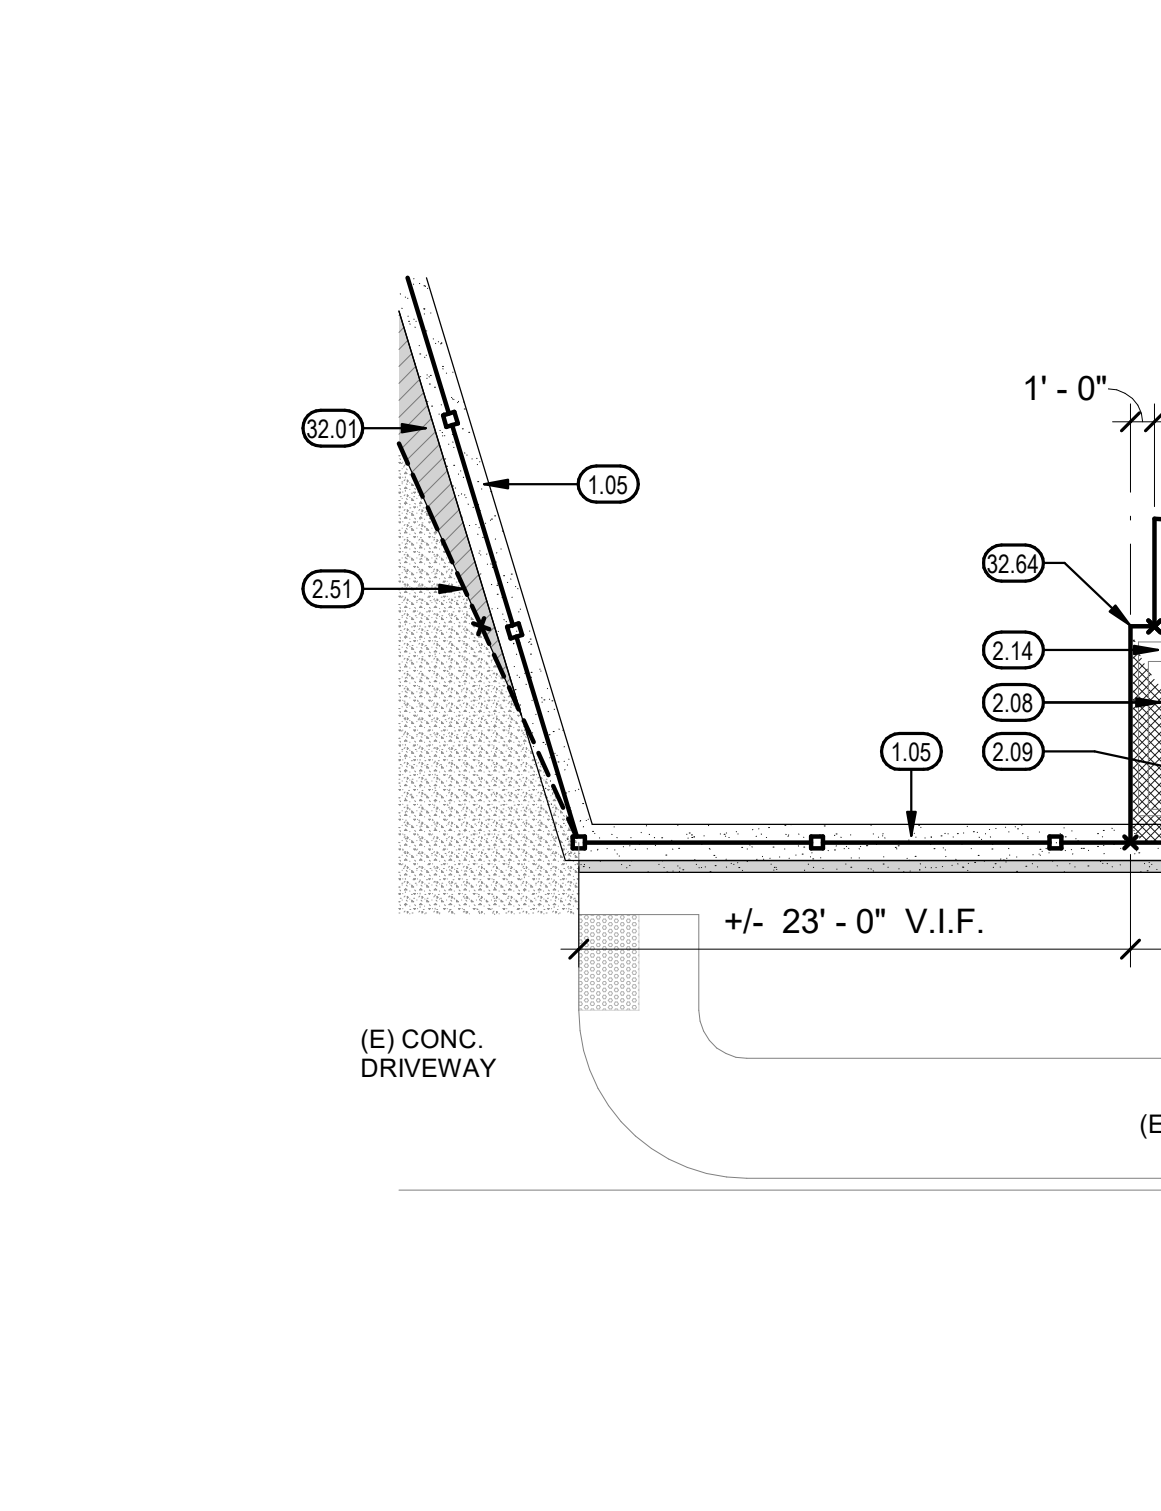

ENLARGED SITE PLAN

1/4" = 1'-0"


11

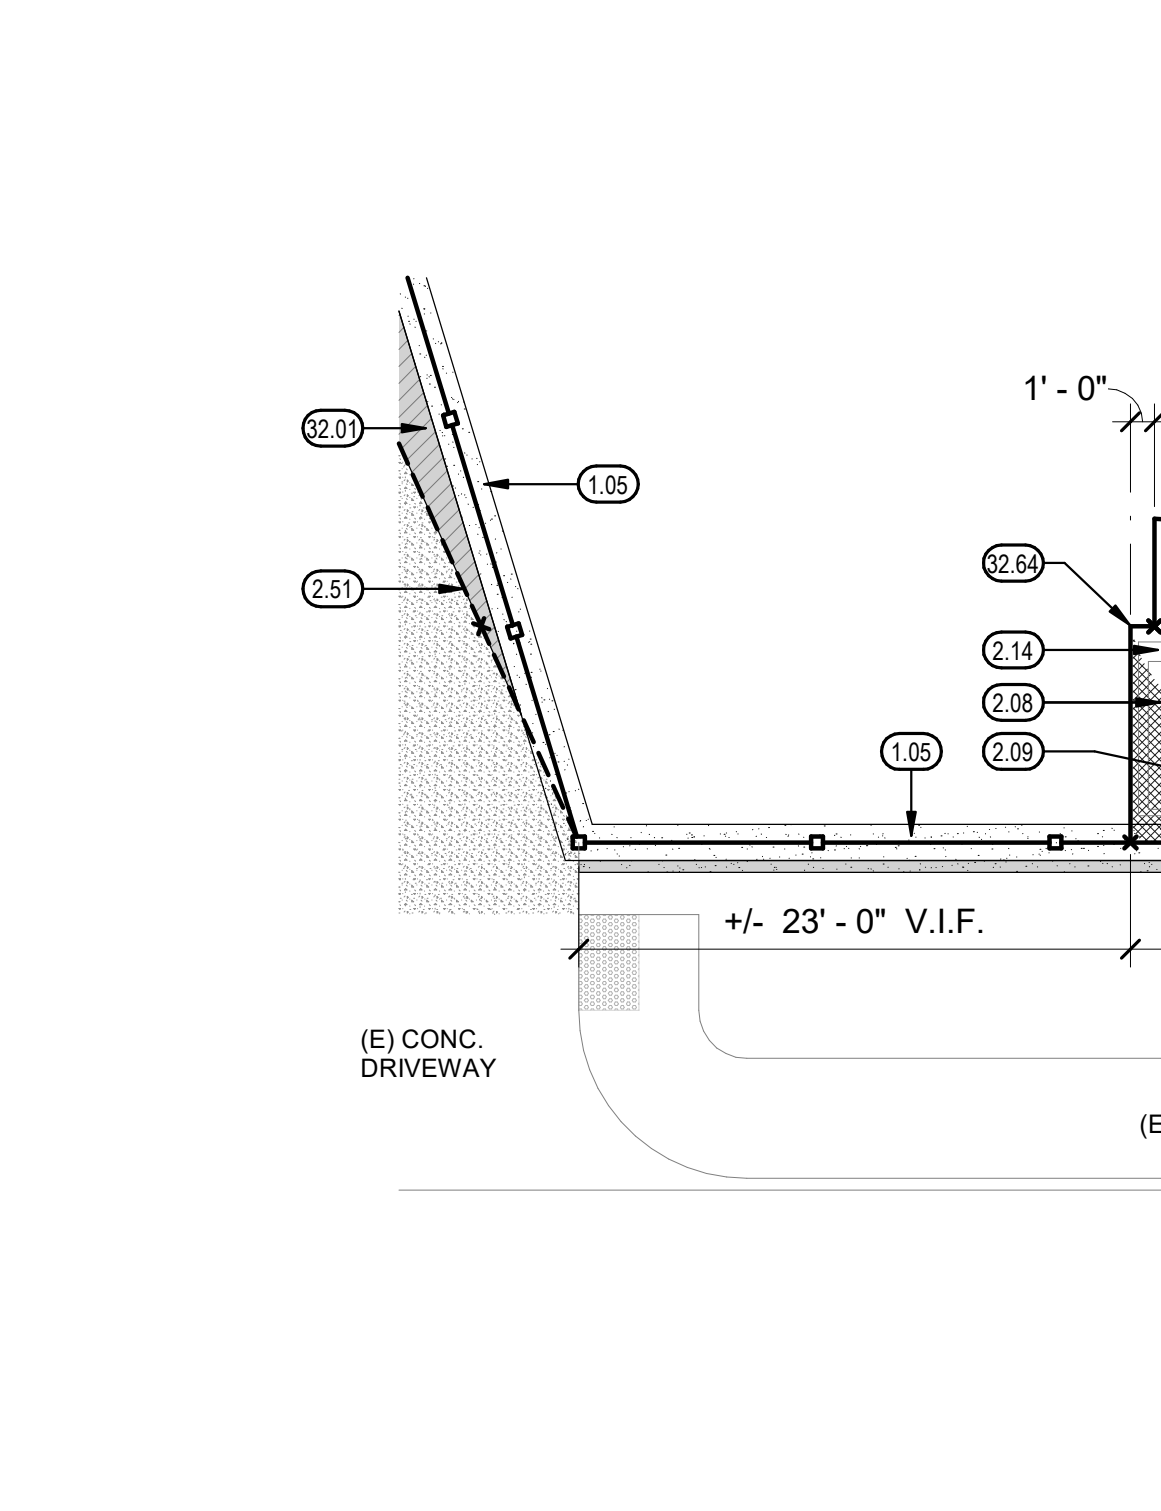

ENLARGED SITE PLAN

1/4" = 1'-0"


11

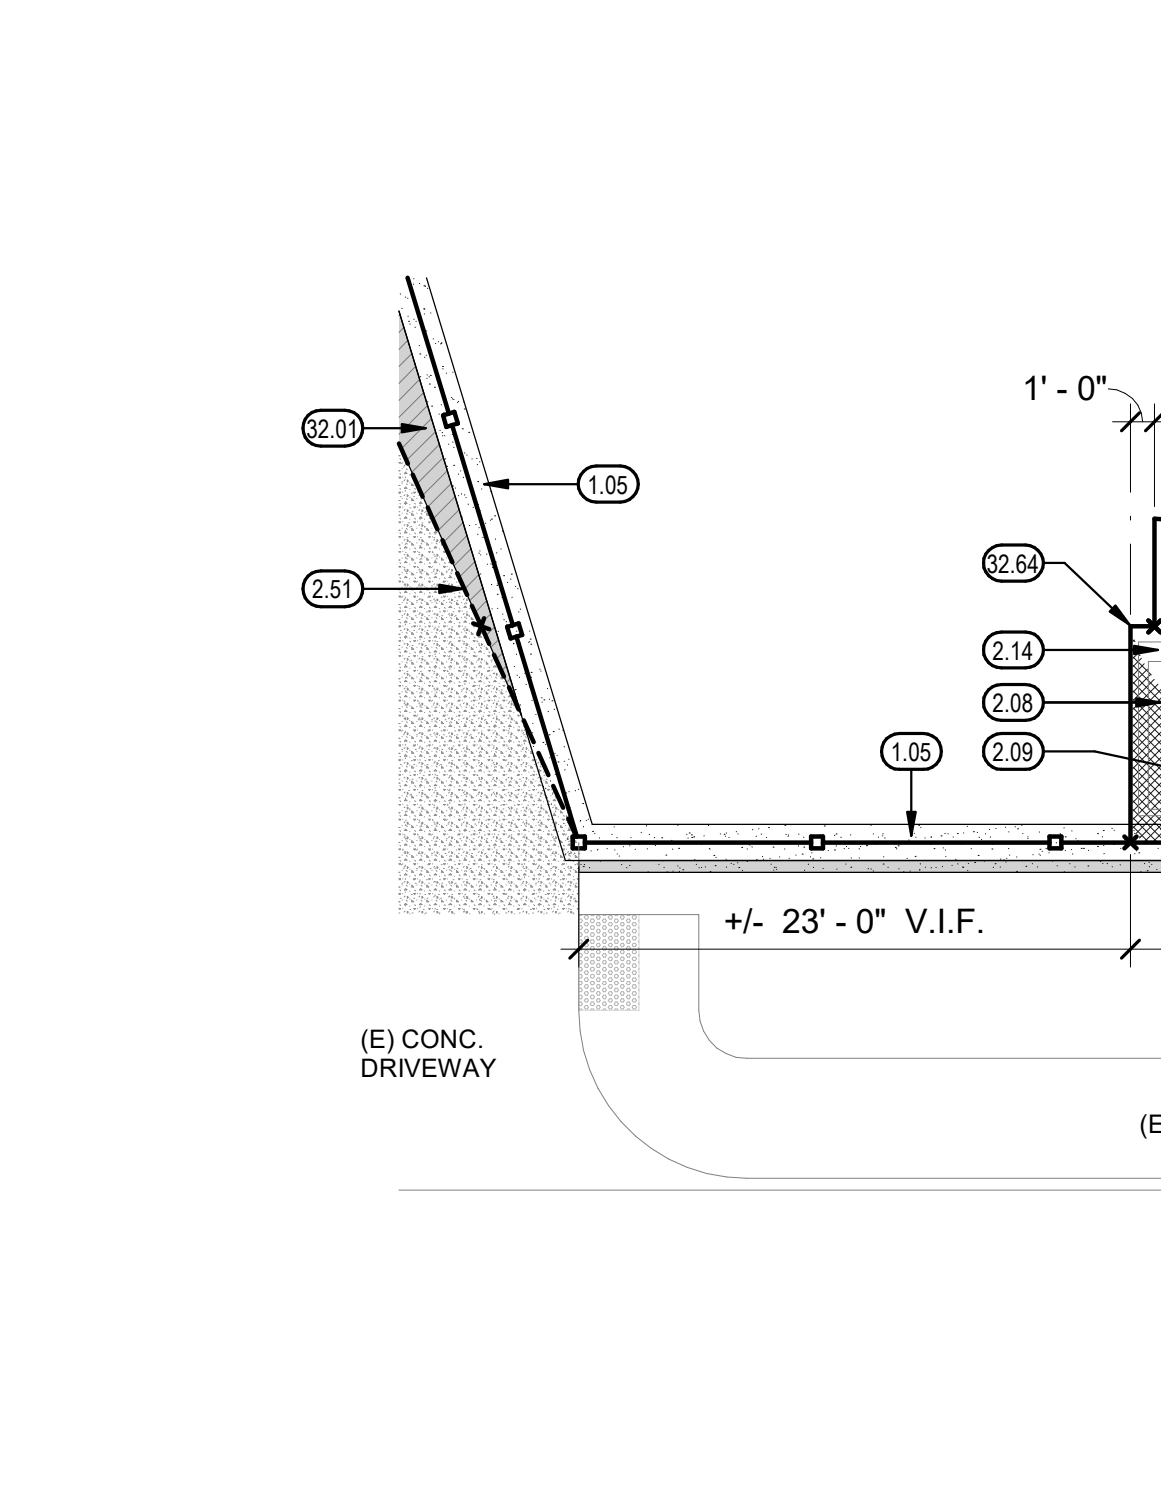

ENLARGED SITE PLAN

1/4" = 1'-0"


11

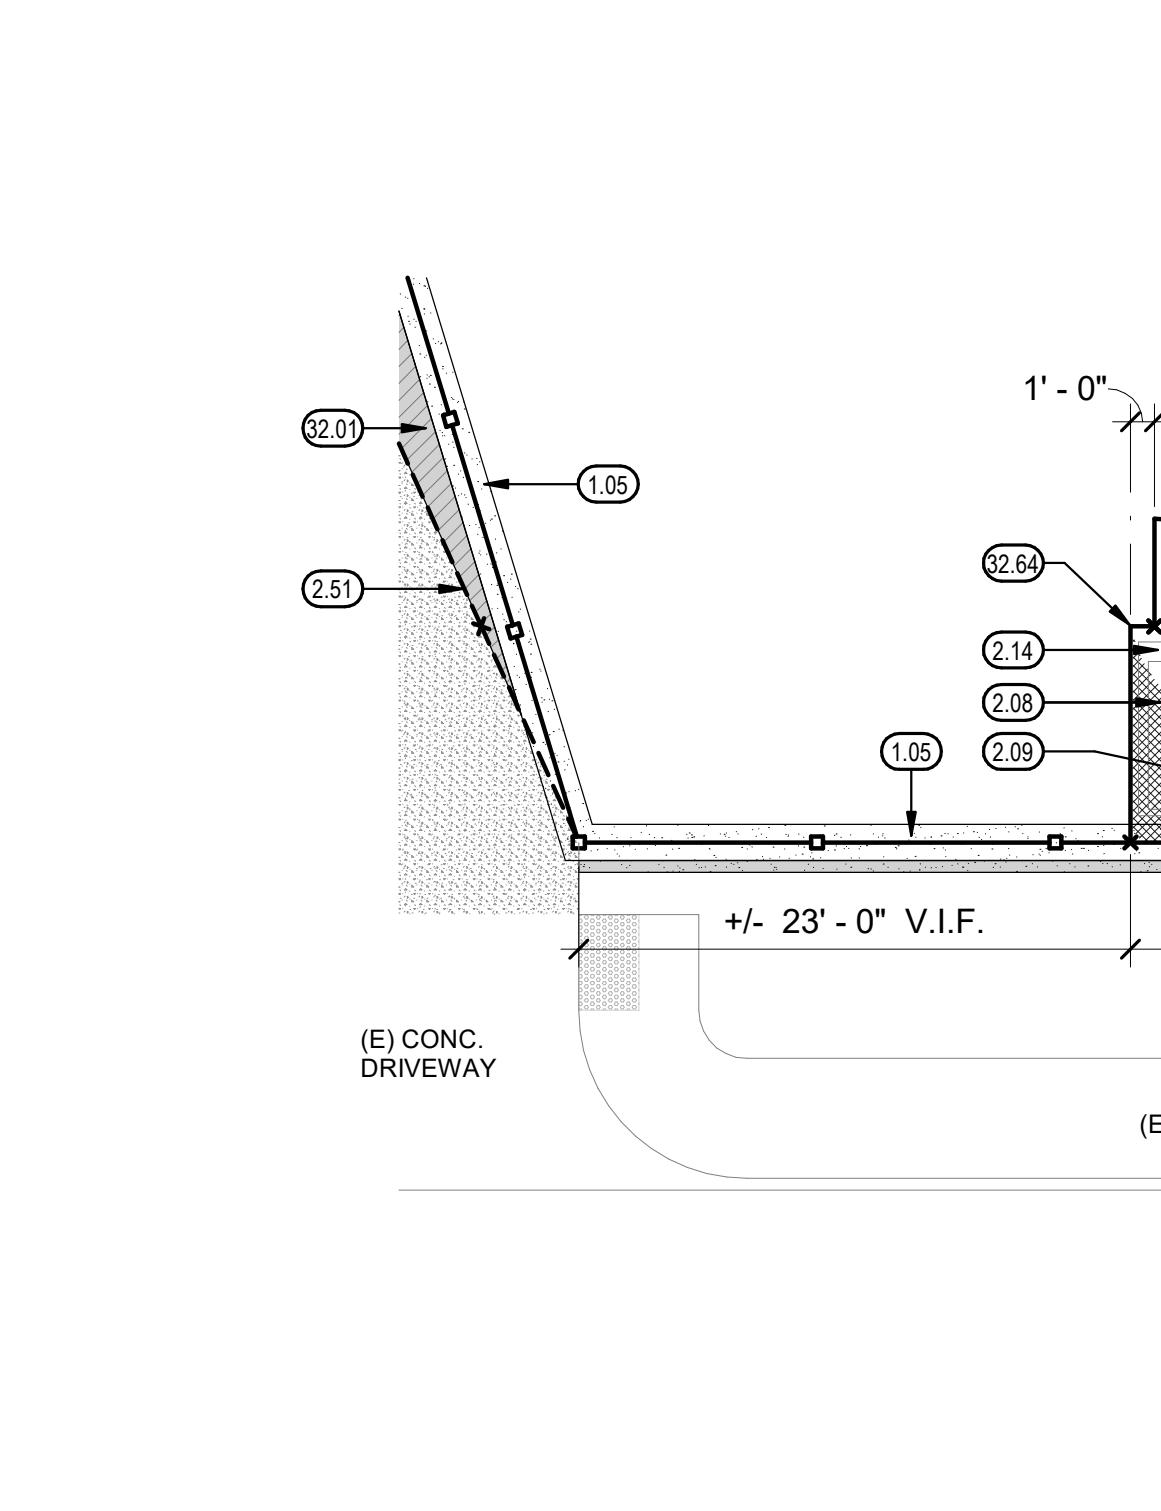

ENLARGED SITE PLAN

1/4" = 1'-0"

11

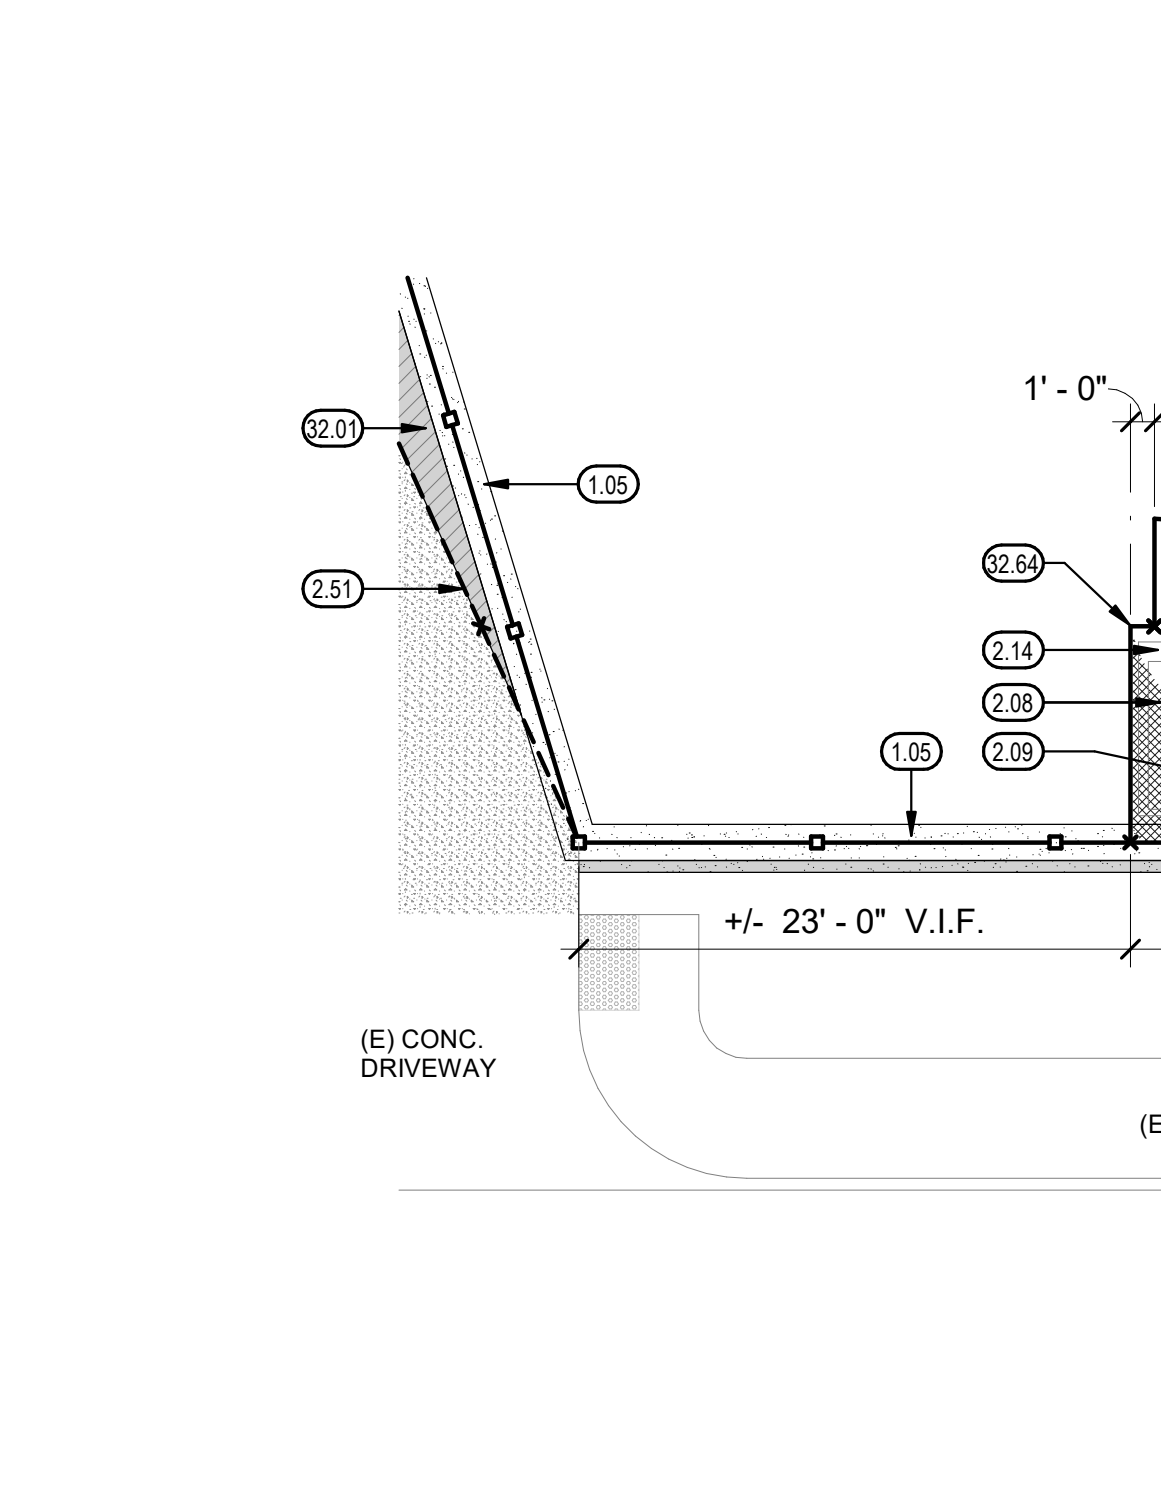




ENLARGED SITE PLAN

GATE SCHEDULE

NO.	MATERIAL	TYPE	GATE OPENING		GATE		PR/SGL	FUNCTION	DETAIL
			MATCH (E)	WIDTH	MATCH (E)	HEIGHT			
GE1	D.M.	SWING	MATCH (E)	MATCH (E)	MATCH (E)	SGL	*EGRESS	NOTE 1,2	
G01	D.M.	SWING	16' - 0"	8' - 0"	6' - 0"	PR	SERVICE	10 / A111	
G02	D.M.	SWING	4' - 0"	4' - 0"	6' - 0"	SGL	SERVICE	2 / A110	
G03	D.M.	SWING	4' - 0"	4' - 0"	6' - 0"	SGL	SERVICE	2 / A110	
G04	D.M.	SWING	8' - 0"	4' - 0"	6' - 0"	PR	*EGRESS	10 / A112	
G05	D.M.	SWING	4' - 0"	4' - 0"	6' - 0"	SGL	SERVICE	2 / A110	
G06	C.L.	SWING	8' - 0"	4' - 0"	6' - 0"	PR	SERVICE	8 / A111	
G07	D.M.	SWING	4' - 0"	4' - 0"	6' - 0"	SGL	SERVICE	2 / A110	
G08	D.M.	SWING	16' - 0"	8' - 0"	6' - 0"	PR	SERVICE	10 / A111	
G09	D.M.	SWING	4' - 0"	4' - 0"	6' - 0"	SGL	SERVICE w/ EXIT	2 / A112	
G10	D.M.	SWING	4' - 0"	4' - 0"	6' - 0"	SGL	SERVICE w/ EXIT	2 / A112	
G11	D.M.	SWING	4' - 0"	4' - 0"	6' - 0"	SGL	SERVICE w/ EXIT	2 / A112	
G12	D.M.	SWING	4' - 0"	4' - 0"	6' - 0"	SGL	SERVICE	2 / A110	
G13	C.L.	SWING	4' - 0"	4' - 0"	6' - 0"	SGL	SERVICE	3 / A111	
G14	D.M.	SWING	8' - 0"	4' - 0"	6' - 0"	PR	SERVICE	3 / A110	
G15	D.M.	SWING	4' - 0"	4' - 0"	6' - 0"	SGL	SERVICE	2 / A110	
G16	D.M.	SWING	22' - 0"	11' - 0"	6' - 0"	SGL	SERVICE	10 / A111	
G17	D.M.	SWING	6' - 0"	6' - 0"	6' - 0"	SGL	SERVICE	2 / A110	

1

   1. CONCRETE FENCE POST FOOTINGS SHALL NOT ENCRoACH INTO PUBLIC RIGHT-OF-WAY.
2. CONTRACTOR SHALL PROTECT IMPROVEMENTS WITHIN THE PUBLIC RIGHT-OF-WAY FROM DAMAGE DURING CONSTRUCTION ACTIVITIES.
3. CONTRACTOR SHALL OBTAIN AN ENCROACHMENT PERMIT BEFORE PERFORMING ANY WORK OR REPAIRS WITHIN THE CITY RIGHT-OF-WAY.
4. ANY WORK OR REPAIRS WITHIN THE CITY RIGHT-OF-WAY SHALL BE PER CITY OF MERCED STANDARDS.
5. CONTRACTOR SHALL MODIFY, REPAIR AND ADJUST (E) IRRIGATION SYSTEM TO ENSURE PROPER IRRIGATION COVERAGE TO (E) MODIFIED TURF AREAS.
6. CONTRACTOR SHALL REPLACE AND/OR REPAIR ANY DAMAGED IRRIGATION, OR TURF AREAS DISTURBED DURING THE COURSE OF CONSTRUCTION.
7. CONTRACTOR TO FIELD VERIFY ALL DIMENSIONS AND SITE CONDITIONS PRIOR TO SUBMITTING THEIR BID
8. MODIFY IRRIGATION PIPING AND SPRAY HEADS AS NEEDED FOR LANDSCAPE ADJUSTMENTS, FENCING INSTALLATION, AND/OR CONCRETE MOWSTRIP

- | | |
|---|--|
|  | (E) DECORATIVE METAL FENCE TO REMAIN |
|  | (E) CHAINLINK FENCE TO REMAIN |
|  | PROPOSED 6' DECORATIVE METAL FENCE, BLACK, SEE |
|  | PROPOSED 6' CHAIN LINK FENCE W/ PRIVACY SLATS, BLACK |
|  | GATE DESIGNATION |
|  | (E) BUILDING, NO WORK |
|  | (E) 20'-0" FIRE LANE PER DSA# 02 -114807 |
|  | (E) ACCESSIBLE PATH OF TRAVEL PER DSA #02-114807 |
|  | (E) PATH OF EMERGENCY EGRESS DSA #02-114807 |
|  | (E) FH
EXISTING FIRE HYDRANT |

- 1.09 ALTERNATE NO. 9: 18" MOWSTRIP AT NEW FENCING, SEE 1/A110
FOR ADDITIONAL INFORMATION
- 1.10 ALTERNATE NO. 10: CONCRETE PAVING BETWEEN MOWSTRIP &
SIDEWALK, SEE 1/A110 FOR ADDITIONAL INFORMATION
- 2.01 EXISTING BACKFLOW
- 2.02 EXISTING CURB RAMP AND DETECTABLE WARNINGS PER DSA
#02-105309
- 2.78 REMOVE EXISTING CHAIN LINK FENCE
- 10.11 ACCESSIBLE PARKING LOT ENTRANCE TOW-AWAY SIGN, SEE 9 / A110
- 10.61 KNOX BOX, EMERGENCY SERVICES KEY STORAGE
- 32.64 6'-0" FT HIGH, CHAIN LINK FENCING W/ BLACK PRIVACY SLATS,
SEE 12 / A110
- 32.65 6'-0" FT HIGH, BLACK DECORATIVE METAL FENCING, SEE 6 / A111
- 32.67 DECORATIVE METAL SERVICE GATE, SEE 2 / A110
- 32.69 DECORATIVE METAL PAIR OF SWING SERVICE GATES, SEE 3 / A110
- 32.72 DECORATIVE METAL ACCESSIBLE GATE, SEE 2 / A112


$$1'' = 40'-0''$$



2

A100




Teter, Inc. expressly reserves its common law copyright and other property rights in these plans. This document, the ideas and designs incorporated herein, as an instrument of professional service, is not to be used in whole or in part, for any other project without prior written authorization.


DRAWING TITLE
SITE PLAN

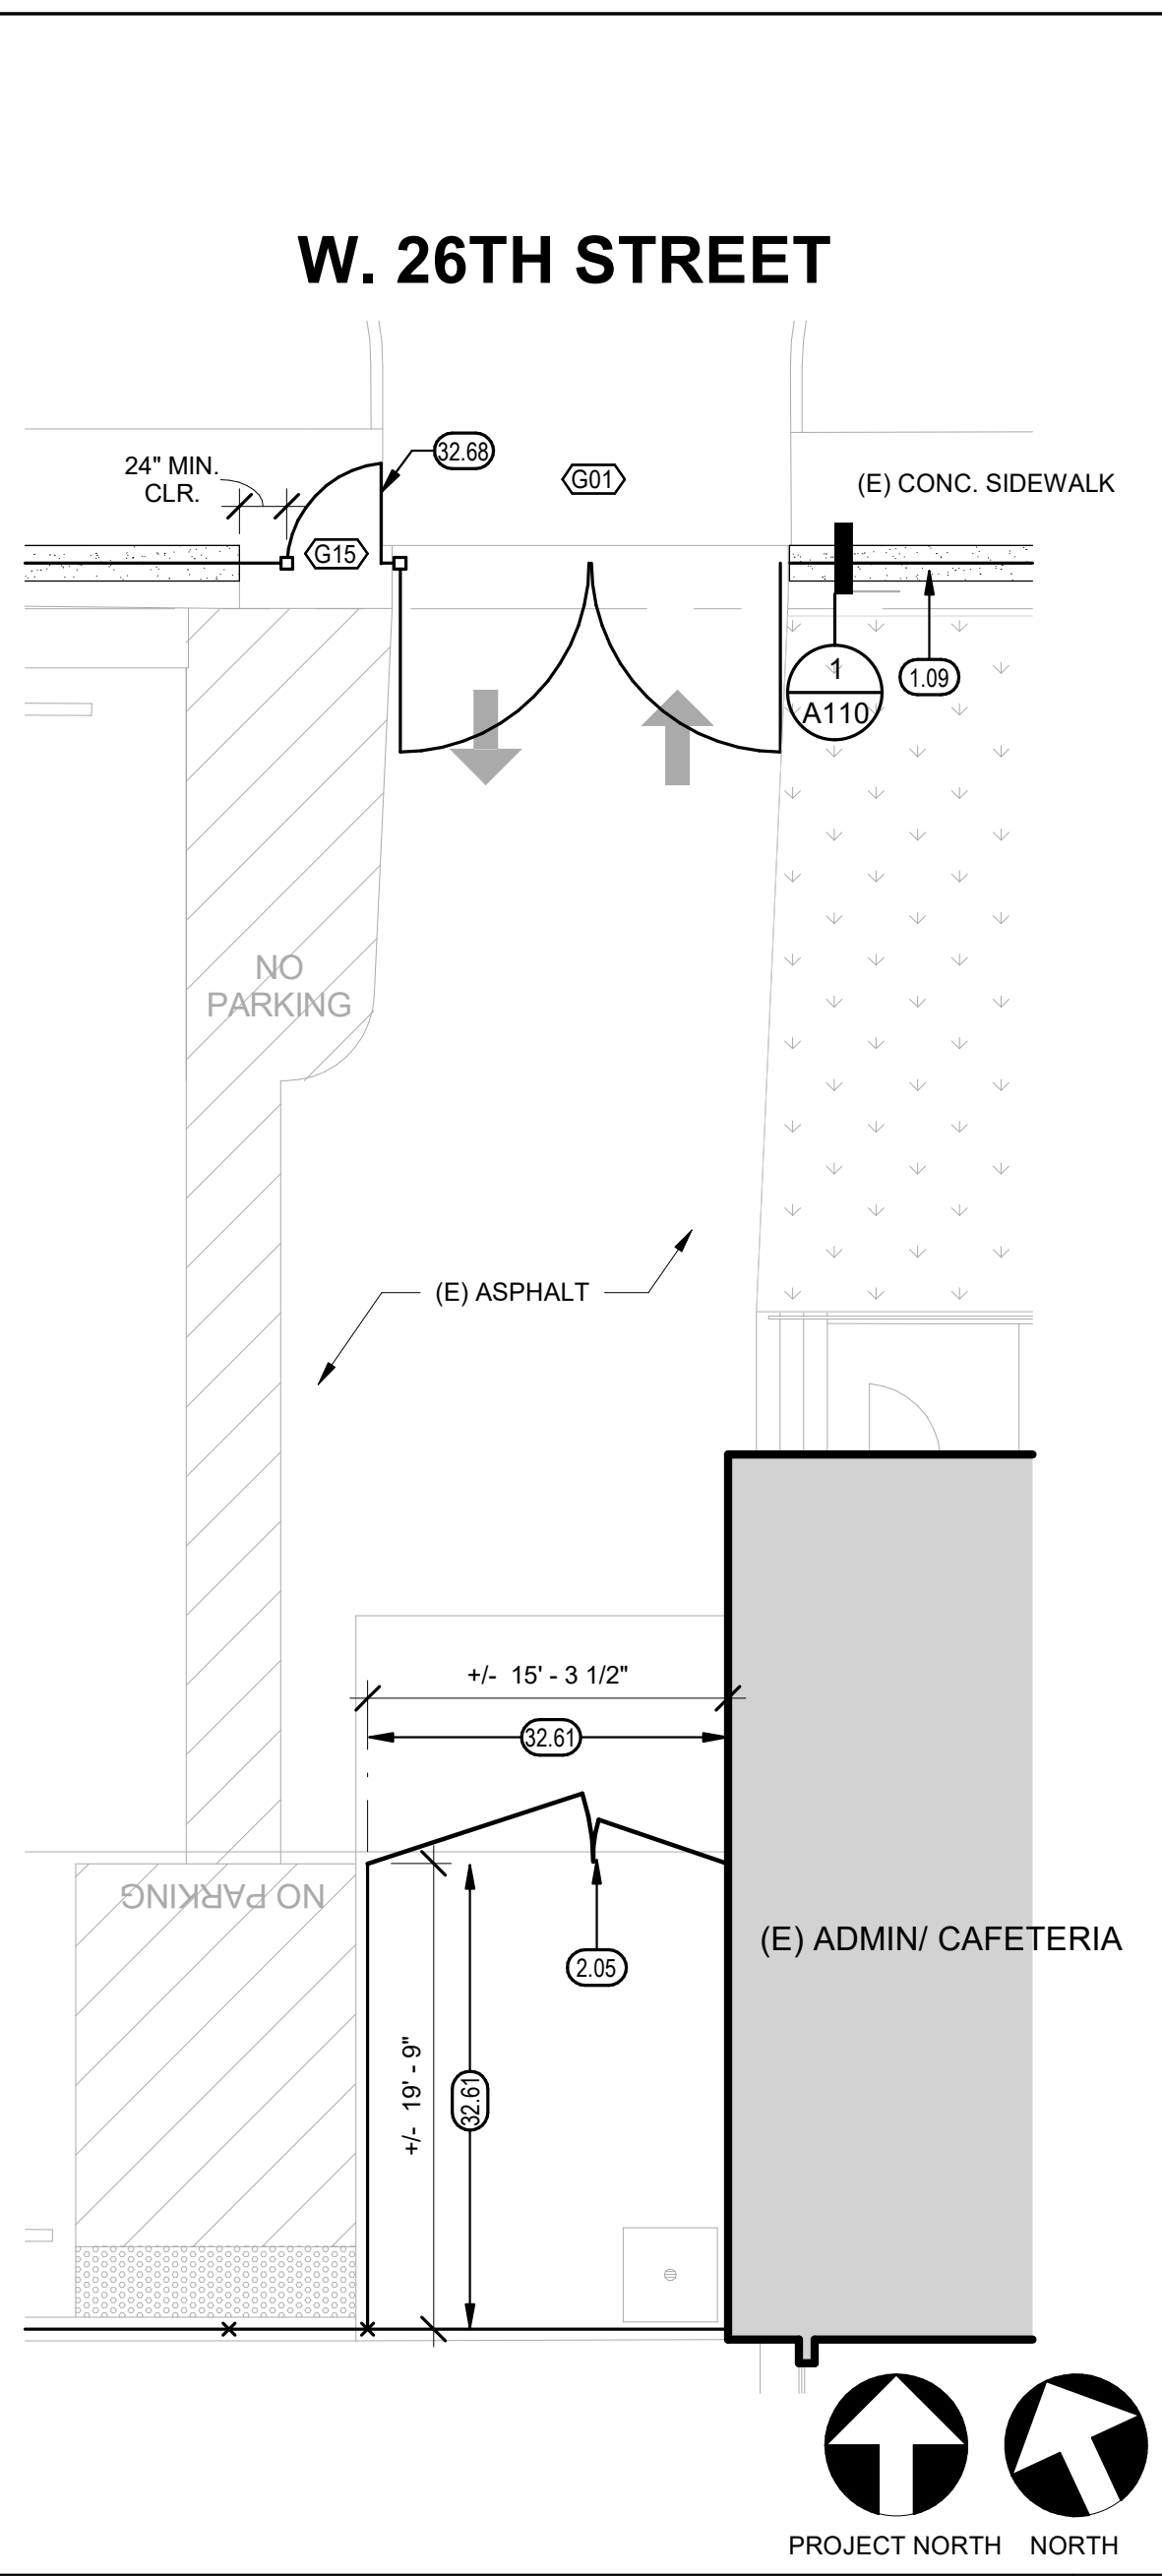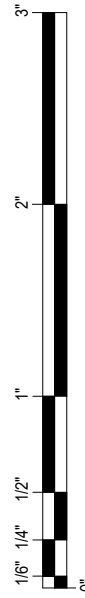


ENLARGED SITE PLAN 1/8" = 1'-0" 19

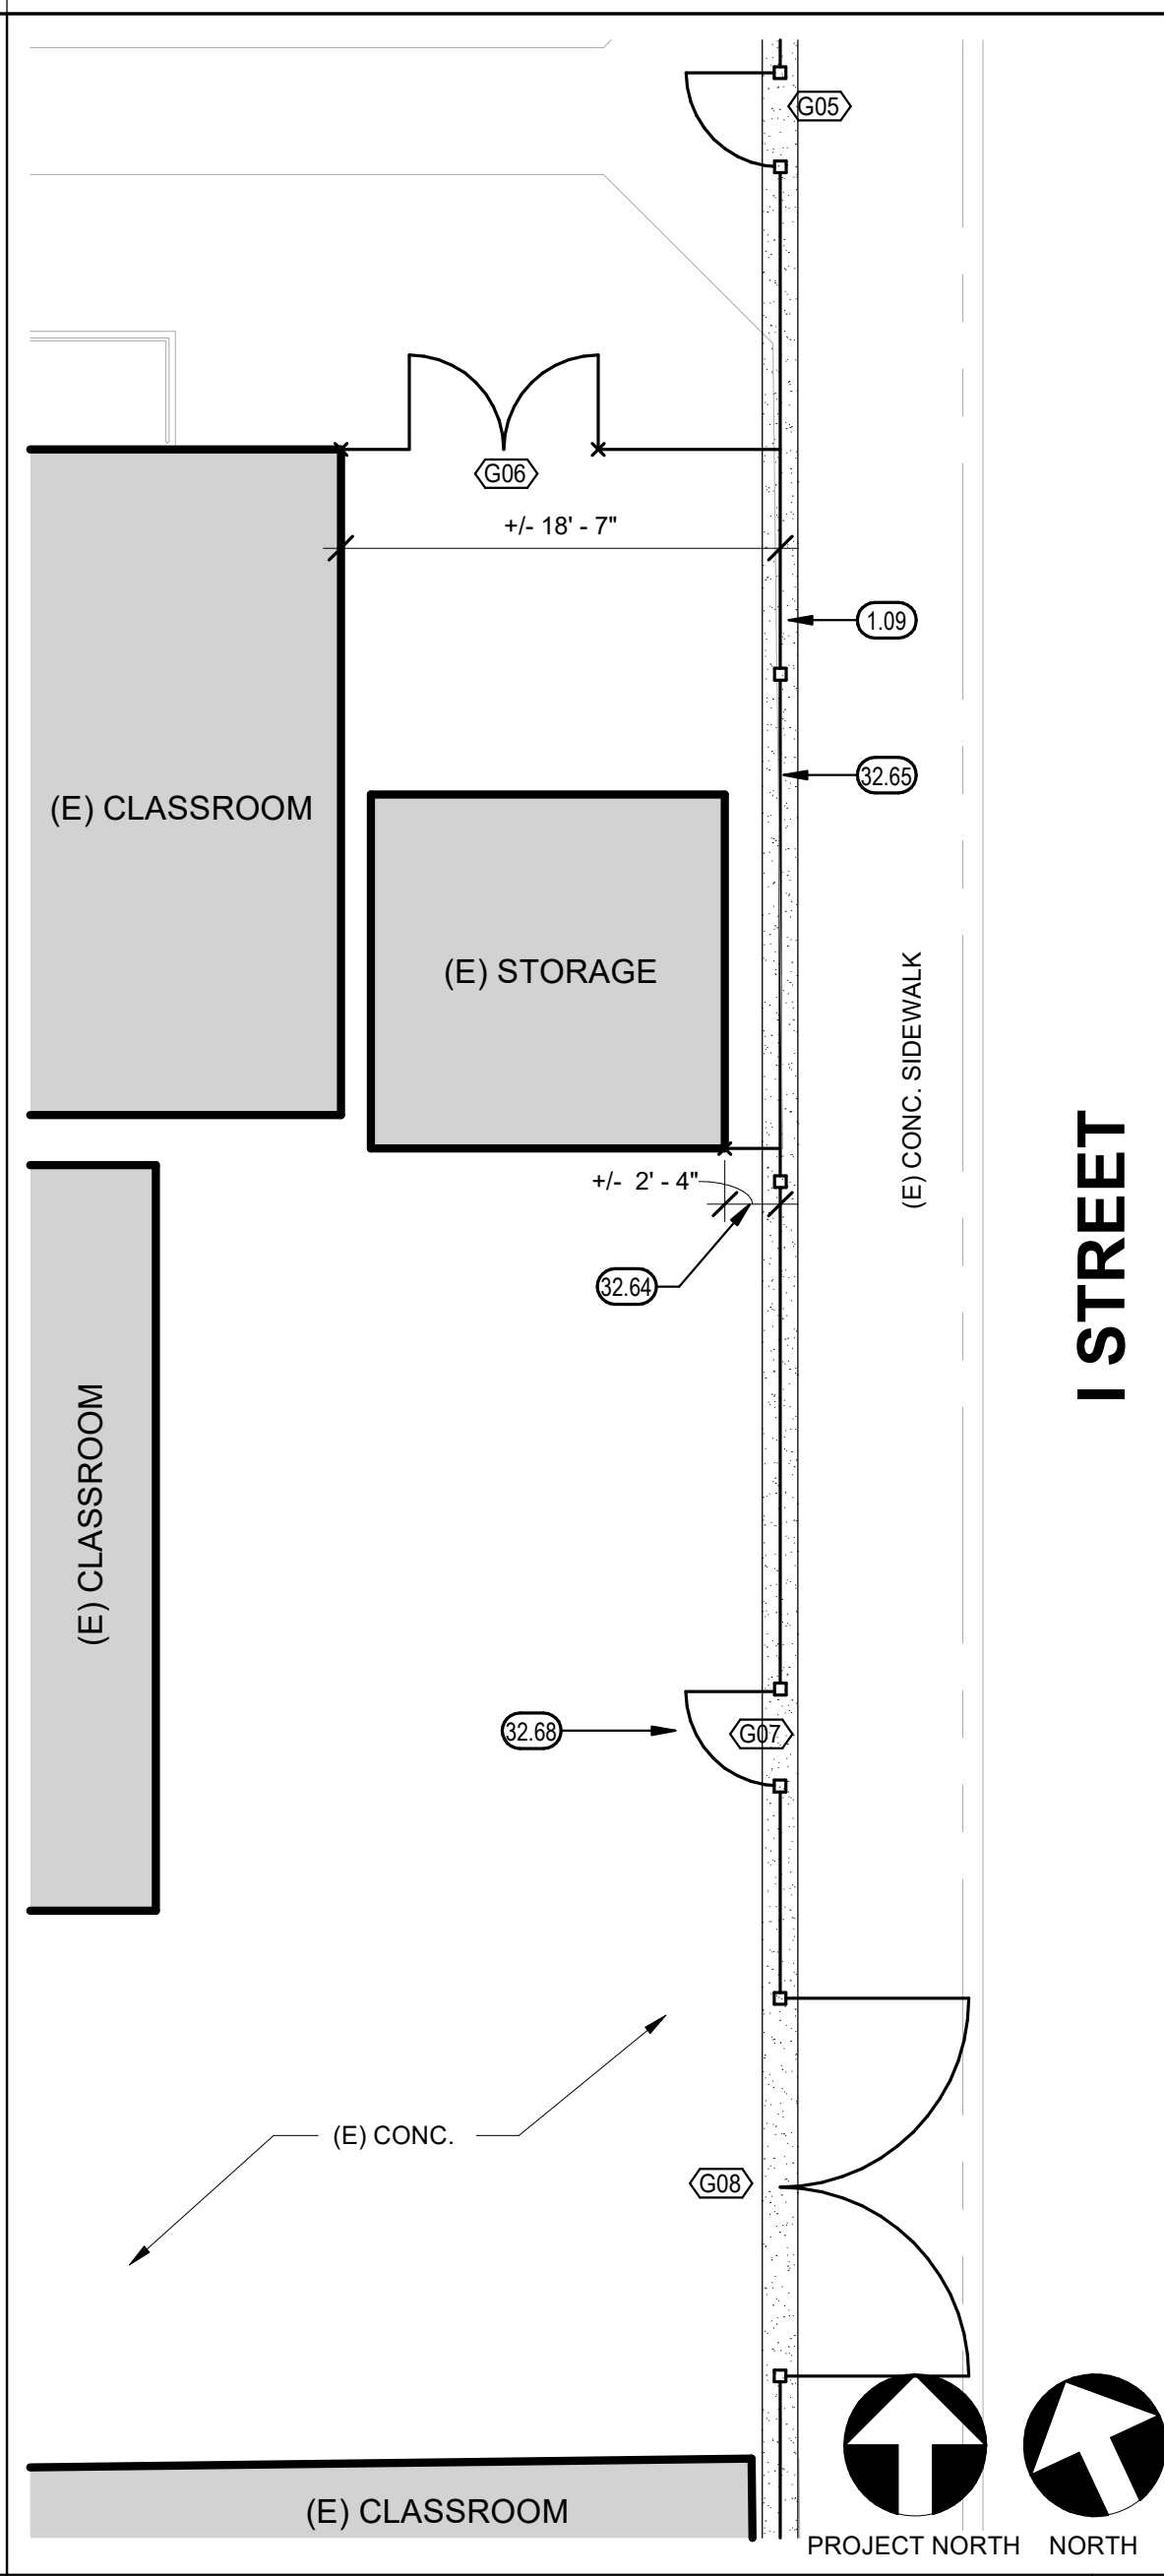

ENLARGED SITE PLAN 1/8" = 1'-0" 15

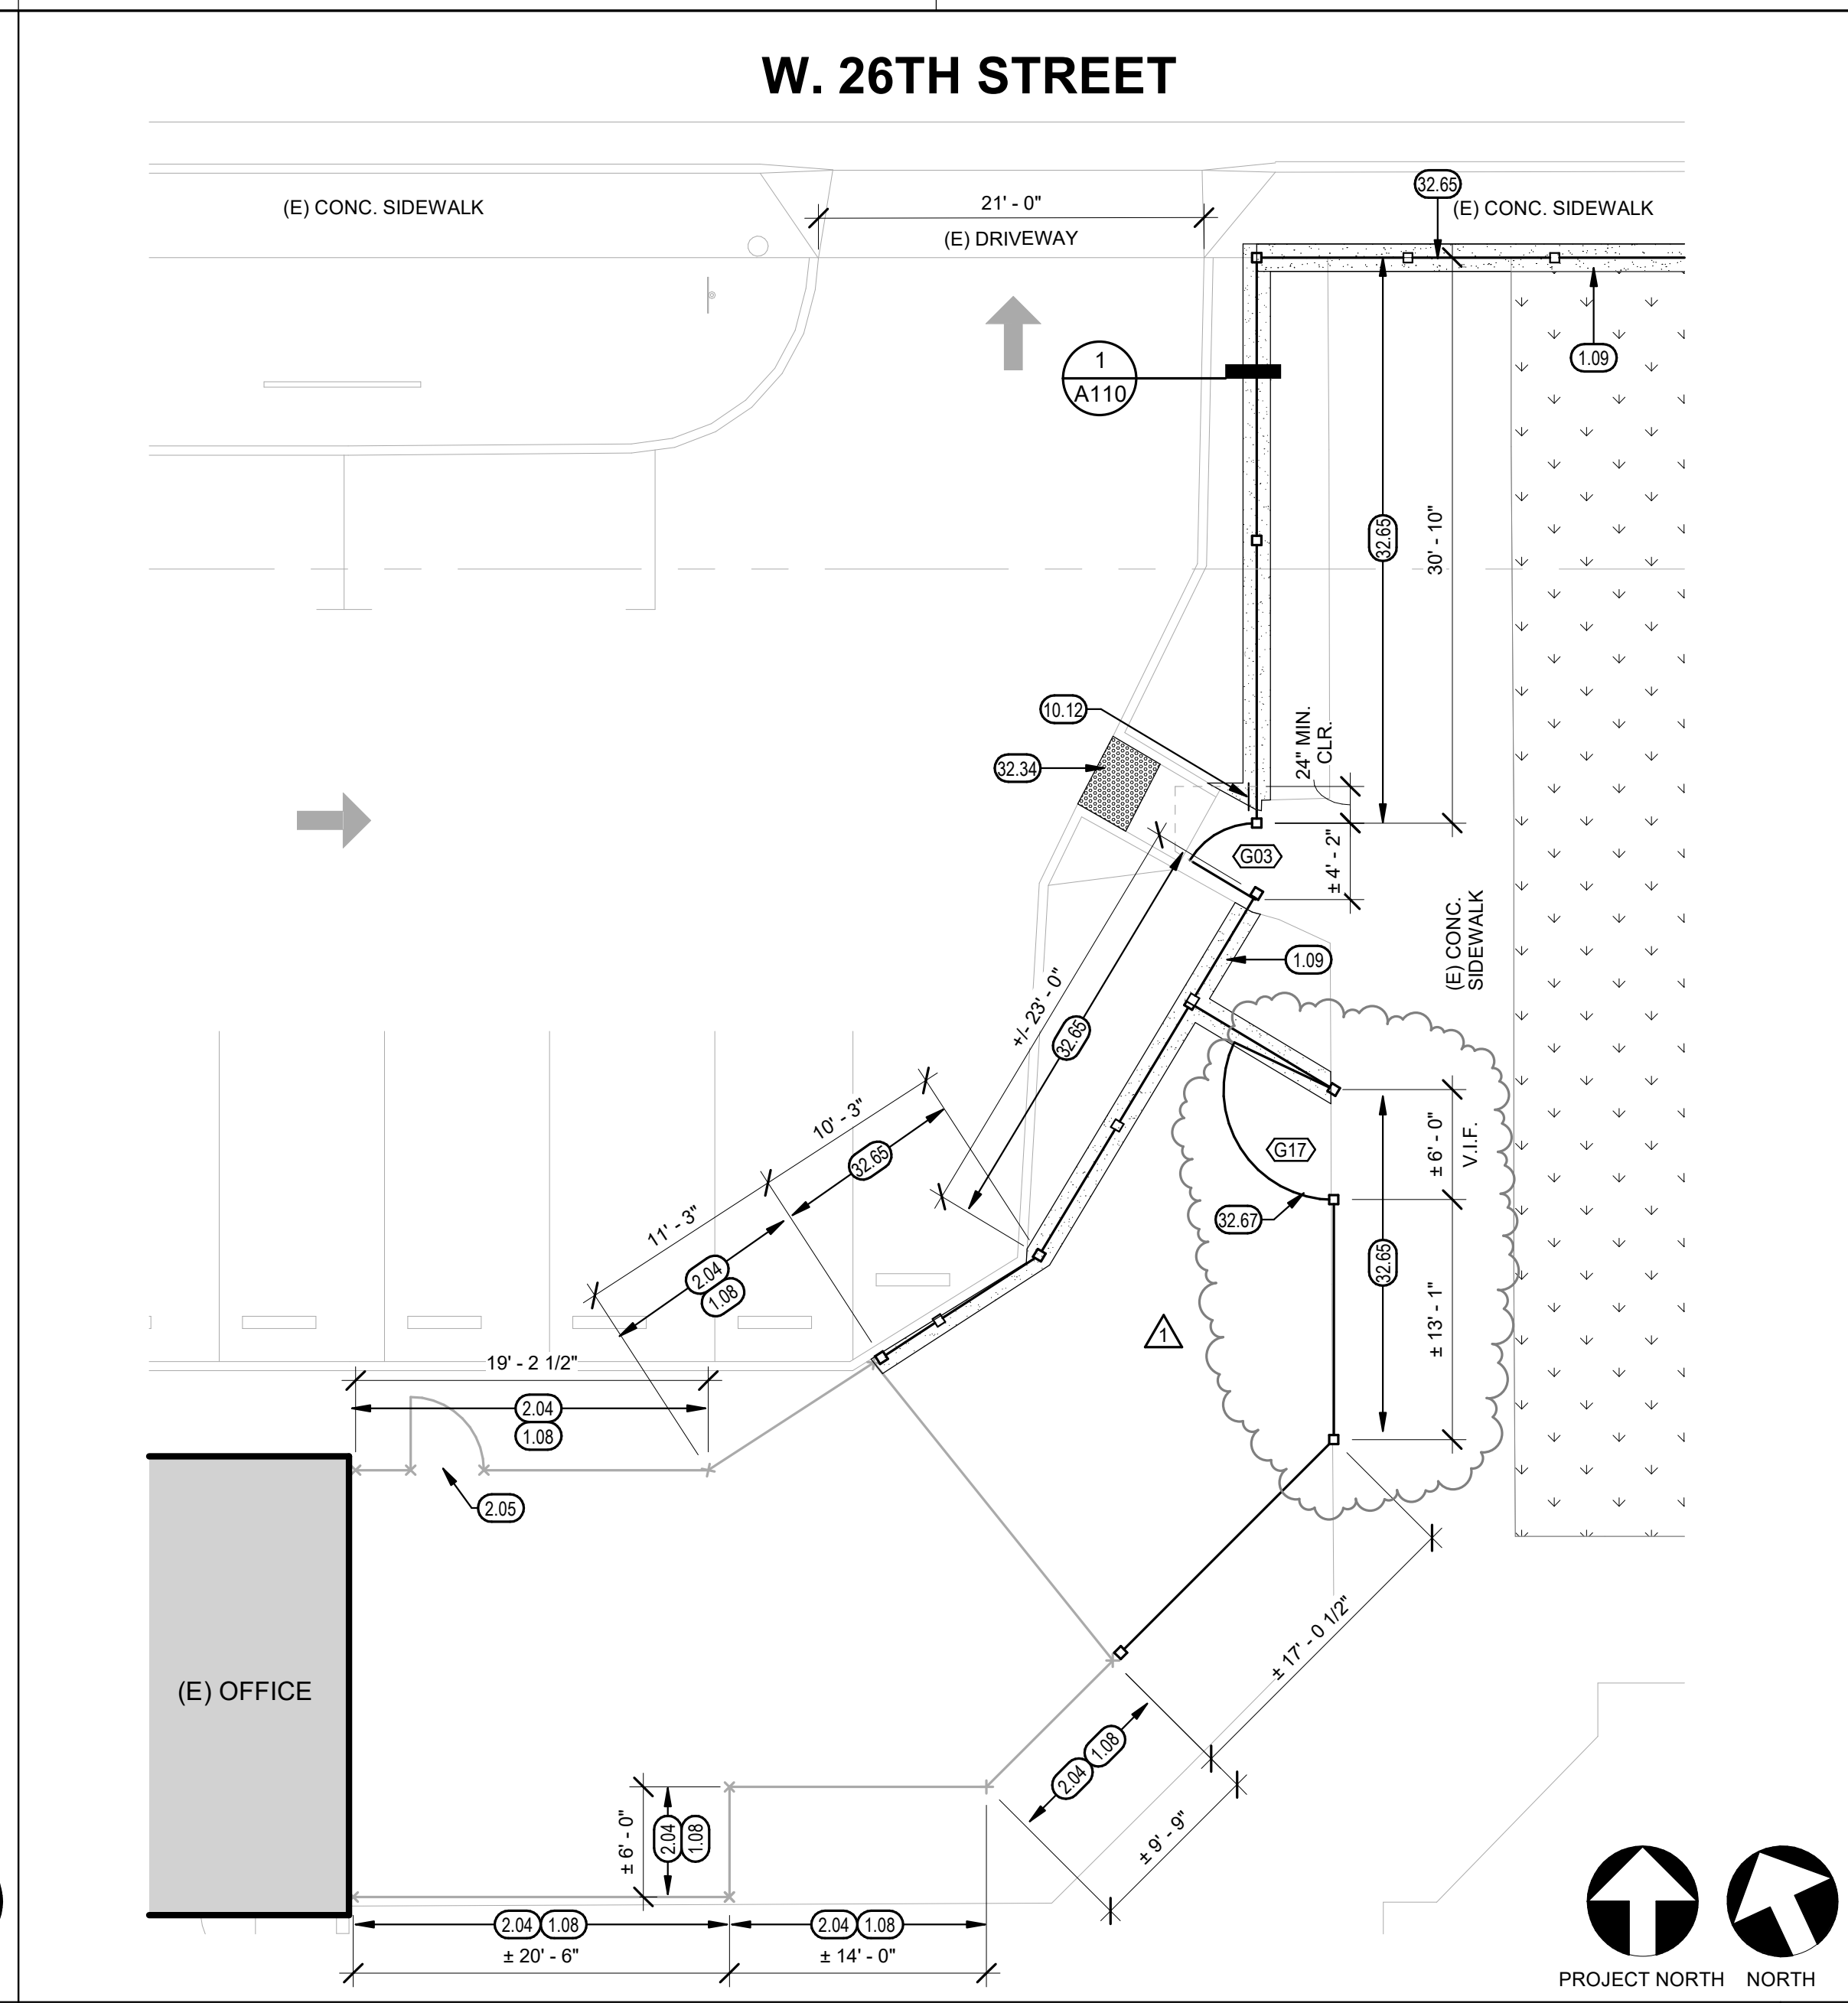

ENLARGED SITE PLAN 1/8" = 1'-0" 7

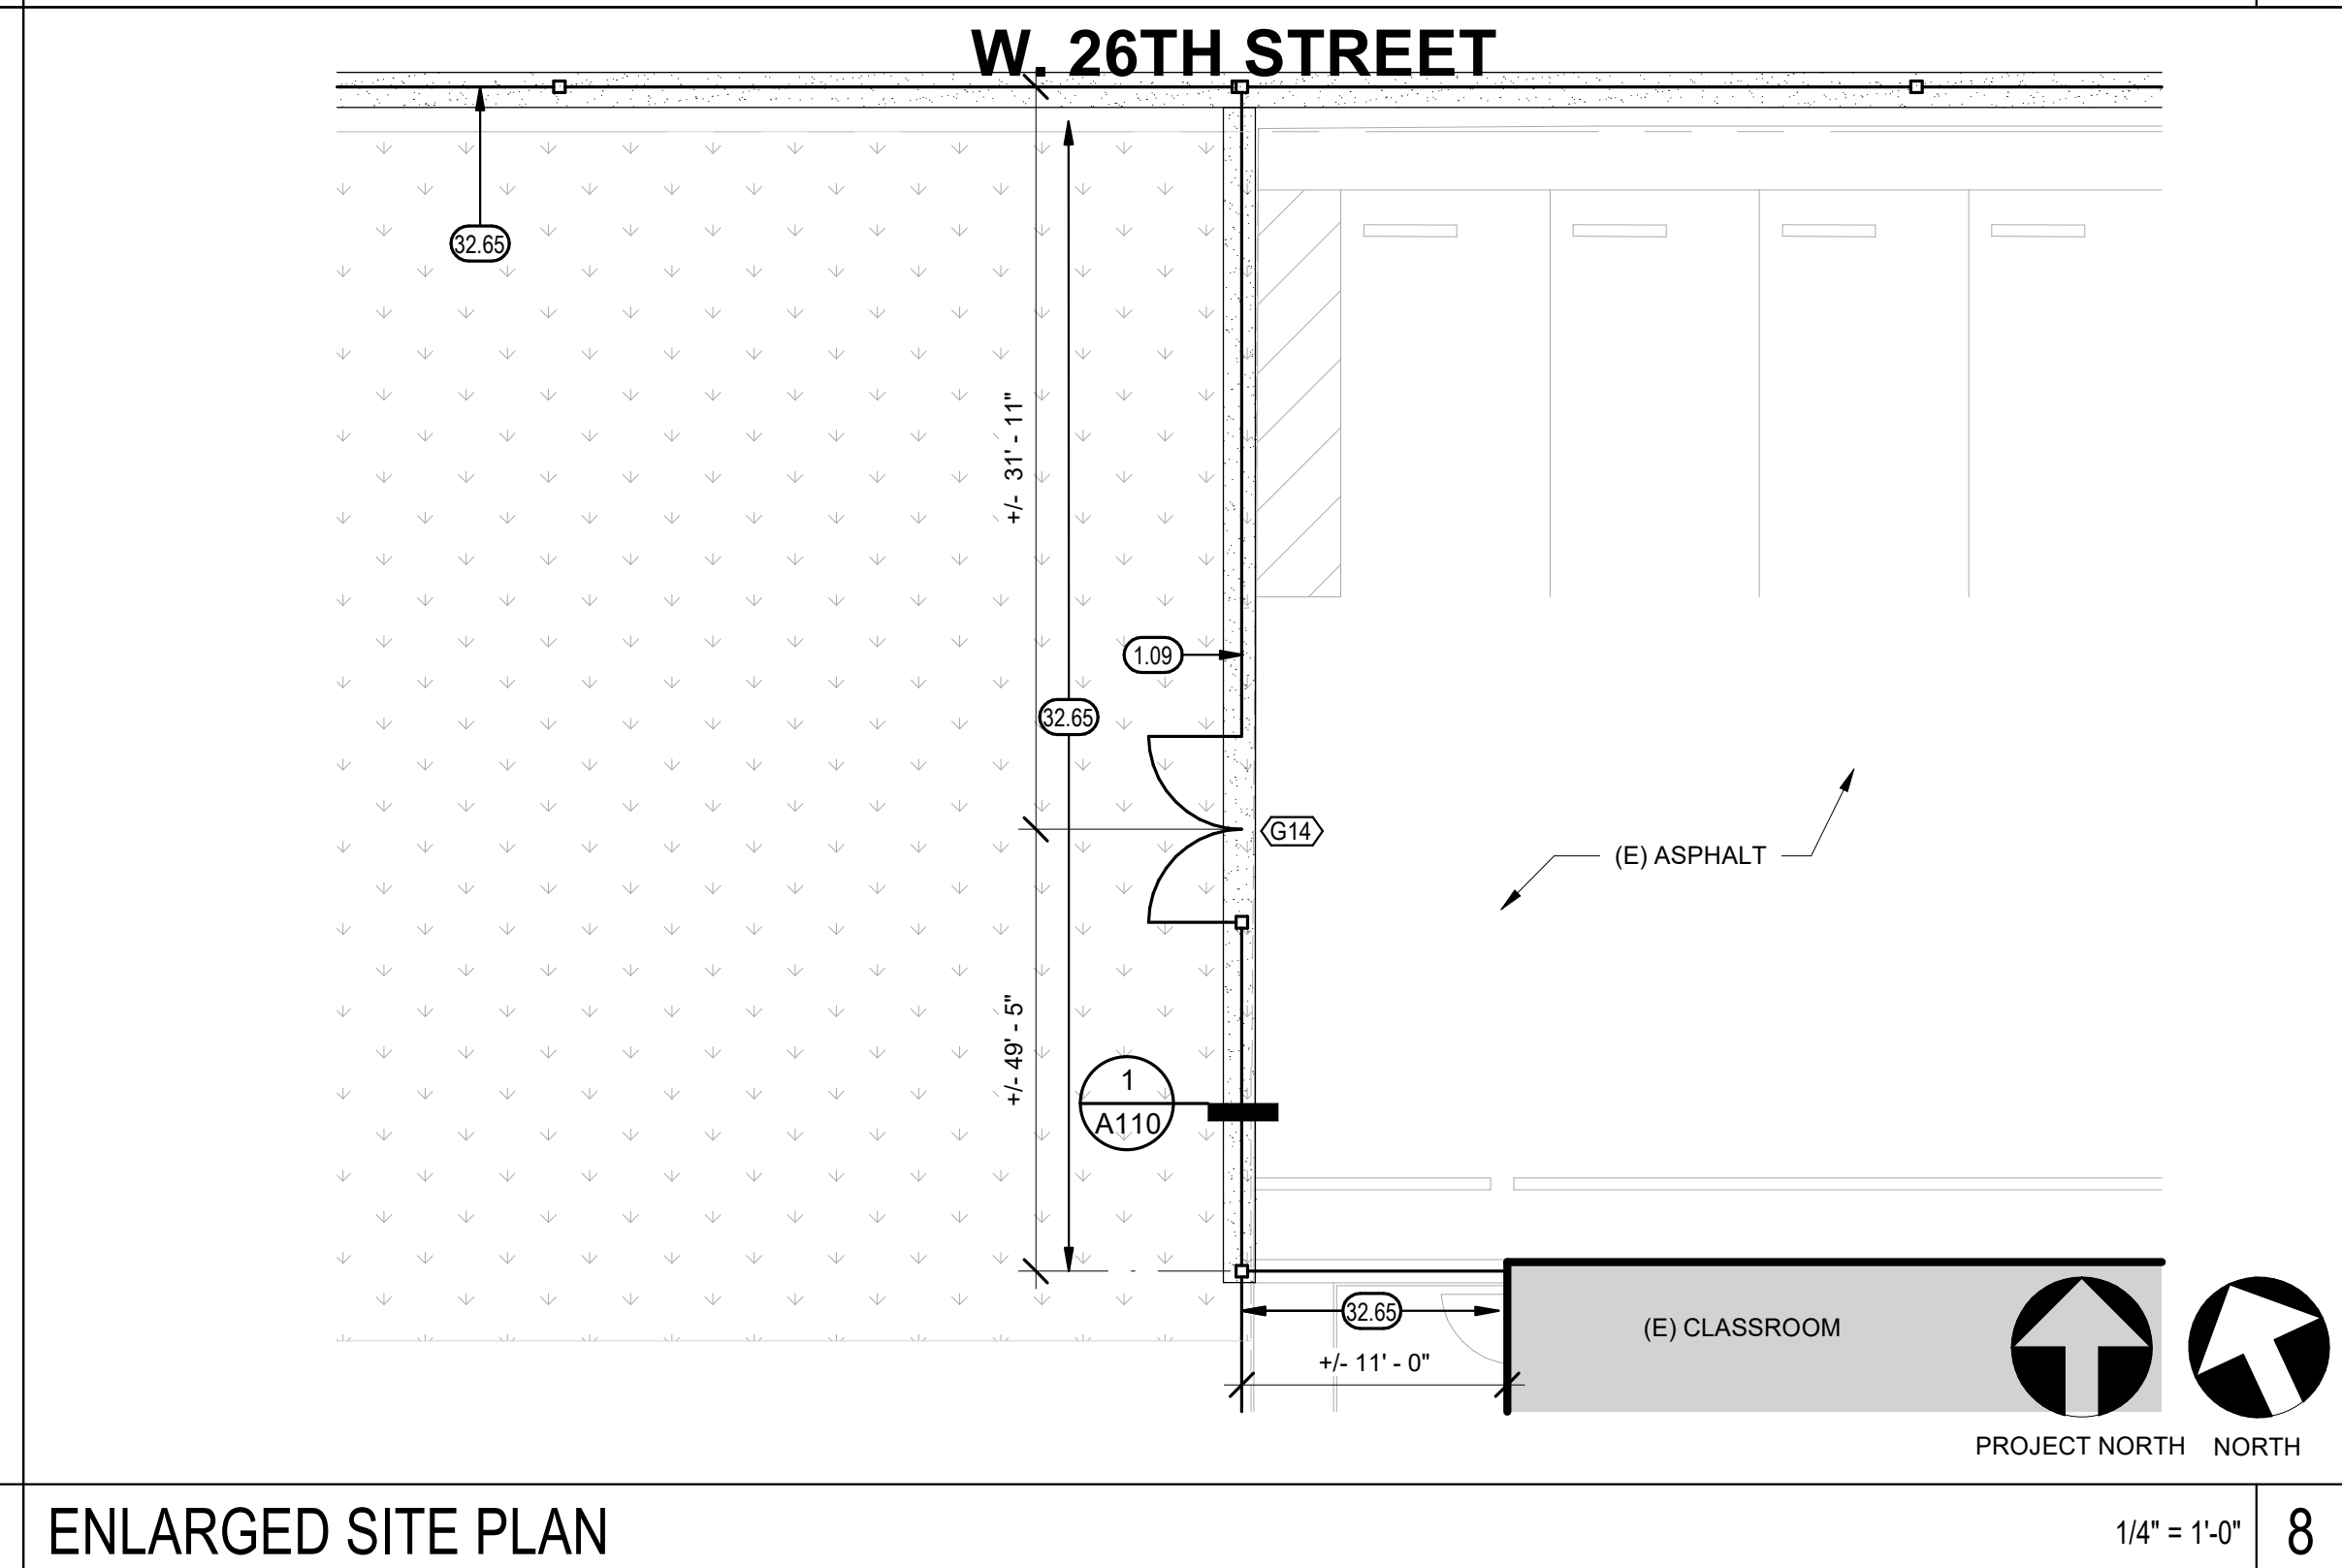

ENLARGED SITE PLAN 1/4" = 1'-0" 8

KEYNOTES

- 1.08 ALTERNATE NO. 8: REMOVE (E) CHAIN LINK FABRIC, PAINT (E) POSTS BLACK, INSTALL NEW BLACK CHAIN LINK FABRIC & HARDWARE
- 1.09 ALTERNATE NO. 9: 18" MOWSTRIP AT NEW FENCING, SEE 1/A110 FOR ADDITIONAL INFORMATION
- 2.04 EXISTING CHAIN LINK FENCE TO REMAIN
- 2.05 EXISTING CHAIN LINK GATE TO REMAIN
- 10.12 SECURITY GATE SIGNAGE, SEE 4 / A112
- 32.34 DETECTABLE WARNING SURFACE, SEE 4 / A111
- 32.61 EXISTING FENCE POSTS, RAILS & TIES TO BE PAINTED BLACK. INSTALL NEW BLACK-COATED FABRIC SYSTEM WITH BLACK PRIVACY SLATS ON EXISTING POSTS AND RAILS
- 32.64 6'-0" FT HIGH, CHAIN LINK FENCING W/ BLACK PRIVACY SLATS, SEE 12 / A110
- 32.65 6'-0" FT HIGH, BLACK DECORATIVE METAL FENCING, SEE 6 / A111
- 32.67 DECORATIVE METAL SERVICE GATE, SEE 2 / A110
- 32.68 DECORATIVE METAL PEDESTRIAN GATE, ACCESSIBLE, SEE 2 / A112

LEGEND

- (E) CHAINLINK FENCE TO REMAIN
- PROPOSED 6" DECORATIVE METAL FENCE, BLACK, SEE 6 / A111
- PROPOSED 6" CHAIN LINK FENCE W/ PRIVACY SLATS, BLACK
- GATE DESIGNATION
- (E) LANDSCAPE
- NEW CONCRETE PAVING PER SPECIFICATIONS
- ALTERNATE: NEW CONCRETE AS INDICATED
- APPROXIMATE LOCATION OF SITE CLEARING/ REMOVAL FOR NEW MOW STRIP, SEE GENERAL NOTES OF A100 FOR ADDITIONAL INFORMATION

MERCED CITY SCHOOL DISTRICT
NEW PERIMETER FENCING
JOHN MUIR ELEMENTARY
MERCED, CA

PROJECT NO.


25-13360

DRAWING

A101

DRAWING TITLE
ENLARGED SITE PLANS

TETER, INC.
FRESNO HEADQUARTERS
VISALIA | BAKERSFIELD | MODESTO | SAN LUIS OBISPO
ARCHITECTS ENGINEERS CONNECTED

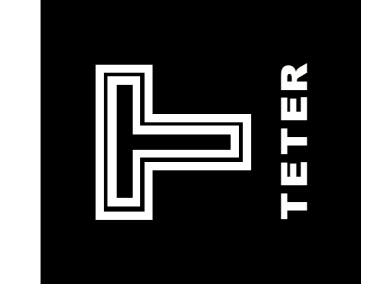



1	11/13/25	BULLETIN NO. 01	MARK	DATE	DESCRIPTION
					DSA SUBMITTAL

Teter, Inc. expressly reserves its common law copyright and other property rights in these plans. This document, the ideas and designs incorporated herein, as an instrument of professional service, is not to be used for any other project without prior written authorization.



Autodesk Docs://13360 MCSD JM ES Perimeter Fencing/13360-A-MCSD-JM ES PERIMETER FENCING.rvt

PLOT DATE: 11/13/2025 3:08:36 PM

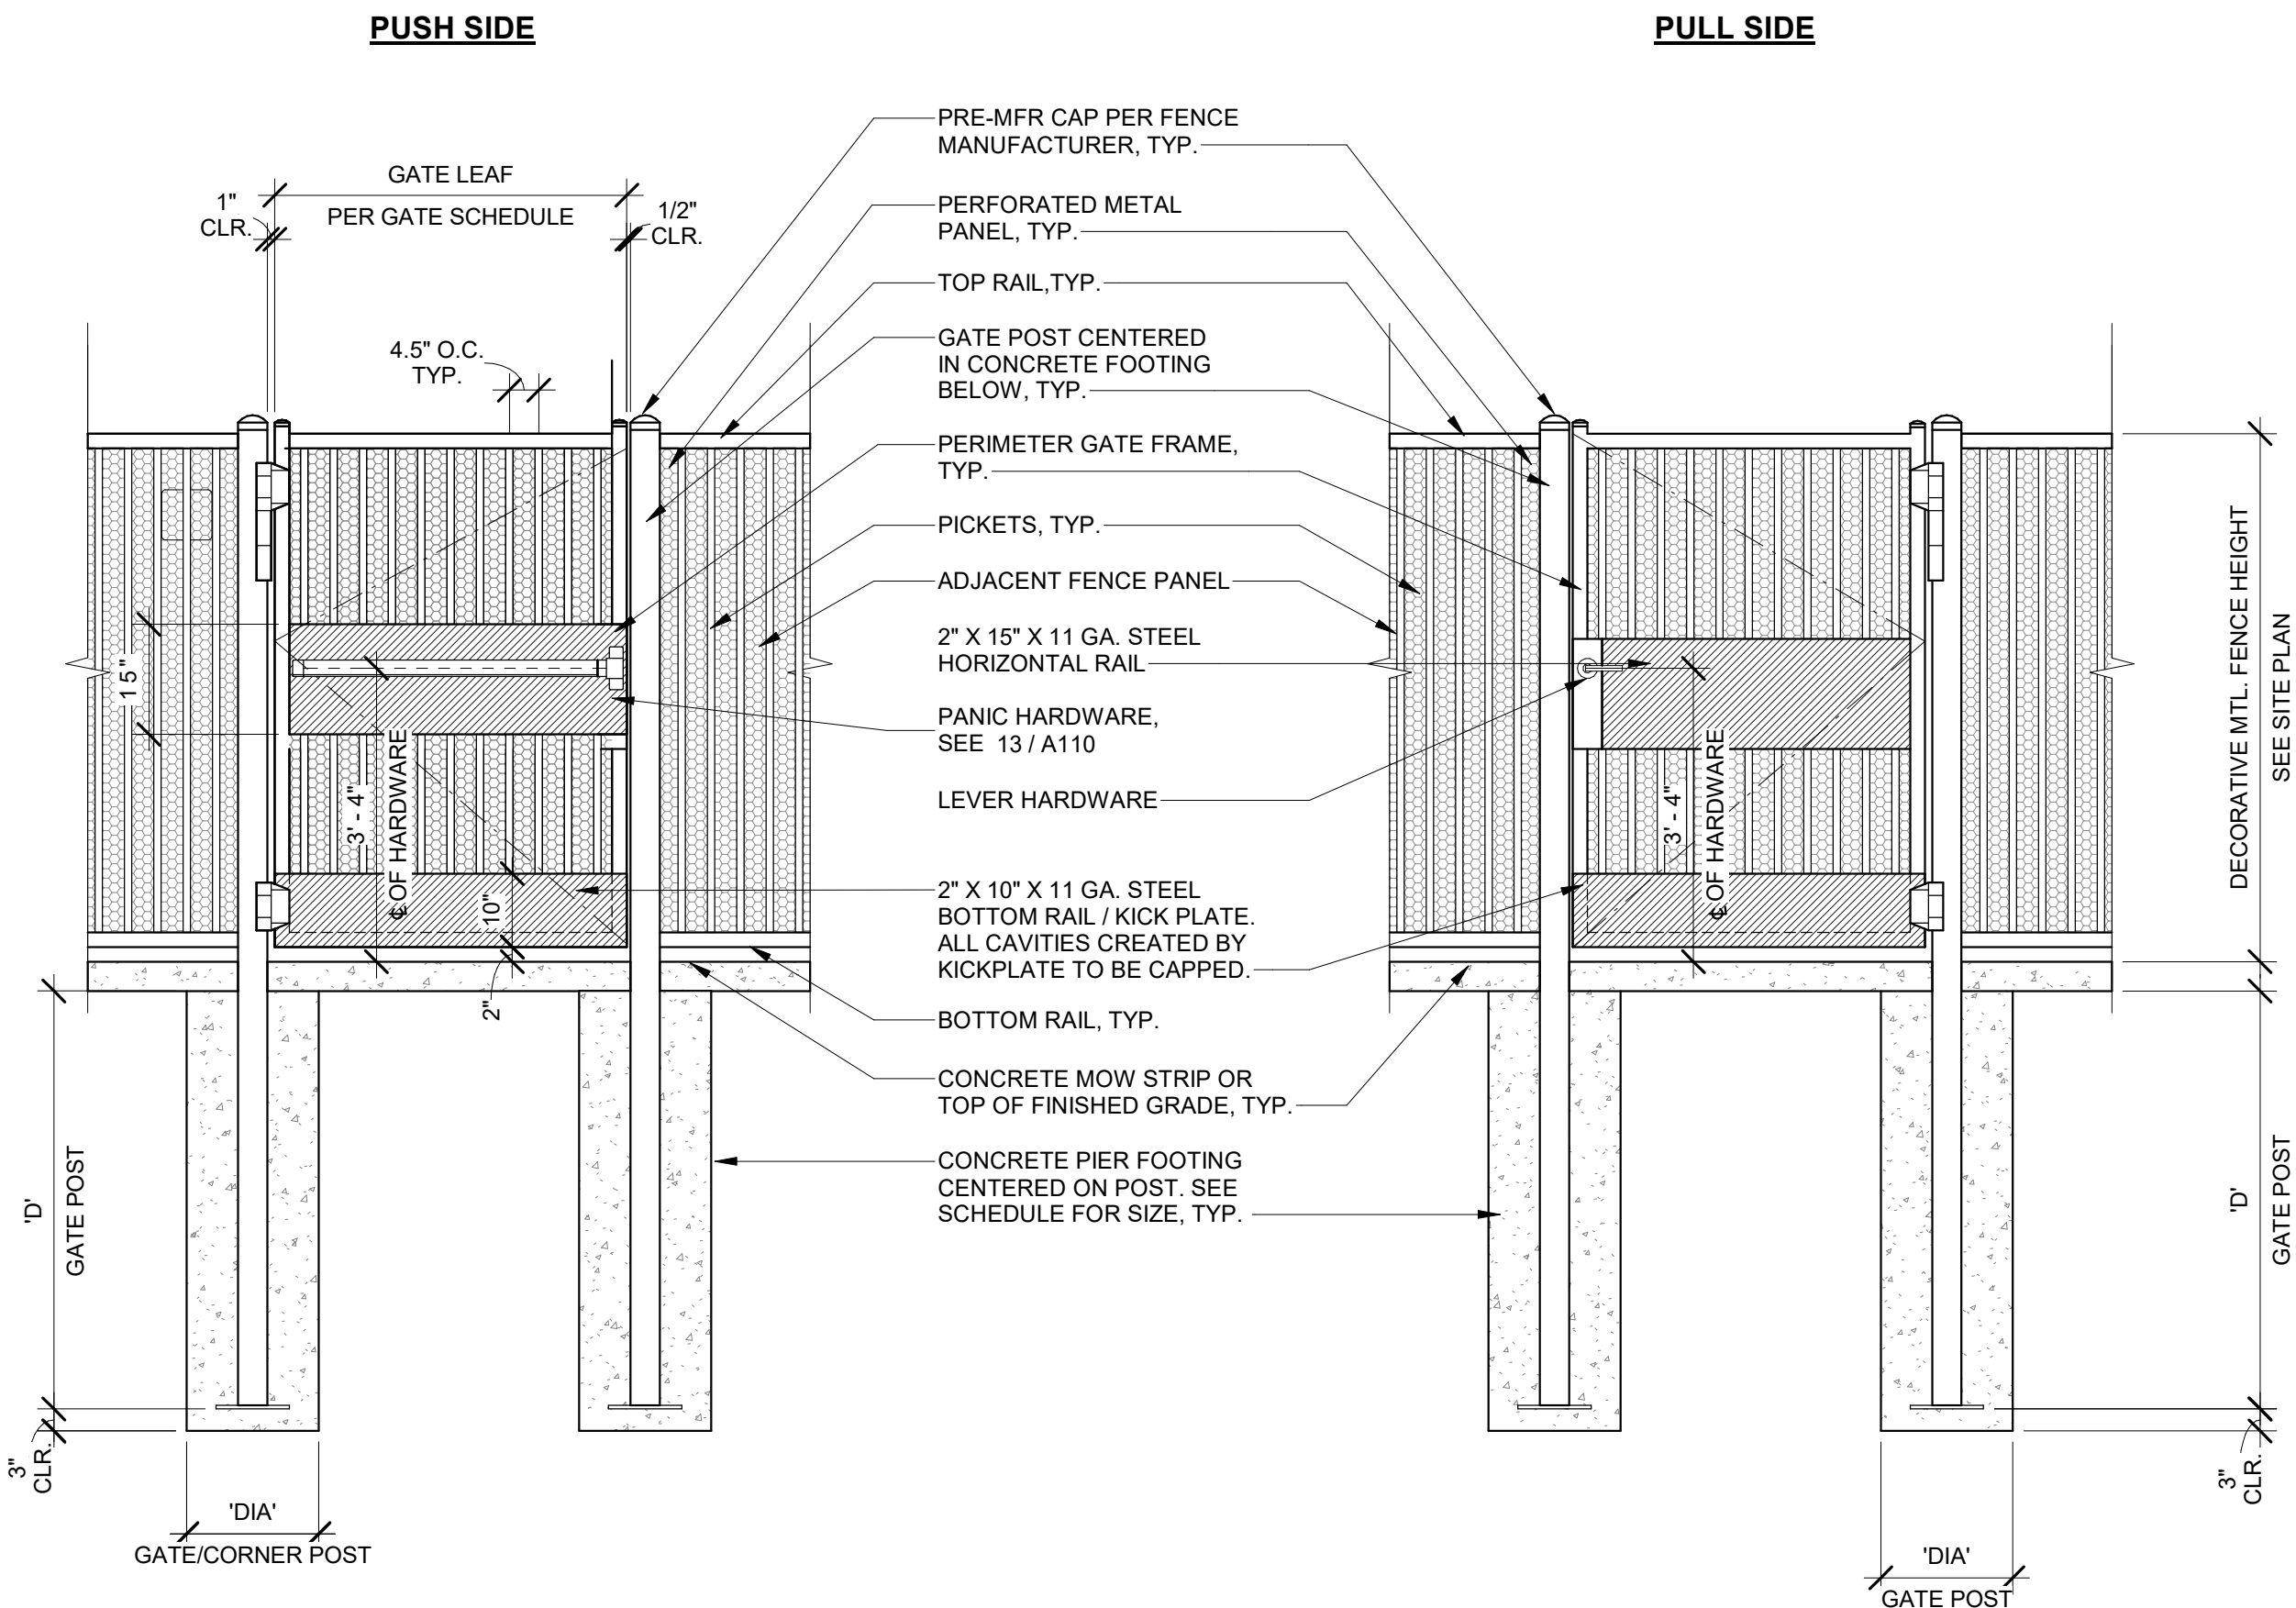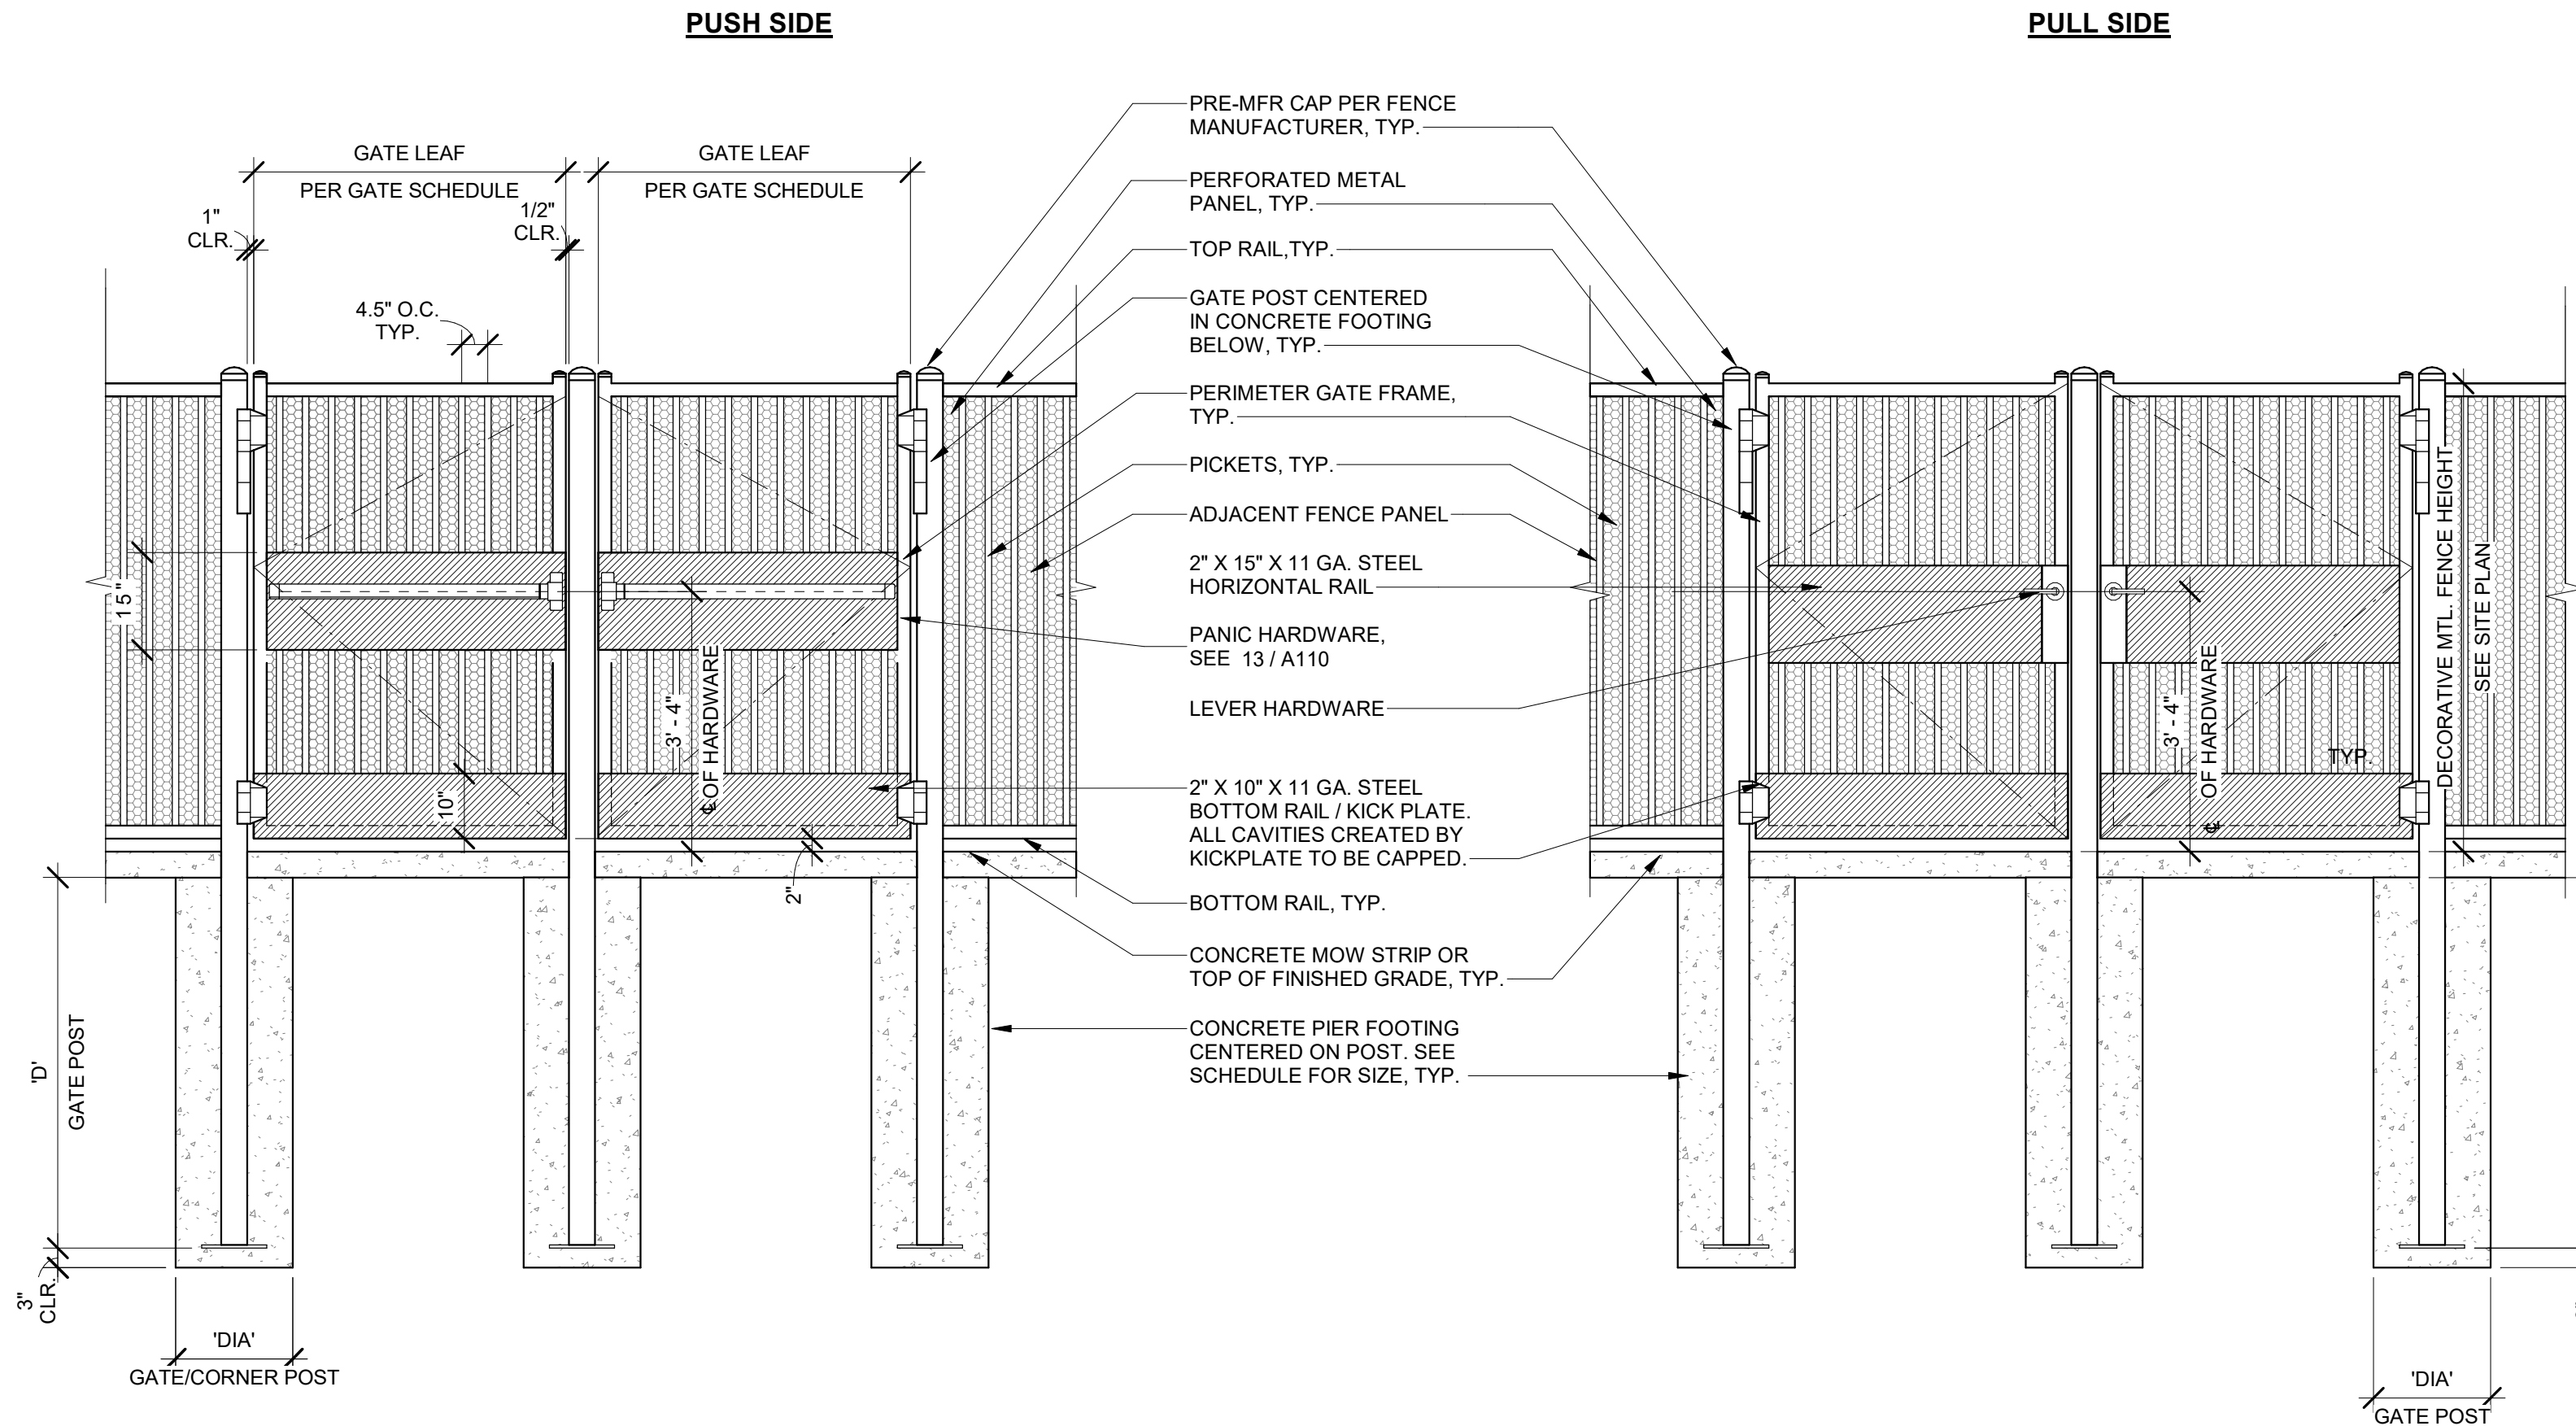


ORNAMENTAL DOUBLE SWING GATE - ACCESSIBLE

1/2" = 1'-0" 10

ORNAMENTAL SWING GATE - ACCESSIBLE

1/2" = 1'-0" 2

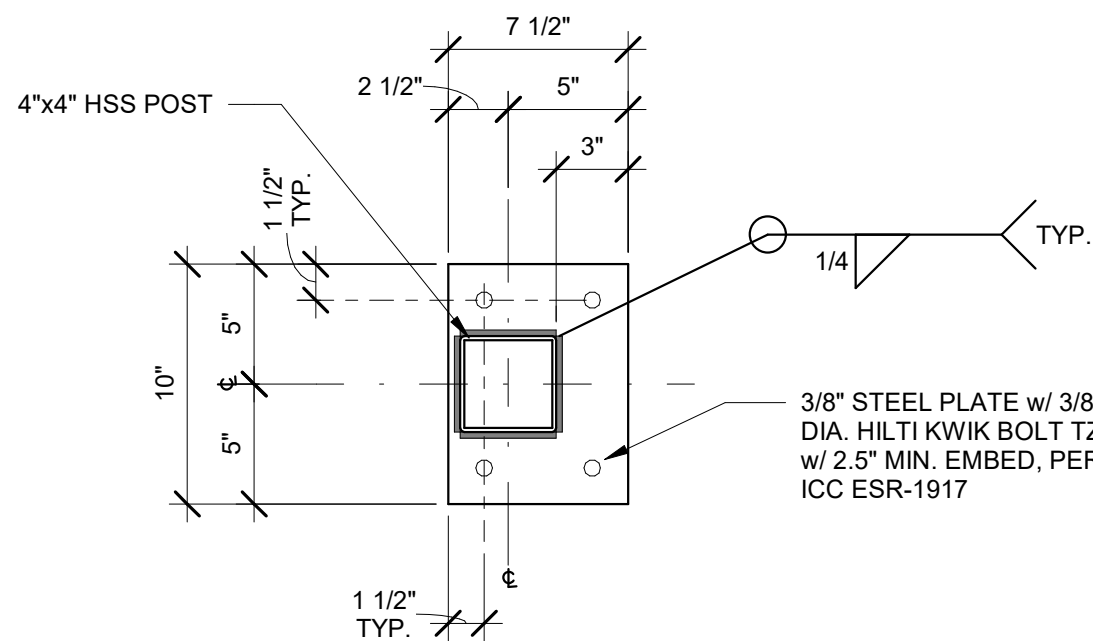


FENCE BASE PLATE

1 1/2" = 1'-0" 15

SECURITY GATE (SG)

SEE SITE PLAN FOR POSTED LOCATION

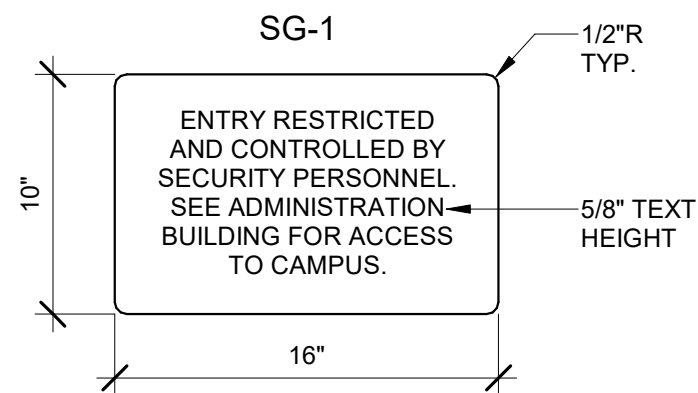

WALL MOUNTED ACCESSIBLE ACCESS SIGN (ISA)

SYMBOL SHALL COMPLY WITH CBC 11B-703.7.2.1

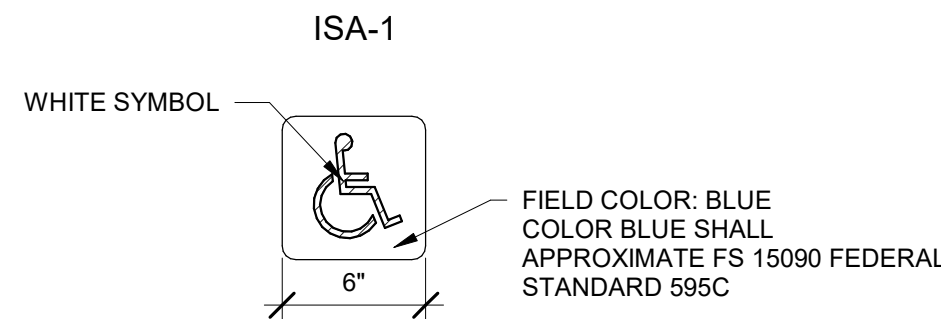


TABLE 11B-703.5.5 (VISUAL CHARACTER HEIGHT)

HEIGHT TO FINISH FLOOR OR GROUND FROM BASELINE OF CHARACTER	HORIZONTAL VIEWING DISTANCE	MINIMUM CHARACTER HEIGHT
40 INCHES TO LESS THAN OR EQUAL TO 70 INCHES	LESS THAN 72 INCHES	5/8 INCHES
	72 INCHES AND GREATER	5/8 INCHES, PLUS 1/8 INCH PER FOOT OF VIEWING DISTANCE ABOVE 72 INCHES
GREATER THAN 70 INCHES TO LESS THAN OR EQUAL TO 120 INCHES	LESS THAN 180 INCHES	2 INCHES
	180 INCHES AND GREATER	2 INCHES, PLUS 1/8 INCH PER FOOT OF VIEWING DISTANCE ABOVE 180 INCHES
GREATER THAN 120 INCHES	LESS THAN 21 FEET	3 INCHES
	21 FEET AND GREATER	3 INCHES, PLUS 1/8 INCH PER FOOT OF VIEWING DISTANCE ABOVE 21 FOOT

GENERAL NOTES:

- INFORMATIONAL SIGNAGE SHALL COMPLY WITH CBC 11B-703.5
- INFORMATIONAL SIGNS ARE NOT REQUIRED TO HAVE RAISED CHARACTERS AND ACCOMPANYING BRAILLE.
- LETTERING TO BE 3/4" HIGH MIN. U.N.O.

FINISH AND CONTRAST (CBC 11B-703.5.1): VISUAL CHARACTERS AND THEIR BACKGROUND SHALL HAVE A NON-GLARE FINISH. CHARACTERS SHALL CONTRAST WITH THEIR FIELD WITH EITHER A LIGHT PICTOGRAM ON A DARK BACKGROUND OR DARK CHARACTERS ON A LIGHT BACKGROUND.

CASE (CBC 11B-703.5.2): CHARACTERS SHALL BE UPPERCASE OR LOWERCASE OR A COMBINATION OF BOTH.

STYLE (CBC 11B-703.5.3): CHARACTERS SHALL BE CONVENTIONAL IN FORM. CHARACTERS SHALL NOT BE ITALIC, OBLIQUE, SCRIPT, HIGHLY DECORATIVE, OR OF OTHER UNUSUAL FORMS.

CHARACTER PROPORTIONS (CBC 11B-703.5.4): CHARACTERS SHALL BE SELECTED FROM FONTS WHERE THE WIDTH OF THE UPPERCASE LETTER "O" IS 60 PERCENT MINIMUM AND 110 PERCENT MAXIMUM OF THE HEIGHT OF THE UPPERCASE LETTER "I".

CHARACTER HEIGHT (CBC 11B-703.5.5): MINIMUM CHARACTER HEIGHT SHALL COMPLY WITH TABLE 11B-703.5.5. VIEWING DISTANCE SHALL BE MEASURED AS THE HORIZONTAL DISTANCE BETWEEN THE CHARACTER AND AN OBSTRUCTION PREVENTING FURTHER APPROACH TOWARDS THE SIGN. CHARACTER HEIGHT SHALL BE BASED ON THE UPPERCASE LETTER "I".

STROKE THICKNESS (CBC 11B-703.5.7): STROKE THICKNESS OF THE UPPERCASE LETTER "I" SHALL BE 10 PERCENT MINIMUM AND 20 PERCENT MAXIMUM OF THE HEIGHT OF THE CHARACTER.

CHARACTER SPACING (CBC 11B-703.5.8): CHARACTER SPACING SHALL BE MEASURED BETWEEN THE TWO CLOSEST POINTS OF ADJACENT CHARACTERS, EXCLUDING WORD SPACES. SPACING BETWEEN INDIVIDUAL CHARACTERS SHALL BE 10 PERCENT MINIMUM AND 35 PERCENT MAXIMUM OF CHARACTER HEIGHT.

LINE SPACING (CBC 11B-703.5.9): SPACING BETWEEN THE BASELINES OF SEPARATE LINES OF CHARACTERS WITHIN A MESSAGE SHALL BE 135 PERCENT MINIMUM AND 170 PERCENT MAXIMUM OF THE CHARACTER HEIGHT.

FORMAT (CBC 11B-703.5.10): TEXT SHALL BE IN A HORIZONTAL FORMAT.

PICTOGRAMS (CBC 11B-703.6): PICTOGRAMS SHALL HAVE A FIELD HEIGHT OF 6 INCHES MINIMUM. CHARACTERS AND BRAILLE SHALL NOT BE LOCATED IN THE PICTOGRAM FIELD. PICTOGRAMS AND THEIR FIELD SHALL HAVE A NON-GLARE FINISH. PICTOGRAMS SHALL CONTRAST WITH THEIR FIELD WITH EITHER A LIGHT PICTOGRAM ON A DARK FIELD OR A DARK PICTOGRAM ON A LIGHT FIELD. PICTOGRAMS SHALL HAVE TEXT DESCRIPTORS LOCATED DIRECTLY BELOW THE PICTOGRAM FIELD AND BRAILLE TRANSLATION BELOW TEXT DESCRIPTION. TEXT DESCRIPTORS SHALL COMPLY WITH CBC SECTIONS 11B-703.2, 11B-703.3, AND 11B-703.4.1.

SYMBOL OF ACCESSIBILITY (CBC 11B-703.7): SYMBOLS OF ACCESSIBILITY AND THEIR BACKGROUND SHALL HAVE A NON-GLARE FINISH. SYMBOLS OF ACCESSIBILITY SHALL CONTRAST WITH THEIR BACKGROUND WITH EITHER A LIGHT SYMBOL ON A DARK BACKGROUND OR A DARK SYMBOL ON A LIGHT BACKGROUND.

INFORMATIONAL SIGNAGE

1 1/2" = 1'-0" 4

Teter, Inc. expressly reserves its common law copyright and other property rights in these plans. This document, the ideas and designs incorporated herein, as an instrument of professional service, is not to be used for any project without prior written authorization.

1 11/13/25 BULLETIN NO. 01

MARK DATE DESCRIPTION

A 10/07/25 DSA SUBMITTAL

TETER, INC.

FRESNO HEADQUARTERS

VISALIA | BAKERSFIELD | MODESTO | SAN LUIS OBISPO

ARCHITECTS ENGINEERS CONNECTED



MERCED CITY SCHOOL DISTRICT
NEW PERIMETER FENCING
JOHN MUIR ELEMENTARY
MERCED, CA

DRAWING TITLE
SITE DETAILS

PROJECT NO.

25-13360

DRAWING

A112