December 11, 2020

# Request for Proposal WAN Fiber Maintenance TSD Bid #9912

For

Troy School District 4400 Livernois Road Troy, MI 48098

Prepared by

# Convergent Technology Partners, LLC 6197 Miller Road, Suite 4 Swartz Creek, MI 48473 810.720.3820 www.ctpartners.net

# Troy School District WAN Fiber Maintenance – Bid #9912

#### SECTION 00 01 00 - TABLE OF CONTENTS

#### SECTION TITLE

#### **DIVISION 00 - BIDDING REQUIREMENTS, BID FORMS**

SECTION 00 01 00 – TABLE OF CONTENTS SECTION 00 30 00 – INSTRUCTIONS TO BIDDERS SECTION 00 30 10 – SCHEDULE OF EVENTS SECTION 00 40 10 – BID PROPOSAL FORM SUPPLEMENTAL A – COST ANALYSIS WORKSHEET SUPPLEMENTAL B – VOLUNTARY ALTERNATES SUPPLEMENTAL C – FAMILIAL DISCLOSURE AFFIDAVIT SUPPLEMENTAL D – IRAN ECONOMIC SANCTIONS ACT AFFIDAVIT

#### **DIVISION 27 – COMMUNICATIONS TRANSMISSION AND DISTRIBUTION**

SECTION 33 82 00 - PROJECT SUMMARY SECTION 33 82 13 – OPTICAL FIBER COMMUNICATIONS

#### **RELATED DOCUMENTS**

2018 AS-BUILTS

SECTION 00 30 00 – BIDDING REQUIREMENTS – INSTRUCTION TO BIDDERS

PART 1 - GENERAL

- 1.1 REQUEST FOR PROPOSALS
  - A. Troy School District is seeking proposals in conjunction with the Federal Universal E-Rate Program for new Category 1 services including:
    - 1. Self-Provisioned Wide Area Network Fiber Maintenance
  - B. A complete list of the buildings ("Sites") are provided in Section 33 82 00 and on project drawings and are incorporated herein by reference. Bid documents may be obtained from the purchasing page (under Departments, Business Services) of the District's web site at www.troy.k12.mi.us.
- 1.2 **Due on or before the Due Date as specified in Section 00 30 10 Schedule of Events**, the Owner will receive bid proposals for the project. The Owner will not consider or accept a bid proposal received after the due date for bid proposal submission. All bid proposals received after the due date will be returned by making them available to the respective Bidder, unopened, for said Bidder to pick-up at their sole cost and expense. Bid proposals shall be submitted to:

Todd Hensley, Purchasing Supervisor C/O John Foster Convergent Technology Partners 6197 Miller Rd, Suite 4 Swartz Creek, Michigan 48473

# 1.3 PROPOSALS/QUOTES

- A. Three (3) "hard" copies and one (1) "soft" (electronic) copy on a USB "flash" drive of the proposals are to be submitted in sealed packaging, clearly marked: "Fiber Maintenance Sealed Bid" for Troy School District and shall be identified with the Bidder's name and address and the date and time of the bid proposal opening. The Owner is not responsible for any postal or delivery delays. No email, facsimile or other electronic bid proposals will be accepted.
- B. Proposals will be opened virtually using Teams Video/Audio conferencing immediately following the due date of the proposals

Microsoft Teams meeting Join on your computer or mobile app <u>Click here to join the meeting</u> Or call in (audio only) <u>(734-412-4950) 647357228#</u>

#### **BIDDING REQUIREMENTS - INSTRUCTIONS TO BIDDERS**

00 30 00 - 1

CONFIDE	ITIALITY NOTICE: This document is the intellectual property of Convergent Technology
Partners.	Any unauthorized review, use, disclosure, or distribution in whole or in part is prohibited. $\odot$
2016	

## 1.4 PROPOSAL AND PRICING FORMAT

- A. All pricing shall be based on estimated amounts that will be used to charge against as work is required.
  - 1. Pricing shall be included for an annual ride out of the network with a written summary of the findings and recommendations.
  - 2. Pricing shall be provided for any single unit items such as Emergency Call Out and Trip Charges. An annual estimate of the number of these items shall be included in the pricing total.
  - 3. Labor estimate to be used is 100 hours annually. The bidder shall provide the hourly rates for each labor type and an estimated number of hours with each type totaling 100 hours.
  - 4. Material shall be estimated based on the size of the network and any anticipated or historical figures. This would include any cable, strand, mounting hardware and consumables required for maintenance of the network.
  - 5. A final estimate based on all of the above items is required and will be listed in the Bid Proposal Form.
  - 6. Pricing is for a three (3) year contract term. Contract term is from July 1, 2021 through June 30, 2024.
- B. The Bid pricing shall be submitted on the Bid Proposal Form and the pricing sheets Supplementals A & B
- C. Bids shall follow the following format:
  - 1. Description of the Firm and all contact information
  - 2. Bid Proposal Form and all Supplementals
  - 3. References
- D. The "hard copy" Bids shall be submitted on 8 1/2" by 11" paper, single sided, single spaced using 10 to 12-point print, in 3 ring binders, clearly labeled to show the Bidder's name.
- E. The "soft copy" Bid shall be in the same structure as the "hard copy" Bids, bound in a .pdf file, submitted on an USB "flash", "Thumb" or similar drive with the hard copies.
- 1.5 SECURITY
  - A. No bid security is required for this RFP.

#### **BIDDING REQUIREMENTS - INSTRUCTIONS TO BIDDERS**

# 1.6 FAMILIAL DISCLOSURE AFFIDAVIT

A. Each bid proposal must be accompanied by a sworn and notarized statement disclosing any familial relationship that exists between the owner or any employee of the Bidder and any member of the Board of Education or the Superintendent of Troy School District. The Board of Education will not accept a bid proposal that does not include this sworn and notarized disclosure statement.

#### 1.7 AFFIDAVIT OF COMPLIANCE – IRAN ECONOMIC SANCTIONS

A. Each bid proposal must be accompanied by the Iran Economic Sanctions Affidavit of Compliance in compliance with Michigan Public Act No. 517 of 2012. The Board of Education will not accept a bid proposal that does not include this sworn and notarized disclosure statement.

#### 1.8 RESERVATION OF RIGHTS

A. The Owner reserves the right, in its sole and absolute discretion (for this provision and all other provisions contained in this RFP), to accept or reject, in whole or in part, any or all bid proposal with or without cause, to waive any irregularities or informalities in this RFP process or any bid proposal, and to award the contract to other than the low bidder, when in the opinion of the Owner, such action will best serve the Owner's interests.

#### 1.9 WITHDRAWAL OF BID PROPOSALS/QUOTES

A. All bid proposals submitted shall not be withdrawn and shall be irrevocable for a minimum period of ninety (90) calendar days following the due date for receipt of bid proposals set forth above.

#### 1.10 REQUESTS FOR CLARIFICATION

1.11 Bidders may request that the School District clarify information contained in this RFP. All such requests must be made in writing via email to John Foster, Convergent Technology Partners, at <u>ifoster@ctpartners.net</u>. Requests for Clarifications and inquiries may only be made via email. The deadline for all Requests for Clarification is per the schedule of events. The aggregated answers to all Requests for Clarification will be provided in an addendum to the RFP which will be issued and posted by 12:00 PM (local time) **December 21, 2017** on the Purchasing page of the District website at <u>www.troy.k12.mi.us</u> for all potential proposers to view.

# 1.12 RESTRICTION ON COMMUNICATION

A. From the issue date of this RFP until a Contractor is selected and the contract is awarded a prospective Contractor shall not communicate about the subject of this RFP or a Contractor's bid proposal with the Owner, its Board of Education, or any individual member, administrators, faculty, staff, students, or employees, except for additional requests for clarification in accordance with the paragraph above.

#### 1.13 RELEASE OF CLAIMS

A. Each Bidder by submitting its Proposal releases the Owner from any and all claims arising out of, and related to, this RFP process and selection of a Contractor.

## 1.14 PROPOSAL COST

A. Respondents of this RFP are responsible for any and all costs incurred by them or others acting on their behalf in preparing or submitting a bid proposal, or otherwise responding to this RFP, or any negotiations incidental to its bid proposal or this RFP.

# 1.15 COLLUSIVE BIDDING

A. All Bidders certify that its bid proposal is made without any previous understanding, agreement or connection with any person, firm or corporation making a bid proposal for the same project and is in all respects fair, without outside control, collusion, fraud or otherwise illegal action.

#### 1.16 DEFINITIONS

- A. Bid Documents are defined as the Instructions to Bidders, Schedule of Events, this RFP, including all Supplemental forms, Attachments, Appendices, Specifications, Drawings and Addenda and the Contract.
- B. Addenda are written or graphic instruments issued prior to the due date of bid proposals which modify or interpret the Bid Documents by additions, deletions, clarifications or corrections. All Addenda issued to Bidders prior to the due date of bid proposals shall become part of the Bid Documents and all bid proposals are to include the Project/Work therein described. Each Bid Proposal submitted shall list all Addenda that have been received prior to the due date of bid proposals.
- C. As used in these Instructions to Bidders, the term "Bid Proposal" means a bid proposal prepared and submitted in response to this RFP.
- D. As used in these Instructions to Bidders, the term "PSC" refers to the Professional Service Contractor and means Convergent Technology Partners and its assigned representative.
- E. Throughout this RFP and Contract, the "Owner" or "District" will be used to refer to District and bidders submitting bid proposals will be referred to as "Bidders" or "Vendors" and a successful Bidder or Vendor will be referred to as a "Contractor".

#### 1.17 BIDDER'S REPRESENTATION

A. Each Bidder, by submitting a Bid Proposal, represents that the Bidder has read and understands the Bid Documents and is familiar with the local conditions under which the project is to be performed. Bidders will be held to have compared the Sites with Bid Documents and have satisfied themselves to all conditions affecting the execution of the Work/Project.

# 1.18 EXAMINATION OF BID DOCUMENTS

- A. Before submitting a Bid Proposal, each Bidder shall examine the RFP documents carefully and shall read the Specifications and the Bid Documents. Each Bidder shall gather complete information prior to bidding as to existing conditions and limitations under which the Work/Project is to be performed, and shall include in its Bid Proposal a sum to cover the cost of items necessary to perform the Work/Project as set forth in the Bid Documents.
- B. No allowance or additional fees will be made to a Bidder because of lack of such examination or knowledge. The submission of a Bid Proposal will be considered as conclusive evidence that the Bidder has made such examination. An on-site-inspection of the Sites during the Bidder's Conference will be for all Bidders and their subcontractors, if any. Vendors may use subcontractors in connection with the Work/Project performed under this RFP provided the Owner has approved the subcontractors. In using subcontractors, the Vendor agrees to be responsible for all their acts and omissions to the same extent as if the subcontractors were employees of the Vendor.

# 1.19 SUBSTITUTIONS

- A. Each Bid Proposal shall be based upon the labor, materials and equipment described in the Bid Documents.
- B. In addition to the Base Bid, the submission of voluntary alternates for a fixed annual fee for maintenance of the Fiber WAN is acceptable. The Owner reserves the right to unilaterally accept or reject, in whole or in part, any voluntary alternates.

# 1.20 BIDDING PROCEDURES

- A. All Bids Proposal must be submitted on the Bid Proposal Forms provided as part of the Bid Documents and in accordance with the Advertisement to Bid and Instructions to Bidders. Bidders must provide a complete list of proposed subcontractors (one per discipline) as indicated on the Bid Forms. Listing two or more subcontractors per discipline will be grounds for disqualification.
- B. All Bidders must provide a proposal for the Base Bid that meets or exceeds the specifications set forth in this RFP. However, all Bidders may suggest Alternates if it is felt that the alternate proposal better suits the intent of this RFP. Any Alternate must be listed as such with separate pricing sheets. Any variance of the feature/functionality of the Base Bid must be identified in any Alternates proposed.
- C. Prior to the due date for bid proposals, any Addenda will be available for inspection wherever the Bid Documents are kept available for that purpose. No Addendum will be issued later than December 21, 2017. It is each Bidders responsibility to ascertain prior to submitting a Bid Proposal that he/she has received all Addenda issued and shall acknowledge their receipt in their Bid Proposal Form.

- D. All Bids must be signed as follows:
  - 1. Corporations: Signature of an officer of the firm who is authorized to bind the corporation.
  - 2. Partnerships: Signature of one partner who is authorized to bind the firm and all of its Partners.
  - 3. Bids submitted by Joint Ventures shall be signed by one of the Joint Ventures and shall be accompanied by a certified copy of the Power of Attorney authorizing the individual signing to bind all the Joint Ventures. If a certified copy of the Joint Venture's certificate submitted with the Bid Proposal indicates that all Joint Ventures have signed, no authorization is required.
  - 4. Individuals signing on own behalf: No authorization is required.
  - 5. Individual signing on behalf of another: Power of Attorney or comparable evidence of authority shall accompany Bid.
- E. Bid proposals shall be prepared on unaltered Bid Forms, which are a part of this RFP. Bidders shall make no additional stipulations on the Bid Form nor qualify the Bid Proposal in any other manner. Unauthorized conditions, limitations, or provisions attached to the Bid Proposal will be cause for rejection of the Bid Proposal. If alterations by erasure or interlineations are made for any reason, explain over such erasure or interlineations with a signed statement from the Bidder. No additional charges, other than those listed on the Bid Proposal Form and Bid Supplemental Forms, shall be made. Prices quoted will include verification/coordination of order, all costs for shipping, delivery to all Sites, insurance, payment and performance bonds, unpacking, setup, installation, operation, testing, cleanup, training and all other requirements contained in the bid documents.
- F. Bids shall be submitted in a sealed envelope. Identified on the face of the envelope:
  - 1. Project name
  - 2. Name and address of Bidder
  - 3. Notation "Fiber Maintenance Sealed Bid"
- G. No responsibility shall attach to the PSC, the Owner, or the authorized representatives of either one, for the premature opening of any Bid Proposal which is not properly addressed, delivered and/or identified. In such event, that Bid Proposal will not be considered and the Bidder will be automatically disqualified from consideration.
- H. Negligence in preparation, improper preparation, errors in and/or omissions in the Bid Proposal shall not relieve the Bidder from fulfillment of any and all applicable obligations and requirements of contained in the Bid Documents.

# Self-Provisioned Fiber Maintenance - Bid # 9912

- I. The Owner or PSC in making copies available of the Bid Documents to Bidders do so only for the purpose of obtaining bid proposals on the project and do not confer a license or grant of use to a Bidder for any other purpose.
- J. All Bidders must complete, sign and return the attached "FAMILIAL DISCLOSURE" and "IRAN ECONOMIC SANCTIONS AFFIDAVITS" with their Bid Proposal.
- K. The Owner considers this RFP legally binding and will require that this Request for Proposal and the Bid Proposal be incorporated by reference into any subsequent Contract between the Contractor and the Owner. It should be understood by the Bidder that this means that the Owner expects the Bidder to satisfy all of the requirements and specifications contained in the RFP. Any exceptions to the RFP must be explicitly noted in the Bid Proposal. Lack of listing all exceptions will be considered acceptance of all of the specifications as presented in this RFP

# 1.21 CONSIDERATION OF BIDS

- A. The Bidder acknowledges the right of the Owner to accept or reject any or all Bid proposals, in whole or in part, with or without cause, to waive any irregularities or informalities in this RFP process or any Bid Proposal, and to award the contract to other than the low bidder. In addition, the Bidder recognizes the right of the Owner to reject a Bid Proposal:
  - 1. If the Bidder fails to furnish any data required by the Bid Documents; or
  - 2. If the Bid Proposal is in any way incomplete or irregular; or
  - 3. If the Bidder's performance was unsatisfactory under a prior contract for the construction, repair, modification, or demolition of a facility with the Owner, or a contractor in privacy of contract with the Owner, which was funded, directly or indirectly, by the Owner;
  - 4. If the Bidder was an employer of construction mechanics working on the construction of facilities funded, directly or indirectly, by the Owner through contracts under 1984 PA 431, MCL 18.1101 et seq; MSA 3.516 (101) et seq, and was determined by the Michigan Department of Labor to have failed to comply with a contractual provision requiring the payment of Department of Labor's prevailing wage or the maintenance of Department of Labor's apprentice-journeyperson ratio determinations for construction mechanics for that facility.
- B. The Owner shall have the right to accept alternates in any order or combination and to determine the lowest responsible Bidder on the basis of the sum of the base bid and the alternates accepted.
- C. Once the contract is awarded to the Contractor, the contract is contingent upon Troy School District Board of Education approval and the Contractor providing the Owner with any and all documents required by the RFP prior to commencement of the Work/Project (i.e. Insurance Certificates, Labor and Material Payment Bond and Performance Bond, etc.). Further, the

## Self-Provisioned Fiber Maintenance - Bid # 9912

Owner reserves the unrestricted right to reduce the contract amount by reducing the scope of Work/project and/or components. Any such action will be taken before specific work on a building or on a project component has commenced. Contract amount shall be reduced or increased based on the unit pricing values.

D. Bidders to whom an award of a contract is under consideration shall submit to the Owner upon his/her request a properly executed Contractor's Qualification Statement, AIA Document A305 or other information format specified by the Owner.

# 1.22 BID SECURITY

- A. No bid security is required for this RFP.
- B. The Owner reserves the right to retain the Bid security of all Bidders until the Contractor enters into the contract or until ninety (90) days after bid opening, whichever is later. If the Contractor refuses to enter into the Contract, the Owner may retain their Bid Security as liquidated damages but not as a penalty.
- 1.23 PERFORMANCE AND LABOR AND MATERIAL PAYMENT BONDS
  - A. No Performance, Labor or Material Payment bonds are required for this project.

# 1.24 TAXES

A. Installation services for the tangible personal property purchased by the Owner is not subject to sales taxation. Moreover, the Owner is exempt from taxation on all tangible personal property purchased by the Owner for its use and consumption; however, this exemption would not apply to any materials required under the Bid Documents that are deemed to be a component of a construction/improvement project to the Owner's Sites/Facilities. All prices submitted on the Bid Proposal Form shall be inclusive of any and all applicable taxes.

# 1.25 PERMITS AND FEES

A. All prices submitted on the Bid Proposal Form shall be inclusive of any and all applicable/required permits and fees.

# 1.26 MICHIGAN RIGHT-TO-KNOW LAW

- A. All Contractors must conform to the provisions of the Michigan Right-To-Know Law, 1986 PA 80, which requires employers to:
  - 1. Develop a communication program designed to safeguard the handling of hazardous chemicals through labeling of chemical containers, and development and availability of Material Safety Data Sheets.
  - 2. Provide training for employees who work with these chemicals; and

# **BIDDING REQUIREMENTS - INSTRUCTIONS TO BIDDERS**

# Self-Provisioned Fiber Maintenance - Bid # 9912

- 3. Develop a written hazard communications program.
- B. The law also provides for specific employee rights. These include:
  - 1. The right to be notified (by employer or Contractor posting) of the location of Material Safety Data Sheet (MSDS);
  - 2. The right to be notified (by employer or Contractor posting) of new or revised MSDS no later than five working days after receipt; and
  - 3. The right to request copies of MSDS from their employers or Contractors.
- C. Provisions of Michigan's Right-to-Know Law may be found in those sections of the Michigan Occupational Safety and Health Act (MIOSHA), which contain Right-to-Know provisions, and the Federal Hazard Community Standard, which is part of the MIOSHA Right-to-Know Law through adoption.

# 1.27 WITHDRAWAL OF BIDS

- A. A Bidder may withdraw its Bid Proposal by written request from an authorized Bidder representative, at any time prior to the due date of bid proposals.
- B. No Bidder may withdraw a Bid Proposal for a period of ninety (90) calendar days, following the due date for receipt of bid proposals, and all bid proposals shall be subject to acceptance by the Owner during this ninety (90) day period.

# 1.28 EXECUTION OF CONTRACT

- A. The Contractor to whom the contract is awarded shall, within ten (10) calendar days after Notice of Award and receipt of the contract from the Owner, execute and deliver required copies to the Owner.
- B. At or prior to delivery of the executed Contract, the Contractor to whom the contract is awarded shall deliver to the Owner those Certificates of Insurance required by the Bid Documents and such Labor and Materials Payment Bonds and Performance Bond as are required by Owner and any other documents required by this RFP.
- C. The Owner shall approve the provided Certificates of Insurance before the Contractor may proceed with the Work/Project. Failure or refusal to provide Certificates of Insurance or any other documents required by this RFP in a form(s) satisfactory to the Owner shall subject the Contractor to loss of time from the allowable construction period equal to the time of delay in furnishing the required material.

# 1.29 POST BID INFORMATION

A. Bid Form(s) shall be submitted as indicated in the Bid Documents. The Bid Form(s) requires all proposed subcontractors for the project to be named; no more than one per discipline.

# **BIDDING REQUIREMENTS - INSTRUCTIONS TO BIDDERS**

00 30 00 - 9

#### 1.30 EQUAL OPPORTUNITY

A. The Contractor and all of its subcontractors shall not discriminate against any employee or applicant for employment because of race, religion, color, sex or national origin.

# PART 2 - EXECUTION

# 2.1 SITE REQUIREMENTS

- A. The Owner Sites are both instructional and administrative facilities that provide year-round services to their students, staff and the community. As such, activities in all buildings are critical to the provisioning of services to the students, staff and the community and shall not be interrupted by the Contractor's Work activities.
- B. The computer and telephone systems associated with this Work will not be taken off-line or removed from service during normal working hours without coordination of the Owner's IT department and the staff of affected buildings. Arrangements must be made by the Contractor to coordinate any such activities.
- C. The Contractor will be required to work around all of the conditions listed above, as well as working with the Owner's staff to minimize disruptions to normal Owner activities.
- D. Installation Guidelines
  - All Work performed on this Project will be installed in accordance with the current edition of the National Electrical Code<sup>®</sup>, the current edition of the National Electrical Safety Code<sup>®</sup>, the current edition of the BICSI Telecommunications Distribution Methods Manual, the current edition of the BICSI Cabling Installation Manual, the latest issue of the ANSI/TIA/EIA Standards as published by Global Engineering Documents as TIA/EIA Commercial Building Telecommunications Standard, and all local codes and ordinances.

# 2.2 QUALITY ASSURANCE

- A. Compliance with Laws and Regulations
  - 1. The Contractor performance of the Work shall comply with all applicable federal, state, and local laws, rules, and regulations and Owner policies, procedure, rules and regulations. The Contractor shall give required notices, shall procure necessary governmental licenses and inspections, and shall pay without burden to the Owner, all fees and charges in connection therewith unless specifically provided otherwise. In the event of violation, the Contractor shall pay all fines and penalties; including attorney's fees and other defense costs and expenses in connection therewith.
- B. Federal Communications Commission
  - 1. Equipment requiring FCC registration or approval shall have received such approval and shall be appropriately identified.

#### **BIDDING REQUIREMENTS - INSTRUCTIONS TO BIDDERS**

00 30 00 - 10

- C. Codes, Standards, and Ordinances
  - 1. All Work shall conform to the latest edition of the National Electrical Code<sup>®</sup>, the Building Code, and all local codes and ordinances, as applicable. ANSI/TIA/EIA shall be adhered to during all installation activities. Methodologies outlined in the latest edition of the BICSI Telecommunications Distribution Methods Manual shall also be used during all installation activities. Should conflicts exist with the foregoing, the authority having jurisdiction for enforcement will have responsibility for making interpretation. The Contractor is wholly responsible to meet or exceed all codes, standards, regulation, manufacturer installation standards and industry best practices.

# 2.3 SAFETY

A. The Contractor shall take the necessary precautions and bear the sole responsibility for the safety of the methods employed in performing the Work. The Contractor shall at all times comply with the regulations set forth by federal, state, and local laws, rules, and regulations concerning "OSHA" and all applicable state labor laws, regulations, and standards. The Contractor shall indemnify and hold harmless the Owner from and against all liabilities, suits, damages, costs, and expenses (including attorney's fees and court costs) that may be imposed on the Owner because of the Contractor, or its subcontractor, or supplier's failure to comply with the regulations stated herein.

#### 2.4 INSPECTION, ACCEPTANCE, AND TITLE

- A. Inspection and Acceptance will be upon successful installation unless otherwise provided. Title to/or risk of loss or damage to all items shall be the responsibility of the Contractor until acceptance by the Owner, unless loss or damage results from negligence by the Owner. If the materials or services supplied to the Owner are found to be defective or do not conform to the specifications, the Owner reserves the right to cancel the Contract upon written notice to and return products at the Contractor's expense, based upon the terms of the Contract.
  - 1. When the Owner is referred to in this section of the RFP relative to inspections, the Owner has designated the PSC as the party to perform such inspections on behalf of the Owner. Notwithstanding the above, the Owner may also perform such inspections along with the PSC.
- B. The Owner shall at all times have access to the Work wherever it is in preparation or progress, and shall provide proper facilities for such access and for inspection.
- C. The Contractor shall not close up any Work until the Owner has inspected the Work. Should the Contractor close up the work prior to inspection by The Owner, the Contractor shall uncover the Work for inspection by the Owner at no cost to the Owner, and then recover the Work according to the specifications contained herein. The Contractor shall notify the Owner in writing when the Work is ready for inspection. The Owner will inspect the Work as expeditiously as possible after receipt of notification from the Contractor.

END OF SECTION

#### **BIDDING REQUIREMENTS - INSTRUCTIONS TO BIDDERS**

00 30 00 - 12

# Troy School District WAN Fiber Maintenance - Bid # 9912

# SECTION 00 30 10 - SCHEDULE OF EVENTS

The following is a projected schedule of events for this project. The schedule may change depending upon the results of the responses.

EVENT	DATE
Bid Release	December 11, 2020
Final Date and time for Questions – 5:00 PM	December 18, 2020
Final Addendum – 12:00 PM	December 21, 2020
Bid Due Date/time and Virtual Opening - 2:30 PM	January 12, 2021
Contract Award	February 23, 2021
Earliest Project Start Date	July 1, 2021

End of Section

#### SCHEDULE OF EVENTS

00 30 10 - 1 of 1

SECTION 00 40 10 - BID PROPOSAL FORM

OWNER:	Troy School District 4400 Livernois Road Troy, Michigan 48083
PROJECT:	Self-Provisioned Fiber Maintenance – Bid #9912
NAME OF BIDD	ER:
BASE BID:	

Lump sum bid for all work specified and shown on the drawings as indicated for base bid in the amount of:

\_ Dollars (\$\_\_\_\_\_\_)

The Bid Proposal amount shall be shown in both words and figures. In the case of discrepancy, the amount shown is words shall govern.

**BASE BID:** The undersigned, having examined the Bid Documents and examined the conditions affecting the Work/Project, hereby proposes and agrees to furnish all of the labor, materials, and equipment and perform all work necessary to complete the Work/Project as required by the Bid Documents for the stipulated sum identified above and detailed in Supplemental A (Cost Analysis Worksheet). The Bid Documents set forth the terms and conditions upon which the Bidder will provide a "turnkey" solution for the installation and operation of the project for use by the Owner and represents and warrants that the design, operation and functionality of the project are in accordance with the Bid Documents. All prices provided by the Bidder on this Bid Proposal Form must include all cables, connectors, equipment etc. that are necessary to the make the project fully operational for the intent and purpose stated in the Bid Documents

# **BID SECURITY**

Enclosed herewith find (Certified Check)/ (Bid Bond) in the amount of <u>N/A</u> being five percent (5%) of the maximum Bid Proposal herein, made payable to Troy School District or naming Troy School District as obligee. The proceeds of which are to remain the property of Troy School District, if the Bidder does not, within ten (10) days after notice of the acceptance of Bid Proposal, enter into the Contract.

TAXES

#### **BID PROPOSAL FORM**

Please identify the amount, if any, of this Bid Proposal that has been attributed to sales or use tax. If an amount has been attributed to such tax, please identify which components of the Bid to which the tax has been attributed.

SUBCONTRACTORS

Bidders must provide attach complete list of proposed subcontractors (one per discipline), if any are proposed to be utilized on the project. Listing two or more subcontractors per discipline will be grounds for disqualification.

#### EXCEPTIONS

Any Exceptions to the terms and conditions contained in the RFP or contract are identified below:

#### ADDENDA

This RFP incorporates the following Addenda:

Addendum No	Dated	Addendum No	Dated
Addendum No	Dated	Addendum No	Dated
Addendum No	Dated	Addendum No	Dated

**BID PROPOSAL FORM SUPPLEMENTS:** 

#### BID PROPOSAL FORM

00 40 10 - 2 of 3

## Self-Provisioned Fiber Maintenance - Bid # 9912

The following Bid Form Proposal Supplements are attached hereto and are considered an integral part of this Bid Proposal Form:

- SUPPLEMENTAL A Cost Analysis Worksheet
- SUPPLEMENTAL B Voluntary Alternates
- SUPPLEMENTAL C Familial Disclosure Affidavit
- SUPPLEMENTAL D- Iran Economic Sanctions Act Compliance Affidavit

USF E-Rate SPIN Num	ber	 	 
BIDDER NAME:			
ADDRESS:			
DATE:			
TELEPHONE:			
EMAIL ADDRESS:			

If award is made to our firm based upon our Bid Proposal, we agree to enter into the form of Contract with the School District in accordance with this Request for Proposal, the contract and our Bid Proposal.

My signature certifies that the Bid Proposal as submitted complies with all terms and conditions as set forth in this Request for Proposal, unless specifically enumerated as an exception as part of this Bid Proposal Form.

I hereby certify that I am authorized to sign as a Representative for the Firm:

(Authorized Signature)

(Print Name)

(Title)

(Date)

# BID PROPOSAL FORM

CONFIDENTIALITY NOTICE: This document is the intellectual property of Convergent Technology Partners. Any unauthorized review, use, disclosure, or distribution in whole or in part is prohibited. © 2016

#### 00 40 10 - 3 of 3

# SUPPLEMENTAL A - COST ANALYSIS WORKSHEET

OWNER: Troy School District 4400 Livernois Road Troy, Michigan 48083

**BIDDER:** 

ADDRESS:

Base Bid Breakdown				
Item	Unit Cost			
Annual Network Maintenance Ride Out				
Emergency Response Calls /per callout				
Truck/Trip Charges /per trip				
Miss Dig "Remote Response"				
(Add others as necessary)				
Estimated Annual Charges				
Labor Type	Unit Labor Rate			
Total 100 Hours Estimated Annual Charges				

# SUPPLEMENTAL A COST ANALYSIS WORKSHEET

Material Item	Unit Cost
Estimated Annual Charges	
Total Estimated Annual Charges	

# SUPPLEMENTAL A COST ANALYSIS WORKSHEET

# SUPPLEMENTAL B - VOLUNTARY ALTERNATES

<b>VOLUNTARY ALTERNATE 1</b>	•
	•

Add/Deduct/No Change		
	Dollars (\$	)
VOLUNTARY ALTERNATE 2:		
Add/Deduct/No Change		
	Dollars (\$	)
VOLUNTARY ALTERNATE 3:	20.000 (4	/
Add/Deduct/No Change		
	Dollars (\$	)

# SUPPLEMENTAL B VOLUNTARY ALTERNATES

# 00 40 14 - 1 of 1

## SUPPLEMENTAL C - FAMILIAL DISCLOSURE AFFIDAVIT

The undersigned, the owner or authorized officer of \_\_\_\_\_\_ (the "Bidder"), pursuant to the familial disclosure requirement provided in the Troy School District (the "District") Request for Proposal(s), hereby represents and warrants that, except as provided below, no familial relationships exist between the owner or any employee of the Bidder, and any member of the Board of Education of the School District or the Superintendent of the School District.

List any Familial Relationships:

	BI	DDER:	
	Ву	 ::	
	— Tit	:le:	
STATE OF MICHIGAN COUNTY OF			
This instrument was acknowledged before me o	on the	_ day of	, 2021, by
·			
			Notary Public
		County, Mic	chigan
	My Comm	ission Expires:	
	Acting in t	he County of:	
SUPPLEMENTAL C FAMILIAL DISCLOSURE AFFAI	DAVIT		00 40 15 - 1 of 1
This document is the intellectual property of Convergent Te disclosure, or distribution in whole or in part is prohibited.		ners. Any unauthorized	I review, use,

# Troy School District Self-Provisioned Fiber Network – Bid # 9912

#### SUPPLEMENTAL D - AFFIDAVIT OF COMPLIANCE - IRAN ECONOMIC SANCTIONS ACT

#### Michigan Public Act No. 517 of 2012

The undersigned, the owner or authorized officer of the below named applicant (the "Applicant"), pursuant to the compliance certification requirement provided in the Troy School District (the "District") Request For Proposals for OSP WAN Fiber Maintenance (the "RFP"), hereby certifies, represents and warrants that the Applicant (including its officers, directors and employees) is not an "Iran linked business" within the meaning of the Iran Economic Sanctions Act, Michigan Public Act No. 517 of 2012 (the "Act"), and that in the event Applicant is awarded a contract as a result of the aforementioned RFP, the Applicant will not become an "Iran linked business" at any time during the course of performing the Work or any services under the contract.

The Applicant further acknowledges that any person who is found to have submitted a false certification is responsible for a civil penalty of not more than \$250,000.00 or 2 times the amount of the contract or proposed contract for which the false certification was made, whichever is greater, the cost of the School District's investigation, and reasonable attorney fees, in addition to the fine. Moreover, any person who submitted a false certification shall be ineligible to bid on a request for proposal for three (3) years from the date it is determined that the person has submitted the false certification.

APPLICANT:			
Name of Applicant			
By:			
Title:			
Date:			
STATE OF Michigan			
COUNTY OF)			
This instrument was acknowledged befor	re me on the	day of	, 2021, by
·			
,	, Notary Public		_ County,
My Commission Expires:			
Acting in the County of:			

#### SECTION 33 82 00 - PROJECT SUMMARY

#### PART 1 - GENERAL

#### 1.1 CURRENT ENVIRONMENT

- A. The Owner has an existing self-provisioned fiber network that provides access to voice, data, video and Internet services to faculty, staff and students throughout the buildings/Sites
- B. The network connects to all Sites within the District. Following is a list of those Sites that are included as a part of this RFP
- C. The network is approximately 20 miles of fiber plant predominately aerial. The selected vendor will be provided with all existing as-builts. The included fiber map is a representation and not to be considered completely accurate.

Barnard Elementary	Boulan Park Middle School
3601 Forge, Troy, MI 48083	3570 Northfield Pkwy, Troy, MI 48084
Bemis Elementary	Larson Middle School
3571 Northfield Pkwy, Troy, MI 48084	2222 E. Long Lake Rd. Troy, MI 48085
Costello Elementary	Smith Middle School
1333 Hamman, Troy, MI 48085	5835 Donaldson, Troy, MI 48085
Hamilton Elementary	Athens High School
5625 Northfield Pkwy, Troy, MI 48098	4333 John R, Troy, MI 48085
Hill Elementary	Troy High School
4600 Forsyth, Troy, MI 48085	4777 Northfield Pkwy, Troy, MI 48098
Leonard Elementary	International Academy: East
4401 Tallman Dr. Troy, MI 48085	1291 Torpey Dr. Troy, MI 48083
Martell Elementary	Central Office
5666 Livernois, Troy, MI 48098	4400 Livernois Rd. Troy, MI 48098
Morse Elementary	Services Building
475 Cherry St. Troy, MI 48083	4420 Livernois Rd. Troy, MI 48098
Schroeder Elementary	Transportation Building
3541 Jack Dr. Troy, MI 48084	120 Hart St. Troy, MI 48098
Troy Union Elementary	Facility Operations Building
1340 East Square Lake Rd. Troy, MI 48085	1140 Rankin, Troy, Michigan 48083
Wass Elementary	Troy Preschool
2340 Willard Dr. Troy, MI 48085	205 W. Square Lake Road, Troy, MI 48098
Wattles Elementary	
3555 Ellenboro, Troy, MI 48083	

#### PROJECT SUMMARY

- 1.2 SUMMARY OF WORK
  - A. The District will require on-going maintenance for the fiber plant. The selected Contractor will be required to provide all labor, materials, supervision and consumables for the proper maintenance of the network
- PART 2 PRODUCTS
- 2.1 GENERAL
  - A. Provide products as indicated in individual sections
- PART 3 EXECUTION
- 3.1 GENERAL
  - A. As indicated in individual sections

#### PROJECT SUMMARY

33 82 00 2 -2

#### SECTION 33 82 13 - OPTICAL FIBER COMMUNICATIONS

#### PART 1 - GENERAL

#### 1.1 RELATED DOCUMENTS

- A. Drawings and general provisions of the Contract, including General and Supplementary Conditions and Division 01 Specification Sections, apply to this Section.
- B. Related Sections:
  - 1. Division 33 Section "Project Summary"

#### 1.2 REFERENCES

- A. The contractor shall comply with the latest edition or revision of all codes, standards and regulations.
- B. The publications listed below form a part of this specification to the extent referenced. The publications are referred to within the text by the basic designation only. Regardless of the date shown for each reference below, the latest edition shall apply.
  - 1. Local Building and Fire Codes, Local Property Right-of-Way Codes and Utility Specifications
  - 2. Building Industry Consulting Services International (BICSI)
    - a. BICSI Outside Plant Design Reference Manual (OSPDRM)
    - b. BICSI Telecommunications Distribution Methods Manual (TDMM)
    - c. BICSI Information Technology Systems Installation Methods Manual (ITSIMM)
  - 3. National Fire Protection Association (NFPA)
    - a. NFPA 70 (2014; AMD 1 2013; Errata 1 2013; AMD 2 2013; Errata 2 2013; AMD 3 2014; Errata 3-4 2014; AMD 4-6 2014) National Electrical Code
  - 4. Telecommunications Industry Association (TIA)
    - a. ANSI/TIA/EIA 758 Customer Owned Outside Plant Telecommunications Cabling Standard
    - b. ANSI/TIA/EIA-526, 7 & 14 Telecommunications Measurements of Optical Fiber Single and Multi-Mode Power Loss

#### OPTICAL FIBER COMMUNICATIONS

#### 33 82 13 1 -2

#### 1.3 DEFINITIONS

A. Unless otherwise specified or indicated herein, electrical and electronics terms used in this specification shall be as defined in TIA-526, TIA-758, and IEEE 100 and herein.


## 1.4 PRODUCTS

A. All products used in the performance of this contract shall be the same or shall meet or exceed the product specifications of those components currently being used in the network.


#### 1.5 EXECUTION

- A. The successful bidder is required to furnish all labor, materials, and supervision in support of this fiber maintenance contract.
- B. The maintenance services include but are not limited to the following:
  - 1. Schedule and perform routine maintenance and inspections including an annual maintenance ride out to identify any routes in the plant that are deficient or appear to require maintenance to avoid outages
  - 2. Schedule maintenance window for planned maintenance outages
  - 3. Respond to reports of damaged fiber facilities from unscheduled outages and customer reported loss in connectivity
  - 4. Coordinate activities with the District technical representative.
  - 5. Acting as the Miss Dig contact for all locating services and performing the on-site locating services for the District
  - 6. Repair and/or replace damaged plant or plant identified through inspections as being deficient
  - 7. Replace identification tags on fiber when replacing segments of the network
  - 8. Test fiber strands for all segments that are replaced for maintenance reasons and provide results to District technology representative
  - 9. Provide updated as-builts of all fiber changes necessitated by maintenance operations under this contract
  - 10. Other services as identified by the Contractor and/or District technical staff to ensure the reliable performance of the fiber Network


#### OPTICAL FIBER COMMUNICATIONS

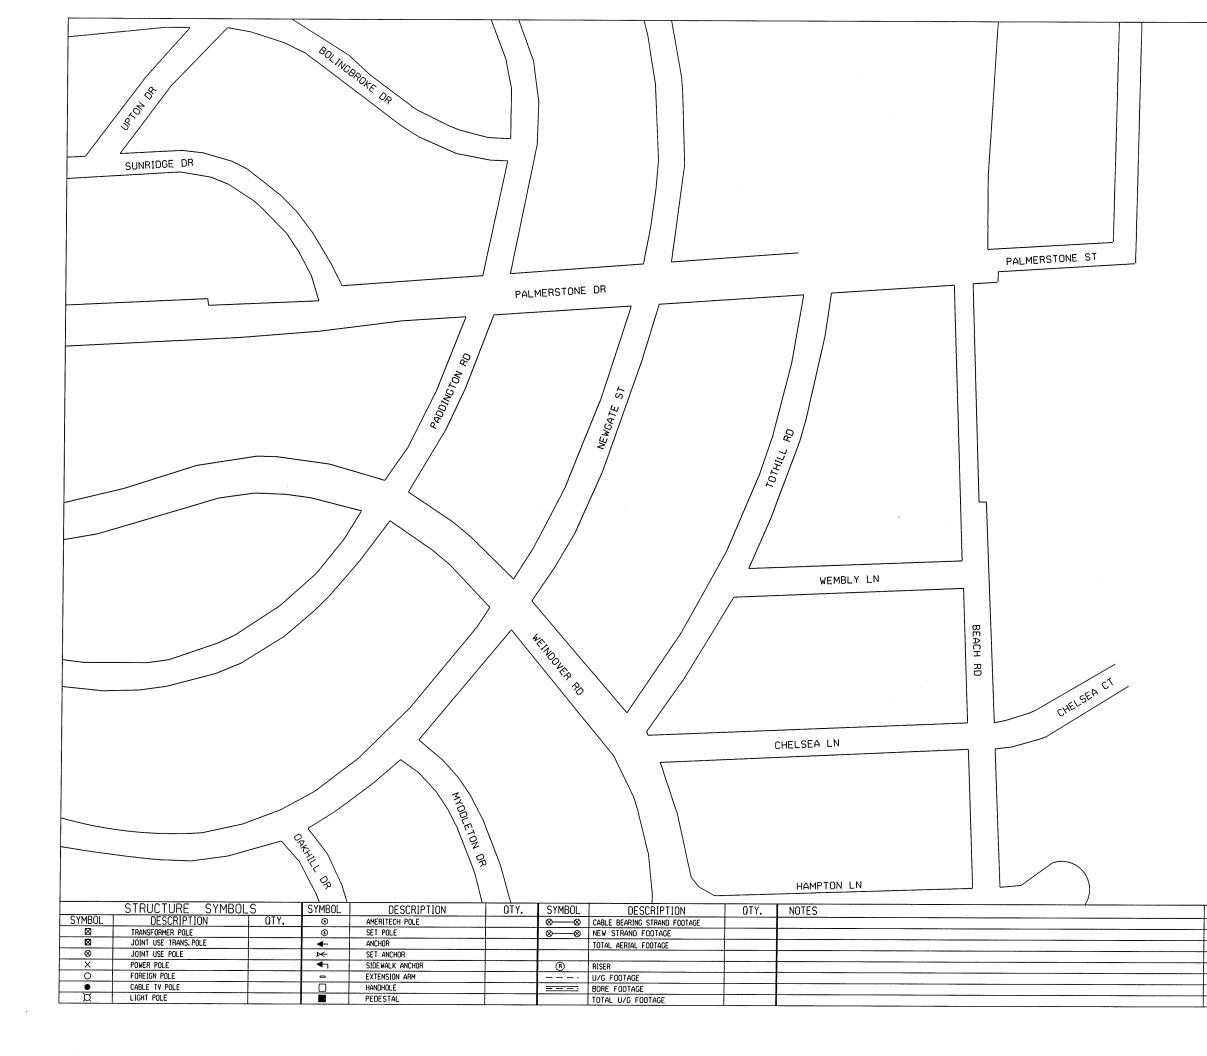

	FIBER SYMBOLS
	SYMBOL DESCRIPT. OTY.
	600 FIBER COUNT 6
SA	
[ ]	
SALEM RD	
김	
)	
/	
L	
	DR
E C	
	₽,
SCHROEDER ES 3541 JACK DR	
SOUL OHER DI	
	AERIAL FIBER
	LINE DESCRIP. OTY.
	<u> </u>
	<u>_</u>
	U/G FIBER
	LINE DESCRIP. OTY.
	TROY SCHOOL DISTRICT
	WIDE ARE NETWORK
	Fiber Link, Inc.
	Tiber Link, Inc.
	1 PT-08U-067-2891 For:810-667-3120
	Ph:810-667-2891 Fax:810-667-3120 Lopeer, Michigon
	CAD FILE: 304-390
AT)	CAD FILE: 304-390 SCALE: 1" - 200'
OTY. REVISIONS	CAD FILE: 304-390 SCALE: 1" • 200' DESIGNED BY: DATE:
OTY. REVISIONS DATE INITIALS	CAD FILE:         304-390           SCALE:         1" - 200'           DESIGNED BY:         DATE:           CAD BY:         TMS           DATE:         6/1/18

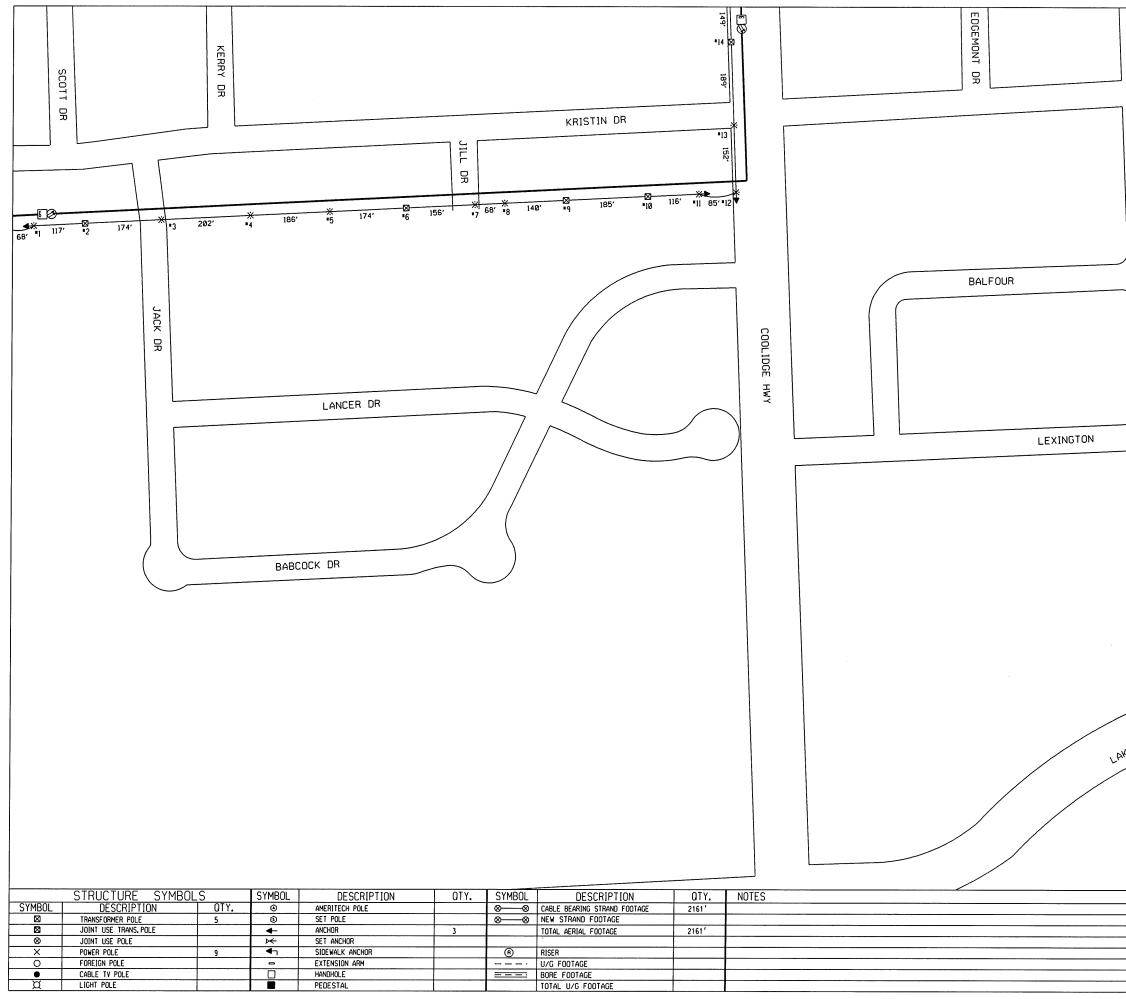





AKEVIEN  TROY SCHOOL DISTRICT WIDE AREA NETWORK  CAD FILE: 307-390 SCALE: 1*-200  OTY. REVISIONS  OTY. REVISIONS  DATE INITIALS  APPROVED BY: DATE: APPROVED BY: DATE: APPROVED BY: DATE: APPROVED BY: DATE: 304-392 307-392 310-392 304-390 307-390 310-390					ŀ	LINE		
TROY SCHOOL DISTRICT WIDE AREA NETWORK           Fiber Link, Inc.           Piber Link, Inc.           CAD FILE: 307-390           SCALE: I* - 200*           DATE           DATE           DATE           DATE           OTY.           DATE           DATE           DATE           MATE:           304-392         307-392         310-392           304-390         307-390         310-392					ŀ		-	·
CAD FILE: 307-390 SCALE: 1" - 200"           QTY.         REVISIONS         DESIGNED BY:         DATE:           DATE         INITIALS         CAD BY:         TMS         DATE:           APPROVED BY:         DATE:         304-392         307-392         310-392           304-390         307-390         310-390         310-390							iver Link, inc	
CAD FILE: 307-390 SCALE: 1" - 200"           QTY.         REVISIONS         DESIGNED BY:         DATE:           DATE         INITIALS         CAD BY:         TMS         DATE:           APPROVED BY:         DATE:         304-392         307-392         310-392           304-390         307-390         310-390         310-390						Ph:AV	0-667-2891	67:3120
OTY.         REVISIONS         DESIGNED BY:         DATE:           DATE         INITIALS         CAD BY:         TMS         DATE:           APPROVED BY:         DATE:         304-392         307-392         310-392           304-390         307-390         310-390         310-390					L			
QTY.         REVISIONS         DESIGNED BY:         DATE:           DATE         INITIALS         CAD BY:         TMS         DATE:6/1/18           APPROVED BY:         DATE:         304-392         307-392         310-392           304-390         307-390         310-390         310-390					H	CAD FILE:	307-390	
DATE         INITIALS         CAD BY:         TMS         DATE:         6/1/18           APPROVED BY:         DATE:         304-392         307-392         310-392           304-390         307-390         310-390         310-390	I	QTY.	RF V1	SIONS				ATE:
APPROVED BY:         DATE:           304-392         307-392         310-392           304-390         307-390         310-390			DATE	INITIALS				
304-390 307-390 310-390								
304-390 307-390 310-390					304	-392	307-392	310-392
					504	JJC	76C 17C	310 332
					304	-390	307-390	310-390
304-388 307-388 310-388								
					304	1-388	307-388	310-388

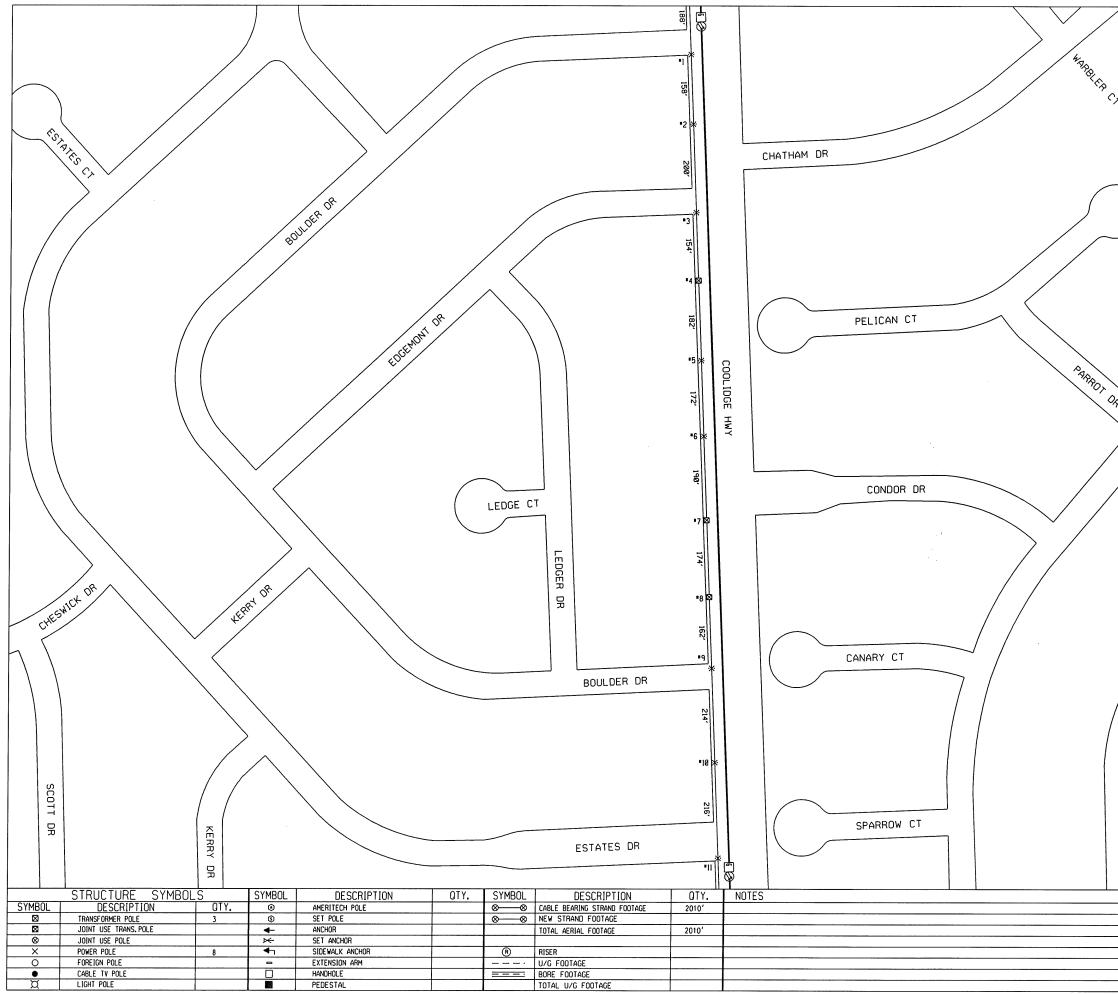

QA     ELSTEND       QA     ELSTEND       U/G     FIBER       LINE     DESCRIP.       OTY.     REVISIONS       DATE     INITIALS       CAD BY:     MATE:	× \ \	
U/G FIBER U/G FIBER UNE DESCRIP. OTY.		6CT 2010'
U/G FIBER U/G FIBER UNE DESCRIP. OTY.		\
U/G FIBER U/G FIBER UNE DESCRIP. OTY.	$\circ_{\varphi} \setminus / \vee /$	
UINE     DESCRIP.     OTY.       DATE     INITIALS		
UINE     DESCRIP.     OTY.       DATE     INITIALS		l
UINE     DESCRIP.     OTY.       DATE     INITIALS		U/G FIBFR
BRALION ST. BRALION ST. BRALI		
TROY SCHOOL DISTRICT WIDE AREA NETWORK Fiber Link, Inc. Prob 47:2501 Freedo-487-3300 Loor, Adopt CAD FILE: 307-392 SCALE: I' + 200' DATE INITIALS APPROVED BY: DATE: APPROVED BY: DATE:		
CAD FILE: 307-392 SCALE: 1" - 200' DATE INITIALS CAD BY: DATE: DATE INITIALS CAD BY: DATE:		
CAD FILE: 07-392 SCALE: 1" • 200" CAD FILE: 07-392 SCALE: 1" • 200" CAD BY: DATE: DATE INITIALS APPROVED BY: DATE: CAD BY: TMS APPROVED BY: DATE:		HIDE AREA NETWURK
CAD FILE: 07-392 SCALE: 1" • 200" CAD FILE: 07-392 SCALE: 1" • 200" CAD BY: DATE: DATE INITIALS APPROVED BY: DATE: CAD BY: TMS APPROVED BY: DATE:		
OPUSD 687-2891 For 80-687-3300           CAD FILE: 307-392           CALE: 1* - 200'           OTY. REVISIONS         DESIGNED BY: DATE:           DATE         INITIALS         CAD BY: TMS         DATE: 6/1/18           APPROVED BY: DATE:		
CAD FILE: 307-392 SCALE: I'' - 200' OTY. REVISIONS DESIGNED BY: DATE: DATE INITIALS CAD BY: TWS DATE:6/1/18 APPROVED BY: DATE:		
OTY. REVISIONS DESIGNED BY: DATE: DATE INITIALS CAD BY: TWS DATE:6/1/18 APPROVED BY: DATE:		
OTY. REVISIONS DESIGNED BY: DATE: DATE INITIALS CAD BY: TMS DATE:6/1/18 APPROVED BY: DATE:		
DATE INITIALS CAD BY: TMS DATE: 6/1/18 APPROVED BY: DATE:	QTY. REVISIONS	
APPROVED BY: DATE:	DATE   INITIALS	CAD BY: TMS DATE: 6/1/18
304-394 307-394 310-394		
		304-394 307-394 310-394
304-392 307-392 310-392		304-392 307-392 310-392
304-390 307-390 310-390		304-390 307-390 310-390
<u>304-340</u> <u>301-340</u> <u>310-340</u>	I	060-010 060-100 060-200

. .

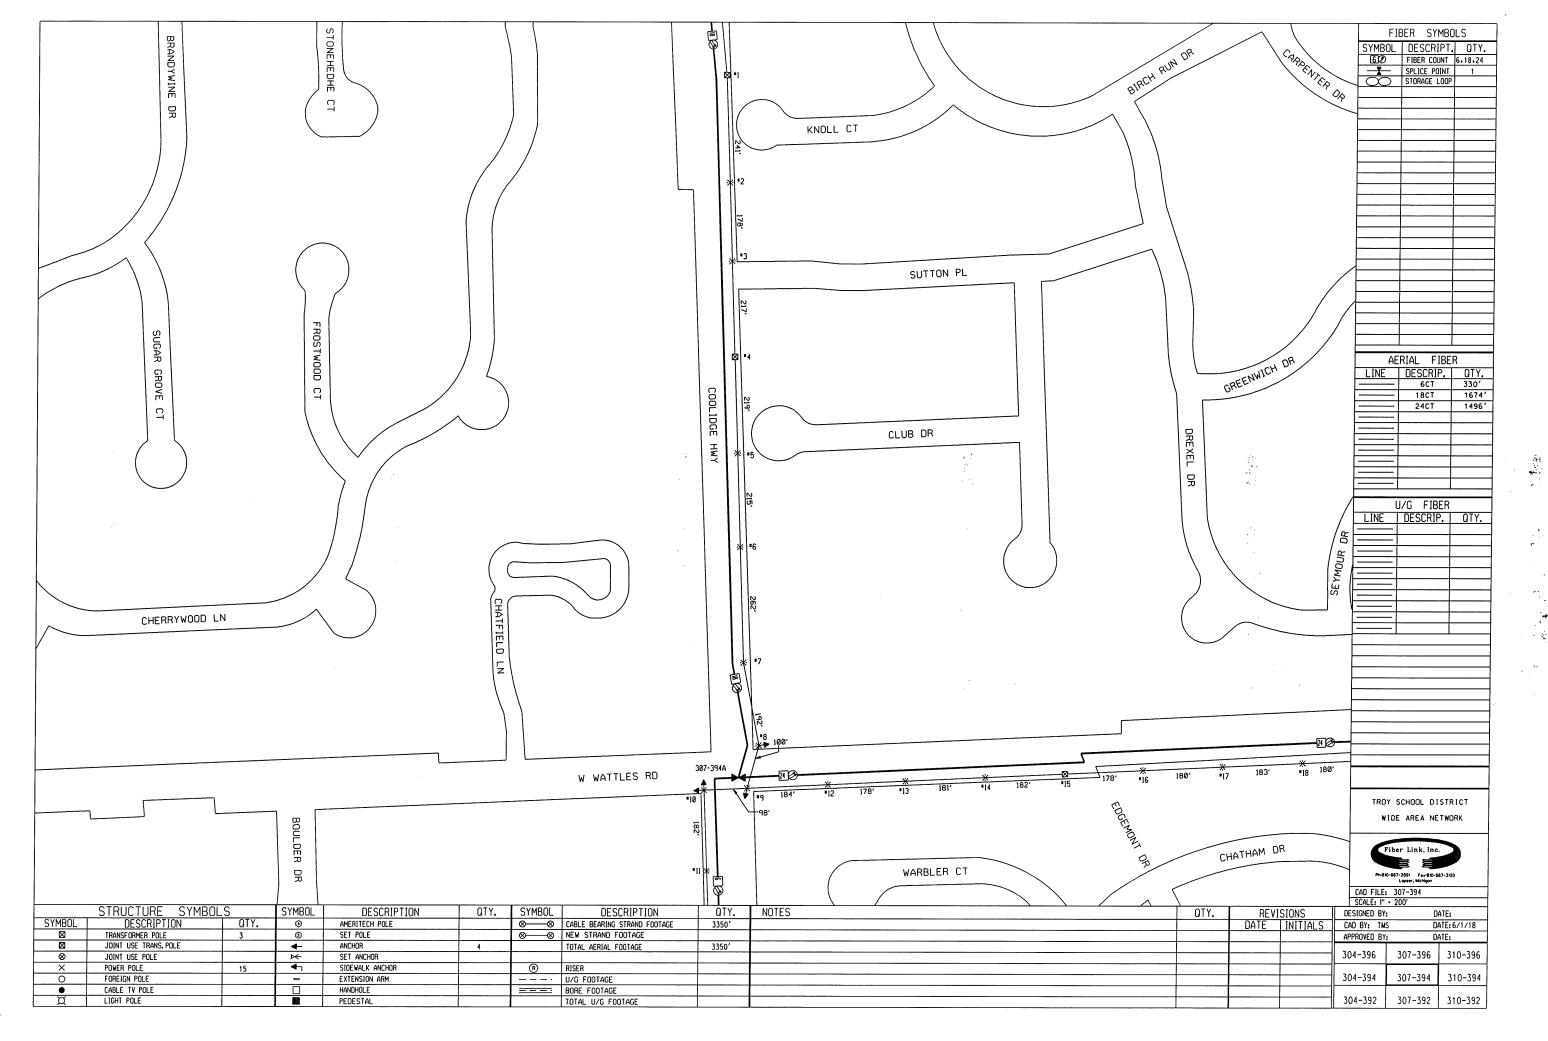

1


. ... · • -




RK			AERIAL FI	IBER
RK			DESCRI	P. OTY.
RK			- 18CT	2069'
RK	/ ~/		_	
RK  RK  OTY. REVISIONS OTY. REVISION			-	
OTY.         REVISIONS         DESIGNED BY:         DATE:           OTY.         REVISIONS         DESIGNED BY:         DATE:           APPROVED BY:         DATE:         304-398         307-396         310-396           304-396         304-396         310-396         310-396	RK		-	
OTY.         REVISIONS         DESIGNED BY:         DATE:           OTY.         REVISIONS         DESIGNED BY:         DATE:           APPROVED BY:         DATE:         304-398         307-396         310-396           304-396         304-396         310-396         310-396			-	
OTY.         REVISIONS         DESIGNED BY:         DATE:           OTY.         REVISIONS         DESIGNED BY:         DATE:           APPROVED BY:         DATE:         304-398         307-396         310-396           304-396         304-396         310-396         310-396				
OTY.         REVISIONS         DESIGNED BY:         DATE:           OTY.         REVISIONS         DESIGNED BY:         DATE:           APPROVED BY:         DATE:         304-398         307-396         310-396           304-396         304-396         310-396         310-396	GA			
WIDE AREA NETWORK           Piber Link, Inc.           CAD FILE: 307-396           SCALE: I'' 200'           DATE           DATE           INITIALS           CAD BY: INS           DATE:           JOATE           JOATE <th></th> <th></th> <th></th> <th></th>				
WIDE AREA NETWORK           Piber Link, Inc.           CAD FILE: 307-396           SCALE: I'' 200'           DATE           DATE           INITIALS           CAD BY: INS           DATE:           JOATE           JOATE <th></th> <th>TROY</th> <th></th> <th>STRICT</th>		TROY		STRICT
OTY.         REVISIONS         Description         First: 0.667.3120           DATE         INITIALS         CAD BY: TWS         DATE: 6/1/18           APPROVED BY:         DATE:           304-398         307-396         310-398           304-396         307-396         310-396				
OTY.         REVISIONS         DESIGNED BY:         DATE;           DATE         INITIALS         CAD BY: TMS         DATE; 6/1/18           APPROVED BY:         DATE;         01-398         307-398         310-398           304-396         307-396         310-396         310-396			DE ANCA NE	INUKK
OTY.         REVISIONS         DESIGNED BY:         DATE;           DATE         INITIALS         CAD BY: TMS         DATE; 6/1/18           APPROVED BY:         DATE;         01-398         307-398         310-398           304-396         307-396         310-396         310-396				
CAD FILE:         307-396           SCALE:         I'' - 200'           DATE         INITIALS           DATE         INITIALS           APPROVED BY:         DATE:           BY:         DATE:     <			iber Link, Inc.	
CAD FILE:         307-396           SCALE:         I'' - 200'           DATE         INITIALS           DATE         INITIALS           APPROVED BY:         DATE:           BY:         DATE:     <			-647-2691	17:3120
OTY.         REVISIONS         DESIGNED BY:         DATE;           DATE         INITIALS         CAD BY: TMS         DATE; 6/1/18           APPROVED BY:         DATE;         04TE;         04TE;           304-398         307-398         310-396           304-396         307-396         310-396				
OTY.         REVISIONS         DESIGNED BY:         DATE:           DATE         INITIALS         CAD BY:         TMS         DATE: 6/1/18           APPROVED BY:         DATE:         304-398         307-398         310-398           304-396         307-396         310-396         310-396		SCALE: 1"	· 500.	
DATE         INITIALS         CAD BY: TMS         DATE: 6/1/18           APPROVED BY:         DATE:           304-398         307-398         310-398           304-396         307-396         310-396	OTY. REVISIONS	DESIGNED BY:	Dŕ	
304-398         307-398         310-398           304-396         307-396         310-396	DATE INITIALS		DA	TE: 6/1/18
304-396 307-396 310-396		APPROVED BY:	Df	IE:
		304-398	307-398	310-398
		304-200		
304-394 307-394 310-394		204-236	201-226	210-236
		304-394	307-394	310-394
	I U	I	I	



					F	IBER SYI	MBOLS
				S	YMBOL		
					60	FIBER COL	JNT 18
					<u> </u>	SPLICE PO	DINT
					$\overline{0}$	STORAGE L	_00P 2
						_	
				$\vdash$		_	
		_					
		[12	<b>10-00</b>				
			====-05-				
77	70' - 4" DUCT V	/ 1¼ INNERD	UCT HH®2	-			
<u>ר</u>							
ž							
피							
FLOWER HILL							
白							
Г <sup>-</sup>							
PR						1	
						1	
				<u> </u>			
					Δ	ERIAL FI	IBER
				┝─└	INE	DESCRI	P. OTY
						- 18CT	153
						·	
						·	
						•	
				[=		· [	
						•	
1						1	
1						1	
1							
1						1	
1							
						U/G FIB	ER
					INE	DESCRIF	P. OTY
						18CT	1865
$\mathbf{X}$				-			
						1	
1	•						
				=			
						· · · · · · · · · · · · · · · · · · ·	
$\Big ight angle$							
					TROY	SCHOOL DI	STRICT
						SCHOOL DI	
					WIC	DE AREA NE	TWORK
					WIC		TWORK
					WIC	DE AREA NE	TWORK
					WIC	DE AREA NE	
					WIC Fit	DE AREA NE	
					WIC File File:	DE AREA NE Der Link, Inc.	
				SCAL	WIC Fill FillE: E: 1" •	DE AREA NE Der Link, Inc. 67-2891 FextBio-66 Lopeer, Michigan 307-398 200'	T WORK
	0TY.	REVI	SIONS		WIC Fill FillE: E: 1" •	DE AREA NE Der Link, Inc. 67-2891 FextBio-66 Lopeer, Michigan 307-398 200'	
	OTY.	RE VI	SIONS	DESIGNE	W10	DE AREA NE	T WORK
	<u>0</u> TY.	REVI DATE	SIONS	DESIGNE CAD BY:	W10 Fit Fit Fit Fit Fit Fit Fit Fit	DE AREA NE Der Link, Inc. 67-2891 Factor of 10947 Aschored 307-398 200' Df Df	T WORK
	<u>OTY.</u>	REVI DATE	SIONS	DESIGNE	W10 Fit Fit Fit Fit Fit Fit Fit Fit	DE AREA NE Der Link, Inc. 67-2891 Factor of 10947 Aschored 307-398 200' Df Df	T WORK
	OTY.	REVI DATE	SIONS INITIALS	SCAL DESIGNE CAD BY: APPROVE	W10 Pite Pite: File: E: 1" - D BY: : TMS D BY:	DE AREA NE	T WORK
	OTY.	REVI DATE	SIONS	DESIGNE CAD BY:	W10 Pite Pite: File: E: 1" - D BY: : TMS D BY:	DE AREA NE Der Link, Inc. 67-2891 Factor of 10947 Aschored 307-398 200' Df Df	T WORK
		REVI DATE	SIONS INITIALS	SCAL DESIGNE CAD BY: APPROVE 304-4(	W10 File: File: E: 1" - E: 0 BY: : TMS E: 0 BY: : 00	DE AREA NE Der Link, Inc. 57-2891	T WORK
	OTY.	REVI DATE	SIONS INITIALS	SCAL DESIGNE CAD BY: APPROVE	W10 File: File: E: 1" - E: 0 BY: : TMS E: 0 BY: : 00	DE AREA NE	T WORK
	OTY.	REVI DATE	SIONS INITIALS	SCAL DESIGNE CAD BY: APPROVE 304-4(	W10 Filter Filter ED BY: ED BY: D BY: 00 98	DE AREA NE Der Link, Inc. 57-2891	T WORK

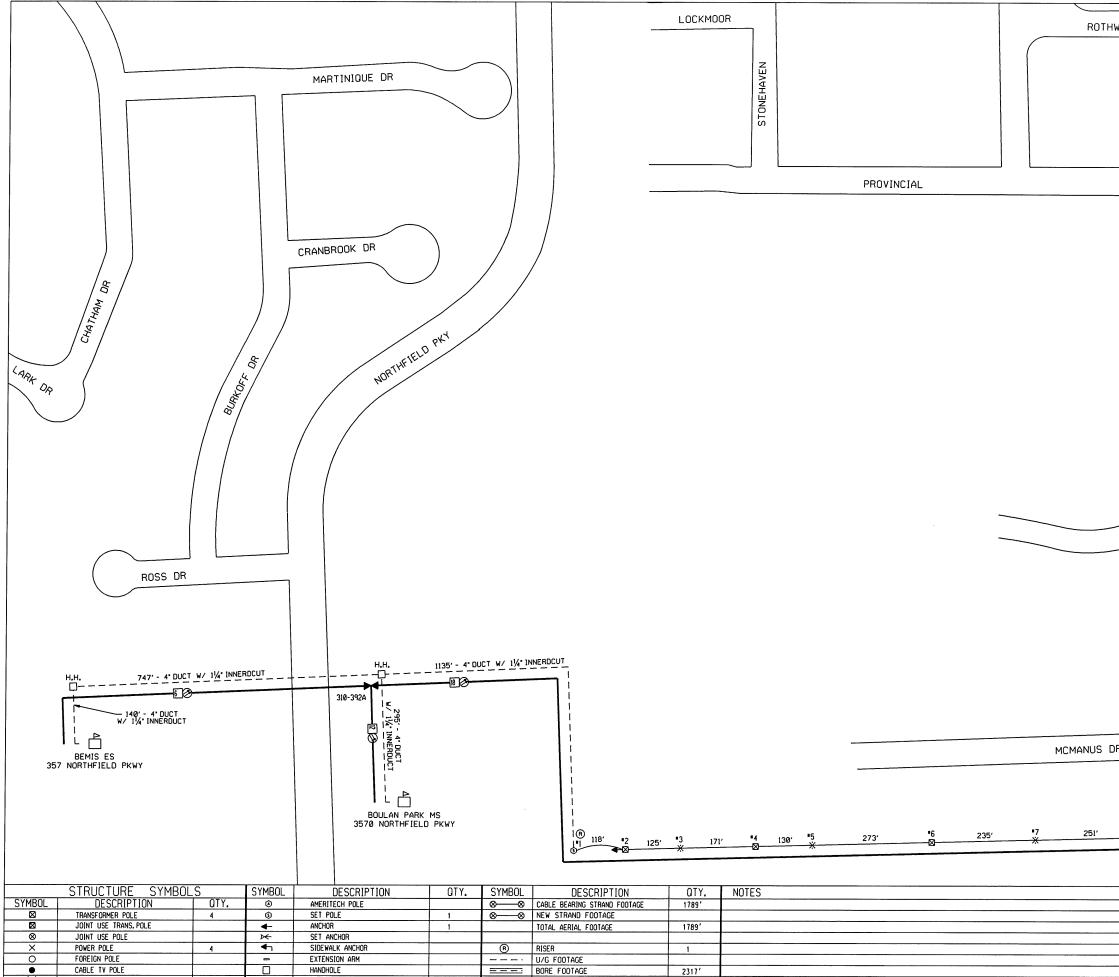

TOTAL U/G FOOTAGE

C LIGHT POLE

2


PEDESTAL


2317'

2342'

iwell i			
IWELL	F]	BER SYM	BOLS
	SYMBOL		
	<u> </u>		IT 6.12.18
		SPLICE POIN	NT 1
		STORAGE LC	
		-	
	ļ		
	1	+	
			-
	L		
	<u> </u>		
		L	
	ΔF	RIAL FIE	RER
	LINE	DESCRIP	
		18CT	1789'
	1	J/G FIBE	R
	LINE	DESCRIP.	OTY.
BOULAN PARK		6CT	987'
BOOLHIN I HIKK		12CT	395'
		18CT	1260'
DR		SCHOOL DIS	TRICT
DR		SCHOOL DIS	
DR			
DR	WID	E AREA NET	
∎8 244′ <b>¤9</b> 242′	WID		
"9 242'	WIDE	E AREA NET	WORK
∎8 244′ <b>¤9</b> 242′	WIDE	E AREA NET	WORK
∎8 244′ ¤9 242′ ———————————————————————————————————	WIDE Fibe Presso-665 CAD FILE: 3	er Link, Inc.	WORK
■8 244' <sup>■</sup> 9 242' ※ <u>⑧</u> 》	WIDE Presto-667 CAD FILE: 3 SCALE: 1" • 2	E AREA NET	WORK
■8 244' ■9 242' ※ ⑧② 0TY. REVISIONS DES	WIDE Prido - 65 CAD FILE: 3 SCALE: 1" - 2 SIGNED BY:	E AREA NET	WORK
■8 244' ■9 242' ※	WIDE Prido 65 CAD FILE: 3 SCALE: 1" 2 SIGNED BY: D BY: TMS	E AREA NET	
■8 244' ■9 242' ※	WIDE Prido - 65 CAD FILE: 3 SCALE: 1" - 2 SIGNED BY:	E AREA NET	
18 244' 19 242' X B D OTY. REVISIONS DES DATE INITIALS CAG APP	WIDE Protocological CAD FILE: 3 SCALE: 1" - 2 SIGNED BY: D BY: TMS PROVED BY:	E AREA NET	
18 244' 19 242' X B D OTY. REVISIONS DES DATE INITIALS CAG APP	WIDE Protocological CAD FILE: 3 SCALE: 1" - 2 SIGNED BY: D BY: TMS PROVED BY:	E AREA NET	WORK
B 244' B 242' X B DATE INITIALS CAD	WIDE Proto-663 SCALE: 1" - 22 SIGNED BY: D BY: TMS PROVED BY: 7-394	E AREA NET	WORK
•8 244' <u>9 242'</u> ★ B & OTY. REVISIONS DES DATE INITIALS CAR APP 30' 30'	WIDE Protocol SCALE: I" - 2 SIGNED BY: OBY: TMS ROVED BY: 7-394 7-392	E AREA NET er Link, Inc. 	WORK
•8 244' <u>9 242'</u> ★ B & OTY. REVISIONS DES DATE INITIALS CAR APP 30' 30'	WIDE Protocol SCALE: I" - 2 SIGNED BY: OBY: TMS ROVED BY: 7-394 7-392	E AREA NET Pr Link, Inc. 2001 factor 40 10-392 100 DA1 DA1 DA1 310-394	WORK

, **.** 

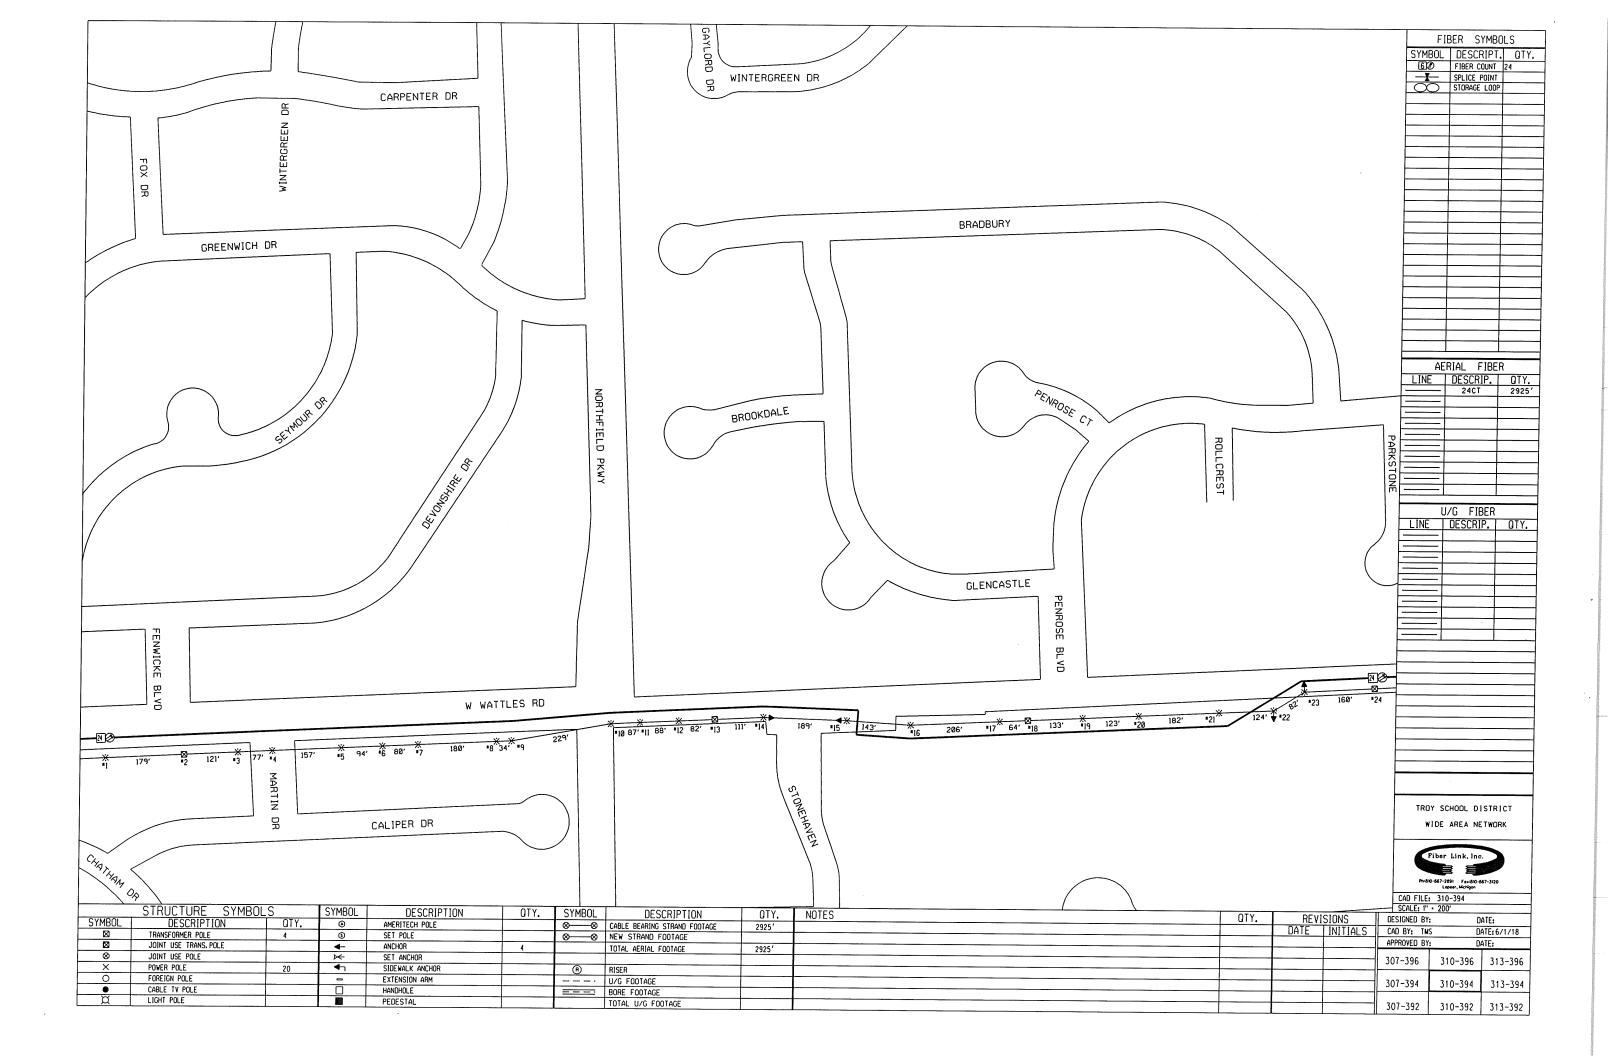

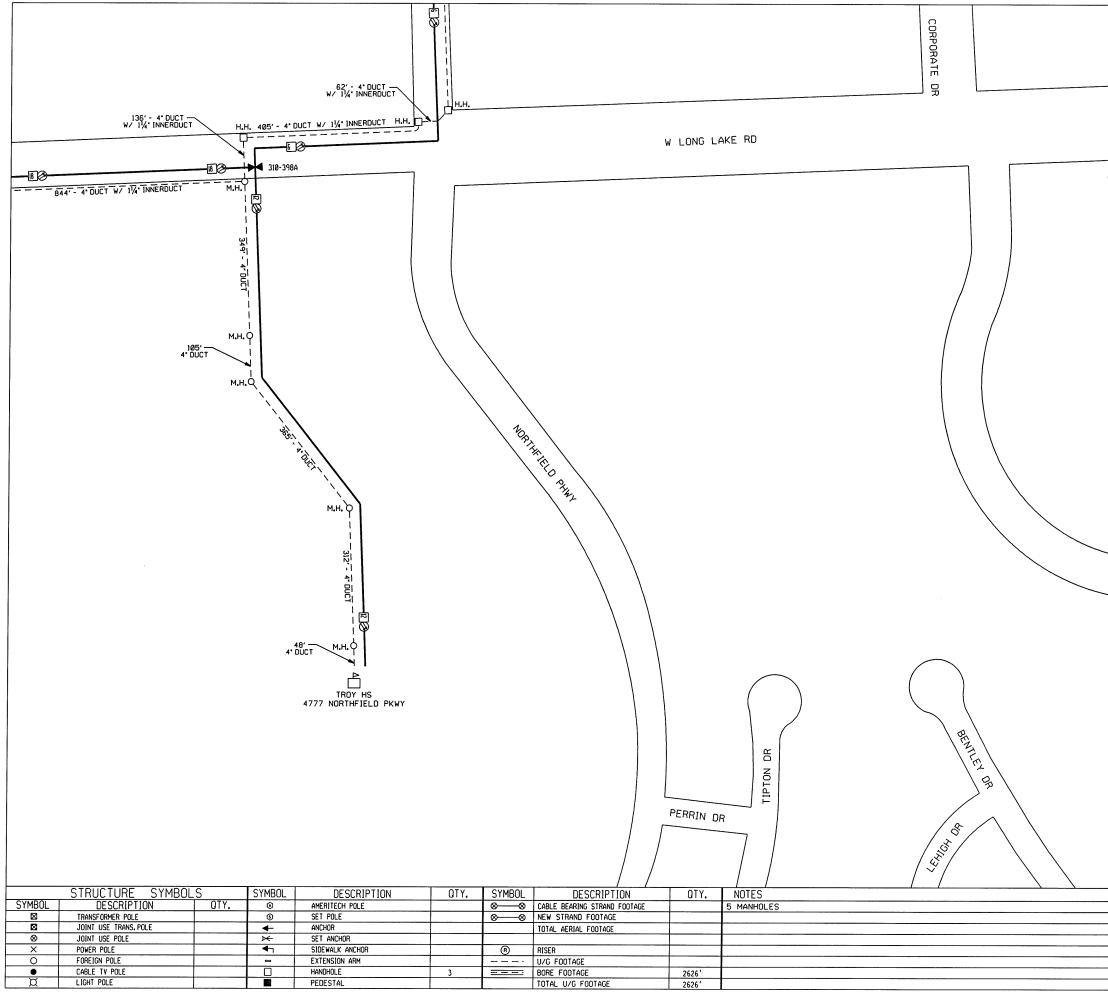

	4BOL	ER SYN	FIE					 
OTY.		DESCRI	OL	SYMB				
	NT 6	FIBER COU		60				
1	INT	SPLICE POI		<u>X</u> _				
	00P	STORAGE L	ر	$\int \infty$				
	-+							 
	+							
				-				
	$-\Gamma$							 
	_							
	$\square$							
	_							
	+							
			_					
	+		-					
		IAL FI						
OTY.		DESCRIP		LINE				
، آ الت	•	DESCRIP	_					
			=†					
			-1					
	$\square$		=1					
	+		_					
	+		=+					
	+		_					
			_					
			-1					
	CD.	G FIBE	11					
<u>דע</u>	<u>_ r(</u>	DESCRIP	<u> </u>	LINE				
)TY. 03'		DESCRIP 6CT	_+					
44'	+	1207	=†					
279'		18CT	_1					
			-					
	_		-	1				 
			=+		פר	MENTO		
	+		=+		717	MENTS	INVES	
			=†					 
			-1					
				-				
r	STRI	HOOL DI	ΥS	TRO				
		AREA NE					/	
		ANCA NE	105	*			(	
	-		_			)	(	
		Link, Inc.	Fiber			(	$\backslash$	
					<	$\langle \langle \rangle \rangle$		
	7-3120	891 Fax:810-66 peer, Michigan	0-667- L	Ph:81	$\sim$ /	CI IR R		
		)-398	31	CAD FILE:		$\sim$		
		)'	• 20	SCALE: 1"	\`	`		 
/10	ATE:			SIGNED BY	SIONS	REVI	QTY.	 
18	TE: 6/			D BY: TM: PROVED BY:	INITIALS	DATE		 
400	313	10-400	3	7-400				 
200	<b>.</b>	0.305	-	2 200				
. (98	313	0-398	3	7-398				
330								
	513	10-228	5	1-228	]			


.


3.0


. . .

• •

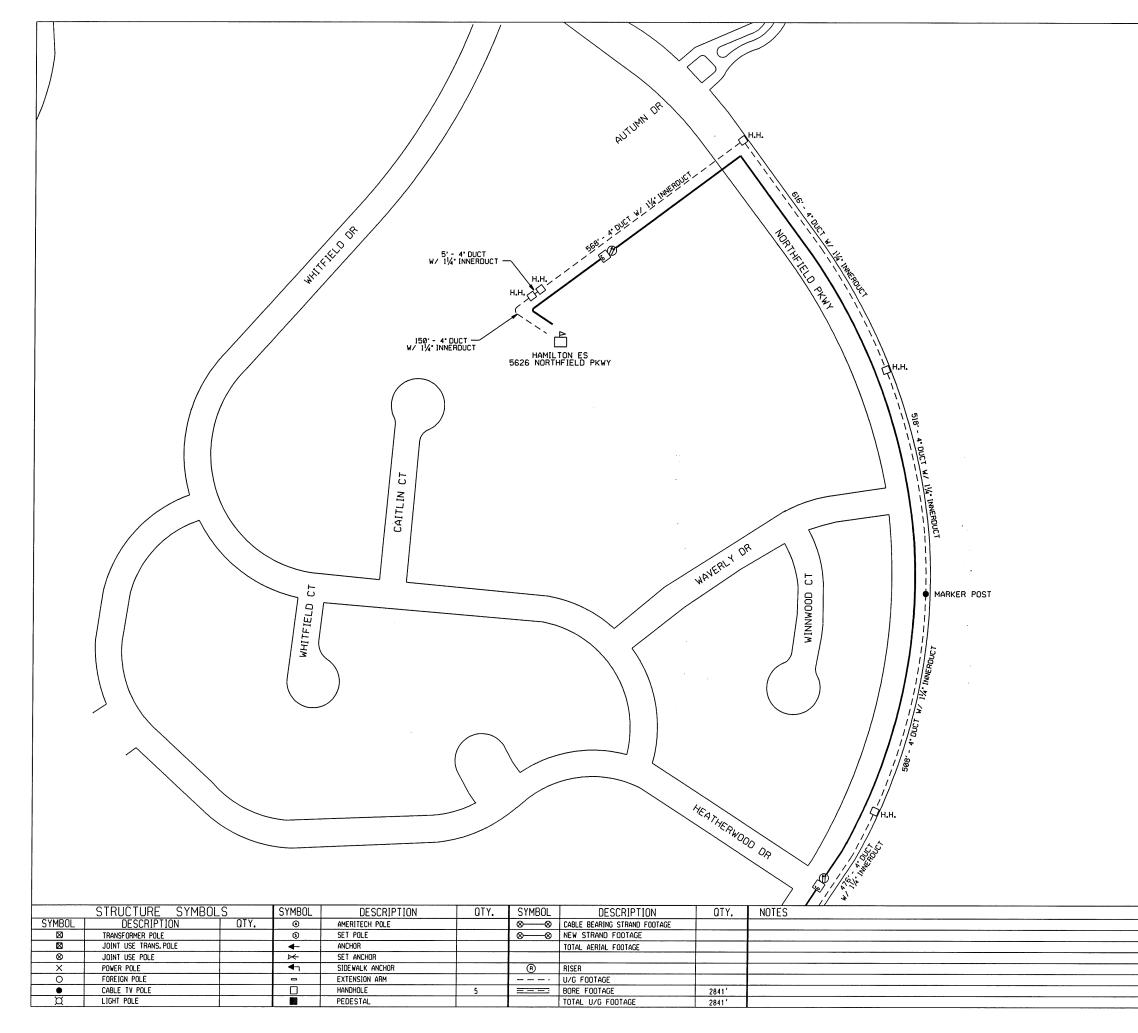


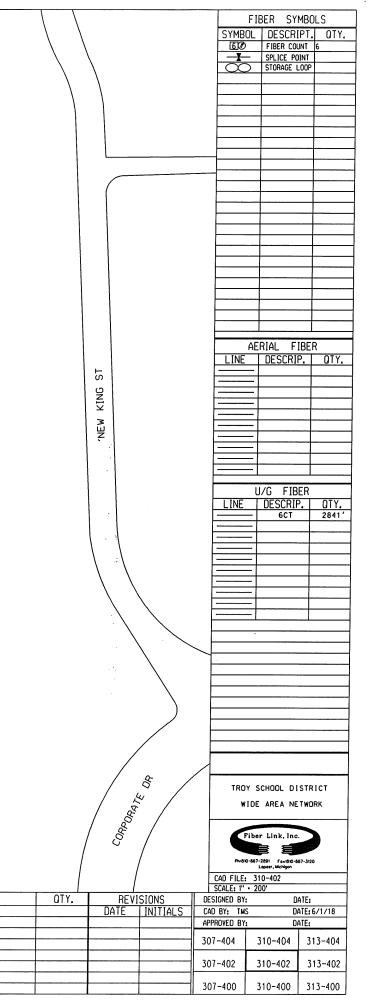


·, .

4


.

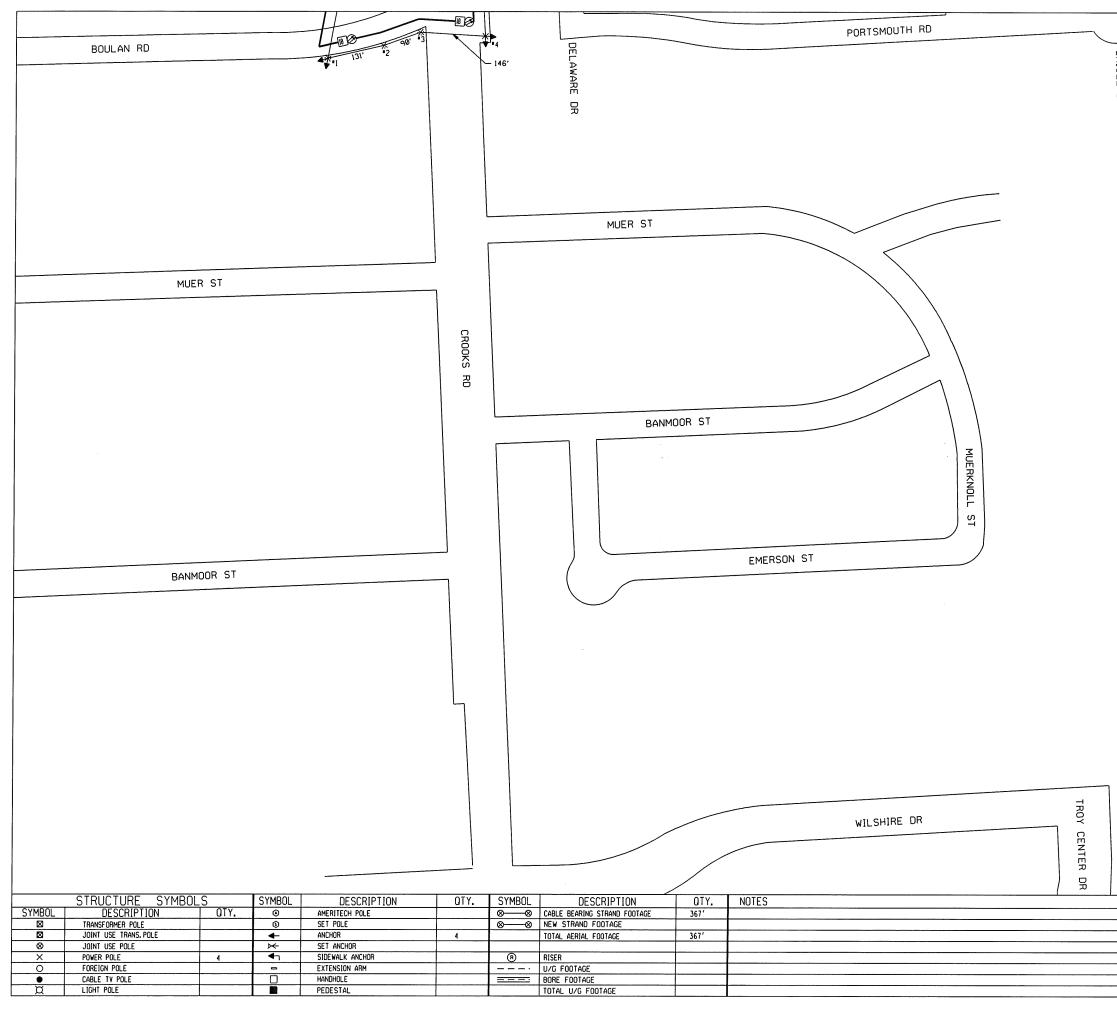


)	P				FIBER SY	
/	OLD CREEK RD			SYMBO		PT. OTY.
	L CR			<u>6</u>	FIBER COU - SPLICE PO	INT 18
	l m				STORAGE L	.00P
		I				
	RD					
	0					
					_	
					_	
						1
					AERIAL FI	IBER
				LINE	DESCRI	P.   OTY.
					- 18CT	367'
					-	
					-	
					-	
					-	
						_
		ā .				
		ă și Alteria			=	
					_	
					U/G FIB	ER
				LINE	DESCRIP	P.   OTY.
					-	
					-	
				-		
					-	
					-	
					-	
					-	
					-	
					-	
					· · · · · · · · · · · · · · · · · · ·	
					· · · · · · · · · · · · · · · · · · ·	
					' SCHOOL D1	STRICT
					Ý SCHOOL DI DE AREA NE	
				WI		TWORK
				WI	DE AREA NE	TWORK
				WI	DE AREA NE	
				W I	DE AREA NE	
				W I	DE AREA NE	
1 01	ΓΥ			CAD FILE: SCALE: 1"	DE AREA NE	T WORK
01	ΓΥ.	REVI	SIONS	CAD FILE: SCALE: 1" DESIGNED BY:	DE AREA NE	TWORK
01	Γ <u>Υ.</u>	RE VI DATE	SIONS	W I F F F F F F F F F F F F F	DE AREA NE iber Link, Inc. 607-2601 Far-80-60 Loper, Merioon 313-390 2001 D/ D/	TWORK
01	Γ <b>Υ.</b>	RE VI DATE	SIONS	W I CAD FILE: SCALE: I" DESIGNED BY: CAD BY: TMS APPROVED BY:	DE AREA NE	TWORK
01	ΓΥ.	RE VI DATE	SIONS INITIALS	W I F F F F F F F F F F F F F	DE AREA NE iber Link, Inc. 607-2601 Far-80-60 Loper, Merioon 313-390 2001 D/ D/	TWORK
01	Γ <u>Υ.</u>	REVI DATE	SIONS INITIALS	W I F F CAD FILE: CAD FILE	DE AREA NE iber Link, Inc. 567-2801 (26-80-7) 313-390 200' D/ 0/ 0/ 0/ 313-392	TWORK
01	Γ <u>Υ.</u>	REVI DATE	SIONS INITIALS	W I CAD FILE: SCALE: I" DESIGNED BY: CAD BY: TMS APPROVED BY:	DE AREA NE	TWORK
01	ΓΥ. 	REVI DATE	SIONS INITIALS	W I F F CAD FILE: CAD FILE	DE AREA NE iber Link, Inc. 567-2801 (26-80-7) 313-390 200' D/ 0/ 0/ 0/ 313-392	TWORK

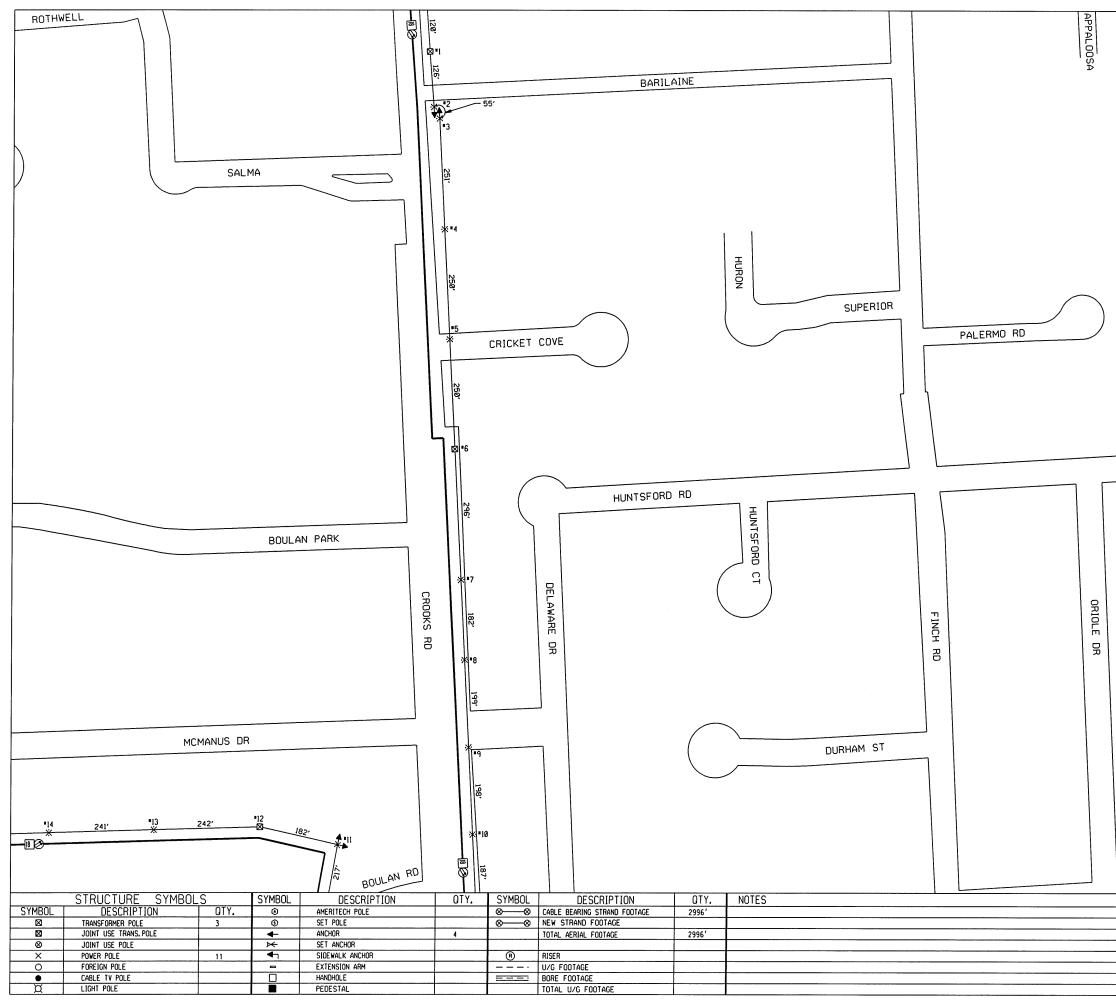


		BER SYMBO	וכ
	SYMBOL	DESCRIPT.	
	60	FIBER COUNT	18
		SPLICE POINT STORAGE LOOP	
OLD CREEK RD.			
151			
\'			
$\langle \rangle$			
$\langle \rangle$	V		
$\sim$			
	\		
	`		
		<u> </u>	
		RIAL FIBE	
	LINE	DESCRIP. 18CT	OTY. 2996'
		1001	2996
	LINE	J/G FIBER DESCRIP.	QTY.
		DESCRIF.	
/	/		
/			-
	/		
ald career mo			
1			
/ & /			
/ /			
/ /			
			ст
	TROY	SCHOOL DISTR	
		SCHOOL DISTR E AREA NETWO	
	WID	E AREA NETWO	
	WID		
	WID	er Link, Inc.	rk
	WIDE Pibe	er Link, Inc.	rk
	WIDI Pravest CAD FILE: 3 SCALE: I'' - 2	er Link, Inc.	rk
OTY. REVISIONS	WIDI Prato 65 CAD FILE: 3 SCALE: 1" • 2 DESIGNED BY:	E AREA NETWO	RK
OTY. REVISIONS DATE INITIALS	CAD BY: TMS	E AREA NETWO	rk
	WIDI Presorest CAD FILE: 3 SCALE: I" - 2 DESIGNED BY: CAD BY: TMS APPROVED BY:	E AREA NETWO	5/1/18
	WIDI Presorest CAD FILE: 3 SCALE: I" - 2 DESIGNED BY: CAD BY: TMS APPROVED BY:	E AREA NETWO	RK
	CAD BY: TMS APPROVED BY: 310-394	E AREA NETWO er Link, Inc. 13-392 1000 DATE: DATE: 1313-394 31	RK
	WIDE Protocology CAD FILE: 3 SCALE: 17 - 2 DESIGNED BY: CAD BY: TMS APPROVED BY: 310-394 310-392	E AREA NETWO er Link, Inc. 	5/1/18

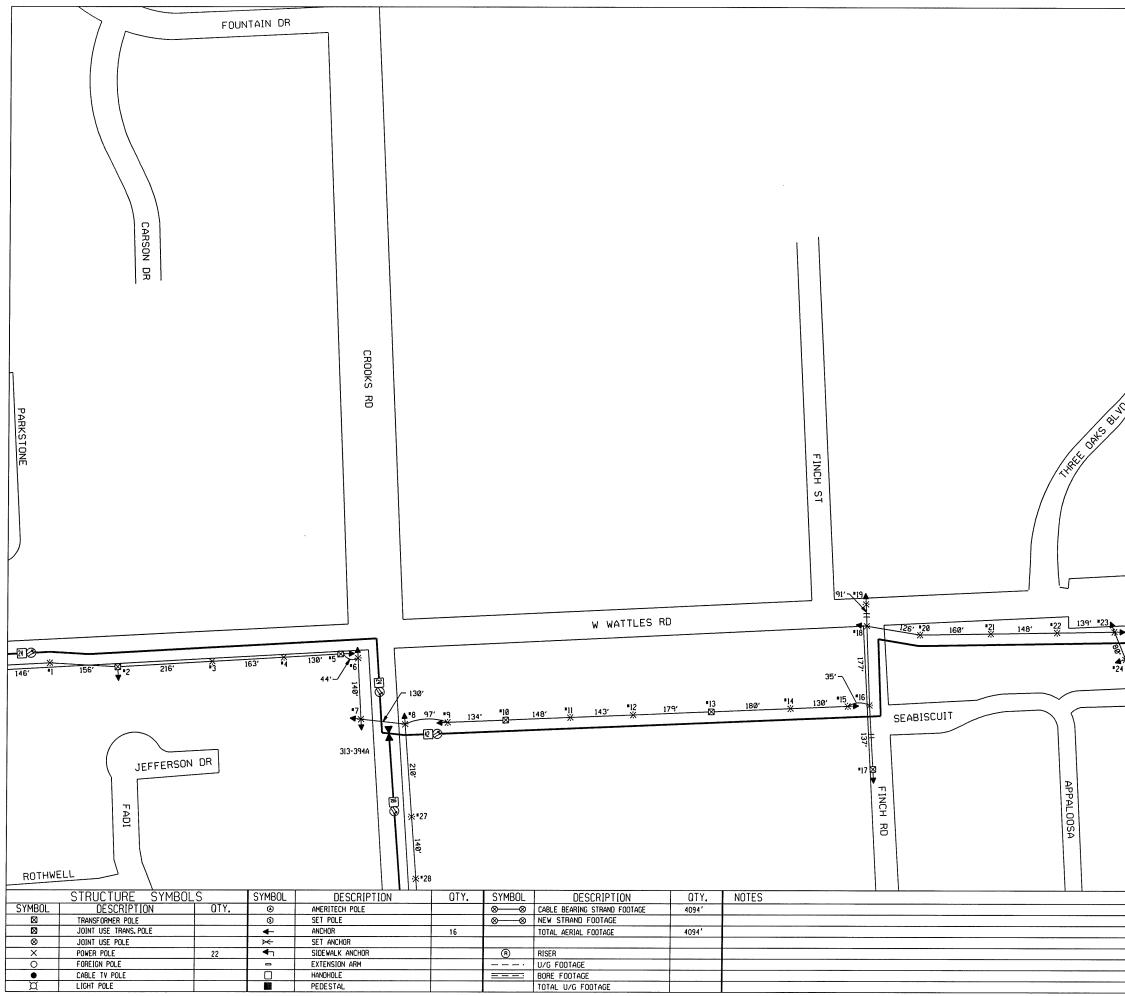


		F	IBER SY	MBOLS
		MBOL		
		50 7	FIBER COL	
		5	SPLICE PO STORAGE L	00P 1
		~~		i
		_		
1				_
	-		1	
JЦ				
$\mathcal{T}$			1	
			ERIAL F	
		INE	DESCRI	
//			18CT 24CT	450' 1225'
//			42CT	2641'
No.				
×/				
/				
			ı 	
			U/G FIB	
		INE	DESCRIP	P. OTY.
	1]=			
$\sim$	$\rightarrow \equiv$			
*	¥—			
8 110' 25 138' 26				
-24				
]				
			SCHOOL DI	
		WID	E AREA NE	TWORK
		_		
$\backslash a \rangle$		Fib	er Link, Inc	
		_		
$\langle \mathcal{F} \rangle$			7-2891 Fax:810-6 Lopeer, Michigon	67-3120
$\langle \delta \rangle$		FILE: 3 5:1" • 2	13-394	]
	DESIGNED			ATE:
DATE INITIALS	CAD BY:	TMS	Di	ATE: 6/1/18
	APPROVED		Di	ATE:
	310-39	6	313-396	316-396
	310-39		313-394	316-304
				316-394
	310 33	<u>`</u>		
	310-39		313-392	316-392

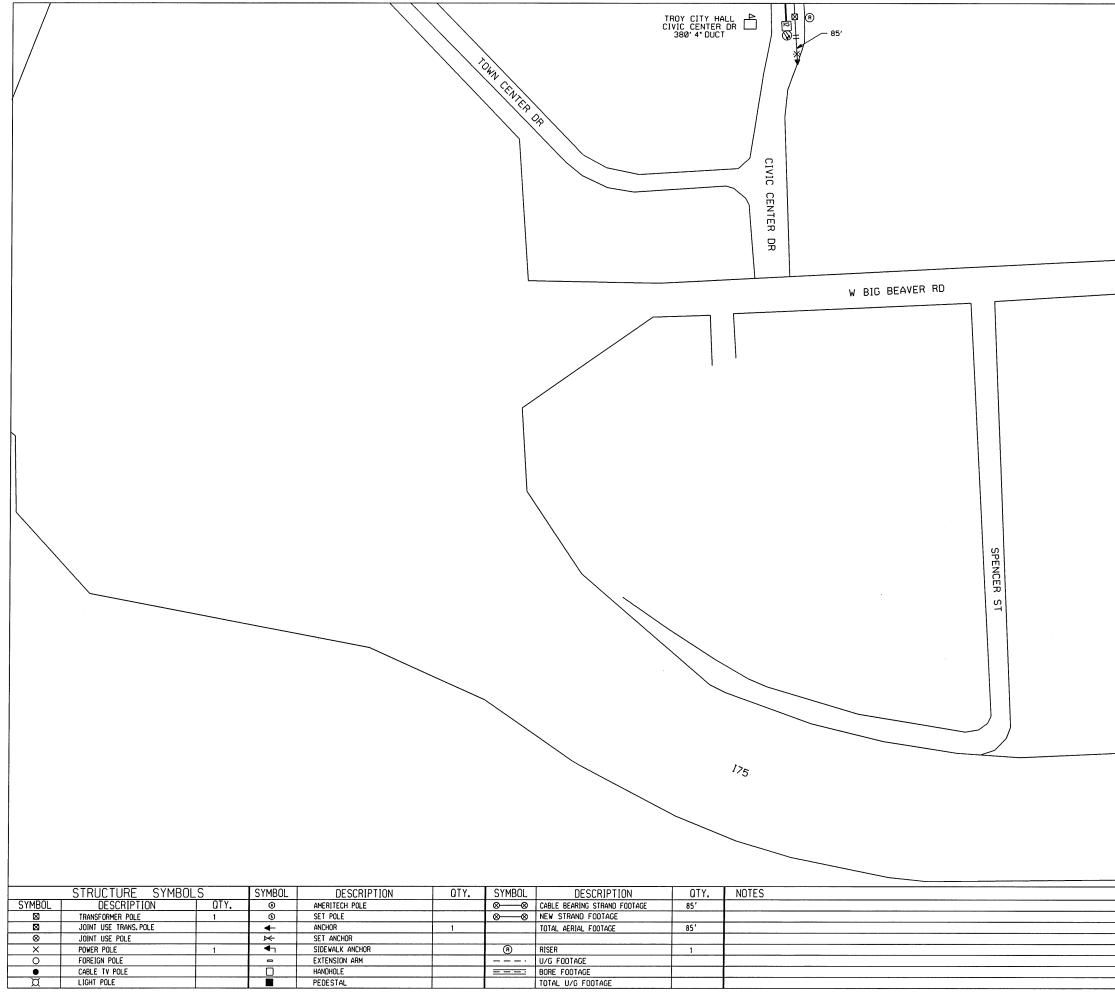



	1		
		FIBER SY	
	SYMBI	DL DESCRI FIBER COL	PT. OTY.
		- SPLICE PO	INT
	$\propto$		00P
	LINE	AERIAL FI	BER P. OTY.
			• 911.
		-	
		_	
		_	
		_	
		_	
		_	
		U/G FIB	
	LINE	DESCRIF	2. OTY.
		-	
		_	
		-	
		_	
		_	
		-	
			STRICT
		Y SCHOOL DI IDE AREA NE	
		I DE AREA NE	
		iber Link, Inc.	
	Ph-81	0-667-2891 Fax:810-66 Lapeer, Michigan	57-3120
	CAD FILE:	316-388	
OTY. REVISIONS	SCALE: 1" DESIGNED BY:		ATE:
DATE INITIALS	· CAD BY: TMS	5 D4	TE: 6/1/18
<b> </b>	APPROVED BY		ITE:
	313-390	316-390	319-390
	313-388	316-388	319-388
	313-386	316-386	319-386

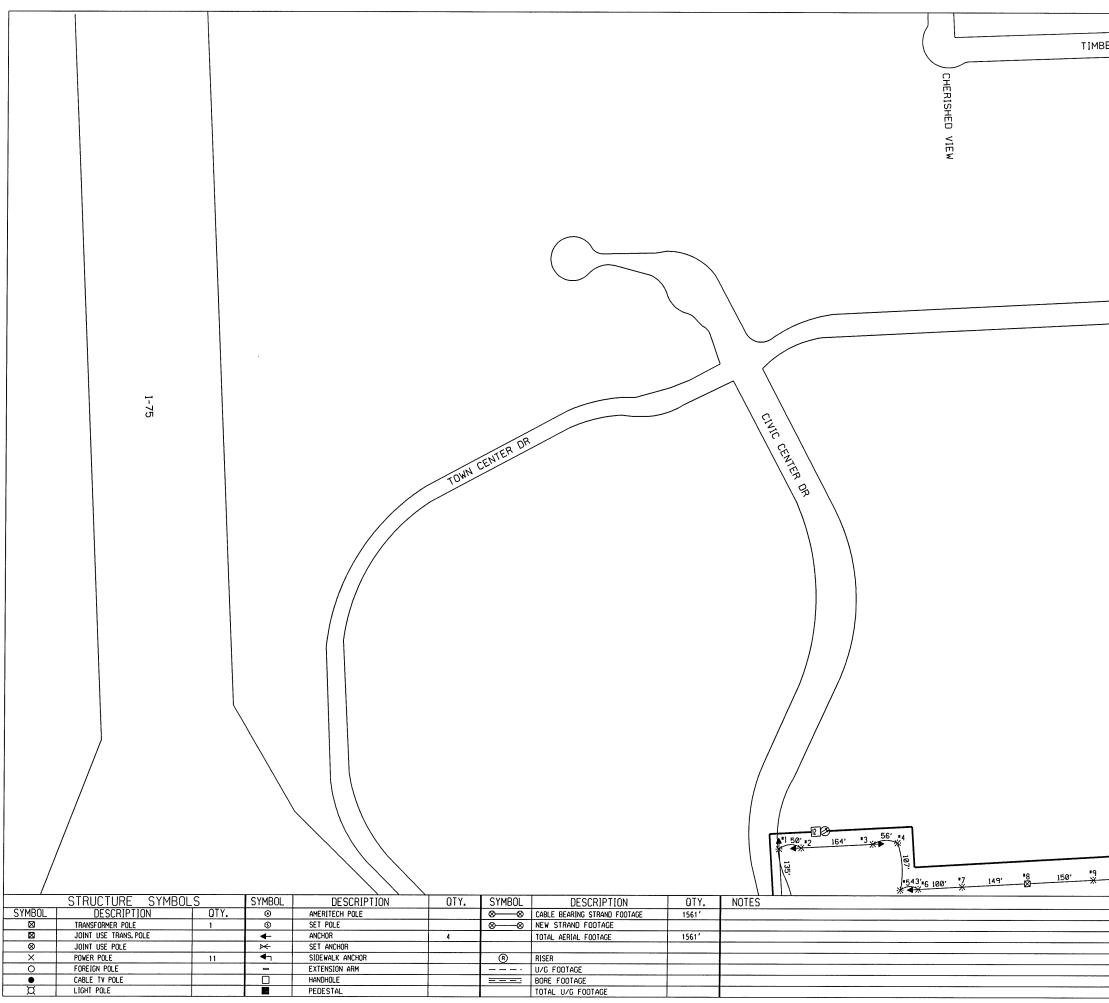


		BER SYM	BOLS
	SYMBOL		
RVIEW	60	FIBER COUN	T 12
		SPLICE POIN	IT
	$\infty$	STORAGE LO	190
		+	
	<b></b>		
			_
		1	-
		1	
		ļ	-
		<u> </u>	+
	<b></b>	1	1
			_
	<u> </u>	l	
	AE	RIAL FIE	ER
	LINE	DESCRIP.	OTY.
		12CT	1561
			+
			+
			1
	<u> </u>		
		J/G FIBE	ĸ
	LINE	DESCRIP.	OTY.
			1
		·····	
	B		
		-	
	1		1
ł		1	
ł	···· ; u., u.,		
	TDOV		
		SCHOOL DIS	
		SCHOOL DIS	
	WIDE		
2 3	WIDE	AREA NET	
12 159/	WIDE Fibe	AREA NET	
147' "10 149' "11 153' "12 158'	WIDE Fibe	er Link, Inc.	
147' "10 149' "11 153' "12 158' X 149' X X X	WIDE Fibe Priduo - 667 CAD FILE: 3	er Link, Inc.	
147′ "10 149′ "11 153′ "12 158′ ※ ※ ※ ※	WIDE Fibe Philosoff CAD FILE: 3 SCALE: 1" • 2	er Link, Inc.	WORK
147' "10 149' "11 153' "12 158' X 0TY. REVISIONS DES	WIDE Fibe Fibe Fibe Fibe Fibe Fibe Fibe Fibe	er Link, Inc.	WORK 3120 E:
147. *10 149. *11 153. *12 158. X 0TY. REVISIONS DES DATE INITIALS CAD	WIDE Fibe Fibe Fibe Fibe Fibe Fibe Fibe Fibe	er Link, Inc.	WORK
147' "10 149' "11 153' "12 158' X 2158' OTY. REVISIONS DES DATE INITIALS CAU APP	WIDE Pribe Pri	AREA NET	WORK 3120 E: E: E: 6/1/18 E:
147' "10 149' "11 153' "12 158' X 2158' OTY. REVISIONS DES DATE INITIALS CAU APP	WIDE Pribe Pri	er Link, Inc.	WORK
147'         *10         149'         *11         153'         *12         158'           0TY.         REVISIONS         DES           DATE         INITIALS         CAL           311         311	WIDE Fibe Proto-667 CAD FILE: 3 SCALE: I" - 2 SIGNED BY: D BY: TMS PROVED BY: 3-392	AREA NET	WORK
147'         *10         149'         *11         153'         *12         158'           0TY.         REVISIONS         DES           DATE         INITIALS         CAL           311         311	WIDE Fibe Proto-667 CAD FILE: 3 SCALE: I" - 2 SIGNED BY: D BY: TMS PROVED BY: 3-392	AREA NET	WORK 3120 E: E: E: 6/1/18 E:

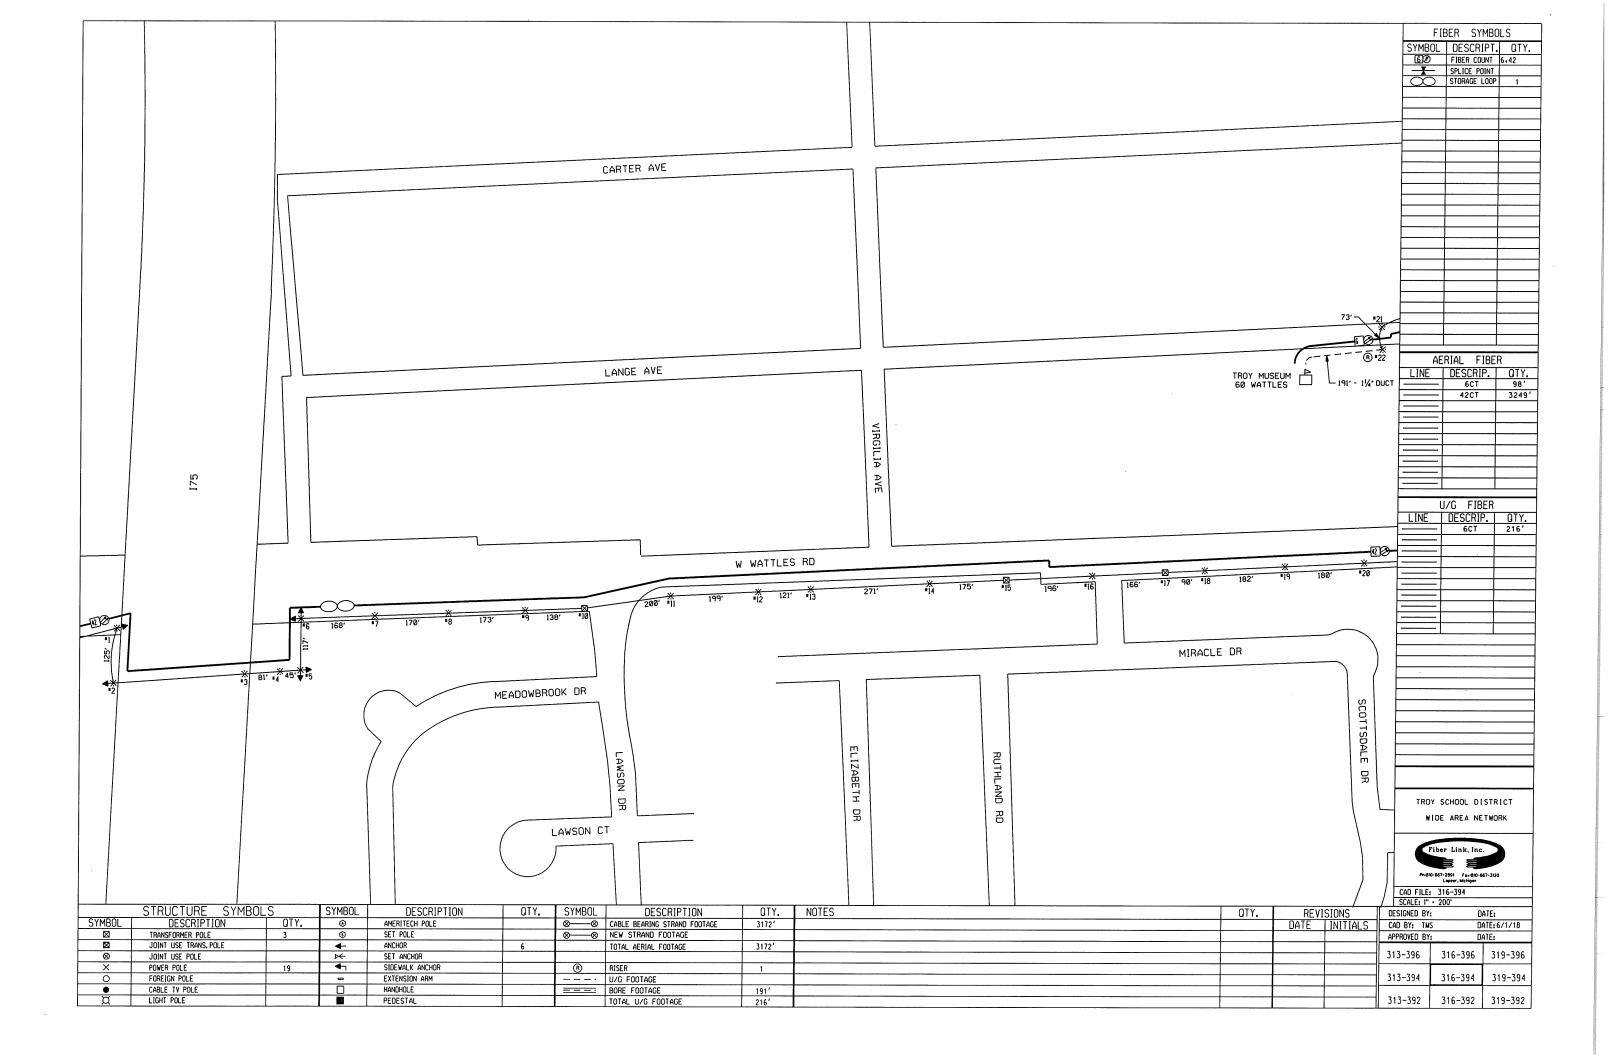


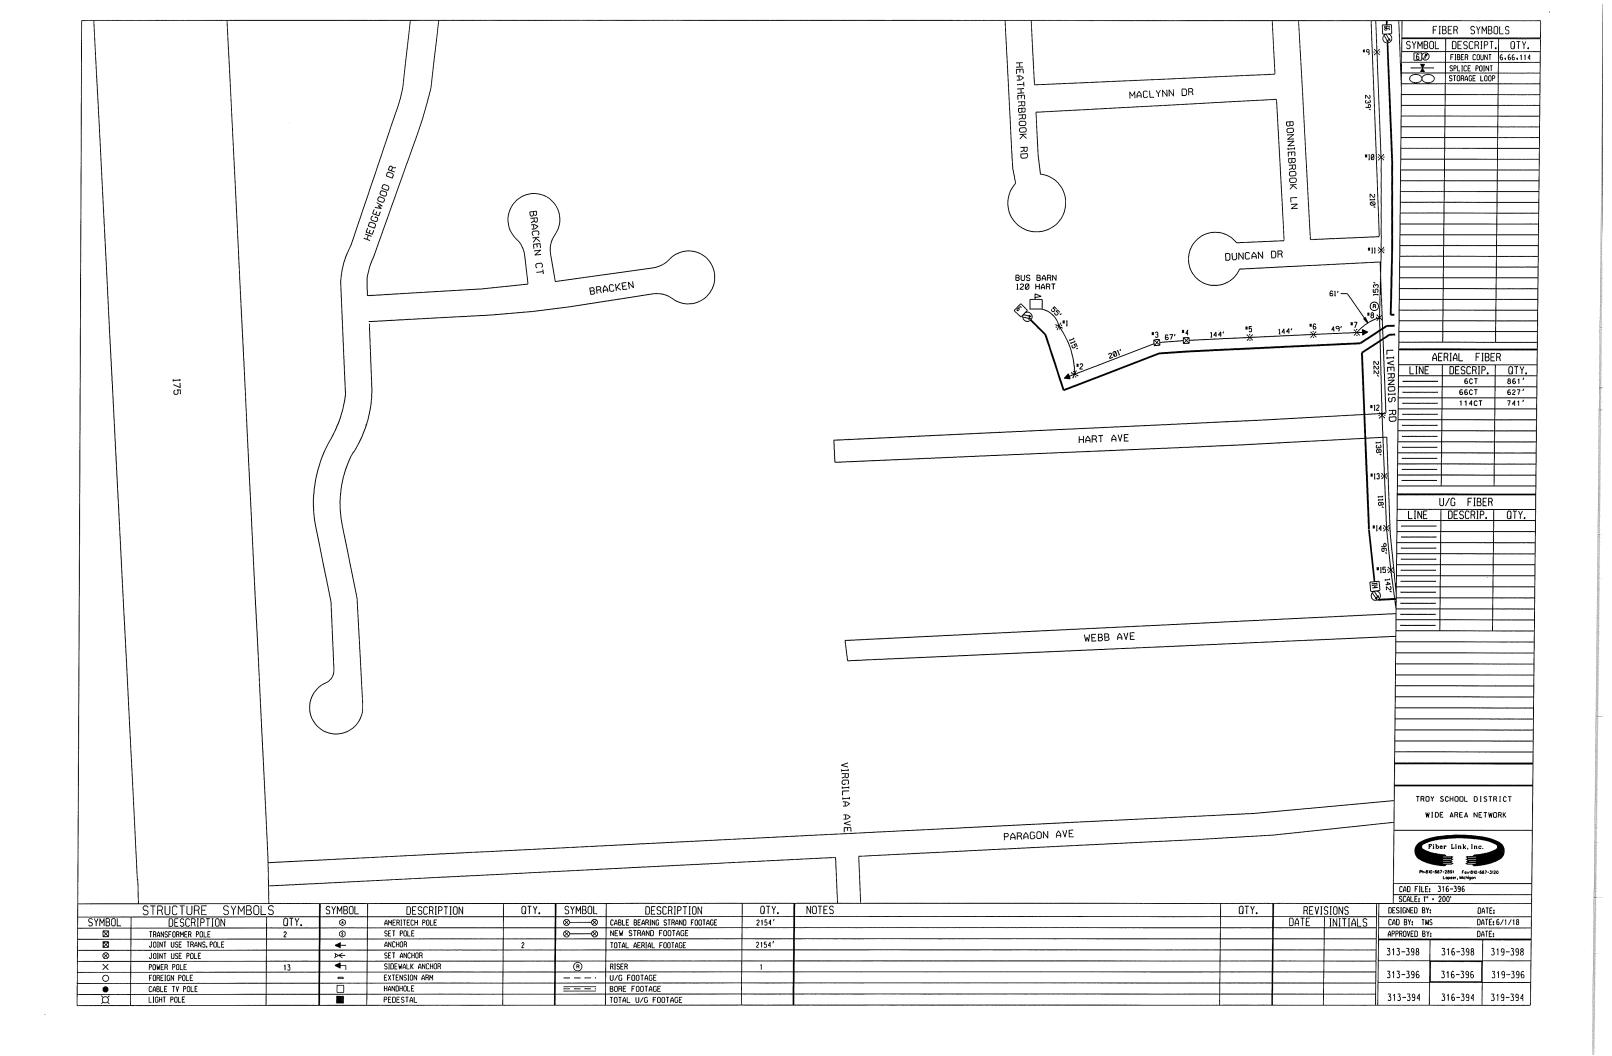

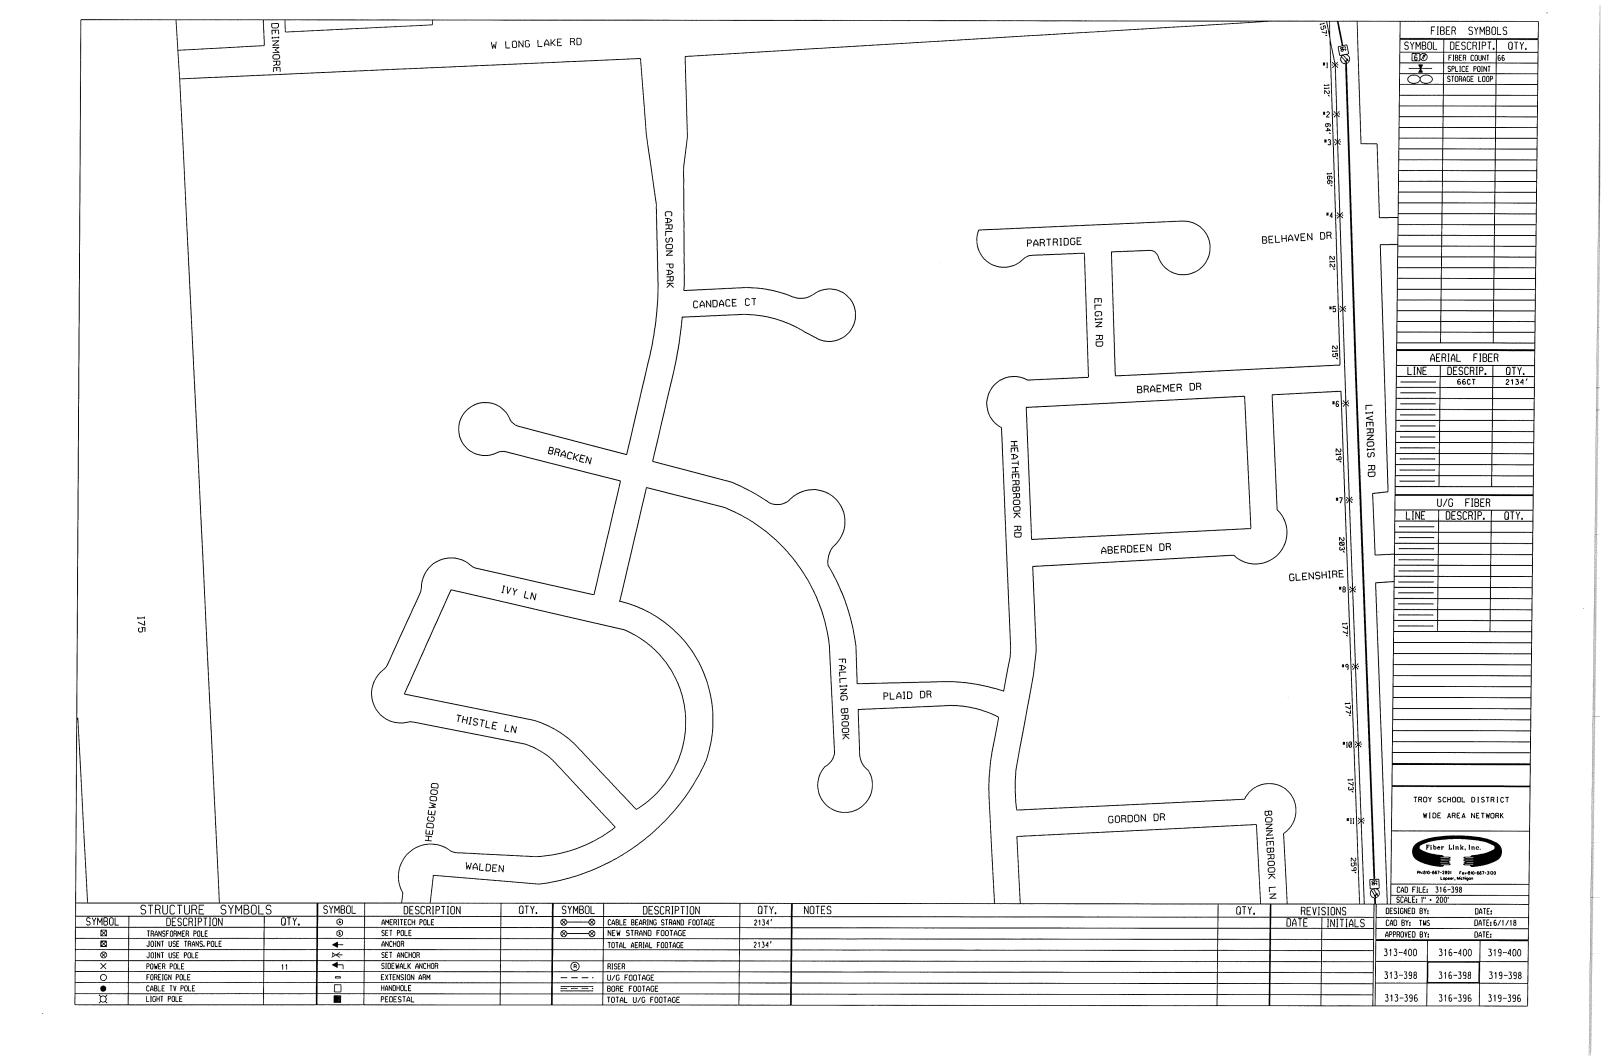

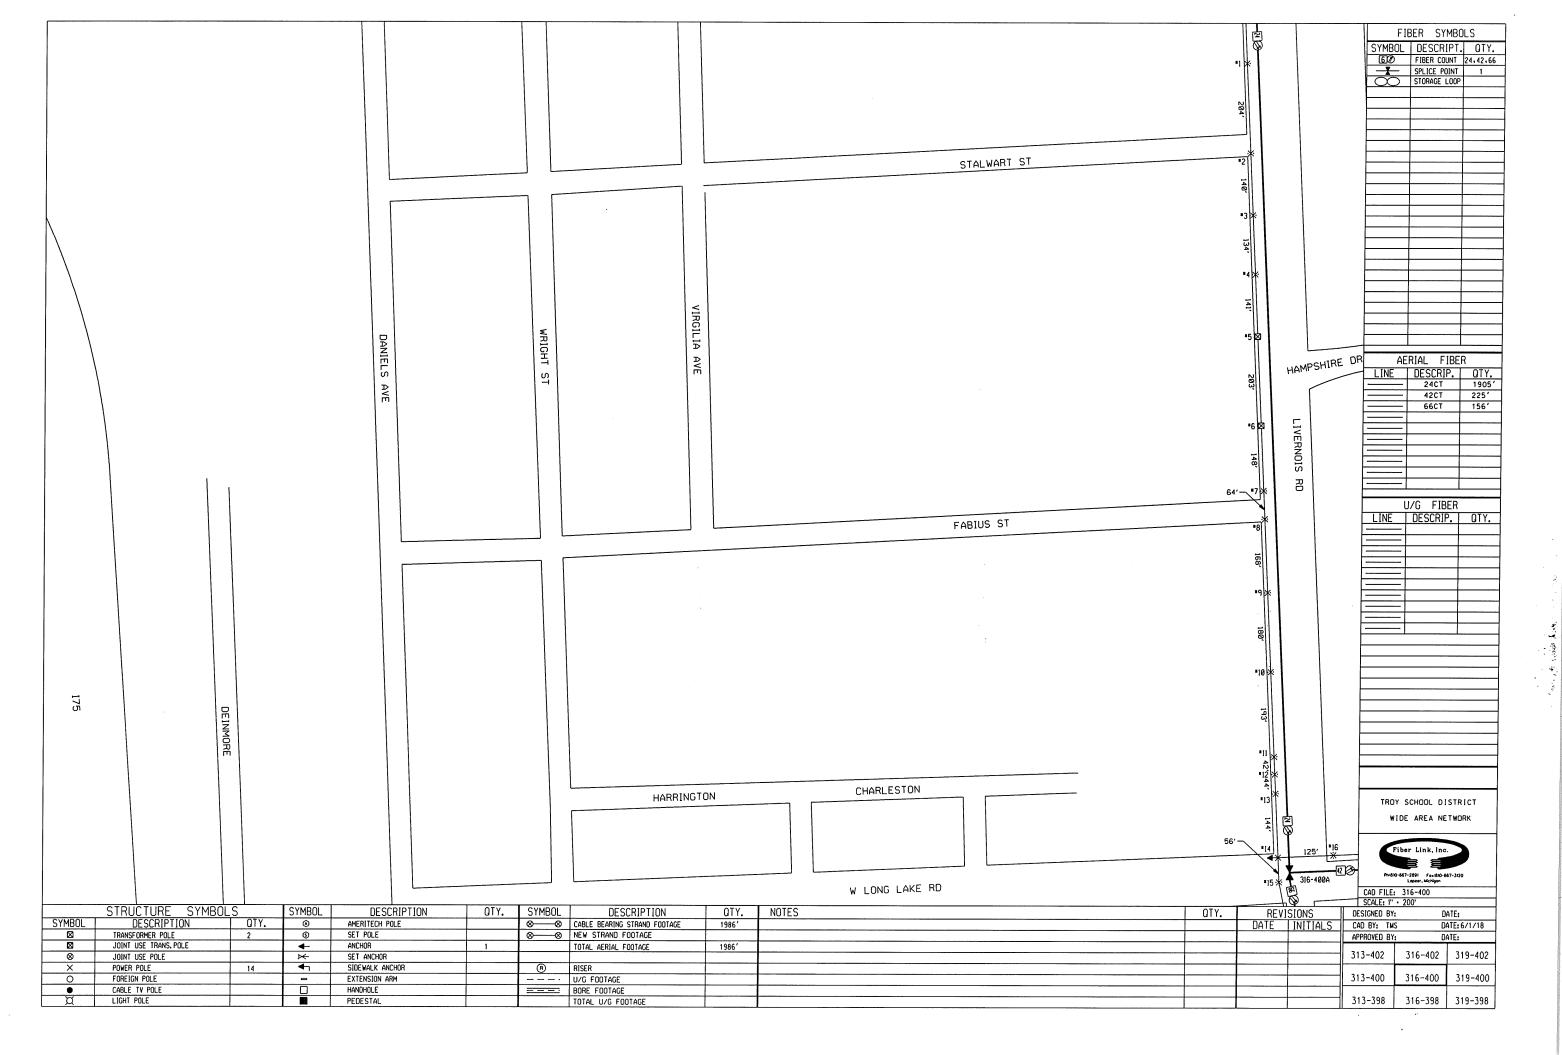



s interest a series .

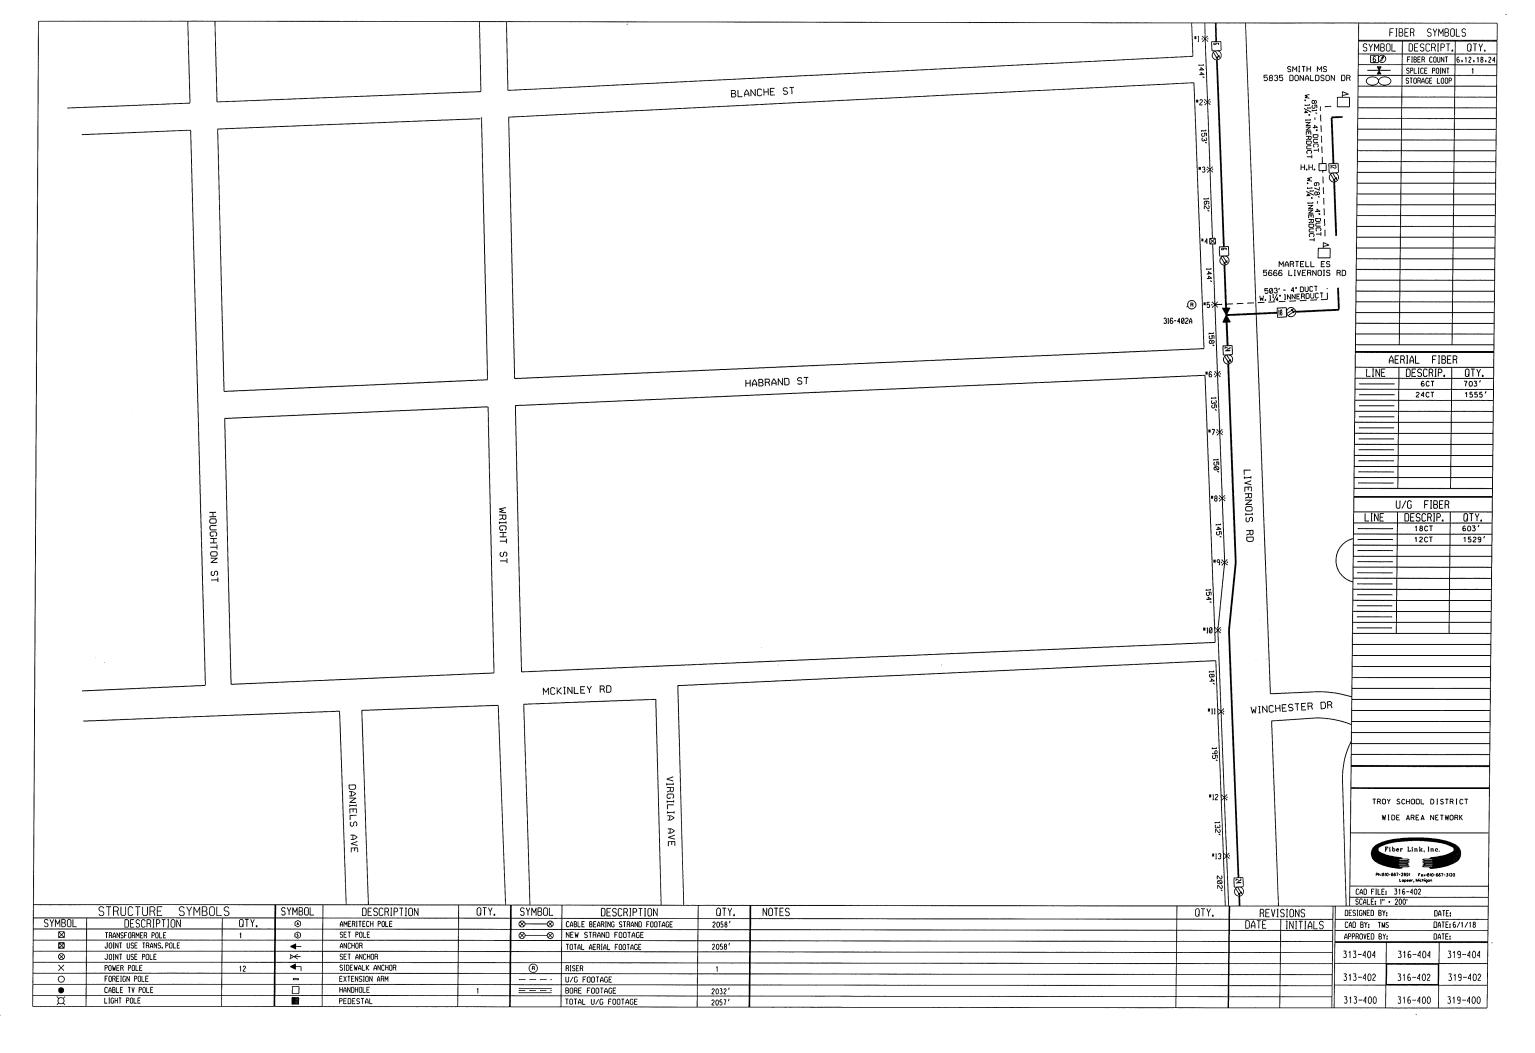


..


-

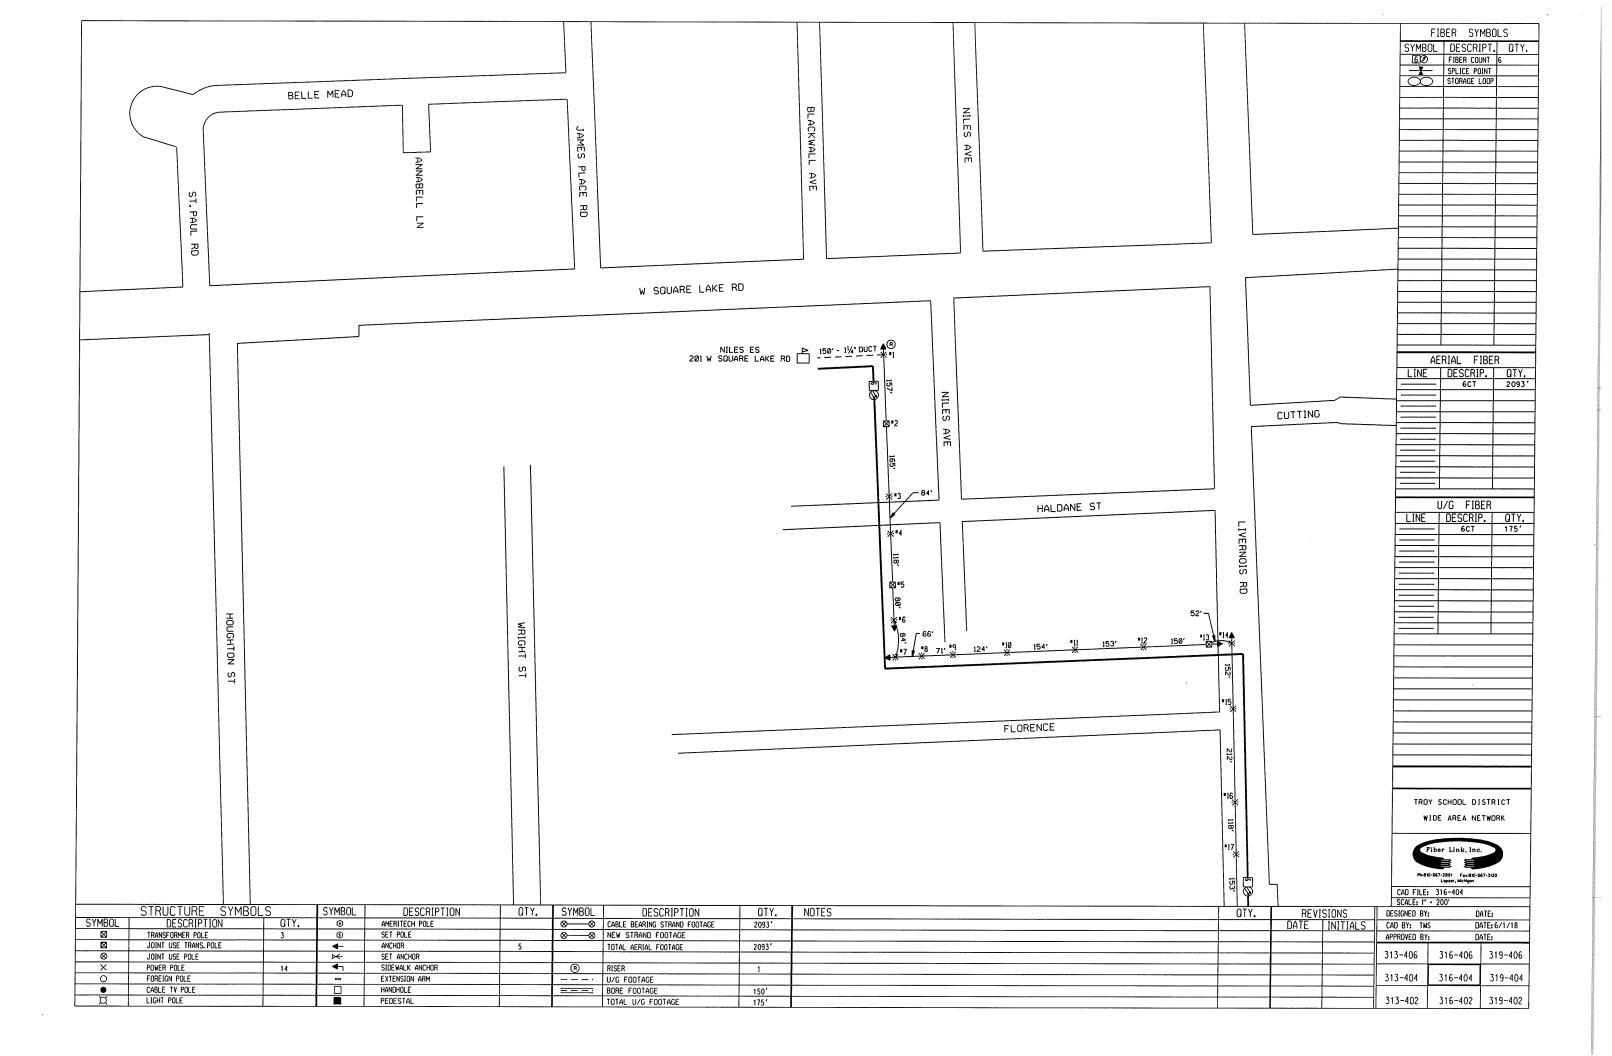


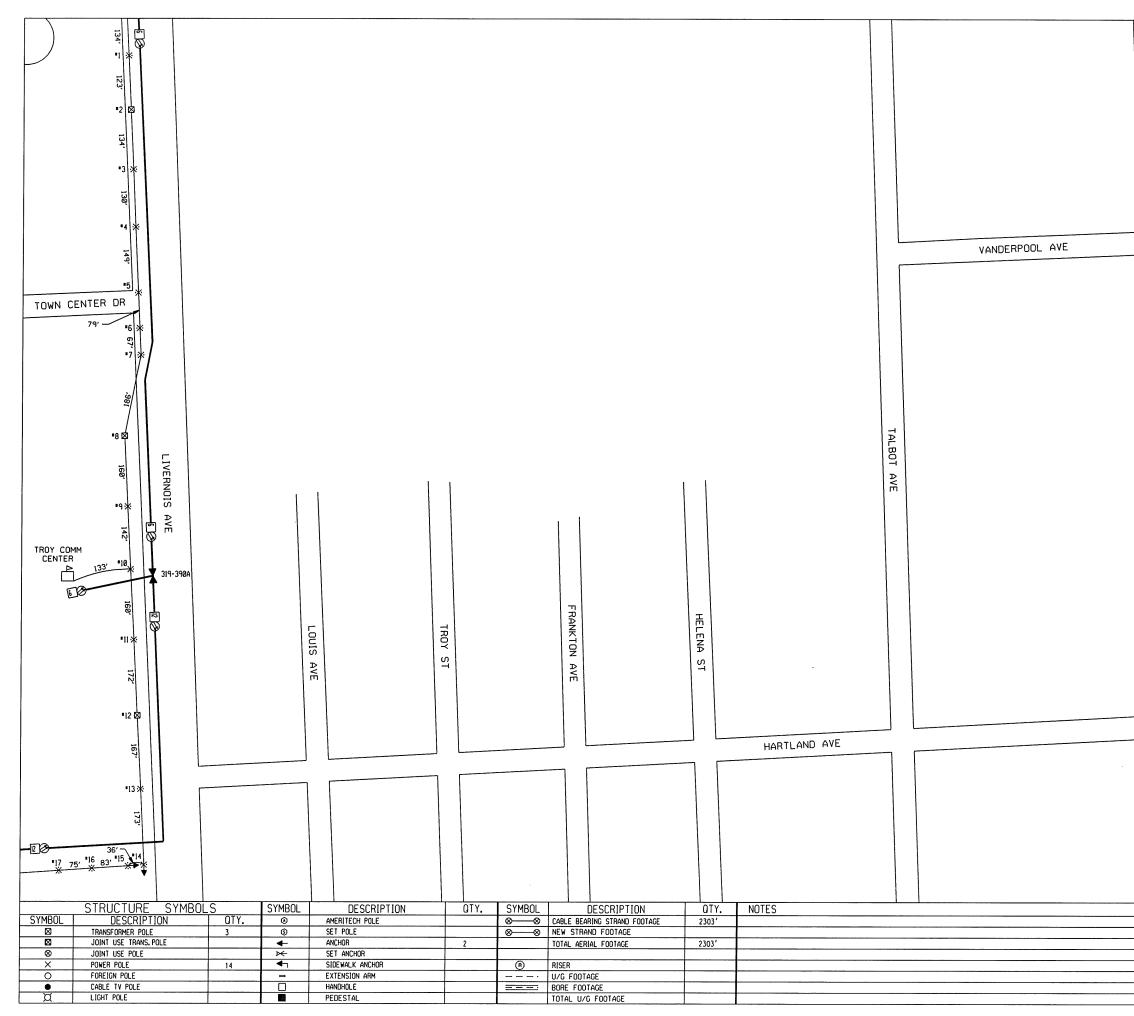


		ELLENBORD ST	SYMBO GIØ	FIBER SYI	PT. OTY. INT 6.12
] [					
			4 	AERIAL FI DESCRII - 6ct-w - 6ct-w - 12ct	233'
KILMER AVE			LINE	- - - - - - - U/G FIB DESCRIF	ER 2. OTY.
					· · · · · · · · · · · · · · · · · · ·
			WI	SCHOOL DI DE AREA NE	TWORK
	GSTON		Privation CAD FILE: SCALE: 1" •	200'	57-3120
OTY.	REVISIONS	CAD	BY: THS	Dŕ	ATE: ATE: 6/1/18
			-392	04 319-392	ATE: 322-392
			-390	319-390	322-390
		316	-388	319-388	322-388

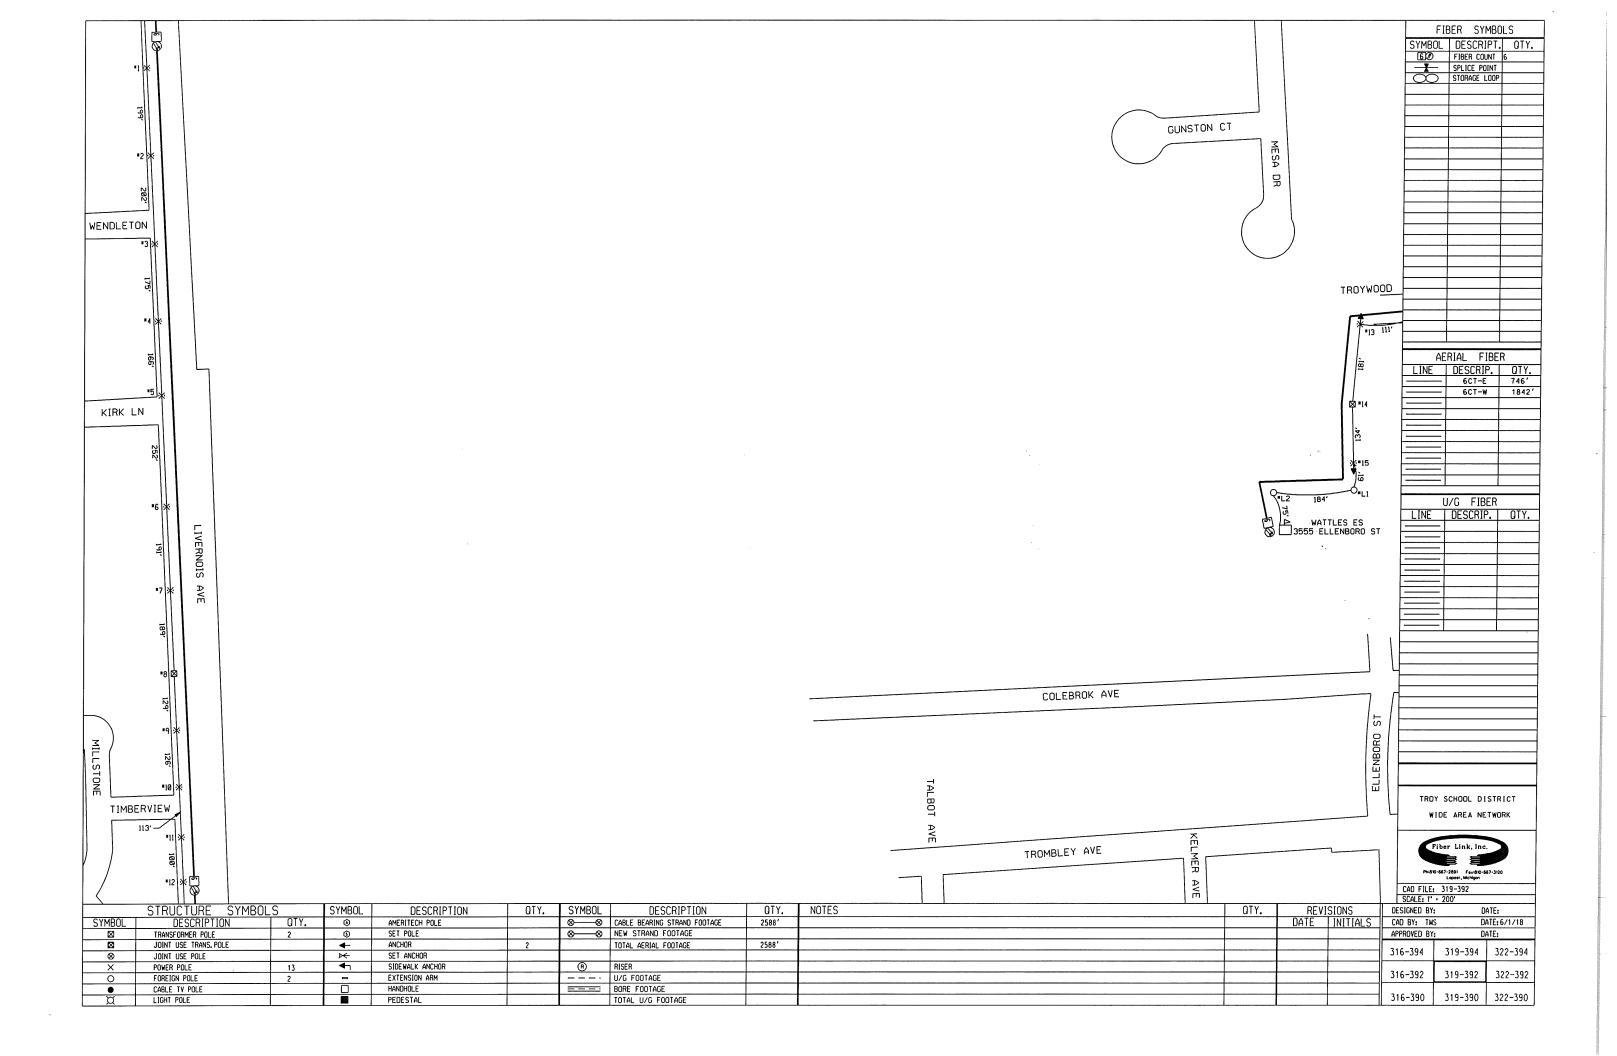


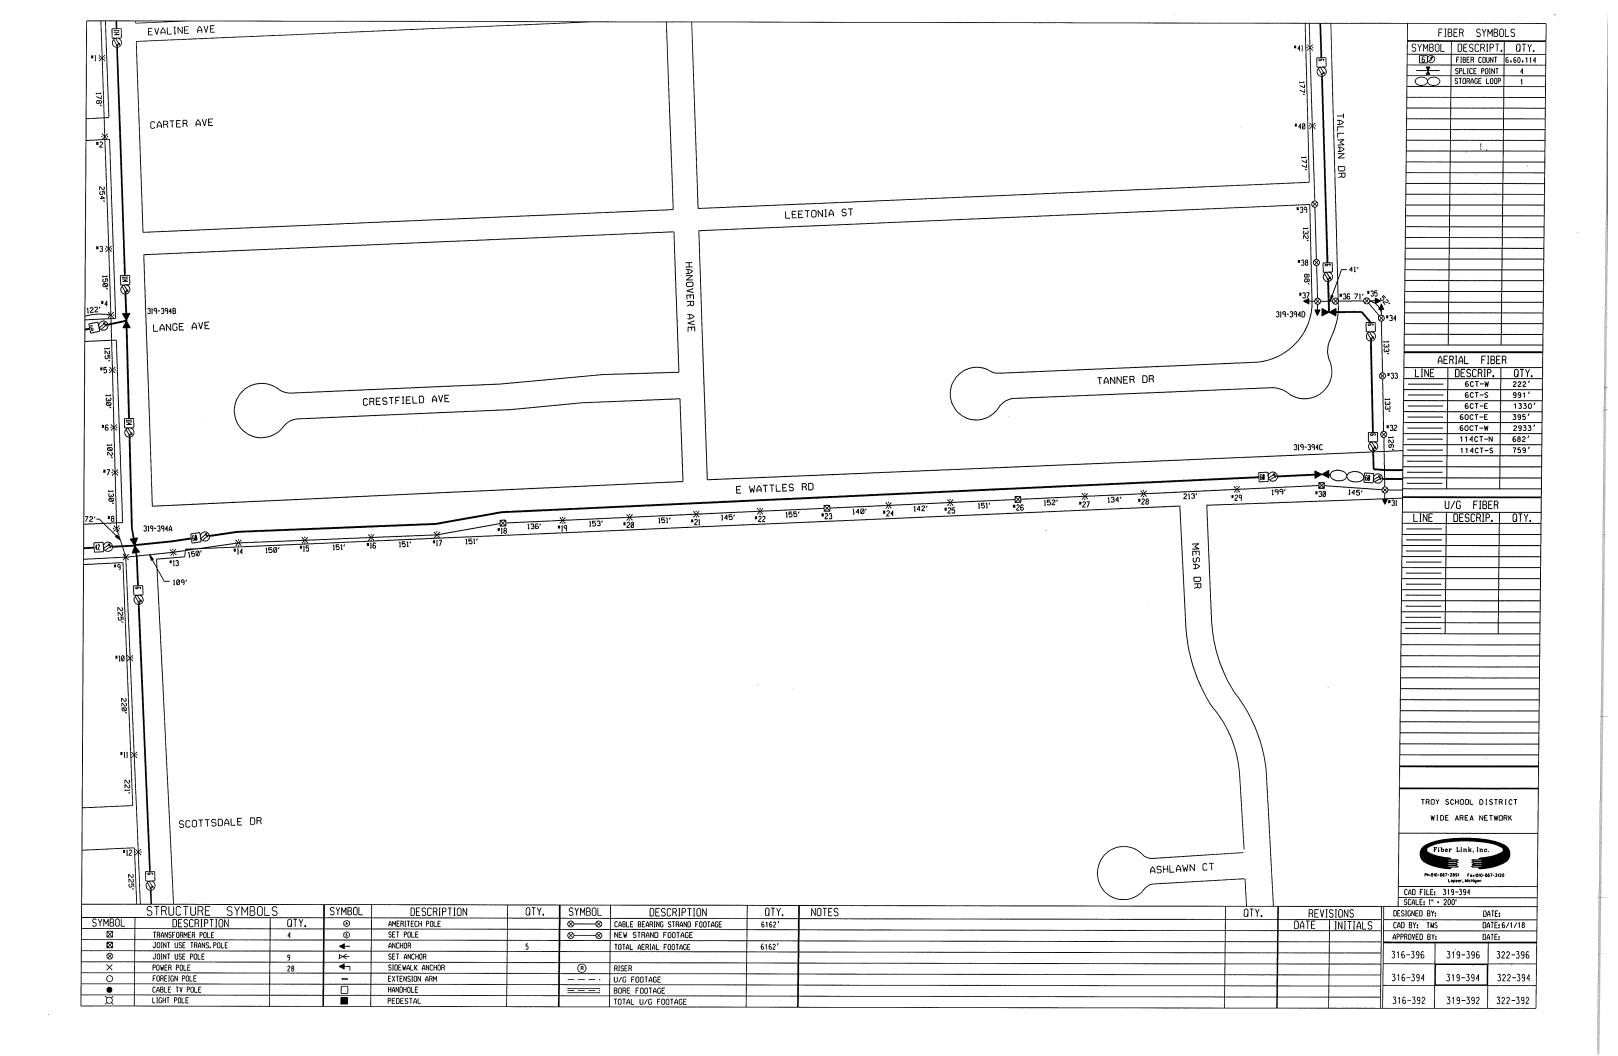

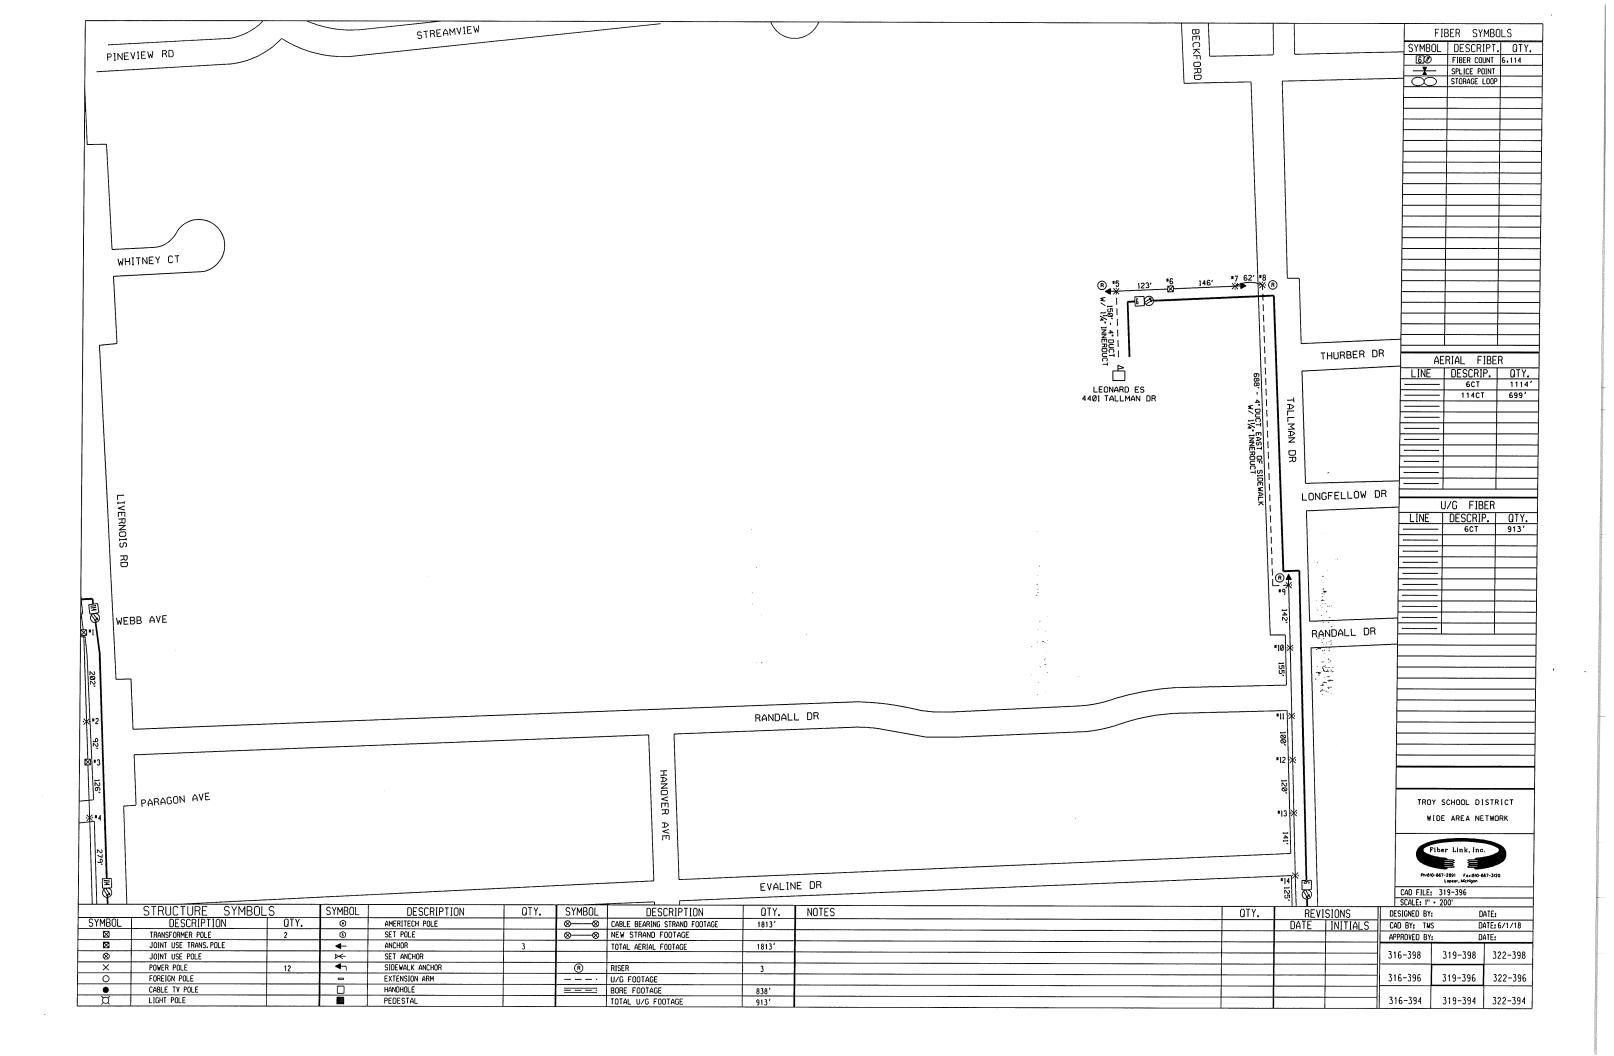


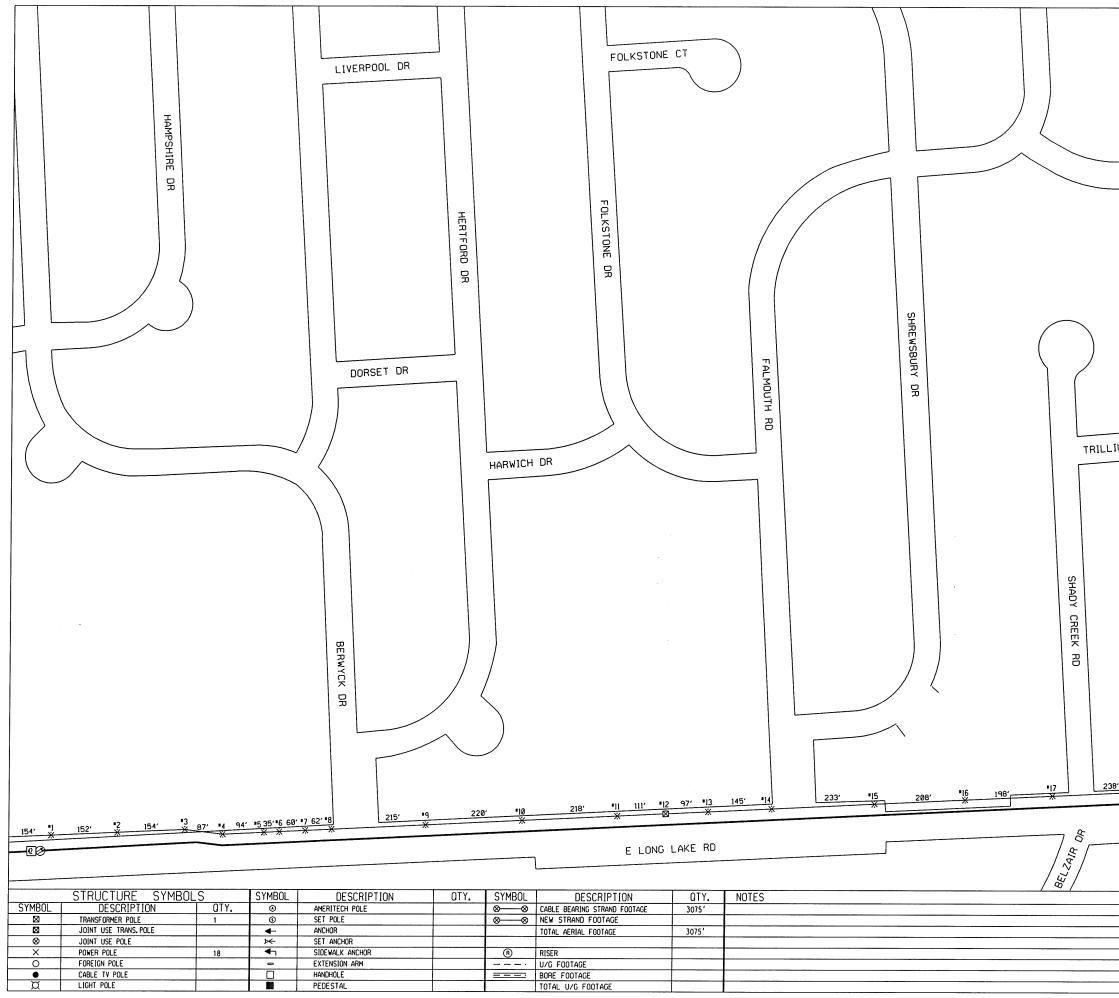


	Т		
	FI	BER SYMBO	
	SYMBOL	DESCRIPT	. OTY.
	60	FIBER COUNT	
	<u> </u>	SPLICE POINT	
	$\overline{\circ}$	STORAGE LOOP	1
			<b> </b>
TRINWAY RD			<u> </u>
		· · · · ·	
		· · · · · · · · · · · · · · · · · · ·	
	AE	RIAL FIBE	R
	LINE	DESCRIP.	OTY.
		42CT	3075
$\langle \rangle$			
( )			
M RD			
		J/G FIBER	
	LINE	DESCRIP.	OTY.
		- to	
· ·			
· 1			
		•	
· · · · ·			
•19 <u>156'</u>			
		SCHOOL DISTR	RICT
228'		SCHOOL DISTR	
		SCHOOL DISTR	
	WIDE	AREA NETWO	
<u>•18 238′ ¥</u> €}2	WIDE Fibe Pr-50-50-567 CAD FILE: 3 SCALE: I" • 2	AREA NETWO	0RK
•18 238' * @2	WIDE Probu-667 CAD FILE: 3 SCALE: I" • 2 DESIGNED BY:	r Link, Inc.	0 0
*18 <u>238′</u> <del>X</del> ℓ2 X 	WIDE Fibe Pr-30-607 CAD FILE: 3 SCALE: 1" • 2 DESIGNED BY: CAD BY: TMS	r Link, Inc. r Link, Inc. 2891 (************************************	0 0 6/1/18
•18 238' ¥ @2	WIDE Probu-667 CAD FILE: 3 SCALE: I" • 2 DESIGNED BY:	r Link, Inc.	0 0 6/1/18

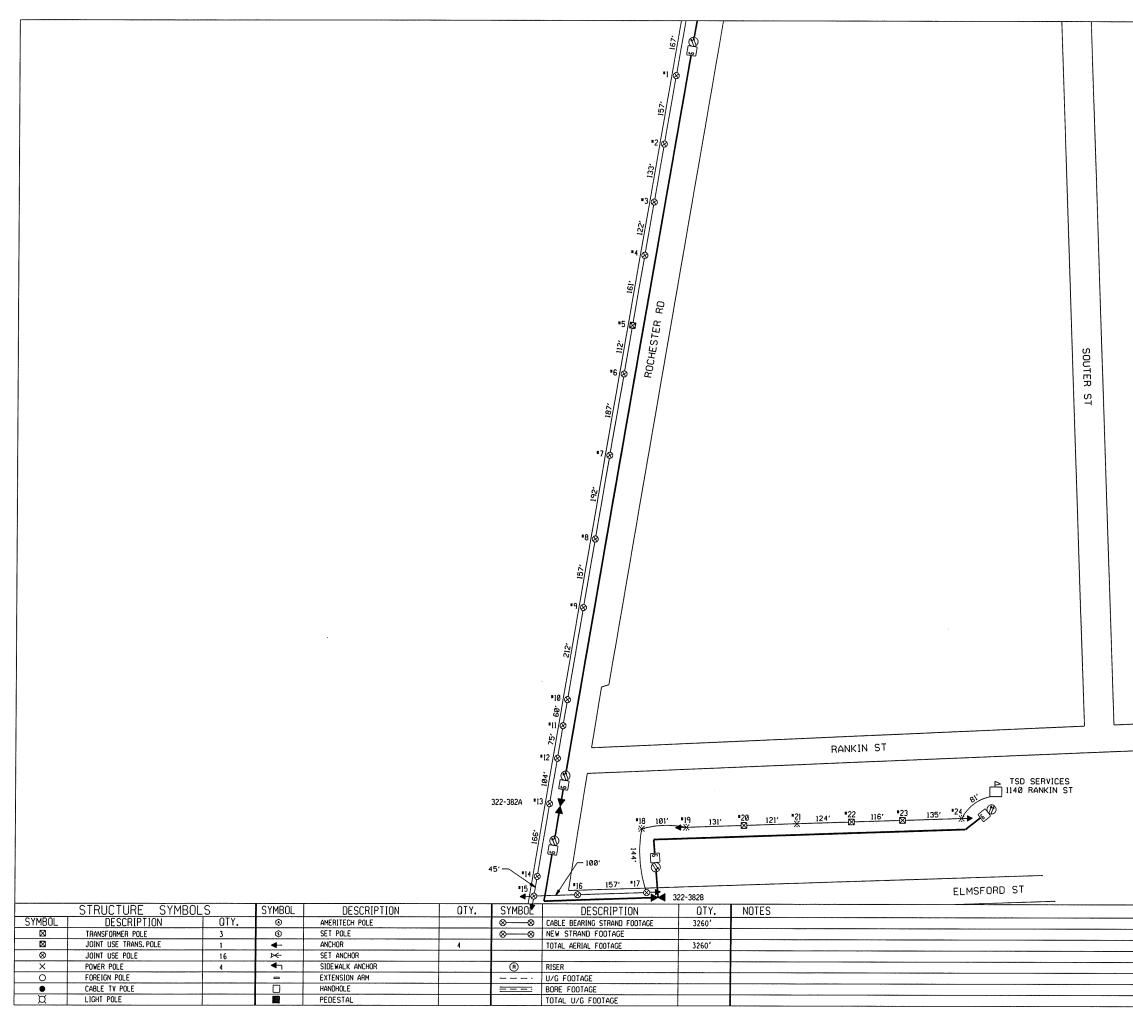


			-			
					FIBER SY	MBOLS
				SYMB		IPT. OTY.
				51110	FIBER COL	
					- SPLICE PC	
				â	STORAGE I	LOOP
			1			
			ŀ			
			ŀ			
			ŀ			
			ŀ			
			F			
			Ē			
			Ĺ			
			F	_		
			Ļ		AERIAL F	
			ŀ	LINE		P. OTY.
			┝		— <u>6</u> CT	3660'
			⊦		_	
			ŀ		_	
			ŀ			
			F		_	
			F		_	
			Г		-	
					_	
					-	
			F			
			L		U/G FIB	ER
			Ļ	LINE	DESCRIF	P. OTY.
			Ŀ		-	
			Ľ		-	
			Ľ			
			E			
			H			
			E		_	
			-		_	
			- F		_	
			- F.		-	
			F	**********		
			H			
			⊢			
				700		CTRICT
					Y SCHOOL DI	
				W	IDE AREA NE	TWORK
			⊢			
					iber Link, Inc	
				-		42-1120
					0-667-2891 Fox:810-8 Lapeer, Michigan	
			C	AD FILE	322-382	
	05.0	CTONC 1		CALE: 1"		ATE
OTY.		SIONS		GNED BY		ATE:
	UAIL	INITIALS		BY: TM		ATE: 6/1/18
		<u>  </u>		OVED BY		ATE:
	1		319	-384	322-384	325-384
	1					
	1		319	-382	322-382	325-382
				7.6.6	200.000	705
	1		319	-300	322-380	325-380
		L		100		

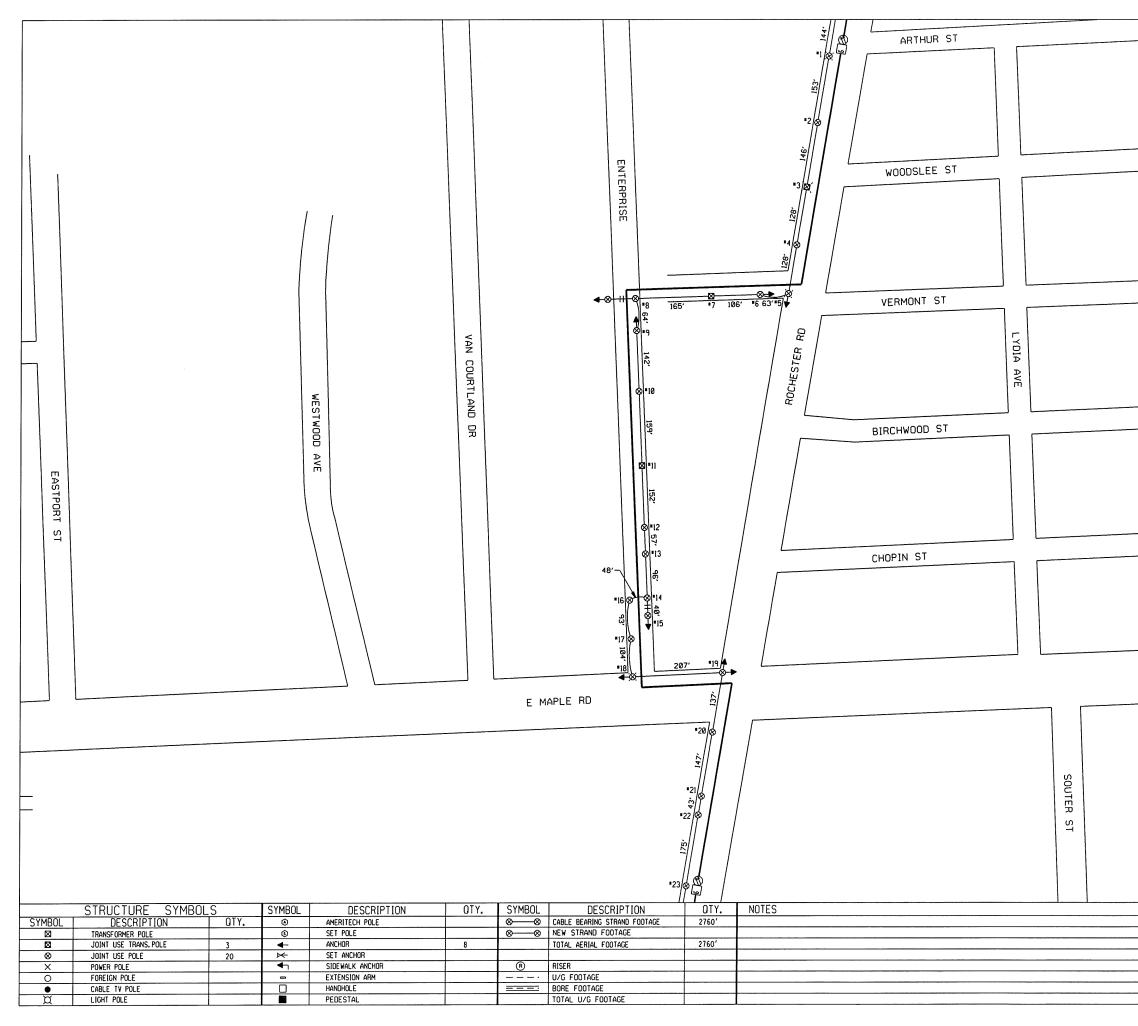


 				F	IBER SYN	MBOLS
 				SYMBO		PT. OTY.
				60	FIBER COU	
					SPLICE PO STORAGE L	
					L STONHUE L	
			ļ			
			ľ	A	ERIAL FI	BER
			ŀ	LINE	DESCRIP	P. OTY.
			ļ		- 6CT	2657'
			ŀ		-	
	-		ŀ		-	
 			l		-	
			ŀ		-	
			ŀ			
			ŀ		•	
			ļ		•	
			ŀ		U/G FIB	FR
			ŀ	LINE	DESCRIP	2. OTY.
		_	ŀ			
	-		ļ		•	
 			┝			
			ŀ			+
			E			
			F		-	
			F			
			ŀ			•
			Ē			
 			_			1 s.
			⊢			
			F			
 			⊢			
			┣			
			E			
			F			
			H			
			F		6 CU 001 0.	STRICT
					SCHOOL DI	
				WI	DE AREA NE	TWORK
			F			
				Fi	ber Link, Inc.	
				Ph:810+(	67-2891 Fax:810-66 Lapeer, Michigon	57-3120
				CAD FILE:	322-384	
 OTY.	DEVIC			SCALE: 1" ·		
 UT.	REVIS DATE	INITIALS		IGNED BY: BY: TMS		ATE: ATE: 6/1/18
	UNIL	INT THES		ROVED BY:		ATE:
				-386		
 			1 319	-300	322-386	325-386
 			319	-384	322-384	325-384
			319	9-382	322-382	325-382

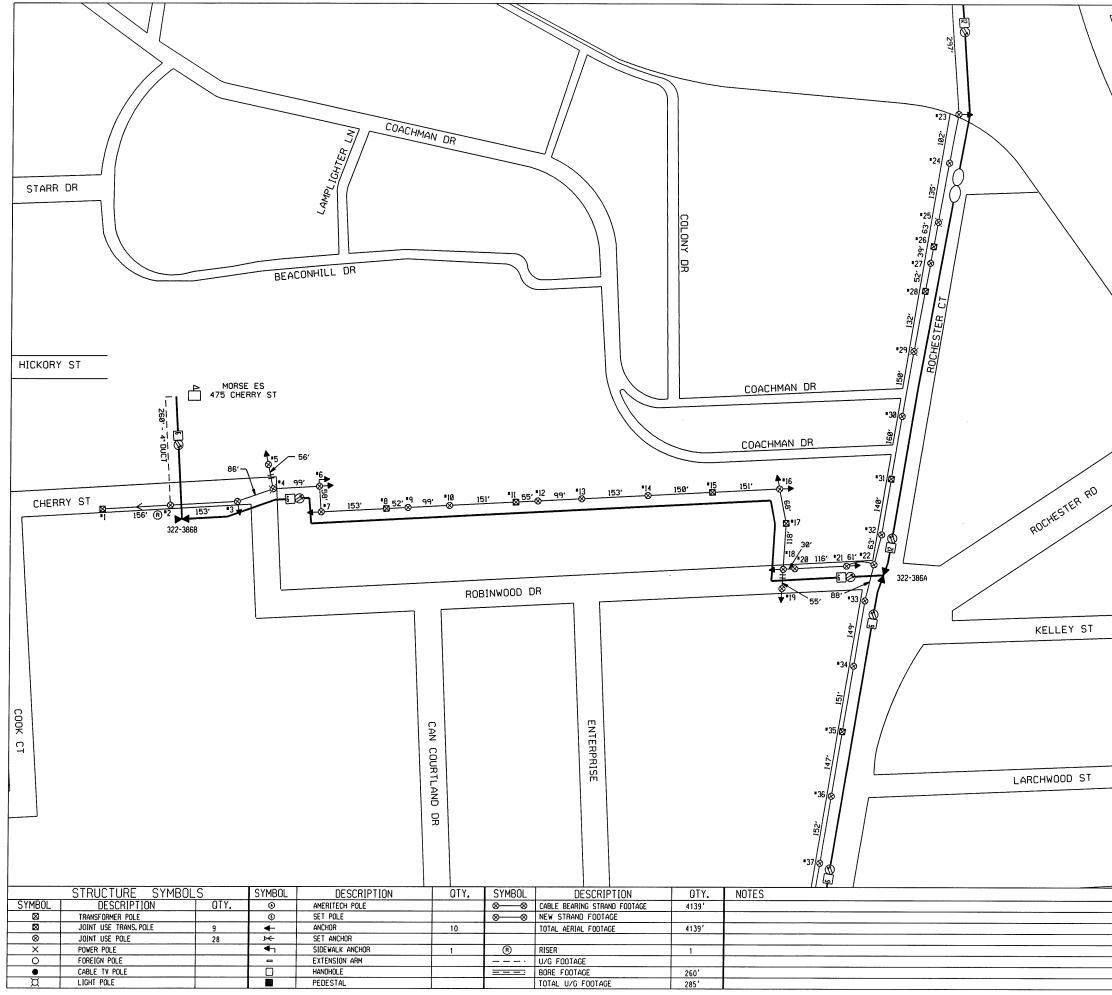


			IBER SYM	BOLS
NAUGHTON RD		SYMBO		
		60	FIBER COUN	T 6.12
			SPLICE POIN	IT 2
$\backslash$			STORAGE LO	OP 1
$\setminus$				
$\langle \rangle$				
$\backslash $				+
$\langle \tilde{z} \rangle$				
ACACIA				
$\backslash$	WHEATON AVE			_
PTE \	$\backslash$			
1507	$\backslash$			
<i>v</i> <i>₅</i> , ∖	$\backslash$			
STEPHENSON HWY				+
$\backslash$	PIEDMONT A	VE		
$\backslash$				
$\backslash$	$\backslash$		erial fie	NFR
$\backslash$	$\backslash$	LINE	DESCRIP	
)	$\backslash$		- 6CT-S	787'
	$\backslash$		- 6CT-W - 12CT	2052' 1583'
/	$\backslash$		-	
			-	
	$\wedge$		-	
/ /	$\sum$		-	
	$\backslash$		-	
	$\backslash$		U/G FIBE	R
	$\backslash$	LINE	DESCRIP.	
	$\backslash$		- 6CT	385'
	$\backslash$		•	
	$\backslash$			
	$\backslash$		·	
		$\searrow = =$	•	
			•	
				·
		TROY	SCHOOL DIS	TRICT
		WI	DE AREA NET	WORK
		Fi	ber Link, Inc.	
			567-2891 Fax:810-667- Lapeer, Michigon	3120
ARTHUR ST		CAD FILE: SCALE: 1" •	322-386	
OTY.	REVISIONS	DESIGNED BY:	DAT	
	DATE INITIALS	CAD BY: THS		E: 6/1/18
		APPROVED BY:	DAT	
		319-388	322-388	325-388
		319-386	322-386	325-386
		F		
		319-384	322-384	325-384

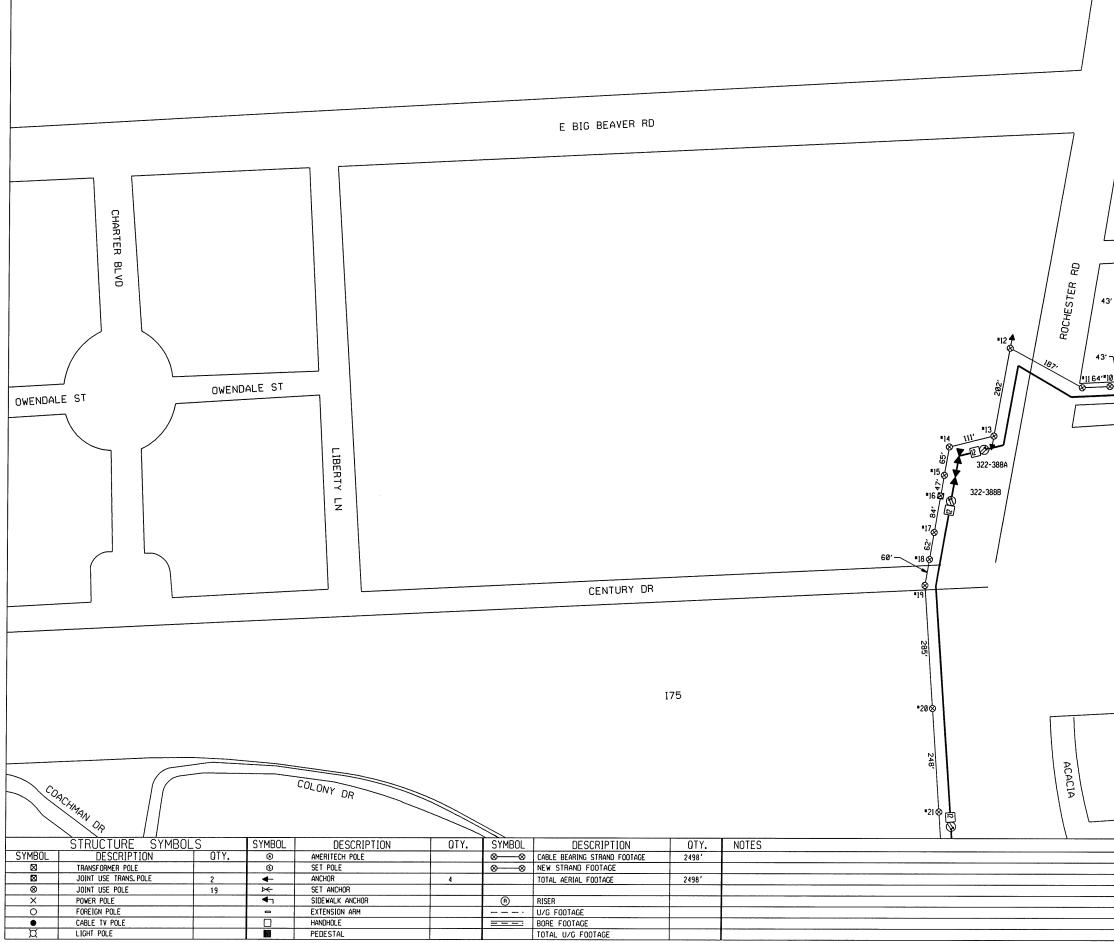

			FIBER SY	MBOLS
<u></u>		SYMBC	and the second se	
/ "\$	H	60	FIBER COL	UNT 12
/ ,/ <b>/</b>		-1	- SPLICE PC	DINT 2
j ŝ/		$\infty$	) STORAGE I	_00P 1
*2 <b>5</b> 7	⊢			
<del>````````````````````````````````</del>				
//				
à/ /				
<i>۳/ ۱</i>	F		_	
//	-			
	F			
*3¢				
· · · · · · · · · · · · · · · · · · ·	F			
]	$\vdash$			
/ ··4 & /				
/				
145				
J.				
HENRIETTA AVE				
HENRIETTA AVE				
il i i i i i i i i i i i i i i i i i i	$\vdash$			
je j	F			
			AERIAL F	IBER
	-	LINE	DESCRI	
178	_		- 12CT	3048'
~~~~~~~~~~~~~~~~~~~~~~~~~~~~~~~~~~~~~~	Ξ		-	
<u>Ч</u> Д				_
	H			
			-	
OWENDALE AVE				
	[		-	
			-	
			-1	
	$\vdash$		U/G FIB	FR
	$\vdash$	INE	DESCRI	
	=		-	
	_		-	
	-		-	
			-	
	-			
			-	_
			-	
			-1	
	$\vdash$			
			,,,,,,,,,,,,	
	-			
		TROY	SCHOOL DI	STRICT
			DE AREA NE	
		WI	UC AREA NE	
		_		<u> </u>
		Fi	iber Link, Inc	
		Ph:810	-667-2891 Fex:810-6 Lopeer, Michigon	67-3120
NAUGHTON RD	CAD	FILE:	322-388	
	SCA	LE: 1" ·	200'	
OTY. REVISIONS	DESIGN	ED BY:	D	ATE:
DATE INITIALS		TMS		ATE: 6/1/18
	APPROV	ED BY:	Di	ATE:
	319-3	90	322-390	325-390
	319-3	88	322-388	325-388
	740 7		700 700	705 700
	319-3	86	322-386	325-386

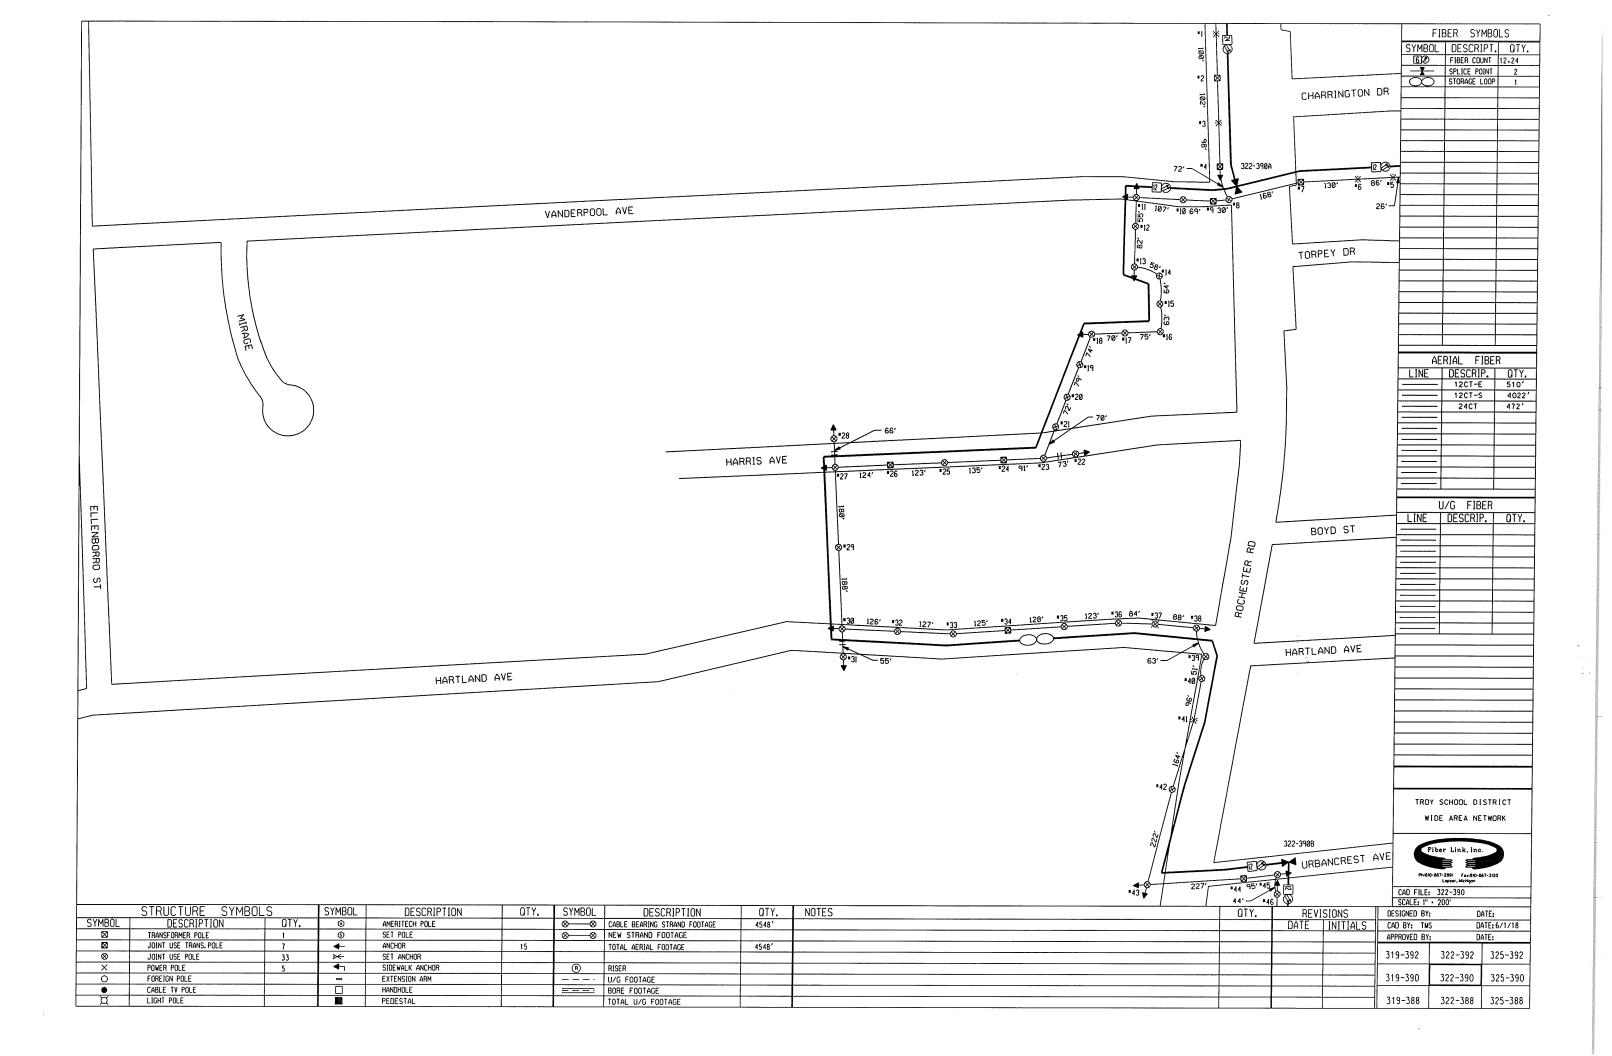


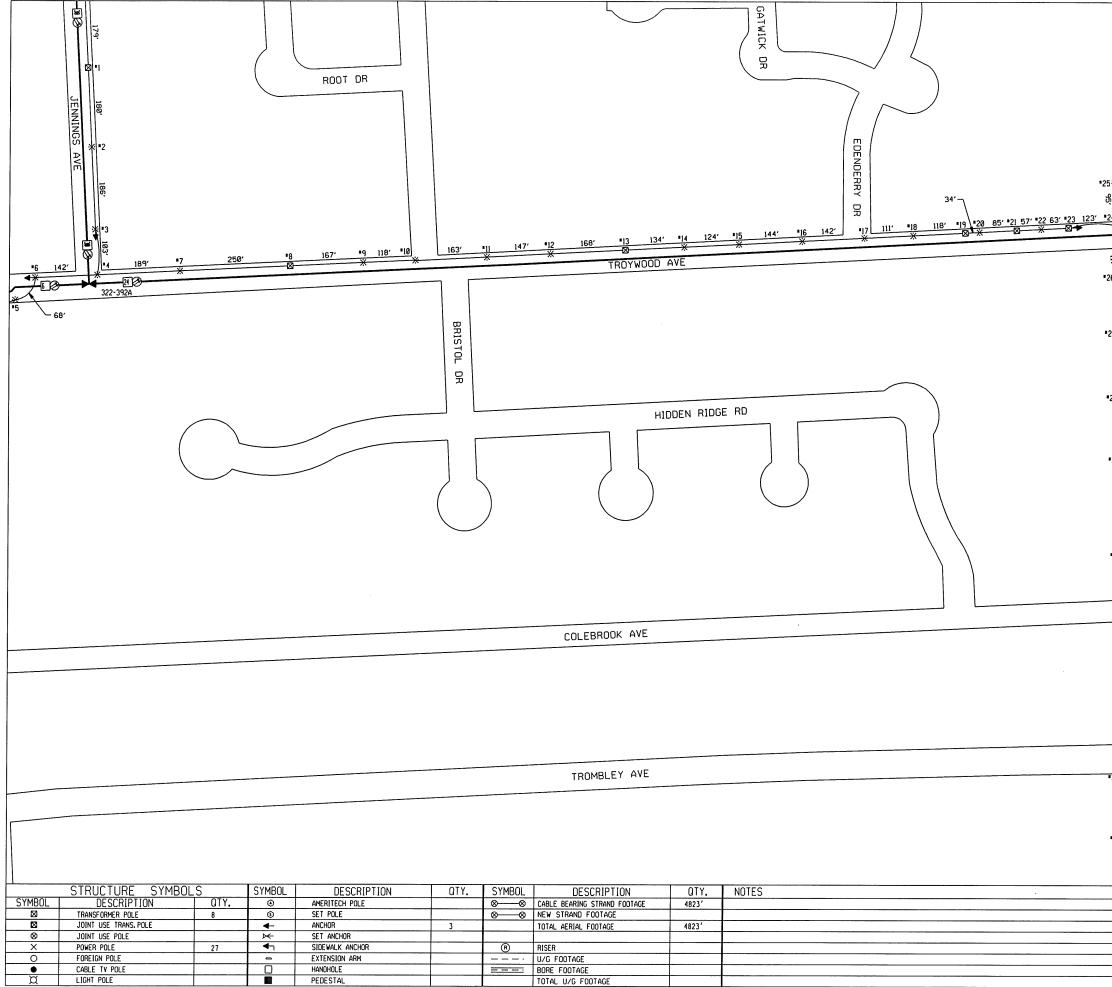


					FIBER SY	
				SYMBC	DE DESCRI	PT. QTY. JNT 6.24.30
					- SPLICE PC	JNI 16+24+30
				$\hat{\mathbf{x}}$	STORAGE I	.00P
5米						
સં						
***						
	BISHOP	UR		┤		
117						
26*						
128'	1					
L, <b> </b>					T	
27 🛱					AERIAL F	IBER
				LINE	DESCRI	P. OTY.
146					- 6CT	310'
~~					- 24CT	3970'
					- <u>30CT</u>	748'
*28*					_	
					-	
- 독이 문 문					-	
I ST					_	
•29米 · · · · · · · · · · · · · · · · · · ·					-	
141' ROCHESTER RU						
	·				U/G FIB	
217				LINE	DESCRIF	P. OTY.
7					-	
					-	
					-	
30 🖾					-	
97					-	
					-	
-31					-	
140'						
•32 * _						
128						
•33 🔆						
128'						
					-	
•34] *				<u> </u>		
-34				TROY	SCHOOL DI	STRICT
154				WI	DE AREA NE	TWORK
Ă,						
			(	F	iber Link, Inc	
•35 🔆						
				Ph:810	-667-2891 Fax:810-6 Lopeer, Michigon	87-3120
137'				CAD FILE:		
	<del></del>			SCALE: 1"	· 200'	
0	TY.	REVISION		ESIGNED BY:		ATE:
		ATE INIT		AD BY: TMS PPROVED BY:		ATE: 6/1/18 ATE:
			3	19-394	322-394	325-394
			3	19-392	322-392	325-392
			3	19-390	322-390	325-390




									01115			MBO	
									SYMB		DESCRI FIBER COL		QTY. 6.24.30.60
										_	SPLICE PO		1
									$\overline{\alpha}$	$\geq$	STORAGE L		
	L		M	AYA	СТ								
							$\overline{}$		/				
											RIAL FI		1
									LINE		DESCRI 6CT		OTY. 262'
											24CT 30CT		3054' 1017'
										=[	60CT		262'
	$\mathbf{F}$	292'		85'	* *20	131'	- <u>*</u> •21	129'		=			
	4							2109-				_	
											/G FIB	FR	
									LINE		DESCRIP		QTY.
ROCHESTER													
ĒST										=		-	
ER R						€. ₹				=			
8						• .				=			
					· .			/		-1			
								(					
					• •		,	$\langle$					
									TRO	Y S	CHOOL DI	STRI	ст
									w	IDE	AREA NE	TWOF	rk
										Fiber	Link, Inc.		
									Ph:81	0-667-2	891 Fex:810-66	67-3120	
									CAD FILE: SCALE: 1"	32	2-394		
			TY.		REN	ISION: INIT	S		SIGNED BY	:	Df	ATE:	/1/19
		-			UHIE		IHL2		D BY: TM: Proved by:	_		ATE:	/1/18
								31	9-396		22-396	32	5-396
						-		31	9-394	3	22-394	32	5-394
		1						31	9-392	3	22-392	32	5-392

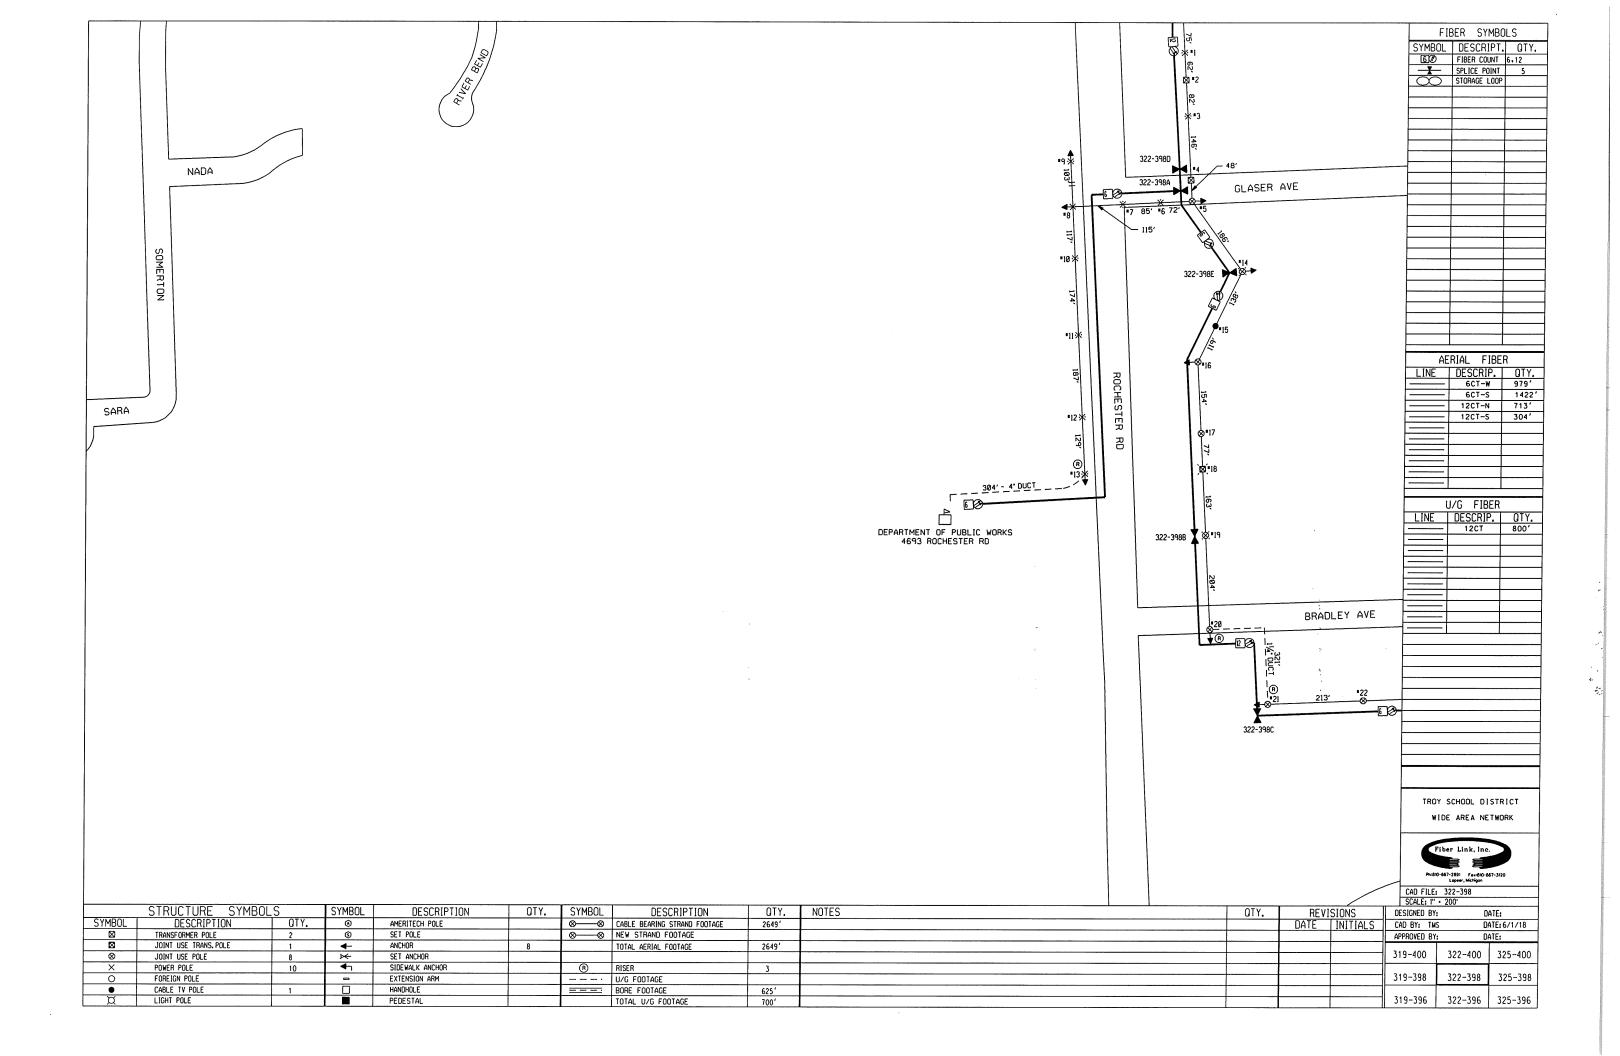

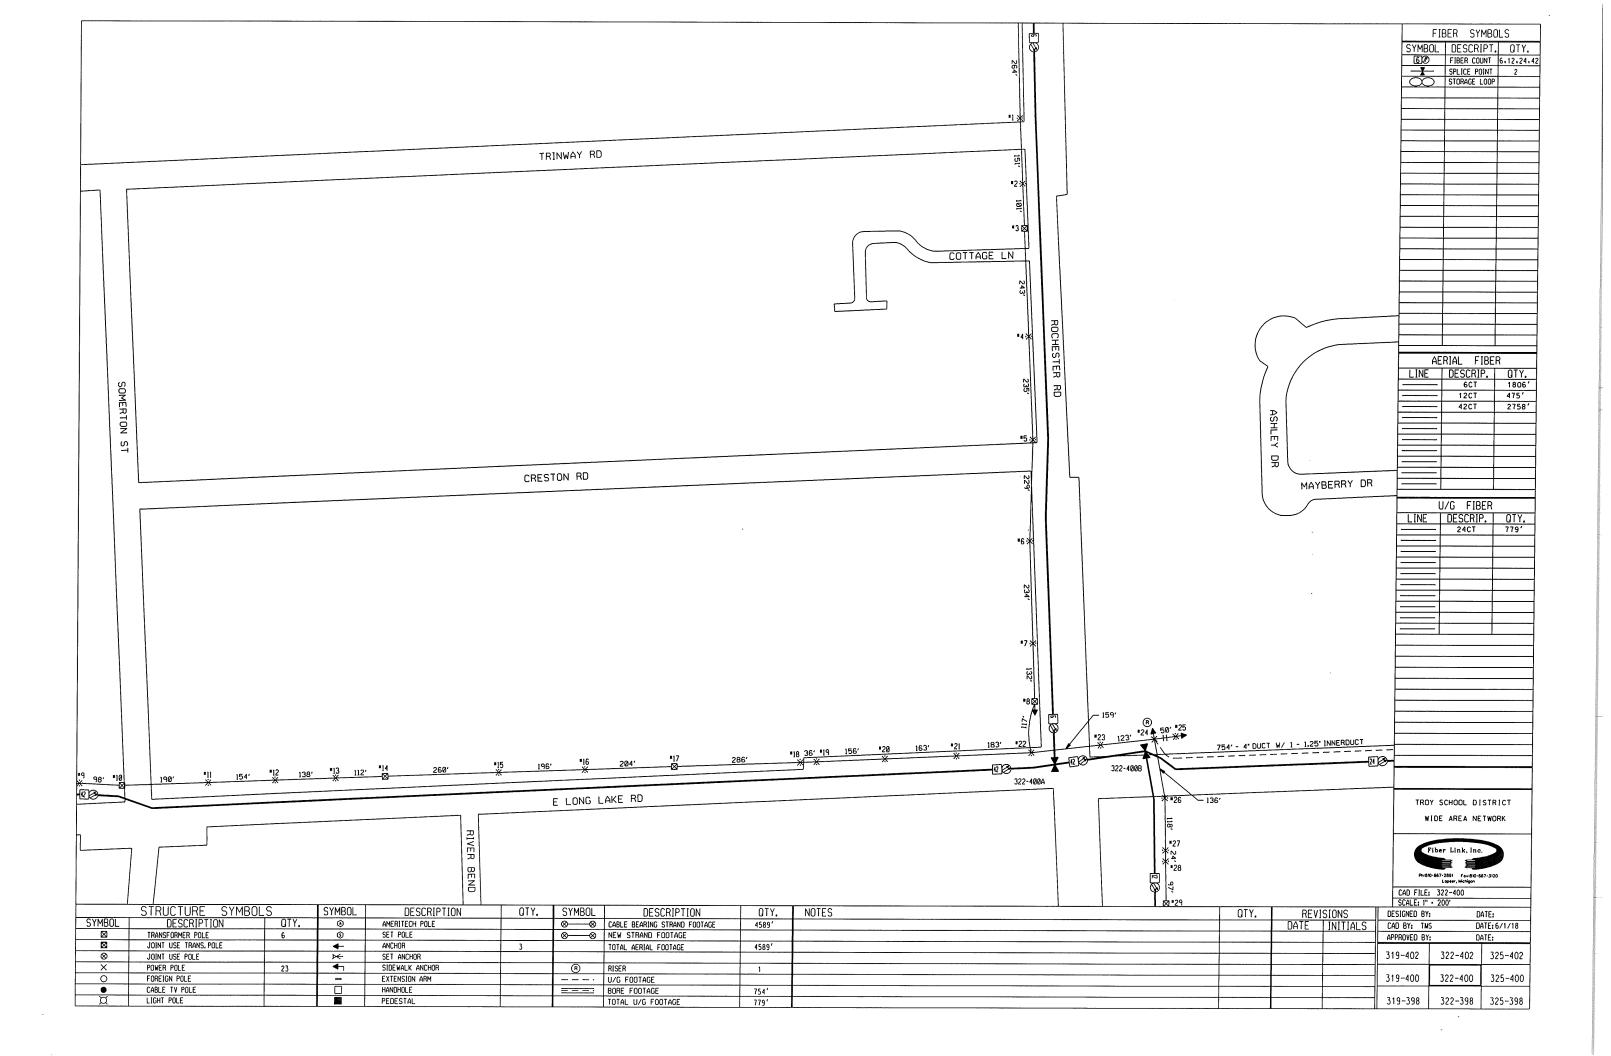


				150	
				169	PLAYER DR
				∎2 ⊠	
				165'	
				•3*	
				253	
				*4 🔆	
					(
				255'	
				•5 米	
				ROCHESTER RD	
				RO	
				"6*	_
				■7 * 138	
SYLV	ANWOOD AVE			159,	
				∎9 <b>Ж</b>	
				102 ×10	
				,661	
				""*	
STRUCTURE SYMBOLS SYMBOL DESCRIPTION OT SYMBOL DESCRIPTION OTY.  AMERITECH POLE	⊗ CABLE BEARING STR	AND FOOTAGE 2004'	NOTES		
⊠         TRANSFORMER POLE         2         ③         SET POLE           ⊠         JOINT USE TRANS. POLE         ←         ANCHOR           ⊗         JOINT USE POLE         ►         SET ANCHOR	⊗ ⊗ NEW STRAND FOOT TOTAL AERIAL FOOT	AGE 2004'			
W         JUINT USE POLE         ✓         SEE THECHON           ×         POWER POLE         9         ◄         SIDEWALK ANCHOR           ○         FOREIGN POLE         9         ◄         SIDEWALK ANCHOR	R     RISER        U/G     FOOTAGE				
CABLE TV POLE     HANDHOLE	BORE FOOTAGE TOTAL U/G FOOTA	26			
X     LIGHT POLE     ■     PEDESTAL		JL			

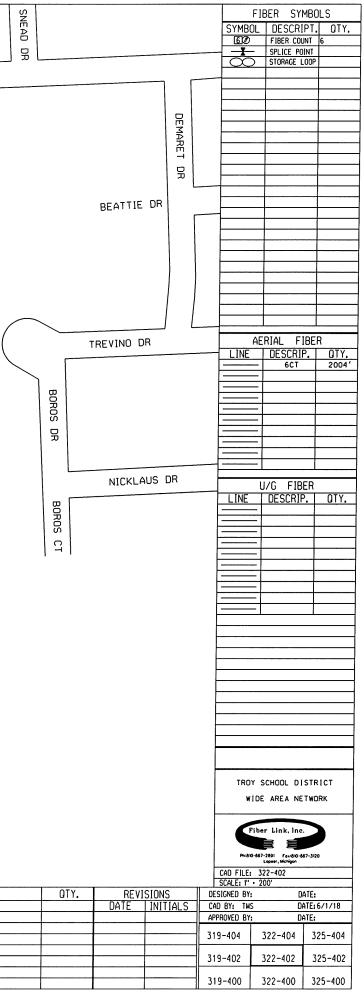



		*6     260'     *5     86'     *4     180'     *3     263'     *2     192'     *1     194'
	E SQUARE LAKE RD	17 * CREEKSID
		AERIAL FIBER LINE DESCRIP. OTY. 6CT 2926'
		FAIRWAY BLVD       MINTIELD       MINTIELD       U/G FIBER       LINE       DESCRIP.       OTY.       MUGUSTA DR
STRUCTURE     SYMBOLS     SYMBOL     DESCRIPTION     OT       SYMBOL     DESCRIPTION     OTY.     Image: Ameritage of the symbols     I	&	QTY.     REVISIONS     DESIGNED BY:     DATE:       DATE     INITIALS     CAD BY:     TMS     DATE:6/1/18       APPROVED BY:     DATE:     319-406     322-406     325-406       319-404     322-404     325-404     319-402     322-402     325-402

(r, q)

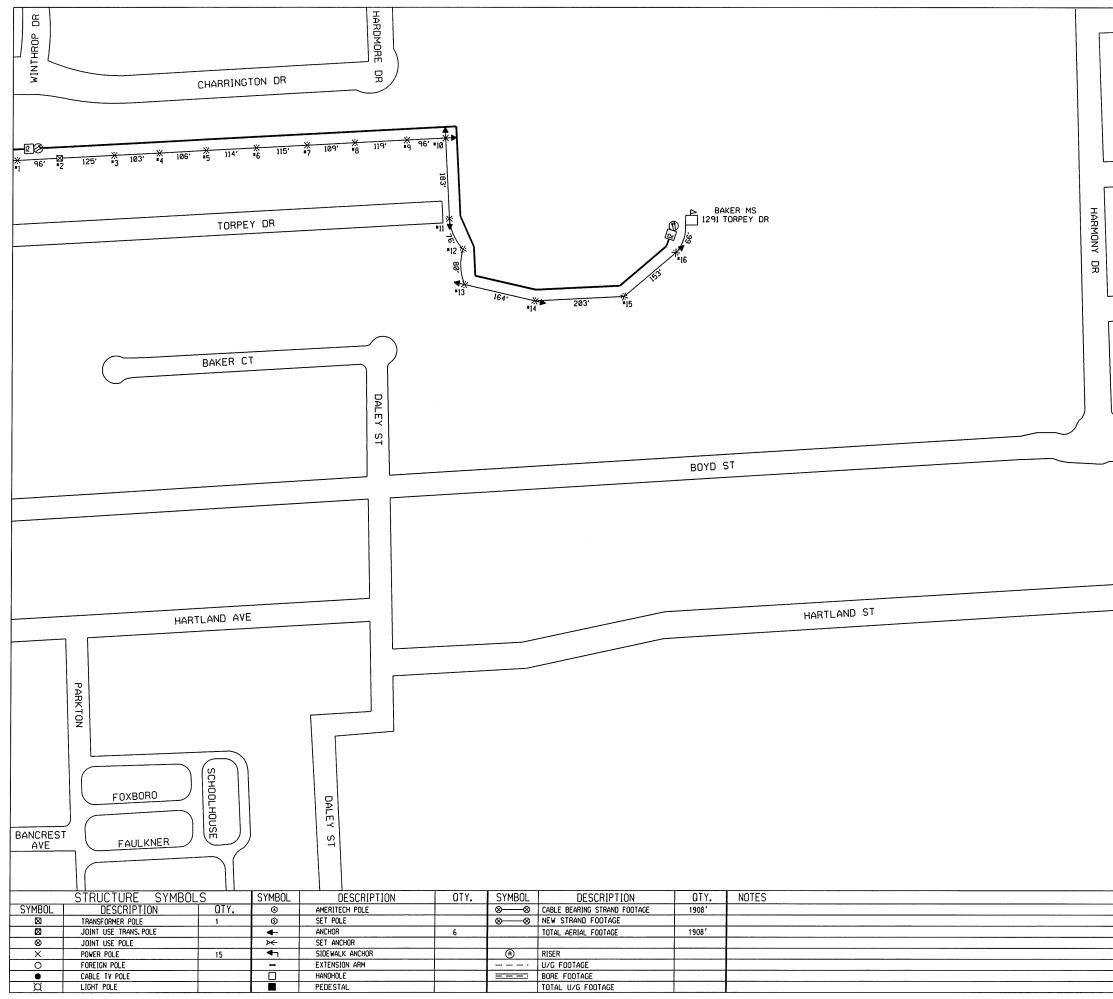



CRIMSON DR		IBER SY	
	SYMBO	L DESCRI FIBER COL	
		SPLICE PO	INT
		STORAGE L	.008
CRESTLINE DR			
LAKEWOOD DR			
		AERIAL FI	
			P. OTY.
		- 12CT	1908
		-	
		-	
<		-	
BOYD DR		-	
		-	
		- 1	
		U/G FIB	
	LINE	DESCRIF	P. OTY.
		-	
		-	
		-	
		-	
		-	
	TROY	SCHOOL DI	STRICT
		SCHOOL DI DE AREA NE	
	WI	DE AREA NE	TWORK
	WI	DE AREA NE ber Link, Inc.	TWORK
	WI	DE AREA NE	
	WI	DE AREA NE	
	W I Pristo CAD FILE: SCALE: 1"	DE AREA NE	T WORK
OTY. REVISIONS DATE INITIALS	WI PHONE CAD FILE: SCALE: I" DESIGNED BY: CAD BY: TWS	DE AREA NE ber Link, Inc. 667 2601, Factor of Lapter, McChigor 200' D/ D/	T WORK
OTY. REVISIONS DATE INITIALS	CAD FILE: SCALE: 1" DESIGNED BY: CAD BY: TMS APPROVED BY:	DE AREA NE	TWORK
OTY. REVISIONS DATE INITIALS	WI PHONE CAD FILE: SCALE: I" DESIGNED BY: CAD BY: TWS	DE AREA NE ber Link, Inc. 667 2601, Factor of Lapter, McChigor 200' D/ D/	T WORK
OTY. REVISIONS DATE INITIALS	CAD FILE: SCALE: 1" DESIGNED BY: CAD BY: TMS APPROVED BY:	DE AREA NE	TWORK

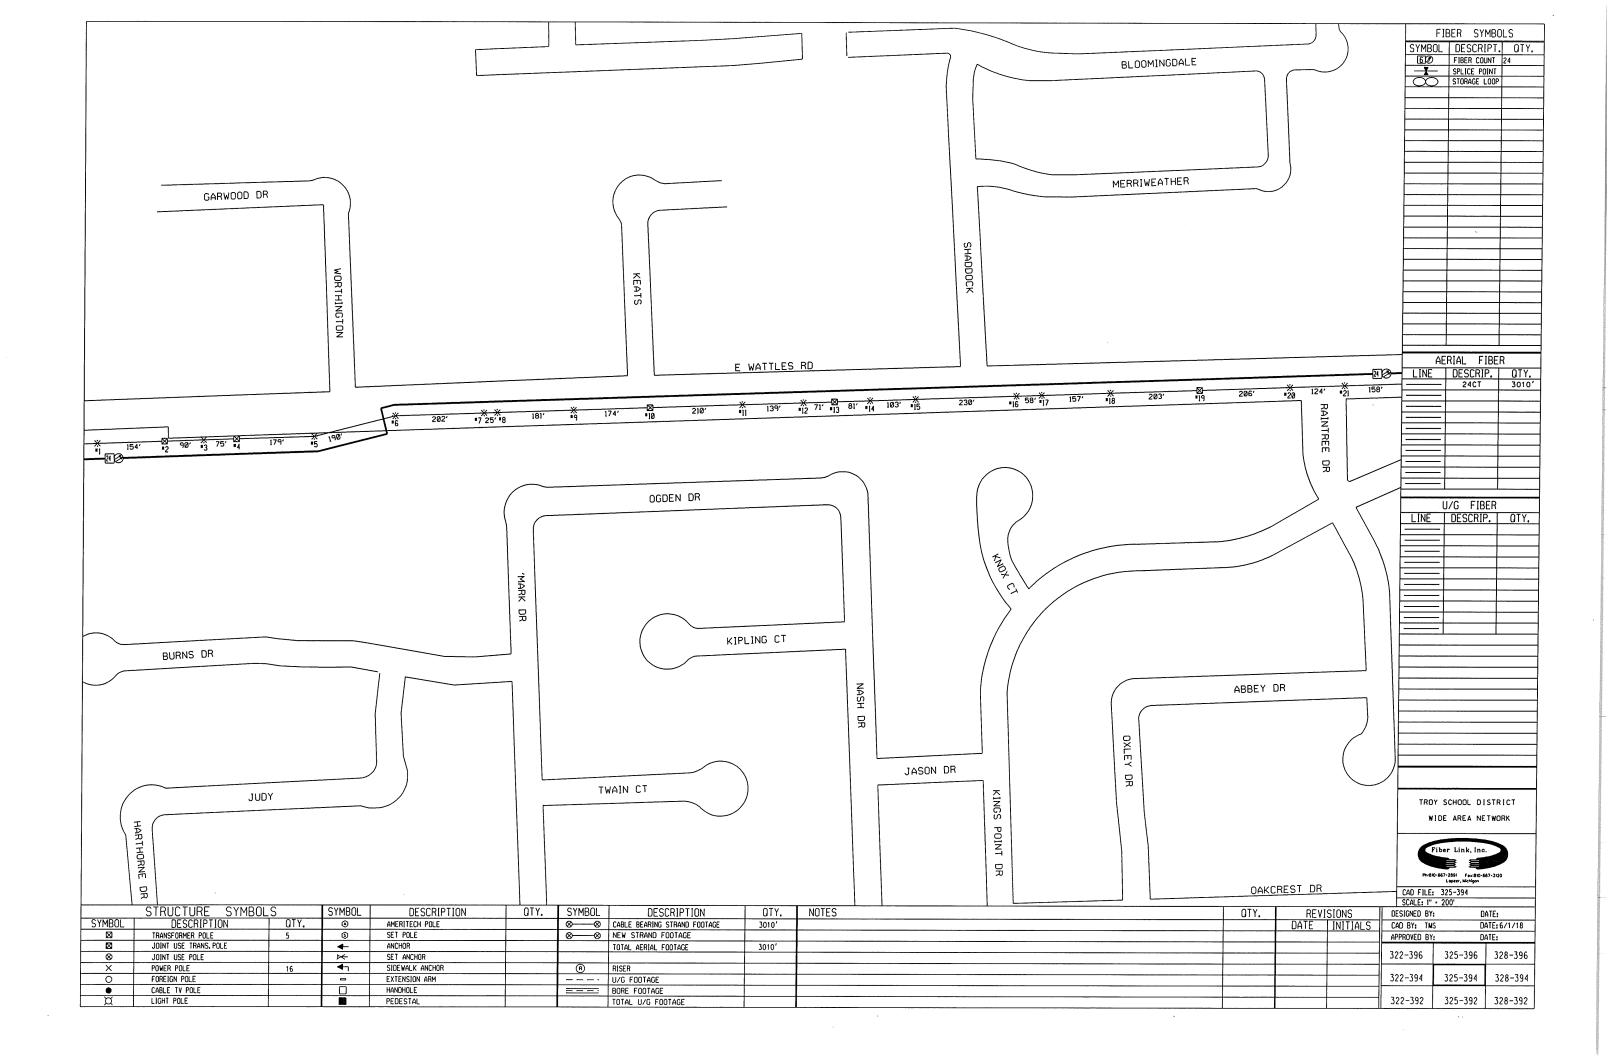

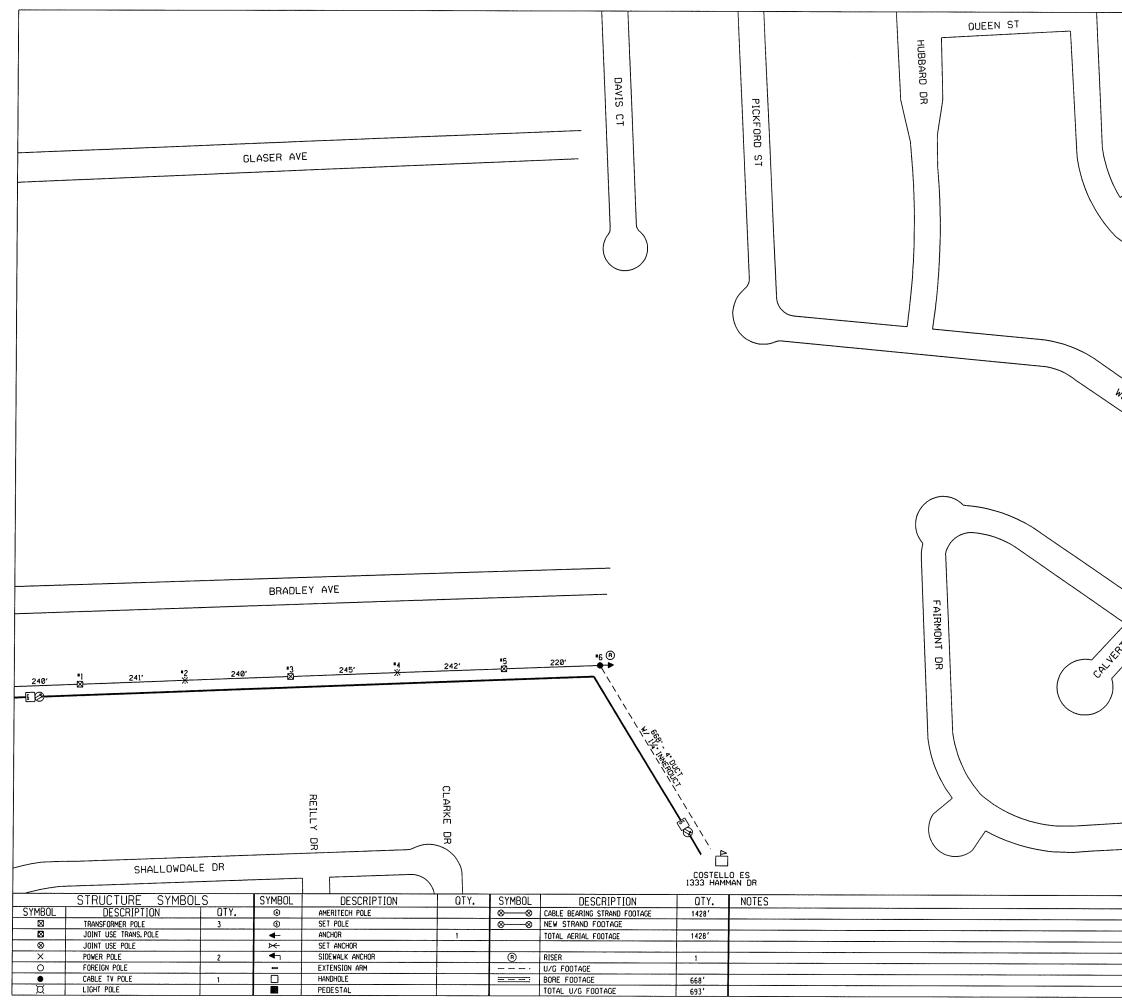

		FIBER SY	
	SYMBO	)L DESCRI FIBER COU	
		- SPLICE PO	
		) STORAGE L	.00P
$\frown$			
$\langle \rangle$			
ALTON CT			
TON			
AL			
$\langle$			
$\mathbf{X}$			
$\langle \rangle$			
$\langle \rangle$			
$\langle \rangle$	₩		
AL TON DR			
, ron			
\' 0q	/		
	/ =		
$\sim$		AERIAL FI	
	LINE	DESCRI	P. OTY.
	/	- 6CT	1428
	′∕/====		
LING DR	、 / ⊨==		
THE DO	`/ 🔚		
	/ 📃	-	
$\langle \langle \langle \langle \rangle \rangle \rangle$		-	
CLING OR LEY S			
$\sim$ $\sim$ /		-	
$\rightarrow$			
		U/G FIB	
	LINE	DESCRIF	P. OTY.
			693'
		- 6CT	693
			STRICT
			STRICT
	WI		
	WI		
	WI	SCHOOL DI DE AREA NE	
	WI		
	WI Produce CAD FILE:	SCHOOL DI DE AREA NE 1000 (607-000) 1000 (7000) 1000 (7000) 10000 (7000) 1000 (7000) 10	
	WI File: SCALE: 1"	SCHOOL DI DE AREA NE 1000 JUNE 1000 JUNE 10	
OTY. REVISIONS	W I Frage CAD FILE: SCALE: I" DESIGNED BY;		STR I CT TWORK
	CAD FILE: SCALE: 1" DESIGNED BY: 5 CAD BY: TMS	SCHOOL DI DE AREA NE iber Link, Inc. 325-398 200' D/ D/ D/ D/	STRICT TWORK
OTY. REVISIONS	CAD FILE: SCALE: 1" - DESIGNED BY: CAD BY: TMS APPROVED BY:		STRICT TWORK
OTY. REVISIONS	CAD FILE: SCALE: 1" DESIGNED BY: 5 CAD BY: TMS	SCHOOL DI DE AREA NE iber Link, Inc. 325-398 200' D/ D/ D/ D/	STR I CT TWORK
C OTY. REVISIONS DATE INITIAL	WI CAD FILE: SCALE: I" DESIGNED BY: CAD BY: TMS APPROVED BY: 322-400		STR I CT TWORK STRIE: ME: 6/1/18 ME: 328-400
OTY. REVISIONS	CAD FILE: SCALE: 1" - DESIGNED BY: CAD BY: TMS APPROVED BY:		STRICT TWORK
OTY. REVISIONS	WI CAD FILE: SCALE: I" DESIGNED BY: CAD BY: TMS APPROVED BY: 322-400		STR I CT TWORK STRIE: ME: 6/1/18 ME: 328-400

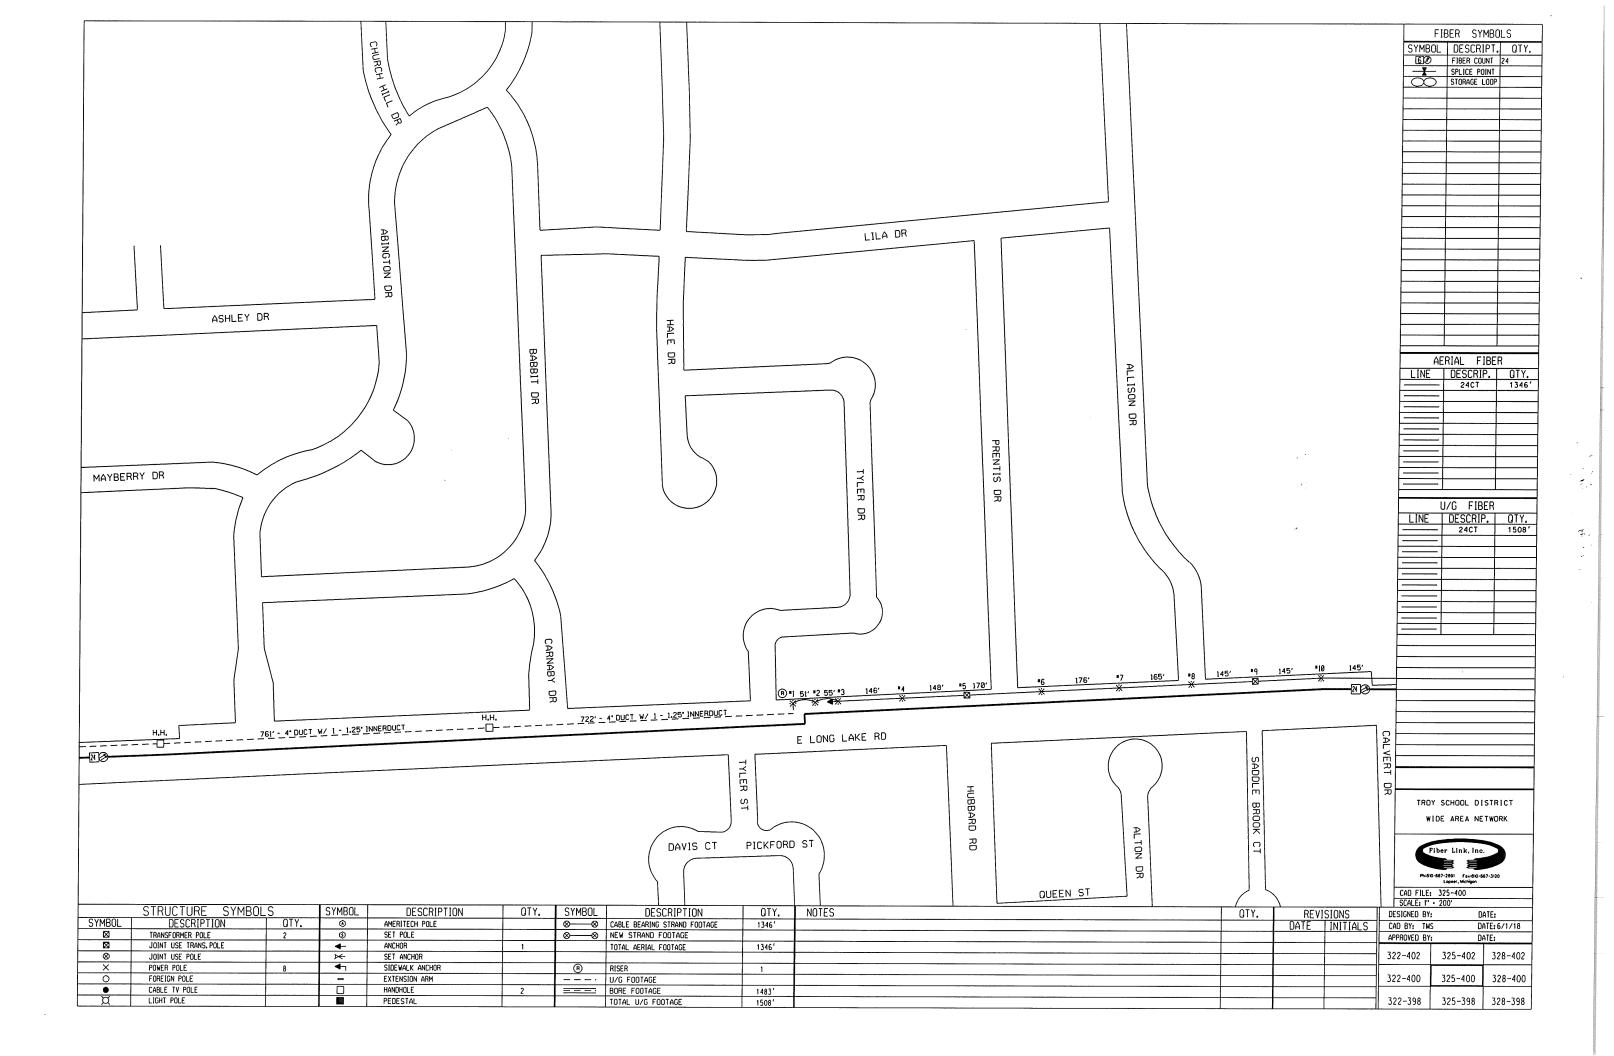


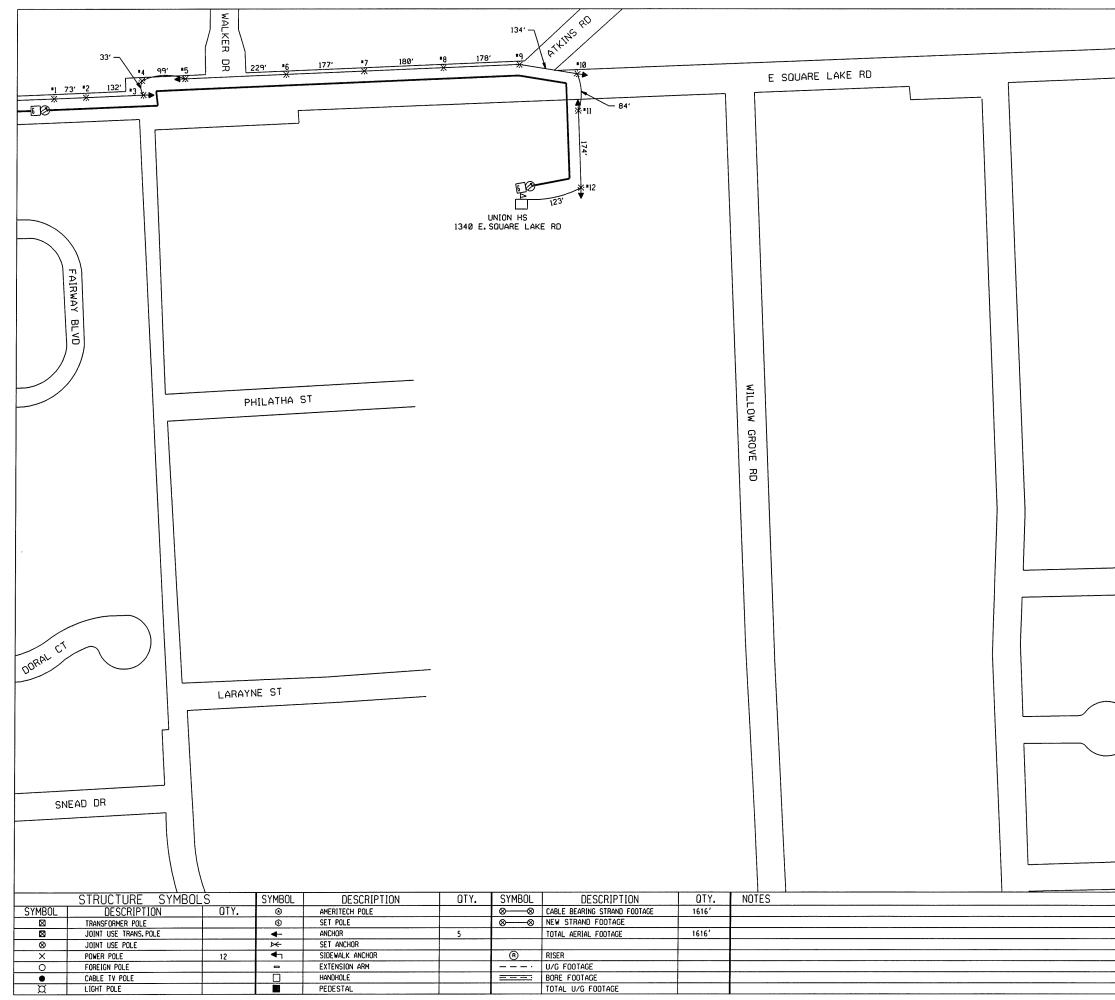



		FIBER SYMBOLS				
		SYMBOL		PT. OTY.		
		<u>8</u>	FIBER COU SPLICE POI			
		$-\overline{\infty}$	STORAGE L	00P		
			_			
				_		
			_			
			1			
			ERIAL FI			
		LINE	DESCRIF			
			6CT	1616'		
			·	_		
			U/G FIBE	R		
		LINE	DESCRIP	. OTY.		
	、 、					
				-		
	)					
	/					
<b>)</b>						
			·····			
\						
)			******			
/						
			SCHOOL 01	TRICT		
			SCHOOL DI			
	/ .	wit	DE AREA NE	IWUKK		
		Fil	er Link, Inc.			
/	•	Ph:810-6	67-2891 Fax:810-66 Lopeer, Michigon	7-3120		
			Lopeer, Michigon 325-404			
		SCALE: 1"	200'			
OTY. REVI DATE	SIONS INITIALS	DESIGNED BY:		TE:		
UAIE	INTIALS	CAD BY: TMS APPROVED BY:		TE: 6/1/18 TE:		
		322-406	325-406	328-406		
		JEL 100				
			I			
		322-404	325-404	328-404		
		322-404	325-404	328-404		



		FIBER SY	
WAYFARER ST	SYMB	OL DESCR	IPT. OTY.
	600 	FIBER CO	
			LOOP
BARNARD ES 3601 FORGE DR			
	LINE	AERIAL F	
		6CT	r. urr. 167'
		_	
		_	
		_	
		_	
		U/G FIB	
	LINE		
		- 6CT	898'
		_	
		-	
		_	
		_	
GROVE DR		_	
	-		
		A	
$\backslash$	тео	Y SCHOOL DI	STRICT
	-		
- DR	L V	IDE AREA NE	
AVERSE			
TRAVERSE DR		Fiber Link, Inc	
	Ph:8	0-667-2891 Fax:810-8 Lapeer, Michigon	67-3120
		Lapeer, Michigon 328-392	
	SCALE: 1"	• 200'	
	DESIGNED BY	: D	ATE:
	CAD BY: TM APPROVED BY		ATE: 6/1/18 ATE:
+	325-394		
	1/7-144	328-394	331-394
	JZJ JJ7		
	325-392	328-392	331-392
		328-392 328-390	331-392 331-390

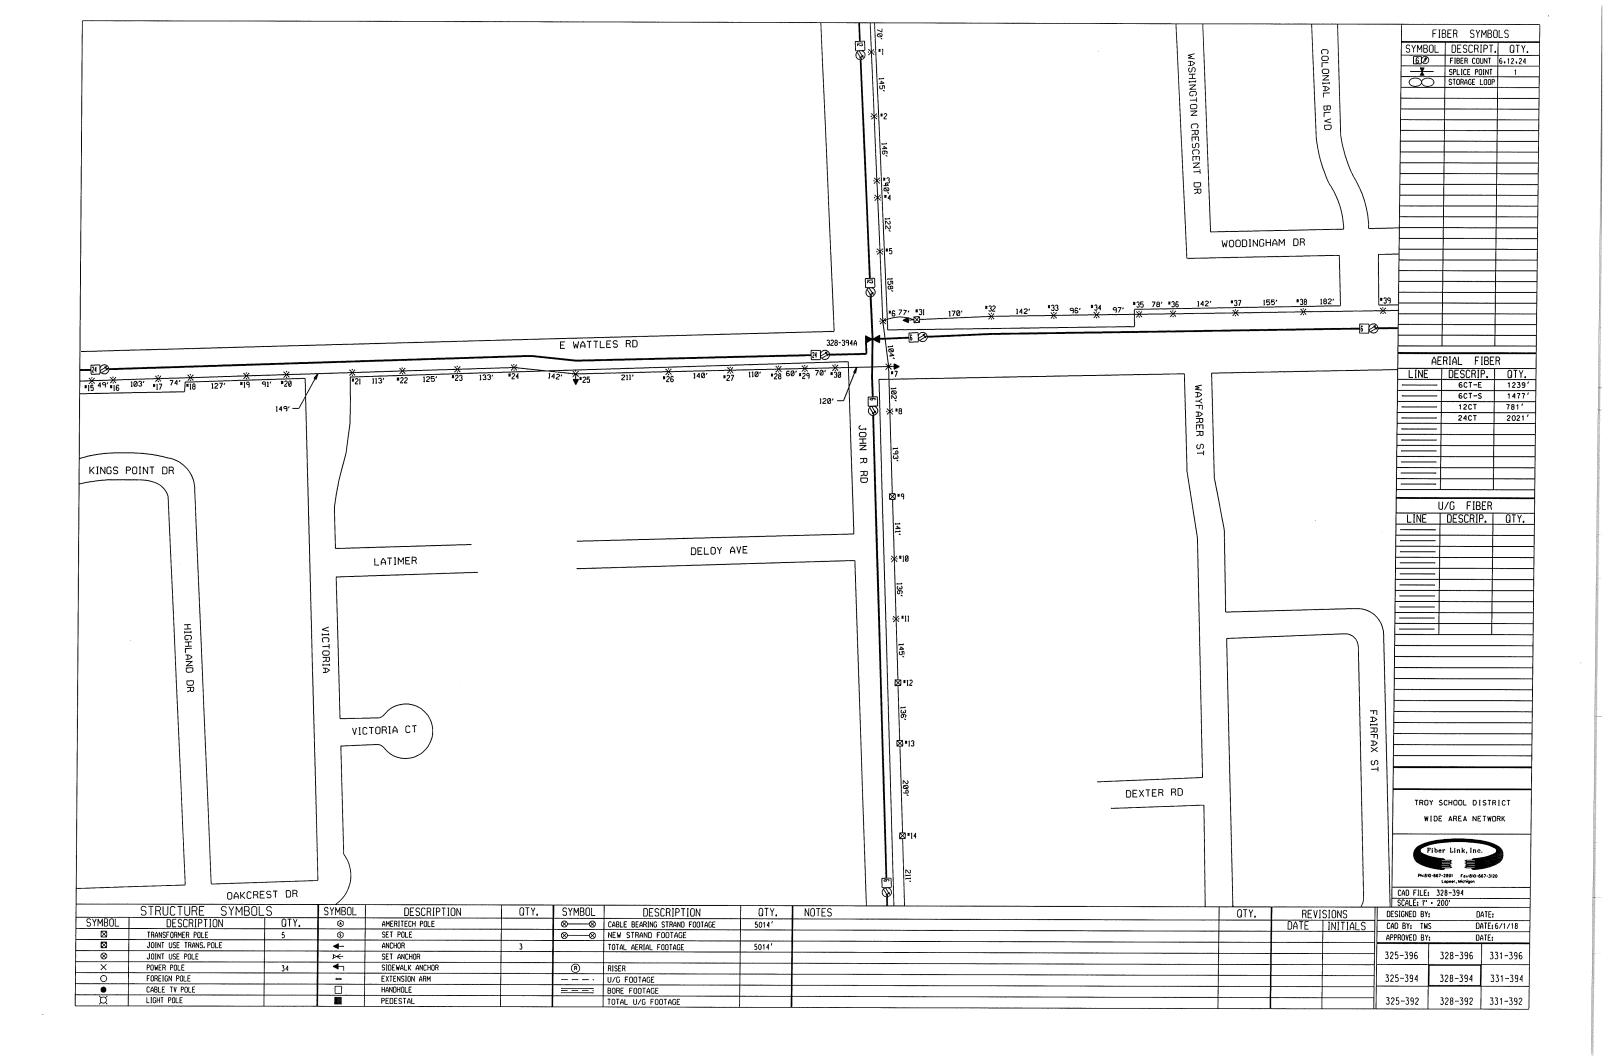

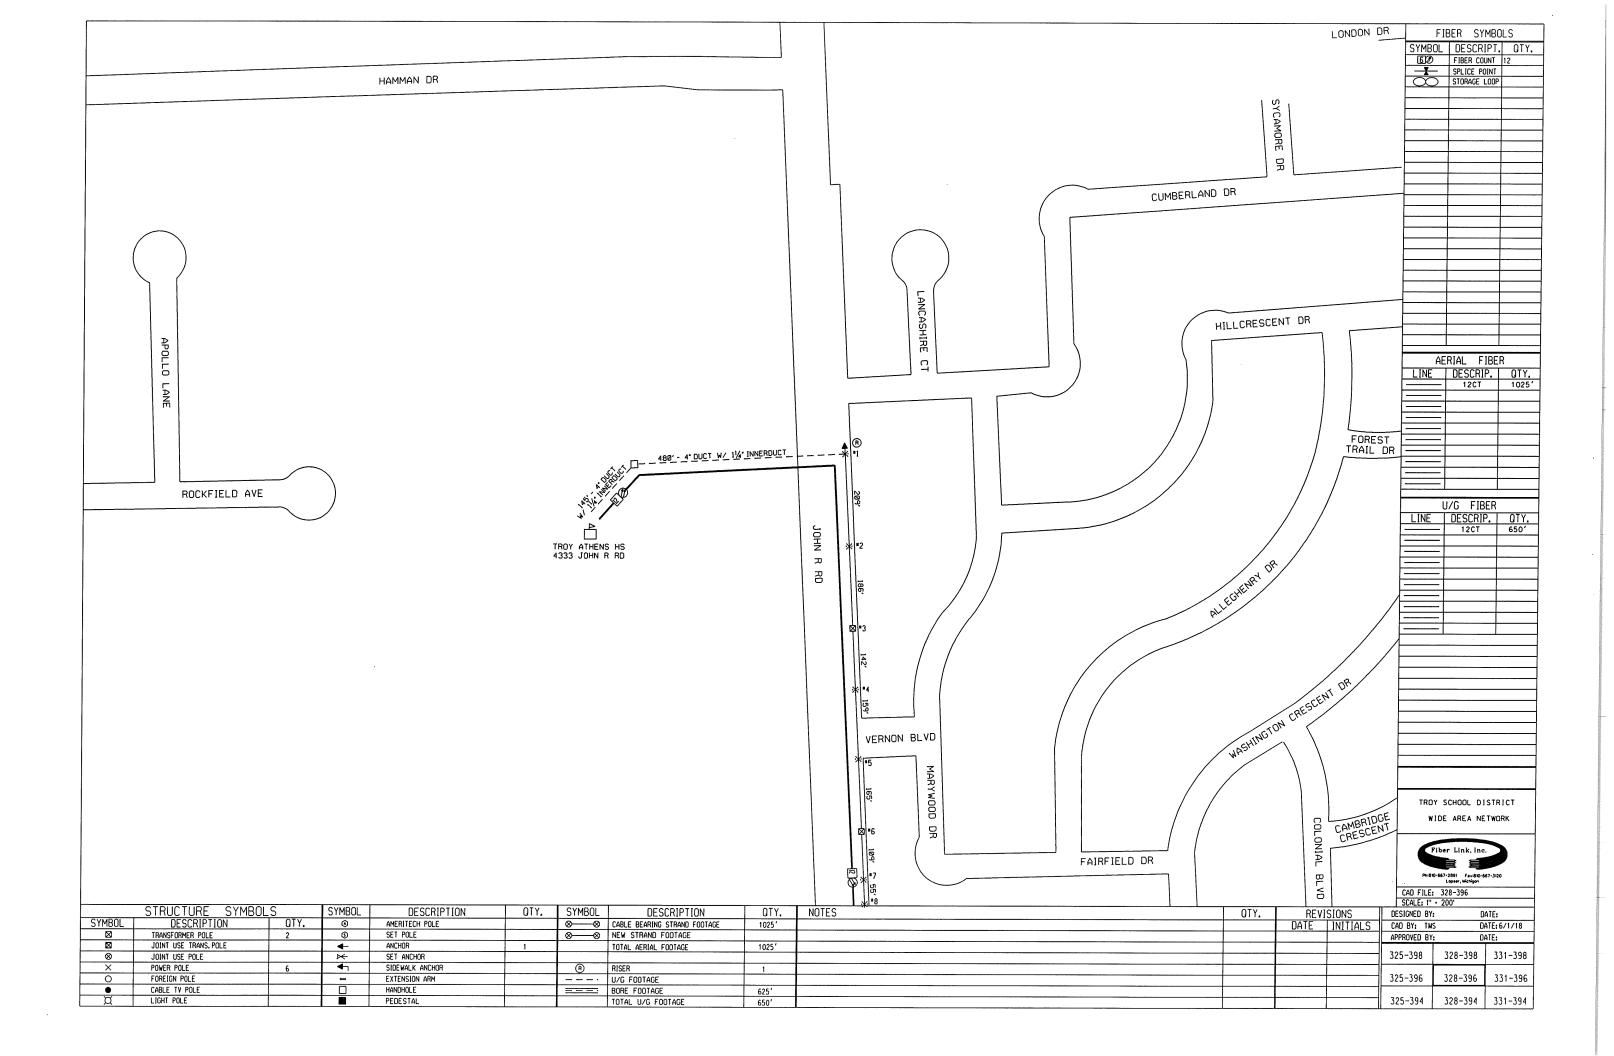


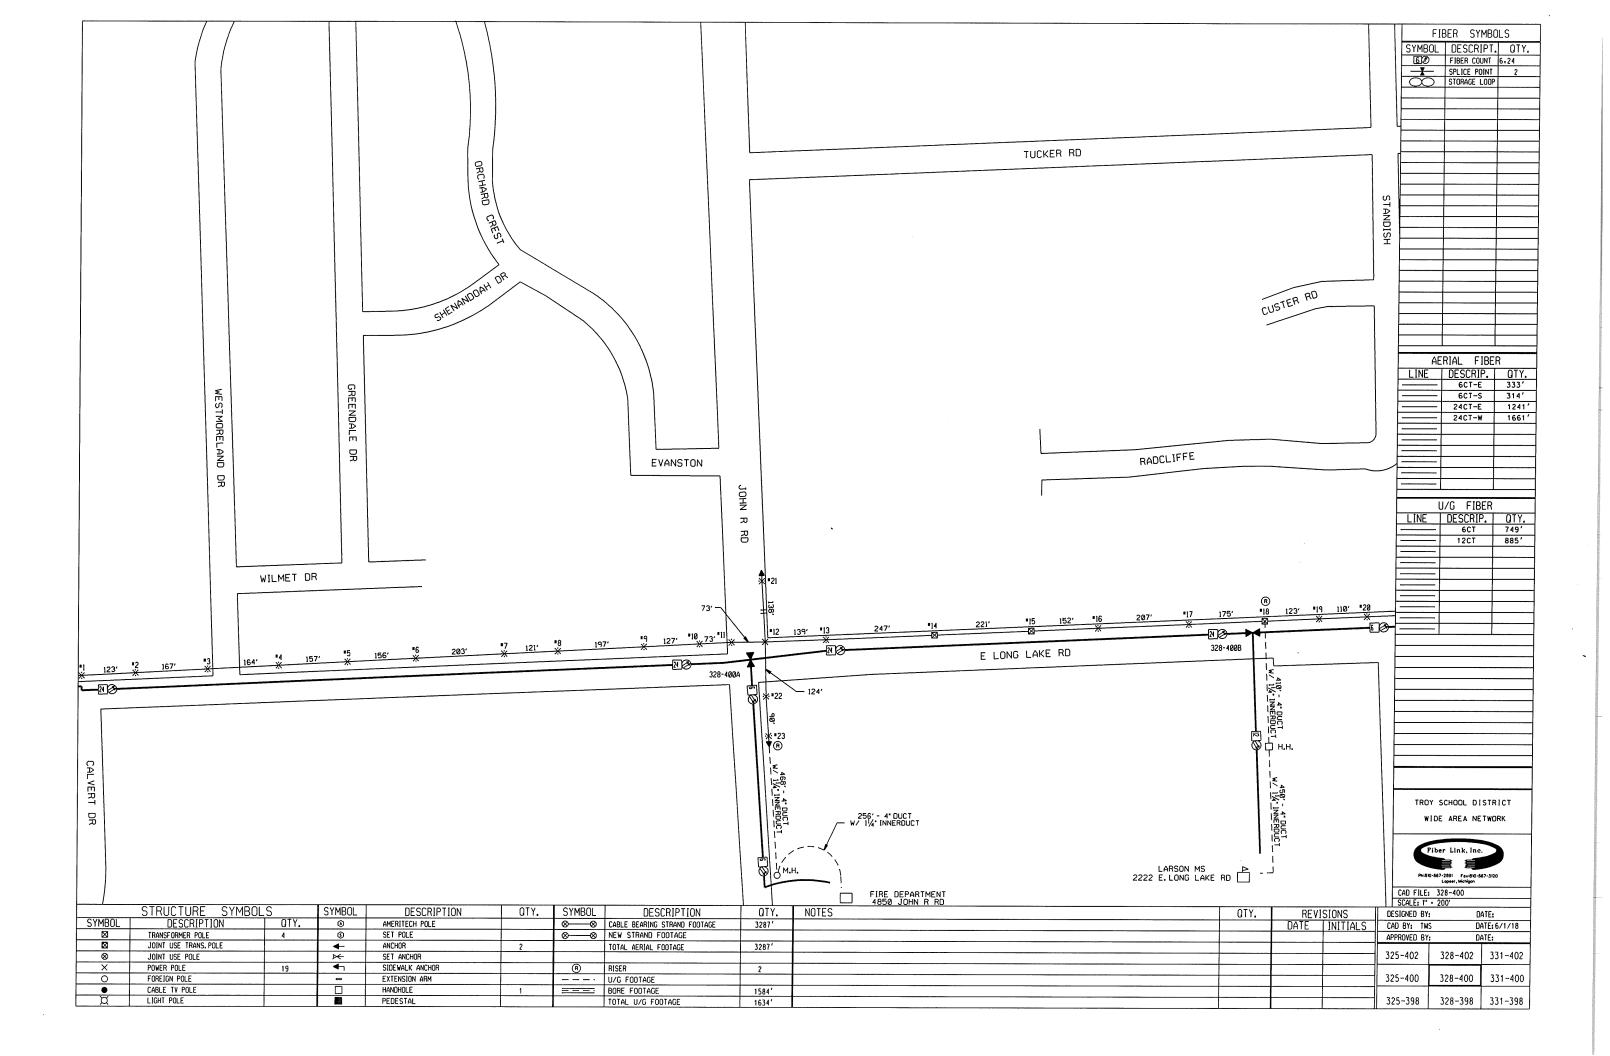





 	)				MBOLS
	1	l	SYMB	OL DESCR	
	$\backslash$	MOREHE		- SPLICE PO	DINT 1
	$\sim$		$\neg \alpha$	STORAGE I	
 			ļ		
				· · ·	
				AERIAL F	
			LINE		
				— 6CT	2563'
				_	
 				_	
	BIRCHDAL	.E	\ <del></del>		
	. *				
				U/G FIB	
			LINE	DESCRI	
	: -			— 6CT	583'
				-	
				-	
				-	
				-1	
				Y SCHOOL DI	STRICT
				IDE AREA NE	
				Fiber Link, Inc	
			Phil	10-667-2891 Fax:810-6	67-3120
				10-667-2891 Fax:810-6 Lapeer, Michigon	67-3120
			CAD FILE	Lapeer, Michigon : 331-394	67-3120
 012			CAD FILE SCALE: 1"	Lapter, Michigan : 331-394 - 200'	
 OTY.	REVI	SIONS	CAD FILE SCALE: 1" DESIGNED BY	Lapser, Michigon : 331-394 - 200' : D	ATE:
 OTY.	REVI DATE	SIONS INITIALS	CAD FILE SCALE: 1" DESIGNED BY CAD BY: TM	Lopeer, Michigon           : 331-394           • 200'           ':         D           S         D	ATE: ATE: 6/1/18
OTY.	REVI DATE	SIONS INITIALS	CAD FILE SCALE: 1" DESIGNED BY CAD BY: TM APPROVED BY	Lopeer, Michigon           : 331-394           - 200'           ':         D           IS         D           ':         D	ATE: ATE:6/1/18 ATE:
 OTY.	REVI DATE	SIONS INITIALS	CAD FILE SCALE: 1" DESIGNED BY CAD BY: TM	Lopeer, Michigon           : 331-394           • 200'           ':         D           S         D	ATE: ATE: 6/1/18
OTY.	REVI DATE	SIONS INITIALS	CAD FILE SCALE: 1" DESIGNED BY CAD BY: TM APPROVED BY 328-396	Lopeer, Michigon : 331-394 - 200' : D S D : D 331-396	ATE: ATE: 6/1/18 ATE: 334-396
OTY.	REVI DATE	SIONS INITIALS	CAD FILE SCALE: 1" DESIGNED BY CAD BY: TM APPROVED BY	Lopeer, Michigon           : 331-394           - 200'           ':         D           IS         D           ':         D	ATE: ATE:6/1/18 ATE:
OTY.	REVI DATE	SIONS INITIALS	CAD FILE SCALE: 1" DESIGNED BY CAD BY: TM APPROVED BY 328-396	Lopeer, Michigon : 331-394 - 200' : D S D : D 331-396	ATE: ATE: 6/1/18 ATE: 334-396

4.

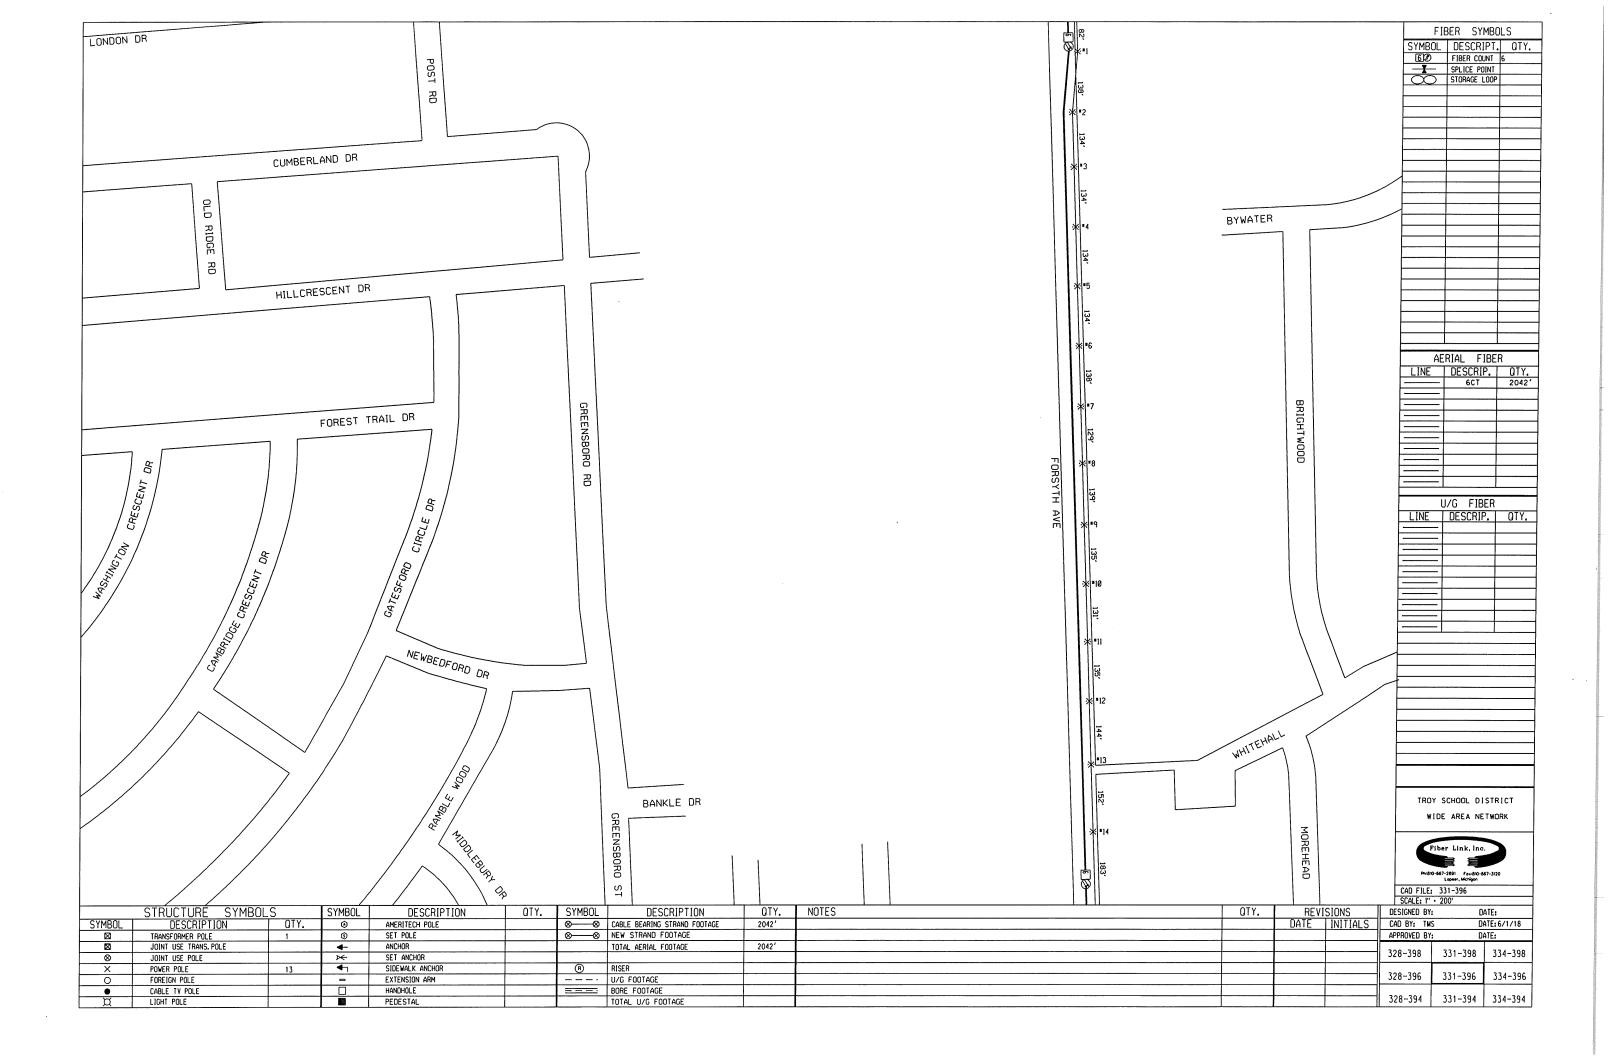

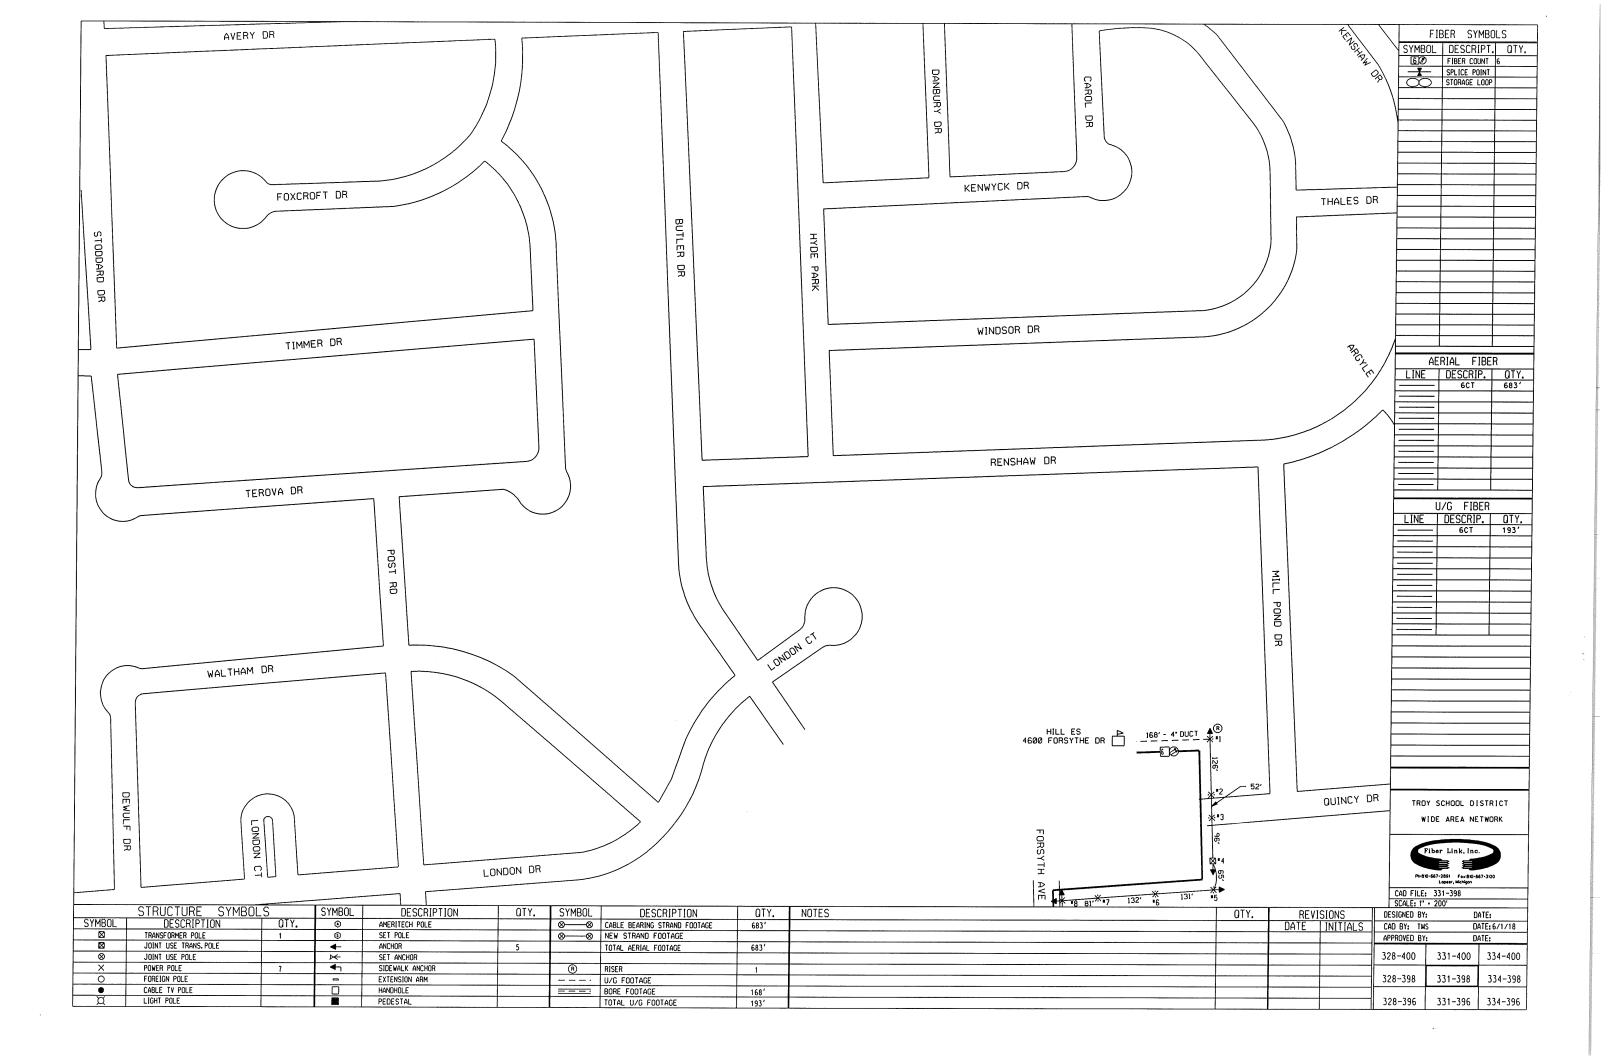

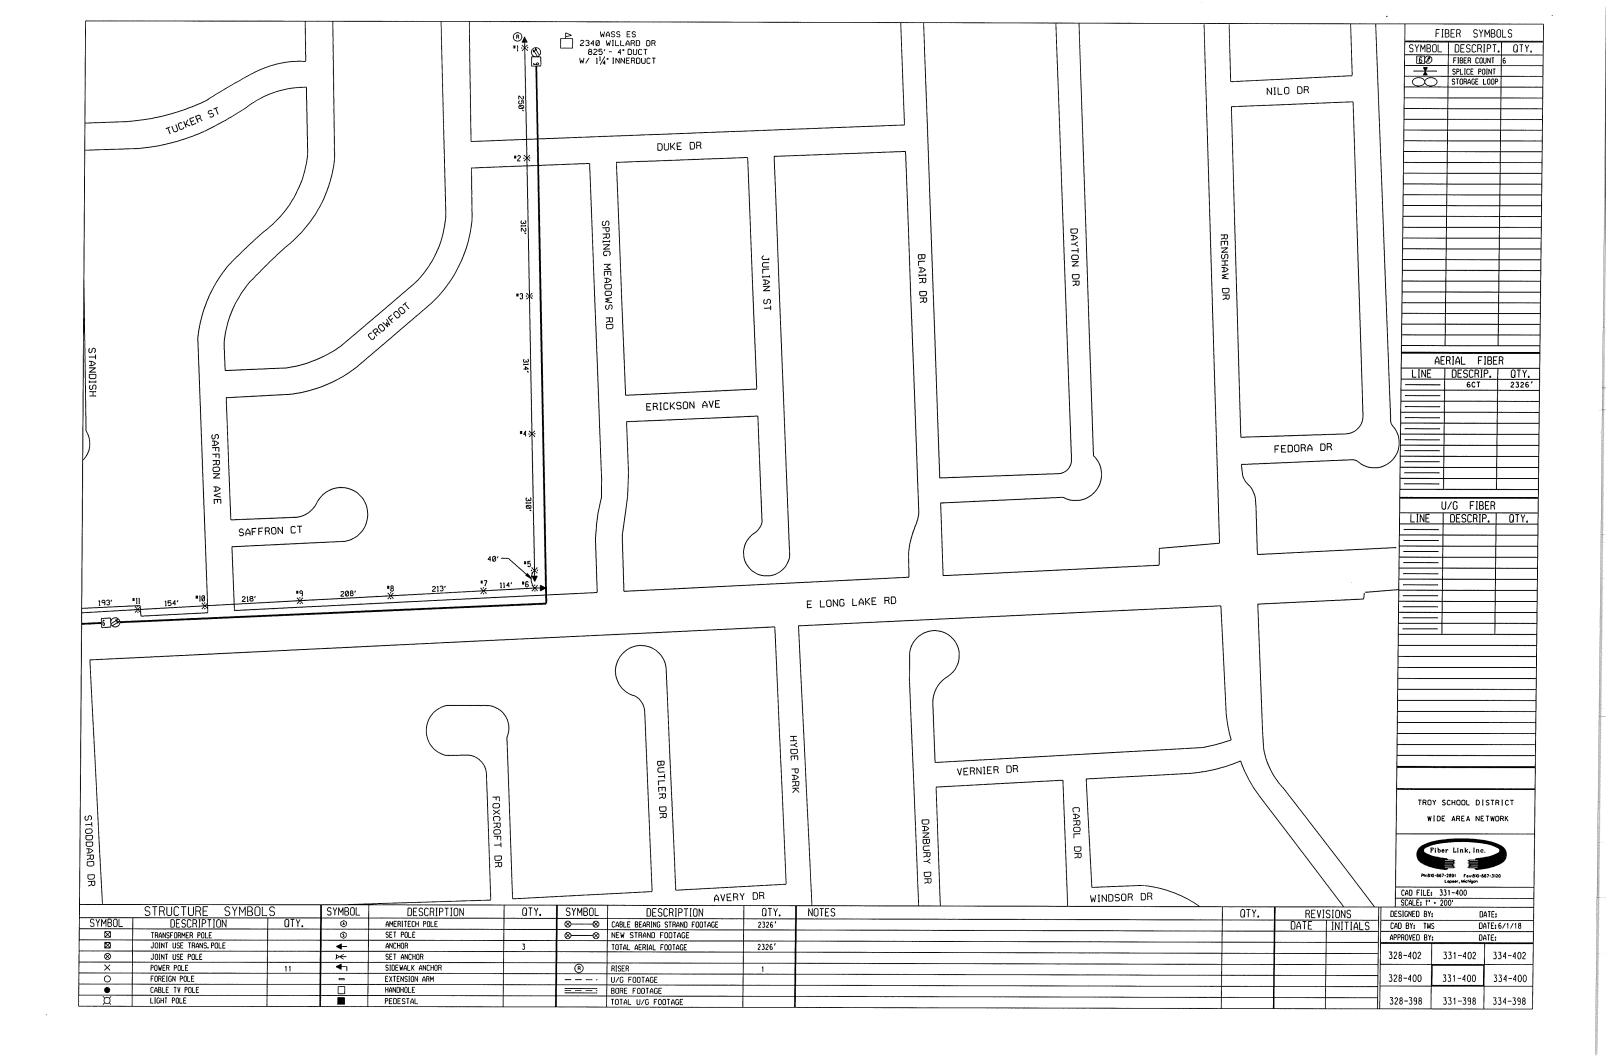



Convergent Technology Partners 6197 Miller Rd., Suite 4 Swartz Creek, MI 48473 810-720-3820

E-mail: info@ctpartners.net Website: www.ctpartners.net

## ADDENDUM 1

Client / Address	Troy School District	Project / Location	WAN Fiber Maintenance
Date Issued	December 18, 2020	Project Number	Bid #9912

## ADDENDUM # 1

A1-1 NOTICE: The bid documents are amended herein which adds to and/or supersedes conflicting or additional information in the Request for Proposal and Project Prints.

Work covered by this Addendum shall be subject to the Introduction, Terms and Conditions, Technical Specifications and Drawings.

Acknowledge this Addendum on the Cost Analysis Worksheet and include the cost of the work herein specified in the Bid.

## A1-2 Changes to the 00 30 10 Schedule of Events

A. The Bid Due Date/Time and Virtual Bid Opening is changed to January 14, 2:30 PM local time.

## Bid Tabulation BID 9912 Fiber Maintenance Troy School District 1/14/2021 @2:30 PM

Vendors	Familial Affadavit	Iran Affadavit	Base Bid Totals	Voluntary Alternate 1	Voluntary Alternate 2
Fiber Link	Х	Х	\$ 112,550.00		
Amcomm	х	Х	\$ 60,395.56		
Turnkey	X	Х	\$ 29,651.62		