



99 S. Almaden Road, Suite 600  
San Jose, CA 95113  
November 25, 2021

**Subject: Bid Package #2**  
Abbott Middle School HVAC Replcmt-DSA 01-119556  
George Hall Elementary School HVAC Replcmt-DSA 01 119523  
Laurel Elementary School HVAC Replcmt DSA 01-119551  
**San Mateo - Foster City School District**

**ADDENDUM NO. 1**

CHANGES AND/OR CLARIFICATIONS OF THE DRAWINGS AND SPECIFICATIONS ARE AS FOLLOWS FOR THE THREE DSA PROJECTS ASSOCIATED WITH BID PACKAGE NO.1. PLEASE NOTE THAT THIS ADDEDUM IS BEING ISSUED IN A COMBINED PACKAGE IN FIVE PARTS.

- Part 1. Cover section addressing all four projects with overlapping information impacting each campus project.
- Part 2. Addendum documentation exclusively for Abbott Middle School Project.
- Part 3. Addendum documentation exclusively for George Hall Elementary School Project.
- Part 4. Addendum documentation exclusively for Laurel Elementary School Project.

**Part 1. Cover section addressing all four projects with overlapping information impacting each campus project.**

- Please note that Addendum #1 has been issued as part of the initial Issued for Bid Documents.

**Part 2. Addendum 1 Items for Abbott Middle School**

- Review posted Addendum No. 1 documents as prepared by Aedis Architects, *attached*.

**Part 3. Addendum 1 Items for George Hall Elementary School**

- Review posted Addendum No. 1 documents as prepared by Aedis Architects, *attached*.

**Part 4. Addendum 1 Items for Laurel Elementary School**

- Review posted Addendum No. 1 documents as prepared by Aedis Architects, *attached*.

END OF ADDEDUM #1



November 24, 2021

Aedis Architects  
387 S. First St., Suite 300  
San Jose, CA 95113

**Subject:** Abbott Middle School HVAC Replacement  
San Mateo - Foster City School District  
Aedis Project No. 2021005.06  
DSA Application #01-119556

### ADDENDUM NO. 1

---

CHANGES AND/OR CLARIFICATIONS OF THE DRAWINGS AND SPECIFICATIONS ARE AS FOLLOWS:

#### SPECIFICATIONS

ITEM NO. 1.1:     TABLE OF CONTENTS

*Add:*        07 31 13 ASPHALT SHINGLES  
*Add:*        07 51 13 BUILT-UP ASPHALT ROOFING  
*Add:*        31 23 16 TRENCHING  
*Delete:*     07 26 00 UNDER SLAB VAPOR BARRIER  
*Delete:*     09 65 19 RESILIENT TILE FLOORING

ITEM NO. 1.2:     SECTION 07 26 00 - UNDER SLAB VAPOR BARRIER

*Delete:*     The specification in its entirety.

ITEM NO. 1.3:     SECTION 07 31 13 - ASPHALT SHINGLES

*Add:*        The specification in its entirety per 07 31 13 Asphalt Shingles.

ITEM NO. 1.4:     SECTION 07 51 13 - BUILT-UP ASPHALT ROOFING

*Add:*        The specification in its entirety per 07 51 13 Build-Up Asphalt Roofing.

ITEM NO. 1.5:     SECTION 09 65 19 – RESILIENT TILE FLOORING

*Delete:*     The specification in its entirety.

ITEM NO. 1.6:     SECTION 31 23 16 - TRENCHING

*Add:*        The specification in its entirety per 31 23 16 Trenching.

**ADDENDUM NO. 1**

11/24/2021

Abbott Middle School HVAC Replacement  
San Mateo – Foster City School District  
Aedis Project No. 2021005.06

**DRAWINGS**

**ARCHITECTURAL**

ITEM NO. 1.7:     DRAWING SHEET T1 – TITLE SHEET

Revise:     General Notes 7 to read as “ALL EXISTING FINISHES OR MATERIALS DAMAGED OR DEMOLISHED DUE TO NEW CONSTRUCTION SHALL BE RESTORED TO THEIR ORIGINAL STATE, INCLUDING BUT NOT LIMITED TO REINSTALLING OR REPLACING EXISTING CHAINLINK FENCING AS REQUIRED AND RESTRIPIING PAVING IN KIND. S.E.D. FOR TRENCH ROUTING. VERIFY IN FIELD AND SEE ARCHITECTURAL SITE PLAN FOR STRIPING AT EXISTING PAVING.”

ITEM NO. 1.8:     DRAWING SHEET A1.02 – SITE PLAN

Add:        Trench area to New Site Plan 1/A1.02 and Graphic Key per AD1-A1.02  
Add:        General Sheet Note #G per AD1-A1.02  
Add:        Striping keynote #3 to New Site Plan 1/A1.02 per AD1-A1.02

ITEM NO. 1.9:     DRAWING SHEET A2.01 – DEMOLITION FLOOR PLAN – WINGS 1, 2, & 3

Add:        General Sheet Note #I per AD1-A2.01

ITEM NO. 1.10:    DRAWING SHEET A2.02 – DEMOLITION FLOOR PLANS – MULTIPURPOSE BLDG

Add:        General Sheet Note #I per AD1-A2.02  
Add:        Mechanical equipment removal keynote #7 at Demolition Floor Plan 1/A2.02 per AD1-A2.02  
Add:        Keystone #8 at Demolition Floor Plan 1/A2.02 per AD1-A2.02

ITEM NO. 1.11:    DRAWING SHEET A3.01 – NEW FLOOR PLANS -WING 1, 2 & 3

Add:        RCP and construction access keynote #10 at 1/A3.01 and 2/A3.01 per AD1-A3.01

ITEM NO. 1.12:    DRAWING SHEET A5.01 – SITE ROOF PLAN

Revise:     Graphic Key per AD1-A5.01  
Revise:     Roof plan Keynotes #2, #4 & #5 per AD1-A5.01

ITEM NO. 1.13:    DRAWING SHEET A8.10 – EXTERIOR DETAILS

Revise:     Detail #2 per AD1-A8.10A  
Revise:     Detail #9 & #19 per AD1-A8.10B

**ADDENDUM NO. 1**

11/24/2021

Abbott Middle School HVAC Replacement  
San Mateo – Foster City School District  
Aedis Project No. 2021005.06

ITEM NO. 1.14: DRAWING SHEET A9.10 – INTERIOR DETAILS, WALL TYPES, & INTERIOR ELEVATIONS

Revise: Detail 1 & 5 per AD1-A9.10A

Revise: Detail 7 per AD1-A9.10B

ITEM NO. 1.15: DRAWING SHEET A11.01 – FINISH SCHEDULE & OPENING SCHEDULES, LEGENDS, & DETAILS

Revise: Door schedule per AD1-A11.01

**MECHANICAL**

ITEM NO. 1.16: DRAWING MP0.02 – SCHEDULES – MECHANICAL

Revise: Classroom Split System Heat Pump Schedule per AD1-MP0.02

ITEM NO. 1.17: DRAWING MP2.01 – FLOOR PLANS – DEMO – WINGS 1 & 2 – MECHANICAL & PLUMBING

Revise: Demolition sheet note #7 per AD1-MP2.01

ITEM NO. 1.18: DRAWING MP2.04 – FLOOR PLANS – DEMO – MULTIPURPOSE BLDG – MECHANICAL & PLUMBING

Add: Demolition sheet note #17 per AD1-MP2.04

Add: Exhaust fan Demolition at work room 13A per AD1-MP2.04

ITEM NO. 1.19: DRAWING MP2.06 – FLOOR PLANS – NEW – WINGS 1 & 2 – MECHANICAL & PLUMBING

Revise: Size of Return register HSR-1 per AD1-MP2.06a

Revise: New Sheet Notes #14, #16, & #19 per AD1-MP2.06a

Revise: General Notes #4 per AD1-MP2.06a

Add: General Notes #8 per AD1-MP2.06a

Add: Dimensions per AD1-MP2.06a

Revise: Keynote #16 to #4 per AD1-MP2.06b

Revise: Keynote #16 to #4 per AD1-MP2.06c

ITEM NO. 1.20: DRAWING MP2.07 – FLOOR PLAN – NEW – WING 3 – MECHANICAL & PLUMBING

Revise: General note #4 per AD1-MP2.07

Add: General note #8 per AD1-MP2.07

ITEM NO. 1.21: DRAWING MP2.08 – FLOOR PLANS – NEW – MUSIC BLDG & MEDIA CENTER – MECHANICAL & PLUMBING

Revise: New Sheet Note #1 per AD1-MP2.08

**ADDENDUM NO. 1**

11/24/2021

Abbott Middle School HVAC Replacement  
San Mateo – Foster City School District  
Aedis Project No. 2021005.06

ITEM NO. 1.22: DRAWING MP2.09 – FLOOR PLANS – NEW – MULTIPURPOSE BUILDING – MECHANICAL & PLUMBING

Revise: Location of CU-14 and CU-13 per AD1-MP2.09

Add: General note #5 per AD1-MP2.09

ITEM NO. 1.23: DRAWING MP6.01– DETAILS – MECHANICAL & PLUMBING

Revise: Detail 6 per AD1-MP6.01

ITEM NO. 1.24: DRAWING SHEET MP6.02 – DETAILS – MECHANICAL & PLUMBING

Revise: Detail 4 per AD1-MP6.02

Add: Detail 6 per AD1-MP6.02

**ELECTRICAL**

ITEM NO. 1.25: DRAWING SHEET E1.1 – ELECTRICAL SITE PLAN

Revise: Site Plan layout at 2-Story Multipurpose Bldg. per AD1-E1.1.

Revise: Sheet Note #5 and #6 per AD1-E1.1.

ITEM NO. 1.26: DRAWING SHEET E3.1 – ELECTRICAL NEW FLOOR PLANS – WINGS 1, 2 & 3

Revise: Electrical plan 1/E3.1, 2/E3.1 & 3/E3.31per AD1-E3.1

Revise: Sheet Noters #1, #2 & #4 per AD1-E3.1

Omit: Sheet Noters #4 per AD1-E3.1

ITEM NO. 1.27: DRAWING SHEET E3.3 – ELECTRICAL NEW FLOOR PLANS – MUSIC BLDG & MEDIA CENTER

Revise: Electrical plan 1/E3.3, 2/E3.3 & 3/E3.3 per AD1-E3.3

Revise: Sheet Noters #1 & #2 per AD1-E3.3

ITEM NO. 1.28: DRAWING SHEET E4.3 – PANEL SCHEDULES

Revise: Panel Schedule per AD1-E4.3

**ADDENDUM NO. 1**

Abbott Middle School HVAC Replacement  
San Mateo – Foster City School District  
Aedis Project No. 2021005.06

11/24/2021



---

Aedis Architects  
Thang Do, Principal



---

Electrical, American Consulting Engineers Electrical  
Sammy Fernandez



---

Mechanical, Cypress Engineering Group  
Metin Serttunc

---

Division of the State Architect

**ADDENDUM NO. 1**

Abbott Middle School HVAC Replacement  
San Mateo – Foster City School District  
Aedis Project No. 2021005.06

11/24/2021

**Attachments:**

Specifications:

07 31 13 Asphalt Shingles (11 pages)  
07 51 13 Build-Up Asphalt Roofing (12 pages)  
31 23 16 Trenching (5 pages)

Drawing:

**ARCHITECTURAL:**

SHEET AD1-A1.02  
SHEET AD1-A2.01  
SHEET AD1-A2.02  
SHEET AD1-A3.01  
SHEET AD1-A5.01  
SHEET AD1-A8.10A  
SHEET AD1-A8.10B  
SHEET AD1-A9.10A  
SHEET AD1-A9.10B  
SHEET AD1-A11.01

**MECHANICAL:**

SHEET AD1-MP0.02  
SHEET AD1-MP2.01  
SHEET AD1-MP2.04  
SHEET AD1-MP2.06a  
SHEET AD1-MP2.06b  
SHEET AD1-MP2.06c  
SHEET AD1-MP2.07  
SHEET AD1-MP2.08  
SHEET AD1-MP2.09  
SHEET AD1-MP6.01  
SHEET AD1-MP6.02

**ELECTRICAL:**

SHEET AD1-E1.1  
SHEET AD1-E3.1  
SHEET AD1-E3.3  
SHEET AD1-E4.3

SECTION 073113 - ASPHALT SHINGLES

PART 1 - GENERAL

1.1 SUMMARY

- A. Section Includes:
  - 1. Glass-fiber-reinforced asphalt shingles.
  - 2. Underlayment materials.

1.2 DEFINITIONS

- A. Roofing Terminology: See ASTM D1079 for definitions of terms related to roofing Work in this Section.

1.3 PREINSTALLATION MEETINGS

- A. Preinstallation Conference: Conduct conference at Project site.

1.4 ACTION SUBMITTALS

- A. Product Data: For the following:
  - 1. Asphalt shingles.
  - 2. Underlayment materials.
  - 3. Asphalt roofing cement.
  - 4. Elastomeric flashing sealant.
- B. Shop Drawings: For metal flashing and trim.
- C. Samples for Initial Selection:
  - 1. For each type of asphalt shingle indicated.
  - 2. For each type of accessory involving color selection.
- D. Samples for Verification: For the following products, in sizes indicated:
  - 1. Asphalt Shingles: Full size.
  - 2. Ridge and Hip Cap Shingles: Full size.
  - 3. Ridge Vent: 12-inch- (305-mm-) long Sample.
  - 4. Exposed Valley Lining: 12 inches (305 mm) square.

ABBOTT MIDDLE SCHOOL HVAC REPLACEMENT  
San Mateo-Foster City School District  
Project No 2021005.06

1.5 INFORMATIONAL SUBMITTALS

- A. Qualification Data: For Installer.
- B. Product Test Reports: For each type of asphalt shingle and underlayment product indicated, for tests performed by manufacturer and witnessed by a qualified testing agency.
- C. Research Reports: For synthetic underlayment, from ICC-ES, indicating that product is suitable for intended use under applicable building codes.
- D. Sample Warranty: For manufacturer's materials warranty.

1.6 CLOSEOUT SUBMITTALS

- A. Maintenance Data: For asphalt shingles to include in maintenance manuals.
- B. Materials warranties.
- C. Roofing Installer's warranty.

1.7 QUALITY ASSURANCE

- A. Installer Qualifications: An authorized installer who is trained and approved by manufacturer.

1.8 DELIVERY, STORAGE, AND HANDLING

- A. Store roofing materials in a dry, well-ventilated location protected from weather, sunlight, and moisture in accordance with manufacturer's written instructions.
- B. Store underlayment rolls on end, on pallets or other raised surfaces. Do not double-stack rolls.
- C. Protect unused roofing materials from weather, sunlight, and moisture when left overnight or when roofing Work is not in progress.
- D. Handle, store, and place roofing materials in a manner to prevent damage to roof deck or structural supporting members.

1.9 FIELD CONDITIONS

- A. Environmental Limitations: Proceed with installation only when existing and forecasted weather conditions permit product installation and related Work to be performed in accordance with manufacturer's written instructions and warranty requirements.

1. Install self-adhering, polymer-modified bitumen sheet underlayment within the range of ambient and substrate temperatures recommended in writing by manufacturer.

#### 1.10 WARRANTY

- A. Materials Warranty: Manufacturer agrees to repair or replace asphalt shingles that fail within specified warranty period.
  1. Failures include, but are not limited to, the following:
    - a. Manufacturing defects.
  2. Materials Warranty Period: 40 years from date of Substantial Completion, prorated, with first 20 years nonprorated.
  3. Wind-Speed Warranty Period: Asphalt shingles will resist blow-off or damage caused by wind speeds of up to 110 mph (49 m/s) 130 mph (58 m/s) for 15 years from date of Substantial Completion.
  4. Algae-Resistance Warranty Period: Asphalt shingles will not discolor for 10 years from date of Substantial Completion.
  5. Workmanship Warranty Period: 20 years from date of Substantial Completion.
- B. Roofing Installer's Warranty: On warranty form at end of this Section, signed by Installer, in which Installer agrees to repair or replace components of asphalt shingle roofing that fail in materials or workmanship within specified warranty period.
  1. Warranty Period: Five years from date of Substantial Completion.

### PART 2 - PRODUCTS

#### 2.1 SOURCE LIMITATIONS

- A. Obtain each type of product from single source from single manufacturer.

#### 2.2 PERFORMANCE REQUIREMENTS

- A. Exterior Fire-Test Exposure: Provide asphalt shingles and related roofing materials identical to those of assemblies tested for Class A fire resistance in accordance with ASTM E108 or UL 790 by Underwriters Laboratories or another testing and inspecting agency acceptable to authorities having jurisdiction. Identify products with appropriate markings of applicable testing agency.
- B. Wind Resistance: Provide asphalt shingles that comply with requirements of ASTM D3161/D3161M, Class F, and with ASTM D7158/D7158M, Class H.
- C. Energy Performance, ENERGY STAR: Provide asphalt shingles that are listed on the DOE's "ENERGY STAR Roof Product List" for steep-slope roof products.

### 2.3 GLASS-FIBER-REINFORCED ASPHALT SHINGLES

- A. Laminated-Strip Asphalt Shingles: ASTM D3462/D3462M, laminated, multi-ply overlay construction; glass-fiber reinforced, mineral-granule surfaced, and self-sealing.
  - 1. Products: Subject to compliance with requirements, provide the following:
    - a. GAF; Timberline HD Reflector Series.
  - 2. Butt Edge: Straight cut.
  - 3. Strip Size: Manufacturer's standard.
  - 4. Algae Resistance: Granules resist algae discoloration.
  - 5. Color and Blends: As selected by Architect from manufacturer's full range.
- B. Hip and Ridge Shingles: Manufacturer's standard units to match asphalt shingles.

### 2.4 UNDERLAYMENT MATERIALS

- A. Fiberglass-reinforced Felt: Asphalt-saturated, fiberglass-reinforced organic felts, nonperforated and complying with ASTM D226 Type II.
  - 1. Products: Subject to compliance with requirements, provide the following:
    - a. GAF; Shingle-Mate.

### 2.5 ACCESSORIES

- A. Asphalt Roofing Cement: ASTM D4586/D4586M Type II, asbestos free.
- B. Elastomeric Flashing Sealant: ASTM C920, Type S, Grade NS, one-part, non-sag, elastomeric polymer sealant; of class and use classifications required to seal joints and remain watertight; recommended in writing by manufacturer for installation of flashing systems.
- C. Roofing Nails: ASTM F1667, aluminum, stainless steel, copper, or hot-dip galvanized-steel wire shingle nails, minimum **0.120-inch- (3-mm-)** diameter, sharp-pointed, with a **3/8- to 7/16-inch- (10- to 11-mm-)** diameter flat head and of sufficient length to penetrate **3/4 inch (19 mm)** into solid wood decking or extend at least **1/8 inch (3 mm)** through sheathing less than **3/4 inch (19 mm)** thick.
  - 1. Where nails are in contact with metal flashing, use nails made from same metal as flashing.
- D. Underlayment Nails: Aluminum, stainless steel, or hot-dip galvanized-steel wire nails with low-profile metal or plastic caps, **1-inch- (25-mm-)** minimum diameter.
  - 1. Provide with minimum **0.0134-inch- (0.34-mm-)** thick metal cap, **0.010-inch- (0.25-mm-)** thick power-driven metal cap, or **0.035-inch- (0.89-mm-)** thick plastic cap; and with minimum **0.083-inch- (2.11-mm-)** thick ring shank or **0.091-inch- (2.31-**

mm-) thick smooth shank of length to penetrate at least **3/4 inch (19 mm)** into roof sheathing or to penetrate through roof sheathing less than **3/4 inch (19 mm)** thick.

## 2.6 METAL FLASHING AND TRIM

### A. Comply with requirements in Section 076200 "Sheet Metal Flashing and Trim."

1. Sheet Metal: Stainless steel.

### B. Fabricate sheet metal flashing and trim to comply with recommendations in SMACNA's "Architectural Sheet Metal Manual" that apply to design, dimensions, metal, and other characteristics of the item unless otherwise specified in this Section or indicated on Drawings.

1. Apron Flashings: Fabricate with lower flange a minimum of **4 inches (102 mm)** over and **4 inches (102 mm)** beyond each side of downslope asphalt shingles and **6 inches (152 mm)** up the vertical surface.
2. Step Flashings: Fabricate with a headlap of **2 inches (51 mm)** and a minimum extension of **4 inches (102 mm)** over the underlying asphalt shingle and up the vertical surface.
3. Counterflashings: Fabricate to cover **4 inches (102 mm)** of base flashing measured vertically; and in lengths required so that no step exceeds **8 inches (203 mm)** and overall length is no more than **10 feet (3 m)**.
  - a. Provide metal reglets for installation.
4. Open-Valley Flashings: Fabricate from metal sheet not less than **24 inches (610 mm)** wide in lengths not exceeding **10 feet (3 m)**, with **1-inch- (25-mm-)** high, inverted-V profile water diverter at center of valley and equal flange widths of not less than **11 inches (279 mm)**.
  - a. Hem flange edges for fastening with metal cleats.
  - b. Add stiffening ribs in flashings to promote drainage.
5. Drip Edges: Fabricate in lengths not exceeding **10 feet (3 m)** with minimum **2-inch (51-mm)** roof-deck flange and **1-1/2-inch (38-mm)** fascia flange with **3/8-inch (10-mm)** drip at lower edge.
6. Vent-Pipe Flashings: ASTM B749, Type L51121, at least **1/16 inch (1.6 mm)** thick. Provide lead sleeve sized to slip over and turn down into pipe, soldered to skirt at slope of roof, and extending at least **4 inches (102 mm)** from pipe onto roof.

## PART 3 - EXECUTION

### 3.1 EXAMINATION

- A. Examine substrates, areas, and conditions, with Installer present, for compliance with requirements for installation tolerances and other conditions affecting performance of the Work.
  - 1. Examine roof sheathing to verify that sheathing joints are supported by framing and blocking or metal clips and that installation is within flatness tolerances.
  - 2. Verify that substrate is sound, dry, smooth, clean, sloped for drainage, and completely anchored and that provisions have been made for flashings and penetrations through asphalt shingles.
  - 3. Verify that vent stacks and other penetrations through roofing are installed and securely fastened.
- B. Prepare written report, endorsed by Installer, listing conditions detrimental to performance of the Work.
- C. Proceed with installation only after unsatisfactory conditions have been corrected.

### 3.2 INSTALLATION OF UNDERLAYMENT MATERIALS

- A. Comply with asphalt shingle and underlayment manufacturers' written installation instructions and with recommendations in NRCA's "The NRCA Roofing Manual: Steep-Slope Roof Systems" applicable to products and applications indicated unless more stringent requirements are specified in this Section or indicated on Drawings.
- B. Asphalt-Saturated, Fiberglass Reinforced Felt: Install on roof deck parallel with and starting at eaves and fasten with underlayment nails.
  - 1. Single-Layer Installation:
    - a. Lap sides a minimum of **4 inches (102 mm)** over underlying course.
    - b. Lap ends a minimum of **4 inches (102 mm)**.
    - c. Stagger end laps between succeeding courses at least **72 inches (1829 mm)**.
  - 2. Double-Layer Installation:
    - a. Install a **19-inch- (483-mm-)** wide starter course at eaves and completely cover with a **36-inch- (914-mm-)** wide second course.
    - b. Install succeeding **36-inch- (914-mm-)** wide courses lapping previous courses **19 inches (483 mm)** in shingle fashion.
    - c. Lap ends a minimum of **4 inches (102 mm)**. Stagger end laps between succeeding courses at least **72 inches (1829 mm)**.
    - d. Apply a continuous layer of asphalt roofing cement over starter course and on felt surface to be concealed by succeeding courses as each felt course is installed. Apply at locations indicated on Drawings.

3. Install felt underlayment on roof deck not covered by self-adhering, polymer-modified bitumen sheet unless otherwise specified in this Section or indicated on Drawings.
    - a. Lap sides of felt over self-adhering sheet not less than 4 inches (102 mm) in direction that sheds water.
    - b. Lap ends of felt not less than 6 inches (152 mm) over self-adhering sheet.
  4. Install fasteners in a grid pattern of 12 inches (305 mm) between side laps with 6-inch (152-mm) spacing at side and end laps.
  5. Terminate felt extended up not less than 4 inches (102 mm) against sidewalls, curbs, chimneys, and other roof projections.
- C. Metal-Flashed, Open-Valley Underlayment: Install two layers of minimum 36-inch- (914-mm-) wide underlayment centered in valley.
1. Use same underlayment as installed on field of roof.
  2. Stagger end laps between layers at least 72 inches (1829 mm).
  3. Lap ends of each layer at least 12 inches (305 mm) in direction that sheds water, and seal with asphalt roofing cement.
  4. Fasten each layer to roof deck with underlayment nails located as far from valley center as possible and only to extent necessary to hold underlayment in place until installation of valley flashing.
  5. Lap roof-deck underlayment over first layer of valley underlayment at least 6 inches (152 mm).

### 3.3 INSTALLATION OF METAL FLASHING AND TRIM

- A. Install metal flashings and trim to comply with requirements in Section 076200 "Sheet Metal Flashing and Trim."
1. Install metal flashings in accordance with recommendations in NRCA's "NRCA Guidelines for Asphalt Shingle Roof Systems."
  2. Bed flanges of metal flashings using asphalt roofing cement or elastomeric flashing sealant.
- B. Apron Flashings: Extend lower flange over and beyond each side of downslope asphalt shingles and up the vertical surface.
- C. Step Flashings: Install with a headlap of 2 inches (51 mm) and extend over underlying shingle and up the vertical face.
1. Install with lower edge of flashing just upslope of, and concealed by, butt of overlying shingle.
  2. Fasten to roof deck only.
- D. Cricket and Backer Flashings: Install against roof-penetrating elements extending concealed flange beneath upslope asphalt shingles and beyond each side.

- E. Counterflashings: Coordinate with installation of base flashing and fit tightly to base flashing. Lap joints a minimum of **4 inches (102 mm)** secured in a waterproof manner.
  - 1. Install in reglets or receivers.
- F. Open-Valley Flashings: Install centered in valleys, lapping ends at least **8 inches (203 mm)** in direction that sheds water. Fasten upper end of each length to roof deck beneath overlap.
  - 1. Secure hemmed flange edges into metal cleats spaced **24 inches (610 mm)** apart and fastened to roof deck.
  - 2. Adhere minimum **9-inch- (229-mm-)** wide strips of self-adhering, polymer-modified bitumen sheet to metal flanges and to underlying self-adhering sheet, polymer-modified bitumen sheet.
    - a. Place strips parallel to and over flanges so that they will be just concealed by installed shingles.
  - 3. Provide a closure at the end of the inverted-V profile of the valley metal to minimize water and ice infiltration.
- G. Rake Drip Edges: Install over underlayment materials and fasten to roof deck.
- H. Eave Drip Edges: Install below underlayment materials and fasten to roof deck.
- I. Pipe Flashings: Form flashing around pipe penetrations and asphalt shingles. Fasten and seal to asphalt shingles as recommended by manufacturer.

### 3.4 INSTALLATION OF ASPHALT SHINGLES

- A. Install asphalt shingles in accordance with manufacturer's written instructions and recommendations in NRCA's "NRCA Guidelines for Asphalt Shingle Roof Systems."
- B. Install starter strip along lowest roof edge, consisting of an asphalt shingle strip at least **7 inches (178 mm)** wide with self-sealing strip face up at roof edge.
  - 1. Extend asphalt shingles **1/2 inch (13 mm)** over fasciae at eaves and rakes.
  - 2. Install starter strip along rake edge.
- C. Install first and remaining courses of laminated asphalt shingles stair-stepping diagonally across roof deck with manufacturer's recommended offset pattern at succeeding courses, maintaining uniform exposure.
- D. Install first and remaining courses of three-tab-strip asphalt shingles stair-stepping diagonally across roof deck with manufacturer's recommended offset pattern at succeeding courses, maintaining uniform exposure.
- E. Fasten asphalt shingle strips with a minimum of four roofing nails, but not less than the number indicated in manufacturer's written instructions for roof slope and design wind speed indicated on Drawings and for warranty requirements specified in this Section.

1. Locate fasteners in accordance with manufacturer's written instructions.
  2. Where roof slope exceeds 18:12, hand seal self-sealing asphalt shingles to improve the shingles' positive bond by applying asphalt roofing cement spots between course overlaps after nailing the upper course.
  3. Where roof slope is less than 4:12, hand seal self-sealing asphalt shingles to improve the shingles' positive bond by applying asphalt roofing cement spots between course overlaps after nailing the upper course.
  4. When ambient temperature during installation is below 50 deg F (10 deg C), hand seal self-sealing asphalt shingles by applying asphalt roofing cement spots between course overlaps after nailing the upper course.
- F. Open Valleys: Cut and fit asphalt shingles at open valleys, trimming upper concealed corners of shingle strips.
1. Maintain uniform width of exposed open valley from highest to lowest point.
  2. Extend shingle a minimum of 4 inches (102 mm) over valley metal.
  3. Set valley edge of asphalt shingles in a 3-inch- (76-mm-) wide bed of asphalt roofing cement.
  4. Do not nail asphalt shingles to metal open-valley flashings.
- G. Ridge Vents: Install continuous ridge vents over asphalt shingles in accordance with manufacturer's written instructions. Fasten with roofing nails of sufficient length to penetrate sheathing.
- H. Hip and Ridge Shingles: Maintain same exposure of cap shingles as roofing-shingle exposure. Lap cap shingles at ridges to shed water away from direction of prevailing winds.
1. Fasten with roofing nails of sufficient length to penetrate sheathing.
  2. Fasten ridge cap asphalt shingles to cover ridge vent without obstructing airflow.

### 3.5 ROOFING INSTALLER'S WARRANTY

- A. WHEREAS <Insert name> of <Insert address>, herein called the "Roofing Installer," has performed roofing and associated work ("the work") on the following project:
1. Owner: <Insert name of Owner>.
  2. Owner Address: <Insert address>.
  3. Building Name/Type: <Insert information>.
  4. Building Address: <Insert address>.
  5. Area of the Work: <Insert information>.
  6. Acceptance Date: <Insert date>.
  7. Warranty Period: <Insert time>.
  8. Expiration Date: <Insert date>.
- B. AND WHEREAS Roofing Installer has contracted (either directly with Owner or indirectly as a subcontractor) to warrant the work against leaks and faulty or defective materials and workmanship for designated Warranty Period,

ABBOTT MIDDLE SCHOOL HVAC REPLACEMENT  
San Mateo-Foster City School District  
Project No 2021005.06

- C. NOW THEREFORE Roofing Installer hereby warrants, subject to terms and conditions herein set forth, that, during Warranty Period, Roofing Installer will, at Roofing Installer's own cost and expense, make or cause to be made such repairs to or replacements of the work as are necessary to correct faulty and defective work and as are necessary to maintain the work in a watertight condition.
- D. This Warranty is made subject to the following terms and conditions:
1. Specifically excluded from this Warranty are damages to the work and other parts of the building, and to building contents, caused by:
    - a. Lightning;
    - b. Peak gust wind speed exceeding 90 mph
    - c. Fire;
    - d. Failure of roofing system substrate, including cracking, settlement, excessive deflection, deterioration, and decomposition;
    - e. Faulty construction of copings, chimneys, skylights, vents, equipment supports, and other edge conditions and penetrations of the work;
    - f. Vapor condensation on bottom of roofing; and
    - g. Activity on roofing by others, including construction contractors, maintenance personnel, other persons, and animals, whether authorized or unauthorized by Owner.
  2. When the work has been damaged by any of foregoing causes, Warranty shall be null and void until such damage has been repaired by Roofing Installer and until cost and expense thereof have been paid by Owner or by another responsible party so designated.
  3. Roofing Installer is responsible for damage to the work covered by this Warranty but is not liable for consequential damages to building or building contents resulting from leaks or faults or defects of the work.
  4. During Warranty Period, if Owner allows alteration of the work by anyone other than Roofing Installer, including cutting, patching, and maintenance in connection with penetrations, attachment of other work, and positioning of anything on roof, this Warranty shall become null and void on date of the alterations, but only to the extent the alterations affect the work covered by this Warranty. If Owner engages Roofing Installer to perform the alterations, Warranty shall not become null and void unless Roofing Installer, before starting the alterations, notified Owner in writing, showing reasonable cause for claim, that the alterations would likely damage or deteriorate the work, thereby reasonably justifying a limitation or termination of this Warranty.
  5. During Warranty Period, if original use of roof is changed and it becomes used for, but was not originally specified for, a use or service more severe than originally specified, this Warranty shall become null and void on date of the change, but only to the extent the change affects the work covered by this Warranty.
  6. Owner shall promptly notify Roofing Installer of observed, known, or suspected leaks, defects, or deterioration and shall afford reasonable opportunity for Roofing Installer to inspect the work and to examine evidence of such leaks, defects, or deterioration.
  7. This Warranty is recognized to be the only warranty of Roofing Installer on the work and shall not operate to restrict or cut off Owner from other remedies and

ABBOTT MIDDLE SCHOOL HVAC REPLACEMENT  
San Mateo-Foster City School District  
Project No. 2021005.06

resources lawfully available to Owner in cases of roofing failure. Specifically, this Warranty shall not operate to relieve Roofing Installer of responsibility for performance of the work according to requirements of the Contract Documents, regardless of whether Contract was a contract directly with Owner or a subcontract with Owner's General Contractor.

END OF SECTION 073113

#### 1.5 ACTION SUBMITTALS

- A. Product Data: For each type of product.
  - 1. For insulation and roof system component fasteners, include copy of SPRI's Directory of Roof Assemblies listing.
- B. Shop Drawings: Include plans, sections, details, and attachments to other work, including the following:
  - 1. Extent of patch and repair work.
  - 2. Details of tying into existing roofing.
- C. Samples for Verification: For the following products:
  - 1. Cap Sheet: Samples of manufacturer's standard colors for selection by Architect.
  - 2. Flashing Sheet: Samples of manufacturer's standard colors for selection by Architect.
  - 3. Aggregate surfacing material in gradation and color required.

#### 1.6 INFORMATIONAL SUBMITTALS

- A. Qualification Data: For Installer and manufacturer.
- B. Evaluation Reports: For components of roofing system, from ICC-ES.
- C. Field quality-control reports.

#### 1.7 CLOSEOUT SUBMITTALS

- A. Maintenance Data: For roofing system to include in maintenance manuals.
- B. Certified statement from existing roof membrane manufacturer, stating that existing roof warranty has not been affected by Work performed under this Section.

#### 1.8 QUALITY ASSURANCE

- A. Manufacturer Qualifications: A qualified manufacturer that is listed in SPRI's Directory of Roof Assemblies for roofing system identical to that used for this Project.
- B. Installer Qualifications: A qualified firm that is approved, authorized, or licensed by roofing system manufacturer to install manufacturer's product and that is eligible to receive manufacturer's special warranty.

## 1.9 DELIVERY, STORAGE, AND HANDLING

- A. Deliver roofing materials to Project site in original containers with seals unbroken and labeled with manufacturer's name, product brand name and type, date of manufacture, approval or listing agency markings, and directions for storing and mixing with other components.
- B. Store liquid materials in their original undamaged containers in a clean, dry, protected location and within the temperature range required by roofing manufacturer.
  - 1. Protect stored liquid material from direct sunlight.
  - 2. Discard and legally dispose of liquid material that cannot be applied within its stated shelf life.
- C. Handle and store roofing materials, and place equipment in a manner to avoid permanent deflection of deck.

## 1.10 FIELD CONDITIONS

- A. Weather Limitations: Proceed with installation only when existing and forecasted weather conditions permit roofing to be installed according to manufacturer's written instructions and warranty requirements.

## PART 2 - PRODUCTS

### 2.1 PERFORMANCE REQUIREMENTS

- A. General Performance: Installed roofing system and flashings shall withstand specified uplift pressures, thermally induced movement, and exposure to weather without failure due to defective manufacture, fabrication, installation, or other defects in construction. Roof system and flashings shall remain watertight.
  - 1. Accelerated Weathering: Roof membrane shall withstand 2000 hours of exposure when tested according to ASTM G152, ASTM G154, or ASTM G155.
  - 2. Impact Resistance: Roof membrane shall resist impact damage when tested according to ASTM D3746/C3746M, ASTM D4272/D4272M, or the "Resistance to Foot Traffic Test" in FM Approvals 4470.
- B. Material Compatibility: Roofing materials shall be compatible with one another and adjacent materials under conditions of service and application required, as demonstrated by roof membrane manufacturer based on testing and field experience.
- C. SPRI's Directory of Roof Assemblies Listing: Roof membrane, base flashings, and component materials shall comply with requirements in FM Approvals 4450 or FM Approvals 4470 as part of a roofing system, and shall be listed in SPRI's Directory of Roof Assemblies for roof assembly identical to that specified for this Project.

- D. ENERGY STAR Listing: Roofing system shall be listed on the DOE's ENERGY STAR "Roof Products Qualified Product List" for low-slope roof products.
- E. Energy Performance: Roofing system shall have an initial solar reflectance of not less than 0.70 and an emissivity of not less than 0.75 when tested according to CRRC-1.
- F. Exterior Fire-Test Exposure: ASTM E108 or UL 790, Class A; for application and roof slopes indicated; testing by a qualified testing agency.
  - 1. Identify products with appropriate markings of applicable testing agency.

## 2.2 MANUFACTURERS

- A. Manufacturers: Subject to compliance with requirements, provide products by the following:
  - 1. GAF.
- B. Source Limitations: Obtain components for roofing system from same manufacturer as roofing membrane.

## 2.3 ROOFING MEMBRANE SHEET MATERIALS

- A. Base Sheet: ASTM D4601/D4601M, Type II, nonperforated, asphalt-impregnated and -coated, glass-fiber sheet, dusted with fine mineral surfacing on both sides.
  - 1. Products: Subject to compliance with requirements, provide the following:
    - a. GAFGLAS #75 Base Sheet.
- B. Ply Sheet: ASTM D2178/D2178M, Type VI, asphalt-impregnated, glass-fiber felt.
  - 1. Products: Subject to compliance with requirements, provide the following:
    - a. GAFGLAS FlexPly 6.
- C. Cap Sheet: ASTM D3909/D3909M, asphalt-impregnated and -coated, glass-fiber cap sheet, with white coarse mineral-granule top surfacing and fine mineral surfacing on bottom surface.
  - 1. Products: Subject to compliance with requirements, provide the following:
    - a. GAFGLAS Energy Cap.

## 2.4 BASE FLASHING SHEET MATERIALS

- A. Backer Sheet: ASTM D2178/D2178M, Type VI, asphalt-impregnated, glass-fiber felt.

- B. Backer Sheet: ASTM D4601/D4601M, Type II, asphalt-impregnated and -coated, glass-fiber sheet, dusted with fine mineral surfacing on both sides.
- C. Glass-Fiber Fabric: Woven glass-fiber cloth, treated with asphalt, complying with ASTM D1668/D1668M, Type I.
- D. Liquid Flashing System: Roof membrane manufacturer's standard one- or two-part moisture curing resin with low solvent content, consisting of a primer, flashing cement, and scrim.

## 2.5 ASPHALT MATERIALS

- A. Asphalt Primer: ASTM D41/D41M.
- B. Roofing Asphalt: ASTM D312/D312M, Type III or IV as recommended by roofing system manufacturer for application.

## 2.6 AUXILIARY ROOFING MATERIALS

- A. General: Auxiliary materials recommended by roofing manufacturer for intended use and compatible with other roofing components.
  - 1. Adhesive and Sealants: Comply with VOC limits of authorities having jurisdiction.
- B. Prefabricated Pipe Flashings: As recommended by roof membrane manufacturer.
- C. Roof Vents: As recommended by roof membrane manufacturer.
  - 1. Size: Not less than 4-inch (100-mm) diameter.
- D. Sheathing Paper: Red-rosin type, minimum 3 lb/100 sq. ft. (0.16 kg/sq. m).
- E. Metal Termination Bars: Manufacturer's standard, predrilled stainless-steel or aluminum bars, approximately 1 by 1/8 inch (25 by 3 mm) thick; with anchors.
- F. Asphalt Roofing Cement: ASTM D4586/D4586M, asbestos free, of consistency required by roofing manufacturer for application.
- G. Mastic Sealant: Polyisobutylene, plain or modified bitumen; nonhardening, nonmigrating, nonskinning, and nondrying.
- H. Fasteners: Factory-coated steel fasteners and metal or plastic plates complying with corrosion-resistance provisions in FM Approvals 4470, designed for fastening built-up roofing components to substrate; tested by manufacturer for required pullout strength, and acceptable to roofing manufacturer.
- I. Miscellaneous Accessories: Provide those recommended by roofing system manufacturer.

## 2.7 COVER BOARDS

- A. Substrate Board: ASTM C208, Type II, Grade 1 Fiberboard roof insulation coverboard with primed red coating.
  - 1. Products: Subject to compliance with requirements, provide the following:
    - a. STRUCTODEK High Density.
  - 2. Thickness: 1/2 inch (13 mm).
  - 3. Surface finish: Factory primed.
- B. Fasteners: Factory-coated steel fasteners and metal or plastic plates complying with corrosion-resistance provisions in FM Approvals 4470, designed for fastening substrate board to roof deck.

## PART 3 - EXECUTION

### 3.1 EXAMINATION

- A. Examine substrates, areas, and conditions, with Installer present, for compliance with requirements and other conditions affecting performance of the Work:
  - 1. Verify that roof openings and penetrations are in place, curbs are set and braced, and roof-drain bodies are securely clamped in place.
  - 2. Verify that wood cants, blocking, curbs, and nailers are securely anchored to roof deck at penetrations and terminations and that nailers match thicknesses of insulation.
  - 3. Verify that deck is securely fastened with no projecting fasteners and with no adjacent units in excess of 1/16 inch (1.6 mm) out of plane relative to adjoining deck.
- B. Proceed with installation only after unsatisfactory conditions have been corrected.

### 3.2 PREPARATION

- A. Clean substrate of dust, debris, moisture, and other substances detrimental to roofing installation according to roofing manufacturer's written instructions.
  - 1. Remove sharp projections.
- B. Prevent materials from entering and clogging roof drains and conductors and from spilling or migrating onto surfaces of other construction.
  - 1. Remove roof-drain plugs when no work is taking place or when rain is forecast.

### 3.3 INSTALLATION OF ROOFING, GENERAL

- A. Install roofing system according to manufacturer's written instructions, SPRI's Directory of Roof Assemblies listed roof assembly requirements, and FM Global Property Loss Prevention Data Sheet 1-29.
- B. Complete terminations and base flashings, and provide temporary seals to prevent water from entering completed sections of roofing system at the end of the workday or when rain is forecast.
  - 1. Remove and discard temporary seals before beginning work on adjoining roofing.
- C. Install roof membrane and auxiliary materials to tie in to existing roofing to maintain weathertightness of transition and to not void warranty for existing roofing system.
- D. Asphalt Heating:
  - 1. Heat asphalt to its equiviscous temperature, measured at the mop cart or mechanical spreader immediately before application.
  - 2. Circulate asphalt during heating.
    - a. Do not raise asphalt temperature above equiviscous temperature range more than one hour before time of application.
  - 3. Do not exceed asphalt manufacturer's recommended temperature limits during asphalt heating.
  - 4. Do not heat asphalt within **25 deg F (14 deg C)** of flash point.
  - 5. Discard asphalt maintained at a temperature exceeding finished blowing temperature for more than four hours.
    - a. Apply hot roofing asphalt within plus or minus **25 deg F (14 deg C)** of equiviscous temperature.
- E. Substrate-Joint Penetrations: Prevent roofing asphalt and adhesives from penetrating substrate joints, entering building, or damaging roofing components or adjacent building construction.

### 3.4 INSTALLATION OF COVER BOARDS

- A. Install cover boards over insulation with long joints in continuous straight lines, with end joints staggered between rows. Offset joints of insulation below a minimum of **6 inches (150 mm)** in each direction.
  - 1. Trim cover board neatly to fit around penetrations and projections, and to fit tight to intersecting sloping roof decks.
  - 2. At internal roof drains, conform to slope of drain sump.
    - a. Trim cover board so that the flow of water is not restricted.

## ABBOTT MIDDLE SCHOOL HVAC REPLACEMENT

San Mateo-Foster City School District

Project No. 2021005.06

3. Cut and fit cover board tight to nailers, projections, and penetrations.
  4. Adhere cover board to substrate using adhesive according to SPRI's Directory of Roof Assemblies listed roof assembly requirements for specified Wind Uplift Load Capacity and FM Global Property Loss Prevention Data Sheet 1-29, as follows:
    - a. Set cover board in a solid mopping of hot roofing asphalt, applied within plus or minus **25 deg F (14 deg C)** of equiviscous temperature.
- B. Install sheathing paper over cover board and immediately beneath roof membrane.

### 3.5 INSTALLATION OF BUILT-UP ROOFING MEMBRANE

- A. Install roofing according to roofing manufacturer's written instructions and applicable recommendations of ARMA/NRCA's "Quality Control Guidelines for the Application of Built-up Roofing" and as follows:
1. Base Sheet: One.
  2. Number of Ply Sheets: Two.
  3. Surfacing: Mineral-granule-surfaced cap sheet.
  4. Mineral-granule-surfaced cap sheet is in addition to number of ply sheets specified.
- B. Start installation of roofing in presence of roofing system manufacturer's technical personnel.
- C. Where roof slope exceeds **1/2 inch per 12 inches (1:24)**, install roofing ply sheets parallel with slope.
- D. Coordinate installation of roofing, so insulation and other components of roofing system not permanently exposed are not subjected to precipitation or left uncovered at the end of the workday or when rain is forecast.
1. Provide tie-offs at end of each day's work to cover exposed roofing membrane sheets and insulation with a course of coated felt set in roofing cement or hot roofing asphalt, with joints and edges sealed.
  2. Complete terminations and base flashings, and provide temporary seals to prevent water from entering completed sections of roofing system.
  3. Remove and discard temporary seals before beginning work on adjoining roofing.
- E. Loosely lay one course of sheathing paper, lapping edges and ends a minimum of **2 inches (51 mm)** and **6 inches (150 mm)**, respectively.
- F. Install lapped base sheet course, extending sheet over and terminating beyond cants. Attach base sheet as follows:
1. Mechanically fasten to substrate.
- G. Install two ply sheets, starting at low point of roof.
1. Align ply sheets without stretching.

2. Shingle side laps of ply sheets uniformly to achieve required number of plies throughout thickness of roofing membrane.
  - a. Shingle in direction to shed water.
3. Extend ply sheets over and terminate above cants.
4. Embed each ply sheet in a solid mopping of hot roofing asphalt applied at rate required by roofing manufacturer, to form a uniform membrane without ply sheets touching.
5. Install ply sheets without wrinkles, tears, and free from air pockets.

H. Cap Sheet: Install lapped granulated cap sheet, starting at low point of roofing.

1. Offset laps from laps of preceding ply sheets, and align cap sheet without stretching.
2. Lap in direction to shed water.
3. Extend cap sheet over and terminate above cants.
4. Embed cap sheet in a solid mopping of hot roofing asphalt applied at rate required by roofing system manufacturer.
5. Install cap sheet without wrinkles, tears, and free from air pockets.

### 3.6 INSTALLATION OF FLASHING AND STRIPPING

- A. Install base flashing over cant strips and other sloping and vertical surfaces, at roof edges, and at penetrations through roof; secure to substrates according to roofing system manufacturer's written instructions and as follows:
  1. Prime substrates with asphalt primer if required by roofing system manufacturer.
  2. Backer Sheet Application: Mechanically fasten backer sheet to walls or parapets. Adhere backer sheet over roofing membrane at cants in a solid mopping of hot roofing asphalt.
  3. Flashing Sheet Application: Adhere flashing sheet to substrate in a solid mopping of hot roofing asphalt applied at not less than **425 deg F (218 deg C)**. Apply hot roofing asphalt to back of flashing sheet if recommended by roofing manufacturer.
- B. Extend base flashing up walls or parapets a minimum of **8 inches (200 mm)** above built-up roofing and **4 inches (100 mm)** onto field of roofing membrane.
- C. Mechanically fasten top of base flashing securely at terminations and perimeter of roofing.
- D. Install stripping according to roofing system manufacturer's written instructions, where metal flanges and edgings are set on roofing membrane.
  1. Flashing Sheet Stripping: Install flashing sheet stripping in a continuous coating of asphalt roofing cement, in a solid mopping of hot roofing asphalt applied at not less than **425 deg F (218 deg C)**, and extend onto roofing membrane, in cold-applied adhesive, or in cold-applied polymer-modified adhesive.
- E. Roof Drains: Set **30-by-30-inch (760-by-760-mm) 4-pound (1.8-kg)** lead flashing in bed of asphaltic adhesive on completed roofing membrane.

1. Cover metal flashing with roofing cap sheet stripping, and extend a minimum of **4 inches (100 mm)** beyond edge of metal flashing onto field of roofing membrane.
2. Clamp roofing membrane, metal flashing, and stripping into roof-drain clamping ring.
3. Install stripping according to roofing manufacturer's written instructions.

### 3.7 FIELD QUALITY CONTROL

- A. Testing Agency: Engage a qualified testing agency to inspect substrate conditions, surface preparation, roof membrane application, flashings, protection, and drainage components, and to furnish reports to Architect.
- B. Perform the following tests:
  1. High-Voltage Spark Testing: Testing agency shall survey entire roof area, flashings, and parapet walls to locate discontinuity in the roof membrane using an electrically charged metal "broom head."
    - a. Perform tests before overlying construction is placed.
    - b. After testing, repair areas of discontinuities, repeat tests, and make further repairs until roofing and flashing installations are contiguous.
      - 1) Cost of retesting is Contractor's responsibility.
    - c. Testing agency shall prepare survey report indicating locations of initial discontinuities.
- C. Test Cuts: Remove test specimens to evaluate problems observed during quality-assurance inspections of roofing system as follows:
  1. Determine approximate quantities of components within roofing system according to ASTM D3617/D3617M.
  2. Examine test specimens for interply voids according to ASTM D3617/D3617M and to comply with criteria established in Appendix 3 in ARMA/NRCA's "Quality Control Guidelines for the Application of Built-up Roofing."
  3. Repair areas where test cuts were made according to roofing manufacturer's written instructions.
- D. Final Roof Inspection: Arrange for roofing system manufacturer's technical personnel to inspect roofing installation on completion, in presence of Architect, and to prepare inspection report.
  1. Notify Architect and Owner 48 hours in advance of date and time of inspection.
- E. Repair or remove and replace components of roofing system where inspections indicate that they do not comply with specified requirements.
- F. Roofing system will be considered defective if it does not pass tests and inspections.
  1. Additional testing and inspecting, at Contractor's expense, will be performed to determine compliance of replaced or additional work with specified requirements.

3.8 PROTECTING AND CLEANING

- A. Protect roofing system from damage and wear during remainder of construction period.
  - 1. When remaining construction does not affect or endanger roofing, inspect roofing system for deterioration and damage, describing its nature and extent in a written report, with copies to Architect and Owner.
- B. Correct deficiencies in or remove roofing components that do not comply with requirements, repair substrates, and repair or reinstall roofing to a condition free of damage and deterioration at time of Substantial Completion and according to warranty requirements.
- C. Clean overspray and spillage from adjacent construction using cleaning agents and procedures recommended by manufacturer of affected construction.

3.9 ROOFING INSTALLER'S WARRANTY

- A. WHEREAS \_\_\_\_\_ of \_\_\_\_\_, herein called the "Roofing Installer," has performed roofing and associated work ("work") on the following project:
  - 1. Owner: **<Insert name of Owner>**.
  - 2. Address: **<Insert address>**.
  - 3. Building Name/Type: **<Insert information>**.
  - 4. Address: **<Insert address>**.
  - 5. Area of Work: **<Insert information>**.
  - 6. Acceptance Date: \_\_\_\_\_.
  - 7. Warranty Period: **<Insert time>**.
  - 8. Expiration Date: \_\_\_\_\_.
- B. AND WHEREAS Roofing Installer has contracted (either directly with Owner or indirectly as a subcontractor) to warrant said work against leaks and faulty or defective materials and workmanship for designated Warranty Period,
- C. NOW THEREFORE Roofing Installer hereby warrants, subject to terms and conditions herein set forth, that during Warranty Period Roofing Installer will, at Roofing Installer's own cost and expense, make or cause to be made such repairs to or replacements of said work as are necessary to correct faulty and defective work and as are necessary to maintain said work in a watertight condition.
- D. This Warranty is made subject to the following terms and conditions:
  - 1. Specifically excluded from this Warranty are damages to work and other parts of the building, and to building contents, caused by:
    - a. lightning;
    - b. peak gust wind speed exceeding 90 **mph**

ABBOTT MIDDLE SCHOOL HVAC REPLACEMENT

San Mateo-Foster City School District

Project No. 2021005.06

- c. fire;
  - d. failure of roofing system substrate, including cracking, settlement, excessive deflection, deterioration, and decomposition;
  - e. faulty construction of parapet walls, copings, chimneys, skylights, vents, equipment supports, and other edge conditions and penetrations of the work;
  - f. vapor condensation on bottom of roofing; and
  - g. activity on roofing by others, including construction contractors, maintenance personnel, other persons, and animals, whether authorized or unauthorized by Owner.
2. When work has been damaged by any of foregoing causes, Warranty shall be null and void until such damage has been repaired by Roofing Installer and until cost and expense thereof have been paid by Owner or by another responsible party so designated.
  3. Roofing Installer is responsible for damage to work covered by this Warranty but is not liable for consequential damages to building or building contents resulting from leaks or faults or defects of work.
  4. During Warranty Period, if Owner allows alteration of work by anyone other than Roofing Installer, including cutting, patching, and maintenance in connection with penetrations, attachment of other work, and positioning of anything on roof, this Warranty shall become null and void on date of said alterations, but only to the extent said alterations affect work covered by this Warranty. If Owner engages Roofing Installer to perform said alterations, Warranty shall not become null and void unless Roofing Installer, before starting said work, shall have notified Owner in writing, showing reasonable cause for claim, that said alterations would likely damage or deteriorate work, thereby reasonably justifying a limitation or termination of this Warranty.
  5. During Warranty Period, if original use of roof is changed and it becomes used for, but was not originally specified for, a promenade, work deck, spray-cooled surface, flooded basin, or other use or service more severe than originally specified, this Warranty shall become null and void on date of said change, but only to the extent said change affects work covered by this Warranty.
  6. Owner shall promptly notify Roofing Installer of observed, known, or suspected leaks, defects, or deterioration and shall afford reasonable opportunity for Roofing Installer to inspect work and to examine evidence of such leaks, defects, or deterioration.
  7. This Warranty is recognized to be the only warranty of Roofing Installer on said work and shall not operate to restrict or cut off Owner from other remedies and resources lawfully available to Owner in cases of roofing failure. Specifically, this Warranty shall not operate to relieve Roofing Installer of responsibility for performance of original work according to requirements of the Contract Documents, regardless of whether Contract was a contract directly with Owner or a subcontract with Owner's General Contractor.

E. IN WITNESS THEREOF, this instrument has been duly executed this \_\_\_\_\_ day of \_\_\_\_\_, \_\_\_\_\_.

1. Authorized Signature: \_\_\_\_\_.
2. Name: \_\_\_\_\_.
3. Title: \_\_\_\_\_.

END OF SECTION 075113

SECTION 312316 – TRENCHING

PART 1 GENERAL

1.1 SUMMARY

- A. Section includes excavating trenches for utilities from outside building to final connection point or public right-of-way or utility; compacted fill from top of utility bedding to subgrade elevations; and backfilling and compaction.
- B. Related Sections:
  - 1. Section 03 30 00 – Cast-in-Place Concrete.

1.2 DEFINITIONS

- A. Utility: Any buried pipe, duct, conduit, or cable.

1.3 FIELD MEASUREMENTS

- A. Verify field measurements prior to fabrication.

1.4 COORDINATION

- A. Section 01 06 00 - Regulatory Requirements.
- B. Verify Work associated with lower elevation utilities is complete before placing higher elevation utilities.
- C. Verify elevations of existing facilities prior to placing new Work.

PART 2 PRODUCTS

2.1 FILL MATERIALS

- A. Fill and Structural Fill shall be: As specified in the project Soils Report and any supplements to the Soils Report.

2.2 ACCESSORIES

- A. Filter Fabric: Non-biodegradable, woven as manufactured by TC Mirafi, Tenax Corp., Tensar Earth Technologies, Inc. or equal.

PART 3 EXECUTION

3.1 LINES AND GRADES

A. Grades

1. Pipes shall be laid true to the lines and grades indicated.
2. The grade alignment of the pipe shall be maintained by the use of a string line parallel with the grade line and vertically above the centerline of the pipe. This line shall be established on level batter boards at intervals of not more than 25 feet. Batter boards shall span the trench and be rigidly anchored to substantial posts driven into the ground on each side of the trench. Three adjacent batter boards must be set before laying pipe to provide a check on the grades and line. Elevation and position of the string line shall be determined from the elevation and position of offset points or stakes located along the pipe route. Pipe shall not be laid using side lines for line or grade.
3. As an alternative means of establishing alignment and grade, a "Laser-Beam" instrument may be utilized with a competent operator.

B. Location of Pipe Lines:

1. The location and approximate depths of the proposed pipe lines are shown on the Drawings.
2. An underground locate service shall be enlisted to discover the location of existing utilities regardless if they are shown on the drawings.
3. The Architect/Engineer reserves the right to make changes in lines, grades, and depths of pipe lines and manholes when such changes are necessary.

3.2 PREPARATION

- A. Identify required lines, levels, contours, and datum locations.
- B. Protect plant life, lawns, and other features remaining as a portion of final landscaping.
- C. Protect bench marks, existing structures, fences, sidewalks, paving, and curbs from excavating equipment and vehicular traffic.
- D. Maintain and protect above and below grade utilities which are to remain.
- E. Cut out soft areas of subgrade not capable of compaction in place. Backfill and compact to density equal to or greater than requirements for subsequent backfill material.

3.3 EXCAVATING

- A. Excavate subsoil required for utilities.

- B. Cut trenches sufficiently wide to enable installation and allow inspection. Remove water or materials that interfere with Work.
- C. Do not interfere with 45 degree bearing splay of foundations.
- D. Hand trim excavation. Hand trim for bell and spigot pipe joints. Remove loose matter.
- E. Remove lumped subsoil, boulders, and rock as directed by the Soils Engineer or other inspector.
- F. Correct over excavated areas with backfill and compact replacement as specified for authorized excavation.
- G. Stockpile excavated material on site. Remove excess material not being used from site.

### 3.4 TRENCHING

- A. Excavations:
  - 1. Excavation shall be dug so that the pipe can be laid and jointed properly. The trench shall be made so that the pipe can be laid to the alignment and depth as shown on the Drawings, and it shall be excavated only so far in advance of pipe laying as permitted by the Architect/Engineer. The excavation shall not be more than two feet wider at the bottom than the outside diameter of the pipe or structure. If there is no interference with construction, or adjacent property, and if soil permits, the Contractor at his own expense shall be permitted to slope the side walls of the excavation starting at a point two (2) feet above the top of pipe.
  - 2. The trench shall be excavated to the depth required so as to provide a uniform and continuous bearing and support for the pipe on bedding material at every point between joints, except where pipe slings or other lifting tackle are withdrawn.
  - 3. Excavation Below Grade:
    - 1) Where excavation indicates that the subsurface materials at the bottom of the trench are in a loose or soft state, the Contractor shall be advised to excavate to a depth where suitable material is encountered, as directed by the Architect/Engineer.
    - 2) Where the bottom of the trench has been excavated by mistake to a greater depth than required, the Contractor shall refill this area using approved material. No additional compensation shall be given to the Contractor. Refilling with earth to bring the bottom of the trench to the proper grade will not be permitted.
  - 4. Excavation within 24 inches of existing utilities shall be governed by specifications of the Owner of the respective utility. The Contractor shall obtain these specifications and follow the same at no extra cost.

5. Excavation and shoring shall adhere to the requirements and safety standards set by OSHA.

- B. Trenching in Advance of Pipe Laying: The trench for the pipe lines shall not be opened for a distance of more than 200 feet at any one time, unless authorized by the Architect/Engineer. At no time will the Contractor be permitted to leave more than 50 feet of trench open at the end of a working day. Adequate protection of open trench shall be provided by the Contractor and the Contractor shall be responsible therefore.

### 3.5 SHEETING AND BRACING

#### A. General:

1. Sheeting and bracing of all excavations shall conform to the latest statutes of the State of California governing safety of workers in the construction industry. When necessary, in the opinion of the Contractor, adequate sheeting and bracing shall be installed to prevent ground movement that may cause damage or settlement to adjacent structures, pipelines and utilities. Any damage due to settlement because of failure to use sheeting or because of inadequate bracing, or through negligence or fault of the Contractor in any other manner, shall be repaired at the Contractor's expense.
2. Sides of trenches in unsuitable, loose or soft material, five feet or more in depth, shall be shored, sheeted, braced, sloped, or otherwise supported by means of sufficient strength to protect employees working within them.

#### B. Sheeting Requirements:

3. Where excavations are made with vertical sides which require supporting, the sheeting and bracing shall be of sufficient strength to sustain the sides of the excavations and to prevent movement which could in any way injure the Work, or adjacent structures, or diminish the working space sufficiently to delay the Work. Special precautions shall be taken where there is additional pressure due to the presence of other structures.
4. It shall be the Contractor's responsibility to select sheeting and bracing of sufficient dimensions and strength and type to adequately support the sides of trenches and excavations.
5. Sheeting and bracing shall be removed before the completion of the Work.

### 3.6 BACKFILLING

- A. Backfill trenches to contours and elevations shown on the drawings.
- B. Systematically backfill to allow maximum time for natural settlement. Do not backfill over porous, wet, or spongy subgrade surfaces.
- C. Fill materials shall be as specified in the Soils Report and any supplements to the Soils Report.

- D. Employ a placement method that does not disturb or damage utilities in trench. Jetting of backfill materials to achieve compaction shall not be permitted.
- E. Maintain optimum moisture content of fill materials to attain required compaction density.
- F. Remove surplus fill materials from site.

3.7 TOLERANCES

- A. Section 01 40 00 - Quality Requirements.
- B. Top Surface of Backfilling Under Paved Areas: Plus or minus 0.05 feet from required elevations.
- C. Top Surface of General Backfilling: Plus or minus 1/10 feet from required elevations.

3.8 FIELD QUALITY CONTROL

- A. Compaction testing will be performed by the project Soils Engineer.
- B. If tests indicate Work does not meet specified requirements, remove Work, replace, compact, and retest.

3.9 PROTECTION OF FINISHED WORK

- A. Section 01 70 00 - Execution and Closeout Requirements.
- B. Reshape and re-compact fills subjected to vehicular traffic during construction.

END OF SECTION



PROJECT  
**ABBOTT MIDDLE SCHOOL - HVAC REPLACEMENT**

SAN MATEO-FOSTER CITY SCHOOL DISTRICT  
CONSULTANT




STATE  
DSA FILE NUMBER 41-26  
APPL # 01-119556

REVISIONS	No.	Description	Date
▲	Addendum 1		11/24/2021


MILESTONES	DATE
DD	
90% CD	
DSA SUB	06/03/21
BACKCHECK	09/29/21

SHEET  
**DEMOLITION FLOOR PLAN - WINGS 1, 2, & 3**


DATE 11/24/2021  
JOB # 2021005.06  
SHEET # AD1-A2.01

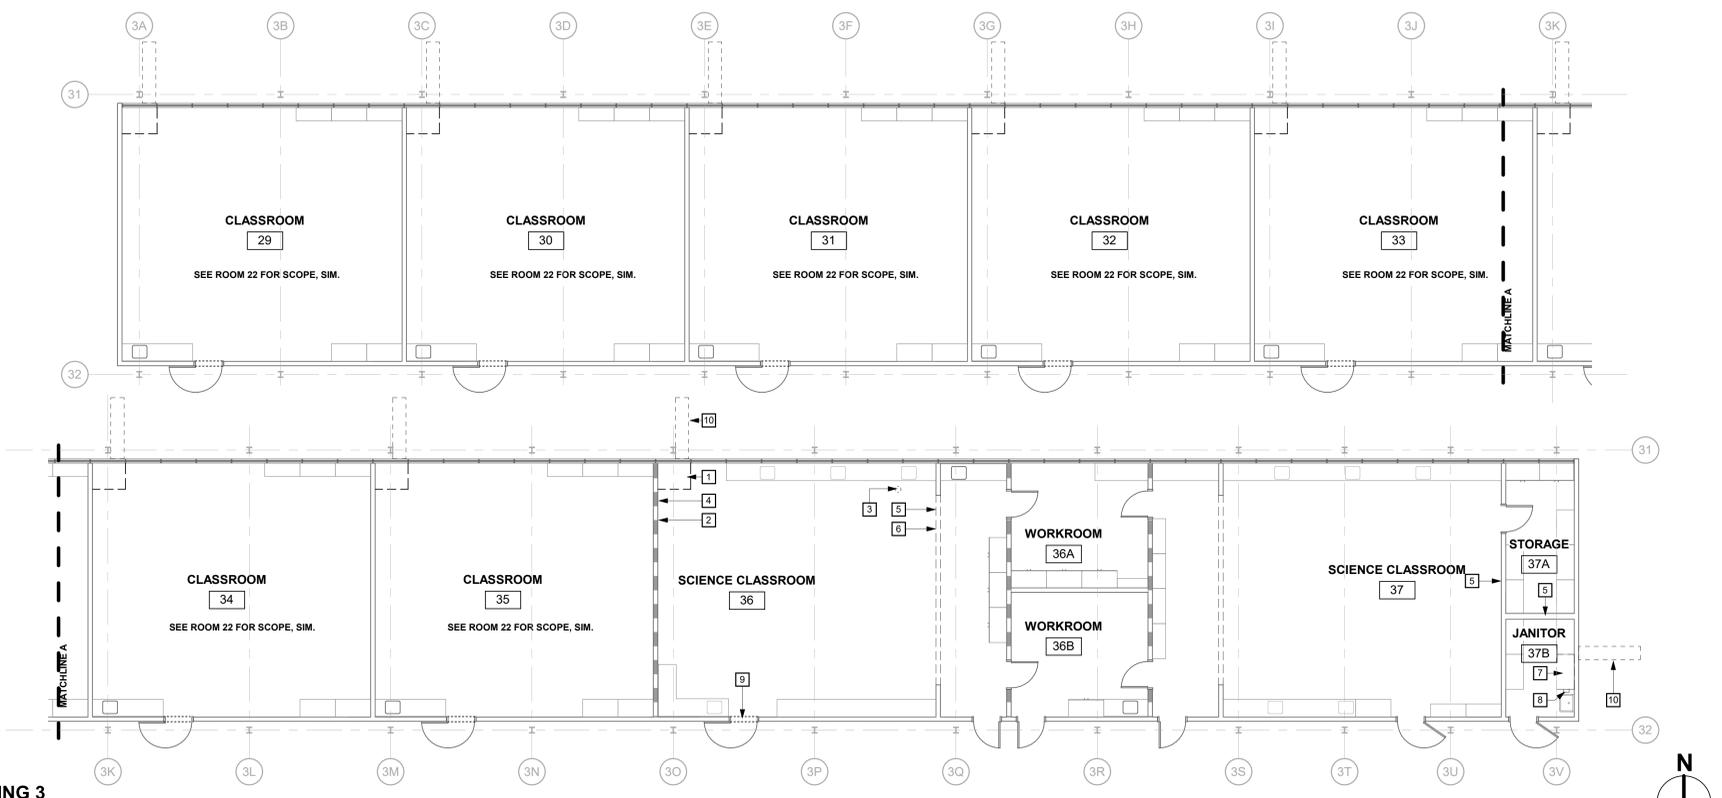

**1 DEMOLITION FLOOR PLAN - WING 3**  
SCALE: 1/8" = 1'-0"

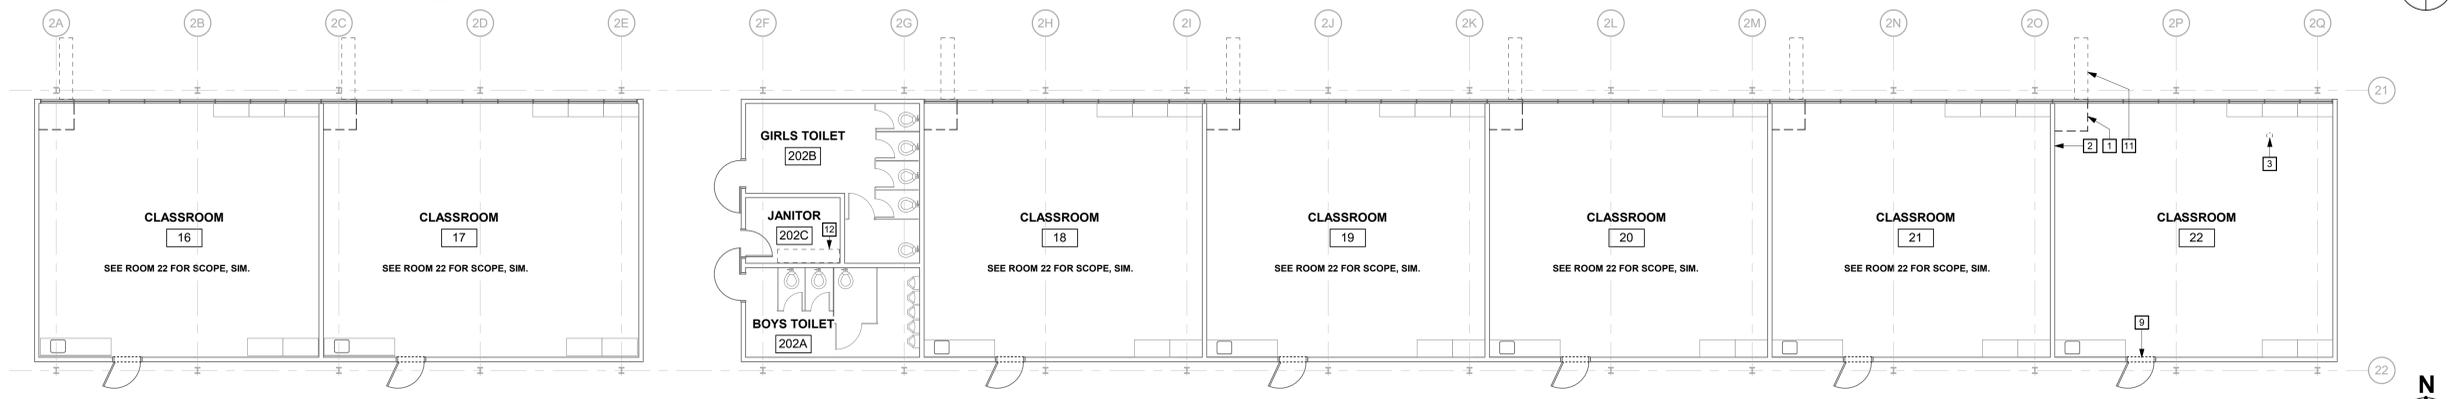

**2 DEMOLITION FLOOR PLAN - WING 2**  
SCALE: 1/8" = 1'-0"

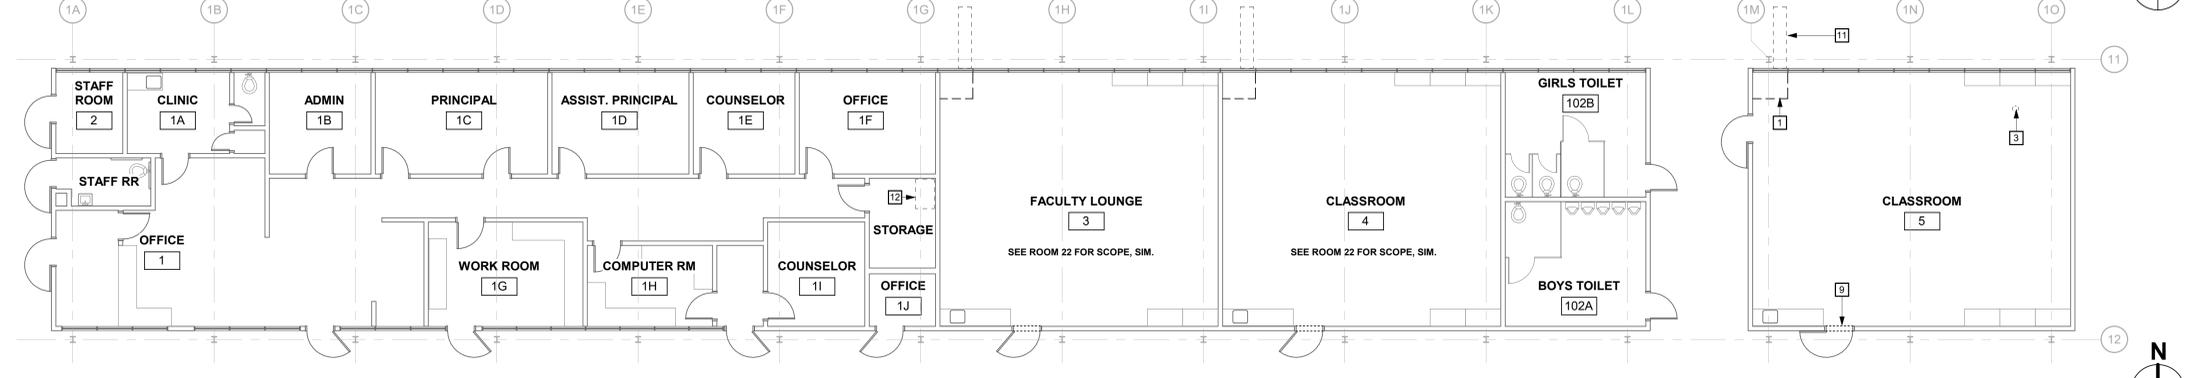



**3 DEMOLITION FLOOR PLAN - WING 1**  
SCALE: 1/8" = 1'-0"

**GENERAL SHEET NOTES CONTINUED**

1 REFER TO "HVAC AND POWER UPGRADE PROJECT HAZARDOUS MATERIALS SURVEY REPORT" CONTRACTOR TO ABATE AREAS AFFECTED BY SCOPE OF WORK. REMOVE AND DISPOSE OF MATERIALS PER REPORT RECOMMENDATIONS.

- GENERAL SHEET NOTES**
- A ROOM NAMES OR NUMBERS MAY NOT BE CONSISTENT BETWEEN DEMOLITION AND NEW FLOOR PLANS.
  - B REFER TO STRUCTURAL, MECHANICAL, AND ELECTRICAL DRAWINGS FOR EXTENT OF STRUCTURAL, MECHANICAL, AND ELECTRICAL DEMOLITION WORK.
  - C VERIFY LIMITS OF DEMOLITION WITH SCOPE OF NEW WORK PRIOR TO COMMENCING WORK.
  - D ALL ITEMS SHOWN DASHED ARE TO BE DEMOLISHED UNLESS OTHERWISE NOTED ON PLANS.
  - E REMOVE ALL MISCELLANEOUS TRIM, CASEWORK, EQUIPMENT, CONDUIT, BASES, AND OTHER SURFACE MOUNTED ITEMS WHETHER SHOWN OR NOT, AS REQUIRED TO FACILITATE SCOPE OF WORK. REMOVE AND CAP ALL OUTLETS, SWITCHES, WIRES, THERMOSTATS, ETC. TO THEIR SOURCE AS REQUIRED. SEE MECHANICAL AND ELECTRICAL DRAWINGS FOR ADDITIONAL INFORMATION AND SCOPE OF WORK.
  - F REMOVE ADJACENT FINISHES AS REQUIRED TO FACILITATE SCOPE OF WORK. PATCH BACK IN KIND.
  - G EXISTING EQUIPMENT INDICATED TO BE RELOCATED PER NEW PLAN IS TO BE STORED AND PROTECTED DURING CONSTRUCTION.
  - H NO DEMOLITION SHALL BEGIN UNTIL PLANS INCLUDING THE DEMOLITION WORK HAVE BEEN APPROVED BY DSA

- DEMOLITION FLOOR PLAN KEYNOTES**
- 1 REMOVE (E) MECHANICAL UNIT AND ENCLOSURE. S.M.D. RECONFIGURE (E) WIREMOLD. SHORTEN CONFIGURATION TIGHT TO NEW ENCLOSURE AND PROVIDE END CAP. SEE NEW FLOOR PLAN FOR MORE INFORMATION.
  - 2 RELOCATE (E) CEILING MOUNTED OCCUPANCY SENSOR, COORDINATED TO NEW DUCT LAYOUT. S.M.D. REPLACE CEILING TILE.
  - 3 RELOCATE (E) DATA OUTLET, COORDINATED TO RECONFIGURED WIREMOLD. LOCATE A.F.F. 15" MIN. TO 48" MAX.
  - 4 CUT AND PREP OPENING FOR MECHANICAL WORK. S.M.D.
  - 5 (E) CASED OPENING ABOVE TO REMAIN.
  - 6 REMOVE (E) CABINET
  - 7 SALVAGE (E) CLEANER DISPENSER FOR REINSTALLATION
  - 8 REMOVE (E) WINDOW GLAZING ABOVE AND PREP FOR NEW WORK. S.M.D.
  - 9 REMOVE PAVING AND PREP PLAYING AREA FOR NEW WORK. S.M.D.
  - 10 REMOVE (E) FULL HEIGHT CASEWORK.

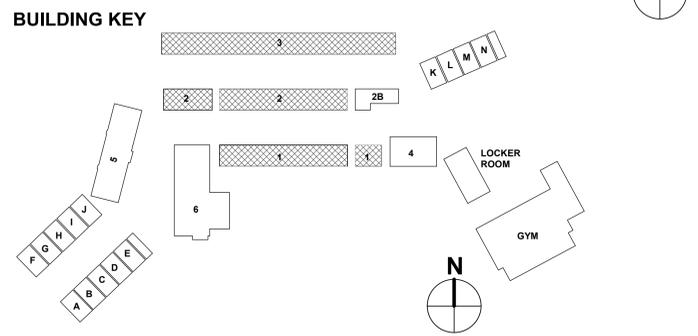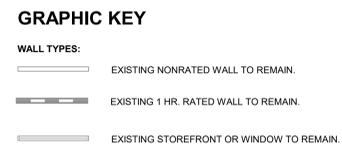


# GENERAL SHEET NOTES


1 REFER TO "HVAC AND POWER UPGRADE PROJECT HAZARDOUS MATERIALS SURVEY REPORT." CONTRACTOR TO ABATE AREAS AFFECTED BY SCOPE OF WORK. REMOVE AND DISPOSE OF MATERIALS PER REPORT RECOMMENDATIONS. ▲

# DEMOLITION FLOOR PLAN KEYNOTES


15 REMOVE (E) MECH EQUIPMENT & INFILL PANEL FOR NEW WORK ▲

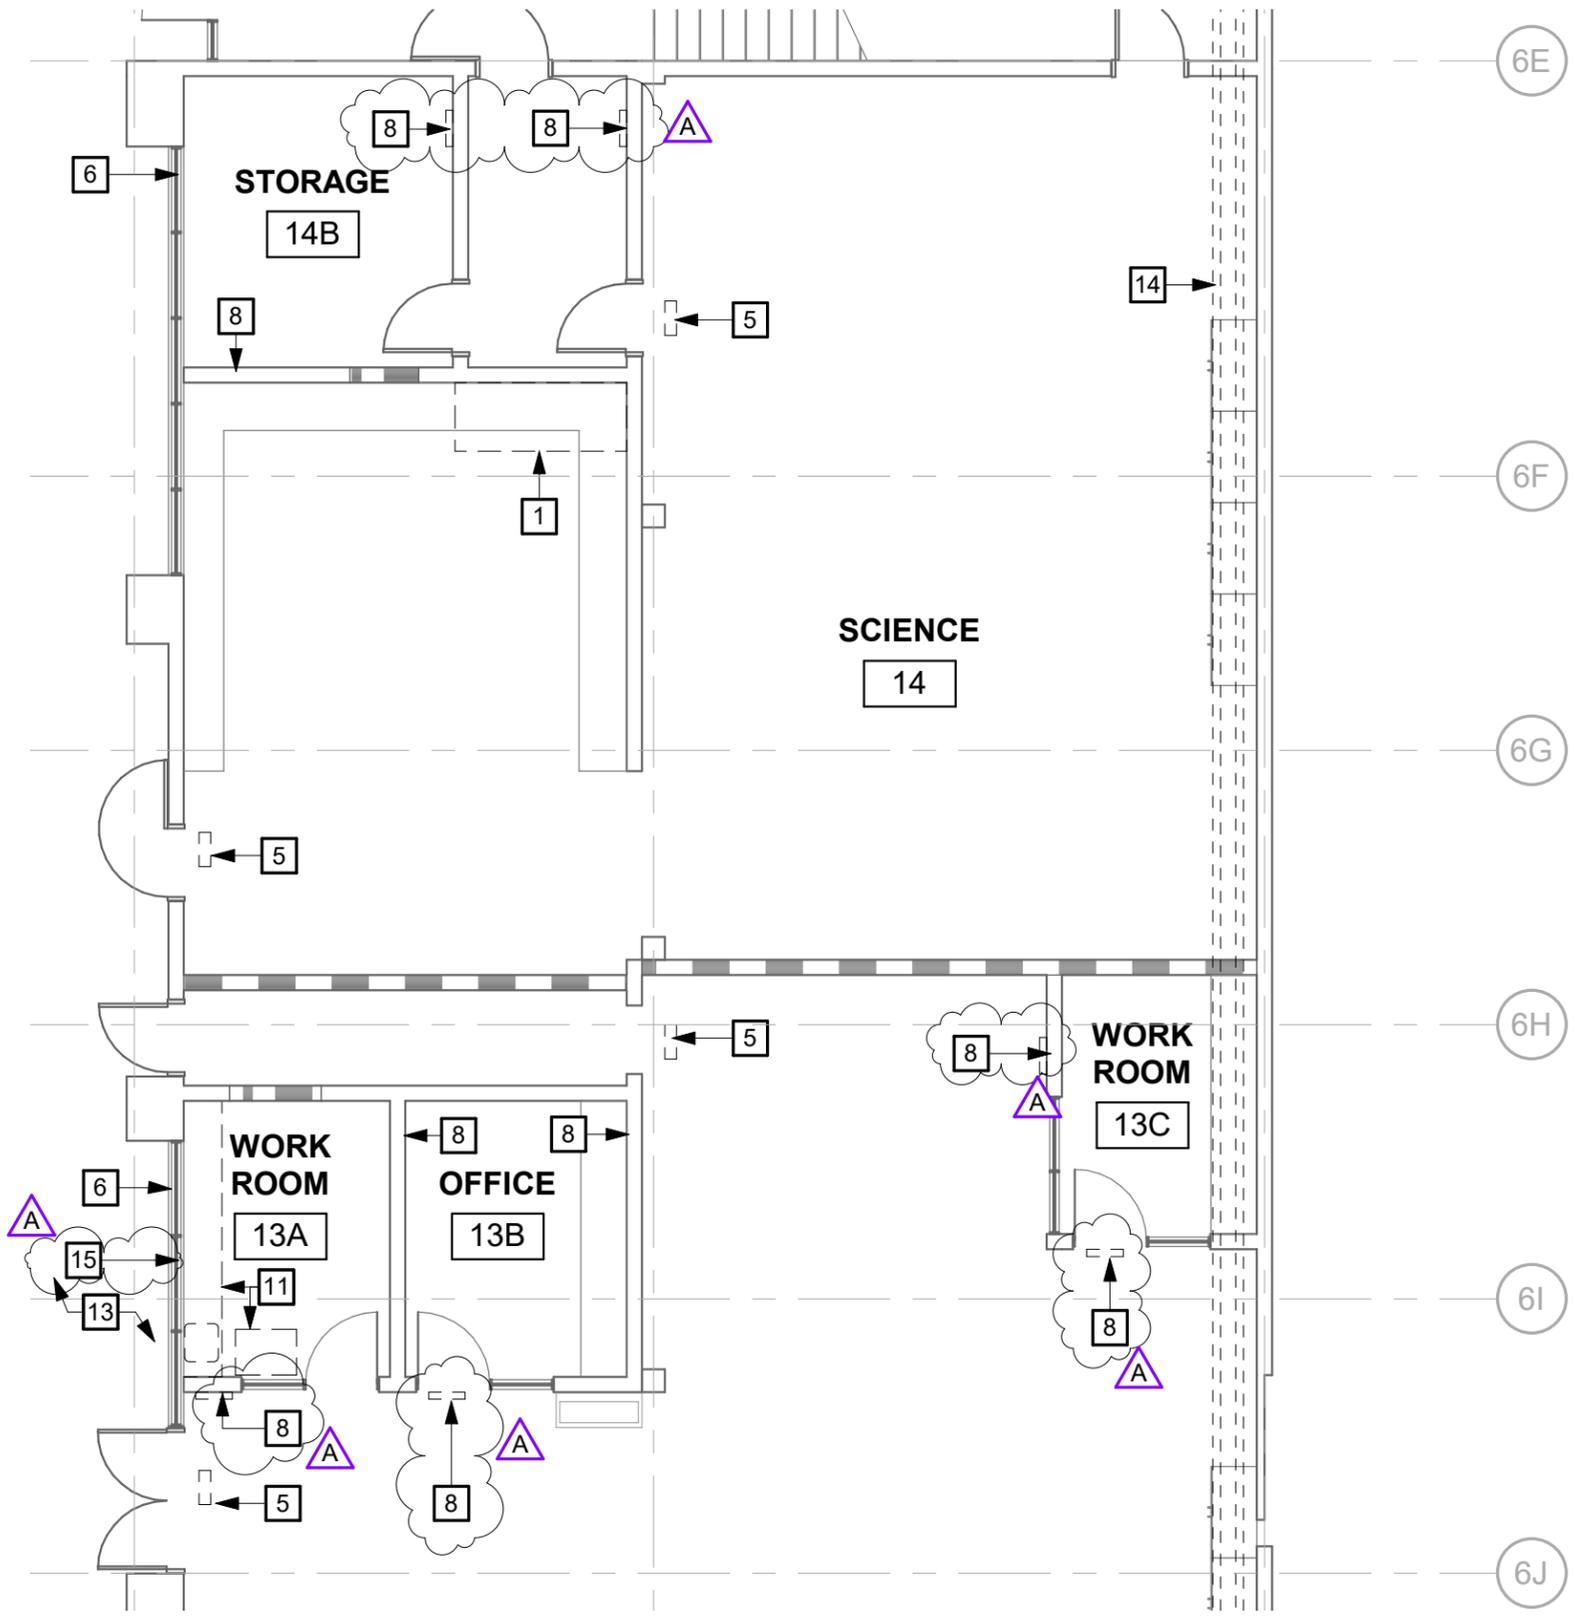


**1 DEMOLITION FIRST FLOOR PLAN - MULTIPURPOSE BLDG**  
SCALE: 1/8" = 1'-0"

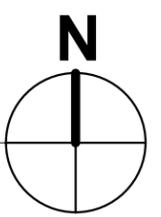

		ABBOTT MIDDLE SCHOOL - HVAC REPLACEMENT SAN MATEO-FOSTER CITY SCHOOL DISTRICT	
		FILE NO.: 41-26 APPL NO.: 01-119556 JOB NO. 2021005.06 DATE 11/24/2021	SHEET <b>AD1-A2.02</b>
387 S. 1st Street, Suite 300 San Jose, CA., 95113		tel: (408) 300 - 5160 fax: (408) 300 - 5121	

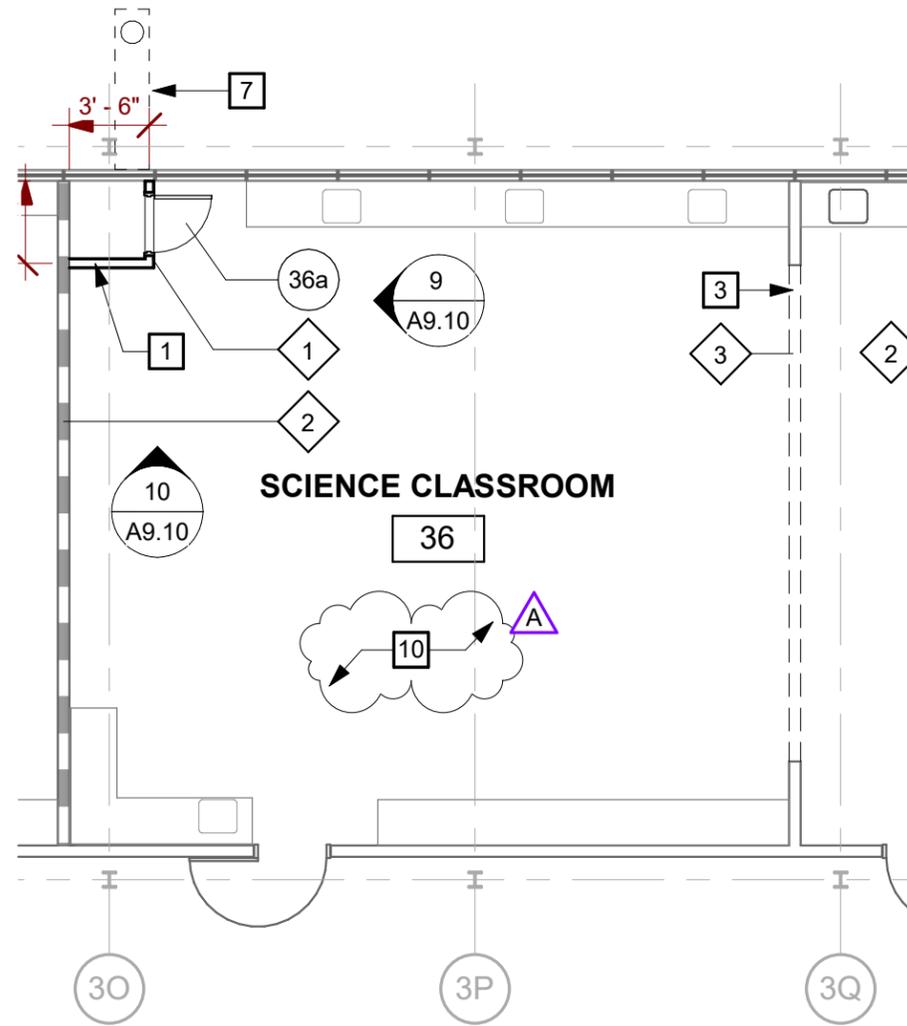

**1 NEW FLOOR PLAN - WING 3**  
SCALE: 1/8" = 1'-0"

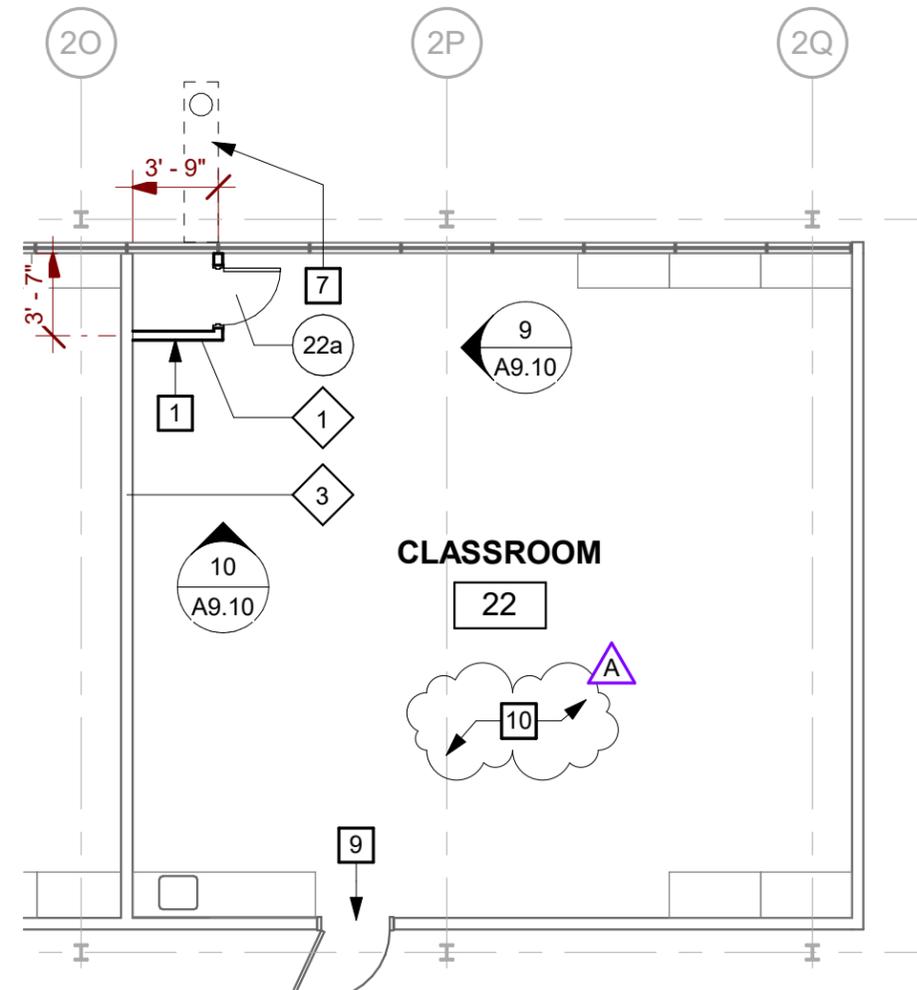

**2 NEW FLOOR PLAN - WING 2**  
SCALE: 1/8" = 1'-0"

### NEW FLOOR PLAN KEYNOTES

- 8 INTERIOR CONDUIT ENCLOSURE, SEE 20/A9.10 AND S.E.D.
- 9 DAMPER @ (E) WINDOW FRAME, S.M.D.
- 10 REFER TO 2/A4.01 FOR TYPICAL CLASSROOM NEW REFLECTED CEILING PLAN. REMOVE AND REINSTALL (E) ACOUSTICAL CEILING TILES ABOVE AS REQUIRED FOR CONSTRUCTION ACCESS INCLUDING BUT NOT LIMITED TO ELECTRICAL ROUTING, MECHANICAL DUCTWORK ANCHORAGE, BLOCKING FOR ROOFTOP PLATFORMS. DO NOT ALTER SUSPENDED A.C.T. GRID.

A



		ABBOTT MIDDLE SCHOOL - HVAC REPLACEMENT	
		SAN MATEO-FOSTER CITY SCHOOL DISTRICT	
387 S. 1st Street, Suite 300 San Jose, CA., 95113	tel: (408) 300 - 5160 fax: (408) 300 - 5121	FILE NO.: 41-26	SHEET
		APPL NO.: 01-119556	<b>AD1-A3.01</b>
		JOB NO. 2021005.06	
		DATE 11/24/2021	



REVISIONS	No.	Description	Date
▲	Addendum 1		11/24/2021

MILESTONES	DATE
DD	
90% CD	
DSA SUB	06/03/21
BACKCHECK	09/29/21

GENERAL SHEET NOTES

- A REFER TO STRUCTURAL, MECHANICAL, AND ELECTRICAL DRAWINGS FOR EXTENT OF STRUCTURAL, MECHANICAL, AND ELECTRICAL WORK.
- B SIZE OF MECHANICAL EQUIPMENT PADS ARE FOR REFERENCE ONLY. THE CONTRACTOR SHALL VERIFY REQUIRED PAD DIMENSION WITH EQUIPMENT MANUFACTURER.



ROOF PLAN KEYNOTES

- 1 PATCH (E) PENETRATION AT REMOVED FLUE AND COMBUSTION AIR INTAKE AND PATCH (N) PENETRATIONS, S.M.D. AND SEE DETAIL 17/A8.10
- 2 MECHANICAL UNIT ON PLATFORM WITH CRICKET, S.M.D. AND SEE DETAIL 10/A8.10. REMOVE (E) ROOFING TO SUBSTRATE FOR CONSTRUCTION ACCESS.
- 3 (E) AIR INTAKE TO REMAIN, S.M.D.
- 4 MECHANICAL UNIT, S.M.D. REMOVE (E) CURB AND REPLACE WITH NEW IN SAME LOCATION, S.M.D. AND SEE DETAIL 19/A8.10
- 5 MECHANICAL UNIT WITH CRICKET, S.M.D. AND SEE DETAIL 10/A8.10. REMOVE (E) CURB AND REPLACE WITH NEW IN SAME LOCATION.

GRAPHIC KEY


- (E) ASPHALT SHINGLE, CLASS C MINIMUM
- (E) BUILT-UP ASPHALT ROOFING, CLASS C MINIMUM ▲
- (E) STANDING SEAM, CLASS C MINIMUM
- (E) METAL ROOFING
- OUTLINE OF WALL BELOW

BUILDING KEY

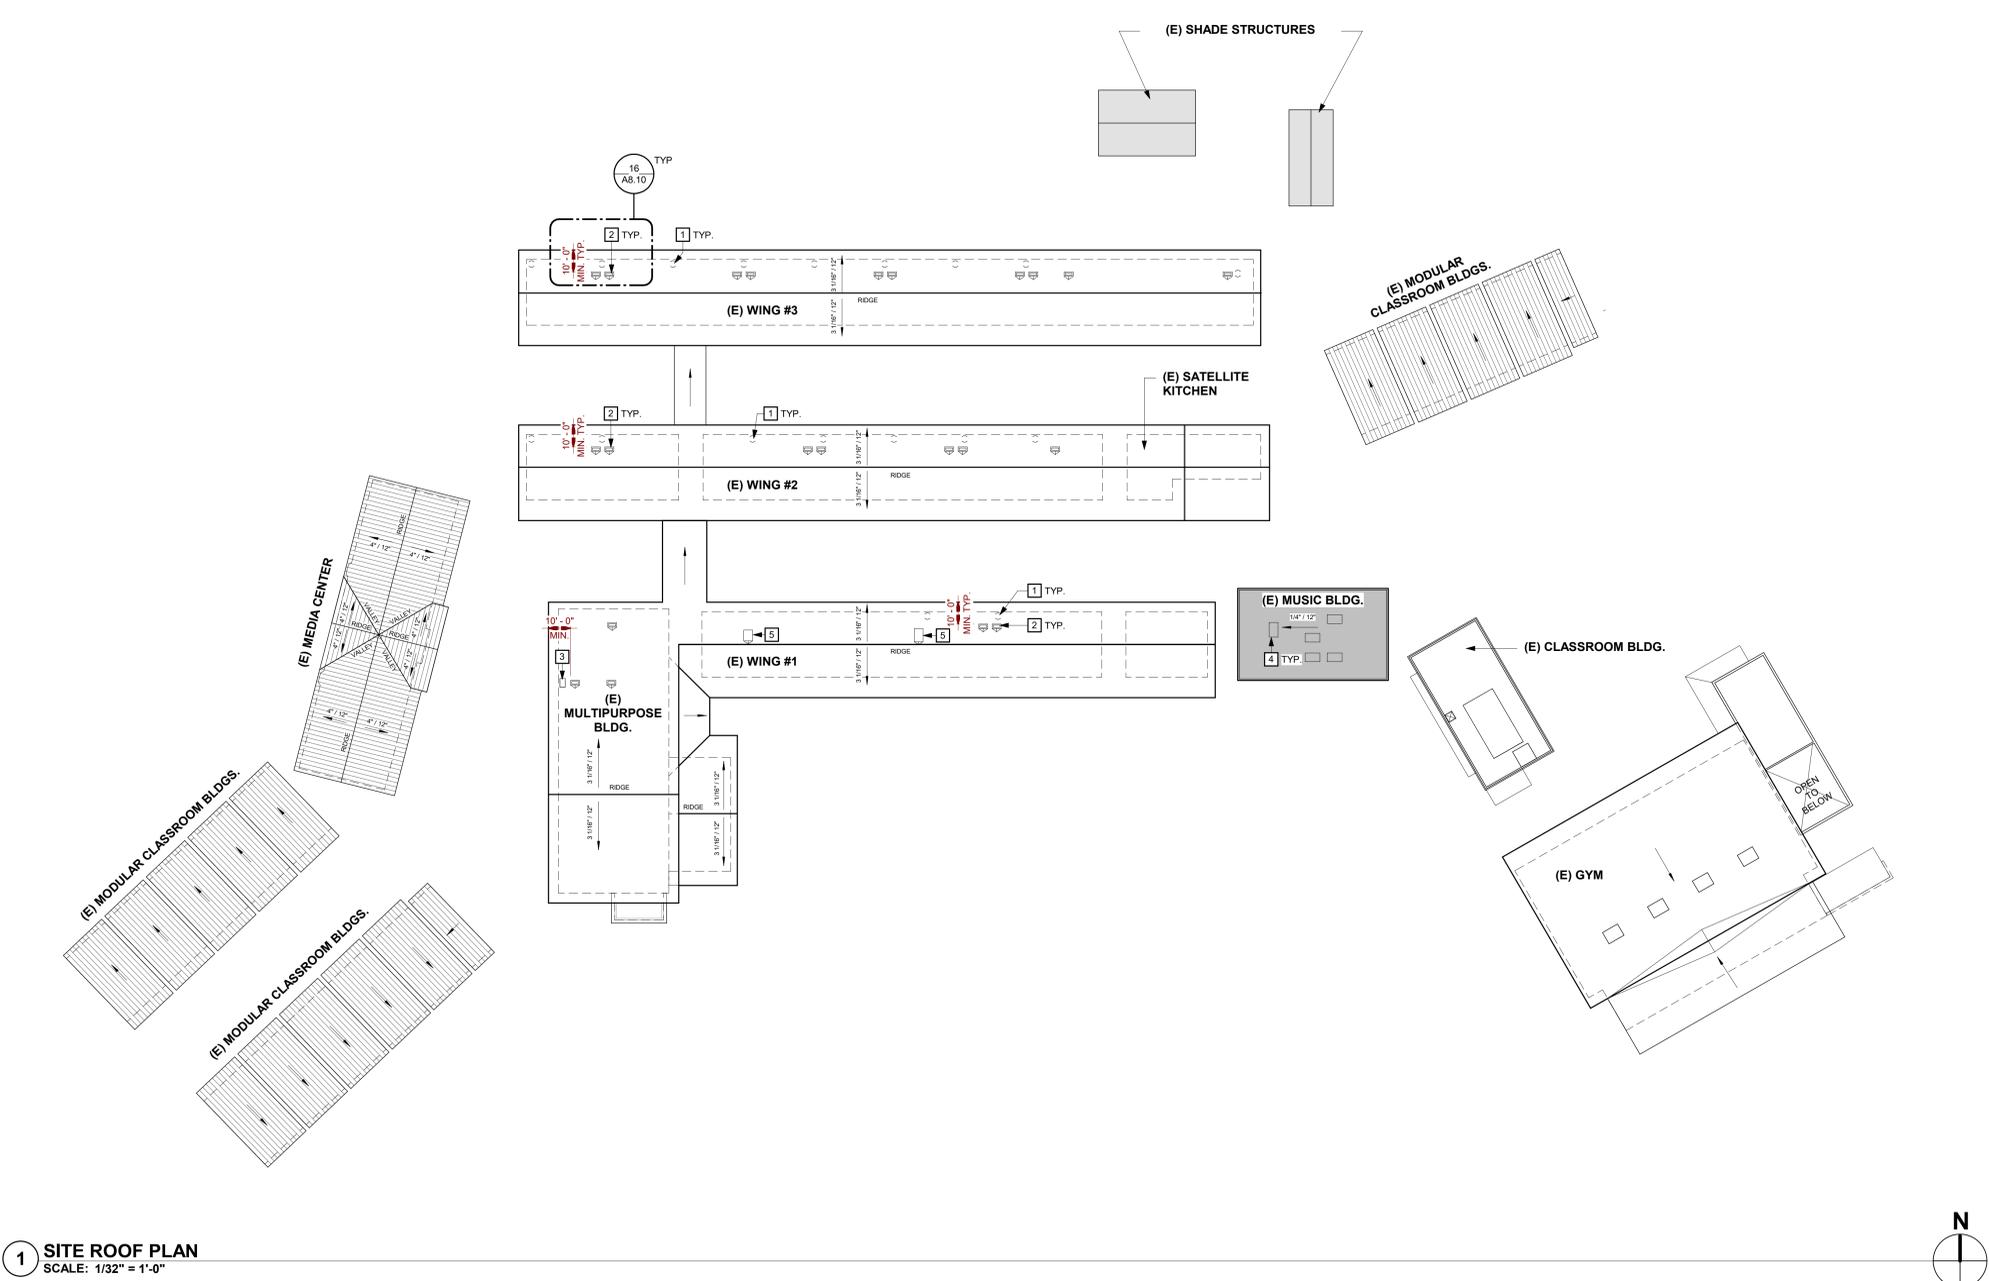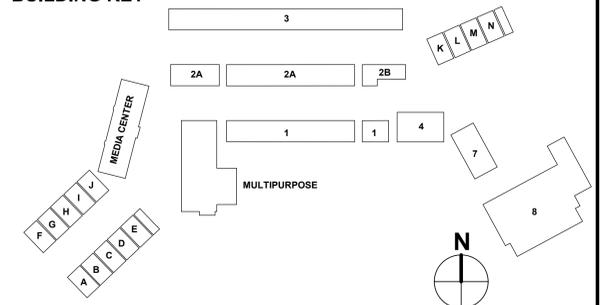

1 SITE ROOF PLAN  
SCALE: 1/32" = 1'-0"




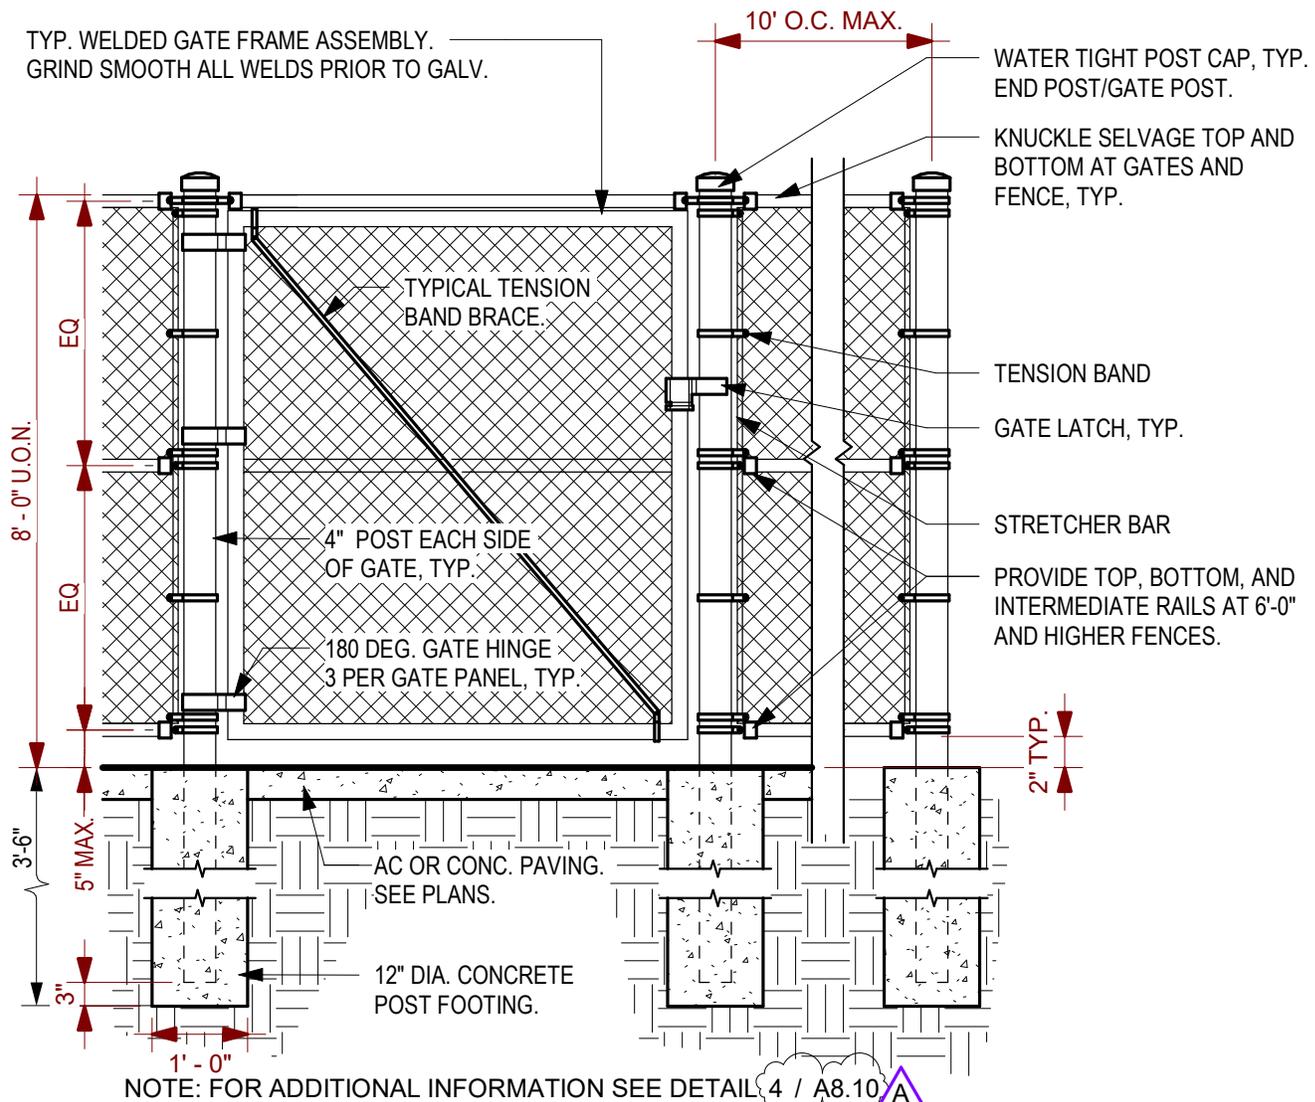

**2** **TYPICAL CHAINLINK GATE (SINGLE)**  
SCALE: 1/2" = 1'-0"



		ABBOTT MIDDLE SCHOOL - HVAC REPLACEMENT SAN MATEO-FOSTER CITY SCHOOL DISTRICT	
		FILE NO.: 41-26	SHEET
387 S. 1st Street, Suite 300 San Jose, CA., 95113		APPL NO.: 01-119556	<b>AD1-A8.10A</b>
tel: (408) 300 - 5160 fax: (408) 300 - 5121		JOB NO. 2021005.06	
		DATE 11/24/21	

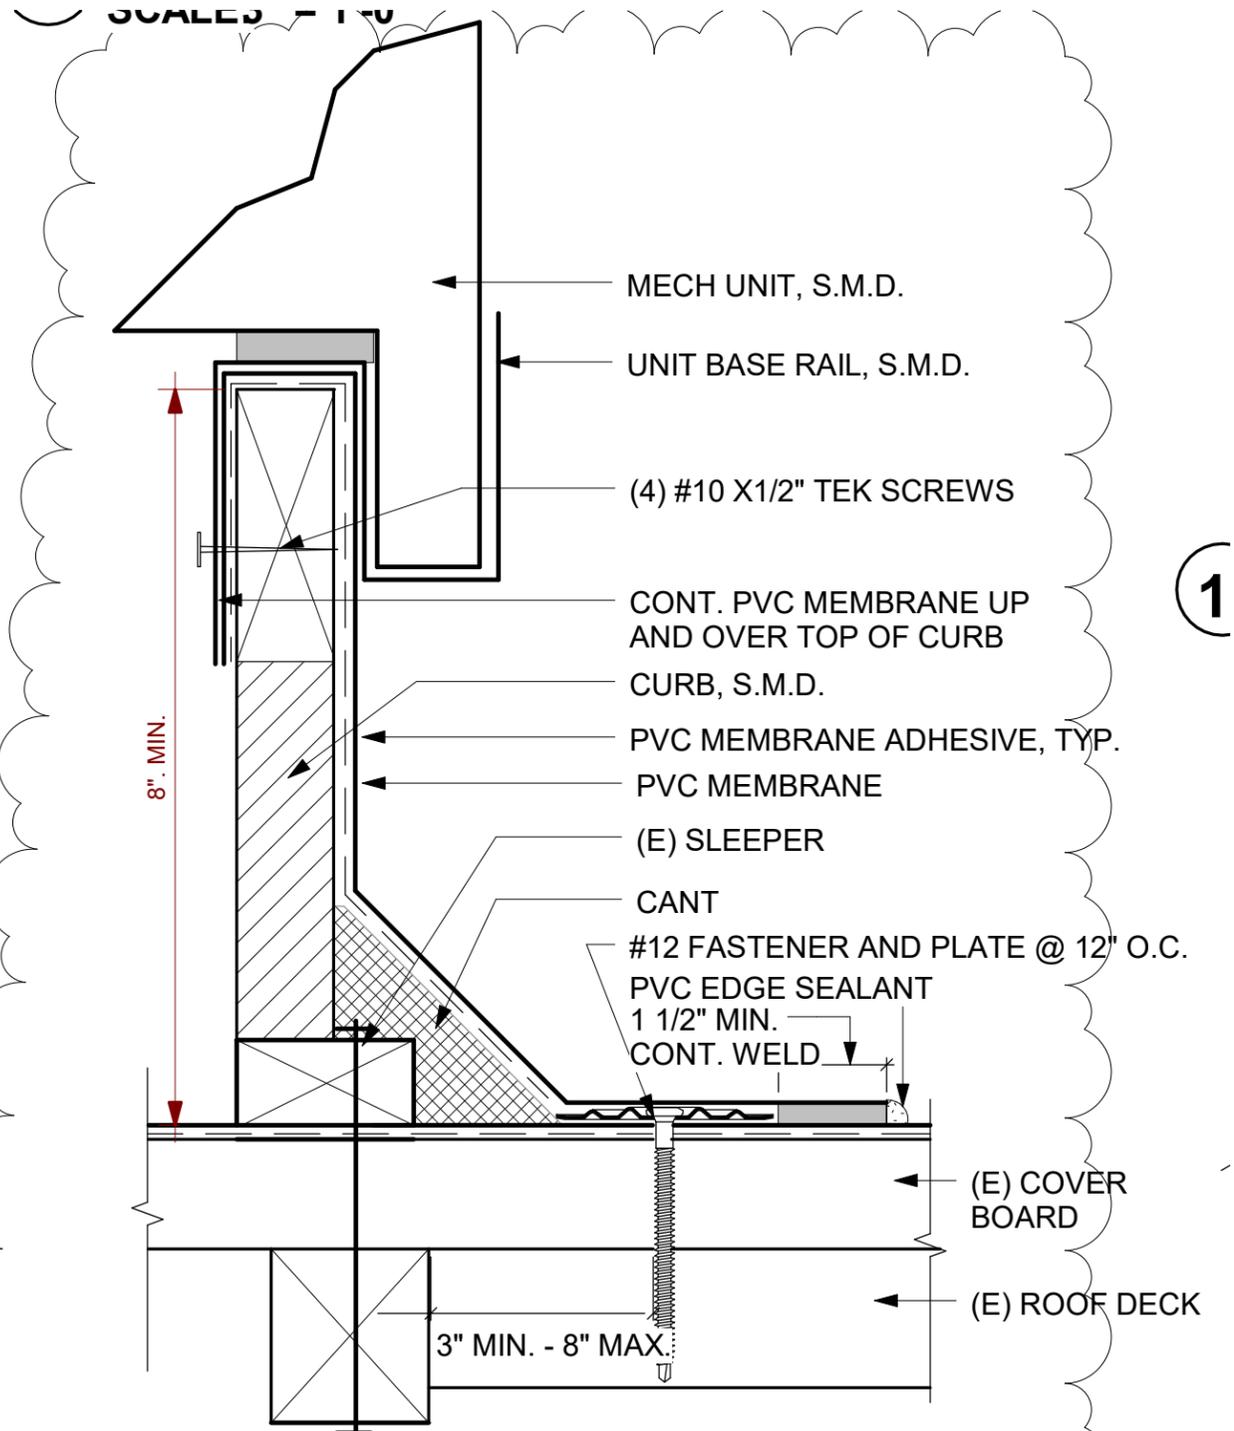


**NOTES:**  
 1. FOR CORNER FLASHING, SEE 20/A8.10  
 2. FOR TRANSITION AT PATCH EDGE, SEE 20/A8.10

**19 SINGLE PLY CURB FLASHING**  
 SCALE 6" = 1'-0"

1


1

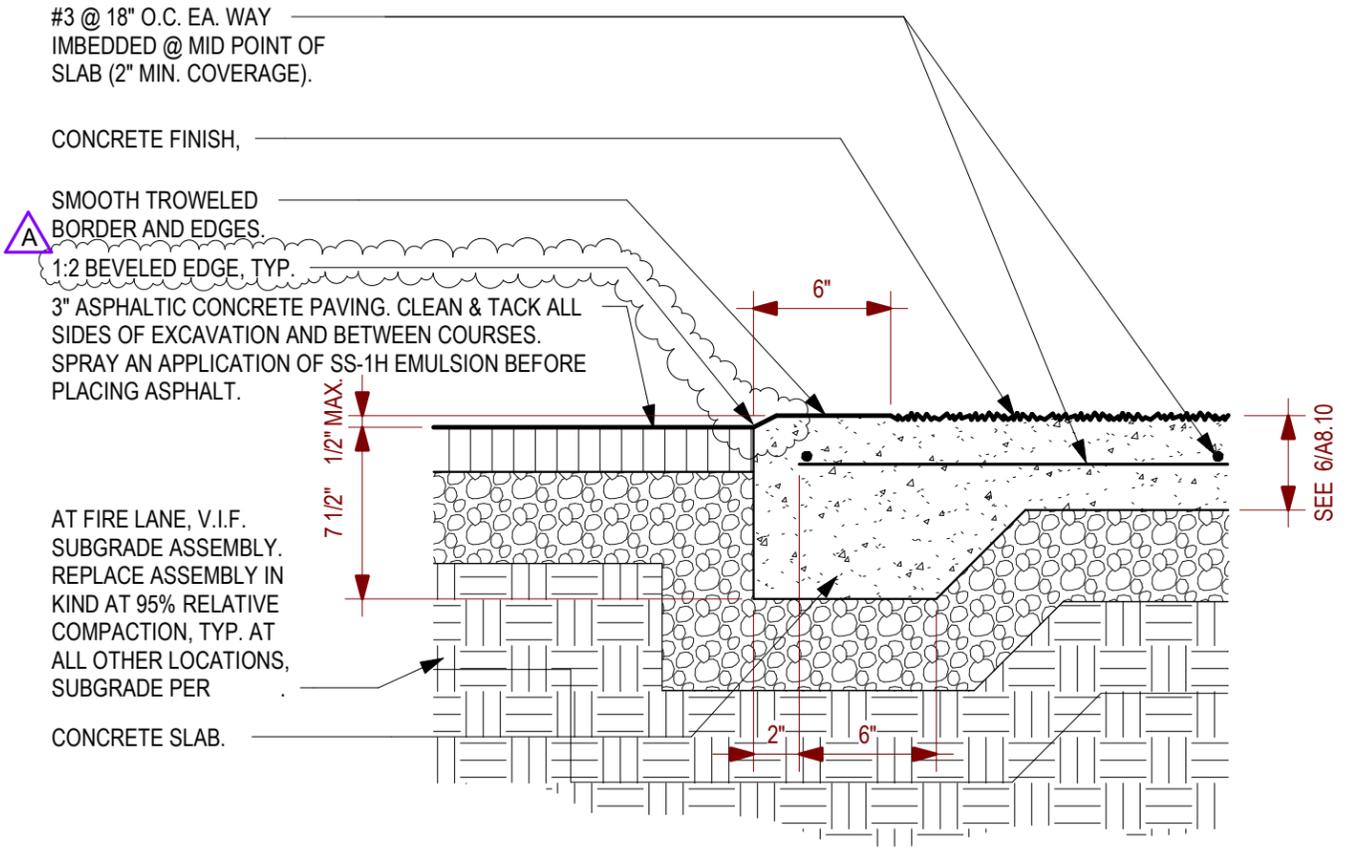

**9 ASPHALT/CONCRETE JOINT**  
 SCALE: 1 1/2" = 1'-0"




		ABBOTT MIDDLE SCHOOL - HVAC REPLACEMENT SAN MATEO-FOSTER CITY SCHOOL DISTRICT	
		FILE NO.: 41-26 APPL NO.: 01-119556 JOB NO.: 2021005.06 DATE: 11/24/2021	SHEET <b>AD1-A8.10B</b>
387 S. 1st Street, Suite 300 San Jose, CA., 95113		tel: (408) 300 - 5160 fax: (408) 300 - 5121	

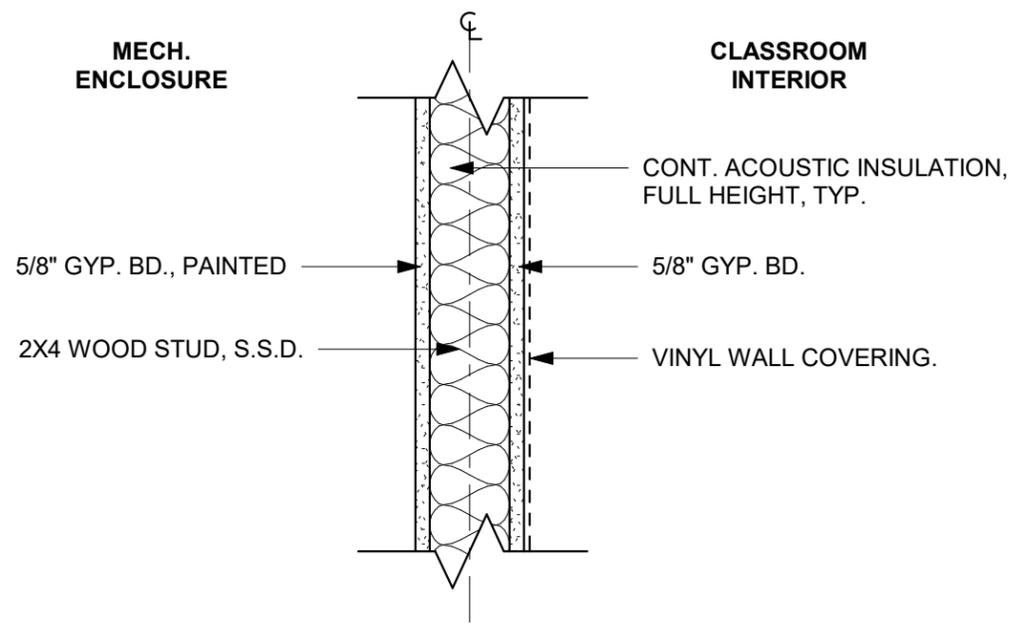

NOTE:  
SEE DETAIL 6/A9.10 FOR TYPICAL SOUND TREATED NONRATED WALL.

**1** WALL TYPE - MECHANICAL ENCLOSURE  
SCALE: 1 1/2" = 1'-0"


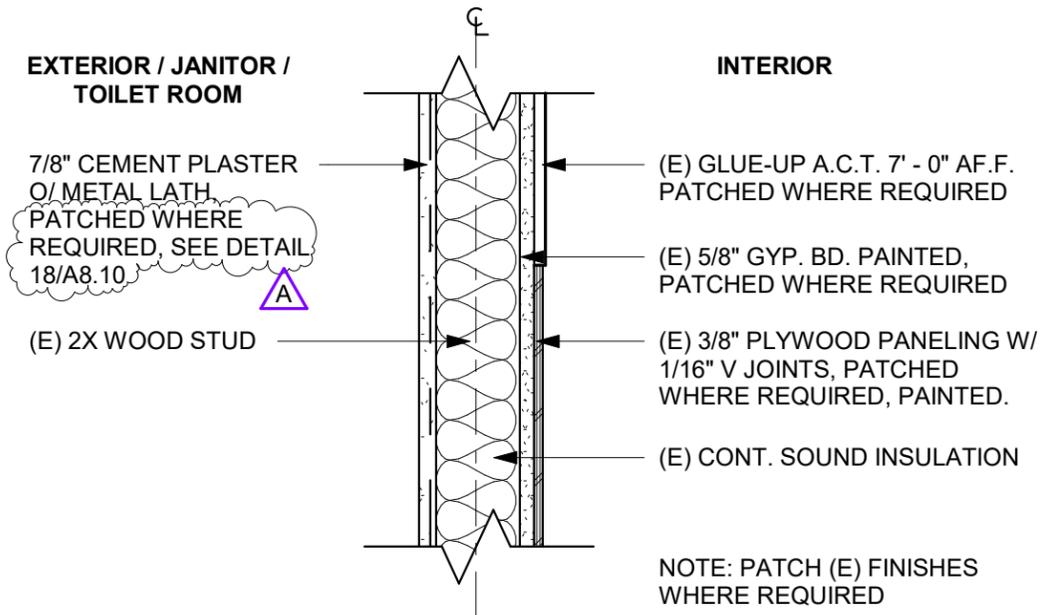


NOTE: PATCH (E) FINISHES WHERE REQUIRED

**5** (E) WALL TYPE 5 - CEMENT PLASTER  
SCALE: 1 1/2" = 1'-0"



		ABBOTT MIDDLE SCHOOL - HVAC REPLACEMENT SAN MATEO-FOSTER CITY SCHOOL DISTRICT	
		FILE NO.: 41-26	SHEET
387 S. 1st Street, Suite 300 San Jose, CA., 95113		tel: (408) 300 - 5160 fax: (408) 300 - 5121	APPL NO.: 01-119556 JOB NO.: 2021005.06 DATE: 11/24/2021
			<b>AD1-A9.10A</b>

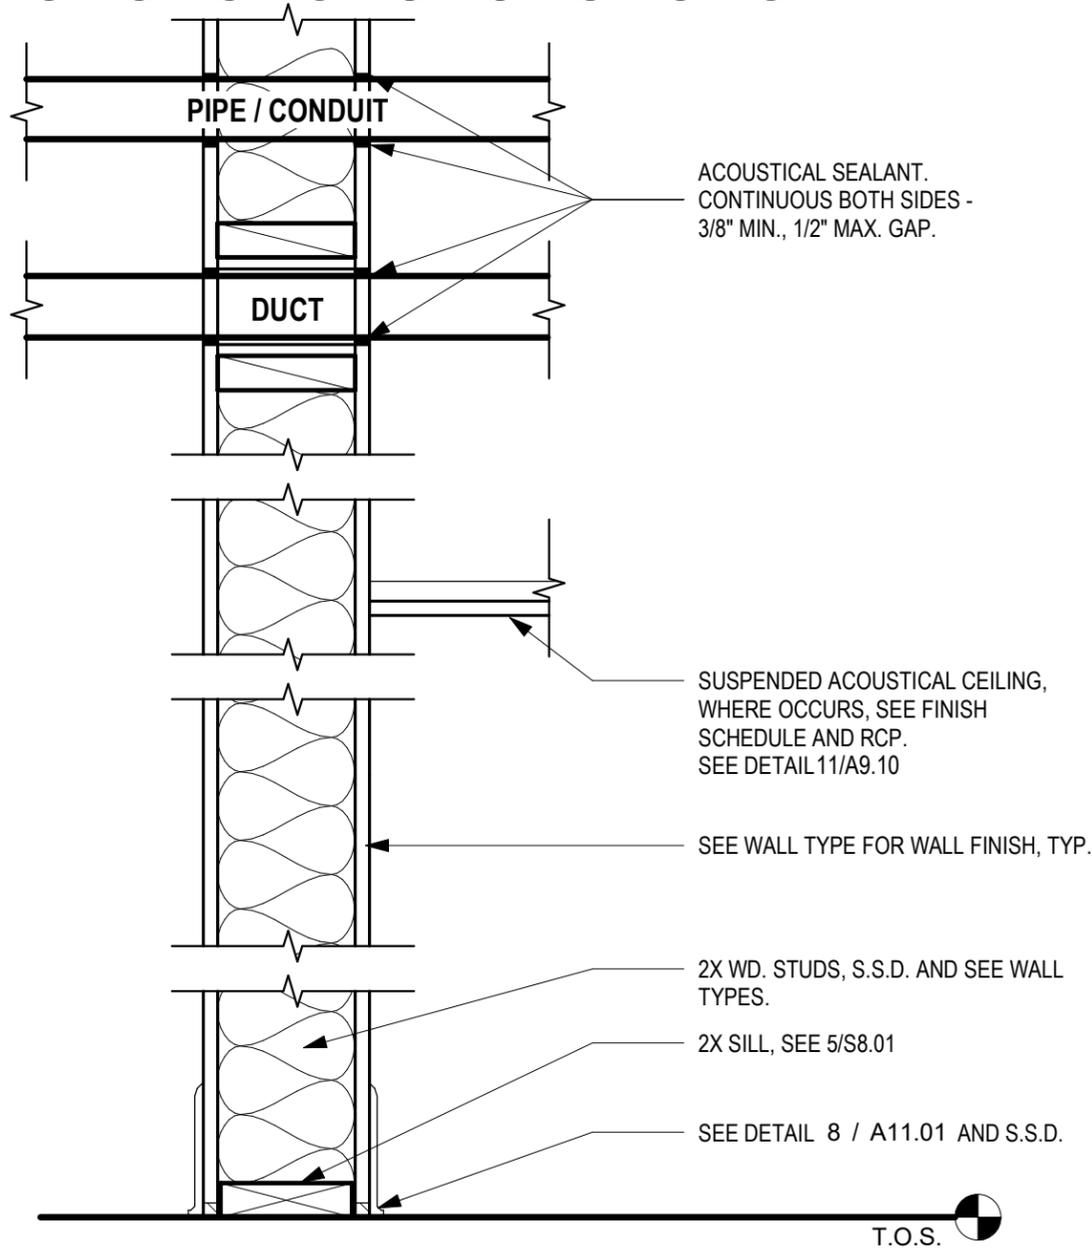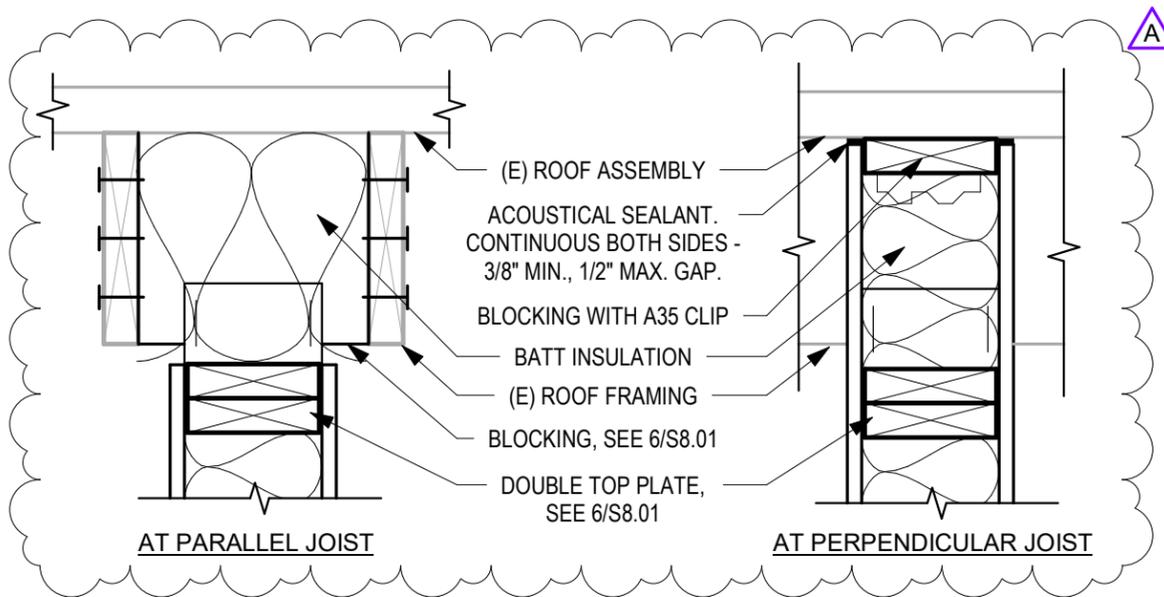

**NOTES:**  
 1. FOR RECESSED ACCESSORIES OR CABINETS, PROVIDE BLOCKING, GYPSUM BOARD AND ACOUSTICAL SEALANT SIMILAR TO DETAIL AT DUCT.

**7 TYPICAL SOUND TREATED NONRATED WALL**  
 SCALE: 1 1/2" = 1'-0"



		ABBOTT MIDDLE SCHOOL - HVAC REPLACEMENT SAN MATEO-FOSTER CITY SCHOOL DISTRICT	
		FILE NO.: 41-26 APPL NO.: 01-119556 JOB NO.: 2021005.06 DATE: 11/24/2021	SHEET <b>AD1-A9.10B</b>
387 S. 1st Street, Suite 300 San Jose, CA., 95113		tel: (408) 300 - 5160 fax: (408) 300 - 5121	

## DOOR SCHEDULE

DOOR ID	OPENING SIZE		DOOR		FRAME		DETAIL HEAD
	WIDTH	HEIGHT	TYPE	FINISH	TYPE	FINISH	
3a	2' - 6"	7' - 0"	A	P-2	F1	P-3	11/A11.01
4a	2' - 6"	7' - 0"	A	P-2	F1	P-3	11/A11.01
5a	2' - 6"	7' - 0"	A	P-2	F1	P-3	11/A11.01
11a	3' - 0"	2' - 6"	A	P-2	F1	P-3	11/A11.01
16a	2' - 6"	7' - 0"	A	P-2	F1	P-3	11/A11.01
17a	2' - 6"	7' - 0"	A	P-2	F1	P-3	11/A11.01
18a	2' - 6"	7' - 0"	A	P-2	F1	P-3	11/A11.01
19a	2' - 6"	7' - 0"	A	P-2	F1	P-3	11/A11.01
20a	2' - 6"	7' - 0"	A	P-2	F1	P-3	11/A11.01
21a	2' - 6"	7' - 0"	A	P-2	F1	P-3	11/A11.01
22a	2' - 6"	7' - 0"	A	P-2	F1	P-3	11/A11.01
29a	2' - 6"	7' - 0"	A	P-2	F1	P-3	11/A11.01
30a	2' - 6"	7' - 0"	A	P-2	F1	P-3	11/A11.01
31a	2' - 6"	7' - 0"	A	P-2	F1	P-3	11/A11.01
32a	2' - 6"	7' - 0"	A	P-2	F1	P-3	11/A11.01
33a	2' - 6"	7' - 0"	A	P-2	F1	P-3	11/A11.01
34a	2' - 6"	7' - 0"	A	P-2	F1	P-3	11/A11.01
35a	2' - 6"	7' - 0"	A	P-2	F1	P-3	11/A11.01
36a	2' - 6"	7' - 0"	A	P-2	F1	P-3	11/A11.01

A



		ABBOTT MIDDLE SCHOOL - HVAC REPLACEMENT  SAN MATEO FOSTER CITY SCHOOL DISTRICT	
387 S. 1st Street, Suite 300 San Jose, CA., 95113  tel: (408) 300 - 5160 fax: (408) 300 - 5121	FILE NO.: 41-26 APPL NO.: 01-119556 JOB NO.: 2021005.06 DATE: 11/24/2021	SHEET	AD1-A11.01

PACKAGED ROOFTOP AIR CONDITIONING UNITS SCHEDULE																					
TAG	MANUFACTURER	MODEL NO.	BUILDING	AREA SERVED	COOLING MBH		GAS HEATING MBH		AIRFLOW CFM	ESP IN. W.G.	OUTSIDE AIR CFM	FAN RPM	MOTOR BHP	SEER	AFUE %	ELECTRICAL			WEIGHT LBS	MOUNTING DETAIL	NOTES
					TOTAL	SENSIBLE	INPUT	OUTPUT								V/PH	MCA	MOCOP			
AC-1	CARRIER	48JCEV06	WING 1	ADMINISTRATION	59.06	53.82	82	65	1990	0.60	450	1959	0.80	19	80	208/3	26	30	750	6/MP6.01	1, 2, 3, 4
AC-2	CARRIER	48VCE05		ADMINISTRATION	47.81	44.72	82	65	1600	0.60	450	1682	0.51	20	80	208/3	25	30	740	6/MP6.01	1, 2, 3, 4
AC-3	CARRIER	48VCE05	MUSIC BLDG	PE STORAGE 8	47.81	44.72	82	65	1600	0.60	450	1682	0.51	20	80	208/3	25	30	740	6/MP6.01	1, 2, 3, 4
AC-4	CARRIER	48VCE05		CLUB ROOM 9	47.81	44.72	82	65	1600	0.60	450	1682	0.51	20	80	208/3	25	30	740	6/MP6.01	1, 2, 3, 4
AC-5	CARRIER	48VCE05		CLUB ROOM 9	47.81	44.72	82	65	1600	0.60	450	1682	0.51	20	80	208/3	25	30	740	6/MP6.01	1, 2, 3, 4
AC-6	CARRIER	48JCEV06		BAND ROOM 6	59.06	53.82	82	65	1990	0.60	450	1959	0.80	19	80	208/3	26	30	750	6/MP6.01	1, 2, 3, 4
AC-7	CARRIER	48JCEV06		CLASSROOM 7, STORAGE OFFICES, PRACTICE ROOM, CONF.	59.06	53.82	82	65	1990	0.60	450	1959	0.80	19	80	208/3	26	30	750	6/MP6.01	1, 2, 3, 4

- WEIGHT INCLUDES ALL OPTIONS AND ACCESSORIES.
- PROVIDE WITH LOW LEAK ECONOMIZER WITH BAROMETRIC RELIEF, MEDIUM GAS HEAT, VARIABLE SPEED COOLING CAPACITY, HIGH STATIC DIRECT DRIVE FAN, LOUVERED HALL GUARDS, HINGED ACCESS PANELS, UNPOWERED CONVENIENCE OUTLET, PHASE MONITOR, AND E-COAT COILS.
- PROVIDE WITH MERV 13 FILTERS.
- PROVIDE WITH DELTA CONTROLS THERMOSTAT WITH CO2 SENSOR. SEE MP5.01 FOR CONTROLS.

PACKAGED INDOOR WALL HEAT PUMPS SCHEDULE																		
TAG	MANUFACTURER	MODEL NO.	AREA SERVED	COOLING MBH		HEATING MBH	AIRFLOW CFM	ESP IN. W.G.	OUTSIDE AIR CFM	MOTOR HP	EER	COP	ELECTRICAL			WEIGHT LBS	MOUNTING DETAIL	NOTES
				TOTAL	SENSIBLE								V/PH	MCA	MOCOP			
WHP-1	BARD	Q48H4-809	PREP AREA 207, SERVING AREA 207A	49.8	31.5	39.5	1500	0.5	200	1/2	11.0	3.3	208/1	54	60	530	12/MP6.01	1, 2, 3, 4

- PROVIDE WITH COMMERCIAL ROOM VENTILATOR AND 2" MERV 13 FILTERS.
- PROVIDE WITH 10 KW ELECTRIC HEAT.
- PROVIDE WITH WALL SLEEVE WITH SPLITTER PLATE, CABINET EXTENSION AND AMCA RATED OUTDOOR LOUVER. PRIME AND PAINT TO MATCH EXISTING FINISH.
- PROVIDE WITH DELTA CONTROLS THERMOSTAT. SEE MP5.02 FOR CONTROLS.

WALL HEAT PUMPS SCHEDULE																	
TAG	MANUFACTURER	MODEL NO.	AREA SERVED	COOLING MBH	HEATING MBH	AIRFLOW CFM	ESP IN. W.G.	OUTSIDE AIR CFM	MOTOR HP	EER	COP	ELECTRICAL			WEIGHT LBS	MOUNTING DETAIL	NOTES
												V/PH	MCA	MOCOP			
WHP-23	BARD	T42S1-A05	SEE PLANS	39.5	39	1250	0.25"	300	3/4	11.0	3.3	208/1	57	60	600	7/MP6.01	1, 2, 3
WHP-24	BARD	T42S1-A05	SEE PLANS	39.5	39	1250	0.25"	300	3/4	11.0	3.3	208/1	57	60	600	7/MP6.01	1, 2, 3
WHP-25	BARD	T42S1-A05	SEE PLANS	39.5	39	1250	0.25"	300	3/4	11.0	3.3	208/1	57	60	600	7/MP6.01	1, 2, 3
WHP-26	BARD	T42S1-A05	SEE PLANS	39.5	39	1250	0.25"	300	3/4	11.0	3.3	208/1	57	60	600	7/MP6.01	1, 2, 3
WHP-38	BARD	T42S1-A05	SEE PLANS	39.5	39	1250	0.25"	300	3/4	11.0	3.3	208/1	57	60	600	7/MP6.01	1, 2, 3
WHP-39	BARD	T42S1-A05	SEE PLANS	39.5	39	1250	0.25"	300	3/4	11.0	3.3	208/1	57	60	600	7/MP6.01	1, 2, 3
WHP-40	BARD	T42S1-A05	SEE PLANS	39.5	39	1250	0.25"	300	3/4	11.0	3.3	208/1	57	60	600	7/MP6.01	1, 2, 3
WHP-41	BARD	T42S1-A05	SEE PLANS	39.5	39	1250	0.25"	300	3/4	11.0	3.3	208/1	57	60	600	7/MP6.01	1, 2, 3
WHP-42	BARD	T42S1-A05	SEE PLANS	39.5	39	1250	0.25"	300	3/4	11.0	3.3	208/1	57	60	600	7/MP6.01	1, 2, 3
WHP-43	BARD	T42S1-A05	SEE PLANS	39.5	39	1250	0.25"	300	3/4	11.0	3.3	208/1	57	60	600	7/MP6.01	1, 2, 3
WHP-44	BARD	T42S1-A05	SEE PLANS	39.5	39	1250	0.25"	300	3/4	11.0	3.3	208/1	57	60	600	7/MP6.01	1, 2, 3
WHP-45	BARD	T42S1-A05	SEE PLANS	39.5	39	1250	0.25"	300	3/4	11.0	3.3	208/1	57	60	600	7/MP6.01	1, 2, 3
WHP-46	BARD	T42S1-A05	SEE PLANS	39.5	39	1250	0.25"	300	3/4	11.0	3.3	208/1	57	60	600	7/MP6.01	1, 2, 3
WHP-47	BARD	T42S1-A05	SEE PLANS	39.5	39	1250	0.25"	300	3/4	11.0	3.3	208/1	57	60	600	7/MP6.01	1, 2, 3

- PROVIDE WITH 30KW ELECTRIC HEAT.
- PROVIDE WITH COMMERCIAL ROOM VENTILATOR AND 2" MERV 13 FILTERS.
- PROVIDE WITH DELTA CONTROLS THERMOSTAT WITH CO2 SENSOR. SEE MP5.02 FOR CONTROLS.

AIR DISTRIBUTION SCHEDULE						
TAG	MANUFACTURER	MODEL NO.	DESCRIPTION	BORDER TYPE	MOUNTING DETAIL	NOTES
HSS-1	TITUS	S300FL	HIGH SIDEWALL SUPPLY	TYPE 1	13/MP6.01	1, 2, 4
HSS-2	TITUS	300RL	HIGH SIDE SUPPLY	TYPE 1	14/MP6.01	1, 2
HSR-1	TITUS	350RL	HIGH SIDEWALL RETURN	TYPE 1	14/MP6.01	2
LSR-1	TITUS	350RL	LOW SIDEWALL RETURN	TYPE 1	14/MP6.01	2, 3
RG-1	TITUS	30RL	RELIEF GRILLE	TYPE 1	17/MP6.01	2, 5

- SET BLADES AT 22.5° DEFLECTION.
- PRIME AND PAINT PER ARCHITECT'S INSTRUCTIONS. REGISTER COLOR SELECTED BY ARCHITECT.
- PROVIDE WITH AIRSAN COMPACT DUCT SILENCER.
- PROVIDE WITH ASD AIR SCOP DEVICE.
- CONTRACTOR TO FIELD VERIFY (E) DIMENSIONS PRIOR TO ORDERING.

CLASSROOM SPLIT SYSTEM HEAT PUMPS SCHEDULE																			
TAG	MANUFACTURER	MODEL	BUILDING	LOCATION	COOLING		HEATING	AIRFLOW CFM	OUTSIDE AIR CFM	REFRIGERANT PIPING		SEER	HSPF	ELECTRICAL			WEIGHT LBS	MOUNTING DETAIL	NOTES
					TOTAL MBH	TOTAL MBH				LIQUID	GAS			V/PH	MCA	MOCOP			
FC-3	SAMSUNG	AM054TNZDCHAA	WING 1	CLASSROOM 3	53	61	1150	450	3/8"	3/4"	-	-	208/1	2.6	15	165	1/MP6.01	2, 3, 4, 6, 7	
HP-3	SAMSUNG	AM053TXMDCHAA		ROOF	-	-	3/8"	3/4"	17.5	10	208/1	34	50	215	4/MP6.01	1			
FC-4	SAMSUNG	AM054TNZDCHAA	WING 1	CLASSROOM 4	53	61	1150	450	3/8"	3/4"	-	-	208/1	2.6	15	165	1/MP6.01	2, 3, 4, 6, 7	
HP-4	SAMSUNG	AM053TXMDCHAA		ROOF	-	-	3/8"	3/4"	17.5	10	208/1	34	50	215	4/MP6.01	1			
FC-5	SAMSUNG	AM054TNZDCHAA	WING 1	CLASSROOM 5	53	61	1150	450	3/8"	3/4"	-	-	208/1	2.6	15	165	1/MP6.01	2, 3, 4, 6, 7	
HP-5	SAMSUNG	AM053TXMDCHAA		ROOF	-	-	3/8"	3/4"	17.5	10	208/1	34	50	215	4/MP6.01	1			
FC-T-1A	SAMSUNG	AC042KXZDCHAA	MULTI-PURPOSE BUILDING	STAFF WORK ROOM	42	47	1000	350	3/8"	5/8"	-	-	NOTE 8			125	1/MP6.02	2, 3, 4, 5, 6, 7, 8, 9	
HP-T-1A	SAMSUNG	AC042KXZDCHAA		EXTERIOR	-	-	3/8"	5/8"	18.4	9.6	208/1	26.4	40	195	4/MP6.01	1			
FC-T-1B	SAMSUNG	AC042KXZDCHAA		STAFF LOUNGE	42	47	1000	350	3/8"	5/8"	-	-	NOTE 8			125	1/MP6.02	2, 3, 4, 5, 6, 7, 8, 9	
HP-T-1B	SAMSUNG	AC042KXZDCHAA		EXTERIOR	-	-	3/8"	5/8"	18.4	9.6	208/1	26.4	40	195	4/MP6.01	1			
FC-15	SAMSUNG	AC030MNHDCCHAA		CLASSROOM 15	30	32	670	180	3/8"	5/8"	-	-	NOTE 8			125	2/MP6.02	2, 4, 7, 8, 10	
HP-15	SAMSUNG	AC030JXSCCCHAA		EXTERIOR	-	-	3/8"	5/8"	19.0	10.1	208/1	32	45	212	4/MP6.01	1			
FC-16	SAMSUNG	AM054TNZDCHAA		WING 2	CLASSROOM 16	53	61	1150	450	3/8"	3/4"	-	-	208/1	2.6	15	165	1/MP6.01	2, 3, 4, 6, 7
HP-16	SAMSUNG	AM053TXMDCHAA			ROOF	-	-	3/8"	3/4"	17.5	10	208/1	34	50	215	4/MP6.01	1		
FC-17	SAMSUNG	AM054TNZDCHAA		WING 2	CLASSROOM 17	53	61	1150	450	3/8"	3/4"	-	-	208/1	2.6	15	165	1/MP6.01	2, 3, 4, 6, 7
HP-17	SAMSUNG	AM053TXMDCHAA			ROOF	-	-	3/8"	3/4"	17.5	10	208/1	34	50	215	4/MP6.01	1		
FC-18	SAMSUNG	AM054TNZDCHAA	WING 2	CLASSROOM 18	53	61	1150	450	3/8"	3/4"	-	-	208/1	2.6	15	165	1/MP6.01	2, 3, 4, 6, 7	
HP-18	SAMSUNG	AM053TXMDCHAA		ROOF	-	-	3/8"	3/4"	17.5	10	208/1	34	50	215	4/MP6.01	1			
FC-19	SAMSUNG	AM054TNZDCHAA	WING 2	CLASSROOM 19	53	61	1150	450	3/8"	3/4"	-	-	208/1	2.6	15	165	1/MP6.01	2, 3, 4, 6, 7	
HP-19	SAMSUNG	AM053TXMDCHAA		ROOF	-	-	3/8"	3/4"	17.5	10	208/1	34	50	215	4/MP6.01	1			
FC-20	SAMSUNG	AM054TNZDCHAA	WING 2	CLASSROOM 20	53	61	1150	450	3/8"	3/4"	-	-	208/1	2.6	15	165	1/MP6.01	2, 3, 4, 6, 7	
HP-20	SAMSUNG	AM053TXMDCHAA		ROOF	-	-	3/8"	3/4"	17.5	10	208/1	34	50	215	4/MP6.01	1			
FC-21	SAMSUNG	AM054TNZDCHAA	WING 2	CLASSROOM 21	53	61	1150	450	3/8"	3/4"	-	-	208/1	2.6	15	165	1/MP6.01	2, 3, 4, 6, 7	
HP-21	SAMSUNG	AM053TXMDCHAA		ROOF	-	-	3/8"	3/4"	17.5	10	208/1	34	50	215	4/MP6.01	1			
FC-22	SAMSUNG	AM054TNZDCHAA	WING 2	CLASSROOM 22	53	61	1150	450	3/8"	3/4"	-	-	208/1	2.6	15	165	1/MP6.01	2, 3, 4, 6, 7	
HP-22	SAMSUNG	AM053TXMDCHAA		ROOF	-	-	3/8"	3/4"	17.5	10	208/1	34	50	215	4/MP6.01	1			
FC-29	SAMSUNG	AM054TNZDCHAA	WING 2	CLASSROOM 29	53	61	1150	450	3/8"	3/4"	-	-	208/1	2.6	15	165	1/MP6.01	2, 3, 4, 6, 7	
HP-29	SAMSUNG	AM053TXMDCHAA		ROOF	-	-	3/8"	3/4"	17.5	10	208/1	34	50	215	4/MP6.01	1			
FC-30	SAMSUNG	AM054TNZDCHAA	WING 2	CLASSROOM 30	53	61	1150	450	3/8"	3/4"	-	-	208/1	2.6	15	165	1/MP6.01	2, 3, 4, 6, 7	
HP-30	SAMSUNG	AM053TXMDCHAA		ROOF	-	-	3/8"	3/4"	17.5	10	208/1	34	50	215	4/MP6.01	1			
FC-31	SAMSUNG	AM054TNZDCHAA	WING 2	CLASSROOM 31	53	61	1150	450	3/8"	3/4"	-	-	208/1	2.6	15	165	1/MP6.01	2, 3, 4, 6, 7	
HP-31	SAMSUNG	AM053TXMDCHAA		ROOF	-	-	3/8"	3/4"	17.5	10	208/1	34	50	215	4/MP6.01	1			
FC-32	SAMSUNG	AM054TNZDCHAA	WING 2	CLASSROOM 32	53	61	1150	450	3/8"</										

# DEMOLITION SHEET NOTES

1. REMOVE (E) FURNACE ENCLOSURE AND FURNACE, COMPLETE, TYP. SEE 3/MP2.01 FOR TYPICAL FURNACE DEMO.
2. REMOVE (E) THERMOSTAT AND WIRING BACK TO (E) FURNACE. SALVAGE (E) THERMOSTAT AND UNIT CONTROLLERS. 30% OF THE EQUIPMENT NEEDS TO BE RETURNED TO THE DISTRICT.
3. REMOVE (E) CONDENSATE DRAIN BRANCH PIPE BACK ABOVE CEILING. CAP AND ABANDON (E) CD MAIN ABOVE CEILING. PATCH AND REPAIR CEILING PER ARCHITECT'S DRAWINGS.
4. REMOVE (E) GAS BRANCH PIPE BACK TO (E) GAS MAIN. CAP AND ABANDON (E) GAS MAIN ABOVE CEILING. PATCH AND REPAIR CEILING TILES / ROOF PER ARCHITECT'S DRAWINGS.
5. (E) GAS SHUT OFF VALVE IN VALVE BOX. CLOSE VALVE BEFORE STARTING GAS DEMO WORK ON THIS WING.
6. (E) GAS SHUT OFF VALVE ON MANIFOLD RISER FURTHER UPSTREAM. CLOSE VALVE BEFORE STARTING DEMO WORK ON THIS WING.
7. REMOVE (E) ROOFTOP AC UNIT AND (E) ROOF CURB. PROTECT (E) OPENINGS FOR CONNECTION TO NEW AC UNIT. DISCONNECT (E) GAS PIPE FROM (E) AC UNIT. REMOVE (E) GAS PIPE UP TO AND INCLUDING SHUT OFF VALVE. DISCONNECT (E) CD PIPE FROM (E) AC UNIT. REMOVE (E) CD PIPE UP TO AND INCLUDING TRAP.
8. REMOVE (E) THERMOSTAT AND WIRING BACK TO (E) AC UNIT. SALVAGE (E) THERMOSTAT AND UNIT CONTROLLERS AND RETURN TO DISTRICT.
9. REMOVE (E) INDOOR WALL HEAT PUMP. PRESERVE (E) WALL OPENING FOR NEW UNIT. (E) DUCTWORK TO REMAIN. (SEE EXISTING REFERENCE DRAWINGS ON 1/MP7.02.) DISCONNECT (E) CONDENSATE DRAIN PIPE AT THE UNIT. PRESERVE OPEN END FOR CONNECTION TO NEW UNIT. REMOVE (E) THERMOSTAT AND WIRING. SALVAGE (E) THERMOSTAT AND RETURN TO DISTRICT.
10. ABANDON (E) GAS AND (E) CONDENSATE DRAIN PIPES ABOVE CEILING, TYP.



CEG JOB NO: 21039

**CYPRESS**  
Engineering Group

831.218.1802  
8 Harris Court, Suite A8  
Monterey, CA 93940  
cypressseg.com


HVAC, Plumbing, Fire Protection  
Building Commissioning  
Industrial Refrigeration  
Environmental Compliance  
Training & Technical Support

	ABBOTT MIDDLE SCHOOL - HVAC REPLACEMENT	
	SAN MATEO-FOSTER CITY SCHOOL DISTRICT	
FILE NO.: 41-26	SHEET	REF. SHEET MP2.01
APPL NO.: 01-119556	<b>AD1-MP2.01</b>	
JOB NO.: 2021005.06		
DATE 11/24/2021		
387 S. 1st Street, Suite 300 San Jose, CA., 95113	tel: (408) 300 - 5160 fax: (408) 300 - 5121	

# DEMOLITION SHEET NOTES

1. REMOVE (E) HEATING VENTILATING UNIT.
2. REMOVE (E) FAN COIL.
3. REMOVE (E) EXHAUST FAN.
4. (E) INTAKE HOOD ON ROOF TO REMAIN.
5. REMOVE (E) HOT WATER SUPPLY AND RETURN PIPING FOR ALL (E) UNITS BEING REMOVED. REMOVE (E) ABANDONED HOT WATER SUPPLY AND RETURN PIPING.
6. REMOVE (E) THERMOSTAT AND WIRING BACK TO THE UNIT IT SERVES. SALVAGE (E) THERMOSTAT AND RETURN TO DISTRICT.
7. (E) DUCTWORK ABOVE CEILING AND (E) REGISTERS TO REMAIN.
8. REMOVE (E) SUPPLY DUCT FROM (E) HV UNIT TO POC. PROTECT OPEN END FOR CONNECTION TO NEW UNIT.
9. REMOVE (E) SUPPLY DUCT. CAP WHERE SHOWN. PRESERVE OTHER END FOR CONNECTION TO NEW UNIT.
10. REMOVE (E) RETURN DUCT UP TO POC. PROTECT OPEN END FOR CONNECTION TO NEW UNIT.
11. REMOVE (E) OUTSIDE AIR DUCT.
12. (E) OUTSIDE AIR LOUVER TO REMAIN.
13. REMOVE (E) SUPPLY DUCT AND REGISTERS.
14. REMOVE (E) SINK AND CAP ALL UTILITIES.
15. REMOVE (E) RETURN DUCT.
16. CAP (E) OUTSIDE AIR INTAKE AFTER PLENUM.
17. REMOVE (E) EF, SEE ARCHITECTS DRAWINGS FOR PATCHING AND REPAIR.

A

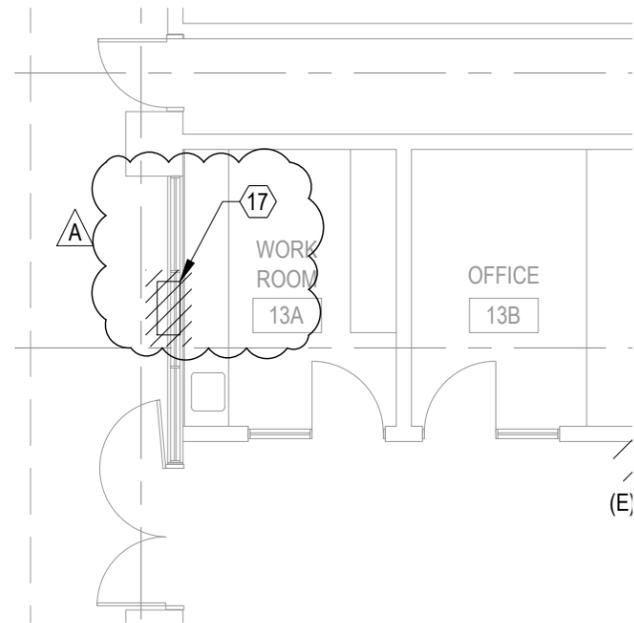

1  
MP2.04

# FIRST FLOOR PLAN - MULTIPURPOSE BLDG - DEMO

SCALE: 1/8" = 1'-0"



CEG JOB NO: 21039

**CYPRESS**  
Engineering Group

HVAC, Plumbing, Fire Protection  
Building Commissioning  
Industrial Refrigeration  
Environmental Compliance  
Training & Technical Support

831.218.1802  
8 Harris Court, Suite A8  
Monterey, CA 93940  
cypressseg.com


		ABBOTT MIDDLE SCHOOL - HVAC REPLACEMENT SAN MATEO-FOSTER CITY SCHOOL DISTRICT	
		FILE NO.: 41-26 APPL NO.: 01-119556 JOB NO.: 2021005.06 DATE: 11/24/2021	SHEET REF. SHEET MP2.04 <b>AD1-MP2.04</b>
387 S. 1st Street, Suite 300 San Jose, CA., 95113		tel: (408) 300 - 5160 fax: (408) 300 - 5121	

# NEW SHEET NOTES


- 14. PIPE CONDENSATE DRAIN FROM HEAT PUMP TO (E) CONDENSATE DRAIN PIPE. SEE DETAIL 8/MP6.01 FOR CONDENSATE DRAIN CONNECTION TO EQUIPMENT.
- 16. CD FROM FAN COIL. DROP CD TIGHT TO EXTERIOR WALL TO ABOVE EXTERIOR CONCRETE WALL, DROP CD TIGHT TO EXTERIOR CONCRETE WALL TO BELOW GRADE, ROUTE TO CD DRYWELL IN LANDSCAPE AREA. SEE DETAILS 8/MP6.01 FOR CD CONNECTION TO EQUIPMENT AND 5/MP6.02 FOR CD DRYWELL.
- 19. 24"x24" RETURN REGISTER HSR-1 WITH GRILLE SILENCER.

GENERAL NOTES

- 1. CONTRACTOR SHALL BE RESPONSIBLE FOR PROTECTING ALL EXISTING AND NEW BUILDING STRUCTURES, SERVICES AND OWNER'S PROPERTY DURING THE ENTIRE PERIOD OF CONSTRUCTION.
- 2. COORDINATE THE LOCATIONS OF ROOF/ WALL OPENINGS, PENETRATIONS, DUCTWORK AND ALL MECHANICAL EQUIPMENT WITH RESPECT TO BUILDING STRUCTURE AND OTHER BUILDING SERVICES TO AVOID CONFLICT.
- 3. FOR CLARITY, ABANDONED CONDENSATE DRAIN PIPES AND (E) GAS MAINS ARE NOT SHOWN ON THIS PLAN. SEE MP2.01.
- 4. PAINT ALL EXPOSED DUCTWORK, SUPPORTS, AND REGISTERS TO MATCH ADJACENT.
- 5. SEE DETAIL 11/MP6.01 FOR PIPE SUPPORT ON ROOF.
- 6. EQUIPMENT MOUNTING DETAIL REFERENCE SHOWN ON SCHEDULES ON SHEETS MP0.02 AND MP0.03.
- 7. CLEAN ALL (E) DUCTWORK AND REGISTERS PER SPECIFICATION 23 01 30.
- 8. PAINT ALL EXPOSED CONDENSATE PIPING AT EXTERIOR TO MATCH ADJACENT.

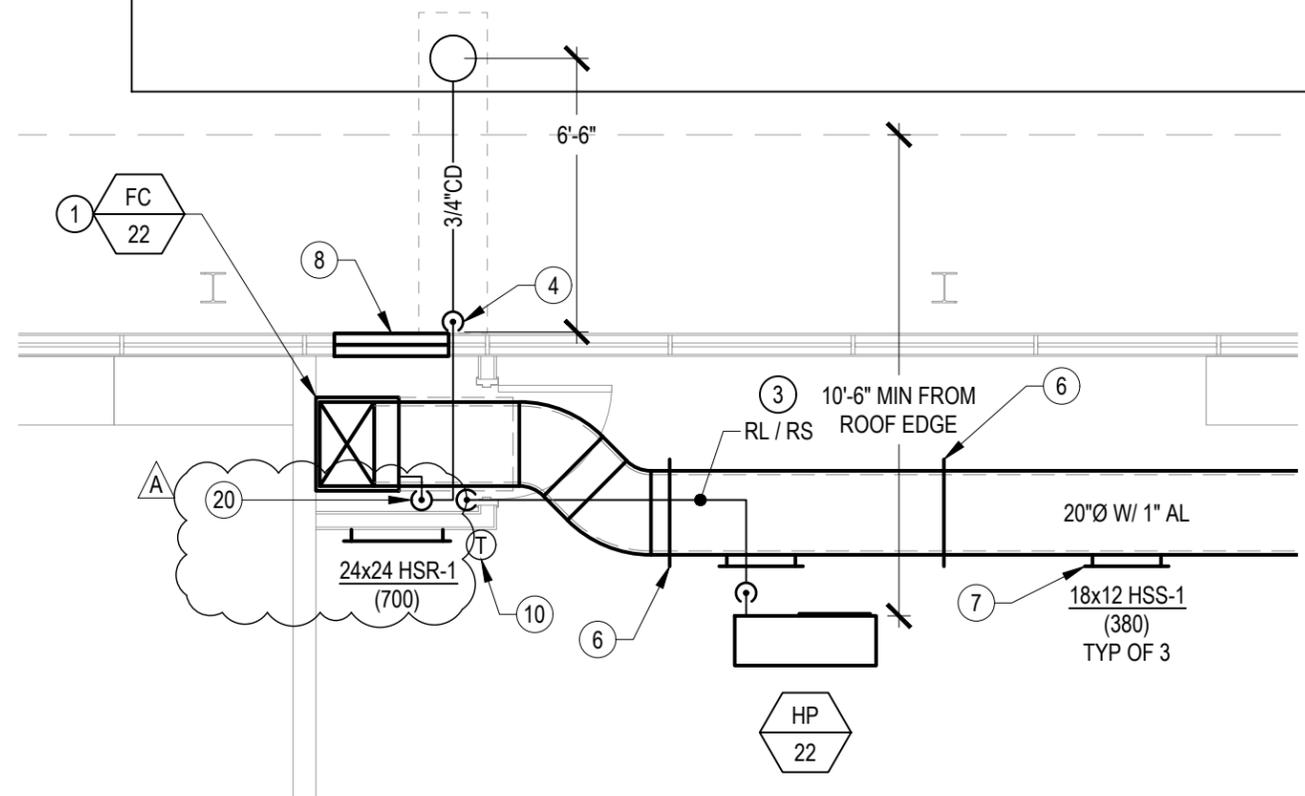

3 PARTIAL FLOOR PLAN - TYPICAL CLASSROOM  
 MP2.06 SCALE: 1/4" = 1'-0"

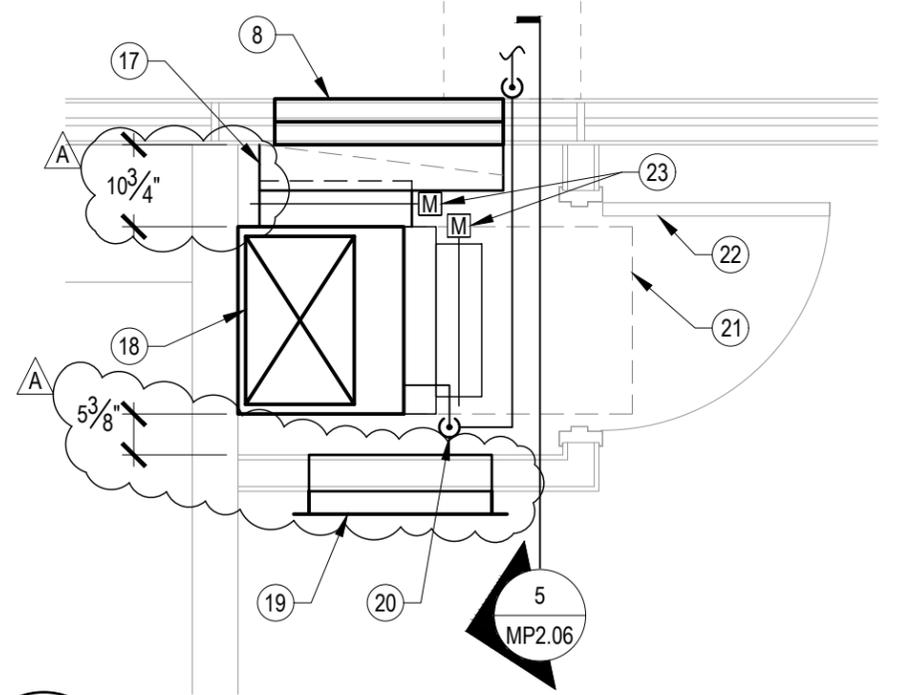

4 FLOOR PLAN - ENCLOSURE  
 MP2.06 SCALE: NONE



CEG JOB NO: 21039

**CYPRESS**  
Engineering Group

HVAC, Plumbing, Fire Protection  
 Building Commissioning  
 Industrial Refrigeration  
 Environmental Compliance  
 Training & Technical Support

831.218.1802  
 8 Harris Court, Suite A8  
 Monterey, CA 93940  
 cypresscg.com


**aedis**  
architects

387 S. 1st Street, Suite 300  
 San Jose, CA., 95113  
 tel: (408) 300 - 5160  
 fax: (408) 300 - 5121

ABBOTT MIDDLE SCHOOL -  
 HVAC REPLACEMENT

SAN MATEO-FOSTER CITY SCHOOL DISTRICT

FILE NO.:	41-26	SHEET	
APPL NO.:	01-119556	REF. SHEET	MP2.06
JOB NO.:	2021005.06		<b>AD1-MP2.06a</b>
DATE	11/24/2021		

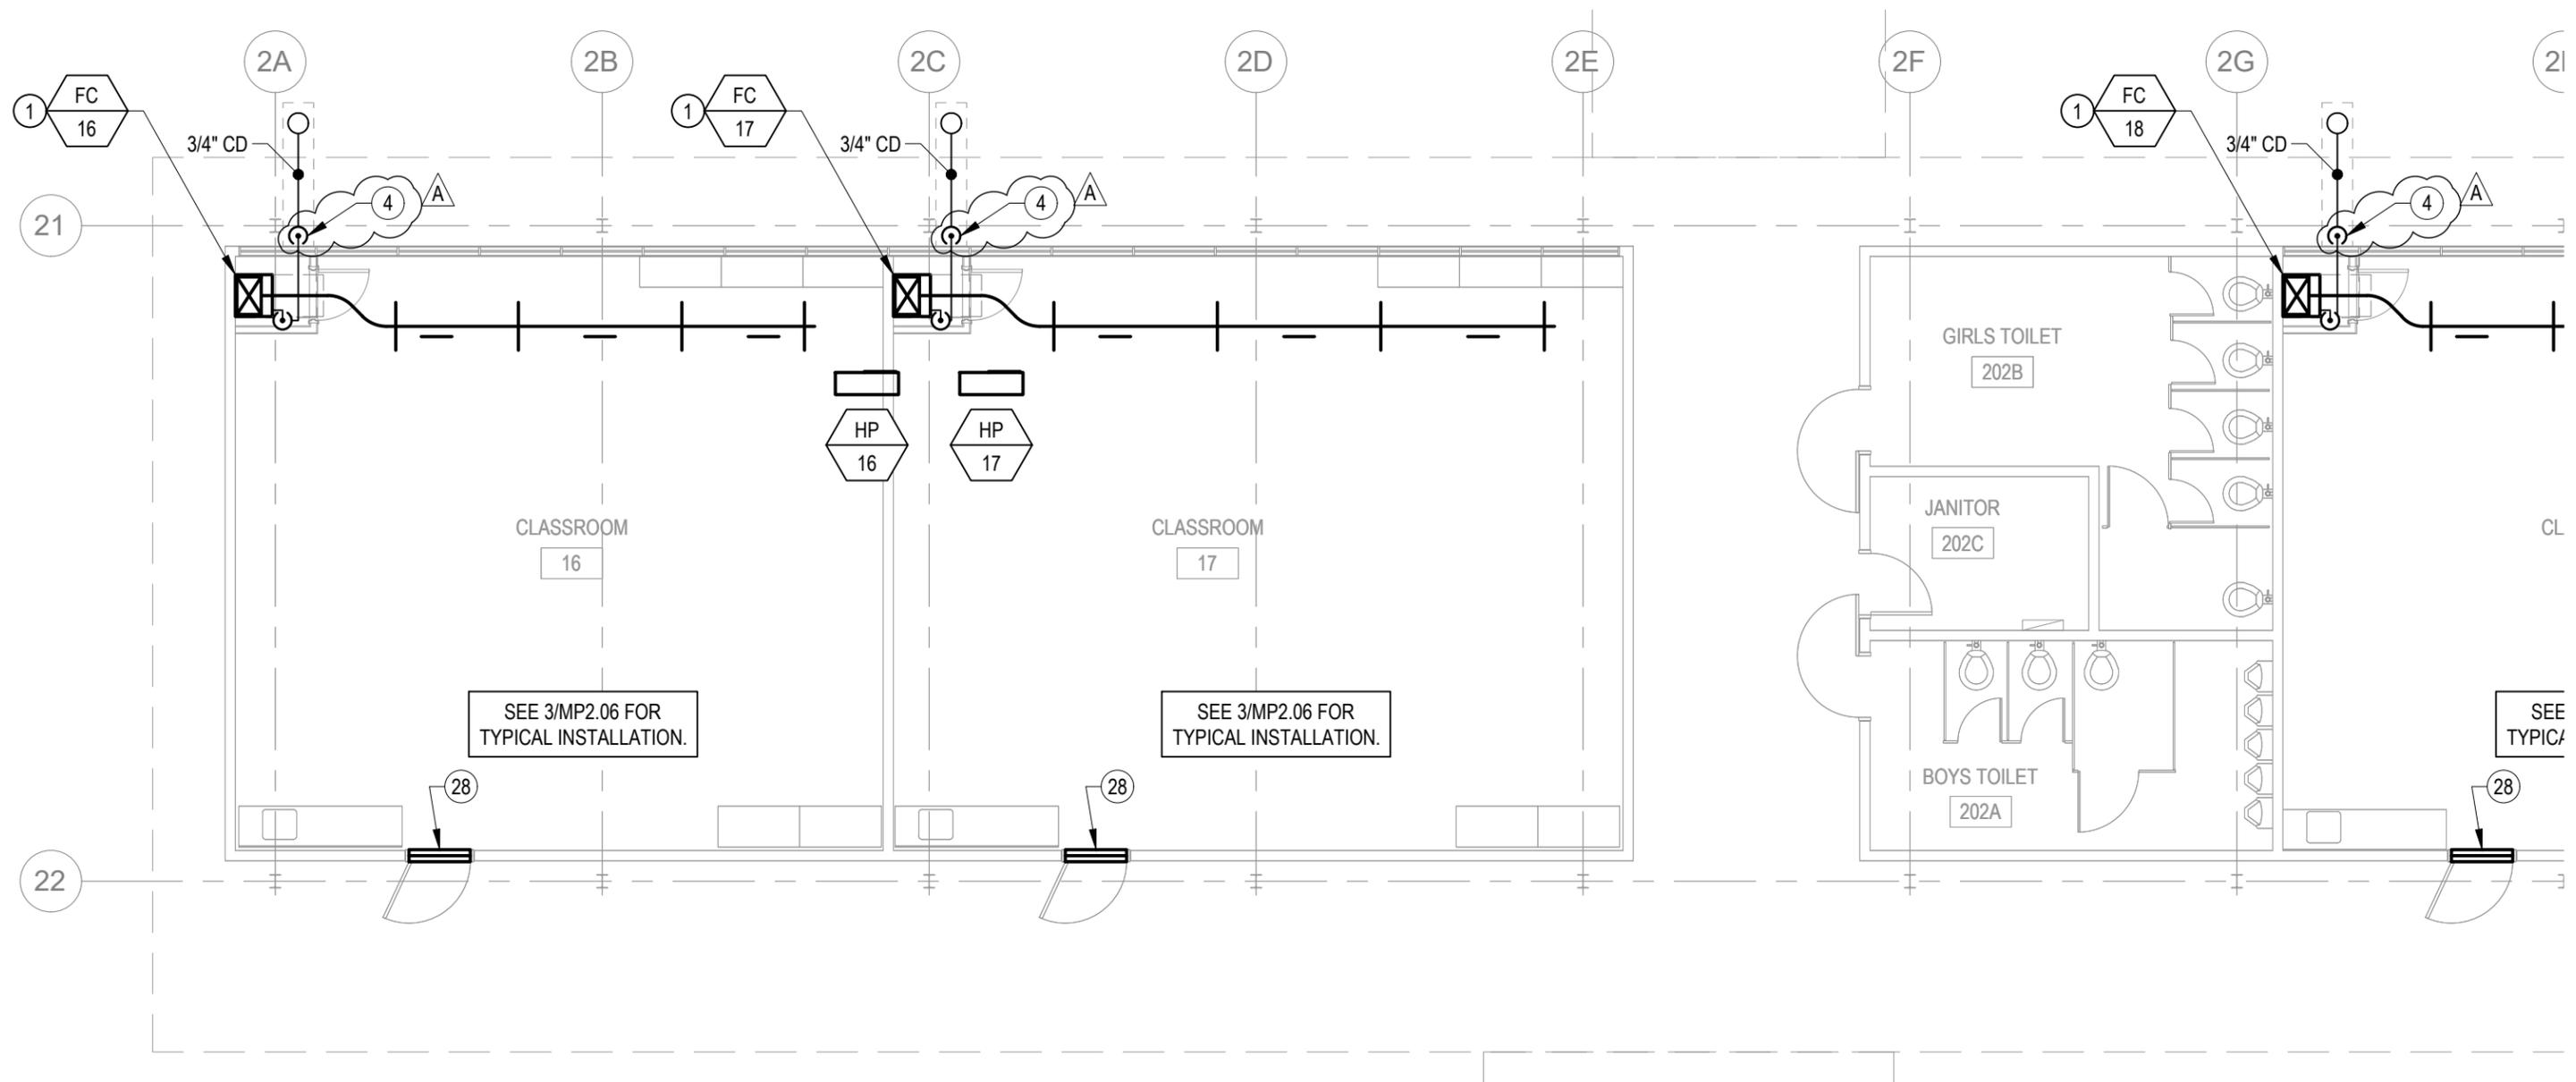

**2 FLOOR PLAN - WING 2 - NEW**  
 MP2.06 SCALE: 1/8" = 1'-0"




CEG JOB NO: 21039

**CYPRESS**  
 Engineering Group

HVAC, Plumbing, Fire Protection  
 Building Commissioning  
 Industrial Refrigeration  
 Environmental Compliance  
 Training & Technical Support

831.218.1802  
 8 Harris Court, Suite A8  
 Monterey, CA 93940  
 cypressseg.com

		ABBOTT MIDDLE SCHOOL - HVAC REPLACEMENT	
		SAN MATEO-FOSTER CITY SCHOOL DISTRICT	
FILE NO.: 41-26	SHEET	REF. SHEET MP2.06	
APPL NO.: 01-119556	<b>AD1-MP2.06b</b>		
JOB NO.: 2021005.06	DATE 11/24/2021		
387 S. 1st Street, Suite 300 San Jose, CA., 95113	tel: (408) 300 - 5160 fax: (408) 300 - 5121		

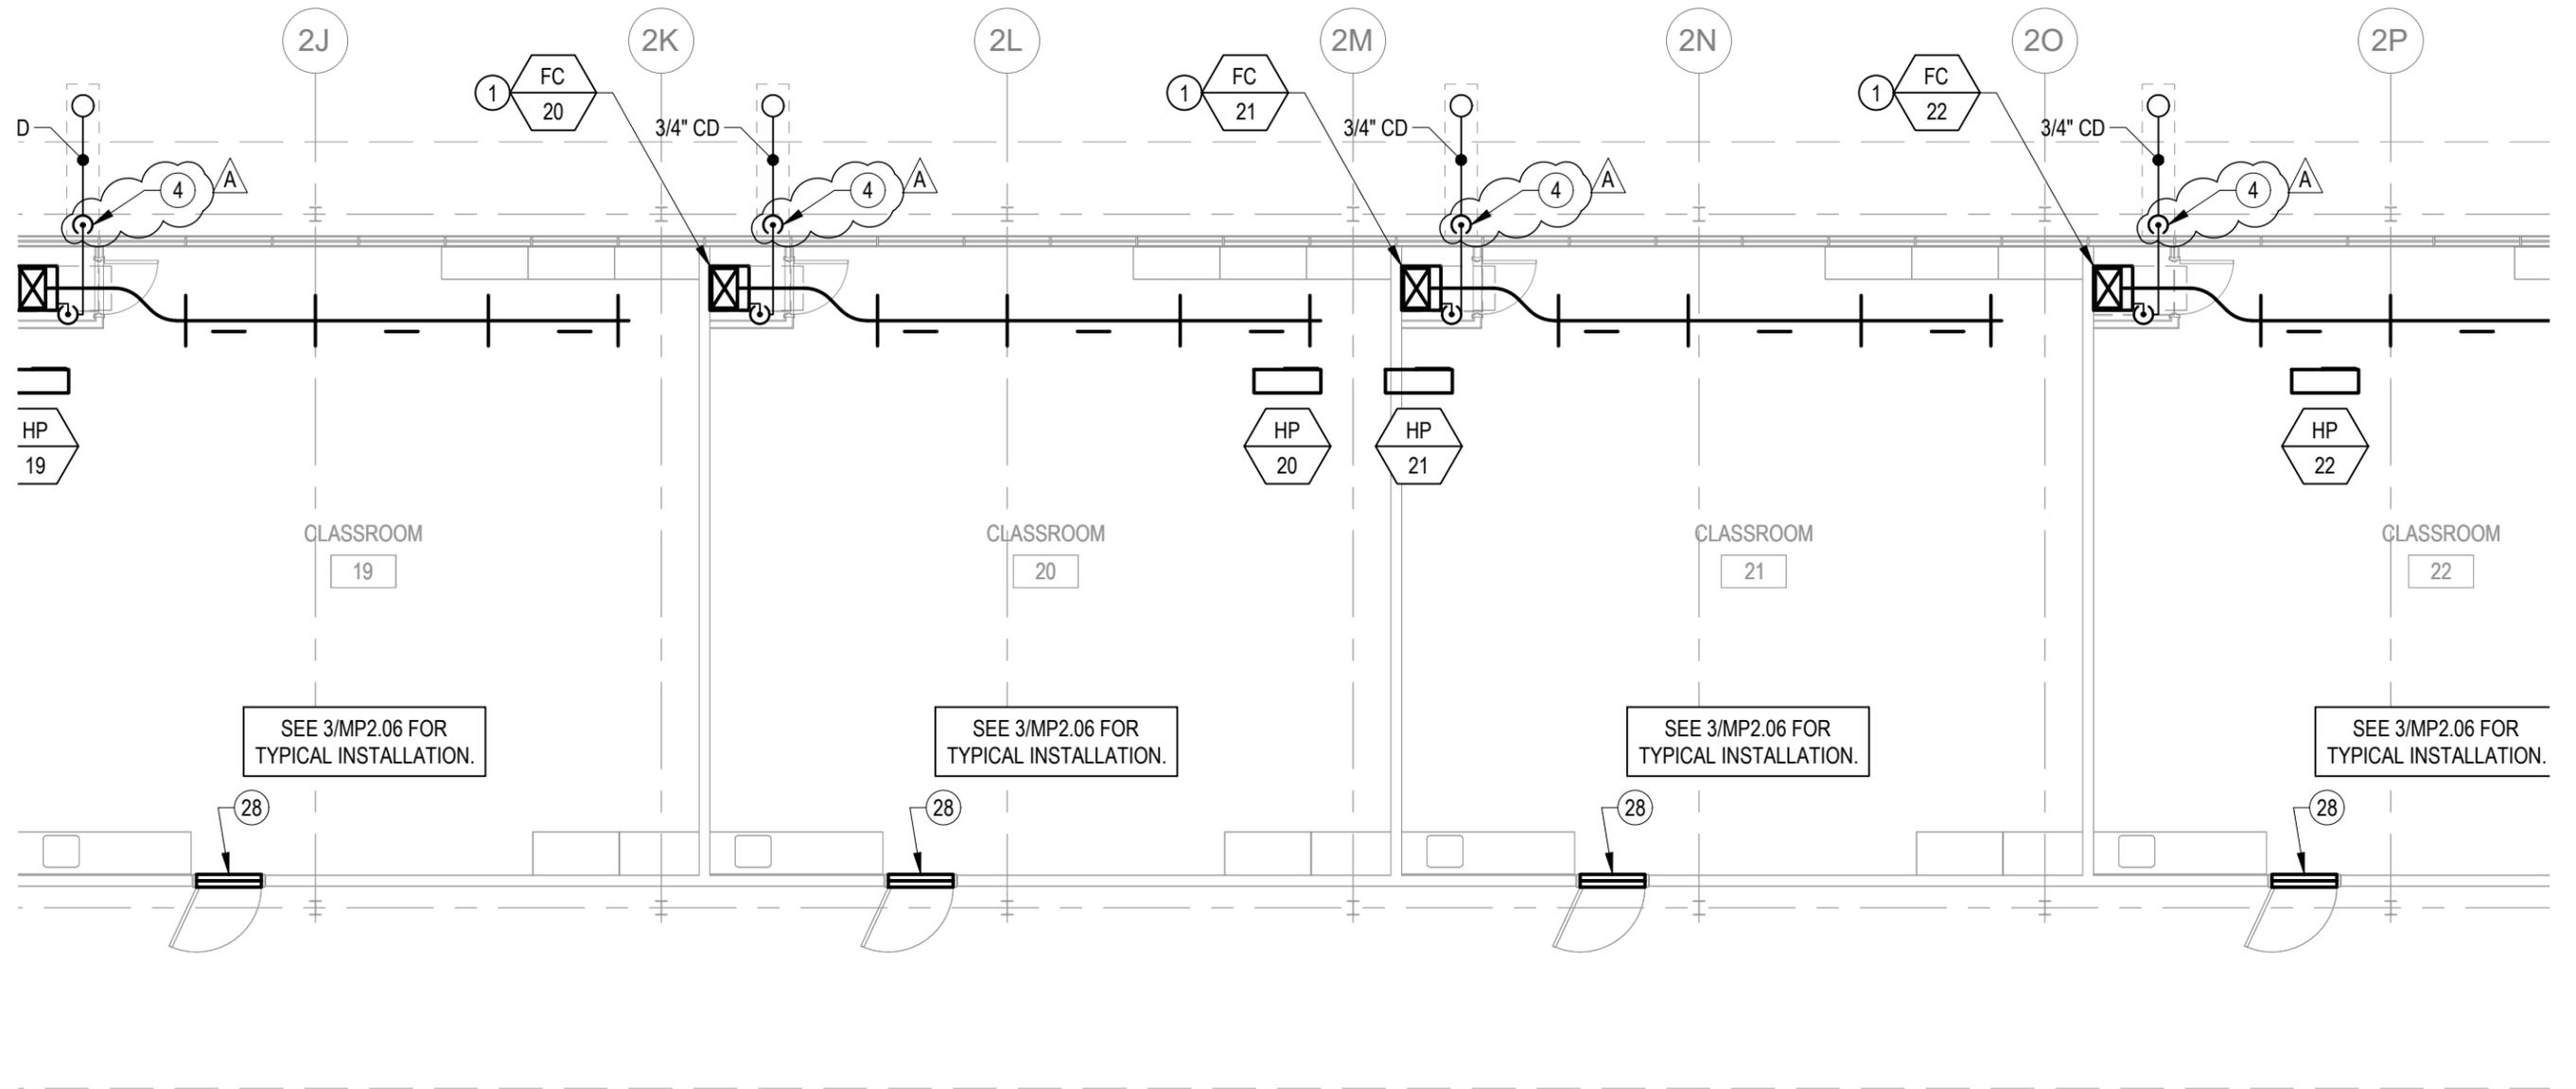

**2 FLOOR PLAN - WING 2 - NEW**  
 MP2.06 SCALE: 1/8" = 1'-0"



CEG JOB NO: 21039

**CYPRESS**  
Engineering Group

HVAC, Plumbing, Fire Protection  
 Building Commissioning  
 Industrial Refrigeration  
 Environmental Compliance  
 Training & Technical Support

831.218.1802  
 8 Harris Court, Suite A8  
 Monterey, CA 93940  
 cypressseg.com

		ABBOTT MIDDLE SCHOOL - HVAC REPLACEMENT SAN MATEO-FOSTER CITY SCHOOL DISTRICT	
		FILE NO.: 41-26 APPL NO.: 01-119556 JOB NO.: 2021005.06 DATE: 11/24/2021	SHEET REF. SHEET MP2.06 <b>AD1-MP2.06c</b>
387 S. 1st Street, Suite 300 San Jose, CA., 95113		tel: (408) 300 - 5160 fax: (408) 300 - 5121	

### GENERAL NOTES

1. CONTRACTOR SHALL BE RESPONSIBLE FOR PROTECTING ALL EXISTING AND NEW BUILDING STRUCTURES, SERVICES AND OWNER'S PROPERTY DURING THE ENTIRE PERIOD OF CONSTRUCTION.
2. COORDINATE THE LOCATIONS OF ROOF/ WALL OPENINGS, PENETRATIONS, DUCTWORK AND ALL MECHANICAL EQUIPMENT WITH RESPECT TO BUILDING STRUCTURE AND OTHER BUILDING SERVICES TO AVOID CONFLICT.
3. FOR CLARITY, ABANDONED CONDENSATE DRAIN PIPES AND (E) GAS MAINS ARE NOT SHOWN ON THIS PLAN. SEE MP2.02.
4. PAINT ALL EXPOSED DUCTWORK AND REGISTERS TO MATCH ADJACENT. <sup>A</sup>
5. SEE DETAIL 11/MP6.01 FOR PIPE SUPPORT ON ROOF.
6. EQUIPMENT MOUNTING DETAIL REFERENCE SHOWN ON SCHEDULES ON SHEETS MP0.02 AND MP0.03.
7. CLEAN ALL (E) DUCTWORK AND REGISTERS PER SPECIFICATION 23 01 30.
8. PAINT ALL EXPOSED CONDENSATE PIPING AT EXTERIOR TO MATCH ADJACENT. <sup>A</sup>



CEG JOB NO: 21039

**CYPRESS**  
Engineering Group

831.218.1802  
8 Harris Court, Suite A8  
Monterey, CA 93940  
cypressseg.com

HVAC, Plumbing, Fire Protection  
Building Commissioning  
Industrial Refrigeration  
Environmental Compliance  
Training & Technical Support

		ABBOTT MIDDLE SCHOOL - HVAC REPLACEMENT  SAN MATEO-FOSTER CITY SCHOOL DISTRICT	
		FILE NO.: 41-26	SHEET
387 S. 1st Street, Suite 300 San Jose, CA., 95113		APPL NO.: 01-119556	REF. SHEET MP2.07
tel: (408) 300 - 5160 fax: (408) 300 - 5121		JOB NO. 2021005.06	<b>AD1-MP2.07</b>
		DATE 11/24/2021	

# NEW SHEET NOTES

- A
1. INSTALL ROOFTOP AC UNIT ON NEW ROOF CURB. ENSURE CORRECT UNIT ORIENTATION AND CONNECT TO (E) SUPPLY AND RETURN DUCTWORK, TYP.
  2. INSTALL GAS PIPE FROM POC TO AC UNIT. INSTALL GAS PIPE WITH SHUTOFF VALVE, DIRT LEG, AND FLEX CONNECTION AT AC UNIT. INSTALL CONDENSATE DRAIN PIPE WITH TRAP AND CONNECT TO (E) CD PIPE. FOR PIPE SUPPORT ON ROOF, SEE DETAIL 11/MP6.01. CONNECT TO AC UNIT PER 8/MP6.01.
  3. INSTALL CONDENSATE DRAIN PIPE WITH TRAP AND CONNECT TO (E) CD PIPE. CONNECT TO AC UNIT PER 8/MP6.01.
  4. INSTALL THERMOSTAT ON WALL AND WIRE TO AC UNIT, TYP OF (5).
  5. INSTALL CONDENSING UNIT ON HOUSEKEEPING PAD, CONNECT REFRIGERANT PIPING TO COOLING COIL.
  6. INSTALL COOLING COIL IN CEILING SPACE AND CONNECT TO (E) DUCTWORK. PROVIDE FLEX CONNECTOR AT DUCT CONNECTION. INSTALL DRAIN PAN UNDER COIL. CONNECT CONDENSATE DRAIN TO (E) CD AND ADD SECONDARY CD PIPE.
  7. INSTALL FURNACE IN CEILING SPACE AND CONNECT TO (E) DUCTWORK. INSTALL COMBUSTION AIR INTAKE. CONNECT FLUE PIPE TO (E) FLUE AT BOTTOM OF ROOF STRUCTURE.
  8. INSTALL FILTER BOX AND CONNECT TO FURNACE. PROVIDE FLEX CONNECTOR AT FURNACE CONNECTION. FILTER

BOX SHALL HAVE SIDE ACCESS, WITH HINGED ACCESS PANEL AND TOOL-LESS CAM LOCKS.

9. CONNECT (E) GAS TO NEW FURNACE PER 8/MP6.01.
10. INSTALL REFRIGERANT PIPE FROM CONDENSING UNIT TO COOLING COIL. SIZE PER MANUFACTURER'S REQUIREMENTS. PROVIDE ALUMINUM JACKETING AT EXTERIOR.
11. INSTALL THERMOSTAT ON WALL AND WIRE TO HVAC EQUIPMENT.




CEG JOB NO: 21039


831.218.1802  
8 Harris Court, Suite A8  
Monterey, CA 93940  
cypresseg.com

HVAC, Plumbing, Fire Protection  
Building Commissioning  
Industrial Refrigeration  
Environmental Compliance  
Training & Technical Support

		ABBOTT MIDDLE SCHOOL - HVAC REPLACEMENT	
		SAN MATEO-FOSTER CITY SCHOOL DISTRICT	
FILE NO.:	41-26	SHEET	REF. SHEET MP2.08
APPL NO.:	01-119556	<b>AD1-MP2.08</b>	
JOB NO.:	2021005.06		
DATE	11/24/2021		
387 S. 1st Street, Suite 300 San Jose, CA., 95113		tel: (408) 300 - 5160 fax: (408) 300 - 5121	

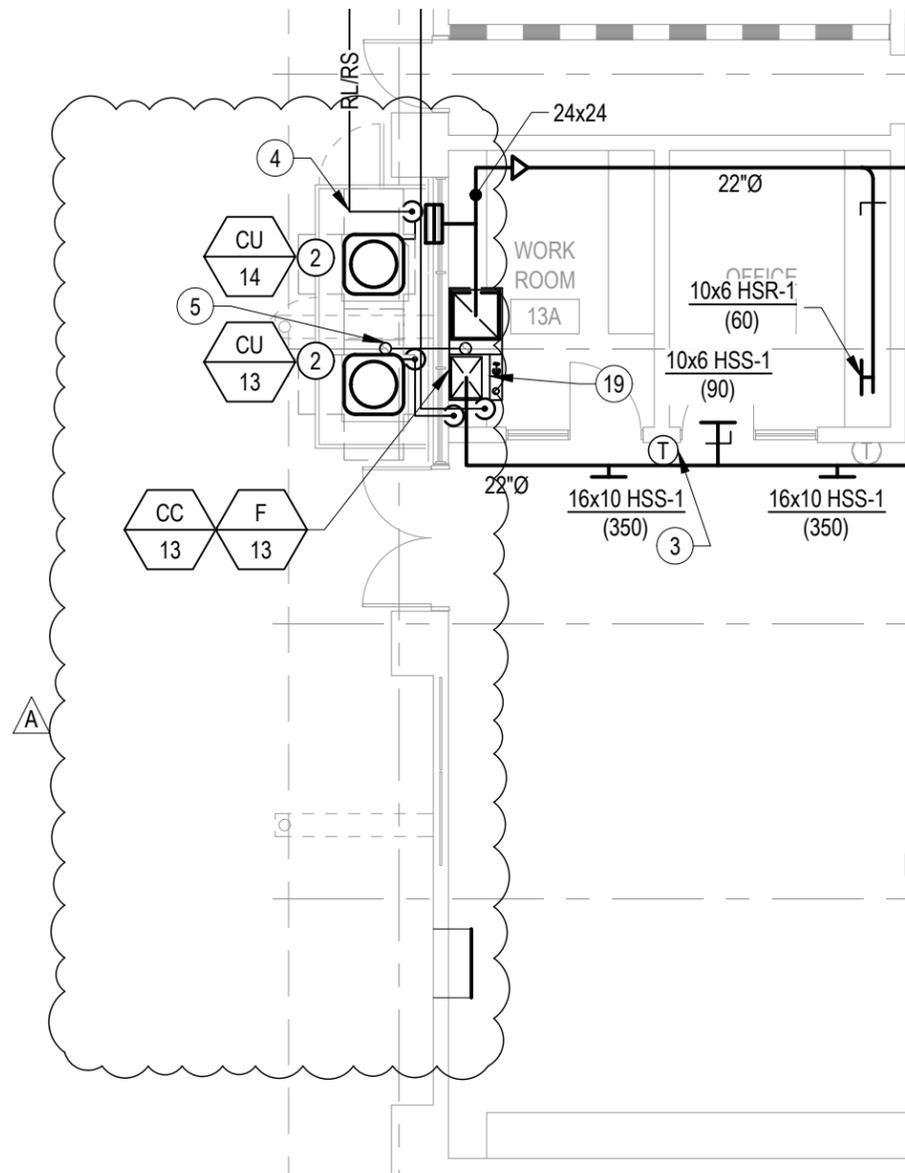

- ### GENERAL NOTES
1. CONTRACTOR SHALL BE RESPONSIBLE FOR PROTECTING ALL EXISTING AND NEW BUILDING STRUCTURES, SERVICES AND OWNER'S PROPERTY DURING THE ENTIRE PERIOD OF CONSTRUCTION.
  2. COORDINATE THE LOCATIONS OF ROOF/ WALL OPENINGS, PENETRATIONS, DUCTWORK AND ALL MECHANICAL EQUIPMENT WITH RESPECT TO BUILDING STRUCTURE AND OTHER BUILDING SERVICES TO AVOID CONFLICT.
  3. EQUIPMENT MOUNTING DETAIL REFERENCE SHOWN ON SCHEDULES ON SHEETS MP0.02 AND MP0.03.
  4. CLEAN ALL (E) DUCTWORK AND REGISTERS PER SPECIFICATION 23 01 30.
  5. PAINT ALL EXPOSED DUCTWORK, SUPPORTS, AND REGISTERS TO MATCH ADJACENT. A

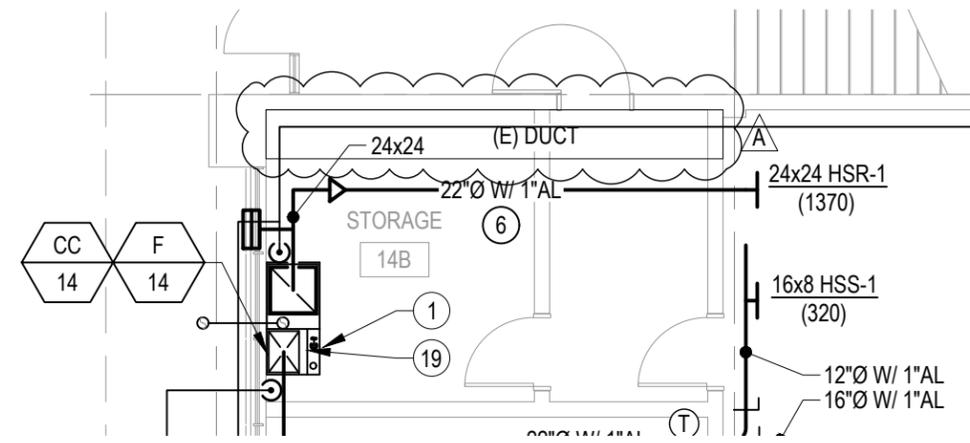

1  
MP2.09

## PARTIAL FIRST FLOOR PLAN - MULTIPURPSE BLDG - NEW

SCALE: 1/8" = 1'-0"




CEG JOB NO: 21039

**CYPRESS**  
Engineering Group

HVAC, Plumbing, Fire Protection  
Building Commissioning  
Industrial Refrigeration  
Environmental Compliance  
Training & Technical Support

831.218.1802  
8 Harris Court, Suite A8  
Monterey, CA 93940  
cypressseg.com

		ABBOTT MIDDLE SCHOOL - HVAC REPLACEMENT  SAN MATEO-FOSTER CITY SCHOOL DISTRICT	
FILE NO.:	41-26	SHEET	REF. SHEET MP2.09
APPL NO.:	01-119556	JOB NO.:	2021005.06
DATE	11/24/2021	AD1-MP2.09	
387 S. 1st Street, Suite 300 San Jose, CA., 95113		tel: (408) 300 - 5160 fax: (408) 300 - 5121	

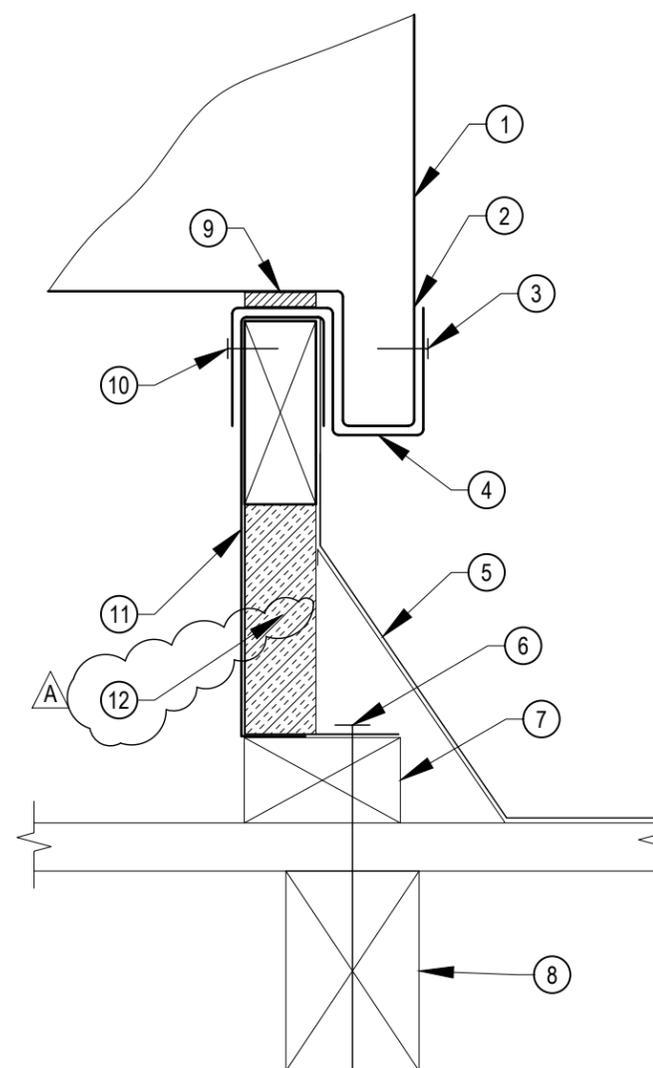

- **DETAIL NOTES:**
1. UNIT. FOR LOCATION, SEE PLANS.
  2. UNIT BASE RAIL.
  3. SECURE HOLD DOWN TO UNIT BASE RAIL WITH (4) #10 x1/2" TEK SCREWS.
  4. MICROMETL UNIT HOLD DOWNS, TYPICAL OF 2 PER SIDE.
  5. ROOFING, SEE ARCHITECTS DRAWINGS.
  6. (E) 5/8"Ø THRU BOLT @ 36" O.C. VERIFY IN FIELD, RE-ATTACH TO CURB.
  7. (E) LEVELING RAIL.
  8. (E) 4X6 BLOCKING.
  9. SEALING GASKET.
  10. SECURE HOLD DOWN TO UNIT CURB WITH (4) #10 x 1/2" TEK SCREWS, TYP.
  11. MICROMETL ROOF CURB W/ WOOD NAILER. MATCH EXISTING CURB.
  12. RIGID INSULATION.

6 ROOFTOP AIR CONDITIONER MOUNTING ON ROOF CURB N.T.S.




CEG JOB NO: 21039

**CYPRESS**  
Engineering Group

831.218.1802  
8 Harris Court, Suite A8  
Monterey, CA 93940  
cypressseg.com

HVAC, Plumbing, Fire Protection  
Building Commissioning  
Industrial Refrigeration  
Environmental Compliance  
Training & Technical Support

		ABBOTT MIDDLE SCHOOL - HVAC REPLACEMENT  SAN MATEO-FOSTER CITY SCHOOL DISTRICT	
FILE NO.:	41-26	SHEET	REF. SHEET MP6.01
APPL NO.:	01-119556	JOB NO.:	2021005.06
DATE	11/24/2021	AD1-MP6.01	
387 S. 1st Street, Suite 300 San Jose, CA., 95113		tel: (408) 300 - 5160 fax: (408) 300 - 5121	

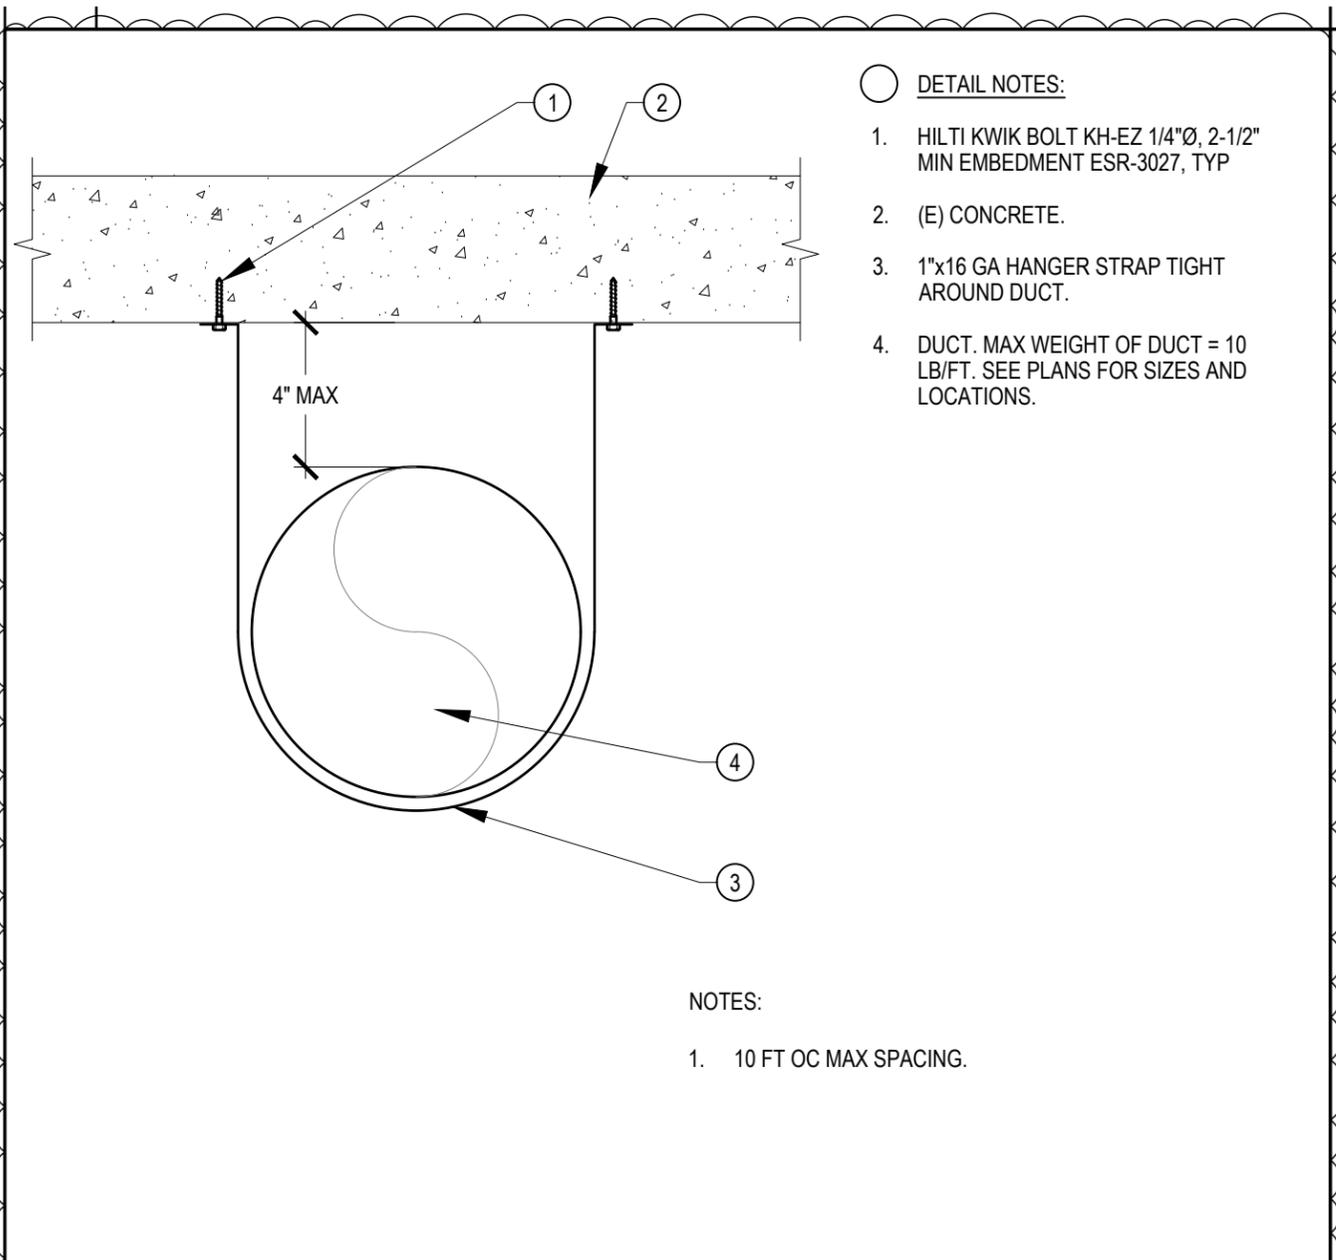


- **DETAIL NOTES:**
1. HILTI KWIK BOLT KH-EZ 1/4"Ø, 2-1/2" MIN EMBEDMENT ESR-3027, TYP
  2. (E) CONCRETE.
  3. 1"x16 GA HANGER STRAP TIGHT AROUND DUCT.
  4. DUCT. MAX WEIGHT OF DUCT = 10 LB/FT. SEE PLANS FOR SIZES AND LOCATIONS.

- NOTES:
1. 10 FT OC MAX SPACING.

6 ROUND DUCT HANGER AT CONCRETE CEILING

N.T.S.

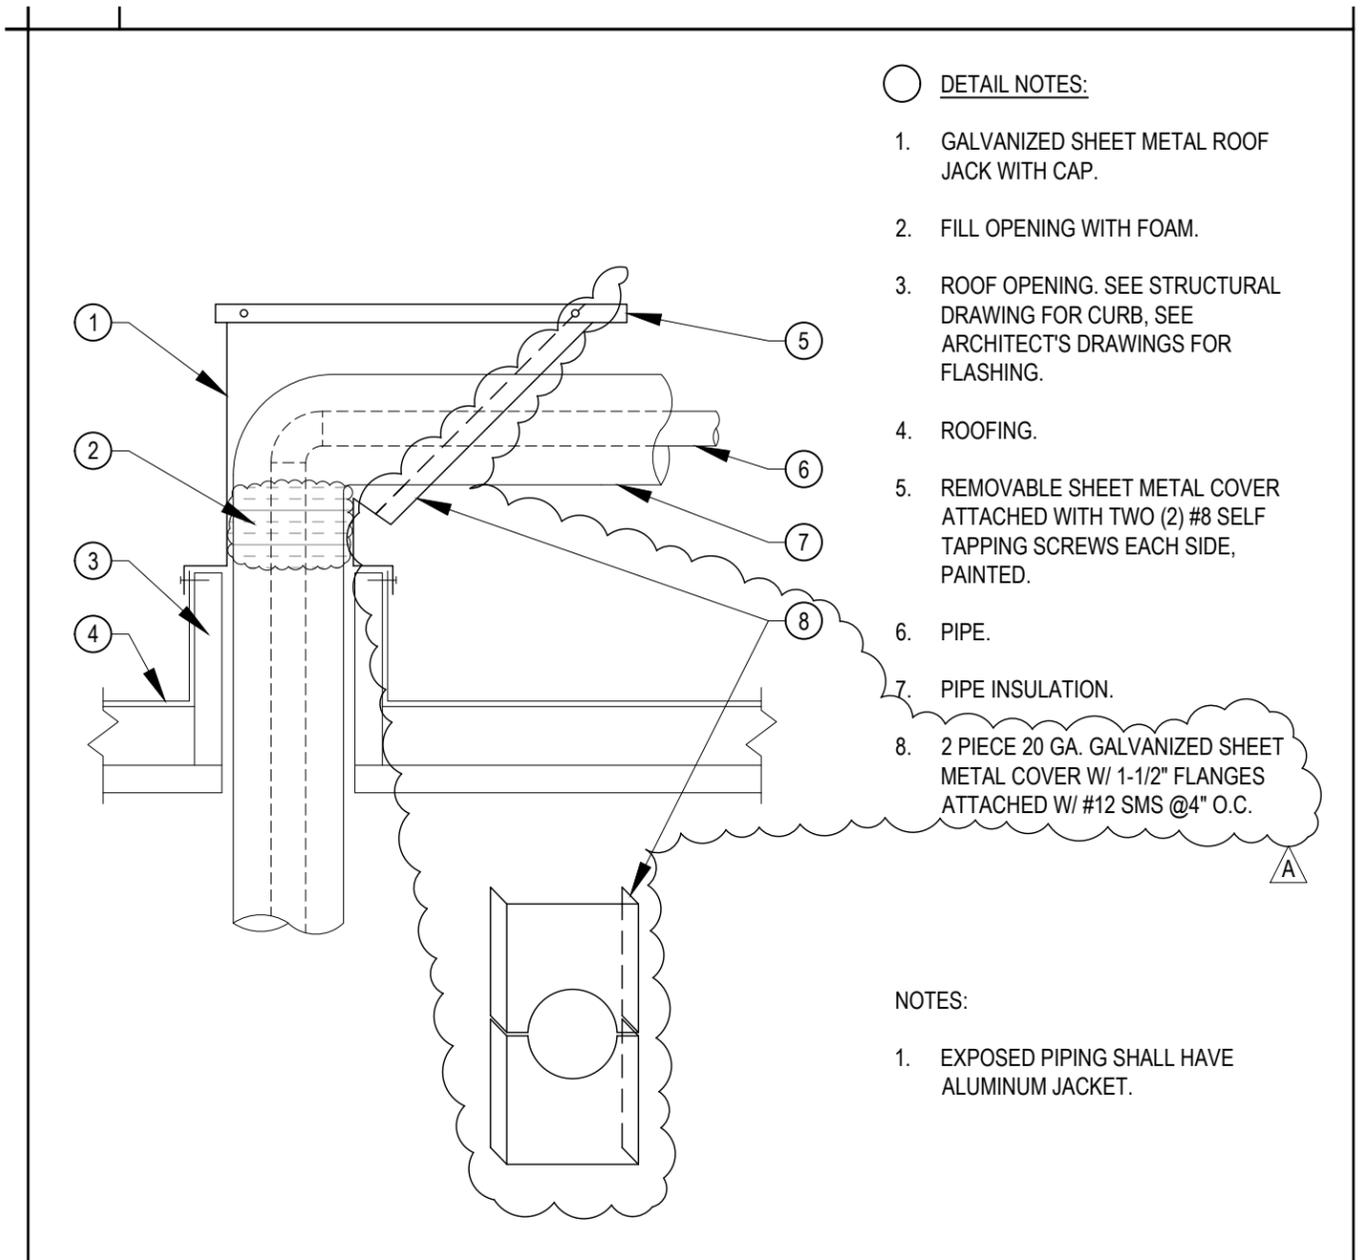

- **DETAIL NOTES:**
1. GALVANIZED SHEET METAL ROOF JACK WITH CAP.
  2. FILL OPENING WITH FOAM.
  3. ROOF OPENING. SEE STRUCTURAL DRAWING FOR CURB, SEE ARCHITECT'S DRAWINGS FOR FLASHING.
  4. ROOFING.
  5. REMOVABLE SHEET METAL COVER ATTACHED WITH TWO (2) #8 SELF TAPPING SCREWS EACH SIDE, PAINTED.
  6. PIPE.
  7. PIPE INSULATION.
  8. 2 PIECE 20 GA. GALVANIZED SHEET METAL COVER W/ 1-1/2" FLANGES ATTACHED W/ #12 SMS @4" O.C.

- NOTES:
1. EXPOSED PIPING SHALL HAVE ALUMINUM JACKET.

4 PIPING ROOF JACK

N.T.S.




CEG JOB NO: 21039

**CYPRESS**  
Engineering Group

HVAC, Plumbing, Fire Protection  
Building Commissioning  
Industrial Refrigeration  
Environmental Compliance  
Training & Technical Support

831.218.1802  
8 Harris Court, Suite A8  
Monterey, CA 93940  
cypressseg.com

		ABBOTT MIDDLE SCHOOL - HVAC REPLACEMENT SAN MATEO-FOSTER CITY SCHOOL DISTRICT	
		FILE NO.: 41-26 APPL NO.: 01-119556 JOB NO.: 2021005.06 DATE: 11/24/2021	SHEET REF. SHEET MP6.02 <b>AD1-MP6.02</b>
387 S. 1st Street, Suite 300 San Jose, CA., 95113		tel: (408) 300 - 5160 fax: (408) 300 - 5121	

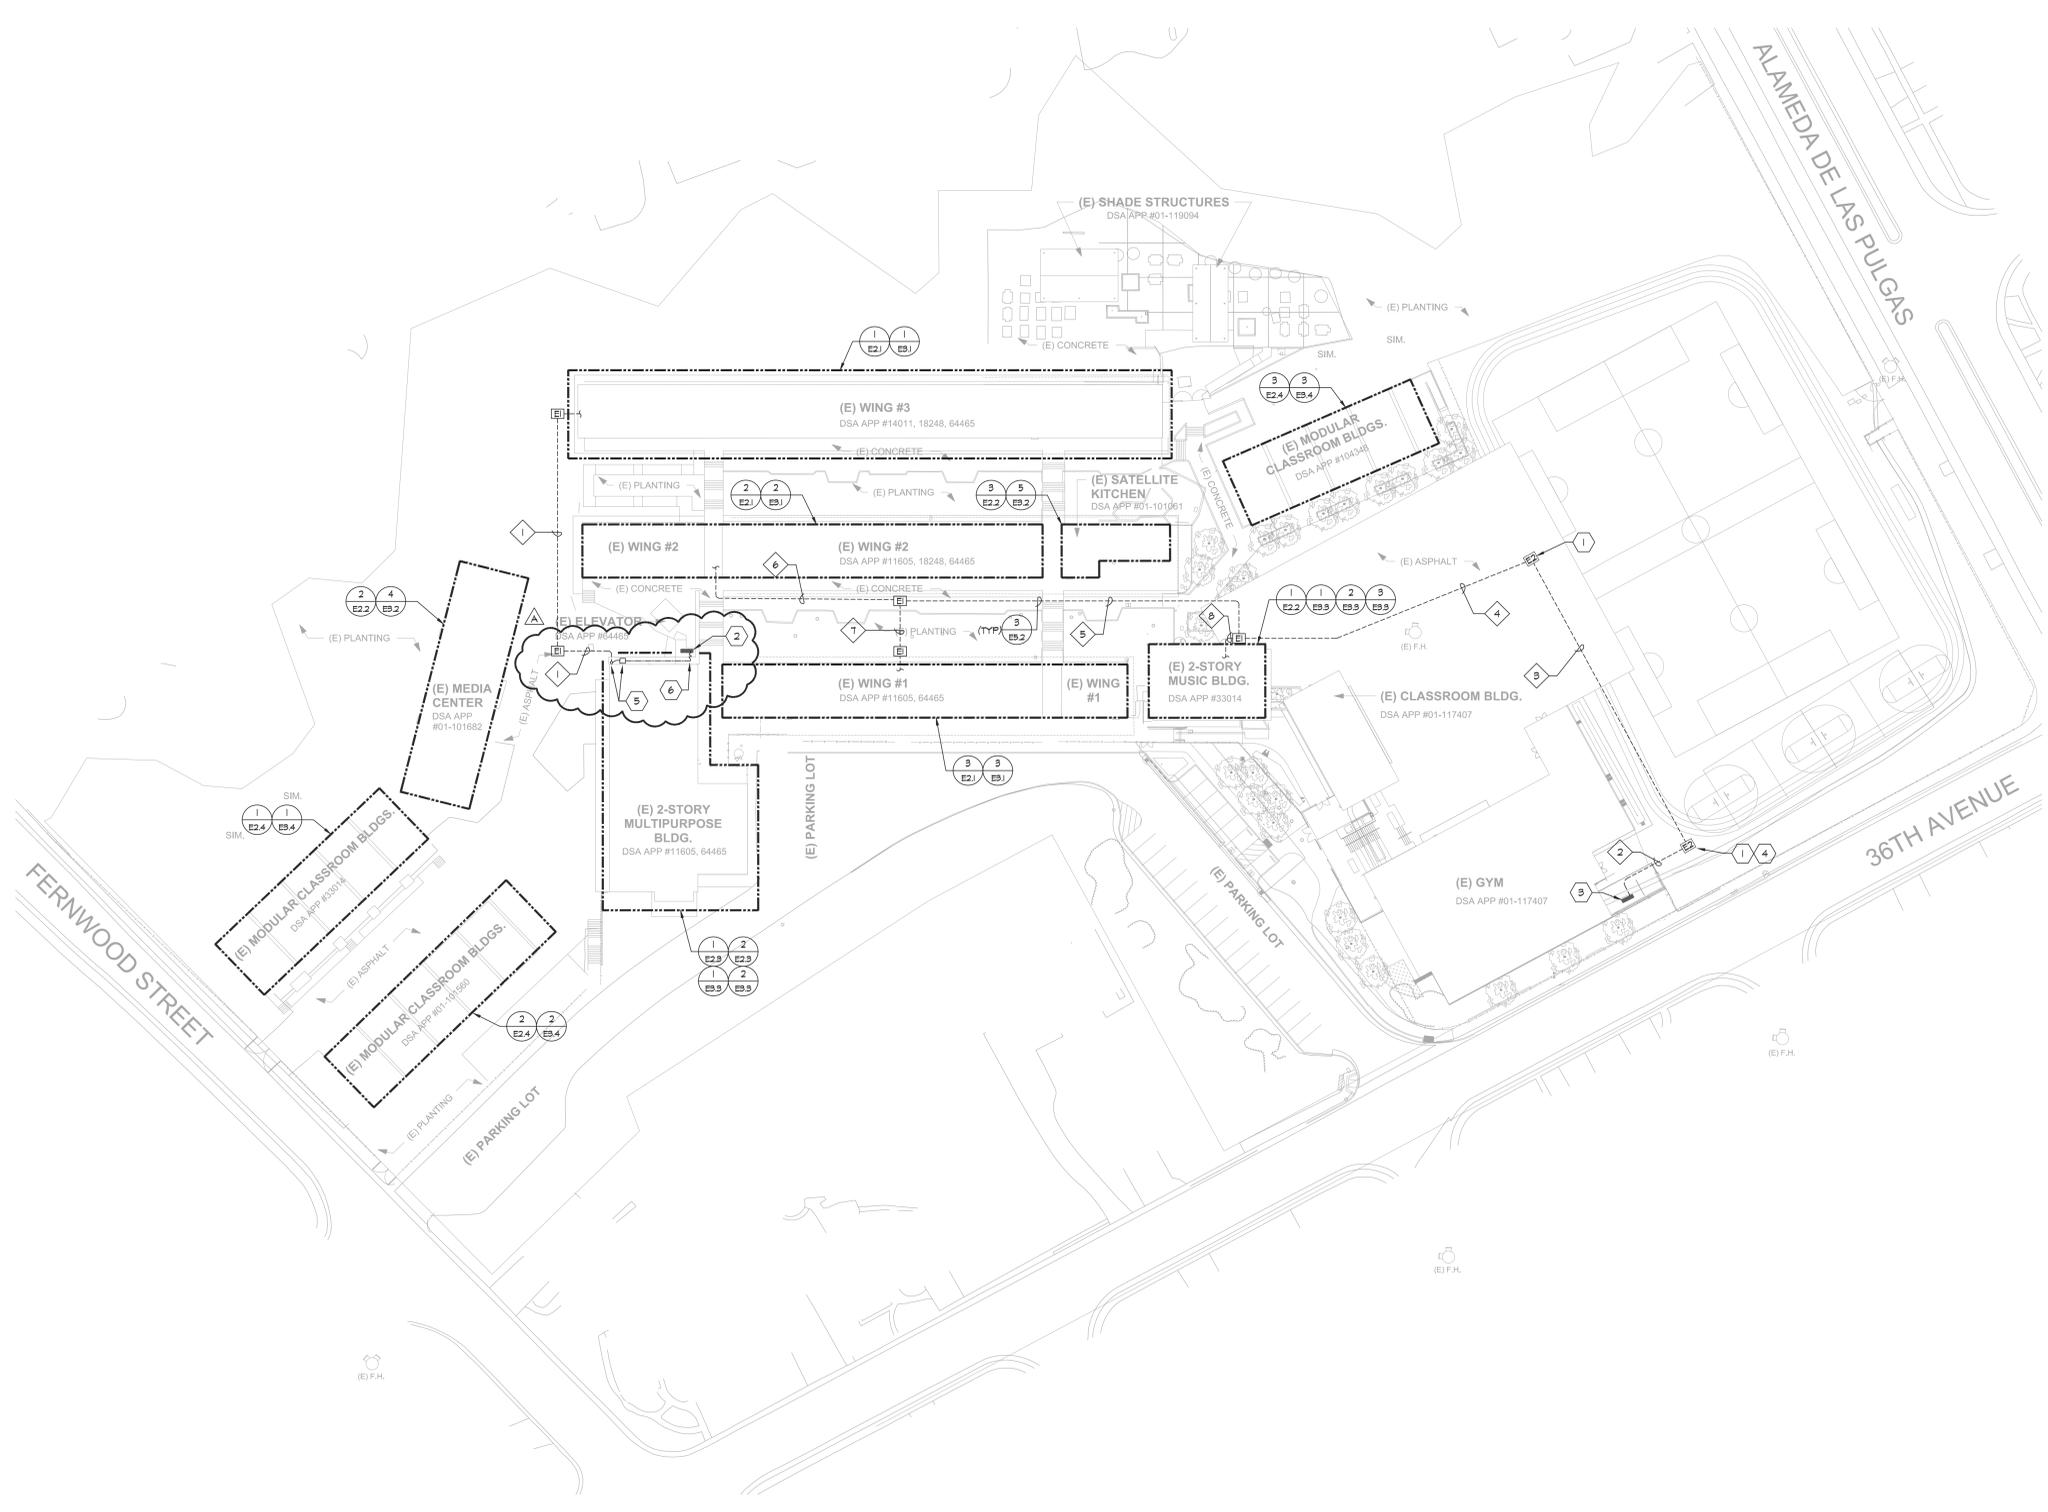

**GENERAL NOTES:**

1. CONTRACTOR SHALL COORDINATE UNDERGROUND REQUIREMENTS WITH ALL OTHER TRADES TO AVOID CONFLICTS.
2. CONTRACTOR SHALL BE RESPONSIBLE FOR ANY SAN CUTTING AND REMOVAL OF EXISTING SURFACES TO FACILITATE UNDERGROUND SYSTEMS. THE CONTRACTOR SHALL PATCH AND REPAIR ALL DAMAGED AND CUT SURFACES TO MATCH ADJACENT.
3. CONTRACTOR TO SITE SURVEY EXISTING CONDITIONS AND LOCATIONS OF EXISTING UNDERGROUND SYSTEMS. WHERE NEW TRENCH WORK OCCURS PRIOR TO BIDDING, CONTRACTOR SHALL TAKE PROPER PRECAUTIONS TO ENSURE EXISTING UNDERGROUND SYSTEMS/CONDUIT/PIPES ARE NOT DAMAGED DURING INSTALLATION. CONTRACTOR IS RESPONSIBLE FOR ANY REPAIRS REQUIRED IN THE EVENT THE EXISTING UNDERGROUND SYSTEMS ARE DAMAGED AS A RESULT OF THE NEW ELECTRICAL TRENCH WORK.
4. ALL ON-SITE TRENCHING SHALL BE INSTALLED PER DETAIL 3/ES.2.
5. SEE DEMOLITION SINGLE LINE DIAGRAM FOR ADDITIONAL REQUIREMENTS.
6. SEE NEW SINGLE LINE DIAGRAM FOR FEEDER, CABLE, AND CONDUIT REQUIREMENTS.

**SHEET NOTES:**

1. EXISTING IN-GRADE BOX.
2. EXISTING MAIN SWITCHBOARD #1.
3. EXISTING MAIN SWITCHBOARD #2.
4. SPLICE CABLES INSIDE THIS EXISTING IN-GRADE ELECTRICAL FULL BOX. PROVIDE POLARIS SUBMERSIBLE SPLICE CONNECTIONS.
5. TRANSITION CONDUITS FROM UNDERGROUND TO ABOVE GROUND AT THE EXTERIOR WALL. ROUTE CONDUITS ON WALL TO ABOVE OVERHANGS. PROVIDE NEMA-3R FULL CAN AND ROUTE CONDUITS UNDERNEATH OVERHANGS.
6. ROUTE CONDUITS UNDERNEATH OVERHANG TO EXISTING SWITCHGEAR LOCATION. PROVIDE LIQUID-TIGHT FLEXIBLE METAL CONDUIT AND TRANSITION CONDUITS INTO THE TOP OF THE SWITCHGEAR.

**CONDUIT SCHEDULE:**

- 1 (N) (3) 3" - PANEL 'EM'
- 2 (E) (1) 4" - PNL 'A' (MUSIC BUILDINGS)  
(E) (1) 4" - PNL 'A' (WING 1)  
(N) (1) 4" - PNL 'DM' (WING 2)
- 3 (E) (2) 4" - PNL 'A' (MUSIC BUILDINGS)  
(N) (3) 4" - PNL 'A' (WING 1)  
(N) (3) 4" - PNL 'DM' (WING 2)
- 4 (E) (2) 4" - PNL 'A' (MUSIC BUILDINGS)  
(N) (3) 4" - PNL 'A' (WING 1)  
(N) (3) 4" - PNL 'DM' (WING 2)
- 5 (N) (4) 4" - PNL 'DM' (WING 2)  
(N) (3) 4" - PNL 'A' (WING 1)
- 6 (N) (3) 4" - PNL 'DM' (WING 2)
- 7 (N) (3) 4" - PNL 'A' (WING 1)
- 8 (N) (2) 4" - PNL 'A' (MUSIC BUILDINGS)

**PULLBOX SCHEDULE:**

- 1 - NEW B2436 ELECTRIC / POWER PULLBOX WITH TRAFFIC RATED LID, LABEL LID POWER.
- 2 - EXISTING B2436 ELECTRIC / POWER PULLBOX WITH TRAFFIC RATED LID, LABEL LID POWER.

**1 ELECTRICAL SITE PLAN**  
E1.1 SCALE: 1" = 40'-0"



**aedis**  
architects  
www.aedisarchitects.com  
387 S. 1st Street, Suite 300  
San Jose, CA 95113  
t el: (408) 300-5160  
f ax: (408) 300-5121

PROJECT  
**ABBOTT MIDDLE SCHOOL - HVAC REPLACEMENT**  
SAN MATEO-FOSTER CITY SCHOOL DISTRICT  
CONSULTANT



American Consulting Engineers  
Electrical, Inc.  
1580 The Alameda, Suite 202 San Jose, CA 95126  
408/231-2312 Fax: 408/231-2313  
E16890 Lic. 062424

STATE  
DSA FILE NUMBER **41-26**  
APPL # **01-119557**

REVISIONS

No.	Description	Date
1	APPENDUM I	11/24/2021

MILESTONES

DD	
90% CD	
DSA SUB	06/03/2021
BACKCHECK	

SHEET  
**ELECTRICAL SITE PLAN**

DATE **11/24/2021**  
JOB # **2021005.06**  
SHEET #

**E1.1**

**GENERAL NOTES:**

- ALL CONDUITS SHALL BE ROUTED CONCEALED IN CEILING BELOW WHERE POSSIBLE.
- CONTRACTOR SHALL COORDINATE EXACT LOCATIONS AND POINTS OF CONNECTION FOR MECHANICAL UNIT WITH MECHANICAL CONTRACTOR, ADJUST LOCATION AND CONNECTION POINTS AS NEEDED.
- SEE PANEL SCHEDULES AND SINGLE LINE DIAGRAM FOR POWER CONNECTION REQUIREMENTS.
- COORDINATE WITH ARCHITECTURAL AND MECHANICAL DRAWINGS FOR ADDITIONAL REQUIREMENTS.
- FUSED AND UNFUSED DISCONNECT SWITCHES SHALL BE 600V RATED, HEAVY DUTY CYCLE. FUSES FOR MECHANICAL UNITS SHALL BE SIZED PER THE MANUFACTURER'S RECOMMENDATION.

**SHEET NOTES:**


- NEW 60A-2P, NEMA-3R, FUSED DISCONNECT SWITCH FOR MECHANICAL UNIT.
- NEW 30A-2P, NEMA-1, MOTOR-RATED DISCONNECT SWITCH FOR MECHANICAL UNIT.
- NEW 30A-2P, NEMA-3R, FUSED DISCONNECT SWITCH FOR MECHANICAL UNIT.
- NOT USED.
- NEW 60A-3P, NEMA-3R, FUSED DISCONNECT SWITCH FOR MECHANICAL UNIT.
- PROVIDE NEW WEATHERPROOF 6FCI RECEPTACLE. RECEPTACLE SHALL BE MOUNTED ON A WEATHERPROOF BOX WITH WHILE-IN-USE COVER. COVER SHALL BE INTERMATIC PFI010MID '8055'.
- PROVIDE MOTOR RATED SWITCH AND 120V POWER FOR CONDENSATION PUMP.
- TRANSITIONING CONDUIT FROM UNDERGROUND TO ABOVE GRADE BEFORE COLUMN AND FOOTING TO AVOID. EXTEND CONDUIT TO WALL.
- PROVIDE (N) 40A-3P CIRCUIT BREAKER IN PANEL AND CIRCUIT SPACE INDICATED.
- PROVIDE NEW DUCT SMOKE DETECTOR AND RELAY MODULE FOR EXISTING FIRE SMOKE DAMPER SHUTDOWN. CONNECT NEW DUCT SMOKE DETECTOR TO EXISTING FIRE ALARM FULL STATION IN THE ROOM AS REQUIRED.

**CABLE SCHEDULE:**

A - (1) #14 UNSHIELDED TWISTED PAIR FOR SIGNALING LINE CIRCUITS.  
 B - (2) #12 FOR 24V POWER (CO DETECTOR)


**EQUIPMENT SCHEDULE:**

EM	FIRE ALARM (N) RELAY MODULE MODEL: NOTIFIER FRM4 CSFM: 1300-0028-214
DD	FIRE ALARM (N) SMOKE DETECTOR W/ DUCT HOUSING MODEL: NOTIFIER FSP-451/DNR CSFM: 1212-0028-509/3240-1659-204

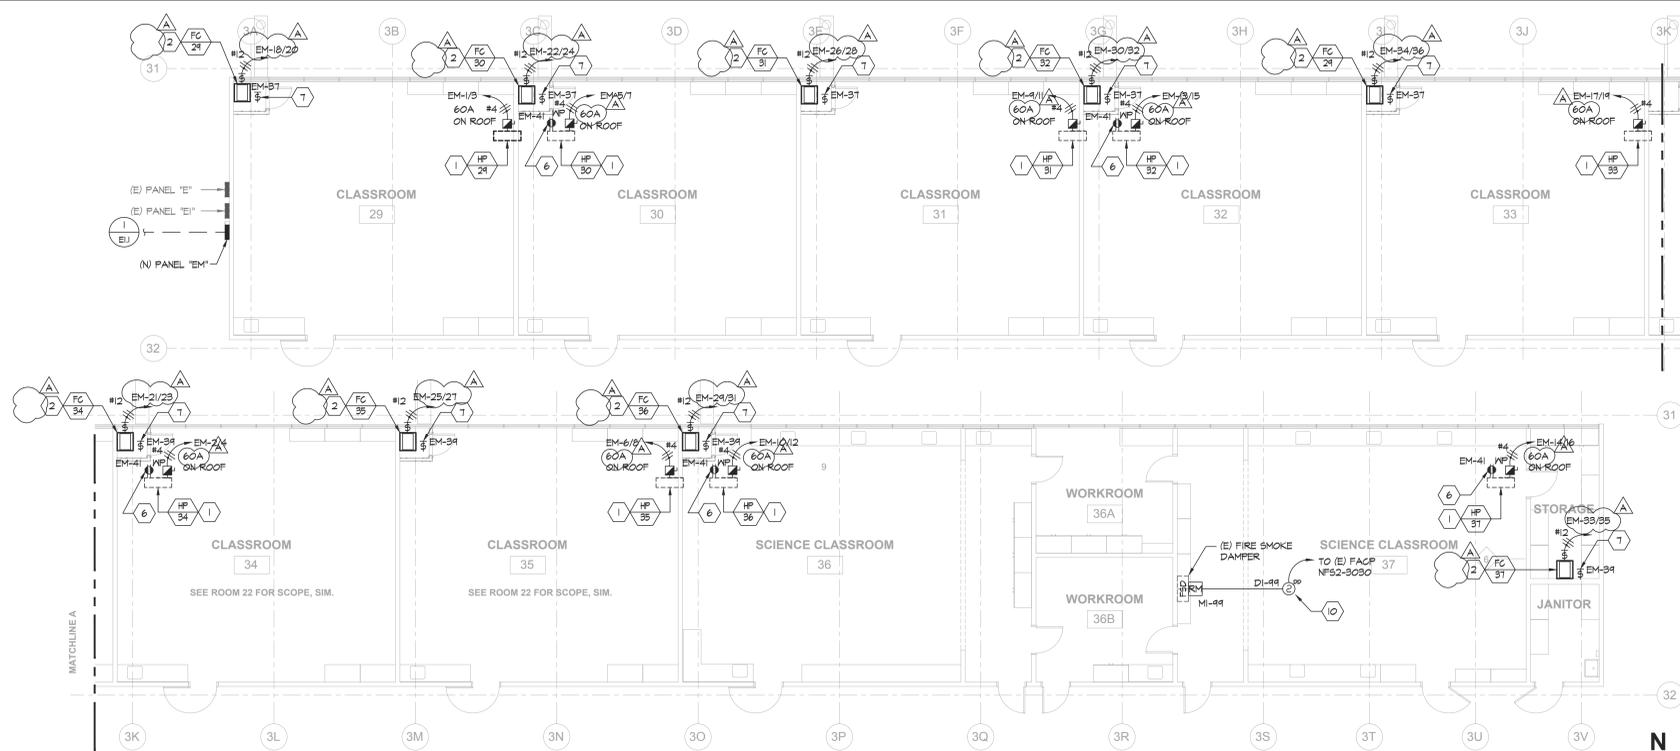


**ELECTRICAL NEW FLOOR PLAN - WING 3**

E3.1 SCALE: 1/8" = 1'-0"

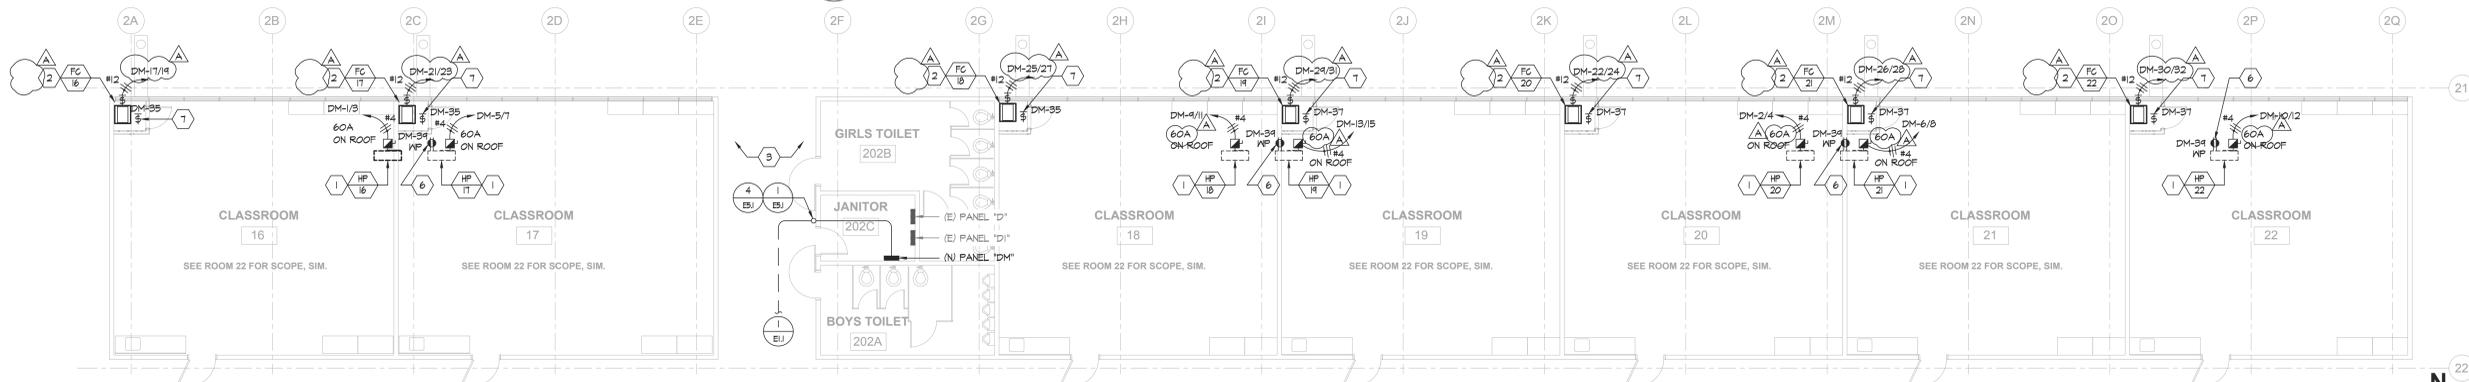

**ELECTRICAL NEW FLOOR PLAN - WING 2**


E3.1 SCALE: 1/8" = 1'-0"

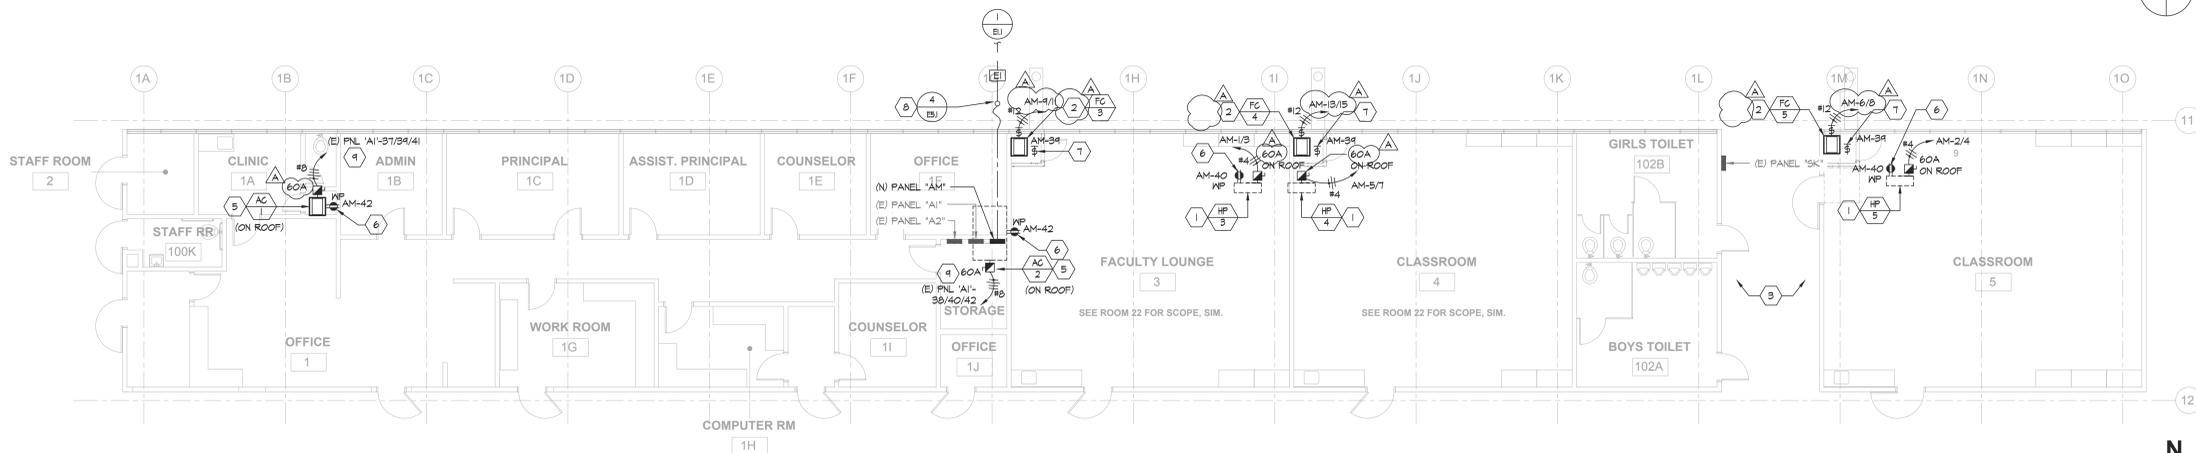

**ELECTRICAL NEW FLOOR PLAN - WING 1**

E3.1 SCALE: 1/8" = 1'-0"

**BUILDING KEY**

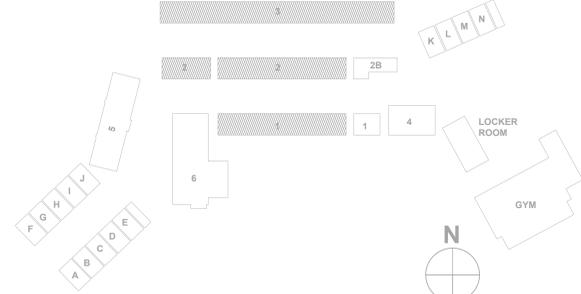

**aedis**  
architects

www.aedisarchitects.com  
 387 S. 1st Street, Suite 300  
 San Jose, CA 95113  
 t: (408)-300-5160  
 f: (408)-300-5121

PROJECT  
**ABBOTT MIDDLE SCHOOL - HVAC REPLACEMENT**

SAN MATEO-FOSTER CITY SCHOOL DISTRICT  
 CONSULTANT



American Consulting Engineers  
 Electrical, Inc.  
 1380 The Alameda, Suite 200  
 San Jose, CA 95126  
 Tel: (408) 234-2313  
 Fax: (408) 234-2312

STAMP


STATE FILE NUMBER  
 DSA NUMBER **41-26**  
 APPL # **01-119557**

REVISIONS  
 No. Description Date  
 APPENDUM 1 11/24/2021


MILESTONES  
 DD  
 90% CD  
 DSA SUB 06/03/2021  
 BACKCHECK

SHEET  
**ELECTRICAL NEW FLOOR PLANS - WING 1, 2 & 3**

DATE 11/24/2021  
 JOB # 2021005.06  
 SHEET # AD-1  
**E3.1**

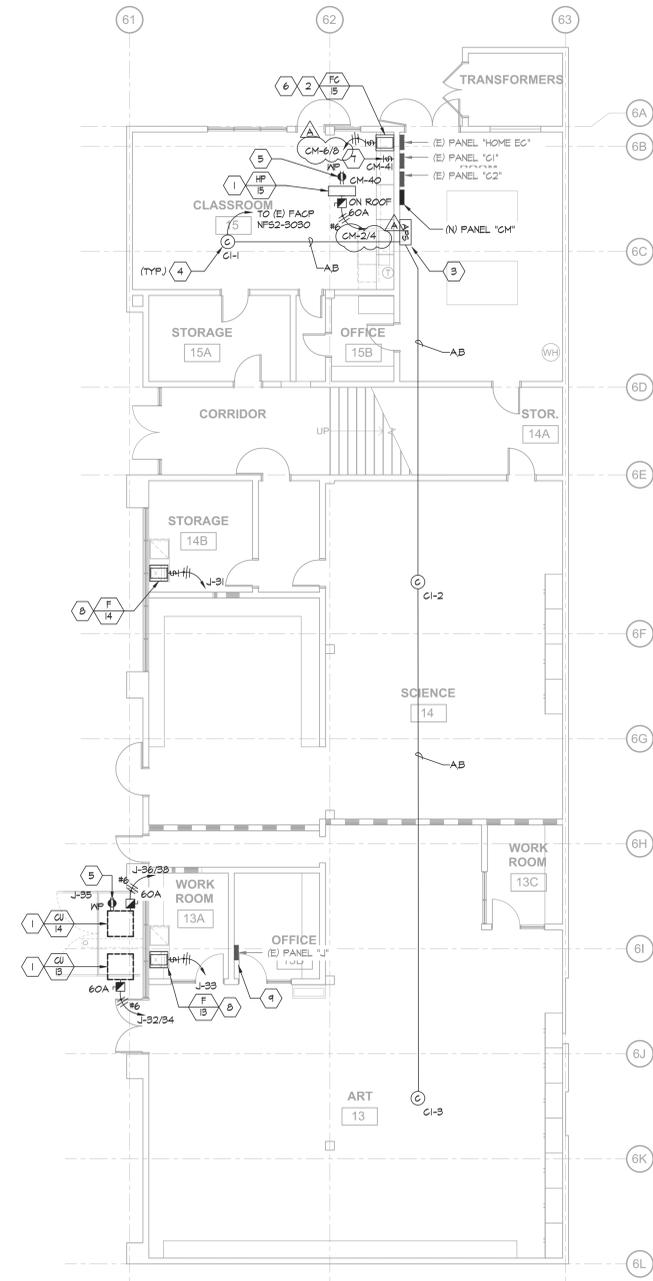

**ELECTRICAL NEW FIRST FLOOR PLAN - MULTIPURPOSE BLDG.**  
 1  
 E3.3 SCALE: 1/8" = 1'-0"

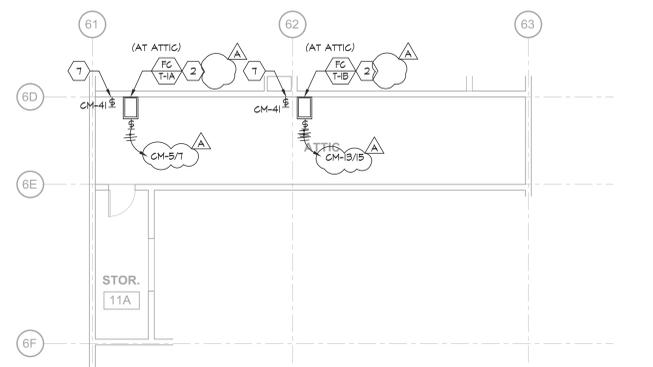

**ELECTRICAL NEW SECOND FLOOR PLAN - MULTIPURPOSE BLDG.**  
 2  
 E3.3 SCALE: 1/8" = 1'-0"



**ELECTRICAL NEW ATTIC PLAN - MULTIPURPOSE BLDG.**  
 3  
 E3.3 SCALE: 1/8" = 1'-0"

**GENERAL NOTES:**

1. ALL CONDUITS SHALL BE ROUTED CONCEALED IN CEILING BELOW WHERE POSSIBLE.
2. CONTRACTOR SHALL COORDINATE EXACT LOCATIONS AND POINTS OF CONNECTION FOR MECHANICAL UNIT WITH MECHANICAL CONTRACTOR. ADJUST LOCATION AND CONNECTION POINTS AS NEEDED.
3. SEE PANEL SCHEDULES AND SINGLE LINE DIAGRAM FOR POWER CONNECTION REQUIREMENTS.
4. COORDINATE WITH ARCHITECTURAL AND MECHANICAL DRAWINGS FOR ADDITIONAL REQUIREMENTS.
5. FUSED DISCONNECT SWITCHES SHALL BE 600V RATED, HEAVY DUTY CYCLE. FUSES FOR MECHANICAL UNITS SHALL BE SIZED PER THE MANUFACTURER'S RECOMMENDATION.
6. VISUAL NOTIFICATION IS NOT REQUIRED FOR CO DETECTION PER CBC 11B-2151.

**SHEET NOTES:**

1. NEW 60A-2P, NEMA-3R, FUSED DISCONNECT SWITCH FOR MECHANICAL UNIT.
2. NEW 30A-2P, NEMA-1, MOTOR-RATED DISCONNECT SWITCH FOR MECHANICAL UNIT.
3. NEW AUXILIARY 24V POWER SUPPLY FOR CARBON MONOXIDE DETECTORS.
4. NEW CARBON MONOXIDE DETECTOR. ROUTE NEW SLC CONNECTION BACK TO EXISTING FIRE ALARM CONTROL PANEL NOTIFIER NF52-3030 AS REQUIRED.
5. PROVIDE NEW WEATHERPROOF 6FCI RECEPTACLE. RECEPTACLE SHALL BE MOUNTED ON A WEATHERPROOF BOX WITH WHILE-IN-USE COVER. COVER SHALL BE INTERMATIC WFO10MAD "BOSS".
6. INDOOR UNIT IS POWER BY THE OUTDOOR UNIT. ROUTE HOMERUN CIRCUIT TO ASSOCIATED OUTDOOR UNIT. REFER TO MECHANICAL SCHEDULE MFD02 FOR ADDITIONAL REQUIREMENTS.
7. PROVIDE MOTOR RATED SWITCH AND 120V POWER FOR CONDENSATION PUMP.
8. PROVIDE 120V MOTOR RATED SWITCH.
9. NEW MECHANICAL CU UNITS CONNECTED TO EXISTING PANEL 'J' ARE SINGLE PHASE. ALL LIGHTING CIRCUITS IN EXISTING PANEL 'J' ARE TO BE REARRANGED SO THEY ARE ON PHASE A AND PHASE B. THE INTENT IS TO PROVIDE A BALANCED LOAD PANEL.

**CABLE SCHEDULE:**

- A - (1) #14 UNSHIELDED TWISTED PAIR FOR SIGNALING LINE CIRCUITS.
- B - (2) #12 FOR 24V POWER (CO DETECTOR)

**EQUIPMENT SCHEDULE:**

Ⓢ	FIRE ALARM: (N) CARBON MONOXIDE DETECTOR W/ BASE MODEL: NOTIFIER F5CO-4B122005 CSFM: 5218-0028.51/1500-1629.104
Ⓜ	FIRE ALARM: (N) AUXILIARY POWER SUPPLY MODEL: NOTIFIER FGPS 2468 CSFM: 1315-0028.225

(E) FIRE ALARM CONTROL PANEL - BATTERY CALCULATION

QUANTITY	MODEL #	DEVICE	SUPV. CURRENT PER	TOTAL SUPV. CURRENT	ALARM CURRENT	TOTAL ALARM CURRENT
1	CPUNF52 3030	FIRE ALARM CONTROL PANEL	0.1200	0.12	0.1300	0.12
1	KDM-R2	FACTP CENTRAL PROCESSING UNIT	0.2200	0.22	0.2200	0.22
1	LDACT-2	DIGITAL COMMUNICATOR	0.0520	0.05	0.0870	0.087
1	LCD2-80	REMOTE ANNUNCIATOR	0.0450	0.0450	0.0800	0.0800
2	LEM-320	LOOP EXPANDER MODULE	0.1000	0.20	0.1000	0.2
2	LCM-320	LOOP CONTROL MODULE	0.1500	0.30	0.1500	0.30
1	DVC-RM	DIGITAL VOICE COMMAND MODULE	0.3000	0.3000	0.3000	0.3000
1	DVC-KD	DIGITAL VOICE COMMAND KEYPAD	0.0800	0.0800	0.0800	0.0800
1	AMP8-24	POWER SUPPLY/BATTERY CHARGER	0.1500	0.1500	0.0500	0.0500

(E) SLC DEVICES	SMOKE DETECTOR/BASE	0.0003	0.0342	0.0085	0.7470	
114	FAPT-851	SMOKE DETECTOR/BASE	0.0003	0.0342	0.0085	0.7470
185	FST-854	HIGH ATTIC HEAT DETECTOR/BASE	0.0003	0.0555	0.0085	1.2325
0	FST-851	HEAT DETECTOR/BASE	0.0003	0.0000	0.0085	0.0000
0	FAPT-851	DUCT DETECTOR/DNR HOUSING	0.0003	0.0000	0.0085	0.0000
1	NB-12LX	PULL STATION	0.0004	0.0004	0.0050	0.0050
4	FRM-1	RELAY MODULE	0.0004	0.0016	0.0085	0.0260
2	ISO-X	ISOLATOR MODULE	0.0004	0.0007	0.0070	0.0340

(E) NOTIFICATION DEVICES	CEILING SPEAKER/STROBE 75CD - 0.50 WATT	0.00	0.00	0.16	2.212	
14	SPSCR	CEILING SPEAKER/STROBE 75CD - 0.50 WATT	0.00	0.00	0.16	2.212
10	SPSCR	CEILING SPEAKER/STROBE 30CD - 0.50 WATT	0.00	0.00	0.08	1.222
10	SPSCR	CEILING SPEAKER/STROBE 15CD - 0.50 WATT	0.00	0.00	0.04	0.77
0	SPSCR	CEILING SPEAKER/STROBE 15CD - 0.25 WATT	0.00	0.00	0.08	0


(N) SLC DEVICES	RELAY MODULE	0.0000	0.0000	0.0085	0.0085	
1	RRM-1	RELAY MODULE	0.0000	0.0000	0.0085	0.0085
1	F5P-951/DNR	DUCT SMOKE DETECTOR	0.0002	0.0002	0.0045	0.0045
8	F5CO-951	CARBON MONOXIDE	0.0002	0.0008	0.0045	0.018

Max. Supv. Current	148
Maximum Supervisory Current:	148
Standby Period 24 hour:	24
Total Supervisory Reserve:	35.53 (A)
Maximum Alarm Current:	7.59
Alarm Period (15 min):	0.249
Total Alarm Reserve:	1.89 (B)
Total Reserve Current: (A + B)	37.42
Safety Margin (20%):	12
Total Amperes Hours Required:	44.90

(N) Battery: 2 - 12V 100 Ampere Hour

**BUILDING KEY**

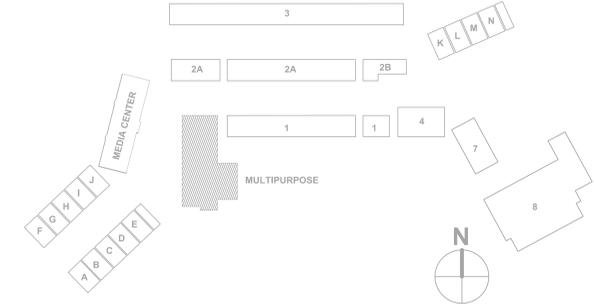

PROJECT  
**ABBOTT MIDDLE SCHOOL - HVAC REPLACEMENT**

SAN MATEO-FOSTER CITY SCHOOL DISTRICT  
 CONSULTANT



American Consulting Engineers Electrical, Inc.  
 1580 The Alameda, Suite 200  
 San Jose, CA 95126  
 Tel: (408) 300-5160 Fax: (408) 300-5121

STATE DSA FILE NUMBER **41-26**  
 APPL # **01-119557**

REVISIONS  
 No. Description Date

APPENDIX I 11/24/2021

MILESTONES  
 DD  
 90% CD  
 DSA SUB 06/03/2021  
 BACKCHECK

SHEET  
**ELECTRICAL NEW FLOOR PLANS - MULTIPURPOSE BLDG**

DATE 11/24/2021  
 JOB # 2021005.06  
 SHEET # AD-1  
**E3.3**

PROJECT  
**ABBOTT MIDDLE SCHOOL - HVAC REPLACEMENT**

SAN MATEO-FOSTER CITY SCHOOL DISTRICT  
CONSULTANT



American Consulting Engineers Electrical, Inc.  
1800 The Alameda, Suite 200  
San Jose, CA 95126  
Tel: (408) 251-2512 Fax: (408) 251-2514

STAMP

STATE  
DSA FILE NUMBER **41-26**  
APPL # **01-119557**

REVISIONS  
No. Description Date  
APPENDUM I 11/24/2021

MILESTONES  
DD  
90% CD  
DSA SUB 06/03/2021  
BACKCHECK

SHEET  
**PANEL SCHEDULES**

DATE 11/24/2021  
JOB # 2021005.06  
SHEET # AD-1  
**E4.3**

PANEL NAME		DM		FED FROM (E)PRL A			
VOLTAGE		208/120V		MAIN CB: 200 AMP			
PHASE		3		BUSSING: 200 AMP			
WIRE		4		MIN. A/C: 10,000			
TYPE		NEMA 1		SUB-FEED CB			
MOUNTING		SURFACE		FED THRU LUGS: YES			
CIRCUIT DESCRIPTION	LOAD TYPE (KVA)	CB	OKT #	PH #	CB	LOAD TYPE (KVA)	CIRCUIT DESCRIPTION
(N) HEAT PUMP 3 - CLASSROOM 3	3.74	20A/1P	1	A 2	50A	3.74	(N) HEAT PUMP 5 - CLASSROOM 5
(N) HEAT PUMP 4 - CLASSROOM 4	3.74	20A/1P	2	B 4	15A	3.74	(N) FAN COOL 5 - CLASSROOM 5
(N) FAN COOL 3 - CLASSROOM 3	0.89	15A	1	B 10	20A/1P	0.89	
(N) FAN COOL 4 - CLASSROOM 4	0.89	15A	1	C 12	20A/1P	0.89	
(N) FAN COOL 5 - CLASSROOM 5	0.89	15A	1	A 14	20A/1P	0.89	
SPARE	0.89	20A/1P	1	B 16	20A/1P	0.89	
(N) MOTOR RATED SWITCH FOR COND. PUMP - WING 1	0.36	20A/1P	3	B 40	20A/1P	0.36	(N) WEATHERPROOF GFCI REC. ROOF MOUNT - WING 1
SPARE	0.36	20A/1P	4	C 42	20A/1P	0.36	(N) WEATHERPROOF GFCI REC. ROOF MOUNT - WING 1
	0	0	0	0	0	0	0
	0	0.4	16.6			0	0.7

PANEL NAME		DM		FED FROM (E)PRL C			
VOLTAGE		208/120V		MAIN CB: 100 AMP			
PHASE		3		BUSSING: 100 AMP			
WIRE		4		MIN. A/C: 10,000			
TYPE		NEMA 1		SUB-FEED CB			
MOUNTING		SURFACE		FED THRU LUGS: YES			
CIRCUIT DESCRIPTION	LOAD TYPE (KVA)	CB	OKT #	PH #	CB	LOAD TYPE (KVA)	CIRCUIT DESCRIPTION
(N) HEAT PUMP 11A - MEZZANINE	3.74	50A	1	A 2	50A	3.74	(N) HEAT PUMP 15 - CLASSROOM 15
(N) FAN COOL 11A - MEZZANINE	0.89	15A	1	C 6	15A	0.89	(N) FAN COOL 15 - CLASSROOM 15
(N) HEAT PUMP 11A - MEZZANINE	3.74	50A	2	B 10	20A/1P	3.74	
(N) FAN COOL 11A - MEZZANINE	0.89	15A	1	A 14	20A/1P	0.89	
SPARE	0.89	20A/1P	1	B 16	20A/1P	0.89	
(N) MOTOR RATED SWITCH - MULTIPURPOSE BLDG	0	0	0	0	0	0	(N) WEATHERPROOF GFCI REC. ROOF MOUNT - MULTIPURPOSE
	0	0	0	0	0	0	0
	0	0.12	18.6			0	0.7

PANEL NAME		DM		FED FROM (E)MSB-2			
VOLTAGE		208/120V		MAIN CB: 400 AMP			
PHASE		3		BUSSING: 400 AMP			
WIRE		4		MIN. A/C: 10,000			
TYPE		NEMA 1		SUB-FEED CB			
MOUNTING		SURFACE		FED THRU LUGS: YES			
CIRCUIT DESCRIPTION	LOAD TYPE (KVA)	CB	OKT #	PH #	CB	LOAD TYPE (KVA)	CIRCUIT DESCRIPTION
(N) HEAT PUMP 16 - CLASSROOM 16	3.74	50A	1	A 2	50A	3.74	(N) HEAT PUMP 20 - CLASSROOM 20
(N) HEAT PUMP 17 - CLASSROOM 17	3.74	50A	2	B 4	50A	3.74	(N) HEAT PUMP 21 - CLASSROOM 21
(N) HEAT PUMP 18 - CLASSROOM 18	3.74	50A	3	C 6	50A	3.74	(N) HEAT PUMP 22 - CLASSROOM 22
(N) HEAT PUMP 19 - CLASSROOM 19	3.74	50A	4	A 14	50A	3.74	(N) HEAT PUMP T-1A, FAN COOL T-1A - TEACHERS AREA
(N) FAN COOL 16 - CLASSROOM 16	0.89	15A	1	B 16	20A/1P	0.89	(N) HEAT PUMP T-1B, FAN COOL T-1B - STORAGE
(N) FAN COOL 17 - CLASSROOM 17	0.89	15A	1	C 18	20A/1P	0.89	(N) FAN COOL 20 - CLASSROOM 20
(N) FAN COOL 18 - CLASSROOM 18	0.89	15A	1	A 20	20A/1P	0.89	(N) FAN COOL 21 - CLASSROOM 21
(N) FAN COOL 19 - CLASSROOM 19	0.89	15A	1	B 22	20A/1P	0.89	(N) FAN COOL 22 - CLASSROOM 22
(N) MOTOR RATED SWITCH FOR COND. PUMP - WING 2	0.36	20A/1P	3	B 24	20A/1P	0.36	(E) PH. 1E
(N) WEATHERPROOF GFCI REC. ROOF MOUNT - WING 2	0.72	20A/1P	3	B 40	20A/1P	0.72	
	0	0	0	0	0	0	0
	0	0.7	0.8	37.1		0	0

PANEL NAME		DM		FED FROM (E)MSB-1			
VOLTAGE		208/120V		MAIN CB: 500 AMP			
PHASE		3		BUSSING: 500 AMP			
WIRE		4		MIN. A/C: 10,000			
TYPE		NEMA 3		SUB-FEED CB			
MOUNTING		SURFACE		FED THRU LUGS: YES			
CIRCUIT DESCRIPTION	LOAD TYPE (KVA)	CB	OKT #	PH #	CB	LOAD TYPE (KVA)	CIRCUIT DESCRIPTION
(N) HEAT PUMP 29 - CLASSROOM 29	3.74	20A/1P	1	A 2	50A	3.74	(N) HEAT PUMP 34 - CLASSROOM 34
(N) HEAT PUMP 30 - CLASSROOM 30	3.74	50A	2	B 4	50A	3.74	(N) HEAT PUMP 35 - CLASSROOM 35
(N) HEAT PUMP 31 - CLASSROOM 31	3.74	50A	3	C 6	50A	3.74	(N) HEAT PUMP 36 - CLASSROOM 36
(N) HEAT PUMP 32 - CLASSROOM 32	3.74	50A	4	A 14	50A	3.74	(N) HEAT PUMP 37 - CLASSROOM 37
(N) HEAT PUMP 33 - CLASSROOM 33	3.74	50A	5	B 16	15A	3.74	(N) FAN COOL 29 - CLASSROOM 29
(N) FAN COOL 34 - CLASSROOM 34	0.89	15A	1	A 20	20A/1P	0.89	(N) FAN COOL 30 - CLASSROOM 30
(N) FAN COOL 35 - CLASSROOM 35	0.89	15A	1	B 22	20A/1P	0.89	(N) FAN COOL 31 - CLASSROOM 31
(N) FAN COOL 36 - CLASSROOM 36	0.89	15A	1	C 24	20A/1P	0.89	(N) FAN COOL 32 - CLASSROOM 32
(N) FAN COOL 37 - CLASSROOM 37	0.89	15A	1	A 26	20A/1P	0.89	(N) FAN COOL 33 - CLASSROOM 33
(N) MOTOR RATED SWITCH FOR COND. PUMP - WING 3	0.60	20A/1P	3	B 28	400A	0.60	(E) PH. 1E
(N) WEATHERPROOF GFCI REC. ROOF MOUNT - WING 3	0.48	20A/1P	3	B 40	400A	0.48	
	0	0	0	0	0	0	0
	0	0.9	44.6			0	0

PANEL NAME		(E)S		FED FROM MSB-1			
VOLTAGE		208/120V		MAIN CB: 160			
PHASE		3		BUSSING: 225 AMP			
WIRE		4		MIN. A/C: 10,000			
TYPE		NEMA 1		SUB-FEED CB			
MOUNTING		SURFACE		FED THRU LUGS: YES			
CIRCUIT DESCRIPTION	LOAD TYPE (KVA)	CB	OKT #	PH #	CB	LOAD TYPE (KVA)	CIRCUIT DESCRIPTION
EXISTING LOAD	0.72	20A/1P	1	A 2	20A/1P	0.72	EXISTING LOAD
EXISTING LOAD	0.72	20A/1P	29	C 30	20A/1P	0.72	EXISTING LOAD
EXISTING LOAD	0.72	20A/1P	31	A 32	20A/1P	0.72	EXISTING LOAD
EXISTING LOAD	0.72	20A/1P	33	B 34	20A/1P	0.72	EXISTING LOAD
EXISTING LOAD	0.72	20A/1P	35	C 36	20A/1P	0.72	EXISTING LOAD
EXISTING LOAD	0.72	20A/1P	37	A 38	20A/1P	0.72	EXISTING LOAD
EXISTING LOAD	0.72	20A/1P	39	B 40	20A/1P	0.72	EXISTING LOAD
EXISTING LOAD	0.72	20A/1P	41	C 42	20A/1P	0.72	EXISTING LOAD
	0	0	0	0	0	0	0
	0	5.0	0	0		0	5.8

PANEL NAME		(E)S		FED FROM MSB-1			
VOLTAGE		208/120V		MAIN CB: 160			
PHASE		3		BUSSING: 225 AMP			
WIRE		4		MIN. A/C: 10,000			
TYPE		NEMA 1		SUB-FEED CB			
MOUNTING		SURFACE		FED THRU LUGS: NO			
CIRCUIT DESCRIPTION	LOAD TYPE (KVA)	CB	OKT #	PH #	CB	LOAD TYPE (KVA)	CIRCUIT DESCRIPTION
EXISTING LOAD	0.72	20A/1P	43	A 44	20A/1P	0.72	EXISTING LOAD
EXISTING LOAD	0.72	20A/1P	45	B 46	20A/1P	0.72	EXISTING LOAD
EXISTING LOAD	0.72	20A/1P	47	C 48	20A/1P	0.72	EXISTING LOAD
EXISTING LOAD	0.72	20A/1P	49	A 50	20A/1P	0.72	EXISTING LOAD
EXISTING LOAD	0.72	20A/1P	51	B 52	20A/1P	0.72	EXISTING LOAD
EXISTING LOAD	0.72	20A/1P	53	C 54	20A/1P	0.72	EXISTING LOAD
EXISTING LOAD	0.72	20A/1P	55	A 56	20A/1P	0.72	EXISTING LOAD
EXISTING LOAD	0.72	20A/1P	57	B 58	20A/1P	0.72	EXISTING LOAD
EXISTING LOAD	0.72	20A/1P	59	C 60	20A/1P	0.72	EXISTING LOAD
EXISTING LOAD	0.72	20A/1P	61	A 62	20A/1P	0.72	EXISTING LOAD
EXISTING LOAD	0.72	20A/1P	63	B 64	20A/1P	0.72	EXISTING LOAD
EXISTING LOAD	0.72	20A/1P	65	C 66	20A/1P	0.72	EXISTING LOAD
EXISTING LOAD	0.72	20A/1P	67	A 68	20A/1P	0.72	EXISTING LOAD
(N) EXTERIOR GFCI REC. - MEDIA CENTER	0.36	(N)20A/1P	69	B 70	(N)40A	0.36	(N) CONDENSING UNIT C - MEDIA CENTER
(N) CONDENSING UNIT A - MEDIA CENTER	2.31	(N)4A	71	C 72	2P	2.31	(N) CONDENSING UNIT D - MEDIA CENTER
(N) CONDENSING UNIT B - MEDIA CENTER	2.31	(N)4A	73	A 74	(N)4A		

November 24, 2021

Aedis Architects  
387 S. First St., Suite 300  
San Jose, CA 95113

**Subject:** George Hall Elementary School HVAC Replacement  
San Mateo - Foster City School District  
Aedis Project No. 2021005.02  
DSA Application #01-119523

**ADDENDUM NO. 1**

---

CHANGES AND/OR CLARIFICATIONS OF THE DRAWINGS AND SPECIFICATIONS ARE AS FOLLOWS:

**SPECIFICATIONS**

ITEM NO. 1.1: TABLE OF CONTENTS

Add: 26 24 13 SWITCHBOARDS, 600 VOLTS AND BELOW

Add: 31 23 16 TRENCHING

ITEM NO. 1.2: SECTION 31 23 16 - TRENCHING

Add: The specification in its entirety per 31 23 16 Trenching.

ITEM NO. 1.3: SECTION 32 31 13 - CHAIN LINK FENCES AND GATES

Add: 2.4 SWING GATES D. Hardware

Item 5.: Panic Hardware: CD 990AX-L-WH-6280 SNB with Gate closer/Hinge:  
SureClose Pivot: SM AT90W"

**DRAWINGS**

**ARCHITECTURAL**

ITEM NO. 1.4: DRAWING SHEET T1 – TITLE SHEET

Revise: General Notes 7 to read as "ALL EXISTING FINISHES OR MATERIALS DAMAGED OR DEMOLISHED DUE TO NEW CONSTRUCTION SHALL BE RESTORED TO THEIR ORIGINAL STATE, INCLUDING BUT NOT LIMITED TO REINSTALLING OR REPLACING EXISTING CHAINLINK FENCING AS REQUIRED AND RESTRIPIPING PAVING IN KIND. S.E.D. FOR TRENCH ROUTING. VERIFY IN FIELD AND SEE ARCHITECTURAL SITE PLAN FOR STRIPING AT EXISTING PAVING."

Delete: Drawing Index: "S2.02- EXISTING FRAMING PLAN - ESCALON BLDG"

**ADDENDUM NO. 1**

11/24/2021

George Hall Elementary School HVAC Replacement  
San Mateo – Foster City School District  
Aedis Project No. 2021005.02

ITEM NO. 1.5: DRAWING SHEET A1.02 – DEMOLITION & NEW SITE PLAN

- Add: Trench area to New Site Plan 1/A1.02 & Graphic Key per AD1-A1.02
- Add: General Sheet Note item G per AD1-A1.02
- Add: Striping keynote 25 to New Site Plan 1/A1.02 per AD1-A1.02

ITEM NO. 1.6: DRAWING SHEET A2.01 – DEMOLITION FLOOR PLANS – WINGS 1, 2, 3, 4

- Add: General Sheet Note #J per AD1-A2.01
- Add: Demolition Floor plan Keynotes #9 & #10 per AD1-A2.01
- Add: Partial ceiling demolition keynote #9 at Demolition Floor Plans 2/A2.01, 3/A2.01, and 4/A2.01 per AD1-A2.01
- Revise: At Classroom 5 replace keynote 2 with keynote 10 per AD1-A2.01

ITEM NO. 1.7: DRAWING SHEET A2.02 – DEMOLITION FLOOR PLAN - ESCALON BLDG

- Revise: Floor Plan Keynote #6 locations per AD1-A2.02
- Add: General Sheet Note #J per AD1-A2.02

ITEM NO. 1.8: DRAWING SHEET A3.01 – NEW FLOOR PLANS – WINGS 1, 2, 3 & 4

- Add: Door tags 3b, 9b & 15b to New Floor Plans 2/A3.01, 3/A3.01, and 4/A3.01 per AD1-A3.01
- Add: Ceiling patching keynote #10 to New Floor Plans 1/A3.01, 2/A3.01, and 3/A3.01 per AD1-A3.01
- Revise: New Floor Plan Keynotes #8 & #9 per AD1-A3.01

ITEM NO. 1.9: DRAWING SHEET A5.01 – PARTIAL SITE ROOF PLAN

- Add: Exhaust fans per AD1-A5.01
- Add: Partial Site Roof Plan Keynotes #3 per AD1-A5.01
- Revise: Partial Site Roof Plan Keynotes #2 per AD1-A5.01

ITEM NO. 1.10: DRAWING SHEET A8.10 – EXTERIOR DETAILS

- Revise: Detail 9 Asphalt/Concrete Joint per AD1-A8.10

ITEM NO. 1.11: DRAWING SHEET A9.10 – INTERIOR DETAILS, WALL TYPES, AND INTERIOR ELEVATIONS

- Revise: Details 1 & 5 per AD1-A9.10a
- Revise: Detail 6 per AD1-A9.10b
- Revise: At Detail 8/A9.10 revise “1"x2"x2.5" GA” to “1"x2"x25 GA”

**ADDENDUM NO. 1**

11/24/2021

George Hall Elementary School HVAC Replacement  
San Mateo – Foster City School District  
Aedis Project No. 2021005.02

ITEM NO. 1.12: DRAWING SHEET A11.01 – FINISH SCHEDULE & FURNITURE SCHEDULE, OPENING SCHEDULE, LEGENDS, & DETAILS

- Add: Doors 3b, 9b & 15b to Door Schedule per AD1-A11.01
- Add: Door Schedule Comments per AD1-A11.01
- Add: Door Type B per AD1-A11.01

**MECHANICAL**

ITEM NO. 1.13: DRAWING SHEET MP0.02 – SCHEDULES – MECHANICAL & PLUMBING

- Revise: Classroom Split System Heat Pump Schedule per AD1-MP0.02
- Revise: Air Distribution Schedule per AD1-MP0.02
- Add: Roof exhaust Fan Schedule per AD1-MP0.02

ITEM NO. 1.14: DRAWING SHEET MP2.03 – FLOOR PLAN – NEW – WINGS 1, 2, 3, 4 – MECHANICAL & PLUMBING

- Add: Roof exhaust fan per AD1-MP2.03a
- Revise: General Notes #4 & #5 per AD1-MP2.03a
- Add: New Sheet Note #23 per AD1-MP2.03a
- Add: Roof exhaust Fan per AD1-MP2.03b
- Add: New Sheet Note #23 per AD1-MP2.03b

ITEM NO. 1.15: DRAWING SHEET MP2.04 – FLOOR PLAN – NEW – ESCALON BLDG – MECHANICAL & PLUMBING

- Revise: Location of HP-32 per AD1-MP2.04a
- Revise: General Notes #4 & #5 per AD1-MP2.04a
- Add: Dimension per AD1-MP2.04a
- Add: View 5/AD1-MP2.04 Partial Floor Plan - Wing 2 - New – Mechanical & Plumbing per AD1-MP2.04b
- Add: New Sheet Note #38 per AD1-MP2.04b
- Add: Exhaust Fan per AD1-MP2.04c

ITEM NO. 1.1: DRAWING SHEET MP6.01 – DETAILS – MECHANICAL & PLUMBING

- Revise: Detail 4 per AD1-MP6.01
- Add: Detail 16 per AD1-MP6.01

**ELECTRICAL**

ITEM NO. 1.16: DRAWING SHEET E1.1 – ELECTRICAL SITE PLAN

- Revise: Conduit Tag #8 per AD1-E1.1

**ADDENDUM NO. 1**

11/24/2021

George Hall Elementary School HVAC Replacement  
San Mateo – Foster City School District  
Aedis Project No. 2021005.02

Revise: Conduit Schedule #8 per AD1-E1.1

ITEM NO. 1.17: DRAWING SHEET E2.1 – ELECTRICAL DEMO FLOOR PLANS - WINGS #1, 2, 3 & 4 AND TYP. RELOCATABLE

Revise: Demolition Sheet Note #4 per AD1-E2.1

ITEM NO. 1.18: DRAWING SHEET E2.2 – ELECTRICAL DEMO FLOOR PLANS, ESCALON

Revise: Demolition Sheet Note #4 per AD1-E2.2

ITEM NO. 1.19: DRAWING SHEET E3.1 – ELECTRICAL NEW FLOOR PLANS, WINGS #1, 2, 3 & 4

Revise: Electrical plans 1/E3.1, 2/E3.1, 3/E3.1 & 4/E3.1 per AD1-E3.1

Add: General Note #6 per AD1-E3.1

Revise: Sheet Note #6 per AD1-E3.1

Add: Sheet Notes #11 & #12 per AD1-E3.1

Add: Solar Conduit stub ups at each wing per AD1-E3.1

Add: Power for exhaust fan per AD1-E3.1

ITEM NO. 1.20: DRAWING SHEET E3.2 – ELECTRICAL DEMO FLOOR PLANS, ESCALON

Revise: Electrical plan 1/E3.2 per AD1-E3.2

Add: Power for exhaust fan at building per AD1-E3.2

Add: General Note #6 per AD1-E3.2

Revise: Sheet Note #5 per AD1-E3.2

Omit: Sheet Note #10 per AD1-E3.2

Add: Sheet Note 11 per AD1-E3.2

Revise: Location of HP-2 per AD1-E3.2

ITEM NO. 1.21: DRAWING SHEET E4.2 – NEW SINGLE LINE DIAGRAM

Revise: Switchboard to be OFCI per AD1-E4.2

ITEM NO. 1.22: DRAWING SHEET E4.3 – PANEL SCHEUDLES

Revise: Panel Schedule per AD1-E4.3

**ADDENDUM NO. 1**

11/24/2021

George Hall Elementary School HVAC Replacement  
San Mateo – Foster City School District  
Aedis Project No. 2021005.02



---

Aedis Architects  
Thang Do, Principal



---

Electrical, American Consulting Engineers Electrical  
Sammy Fernandez



---

Mechanical, Cypress Engineering Group  
Metin Serttunc

---

Division of the State Architect

**ADDENDUM NO. 1**

George Hall Elementary School HVAC Replacement  
San Mateo – Foster City School District  
Aedis Project No. 2021005.02

11/24/2021

**Attachments:**

Specifications:

31 23 16 Trenching (5 pages)

Drawings:

**ARCHITECTURAL:**

SHEET AD1-A1.02

SHEET AD1-A2.01

SHEET AD1-A2.02

SHEET AD1-A3.01

SHEET AD1-A5.01

SHEET AD1-A8.10

SHEET AD1-A9.10a

SHEET AD1-A9.10b

SHEET AD1-A11.01

**MECHANICAL:**

SHEET AD1-MP0.02

SHEET AD1-MP2.03a

SHEET AD1-MP2.03b

SHEET AD1-MP2.04a

SHEET AD1-MP2.04b

SHEET AD1-MP2.04c

SHEET AD1-MP6.01

**ELECTRICAL:**

SHEET AD1-E1.1

SHEET AD1-E2.1

SHEET AD1-E2.2

SHEET AD1-E3.1

SHEET AD1-E3.2

SHEET AD1-E4.2

SHEET AD1-E4.3

SECTION 312316 – TRENCHING

PART 1 GENERAL

1.1 SUMMARY

- A. Section includes excavating trenches for utilities from outside building to final connection point or public right-of-way or utility; compacted fill from top of utility bedding to subgrade elevations; and backfilling and compaction.
- B. Related Sections:
  - 1. Section 03 30 00 – Cast-in-Place Concrete.

1.2 DEFINITIONS

- A. Utility: Any buried pipe, duct, conduit, or cable.

1.3 FIELD MEASUREMENTS

- A. Verify field measurements prior to fabrication.

1.4 COORDINATION

- A. Section 01 06 00 - Regulatory Requirements.
- B. Verify Work associated with lower elevation utilities is complete before placing higher elevation utilities.
- C. Verify elevations of existing facilities prior to placing new Work.

PART 2 PRODUCTS

2.1 FILL MATERIALS

- A. Fill and Structural Fill shall be: As specified in the project Soils Report and any supplements to the Soils Report.

2.2 ACCESSORIES

- A. Filter Fabric: Non-biodegradable, woven as manufactured by TC Mirafi, Tenax Corp., Tensar Earth Technologies, Inc. or equal.

## PART 3 EXECUTION

### 3.1 LINES AND GRADES

#### A. Grades

1. Pipes shall be laid true to the lines and grades indicated.
2. The grade alignment of the pipe shall be maintained by the use of a string line parallel with the grade line and vertically above the centerline of the pipe. This line shall be established on level batter boards at intervals of not more than 25 feet. Batter boards shall span the trench and be rigidly anchored to substantial posts driven into the ground on each side of the trench. Three adjacent batter boards must be set before laying pipe to provide a check on the grades and line. Elevation and position of the string line shall be determined from the elevation and position of offset points or stakes located along the pipe route. Pipe shall not be laid using side lines for line or grade.
3. As an alternative means of establishing alignment and grade, a "Laser-Beam" instrument may be utilized with a competent operator.

#### B. Location of Pipe Lines:

1. The location and approximate depths of the proposed pipe lines are shown on the Drawings.
2. An underground locate service shall be enlisted to discover the location of existing utilities regardless if they are shown on the drawings.
3. The Architect/Engineer reserves the right to make changes in lines, grades, and depths of pipe lines and manholes when such changes are necessary.

### 3.2 PREPARATION

- A. Identify required lines, levels, contours, and datum locations.
- B. Protect plant life, lawns, and other features remaining as a portion of final landscaping.
- C. Protect bench marks, existing structures, fences, sidewalks, paving, and curbs from excavating equipment and vehicular traffic.
- D. Maintain and protect above and below grade utilities which are to remain.
- E. Cut out soft areas of subgrade not capable of compaction in place. Backfill and compact to density equal to or greater than requirements for subsequent backfill material.

### 3.3 EXCAVATING

- A. Excavate subsoil required for utilities.

- B. Cut trenches sufficiently wide to enable installation and allow inspection. Remove water or materials that interfere with Work.
- C. Do not interfere with 45 degree bearing splay of foundations.
- D. Hand trim excavation. Hand trim for bell and spigot pipe joints. Remove loose matter.
- E. Remove lumped subsoil, boulders, and rock as directed by the Soils Engineer or other inspector.
- F. Correct over excavated areas with backfill and compact replacement as specified for authorized excavation.
- G. Stockpile excavated material on site. Remove excess material not being used from site.

### 3.4 TRENCHING

- A. Excavations:
  - 1. Excavation shall be dug so that the pipe can be laid and jointed properly. The trench shall be made so that the pipe can be laid to the alignment and depth as shown on the Drawings, and it shall be excavated only so far in advance of pipe laying as permitted by the Architect/Engineer. The excavation shall not be more than two feet wider at the bottom than the outside diameter of the pipe or structure. If there is no interference with construction, or adjacent property, and if soil permits, the Contractor at his own expense shall be permitted to slope the side walls of the excavation starting at a point two (2) feet above the top of pipe.
  - 2. The trench shall be excavated to the depth required so as to provide a uniform and continuous bearing and support for the pipe on bedding material at every point between joints, except where pipe slings or other lifting tackle are withdrawn.
  - 3. Excavation Below Grade:
    - 1) Where excavation indicates that the subsurface materials at the bottom of the trench are in a loose or soft state, the Contractor shall be advised to excavate to a depth where suitable material is encountered, as directed by the Architect/Engineer.
    - 2) Where the bottom of the trench has been excavated by mistake to a greater depth than required, the Contractor shall refill this area using approved material. No additional compensation shall be given to the Contractor. Refilling with earth to bring the bottom of the trench to the proper grade will not be permitted.
  - 4. Excavation within 24 inches of existing utilities shall be governed by specifications of the Owner of the respective utility. The Contractor shall obtain these specifications and follow the same at no extra cost.

GEORGE HALL ELEMENTARY SCHOOL HVAC  
REPLACEMENT  
San Mateo-Foster City School District  
2021005.02

5. Excavation and shoring shall adhere to the requirements and safety standards set by OSHA.
- B. Trenching in Advance of Pipe Laying: The trench for the pipe lines shall not be opened for a distance of more than 200 feet at any one time, unless authorized by the Architect/Engineer. At no time will the Contractor be permitted to leave more than 50 feet of trench open at the end of a working day. Adequate protection of open trench shall be provided by the Contractor and the Contractor shall be responsible therefore.

### 3.5 SHEETING AND BRACING

- A. General:
1. Sheeting and bracing of all excavations shall conform to the latest statutes of the State of California governing safety of workers in the construction industry. When necessary, in the opinion of the Contractor, adequate sheeting and bracing shall be installed to prevent ground movement that may cause damage or settlement to adjacent structures, pipelines and utilities. Any damage due to settlement because of failure to use sheeting or because of inadequate bracing, or through negligence or fault of the Contractor in any other manner, shall be repaired at the Contractor's expense.
  2. Sides of trenches in unsuitable, loose or soft material, five feet or more in depth, shall be shored, sheeted, braced, sloped, or otherwise supported by means of sufficient strength to protect employees working within them.
- B. Sheeting Requirements:
3. Where excavations are made with vertical sides which require supporting, the sheeting and bracing shall be of sufficient strength to sustain the sides of the excavations and to prevent movement which could in any way injure the Work, or adjacent structures, or diminish the working space sufficiently to delay the Work. Special precautions shall be taken where there is additional pressure due to the presence of other structures.
  4. It shall be the Contractor's responsibility to select sheeting and bracing of sufficient dimensions and strength and type to adequately support the sides of trenches and excavations.
  5. Sheeting and bracing shall be removed before the completion of the Work.

### 3.6 BACKFILLING

- A. Backfill trenches to contours and elevations shown on the drawings.
- B. Systematically backfill to allow maximum time for natural settlement. Do not backfill over porous, wet, or spongy subgrade surfaces.
- C. Fill materials shall be as specified in the Soils Report and any supplements to the Soils Report.

- D. Employ a placement method that does not disturb or damage utilities in trench. Jetting of backfill materials to achieve compaction shall not be permitted.
- E. Maintain optimum moisture content of fill materials to attain required compaction density.
- F. Remove surplus fill materials from site.

3.7 TOLERANCES

- A. Section 01 40 00 - Quality Requirements.
- B. Top Surface of Backfilling Under Paved Areas: Plus or minus 0.05 feet from required elevations.
- C. Top Surface of General Backfilling: Plus or minus 1/10 feet from required elevations.

3.8 FIELD QUALITY CONTROL

- A. Compaction testing will be performed by the project Soils Engineer.
- B. If tests indicate Work does not meet specified requirements, remove Work, replace, compact, and retest.

3.9 PROTECTION OF FINISHED WORK

- A. Section 01 70 00 - Execution and Closeout Requirements.
- B. Reshape and re-compact fills subjected to vehicular traffic during construction.

END OF SECTION

**GENERAL SHEET NOTES**

- A BUILDINGS ARE UNSPRINKLERED. TYPE V-B CONSTRUCTION UNLESS OTHERWISE NOTED
- B NO DEMOLITION SHALL BEGIN UNTIL PLANS INCLUDING THE DEMOLITION WORK HAVE BEEN APPROVED BY DSA
- C CONTRACTOR SHALL MAINTAIN FIRE LANE ACCESS THROUGHOUT PROJECT.
- D DO NOT INTERRUPT EXISTING UTILITY SERVICES SERVING OCCUPIED OR USED FACILITIES, EXCEPT WHEN AUTHORIZED IN WRITING BY AND COORDINATED WITH THE OWNER.
- E PROTECT EXISTING & NEW STRUCTURES, UTILITIES, SIDEWALKS, PAVEMENTS, TREES AND SHRUBS FROM DAMAGE DURING CONSTRUCTION.
- F REFER TO ELECTRICAL AND MECHANICAL DRAWINGS FOR EXTENT OF ELECTRICAL AND MECHANICAL WORK.
- G ALL EXISTING FINISHES OR MATERIALS DAMAGED OR DEMOLISHED DUE TO NEW CONSTRUCTION SHALL BE RESTORED TO THEIR ORIGINAL STATE, INCLUDING BUT NOT LIMITED TO REINSTALLING OR REPLACING EXISTING CHAINLINK FENCING AS REQUIRED AND RESTRIPPING PAVING IN KIND, S.E.D. FOR TRENCH FOOTING, SEE ARCHITECTURAL SITE PLAN FOR STRIPPING AT EXISTING PAVING

**DEMO & NEW SITE PLAN KEYNOTES**

- 1 REMOVE (E) ELECTRICAL EQUIPMENT AND PAD, S.E.D.
- 2 (E) CHAINLINK FENCING TO REMAIN. SALVAGE AND REINSTALL FABRIC AND BOTTOM BAR AS REQUIRED FOR CONSTRUCTION ACCESS.
- 3 (E) GATE TO REMAIN
- 4 (E) ELECTRICAL BOX, S.E.D. CAP CONDUIT AND REMOVE ABANDONED PULL BOX.
- 5 (E) PLANTING AND IRRIGATION TO BE REMOVED. CAP IRRIGATION BEFORE REMOVAL. PREP FOR NEW WORK.
- 6 (E) IRRIGATION BOX TO REMAIN.
- 7 (E) PLANTING TO REMAIN
- 8 (E) SIDEWALK TO REMAIN
- 9 (E) CHAINLINK FENCING TO REMAIN.
- 10 PAVING MATERIAL TRANSITION, SEE DETAIL 9/A8.10
- 11 INFILL CONCRETE AT REMOVED PLANTING. SEE DETAIL 6/A8.10
- 12 AT CHAINLINK FENCING AND POSTS, 4" SPHERE SHALL NOT PASS BETWEEN FENCING AND ADJACENT SURFACES, TYP.
- 13 CHAINLINK FENCE, SEE DETAIL 2/A8.10 AND S.E.D.
- 14 AT (E) 8" CHAINLINK FENCING TO REMAIN ADJACENT REMOVED CHAINLINK, RECONNECT (E) CHAINLINK FABRIC TO (E) POLE, SEE DETAIL 4/A8.10 SIM. FOR REQUIREMENTS.
- 15 10'-0" W DOUBLE GATE, SEE DETAIL 3/A8.10 AND S.E.D.
- 16 FEATHER CONCRETE FINISH AT (N) PAVING TO FACILITATE DRAINAGE TOWARD OPENINGS IN CMU
- 17 4'-0" W GATE, SEE DETAIL 2/A8.10 AND S.E.D.
- 18 ROUTE ELECTRICAL CONDUIT 5' MIN. CLR. OF FUTURE CONSTRUCTION, S.E.D. FOR MORE INFORMATION
- 19 REMOVE (E) 8" CHAINLINK FENCING FOR INSTALLATION OF (N) GATE. SEE NEW SITE PLAN FOR ADDITIONAL INFORMATION.
- 20 ELECTRICAL EQUIPMENT, S.E.D.
- 21 INFILL CONCRETE AT REMOVED PLANTING. SEE DETAIL 6/A8.10. CONFORM TO ADJACENT PAVING. SLOPE 2% MIN AWAY FROM (E) BUILDINGS
- 22 REMOVE AND REINSTALL CHAINLINK RAILS AND FABRIC AS REQUIRED FOR TRENCHING, TYP.
- 23 RESTRIPE (E) PLAYGROUND STRIPING IN KIND AT TRENCHING, S.E.D.
- 24 (E) ELECTRICAL EQUIPMENT, S.E.D.
- 25 (E) STRIPING TO REMAIN


**GRAPHIC KEY**

- EXISTING TOILET ROOMS.
- EXISTING CONSTRUCTION TO REMAIN
- EXISTING COVERED STRUCTURE
- TRENCH FOR ELECTRICAL WORK, S.E.D., 8/55.01 & DETAILS ON SHEET A8.10
- ASSUMED PROPERTY LINE
- (E) CHAINLINK FENCE
- (N) CHAINLINK FENCE
- EXISTING FIRE HYDRANT
- (E) F.H.

PROJECT  
**GEORGE HALL  
ELEMENTARY  
SCHOOL - HVAC  
REPLACEMENT**

SAN MATEO-FOSTER CITY  
SCHOOL DISTRICT

CONSULTANT

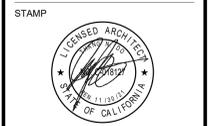

STATE  
DSA FILE NUMBER **41-26**  
APPL # **01-119523**

REVISIONS



No.	Description	Date
1	Addendum 1	11/24/2021

MILESTONES

DD	
90% CD	
DSA SUB	05/21/2021
BACKCHECK	10/04/2021


SHEET  
**DEMOLITION &  
NEW SITE PLAN**

DATE **11/24/2021**  
JOB # **2021005.02**  
SHEET # **AD1-  
A1.02**

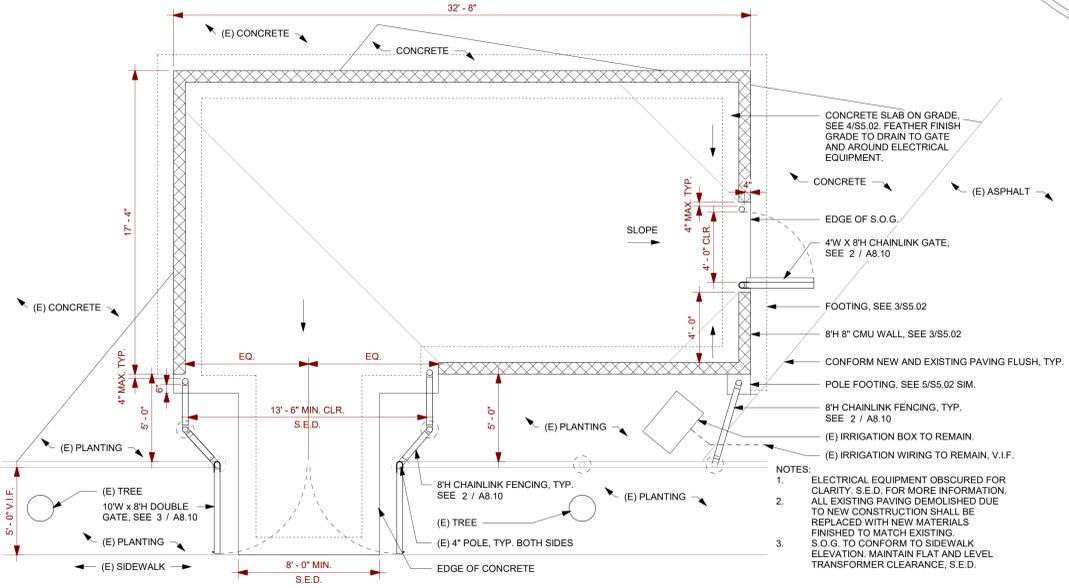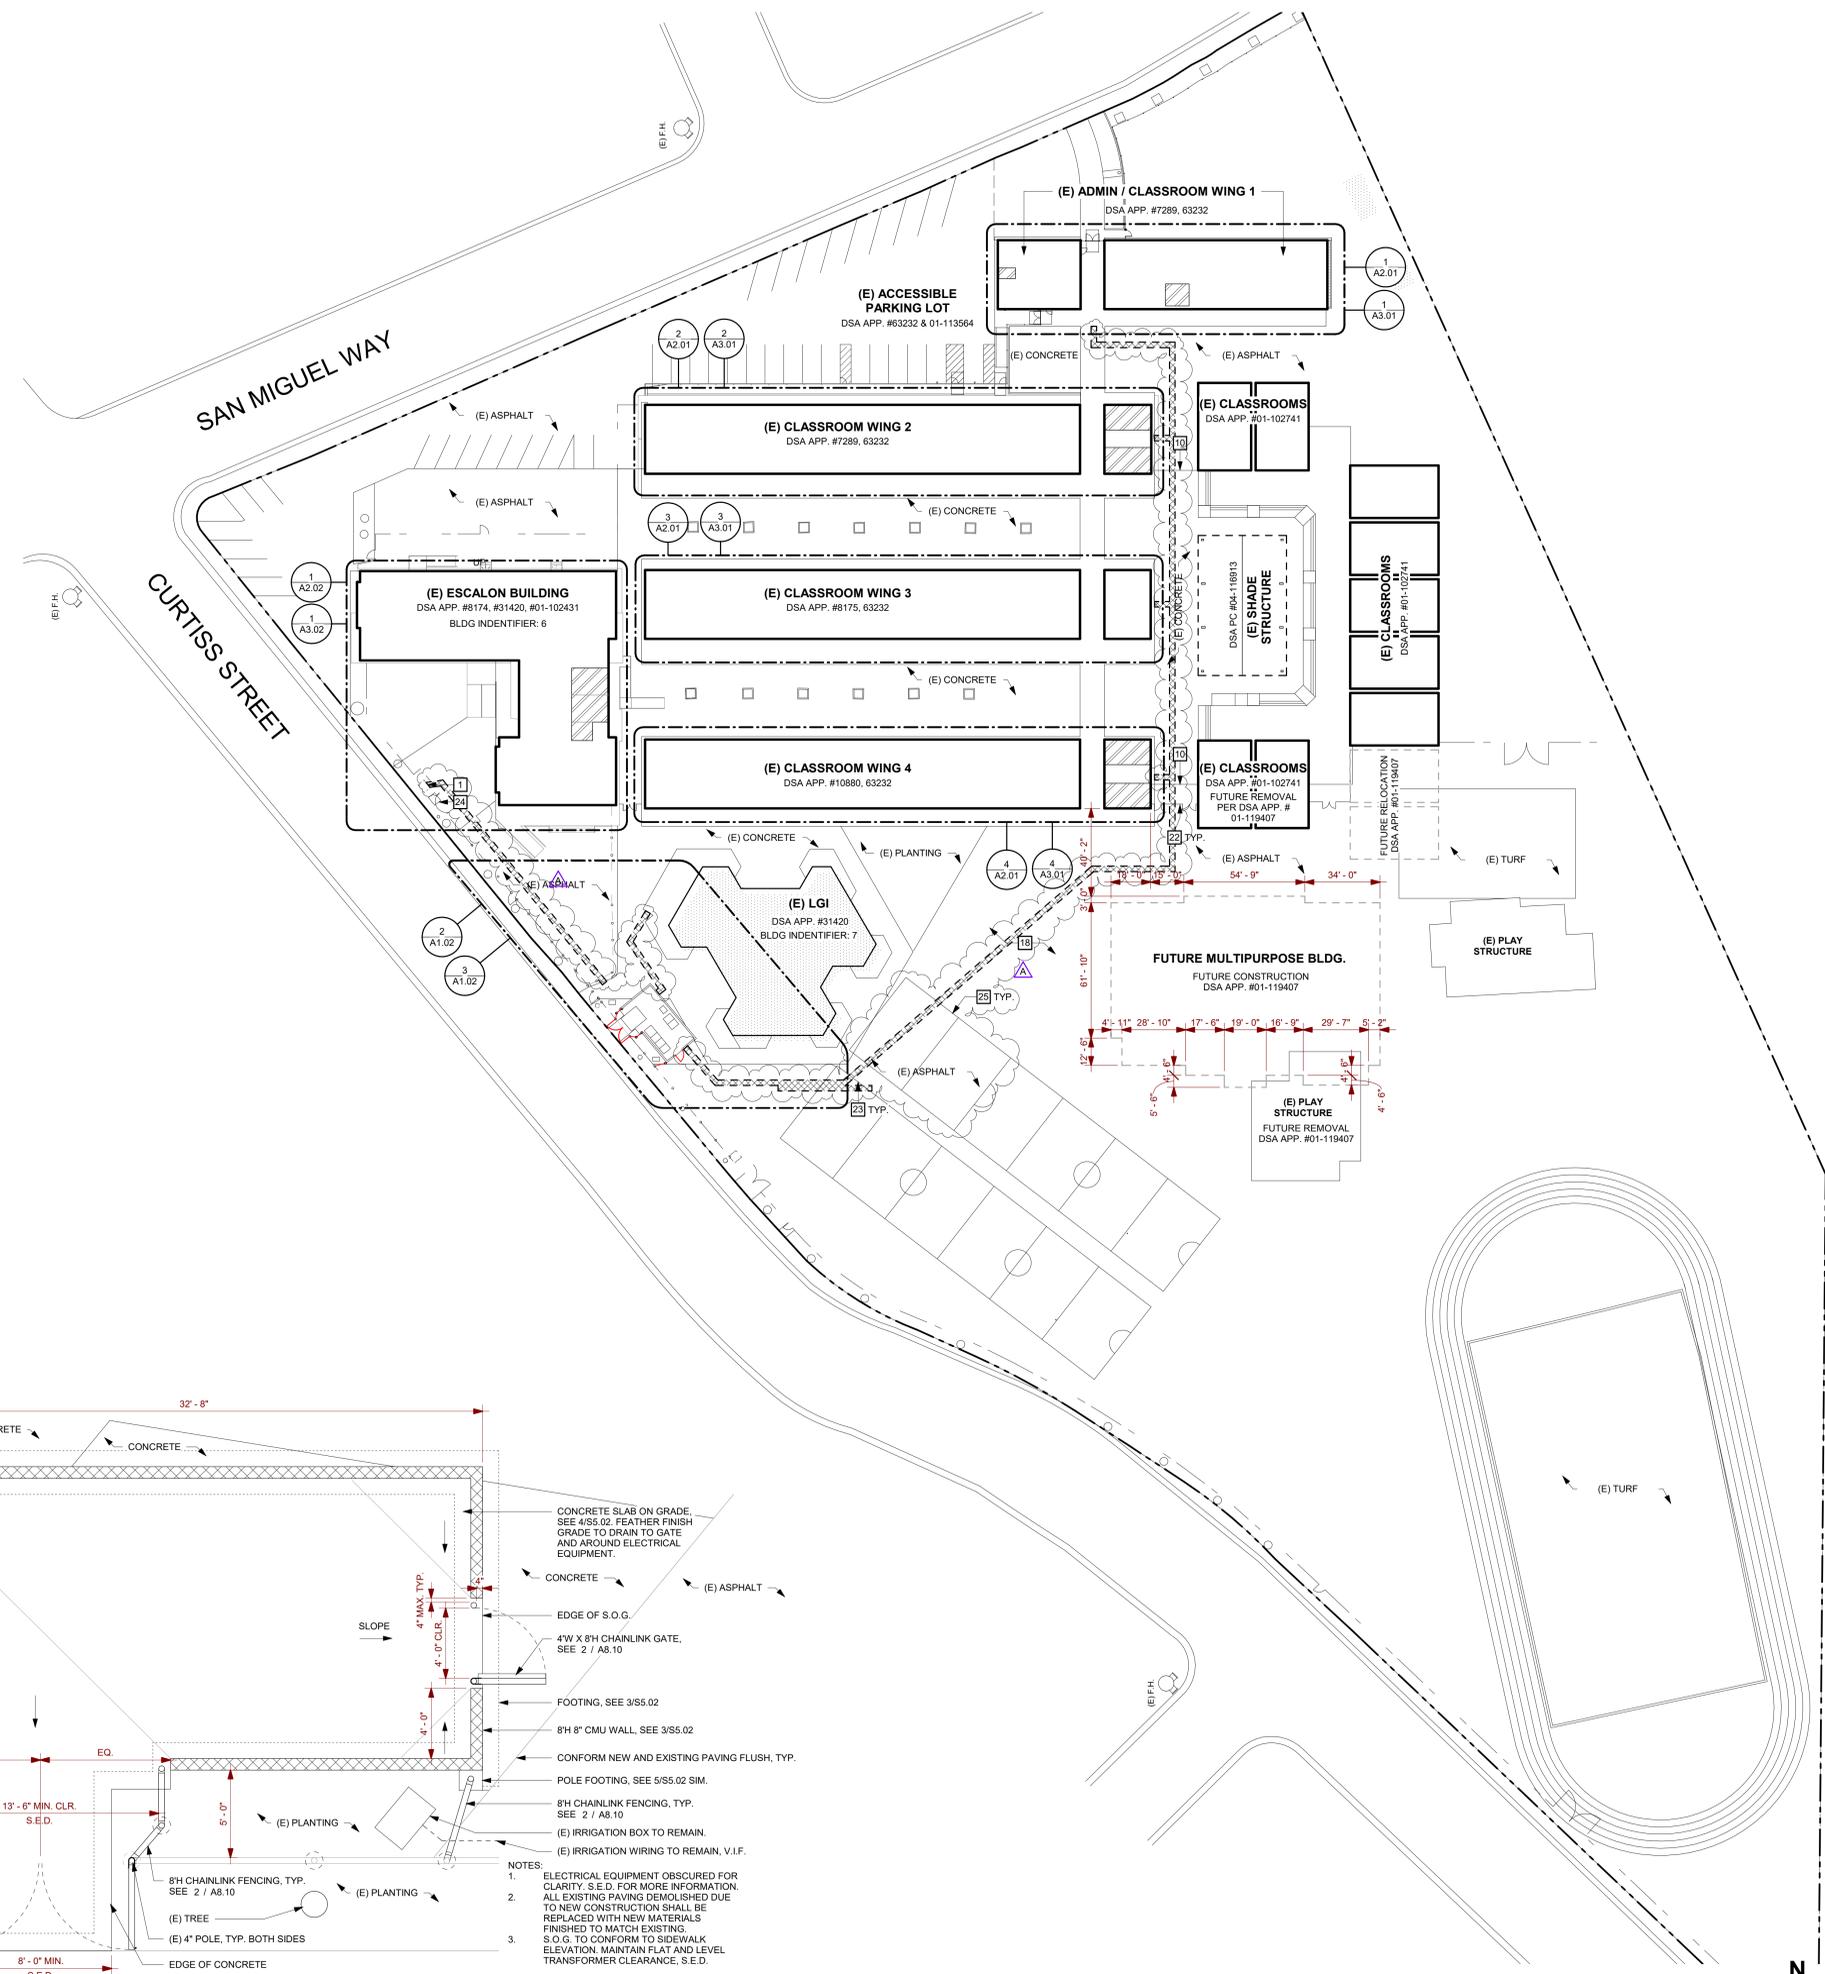


**4 ELECTRICAL ENCLOSURE ENLARGED LAYOUT**  
SCALE: 1/4" = 1'-0"


**1 NEW SITE PLAN**  
SCALE: 1/32" = 1'-0"

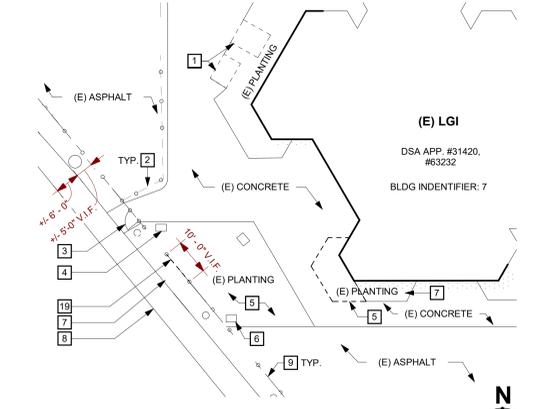


**2 DEMOLITION ENLARGED SITE PLAN**  
SCALE: 1" = 20'-0"

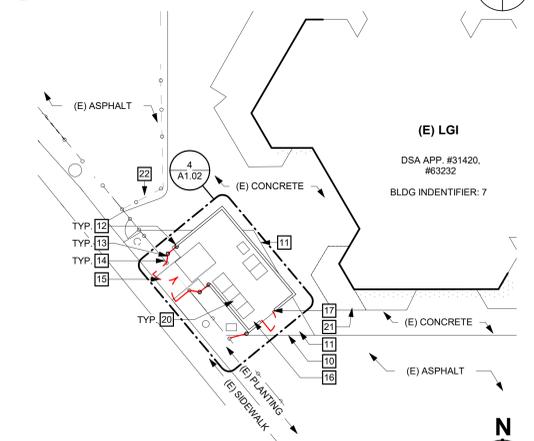


**3 NEW ENLARGED SITE PLAN**  
SCALE: 1" = 20'-0"

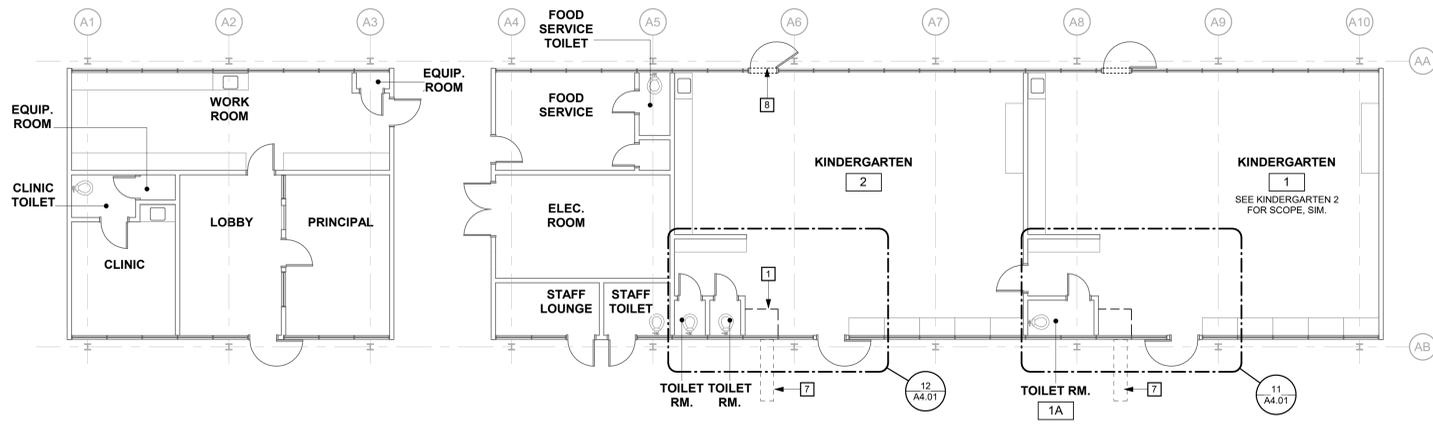


**1 DEMOLITION FLOOR PLAN - WING 1**  
SCALE: 1/8" = 1'-0"

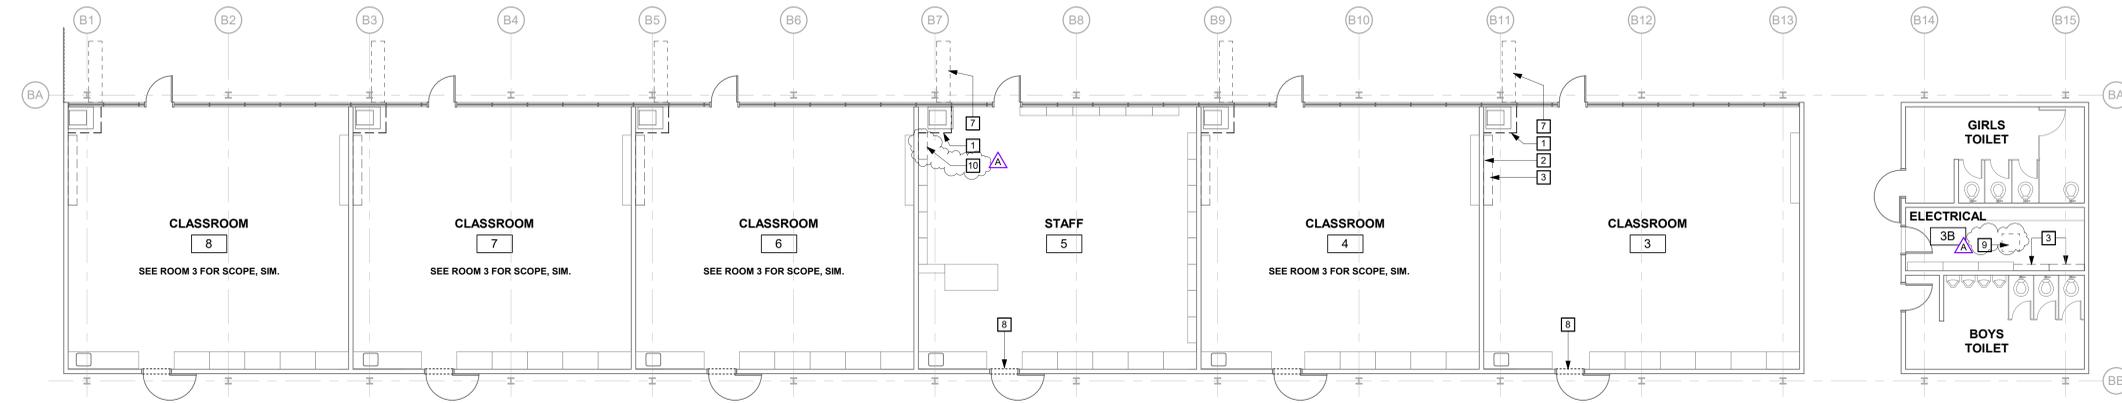

**2 DEMOLITION FLOOR PLAN - WING 2**  
SCALE: 1/8" = 1'-0"

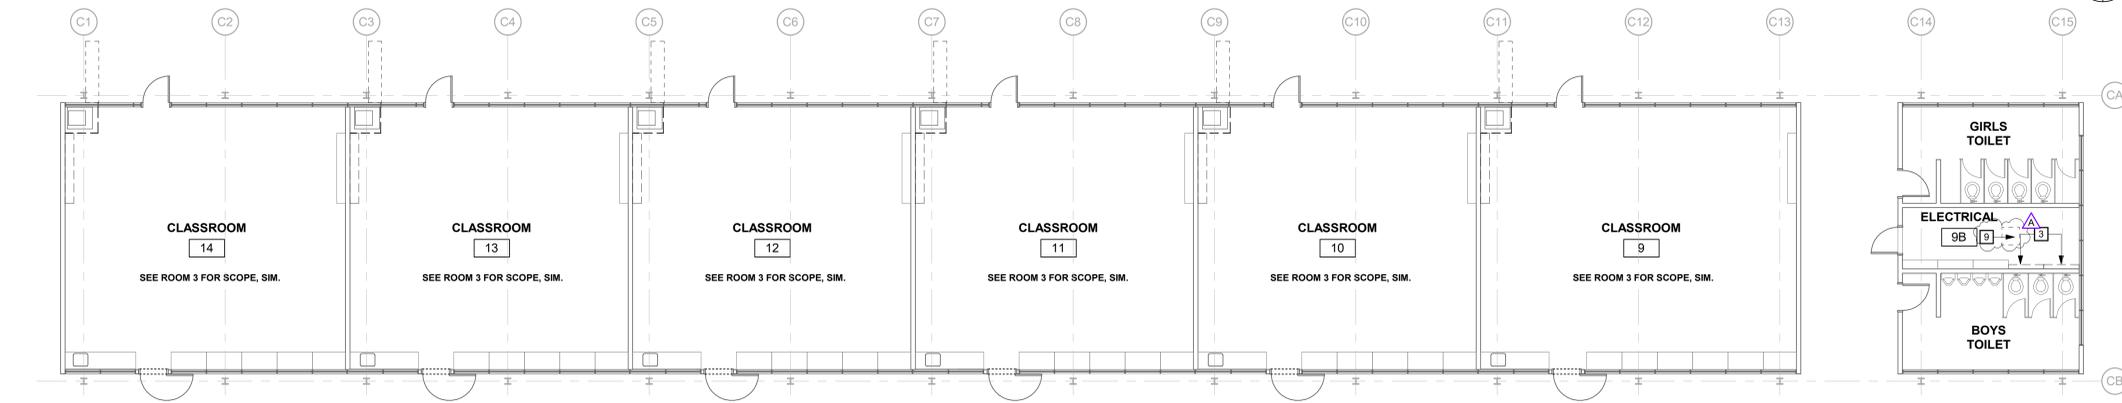

**3 DEMOLITION FLOOR PLAN - WING 3**  
SCALE: 1/8" = 1'-0"

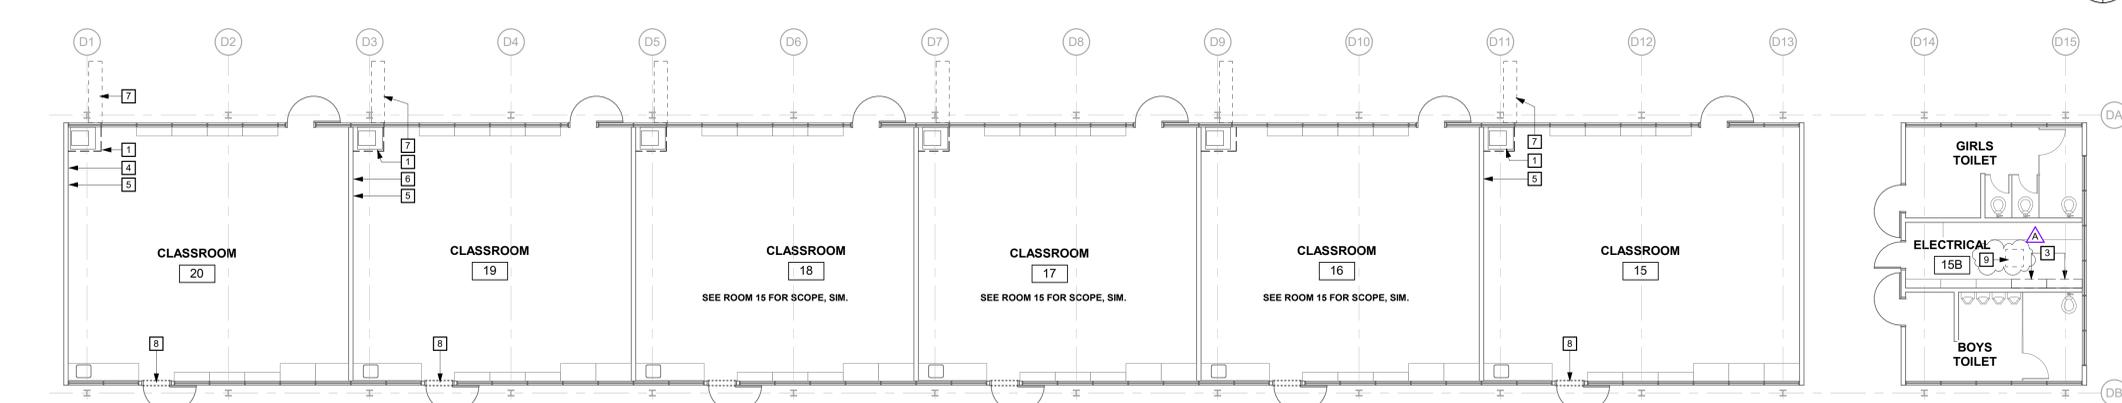

**4 DEMOLITION FLOOR PLAN - WING 4**  
SCALE: 1/8" = 1'-0"

**GENERAL SHEET NOTES**

- A ROOM NAMES OR NUMBERS MAY NOT BE CONSISTENT BETWEEN DEMOLITION AND NEW FLOOR PLANS.
- B REFER TO STRUCTURAL, MECHANICAL, AND ELECTRICAL DRAWINGS FOR EXTENT OF STRUCTURAL, MECHANICAL, AND ELECTRICAL DEMOLITION WORK.
- C VERIFY LIMITS OF DEMOLITION WITH SCOPE OF NEW WORK PRIOR TO COMMENCING WORK.
- D ALL ITEMS SHOWN DASHED ARE TO BE DEMOLISHED UNLESS OTHERWISE NOTED ON PLANS.
- E REMOVE ALL MISCELLANEOUS TRIM, CASEWORK, EQUIPMENT, CONDUIT, BASES, AND OTHER SURFACE MOUNTED ITEMS WHETHER SHOWN OR NOT, AS REQUIRED TO FACILITATE SCOPE OF WORK. REMOVE AND CAP ALL OUTLETS, SWITCHES, WIRES, THERMOSTATS, ETC. TO THEIR SOURCE AS REQUIRED. SEE MECHANICAL AND ELECTRICAL DRAWINGS FOR ADDITIONAL INFORMATION AND SCOPE OF WORK.
- F REMOVE ADJACENT FINISHES AS REQUIRED TO FACILITATE SCOPE OF WORK. PATCH BACK IN KIND.
- G EXISTING EQUIPMENT INDICATED TO BE RELOCATED PER NEW PLAN IS TO BE STORED AND PROTECTED DURING CONSTRUCTION.
- H NO DEMOLITION SHALL BEGIN UNTIL PLANS INCLUDING THE DEMOLITION WORK HAVE BEEN APPROVED BY DSA.
- I DIMENSIONS FOR EXISTING BUILDING ARE APPROXIMATE. CONTRACTOR TO FIELD VERIFY PRIOR TO START OF CONSTRUCTION.
- J REFER TO "HVAC AND POWER UPGRADE PROJECT HAZARDOUS MATERIALS SURVEY REPORT." CONTRACTOR TO ABATE AREAS AFFECTED BY SCOPE OF WORK. REMOVE AND DISPOSE OF MATERIALS PER REPORT RECOMMENDATIONS.

**DEMOLITION FLOOR PLAN KEYNOTES**


- 1 REMOVE (E) MECHANICAL UNIT AND ENCLOSURE, S.M.D.
- 2 REMOVE (E) 4'x 8' TACK PANEL
- 3 REMOVE (E) CABINET
- 4 SALVAGE (E) 8'x 4' WHITEBOARD AND TURN OVER TO OWNER
- 5 SHORTEN (E) RACEWAY. COORDINATE LENGTH TIGHT TO NEW ENCLOSURE. SEE NEW FLOOR PLANS.
- 6 SALVAGE (E) 36" x 48" TACK PANEL AND TURN OVER TO DISTRICT
- 7 REMOVE PAVING AND PREP FOR NEW WORK, S.M.D.
- 8 REMOVE (E) WINDOW, GLAZING ABOVE AND PREP FOR NEW WORK, S.M.D.
- 9 REMOVE (E) GYP. BD CEILING FOR EXHAUST FAN INSTALLATION, S.M.D.
- 10 REMOVE FIRST SECTION OF CASEWORK. CUT TOP AND BOTTOM SHELF FLUSH TO ADJACENT CASEWORK TO REMAIN. REMOVE SHELVING.



www.aedisarchitects.com  
387 S. 1st Street, Suite 300  
San Jose, CA 95113  
tel: (408) 300-5100  
fax: (408) 300-5121

PROJECT  
**GEORGE HALL  
ELEMENTARY  
SCHOOL - HVAC  
REPLACEMENT**

SAN MATEO-FOSTER CITY  
SCHOOL DISTRICT  
CONSULTANT

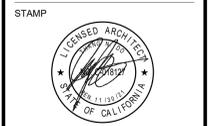

STATE  
DSA FILE NUMBER 41-26  
APPL # 01-119523

No.	Description	Date
1	Addendum 1	11/24/2021

**MILESTONES**

DD	
90% CD	
DSA SUB	05/21/2021
BACKCHECK	10/04/2021


SHEET  
**DEMOLITION  
FLOOR PLANS -  
WINGS 1, 2, 3 & 4**

DATE 11/24/2021  
JOB # 2021005.02  
SHEET # AD1-  
**A2.01**


**GRAPHIC KEY**

- EXISTING WALL TO BE DEMOLISHED.
- EXISTING WALL TO REMAIN.
- EXISTING STOREFRONT OR WINDOW TO REMAIN.

**BUILDING KEY**

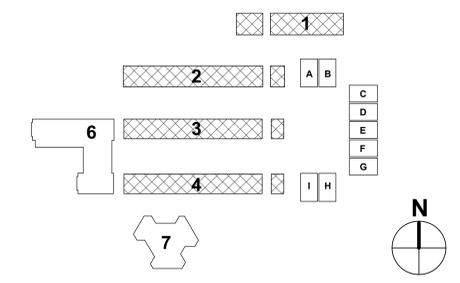

11/24/2021 2:26:45 PM C:\Users\lbailey\Documents\2021005.02\_George Hall ES - HVAC Replacement\_Central(2019 version)\_lbailey\KRP\_IP.rvt

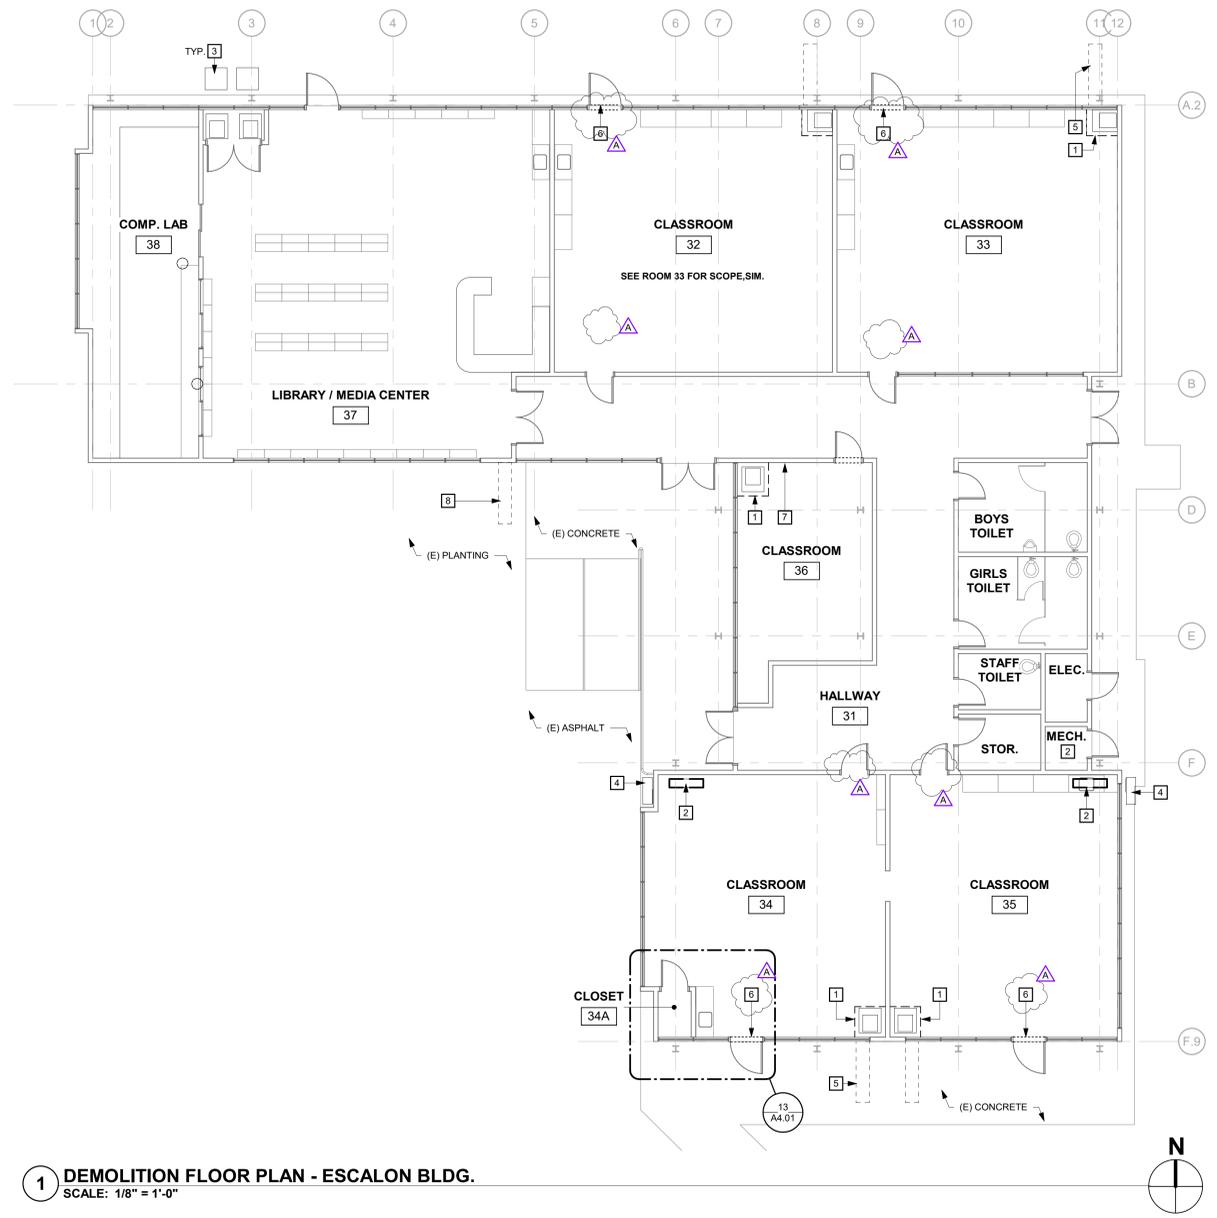

**1 DEMOLITION FLOOR PLAN - ESCALON BLDG.**  
SCALE: 1/8" = 1'-0"

**GENERAL SHEET NOTES**

- A ROOM NAMES OR NUMBERS MAY NOT BE CONSISTENT BETWEEN DEMOLITION AND NEW FLOOR PLANS.
- B REFER TO STRUCTURAL, MECHANICAL, AND ELECTRICAL DRAWINGS FOR EXTENT OF STRUCTURAL, MECHANICAL, AND ELECTRICAL DEMOLITION WORK.
- C VERIFY LIMITS OF DEMOLITION WITH SCOPE OF NEW WORK PRIOR TO COMMENCING WORK.
- D ALL ITEMS SHOWN DASHED ARE TO BE DEMOLISHED UNLESS OTHERWISE NOTED ON PLANS.
- E REMOVE ALL MISCELLANEOUS TRIM, CASEWORK, EQUIPMENT, CONDUIT, BASES, AND OTHER SURFACE MOUNTED ITEMS WHETHER SHOWN OR NOT, AS REQUIRED TO FACILITATE SCOPE OF WORK. REMOVE AND CAP ALL OUTLETS, SWITCHES, WIRES, THERMOSTATS, ETC. TO THEIR SOURCE AS REQUIRED. SEE MECHANICAL AND ELECTRICAL DRAWINGS FOR ADDITIONAL INFORMATION AND SCOPE OF WORK.
- F REMOVE ADJACENT FINISHES AS REQUIRED TO FACILITATE SCOPE OF WORK. PATCH BACK IN KIND.
- G EXISTING EQUIPMENT INDICATED TO BE RELOCATED PER NEW PLAN IS TO BE STORED AND PROTECTED DURING CONSTRUCTION.
- H NO DEMOLITION SHALL BEGIN UNTIL PLANS INCLUDING THE DEMOLITION WORK HAVE BEEN APPROVED BY DSA.
- I DIMENSIONS FOR EXISTING BUILDING ARE APPROXIMATE. CONTRACTOR TO FIELD VERIFY PRIOR TO START OF CONSTRUCTION.
- J REFER TO "HVAC AND POWER UPGRADE PROJECT HAZARDOUS MATERIALS SURVEY REPORT." CONTRACTOR TO ABATE AREAS AFFECTED BY SCOPE OF WORK. REMOVE AND DISPOSE OF MATERIALS PER REPORT RECOMMENDATIONS.


**DEMOLITION FLOOR PLAN KEYNOTES**

- 1 REMOVE (E) MECHANICAL UNIT AND ENCLOSURE, S.M.D. RECONFIGURE (E) ADJACENT WIREMOLD
- 2 REMOVE (E) MECHANICAL UNIT; PATCH AND PAINT WALL TO MATCH ADJACENT (E) EQUIPMENT TO REMAIN, S.M.D.
- 4 REMOVE (E) MECHANICAL UNIT AND ENCLOSURE; PATCH AND PAINT WALL TO MATCH ADJACENT
- 5 REMOVE PAVING AND PREP FOR NEW WORK, S.M.D.
- 6 REMOVE (E) WINDOW GLAZING ABOVE AND PREP FOR NEW WORK, S.M.D.
- 7 SALVAGE (E) TACK PANEL AND PROJECTOR SCREEN. TURN OVER TO DISTRICT
- 8 REMOVE PLANTING AND PREP FOR NEW WORK. DO NOT CUT TREE ROOTS OVER 2" DIA. SEE NEW FLOOR PLAN FOR MORE INFORMATION

**GRAPHIC KEY**

- EXISTING WALL TO BE DEMOLISHED.
- EXISTING WALL TO REMAIN.
- EXISTING STOREFRONT OR WINDOW TO REMAIN.

**BUILDING KEY**

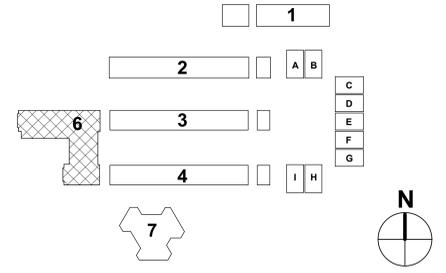


www.aedisarchitects.com  
387 S. 1st Street, Suite 300  
San Jose, CA 95113  
tel: (408)-300-5100  
fax: (408)-300-5121

PROJECT  
**GEORGE HALL  
ELEMENTARY  
SCHOOL - HVAC  
REPLACEMENT**

SAN MATEO-FOSTER CITY  
SCHOOL DISTRICT

CONSULTANT

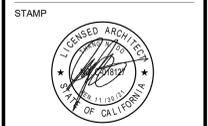

STATE  
DSA FILE NUMBER 41-26  
APPL # 01-119523

REVISIONS


No.	Description	Date
1	Addendum 1	11/24/2021

MILESTONES


DD	
90% CD	
DSA SUB	05/21/2021
BACKCHECK	10/04/2021

SHEET  
**DEMOLITION  
FLOOR PLAN -  
ESCALON BLDG.**


DATE 10/04/2021  
JOB # 2021005.02  
SHEET # AD1-  
**A2.02**

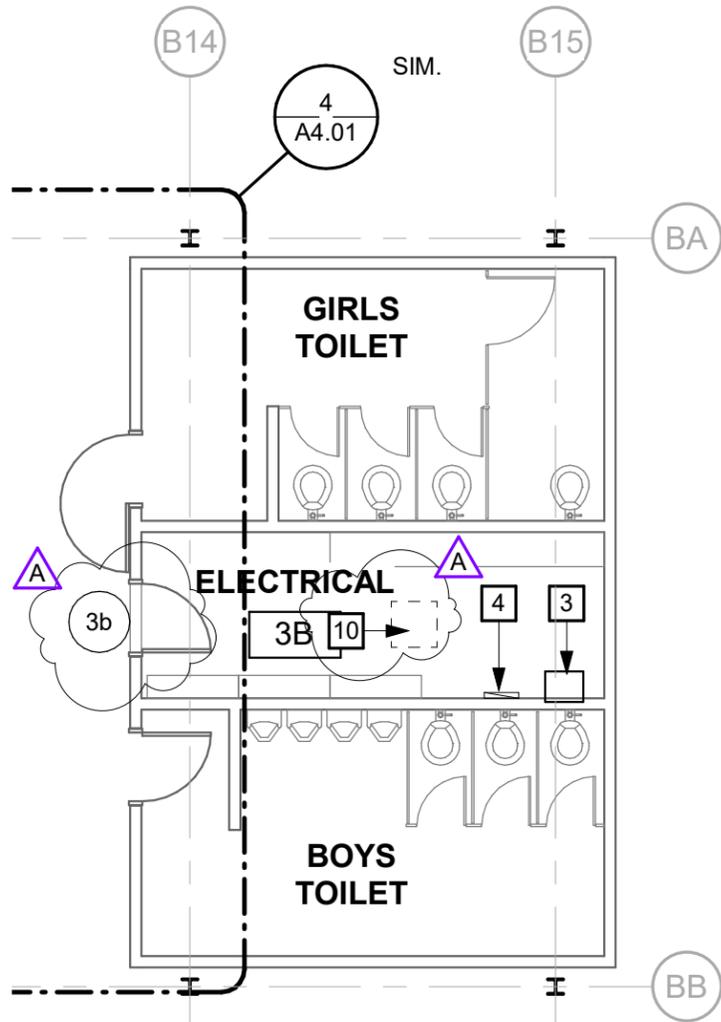

**2 NEW FLOOR PLAN - WING 2**  
SCALE: 1/8" = 1'-0"

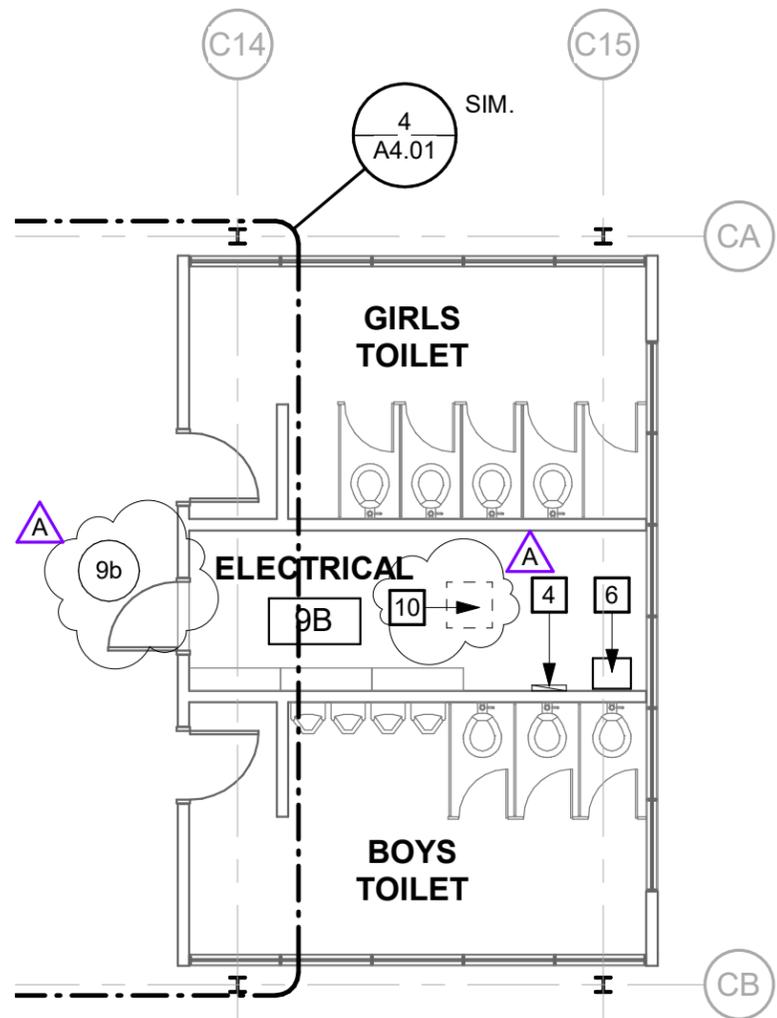

**3 NEW FLOOR PLAN - WING 3**  
SCALE: 1/8" = 1'-0"

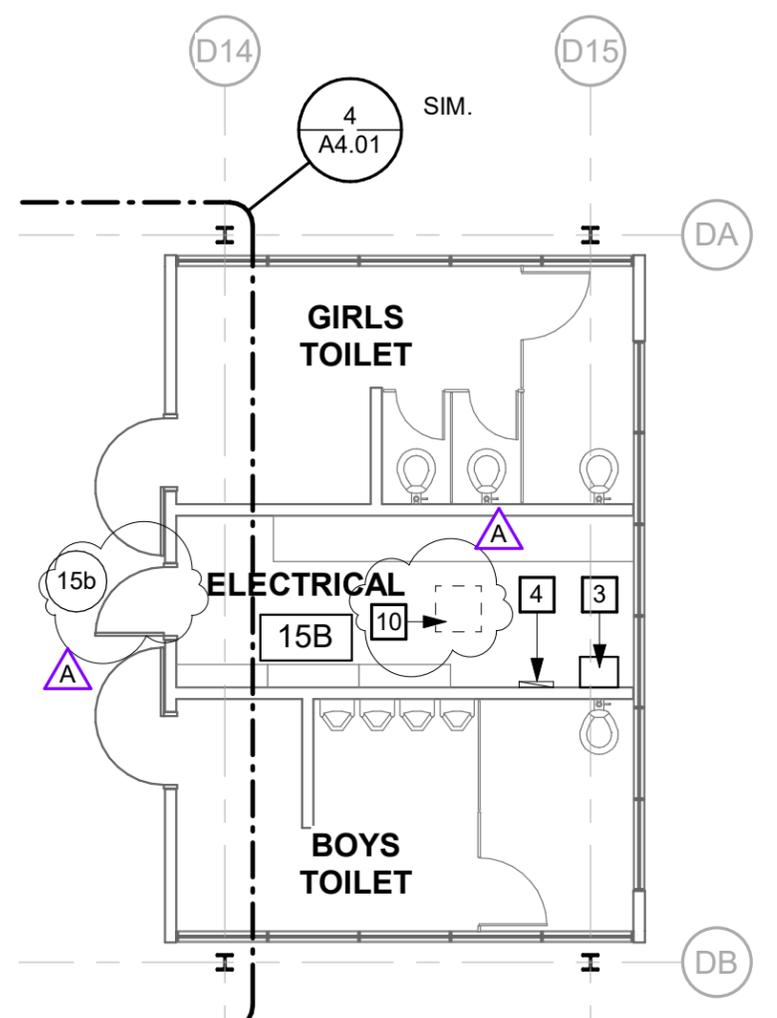

**4 NEW FLOOR PLAN - WING 4**  
SCALE: 1/8" = 1'-0"

**NEW FLOOR PLAN KEYNOTES**

- 7 PATCH PAVING AT DRY WELL. SEE 6/A8.10 AND S.M.D.
- 8 PATCH AND PAINT EXTERIOR FACE WHERE FIRST SECTION OF CASEWORK HAS BEEN REMOVED.
- 9 REFER TO 5/A4.01 FOR TYPICAL CLASSROOM NEW REFLECTED CEILING PLAN. REMOVE AND REINSTALL (E) ACOUSTICAL CEILING TILES ABOVE AS REQUIRED FOR CONSTRUCTION ACCESS INCLUDING BUT NOT LIMITED TO ELECTRICAL ROUTING, MECHANICAL DUCTWORK ANCHORAGE, BLOCKING FOR ROOFTOP PLATFORMS. DO NOT ALTER SUSPENDED A.C.T. GRID.
- 10 PATCH AND PAINT GYP. BD. CEILING ADJACENT EXHAUST FAN, S.M.D.



		GEORGE HALL ELEMENTARY SCHOOL - HVAC REPLACEMENT	
		SAN MATEO-FOSTER CITY SCHOOL DISTRICT	
FILE NO.:	41-26	SHEET	
APPL NO.:	01-119523	<b>AD1-3.01</b>	
JOB NO.:	2021005.02		
DATE:	11/24/2021		
387 S. 1st Street, Suite 300 San Jose, CA., 95113		tel: (408) 300 - 5160 fax: (408) 300 - 5121	

PROJECT

GEORGE HALL  
ELEMENTARY  
SCHOOL - HVAC  
REPLACEMENT

SAN MATEO-FOSTER CITY  
SCHOOL DISTRICT

CONSULTANT

STAMP



STATE

DSA FILE NUMBER 41-26

APPL # 01-119523

REVISIONS

No.	Description	Date
1	Addendum 1	11/24/2021

11/24/2021

MILESTONES

DD

90% CD

DSA SUB 05/21/2021

BACKCHECK 10/04/2021

SHEET

PARTIAL SITE  
ROOF PLAN

DATE 10/04/2021

JOB # 2021005.02

SHEET # AD1-

A5.01

GENERAL SHEET NOTES

- A REFER TO MECHANICAL AND ELECTRICAL DRAWINGS FOR EXTENT OF MECHANICAL AND ELECTRICAL WORK.
- B SIZE OF MECHANICAL EQUIPMENT PADS ARE FOR REFERENCE ONLY. THE CONTRACTOR SHALL VERIFY REQUIRED PAD DIMENSION WITH EQUIPMENT MANUFACTURER.



PARTIAL SITE ROOF PLAN KEYNOTES

- 1 PATCH (E) PENETRATION AT REMOVED FLUE AND COMBUSTION AIR INTAKE AND PATCH (N) PENETRATIONS. S.M.D. AND SEE DETAIL 17/A8.10
- 2 MECHANICAL UNIT ON PLATFORM WITH CRICKET. S.M.D. AND SEE DETAIL 19/A8.10. REMOVE (E) ROOFING TO SUBSTRATE FOR CONSTRUCTION ACCESS.
- 3 EXHAUST FAN SEE 10/A8.10 SIM. S.M.D. REMOVE (E) ROOFING TO SUBSTRATE AND PREP OPENING AS REQUIRED FOR NEW WORK.

GRAPHIC KEY


- (E) ASPHALT SHINGLE, CLASS C MINIMUM
- (E) TPO SINGLE PLY ROOFING, CLASS C MINIMUM
- (E) MINERAL CAP SHEET, CLASS C MINIMUM
- OUTLINE OF WALL BELOW.

BUILDING KEY

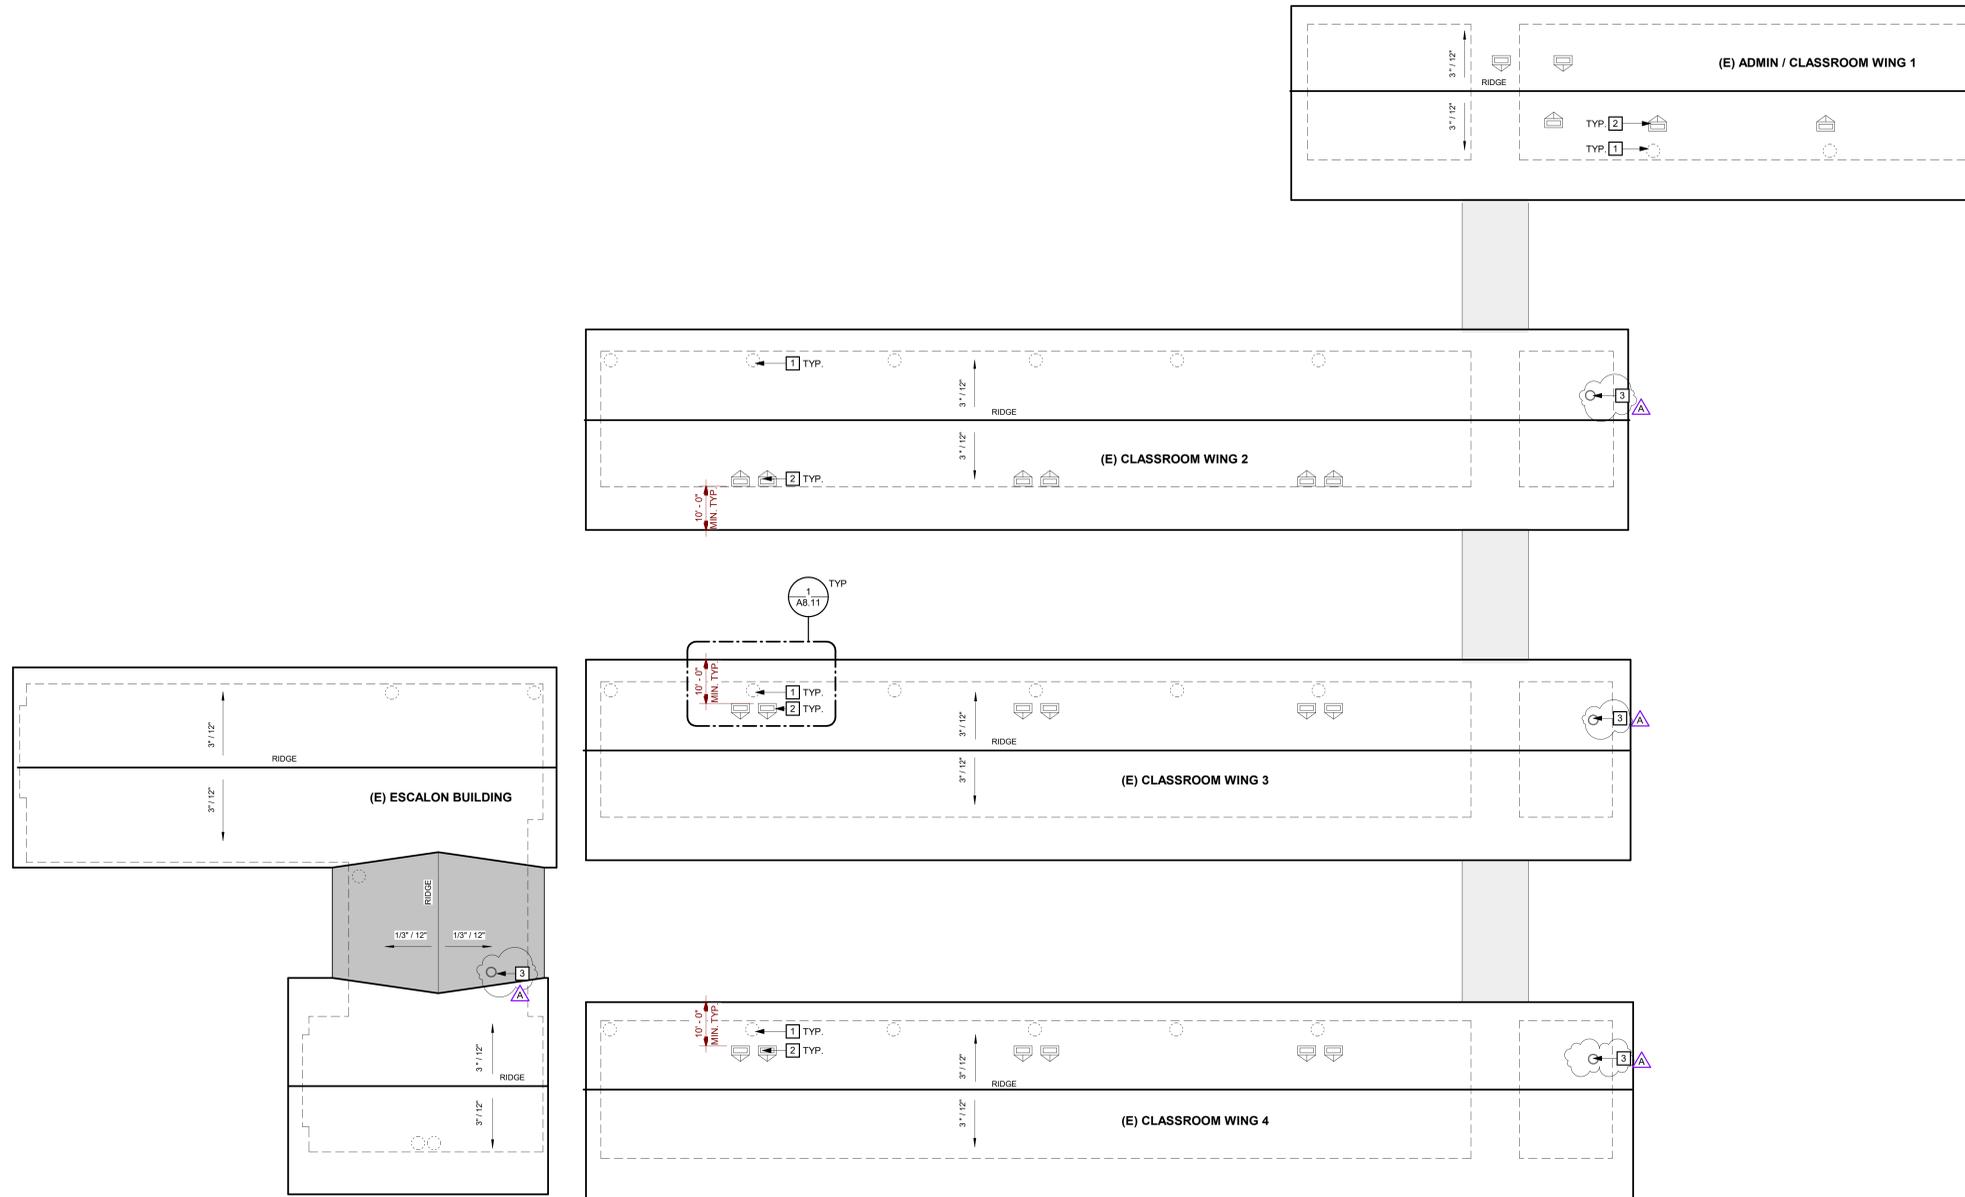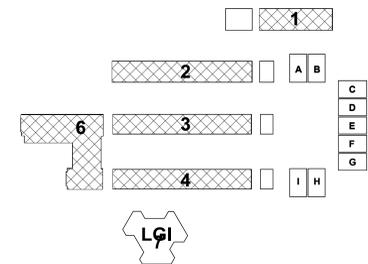

1 PARTIAL SITE ROOF PLAN  
SCALE: 1/16" = 1'-0"




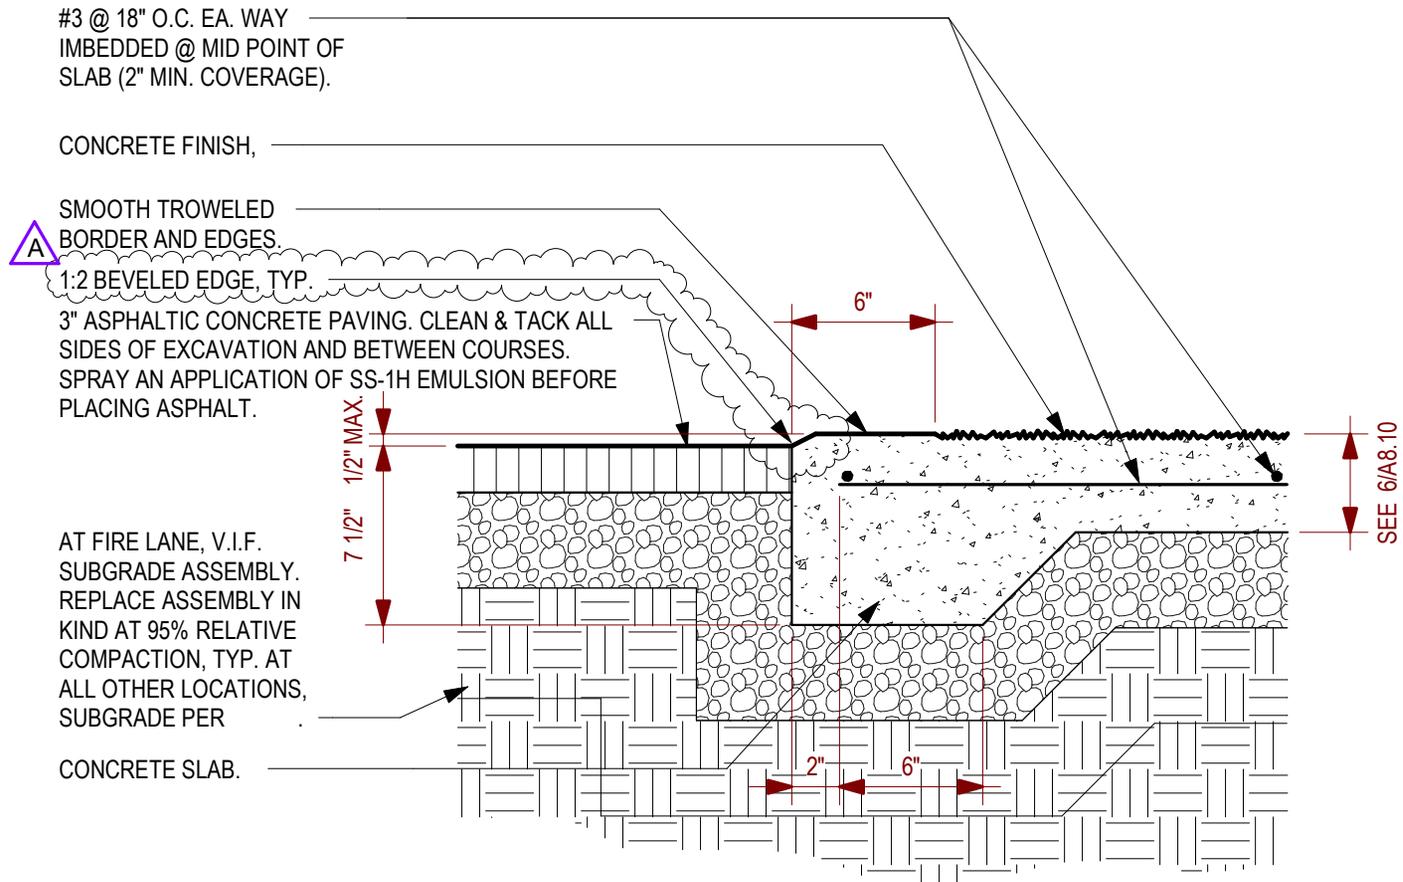

**9 ASPHALT/CONCRETE JOINT**  
SCALE: 1 1/2" = 1'-0"




		GEORGE HALL ELEMENTARY SCHOOL - HVAC REPLACEMENT SAN MATEO FOSTER CITY SCHOOL DISTRICT	
		FILE NO.: 41-26	SHEET
387 S. 1st Street, Suite 300 San Jose, CA., 95113 tel: (408) 300 - 5160 fax: (408) 300 - 5121		APPL NO.: 01-119523	<b>AD1-A8.10</b>
		JOB NO.: 2021005.02	
		DATE 11/24/2021	

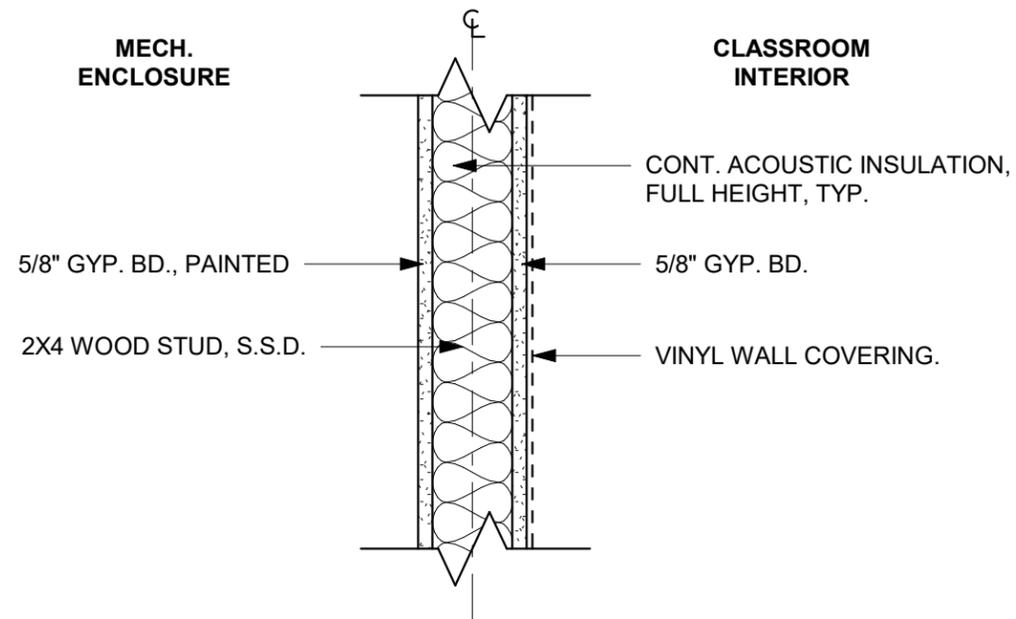

**A**

**NOTE:**  
SEE DETAIL 6/A9.10 FOR TYPICAL SOUND TREATED NONRATED WALL.

**1** **WALL TYPE - MECHANICAL ENCLOSURE**  
SCALE: 1 1/2" = 1'-0"

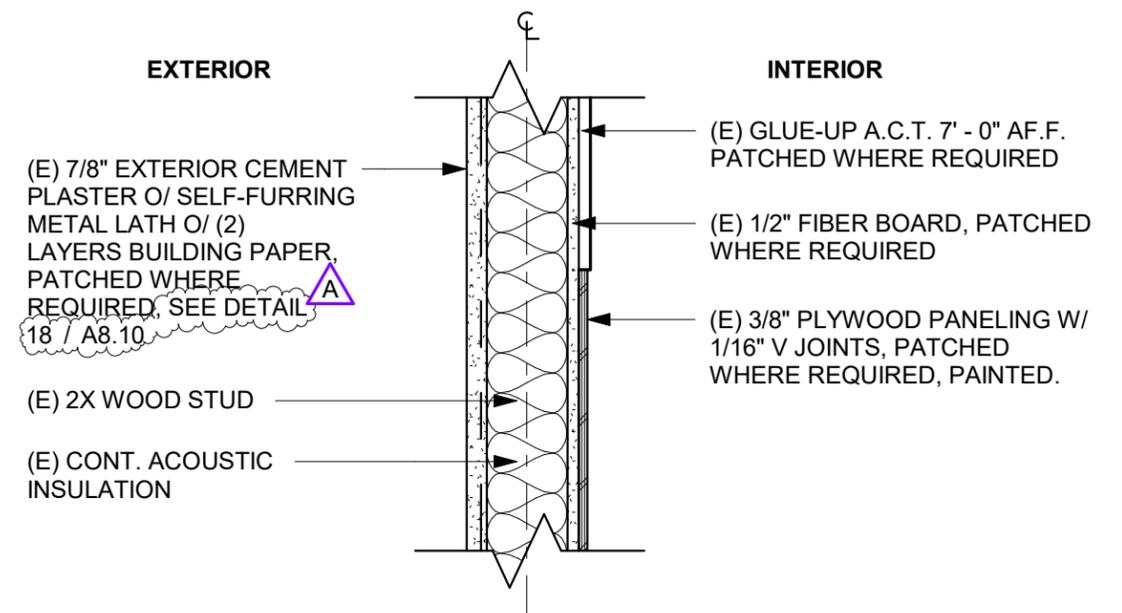



**ADDITIONAL WALL TYPES**

5A - REPLACE (E) GLUE-UP A.C.T., (E) 3/8" PLYWOOD PANELING, AND (E) 1/2" FIBER BOARD WITH (E) 5/8" GYP. BD. AT INTERIOR.

**5** **WALL TYPE - CEMENT PLASTER / GLUE-UP ACT**  
SCALE: 1 1/2" = 1'-0"



		GEORGE HALL ELEMENTARY SCHOOL - HVAC REPLACEMENT SAN MATEO-FOSTER CITY SCHOOL DISTRICT	
		FILE NO.: 41-26	SHEET
387 S. 1st Street, Suite 300 San Jose, CA., 95113		tel: (408) 300 - 5160 fax: (408) 300 - 5121	APPL NO.: 01-119523 JOB NO.: 2021005.02 DATE: 11/24/2021
			<b>AD1-A9.10A</b>

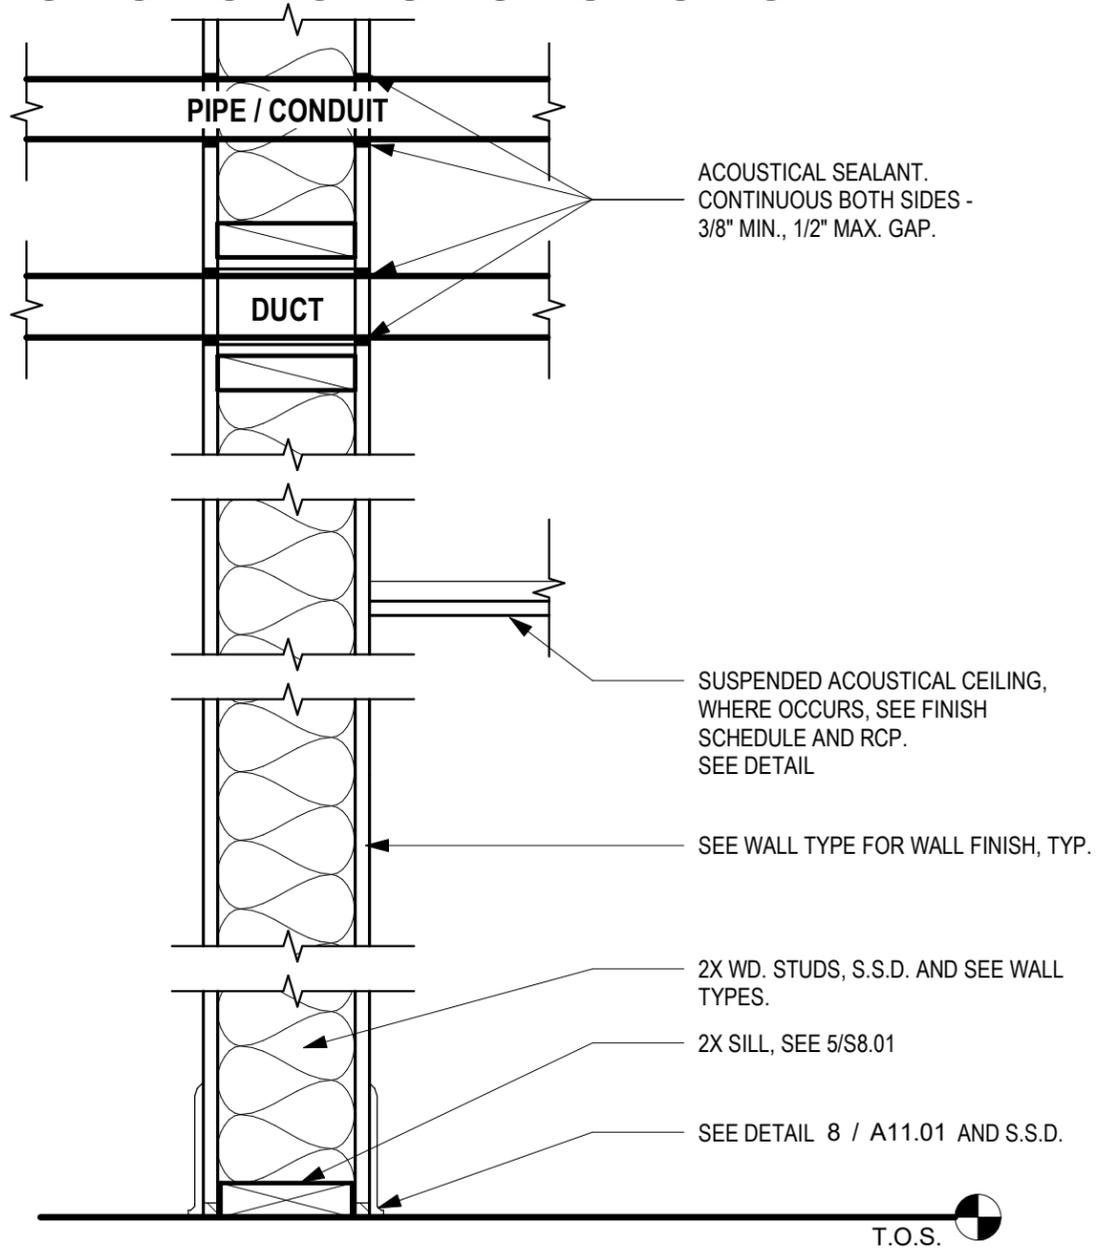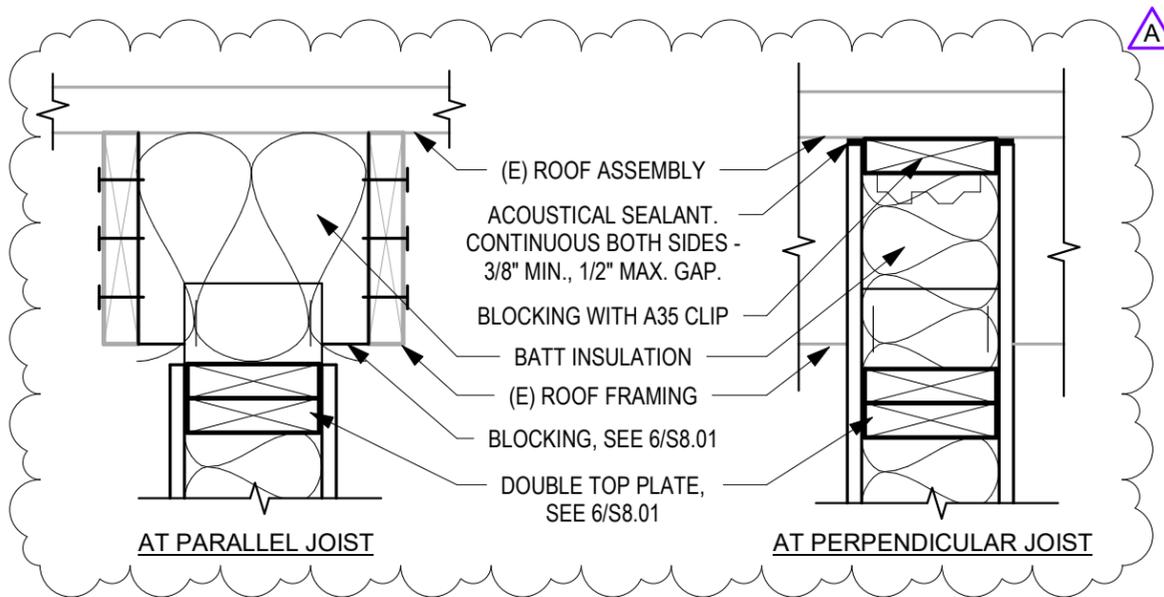

- NOTES:**
- FOR RECESSED ACCESSORIES OR CABINETS, PROVIDE BLOCKING, GYPSUM BOARD AND ACOUSTICAL SEALANT SIMILAR TO DETAIL AT DUCT.


**6 TYPICAL SOUND TREATED NONRATED WALL**  
 SCALE: 1 1/2" = 1'-0"



		GEORGE HALL ELEMENTARY SCHOOL - HVAC REPLACEMENT SAN MATEO-FOSTER CITY SCHOOL DISTRICT	
		FILE NO.: 41-26	SHEET
387 S. 1st Street, Suite 300 San Jose, CA., 95113		tel: (408) 300 - 5160 fax: (408) 300 - 5121	APPL NO.: 01-119523 JOB NO. 2021005.02 DATE 11/24/2021
			<b>AD1-A9.10B</b>

## DOOR SCHEDULE

DOOR ID	OPENING SIZE		DOOR		FRAME		DETAILS				HARDWARE GROUP	COMMENTS
	WIDTH	HEIGHT	TYPE	FINISH	TYPE	FINISH	HEAD	JAMB-1	JAMB-2	SILL		
1a	2' - 6"	7' - 0"	A	P-2	F1	P-3	11/A11.01	11/A11.01	11/A11.01	3/A11.01	01	
2a	2' - 6"	7' - 0"	A	P-2	F1	P-3	11/A11.01	11/A11.01	11/A11.01	3/A11.01	01	
3a	2' - 6"	7' - 0"	A	P-2	F1	P-3	11/A11.01	11/A11.01	11/A11.01	3/A11.01	01	
3b	3' - 0"	7' - 0"	B	-	-	-	-	-	-	-	-	1
4a	2' - 6"	7' - 0"	A	P-2	F1	P-3	11/A11.01	11/A11.01	11/A11.01	3/A11.01	01	
5a	2' - 6"	7' - 0"	A	P-2	F1	P-3	11/A11.01	11/A11.01	11/A11.01	3/A11.01	01	
6a	2' - 6"	7' - 0"	A	P-2	F1	P-3	11/A11.01	11/A11.01	11/A11.01	3/A11.01	01	
7a	2' - 6"	7' - 0"	A	P-2	F1	P-3	11/A11.01	11/A11.01	11/A11.01	3/A11.01	01	
8a	2' - 6"	7' - 0"	A	P-2	F1	P-3	11/A11.01	11/A11.01	11/A11.01	3/A11.01	01	
9a	2' - 6"	7' - 0"	A	P-2	F1	P-3	11/A11.01	11/A11.01	11/A11.01	3/A11.01	01	
9b	3' - 0"	7' - 0"	B	-	-	-	-	-	-	-	-	1
10a	2' - 6"	7' - 0"	A	P-2	F1	P-3	11/A11.01	11/A11.01	11/A11.01	3/A11.01	01	
11a	2' - 6"	7' - 0"	A	P-2	F1	P-3	11/A11.01	11/A11.01	11/A11.01	3/A11.01	01	
12a	2' - 6"	7' - 0"	A	P-2	F1	P-3	11/A11.01	11/A11.01	11/A11.01	3/A11.01	01	
13a	2' - 6"	7' - 0"	A	P-2	F1	P-3	11/A11.01	11/A11.01	11/A11.01	3/A11.01	01	
14a	2' - 6"	7' - 0"	A	P-2	F1	P-3	11/A11.01	11/A11.01	11/A11.01	3/A11.01	01	
15a	2' - 6"	7' - 0"	A	P-2	F1	P-3	11/A11.01	11/A11.01	11/A11.01	3/A11.01	01	
15b	3' - 0"	7' - 0"	B	-	-	-	-	-	-	-	-	1
16a	2' - 6"	7' - 0"	A	P-2	F1	P-3	11/A11.01	11/A11.01	11/A11.01	3/A11.01	01	
17a	2' - 6"	7' - 0"	A	P-2	F1	P-3	11/A11.01	11/A11.01	11/A11.01	3/A11.01	01	
18a	2' - 6"	7' - 0"	A	P-2	F1	P-3	11/A11.01	11/A11.01	11/A11.01	3/A11.01	01	
19a	2' - 6"	7' - 0"	A	P-2	F1	P-3	11/A11.01	11/A11.01	11/A11.01	3/A11.01	01	
20a	2' - 6"	7' - 0"	A	P-2	F1	P-3	11/A11.01	11/A11.01	11/A11.01	3/A11.01	01	
32a	2' - 6"	7' - 0"	A	P-2	F1	P-3	11/A11.01	11/A11.01	11/A11.01	3/A11.01	01	
33a	2' - 6"	7' - 0"	A	P-2	F1	P-3	11/A11.01	11/A11.01	11/A11.01	3/A11.01	01	
34a	2' - 6"	7' - 0"	A	P-2	F1	P-3	11/A11.01	11/A11.01	11/A11.01	3/A11.01	01	
35a	2' - 6"	7' - 0"	A	P-2	F1	P-3	11/A11.01	11/A11.01	11/A11.01	3/A11.01	01	
36a	2' - 6"	7' - 0"	A	P-2	F1	P-3	11/A11.01	11/A11.01	11/A11.01	3/A11.01	01	

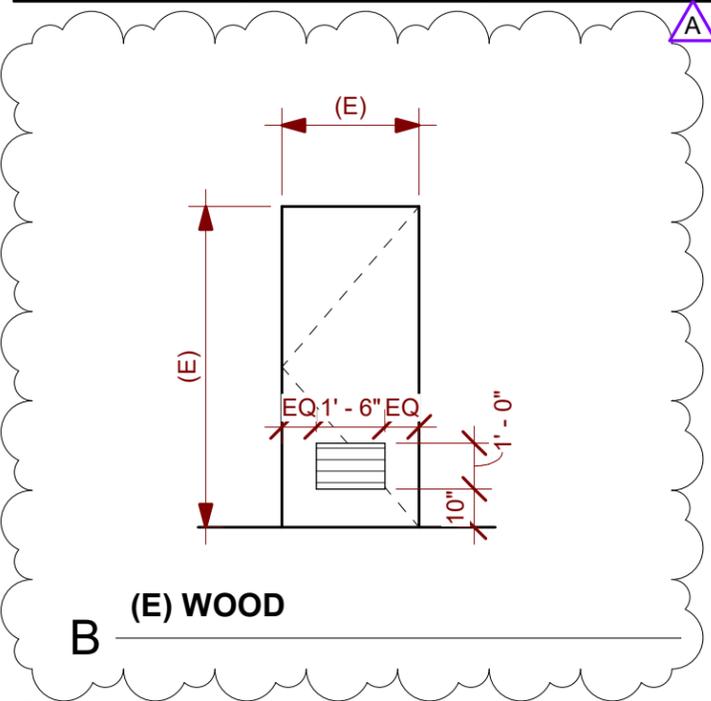

**DOOR TYPES**  
SCALE: 1/4" = 1'-0"

## DOOR SCHEDULE COMMENTS

1 PROVIDE NEW LOUVER AT EXISTING DOOR. CUT AND PREP AS REQUIRED. PAINT LOUVER TO MATCH DOOR



<b>aedis</b> architects		GEORGE HALL ELEMENTARY SCHOOL - HVAC REPLACEMENT	
387 S. 1st Street, Suite 300 San Jose, CA., 95113		tel: (408) 300 - 5160 fax: (408) 300 - 5121	
SAN MATEO-FOSTER CITY SCHOOL DISTRICT		SHEET	
FILE NO.: 41-26	APPL NO.: 01-119523	JOB NO.: 2021005.02	<b>AD1-A11.01</b>
DATE: 11/24/2021			

SPLIT SYSTEM AIR CONDITIONERS SCHEDULE																
TAG	MANUFACTURER	MODEL	WING / BUILDING	LOCATION	COOLING TOTAL MBH	HEATING TOTAL MBH	AIRFLOW CFM			SEER	ELECTRICAL			WEIGHT LBS	MOUNTING DETAIL	NOTES
							LIQUID	GAS			V / PH	NCA	MCCP			
SSO-1	SAMSUNG	AR24TSFYBWKVCV	WING 1	ROOF	22	24	-	1/4"	5/8"	18	208 / 1	20	30	125	2MP6.01	
SSI-1	SAMSUNG	AR24TSFYBWKVCV		KITCHEN			657	1/4"	5/8"	-	NOTE 1			30	3MP6.01	2, 3, 4, 5
SSO-2	SAMSUNG	AR24TSFYBWKVCV	WING 1	ROOF	9	11	-	1/4"	3/8"	23.5	208 / 1	12	20	70	2MP6.01	
SSI-2	SAMSUNG	AR24TSFYBWKVCV		PSYCH 2A			371	1/4"	3/8"	-	NOTE 1			25	3MP6.01	2, 3, 4, 5
SSO-3	SAMSUNG	AR24TSFYBWKVCV	WING 1	ROOF	22	NOTE 6	-	1/4"	5/8"	18	208 / 1	20	30	125	2MP6.01	
SSI-3	SAMSUNG	AR24TSFYBWKVCV		ELECTRICAL ROOM			657	1/4"	5/8"	-	NOTE 1			30	3MP6.01	2, 3, 4, 5

- INDOOR UNITS ARE POWERED BY OUTDOOR UNIT.
- PROVIDE WITH WALL MOUNTING BRACKET.
- PROVIDE WITH SAMSUNG WALL MOUNTED THERMOSTAT.

- PROVIDE WITH BACNET INTERFACE CARD. SEE MP5.01 FOR CONTROLS.
- PROVIDE WITH CONDENSATE PUMP.
- LOCK OUT HEATING.

AIR DISTRIBUTION SCHEDULE						
TAG	MANUFACTURER	MODEL NO.	DESCRIPTION	BORDER TYPE	MOUNTING DETAIL	NOTES
HSS-1	TITUS	S30FL	HIGH SIDEWALL SUPPLY	TYPE 1	12MP6.01	1, 2, 4
HSS-2	TITUS	300RL	HIGH SIDEWALL SUPPLY	TYPE 1	13MP6.01	1, 2
HSR-1	TITUS	350RL	HIGH SIDEWALL RETURN	TYPE 1	13MP6.01	2, 3
RG-1	TITUS	30RL	RELIEF GRILLE	TYPE 1	10MP6.01	2, 5
EG-1	TITUS	8R	EXHAUST GRILLE	LAY-IN	17MP6.01	2

- SET BLADES AT 22.5° DEFLECTION.
- PRIME AND PAINT PER ARCHITECT'S INSTRUCTIONS. REGISTER COLOR SELECTED BY ARCHITECT.
- PROVIDE WITH ARSAN COMPACT DUCT SILENCER.
- PROVIDE WITH ASD AIR SCOOP DEVICE.
- CONTRACTOR TO FIELD VERIFY (E) DIMENSIONS PRIOR TO ORDERING.

ROOF EXHAUST FANS SCHEDULE												
TAG	MANUFACTURER	MODEL NO.	AREA SERVED	AIRFLOW CFM	ESP IN. W.G.	FAN RPM	SOUND POWER SONES	MOTOR		WEIGHT LBS	MOUNTING DETAIL	NOTES
								HP / WATTS	V / PH			
REF-2-1	GREENHECK	G-08B-VG	ELEC. RM 3B	450	0.25	1125	6.0	1/4	115 / 1	45	16MP6.01	1, 2
REF-3-1	GREENHECK	G-08B-VG	ELEC. RM 9B	450	0.25	1125	6.0	1/4	115 / 1	45	16MP6.01	1, 2
REF-4-1	GREENHECK	G-08B-VG	ELEC. RM 15B	450	0.25	1125	6.0	1/4	115 / 1	45	16MP6.01	1, 2
REF-E-1	GREENHECK	G-070-VG	ELEC.	250	0.25	1479	4.1	1/15	115 / 1	45	16MP6.01	1, 2


- PROVIDE WITH UL LISTING, FAN MOUNTED SPEED CONTROL, BACKDRAFT DAMPER, BIRDSCREEN AND ROOF CURB.
- PROVIDE WITH LINE VOLTAGE TSTAT.

CLASSROOM SPLIT SYSTEM HEAT PUMPS SCHEDULE																			
TAG	MANUFACTURER	MODEL	BUILDING / WING	LOCATION	COOLING TOTAL MBH	HEATING TOTAL MBH	AIRFLOW CFM	OUTSIDE AIR CFM	REFRIGERANT PIPING			SEER	HSPF	ELECTRICAL			WEIGHT LBS	MOUNTING DETAIL	NOTES
									LIQUID	GAS				V / PH	NCA	MCCP			
FC-1	SAMSUNG	AM054TNZDCHAA	WING 1	CLASSROOM 1	53	61	1600	450	3/8"	3/4"	-	-	208/1	2.6	15	164	15	2, 3, 4, 6, 7	
HP-1	SAMSUNG	AM053TXMDCHAA		ROOF	-	-	3/8"	3/4"	17.5	10	208 / 1	34	50	212	50	1			
FC-2	SAMSUNG	AM054TNZDCHAA	WING 1	CLASSROOM 2	53	61	1600	450	3/8"	3/4"	-	-	208/1	2.6	15	164	1MP6.01	2, 3, 4, 6, 7	
HP-2	SAMSUNG	AM053TXMDCHAA		ROOF	-	-	3/8"	3/4"	17.5	10	208 / 1	34	50	212	3MP6.01	1			
FC-3	SAMSUNG	AM054TNZDCHAA	WING 1	CLASSROOM 3	53	61	1155	450	3/8"	3/4"	-	-	208/1	2.6	15	164	1MP6.01	2, 3, 4, 6, 7	
HP-3	SAMSUNG	AM053TXMDCHAA		ROOF	-	-	3/8"	3/4"	17.5	10	208 / 1	34	50	212	3MP6.01	1			
FC-4	SAMSUNG	AM054TNZDCHAA	WING 1	CLASSROOM 4	53	61	1155	450	3/8"	3/4"	-	-	208/1	2.6	15	164	1MP6.01	2, 3, 4, 6, 7	
HP-4	SAMSUNG	AM053TXMDCHAA		ROOF	-	-	3/8"	3/4"	17.5	10	208 / 1	34	50	212	3MP6.01	1			
FC-5	SAMSUNG	AM054TNZDCHAA	WING 2	CLASSROOM 5	53	61	1155	450	3/8"	3/4"	-	-	208/1	2.6	15	164	1MP6.01	2, 3, 4, 6, 7	
HP-5	SAMSUNG	AM053TXMDCHAA		ROOF	-	-	3/8"	3/4"	17.5	10	208 / 1	34	50	212	3MP6.01	1			
FC-6	SAMSUNG	AM054TNZDCHAA	WING 2	CLASSROOM 6	53	61	1155	450	3/8"	3/4"	-	-	208/1	2.6	15	164	1MP6.01	2, 3, 4, 6, 7	
HP-6	SAMSUNG	AM053TXMDCHAA		ROOF	-	-	3/8"	3/4"	17.5	10	208 / 1	34	50	212	3MP6.01	1			
FC-7	SAMSUNG	AM054TNZDCHAA	WING 2	CLASSROOM 7	53	61	1155	450	3/8"	3/4"	-	-	208/1	2.6	15	164	1MP6.01	2, 3, 4, 6, 7	
HP-7	SAMSUNG	AM053TXMDCHAA		ROOF	-	-	3/8"	3/4"	17.5	10	208 / 1	34	50	212	3MP6.01	1			
FC-8	SAMSUNG	AM054TNZDCHAA	WING 2	CLASSROOM 8	53	61	1155	450	3/8"	3/4"	-	-	208/1	2.6	15	164	1MP6.01	2, 3, 4, 6, 7	
HP-8	SAMSUNG	AM053TXMDCHAA		ROOF	-	-	3/8"	3/4"	17.5	10	208 / 1	34	50	212	3MP6.01	1			
FC-9	SAMSUNG	AM054TNZDCHAA	WING 2	CLASSROOM 9	53	61	1155	450	3/8"	3/4"	-	-	208/1	2.6	15	164	1MP6.01	2, 3, 4, 6, 7	
HP-9	SAMSUNG	AM053TXMDCHAA		ROOF	-	-	3/8"	3/4"	17.5	10	208 / 1	34	50	212	3MP6.01	1			
FC-10	SAMSUNG	AM054TNZDCHAA	WING 2	CLASSROOM 10	53	61	1155	450	3/8"	3/4"	-	-	208/1	2.6	15	164	1MP6.01	2, 3, 4, 6, 7	
HP-10	SAMSUNG	AM053TXMDCHAA		ROOF	-	-	3/8"	3/4"	17.5	10	208 / 1	34	50	212	3MP6.01	1			
FC-11	SAMSUNG	AM054TNZDCHAA	WING 3	CLASSROOM 11	53	61	1155	450	3/8"	3/4"	-	-	208/1	2.6	15	164	1MP6.01	2, 3, 4, 6, 7	
HP-11	SAMSUNG	AM053TXMDCHAA		ROOF	-	-	3/8"	3/4"	17.5	10	208 / 1	34	50	212	3MP6.01	1			
FC-12	SAMSUNG	AM054TNZDCHAA	WING 3	CLASSROOM 12	53	61	1155	450	3/8"	3/4"	-	-	208/1	2.6	15	164	1MP6.01	2, 3, 4, 6, 7	
HP-12	SAMSUNG	AM053TXMDCHAA		ROOF	-	-	3/8"	3/4"	17.5	10	208 / 1	34	50	212	3MP6.01	1			
FC-13	SAMSUNG	AM054TNZDCHAA	WING 3	CLASSROOM 13	53	61	1155	450	3/8"	3/4"	-	-	208/1	2.6	15	164	1MP6.01	2, 3, 4, 6, 7	
HP-13	SAMSUNG	AM053TXMDCHAA		ROOF	-	-	3/8"	3/4"	17.5	10	208 / 1	34	50	212	3MP6.01	1			
FC-14	SAMSUNG	AM054TNZDCHAA	WING 3	CLASSROOM 14	53	61	1155	450	3/8"	3/4"	-	-	208/1	2.6	15	164	1MP6.01	2, 3, 4, 6, 7	
HP-14	SAMSUNG	AM053TXMDCHAA		ROOF	-	-	3/8"	3/4"	17.5	10	208 / 1	34	50	212	3MP6.01	1			
FC-15	SAMSUNG	AM054TNZDCHAA	WING 3	CLASSROOM 15	53	61	1155	450	3/8"	3/4"	-	-	208/1	2.6	15	164	1MP6.01	2, 3, 4, 6, 7	
HP-15	SAMSUNG	AM053TXMDCHAA		ROOF	-	-	3/8"	3/4"	17.5	10	208 / 1	34	50	212	3MP6.01	1			
FC-16	SAMSUNG	AM054TNZDCHAA	WING 3	CLASSROOM 16	53	61	1155	450	3/8"	3/4"	-	-	208/1	2.6	15	164	1MP6.01	2, 3, 4, 6, 7	
HP-16	SAMSUNG	AM053TXMDCHAA		ROOF	-	-	3/8"	3/4"	17.5	10	208 / 1	34	50	212	3MP6.01	1			
FC-17	SAMSUNG	AM054TNZDCHAA	WING 3	CLASSROOM 17	53	61	1155	450	3/8"	3/4"	-	-	208/1	2.6	15	164	1MP6.01	2, 3, 4, 6, 7	
HP-17	SAMSUNG	AM053TXMDCHAA		ROOF	-	-	3/8"	3/4"	17.5	10	208 / 1	34	50	212	3MP6.01	1			
FC-18	SAMSUNG	AM054TNZDCHAA	WING 4	CLASSROOM 18	53	61	1155	450	3/8"	3/4"	-	-	208/1	2.6	15	164	1MP6.01	2, 3, 4, 6, 7	
HP-18	SAMSUNG	AM053TXMDCHAA		ROOF	-	-	3/8"	3/4"	17.5	10	208 / 1	34	50	212	3MP6.01	1			
FC-19	SAMSUNG	AM054TNZDCHAA	WING 4	CLASSROOM 19	53	61	1155	450	3/8"	3/4"	-	-	208/1	2.6	15	164	1MP6.01	2, 3, 4, 6, 7	
HP-19	SAMSUNG	AM053TXMDCHAA		ROOF	-	-	3/8"	3/4"	17.5	10	208 / 1	34	50	212	3MP6.01	1			
FC-20	SAMSUNG	AM054TNZDCHAA	WING 4	CLASSROOM 20	53	61	1155	450	3/8"	3/4"	-	-	208/1	2.6	15	164	1MP6.01	2, 3, 4, 6, 7	
HP-20	SAMSUNG	AM053TXMDCHAA		ROOF	-	-	3/8"	3/4"	17.5	10	208 / 1	34	50	212	3MP6.01	1			
FC-32	SAMSUNG	AM054TNZDCHAA	WING 4	CLASSROOM 32	53	61	1155	450	3/8"	3/4"	-	-	208/1	2.6	15	164	1MP6.01	2, 3, 4, 6, 7	
HP-32	SAMSUNG	AM053TXMDCHAA		ROOF	-	-	3/8"	3/4"	17.5	10	208 / 1	34	50	212	15MP6.01	1			
FC-33	SAMSUNG	AM054TNZDCHAA	WING 4	CLASSROOM 33	53	61	1155	450	3/8"	3/4"	-	-	208/1	2.6	15	164	1MP6.01	2, 3, 4, 6, 7	
HP-33	SAMSUNG	AM053TXMDCHAA		ROOF	-	-	3/8"	3/4"	17.5	10	208 / 1	34	50	212	15MP6.01	1			
FC-34	SAMSUNG	AM054TNZDCHAA	WING 4	CLASSROOM 34	53	61	1155	450	3/8"	3/4"	-	-	208/1	2.6	15	164	1MP6.01	2, 3, 4, 6, 7	
HP-34	SAMSUNG	AM053TXMDCHAA		ROOF	-	-	3/8"	3/4"	17.5	10	208 / 1	34	50	212	15MP6.01	1			
FC-35	SAMSUNG	AM054TNZDCHAA	WING 4	CLASSROOM 35	53	61	900	450	3/8"	3/4"	-	-	208/1	2.6	15	164	1MP6.01	2, 3, 4, 6, 7	
HP-35	SAMSUNG	AM053TXMDCHAA		ROOF	-	-	3/8"	3/4"	17.5	10	208 / 1	34	50	212	15MP6.01	1			
FC-36	SAMSUNG	ACC2KNZDCHAA	WING 4	CLASSROOM 36	24	27	760	150	1/4"	5/8"	-	-	NOTE 8			100	1MP6.01	2, 3, 4, 5, 6, 7, 8	
HP-36	SAMSUNG	AM024IXADCHAA		ROOF	-	-	1/4"	5/8"	17.5	10	208 / 1	34	50	145	15MP6.01	1			

- SPLIT SYSTEM SHALL BE ABLE TO OPERATE AT 94% HEATING CAPACITY DOWN TO 32°F OUTDOOR AMBIENT TEMPERATURE.
- CFM BASED ON 0.55 ESP.
- PROVIDE WITH SAMSUNG MM-A60UN 24VAC THERMOSTAT ADAPTER AND 24VAC TRANSFORMER.
- PROVIDE WITH DELTA CONTROL THERMOSTAT WITH CO2 SENSOR. SEE MP5.01 FOR CONTROLS.
- PROVIDE WITH CONDENSATE PUMP.
- PROVIDE WITH MERV-13 FILTERS WITH FILTER ACCESS PANEL.
- FAN COIL SHALL BE ADJUSTED TO OPERATE AT CONSTANT SPEED AT INDICATED CFM.
- INDOOR UNIT POWERED BY OUTDOOR UNIT.

**aedis**  
architects

www.aedisarchitects.com  
387 S. 1st Street, Suite 300  
San Jose, CA 95113  
tel: (408)-300-5160  
fax: (408)-300-5121

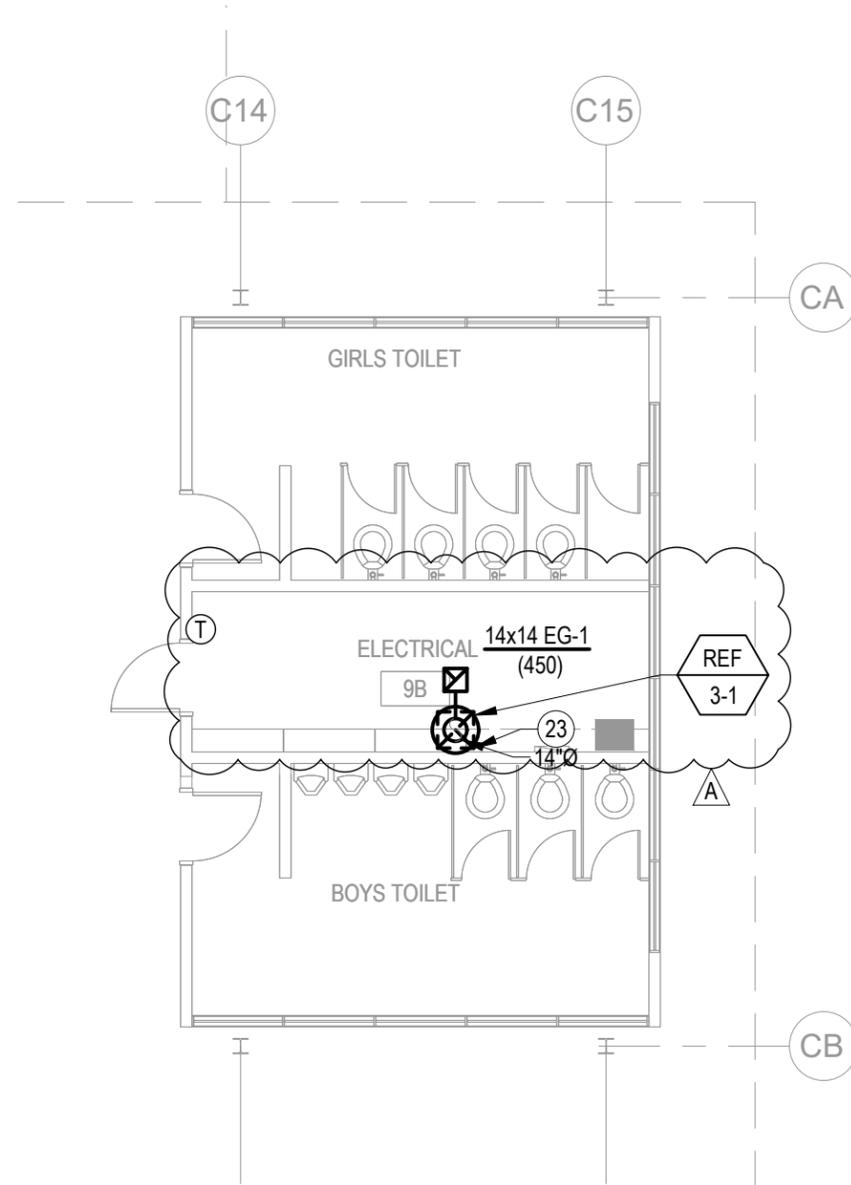

- GENERAL NOTES**
4. PAINT ALL EXPOSED DUCTWORK, SUPPORTS, AND REGISTERS TO MATCH ADJACENT.
  5. PAINT CONDENSATE PIPING AT EXTERIOR OF BUILDING TO MATCH ADJACENT.
- # NEW SHEET NOTES**
23. INSTALL EXHAUST FAN ON ROOF.

3  
MP2.03

# PARTIAL FLOOR PLAN - WING 3 - NEW - MECHANICAL & PLUMBING

SCALE: 1/8" = 1'-0"




CEG JOB NO: 21034

**CYPRESS**  
Engineering Group

HVAC, Plumbing, Fire Protection  
Building Commissioning  
Industrial Refrigeration  
Environmental Compliance  
Training & Technical Support

831.218.1802  
8 Harris Court, Suite A8  
Monterey, CA 93940  
cypressseg.com

		GEORGE HALL ELEMENTARY SCHOOL - HVAC REPLACEMENT  SAN MATEO-FOSTER CITY SCHOOL DISTRICT	
387 S. 1st Street, Suite 300 San Jose, CA., 95113	tel: (408) 300 - 5160 fax: (408) 300 - 5121	FILE NO.: 41-26 APPL NO.: 01-119523 JOB NO.: 2021005.02 DATE 11/19/2021	SHEET REF. SHEET MP2.03 <b>AD1-MP2.03a</b>

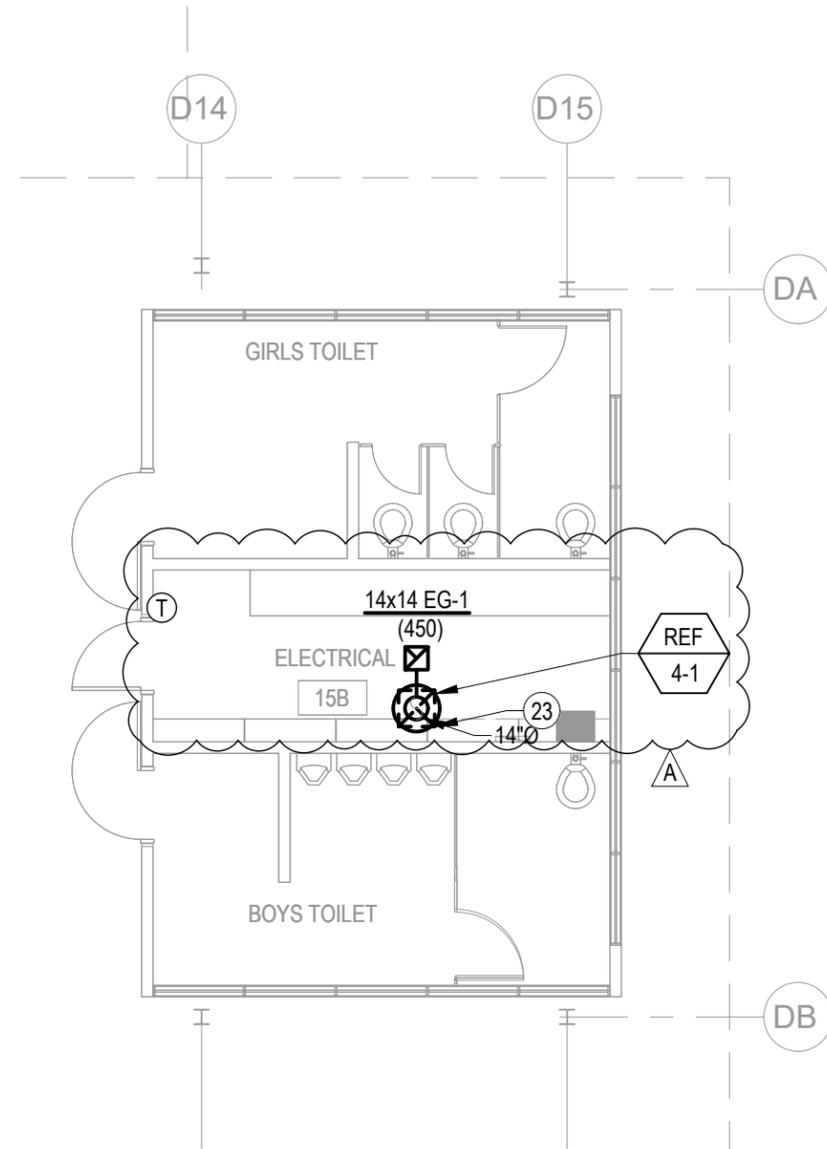

# NEW SHEET NOTES

23. INSTALL EXHAUST FAN ON ROOF.

4  
MP2.03

# PARTIAL FLOOR PLAN - WING 4 - NEW - MECHANICAL & PLUMBING

SCALE: 1/8" = 1'-0"




**CYPRESS**  
Engineering Group

831.218.1802  
8 Harris Court, Suite A8  
Monterey, CA 93940  
cypressseg.com

HVAC, Plumbing, Fire Protection  
Building Commissioning  
Industrial Refrigeration  
Environmental Compliance  
Training & Technical Support

CEG JOB NO: 21034


		GEORGE HALL ELEMENTARY SCHOOL - HVAC REPLACEMENT SAN MATEO-FOSTER CITY SCHOOL DISTRICT	
		FILE NO.: 41-26 APPL NO.: 01-119523 JOB NO.: 2021005.02 DATE: 11/19/2021	SHEET REF. SHEET MP2.03 <b>AD1-MP2.03b</b>
387 S. 1st Street, Suite 300 San Jose, CA., 95113		tel: (408) 300 - 5160 fax: (408) 300 - 5121	

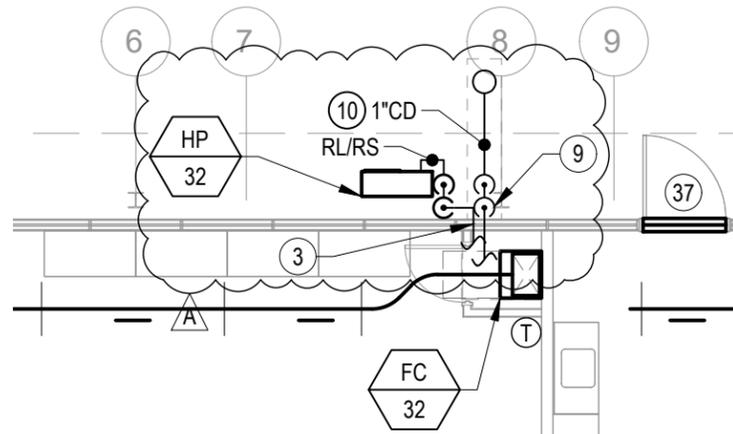

**GENERAL NOTES**

4. PAINT ALL EXPOSED DUCTWORK, SUPPORTS, AND REGISTERS TO MATCH ADJACENT.
5. PAINT CONDENSATE PIPING AT EXTERIOR OF BUILDING TO MATCH ADJACENT.

**1 PARTIAL FLOOR PLAN - ESCALON BLDG - NEW - MECHANICAL & PLUMBING**  
 MP2.04 SCALE: 1/8" = 1'-0"

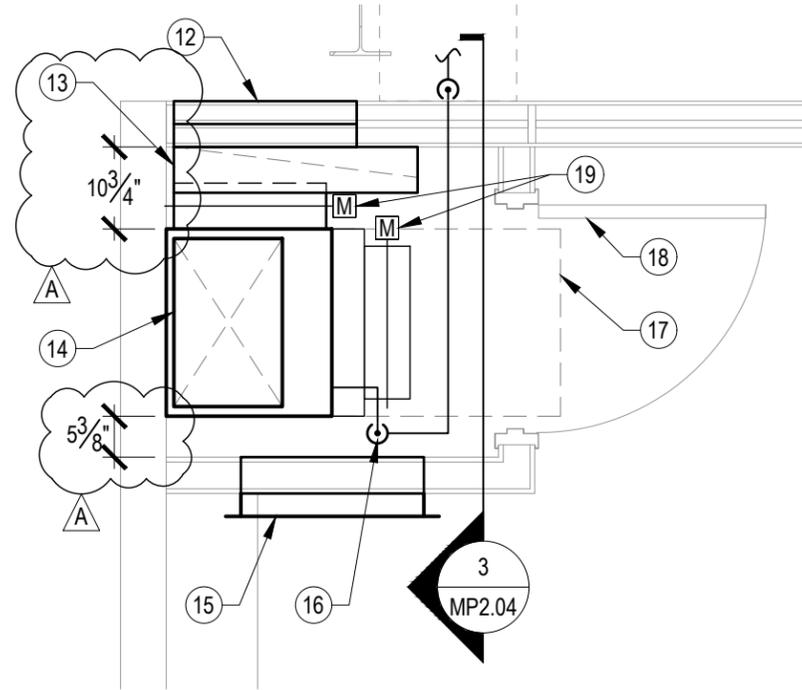

**2 FLOOR PLAN - ENCLOSURE**  
 MP2.04 SCALE: NONE




CEG JOB NO: 21034

**CYPRESS**  
Engineering Group

HVAC, Plumbing, Fire Protection  
 Building Commissioning  
 Industrial Refrigeration  
 Environmental Compliance  
 Training & Technical Support

831.218.1802  
 8 Harris Court, Suite A8  
 Monterey, CA 93940  
 cypressseg.com

	GEORGE HALL ELEMENTARY SCHOOL - HVAC REPLACEMENT  SAN MATEO-FOSTER CITY SCHOOL DISTRICT	
	FILE NO.: 41-26	SHEET REF. SHEET MP2.04
	APPL NO.: 01-119523	<b>AD1-MP2.04a</b>
	JOB NO.: 2021005.02 DATE 11/19/2021	
387 S. 1st Street, Suite 300 San Jose, CA., 95113		tel: (408) 300 - 5160 fax: (408) 300 - 5121

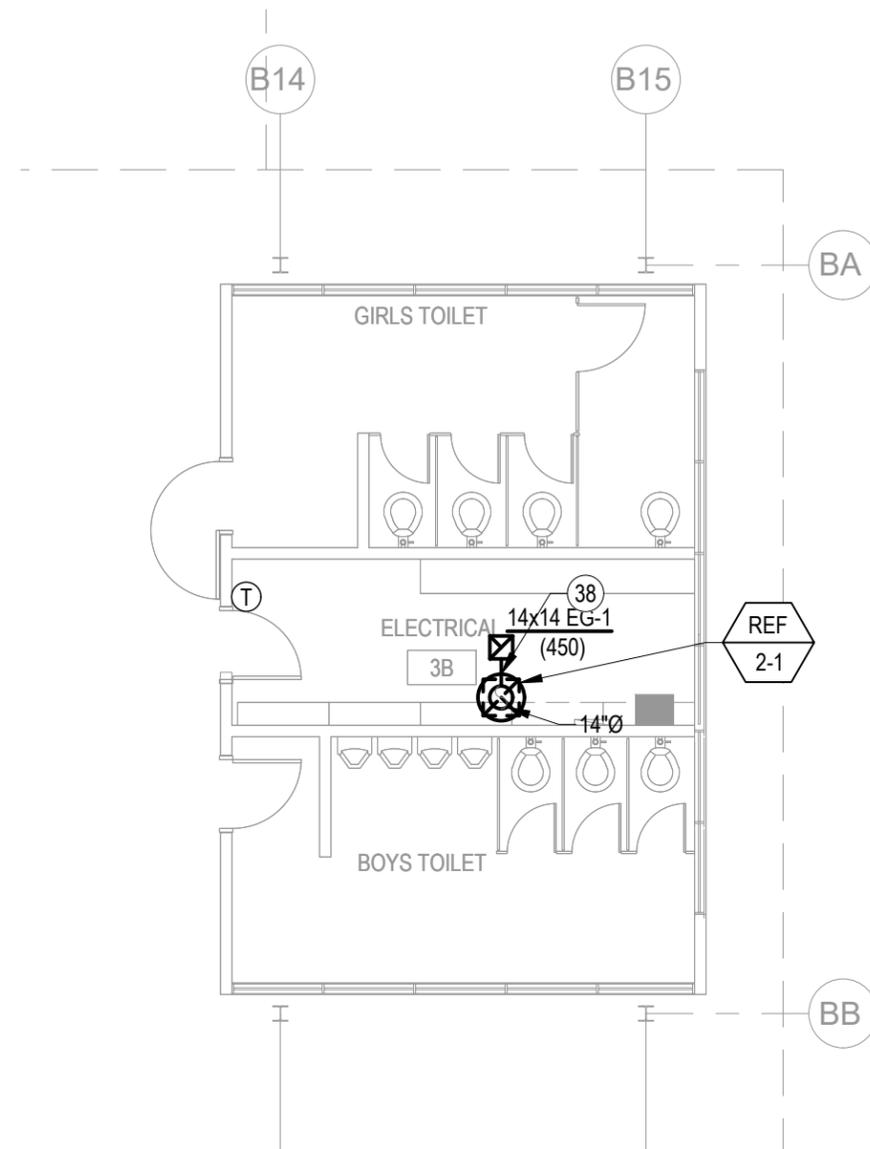

# NEW SHEET NOTES  
 38. INSTALL EXHAUST FAN ON ROOF.

5 PARTIAL FLOOR PLAN - WING 2 - NEW - MECHANICAL & PLUMBING  
 AD1-MP2.04 SCALE: 1/8" = 1'-0"



A

CEG JOB NO: 21034




**CYPRESS**  
 Engineering Group

HVAC, Plumbing, Fire Protection  
 Building Commissioning  
 Industrial Refrigeration  
 Environmental Compliance  
 Training & Technical Support

831.218.1802  
 8 Harris Court, Suite A8  
 Monterey, CA 93940  
 cypressseg.com

		GEORGE HALL ELEMENTARY SCHOOL - HVAC REPLACEMENT SAN MATEO-FOSTER CITY SCHOOL DISTRICT	
		FILE NO.: 41-26 APPL NO.: 01-119523 JOB NO.: 2021005.02 DATE: 11/19/2021	SHEET REF. SHEET MP2.04 <b>AD1-MP2.04b</b>
387 S. 1st Street, Suite 300 San Jose, CA., 95113		tel: (408) 300 - 5160 fax: (408) 300 - 5121	

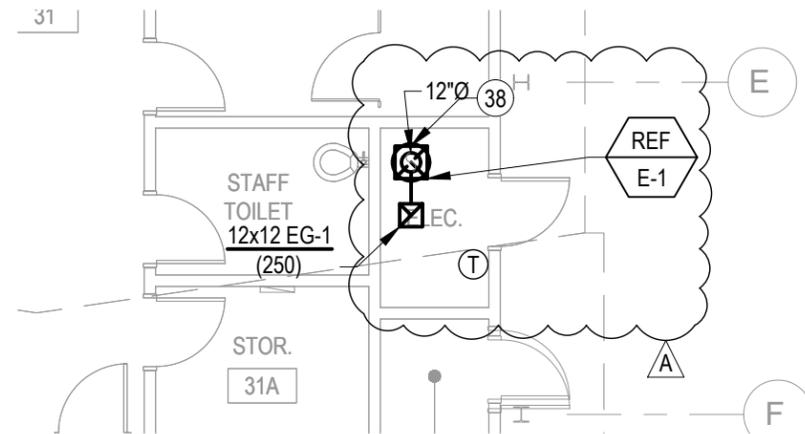

5  
MP2.04

# PARTIAL FLOOR PLAN - ESCALON BLDG - NEW - MECHANICAL & PLUMBING

SCALE: 1/8" = 1'-0"



**CYPRESS**  
Engineering Group

831.218.1802  
8 Harris Court, Suite A8  
Monterey, CA 93940  
cypressseg.com

HVAC, Plumbing, Fire Protection  
Building Commissioning  
Industrial Refrigeration  
Environmental Compliance  
Training & Technical Support

CEG JOB NO: 21034

**aedis**  
architects

387 S. 1st Street, Suite 300  
San Jose, CA., 95113


tel: (408) 300 - 5160  
fax: (408) 300 - 5121

GEORGE HALL ELEMENTARY SCHOOL -  
HVAC REPLACEMENT

SAN MATEO-FOSTER CITY SCHOOL DISTRICT

FILE NO.: 41-26  
APPL NO.: 01-119523  
JOB NO.: 2021005.02  
DATE 11/19/2021


SHEET  
REF. SHEET MP2.04  
**AD1-MP2.04c**

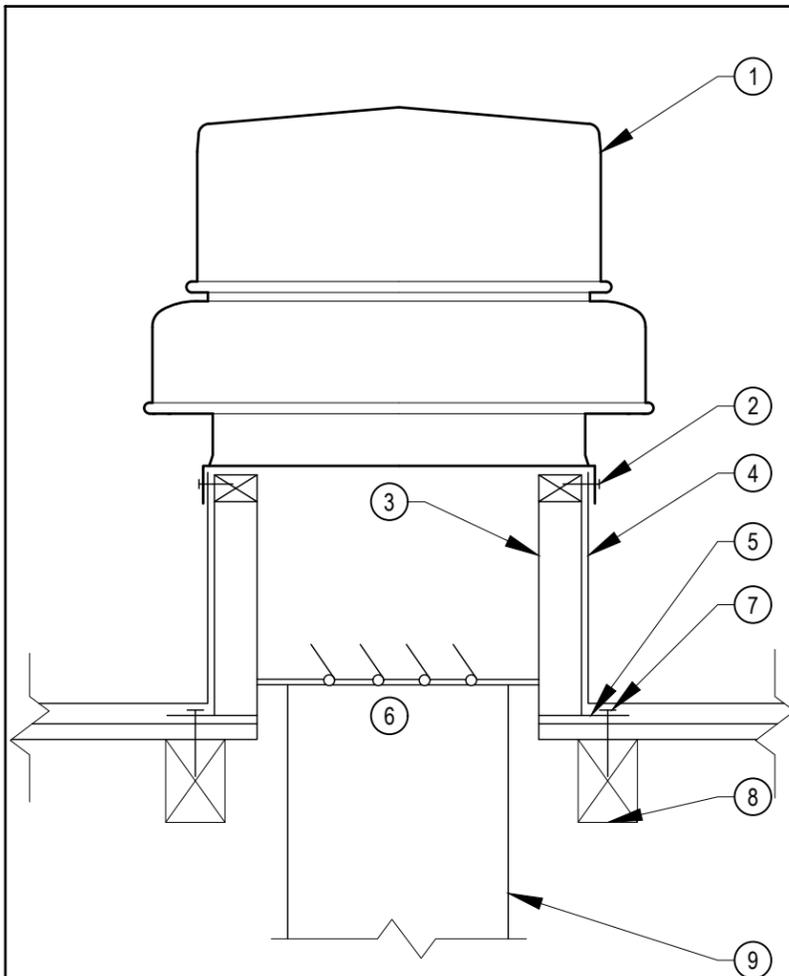

- **DETAIL NOTES:**
1. EXHAUST FAN.
  2. SECURE TO ROOF CURB WITH #12 SELF TAPPING SCREWS AT 12" ON CENTER. MINIMUM 2 PER SIDE.
  3. FACTORY CURB WITH NAILER.
  4. FOR ROOFING AND FLASHING, SEE ARCHITECT'S DRAWINGS.
  5. ROOF DECK.
  6. BACKDRAFT DAMPER.
  7. 3/8"Ø LAG SCREW THRU CURB AND ROOF WITH 3" MINIMUM EMBEDMENT INTO BLOCKING.
  8. 4x BLOCKING. SECURE TO STRUCTURE WITH SIMPSON HU44 HANGERS EACH END.
  9. DUCT SIZE PER PLAN

16 EXHAUST FAN MOUNTING

N.T.S.

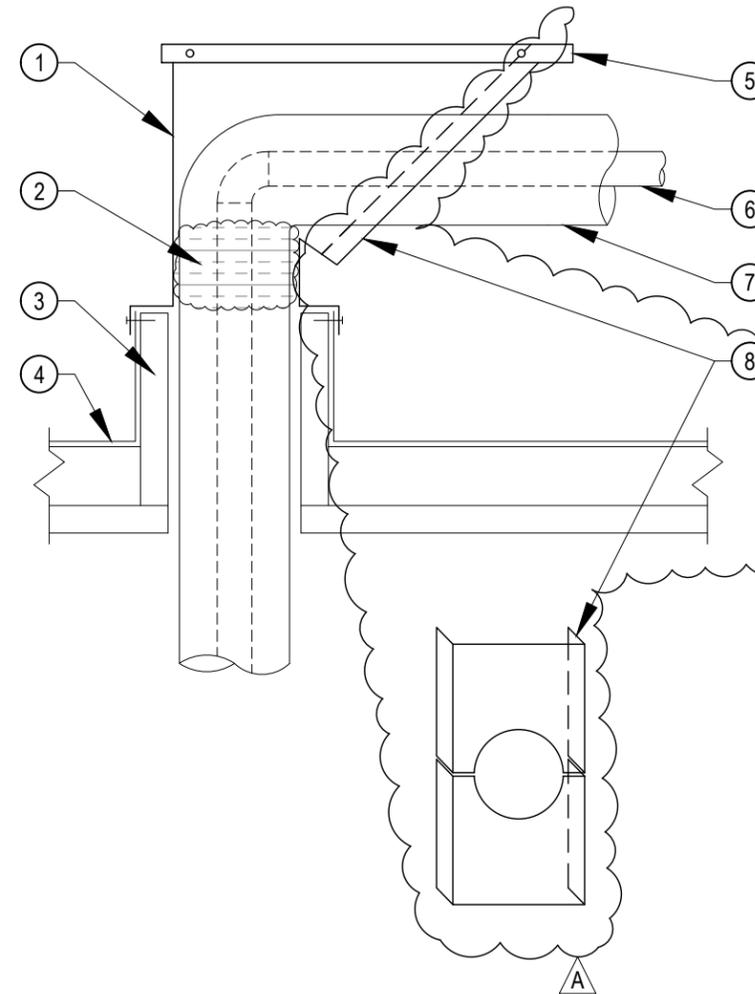

- **DETAIL NOTES:**
1. GALVANIZED SHEET METAL ROOF JACK WITH CAP.
  2. FILL OPENING WITH FOAM.
  3. ROOF OPENING. SEE STRUCTURAL DRAWING FOR CURB, SEE ARCHITECT'S DRAWINGS FOR FLASHING.
  4. ROOFING.
  5. REMOVABLE SHEET METAL COVER ATTACHED WITH TWO (2) #8 SELF TAPPING SCREWS EACH SIDE, PAINTED.
  6. PIPE.
  7. PIPE INSULATION.
  8. 2 PIECE 20 GA. GALVANIZED SHEET METAL COVER W/ 1-1/2" FLANGES ATTACHED W/ #12 SMS @4" O.C.

**NOTES:**

1. EXPOSED PIPING SHALL HAVE ALUMINUM JACKET.

4 PIPING ROOF JACK

N.T.S.



831.218.1802  
8 Harris Court, Suite A8  
Monterey, CA 93940  
cypressseg.com

HVAC, Plumbing, Fire Protection  
Building Commissioning  
Industrial Refrigeration  
Environmental Compliance  
Training & Technical Support

CEG JOB NO: 21034



387 S. 1st Street, Suite 300  
San Jose, CA., 95113



tel: (408) 300 - 5160  
fax: (408) 300 - 5121

GEORGE HALL ELEMENTARY SCHOOL -  
HVAC REPLACEMENT

SAN MATEO-FOSTER CITY SCHOOL DISTRICT

FILE NO.: 41-26  
APPL NO.: 01-119523  
JOB NO.: 2021005.02  
DATE 11/19/2021

SHEET  
REF. SHEET MP6.01  
**AD1-MP6.01**

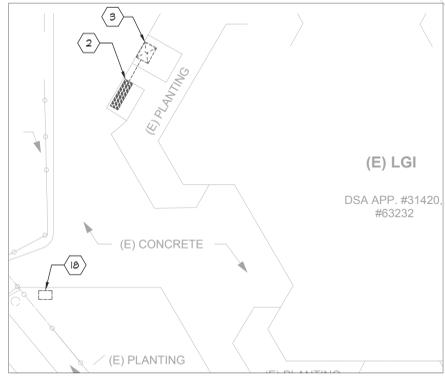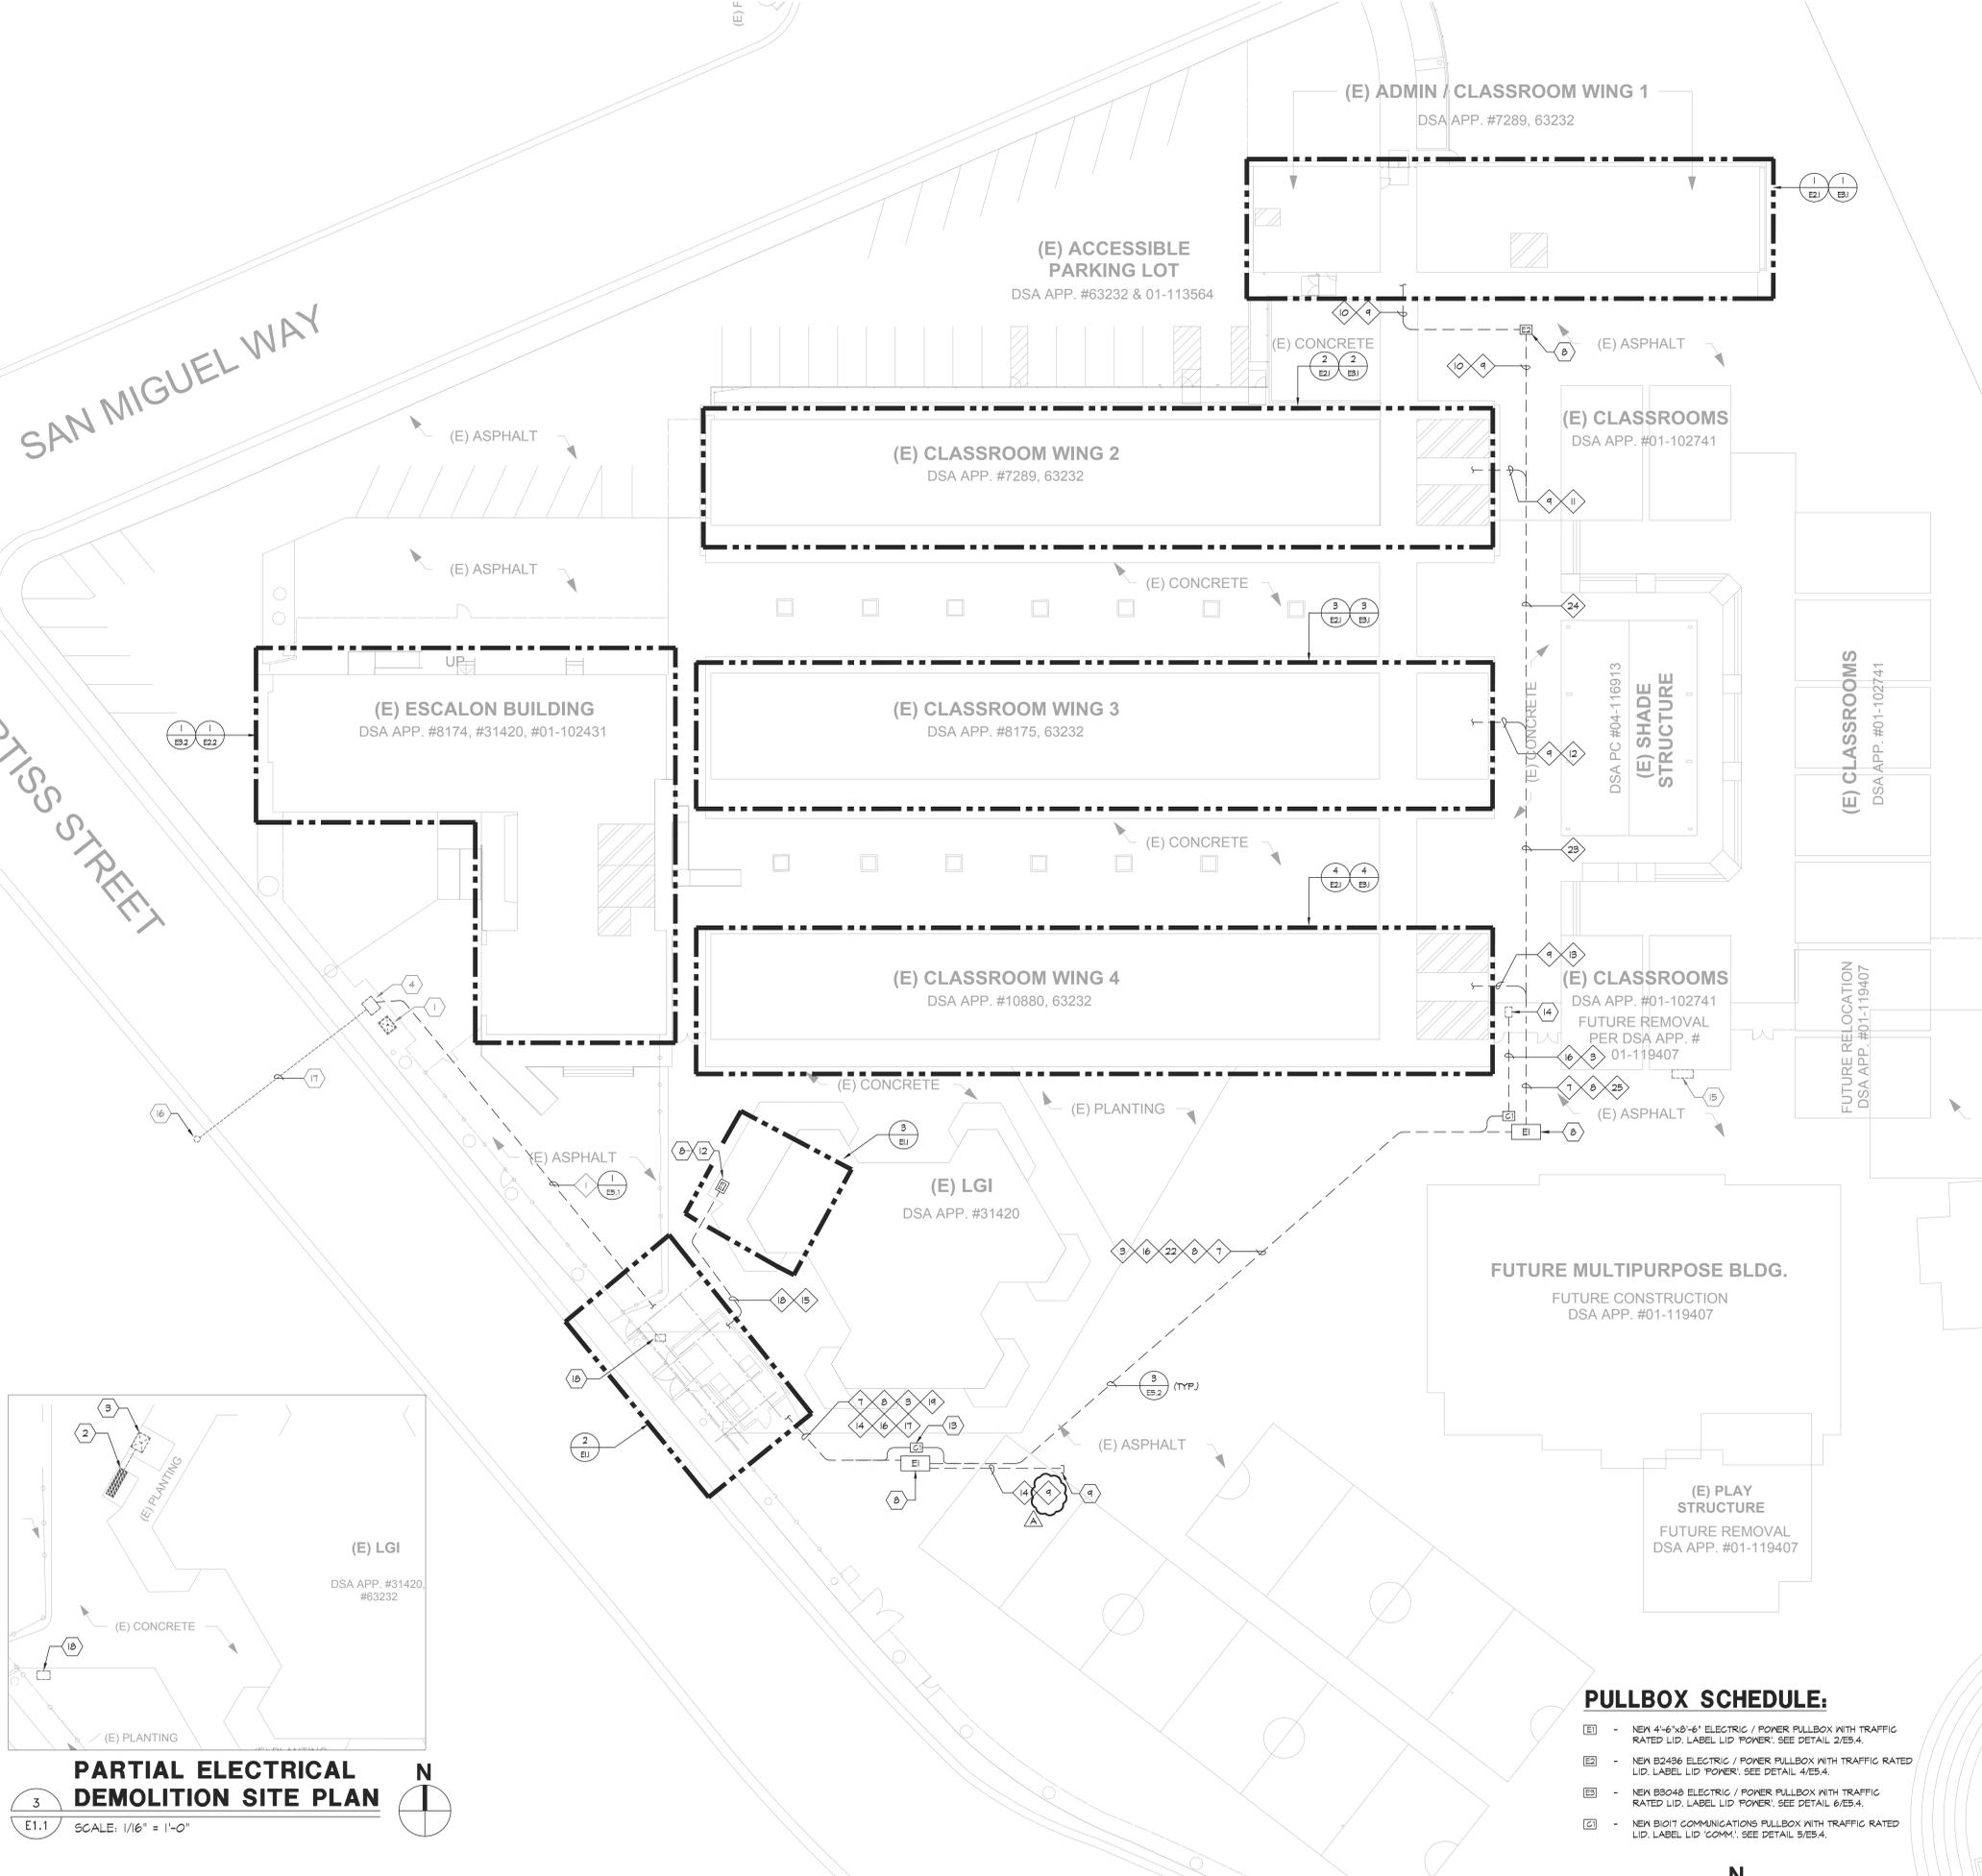

**PARTIAL ELECTRICAL DEMOLITION SITE PLAN**  
 E1.1 SCALE: 1/16" = 1'-0"

**ELECTRICAL SITE PLAN**  
 E1.1 SCALE: 1" = 20'-0"

- PULLBOX SCHEDULE:**
- ⓔ - NEW 4'-6"X8'-6" ELECTRIC / POWER PULLBOX WITH TRAFFIC RATED LID, LABEL LID 'POWER', SEE DETAIL 2/ES.4
  - ⓕ - NEW B2456 ELECTRIC / POWER PULLBOX WITH TRAFFIC RATED LID, LABEL LID 'POWER', SEE DETAIL 4/ES.4
  - ⓖ - NEW B9048 ELECTRIC / POWER PULLBOX WITH TRAFFIC RATED LID, LABEL LID 'POWER', SEE DETAIL 6/ES.4
  - ⓗ - NEW B1017 COMMUNICATIONS PULLBOX WITH TRAFFIC RATED LID, LABEL LID 'COMM', SEE DETAIL 5/ES.4

**GENERAL NOTES:**


1. CONTRACTOR SHALL COORDINATE UNDERGROUND REQUIREMENTS WITH ALL OTHER TRADES TO AVOID CONFLICTS.
2. CONTRACTOR SHALL BE RESPONSIBLE FOR ANY SAN CUTTING AND REMOVAL OF EXISTING SURFACES TO FACILITATE UNDERGROUND SYSTEMS. THE CONTRACTOR SHALL PATCH AND REPAIR ALL DAMAGED AND CUT SURFACES TO MATCH ADJACENT.
3. CONTRACTOR TO SITE SURVEY EXISTING CONDITIONS AND LOCATIONS OF EXISTING UNDERGROUND SYSTEMS, WHERE NEW TRENCH WORK OCCURS PRIOR TO BIDDING. CONTRACTOR SHALL TAKE PROPER PRECAUTIONS TO ENSURE EXISTING UNDERGROUND SYSTEMS/CONDUIT/PIPES ARE NOT DAMAGED DURING INSTALLATION. CONTRACTOR IS RESPONSIBLE FOR ANY REPAIRS REQUIRED IN THE EVENT THE EXISTING UNDERGROUND SYSTEMS ARE DAMAGED AS A RESULT OF THE NEW ELECTRICAL TRENCH WORK.
4. INSTALL P64E PRIMARY TRENCH PER 1/ ES.1.
5. INSTALL P64E SECONDARY TRENCH PER 5/ ES.1.
6. P64E TRANSFORMER PAD SHALL BE PER 2/ ES.1.
7. ALL ON SITE TRENCH SHALL BE INSTALLED PER 3/ ES.4.
8. SEE THE DEMO SINGLE LINE DIAGRAM FOR ADDITIONAL REQUIREMENTS.
9. SEE NEW SINGLE LINE DIAGRAM FOR FEEDER CABLE AND CONDUIT REQUIREMENTS.
10. THE CONTRACTOR SHALL MANDEREL THROUGH THE ENTIRE P64E CONDUIT SYSTEM, COORDINATE WITH P64E FOR ADDITIONAL REQUIREMENTS AND PROCEDURES.

**SHEET NOTES:**

- ① EXISTING P64E TRANSFORMER TO REMAIN.
- ② EXISTING 1200A MAIN SWITCHBOARD AND PAD TO BE DEMOLISHED AND REPLACED WITH AN IN-GRADE FULL BOX INTERCEPT LGI CONDUIT AT THIS LOCATION.
- ③ EXISTING P64E TRANSFORMER TO BE REMOVED BY P64E, DEMOLISH EXISTING TRANSFORMER PAD AND PATCH SURFACE TO MATCH EXISTING.
- ④ EXISTING P64E ABOVE GRADE SWITCH LOCATION TO REMAIN.
- ⑤ FUTURE FV DISCONNECT SWITCH.
- ⑥ FUTURE FV DISTRIBUTION PANEL.
- ⑦ NEW 2500A MAIN SWITCHBOARD.
- ⑧ NEW IN-GRADE ELECTRICAL FULL BOX, LABEL LID 'ELECTRICAL'.
- ⑨ STUB CONDUIT FOR FUTURE MU TO THIS LOCATION AND CAP FOR FUTURE USE.
- ⑩ (N) 1000A DISTRIBUTION PANEL 'DPI'.
- ⑪ (N) 300KVA TRANSFORMER 'T-DP'.
- ⑫ PROVIDE NEW FULL BOX IN PLACE OF THE EXISTING MAIN SWITCHBOARD, INTERCEPT THE EXISTING FEEDER AND CONDUIT FOR EXISTING PANEL 'L61', 'E' AND 'DP2' AT THIS LOCATION.
- ⑬ NEW SIGNAL FULL BOX LABEL LID 'SIGNAL'.
- ⑭ EXISTING SIGNAL FULL BOX STUB NEW CONDUIT INTO EXISTING BOX AS REQUIRED.
- ⑮ EXISTING PANEL 'DP2' TO REMAIN.
- ⑯ EXISTING P64E POLE TO REMAIN.
- ⑰ EXISTING P64E UNDERGROUND PRIMARY STREET CROSSINGS TO REMAIN.
- ⑱ EXISTING UNUSED UNDERGROUND IN-GRADE FULL BOX TO BE DEMOLISHED AND REMOVED, CAP EXISTING CONDUIT.

**CONDUIT SCHEDULE:**

- |  |  |
|--|--|
| ① (N) (1) 4" - P64E PRIMARY.                 | ⑭ (N) (4) 4" - (FUTURE MU BLDGS).        |
| ② (N) (7) 5" - P64E SECONDARY.               | ⑮ (N) (1) 4" - PANEL 'E'.                |
| ③ (N) (1) 1" - P64E COMMUNICATIONS.          | ⑯ (N) (1) 2" - FUTURE FV COMMUNICATIONS. |
| ④ (N) (2) 2.5" - XFMR 'DPI'.                 | ⑰ (N) (4) 4" - SPARE POWER.              |
| ⑤ (N) (2) 3" - FUTURE FV DISTRIBUTION PANEL. | ⑱ (N) (1) 4" - PANEL 'L61'.              |
| ⑥ (N) (3) 3" - PANEL 'DPI'.                  | ⑲ (N) (2) 4" - (E) PANEL 'DP2'.          |
| ⑦ (N) (1) 2.5" - XFMR 'AM'.                  | ⑳ (N) (2) 2.5" - SPARE.                  |
| ⑧ (N) (1) 2.5" - XFMR 'BM'.                  | ㉑ (1) (2) 2.5" - FUTURE FV.              |
| ⑨ (N) (1) 2.5" - XFMR 'CM'.                  | ㉒ (N) (2) 2.5" - FUTURE FV.              |
| ⑩ (N) (1) 2.5" - XFMR 'DM'.                  | ㉓ (N) (2) 4" - SPARE.                    |
| ⑪ (N) (1) 2.5" - XFMR 'DM'.                  | ㉔ (N) (1) 2.5" - XFMR 'AM'.              |
| ⑫ (N) (1) 2.5" - XFMR 'BM'.                  | ㉕ (N) (1) 2.5" - XFMR 'BM'.              |
| ⑬ (N) (1) 2.5" - XFMR 'CM'.                  | ㉖ (N) (1) 2.5" - XFMR 'CM'.              |
| ⑭ (N) (1) 2.5" - XFMR 'DM'.                  | ㉗ (N) (2) 2.5" - FUTURE FV.              |
|  | ㉘ (N) (4) 2.5" - FUTURE FV.              |

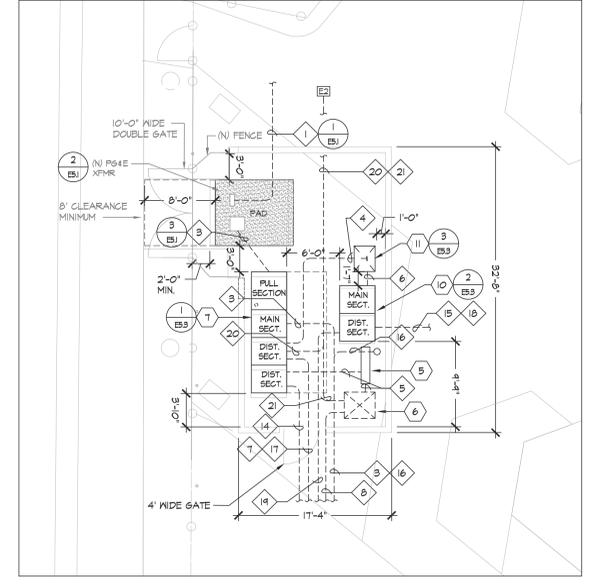

**ELECTRICAL SWITCHGEAR DIMENSIONS**  
 E1.1 SCALE: 1/8"=1'-0"



www.aedisarchitects.com  
 387 S. 1st Street, Suite 300  
 San Jose, CA 95113  
 t: (408) 300-5160  
 f: (408) 300-5121

PROJECT  
**GEORGE HALL ELEMENTARY SCHOOL - HVAC REPLACEMENT**

SAN MATEO-FOSTER CITY SCHOOL DISTRICT  
 CONSULTANT



American Consulting Engineers Electrical, Inc.  
 1990 The Alameda, Suite 202  
 San Jose, CA 95126  
 408/236-2312  
 Fax: 408/236-2314

STAMP  
 STATE FILE NUMBER  
 DSA APP. NUMBER 41-26  
 APPL. # 01-119523

REVISIONS  
 No. Description Date  
 Δ ADDENDUM 1 11/24/2021

MILESTONES  
 DD  
 90% CD  
 DSA SUB 05/21/2021  
 BACKCHECK 10/01/2021

SHEET  
**ELECTRICAL SITE PLAN**

DATE 11/24/2021  
 JOB # 2021005.02  
 SHEET # AD-1  
**E1.1**




**GENERAL NOTES:**

- CONTRACTOR SHALL REFER TO MECHANICAL DRAWINGS FOR ADDITIONAL DEMO REQUIREMENTS.
- EXISTING ELECTRICAL PANELS ARE TO REMAIN.
- SEE NEW ELECTRICAL FLOOR PLANS FOR ADDITIONAL REQUIREMENTS.
- SEE DEMO AND NEW SINGLE LINE DIAGRAMS FOR ADDITIONAL REQUIREMENTS.



**DEMOLITION SHEET NOTES:**

- EXISTING MECHANICAL UNIT TO BE DEMOLISHED. PULL EXISTING ELECTRICAL CIRCUITRY BACK TO SOURCE AND REMOVE. REMOVE ALL CONDUITS, J-BOXES AND DISCONNECT SWITCH ASSOCIATED WITH THE DEMOLISHED UNIT.
- EXISTING MECHANICAL UNIT AND CONNECTIONS TO REMAIN.
- EXISTING EXIT SIGN TO BE DISCONNECTED AND RELOCATED TO FACILITATE NEW WORK. EXISTING CIRCUITRY TO BE REUSED AND REPROGRAMMED.
- EXISTING LIGHT SOCKET AND FIXTURE TO BE DEMOLISHED AND REPLACED WITH NEW. EXISTING CIRCUITRY AND CONTROLS TO BE REUSED.
- THE EXISTING FIRE ALARM EQUIPMENT LOCATED ON THE WALL IS TO BE RELOCATED TO FACILITATE NEW WORK. RELOCATE EXISTING FIRE ALARM EQUIPMENT IN THE SAME ROOM OUTSIDE THE AREA OF THE NEW WORK. VERIFY EXISTING CIRCUITRY AND EXTEND AS REQUIRED.
- REMOVE ABANDONED AND UNUSED ELECTRICAL EQUIPMENT FROM THE WALL AT THIS LOCATION. COORDINATE WITH ARCHITECT.

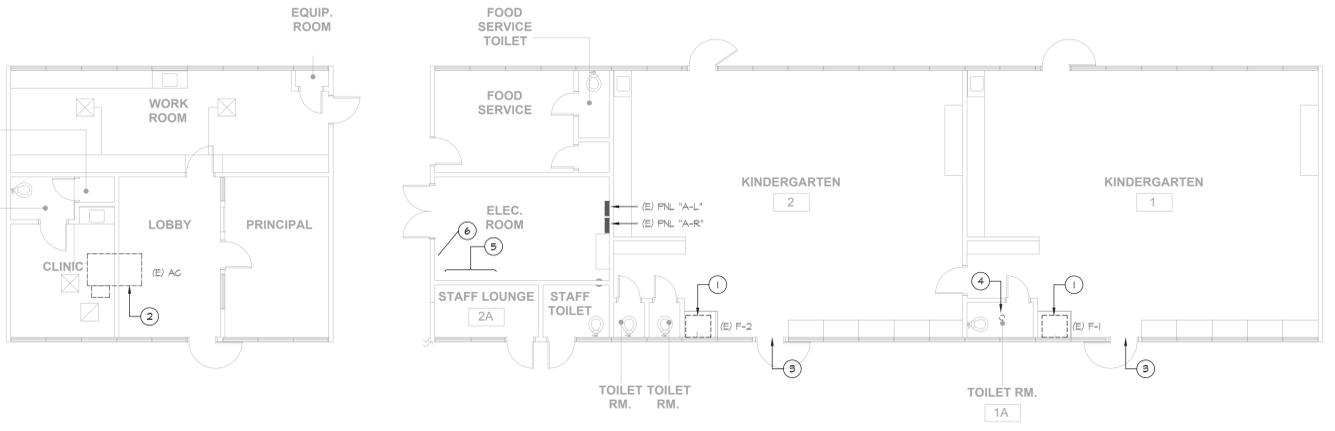



**1 ELECTRICAL DEMO FLOOR PLAN - WING #1**

E2.1 SCALE: 1/8" = 1'-0"

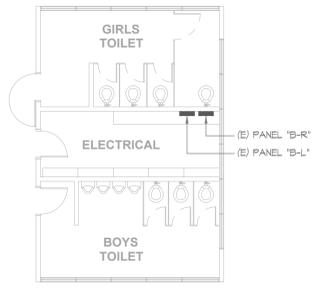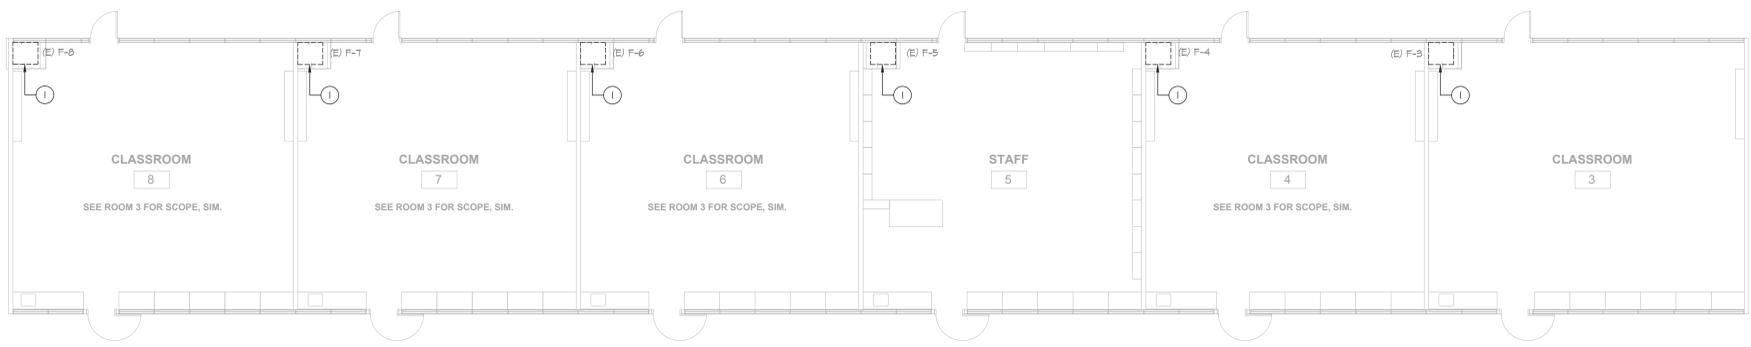



**2 ELECTRICAL DEMO FLOOR PLAN - WING #2**

E2.1 SCALE: 1/8" = 1'-0"

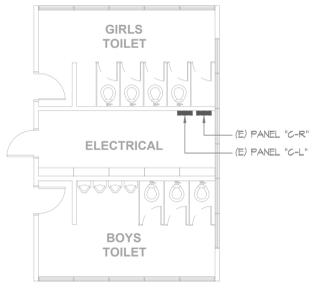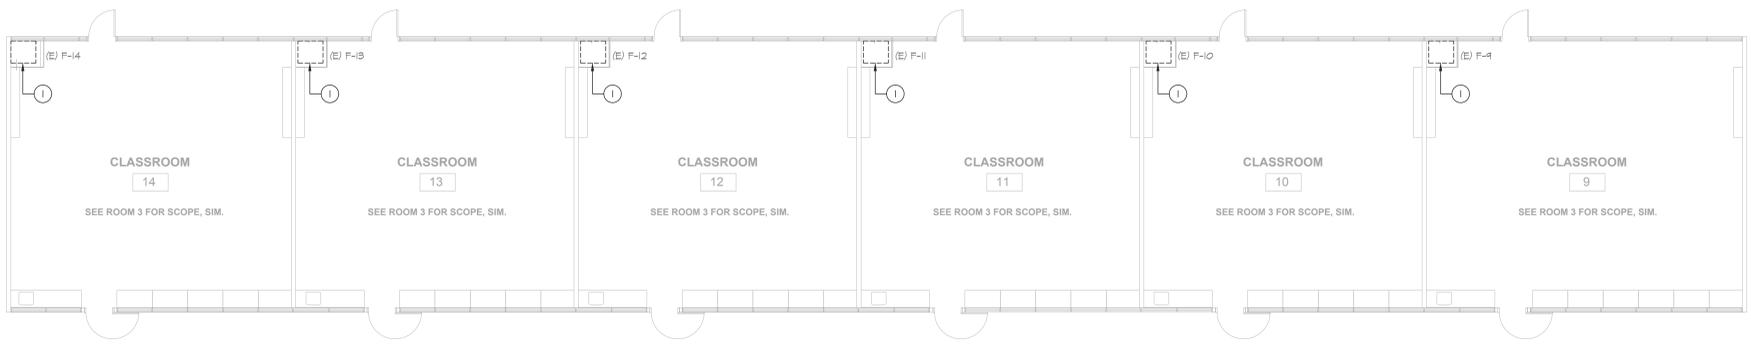

**3 ELECTRICAL DEMO FLOOR PLAN - WING #3**

E2.1 SCALE: 1/8" = 1'-0"

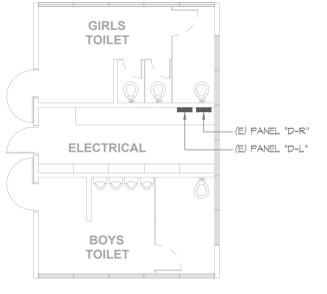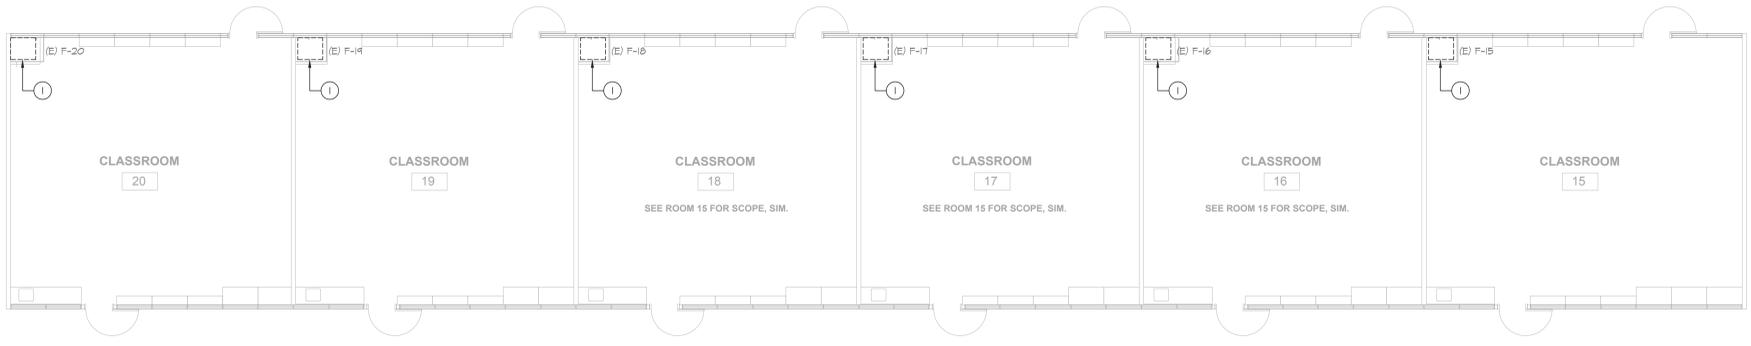


**4 ELECTRICAL DEMO FLOOR PLAN - WING #4**

E2.1 SCALE: 1/8" = 1'-0"



**BUILDING KEY**

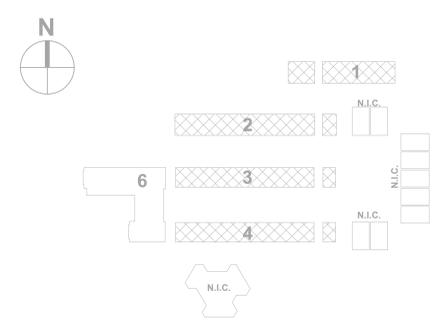

PROJECT  
**GEORGE HALL  
ELEMENTARY  
SCHOOL - HVAC  
REPLACEMENT**

SAN MATEO-FOSTER CITY  
SCHOOL DISTRICT  
CONSULTANT



**American Consulting Engineers  
Electrical, Inc.**  
1980 The Alameda, Suite 202  
San Jose, CA 95126  
JOB # E21-119523  
408/236-2312  
408/236-2318

STATE  
DSA FILE NUMBER **41-26**  
APPL # **01-119523**

REVISIONS


No.	Description	Date
▲	ADDENDUM 1	11/24/2021

MILESTONES

DD	
90% CD	
DSA SUB	05/21/2021
BACKCHECK	10/01/2021

SHEET  
**ELECTRICAL  
DEMO FLOOR  
PLANS -  
ESCALON BLDG  
& LGI**

DATE **11/24/2021**  
JOB # **2021005.02**  
SHEET # **AD-1  
E2.2**

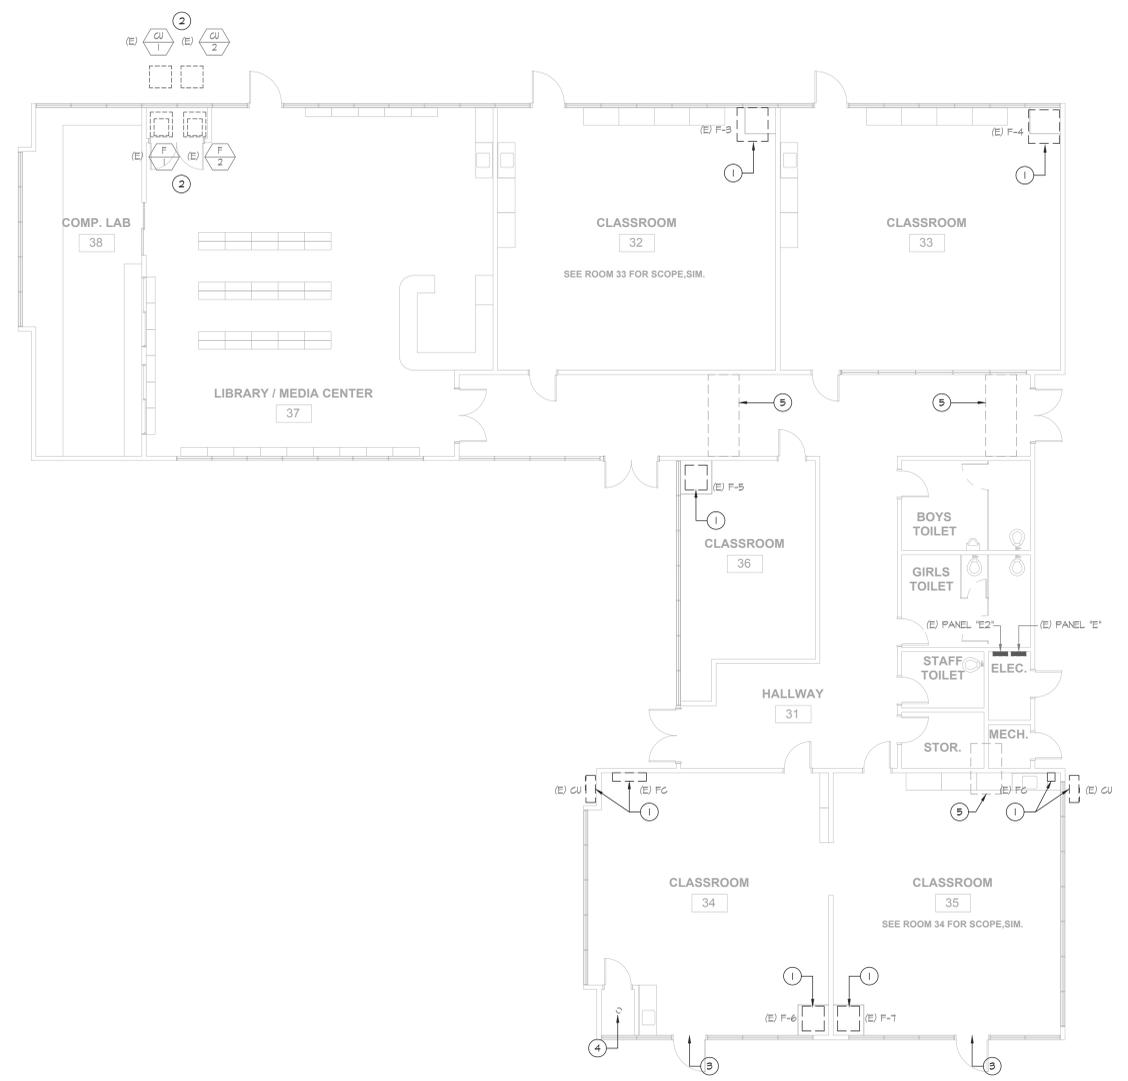

**1 ELECTRICAL DEMO FLOOR PLAN - ESCALON BLDG.**  
E2.2 SCALE: 1/8" = 1'-0"




**GENERAL NOTES:**


- CONTRACTOR SHALL REFER TO MECHANICAL DRAWINGS FOR ADDITIONAL DEMO REQUIREMENTS.
- EXISTING ELECTRICAL PANELS ARE TO REMAIN.
- SEE NEW ELECTRICAL FLOOR PLANS FOR ADDITIONAL REQUIREMENTS.
- SEE DEMO AND NEW SINGLE LINE DIAGRAMS FOR ADDITIONAL REQUIREMENTS.

**DEMOLITION SHEET NOTES:**

- EXISTING MECHANICAL UNIT TO BE DEMOLISHED. PULL EXISTING ELECTRICAL CIRCUITRY BACK TO SOURCE AND REMOVE. REMOVE ALL CONDUITS, J-BOXES AND DISCONNECT SWITCH ASSOCIATED WITH THE DEMOLISHED UNIT.
- EXISTING MECHANICAL UNIT AND CONNECTIONS TO REMAIN.
- EXISTING EXIT SIGN TO BE DISCONNECTED AND RELOCATED TO FACILITATE NEW WORK. EXISTING CIRCUITRY TO BE REVISED AND EXTENDED.
- EXISTING LIGHT SOCKET AND FIXTURE TO BE DEMOLISHED AND REPLACED WITH NEW. EXISTING CIRCUITRY AND CONTROLS TO BE REVISED.
- REMOVE CEILING FINISH AND ROUTE NEW CONDUITS CONCEALED IN CHASE. PATCH AND REPAIR.

**BUILDING KEY**

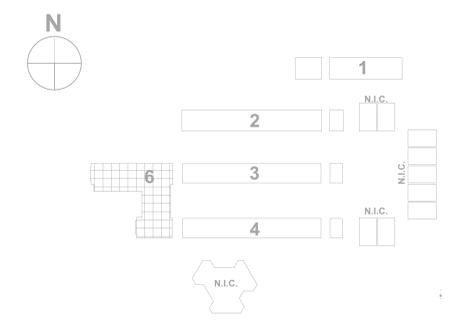

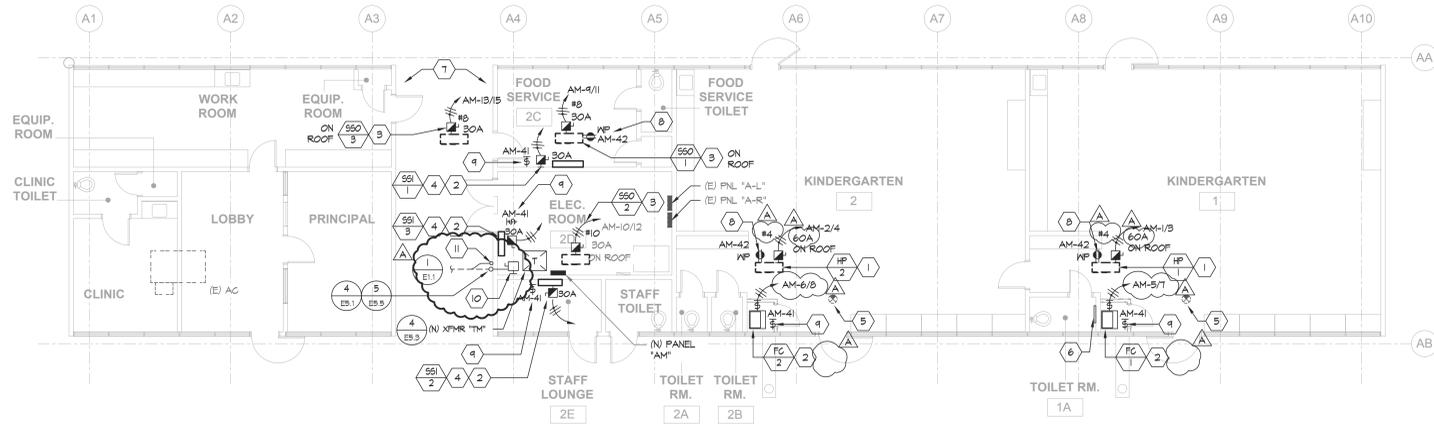

**GENERAL NOTES:**

1. ALL CONDUITS SHALL BE ROUTED CONCEALED IN CEILING BELOW WHERE POSSIBLE. ALL EXPOSED CONDUITS SHALL BE PAINTED.
2. CONTRACTOR SHALL COORDINATE EXACT LOCATIONS AND POINTS OF CONNECTION FOR MECHANICAL UNIT WITH MECHANICAL CONTRACTOR. ADJUST LOCATION AND CONNECTION POINTS AS NEEDED.
3. SEE PANEL SCHEDULES AND SINGLE LINE DIAGRAM FOR POWER CONNECTION REQUIREMENTS.
4. COORDINATE WITH ARCHITECTURAL AND MECHANICAL DRAWINGS FOR ADDITIONAL REQUIREMENTS.
5. FUSED AND UNFUSED DISCONNECT SWITCHES SHALL BE 600V RATED, HEAVY DUTY CYCLE. FUSES FOR MECHANICAL UNITS SHALL BE SIZED PER THE MANUFACTURER'S RECOMMENDATION.
6. PROVIDE CONDUIT ROOF PENETRATIONS REQUIRED. COORDINATE ROOF PENETRATION LOCATIONS WITH MECHANICAL'S PIPING ROOF PENETRATIONS. ROOF PENETRATION SHALL BE PER DETAIL 4/MP6.01.

**SHEET NOTES:**

- 1 NEW 60A/2P NEMA-3R, FUSED DISCONNECT SWITCH FOR MECHANICAL UNIT.
- 2 NEW 30A-2P, NEMA-1 (MOTOR-RATED) DISCONNECT SWITCH FOR MECHANICAL UNIT.
- 3 NEW 30A-2P, NEMA-3R, FUSED DISCONNECT SWITCH FOR MECHANICAL UNIT.
- 4 INDOOR UNIT IS POWER BY THE OUTDOOR UNIT. ROUTE HOMERUN CIRCUIT TO ASSOCIATED OUTDOOR UNIT. REFER TO MECHANICAL SCHEDULE MPO.02 FOR ADDITIONAL REQUIREMENTS.
- 5 EXISTING EXIT SIGN TO BE RELOCATED TO FACILITATE THE NEW MECHANICAL WORK. EXTEND EXISTING CIRCUITRY TO NEW LOCATION. RECONNECT AS REQUIRED.
- 6 PROVIDE NEW WALL MOUNTED LIGHT FIXTURE IN NEW LOCATION. FIXTURE SHALL BE H.E. WILLIAMS SLF-2119-955-HA-100. REUSE EXISTING CIRCUITRY AND LIGHTING CONTROLS. EXTEND WITH NEW CIRCUITRY AS REQUIRED.
- 7 MOUNT CONDUIT ADJACENT TO CHASE AND ROUTE ACROSS THE HALLWAY.
- 8 PROVIDE NEW WEATHERPROOF 6FCI RECEPTACLE. RECEPTACLE SHALL BE MOUNTED ON A WEATHERPROOF BOX WITH W/ILE-IN-USE COVER. COVER SHALL BE INTERMATIC INPQIMXD "BOSS".
- 9 PROVIDE MOTOR RATED SWITCH AND 120V POWER FOR CONDENSATION PUMP.
- 10 NEW 400A-3P, NEMA 1, UNFUSED DISCONNECT SWITCH.
- 11 STUB FUTURE SOLAR CONDUIT 18" ABOVE GRADE AT THIS APPROXIMATE LOCATION AND CAP.
- 12 PROVIDE 120V MOTOR RATED SWITCH FOR EXHAUST FAN. PROVIDE #10'S HOMERUN AND CONNECT TO CIRCUIT INDICATED. COORDINATE EXACT LOCATION WITH MECHANICAL DRAWINGS AND MECHANICAL CONTRACTOR.

**aedis**  
architects

www.aedisarchitects.com  
387 S. 1st Street, Suite 300  
San Jose, CA 95113  
t el: (408) 300-5160  
f ax: (408) 300-5121

PROJECT  
**GEORGE HALL  
ELEMENTARY  
SCHOOL - HVAC  
REPLACEMENT**


SAN MATEO-FOSTER CITY  
SCHOOL DISTRICT  
CONSULTANT



American Consulting Engineers  
Electrical, Inc.  
1990 The Alameda, Suite 200 San Jose, CA 95126  
408/236-2312  
408/236-2314  
JOB # E3.1/03100


**1 ELECTRICAL NEW FLOOR PLAN - WING #1**

E3.1 SCALE: 1/8" = 1'-0"

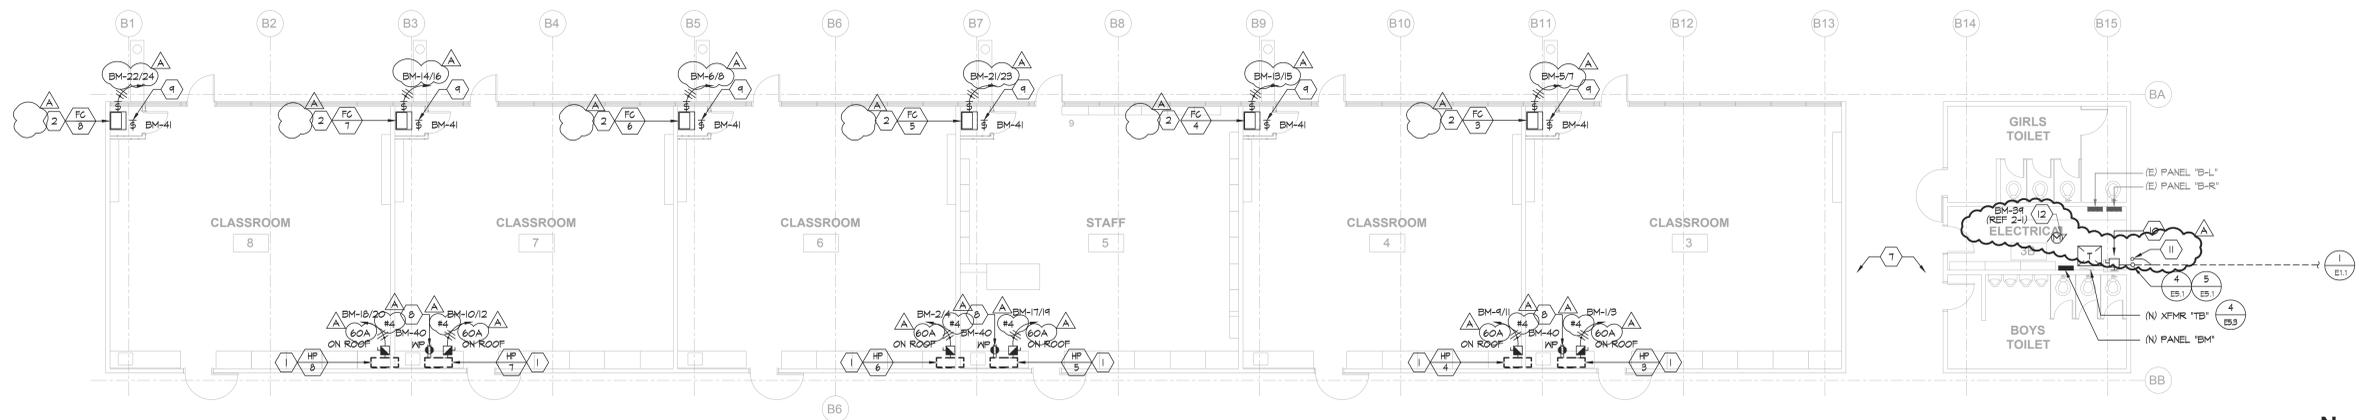


**2 ELECTRICAL NEW FLOOR PLAN - WING #2**

E3.1 SCALE: 1/8" = 1'-0"

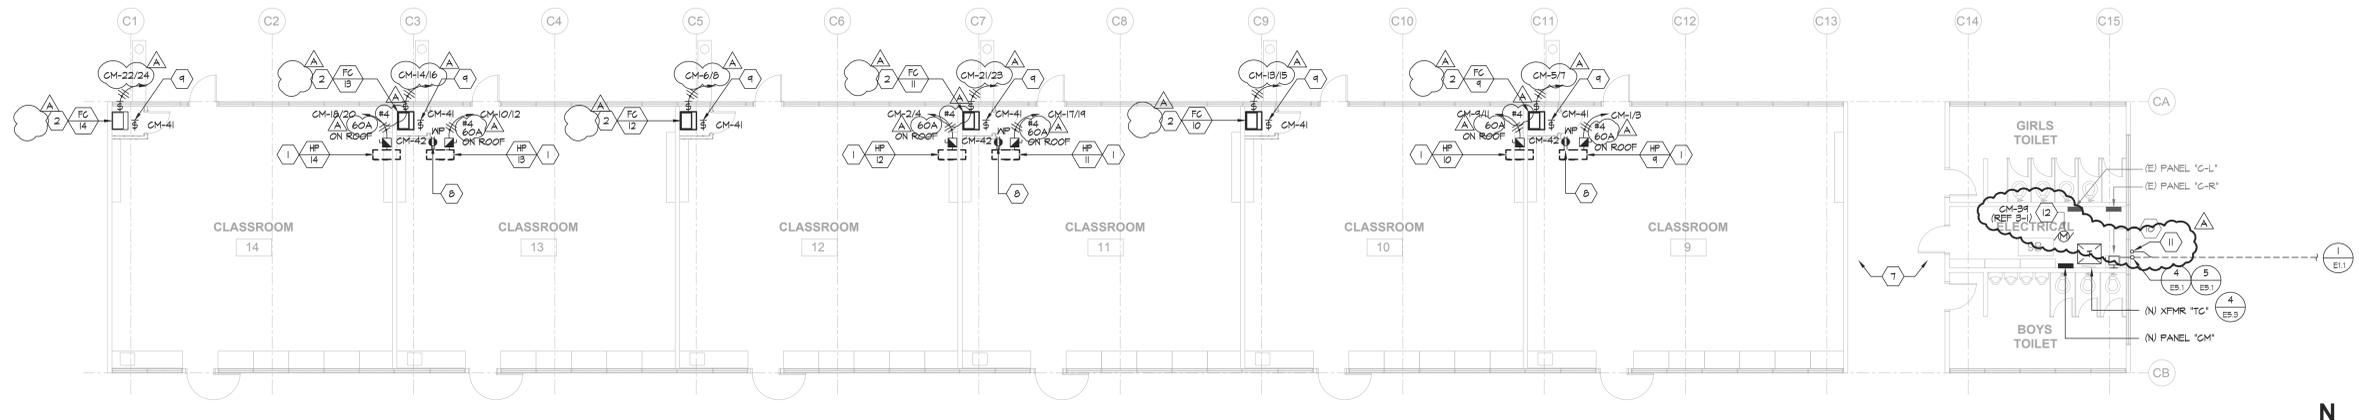

**3 ELECTRICAL NEW FLOOR PLAN - WING #3**


E3.1 SCALE: 1/8" = 1'-0"

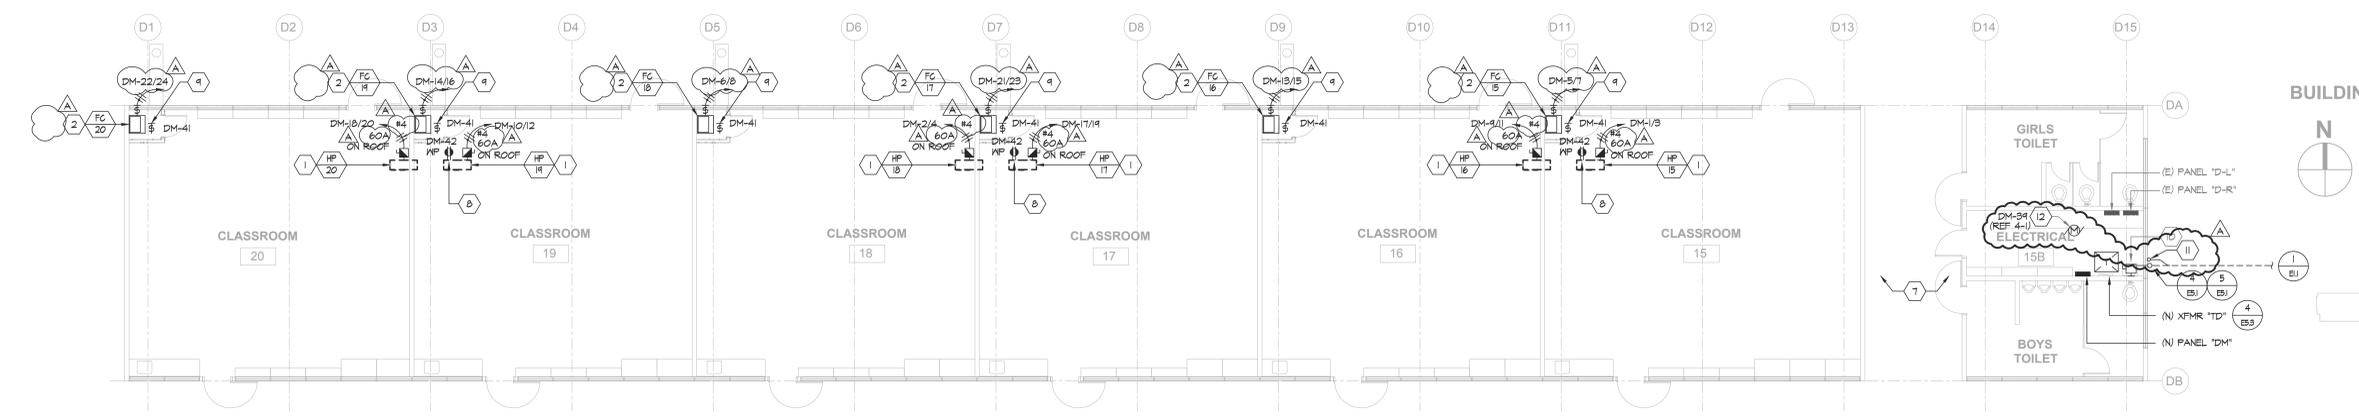

**4 ELECTRICAL NEW FLOOR PLAN - WING #4**

E3.1 SCALE: 1/8" = 1'-0"

**BUILDING KEY**

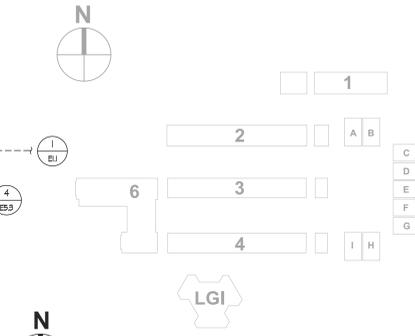

STAMP

STATE  
DSA FILE NUMBER 41-26  
APPL # 01-119523

REVISIONS

No.	Description	Date
ADDENDUM 1		11/24/2021


MILESTONES

DD	
90% CD	
DSA SUB	05/21/2021
BACKCHECK	10/01/2021

SHEET  
**ELECTRICAL NEW  
FLOOR PLANS -  
WINGS #1, #2, #3,  
#4 AND TYP.  
RELOCATABLE**

DATE 11/24/2021  
JOB # 2021005.02  
SHEET #

**E3.1**

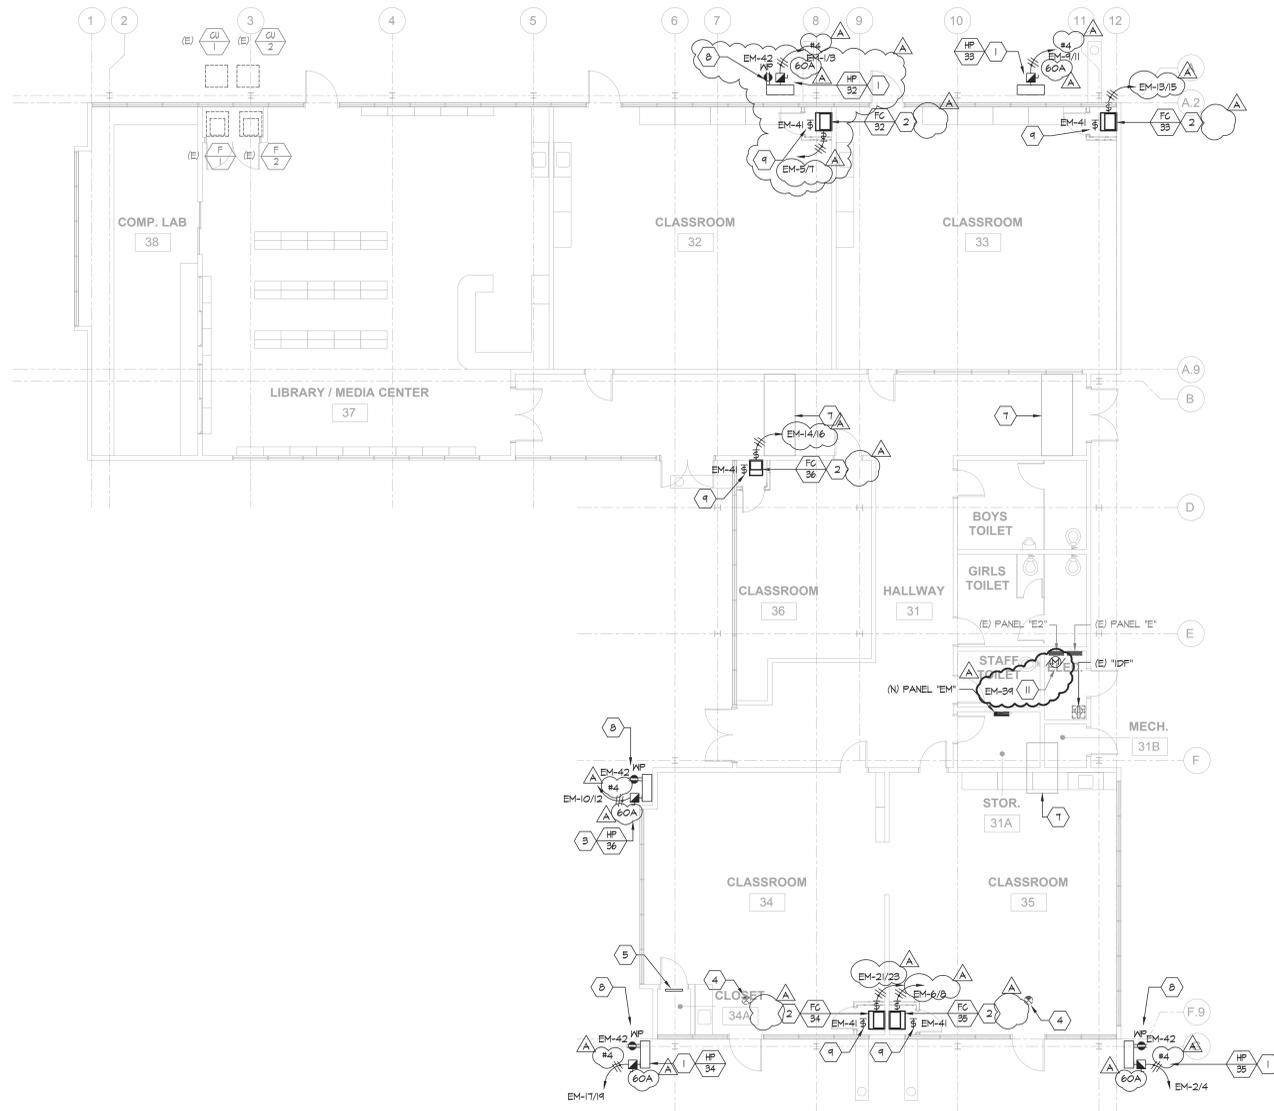

**1 ELECTRICAL NEW FLOOR PLAN - ESCALON BLDG.**  
 E3.2 SCALE: 1/8" = 1'-0"


**GENERAL NOTES:**

1. ALL CONDUITS SHALL BE ROUTED CONCEALED IN CEILING BELOW WHERE POSSIBLE.
2. CONTRACTOR SHALL COORDINATE EXACT LOCATIONS AND POINTS OF CONNECTION FOR MECHANICAL UNIT WITH MECHANICAL CONTRACTOR. ADJUST LOCATION AND CONNECTION POINTS AS NEEDED.
3. SEE PANEL SCHEDULES AND SINGLE LINE DIAGRAM FOR PANEY CONNECTION REQUIREMENTS.
4. COORDINATE WITH ARCHITECTURAL AND MECHANICAL DRAWINGS FOR ADDITIONAL REQUIREMENTS.
5. FUSED DISCONNECT SWITCHES SHALL BE 600V RATED, HEAVY DUTY CYCLE. FUSES FOR MECHANICAL UNITS SHALL BE SIZED PER THE MANUFACTURER'S RECOMMENDATION.
6. PROVIDE CONDUIT ROOF PENETRATIONS REQUIRED. COORDINATE ROOF PENETRATION LOCATIONS WITH MECHANICAL'S PIPING ROOF PENETRATIONS. ROOF PENETRATION SHALL BE PER DETAIL 4/M/6/01.

**SHEET NOTES:**

1. NEW 60A-2P NEMA-3R FUSED DISCONNECT SWITCH FOR MECHANICAL UNIT.
2. NEW 30A-2P NEMA-1 (MOTOR-RATED) DISCONNECT SWITCH FOR MECHANICAL UNIT.
3. NEW 30A-2P NEMA-3R FUSED DISCONNECT SWITCH FOR MECHANICAL UNIT.
4. EXISTING EXIT SIGN TO BE RELOCATED TO FACILITATE THE NEW MECHANICAL WORK. EXTEND EXISTING CIRCUITRY TO NEW LOCATION. RECONNECT AS REQUIRED.
5. PROVIDE NEW WALL MOUNTED LIGHT FIXTURE IN NEW LOCATION. FIXTURE SHALL BE H.E. WILLIAMS SLF-2113-835-HA-120. REUSE EXISTING CIRCUITRY AND LIGHTING CONTRLS. EXTEND WITH NEW CIRCUITRY AS REQUIRED.
6. ROUTE CONDUIT EXPOSED ON CEILING TO NEW PANEL.
7. PATCH AND REPAIR CEILING CHASE WHERE DEMO WORK OCCURRED.
8. PROVIDE NEW WEATHERPROOF 6FCI RECEPTACLE. RECEPTACLE SHALL BE MOUNTED ON A WEATHERPROOF BOX WITH WHILE-IN-USE COVER. COVER SHALL BE INTERMATIC WPDIMXD "BOSS".
9. PROVIDE MOTOR RATED SWITCH AND 120V POWER FOR CONDENSATION PUMP.
10. NOT USED.
11. PROVIDE 120V MOTOR RATED SWITCH FOR EXHAUST FAN. PROVIDE #10'S HOMERUN AND CONNECT TO CIRCUIT INDICATED. COORDINATE EXACT LOCATION WITH MECHANICAL DRAWINGS AND MECHANICAL CONTRACTOR.

**BUILDING KEY**

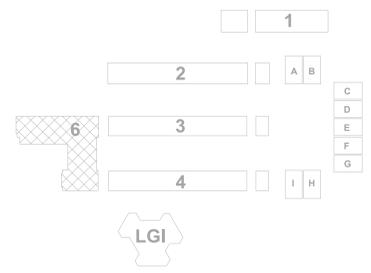

PROJECT  
**GEORGE HALL  
 ELEMENTARY  
 SCHOOL - HVAC  
 REPLACEMENT**

SAN MATEO-FOSTER CITY  
 SCHOOL DISTRICT  
 CONSULTANT



American Consulting Engineers  
 Electrical, Inc.  
 1980 The Alameda, Suite 207  
 San Jose, CA 95126  
 JOB # E32103300  
 408/236-2312  
 Fax: 408/236-2314

STAMP

STATE  
 DSA FILE NUMBER **41-26**  
 APPL # **01-119523**

REVISIONS


No.	Description	Date
1	ADDENDUM 1	11/24/2021

MILESTONES

DD	
90% CD	
DSA SUB	05/21/2021
BACKCHECK	10/01/2021

SHEET  
**ELECTRICAL NEW  
 FLOOR PLANS -  
 ESCALON BLDG  
 & LGI**

DATE **11/24/2021**  
 JOB # **2021005.02**  
 SHEET # **AD-1  
 E3.2**

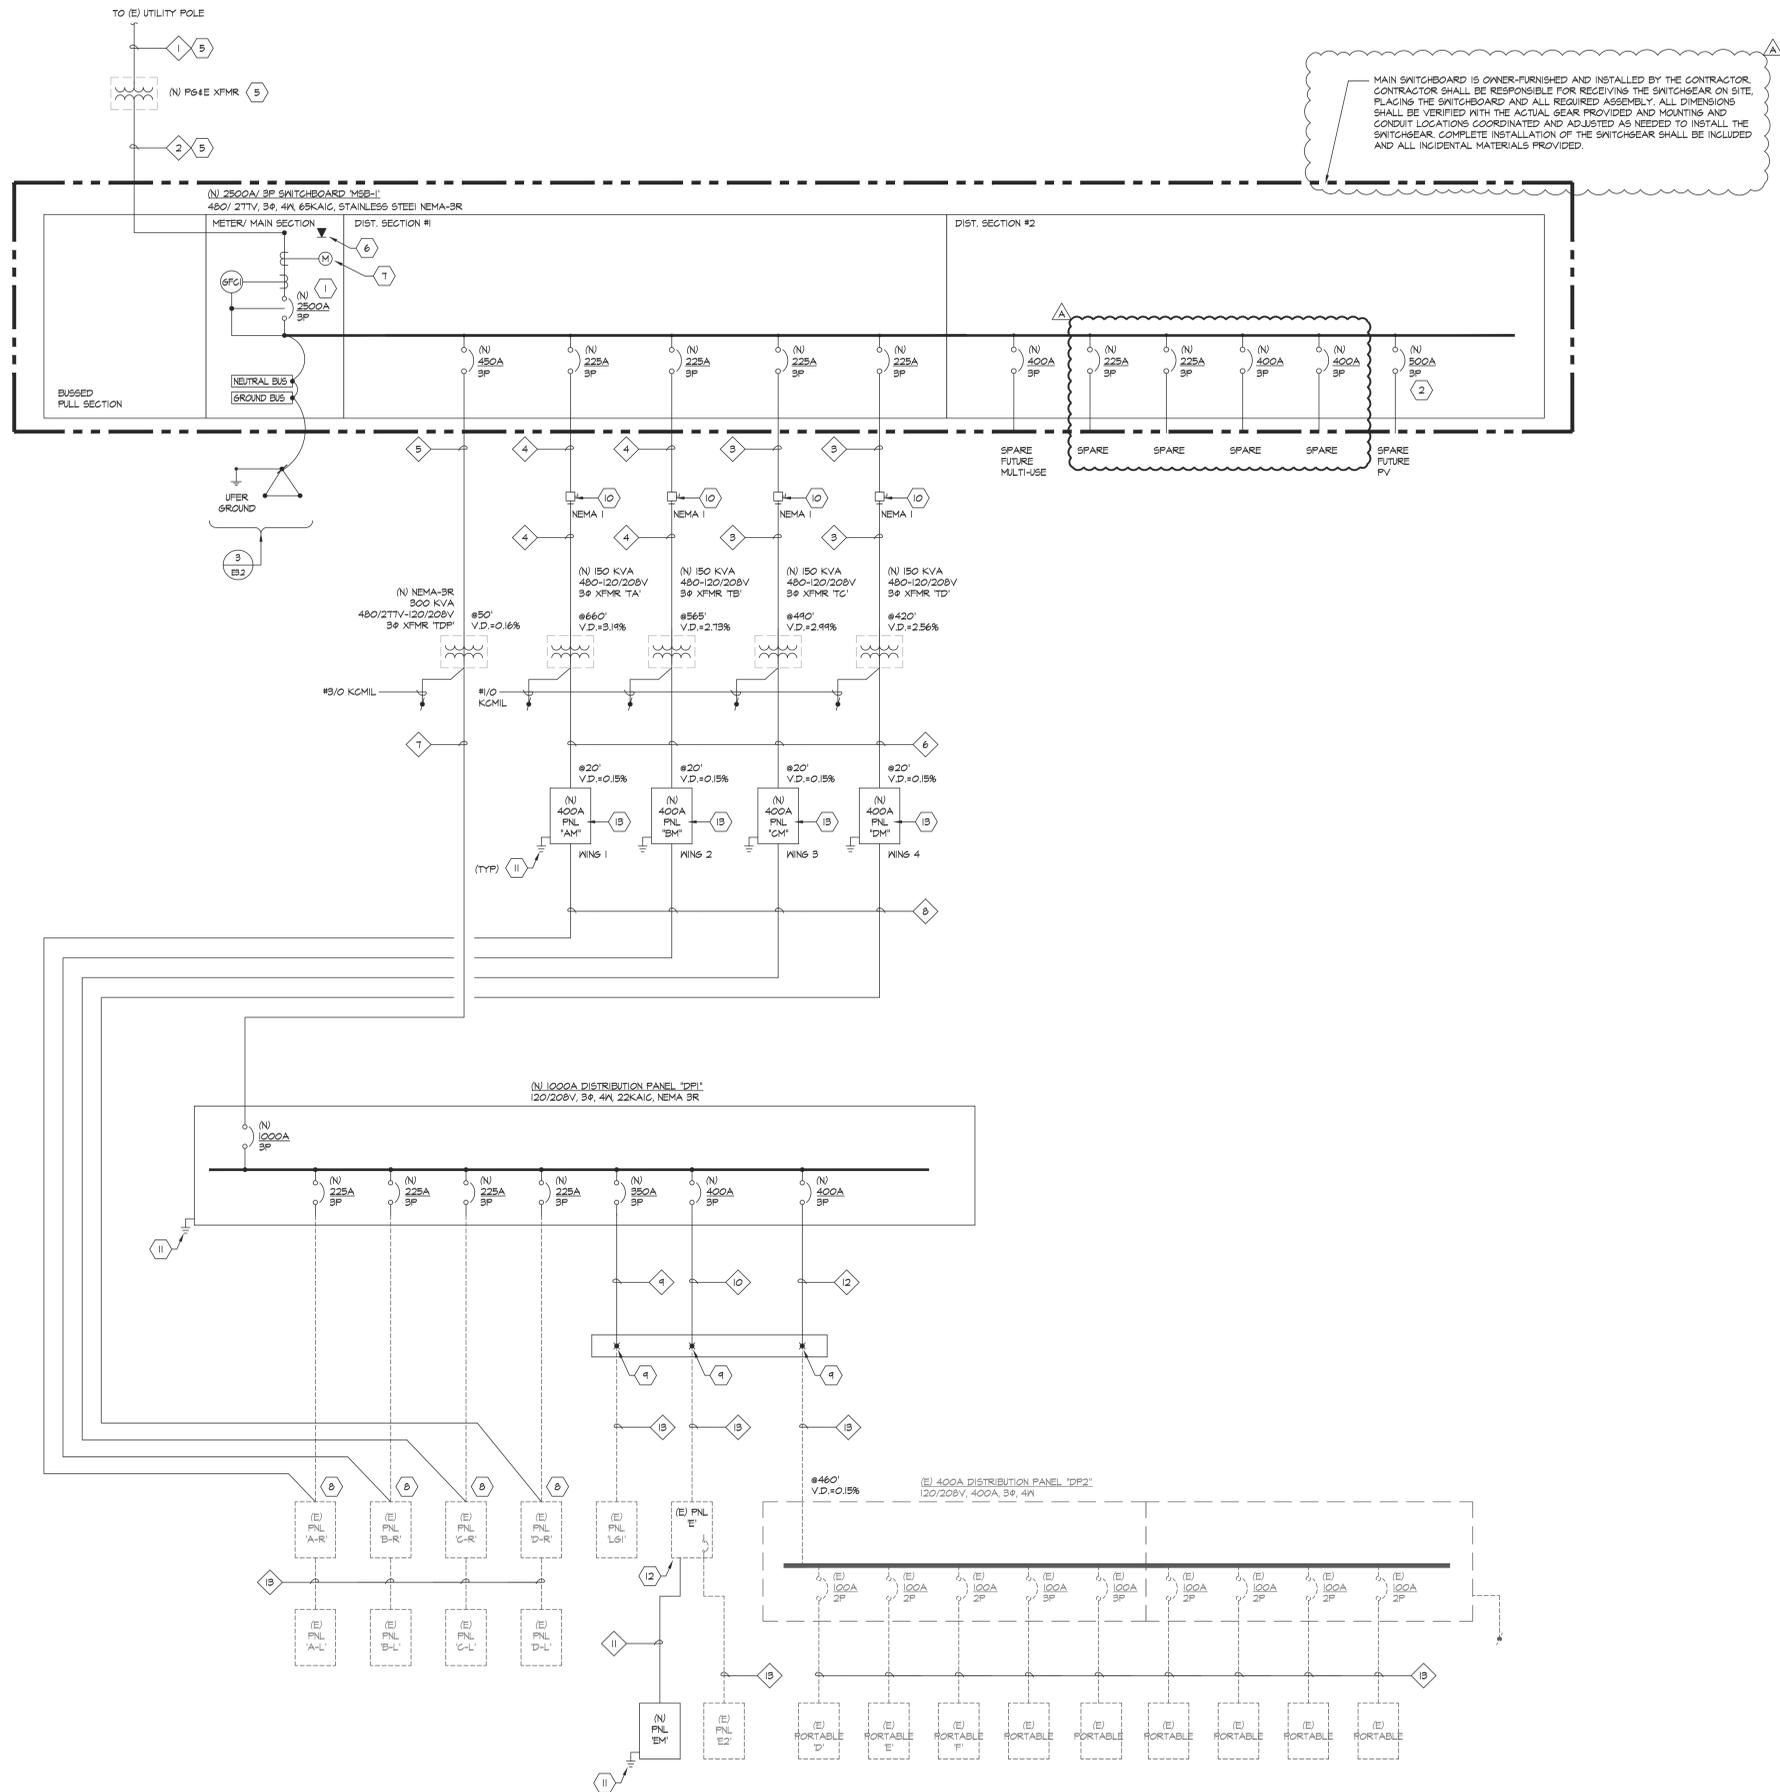

MAIN SWITCHBOARD IS OWNER-FURNISHED AND INSTALLED BY THE CONTRACTOR. CONTRACTOR SHALL BE RESPONSIBLE FOR RECEIVING THE SWITCHGEAR ON SITE. PLACING THE SWITCHBOARD AND ALL REQUIRED ASSEMBLY. ALL DIMENSIONS SHALL BE VERIFIED WITH THE ACTUAL GEAR PROVIDED AND MOUNTING AND CONDUIT LOCATIONS COORDINATED AND ADJUSTED AS NEEDED TO INSTALL THE SWITCHGEAR. COMPLETE INSTALLATION OF THE SWITCHGEAR SHALL BE INCLUDED AND ALL INCIDENTAL MATERIALS PROVIDED.

**GENERAL NOTES:**

- SEE DETAIL 2/EB 2 FOR GRONDING AT SWITCHBOARD ENCLOSURE REQUIREMENTS.
- SEE DETAIL 3/EB 2 FOR MAIN SWITCHBOARD GRONDING REQUIREMENTS.
- SEE DETAIL 5/EB 2 FOR TRANSFORMER GRONDING REQUIREMENTS.
- ALL TRANSFORMERS SHALL BE CLASS 155 INSULATION - COMPLETELY ENCLOSED EXCEPT FOR VENTILATION.
- SEE ENLARGED SWITCHGEAR PLAN FOR ADDITIONAL REQUIREMENTS.
- THE CONTRACTOR SHALL OBTAIN THE P64E SUBSTRUCTURE PACKAGE PRIOR TO ANY RELATED WORK. THE CONTRACTOR SHALL COORDINATE ALL P64E INSTALLATION REQUIREMENTS WITH P64E GREENBOOK AND P64E SUBSTRUCTURE PACKAGE.
- SEE THE ENLARGED SITE DEMO SITE PLAN AND DEMO SINGLE LINE DIAGRAM FOR ADDITIONAL INFORMATION.
- PROVIDE THE REQUIRED ARC FLASH HAZARD WARNING LABEL TO MEET THE REQUIREMENTS OF CEC 110.16. SEE SPECIFICATIONS FOR ADDITIONAL REQUIREMENTS.
- PROVIDE MAINTENANCE SWITCH FOR ARC ENERGY REDUCTION TO MEET THE REQUIREMENTS OF CEC 240.81.

**SHEET NOTES:**

- MAIN BREAKER SHALL BE 6FCI PER CEC.
- PV BREAKER TO BE INSTALLED AT THE FURTHEST POINT ON THE BUS BAR.
- INTERCEPT EXISTING FEEDER CONDUIT WITH NEW CONDUIT. CONTRACTOR TO VERIFY EXACT (E) CONDUIT SIZES AND MATCH AS REQUIRED TO INTERCEPT. EXTEND (N) CONDUITS AND FEEDERS TO (N) XFMR 'TA'. SEE SITE PLAN FOR APPROXIMATE LOCATION. SITE VERIFY EXACT LOCATIONS.
- CONNECT NEW FEEDERS TO (E) 800A DISTRIBUTION PANEL. CONTRACTOR SHALL PROVIDE EQUIPMENT REQUIRED TO TERMINATE NEW FEEDERS. SEE SITE PLAN FOR APPROXIMATE LOCATION. SITE VERIFY EXACT LOCATION.
- INSTALL PER P64E AND P64E GREENBOOK REQUIREMENTS.
- PROVIDE TWO DEDICATED TELEPHONE LINES FROM THE MAIN SWITCHBOARD TO THE TELEPHONE MPOE PER P64E REQUIREMENTS. MOUNT TELEPHONE OUTLETS INSIDE METER SECTION FOR THE MAIN SWITCHBOARD BEHIND THE SWITCHBOARDS DOORS. MOUNT IN NEMA-3R JUNCTION BOX.
- PROVIDE P64E METER PER P64E REQUIREMENTS.
- COORDINATE THE DISCONNECT AND REMOVAL OF THE EXISTING FEEDERS WITH THE PROJECT SCHEDULE AFTER REMOVAL OF EXISTING FEEDER AND CONDUITS. CONTRACTOR SHALL RECONNECT PANEL WITH NEW FEEDERS AND CONDUIT AS SHOWN.
- PROVIDE INGRADE PULL BOX TO INTERCEPT EXISTING FEEDER CIRCUIT. PROVIDE POLARIS SUBMERSIBLE SPLICE. SEE SITE PLAN FOR ADDITIONAL REQUIREMENTS.
- PROVIDE 400A-3P, 600V, HEAVY DUTY, DISCONNECT SWITCH FOR TRANSFORMER.
- GROUND PER CEC.
- PROVIDE 200A-3P CIRCUIT BREAKER IN EXISTING PANEL'S SUBFEED POSITION.
- PROVIDE 225A-3P CIRCUIT BREAKER IN NEW PANEL'S SUBFEED POSITION.

**CABLE SCHEDULE:**

- 1 (N) 1) 4" - P64E PRIMARY.
- 2 (N) 1) 5" - P64E SECONDARY
- 3 (N) 1) 2-1/2" WITH (N) (3) #4/0 + (1) #4 GND.
- 4 (N) 1) 2-1/2" WITH (N) (3) #4/0 + (1) #4 GND.
- 5 (N) 2) 2-1/2" EACH CONDUIT WITH (N) (4) #4/0 + (1) #2 GND.
- 6 (N) 1) 4" WITH (N) (4) #600 + (1) #1/0 GND.
- 7 (N) 3) 3" EACH CONDUIT WITH (N) (4) #400 + (1) #3 GND.
- 8 (N) 1) 2-1/2" WITH (N) (4) #4/0 + (1) #4 GND.
- 9 (N) 1) 4" WITH (N) (4) #500 + (1) #3 GND.
- 10 (N) 1) 4" WITH (N) (4) #600 + (1) #3 GND.
- 11 (N) 1) 2" WITH (N) (4) #3/0 + (1) #6 GND.
- 12 (N) 1) 4" WITH (N) (4) #600 + (1) #3 GND.
- 13 EXISTING CONDUITS AND CABLES TO REMAIN.

**1 NEW SINGLE LINE DIAGRAM**  
E4.2 NOT TO SCALE

**aedis**  
architects  
www.aedisarchitects.com  
387 S. 1st Street, Suite 300  
San Jose, CA 95113  
tel: (408)-300-5160  
fax: (408)-300-5121

PROJECT  
**GEORGE HALL ELEMENTARY SCHOOL - HVAC REPLACEMENT**  
SAN MATEO-FOSTER CITY SCHOOL DISTRICT  
CONSULTANT



American Consulting Engineers Electrical, Inc.  
1900 The Alameda, Suite 202  
San Jose, CA 95126  
Tel: 408/236-2312 Fax: 408/236-2314

STATE FILE NUMBER **41-26**  
APPL # **01-119523**

REVISIONS

No.	Description	Date
ADDENDUM 1		11/24/2021

MILESTONES

DD	
90% CD	
DSA SUB	05/21/2021
BACKCHECK	10/01/2021

SHEET  
**NEW SINGLE LINE DIAGRAM**

DATE **11/24/2021**  
JOB # **2021005.02**  
SHEET # **AD-1**  
**E4.2**

PANEL NAME:		(N) "AM"		FED FROM: (N) MSB-1					
VOLTAGE:		208/120V		MAIN C/B: 400A-3P					
PHASE:		3		BUSSSING: 400 AMP					
WIRE:		4		MIN. AIC: 10,000					
TYPE:		NEMA 1		SUB-FEED C/B: 225A-3P					
MOUNTING:		SURFACE		FEED THRU LUGS: YES					
CIRCUIT DESCRIPTION	LOAD TYPE (KVA)	CB	CKT	CKT	CB	LOAD TYPE (KVA)	CIRCUIT DESCRIPTION		
(N) HEAT PUMP 1 - KINDERGARTEN 1	3.74	50A	1	2	50A	3.74	(N) HEAT PUMP 2 - KINDERGARTEN 2		
" " " " " "	3.74	2P	3	4	2P	3.74	" " " " " "		
(N) FAN COIL 1 - KINDERGARTEN 1	0.89	15A	5	6	15A	0.89	(N) FAN COIL 2 - KINDERGARTEN 2		
" " " " " "	0.89	2P	7	8	2P	0.89	" " " " " "		
(N) SPLIT SYSTEM AC UNIT 1 - ROOF	2.08	30A	9	10	20A	2.08	(N) SPLIT SYSTEM AC UNIT 2 - ROOF		
" " " " " "	2.08	2P	11	12	2P	2.08	" " " " " "		
(N) SPLIT SYSTEM AC UNIT 3 - ROOF	2.08	30A	13	14	20A/1P	2.08	SPARE		
" " " " " "	2.08	2P	15	16	20A/1P	2.08	SPARE		
SPARE		20A/1P	17	18	20A/1P		SPARE		
SPARE		20A/1P	19	20	20A/1P		SPARE		
SPARE		20A/1P	21	22	20A/1P		SPARE		
SPARE		20A/1P	23	24	20A/1P		SPARE		
SPARE		20A/1P	25	26	20A/1P		SPARE		
SPARE		20A/1P	27	28	20A/1P		SPARE		
SPARE		20A/1P	29	30	20A/1P		SPARE		
SPARE		20A/1P	31	32	20A/1P		SPARE		
SPARE		20A/1P	33	34	20A/1P		SPARE		
SPARE		20A/1P	35	36	20A/1P		SPARE		
SPARE		20A/1P	37	38	20A/1P		SPARE		
SPARE		20A/1P	39	40	20A/1P	0.18	(N) WEATHER PROOF GFCI RECEPTACLE - WING #1		
(N) MOTOR RATED SWITCH FOR COND. PUMP - WING 1	0.00	20A/1P	41	42	20A/1P	0.38	" " " " " "		
	0	0	0.00	17.00		0	0.54	0	11.77
LOAD SUMMARY	CONNECTED KVA	DEMAND FACTOR	DEMAND KVA	Yes/No					
(LTG) LIGHTING X 125%	0	1.25	0.0	FULL RATED AIC	Y				
(REC) RECEIPTS PER 220.44	0.5	1.00	0.5	SERIES RATED AIC	N				
10KVA x 100% + REMAINDER x 50%	0	0.50	0.0	SURGE PROTECTIVE DEVICE	N				
(MTR) LARGEST MOTOR X 125%	0.6	1.25	0.8	COPPER BUSSING	Y				
REMAINING MOTORS x 100%	0	1.00	0.0	ALUMINUM BUSSING	N				
(INCL) NON CONTINUOUS LOAD x 100%	28.4	1.00	28.4						
KVA PHASE A (CONNECTED)				11.4					
KVA PHASE B (CONNECTED)				13.1					
KVA PHASE C (CONNECTED)				6.1					
TOTAL DEMAND KVA				30.7					
TOTAL LOAD AMPERES				36.9					

PANEL NAME:		(N) "BM"		FED FROM: (N) MSB-1					
VOLTAGE:		208/120V		MAIN C/B: 400A-3P					
PHASE:		3		BUSSSING: 400 AMP					
WIRE:		4		MIN. AIC: 10,000					
TYPE:		NEMA 1		SUB-FEED C/B: 225A-3P					
MOUNTING:		SURFACE		FEED THRU LUGS: YES					
CIRCUIT DESCRIPTION	LOAD TYPE (KVA)	CB	CKT	CKT	CB	LOAD TYPE (KVA)	CIRCUIT DESCRIPTION		
(N) HEAT PUMP 3 - CLASSROOM 3	3.74	50A	1	2	50A	3.74	(N) HEAT PUMP 6 - CLASSROOM 6		
" " " " " "	3.74	2P	3	4	2P	3.74	" " " " " "		
(N) FAN COIL 3 - CLASSROOM 3	0.89	15A	5	6	15A	0.89	(N) FAN COIL 8 - CLASSROOM 8		
" " " " " "	0.89	2P	7	8	2P	0.89	" " " " " "		
(N) HEAT PUMP 4 - CLASSROOM 4	3.74	50A	9	10	50A	3.74	(N) HEAT PUMP 7 - CLASSROOM 7		
" " " " " "	3.74	2P	11	12	2P	3.74	" " " " " "		
(N) FAN COIL 4 - CLASSROOM 4	0.89	15A	13	14	15A	0.89	(N) FAN COIL 7 - CLASSROOM 7		
" " " " " "	0.89	2P	15	16	2P	0.89	" " " " " "		
(N) HEAT PUMP 5 - STAFF 5	3.74	50A	17	18	50A	3.74	(N) HEAT PUMP 8 - CLASSROOM 8		
" " " " " "	3.74	2P	19	20	2P	3.74	" " " " " "		
(N) FAN COIL 5 - CLASSROOM 5	0.89	15A	21	22	15A	0.89	(N) FAN COIL 8 - CLASSROOM 8		
" " " " " "	0.89	2P	23	24	2P	0.89	" " " " " "		
SPARE		20A/1P	25	26	20A/1P		SPARE		
SPARE		20A/1P	27	28	20A/1P		SPARE		
SPARE		20A/1P	29	30	20A/1P		SPARE		
SPARE		20A/1P	31	32	20A/1P		SPARE		
SPARE		20A/1P	33	34	20A/1P		SPARE		
SPARE		20A/1P	35	36	20A/1P		SPARE		
SPARE		20A/1P	37	38	20A/1P		SPARE		
SPARE		20A/1P	39	40	20A/1P	0.54	(N) WEATHER PROOF GFCI RECEPTACLE - WING #2		
(N) MOTOR RATED SWITCH FOR COND. PUMP - WING 2	0.00	20A/1P	41	42	20A/1P	0.72	" " " " " "		
	0	0	0.72	27.83		0	0.54	0	27.83
LOAD SUMMARY	CONNECTED KVA	DEMAND FACTOR	DEMAND KVA	Yes/No					
(LTG) LIGHTING X 125%	0	1.25	0.0	FULL RATED AIC	Y				
(REC) RECEIPTS PER 220.44	0.5	1.00	0.5	SERIES RATED AIC	N				
10KVA x 100% + REMAINDER x 50%	0	0.50	0.0	SURGE PROTECTIVE DEVICE	N				
(MTR) LARGEST MOTOR X 125%	0.7	1.25	0.9	COPPER BUSSING	Y				
REMAINING MOTORS x 100%	0	1.00	0.0	ALUMINUM BUSSING	N				
(INCL) NON CONTINUOUS LOAD x 100%	55.7	1.00	55.7						
KVA PHASE A (CONNECTED)				18.6					
KVA PHASE B (CONNECTED)				19.1					
KVA PHASE C (CONNECTED)				19.3					
TOTAL DEMAND KVA				57.1					
TOTAL LOAD AMPERES				68.8					

PANEL NAME:		(N) "CM"		FED FROM: (N) MSB-1					
VOLTAGE:		208/120V		MAIN C/B: 400A-3P					
PHASE:		3		BUSSSING: 400 AMP					
WIRE:		4		MIN. AIC: 10,000					
TYPE:		NEMA 1		SUB-FEED C/B: 225A-3P					
MOUNTING:		SURFACE		FEED THRU LUGS: YES					
CIRCUIT DESCRIPTION	LOAD TYPE (KVA)	CB	CKT	CKT	CB	LOAD TYPE (KVA)	CIRCUIT DESCRIPTION		
(N) HEAT PUMP 9 - CLASSROOM 9	3.74	50A	1	2	50A	3.74	(N) HEAT PUMP 12 - CLASSROOM 12		
" " " " " "	3.74	2P	3	4	2P	3.74	" " " " " "		
(N) FAN COIL 9 - CLASSROOM 9	0.89	15A	5	6	15A	0.89	(N) HEAT PUMP 12 - CLASSROOM 12		
" " " " " "	0.89	2P	7	8	2P	0.89	" " " " " "		
(N) HEAT PUMP 10 - CLASSROOM 10	3.74	50A	9	10	50A	3.74	(N) HEAT PUMP 13 - CLASSROOM 13		
" " " " " "	3.74	2P	11	12	2P	3.74	" " " " " "		
(N) FAN COIL 10 - CLASSROOM 10	0.89	15A	13	14	15A	0.89	(N) HEAT PUMP 13 - CLASSROOM 13		
" " " " " "	0.89	2P	15	16	2P	0.89	" " " " " "		
(N) HEAT PUMP 11 - CLASSROOM 11	3.74	50A	17	18	50A	3.74	(N) HEAT PUMP 14 - CLASSROOM 14		
" " " " " "	3.74	2P	19	20	2P	3.74	" " " " " "		
(N) FAN COIL 11 - CLASSROOM 11	0.89	15A	21	22	15A	0.89	(N) HEAT PUMP 14 - CLASSROOM 14		
" " " " " "	0.89	2P	23	24	2P	0.89	" " " " " "		
SPARE		20A/1P	25	26	20A/1P		SPARE		
SPARE		20A/1P	27	28	20A/1P		SPARE		
SPARE		20A/1P	29	30	20A/1P		SPARE		
SPARE		20A/1P	31	32	20A/1P		SPARE		
SPARE		20A/1P	33	34	20A/1P		SPARE		
SPARE		20A/1P	35	36	20A/1P		SPARE		
SPARE		20A/1P	37	38	20A/1P		SPARE		
SPARE		20A/1P	39	40	20A/1P	0.54	(N) WEATHER PROOF GFCI RECEPTACLE - WING #3		
(N) MOTOR RATED SWITCH FOR COND. PUMP - WING 3	0.00	20A/1P	41	42	20A/1P	0.72	" " " " " "		
	0	0	0.72	27.83		0	0.54	0	27.83
LOAD SUMMARY	CONNECTED KVA	DEMAND FACTOR	DEMAND KVA	Yes/No					
(LTG) LIGHTING X 125%	0	1.25	0.0	FULL RATED AIC	Y				
(REC) RECEIPTS PER 220.44	0.5	1.00	0.5	SERIES RATED AIC	N				
10KVA x 100% + REMAINDER x 50%	0	0.50	0.0	SURGE PROTECTIVE DEVICE	N				
(MTR) LARGEST MOTOR X 125%	0.7	1.25	0.9	COPPER BUSSING	Y				
REMAINING MOTORS x 100%	0	1.00	0.0	ALUMINUM BUSSING	N				
(INCL) NON CONTINUOUS LOAD x 100%	55.7	1.00	55.7						
KVA PHASE A (CONNECTED)				18.6					
KVA PHASE B (CONNECTED)				19.1					
KVA PHASE C (CONNECTED)				19.3					
TOTAL DEMAND KVA				57.1					
TOTAL LOAD AMPERES				68.8					

PANEL NAME:		(N) "DM"		FED FROM: (N) MSB-1					
VOLTAGE:		208/120V		MAIN C/B: 400A-3P					
PHASE:		3		BUSSSING: 400 AMP					
WIRE:		4		MIN. AIC: 10,000					
TYPE:		NEMA 1		SUB-FEED C/B: 225A-3P					
MOUNTING:		SURFACE		FEED THRU LUGS: YES					
CIRCUIT DESCRIPTION	LOAD TYPE (KVA)	CB	CKT	CKT	CB	LOAD TYPE (KVA)	CIRCUIT DESCRIPTION		
(N) HEAT PUMP 15 - CLASSROOM 15	3.74	50A	1	2	50A	3.74	(N) HEAT PUMP 18 - CLASSROOM 18		
" " " " " "	3.74	2P	3	4	2P	3.74	" " " " " "		
(N) FAN COIL 15 - CLASSROOM 15	0.89	15A	5	6	15A	0.89	(N) HEAT PUMP 18 - CLASSROOM 18		
" " " " " "	0.89	2P	7	8	2P	0.89	" " " " " "		
(N) HEAT PUMP 16 - CLASSROOM 16	3.74	50A	9	10	50A	3.74	(N) HEAT PUMP 19 - CLASSROOM 19		
" " " " " "	3.74	2P	11	12	2P	3.74	" " " " " "		
(N) FAN COIL 16 - CLASSROOM 16	0.89	15A	13	14	15A	0.89	(N) HEAT PUMP 19 - CLASSROOM 19		
" " " " " "	0.89	2P	15	16	2P	0.89	" " " " " "		
(N) HEAT PUMP 17 - CLASSROOM 17	3.74	50A	17	18	50A	3.74	(N) HEAT PUMP 20 - CLASSROOM 20		
" " " " " "	3.74	2P	19	20	2P	3.74	" " " " " "		
(N) FAN COIL 17 - CLASSROOM 17	0.89	15A	21	22	15A	0.89	(N) HEAT PUMP 20 - CLASSROOM 20		
" " " " " "	0.89	2P	23	24	2P	0.89	" " " " " "		
SPARE		20A/1P	25	26	20A/1P		SPARE		
SPARE		20A/1P	27	28	20A/1P		SPARE		
SPARE		20A/1P	29	30	20A/1P		SPARE		
SPARE		20A/1P	31	32	20A/1P		SPARE		
SPARE		20A/1P	33	34	20A/1P		SPARE		
SPARE		20A/1P	35	36	20A/1P		SPARE		
SPARE		20A/1P	37	38	20A/1P		SPARE		
SPARE		20A/1P	39	40	20A/1P	0.54	(N) WEATHER PROOF GFCI RECEPTACLE - WING #4		
(N) MOTOR RATED SWITCH FOR COND. PUMP - WING 4	0.00	20A/1P	41	42	20A/1P	0.72	" " " " " "		
	0	0	0.72	27.83		0	0.54	0	27.83
LOAD SUMMARY	CONNECTED KVA	DEMAND FACTOR	DEMAND KVA	Yes/No					
(LTG) LIGHTING X 125%	0	1.25	0.0	FULL RATED AIC	Y				
(REC) RECEIPTS PER 220.44	0.5	1.00	0.5	SERIES RATED AIC	N				
10KVA x 100% + REMAINDER x 50%	0	0.50	0.0	SURGE PROTECTIVE DEVICE	N				
(MTR) LARGEST MOTOR X 125%	0.7	1.25	0.9	COPPER BUSSING	Y				
REMAINING MOTORS x 100%	0	1.00	0.0	ALUMINUM BUSSING	N				
(INCL) NON CONTINUOUS LOAD x 100%	55.7	1.00	55.7						
KVA PHASE A (CONNECTED)				18.6					
KVA PHASE B (CONNECTED)				18.6					
KVA PHASE C (CONNECTED)				19.8					
TOTAL DEMAND KVA				57.1					
TOTAL LOAD AMPERES				68.8					

PANEL NAME:		(N) "EM"		FED FROM: (N) MSB-1			
VOLTAGE:		208/120V		MAIN C/B: 200A-3P			
PHASE:		3		BUSSSING: 200 AMP			
WIRE:		4		MIN. AIC: 42,000			
TYPE:		NEMA 1		SUB-FEED C/B:			
MOUNTING:		SURFACE		FEED THRU LUGS: YES			
CIRCUIT DESCRIPTION	LOAD TYPE (KVA)	CB	CKT	CKT	CB	LOAD TYPE (KVA)	CIRCUIT DESCRIPTION
(N) HEAT PUMP 32 - CLASSROOM 32	3.74	50A	1	2	5		



November 24, 2021

Aedis Architects  
387 S. First St., Suite 300  
San Jose, CA 95113

**Subject:** Laurel Elementary School HVAC Replacement  
San Mateo - Foster City School District  
Aedis Project No. 2021005.03  
DSA Application #01-119551

### ADDENDUM NO. 1

---

CHANGES AND/OR CLARIFICATIONS OF THE DRAWINGS AND SPECIFICATIONS ARE AS FOLLOWS:

#### SPECIFICATIONS

ITEM NO. 1.1: TABLE OF CONTENTS

Add: 07 31 13 ASPHALT SHINGLES  
Add: 09 91 14 EXTERIOR PAINTING  
Add: 26 24 13 SWITCHCHBOARDS, 600 VOLTS AND BELOW  
Add: 31 23 16 TRENCHING

ITEM NO. 1.2: SECTION 07 31 13 – ASPHALT SHINGLES

Replace: Remove specification 07 31 13 Asphalt Shingles and replace in its entirety per attached 07 31 13 Asphalt Shingles.

ITEM NO. 1.3: SECTION 09 91 14 – EXTERIOR PAINTING

Add: The specification in its entirety per 09 91 14 Exterior Painting.

ITEM NO. 1.4: SECTION 31 23 16 - TRENCHING

Add: The specification in its entirety per 31 23 16 Trenching.

ITEM NO. 1.5: SECTION 32 31 13 - CHAIN LINK FENCES AND GATES

Revise: 2.2 CHAIN-LINK FENCE FABRIC Item 2 subparagraph b. to read as:  
Zinc- Coated Fabric: ASTM A392, Type II, Class 1, 1.2 oz/sq. ft with zinc coating applied after weaving.

Add: 2.4 SWING GATES D. Hardware  
Item 5.: Panic Hardware: CD 990AX-L-WH-6280 SNB with Gate closer/Hinge:  
SureClose Pivot: SM AT90W”

**ADDENDUM NO. 1**

11/24/2021

Laurel Elementary School HVAC Replacement  
San Mateo – Foster City School District  
Aedis Project No. 2021005.03

**DRAWINGS**

**ARCHITECTURAL**

ITEM NO. 1.6:     DRAWING SHEET T1 – TITLE SHEET

Revise:     General Note 7 to read as “ALL EXISTING FINISHES OR MATERIALS DAMAGED OR DEMOLISHED DUE TO NEW CONSTRUCTION SHALL BE RESTORED TO THEIR ORIGINAL STATE, INCLUDING BUT NOT LIMITED TO REINSTALLING OR REPLACING EXISTING CHAINLINK FENCING AS REQUIRED AND RESTRIPIING PAVING IN KIND. S.E.D. FOR TRENCH ROUTING. VERIFY IN FIELD AND SEE ARCHITECTURAL SITE PLAN FOR STRIPING AT EXISTING PAVING.”

ITEM NO. 1.7:     DRAWING SHEET A1.02 – SITE PLAN

Add:     Trench area to New Site Plan 1/A1.02 & Graphic Key per AD1-A1.02  
Add:     General Sheet Note #G per AD1-A1.02  
Add:     Site Plan Keynotes #17 to New Site Plan 1/A1.02 per AD1-A1.02  
Add:     Enlarged plan call outs to 2/A2.02 & 4/A3.02 in New Site Plan 1/A1.02 per AD1-A1.02

ITEM NO. 1.8:     DRAWING SHEET A2.01 – DEMOLITION FLOOR PLANS - BLDG B & C

Add:     General Sheet Note #J per AD1-A2.01  
Revise:     Demolition Floor Plan Keynote #1 per AD1-A2.01  
Add:     Filler panel removal keynote #8 to Demolition Floor Plans 1/A2.01 and 2/A2.01 per AD1-A2.01  
Add:     Partial ceiling demolition keynote #9 to Demolition Floor Plans 1/A2.01 and 2/A2.01 per AD1-A2.01

ITEM NO. 1.9:     DRAWING SHEET A2.02 – DEMOLITION FLOOR PLAN - BLDG A

Add:     General Sheet Note #J per AD1-A2.02  
Revise:     Demolition Floor Plan Keynote #1 per AD1-A2.02  
Add:     Filler panel removal keynote #8 to Demolition Floor Plans 1/A2.02 per AD1-A2.01  
Add:     Partial ceiling demolition keynote #9 to Demolition Floor Plans 1/A2.02 per AD1-A2.01  
Add:     View 2/A2.02 Demolition Partial Floor Plan – Bldg D per AD1-A2.02

ITEM NO. 1.10:    DRAWING SHEET A3.01 – NEW FLOOR PLANS - BLDGS B & C

Add:     Door tags 15ab & 7ab to 1/A3.01 and 2/A3.01 per AD1-A3.01  
Add:     Ceiling patching keynote #4 in New Floor Plans 1/A3.01 and 2/A3.01 per AD1-A3.01  
Revise:     New Floor Plan Keynote #3 per AD1-A3.01

**ADDENDUM NO. 1**

11/24/2021

Laurel Elementary School HVAC Replacement  
San Mateo – Foster City School District  
Aedis Project No. 2021005.03

**ITEM NO. 1.11: DRAWING SHEET A3.02 – NEW FLOOR PLANS - BLDG A**

*Add:* View 4/A3.02 New Partial Floor Plan - Bldg. D per AD1-A3.02  
*Revise:* New Floor Plan Keynote #6 per AD1-A3.02  
*Add:* New Floor Plan Keynote #13 @ per AD1-A3.02

**ITEM NO. 1.12: DRAWING SHEET A5.01 – SITE ROOF PLAN**

*Add:* Exhaust fans per AD1-A5.01  
*Add:* General Note #C per AD1-A5.01  
*Revise:* Site Roof Plan Keynote #2 per AD1-A5.01  
*Add:* Site Roof Plan Keynote #4 per AD1-A5.01

**ITEM NO. 1.13: DRAWING SHEET A8.10 – EXTERIOR DETAILS**

*Revise:* Detail 9 per AD1-A8.10

**ITEM NO. 1.14: DRAWING SHEET A9.10 – INTERIOR ELEVATIONS & DETAILS**

*Revise:* Details 1 & 4 per AD1-A9.10A  
*Revise:* Detail 6 per AD1-A9.10A

**ITEM NO. 1.15: DRAWING SHEET A11.01 – FINISH SCHEDULE & OPENING SCHEDULE, LEGENDS, & DETAILS**

*Add:* Doors 7ab, 15ab & 41ab to Door Schedule per AD1-11.01  
*Add:* Door Schedule Comments per AD1-11.01  
*Add:* Door Type B per AD1-11.01

**MECHANICAL****ITEM NO. 1.16: DRAWING SHEET MP0.02 – SCHEDULES – MECHANICAL & PLUMBING**

*Revise:* Classroom split system heat pump schedule per AD1-MP0.02.  
*Add:* Roof exhaust fan schedule added per AD1-MP0.02.

**ITEM NO. 1.17: DRAWING SHEET MP2.03 – FLOOR PLAN – NEW – BLDG B, C, & TYPICAL CLASSROOM – MECHANICAL & PLUMBING**

*Revise:* General notes #4 & #5 per AD1-MP2.03a.  
*Add:* New Sheet Notes #28 per AD1-MP2.03a.  
*Add:* Roof exhaust fan added to plan per AD1-MP2.03a.  
*Add:* Roof exhaust fan added to plan per AD1-MP2.03b.

**ITEM NO. 1.18: DRAWING SHEET MP2.04 – FLOOR PLAN – NEW – BLDG A– MECHANICAL & PLUMBING**

*Revise:* General notes #4 & #5 per AD1-MP2.04

**ADDENDUM NO. 1**

11/24/2021

Laurel Elementary School HVAC Replacement  
San Mateo – Foster City School District  
Aedis Project No. 2021005.03

Add: Multi-Purpose Floor Plan per AD1-MP2.04  
Add: New Sheet Notes #14 per AD1-MP2.04

ITEM NO. 1.19: DRAWING SHEET MP6.01 – DETAILS – MECHANICAL & PLUMBING

Revise: Detail 4 per AD1-MP6.01a  
Add: Detail 6 per AD1-MP6.01a  
Revise: Detail 14 as shown clouded on AD1-MP6.01b

**ELECTRICAL**

ITEM NO. 1.20: DRAWING SHEET E1.1 – ELECTRICAL SITE PLAN

Revise: Conduit Tag #9 per AD1-E1.1  
Revise: Sheet Notes #10 & 11 per AD1-E1.1  
Add: Conduit Tag #22 and #23 per AD1-E1.1  
Add: Power for exhaust fan at building D per AD1-E1.1  
Revise: Conduit tag callouts per AD1-E1.1

ITEM NO. 1.21: DRAWING SHEET E3.1 – ELECTRICAL NEW FLOOR PLANS – BLDGS B & C

Add: General Note #7 per AD1-E3.1  
Add: Sheet Note #12 and #13 per ad1-E3.1  
Add: Conduit Tag #4 per AD1-E3.1  
Add: Solar Conduit stub ups at each wing per AD1-E3.1  
Revise: Sheet notes #1, #2, and #4 per AD1-E3.1  
Revise: Classroom power plans per AD1-E3.1

ITEM NO. 1.22: DRAWING SHEET E3.2 – ELECTRICAL NEW FLOOR PLANS – BLDG A

Add: General Note #7 per AD1-E3.2  
Add: Sheet Note #11 per AD1-E3.2  
Add: Conduit Tag #2 per AD1-E3.2  
Add: Solar Conduit stub ups at each wing per AD1-E3.2  
Revise: Classroom power plans per AD1-E3.2

ITEM NO. 1.23: DRAWING SHEET E4.2 – NEW SINGLE LINE DIAGRAM

Revise: Feeders to existing panel P1 and P2 per AD1-E4.2  
Add: Conduit Tag #15 per AD1-E4.2  
Revise: Switchboard to be OFCI per AD1-E4.2

ITEM NO. 1.24: DRAWING SHEET E4.3 – PANEL SCHEDULES

Revise: Main Circuit breakers on the panels per AD1-E4.3  
Revise: Panel Schedule per AD1-E4.3

**ADDENDUM NO. 1**

Laurel Elementary School HVAC Replacement  
San Mateo – Foster City School District  
Aedis Project No. 2021005.03

11/24/2021



---

Aedis Architects  
Thang Do, Principal



---

Electrical, American Consulting Engineers Electrical  
Sammy Fernandez



---

Mechanical, Cypress Engineering Group  
Metin Serttunc

---

Division of the State Architect

**ADDENDUM NO. 1**

Laurel Elementary School HVAC Replacement  
San Mateo – Foster City School District  
Aedis Project No. 2021005.03

11/24/2021

**Attachments:**

Specifications:

07 31 13 Asphalt Shingles (12 pages)

09 91 14 Exterior Painting (8 pages)

31 23 16 Trenching (5 pages)

Drawing:

**ARCHITECTURAL:**

SHEET AD1-A1.02

SHEET AD1-A2.01

SHEET AD1-A2.02

SHEET AD1-A3.01

SHEET AD1-A3.02

SHEET AD1-A5.01

SHEET AD1-A8.10

SHEET AD1-A9.10A

SHEET AD1-A9.10B

SHEET AD1-A11.01

**MECHANICAL:**

SHEET AD1-MP0.02

SHEET AD1-MP2.03a

SHEET AD1-MP2.03b

SHEET AD1-MP2.04

SHEET AD1-MP6.01a

SHEET AD1-MP6.01b

**ELECTRICAL:**

SHEET AD1-E1.1

SHEET AD1-E3.1

SHEET AD1-E3.2

SHEET AD1-E4.2

SHEET AD1-E4.3

SECTION 073113 - ASPHALT SHINGLES

PART 1 - GENERAL

1.1 SUMMARY

- A. Section Includes:
  - 1. Glass-fiber-reinforced asphalt shingles.
  - 2. Underlayment materials.

1.2 DEFINITIONS

- A. Roofing Terminology: See ASTM D1079 for definitions of terms related to roofing Work in this Section.

1.3 PREINSTALLATION MEETINGS

- A. Preinstallation Conference: Conduct conference at Project site.

1.4 ACTION SUBMITTALS

- A. Product Data: For the following:
  - 1. Asphalt shingles.
  - 2. Underlayment materials.
  - 3. Asphalt roofing cement.
  - 4. Elastomeric flashing sealant.
- B. Shop Drawings: For metal flashing and trim.
- C. Samples for Initial Selection:
  - 1. For each type of asphalt shingle indicated.
  - 2. For each type of accessory involving color selection.
- D. Samples for Verification: For the following products, in sizes indicated:
  - 1. Asphalt Shingles: Full size.
  - 2. Ridge and Hip Cap Shingles: Full size.
  - 3. Ridge Vent: 12-inch- (305-mm-) long Sample.
  - 4. Exposed Valley Lining: 12 inches (305 mm) square.

LAUREL ELEMENTARY SCHOOL HVAC REPLACEMENT  
San Mateo-Foster City School District  
Project No 2021005.03

1.5 INFORMATIONAL SUBMITTALS

- A. Qualification Data: For Installer.
- B. Product Test Reports: For each type of asphalt shingle and underlayment product indicated, for tests performed by manufacturer and witnessed by a qualified testing agency.
- C. Research Reports: For synthetic underlayment, from ICC-ES, indicating that product is suitable for intended use under applicable building codes.
- D. Sample Warranty: For manufacturer's materials warranty.

1.6 CLOSEOUT SUBMITTALS

- A. Maintenance Data: For asphalt shingles to include in maintenance manuals.
- B. Materials warranties.
- C. Roofing Installer's warranty.

1.7 QUALITY ASSURANCE

- A. Installer Qualifications: An authorized installer who is trained and approved by manufacturer.

1.8 DELIVERY, STORAGE, AND HANDLING

- A. Store roofing materials in a dry, well-ventilated location protected from weather, sunlight, and moisture in accordance with manufacturer's written instructions.
- B. Store underlayment rolls on end, on pallets or other raised surfaces. Do not double-stack rolls.
- C. Protect unused roofing materials from weather, sunlight, and moisture when left overnight or when roofing Work is not in progress.
- D. Handle, store, and place roofing materials in a manner to prevent damage to roof deck or structural supporting members.

1.9 FIELD CONDITIONS

- A. Environmental Limitations: Proceed with installation only when existing and forecasted weather conditions permit product installation and related Work to be performed in accordance with manufacturer's written instructions and warranty requirements.

1. Install self-adhering, polymer-modified bitumen sheet underlayment within the range of ambient and substrate temperatures recommended in writing by manufacturer.

#### 1.10 WARRANTY

- A. Materials Warranty: Manufacturer agrees to repair or replace asphalt shingles that fail within specified warranty period.
  1. Failures include, but are not limited to, the following:
    - a. Manufacturing defects.
  2. Materials Warranty Period: 40 years from date of Substantial Completion, prorated, with first 20 years nonprorated.
  3. Wind-Speed Warranty Period: Asphalt shingles will resist blow-off or damage caused by wind speeds of up to 110 mph (49 m/s) 130 mph (58 m/s) for 15 years from date of Substantial Completion.
  4. Algae-Resistance Warranty Period: Asphalt shingles will not discolor for 10 years from date of Substantial Completion.
  5. Workmanship Warranty Period: 20 years from date of Substantial Completion.
- B. Roofing Installer's Warranty: On warranty form at end of this Section, signed by Installer, in which Installer agrees to repair or replace components of asphalt shingle roofing that fail in materials or workmanship within specified warranty period.
  1. Warranty Period: Five years from date of Substantial Completion.

### PART 2 - PRODUCTS

#### 2.1 SOURCE LIMITATIONS

- A. Obtain each type of product from single source from single manufacturer.

#### 2.2 PERFORMANCE REQUIREMENTS

- A. Exterior Fire-Test Exposure: Provide asphalt shingles and related roofing materials identical to those of assemblies tested for Class A fire resistance in accordance with ASTM E108 or UL 790 by Underwriters Laboratories or another testing and inspecting agency acceptable to authorities having jurisdiction. Identify products with appropriate markings of applicable testing agency.
- B. Wind Resistance: Provide asphalt shingles that comply with requirements of ASTM D3161/D3161M, Class F, and with ASTM D7158/D7158M, Class H.
- C. Energy Performance, ENERGY STAR: Provide asphalt shingles that are listed on the DOE's "ENERGY STAR Roof Product List" for steep-slope roof products.

## 2.3 GLASS-FIBER-REINFORCED ASPHALT SHINGLES

- A. Laminated-Strip Asphalt Shingles: ASTM D3462/D3462M, laminated, multi-ply overlay construction; glass-fiber reinforced, mineral-granule surfaced, and self-sealing.
  - 1. Products: Subject to compliance with requirements, provide the following:
    - a. CertainTeed; Landmark.
  - 2. Butt Edge: Straight cut.
  - 3. Strip Size: Manufacturer's standard.
  - 4. Algae Resistance: Granules resist algae discoloration.
  - 5. Color and Blends: As selected by Architect from manufacturer's full range.
- B. Hip and Ridge Shingles: Manufacturer's standard units to match asphalt shingles.

## 2.4 UNDERLAYMENT MATERIALS

- A. Organic Felt: Asphalt-saturated organic felts, nonperforated and complying with the following:
  - 1. ASTM D4869/D4869M: Type II.
- B. Synthetic Underlayment: UV-resistant polypropylene, polyolefin, or polyethylene polymer fabric with surface coatings or treatments to improve traction underfoot and abrasion resistance; evaluated and documented to be suitable for use as a roof underlayment under applicable codes by a testing and inspecting agency acceptable to authorities having jurisdiction.
  - 1. Products: Subject to compliance with requirements, provide the following:
    - a. CertainTeed; Diamond Deck
- C. Self-Adhering, Polymer-Modified Bitumen Sheet: ASTM D1970/D1970M, minimum **40-mil- (1.0-mm-)** thick sheet; glass-fiber-mat-reinforced, polymer-modified asphalt; with slip-resistant top surface and release backing; cold applied.
  - 1. Products: Subject to compliance with requirements, provide the following:
    - a. CertainTeed; WinterGuard
  - 2. Top Surface: Textured polymer film.
- D. Granular-Surfaced Valley Lining: ASTM D3909/D3909M, mineral-granular-surfaced, glass-felt-based, asphalt roll roofing; **36 inches (914 mm)** wide.

## 2.5 ACCESSORIES

- A. Asphalt Roofing Cement: ASTM D4586/D4586M Type II, asbestos free.

- B. Elastomeric Flashing Sealant: ASTM C920, Type S, Grade NS, one-part, non-sag, elastomeric polymer sealant; of class and use classifications required to seal joints and remain watertight; recommended in writing by manufacturer for installation of flashing systems.
- C. Roofing Nails: ASTM F1667, aluminum, stainless steel, copper, or hot-dip galvanized-steel wire shingle nails, minimum 0.120-inch- (3-mm-) diameter, sharp-pointed, with a 3/8- to 7/16-inch- (10- to 11-mm-) diameter flat head and of sufficient length to penetrate 3/4 inch (19 mm) into solid wood decking or extend at least 1/8 inch (3 mm) through sheathing less than 3/4 inch (19 mm) thick.
  - 1. Where nails are in contact with metal flashing, use nails made from same metal as flashing.
- D. Underlayment Nails: Aluminum, stainless steel, or hot-dip galvanized-steel wire nails with low-profile metal or plastic caps, 1-inch- (25-mm-) minimum diameter.
  - 1. Provide with minimum 0.0134-inch- (0.34-mm-) thick metal cap, 0.010-inch- (0.25-mm-) thick power-driven metal cap, or 0.035-inch- (0.89-mm-) thick plastic cap; and with minimum 0.083-inch- (2.11-mm-) thick ring shank or 0.091-inch- (2.31-mm-) thick smooth shank of length to penetrate at least 3/4 inch (19 mm) into roof sheathing or to penetrate through roof sheathing less than 3/4 inch (19 mm) thick.

## 2.6 METAL FLASHING AND TRIM

- A. Comply with requirements in Section 076200 "Sheet Metal Flashing and Trim."
  - 1. Sheet Metal: Stainless steel.
- B. Fabricate sheet metal flashing and trim to comply with recommendations in SMACNA's "Architectural Sheet Metal Manual" that apply to design, dimensions, metal, and other characteristics of the item unless otherwise specified in this Section or indicated on Drawings.
  - 1. Apron Flashings: Fabricate with lower flange a minimum of 4 inches (102 mm) over and 4 inches (102 mm) beyond each side of downslope asphalt shingles and 6 inches (152 mm) up the vertical surface.
  - 2. Step Flashings: Fabricate with a headlap of 2 inches (51 mm) and a minimum extension of 4 inches (102 mm) over the underlying asphalt shingle and up the vertical surface.
  - 3. Counterflashings: Fabricate to cover 4 inches (102 mm) of base flashing measured vertically; and in lengths required so that no step exceeds 8 inches (203 mm) and overall length is no more than 10 feet (3 m).
    - a. Provide metal reglets for installation.
  - 4. Open-Valley Flashings: Fabricate from metal sheet not less than 24 inches (610 mm) wide in lengths not exceeding 10 feet (3 m), with 1-inch- (25-mm-) high, inverted-V

profile water diverter at center of valley and equal flange widths of not less than **11 inches (279 mm)**.

- a. Hem flange edges for fastening with metal cleats.
  - b. Add stiffening ribs in flashings to promote drainage.
5. Drip Edges: Fabricate in lengths not exceeding **10 feet (3 m)** with minimum **2-inch (51-mm)** roof-deck flange and **1-1/2-inch (38-mm)** fascia flange with **3/8-inch (10-mm)** drip at lower edge.
  6. Vent-Pipe Flashings: ASTM B749, Type L51121, at least **1/16 inch (1.6 mm)** thick. Provide lead sleeve sized to slip over and turn down into pipe, soldered to skirt at slope of roof, and extending at least **4 inches (102 mm)** from pipe onto roof.

### PART 3 - EXECUTION

#### 3.1 EXAMINATION

- A. Examine substrates, areas, and conditions, with Installer present, for compliance with requirements for installation tolerances and other conditions affecting performance of the Work.
  1. Examine roof sheathing to verify that sheathing joints are supported by framing and blocking or metal clips and that installation is within flatness tolerances.
  2. Verify that substrate is sound, dry, smooth, clean, sloped for drainage, and completely anchored and that provisions have been made for flashings and penetrations through asphalt shingles.
  3. Verify that vent stacks and other penetrations through roofing are installed and securely fastened.
- B. Prepare written report, endorsed by Installer, listing conditions detrimental to performance of the Work.
- C. Proceed with installation only after unsatisfactory conditions have been corrected.

#### 3.2 INSTALLATION OF UNDERLAYMENT MATERIALS

- A. Comply with asphalt shingle and underlayment manufacturers' written installation instructions and with recommendations in NRCA's "The NRCA Roofing Manual: Steep-Slope Roof Systems" applicable to products and applications indicated unless more stringent requirements are specified in this Section or indicated on Drawings.
- B. Asphalt-Saturated Felt: Install on roof deck parallel with and starting at eaves and fasten with underlayment nails.
  1. Single-Layer Installation:

- a. Lap sides a minimum of [2 inches (51 mm)] [4 inches (102 mm)] over underlying course.
  - b. Lap ends a minimum of 4 inches (102 mm).
  - c. Stagger end laps between succeeding courses at least 72 inches (1829 mm).
2. Double-Layer Installation:
- a. Install a 19-inch- (483-mm-) wide starter course at eaves and completely cover with a 36-inch- (914-mm-) wide second course.
  - b. Install succeeding 36-inch- (914-mm-) wide courses lapping previous courses 19 inches (483 mm) in shingle fashion.
  - c. Lap ends a minimum of 4 inches (102 mm). Stagger end laps between succeeding courses at least 72 inches (1829 mm).
  - d. Apply a continuous layer of asphalt roofing cement over starter course and on felt surface to be concealed by succeeding courses as each felt course is installed. Apply at locations indicated on Drawings.
3. Install felt underlayment on roof deck not covered by self-adhering, polymer-modified bitumen sheet unless otherwise specified in this Section or indicated on Drawings.
- a. Lap sides of felt over self-adhering sheet not less than 4 inches (102 mm) in direction that sheds water.
  - b. Lap ends of felt not less than 6 inches (152 mm) over self-adhering sheet.
4. Install fasteners in a grid pattern of 12 inches (305 mm) between side laps with 6-inch (152-mm) spacing at side and end laps.
5. Terminate felt extended up not less than 4 inches (102 mm) against sidewalls, curbs, chimneys, and other roof projections.
- C. Synthetic Underlayment:
1. Install on roof deck parallel with and starting at the eaves.
    - a. Lap sides and ends as recommended in writing by manufacturer, but not less than 4 inches (102 mm) for side laps and 6 inches (152 mm) for end laps.
    - b. Stagger end laps between succeeding courses at interval recommended in writing by manufacturer, but not less than 72 inches (1829 mm).
    - c. Fasten with underlayment nails in accordance with manufacturer's written instructions.
    - d. Cover underlayment within period recommended in writing by manufacturer.
  2. Install in single layer on roofs sloped at 4:12 and greater.
  3. Install in double layer on roofs sloped at less than 4:12.
  4. Install synthetic underlayment on roof deck not covered by self-adhering, polymer-modified bitumen sheet unless otherwise specified in this Section or indicated on Drawings.
    - a. Lap sides of underlayment over self-adhering sheet not less than 4 inches (102 mm) in direction to shed water.

LAUREL ELEMENTARY SCHOOL HVAC REPLACEMENT  
San Mateo-Foster City School District  
Project No 2021005.03

- b. Lap ends of underlayment not less than **6 inches (152 mm)** over self-adhering sheet.
5. Install fasteners in a grid pattern of **12 inches (305 mm)** between side laps with **6-inch (152-mm)** spacing at side and end laps.
        6. Terminate synthetic underlayment extended up not less than **4 inches (102 mm)** against sidewalls, curbs, chimneys, and other roof projections.
- D. Granular-Surfaced, Concealed Valley Lining: For woven valleys. Comply with recommendations in NRCA's "NRCA Guidelines for Asphalt Shingle Roof Systems."
  1. Lap roof-deck underlayment over valley lining at least **6 inches (152 mm)**.
  2. Install a **36-inch- (914-mm-)** wide strip of granular-surfaced valley lining, with granular-surface face up, centered in valley and fastened to roof deck.
  3. Lap ends of strips at least **12 inches (305 mm)** in direction to shed water, and seal with asphalt roofing cement.
  4. Fasten to roof deck.
- E. Metal-Flashed, Open-Valley Underlayment: Install two layers of minimum **36-inch- (914-mm-)** wide underlayment centered in valley.
  1. Use same underlayment as installed on field of roof.
  2. Stagger end laps between layers at least **72 inches (1829 mm)**.
  3. Lap ends of each layer at least **12 inches (305 mm)** in direction that sheds water, and seal with asphalt roofing cement.
  4. Fasten each layer to roof deck with underlayment nails located as far from valley center as possible and only to extent necessary to hold underlayment in place until installation of valley flashing.
  5. Lap roof-deck underlayment over first layer of valley underlayment at least **6 inches (152 mm)**.
- F. Granular-Surfaced, Open-Valley Lining: Before installing valley lining, install **36-inch- (914-mm-)** wide felt underlayment centered in valley. Fasten to roof deck with underlayment nails.
  1. Lap roof-deck felt underlayment over valley felt underlayment at least **6 inches (152 mm)**.
  2. Install an **18-inch- (457-mm-)** wide strip of valley lining centered in valley, with granular-surface face down.
  3. Install a second **36-inch- (914-mm-)** wide strip of valley lining centered in valley, with granular-surface face up.
  4. Lap ends of each strip at least **12 inches (305 mm)** in direction to shed water, and seal with asphalt roofing cement.
  5. Stagger end laps between succeeding strips at least **72 inches (1829 mm)**.
  6. Fasten each strip to roof deck.

3.3 INSTALLATION OF METAL FLASHING AND TRIM

- A. Install metal flashings and trim to comply with requirements in Section 076200 "Sheet Metal Flashing and Trim."
  - 1. Install metal flashings in accordance with recommendations in NRCA's "NRCA Guidelines for Asphalt Shingle Roof Systems."
  - 2. Bed flanges of metal flashings using asphalt roofing cement or elastomeric flashing sealant.
- B. Apron Flashings: Extend lower flange over and beyond each side of downslope asphalt shingles and up the vertical surface.
- C. Step Flashings: Install with a headlap of 2 inches (51 mm) and extend over underlying shingle and up the vertical face.
  - 1. Install with lower edge of flashing just upslope of, and concealed by, butt of overlying shingle.
  - 2. Fasten to roof deck only.
- D. Cricket and Backer Flashings: Install against roof-penetrating elements extending concealed flange beneath upslope asphalt shingles and beyond each side.
- E. Counterflashings: Coordinate with installation of base flashing and fit tightly to base flashing. Lap joints a minimum of 4 inches (102 mm) secured in a waterproof manner.
  - 1. Install in reglets or receivers.
- F. Open-Valley Flashings: Install centered in valleys, lapping ends at least 8 inches (203 mm) in direction that sheds water. Fasten upper end of each length to roof deck beneath overlap.
  - 1. Secure hemmed flange edges into metal cleats spaced 24 inches (610 mm) apart and fastened to roof deck.
  - 2. Adhere minimum 9-inch- (229-mm-) wide strips of self-adhering, polymer-modified bitumen sheet to metal flanges and to underlying self-adhering sheet, polymer-modified bitumen sheet.
    - a. Place strips parallel to and over flanges so that they will be just concealed by installed shingles.
  - 3. Provide a closure at the end of the inverted-V profile of the valley metal to minimize water and ice infiltration.
- G. Rake Drip Edges: Install over underlayment materials and fasten to roof deck.
- H. Eave Drip Edges: Install below underlayment materials and fasten to roof deck.
- I. Pipe Flashings: Form flashing around pipe penetrations and asphalt shingles. Fasten and seal to asphalt shingles as recommended by manufacturer.

### 3.4 INSTALLATION OF ASPHALT SHINGLES

- A. Install asphalt shingles in accordance with manufacturer's written instructions and recommendations in NRCA's "NRCA Guidelines for Asphalt Shingle Roof Systems."
- B. Install starter strip along lowest roof edge, consisting of an asphalt shingle strip at least **7 inches (178 mm)** wide with self-sealing strip face up at roof edge.
  - 1. Extend asphalt shingles **1/2 inch (13 mm)** over fasciae at eaves and rakes.
  - 2. Install starter strip along rake edge.
- C. Install first and remaining courses of laminated asphalt shingles stair-stepping diagonally across roof deck with manufacturer's recommended offset pattern at succeeding courses, maintaining uniform exposure.
- D. Install first and remaining courses of three-tab-strip asphalt shingles stair-stepping diagonally across roof deck with manufacturer's recommended offset pattern at succeeding courses, maintaining uniform exposure.
- E. Fasten asphalt shingle strips with a minimum of four roofing nails, but not less than the number indicated in manufacturer's written instructions for roof slope and design wind speed indicated on Drawings and for warranty requirements specified in this Section.
  - 1. Locate fasteners in accordance with manufacturer's written instructions.
  - 2. Where roof slope exceeds 18:12, hand seal self-sealing asphalt shingles to improve the shingles' positive bond by applying asphalt roofing cement spots between course overlaps after nailing the upper course.
  - 3. Where roof slope is less than 4:12, hand seal self-sealing asphalt shingles to improve the shingles' positive bond by applying asphalt roofing cement spots between course overlaps after nailing the upper course.
  - 4. When ambient temperature during installation is below **50 deg F (10 deg C)**, hand seal self-sealing asphalt shingles by applying asphalt roofing cement spots between course overlaps after nailing the upper course.
- F. Open Valleys: Cut and fit asphalt shingles at open valleys, trimming upper concealed corners of shingle strips.
  - 1. Maintain uniform width of exposed open valley from highest to lowest point.
  - 2. Extend shingle a minimum of **4 inches (102 mm)** over valley metal.
  - 3. Set valley edge of asphalt shingles in a **3-inch- (76-mm-)** wide bed of asphalt roofing cement.
  - 4. Do not nail asphalt shingles to metal open-valley flashings.
- G. Ridge Vents: Install continuous ridge vents over asphalt shingles in accordance with manufacturer's written instructions. Fasten with roofing nails of sufficient length to penetrate sheathing.
- H. Hip and Ridge Shingles: Maintain same exposure of cap shingles as roofing-shingle exposure. Lap cap shingles at ridges to shed water away from direction of prevailing winds.

1. Fasten with roofing nails of sufficient length to penetrate sheathing.
2. Fasten ridge cap asphalt shingles to cover ridge vent without obstructing airflow.

### 3.5 ROOFING INSTALLER'S WARRANTY

- A. WHEREAS **<Insert name>** of **<Insert address>**, herein called the "Roofing Installer," has performed roofing and associated work ("the work") on the following project:
1. Owner: **<Insert name of Owner>**.
  2. Owner Address: **<Insert address>**.
  3. Building Name/Type: **<Insert information>**.
  4. Building Address: **<Insert address>**.
  5. Area of the Work: **<Insert information>**.
  6. Acceptance Date: **<Insert date>**.
  7. Warranty Period: **<Insert time>**.
  8. Expiration Date: **<Insert date>**.
- B. AND WHEREAS Roofing Installer has contracted (either directly with Owner or indirectly as a subcontractor) to warrant the work against leaks and faulty or defective materials and workmanship for designated Warranty Period,
- C. NOW THEREFORE Roofing Installer hereby warrants, subject to terms and conditions herein set forth, that, during Warranty Period, Roofing Installer will, at Roofing Installer's own cost and expense, make or cause to be made such repairs to or replacements of the work as are necessary to correct faulty and defective work and as are necessary to maintain the work in a watertight condition.
- D. This Warranty is made subject to the following terms and conditions:
1. Specifically excluded from this Warranty are damages to the work and other parts of the building, and to building contents, caused by:
    - a. Lightning;
    - b. Peak gust wind speed exceeding **90 mph**
    - c. Fire;
    - d. Failure of roofing system substrate, including cracking, settlement, excessive deflection, deterioration, and decomposition;
    - e. Faulty construction of copings, chimneys, skylights, vents, equipment supports, and other edge conditions and penetrations of the work;
    - f. Vapor condensation on bottom of roofing; and
    - g. Activity on roofing by others, including construction contractors, maintenance personnel, other persons, and animals, whether authorized or unauthorized by Owner.
  2. When the work has been damaged by any of foregoing causes, Warranty shall be null and void until such damage has been repaired by Roofing Installer and until cost and expense thereof have been paid by Owner or by another responsible party so designated.

LAUREL ELEMENTARY SCHOOL HVAC REPLACEMENT  
San Mateo-Foster City School District  
Project No 2021005.03

3. Roofing Installer is responsible for damage to the work covered by this Warranty but is not liable for consequential damages to building or building contents resulting from leaks or faults or defects of the work.
4. During Warranty Period, if Owner allows alteration of the work by anyone other than Roofing Installer, including cutting, patching, and maintenance in connection with penetrations, attachment of other work, and positioning of anything on roof, this Warranty shall become null and void on date of the alterations, but only to the extent the alterations affect the work covered by this Warranty. If Owner engages Roofing Installer to perform the alterations, Warranty shall not become null and void unless Roofing Installer, before starting the alterations, notified Owner in writing, showing reasonable cause for claim, that the alterations would likely damage or deteriorate the work, thereby reasonably justifying a limitation or termination of this Warranty.
5. During Warranty Period, if original use of roof is changed and it becomes used for, but was not originally specified for, a use or service more severe than originally specified, this Warranty shall become null and void on date of the change, but only to the extent the change affects the work covered by this Warranty.
6. Owner shall promptly notify Roofing Installer of observed, known, or suspected leaks, defects, or deterioration and shall afford reasonable opportunity for Roofing Installer to inspect the work and to examine evidence of such leaks, defects, or deterioration.
7. This Warranty is recognized to be the only warranty of Roofing Installer on the work and shall not operate to restrict or cut off Owner from other remedies and resources lawfully available to Owner in cases of roofing failure. Specifically, this Warranty shall not operate to relieve Roofing Installer of responsibility for performance of the work according to requirements of the Contract Documents, regardless of whether Contract was a contract directly with Owner or a subcontract with Owner's General Contractor.

END OF SECTION 073113

## SECTION 099114 - EXTERIOR PAINTING

### PART 1 - GENERAL

#### 1.1 SUMMARY

##### A. Section Includes:

1. Surface preparation and application of paint systems on exterior substrates.
  - a. Concrete.
  - b. Galvanized metal.
  - c. Aluminum (not anodized or otherwise coated).
  - d. Wood.
  - e. Portland cement plaster (stucco).

#### 1.2 ACTION SUBMITTALS

##### A. Product Data: For each type of product.

1. Include preparation requirements and application instructions.
2. Indicate VOC content.

##### B. Samples: For each type of topcoat product.

##### C. Samples for Initial Selection: For each type of topcoat product.

##### D. Samples for Verification: For each type of paint system and each color and gloss of topcoat.

1. Submit Samples on rigid backing, 8 inches (200 mm) square.
2. Apply coats on Samples in steps to show each coat required for system.
3. Label each coat of each Sample.
4. Label each Sample for location and application area.

##### E. Product List: Cross-reference to paint system and locations of application areas. Use same designations indicated on Drawings and in the Exterior Painting Schedule to cross-reference paint systems specified in this Section. Include color designations.

#### 1.3 MAINTENANCE MATERIAL SUBMITTALS

##### A. Furnish extra materials that match products installed and that are packaged with protective covering for storage and identified with labels describing contents.

1. Paint: 5 percent, but not less than 1 gal. (3.8 L) of each material and color applied.

#### 1.4 QUALITY ASSURANCE

- A. Mockups: Apply mockups of each paint system indicated and each color and finish selected to verify selections made under Sample submittals, to demonstrate aesthetic effects, and to set quality standards for materials and execution.
  - 1. Architect will select one surface to represent surfaces and conditions for application of each paint system.
    - a. Vertical and Horizontal Surfaces: Provide samples of at least 100 sq. ft. (9 sq. m).
    - b. Other Items: Architect will designate items or areas required.
  - 2. Final approval of color selections will be based on mockups.
    - a. If preliminary color selections are not approved, apply additional mockups of additional colors selected by Architect at no added cost to Owner.
  - 3. Approval of mockups does not constitute approval of deviations from the Contract Documents contained in mockups unless Architect specifically approves such deviations in writing.
  - 4. Subject to compliance with requirements, approved mockups may become part of the completed Work if undisturbed at time of Substantial Completion.

#### 1.5 DELIVERY, STORAGE, AND HANDLING

- A. Store materials not in use in tightly covered containers in well-ventilated areas with ambient temperatures continuously maintained at not less than 45 deg F (7 deg C).
  - 1. Maintain containers in clean condition, free of foreign materials and residue.
  - 2. Remove rags and waste from storage areas daily.

#### 1.6 FIELD CONDITIONS

- A. Apply paints only when temperature of surfaces to be painted and ambient air temperatures are between 50 and 95 deg F (10 and 35 deg C).
- B. Do not apply paints in snow, rain, fog, or mist; when relative humidity exceeds 85 percent; at temperatures less than 5 deg F (3 deg C) above the dew point; or to damp or wet surfaces.

### PART 2 - PRODUCTS

#### 2.1 MANUFACTURERS

- A. Manufacturers: Subject to compliance with requirements, provide products by one of the following:

1. Kelly-Moore Paint Company Inc.: District Standard
- B. Source Limitations: Obtain paint from single source from single manufacturer.

## 2.2 PAINT GENERAL

- A. Material Compatibility:
  1. Provide materials for use within each paint system that are compatible with one another and substrates indicated, under conditions of service and application as demonstrated by manufacturer, based on testing and field experience.
  2. For each coat in a paint system, provide products recommended in writing by topcoat manufacturers for use in paint system and on substrate indicated.
- B. Colors: As selected by Architect from manufacturer's full range.

## PART 3 - EXECUTION

### 3.1 EXAMINATION

- A. Examine substrates and conditions, with Applicator present, for compliance with requirements for maximum moisture content and other conditions affecting performance of the Work.
- B. Maximum Moisture Content of Substrates: When measured with an electronic moisture meter as follows:
  1. Concrete: 12 percent.
  2. Wood: 15 percent.
  3. Portland Cement Plaster: 12 percent.
- C. Portland Cement Plaster Substrates: Verify that plaster is fully cured.
- D. Verify suitability of substrates, including surface conditions and compatibility, with existing finishes and primers.
- E. Proceed with coating application only after unsatisfactory conditions have been corrected.
  1. Application of coating indicates acceptance of surfaces and conditions.

### 3.2 PREPARATION

- A. Comply with manufacturer's written instructions applicable to substrates and paint systems indicated.
- B. Remove hardware, covers, plates, and similar items already in place that are removable and are not to be painted. If removal is impractical or impossible because of size or weight of item, provide surface-applied protection before surface preparation and painting.

LAUREL ELEMENTARY SCHOOL HVAC REPLACEMENT  
San Mateo-Foster City School District  
Project No. 2021005.03

1. After completing painting operations, use workers skilled in the trades involved to reinstall items that were removed. Remove surface-applied protection.
- C. Clean substrates of substances that could impair bond of paints, including dust, dirt, oil, grease, and incompatible paints and encapsulants.
  1. Remove incompatible primers and reprime substrate with compatible primers or apply tie coat as required to produce paint systems indicated.
- D. Concrete Substrates: Remove release agents, curing compounds, efflorescence, and chalk. Do not paint surfaces if moisture content or alkalinity of surfaces to be painted exceeds that permitted in manufacturer's written instructions.
- E. Steel Substrates: Remove rust, loose mill scale, and shop primer if any. Clean using methods recommended in writing by paint manufacturer but not less than the following:
  1. SSPC-SP 2.
  2. SSPC-SP 3.
  3. SSPC-SP 7/NACE No. 4.
  4. SSPC-SP 11.
- F. Shop-Primed Steel Substrates: Clean field welds, bolted connections, and areas where shop paint is abraded. Paint exposed areas with the same material as used for shop priming to comply with SSPC-PA 1 for touching up shop-primed surfaces.
- A. Galvanized-Metal Substrates: Remove grease and oil residue from galvanized sheet metal with Krud Kutter Metal Clean and Etch to dissolve passivator and use mechanical methods as necessary, to produce clean, lightly etched surfaces that promote adhesion of subsequently applied paints.
- B. Aluminum Substrates: Remove loose surface oxidation.
- C. Wood Substrates:
  1. Scrape and clean knots. Before applying primer, apply coat of knot sealer recommended in writing by topcoat manufacturer for exterior use in paint system indicated.
  2. Sand surfaces that will be exposed to view, and remove sanding dust.
  3. Prime edges, ends, faces, undersides, and backsides of wood.
  4. After priming, fill holes and imperfections in the finish surfaces with putty or plastic wood filler. Sand smooth when dried.

### 3.3 INSTALLATION

- A. Apply paints in accordance with manufacturer's written instructions.
  1. Use applicators and techniques suited for paint and substrate indicated.
  2. Paint surfaces behind movable items same as similar exposed surfaces. Before final installation, paint surfaces behind permanently fixed items with prime coat only.

3. Paint both sides and edges of exterior doors and entire exposed surface of exterior door frames.
  4. Paint entire exposed surface of window frames and sashes.
  5. Do not paint over labels of independent testing agencies or equipment name, identification, performance rating, or nomenclature plates.
  6. Primers specified in the Exterior Painting Schedule may be omitted on items that are factory primed or factory finished if compatible with intermediate and topcoat coatings and acceptable to intermediate and topcoat paint manufacturers.
  7. For previously painted or factory primed surfaces where bare substrate is exposed, spot prime with manufacturer recommended primer.
  8. Previously painted surfaces may require full prime and is subject to field inspection recommendation.
- B. Tint undercoats same color as topcoat, but tint each undercoat a lighter shade to facilitate identification of each coat if multiple coats of same material are to be applied. Provide sufficient difference in shade of undercoats to distinguish each separate coat.
- C. If undercoats or other conditions show through topcoat, apply additional coats until cured film has a uniform paint finish, color, and appearance.
- D. Apply paints to produce surface films without cloudiness, spotting, holidays, laps, brush marks, roller tracking, runs, sags, ropiness, or other surface imperfections. Cut in sharp lines and color breaks.
- E. Painting Fire Suppression, Plumbing, HVAC, Electrical, Communication, and Electronic Safety and Security Work:
1. Paint the following work where exposed to view:
    - a. Equipment, including panelboards.
    - b. Uninsulated metal piping.
    - c. Uninsulated plastic piping.
    - d. Pipe hangers and supports.
    - e. Metal conduit.
    - f. Plastic conduit.
    - g. Tanks that do not have factory-applied final finishes.

### 3.4 FIELD QUALITY CONTROL

- A. Dry Film Thickness Testing: Owner may engage the services of a qualified testing and inspecting agency to inspect and test paint for dry film thickness.
1. Contractor shall touch up and restore painted surfaces damaged by testing.
  2. If test results show that dry film thickness of applied paint does not comply with paint manufacturer's written instructions, Contractor shall pay for testing and apply additional coats as needed to provide dry film thickness that complies with paint manufacturer's written instructions.

### 3.5 CLEANING AND PROTECTION

- A. At end of each workday, remove rubbish, empty cans, rags, and other discarded materials from Project site.
  - 1. Do not clean equipment with free-draining water and prevent solvents, thinners, cleaners, and other contaminants from entering into waterways, sanitary and storm drain systems, and ground.
  - 2. Dispose of contaminants in accordance with requirements of authorities having jurisdiction.
  - 3. Allow empty paint cans to dry before disposal.
  - 4. Collect waste paint by type and deliver to recycling or collection facility.
- B. After completing paint application, clean spattered surfaces. Remove spattered paints by washing, scraping, or other methods. Do not scratch or damage adjacent finished surfaces.
- C. Protect work of other trades against damage from paint application. Correct damage to work of other trades by cleaning, repairing, replacing, and refinishing, as approved by Architect, and leave in an undamaged condition.
- D. At completion of construction activities of other trades, touch up and restore damaged or defaced painted surfaces.

### 3.6 EXTERIOR PAINTING SCHEDULE

- A. Concrete Substrates, Nontraffic Surfaces:
  - 1. Latex System:
    - a. Prime Coat: Primer, alkali resistant, water based.
      - 1) KM 247 Acryshield Masonry Primer
      - 2) Or approved equal
    - b. Prime Coat, Latex: Exterior, matching topcoat.
    - c. Intermediate Coat: Latex, exterior, matching topcoat.
    - d. Low-Sheen Topcoat: Latex, exterior, low sheen
      - 1) KM 1210 Premium Professional Exterior 100% Acrylic Low Sheen
      - 2) Or approved equal
- B. Steel and Iron Substrates:
  - 1. Alkyd System:
    - a. Alkyd Prime Coat: Primer, alkyd, anticorrosive, for metal.

- 1) Rust-Oleum CV740 Alkyd Metal Primer Low VOC
  - 2) Or approved equal
  - b. Shop Prime Coat: Shop primer specified in Section where substrate is specified.
  - c. Surface-Tolerant Prime Coat: Primer, metal, surface tolerant.
    - 1) Rust-Oleum CV740 Alkyd Metal Primer Low VOC
    - 2) Or approved equal
  - d. Intermediate Coat: Exterior, alkyd enamel, matching topcoat.
  - e. Semigloss Topcoat: Alkyd, exterior, semigloss
    - 1) KM 1998 Epic Water Urethane Modified Alkyd Semi-Gloss Enamel
    - 2) Or approved equal
- C. Galvanized-Metal Substrates:
1. Water-Based Light Industrial Coating System:
    - a. For use at handrails unless otherwise noted
    - b. Acrylic Prime Coat: Primer, galvanized, water based.
      - 1) KM 5725 DTM Acrylic Metal Primer/Finish
      - 2) Or approved equal
    - c. Intermediate Coat: Light industrial coating, exterior, water based, matching topcoat.
    - d. Semigloss Topcoat: Light industrial coating, exterior, water based, semigloss
      - 1) KM 5885 DTM High Performance Acrylic Semi-Gloss Enamel
      - 2) Or approved equal
    - e. Intermediate Coat: Exterior, alkyd enamel, matching topcoat.
    - f. Semigloss Topcoat: Alkyd, exterior, semigloss
      - 1) KM 1998 Epic Water Urethane Modified Alkyd Semi-Gloss Enamel
      - 2) Or approved
- D. Aluminum Substrates:
1. Latex System:
    - a. Prime Coat: Primer, quick dry, for aluminum.

LAUREL ELEMENTARY SCHOOL HVAC REPLACEMENT  
San Mateo-Foster City School District  
Project No. 2021005.03

- 1) KM 5725 DTM Acrylic Metal Primer/Finish
  - 2) Or approved equal
  - b. Intermediate Coat: Latex, exterior, matching topcoat.
  - c. Semigloss Topcoat: Latex, exterior, semigloss
    - 1) KM 5885 DTM High Performance Semi-Gloss Enamel
    - 2) Or approved
- E. Wood Substrates: Wood trim, Doors.
1. Latex over Latex Primer System:
    - a. Prime Coat: Primer, latex for exterior wood.
      - 1) KM 295 Kel-Bond Universal Primer
      - 2) Or approved equal
    - b. Intermediate Coat: Latex, exterior, matching topcoat.
    - c. Semigloss Topcoat: Latex, exterior, semigloss
      - 1) KM 1215 Premium Professional Exterior 100% Acrylic Semi-Gloss
      - 2) Or approved equal
- F. Portland Cement Plaster Substrates:
1. Latex System:
    - a. Latex Prime Coat: Latex, exterior, matching topcoat.
    - b. Alkali-Resistant Prime Coat: Primer, alkali resistant, water based.
      - 1) KM 247 Acryshield Masonry Primer
      - 2) Or approved equal
    - c. Intermediate Coat: Latex, exterior, matching topcoat.
    - d. Low-Sheen Topcoat: Latex, exterior, low sheen
      - 1) KM 1210 Premium Professional Exterior Low Sheen
      - 2) Or approved equal

END OF SECTION 099114

SECTION 312316 – TRENCHING

PART 1 GENERAL

1.1 SUMMARY

- A. Section includes excavating trenches for utilities from outside building to final connection point or public right-of-way or utility; compacted fill from top of utility bedding to subgrade elevations; and backfilling and compaction.
- B. Related Sections:
  - 1. Section 03 30 00 – Cast-in-Place Concrete.

1.2 DEFINITIONS

- A. Utility: Any buried pipe, duct, conduit, or cable.

1.3 FIELD MEASUREMENTS

- A. Verify field measurements prior to fabrication.

1.4 COORDINATION

- A. Section 01 06 00 - Regulatory Requirements.
- B. Verify Work associated with lower elevation utilities is complete before placing higher elevation utilities.
- C. Verify elevations of existing facilities prior to placing new Work.

PART 2 PRODUCTS

2.1 FILL MATERIALS

- A. Fill and Structural Fill shall be: As specified in the project Soils Report and any supplements to the Soils Report.

2.2 ACCESSORIES

- A. Filter Fabric: Non-biodegradable, woven as manufactured by TC Mirafi, Tenax Corp., Tensar Earth Technologies, Inc. or equal.

PART 3 EXECUTION

3.1 LINES AND GRADES

A. Grades

1. Pipes shall be laid true to the lines and grades indicated.
2. The grade alignment of the pipe shall be maintained by the use of a string line parallel with the grade line and vertically above the centerline of the pipe. This line shall be established on level batter boards at intervals of not more than 25 feet. Batter boards shall span the trench and be rigidly anchored to substantial posts driven into the ground on each side of the trench. Three adjacent batter boards must be set before laying pipe to provide a check on the grades and line. Elevation and position of the string line shall be determined from the elevation and position of offset points or stakes located along the pipe route. Pipe shall not be laid using side lines for line or grade.
3. As an alternative means of establishing alignment and grade, a "Laser-Beam" instrument may be utilized with a competent operator.

B. Location of Pipe Lines:

1. The location and approximate depths of the proposed pipe lines are shown on the Drawings.
2. An underground locate service shall be enlisted to discover the location of existing utilities regardless if they are shown on the drawings.
3. The Architect/Engineer reserves the right to make changes in lines, grades, and depths of pipe lines and manholes when such changes are necessary.

3.2 PREPARATION

- A. Identify required lines, levels, contours, and datum locations.
- B. Protect plant life, lawns, and other features remaining as a portion of final landscaping.
- C. Protect bench marks, existing structures, fences, sidewalks, paving, and curbs from excavating equipment and vehicular traffic.
- D. Maintain and protect above and below grade utilities which are to remain.
- E. Cut out soft areas of subgrade not capable of compaction in place. Backfill and compact to density equal to or greater than requirements for subsequent backfill material.

3.3 EXCAVATING

- A. Excavate subsoil required for utilities.

- B. Cut trenches sufficiently wide to enable installation and allow inspection. Remove water or materials that interfere with Work.
- C. Do not interfere with 45 degree bearing splay of foundations.
- D. Hand trim excavation. Hand trim for bell and spigot pipe joints. Remove loose matter.
- E. Remove lumped subsoil, boulders, and rock as directed by the Soils Engineer or other inspector.
- F. Correct over excavated areas with backfill and compact replacement as specified for authorized excavation.
- G. Stockpile excavated material on site. Remove excess material not being used from site.

### 3.4 TRENCHING

- A. Excavations:
  - 1. Excavation shall be dug so that the pipe can be laid and jointed properly. The trench shall be made so that the pipe can be laid to the alignment and depth as shown on the Drawings, and it shall be excavated only so far in advance of pipe laying as permitted by the Architect/Engineer. The excavation shall not be more than two feet wider at the bottom than the outside diameter of the pipe or structure. If there is no interference with construction, or adjacent property, and if soil permits, the Contractor at his own expense shall be permitted to slope the side walls of the excavation starting at a point two (2) feet above the top of pipe.
  - 2. The trench shall be excavated to the depth required so as to provide a uniform and continuous bearing and support for the pipe on bedding material at every point between joints, except where pipe slings or other lifting tackle are withdrawn.
  - 3. Excavation Below Grade:
    - 1) Where excavation indicates that the subsurface materials at the bottom of the trench are in a loose or soft state, the Contractor shall be advised to excavate to a depth where suitable material is encountered, as directed by the Architect/Engineer.
    - 2) Where the bottom of the trench has been excavated by mistake to a greater depth than required, the Contractor shall refill this area using approved material. No additional compensation shall be given to the Contractor. Refilling with earth to bring the bottom of the trench to the proper grade will not be permitted.
  - 4. Excavation within 24 inches of existing utilities shall be governed by specifications of the Owner of the respective utility. The Contractor shall obtain these specifications and follow the same at no extra cost.

5. Excavation and shoring shall adhere to the requirements and safety standards set by OSHA.

- B. Trenching in Advance of Pipe Laying: The trench for the pipe lines shall not be opened for a distance of more than 200 feet at any one time, unless authorized by the Architect/Engineer. At no time will the Contractor be permitted to leave more than 50 feet of trench open at the end of a working day. Adequate protection of open trench shall be provided by the Contractor and the Contractor shall be responsible therefore.

### 3.5 SHEETING AND BRACING

#### A. General:

1. Sheeting and bracing of all excavations shall conform to the latest statutes of the State of California governing safety of workers in the construction industry. When necessary, in the opinion of the Contractor, adequate sheeting and bracing shall be installed to prevent ground movement that may cause damage or settlement to adjacent structures, pipelines and utilities. Any damage due to settlement because of failure to use sheeting or because of inadequate bracing, or through negligence or fault of the Contractor in any other manner, shall be repaired at the Contractor's expense.
2. Sides of trenches in unsuitable, loose or soft material, five feet or more in depth, shall be shored, sheeted, braced, sloped, or otherwise supported by means of sufficient strength to protect employees working within them.

#### B. Sheeting Requirements:

3. Where excavations are made with vertical sides which require supporting, the sheeting and bracing shall be of sufficient strength to sustain the sides of the excavations and to prevent movement which could in any way injure the Work, or adjacent structures, or diminish the working space sufficiently to delay the Work. Special precautions shall be taken where there is additional pressure due to the presence of other structures.
4. It shall be the Contractor's responsibility to select sheeting and bracing of sufficient dimensions and strength and type to adequately support the sides of trenches and excavations.
5. Sheeting and bracing shall be removed before the completion of the Work.

### 3.6 BACKFILLING

- A. Backfill trenches to contours and elevations shown on the drawings.
- B. Systematically backfill to allow maximum time for natural settlement. Do not backfill over porous, wet, or spongy subgrade surfaces.
- C. Fill materials shall be as specified in the Soils Report and any supplements to the Soils Report.

- D. Employ a placement method that does not disturb or damage utilities in trench. Jetting of backfill materials to achieve compaction shall not be permitted.
- E. Maintain optimum moisture content of fill materials to attain required compaction density.
- F. Remove surplus fill materials from site.

3.7 TOLERANCES

- A. Section 01 40 00 - Quality Requirements.
- B. Top Surface of Backfilling Under Paved Areas: Plus or minus 0.05 feet from required elevations.
- C. Top Surface of General Backfilling: Plus or minus 1/10 feet from required elevations.

3.8 FIELD QUALITY CONTROL


- A. Compaction testing will be performed by the project Soils Engineer.
- B. If tests indicate Work does not meet specified requirements, remove Work, replace, compact, and retest.

3.9 PROTECTION OF FINISHED WORK


- A. Section 01 70 00 - Execution and Closeout Requirements.
- B. Reshape and re-compact fills subjected to vehicular traffic during construction.

END OF SECTION


HACIENDA STREET

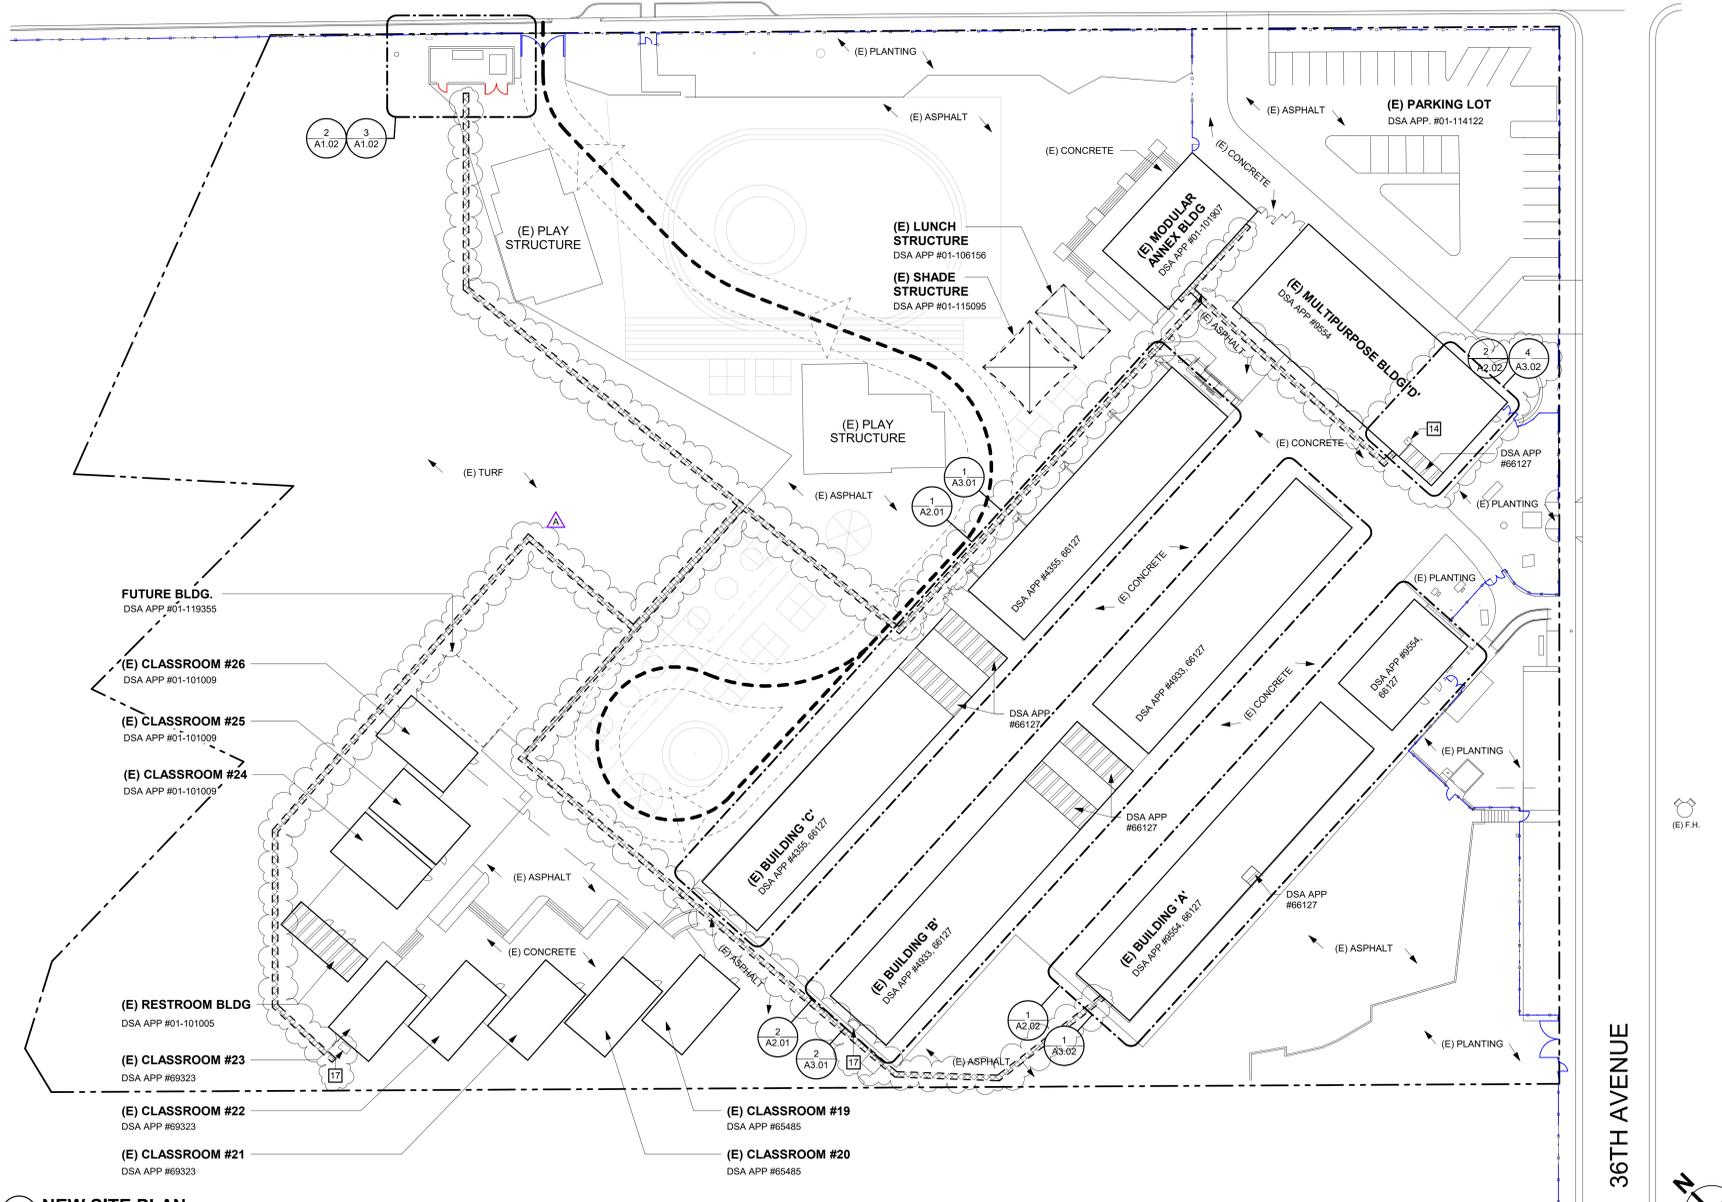


**1 NEW SITE PLAN**  
SCALE: 1/32" = 1'-0"

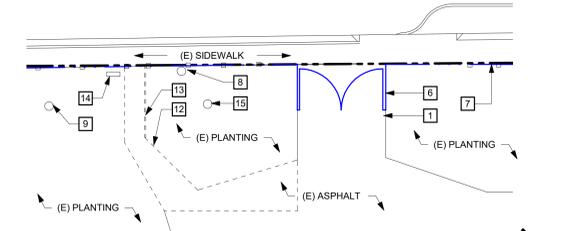

**2 ENLARGED DEMOLITION SITE PLAN**  
SCALE: 1/16" = 1'-0"

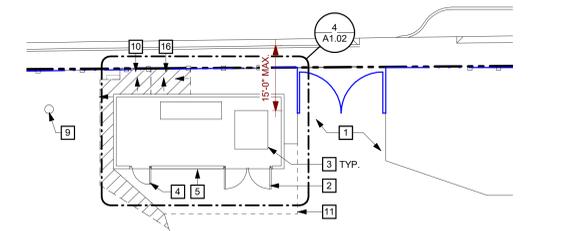


**3 ENLARGED NEW SITE PLAN**  
SCALE: 1/16" = 1'-0"

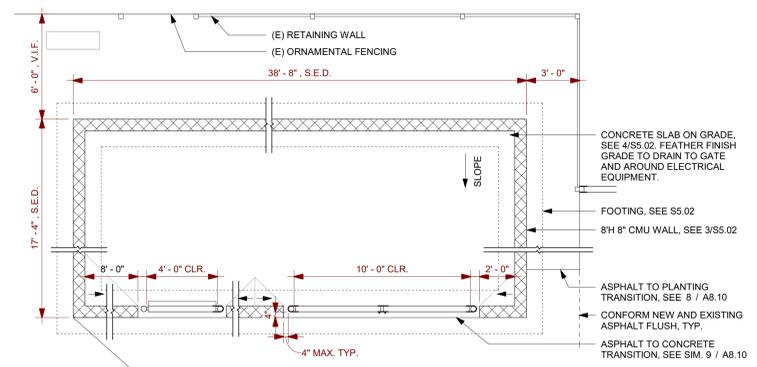

**4 ELECTRICAL ENCLOSURE ENLARGED LAYOUT**  
SCALE: 1/4" = 1'-0"

- GENERAL SHEET NOTES**
- A BUILDINGS ARE UNSPRINKLERED. TYPE V-B CONSTRUCTION UNLESS OTHERWISE NOTED.
  - B NO DEMOLITION SHALL BEGIN UNTIL PLANS INCLUDING THE DEMOLITION WORK HAVE BEEN APPROVED BY DSA.
  - C CONTRACTOR SHALL MAINTAIN FIRE LANE ACCESS THROUGHOUT PROJECT.
  - D DO NOT INTERRUPT EXISTING UTILITY SERVICES SERVING OCCUPIED OR USED FACILITIES, EXCEPT WHEN AUTHORIZED IN WRITING BY AND COORDINATED WITH THE OWNER.
  - E PROTECT EXISTING & NEW STRUCTURES, UTILITIES, SIDEWALKS, PAVEMENTS, TREES AND SHRUBS FROM DAMAGE DURING CONSTRUCTION.
  - F REFER TO ELECTRICAL AND MECHANICAL DRAWINGS FOR EXTENT OF ELECTRICAL AND MECHANICAL WORK.
  - G ALL EXISTING FINISHES OR MATERIALS DAMAGED OR DEMOLISHED DUE TO NEW CONSTRUCTION SHALL BE RESTORED TO THEIR ORIGINAL STATE, INCLUDING BUT NOT LIMITED TO REINSTALLING OR REPLACING EXISTING CHAINLINK FENCING AS REQUIRED AND RESTRIPIING PAVING IN KIND. S.E.D. FOR TRENCH ROUTING, SEE ARCHITECTURAL SITE PLAN FOR STRIPING AT EXISTING PAVING.

- SITE PLAN KEYNOTES**
- 1 (E) ASPHALT TO REMAIN.
  - 2 10'W DOUBLE GATE, SEE DETAIL 3/A8.10.
  - 3 ELECTRICAL EQUIPMENT, S.E.D.
  - 4 4'W GATE, SEE DETAIL 2/A8.10.
  - 5 CMU ENCLOSURE, S.E.D. AND S.S.D.
  - 6 (E) GATE TO REMAIN.
  - 7 (E) ORNAMENTAL FENCING TO REMAIN.
  - 8 (E) TREE TO BE REMOVED. REMOVE STUMP TO 6" BELOW GRADE.
  - 9 (E) TREE TO REMAIN.
  - 10 INFILL NATIVE SOIL. PROVIDE COVERAGE AT FOUNDATION PER 3/S5.02. CONFORM FLUSH AT ASPHALT PAVING AND PROPERTY LINE.
  - 11 INFILL ASPHALT, CONFORMING TO ADJACENT. SEE 9/A8.10.
  - 12 REMOVE (E) ASPHALT PAVING.
  - 13 REMOVE (E) RETAINING WALL, CHAINLINK FENCING, AND FOOTINGS.
  - 14 (E) EQUIPMENT TO REMAIN.
  - 15 RELOCATE (E) TREE TO ALTERNATE LOCATION ON CAMPUS. COORDINATE FINAL LOCATION WITH DISTRICT.
  - 16 AT (E) RETAINING WALL TO REMAIN, CONFORM TO ADJACENT GRADING.
  - 17 NEW TRANSFORMER PAD, S.E.D.

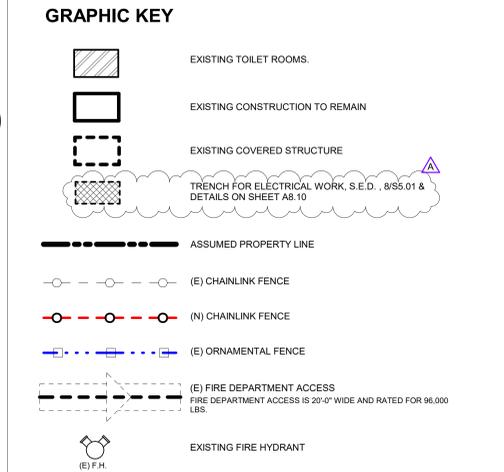


**aedis**  
architects

www.aedisarchitects.com  
387 S. 1st Street, Suite 300  
San Jose, CA 95113  
tel: (408) 300-5100  
fax: (408) 300-5121

PROJECT  
**LAUREL ELEMENTARY SCHOOL - HVAC REPLACEMENT**

SAN MATEO-FOSTER CITY SCHOOL DISTRICT

CONSULTANT

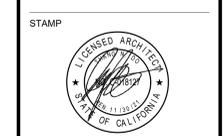

STATE  
DSA FILE NUMBER **41-26**  
APPL # **01-119551**

REVISIONS

No.	Description	Date
1	Addendum 1	11/24/2021



MILESTONES

DD	
90% CD	
DSA SUB	05/28/2021
BACKCHECK	10/06/2021



SHEET  
**SITE PLAN**

DATE **11/24/2021**  
JOB # **2021005.03**  
SHEET # **AD1-A1.02**

11/24/2021 4:58:59 PM C:\Users\szhang\Documents\2021005.03\_Laurel ES - HVAC Replacement\_Central(2019 version)\_szhangD8N3P.rvt

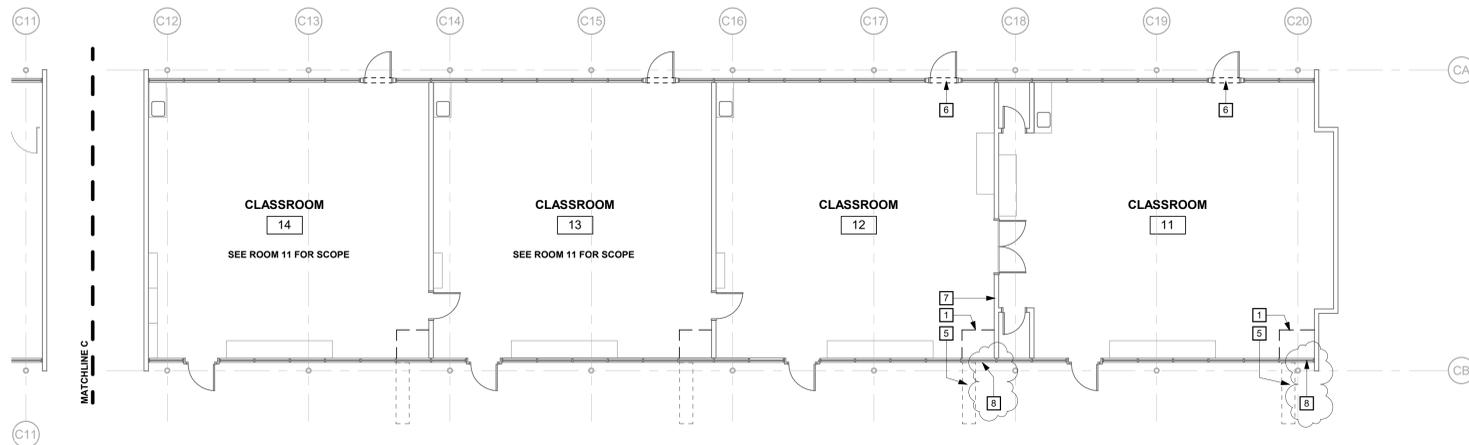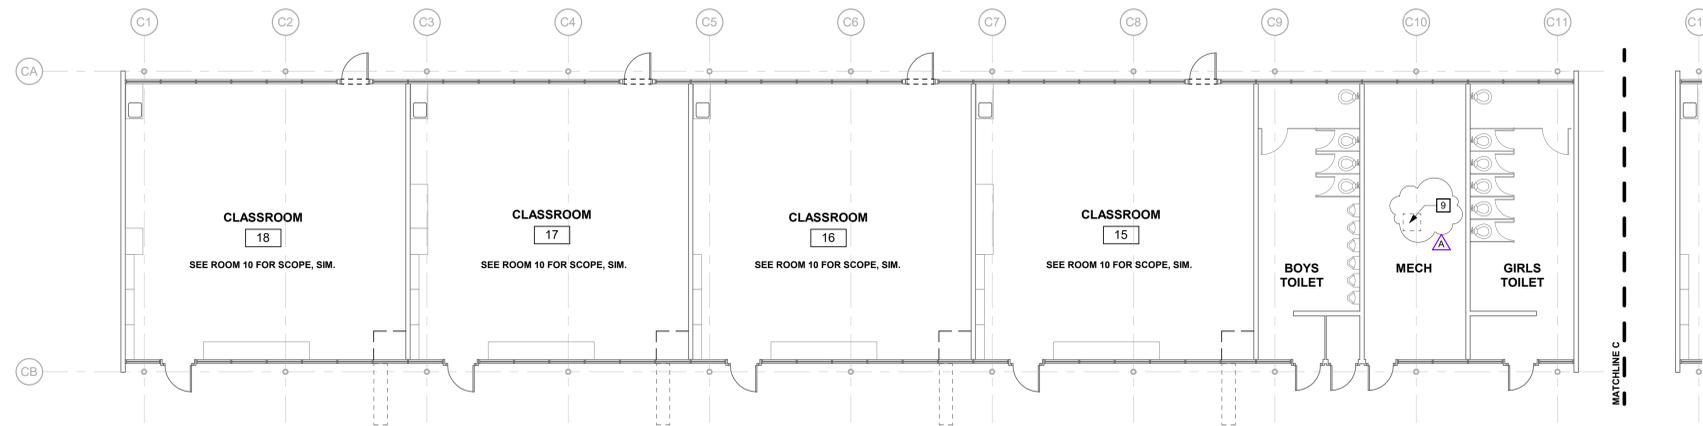

**1 DEMOLITION FLOOR PLAN - BLDG C**  
SCALE: 1/8" = 1'-0"

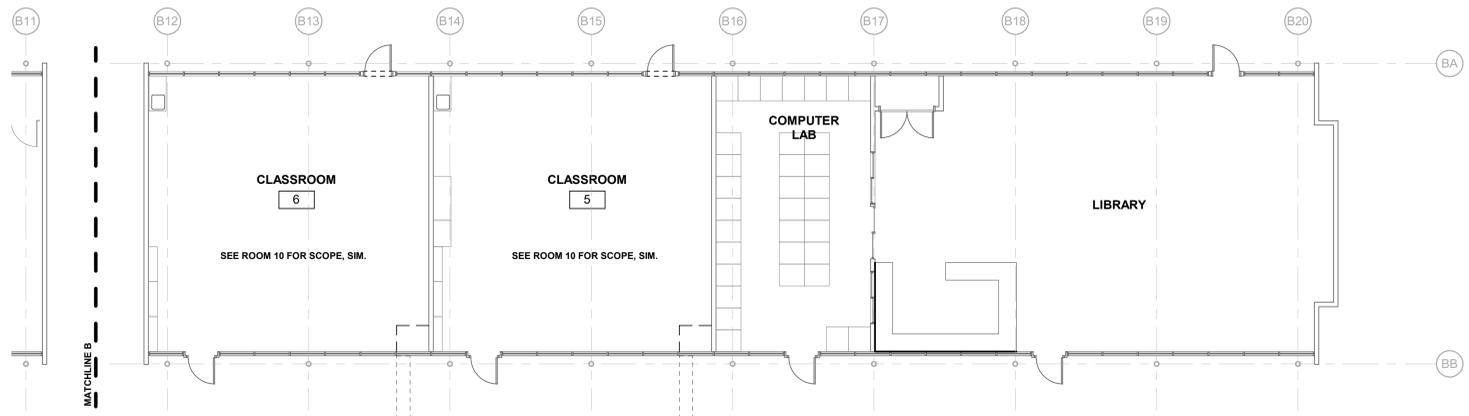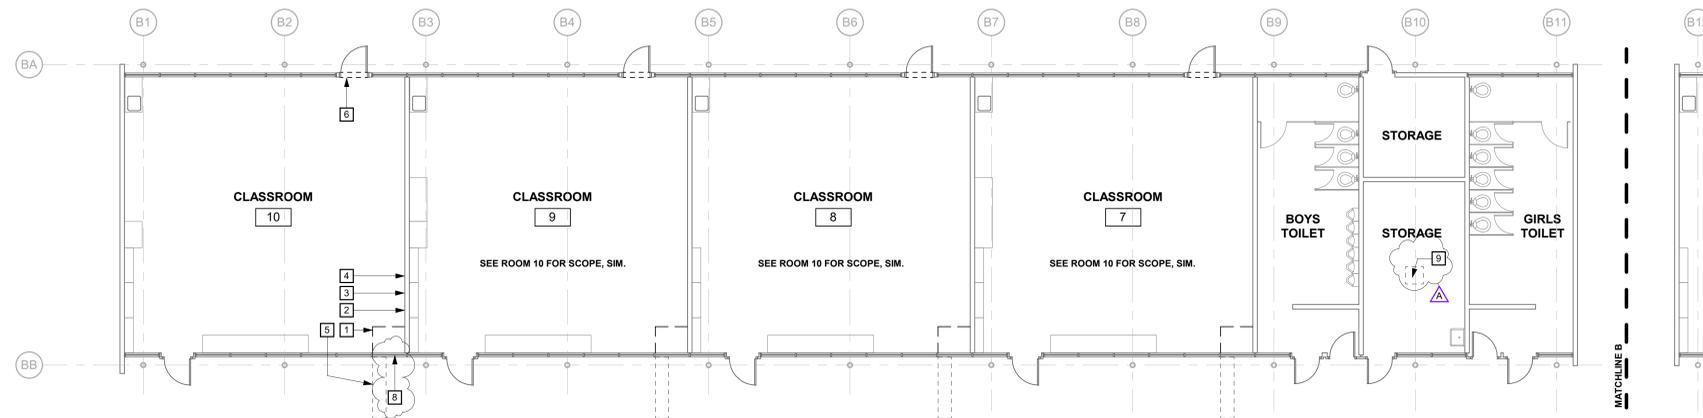

**2 DEMOLITION FLOOR PLAN - BLDG B**  
SCALE: 1/8" = 1'-0"

**GENERAL SHEET NOTES**

- A ROOM NAMES OR NUMBERS MAY NOT BE CONSISTENT BETWEEN DEMOLITION AND NEW FLOOR PLANS.
- B REFER TO MECHANICAL AND ELECTRICAL DRAWINGS FOR EXTENT OF MECHANICAL AND ELECTRICAL DEMOLITION WORK.
- C VERIFY LIMITS OF DEMOLITION WITH SCOPE OF NEW WORK PRIOR TO COMMENCING WORK.
- D ALL ITEMS SHOWN DASHED ARE TO BE DEMOLISHED UNLESS OTHERWISE NOTED ON PLANS.
- E REMOVE ALL MISCELLANEOUS TRIM, CASEWORK, EQUIPMENT, CONDUIT, BASES, AND OTHER SURFACE MOUNTED ITEMS WHETHER SHOWN OR NOT, AS REQUIRED TO FACILITATE SCOPE OF WORK. REMOVE AND CAP ALL OUTLETS, SWITCHES, WIRES, THERMOSTATS, ETC. TO THEIR SOURCE AS REQUIRED. SEE MECHANICAL AND ELECTRICAL DRAWINGS FOR ADDITIONAL INFORMATION AND SCOPE OF WORK.
- F REMOVE ADJACENT FINISHES AS REQUIRED TO FACILITATE SCOPE OF WORK. PATCH BACK IN KIND.
- G EXISTING EQUIPMENT INDICATED TO BE RELOCATED PER NEW PLAN IS TO BE STORED AND PROTECTED DURING CONSTRUCTION.
- H NO DEMOLITION SHALL BEGIN UNTIL PLANS INCLUDING THE DEMOLITION WORK HAVE BEEN APPROVED BY DSA.
- I DIMENSIONS FOR EXISTING BUILDING ARE APPROXIMATE. CONTRACTOR TO FIELD VERIFY PRIOR TO START OF CONSTRUCTION.
- J REFER TO "HVAC AND POWER UPGRADE PROJECT HAZARDOUS MATERIALS SURVEY REPORT." CONTRACTOR TO ABATE AREAS AFFECTED BY SCOPE OF WORK. REMOVE AND DISPOSE OF MATERIALS PER REPORT RECOMMENDATIONS.


**DEMOLITION FLOOR PLAN KEYNOTES**

- 1 REMOVE (E) MECHANICAL UNIT AND METAL ENCLOSURE, T-BAR AND GYP SOFFIT, S.M.D.
- 2 SHORTEN (E) RACEWAY SURROUNDING THREE SIDES OF (E) WHITEBOARD. COORDINATE LENGTH TIGHT TO NEW ENCLOSURE. SEE NEW FLOOR PLANS.
- 3 REMOVE (E) 4' X 16' WHITEBOARD AND TURN OVER TO DISTRICT
- 4 RELOCATE (E) DATA OUTLET, COORDINATED TO RECONFIGURED WIREMOLD. LOCATE A.F.F. 15" MIN. TO 48" MAX.
- 5 REMOVE PAVING AND PREP FOR NEW WORK, S.M.D.
- 6 REMOVE (E) WINDOW GLAZING ABOVE AND PREP FOR NEW WORK, S.M.D.
- 7 REMOVE (E) TACK PANEL AND TURN OVER TO DISTRICT
- 8 REMOVE (E) FILLER PANEL FOR FUTURE AIR IN-TAKE AT MECHANICAL ENCLOSURE
- 9 REMOVE PARTIAL GYP, BQ CEILING FOR FUTURE EXHAUST FAN, S.M.D.

**GRAPHIC KEY**

- EXISTING NONRATED WALL TO REMAIN.
- EXISTING STOREFRONT OR WINDOW TO REMAIN.
- - - - - EXISTING ENCLOSURE TO BE DEMOLISHED


**BUILDING KEY**

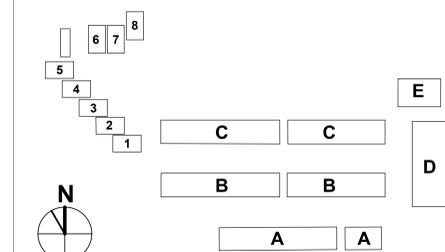

PROJECT  
**LAUREL ELEMENTARY SCHOOL - HVAC REPLACEMENT**

SAN MATEO-FOSTER CITY SCHOOL DISTRICT

CONSULTANT

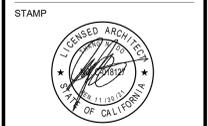

STATE  
DSA FILE NUMBER 41-26  
APPL # 01-119551

REVISIONS

No.	Description	Date
1	Addendum 1	11/24/2021


MILESTONES

DD	
90% CD	
DSA SUB	05/28/2021
BACKCHECK	10/06/2021


**DEMOLITION FLOOR PLANS - BLDG B & C**

DATE 11/24/2021  
JOB # 2021005.03  
SHEET # AD1-A2.01

11/22/2021 5:53:21 PM C:\Users\rsal\Documents\2021005.03\_Laurel ES - HVAC Replacement\_Central(2019 version)\_etisal\_aedis.rvt

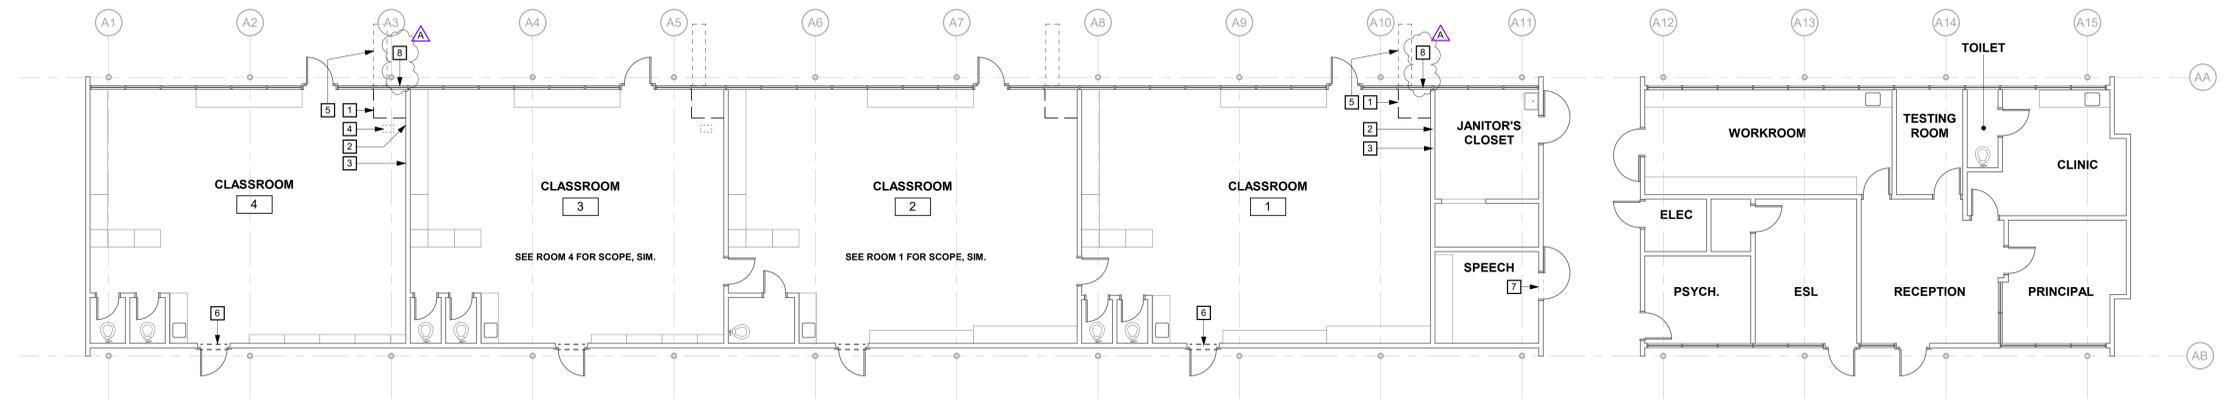

**1 DEMOLITION FLOOR PLAN - BLDG A**  
SCALE: 1/8" = 1'-0"

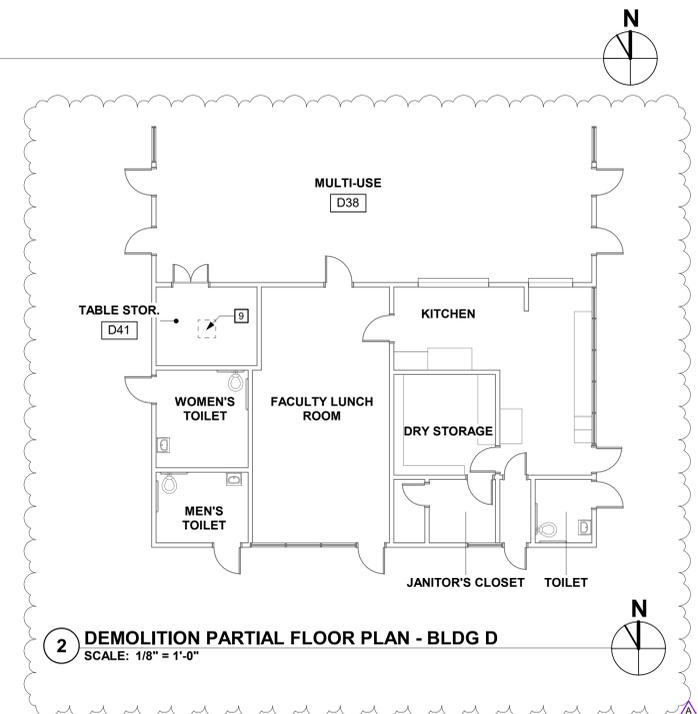

**2 DEMOLITION PARTIAL FLOOR PLAN - BLDG D**  
SCALE: 1/8" = 1'-0"

**GENERAL SHEET NOTES**

- A ROOM NAMES OR NUMBERS MAY NOT BE CONSISTENT BETWEEN DEMOLITION AND NEW FLOOR PLANS.
- B REFER TO MECHANICAL AND ELECTRICAL DRAWINGS FOR EXTENT OF MECHANICAL AND ELECTRICAL DEMOLITION WORK.
- C VERIFY LIMITS OF DEMOLITION WITH SCOPE OF NEW WORK PRIOR TO COMMENCING WORK.
- D ALL ITEMS SHOWN DASHED ARE TO BE DEMOLISHED UNLESS OTHERWISE NOTED ON PLANS.
- E REMOVE ALL MISCELLANEOUS TRIM, CASEWORK, EQUIPMENT, CONDUIT, BASES, AND OTHER SURFACE MOUNTED ITEMS WHETHER SHOWN OR NOT, AS REQUIRED TO FACILITATE SCOPE OF WORK. REMOVE AND CAP ALL OUTLETS, SWITCHES, WIRES, THERMOSTATS, ETC. TO THEIR SOURCE AS REQUIRED. SEE MECHANICAL AND ELECTRICAL DRAWINGS FOR ADDITIONAL INFORMATION AND SCOPE OF WORK.
- F REMOVE ADJACENT FINISHES AS REQUIRED TO FACILITATE SCOPE OF WORK. PATCH BACK IN KIND.
- G EXISTING EQUIPMENT INDICATED TO BE RELOCATED PER NEW PLAN IS TO BE STORED AND PROTECTED DURING CONSTRUCTION.
- H NO DEMOLITION SHALL BEGIN UNTIL PLANS INCLUDING THE DEMOLITION WORK HAVE BEEN APPROVED BY DSA.
- I DIMENSIONS FOR EXISTING BUILDING ARE APPROXIMATE. CONTRACTOR TO FIELD VERIFY PRIOR TO START OF CONSTRUCTION.

REFER TO "HVAC AND POWER UPGRADE PROJECT HAZARDOUS MATERIALS SURVEY REPORT". CONTRACTOR TO ABATE AREAS AFFECTED BY SCOPE OF WORK. REMOVE AND DISPOSE OF MATERIALS PER REPORT RECOMMENDATIONS.



**DEMOLITION FLOOR PLAN KEYNOTES**

- 1 REMOVE (E) MECHANICAL UNIT AND METAL ENCLOSURE, T-BAR AND GYP SOFFIT, S.M.D.
- 2 RECONFIGURE (E) RACEWAY. COORDINATE LENGTH TIGHT TO NEW ENCLOSURE, SEE NEW FLOOR PLANS.
- 3 REMOVE (E) TACK PANEL AND TURN OVER TO DISTRICT
- 4 (E) CEILING MOUNTED MOTION DETECTOR TO BE REMOVED AND REINSTALLED IN PLACE, AS REQUIRED TO FACILITATE CONSTRUCTION. REPLACE CEILING TILE.
- 5 REMOVE PAVING AND PREP FOR NEW WORK, S.M.D.
- 6 REMOVE (E) WINDOW GLAZING ABOVE AND PREP FOR NEW WORK, S.M.D.
- 7 PREP FOR NEW WORK, S.M.D.
- 8 REMOVE (E) FILLER PANEL FOR FUTURE AIR IN-TAKE AT MECHANICAL ENCLOSURE
- 9 REMOVE PARTIAL GYP, BD CEILING FOR FUTURE EXHAUST FAN, S.M.D.

**GRAPHIC KEY**

- EXISTING NONRATED WALL TO REMAIN.
- EXISTING STOREFRONT OR WINDOW TO REMAIN.
- - - - - EXISTING ENCLOSURE TO BE DEMOLISHED

**BUILDING KEY**

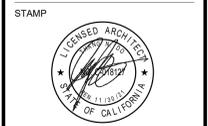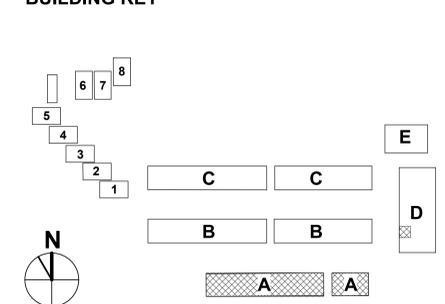

STATE  
DSA FILE NUMBER 41-26  
APPL # 01-119551

REVISIONS


No.	Description	Date
1	Addendum 1	11/24/2021

MILESTONES


DD	
90% CD	
DSA SUB	05/28/2021
BACKCHECK	10/06/2021

**DEMOLITION FLOOR PLAN - BLDG A**

DATE 11/24/2021  
JOB # 2021005.03  
SHEET # AD1-A2.02

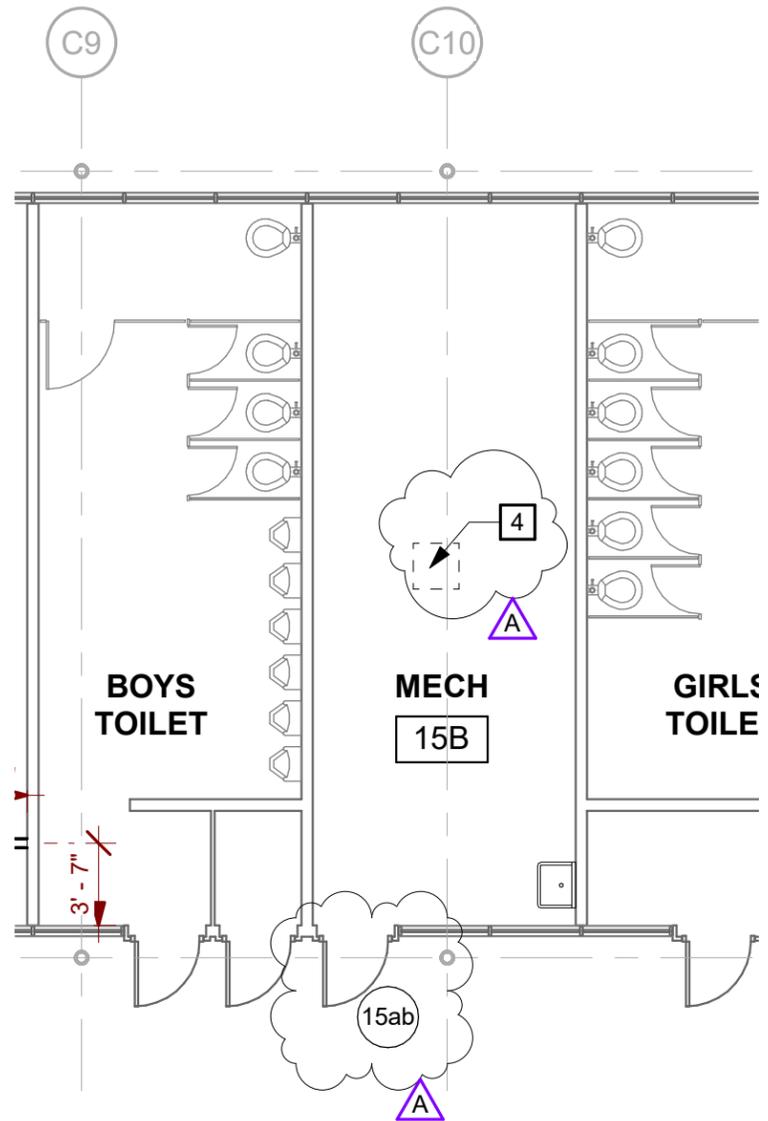

**1 NEW FLOOR PLAN - BLDG C**  
SCALE: 1/8" = 1'-0"

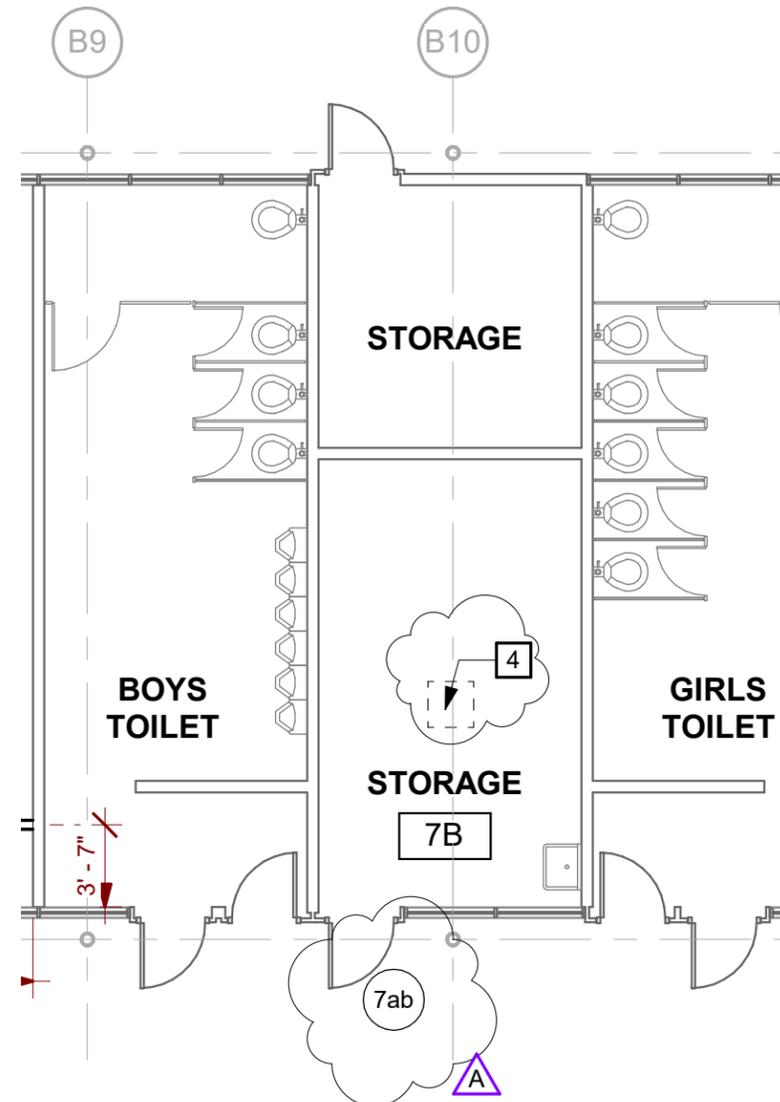


**2 NEW FLOOR PLAN - BLDG B**  
SCALE: 1/8" = 1'-0"

### NEW FLOOR PLAN KEYNOTES

- 3 REFER TO 2/A3.02 FOR TYPICAL REFLECTED CEILING PLAN. REMOVE AND REINSTALL (E) ACOUSTICAL CEILING TILES ABOVE AS REQUIRED FOR CONSTRUCTION ACCESS INCLUDING BUT NOT LIMITED TO ELECTRICAL ROUTING, MECHANICAL DUCTWORK ANCHORAGE, BLOCKING FOR ROOFTOP PLATFORMS. DO NOT ALTER SUSPENDED A.C.T. GRID. ▲
- 4 PATCH AND PAINT GYP. BD. CEILING ADJACENT EXHAUST FAN. S.M.D.



		LAUREL ELEMENTARY SCHOOL - HVAC REPLACEMENT		
		SAN MATEO-FOSTER CITY SCHOOL DISTRICT		
387 S. 1st Street, Suite 300 San Jose, CA., 95113		tel: (408) 300 - 5160 fax: (408) 300 - 5121	FILE NO.: 41-26 APPL NO.: 01-119551 JOB NO. 2021005.03 DATE 11/24/21	SHEET <b>AD1-A3.01</b>

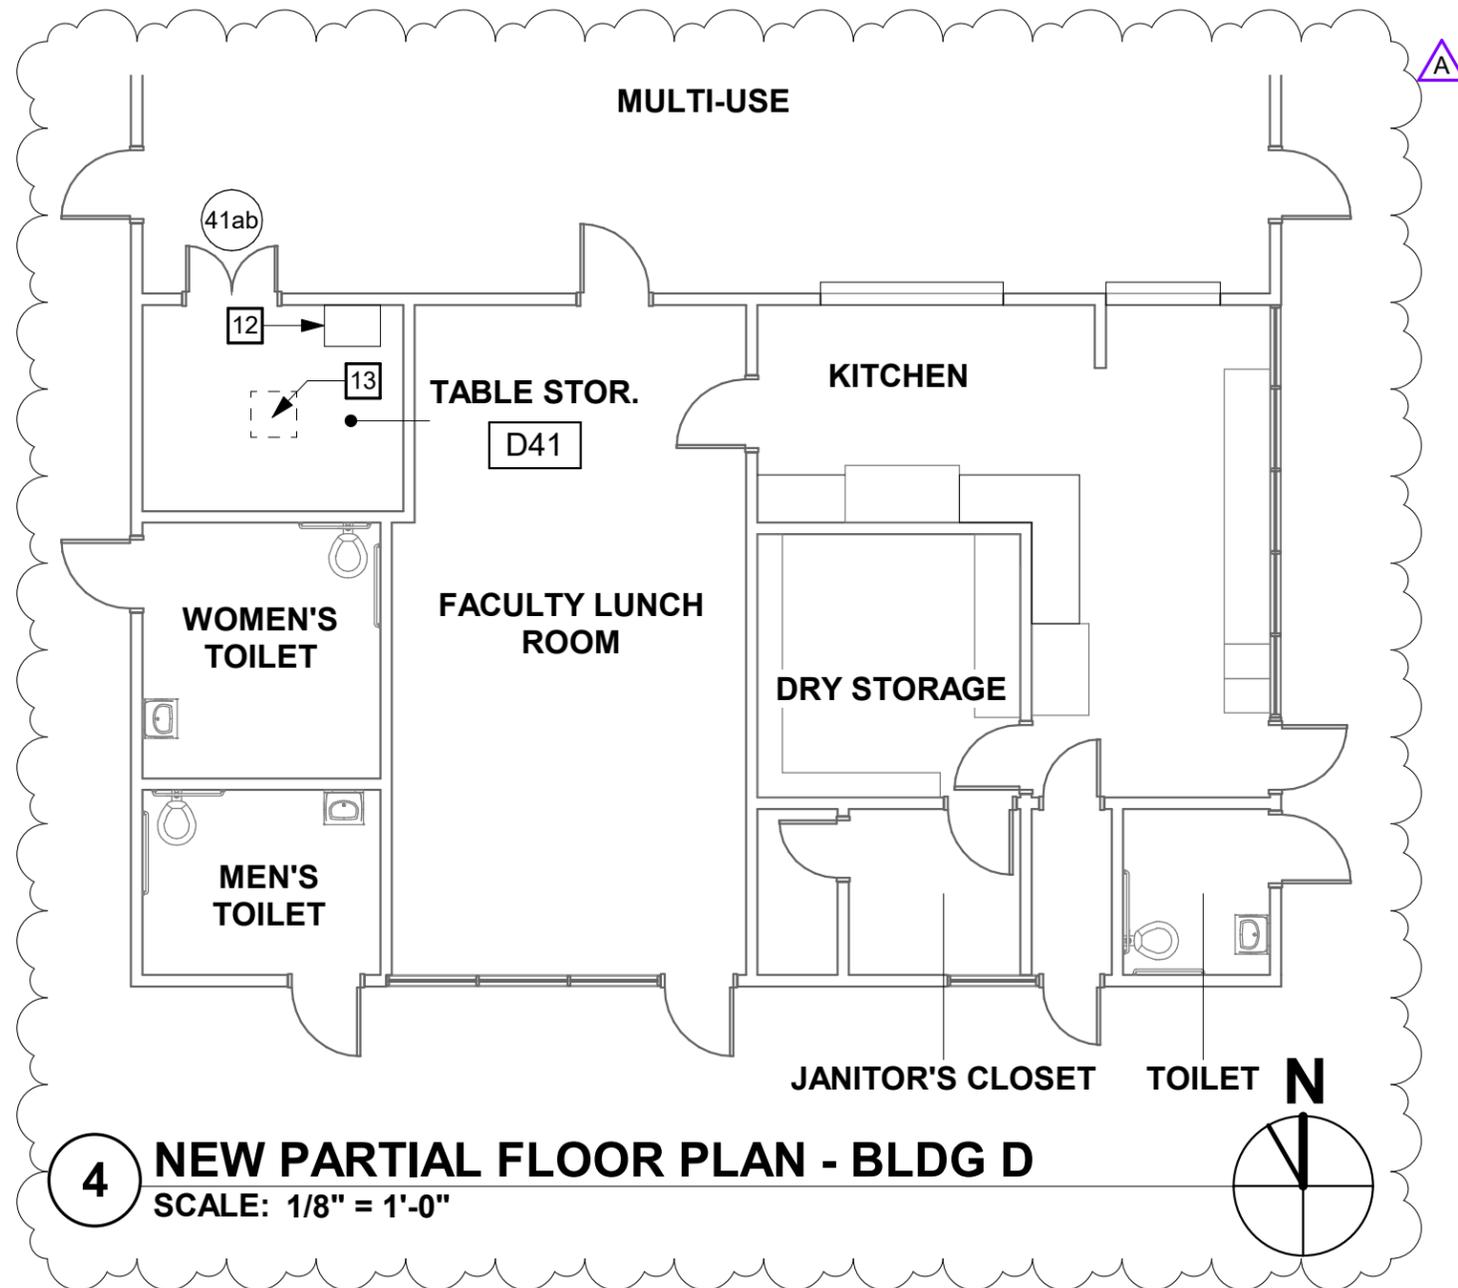

### NEW FLOOR PLAN KEYNOTES

- 6 REFER TO 2/A3.02 FOR TYPICAL REFLECTED CEILING PLAN. REMOVE AND REINSTALL (E) ACOUSTICAL CEILING TILES ABOVE AS REQUIRED FOR CONSTRUCTION ACCESS INCLUDING BUT NOT LIMITED TO ELECTRICAL ROUTING, MECHANICAL DUCTWORK ANCHORAGE, BLOCKING FOR ROOFTOP PLATFORMS. DO NOT ALTER SUSPENDED A.C.T. GRID.
- 12 ELECTRICAL EQUIPMENT S.E.D.
- 13 PATCH AND PAINT GYP. BD. CEILING ADJACENT EXHAUST FAN. S.M.D.



		LAUREL ELEMENTARY SCHOOL - HVAC REPLACEMENT	
		SAN MATEO-FOSTER CITY SCHOOL DISTRICT	
FILE NO.:	41-26	SHEET	
APPL NO.:	01-119551	<b>AD1-A3.02</b>	
JOB NO.:	2021005.03		
DATE	11/24/21		
387 S. 1st Street, Suite 300 San Jose, CA., 95113		tel: (408) 300-5160 fax: (408) 300-5121	

PROJECT

LAUREL  
ELEMENTARY  
SCHOOL - HVAC  
REPLACEMENT

SAN MATEO-FOSTER CITY  
SCHOOL DISTRICT

CONSULTANT

STAMP



STATE

DSA FILE NUMBER 41-26

APPL # 01-119551

REVISIONS

No.	Description	Date
1	Addendum 1	11/24/2021

MILESTONES

DD	
90% CD	
DSA SUB	05/28/2021
BACKCHECK	10/06/2021





SHEET

SITE ROOF PLAN

DATE 11/24/2021

JOB # 2021005.03

SHEET # AD1-  
A5.01

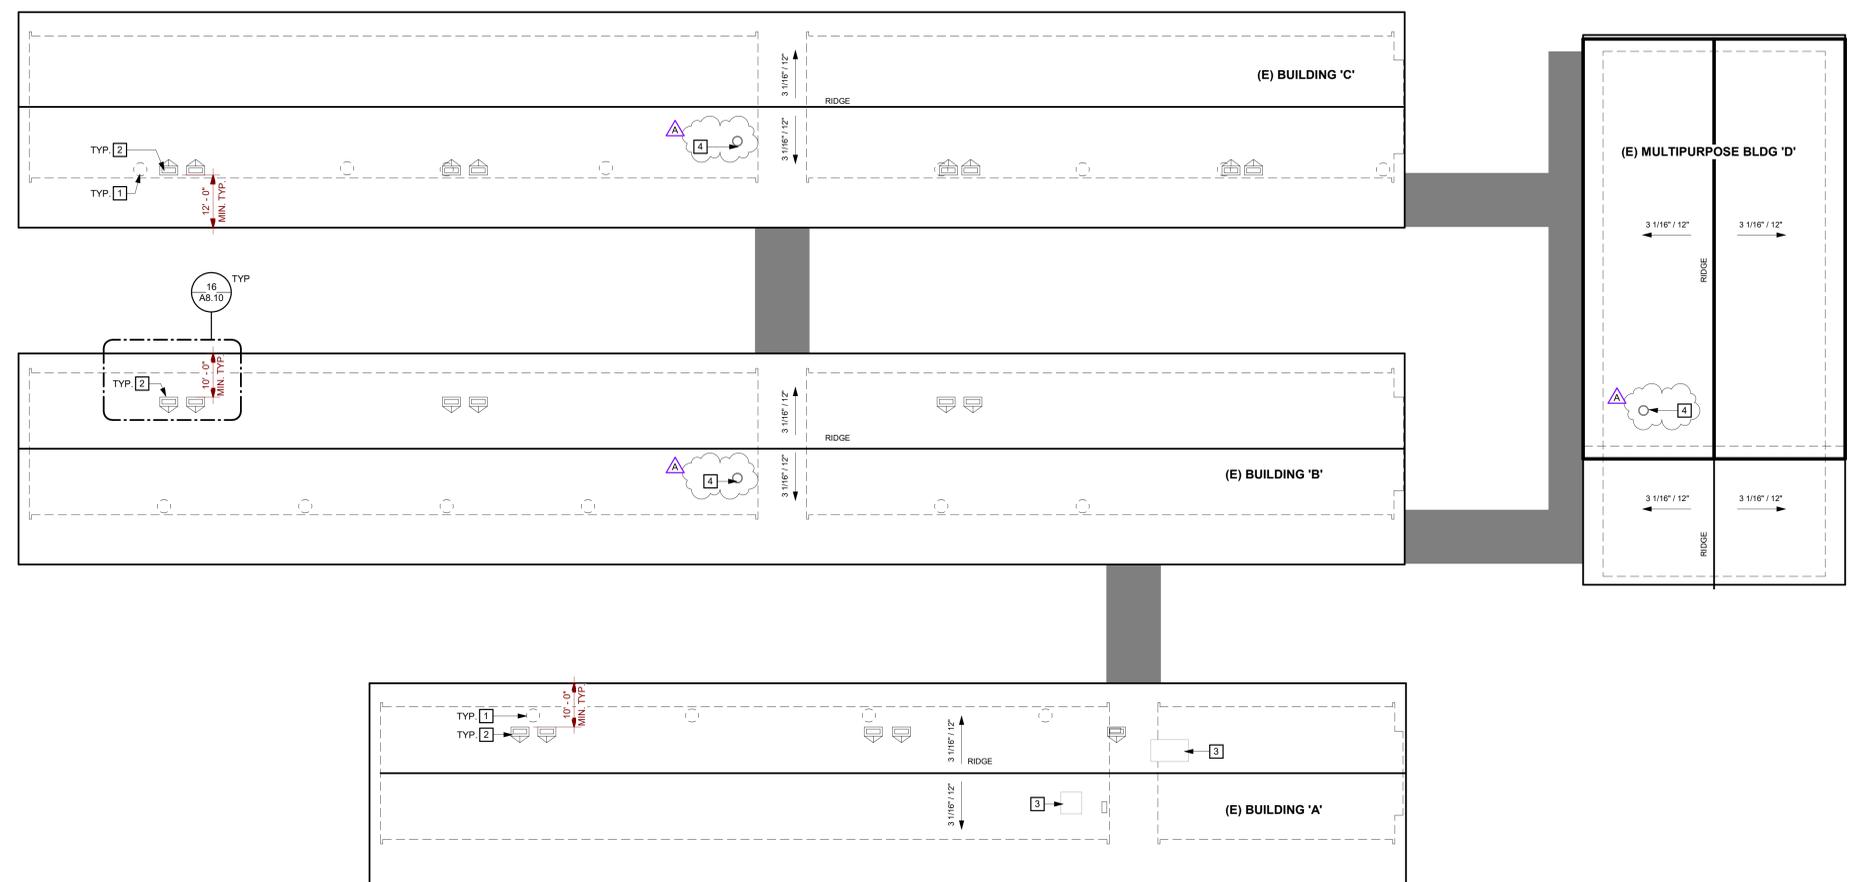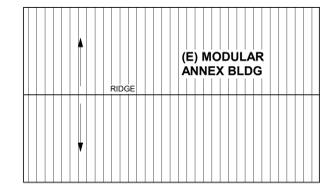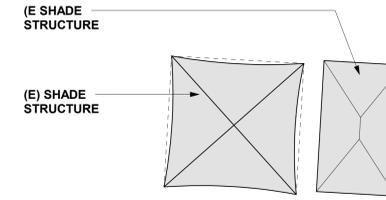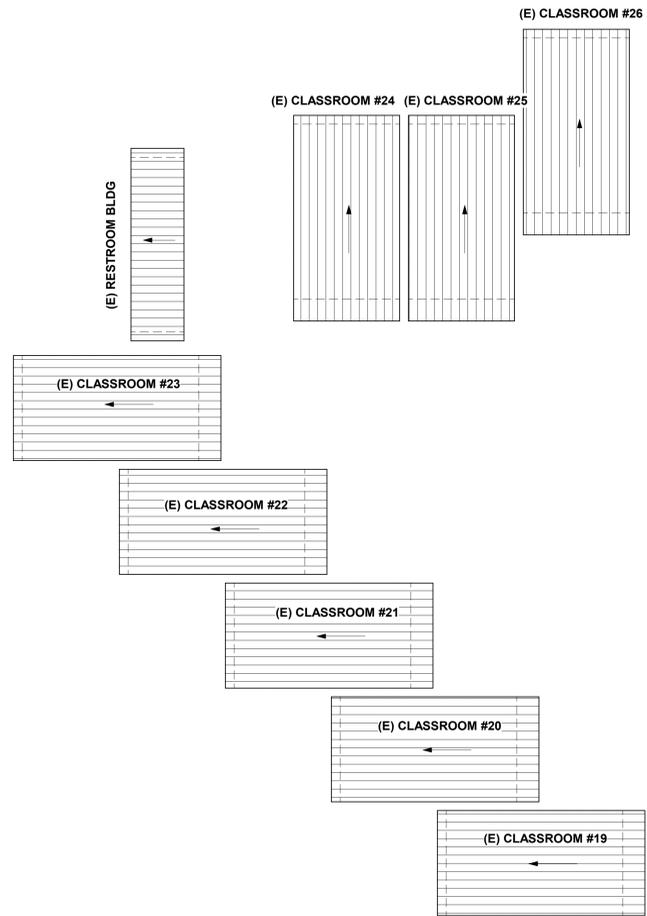

1 SITE ROOF PLAN  
SCALE: 1/16" = 1'-0"

GENERAL SHEET NOTES

- A REFER TO MECHANICAL AND ELECTRICAL DRAWINGS FOR EXTENT OF MECHANICAL AND ELECTRICAL WORK.
- B SIZE OF MECHANICAL EQUIPMENT PADS ARE FOR REFERENCE ONLY. THE CONTRACTOR SHALL VERIFY REQUIRED PAD DIMENSION WITH EQUIPMENT MANUFACTURER.
- C REFER TO "HVAC AND POWER UPGRADE PROJECT HAZARDOUS MATERIALS SURVEY REPORT." CONTRACTOR TO ABATE AREAS AFFECTED BY SCOPE OF WORK. REMOVE AND DISPOSE OF MATERIALS PER REPORT RECOMMENDATIONS.


SITE ROOF PLAN KEYNOTES

- 1 PATCH (E) PENETRATION AT REMOVED FLUE AND COMBUSTION AIR INTAKE AND PATCH (N) PENETRATIONS. S.M.D. AND SEE DETAIL 17/A8.10
- 2 MECHANICAL UNIT ON PLATFORM WITH CRICKET. S.M.D. AND SEE DETAIL 10/A8.10. REMOVE (E) ROOFING TO SUBSTRATE FOR CONSTRUCTION ACCESS.
- 3 (E) MECHANICAL EQUIPMENT
- 4 EXHAUST FAN SEE 10/A8.10 SIM. S.M.D. REMOVE (E) ROOFING TO SUBSTRATE AND PREP OPENING AS REQUIRED FOR NEW WORK.

GRAPHIC KEY

- (E) ASPHALT SHINGLE, CLASS C MINIMUM
- (E) STANDING SEAM, CLASS C MINIMUM
- (E) MINERAL CAP SHEET, CLASS C MINIMUM
- (E) METAL ROOFING
- OUTLINE OF WALL BELOW




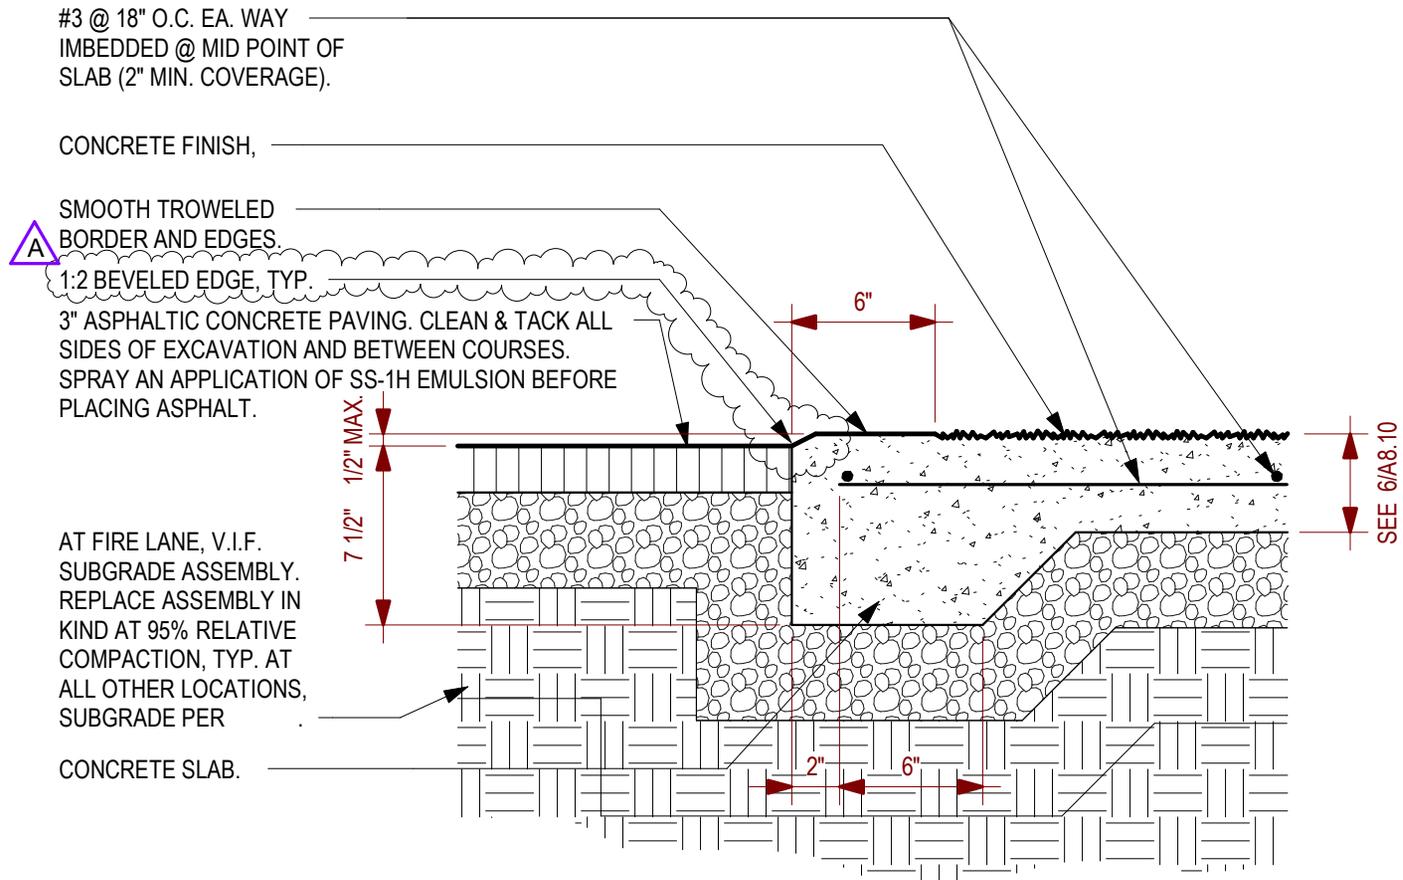

**9 ASPHALT/CONCRETE JOINT**  
SCALE: 1 1/2" = 1'-0"




		LAUREL ELEMENTARY SCHOOL - HVAC REPLACEMENT SAN MATEO FOSTER CITY SCHOOL DISTRICT	
		FILE NO.: 41-26	SHEET
387 S. 1st Street, Suite 300 San Jose, CA., 95113 tel: (408) 300 - 5160 fax: (408) 300 - 5121		APPL NO.: 01-119551	<b>AD1-A8.10</b>
		JOB NO.: 2021005.03	
		DATE 11/24/2021	

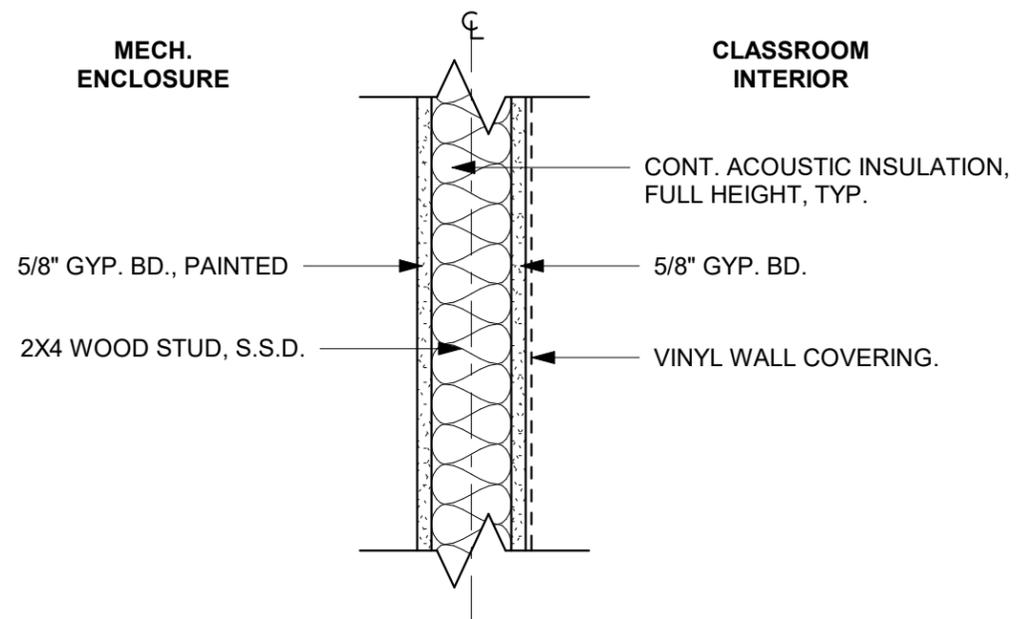

**NOTE:**  
SEE DETAIL 6/A9.10 FOR TYPICAL SOUND TREATED NONRATED WALL. A



**1** **WALL TYPE - MECHANICAL ENCLOSURE**  
SCALE: 1 1/2" = 1'-0"

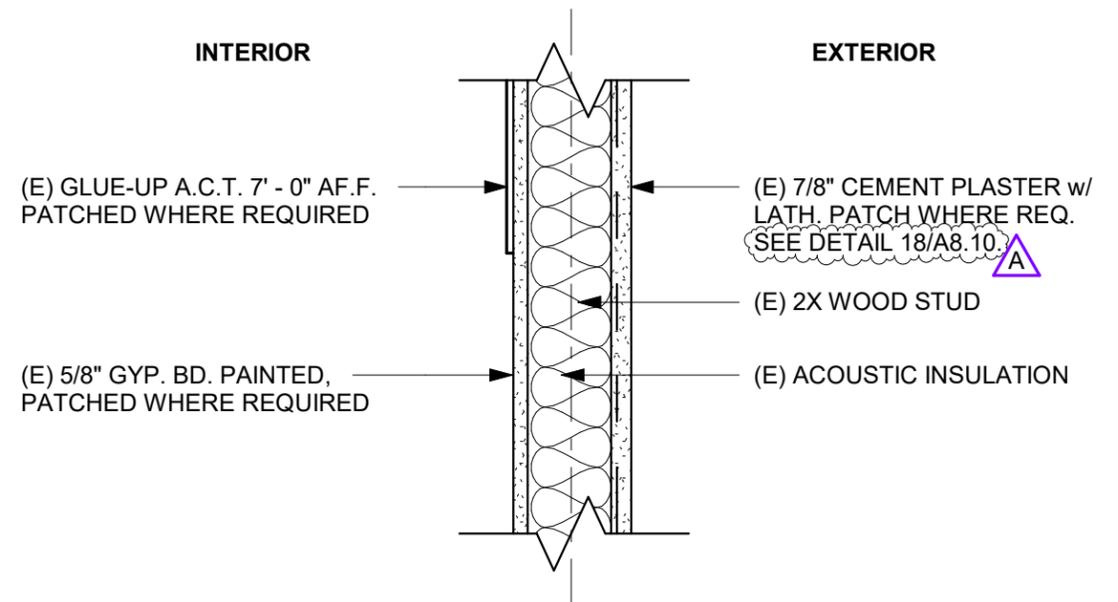

**4** **(E) WALL TYPE - GLUE-UP A.C.T. / EXT. CEMENT PLASTER**  
SCALE: 1 1/2" = 1'-0"



		LAUREL ELEMENTARY SCHOOL - HVAC REPLACEMENT	
		SAN MATEO-FOSTER CITY SCHOOL DISTRICT	
FILE NO.:	41-26	SHEET	
APPL NO.:	01-119551	<b>AD1-A9.10A</b>	
JOB NO.:	2021005.03		
DATE	11/24/2021		
387 S. 1st Street, Suite 300 San Jose, CA., 95113		tel: (408) 300 - 5160 fax: (408) 300 - 5121	

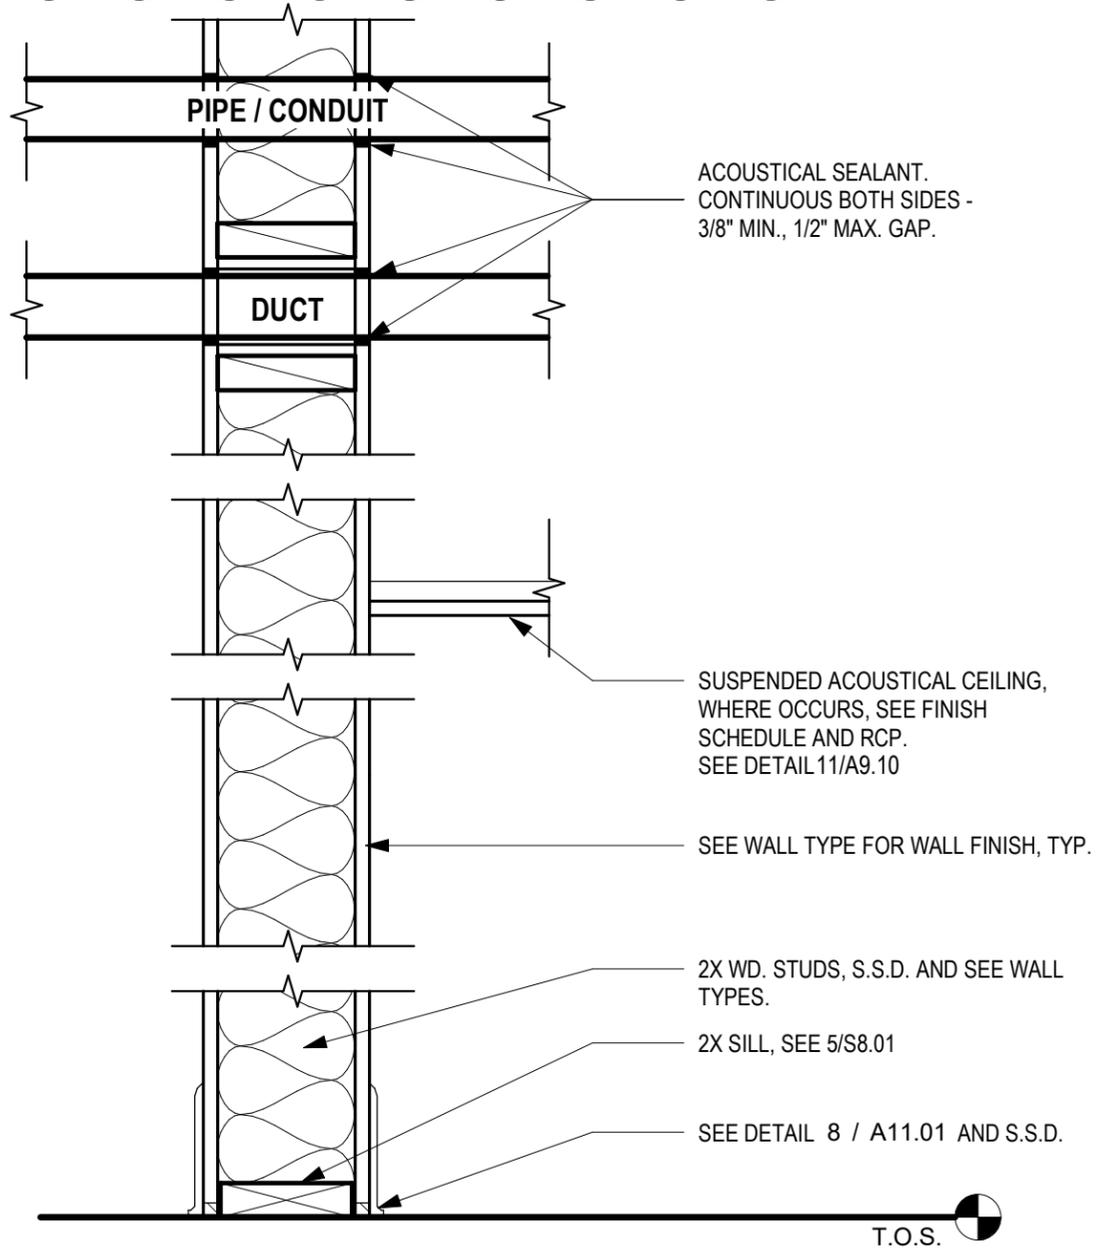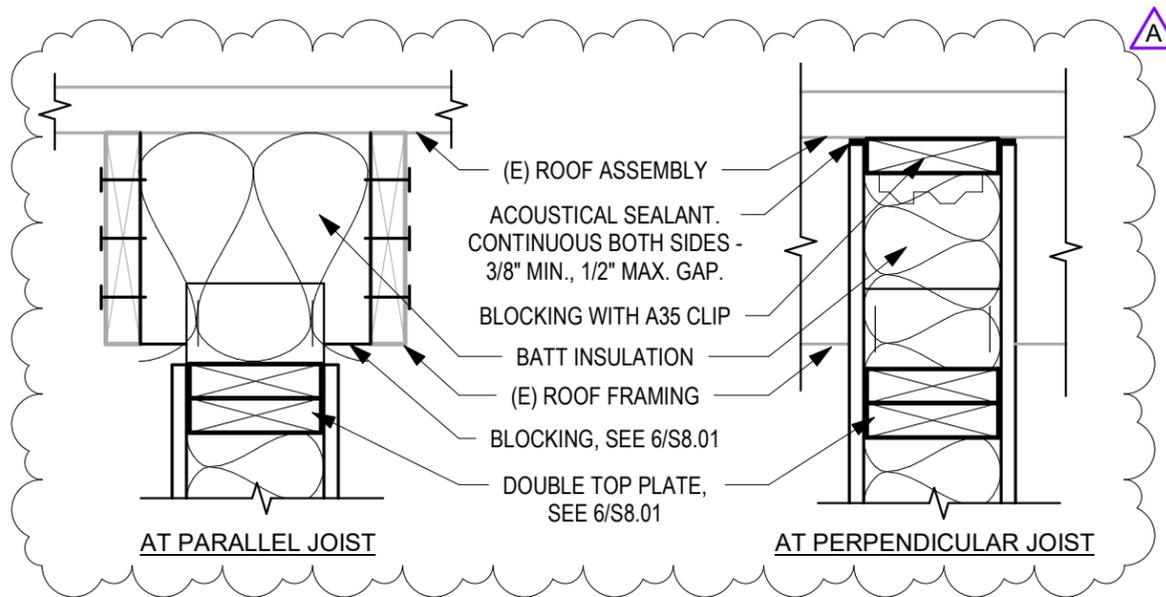

- NOTES:**
- FOR RECESSED ACCESSORIES OR CABINETS, PROVIDE BLOCKING, GYPSUM BOARD AND ACOUSTICAL SEALANT SIMILAR TO DETAIL AT DUCT.


**6 TYPICAL SOUND TREATED NONRATED WALL**  
 SCALE: 1 1/2" = 1'-0"



		LAUREL ELEMENTARY SCHOOL - HVAC REPLACEMENT SAN MATEO-FOSTER CITY SCHOOL DISTRICT	
		FILE NO.: 41-26	SHEET
387 S. 1st Street, Suite 300 San Jose, CA., 95113		tel: (408) 300 - 5160 fax: (408) 300 - 5121	APPL NO.: 01-119551 JOB NO. 2021005.03 DATE 11/24/2021
			<b>AD1-A9.10B</b>

## DOOR SCHEDULE

DOOR ID	OPENING SIZE		DOOR		FRAME		DETAILS (Sheet A11.01 U.O.N.)				HARDWARE GROUP	COMMENTS
	WIDTH	HEIGHT	TYPE	FINISH	TYPE	FINISH	HEAD	JAMB-1	JAMB-2	SILL		
1a	2' - 6"	7' - 0"	A	P-2	F1	P-3	11/A11.01	11/A11.01	11/A11.01	4/A11.01	01	
2a	2' - 6"	7' - 0"	A	P-2	F1	P-3	11/A11.01	11/A11.01	11/A11.01	4/A11.01	01	
3a	2' - 6"	7' - 0"	A	P-2	F1	P-3	11/A11.01	11/A11.01	11/A11.01	4/A11.01	01	
4a	2' - 6"	7' - 0"	A	P-2	F1	P-3	11/A11.01	11/A11.01	11/A11.01	4/A11.01	01	
5a	2' - 6"	7' - 0"	A	P-2	F1	P-3	11/A11.01	11/A11.01	11/A11.01	4/A11.01	01	
6a	2' - 6"	7' - 0"	A	P-2	F1	P-3	11/A11.01	11/A11.01	11/A11.01	4/A11.01	01	
7a	2' - 6"	7' - 0"	A	P-2	F1	P-3	11/A11.01	11/A11.01	11/A11.01	4/A11.01	01	
7ab	2' - 10"	7' - 0"	B	-	-	-	-	-	-	-	-	1
8a	2' - 6"	7' - 0"	A	P-2	F1	P-3	11/A11.01	11/A11.01	11/A11.01	4/A11.01	01	
9a	2' - 6"	7' - 0"	A	P-2	F1	P-3	11/A11.01	11/A11.01	11/A11.01	4/A11.01	01	
10a	2' - 6"	7' - 0"	A	P-2	F1	P-3	11/A11.01	11/A11.01	11/A11.01	4/A11.01	01	
11a	2' - 6"	7' - 0"	A	P-2	F1	P-3	11/A11.01	11/A11.01	11/A11.01	4/A11.01	01	
12a	2' - 6"	7' - 0"	A	P-2	F1	P-3	11/A11.01	11/A11.01	11/A11.01	4/A11.01	01	
13a	2' - 6"	7' - 0"	A	P-2	F1	P-3	11/A11.01	11/A11.01	11/A11.01	4/A11.01	01	
14a	2' - 6"	7' - 0"	A	P-2	F1	P-3	11/A11.01	11/A11.01	11/A11.01	4/A11.01	01	
15a	2' - 6"	7' - 0"	A	P-2	F1	P-3	11/A11.01	11/A11.01	11/A11.01	4/A11.01	01	
15ab	2' - 10"	7' - 0"	B	-	-	-	-	-	-	-	-	1
16a	2' - 6"	7' - 0"	A	P-2	F1	P-3	11/A11.01	11/A11.01	11/A11.01	4/A11.01	01	
17a	2' - 6"	7' - 0"	A	P-2	F1	P-3	11/A11.01	11/A11.01	11/A11.01	4/A11.01	01	
18a	2' - 6"	7' - 0"	A	P-2	F1	P-3	11/A11.01	11/A11.01	11/A11.01	4/A11.01	01	
41ab	4' - 0"	7' - 0"	B	-	-	-	-	-	-	-	-	1

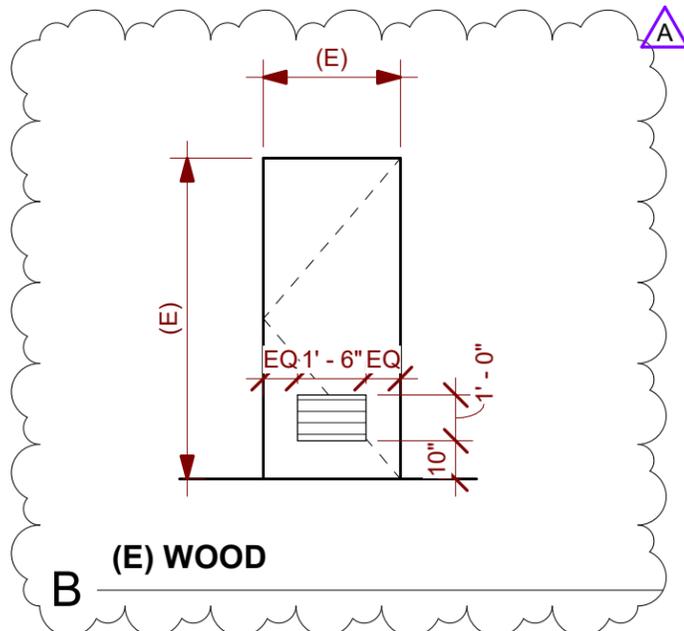

### DOOR SCHEDULE COMMENTS

1 PROVIDE NEW LOUVER AT EXISTING DOOR. CUT AND PREP AS REQUIRED. PAINT LOUVER TO DOOR.

**DOOR TYPES**  
SCALE: 1/4" = 1'-0"



<b>aedis</b> architects		LAUREL ELEMENTARY SCHOOL - HVAC REPLACEMENT SAN MATEO-FOSTER CITY SCHOOL DISTRICT	
387 S. 1st Street, Suite 300 San Jose, CA., 95113	tel: (408) 300 - 5160 fax: (408) 300 - 5121	FILE NO.: 41-26 APPL NO.: 01-119551 JOB NO.: 2021005.03 DATE: 11/24/2021	SHEET <b>AD1-A11.01</b>

PROJECT  
**LAUREL  
ELEMENTARY  
SCHOOL - HVAC  
REPLACEMENT**

SAN MATEO-FOSTER CITY  
SCHOOL DISTRICT

CONSULTANT

DECISION: 2005

**CYPRESS**  
Engineering Group

HVAC, Plumbing, Fire Protection  
Building, Mechanical, Electrical  
Environmental Compliance  
Training & Technical Support

cypresseng.com



STATE  
FILE NUMBER **41-26**  
APPL # **01-119551**

REVISIONS

No.	Description	Date
1	Addendum 1	11/24/2021

MILESTONES

DD	
90% CD	
DSA SUB	05/28/2021
BACKCHECK	10/06/2021

SHEET  
**SCHEDULES-  
MECHANICAL &  
PLUMBING**

DATE **11/24/2021**  
JOB # **2021005.03**  
SHEET # **AD1-  
MP0.02**

**ROOF EXHAUST FANS SCHEDULE**

TAG	MANUFACTURER	MODEL NO.	AREA SERVED	AIRFLOW CFM	ESP IN. W.G.	FAN RPM	SOUND POWER SONES	MOTOR		WEIGHT LBS	MOUNTING DETAIL	NOTES
								HP / WATTS	V / PH			
REF-B-1	GREENHECK	G-098-VG	STORAGE	450	0.25	1125	6.0	1/4	115 / 1	45	16/MP6.01	1, 2
REF-C-1	GREENHECK	G-098-VG	MECH	450	0.25	1125	6.0	1/4	115 / 1	45	16/MP6.01	1, 2
REF-D-1	GREENHECK	G-070-VG	TABLE STORAGE	250	0.25	1479	4.1	1/15	115 / 1	45	16/MP6.01	1, 2

1. PROVIDE WITH UL LISTING, FAN MOUNTED SPEED CONTROL, BACKDRAFT DAMPER, BIRDSCREEN, AND ROOF CURB.  
2. PROVIDE WITH LINE VOLTAGE TSTAT.

**CLASSROOM SPLIT SYSTEM HEAT PUMPS SCHEDULE**

TAG	MANUFACTURER BASIS OF DESIGN	MODEL	BLDG	LOCATION	COOLING	HEATING	AIRFLOW CFM	OUTSIDE AIR CFM	REFRIGERANT PIPING		SEER	HSPF	ELECTRICAL			WEIGHT LBS	MOUNTING DETAIL	NOTES
					TOTAL MBH	TOTAL MBH			LIQUID	GAS			V / PH	MCA	MOCP			
FC-1	SAMSUNG	AM054TNZDCHAA	BLDG A	CLASSROOM 1	53	61	1150	450	3/8"	3/4"	-	-	208/1	2.6	15	164	1/MP6.01	2, 3, 4, 5, 6, 7
HP-1	SAMSUNG	AM053TXMDCHAA		ROOF	-	-	3/8"	3/4"	17.5	10	208 / 1	34	50	212	3/MP6.01	1		
FC-2	SAMSUNG	AM054TNZDCHAA		CLASSROOM 2	53	61	1150	450	3/8"	3/4"	-	-	208/1	2.6	15	164	1/MP6.01	2, 3, 4, 5, 6, 7
HP-2	SAMSUNG	AM053TXMDCHAA		ROOF	-	-	3/8"	3/4"	17.5	10	208 / 1	34	50	212	3/MP6.01	1		
FC-3	SAMSUNG	AM054TNZDCHAA	CLASSROOM 3	53	61	1150	450	3/8"	3/4"	-	-	208/1	2.6	15	164	1/MP6.01	2, 3, 4, 5, 6, 7	
HP-3	SAMSUNG	AM053TXMDCHAA	ROOF	-	-	3/8"	3/4"	17.5	10	208 / 1	34	50	212	3/MP6.01	1			
FC-4	SAMSUNG	AM054TNZDCHAA	CLASSROOM 4	53	61	1150	450	3/8"	3/4"	-	-	208/1	2.6	15	164	1/MP6.01	2, 3, 4, 5, 6, 7	
HP-4	SAMSUNG	AM053TXMDCHAA	ROOF	-	-	3/8"	3/4"	17.5	10	208 / 1	34	50	212	3/MP6.01	1			
FC-5	SAMSUNG	AM054TNZDCHAA	CLASSROOM 5	53	61	1150	450	3/8"	3/4"	-	-	208/1	2.6	15	164	1/MP6.01	2, 3, 4, 5, 6, 7	
HP-5	SAMSUNG	AM053TXMDCHAA	ROOF	-	-	3/8"	3/4"	17.5	10	208 / 1	34	50	212	3/MP6.01	1			
FC-6	SAMSUNG	AM054TNZDCHAA	CLASSROOM 6	53	61	1150	450	3/8"	3/4"	-	-	208/1	2.6	15	164	1/MP6.01	2, 3, 4, 5, 6, 7	
HP-6	SAMSUNG	AM053TXMDCHAA	ROOF	-	-	3/8"	3/4"	17.5	10	208 / 1	34	50	212	3/MP6.01	1			
FC-7	SAMSUNG	AM054TNZDCHAA	CLASSROOM 7	53	61	1150	450	3/8"	3/4"	-	-	208/1	2.6	15	164	1/MP6.01	2, 3, 4, 5, 6, 7	
HP-7	SAMSUNG	AM053TXMDCHAA	ROOF	-	-	3/8"	3/4"	17.5	10	208 / 1	34	50	212	3/MP6.01	1			
FC-8	SAMSUNG	AM054TNZDCHAA	CLASSROOM 8	53	61	1150	450	3/8"	3/4"	-	-	208/1	2.6	15	164	1/MP6.01	2, 3, 4, 5, 6, 7	
HP-8	SAMSUNG	AM053TXMDCHAA	ROOF	-	-	3/8"	3/4"	17.5	10	208 / 1	34	50	212	3/MP6.01	1			
FC-9	SAMSUNG	AM054TNZDCHAA	CLASSROOM 9	53	61	1150	450	3/8"	3/4"	-	-	208/1	2.6	15	164	1/MP6.01	2, 3, 4, 5, 6, 7	
HP-9	SAMSUNG	AM053TXMDCHAA	ROOF	-	-	3/8"	3/4"	17.5	10	208 / 1	34	50	212	3/MP6.01	1			
FC-10	SAMSUNG	AM054TNZDCHAA	CLASSROOM 10	53	61	1150	450	3/8"	3/4"	-	-	208/1	2.6	15	164	1/MP6.01	2, 3, 4, 5, 6, 7	
HP-10	SAMSUNG	AM053TXMDCHAA	ROOF	-	-	3/8"	3/4"	17.5	10	208 / 1	34	50	212	3/MP6.01	1			
FC-11	SAMSUNG	AM054TNZDCHAA	CLASSROOM 11	53	61	1150	450	3/8"	3/4"	-	-	208/1	2.6	15	164	1/MP6.01	2, 3, 4, 5, 6, 7	
HP-11	SAMSUNG	AM053TXMDCHAA	ROOF	-	-	3/8"	3/4"	17.5	10	208 / 1	34	50	212	3/MP6.01	1			
FC-12	SAMSUNG	AM054TNZDCHAA	CLASSROOM 12	53	61	1150	450	3/8"	3/4"	-	-	208/1	2.6	15	164	1/MP6.01	2, 3, 4, 5, 6, 7	
HP-12	SAMSUNG	AM053TXMDCHAA	ROOF	-	-	3/8"	3/4"	17.5	10	208 / 1	34	50	212	3/MP6.01	1			
FC-13	SAMSUNG	AM054TNZDCHAA	CLASSROOM 13	53	61	1150	450	3/8"	3/4"	-	-	208/1	2.6	15	164	1/MP6.01	2, 3, 4, 5, 6, 7	
HP-13	SAMSUNG	AM053TXMDCHAA	ROOF	-	-	3/8"	3/4"	17.5	10	208 / 1	34	50	212	3/MP6.01	1			
FC-14	SAMSUNG	AM054TNZDCHAA	CLASSROOM 14	53	61	1150	450	3/8"	3/4"	-	-	208/1	2.6	15	164	1/MP6.01	2, 3, 4, 5, 6, 7	
HP-14	SAMSUNG	AM053TXMDCHAA	ROOF	-	-	3/8"	3/4"	17.5	10	208 / 1	34	50	212	3/MP6.01	1			
FC-15	SAMSUNG	AM054TNZDCHAA	CLASSROOM 15	53	61	1150	450	3/8"	3/4"	-	-	208/1	2.6	15	164	1/MP6.01	2, 3, 4, 5, 6, 7	
HP-15	SAMSUNG	AM053TXMDCHAA	ROOF	-	-	3/8"	3/4"	17.5	10	208 / 1	34	50	212	3/MP6.01	1			
FC-16	SAMSUNG	AM054TNZDCHAA	CLASSROOM 16	53	61	1150	450	3/8"	3/4"	-	-	208/1	2.6	15	164	1/MP6.01	2, 3, 4, 5, 6, 7	
HP-16	SAMSUNG	AM053TXMDCHAA	ROOF	-	-	3/8"	3/4"	17.5	10	208 / 1	34	50	212	3/MP6.01	1			
FC-17	SAMSUNG	AM054TNZDCHAA	CLASSROOM 17	53	61	1150	450	3/8"	3/4"	-	-	208/1	2.6	15	164	1/MP6.01	2, 3, 4, 5, 6, 7	
HP-17	SAMSUNG	AM053TXMDCHAA	ROOF	-	-	3/8"	3/4"	17.5	10	208 / 1	34	50	212	3/MP6.01	1			
FC-18	SAMSUNG	AM054TNZDCHAA	CLASSROOM 18	53	61	1150	450	3/8"	3/4"	-	-	208/1	2.6	15	164	1/MP6.01	2, 3, 4, 5, 6, 7	
HP-18	SAMSUNG	AM053TXMDCHAA	ROOF	-	-	3/8"	3/4"	17.5	10	208 / 1	34	50	212	3/MP6.01	1			

1. SPLIT SYSTEM SHALL BE ABLE TO OPERATE AT 94% HEATING CAPACITY DOWN TO 32°F OUTDOOR AMBIENT TEMPERATURE.  
2. CFM BASED ON 0.55 ESP.  
3. PROVIDE WITH SAMSUNG MM-AGJUN 24VAC THERMOSTAT ADAPTER AND 24VAC TRANSFORMER.  
4. PROVIDE WITH DELTA CONTROL THERMOSTAT WITH CO2 SENSOR. SEE MP5.01 FOR CONTROLS.

5. PROVIDE WITH MERV-13 FILTERS WITH FILTER ACCESS PANEL.  
6. FAN COIL SHALL BE ADJUSTED TO OPERATE AT CONSTANT SPEED AT INDICATED CFM.  
7. NOT USED.

**SPLIT SYSTEM HEAT PUMPS SCHEDULE**

TAG	MANUFACTURER BASIS OF DESIGN	MODEL	LOCATION	COOLING	HEATING	AIRFLOW CFM	ESP IN. W.G.	REFRIGERANT PIPING		SEER	HSPF	ELECTRICAL			WEIGHT LBS	MOUNTING DETAIL	NOTES
				TOTAL MBH	TOTAL MBH			LIQUID	GAS			V / PH	MCA	MOCP			
SSO-A-1	SAMSUNG	AR09TSPYBKVCV	ROOF	-	-	14"	3/8"	23.5	12	208 / 1	12	20	70	3/MP6.01			
SSI-A-1	SAMSUNG	AR09TSPYBKVCV	BUILDING A SPEECH	9	11	300	-	14"	3/8"	-	-	NOTE 1			20	2/MP6.01	2, 3, 4, 5

1. INDOOR UNIT POWERED BY OUTDOOR UNIT.  
2. PROVIDE WITH WALL MOUNTING BRACKET.  
3. PROVIDE WITH SAMSUNG WALL MOUNTED THERMOSTAT.  
4. PROVIDE WITH BACNET INTERFACE CARD. SEE MP5.01 FOR CONTROLS.  
5. PROVIDE WITH CONDENSATE PUMP.

**EXHAUST FANS SCHEDULE**


TAG	MANUFACTURER	MODEL NO.	AREA SERVED	AIRFLOW CFM	ESP IN. W.G.	FAN RPM	SOUND POWER SONES	MOTOR		WEIGHT LBS	MOUNTING DETAIL	NOTES
								HP	V / PH			
EF-A-1	GREENHECK	G-097-VG	BLDG A ELEC ROOM	160	0.25	1061	4.4	1/4	115 / 1	65	6/MP6.01	1, 2

1. PROVIDE WITH UL LISTING, FAN MOUNTED SPEED CONTROL, GRAVITY OPERATED BACKDRAFT DAMPER, BIRDSCREEN, AND PITCHED ROOF CURB.  
2. CONTROL WITH THERMOSTAT. ADD TEMPERATURE SENSOR IN BMS.

**AIR DISTRIBUTION SCHEDULE**

TAG	MANUFACTURER	MODEL NO.	DESCRIPTION	BORDER TYPE	MOUNTING DETAIL	NOTES
HSS-1	TITUS	S300FL	HIGH SIDEWALL SUPPLY	TYPE 1	12/MP6.01	1, 2, 4
HSR-1	TITUS	350RL	HIGH SIDEWALL RETURN	TYPE 1	13/MP6.01	2, 3

1. SET BLADES AT 22.5° DEFLECTION.  
2. PRIME AND PAINT PER ARCHITECT'S INSTRUCTIONS. REGISTER COLOR SELECTED BY ARCHITECT.  
3. PROVIDE WITH AIRSAN COMPACT DUCT SILENCER.  
4. PROVIDE WITH ASD AIR SCOOP DEVICE.

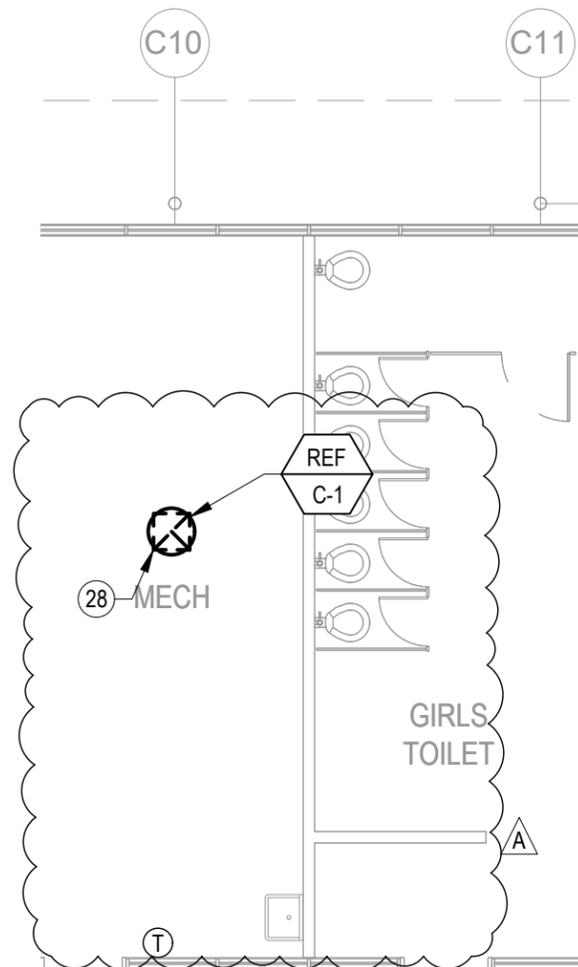

### GENERAL NOTES

1. CONTRACTOR SHALL BE RESPONSIBLE FOR PROTECTING ALL EXISTING AND NEW BUILDING STRUCTURES, SERVICES AND OWNER'S PROPERTY DURING THE ENTIRE PERIOD OF CONSTRUCTION.
2. COORDINATE THE LOCATIONS OF ROOF/ WALL OPENINGS, PENETRATIONS, DUCTWORK AND ALL MECHANICAL EQUIPMENT WITH RESPECT TO BUILDING STRUCTURE AND OTHER BUILDING SERVICES TO AVOID CONFLICT.
3. FOR CLARITY, ABANDONED CD PIPING AND (E) GAS MAINS NOT SHOWN ON THIS PLAN. SEE MP2.01.
4. PAINT ALL EXPOSED DUCTWORK, SUPPORTS, AND REGISTERS TO MATCH ADJACENT. ▲
5. PAINT CONDENSATE PIPING AT EXTERIOR OF BUILDING TO MATCH ADJACENT.
6. SEE DETAIL 7/MP6.01 FOR PIPE SUPPORT ON ROOF.

### # NEW SHEET NOTES

28. INSTALL EXHAUST FAN ON ROOF. ▲

# 1 PARTIAL FLOOR PLAN - BLDG C - NEW - MECHANICAL & PLUMBING

MP2.03 SCALE: 1/8" = 1'-0"




CEG JOB NO: 21035

**CYPRESS**  
Engineering Group

831.218.1802  
8 Harris Court, Suite A8  
Monterey, CA 93940  
cypressseg.com

HVAC, Plumbing, Fire Protection  
Building Commissioning  
Industrial Refrigeration  
Environmental Compliance  
Training & Technical Support

		LAUREL ELEMENTARY SCHOOL - HVAC REPLACEMENT	
		SAN MATEO-FOSTER CITY SCHOOL DISTRICT	
FILE NO.:	41-26	SHEET	
APPL NO.:	01-119551	REF. SHEET MP2.03	
JOB NO.:	2021005.03	<b>AD1-MP2.03a</b>	
DATE	11/24/2021		
387 S. 1st Street, Suite 300 San Jose, CA., 95113		tel: (408) 300 - 5160 fax: (408) 300 - 5121	

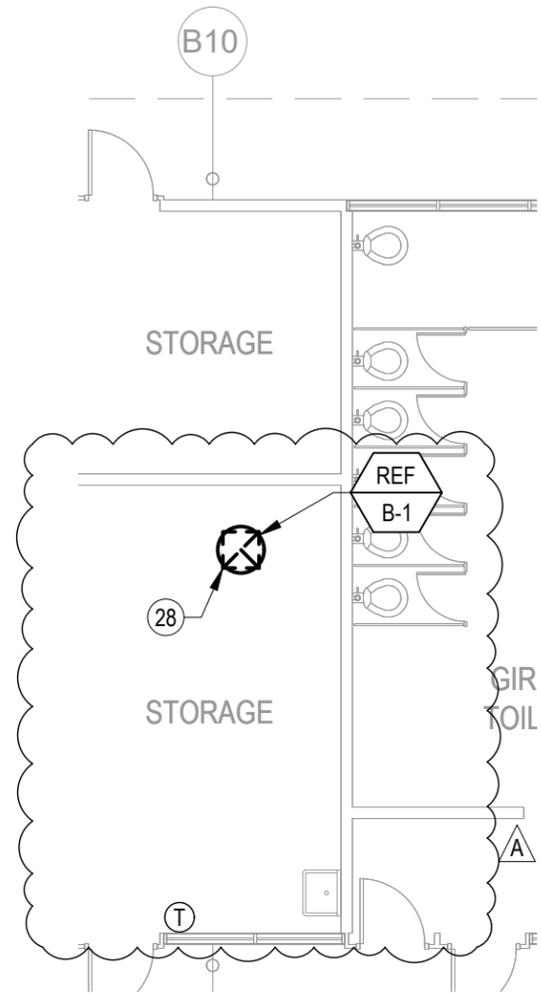

2  
MP2.03

# PARTIAL FLOOR PLAN - BLDG B - NEW - MECHANICAL & PLUMBING

SCALE: 1/8" = 1'-0"




CEG JOB NO: 21035

**CYPRESS**  
Engineering Group

HVAC, Plumbing, Fire Protection  
Building Commissioning  
Industrial Refrigeration  
Environmental Compliance  
Training & Technical Support

831.218.1802  
8 Harris Court, Suite A8  
Monterey, CA 93940  
cypressseg.com


		LAUREL ELEMENTARY SCHOOL - HVAC REPLACEMENT	
		SAN MATEO-FOSTER CITY SCHOOL DISTRICT	
FILE NO.:	41-26	SHEET	REF. SHEET MP2.03
APPL NO.:	01-119551	<b>AD1-MP2.03b</b>	
JOB NO.:	2021005.03		
DATE	11/24/2021		
387 S. 1st Street, Suite 300 San Jose, CA., 95113		tel: (408) 300 - 5160 fax: (408) 300 - 5121	

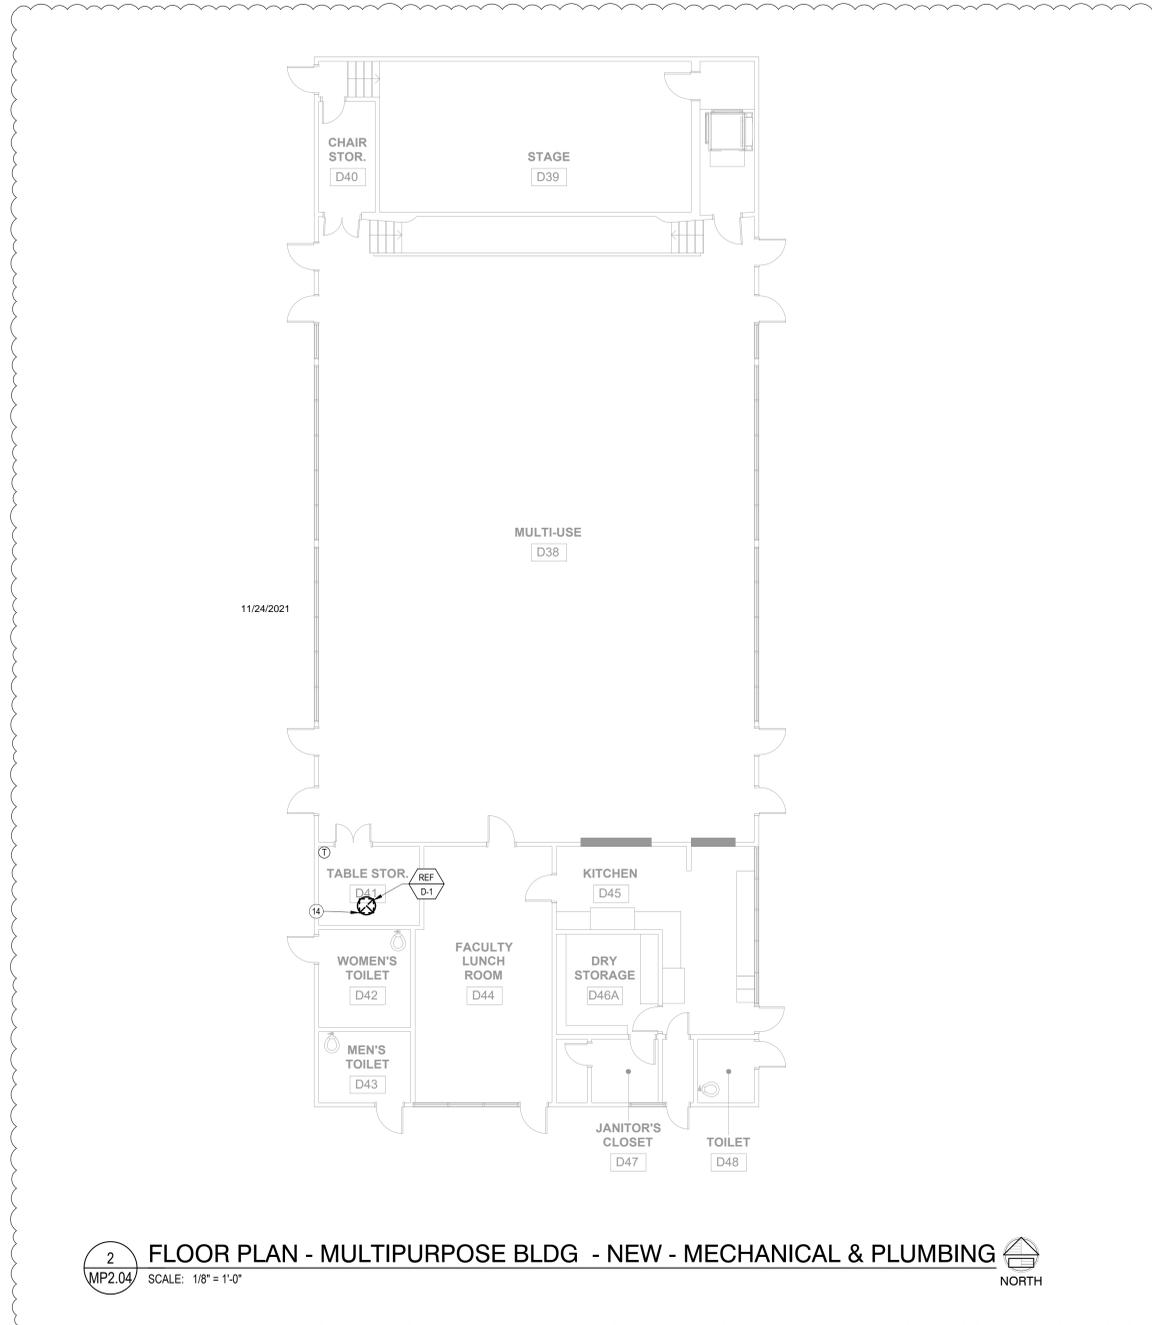

**2 FLOOR PLAN - MULTIPURPOSE BLDG - NEW - MECHANICAL & PLUMBING**  
 SCALE: 1/8" = 1'-0" NORTH

- GENERAL NOTES**
- CONTRACTOR SHALL BE RESPONSIBLE FOR PROTECTING ALL EXISTING AND NEW BUILDING STRUCTURES, SERVICES AND OWNER'S PROPERTY DURING THE ENTIRE PERIOD OF CONSTRUCTION.
  - COORDINATE THE LOCATIONS OF ROOF WALL OPENINGS, PENETRATIONS, DUCTWORK AND ALL MECHANICAL EQUIPMENT WITH RESPECT TO BUILDING STRUCTURE AND OTHER BUILDING SERVICES TO AVOID CONFLICT.
  - FOR CLARITY, ABANDONED CD PIPING AND (E) GAS MAINS NOT SHOWN ON THIS PLAN. SEE MP2.02.
  - PAINT ALL EXPOSED DUCTWORK, SUPPORTS, AND REGISTERS TO MATCH ADJACENT.
  - PAINT CONDENSATE PIPING AT EXTERIOR OF BUILDING TO MATCH ADJACENT.
  - SEE DETAIL 7MP6.01 FOR PIPE SUPPORT ON ROOF.

- NEW SHEET NOTES**
- INSTALL HEAT PUMP ON ROOF, MIN 10 FT FROM EDGE OF ROOF, TYP.
  - INSTALL FAN COIL, TYP. SEE SMP2.03 AND 6MP2.03 FOR TYPICAL FAN COIL INSTALLATION. SEE 1MP6.01 FOR TYPICAL FAN COIL MOUNTING.
  - CD FROM FAN COIL, DROP CD PIPE TIGHT TO EXTERIOR WALL TO BELOW GRADE, AND ROUTE TO CD DRYWELL. PROVIDE CLEANOUT FOR EACH AGGREGATE HORIZONTAL CHANGE IN DIRECTION EXCEEDING 135°. SEE 13MP6.01 FOR CD DRYWELL.
  - SAWCUT, REPAIR, AND PATCH TO MATCH EXISTING. SEE SHEET A8.10 ON ARCHITECT'S DRAWINGS FOR PATCHING AT GRADE.
  - MOTORIZED RELIEF DAMPER AND RETURN GRILLE (RG-1) MOUNTED TO BOTH SIDES OF RELIEF OPENING. DAMPER AND GRILLE SIZE TO MATCH (E) FRAME, APPROXIMATELY 46"x35". RETURN GRILLE TO FILL ENTIRE (E) WINDOW PANEL. VERIFY EXACT DIMENSIONS IN FIELD.
  - INSTALL FAN COIL ABOVE DOOR, COORDINATE EXACT HEIGHT WITH DISTRICT.
  - PUMP CONDENSATE FROM FAN COIL TO (E) SINK IN JANITOR'S CLOSET. CONNECT TO SINK TAILPIECE. RUN PIPE TIGHT TO CEILING.
  - INSTALL REFRIGERANT PIPING FROM HEAT PUMP ON ROOF TO FAN COIL. RUN PIPING ALONG SAME ROUTE AS CONDENSATE PIPING.
  - INSTALL ROOFTOP EXHAUST FAN ON PITCHED ROOF CURB. ENSURE EXHAUST FAN IS A MINIMUM OF 10 FT AWAY FROM ANY OUTSIDE AIR INTAKES.
  - CD FROM FAN COIL, DROP PIPE DOWN TO ENCLOSURE FLOOR AT LEFT SIDE OF UNIT, ENSURING PIPE DOES NOT BLOCK FILTER ACCESS. THEN RUN ALONG FLOOR TO EXTERIOR WALL. PROVIDE CLEANOUT FOR EACH AGGREGATE HORIZONTAL CHANGE IN DIRECTION EXCEEDING 135°. SEE 9MP6.01 FOR CONNECTION TO UNIT.
  - (E) ROOF OUTLINE, TYP.
  - INSTALL THERMOSTAT ON INTERIOR WALL AND WIRE TO FAN COIL SSI-A-1.
  - INSTALL THERMOSTAT ON INTERIOR WALL AND WIRE TO EXHAUST FAN EF-A-1.
  - INSTALL EXHAUST FAN ON ROOF, INSTALL THERMOSTAT ON INTERIOR WALL AND WIRE TO REF-D-1.

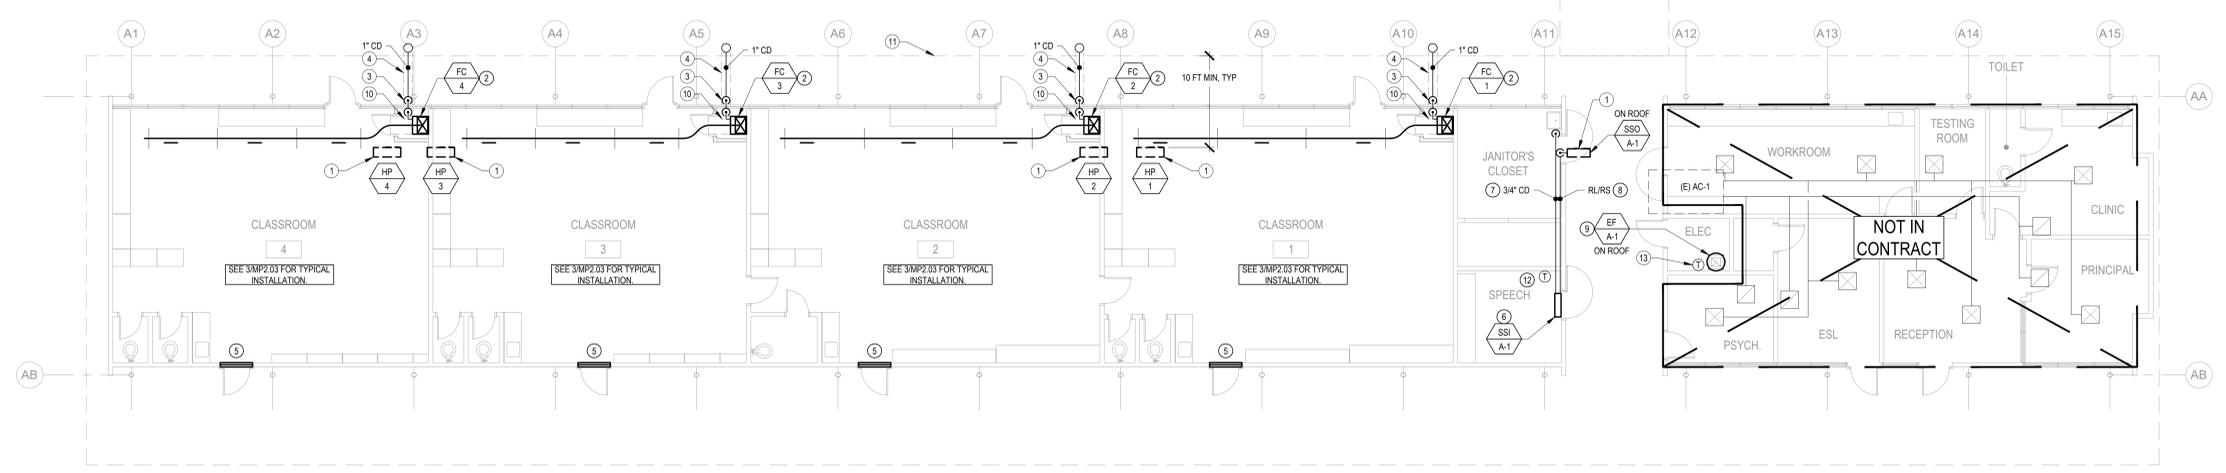

**1 FLOOR PLAN - BLDG A - NEW - MECHANICAL & PLUMBING**  
 SCALE: 1/8" = 1'-0" NORTH

**aedis architects**  
 www.aedisarchitects.com  
 387 S. 1st Street, Suite 300  
 San Jose, CA 95113  
 tel: (408)-300-5160  
 fax: (408)-300-5121

PROJECT  
**LAUREL ELEMENTARY SCHOOL - HVAC REPLACEMENT**

SAN MATEO-FOSTER CITY SCHOOL DISTRICT

CONSULTANT  
**CYPRESS Engineering Group**  
 Monterey, CA 93940  
 cypresseng.com



STATE  
 DSA FILE NUMBER **41-26**  
 APPL # **01-119551**

REVISIONS


No.	Description	Date

MILESTONES

DD	
90% CD	
DSA SUB	05/28/2021
BACKCHECK	10/06/2021

SHEET  
**FLOOR PLAN - NEW - BLDG A - MECHANICAL & PLUMBING**

DATE **11/24/2021**  
 JOB # **2021005.03**  
 SHEET # **MP2.04**

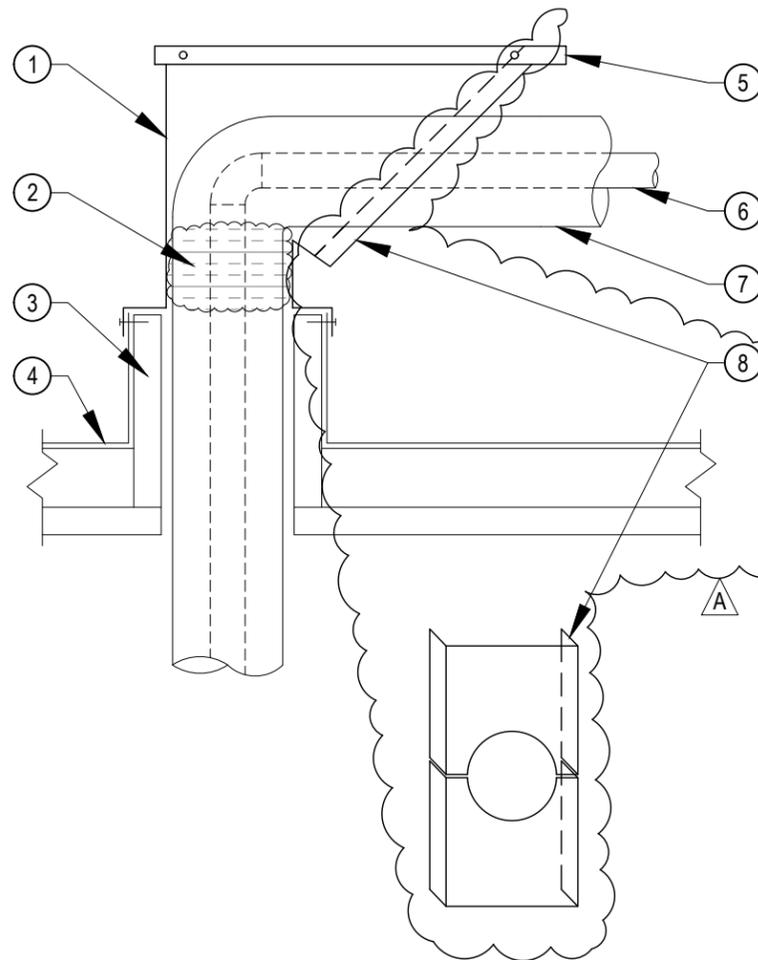


- DETAIL NOTES:
1. GALVANIZED SHEET METAL ROOF JACK WITH CAP.
  2. FILL OPENING WITH FOAM.
  3. ROOF OPENING. SEE STRUCTURAL DRAWING FOR CURB, SEE ARCHITECT'S DRAWINGS FOR FLASHING.
  4. ROOFING.
  5. REMOVABLE SHEET METAL COVER ATTACHED WITH TWO (2) #8 SELF TAPPING SCREWS EACH SIDE, PAINTED.
  6. PIPE.
  7. PIPE INSULATION.
  8. 2 PIECE 20 GA. GALVANIZED SHEET METAL COVER W/ 1-1/2" FLANGES ATTACHED W/ #12 SMS @4" O.C.

- NOTES:
1. EXPOSED PIPING SHALL HAVE ALUMINUM JACKET.

4 PIPING ROOF JACK

N.T.S.

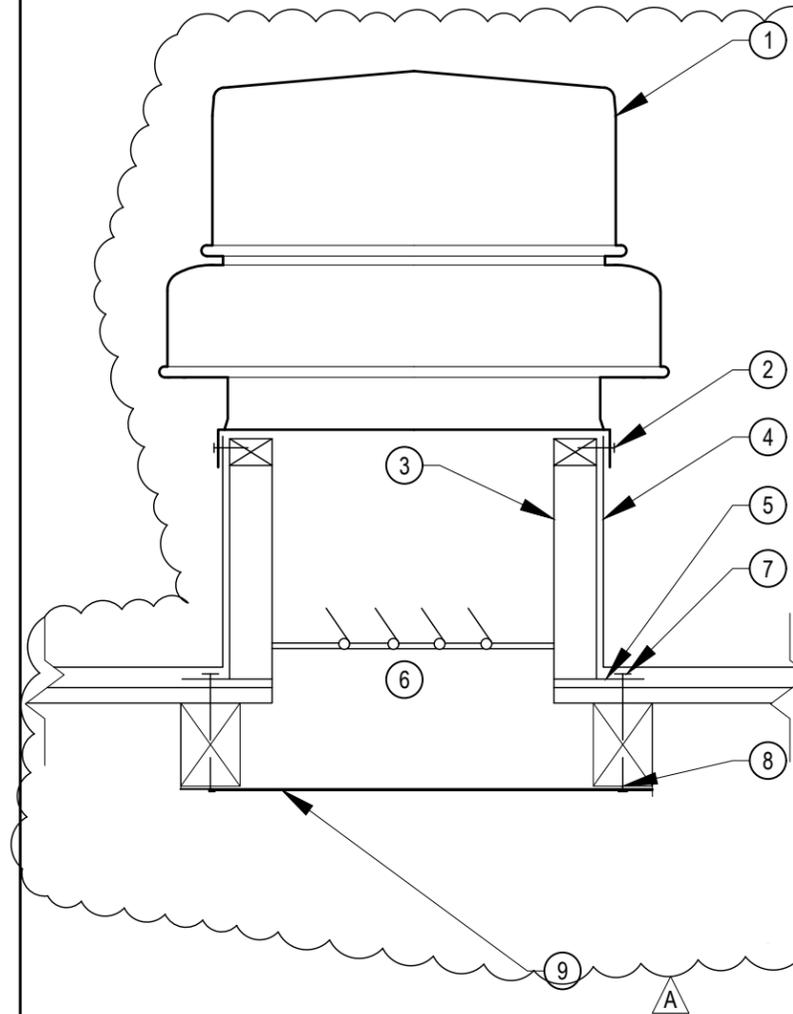

- DETAIL NOTES:
1. EXHAUST FAN.
  2. SECURE TO ROOF CURB WITH #12 SELF TAPPING SCREWS AT 12" ON CENTER. MINIMUM 2 PER SIDE.
  3. FACTORY CURB WITH NAILER.
  4. FOR ROOFING AND FLASHING, SEE ARCHITECT'S DRAWINGS.
  5. ROOF DECK.
  6. BACKDRAFT DAMPER.
  7. 3/8"Ø LAG SCREW THRU CURB AND ROOF WITH 3" MINIMUM EMBEDMENT INTO BLOCKING.
  8. 4x BLOCKING. SECURE TO STRUCTURE WITH SIMPSON HU44 HANGERS EACH END.
  9. 1/4" METAL MESH SCREEN, ATTACHED TO FRAMED BLOCKING W/ #8 WOOD SCREWS @ 6" O.C. ALL AROUND.

6 EXHAUST FAN MOUNTING

N.T.S.



831.218.1802  
8 Harris Court, Suite A8  
Monterey, CA 93940  
cypressseg.com

HVAC, Plumbing, Fire Protection  
Building Commissioning  
Industrial Refrigeration  
Environmental Compliance  
Training & Technical Support

CEG JOB NO: 21035




387 S. 1st Street, Suite 300  
San Jose, CA., 95113

tel: (408) 300 - 5160  
fax: (408) 300 - 5121

LAUREL ELEMENTARY SCHOOL -  
HVAC REPLACEMENT  
SAN MATEO-FOSTER CITY SCHOOL DISTRICT

FILE NO.: 41-26  
APPL NO.: 01-119551  
JOB NO.: 2021005.03  
DATE 11/24/2021

SHEET  
REF. SHEET MP6.01  
**AD1-MP6.01a**

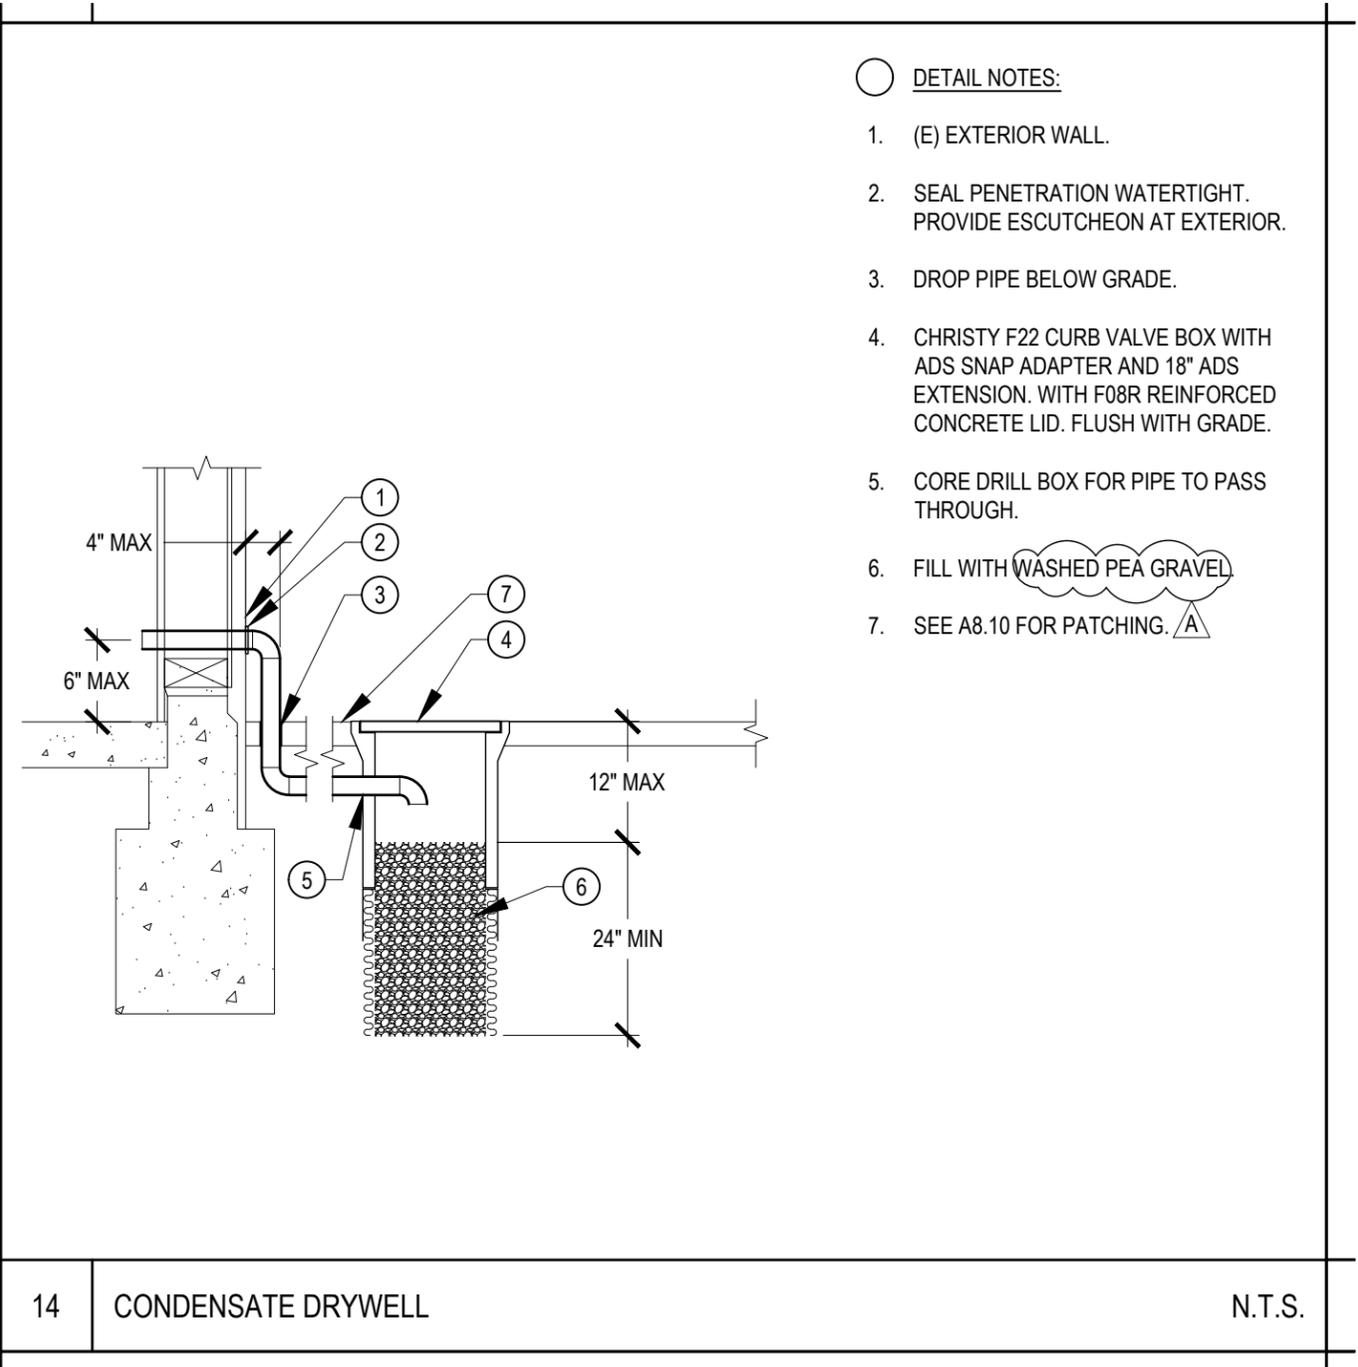

- DETAIL NOTES:
1. (E) EXTERIOR WALL.
  2. SEAL PENETRATION WATERTIGHT. PROVIDE ESCUTCHEON AT EXTERIOR.
  3. DROP PIPE BELOW GRADE.
  4. CHRISTY F22 CURB VALVE BOX WITH ADS SNAP ADAPTER AND 18" ADS EXTENSION. WITH F08R REINFORCED CONCRETE LID. FLUSH WITH GRADE.
  5. CORE DRILL BOX FOR PIPE TO PASS THROUGH.
  6. FILL WITH WASHED PEA GRAVEL.
  7. SEE A8.10 FOR PATCHING. A

14 CONDENSATE DRYWELL N.T.S.




CEG JOB NO: 21035

**CYPRESS**  
Engineering Group

831.218.1802  
8 Harris Court, Suite A8  
Monterey, CA 93940  
cypressseg.com

HVAC, Plumbing, Fire Protection  
Building Commissioning  
Industrial Refrigeration  
Environmental Compliance  
Training & Technical Support

	LAUREL ELEMENTARY SCHOOL - HVAC REPLACEMENT	
	SAN MATEO-FOSTER CITY SCHOOL DISTRICT	
FILE NO.:	41-26	SHEET
APPL NO.:	01-119551	REF. SHEET MP6.01
JOB NO.:	2021005.03	<b>AD1-MP6.01b</b>
DATE	11/24/2021	
387 S. 1st Street, Suite 300 San Jose, CA., 95113	tel: (408) 300 - 5160 fax: (408) 300 - 5121	

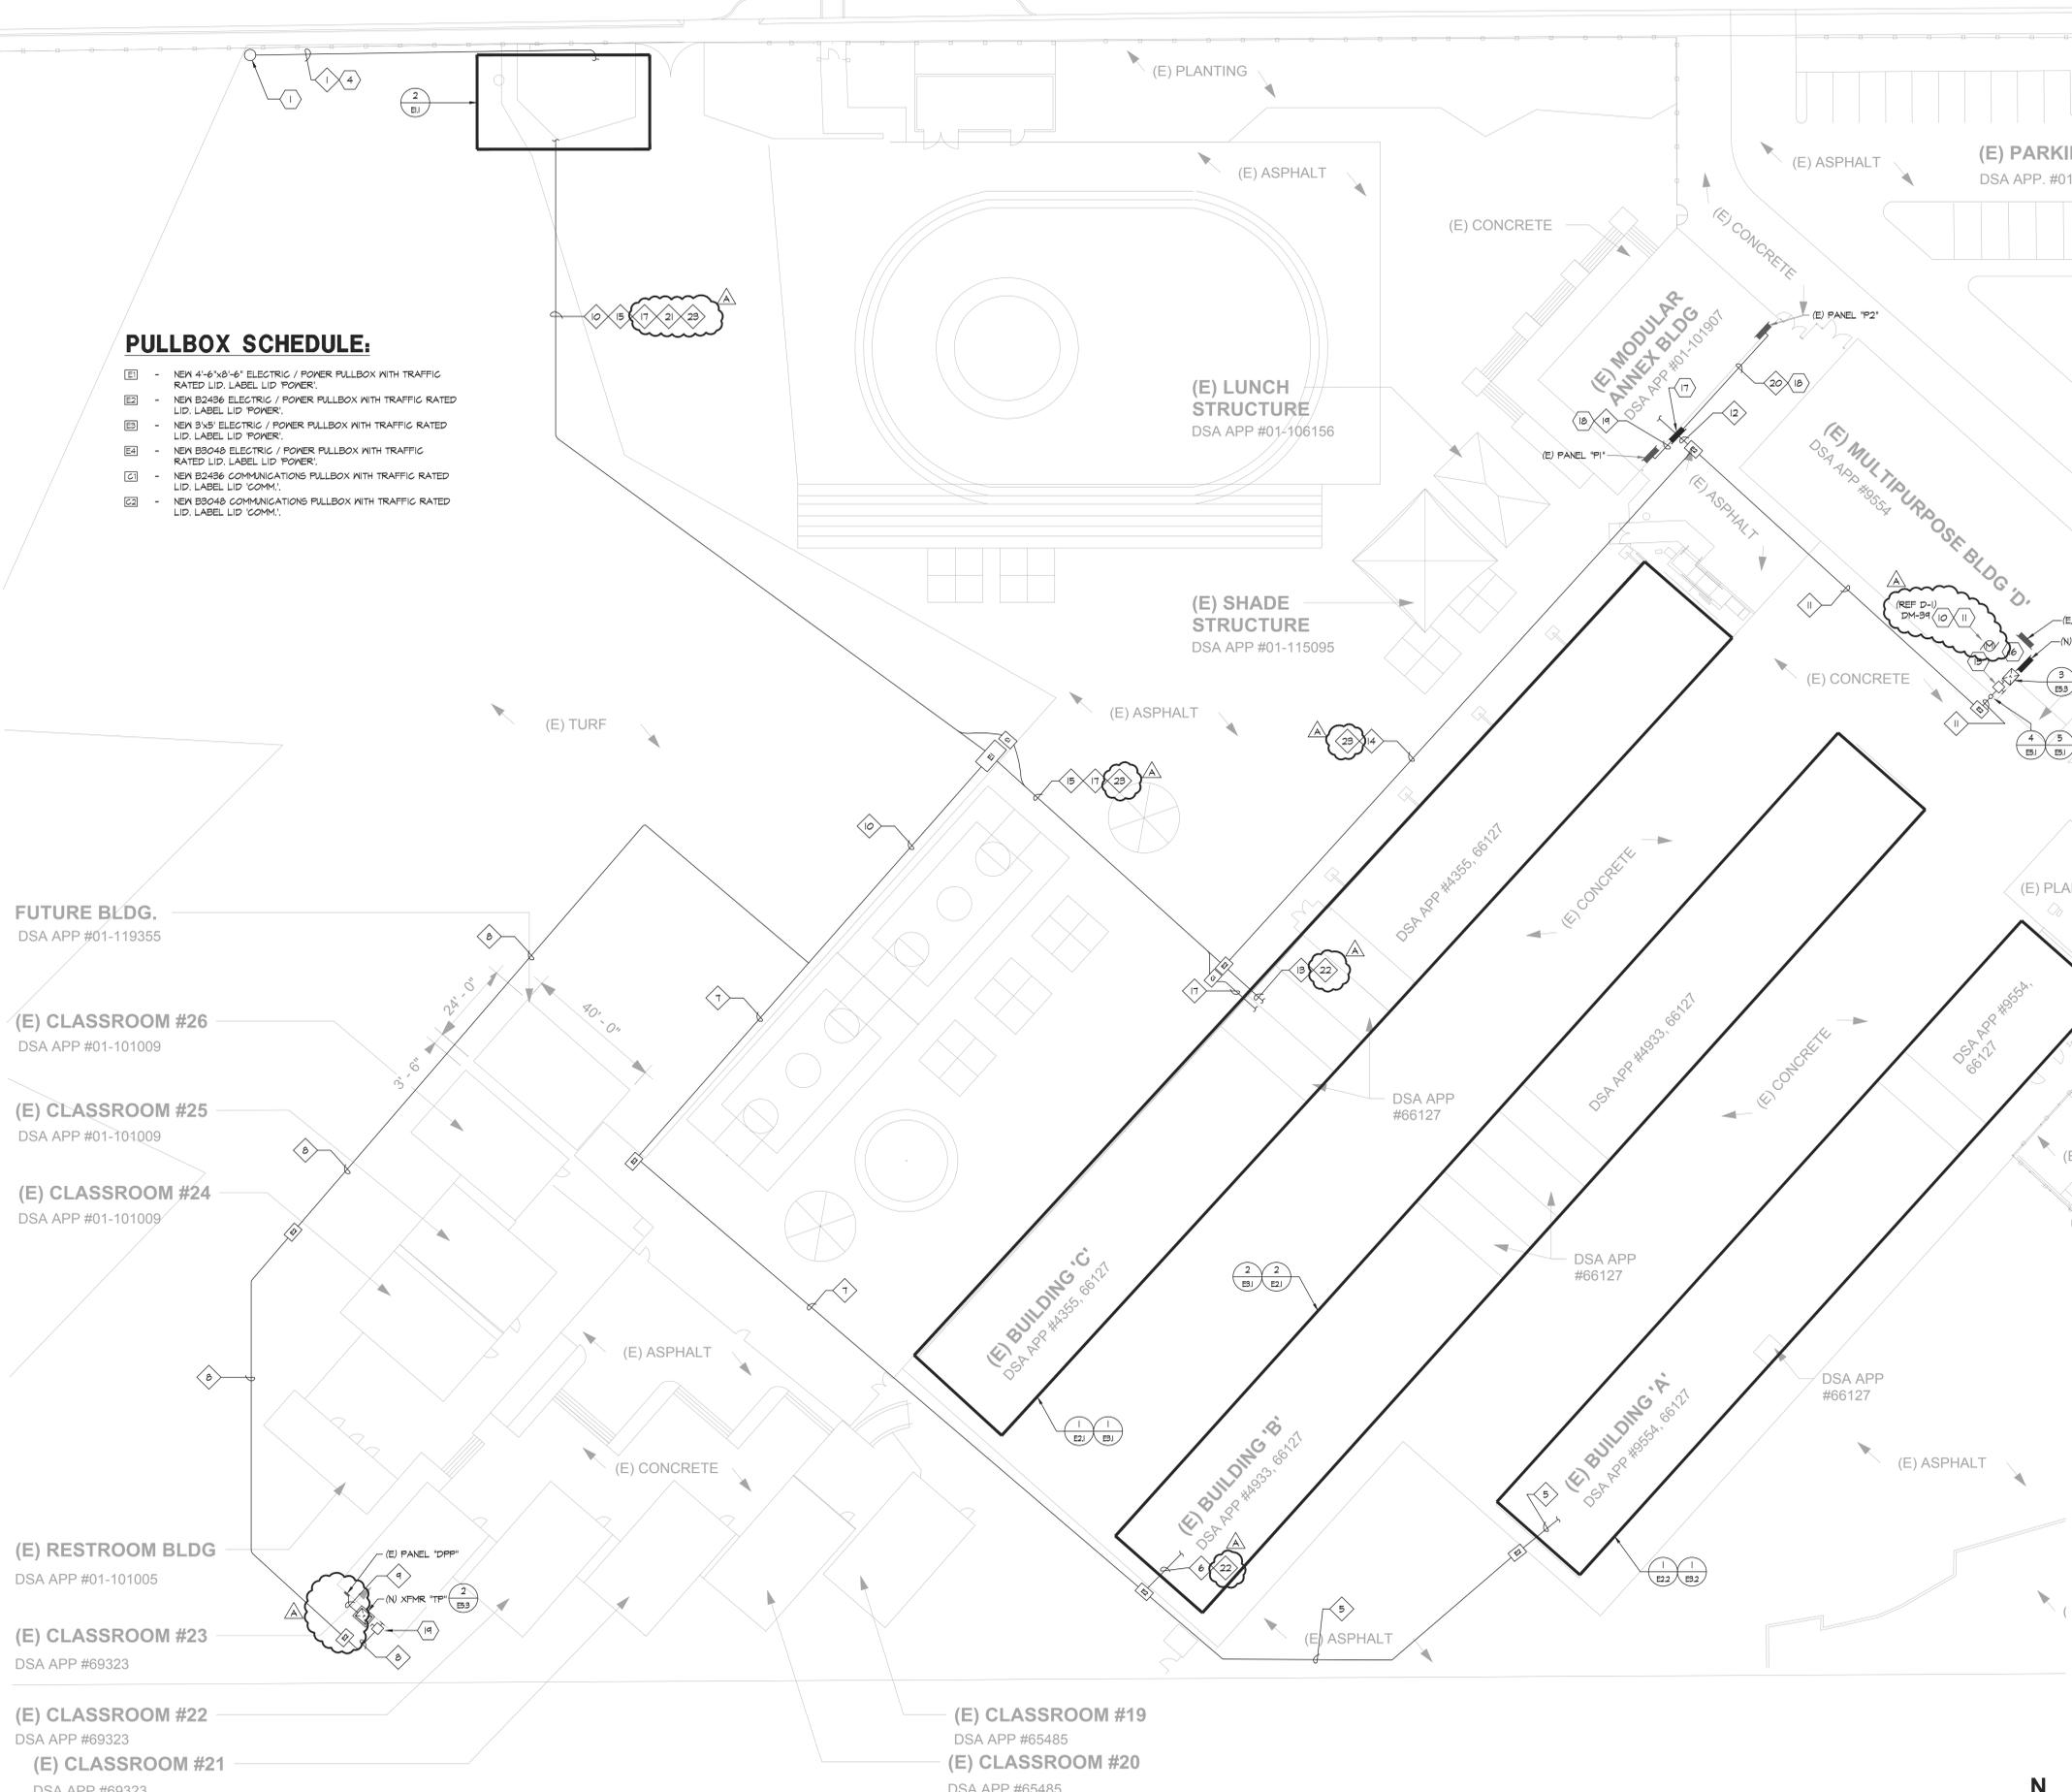

**PULLBOX SCHEDULE:**

- 1 - NEW 4"-6"x8"-6" ELECTRIC / POWER PULLBOX WITH TRAFFIC RATED LID, LABEL LID 'POWER'.

**GENERAL NOTES:**


1. CONTRACTOR SHALL COORDINATE UNDERGROUND REQUIREMENTS WITH ALL OTHER TRADES TO AVOID CONFLICTS.
2. CONTRACTOR SHALL BE RESPONSIBLE FOR ANY SAN CUTTING AND REMOVAL OF EXISTING SURFACES TO FACILITATE UNDERGROUND SYSTEMS. THE CONTRACTOR SHALL PATCH AND REPAIR ALL DAMAGED AND CUT SURFACES TO MATCH ADJACENT.
3. CONTRACTOR TO SITE SURVEY EXISTING CONDITIONS AND LOCATIONS OF EXISTING UNDERGROUND SYSTEMS WHERE NEW TRENCH WORK OCCURS PRIOR TO BIDDING. CONTRACTOR SHALL TAKE PROPER PRECAUTIONS TO ENSURE EXISTING UNDERGROUND SYSTEMS/CONDUIT/PIPES ARE NOT DAMAGED DURING INSTALLATION. CONTRACTOR IS RESPONSIBLE FOR ANY REPAIRS REQUIRED IN THE EVENT THE EXISTING UNDERGROUND SYSTEMS ARE DAMAGED AS A RESULT OF THE NEW ELECTRICAL TRENCH WORK.
4. INSTALL P64E PRIMARY TRENCH PER 1/ ES.1.
5. INSTALL P64E SECONDARY TRENCH PER 3/ ES.1.
6. P64E TRANSFORMER PAD SHALL BE PER 2/ ES.1.
7. ALL ON SITE TRENCH SHALL BE INSTALLED PER 3/ ES.4.
8. SEE DEMO SINGLE LINE DIAGRAM FOR ADDITIONAL REQUIREMENTS.
9. SEE NEW SINGLE LINE DIAGRAM FOR FEEDER CABLE AND CONDUIT REQUIREMENTS.
10. THE CONTRACTOR SHALL MANDREL THROUGH THE ENTIRE P64E CONDUIT SYSTEM. COORDINATE WITH P64E FOR ADDITIONAL REQUIREMENTS AND PROCEDURES.

**SHEET NOTES:**

- 1 EXISTING P64E UTILITY POLE WITH NEW P64E PRIMARY RISER.
- 2 EXISTING 1600A MAIN SWITCHBOARD TO BE DEMOLISHED, DEMOLISH EXISTING UNDERGROUND PAD AND PATCH SURFACE TO MATCH EXISTING.
- 3 EXISTING P64E TRANSFORMER TO BE REMOVED BY P64E, DEMOLISH EXISTING TRANSFORMER PAD AND PATCH SURFACE TO MATCH EXISTING.
- 4 NEW STREET CROSSING FOR PRIMARY CONDUIT, CONTRACTOR TO OBTAIN ALL CITY PERMITS FOR PROVIDING THE STREET CROSSING.
- 5 FUTURE PV DISCONNECT SWITCH.
- 6 FUTURE PV DISTRIBUTION PANEL.
- 7 NEW 2000A MAIN SWITCHBOARD.
- 8 NEW IN-GRADE ELECTRICAL PULL BOX LABEL LID 'ELECTRICAL'.
- 9 REFER TO DETAIL SHEET 4 FOR CONDUIT TRENCH BELOW FOUNDATION.
- 10 PROVIDE NEMA-3R, 120V MOTOR RATED SWITCH FOR ROOFTOP EXHAUST FAN.
- 11 ROUTE 120V CIRCUIT TO THE PANEL AND CIRCUIT INDICATED, COORDINATE EXACT LOCATION WITH MECHANICAL CONTRACTOR.
- 12 NOT USED.
- 13 NEW SIGNAL PULL BOX LABEL LID 'SIGNAL'.
- 14 EXISTING SIGNAL PULL BOX STUB NEW CONDUIT INTO EXISTING BOX AS REQUIRED.
- 15 NEW 400A-3P, 480V UNFUSED DISCONNECT SWITCH.
- 16 NEW DISCONNECT SWITCH, XFMR 'TD' AND PANEL 'DM' TO BE INSTALLED IN EXISTING STORAGE ROOM IN BUILDING 'D'.
- 17 NEW PANEL 'DPA', PANEL TO BE SURFACE MOUNTED ON THE EXTERIOR OF THE MODULAR ANNEX BUILDING.
- 18 CONDUIT ROUTED EXPOSED ON THE EXTERIOR OF THE MODULAR ANNEX BUILDING.
- 19 NEW 200A-3P, 480V UNFUSED DISCONNECT SWITCH.

**CONDUIT SCHEDULE:**

- 1 (N) (1) 4" - P64E PRIMARY.
- 2 (N) (1) 5" - P64E SECONDARY.
- 3 (N) (1) 1" - P64E COMMUNICATIONS.
- 4 (N) (2) 3" - FUTURE PV DISTRIBUTION PANEL.
- 5 (N) 2.5" - XFMR 'TA'.
- 6 (N) (1) 2.5" - FUTURE PV.
- 7 (N) (2) 2.5" - XFMR 'TB'.
- 8 (N) (2) 2.5" - XFMR 'TC'.
- 9 (N) (2) 2.5" - XFMR 'TD'.
- 10 (N) (2) 2.5" - XFMR 'TE'.
- 11 (N) (2) 2.5" - XFMR 'TF'.
- 12 (N) (2) 2.5" - FUTURE PV.
- 13 (N) (2) 2.5" - FUTURE PV.
- 14 (N) (2) 2.5" - FUTURE PV.
- 15 (N) (2) 2.5" - FUTURE PV.
- 16 (N) (2) 2.5" - FUTURE PV.
- 17 (N) (1) 1" - P64E COMMUNICATIONS.
- 18 (N) 2" - FUTURE PV COMMUNICATIONS.
- 19 (N) (1) 1.5" - PANEL 'P1'.
- 20 (N) (1) 1.5" - PANEL 'P2'.
- 21 (N) (3) 4" - SPARE.
- 22 (N) (1) 2.5" - FUTURE PV.
- 23 (N) (1) 2" - FUTURE EM.

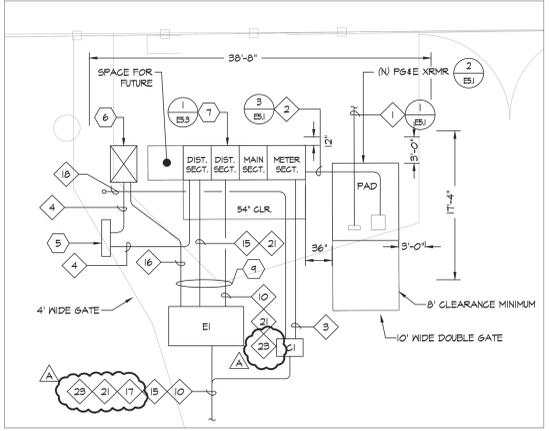

**ELECTRICAL SWITCHGEAR DIMENSIONS**

SCALE: 1/8"=1'-0"

**ELECTRICAL SITE PLAN**

SCALE: 1" = 20'-0"



www.aedisarchitects.com  
387 S. 1st Street, Suite 300  
San Jose, CA 95113  
t: (408)-300-5160  
f: (408)-300-5121

PROJECT  
**LAUREL ELEMENTARY SCHOOL - HVAC REPLACEMENT**

SAN MATEO-FOSTER CITY SCHOOL DISTRICT  
CONSULTANT



American Consulting Engineers  
Electrical, Inc.  
1580 The Alameda, Suite 202  
San Jose, CA 95126  
Tel: 408-238-2313  
Fax: 408-238-2314

STAMP

STATE FILE NUMBER  
DSA APP NUMBER **41-26**  
APPL # **01-119551**

REVISIONS	No.	Description	Date
ADDENDUM 1	11/24/2021		

MILESTONES  
DD  
90% CD  
DSA SUB 05/28/2021  
BACKCHECK

SHEET  
**ELECTRICAL SITE PLAN**

DATE 11/24/2021  
JOB # 2021005.03  
SHEET # AD-1  
**E1.1**



STAMP

STATE  
FILE NUMBER  
DSA FILE NUMBER 41-26  
APPL # 01-119551

REVISIONS

No.	Description	Date
ADDENDUM 1		11/24/2021

MILESTONES

DD	
90% CD	
DSA SUB	05/28/2021
BACKCHECK	

SHEET  
**ELECTRICAL NEW FLOOR PLANS -  
BLDG B & C**

DATE 11/24/2021  
JOB # 2021005.03  
SHEET # AD-1  
**E3.1**

**GENERAL NOTES:**

- ALL CONDUITS SHALL BE ROUTED CONCEALED IN CEILING BELOW WHERE POSSIBLE.
- CONTRACTOR SHALL COORDINATE EXACT LOCATIONS AND POINTS OF CONNECTION FOR MECHANICAL UNIT WITH MECHANICAL CONTRACTOR. ADJUST LOCATION AND CONNECTION POINTS AS NEEDED.
- SEE PANEL SCHEDULES AND SINGLE LINE DIAGRAM FOR POWER CONNECTION REQUIREMENTS.
- COORDINATE WITH ARCHITECTURAL AND MECHANICAL DRAWINGS FOR ADDITIONAL REQUIREMENTS.
- FUSED AND UNFUSED DISCONNECT SWITCHES SHALL BE 600V RATED, HEAVY DUTY CYCLE. FUSES FOR MECHANICAL UNITS SHALL BE SIZED PER THE MANUFACTURER'S RECOMMENDATION.
- DISCONNECT SWITCHES ON THE ROOF SHALL BE MOUNTED TO THE HEAT PUMP UNIT. COORDINATE INSTALLATION LOCATION WITH THE UNIT INSTALLER AND MANUFACTURER.



1. PROVIDE CONDUIT ROOF PENETRATIONS REQUIRED. COORDINATE ROOF PENETRATION LOCATIONS WITH MECHANICAL'S PIPING ROOF PENETRATIONS. ROOF PENETRATION SHALL BE PER DETAIL 4/MP6.01.

**SHEET NOTES:**



- NEW 60A-2P, NEMA-3R, FUSED DISCONNECT SWITCH FOR MECHANICAL UNIT.
- NEW 30A-2P, NEMA-4, MOTOR-RATED DISCONNECT SWITCH FOR MECHANICAL UNIT.
- NEW 30A-2P, NEMA-3R, FUSED DISCONNECT SWITCH FOR MECHANICAL UNIT.
- NOT USED.
- EXISTING MECHANICAL UNIT AND CONNECTIONS TO REMAIN.
- PROVIDE NEW WEATHERPROOF GFCI RECEPTACLE. RECEPTACLE SHALL BE MOUNTED ON A WEATHERPROOF BOX WITH WHILE-IN-USE COVER. COVER SHALL BE INTERMATIC WFOIMXD 'BOSS'.
- PROVIDE MOTOR RATED SWITCH AND 120V POWER FOR CONDENSATION PUMP.
- NEW 400A-3P, 480V UNFUSED DISCONNECT SWITCH.
- STUB LOW VOLTAGE CONDUIT INTO THE ROOM AND GAP FOR FUTURE USE.
- MOUNT CONDUIT ADJACENT TO CHASE AND ROUTE ACROSS THE HALLWAY.
- ROUTE MECHANICAL UNITS CIRCUIT HOMERUN UNDER CANOPY AS INDICATED BY SHEET NOTE #10. CONNECT TO NEW ELECTRICAL PANEL.
- STUB FUTURE SOLAR CONDUIT 18" ABOVE GRADE AT THIS APPROXIMATE LOCATION AND GAP.
- PROVIDE 120V MOTOR RATED SWITCH FOR EXHAUST FAN. PROVIDE #10'S HOMERUN AND CONNECT TO CIRCUIT INDICATED. COORDINATE EXACT LOCATION WITH MECHANICAL DRAWINGS AND MECHANICAL CONTRACTOR.

**CONDUIT SCHEDULE:**

- (N) (2) 2.5" C - XFMR 'C'.
- (N) (1) 1" C - PG&E COMMUNICATIONS.  
(N) (1) 2" C - FUTURE PV COMMUNICATIONS.
- (N) (2) 2.5" C - XFMR 'B'.
- (N) (1) 2.5" C - FUTURE PV.

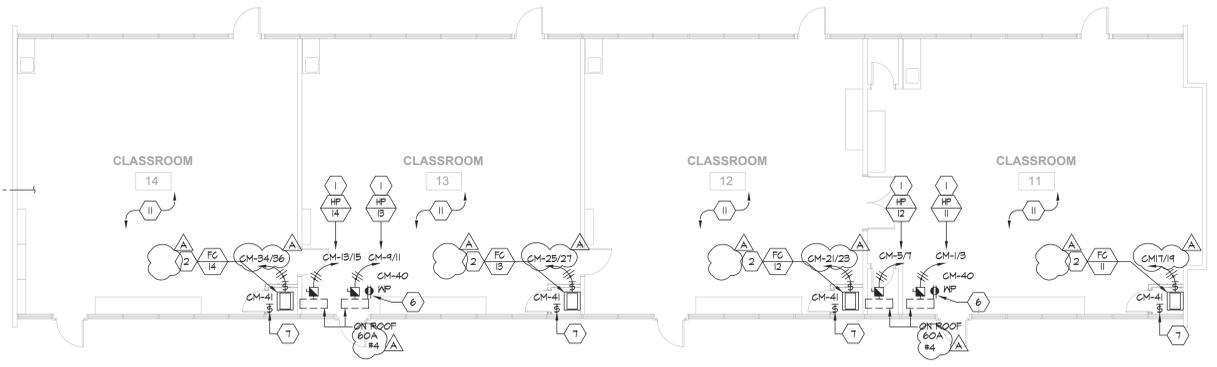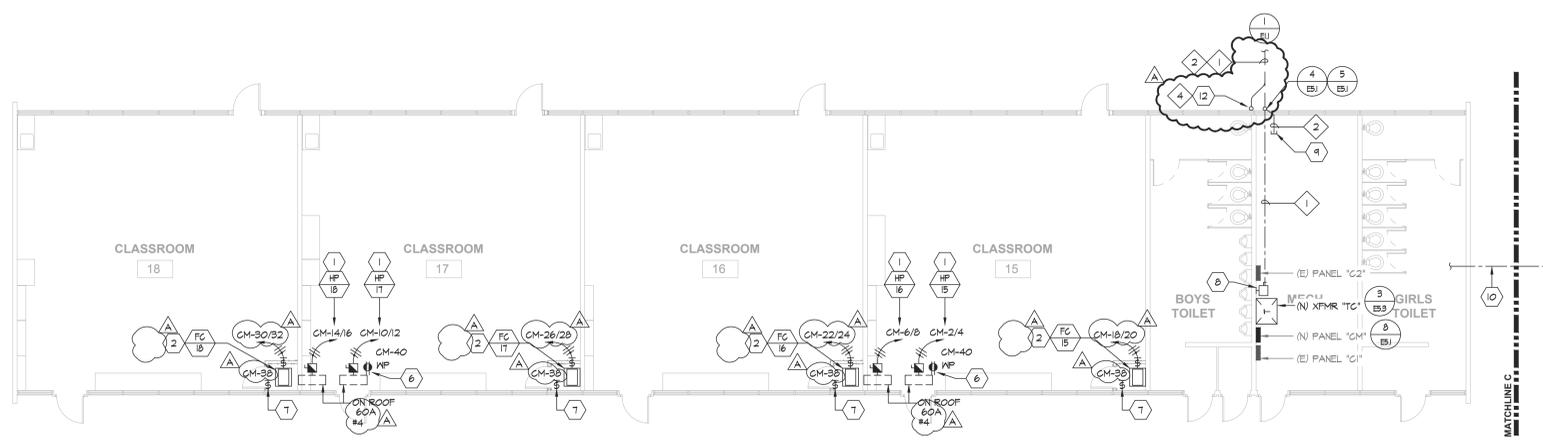


**1 ELECTRICAL NEW FLOOR PLAN - BLDG C**  
E3.1 SCALE: 1/8" = 1'-0"

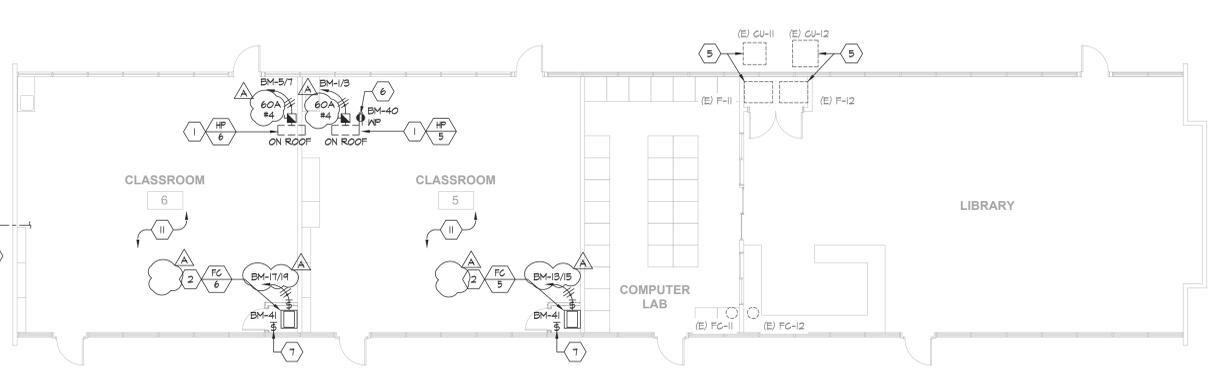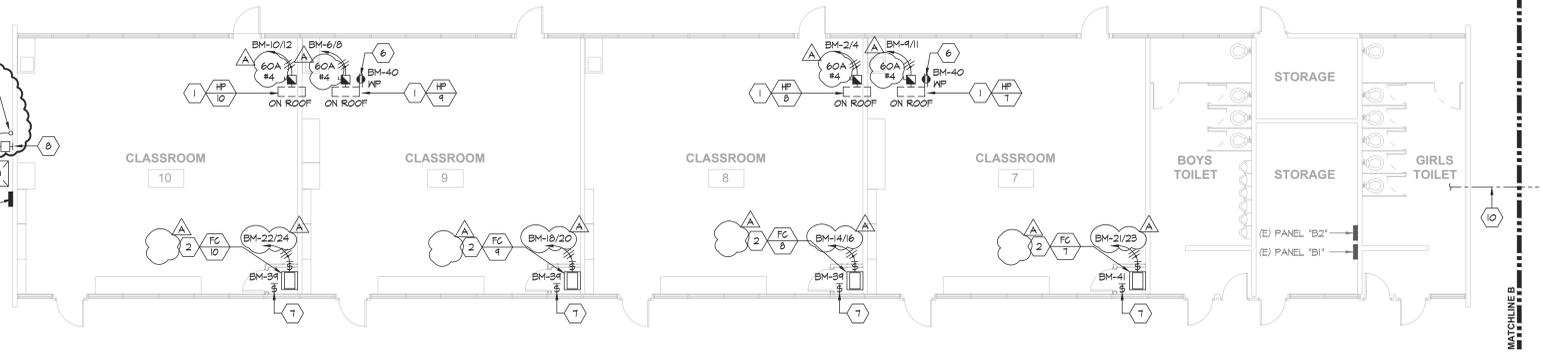


**2 ELECTRICAL NEW FLOOR PLAN - BLDG B**  
E3.1 SCALE: 1/8" = 1'-0"



**BUILDING KEY**

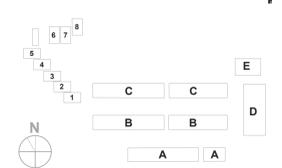

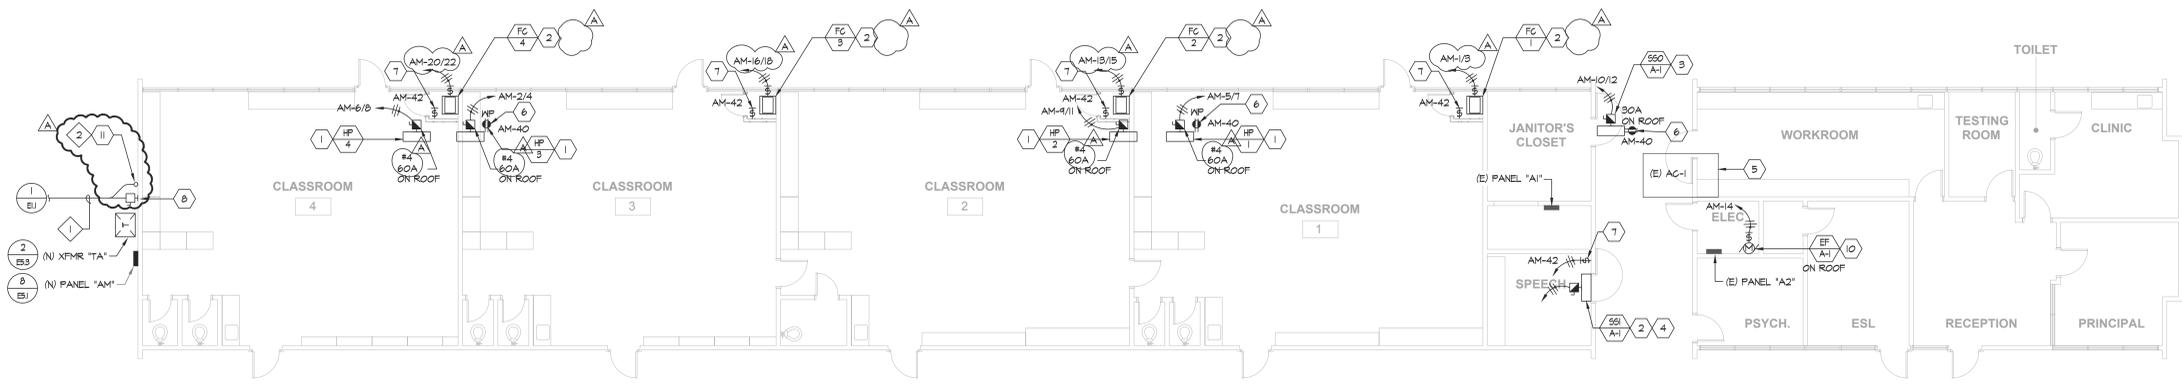

**1 ELECTRICAL NEW FLOOR PLAN - BLDG A**  
E3.2 SCALE: 1/8" = 1'-0"



**GENERAL NOTES:**

- ALL CONDUITS SHALL BE ROUTED CONCEALED IN CEILING BELOW WHERE POSSIBLE.
- CONTRACTOR SHALL COORDINATE EXACT LOCATIONS AND POINTS OF CONNECTION FOR MECHANICAL UNIT WITH MECHANICAL CONTRACTOR. ADJUST LOCATION AND CONNECTION POINTS AS NEEDED.
- SEE PANEL SCHEDULES AND SINGLE LINE DIAGRAM FOR POWER CONNECTION REQUIREMENTS.
- COORDINATE WITH ARCHITECTURAL AND MECHANICAL DRAWINGS FOR ADDITIONAL REQUIREMENTS.
- FUSED AND UNFUSED DISCONNECT SWITCHES SHALL BE 600V RATED, HEAVY DUTY CYCLE. FUSES FOR MECHANICAL UNITS SHALL BE SIZED PER THE MANUFACTURER'S RECOMMENDATION.
- DISCONNECT SWITCHES ON THE ROOF SHALL BE MOUNTED TO THE HEAT PUMP UNIT. COORDINATE INSTALLATION LOCATION WITH THE UNIT INSTALLER AND MANUFACTURER.

1. PROVIDE CONDUIT ROOF PENETRATIONS REQUIRED. COORDINATE ROOF PENETRATION LOCATIONS WITH MECHANICAL'S PIPING ROOF PENETRATIONS. ROOF PENETRATION SHALL BE PER DETAIL 4/MP6.01.


**SHEET NOTES:**

- NEW 60A/2P, NEMA-3R, FUSED DISCONNECT SWITCH FOR MECHANICAL UNIT.
- NEW 30A-2P, NEMA-4, MOTOR-RATED DISCONNECT SWITCH FOR MECHANICAL UNIT.
- NEW 30A-2P, NEMA-3R, FUSED DISCONNECT SWITCH FOR MECHANICAL UNIT.
- INDOOR UNIT IS POWER BY THE OUTDOOR UNIT. ROUTE HOMERUN CIRCUIT TO ASSOCIATED OUTDOOR UNIT. REFER TO MECHANICAL SCHEDULE MP0.02 FOR ADDITIONAL REQUIREMENTS.
- EXISTING MECHANICAL UNIT AND CONNECTIONS TO REMAIN.
- PROVIDE NEW WEATHERPROOF 6FCI RECEPTACLE. RECEPTACLE SHALL BE MOUNTED ON A WEATHERPROOF BOX WITH WHILE-IN-USE COVER. COVER SHALL BE INTERMATIC MP01MMD-1805S1.
- PROVIDE MOTOR RATED SWITCH AND 120V POWER FOR CONDENSATION PUMP.
- NEW 200A/3P, 480V UNFUSED DISCONNECT SWITCH.
- NOT USED.
- PROVIDE NEMA-3R MOTOR RATED SWITCH AND 120V POWER.
- STUB FUTURE SOLAR CONDUIT 18" ABOVE GRADE AT THIS APPROXIMATE LOCATION AND CAP.

**CONDUIT SCHEDULE:**

- (N) (1) 2 1/2" - XFMR 'TA'.
- (N) (1) 2 1/2" - FUTURE PV.

**BUILDING KEY**

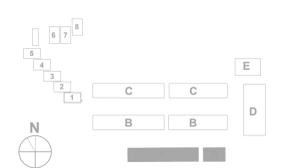

PROJECT  
**LAUREL ELEMENTARY SCHOOL - HVAC REPLACEMENT**

SAN MATEO-FOSTER CITY SCHOOL DISTRICT  
CONSULTANT



American Consulting Engineers Electrical, Inc.  
1985 The Alameda, Suite 200  
San Jose, CA 95126  
Tel: 408-236-2313 Fax: 408-236-2314

STATE DSA FILE NUMBER 41-26  
APPL # 01-119551

REVISIONS	No.	Description	Date
ADDENDUM 1	11/24/2021		

MILESTONES  
DD  
90% CD  
DSA SUB 05/28/2021  
BACKCHECK

SHEET  
**ELECTRICAL NEW FLOOR PLANS - BLDGS A**

DATE 11/24/2021  
JOB # 2021005.03  
SHEET # AD-1  
**E3.2**



PROJECT  
**LAUREL  
ELEMENTARY  
SCHOOL - HVAC  
REPLACEMENT**

SAN MATEO-FOSTER CITY  
SCHOOL DISTRICT  
CONSULTANT



American Consulting Engineers  
Electrical, Inc.  
1580 The Alameda, Suite 202 San Jose, CA 95126  
Tel: (408) 551-0300 Fax: (408) 236-5214

STATE FILE NUMBER  
DSA FILE NUMBER **41-26**  
APPL # **01-119551**

REVISIONS  
No. Description Date  
ADDENDUM 1 11/24/2021

MILESTONES  
DD  
90% CD  
DSA SUB 05/28/2021  
BACKCHECK

SHEET  
**PANEL  
SCHEDULES**

DATE 11/24/2021  
JOB # 2021005.03  
SHEET # AD-1  
**E4.3**

**SHEET NOTES:**

- 1 PROVIDE SUBFEED CIRCUIT BREAKERS TO RE-FEED EXISTING PANELS. SEE SINGLE LINE DIAGRAM FOR ADDITIONAL REQUIREMENTS.

PANEL NAME		VOLTAGE		PHASE		WIRE		TYPE		MOUNTING		FED FROM		MAIN CB		BUSSING		MIN. A.C.		SUB-FEED CB		FEED THRU LUGS	
AM		208/120V		3		4		NEMA 3R		SURFACE		XFMR TA		400A-3P		400 AMP		10/100		150A-3P		YES	
CIRCUIT DESCRIPTION	LOAD TYPE (KVA)	L-TG	REC	MTR	NCL	CB	OCT #	PH #	OCT #	CB	LOAD TYPE (KVA)	L-TG	REC	MTR	NCL	CIRCUIT DESCRIPTION	LOAD TYPE (KVA)	L-TG	REC	MTR	NCL	CIRCUIT DESCRIPTION	
																							AMP
(N) FC-1 - CLASSROOM 1	0.89	15A				1	1	A	2	50A	4.37					(N) HP-3 - CLASSROOM 3	4.37						
...	...	...	...	...	...	...	...	...	...	...	...	...	...	...	...	...	...	...	...	...	...	...	...
(N) HP-1 - CLASSROOM 1	3.74	50A				3	3	B	4	50A	4.37					(N) HP-4 - CLASSROOM 4	4.37						
...	...	...	...	...	...	...	...	...	...	...	...	...	...	...	...	...	...	...	...	...	...	...	...
(N) HP-2 - CLASSROOM 2	3.74	50A				5	5	C	6	50A	1.24					(N) SSO-A1 / SSI-A-1	1.24						
...	...	...	...	...	...	...	...	...	...	...	...	...	...	...	...	...	...	...	...	...	...	...	...
(N) FC-2 - CLASSROOM 2	0.89	15A				7	7	A	8	20A	3.74					(N) FC-3 - CLASSROOM 3	0.89						
...	...	...	...	...	...	...	...	...	...	...	...	...	...	...	...	...	...	...	...	...	...	...	...
SPARE						9	9	B	10	20A	3.74					SPARE							
...	...	...	...	...	...	...	...	...	...	...	...	...	...	...	...	...	...	...	...	...	...	...	...
