

ADDENDUM NO. 3

PROJECT MANUAL

Project No.: 5514

DSA App No. 02-119770

July 11, 2022

**GRANT MIDDLE SCHOOL
SITE IMPROVEMENTS**

KINGS CANYON UNIFIED SCHOOL DISTRICT

Bid No. 2124 Grant Middle School Site Improvements (Re-Bid)



This Addendum and Addendum drawings form a part of the Contract Documents. It modifies the original Project Manual and Drawings. Bidders are required to acknowledge receipt of this Addendum in the space provided in the Bid Form. Failure to acknowledge receipt of each addendum may subject bidder to disqualification.

ADDENDUM NO. 3

PROJECT MANUAL

Project No.: 5514

DSA App No. 02-119770

July 11, 2022

**GRANT MIDDLE SCHOOL
SITE IMPROVEMENTS**

KINGS CANYON UNIFIED SCHOOL DISTRICT

Bid No. 2124 Grant Middle School Site Improvements (Re-Bid)



This Addendum and Addendum drawings form a part of the Contract Documents. It modifies the original Project Manual and Drawings. Bidders are required to acknowledge receipt of this Addendum in the space provided in the Bid Form. Failure to acknowledge receipt of each addendum may subject bidder to disqualification.

Project No. 5514

GENERAL INFORMATION:

3-01 GENERAL:

- a. Contractor to provide knox box, per City of Reedley Fire Department, at each drive gate, typical of two.
- b. Existing flashing crosswalk beacon system to be removed and relocated as indicated on Sheet E1.01. Existing flashing road markers to be removed per Note #4, Sheet E1.01.
- c. Engineer's construction cost estimate is \$700,000.

3-02 PROJECT MANUAL, BID DOCUMENTS: Add the following documents in their entirety:

- a. 2020 DVBE Certificate. See Exhibit 3-02a.
- b. 2020 DVBE Good Faith Worksheet. See Exhibit 3-02b.
- c. Federal Requirements. See Exhibit 3-02c.

DRAWINGS

CIVIL

3-03 DRAWINGS, SHEET C1.0 – GRADING PLAN: Replace drawing C1.0 in its entirety; see Addendum Drawing C1.0.

ARCHITECTURAL

3-04 DRAWINGS, SHEET A1.01 – SITE PLAN: Replace drawing A1.01 in its entirety; see Addendum Drawing A1.01.

3-05 DRAWINGS, SHEET A1.02 – ENLARGED SITE & DEMO PLAN: Replace drawing A1.02 in its entirety; see Addendum Drawing A1.02.

ELECTRICAL

3-06 DRAWINGS, SHEET E0.03 – STREET LIGHTING DETAILS: Replace drawing E0.03 in its entirety; see Addendum Drawing E0.03.

3-07 DRAWINGS, SHEET E1.01 – ELECTRICAL SITE PLAN - DEMOLITION: Replace drawing E1.01 in its entirety; see Addendum Drawing E1.01.

3-08 DRAWINGS, SHEET E1.02 – ELECTRICAL SITE PLAN - NEW: Replace drawing E1.02 in its entirety; see Addendum Drawing E1.02.

END ADDENDUM NO. 3

**PRIME BIDDER CERTIFICATION OF DISABLED VETERAN
BUSINESS ENTERPRISE PARTICIPATION**

To be completed by the Prime Bidder

PAGE 1 OF 2

PART I – IDENTIFICATION INFORMATION		
BIDDER'S NAME	BUSINESS ADDRESS	TELEPHONE NUMBER
SCHOOL DISTRICT	COUNTY	APPLICATION NO.
PART II – METHOD OF COMPLIANCE WITH DVBE PARTICIPATION GOALS – Include this form and any other applicable documents listed in this table with your bid/proposal. Read the three columns in the table below as sentences from left to right. Check the appropriate box to indicate your method of committing the contract dollar amount. NOTE: <i>Architectural, engineering, environmental, land surveying or construction management firms must indicate their method of compliance by marking the appropriate box A, B, C, or D after selection by the District and before the contract is signed.</i>		
YOUR BUSINESS ENTERPRISE	AND YOU	AND YOU
A. ☐ <i>is Disabled Veteran owned and your forces, will perform at least 3 percent of this contract</i>	<i>will include a copy of your DVBE letter from the Office of Small Business and Disabled Veteran Business Enterprise Services (OSDS).</i>	
B. ☐ <i>is Disabled Veteran owned but is unable to perform the 3 percent of this contract with your forces</i>	<i>will use DVBE subcontractors/ suppliers to bring the contract participation to at least 3 percent</i>	<i>will include a copy of each DVBE's letter from OSDS (including yours, if applicable).</i>
C. ☐ <i>is not Disabled Veteran owned</i>	<i>will use DVBE subcontractors/ suppliers for at least 3 percent of this contract</i>	
D. ☐ <i>is unable to meet the required participation goals</i>	<i>will complete a Good Faith Effort to obtain DVBE participation</i>	<i>will include the Prime Bidder's Good Faith Effort Worksheet.</i>

Note: An Office of Small Business and Disabled Veteran Business Enterprise Services (OSDS) letter must be attached for each DVBE participating in the contract. The DVBE letter is obtained by application through the OSDS and must be provided at the time of bid opening. If the letter is not provided, the bid may be deemed nonresponsive and may be ineligible for award of the contract.

Continued on reverse side

PART III – DVBE DOLLAR PARTICIPATION OF BID/PROPOSAL – Architectural, engineering, environmental, land surveying or construction management firms complete this part **after** selection by the district and before the contract is signed.

Show deductive alternate(s) in parenthesis. For more alternates/base bids, use a separate page to show items.

- A. If your business enterprise is a DVBE, list in the appropriate column the total dollar amount of your bid to be performed by your own participation.
- B. List all your DVBE subcontractors/suppliers. Enter in the appropriate column the dollar amount for each of your subcontractors/suppliers.
- C. Enter the total of Lines A and B for each column.
- D. Enter the dollar amount of the bid/proposal to be performed by **non-DVBE** firms. Note: This line is the sum of the prime and subcontractor(s) **non-DVBE** dollar participation.
- E. Enter the sum of the column totals from Line C and Line D. Note: Please be aware that the final determination of DVBE compliance is made based on the contract amount resulting from the district's acceptance or rejection of alternates.

	BASE BID/PROPOSAL	ALTERNATE #1	ALTERNATE #2	ALTERNATE #3 OR BASE BID B	ALTERNATE #4 OR BASE BID C	ALTERNATE #5 (Modernization or Reconstruction Only)
A. Prime Bidder, <i>if DVBE</i> (own participation)	\$	\$	\$	\$	\$	\$
B. DVBE Subcontractor or Supplier						
1.						
2.						
3.						
4.						
C. Subtotal (A & B)						
D. Non-DVBE						
E. Total Bid						

PRIME BIDDER GOOD FAITH EFFORT WORKSHEET

This worksheet is to be used to assist the Prime Bidder in meeting the 3% DVBE participation goal

PAGE 1 OF 2

BIDDER'S NAME	BUSINESS ADDRESS	CONTACT PERSON
TELEPHONE NUMBER	OWNER	COUNTY

GENERAL INSTRUCTIONS:

This worksheet is to be used to assist you in meeting the 3 percent DVBE participation goal. If specific information is not provided for Parts I through III, you do not meet the test of the "Good Faith Effort" and cannot so certify. If you are qualifying based on a "Good Faith Effort" you must include this form with your bid/proposal to the Owner.

PART I – CONTACTS

To identify DVBE subcontractors/suppliers for participation in your bid/proposal, contact must be made with each of the following categories. It is recommended that you contact several DVBE organizations.

CATEGORY	TELEPHONE NUMBER	DATE CONTACTED	PERSON CONTACTED
1. Owner			
2. Office of Small Business and Disabled Veteran Business Enterprise Services (OSDS). OSDS provides assistance locating DVBEs at https://caleprocure.ca.gov/pages/PublicSearch/supplier-search.aspx .	(916) 375-4940		
3. DVBE Organizations (<i>List</i>):			
4. Write "recorded message" in this column, if applicable.			

PART II – ADVERTISEMENTS You must make at least two (2) advertisements, one (1) in a paper that focuses on DVBE and one (1) in a trade paper. Advertisements should be published at least 14 days prior to bid/proposal opening; if you cannot advertise 14 days prior, advertise as soon as possible and provide an explanation. (Advertisements must be published in time to allow for a reasonable response). Advertisements must include that your firm is seeking DVBE participation, the project name and location, your firm's name, your firm's contact person, and phone number.

Attach copies of advertisements to this form.

FOCUS/TRADE PAPER NAME	CHECK ONE		DATE OF ADVERTISEMENT
	TRADE	FOCUS	

PART III – DVBE SOLICITATIONS List DVBE subcontractors/suppliers that were invited to bid. Use the following instructions to complete the remainder of this section (read the three columns as a sentence from left to right). If you need additional space to list DVBE solicitations, please use a separate page and attach to this form.

IF THE DVBE.....	THEN.....	AND.....		
Was selected to participate	Check "yes" in the "SELECTED" column, include the applicable dollar amount in Part III of the Prime Bidder Certification	Include a copy of their DVBE letter from OSDs.		
Was not selected to participate	Check "no" in the "SELECTED" column	State why in the "REASON NOT SELECTED" column.		
Did not respond to your solicitation	Check the "NO RESPONSE" column			
DISABLED VETERANS BUSINESS ENTERPRISES CONTACTED	SELECTED		REASON NOT SELECTED <i>This section must be completed</i>	NO RESPONSE
	YES	NO		

IMPORTANT NOTE:

Please be aware that certification of the "Good Faith Effort" may only be made if you fully complete Parts I, II, and III on both sides of this form. A copy of this form must be retained by you and may be subject to a future audit.

CERTIFICATION

I, _____ certify that I am the bidder's Chief Executive Officer and that I have made a diligent effort to ascertain the facts with regard to the representations made herein. In making this certification, I am aware of Section 12650 et seq. of the Government Code providing for the imposition of treble damages for making false claims.




SIGNATURE OF CHIEF EXECUTIVE OFFICER

DATE

Federal Requirements

Compliance with Law. While performing the services contemplated by this Agreement, Contractor agrees to comply with all applicable laws and regulations. Contractor understands and acknowledges that the purchase is being funded through a Federal Award and that, as a result, the Agreement is subject to applicable Federal law. Contractor agrees to comply with all such requirements, including but not limited to the requirements set forth in this Section.

- a. Equal Employment Opportunity. Contractor agrees to comply with and be bound by Title 14, CFR, Section 60-1.4(b), the terms of which are incorporated by reference as though set forth in full herein.
- b. Clean Air Act and Federal Water Pollution Control Act. Contractor agrees to comply with and be bound by, and assist District in ensuring compliance with, all applicable standards, orders, and regulations issued pursuant to section 306 of the Clean Air Act (42 U.S.C. 1857(h)), section 508 of the Clean Air Act (33 U.S.C. 1368), Executive Order 11738, Environmental Protection Agency regulations (40 CFR part 15), and Federal Water Pollution Control Act (42 U.S.C. §§ 7401-7671g) and the Federal Water Pollution Control Act as amended (33 U.S.C. §§ 1251-1387). Any violations must be reported to the Federal awarding agency and the Regional Office of the Environmental Protection Agency (EPA).
- c. Debarment and Suspension. Contractor represents and warrants that it is not listed on the government-wide exclusions in the System for Award Management (SAM), and Contractor agrees to comply with and be bound by, and assist District in ensuring compliance with, the OMB guidelines at 2 CFR 180 that implement Executive Orders 12549 (3 CFR part 1986 Comp., p. 189) and 12689 (3 CFR part 1989 Comp., p. 235), “Debarment and Suspension.” SAM Exclusions contains the names of parties debarred, suspended, or otherwise excluded by agencies, as well as parties declared ineligible under statutory or regulatory authority other than Executive Order 12549.
- d. Byrd Anti-Lobbying Amendment. Contractor agrees to comply with and be bound by, and assist District in ensuring compliance with, the Byrd Anti-Lobbying Amendment (31 U.S.C. § 1352). Contractor shall file the declaration and certification required by 31 U.S.C. § 1352(b).
- e. Conflict of Interest. Contractor agrees to comply with the District’s conflict of interest standard and has demonstrated an ability to successfully perform the terms of This Agreement. Contractor will provide further verified information as may be requested by the District.
- f. Buy American Act. As required by 41 U.S.C. Chapter 83 (“Buy American Act”) Contractor shall comply with and be bound by and assist the District in ensuring that goods used in a manner that complies with the Buy American Act, unless an exception of the requirement is approved, and Contractor will provide any further verified information as may be requested by the District.
- g. Federal Labor Standards. Contractor agrees to comply with applicable Federal labor standards, including but not limited to the Davis-Bacon Act (40 U.S.C. 3141-3148), the Anti-Kickback Act of 1986 (41 U.S.C. 51-58), and Contract Work Hours and Safety Standards Act - CWHSSA (40 U.S.C. 3702).

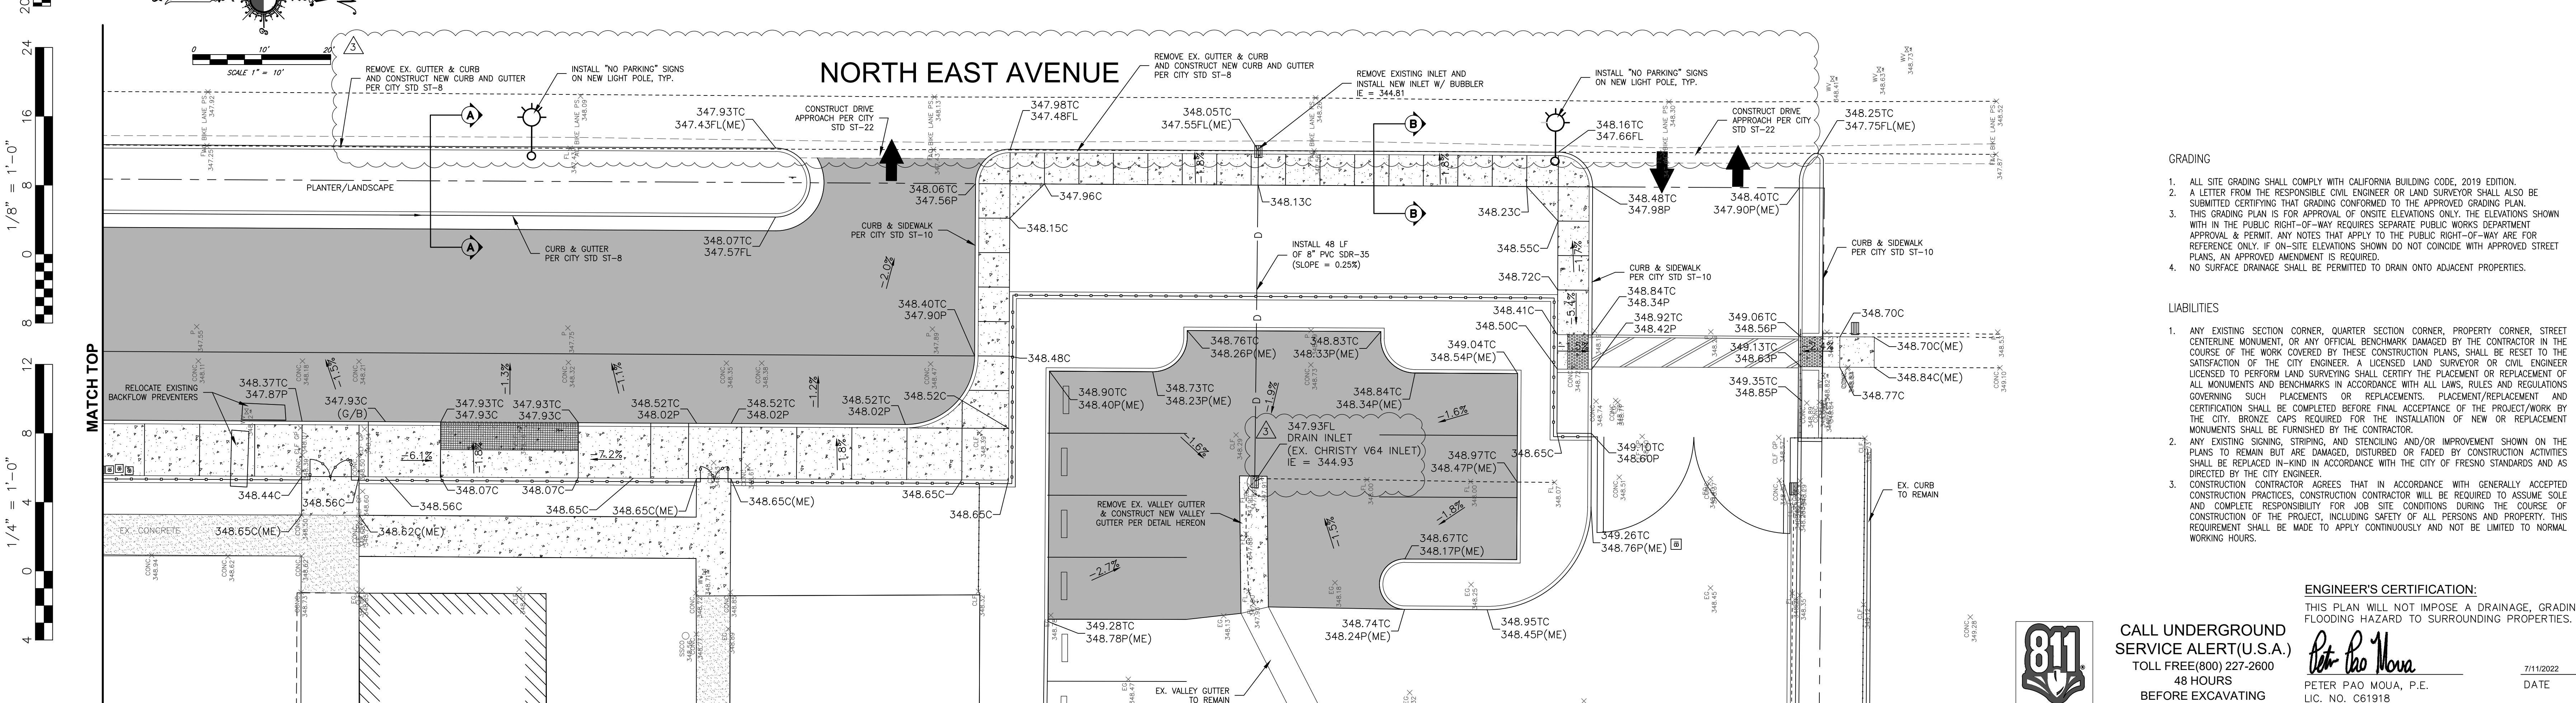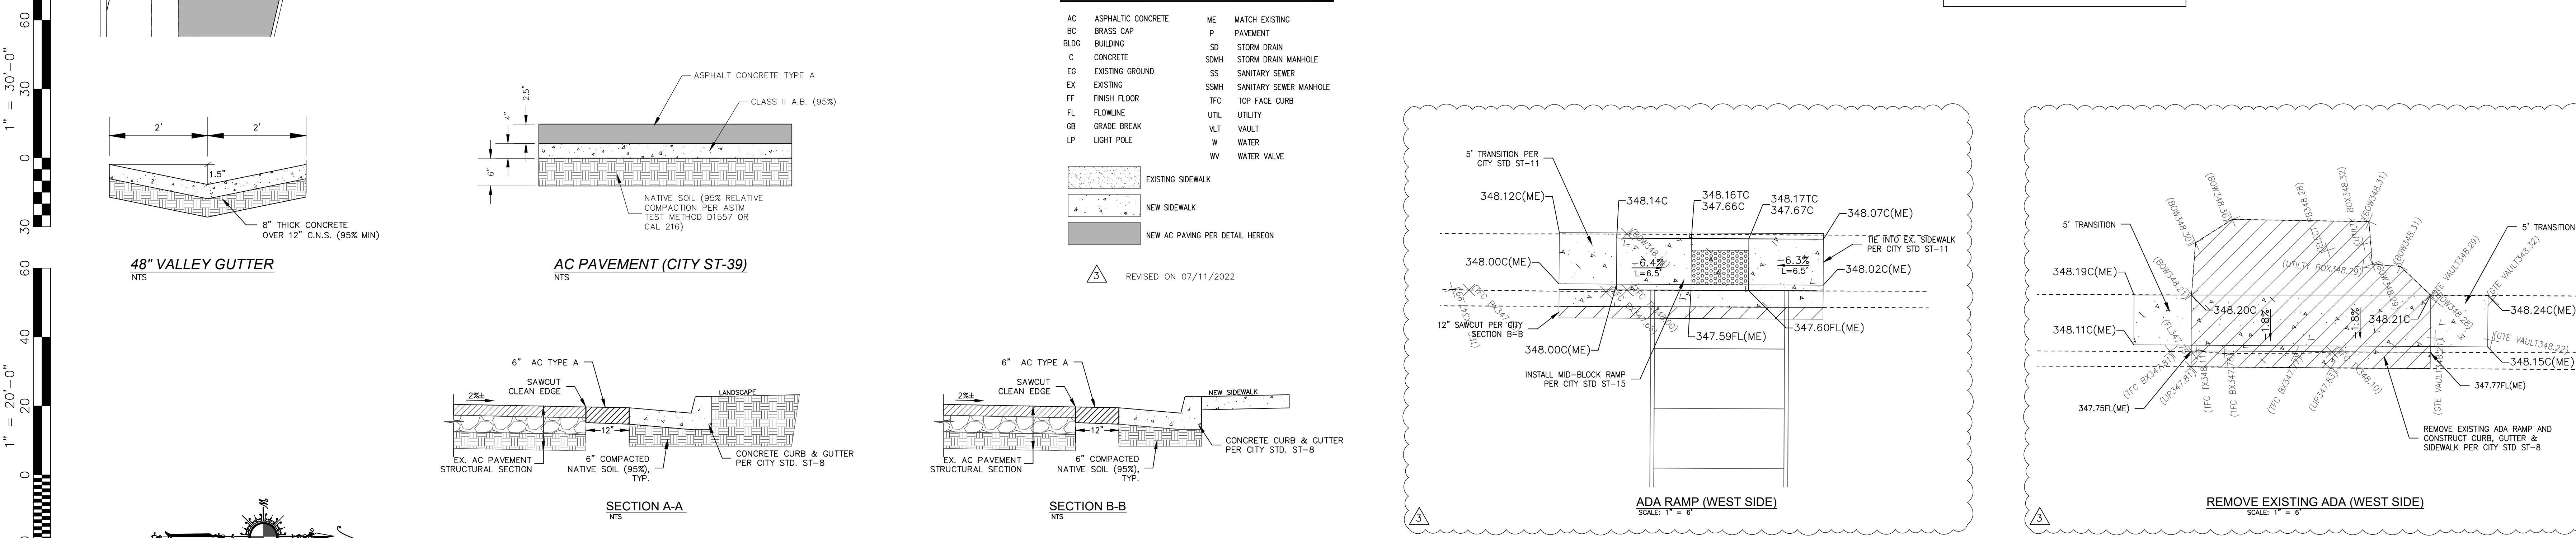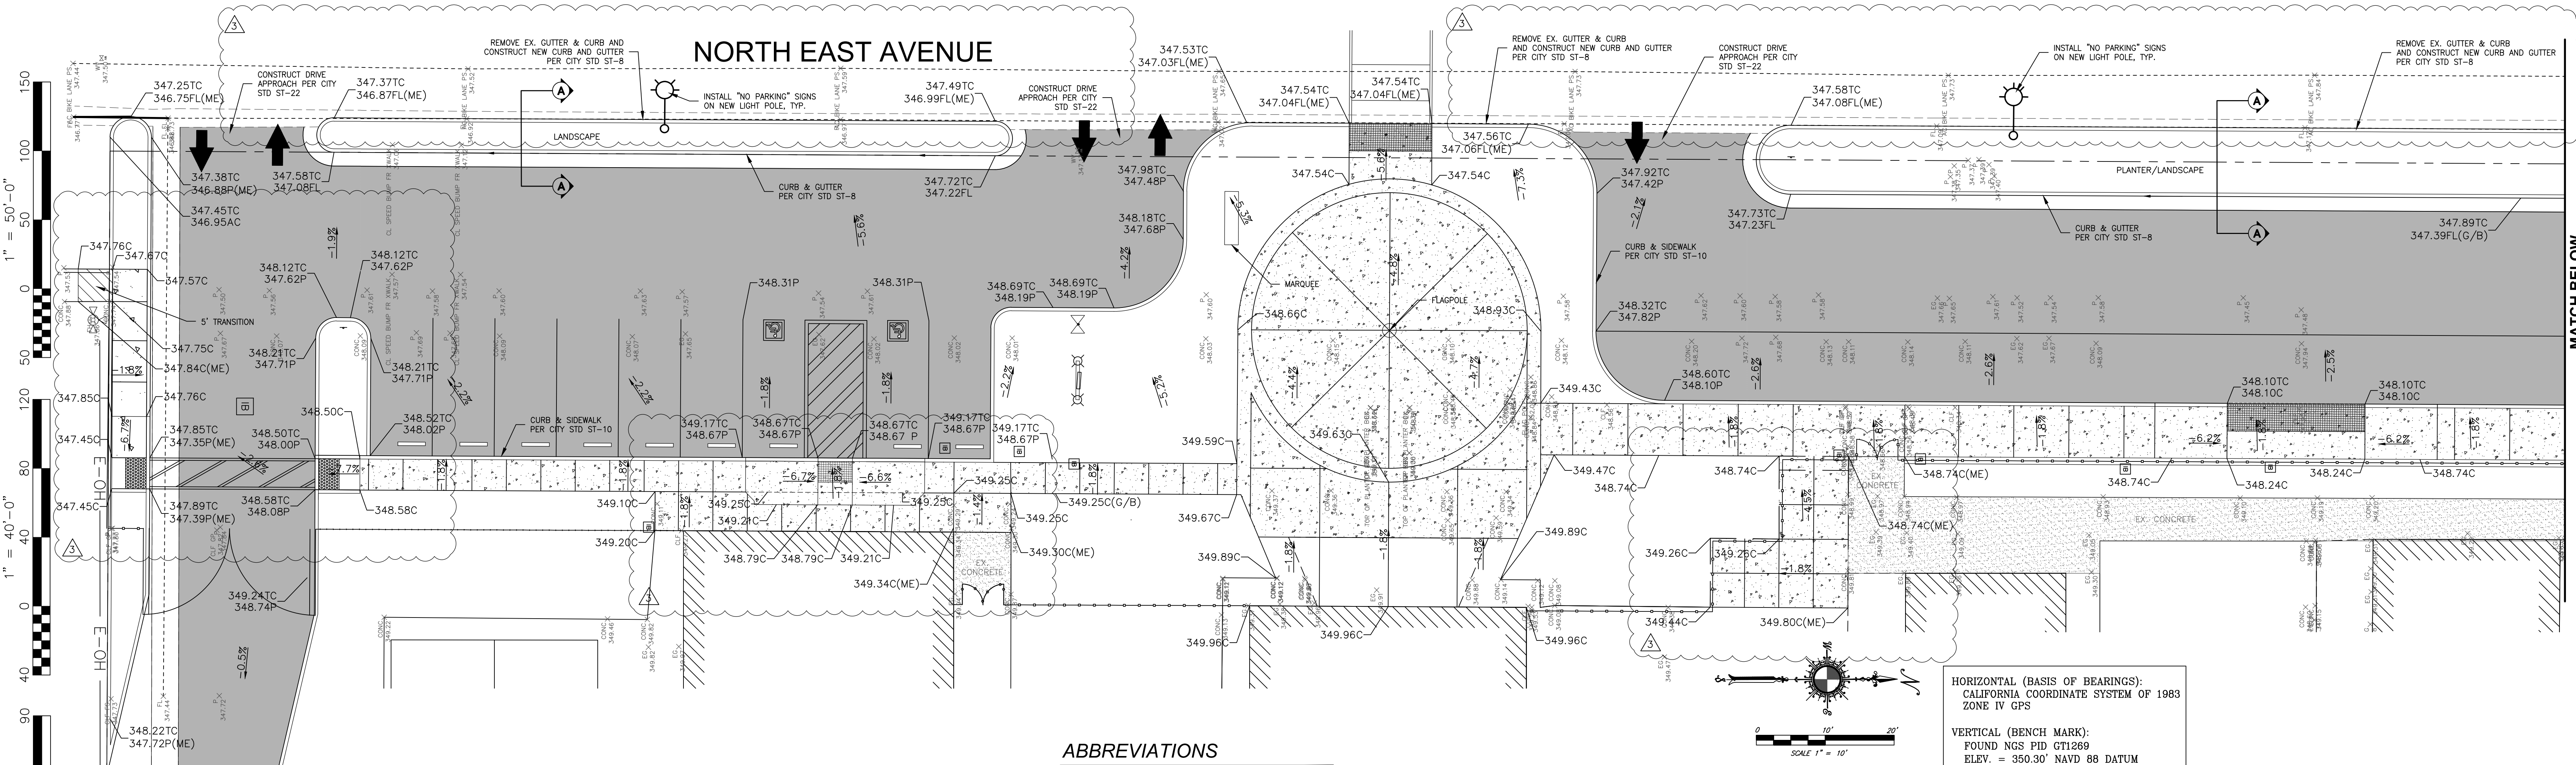

**KINGS CANYON
UNIFIED SCHOOL
DISTRICT**
1801 10TH STREET
REEDLEY, CA 93654

Owner:

**KINGS CANYON
UNIFIED SCHOOL
DISTRICT**
1801 10TH STREET
REEDLEY, CA 93654

Project Name:

SITE IMPROVEMENT

Project Address:

**GRANT MIDDLE
SCHOOL**
21771 E. PARLIER AVE
REEDLEY, CA 93654

integrated
designs
by SOMAM, Inc.

**ARCHITECTURE
ENGINEERING
INTERIOR DESIGN**

6011 N. FRESNO STREET, SUITE 130
FRESNO CALIFORNIA 93710
P: (559) 436-0881 F: (559) 436-0887
E: design@somam.com
integrateddesigns.com

Ownership of Documents

This document, the ideas and designs incorporated herein, as an instrument of Professional Service is the property of Integrated Design by SOMAM Inc. and is not to be used, in whole or in part for any other project without written authorization.

© COPYRIGHT 2020

Stamp:

Sheet Title:

GRADING PLAN

Job No.:

5514

Sheet No.:

C1.0
ADDENDUM 3

Release:


7/11/2022

DATE

9/11/2022

SAVE DATE 7/11/2022

\\PETER-PC\Projects\ME20\ME-169 Grant Middle School (CVEAS)\Grading\ME-169 GRADING.dwg

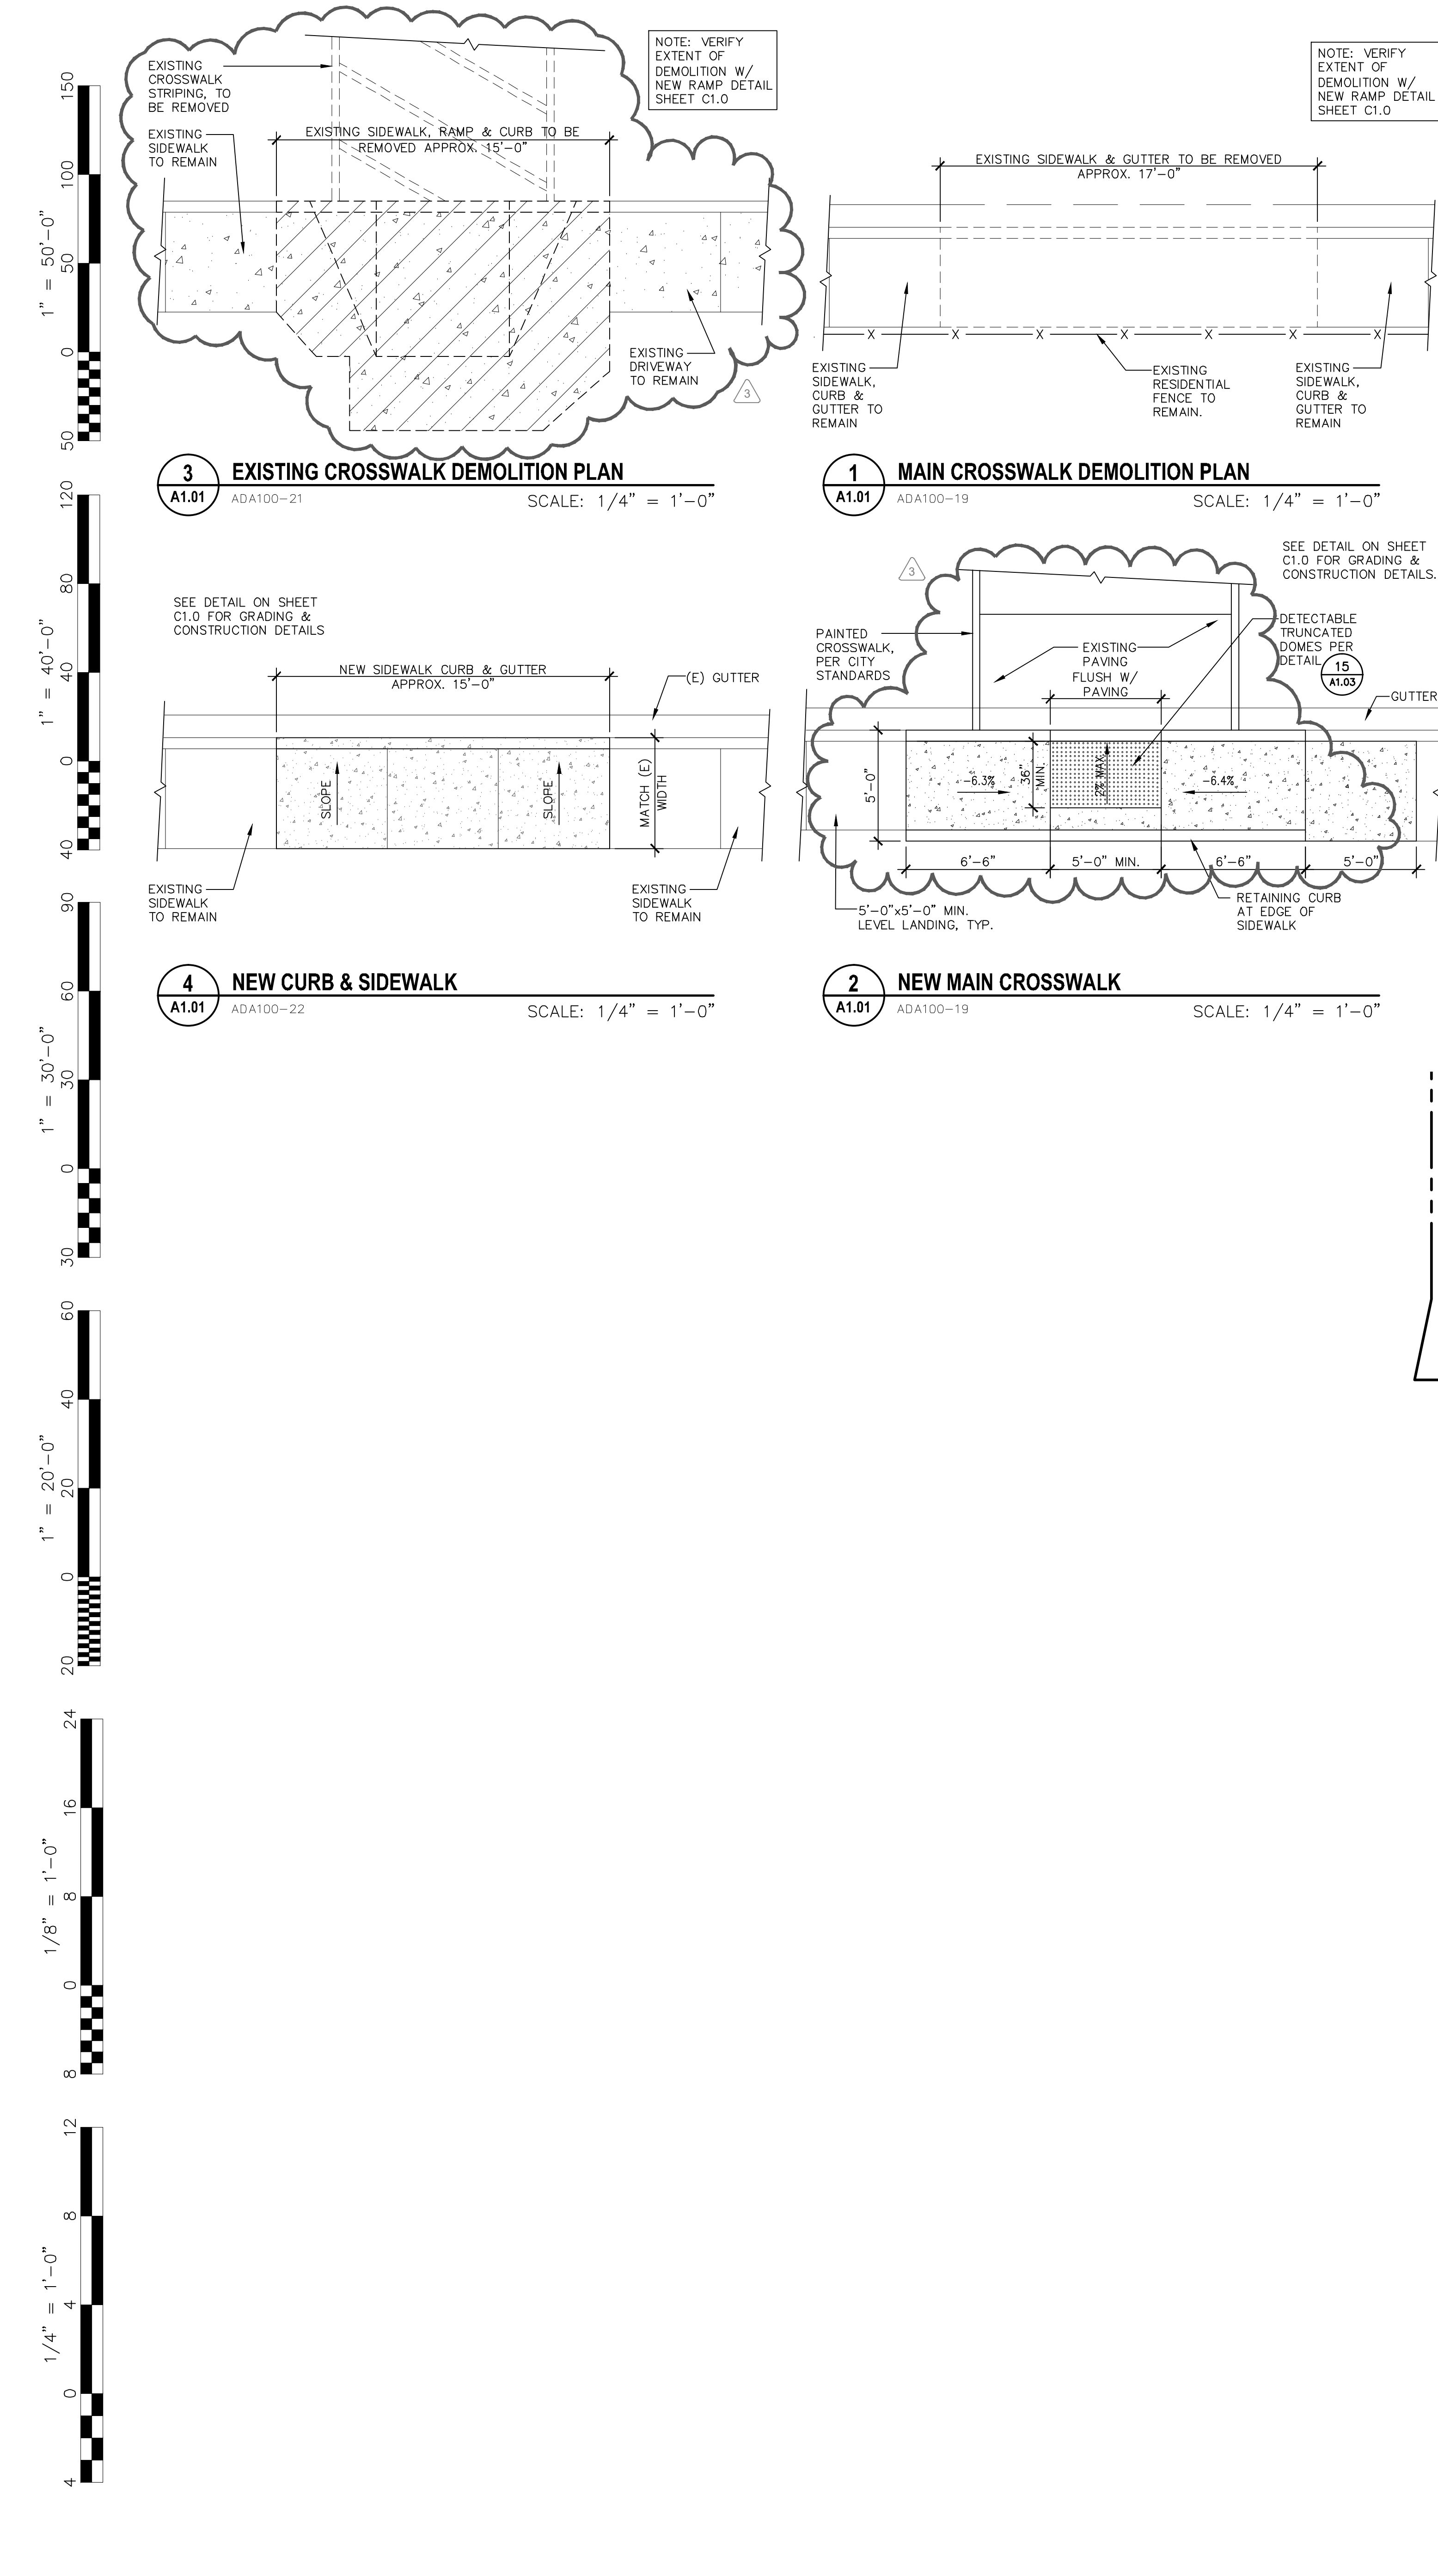

810

FIRE & LIFE SAFETY SITE CONDITIONS SUBMITTAL

Division of the State Architect (DSA) documents referenced within this publication are available on the [DSA Forms](#) or [DSA Publications](#) webpages.

To facilitate the Division of the State Architect's (DSA) fire and life safety plan review of project site conditions, DSA requires the design professional to provide the following information at time of project submittal for projects consisting of construction of a new campus, construction of new building(s), additions to existing buildings, and for site alternate design means for fire department emergency vehicle access, and fire suppression water supply.

Information associated with compliance items 1 through 3 below is to be provided for all project types indicated above. Information associated with items 4 through 7 is to be completed when an alternate means is utilized. Acknowledgement by the school district and signature from the Local Fire Authority (LFA) is only required when an alternate design means is being requested.

The Project Information and Fire & Life Safety Information sections are to be completed for all projects and imaged onto the fire access site plan. When an alternate design/means is proposed, all sections on pages 1 and 2 are to be completed and imaged on the fire access site plan.

For additional information refer to the instructions at the end of this form and DSA Policy PL 09-01: *Fire Flow for Buildings*.

PROJECT INFORMATION		
School District/Owner: Kings Canyon Unified School District		
Project Name/School: Grant Middle School Improvements		
Project Address: 360 N. East Ave., Reedley, CA 93654		
FIRE & LIFE SAFETY INFORMATION		
1. Has a fire hydrant flow test been performed within the past 12 months? <i>(If yes, provide a copy of the test data.)</i>	Yes ☐	No ☒
2. Was the fire hydrant water flow test performed as part of this LFA review?	Yes ☐	No ☒
3. Is the project located within a designated fire hazard severity zone (FHSZ) as established by Cal-Fire? <i>(If yes, indicate FHSZ classification below.)</i>	Yes ☐	No ☒
Refer to the following website for FHSZ locations: http://eqis.fire.ca.gov/FHSZ/	Moderate ☐	High ☐ Very High ☐
Wildland Interface Area (WIFA) <i>(If any designations are checked, project design must meet the requirements of CBC Chapter 7A.)</i>		WIFA ☐

DGS DSA 810 (revised 12/29/20) DIVISION OF THE STATE ARCHITECT DEPARTMENT OF GENERAL SERVICES STATE OF CALIFORNIA Page 1 of 4

FIRE & LIFE SAFETY SITE CONDITIONS SUBMITTAL

CONDITION MEANS AND METHODS RESOLUTION	ALTERNATE ACCEPTED			
	Yes	No	N/A	N/R
4. Emergency vehicle access roadways do not meet CFC requirements.				☒
4a. Acceptable Alternate: Emergency vehicle and personnel access as proposed by the project architect is acceptable for providing fire suppression and protection of life and property.				
5. Fire Hydrants: Number and spacing does not meet CFC requirements.				☒
5a. Acceptable Alternate: Number of fire hydrants and spacing as proposed by the project architect is acceptable for fire suppression and protection of life and property.				
6. Fire Hydrants: Water flow and pressure are less than CFC minimum.				☒
6a. Acceptable Alternate: The available flow and pressure is acceptable for providing fire suppression and protection of life and property.				
7. Location of fire department connection(s) serving fire sprinkler systems or standpipe systems does not meet CFC requirements.				☒
7a. Acceptable Alternate: The location of fire department connection serving the fire sprinkler system and/or standpipe system is acceptable for providing fire suppression and protection of life and property.				

School District Acceptance of Acceptable Design Alternates

By signing this form, the school district acknowledges and accepts the proposed design as an alternative to California Building Code (CBC) and California Fire Code (CFC) minimum requirements, as indicated by one or more of the conditions indicated at items 4a, 5a, 6a or 7a, for providing fire and life safety protection of life and property.

Accepted by: _____ Title: _____

Signature: _____ Date: _____

LOCAL FIRE AUTHORITY (LFA) INFORMATION	
LFA Agency Name: _____	
LFA Review Official: _____	
Title: _____	Work Phone: _____
Work Email: _____	
LFA Reviewer's Signature: _____ Date: _____	

DGS DSA 810 (revised 12/29/20) DIVISION OF THE STATE ARCHITECT DEPARTMENT OF GENERAL SERVICES STATE OF CALIFORNIA Page 2 of 4

KEY NOTES

- NEW CURB & SIDEWALK
- NEW STUDENT DROP OFF LANE(S)
- NEW ASPHALT PAVING
- NEW DECORATIVE METAL DRIVE GATES
- NEW 6" HIGH DECORATIVE METAL FENCE
- NEW ACCESSIBLE MAIN GATES
- NEW CONCRETE ENTRY PLAZA
- NEW 33" HIGH FLAG POLE
- NEW VISITOR PARKING
- NEW ACCESSIBLE PARKING
- NEW CURB & GUTTER
- NEW CROSSWALK PER CITY STANDARDS
- NEW LANDSCAPED ISLAND
- FUTURE MARQUEE APPROVED UNDER DSA APP#02-119014
- NEW LANDSCAPE AREA
- NEW SIDEWALK
- NEW DRIVE APPROACH
- NEW TOW AWAY SIGNAGE @ DRIVE ENTRY
- NEW DIRECTIONAL ARROWS & STRIPING
- EXISTING BUILDING TO REMAIN, NO WORK
- EXISTING LANDSCAPE ISLAND TO REMAIN
- EXISTING PARKING TO REMAIN- PARKING APPROVED UNDER DSA 02-109693
- EXISTING LANDSCAPE TO REMAIN
- EXISTING CONCRETE WALKS TO REMAIN.
- NEW 20'-0" WIDE ACCESS LANE. DESIGNED TO MEET DSA PL07-03.
- CURB TO BE PAINTED RED UPON WHICH IS CLEARLY PAINTED IN WHITE THE WORDS 'NO PARKING FIRE LANE'. EXTEND FULL LENGTH OF CURB.
- EXISTING FIRE TRUCK ACCESS LANE.

PARKING

PARKING LOT # 1
42 STALLS TOTAL
3 ACCESSIBLE SPACES
(SPACES REQUIRED)


VISITOR PARKING
9 STALLS TOTAL
1 ACCESSIBLE SPACES
(SPACE REQUIRED)

ACCESSIBLE PATH

THE EXISTING PATH OF TRAVEL IDENTIFIED WITHIN THE CAMPUS HAS BEEN DETERMINED TO MEET CURRENT REQUIREMENTS FOR ACCESSIBILITY BY THE DESIGN PROFESSIONAL IN GENERAL RESPONSIBLE CHARGE OF THIS PROJECT. ALL WORK WITHIN THE SCOPE OF THIS PROJECT HAS BEEN DESIGNED TO MEET CURRENT CODE REQUIREMENTS.

LEGEND

- NEW CONCRETE WALKS
- NEW LANDSCAPING
- EXISTING TURF & LANDSCAPE TO REMAIN
- EXISTING OR NEW FIRE TRUCK ACCESS LANE
- ACCESSIBLE PATH OF TRAVEL
- INDICATES AREA OF WORK
- NEW FENCING & GATES
- PROPERTY LINE
- EXISTING FENCING

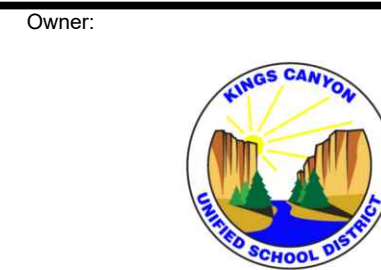

**KINGS CANYON
UNIFIED SCHOOL
DISTRICT**
1801 10TH ST.
REEDLEY, CA 93654

Project Name:
**SITE
IMPROVEMENTS**

Project Address:
**GRANT MIDDLE
SCHOOL**
360 N. EAST AVENUE
REEDLEY, CA 93654



**integrated
designs**
by SOMAM, Inc.

**ARCHITECTURE
ENGINEERING
INTERIOR DESIGN**

6011 N. FRESNO STREET, SUITE 130
FRESNO CALIFORNIA 93710
P:(559) 436-0881 F:(559) 436-0887
E: design@somam.com
integrateddesigns.com

Ownership of Documents
This document, the original and design incorporated herein, is an instrument of Professional Service is the property of Integrated Designs by SOMAM Inc. and is not to be used, in whole or in part for any other project without written authorization.
© COPYRIGHT 2022

Stamp:



Sheet Title:

SITE PLAN



Job No.:

5514

Sheet No.:



A1.01

Release: ADDENDUM 3

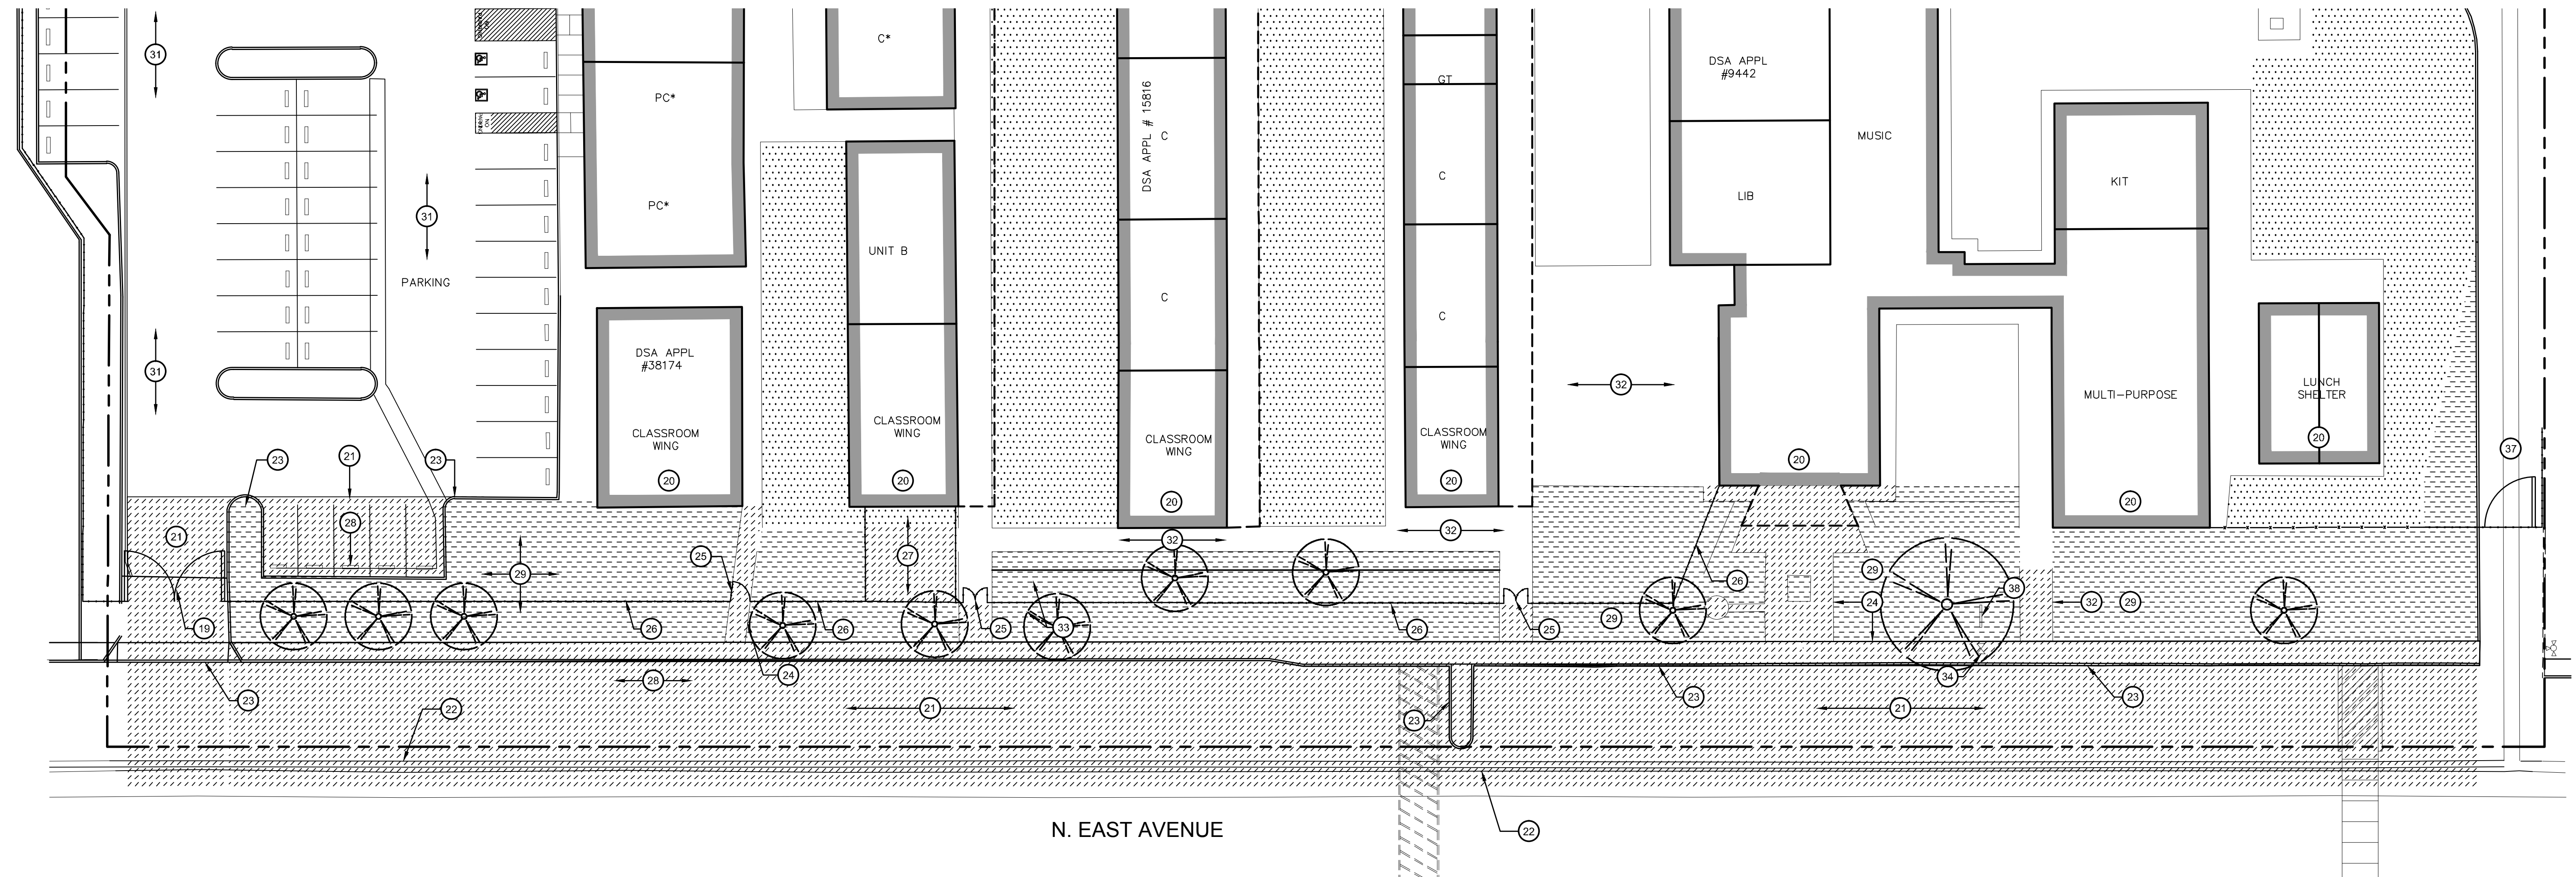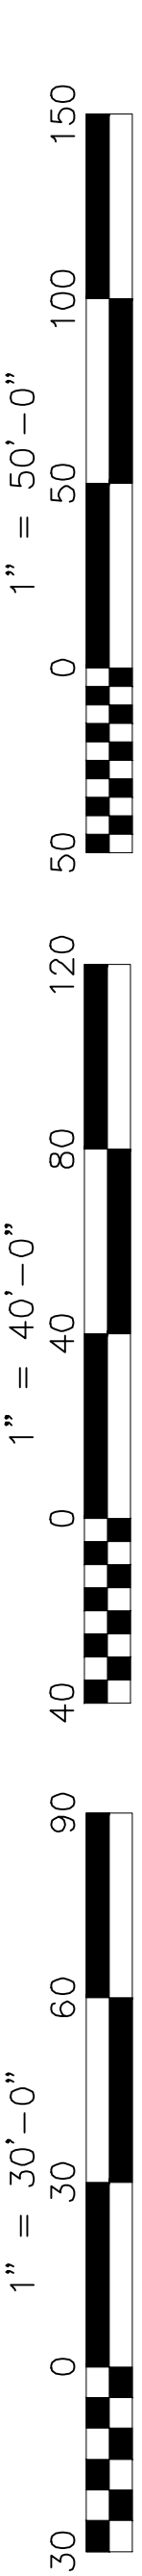

ENLARGED DEMO SITE PLAN
SITE IMPROVEMENTS

SCALE: 1" = 20'

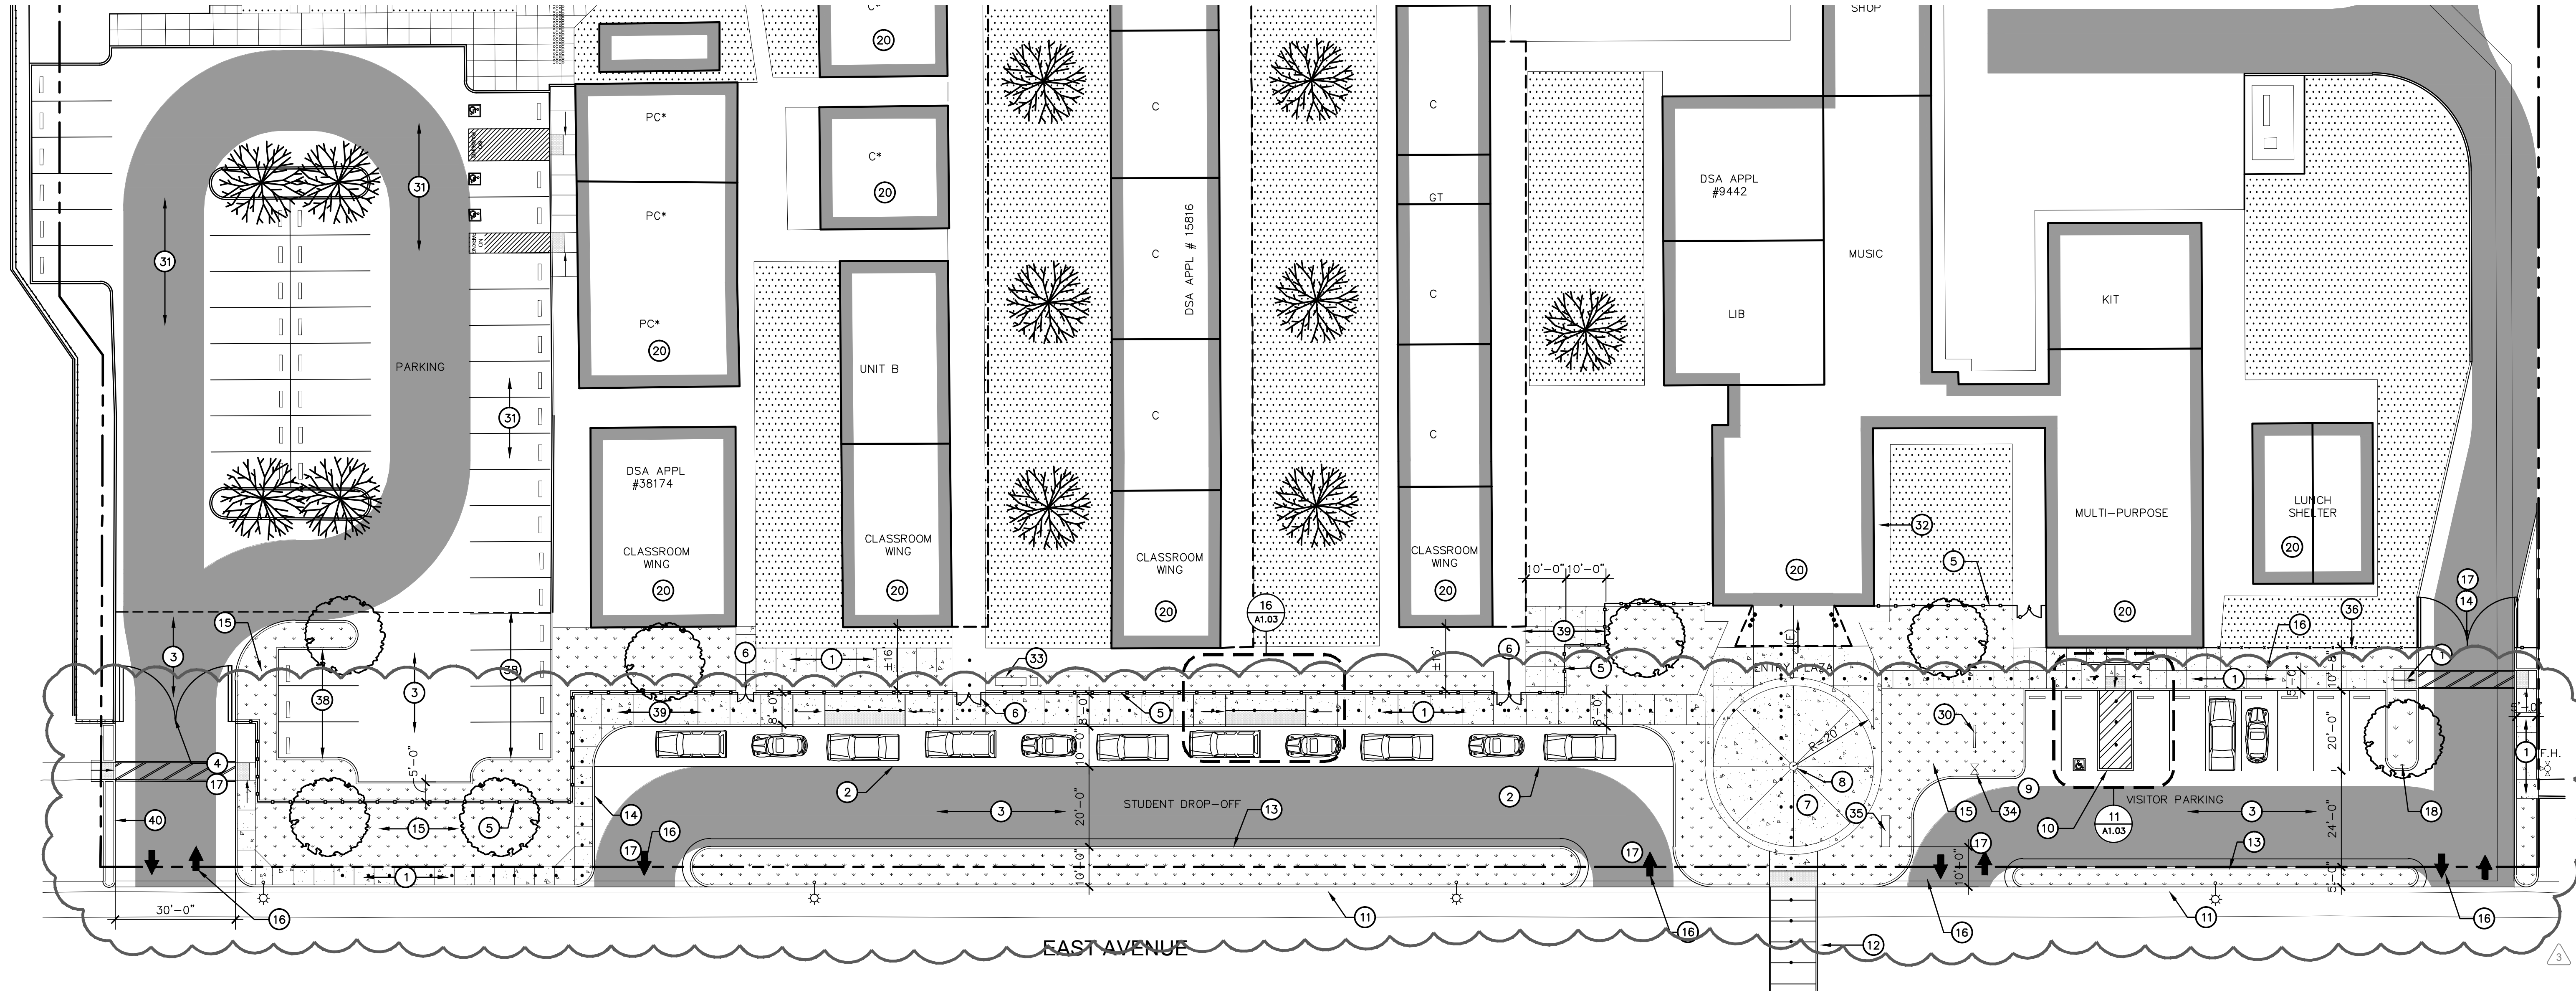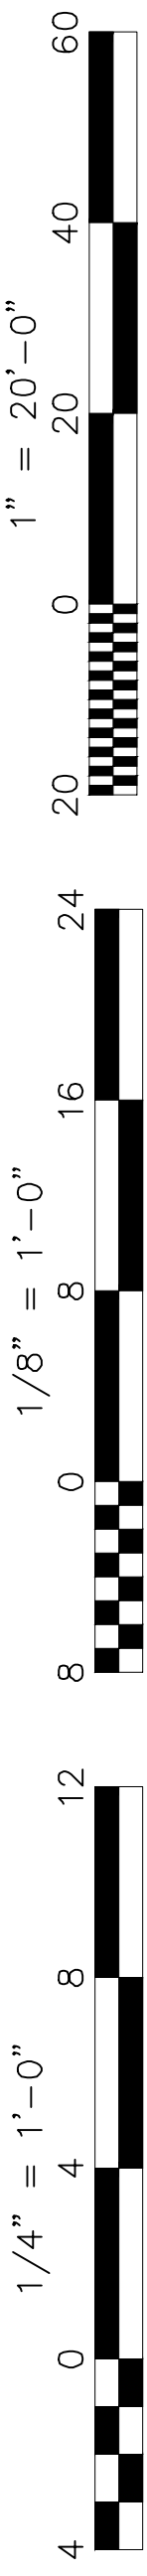

ENLARGED SITE PLAN
SITE IMPROVEMENTS

SCALE: 1" = 20'

KEY NOTES

1. NEW CURB & SIDEWALK
2. NEW STUDENT DROP OFF LANE(S)
3. NEW ASPHALT PAVING, - SEE CIVIL
4. NEW DECORATIVE METAL DRIVE GATES, SEE DETAIL, BAY.03
5. NEW 6' HIGH DECORATIVE METAL FENCE, SEE DTL. #7/A1.03
6. NEW ACCESSIBLE MAN GATES, SEE DTL. #8/A1.03, GATES TO BE 8'-0" WIDE.
7. NEW CONCRETE ENTRY PLAZA
8. NEW FLAG POLE, 33' HIGH, - SEE 4/A1.03.
9. NEW VISITOR PARKING.
10. NEW ACCESSIBLE PARKING
11. NEW CURB GUTTER, SEE CIVIL SHEET C1.0.
12. NEW CROSSWALK PER CITY STANDARDS - SEE A1.01 FOR WORK IN CITY ROW.
13. NEW LANDSCAPED ISLAND
14. NEW CHAIN LINK GATE, - SEE 22/A1.03.
15. NEW LANDSCAPE AREA
16. NEW DIRECTIONAL ARROWS & STRIPING
17. NEW DRIVE APPROACH, PROVIDE KNOX BOX PER CITY OF REEDLEY STANDARDS.
18. NEW TOW AWAY SIGNAGE @ DRIVE ENTRY, - SEE 13/A1.03.
19. EXISTING DRIVE GATES TO BE REMOVED
20. EXISTING BUILDING TO REMAIN, NO WORK
21. EXISTING ASPHALT PARKING TO BE REMOVED
22. EXISTING VALLEY GUTTER TO BE REMOVED
23. EXISTING CURB & SIDE WALK TO BE REMOVED
24. EXISTING CONCRETE WALK TO BE REMOVED
25. EXISTING CHAIN LINK GATE TO BE REMOVED
26. EXISTING CHAIN LINK FENCING TO BE REMOVED
27. EXISTING BIKE RACKS & ASPHALT PAVING TO BE REMOVED
28. EXISTING WHEEL STOPS TO BE REMOVED, TYPICAL THIS BAY.
29. EXISTING LANDSCAPE TO BE REMOVED, SEE LEGEND
30. EXISTING BACKFLOW PREVENTION DEVICE TO REMAIN.
31. EXISTING PARKING TO REMAIN
32. EXISTING CONCRETE WALK TO REMAIN
33. EXISTING BACKFLOW PREVENTION DEVICE TO BE REMOVED AND RELOCATED BEHIND NEW FENCE.
34. EXISTING WATER METER TO BE REPLACED
35. FUTURE MARQUE APPROVED UNDER SEPARATE APPLICATION DSA #02-119014.
36. EXISTING CHAIN LINK FENCE TO REMAIN.
37. EXISTING CHAIN LINK GATE TO BE REMOVED.
38. NEW PARKING STALLS w/ WHEEL STOPS.
39. NOT USED.
40. NEW CONCRETE ISLAND w/ CURBS.

Owner:



**KINGS CANYON
UNIFIED SCHOOL
DISTRICT**
1801 10TH ST.
REEDLEY, CA 93654

Project Name:

**SITE
IMPROVEMENTS**

Project Address:

**GRANT MIDDLE
SCHOOL**
360 N. EAST AVENUE
REEDLEY, CA 93654



**integrated
designs**
by SOMAM, Inc.

**ARCHITECTURE
ENGINEERING
INTERIOR DESIGN**

6011 N. FRESNO STREET, SUITE 130
FRESNO CALIFORNIA 93710
P:(559) 436-0881 F:(559) 436-0887
E: design@somam.com
integrateddesigns.com

Disclaimer of Documents
This document, the plans and designs incorporated herein, as an instrument of Professional Service is the property of Integrated Designs by SOMAM Inc. and is to be used, in whole or in part for any other project without written authorization.
© COPYRIGHT 2022

Stamp:



Sheet Title:

**ENLARGED
SITE & DEMO
PLAN**

Job No.:

5514

Sheet No.:

A1.02

Release: ADDENDUM 3

LANDSCAPE






CONTRACTOR TO PROVIDE NEW LANDSCAPE & IRRIGATION SYSTEM AS DESIGN-BUILD SUBMITTAL FOR THE SCHOOL DISTRICT'S REVIEW PRIOR TO INSTALLATION.

CONTRACTOR TO INSTALL PLANT MATERIAL IN ACCORDANCE WITH SCHOOL DISTRICT'S APPROVED PLANT LIST AND STANDARDS. ALL PLANT MATERIAL SHALL HAVE 3" BARK MULCH PLACED BENEATH IN ACCORDANCE WITH STATE MWEO STANDARDS. SEE SPECIFICATIONS FOR ADDITIONAL REQUIREMENTS.

ALL IRRIGATION SYSTEM MATERIALS SHALL BE INSTALLED TO MEET SCHOOL DISTRICT STANDARDS. COORDINATE P.O.C. WITH EXISTING IRRIGATION SYSTEM. SEE SPECIFICATIONS FOR ADDITIONAL SYSTEM REQUIREMENTS. IRRIGATION SYSTEM SO DESIGNED BY CONTRACTOR SHALL CONFORM TO THE LATEST MWEO STANDARDS AND REQUIREMENTS.

LEGEND

- NEW CONCRETE WALKS
- NEW LANDSCAPING
- EXISTING TURF & LANDSCAPE TO REMAIN
- EXISTING BUILDINGS
- ACCESSIBLE PATH OF TRAVEL
- NEW DECORATIVE METAL FENCING & GATES
- EXISTING CHAIN LINK FENCING
- DEMO EXISTING CONCRETE & ASPHALT
- DEMO EXISTING LANDSCAPE, INCLUDING TREES, SHRUBS AND TURF
- EXISTING FIRE HYDRANT TO REMAIN
- EXISTING TREES TO BE REMOVED
- EXISTING TREES TO REMAIN
- NEW TREES

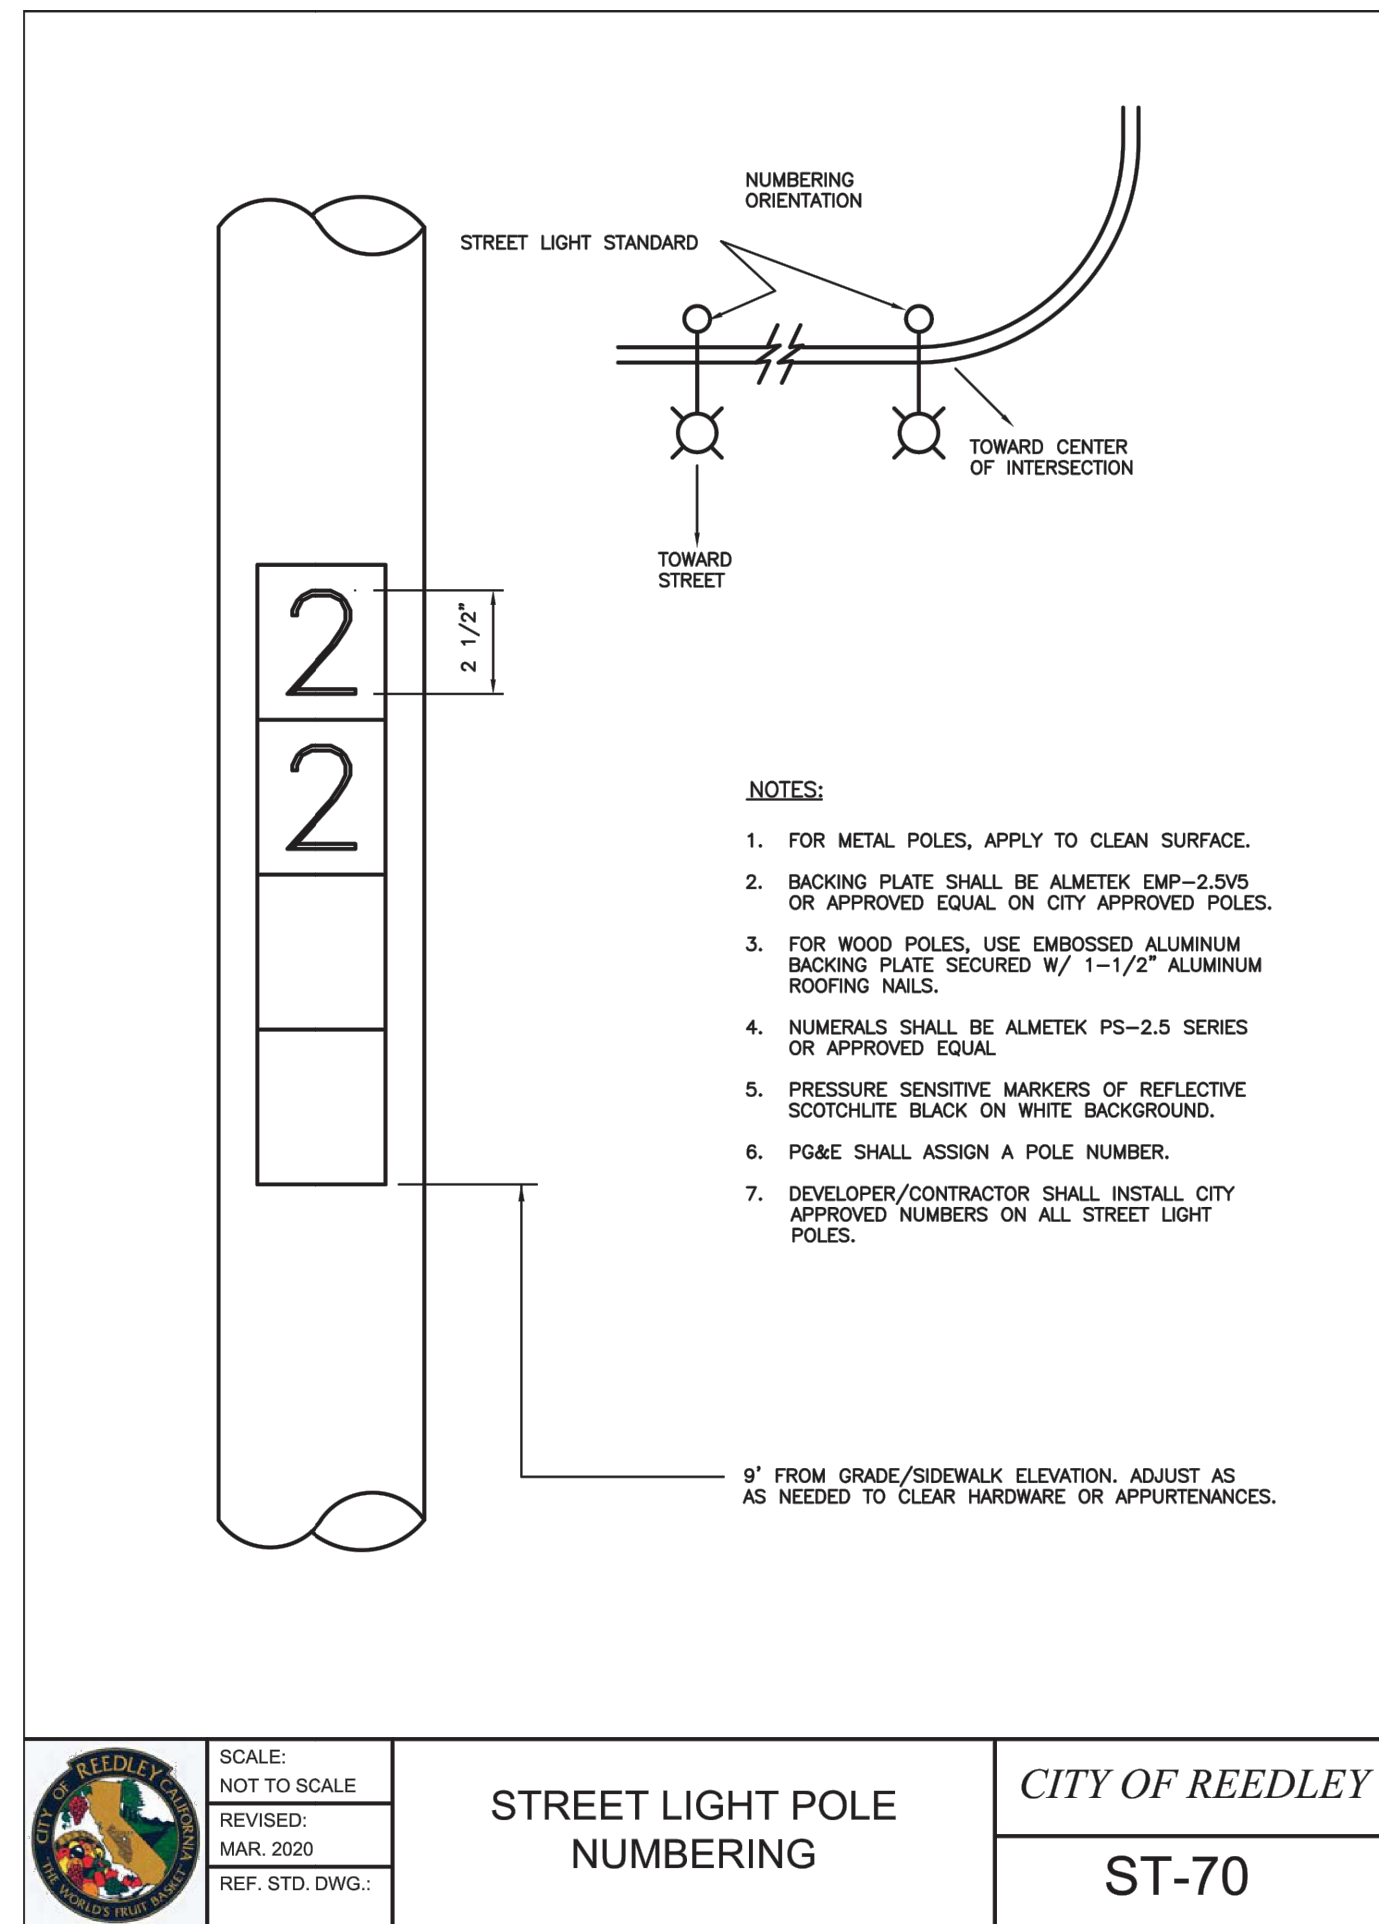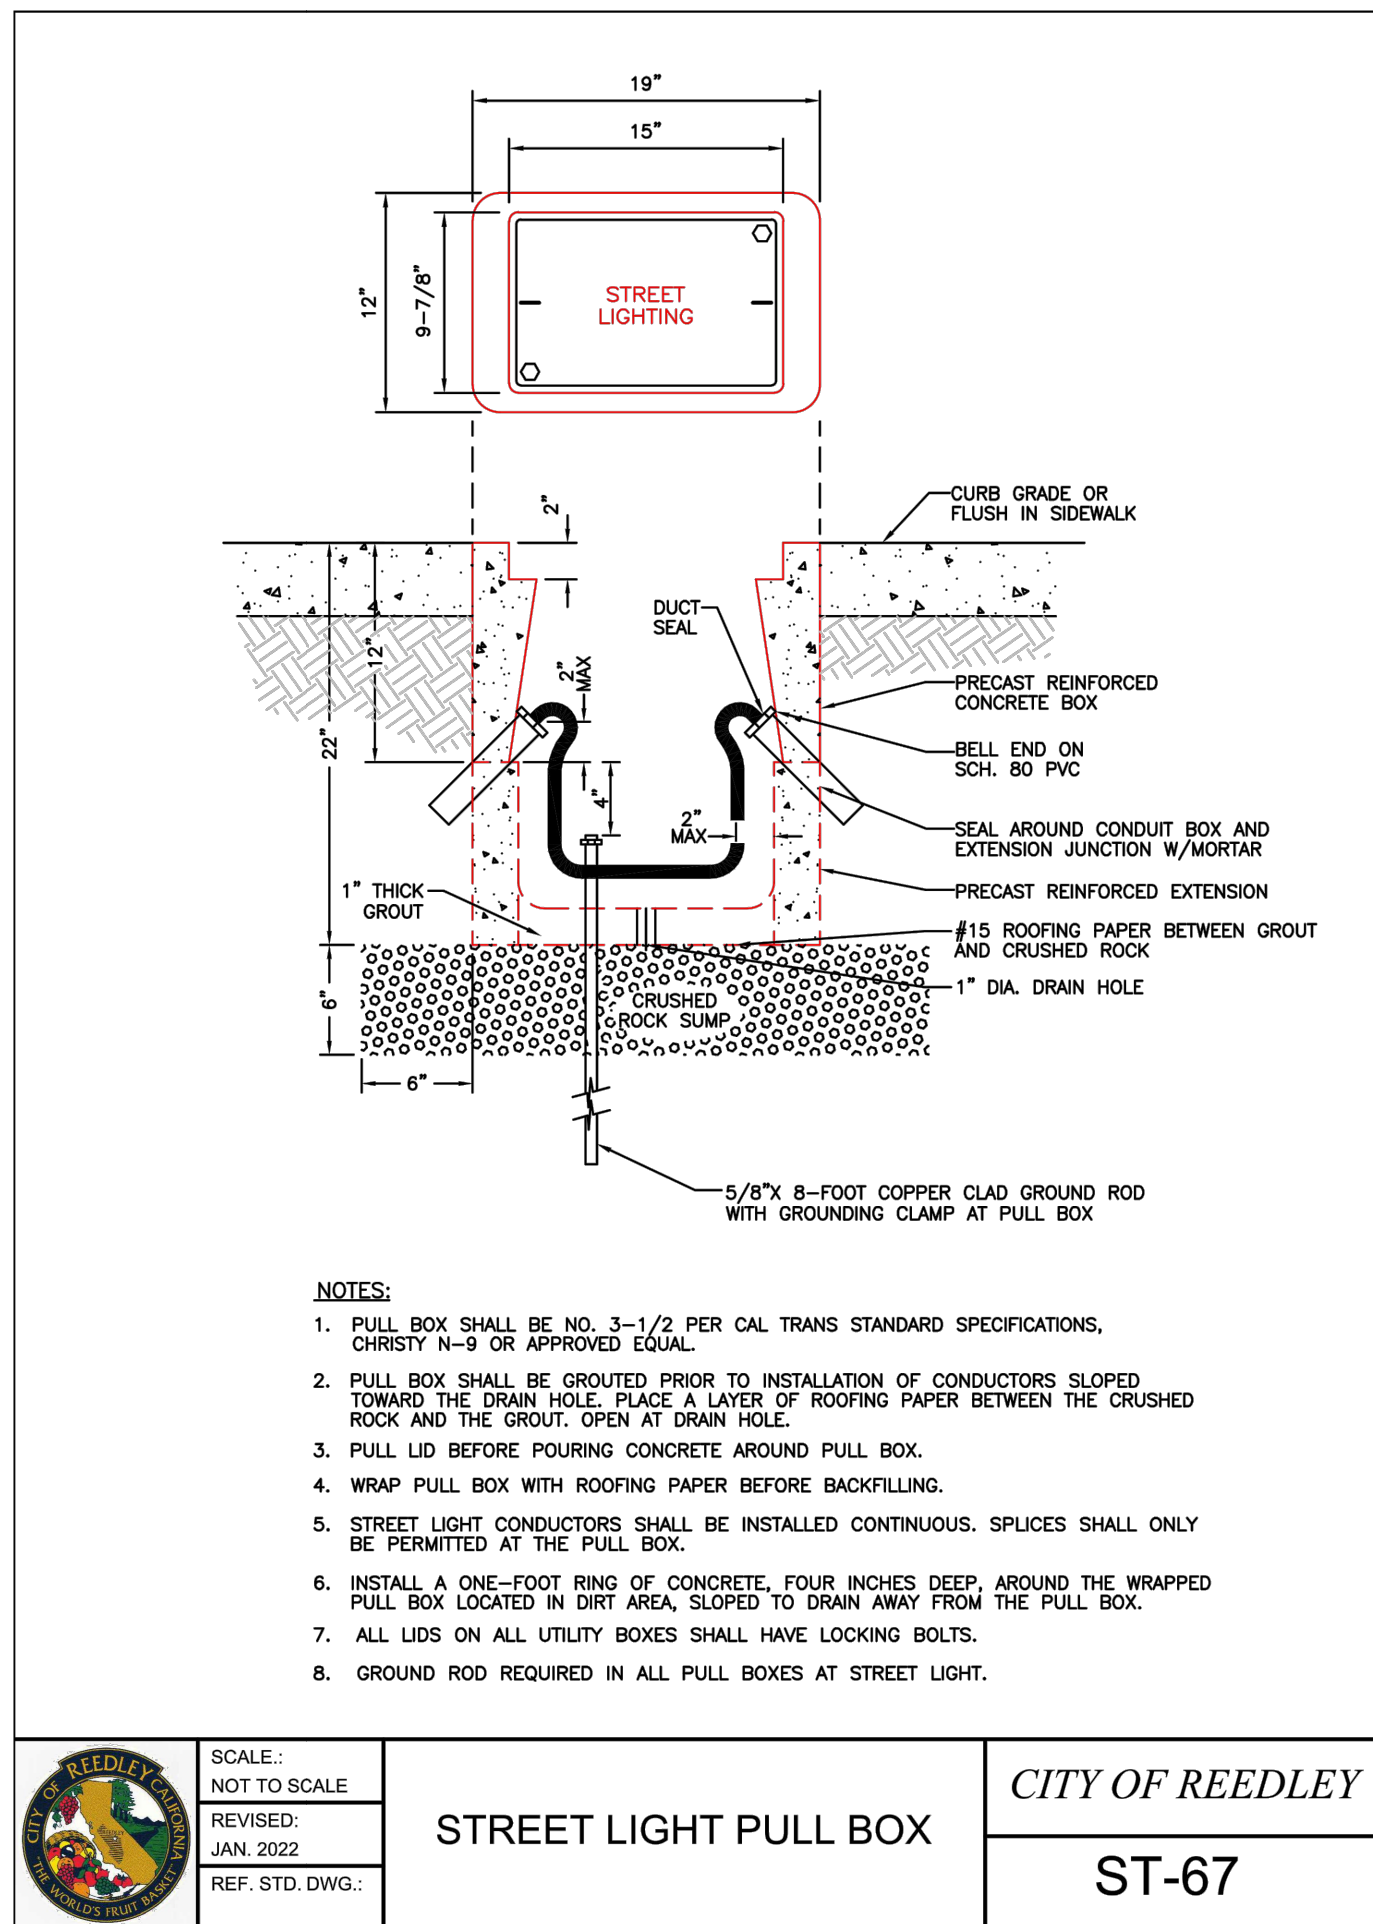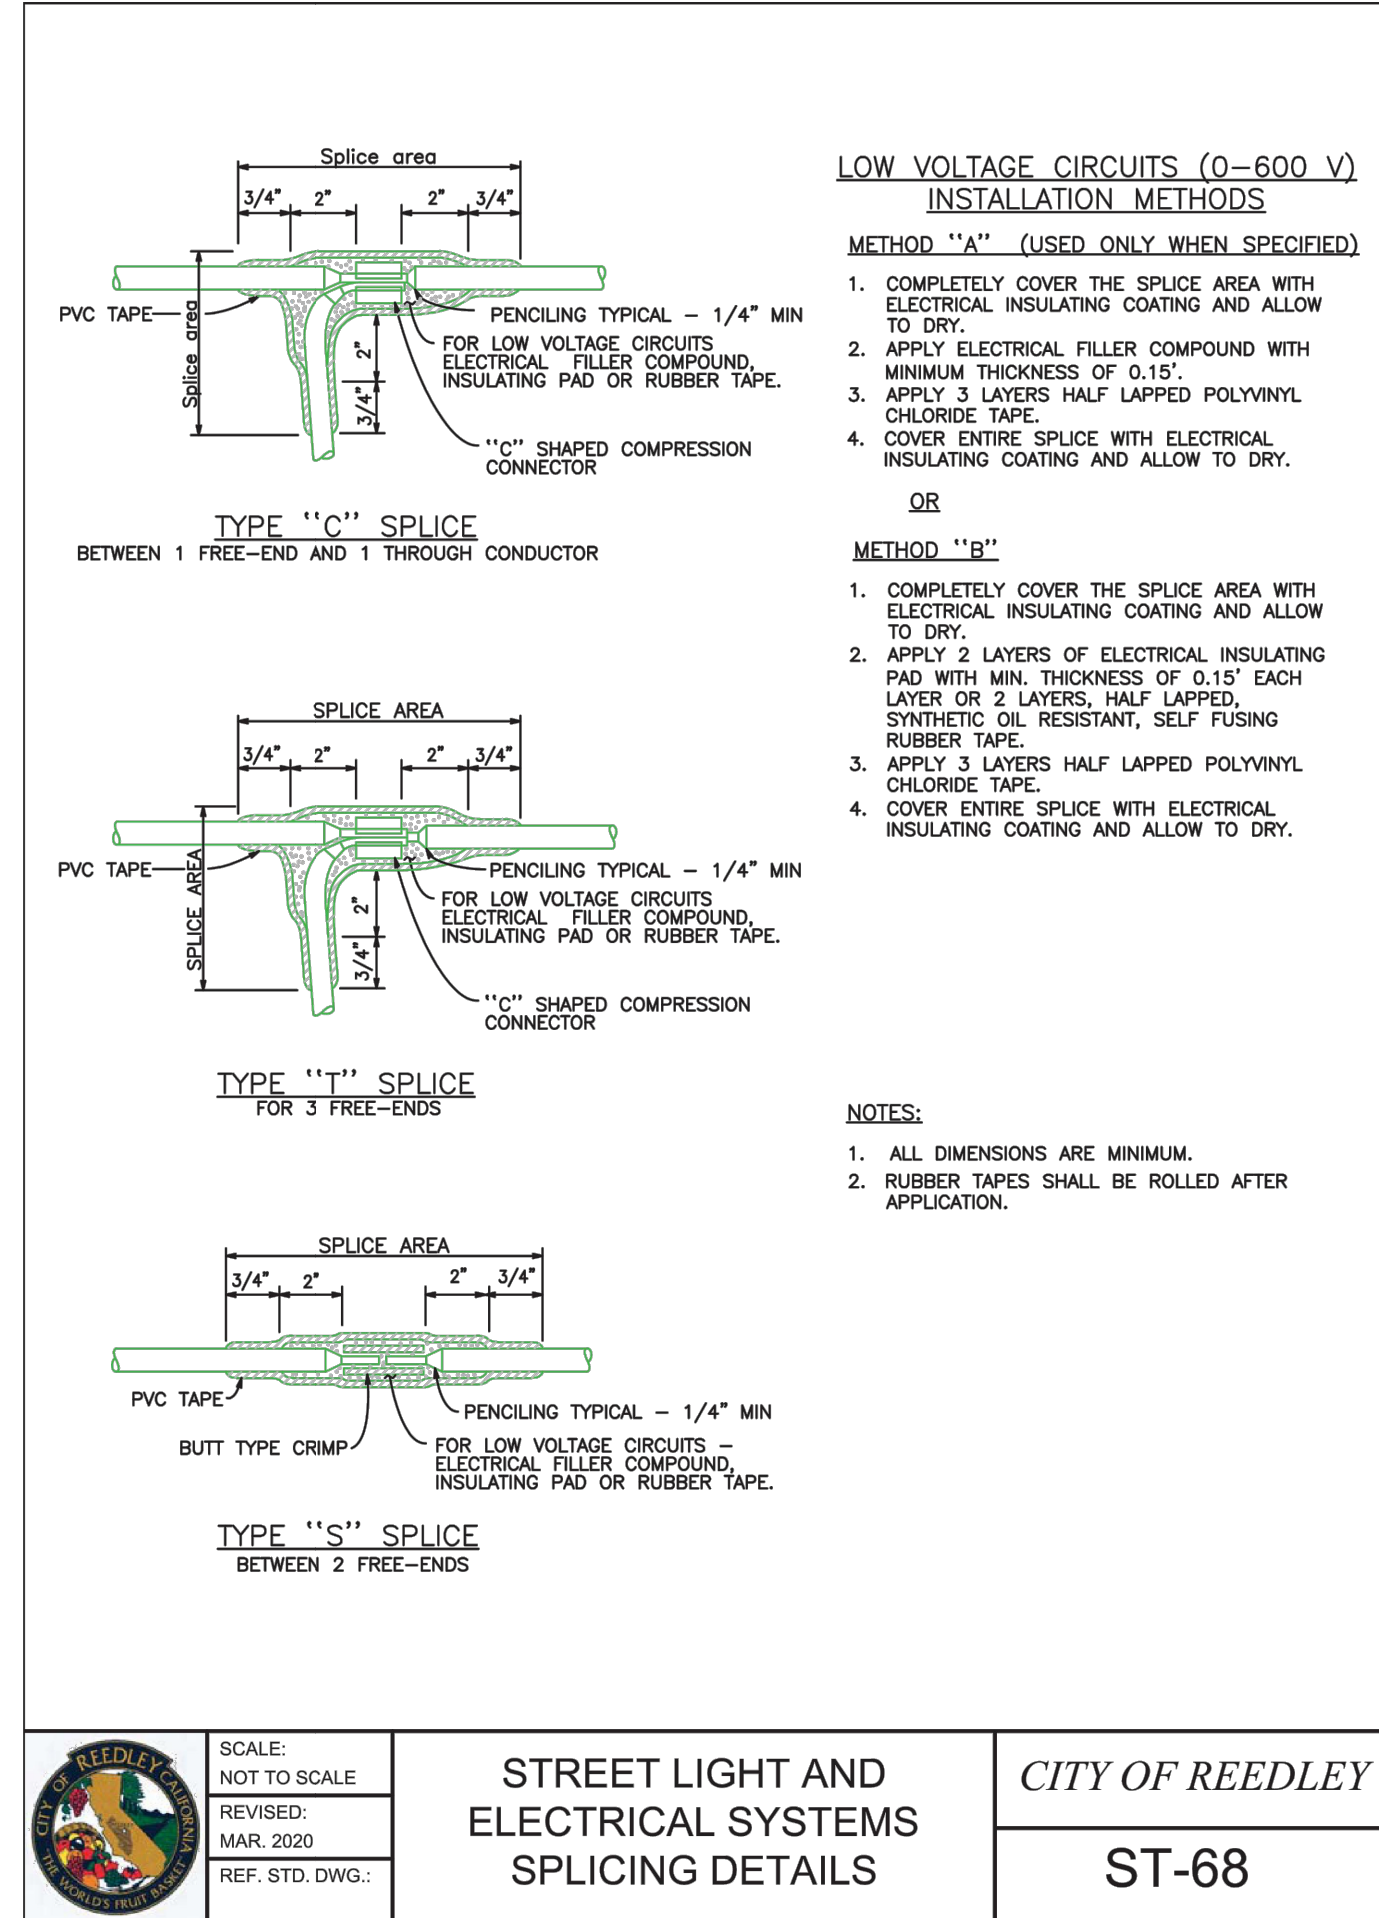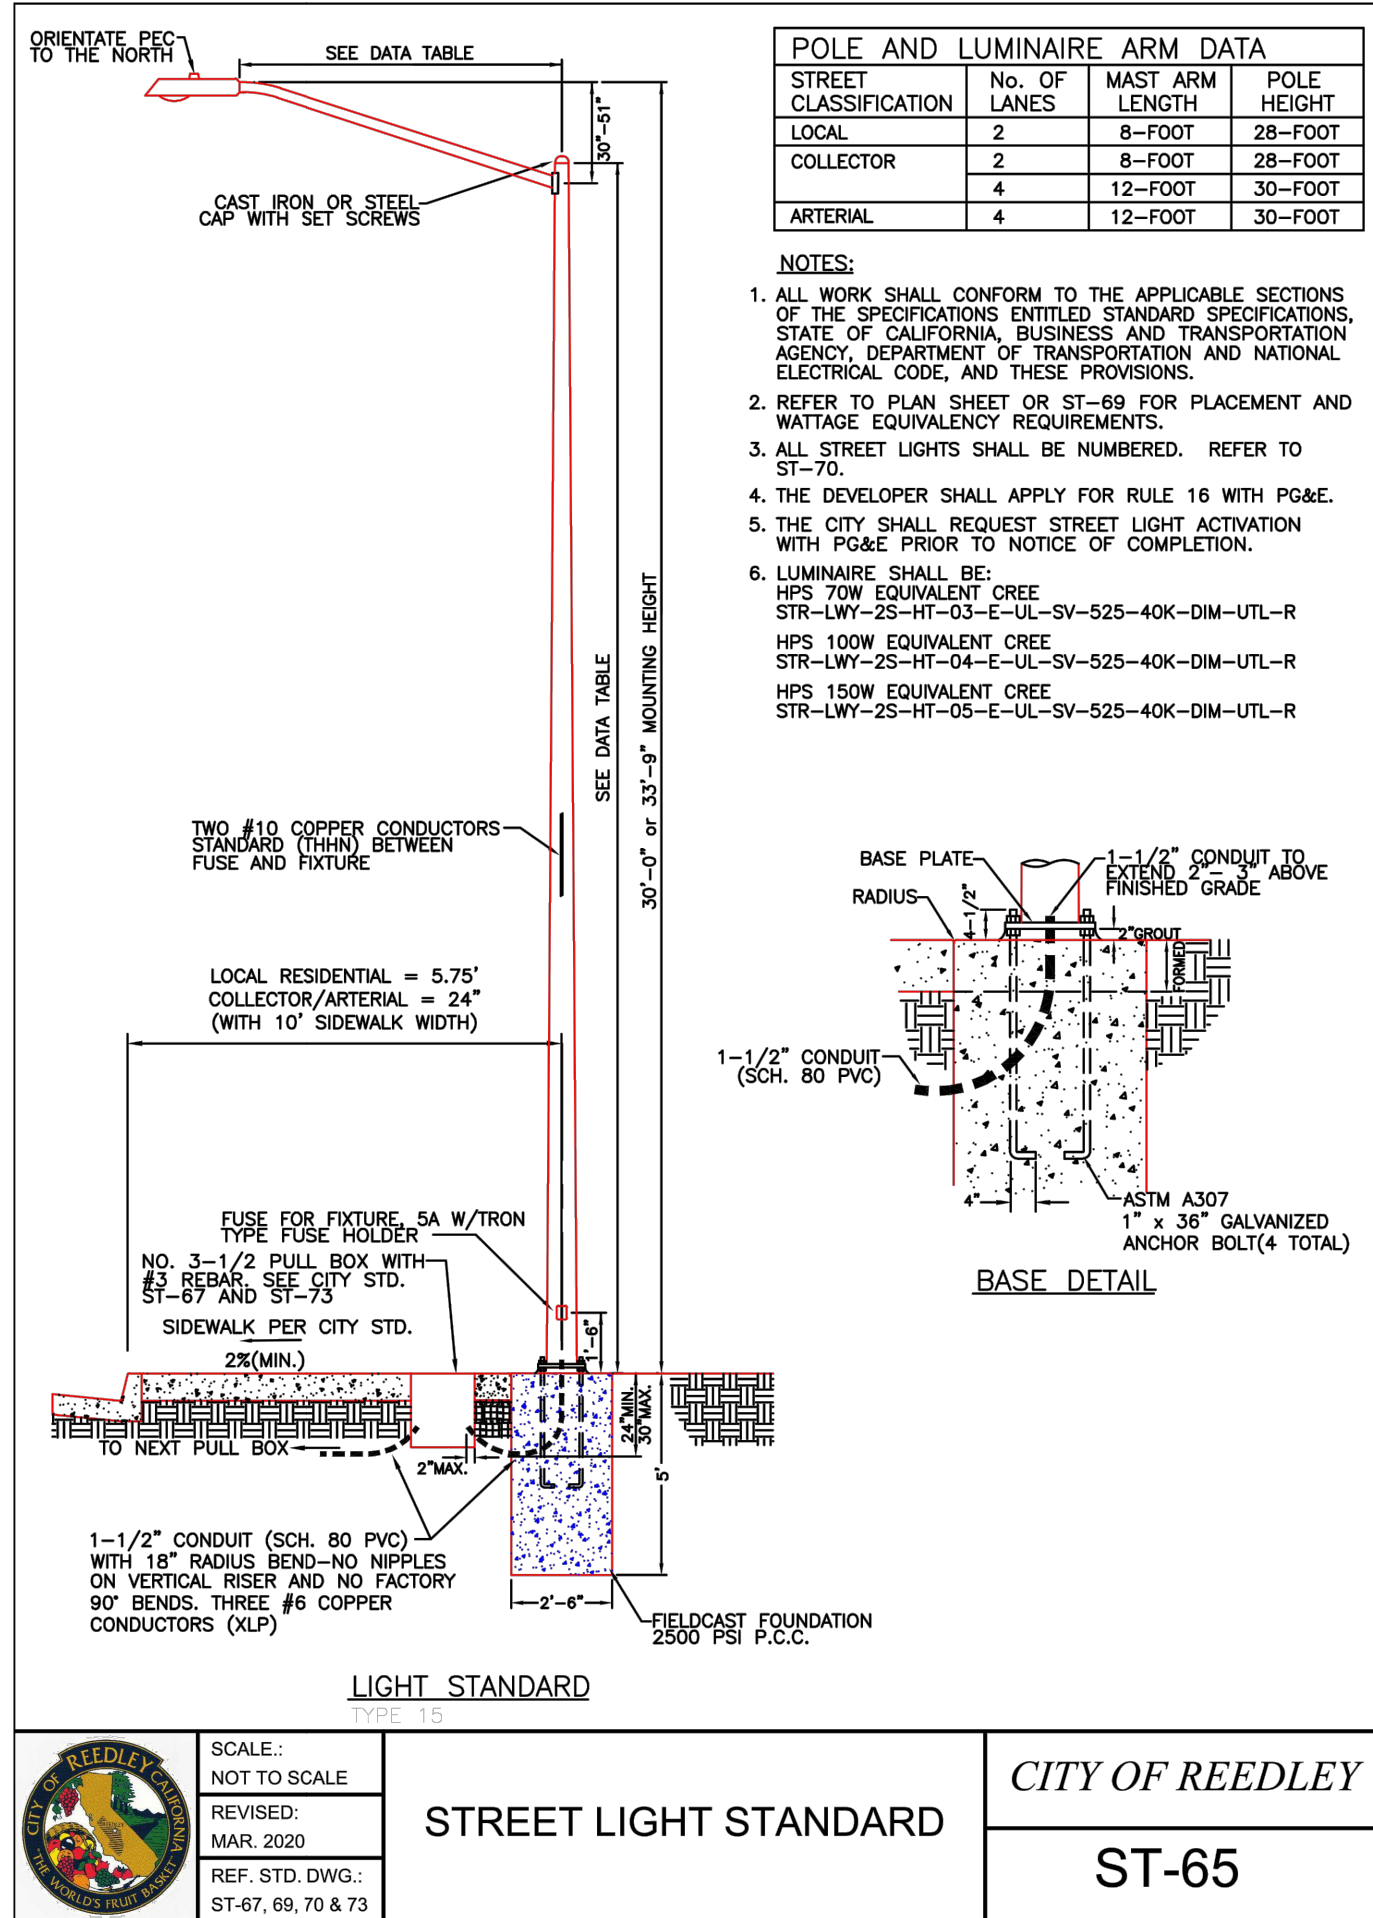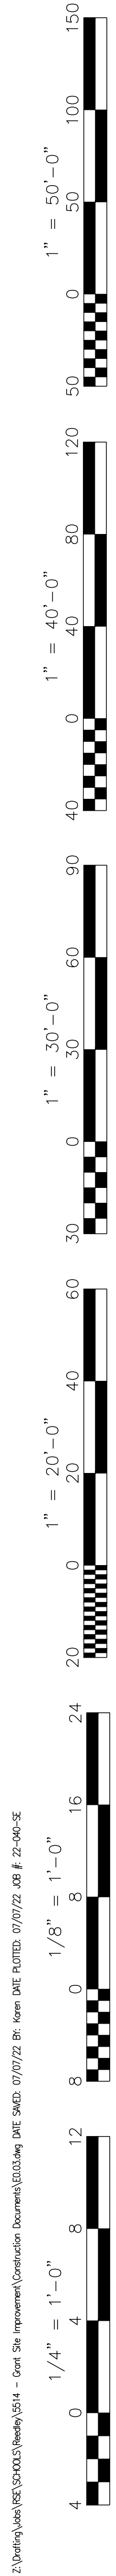


KINGS CANYON SCHOOL DISTRICT

1801 10TH ST.
REEDLEY, CA

SITE IMPROVEMENTS

GRANT MIDDLE SCHOOL

360 N. EAST AVENUE
REEDLEY, CA 93654

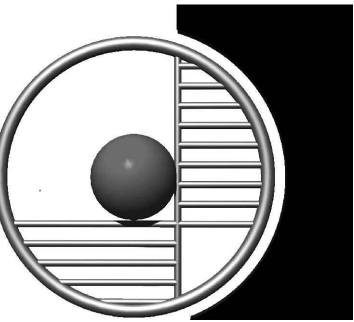

by SOMAM, Inc.

ARCHITECTURE ENGINEERING INTERIOR DESIGN

6011 N. FRESNO STREET, SUITE 130
FRESNO CALIFORNIA 93710
P: (559) 436-0881 F: (559) 436-0887
E: design@somam.com
Integrateddesigns.com

This document, the ideas and designs incorporated herein, as an instrument of Professional Service is the property of Integrated Designs by SOMAM Inc. and is not to be used, in whole or in part for any other project without written authorization.
© COPYRIGHT 2020

Stamp:

Sheet Title:

STREET LIGHTING DETAILS

Job No.:

5514



Sheet No.:

E0.03


Release: ADDENDUM #3 Issue Date: 07-07-22

Rose Sing Eastham & Associates
Electrical Consultants
131 S. Dunworth - (559)733-2671
Visalia, California 93292-6705



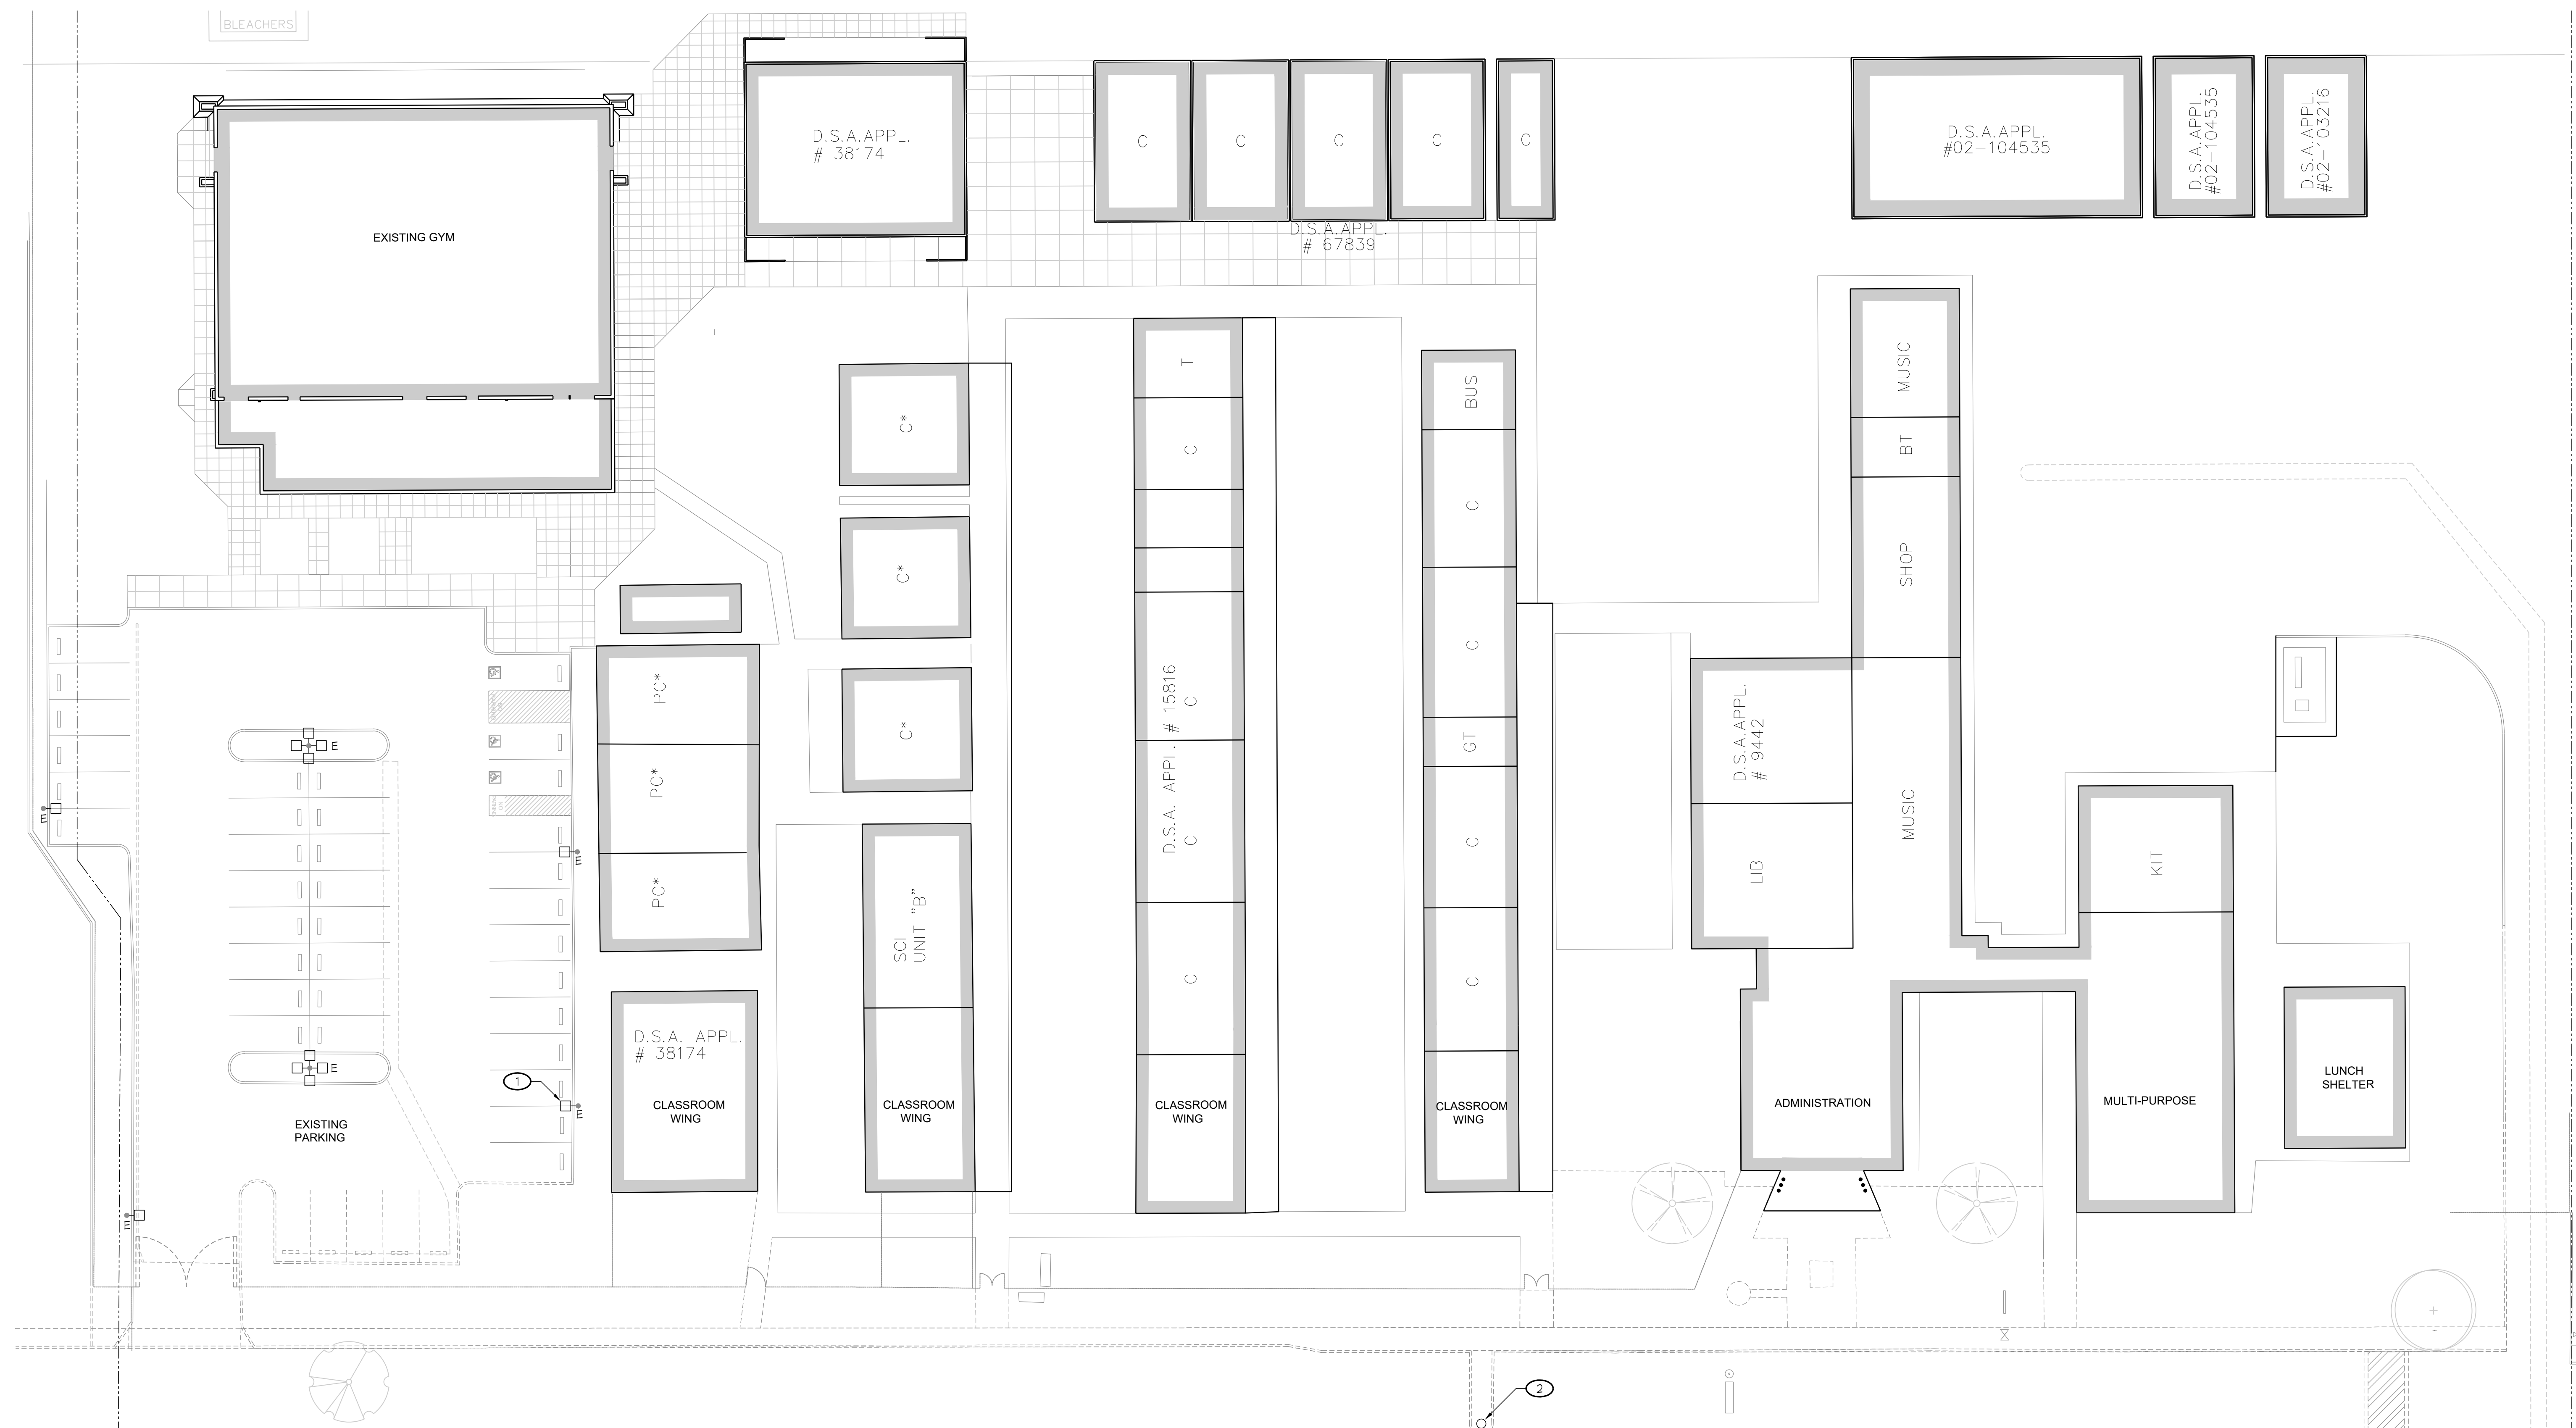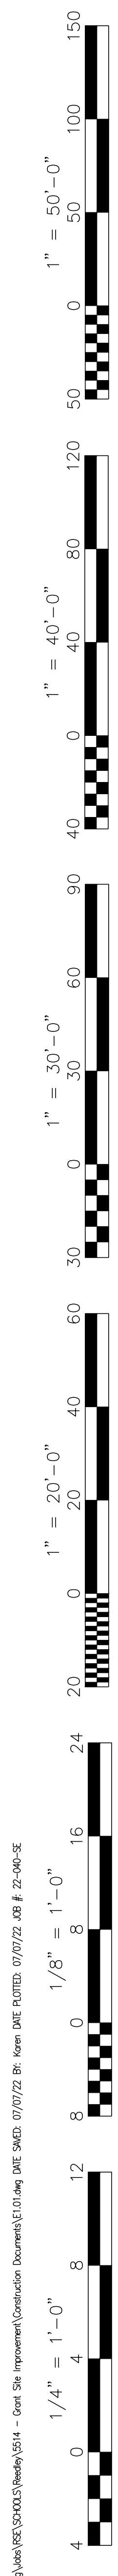

EAST AVENUE

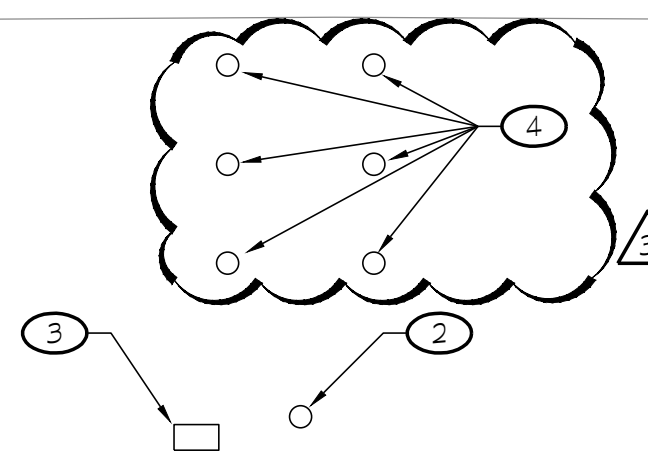

GENERAL NOTE:
1. ROAD REPAIR SHALL BE AS REQUIRED BY CIVIL PLANS AND PER ALL CITY REQUIREMENTS.

- NOTES (THIS SHEET ONLY):
- 1. VERIFY EXISTING LOCATION OF UNDERGROUND FEED.
 - 2. EXISTING SOLAR POWERED PEDESTRIAN FLASHING BEACON SYSTEM SHALL BE REMOVED AND RELOCATED TO NEW PEDESTRIAN CROSSWALK.
 - 3. EXISTING METER PEDESTAL, TO BE DISCONNECTED WITH PG&E. SALVAGE METER PEDESTAL AND CHRISTY BOX TO THE CITY YARD.
 - 4. EXISTING FLASHING ROAD MARKERS SHALL BE REMOVED. REMOVE LIGHT FIXTURE BASE AND PLUG WITH ASPHALT, PER CITY STANDARDS AND CIVIL ENGINEER REQUIREMENTS.

ELECTRICAL SITE PLAN - DEMOLITION
SITE IMPROVEMENTS

1" = 20'-0" SCALE:

Rose Sing Eastham & Associates
Electrical Consultants
131 S. Dunworth - (559)733-2671
Visalia, California 93292-6705



Owner:

**KINGS CANYON
SCHOOL DISTRICT**

1801 10TH ST.
REEDLEY, CA

Project Name:

**SITE
IMPROVEMENTS**

Project Address:

**GRANT MIDDLE
SCHOOL**

360 N. EAST AVENUE
REEDLEY, CA 93654

**integrated
designs**
by SOMAM, Inc.

**ARCHITECTURE
ENGINEERING
INTERIOR DESIGN**

6011 N. FRESNO STREET, SUITE 130
FRESNO CALIFORNIA 93710
P:(559) 436-0881 F:(559) 436-0887
E: design@somam.com
integrateddesigns.com

Ownership of Documents:

This document, the ideas and designs incorporated herein, as an instrument of Professional Service is the property of Integrated Designs by SOMAM Inc. and is not to be used, in whole or in part for any other project without written authorization.
© COPYRIGHT 2020

Stamp:

Sheet Title:

**ELECTRICAL
SITE PLAN -
DEMOLITION**



Job No.:

5514

Sheet No.:

E1.01

Release: ADDENDUM #3 Issue Date: 07-07-22

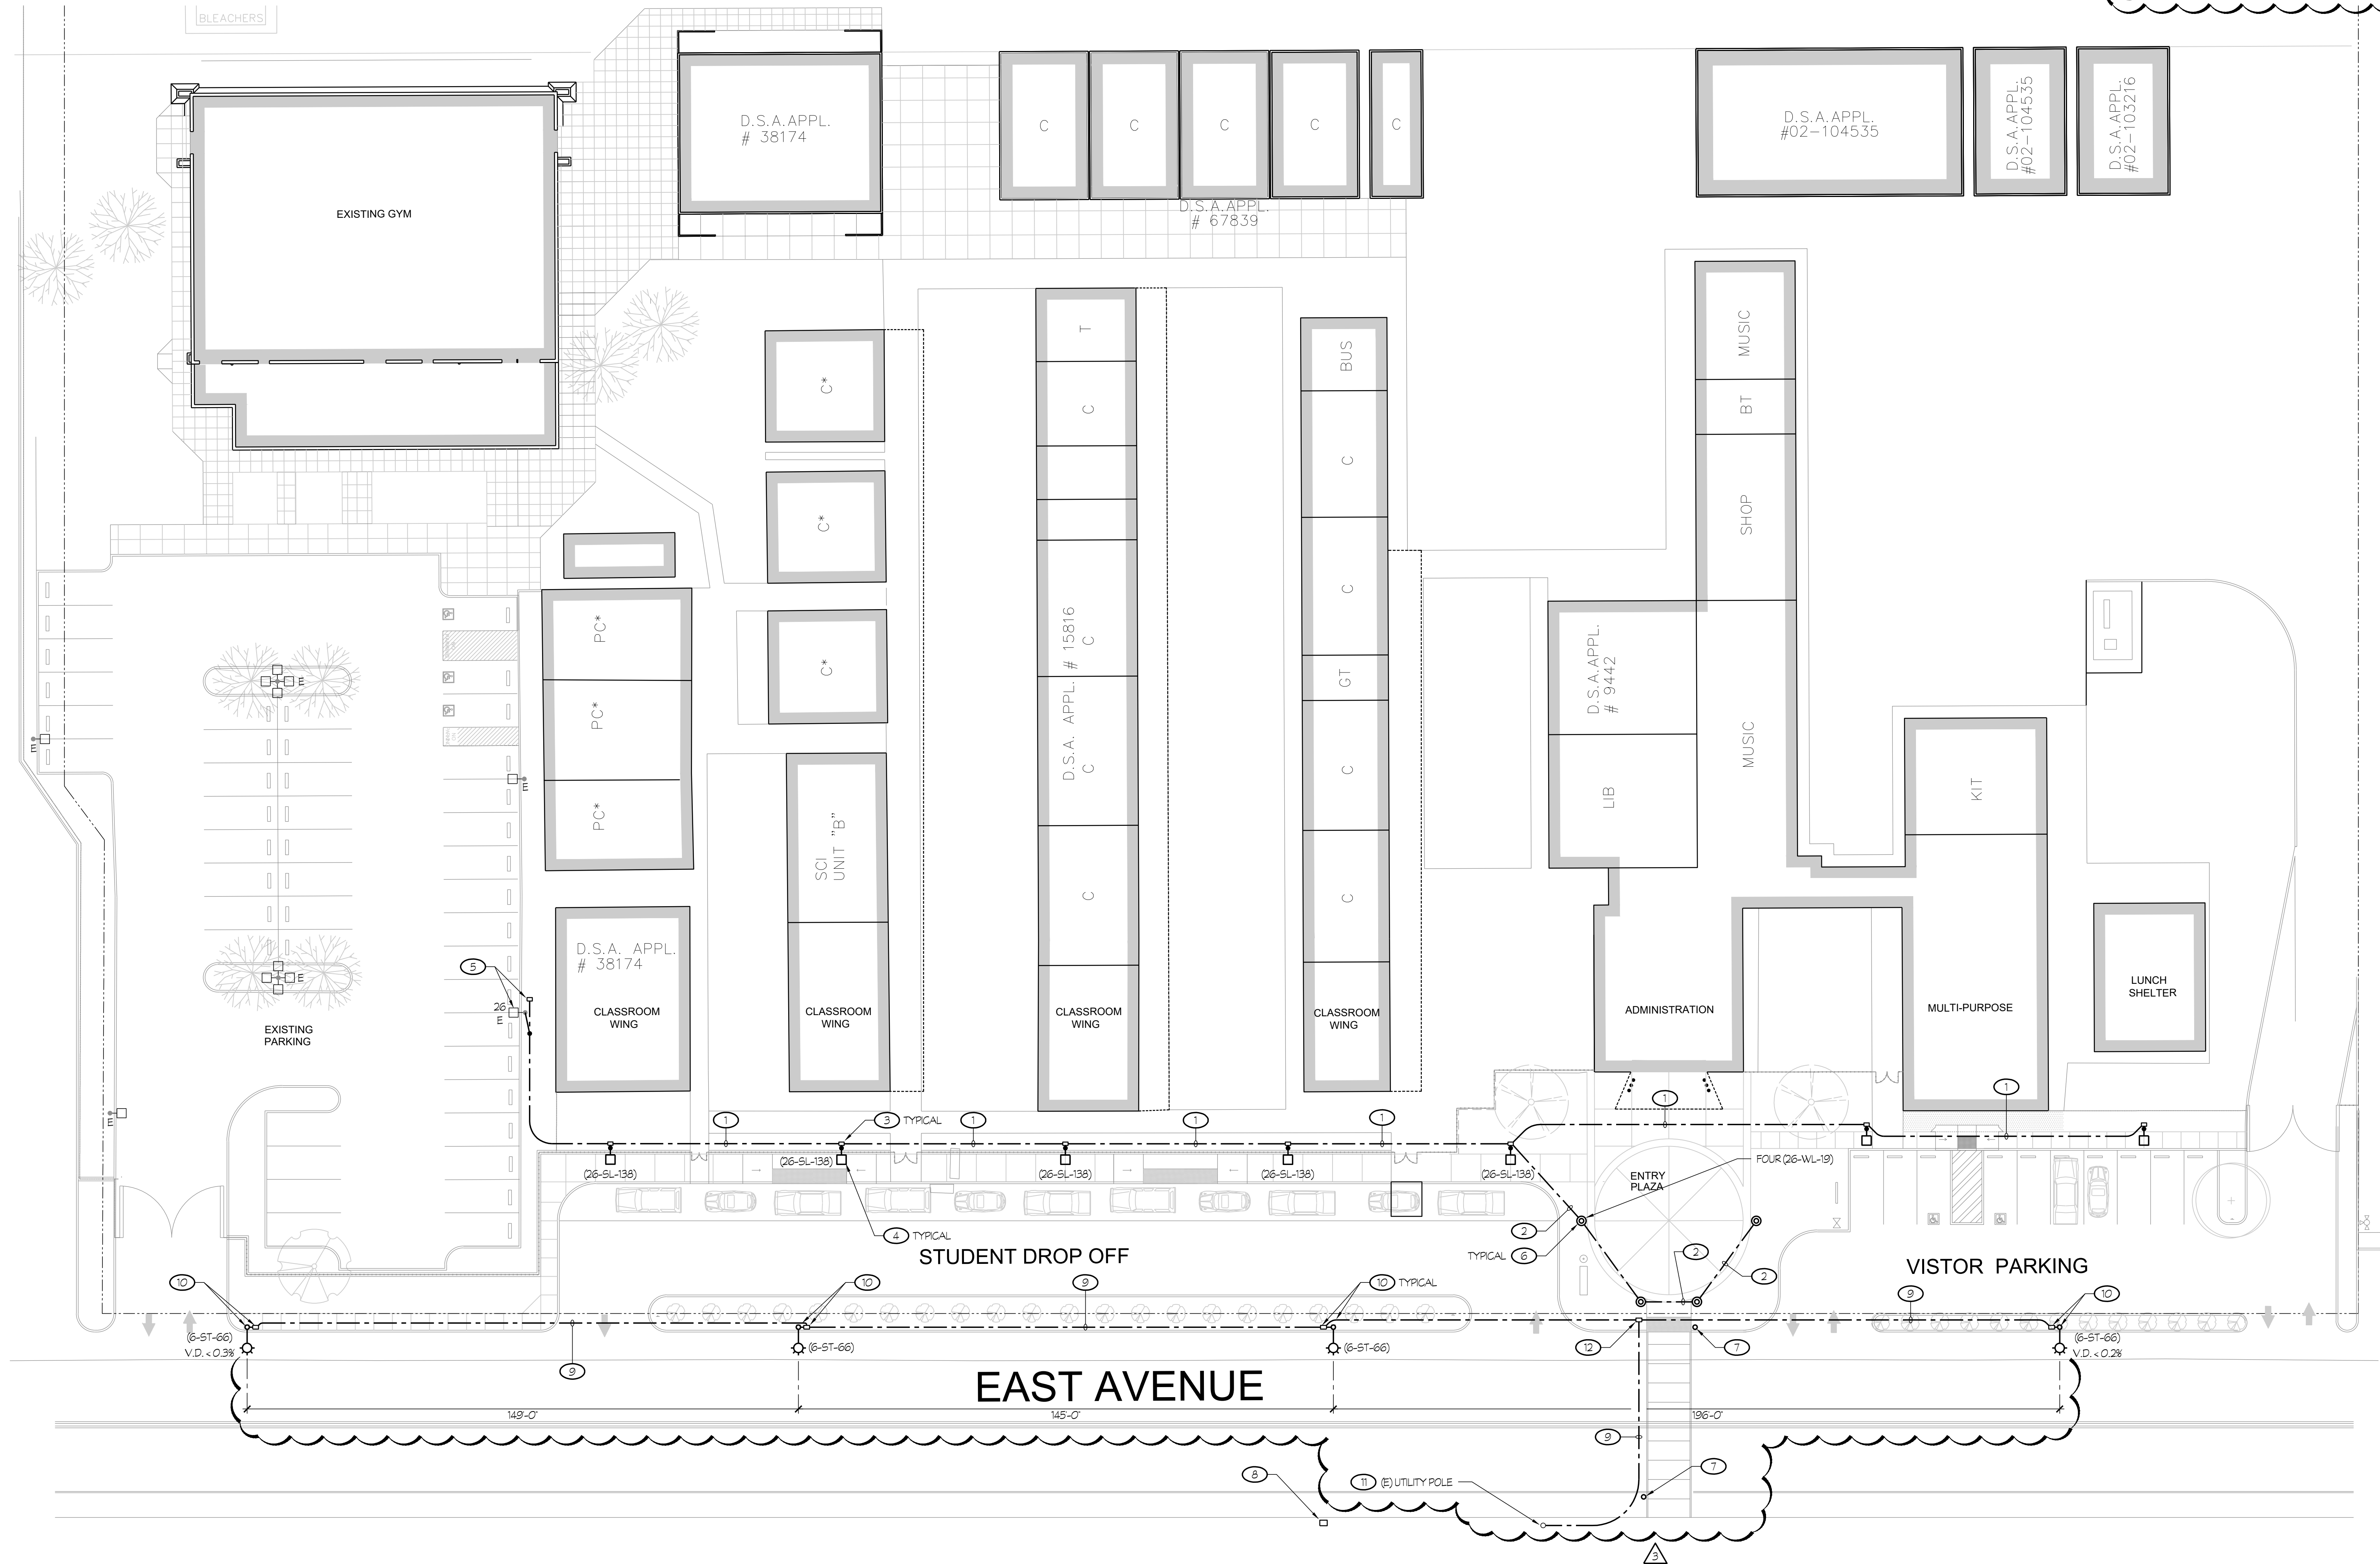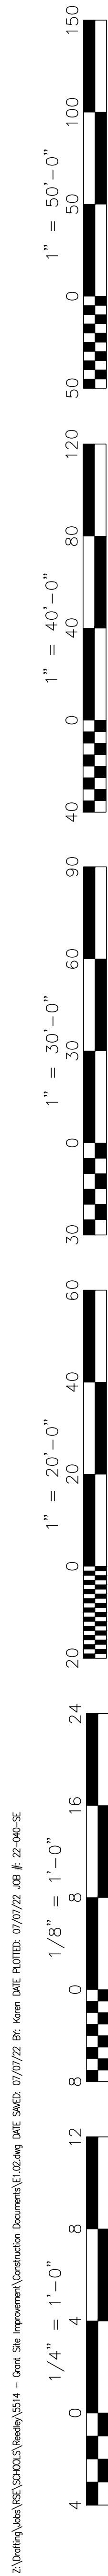

- NOTES (THIS SHEET ONLY):
- 1" C - 2 #8 + 1 #10 GND.
 - 3/4" C - 2 #12 + 1 #12 GND.
 - PROVIDE INGROUND PULL BOX FOR ROUTING OF LIGHT CIRCUITS PER DETAIL #5/E.O.01.
 - REFER TO DETAIL #1/E.O.01 FOR MOUNTING REQUIREMENTS. TYPICAL FOR TYPE 'SL' FIXTURES.
 - INTERCEPT EXISTING LIGHT CIRCUIT WITH PULL BOX AND EXTEND CIRCUIT AS REQUIRED.
 - REFER TO DETAIL #3/E.O.01 FOR MOUNTING REQUIREMENTS.
 - RELOCATED PEDESTRIAN FLASHING BEACON SYSTEM. REFER TO DETAIL #6/E.O.01 FOR REQUIREMENTS. SYSTEM SHALL BE IN WORKING CONDITION PRIOR TO ACCEPTANCE.
 - EXISTING METER PEDESTAL TO BE DISCONNECTED WITH PG&E. SALVAGE METER PEDESTAL AND CHRISTY BOX TO THE GTY YARD.
 - 1 1/2" C - 2 #6 + 1 #10 GND.
 - AT EACH STREET LIGHT LOCATION, PROVIDE PULL BOX (CHRISTY N9) PER CITY STANDARD ST-67 AND INSTALL STREETLIGHT PER CITY STANDARD ST-65. REFER TO SHEET #E.O.03 FOR DETAILS. TYPICAL AT EACH STREET LIGHT LOCATION.
 - COORDINATE CONNECTION POINT WITH APPROVED UTILITY PLANS AS REQUIRED BY PG&E. CONTRACTOR IS RESPONSIBLE TO COORDINATE ENERGIZING LIGHTS WITH PG&E.
 - STREET LIGHT STANDARD PULL BOX #ST-67, ON SHEET #E.O.03.

Owner:

**KINGS CANYON
SCHOOL DISTRICT**

1801 10TH ST.
REEDLEY, CA

Project Name:

**SITE
IMPROVEMENTS**

Project Address:

**GRANT MIDDLE
SCHOOL**

360 N. EAST AVENUE
REEDLEY, CA 93654

**integrated
designs**
by SOMAM, Inc.

**ARCHITECTURE
ENGINEERING
INTERIOR DESIGN**

6011 N. FRESNO STREET, SUITE 130
FRESNO CALIFORNIA 93710
P:(559) 436-0881 F:(559) 436-0887
E: design@somam.com
integrateddesigns.com

Ownership of Documents
This document, the ideas and designs incorporated herein, as an instrument of Professional Service to the property of Integrated Designs by SOMAM Inc. and is not to be used, in whole or in part for any other project without written authorization.
© COPYRIGHT 2020

Stamp:

Sheet Title:

**ELECTRICAL
SITE PLAN -
NEW**


Job No.:

5514

Sheet No.:

E1.02

Release: ADDENDUM #3 Issue Date: 07-07-22

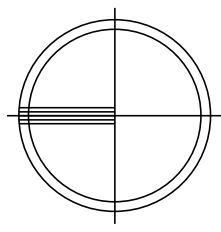

ELECTRICAL SITE PLAN - NEW
SITE IMPROVEMENTS

SCALE: 1" = 20'-0"

Rose Sing Eastham & Associates
Electrical Consultants
131 S. Dunworth - (559) 733-2671
Visalia, California 93292-6705

