ADDENDUM TO BID DOCUMENTS

Pleasanton Unitied School District	ADDENDUM 02
Achievement Partnerships Communication	Project: Mohr Elementary Campus Wide Exterior Painting (2021-22.08)
	Date: February 10, 2022

The following clarifications are provided based on questions received or changes in District requirements and must be added/considered when completing your submittal:

Acknowledgement of receipt of this <u>ADDENDUM</u> is required in the bid form. Please clearly note the addendum date and number.

CLARIFICATIONS:

The following changes are made to the bid documents:

- 1. Refer to the project drawings.
 - a. Replace the previously issued project drawings with the attached.
- 2. Benches
 - a. Refer to drawings page 44 "Benches and Tabletops." Paint all of the benches. There are approximately 55 of them.
- 3. Building Numbers and Room Labels
 - a. Refer to the drawings. See Notes.
- 4. Speakers
 - a. Paint the speakers per plan. See page 25 "Building C".


Attachments:

- A. Updated Project Drawings (49 pages)
- B. Mandatory Bid Walk Sign In Sheet (2 pages)

END OF ADDENDUM 02

EXTERIOR PAINTING PROJECT MOHR ELEMENTARY SCHOOL - 3300 DENNIS DR, PLEASANTON, CA 94588

PLEASANTON UNIFIED SCHOOL DISTRICT OWNER 4665 BERNAL AVE. PLEASANTON, CA 94566

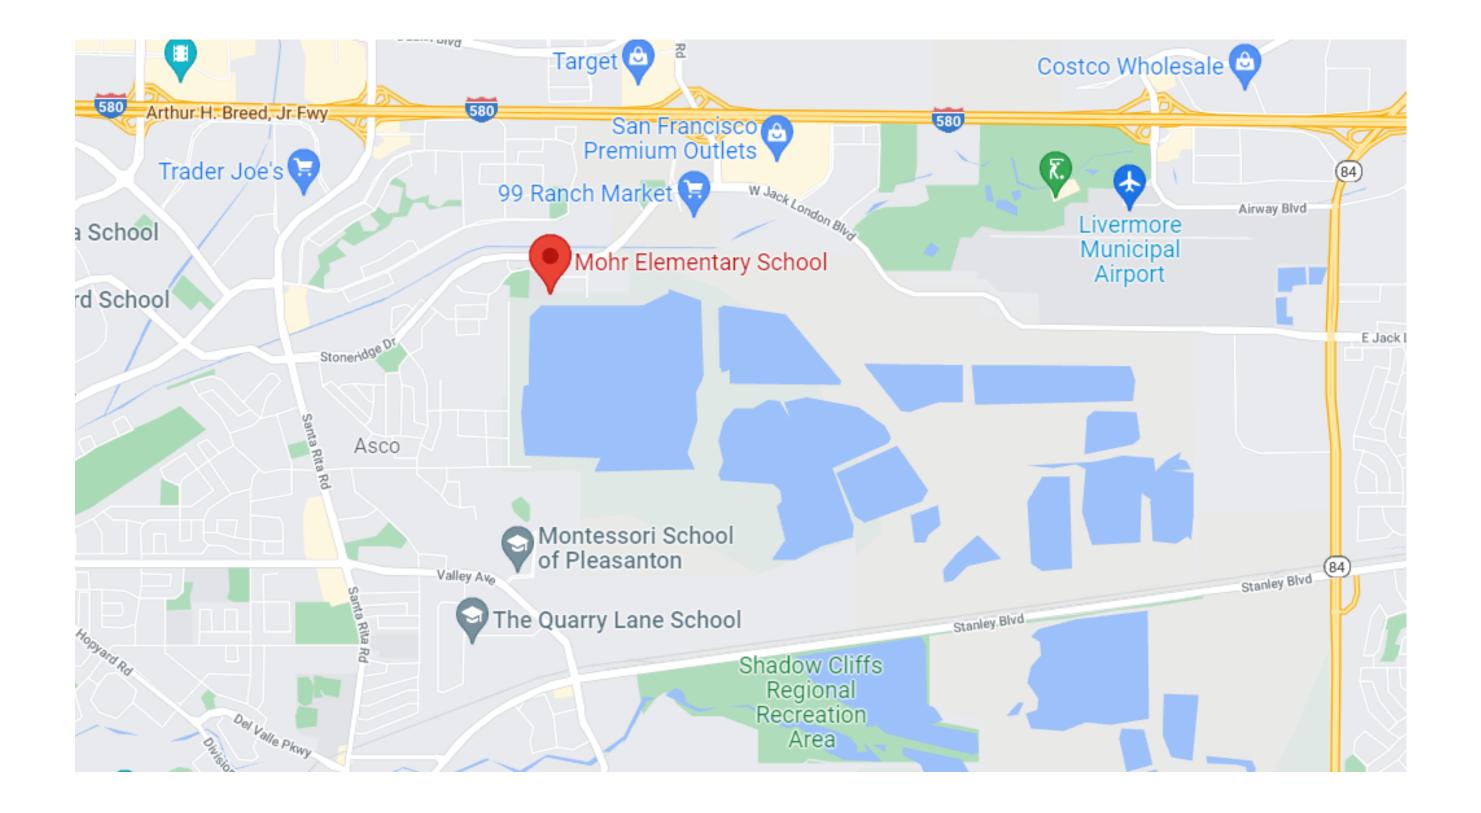

VICINITY MAP

SUMMARY SCOPE OF WORK:

CLEANING, PREPARATION, AND PAINTING THE EXTERIORS OF ALL THE BUILDINGS AT MOHR ELEMENTARY SCHOOL INCLUDING BUT NOT LIMITED TO: ROOF PANELS. METAL TRIM, STUCCO WALLS, DOORS AND DOOR FRAMES, STAIRS AND RAILINGS.

BID DATE:

FEBRUARY 17, 2022 2:00PM

ADDITIVE ALTERNATES:

N/A

DRAWING TITLE:

COVER SHEET

Note: 1.Typical - Structure of benches and tables to be painted P-1

.

3 5

· .

.

18

.

. .

× .

1.54

· · · · ·


*

.

LABELED SITE PLAN

Labels as per On-Site Signage

Mohr Elementary School Pleasanton Unified School District February 2, 2022

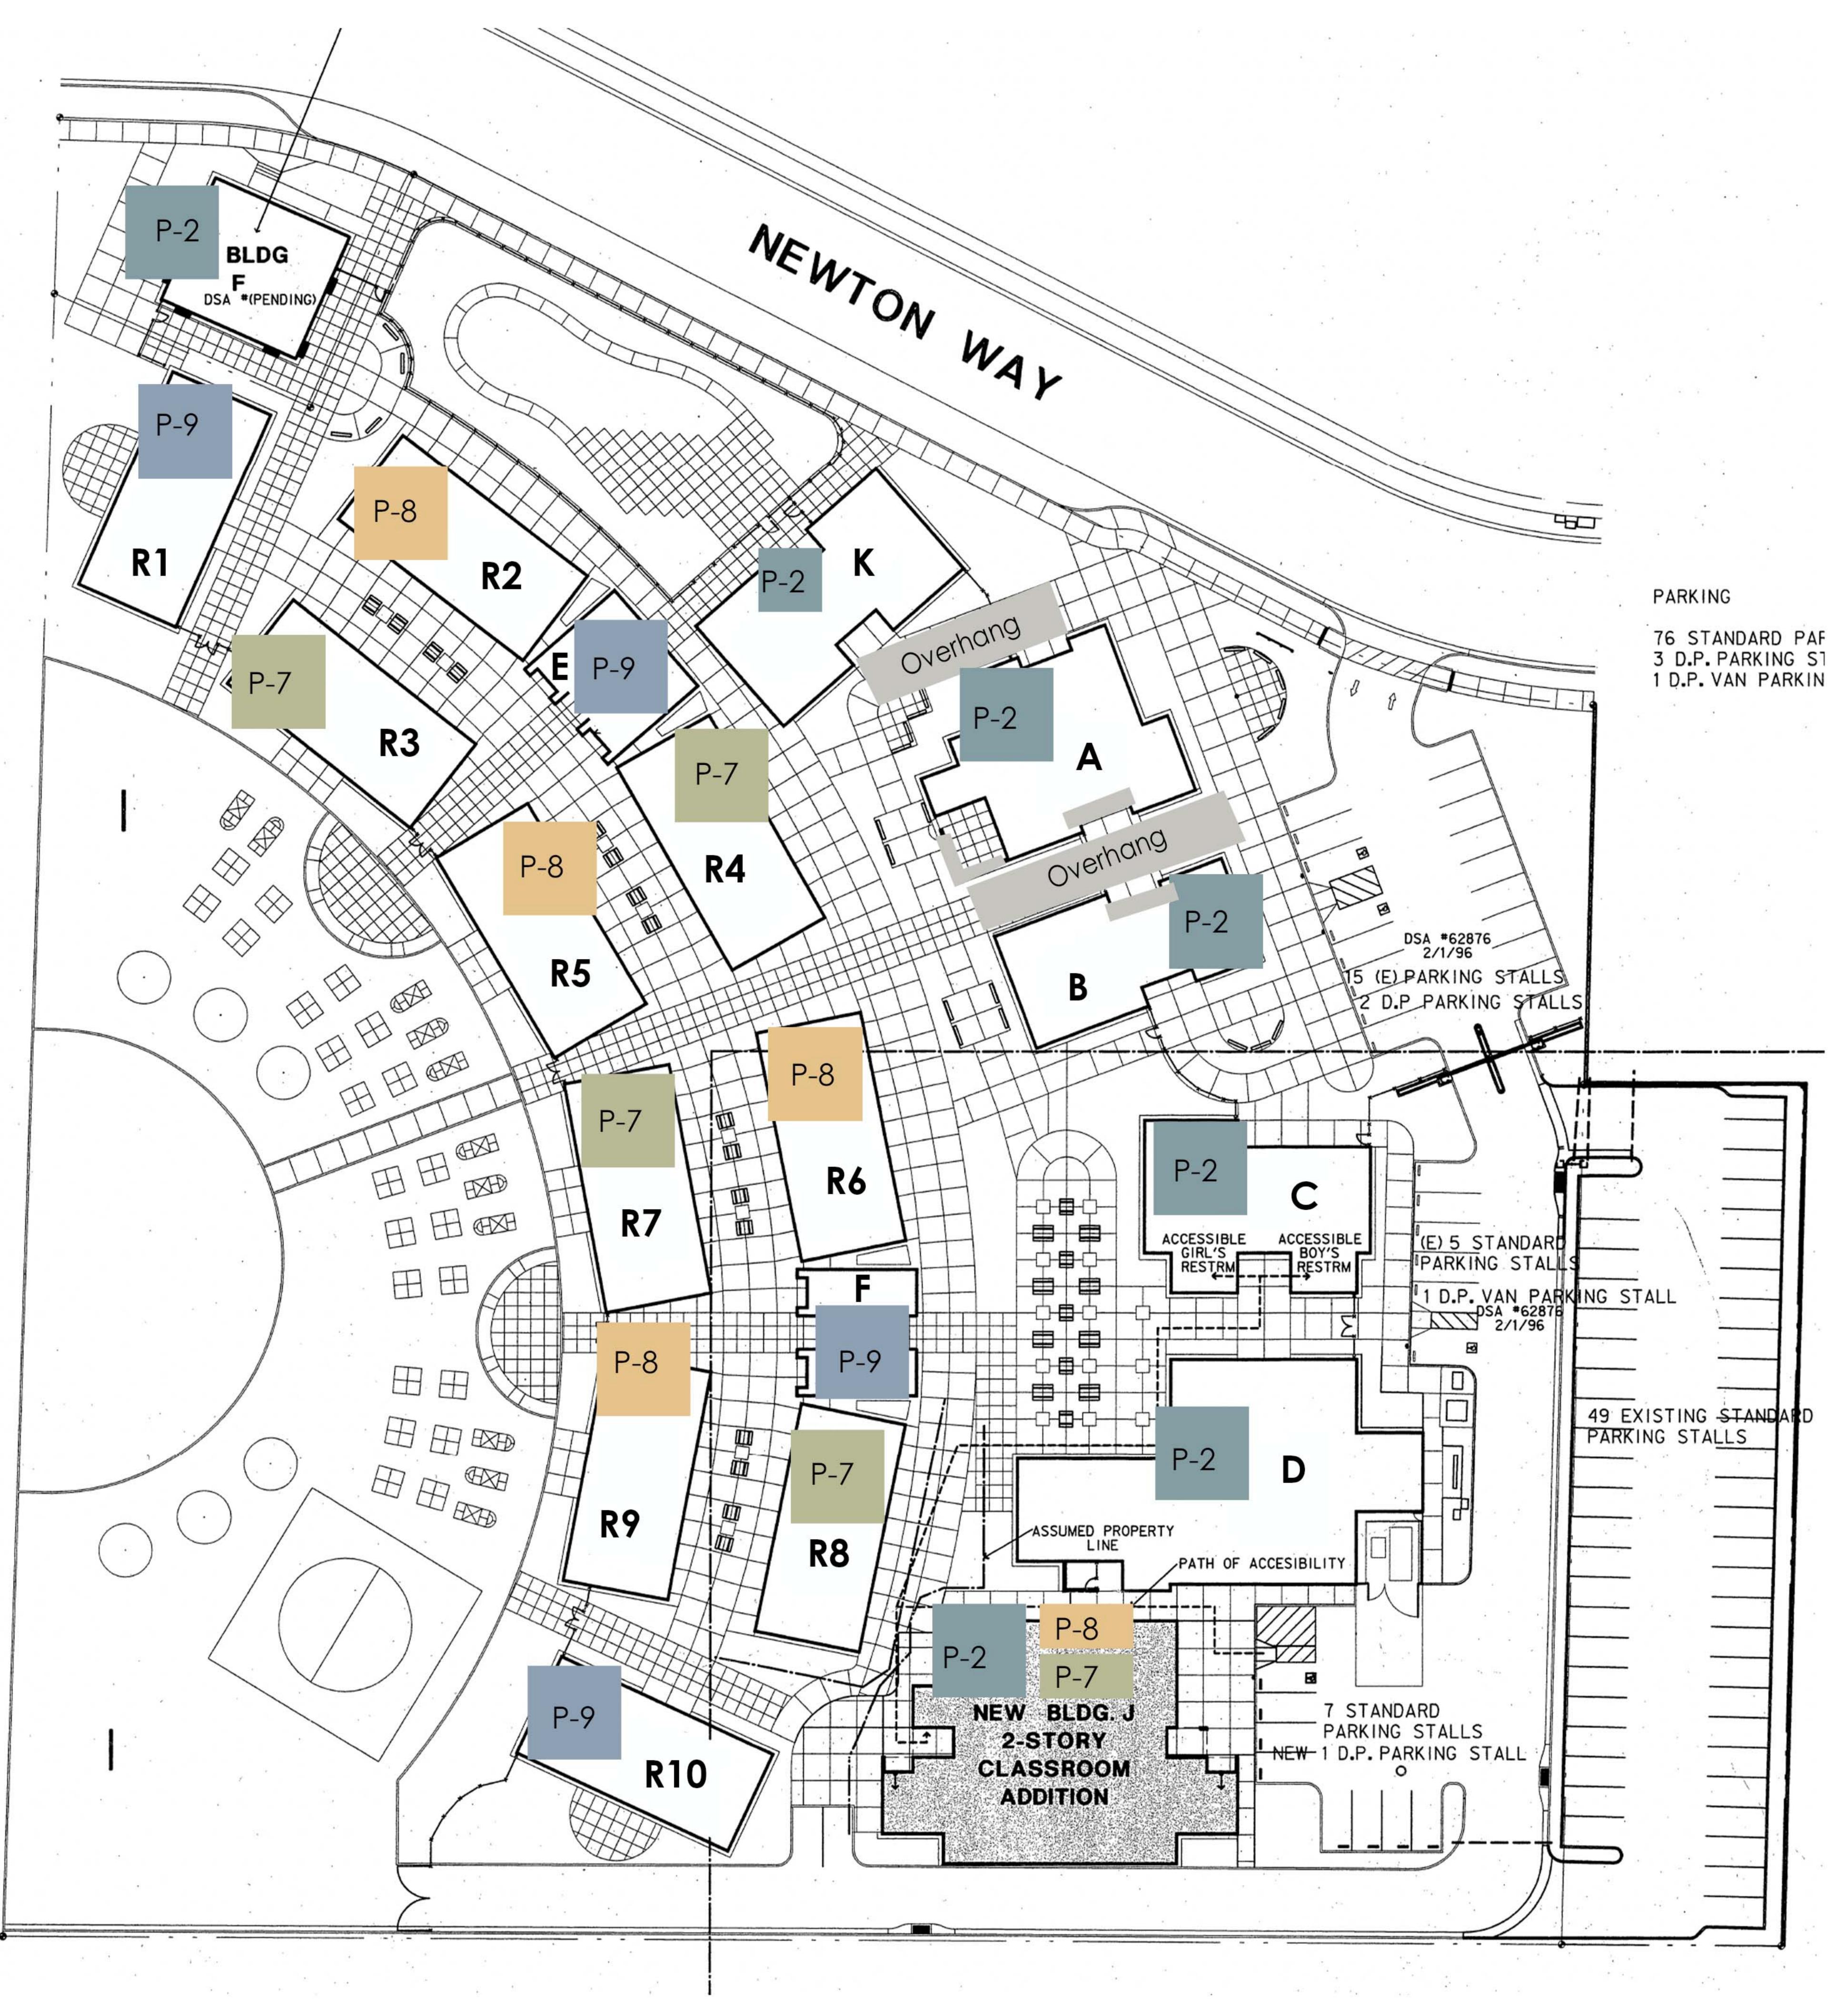



Bud's Sail



KM 4867 Soul Quenching

P-3 Kelly Moore KM 5822 San Francisco Fog



Oxford Brick

Doors



Casings, Railings

Main body, Accents



P-7 Kelly Moore KM 4776

Green Tea




Kelly Moore KM 5273 Casava Cake

P-9 Kelly Moore KM 4993

Tsunami

Perimeter Fence


Accents for R Buildings

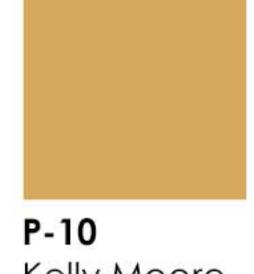


Kelly Moore KM 5281 Saffron Robe



KM 5512 Love Birds

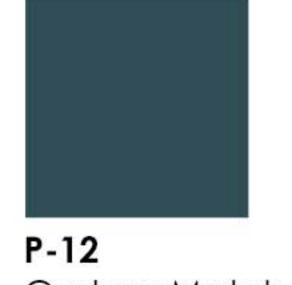


Custom Match to: Inemec 49BL **Reflection Pool**

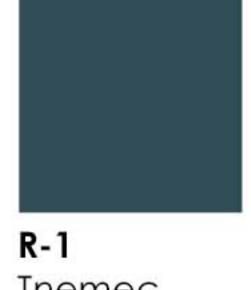

Tnemec 49BL **Reflection Pool**

Walkway Pencils

Roof

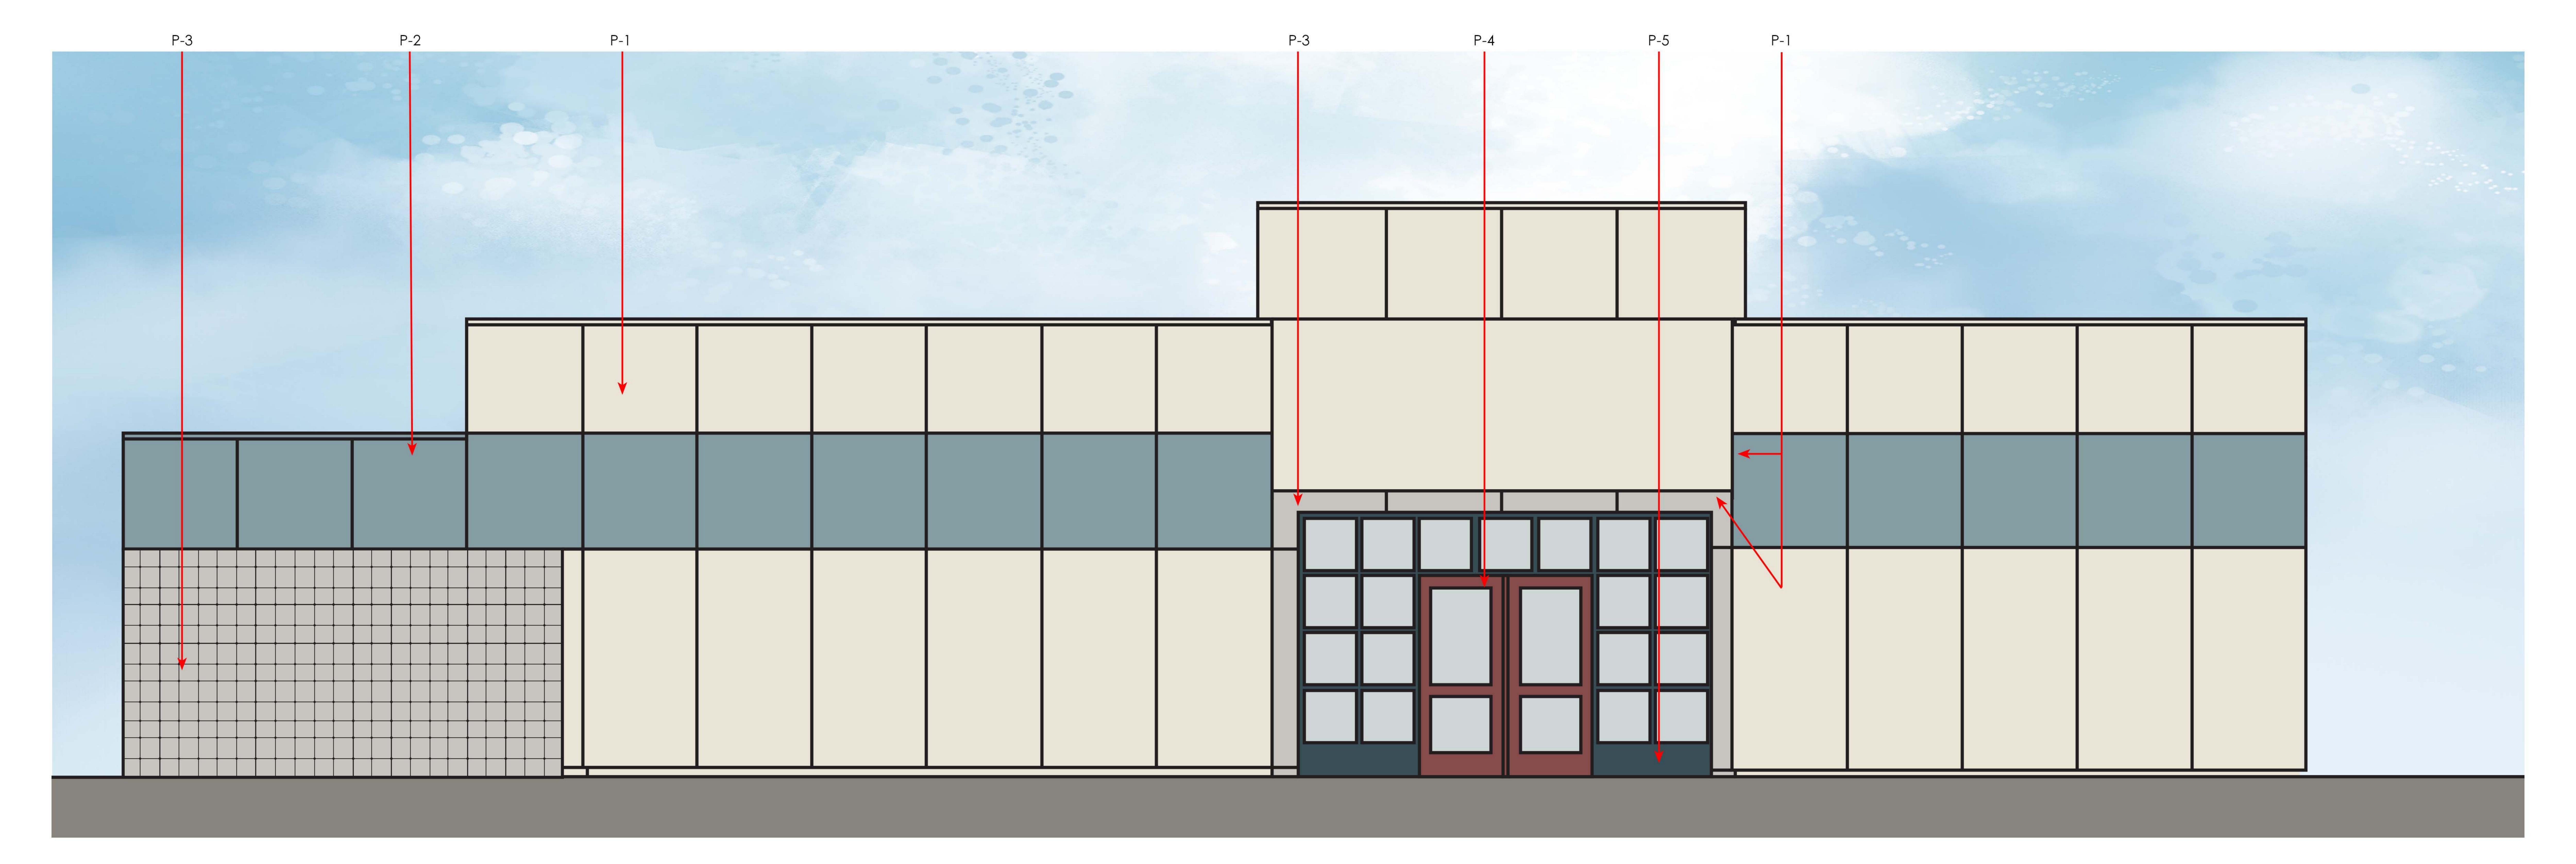

E17 Exterior Elevation - Admin Building

Mohr Elementary School Pleasanton Unified School District February 2, 2022








Kelly Moore KMW 24-1 Bud's Sail

P-2 Kelly Moore KM 4867 Soul Quenching

KM 5822 San Francisco Fog

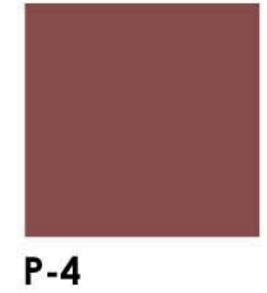

Kelly Moore HLS 4269 Oxford Brick

Doors



P-5 Kelly Moore KMA 28 Bay Isle Pointe

Casings, Railings



P-6 Kelly Moore KMA 87 Stiletto







KM 4776 Green Tea

P-8 Kelly Moore KM 5273 Casava Cake Tsunami

P-9 Kelly Moore KM 4993

Accents for R Buildings

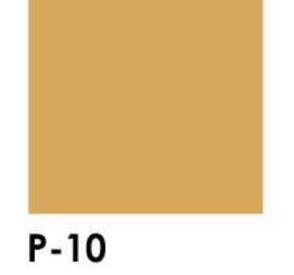

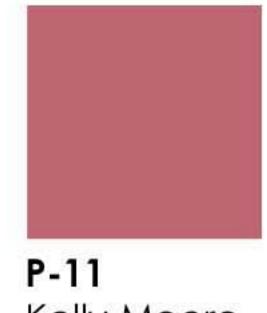

Kelly Moore KM 5281 Saffron Robe

Kelly Moore KM 5512 Love Birds



P-12 Custom Match to: Inemec 49BL Reflection Pool



R-1 Inemec 49BL **Reflection Pool** Note:

- and exteriors typical.

Walkway Pencils

Roof

1. On all exterior doors and frames, paint interiors and exteriors - typical 2. On all storefront doors and windows, paint interiors and exteriors - typical 3. At building A - Paint all 3 sets of storefront doors and windows, paint interiors

COlourstudio

375 ALABAMA ST. STE 229 SAN FRANCISCO, CA 94110



N17 Exterior Elevation - Admin Building

Mohr Elementary School Pleasanton Unified School District February 2, 2022





P-3 Kelly Moore

Bud's Sail

Kelly Moore KM 4867 Soul Quenching

KM 5822 San Francisco Fog



P-4 Kelly Moore HLS 4269 Oxford Brick

Doors



Kelly Moore KMA 28 Bay Isle Pointe

Casings, Railings



P-6 Kelly Moore KMA 87 Stiletto






Kelly Moore KM 4776 Green Tea

P-8 Kelly Moore KM 5273 Casava Cake Tsunami

P-9 Kelly Moore KM 4993

Accents for R Buildings

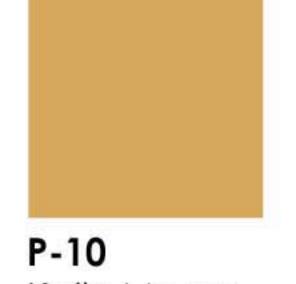



Kelly Moore KM 5281 Saffron Robe

Kelly Moore KM 5512 Love Birds



P-12 Custom Match to: Tnemec 49BL Reflection Pool




R-1 Inemec 49BL **Reflection Pool** Note:

- and exteriors typical.

 On all exterior doors and frames, paint interiors and exteriors - typical 2. On all storefront doors and windows, paint interiors and exteriors - typical 3. At building A - Paint all 3 sets of storefront doors and windows, paint interiors



SAN FRANCISCO, CA 94110

 


A10 Exterior Elevation - Multi-purpose Building

Mohr Elementary School Pleasanton Unified School District February 2, 2022



Bud's Sail

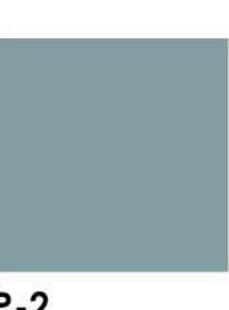

P-2 Kelly Moore

P-3 Kelly Moore KM 4867 KM 5822 Soul Quenching San Francisco Fog



Kelly Moore HLS 4269 Oxford Brick

Doors

P-4





P-5 Kelly Moore KMA 28 Bay Isle Pointe

Casings, Railings



P-6 Kelly Moore KMA 87 Stiletto

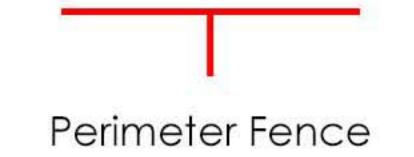

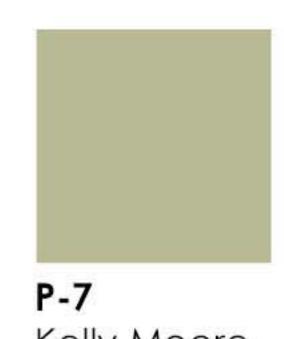








Kelly Moore KM 4776 Green Tea

Kelly Moore KM 5273 KM 4993 Casava Cake Tsunami

P-9 Kelly Moore KM 4993

Accents for R Buildings

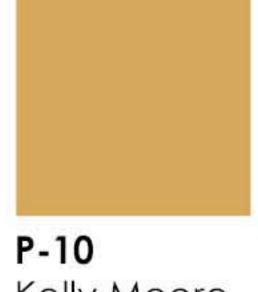




P-10P-11Kelly MooreKelly MooreKM 5281KM 5512Saffron RobeLove Birds Kelly Moore KM 5512



P-12 Custom Match to: Tnemec 49BL Reflection Pool

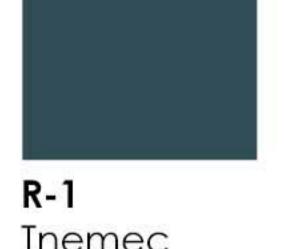

Inemec 49BL **Reflection Pool**


Note:

1. On all exterior doors and frames, paint interiors and exteriors - typical 2. On all storefront doors and windows, paint interiors and exteriors - typical

Roof




SAN FRANCISCO, CA 94110

 

N10 Exterior Elevation - Building D

Mohr Elementary School Pleasanton Unified School District February 2, 2022

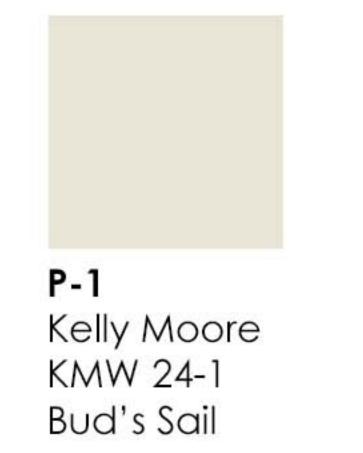





P-2 Kelly Moore

P-3 Kelly Moore KM 4867 KM 5822 Soul Quenching San Francisco Fog

Main body, Accents



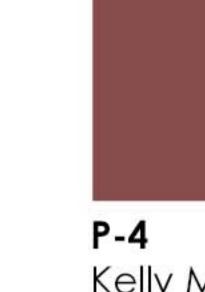

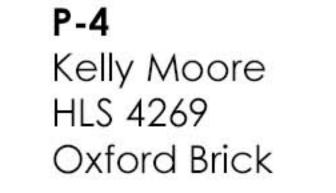

Doors




P-5 Kelly Moore KMA 28 Bay Isle Pointe

Casings, Railings



P-6 Kelly Moore KMA 87 Stiletto

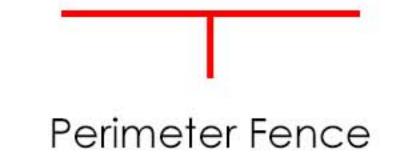


P-7



Kelly Moore KM 4776 Green Tea

P-8 Kelly Moore KM 5273 KM 4993 Casava Cake Tsunami

P-9 Kelly Moore KM 4993

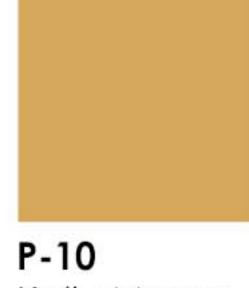



P-10P-11Kelly MooreKelly MooreKM 5281KM 5512Saffron RobeLove Birds Kelly Moore KM 5512



P-12 Custom Match to: Tnemec 49BL Reflection Pool




R-1 Inemec 49BL **Reflection Pool**

Note:

1. On all exterior doors and frames, paint interiors and exteriors - typical 2. On all storefront doors and windows, paint interiors and exteriors - typical

Roof

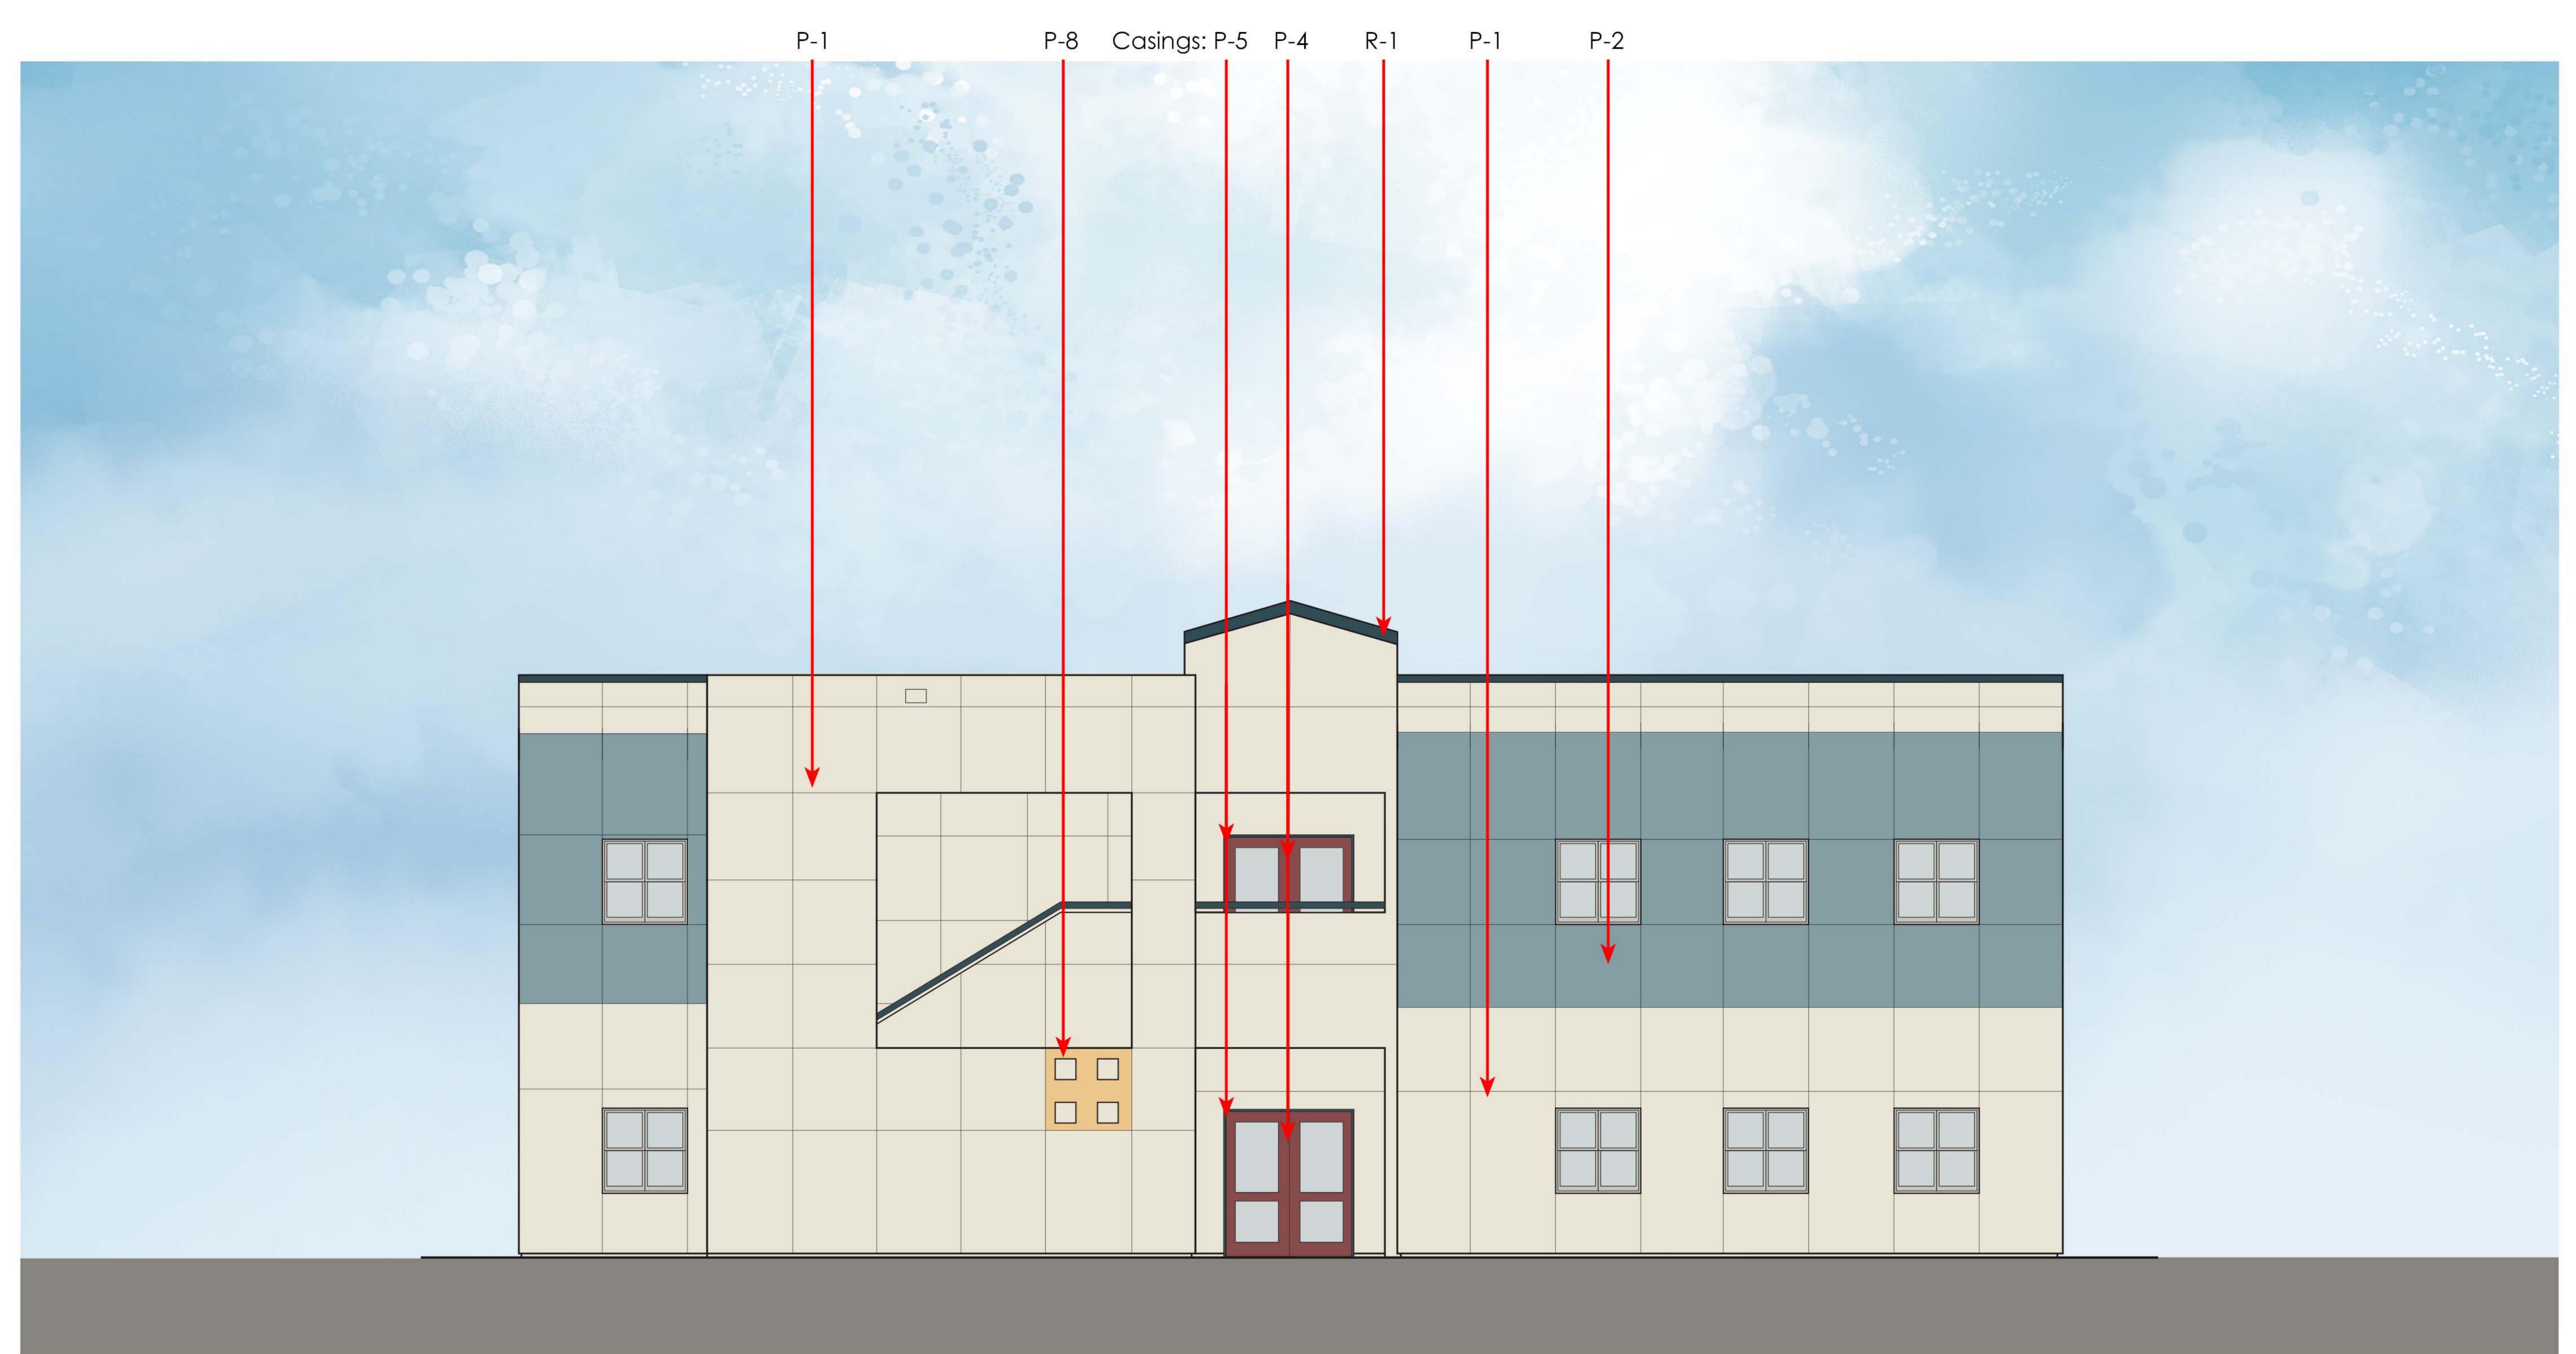

East Elevation Exterior Elevation - 2 Story Classroom

Mohr Elementary School Pleasanton Unified School District February 2, 2022



Kelly Moore KMW 24-1 Bud's Sail




Kelly Moore KM 4867



Soul Quenching San Francisco Fog



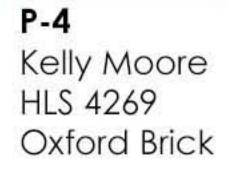



Doors

Note: 1. On all exterior doors and frames, paint interiors and exteriors - typical 2. On all storefront doors and windows, paint interiors and exteriors - typical



Bay Isle Pointe







P-6 Kelly Moore KMA 87 Stiletto

P-7


Kelly Moore KM 4776 Green Tea

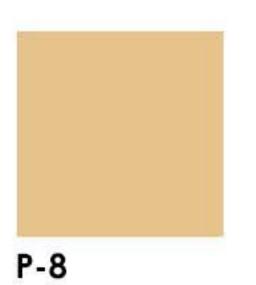

Kelly Moore KM 5273 Casava Cake Tsunami

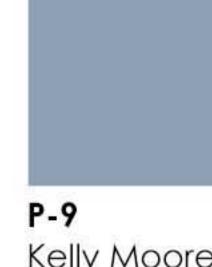

Kelly Moore KM 4993

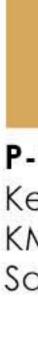

Perimeter Fence

Accents for R Buildings





KM 5512 Love Birds

Walkway Pencils




Custom Match to: Inemec 49BL **Reflection Pool**



49BL Reflection Pool

Roof

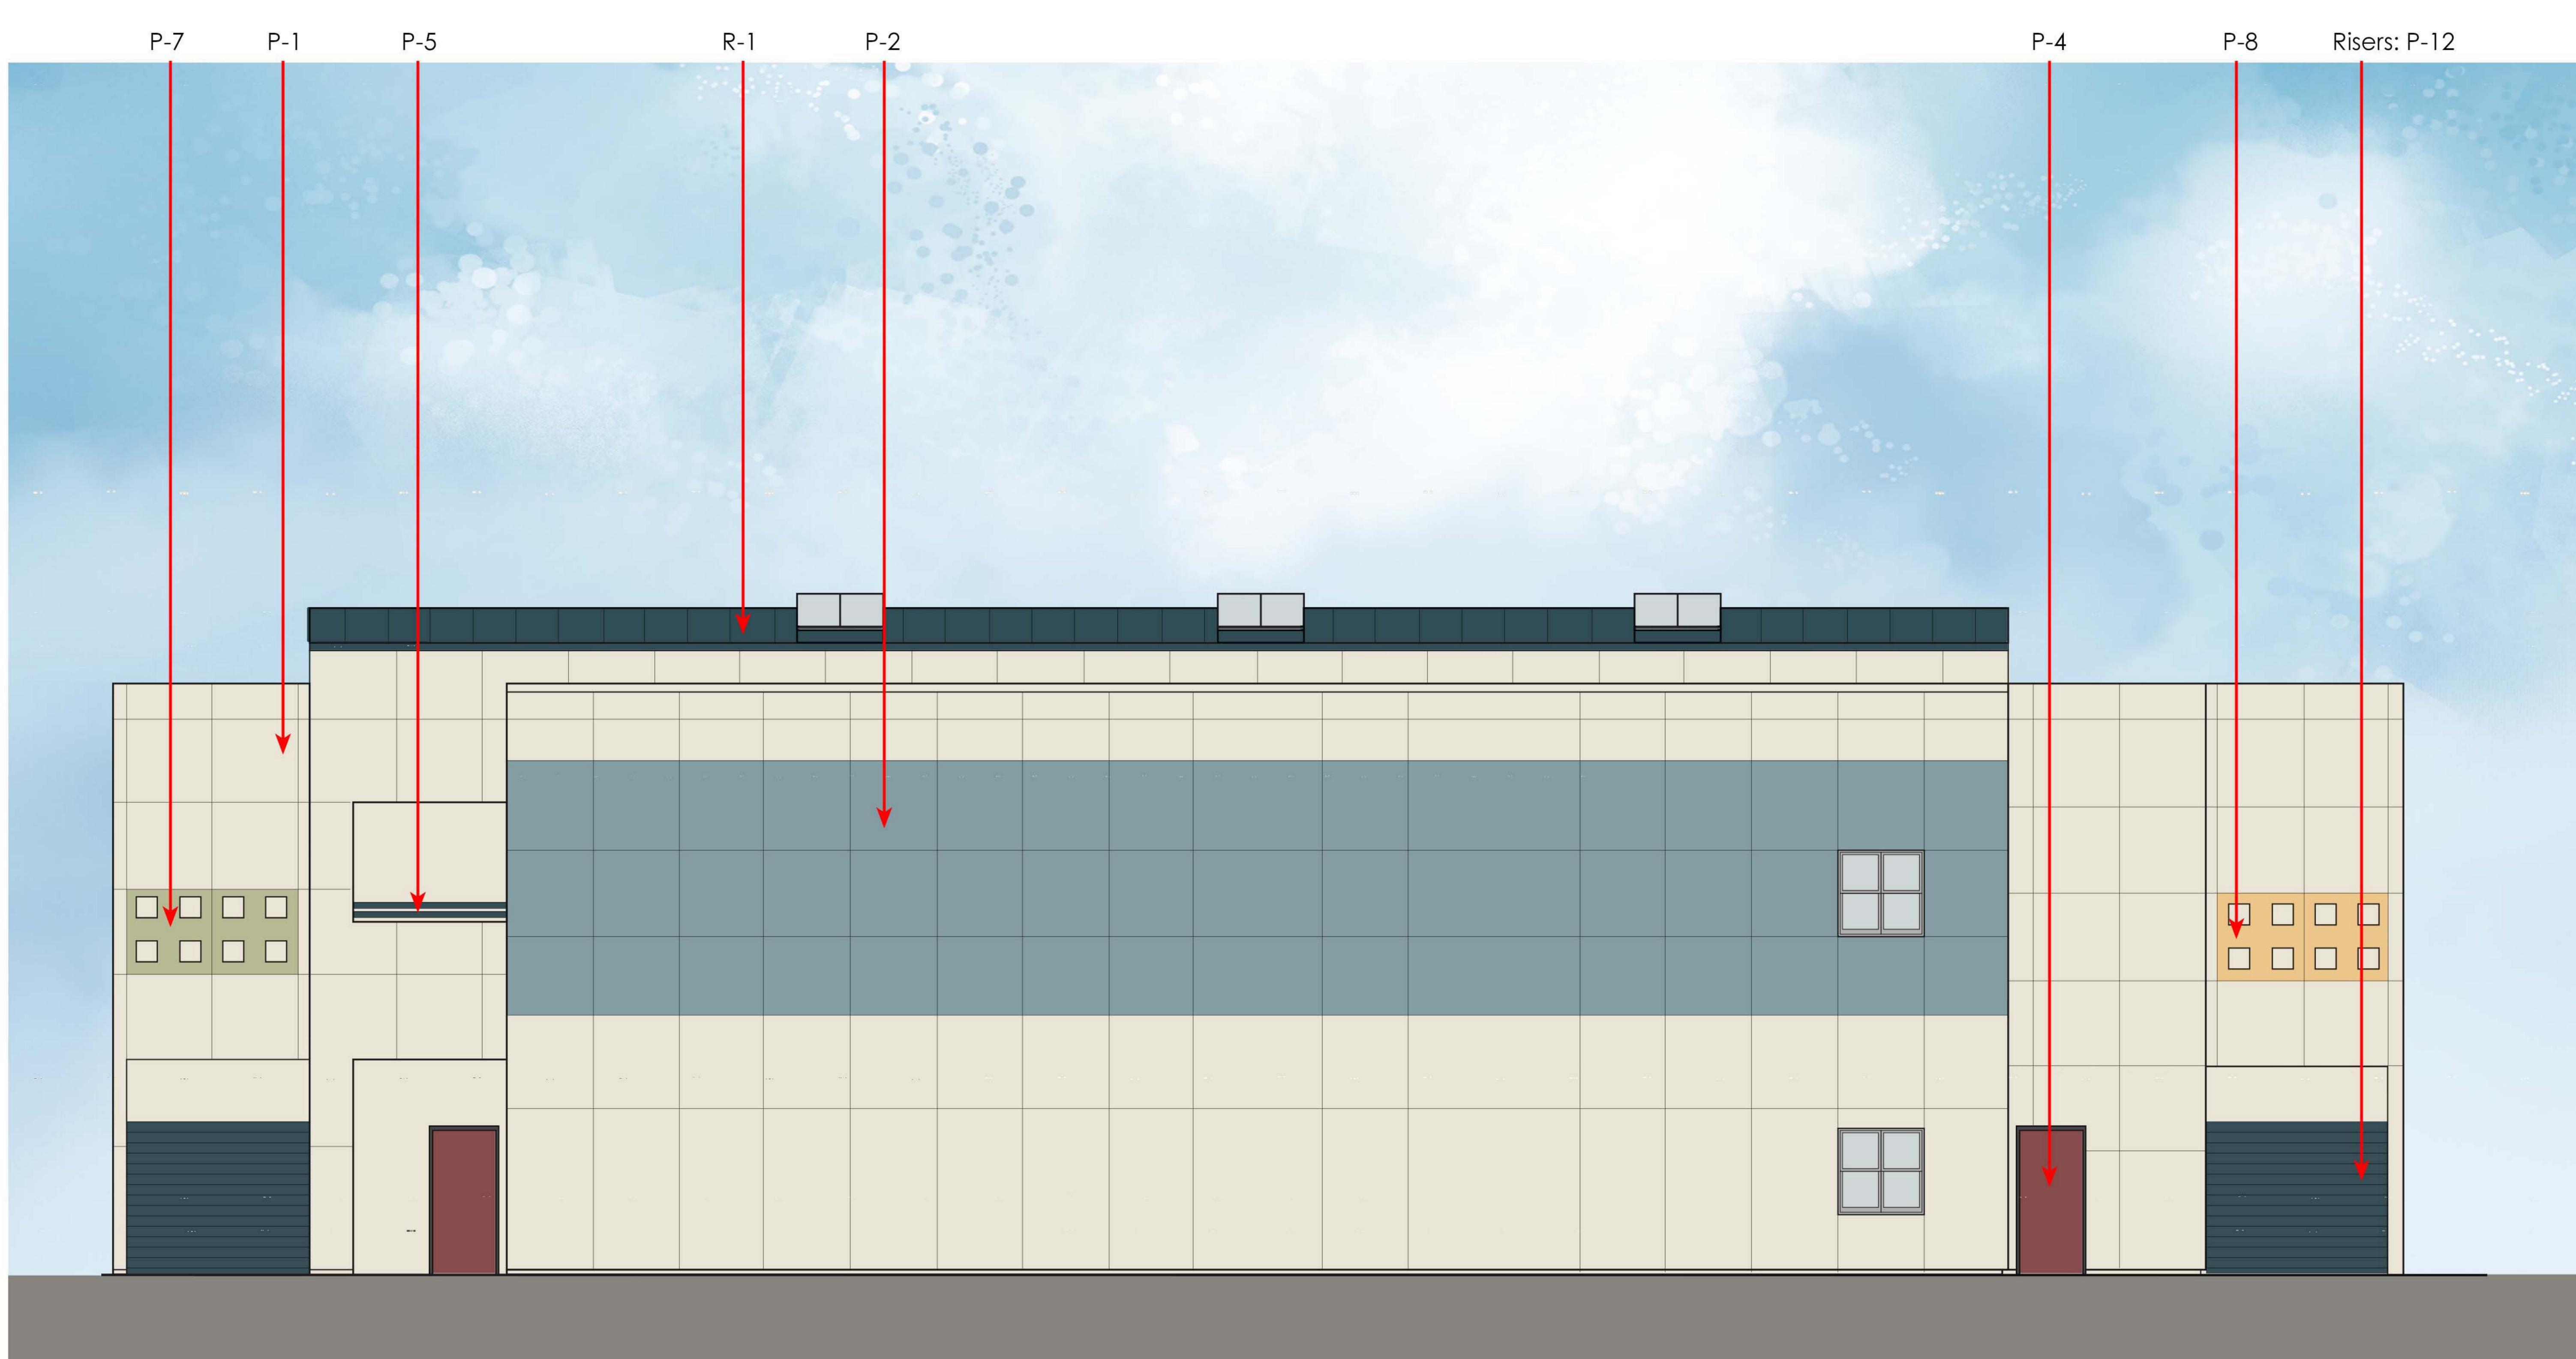


North Elevation Exterior Elevation - 2 Story Classroom

Mohr Elementary School Pleasanton Unified School District February 2, 2022



KMW 24-1

Bud's Sail

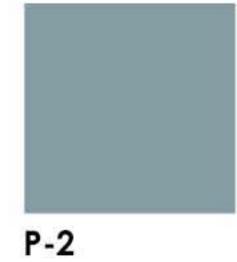

Kelly Moore KM 4867 Soul Quenching



KM 5822 San Francisco Fog



Kelly Moore HLS 4269 Oxford Brick





Bay Isle Pointe




Main body, Accents

Note:


On all exterior doors and frames, paint interiors and exteriors - typical
On all storefront doors and windows, paint interiors and exteriors - typical



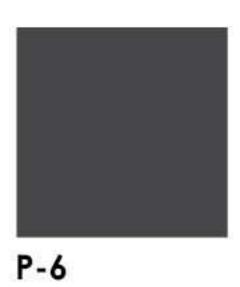

Kelly Moore KMA 87 Stiletto

Perimeter Fence

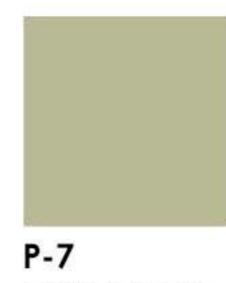

Kelly Moore KM 4776 Green Tea



P-8 Kelly Moore KM 5273 Casava Cake Tsunami



P-10

Accents for R Buildings





KM 5512 Love Birds

Walkway Pencils




Custom Match to: Tnemec 49BL **Reflection Pool**



Inemec 49BL **Reflection Pool**

Roof

Page 7

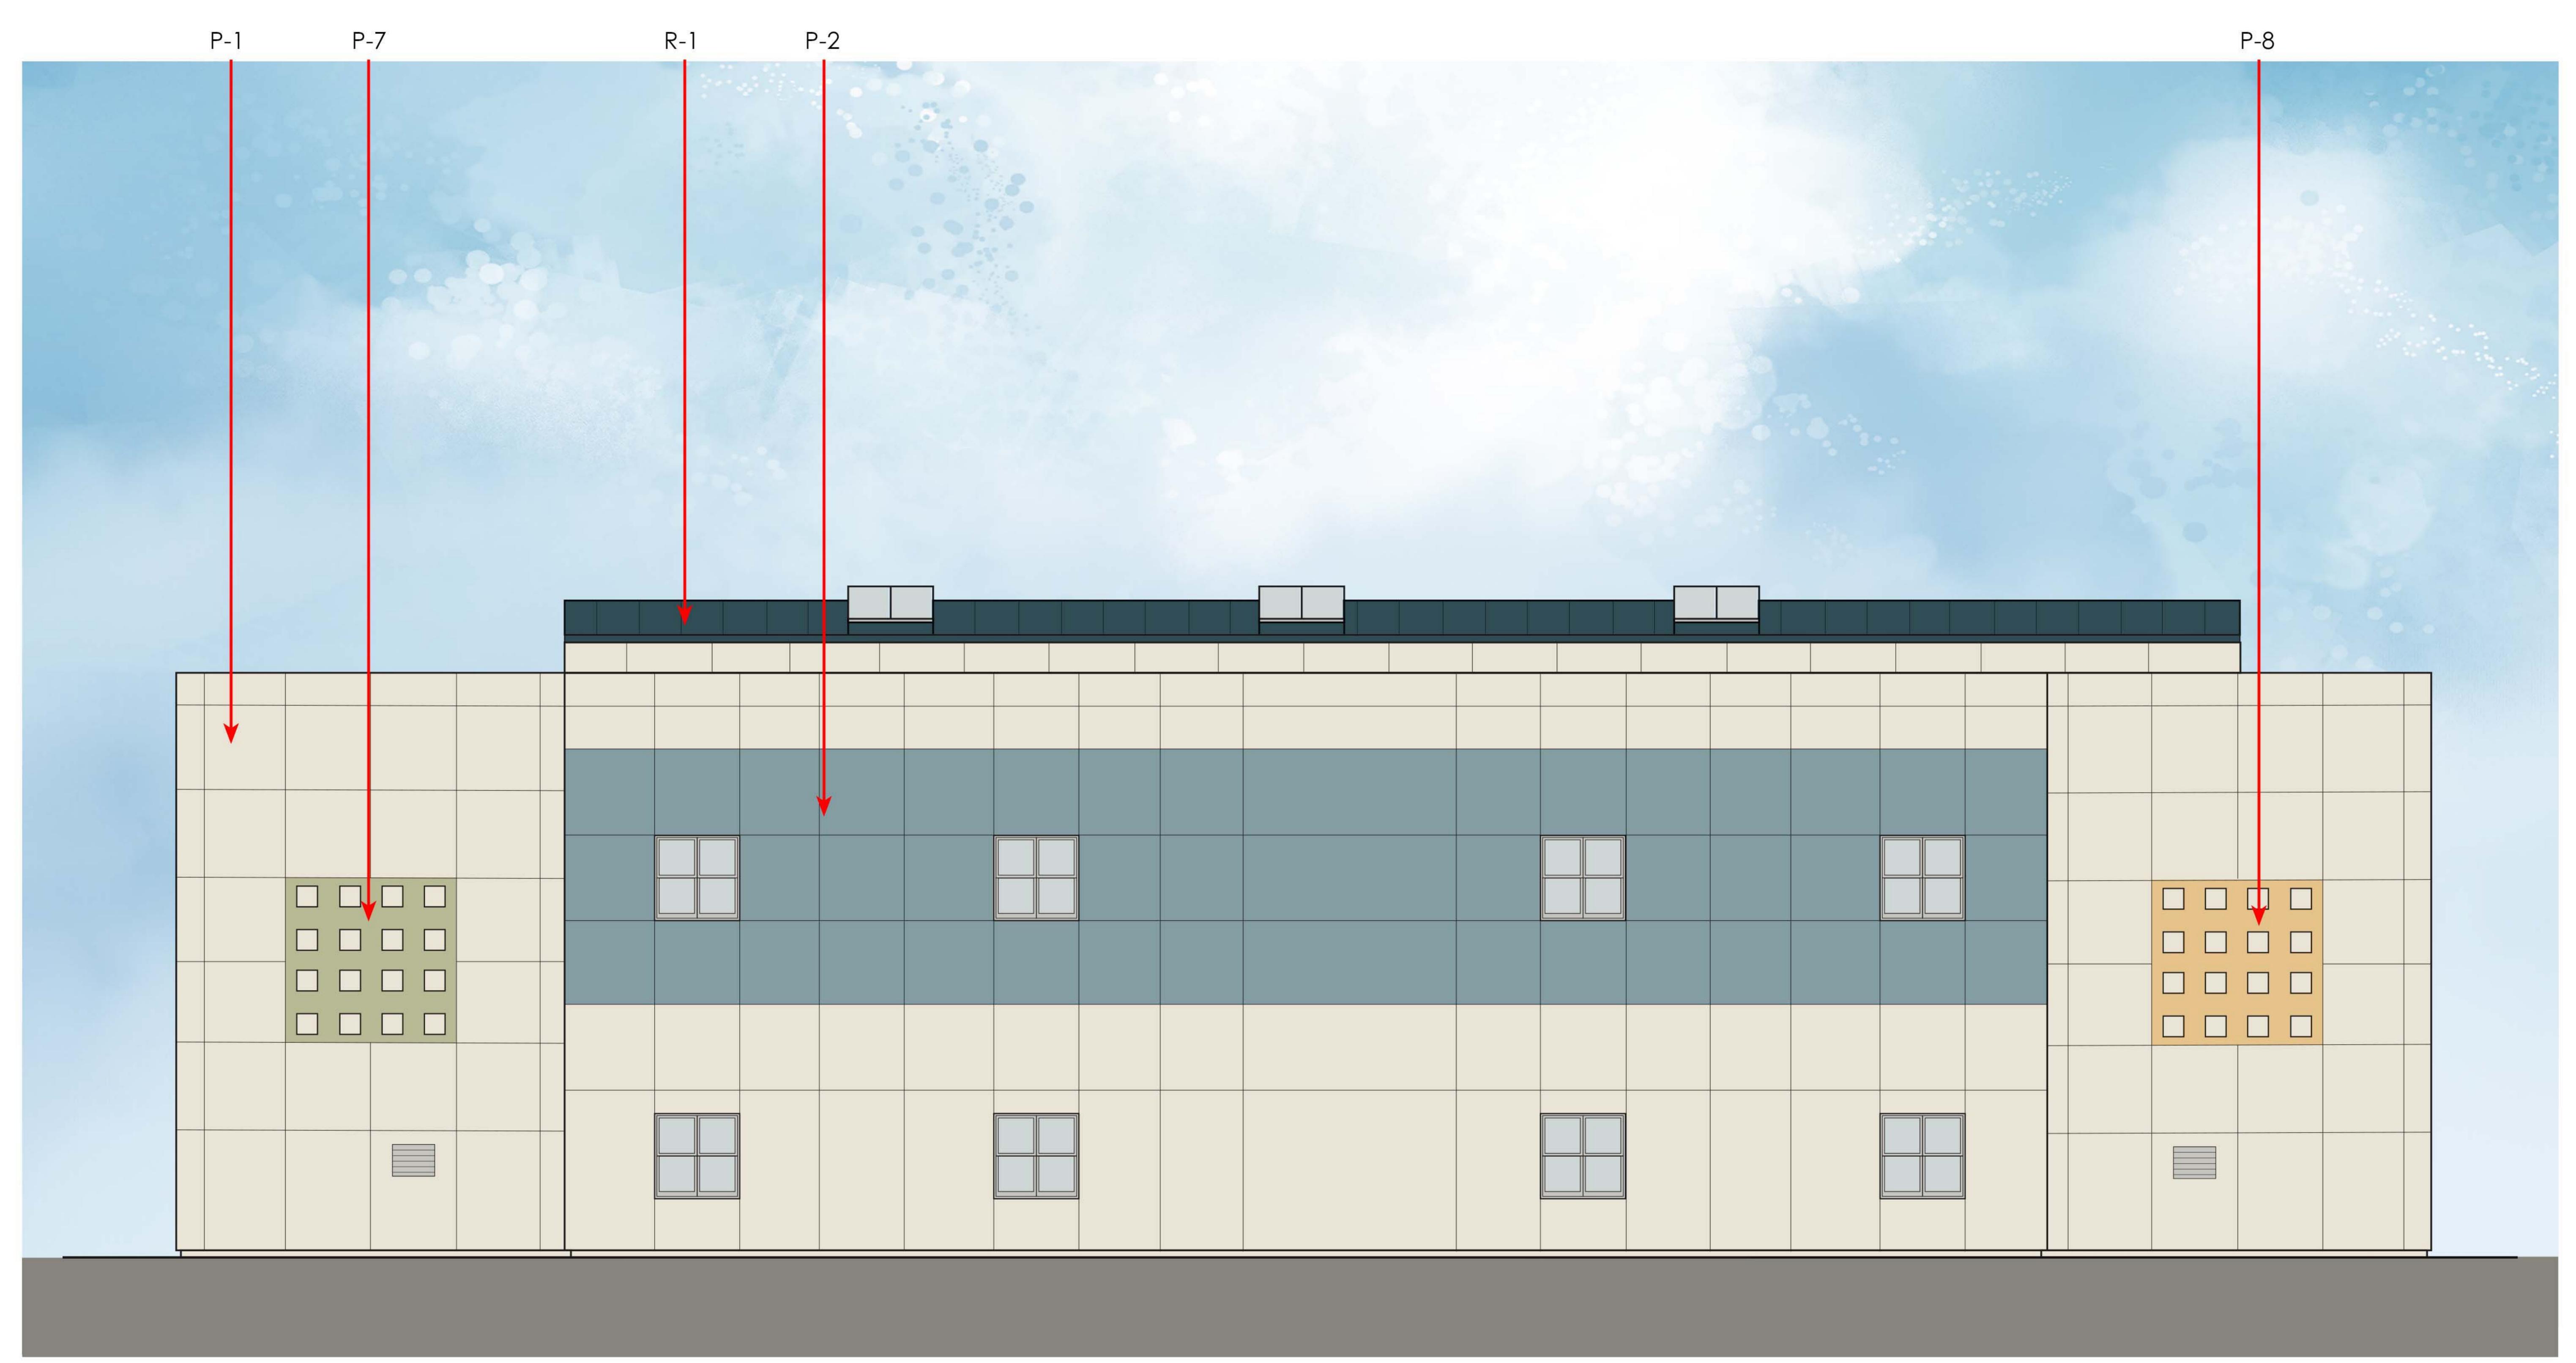

South Elevation Exterior Elevation - 2 Story Classroom

Mohr Elementary School Pleasanton Unified School District February 2, 2022




KMW 24-1

Bud's Sail



Kelly Moore KM 4867



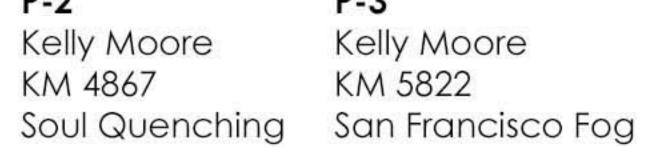



Kelly Moore HLS 4269 Oxford Brick






Main body, Accents

Doors

Note: 1. On all exterior doors and frames, paint interiors and exteriors - typical 2. On all storefront doors and windows, paint interiors and exteriors - typical





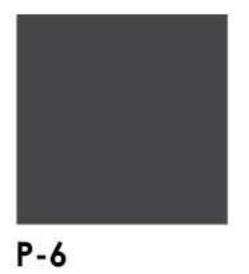

Kelly Moore KMA 87 Stiletto

Perimeter Fence



Kelly Moore KM 4776 Green Tea




P-8 Kelly Moore KM 5273 Casava Cake Tsunami



P-10

Accents for R Buildings

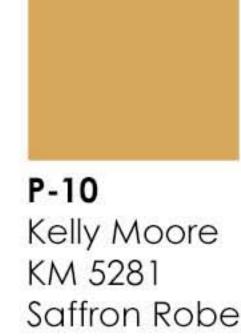



Saffron Robe



KM 5512 Love Birds

Walkway Pencils




Custom Match to: Tnemec 49BL **Reflection Pool**



Inemec 49BL **Reflection Pool**

Roof

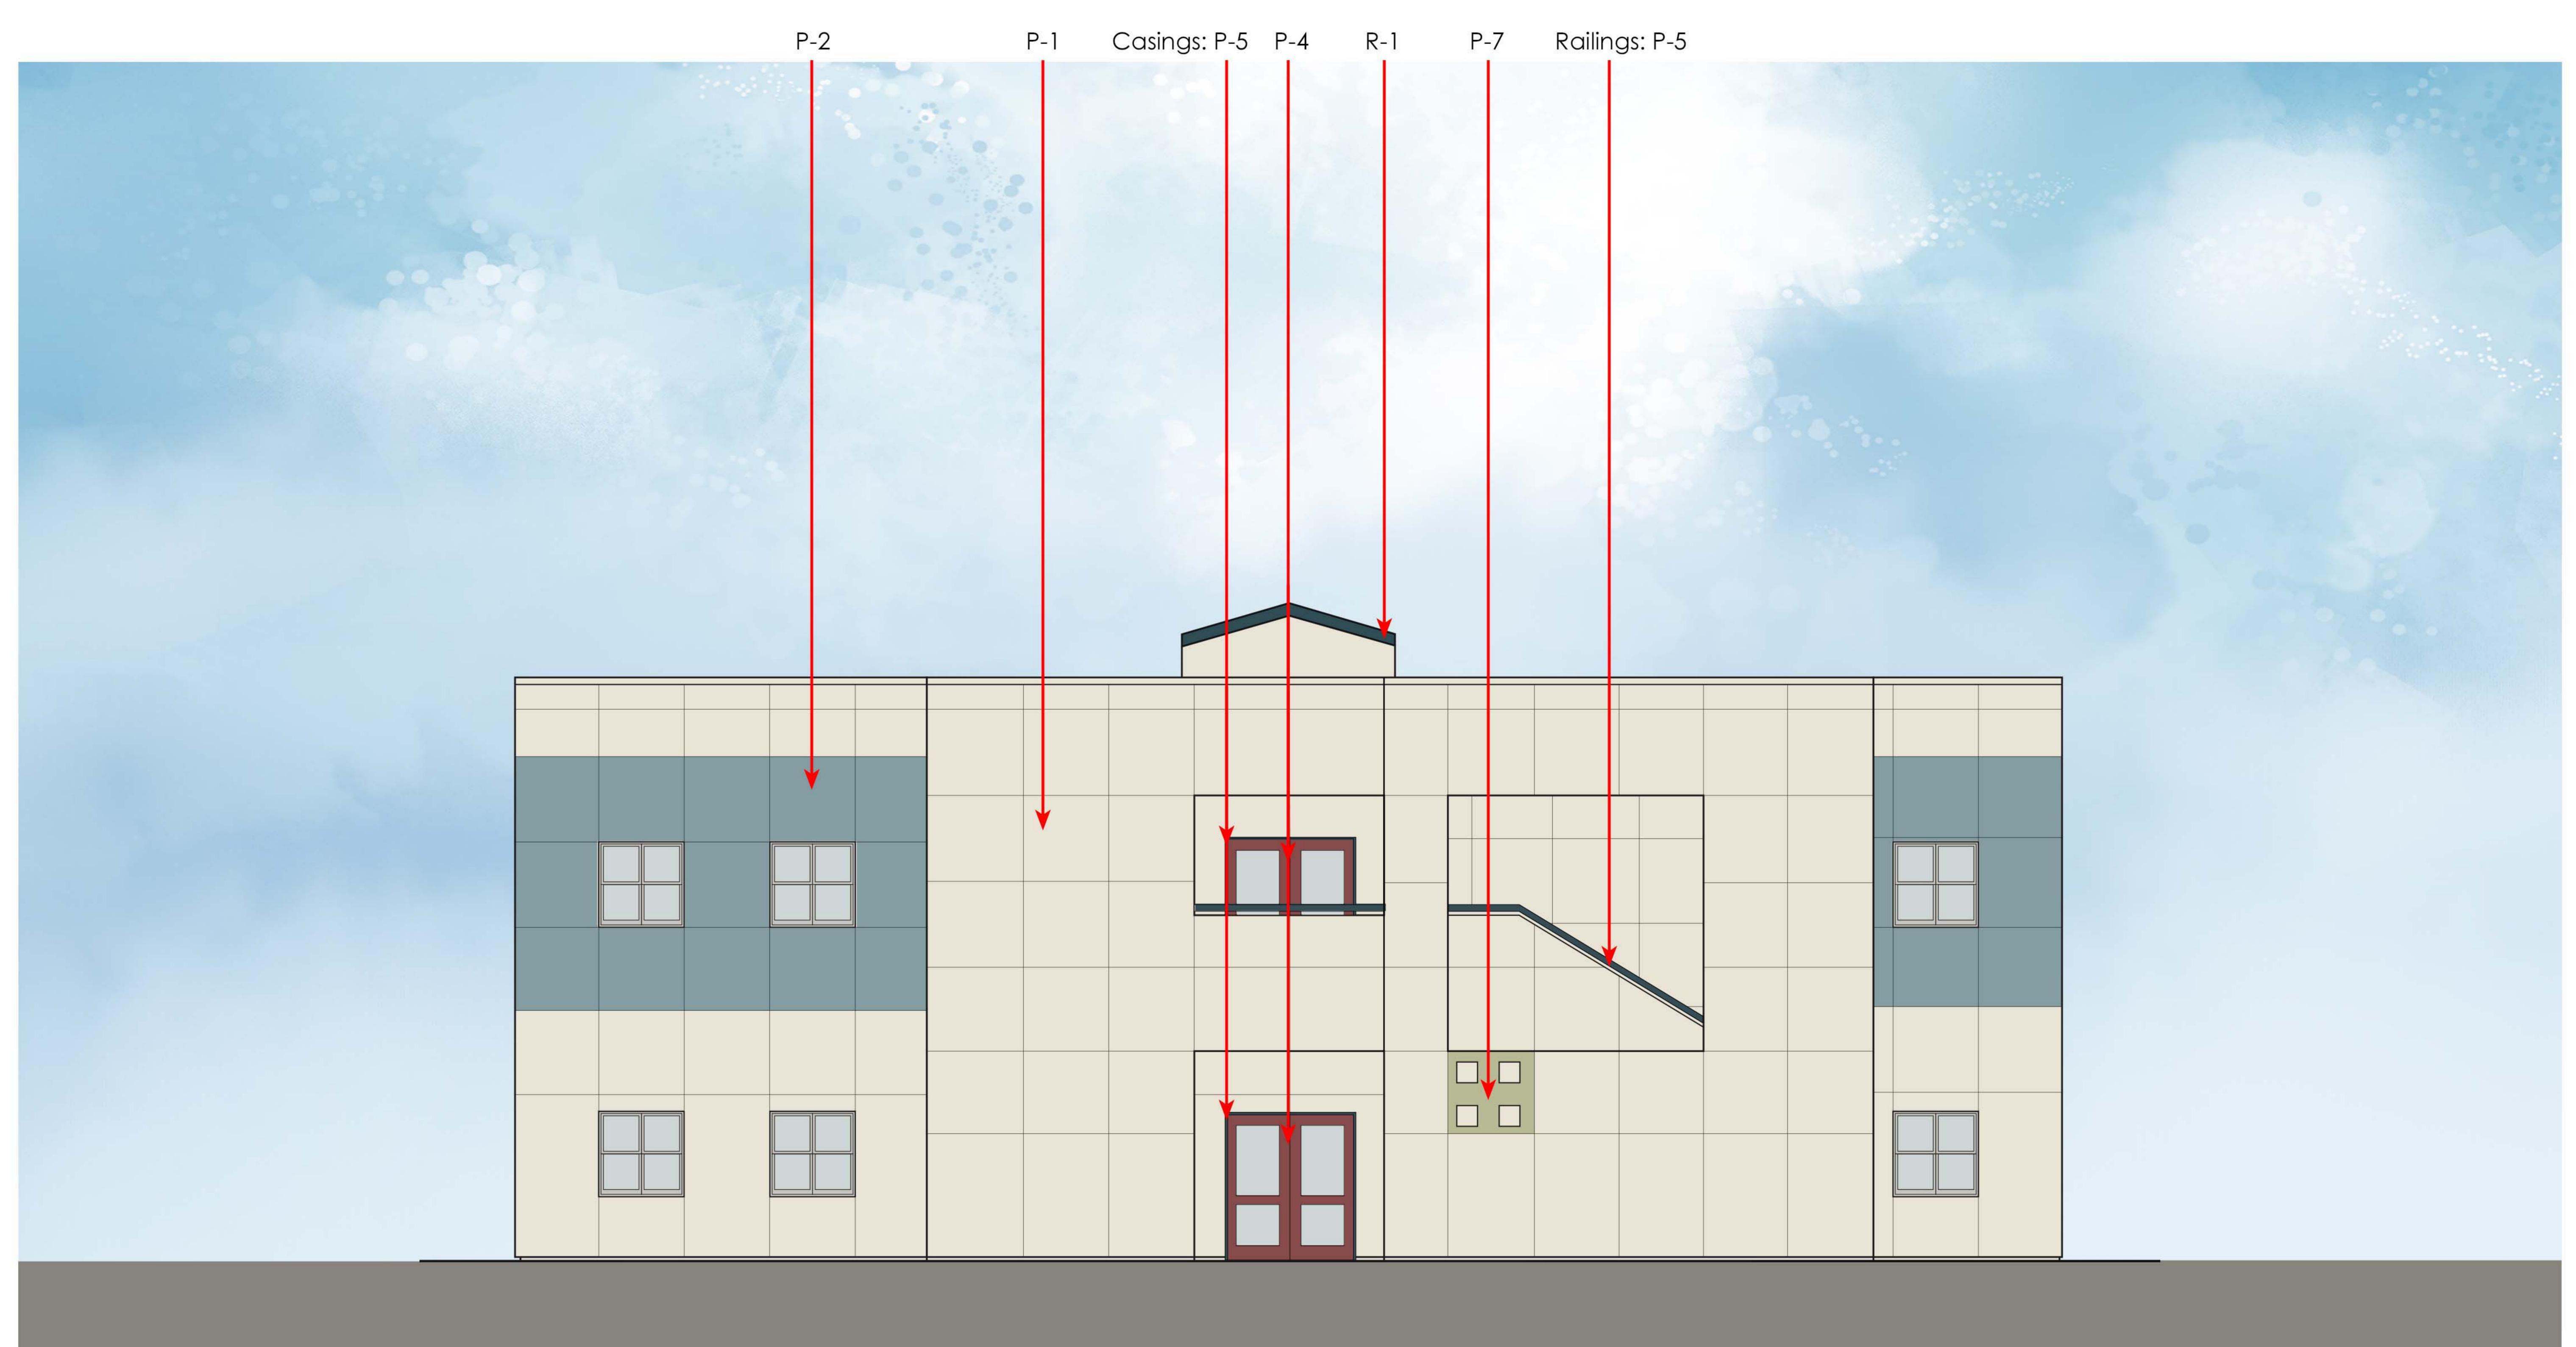


West Elevation Exterior Elevation - 2 Story Classroom

Mohr Elementary School Pleasanton Unified School District February 2, 2022





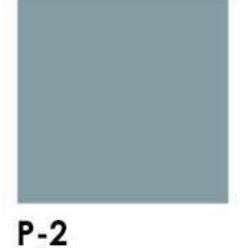

Kelly Moore KM 4867



Kelly Moore KM 5822 Soul Quenching San Francisco Fog



Kelly Moore HLS 4269 Oxford Brick





Casings, Railings

Main body, Accents

Note: 1. On all exterior doors and frames, paint interiors and exteriors - typical 2. On all storefront doors and windows, paint interiors and exteriors - typical





Kelly Moore KMA 87 Stiletto

Perimeter Fence



Kelly Moore KM 4776 Green Tea




P-8 Kelly Moore KM 5273 Casava Cake Tsunami



P-10

Accents for R Buildings

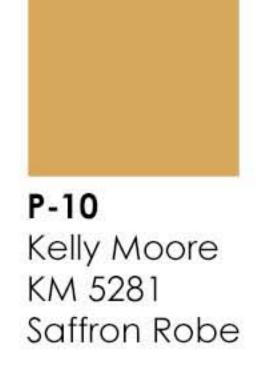




Kelly Moore KM 5512 Love Birds






P-12 Custom Match to: Tnemec 49BL **Reflection Pool**

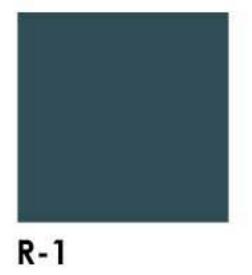

Inemec 49BL **Reflection Pool**

Roof

 

E17 Exterior Elevation - Buildings R1, R10

Mohr Elementary School Pleasanton Unified School District February 2, 2022






P-2

P-3 Kelly Moore Kelly Moore KM 4867 KM 5822 Soul Quenching San Francisco Fog P-4





Kelly Moore HLS 4269 Oxford Brick

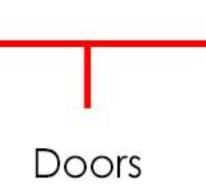




Kelly Moore KMA 28 Bay Isle Pointe



P-6

Kelly Moore KMA 87 Stiletto

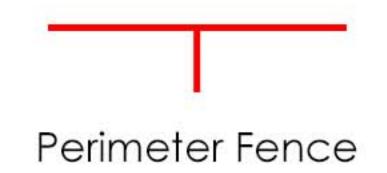


P-7 Kelly Moore KM 4776 Green Tea








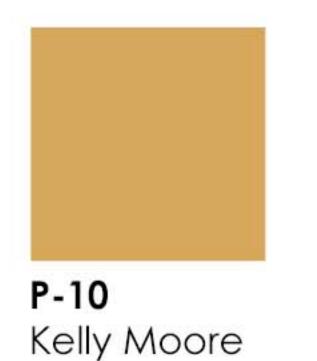

Kelly Moore KM 5281 Saffron Robe

Accents for R Buildings


Walkway Pencils

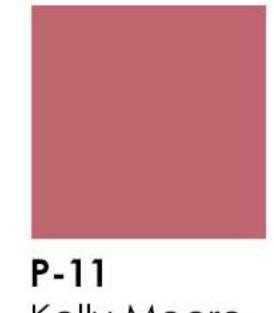

Kelly Moore KM 5512 Love Birds



P-12 Custom Match to: Tnemec 49BL Reflection Pool

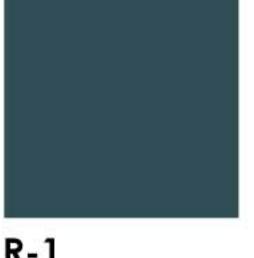


R-1 Tnemec 49BL Reflection Pool

Note:

1. On all exterior doors and frames, paints interiors and exteriors - typical 2. On all storefront doors and windows, paint interiors and exteriors - typical

Roof



 

N17 Exterior Elevation - Buildings R1, R10

Mohr Elementary School Pleasanton Unified School District February 2, 2022






P-2 Kelly Moore KM 4867 Soul Quenching

P-3 Kelly Moore KM 5822 San Francisco Fog P-4



Kelly Moore HLS 4269 Oxford Brick

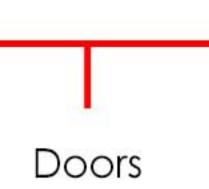

P-5 Kelly Moore KMA 28 Bay Isle Pointe





P-6 Kelly Moore KMA 87 Stiletto



P-7 Kelly Moore KM 4776 Green Tea



KM 5273





Accents for R Buildings

Casava Cake Tsunami


Walkway Pencils



Kelly Moore KM 5512 Love Birds



P-12 Custom Match to: Tnemec 49BL Reflection Pool

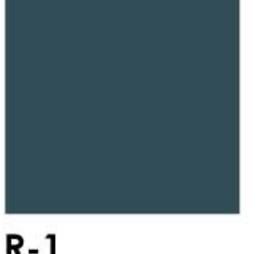


R-1 Tnemec 49BL Reflection Pool Note:

1. On all exterior doors and frames, paints interiors and exteriors - typical

2. On all storefront doors and windows, paint interiors and exteriors - typical

Roof



 

E17 Exterior Elevation - Buildings R3, R4, R7, R8

Mohr Elementary School Pleasanton Unified School District February 2, 2022






P-2 Kelly Moore KM 4867 Soul Quenching


P-3 Kelly Moore KM 5822 San Francisco Fog P-4





Kelly Moore HLS 4269 Oxford Brick

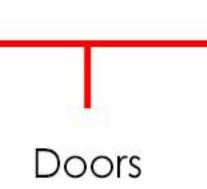

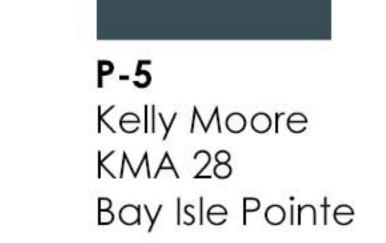

Casings, Railings



P-6 Kelly Moore KMA 87 Stiletto



P-7 Kelly Moore KM 4776 Green Tea








KM 5273 Casava Cake Tsunami

Accents for R Buildings


Walkway Pencils

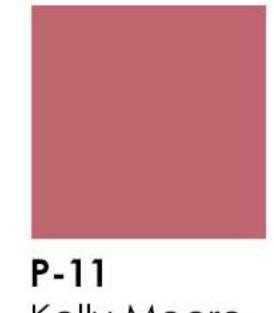

Kelly Moore KM 5512 Love Birds



P-12 Custom Match to: Tnemec 49BL Reflection Pool

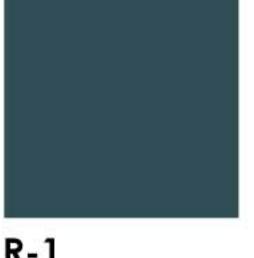


R-1 Tnemec 49BL Reflection Pool

Note:

1. On all exterior doors and frames, paints interiors and exteriors - typical 2. On all storefront doors and windows, paint interiors and exteriors - typical

Roof



 

N17 Exterior Elevation - Buildings R3, R4, R7, R8

Mohr Elementary School Pleasanton Unified School District February 2, 2022





P-2 Kelly Moore KM 4867 Soul Quenching

P-3 Kelly Moore KM 5822 San Francisco Fog P-4



Kelly Moore HLS 4269 Oxford Brick



Doors




P-5 Kelly Moore KMA 28 Bay Isle Pointe



P-6

Kelly Moore KMA 87 Stiletto

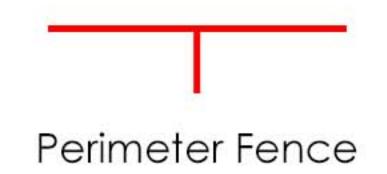


P-7 Kelly Moore KM 4776 Green Tea







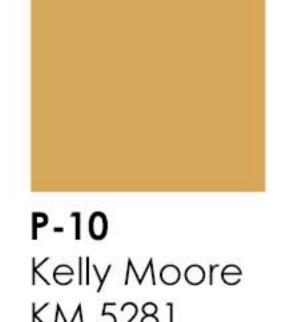

Kelly Moore KM 5281 Saffron Robe

Accents for R Buildings

KM 5273

Walkway Pencils



Kelly Moore KM 5512 Love Birds



P-12 Custom Match to: Tnemec 49BL Reflection Pool



R-1 Tnemec 49BL Reflection Pool


Note:

1. On all exterior doors and frames, paints interiors and exteriors - typical

2. On all storefront doors and windows, paint interiors and exteriors - typical

Roof



 

E17 Exterior Elevation - Buildings R2, R5, R6, R9

Mohr Elementary School Pleasanton Unified School District February 2, 2022






P-2 Kelly Moore KM 4867 Soul Quenching

P-3 Kelly Moore KM 5822 San Francisco Fog P-4





Kelly Moore HLS 4269 Oxford Brick

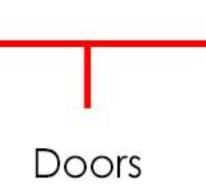





P-6


Kelly Moore KMA 87 Stiletto










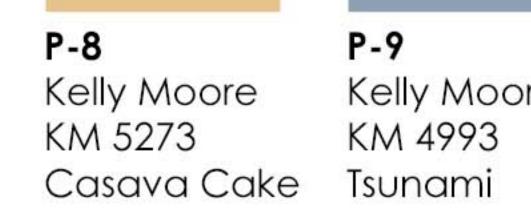

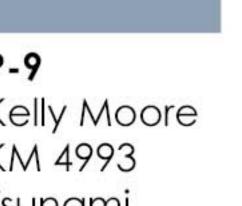




Kelly Moore KM 5281 Saffron Robe

Accents for R Buildings


Walkway Pencils

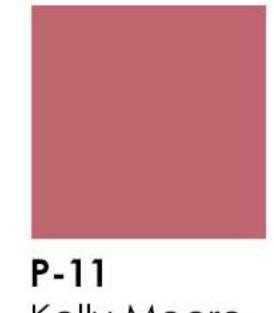

Kelly Moore KM 5512 Love Birds



P-12 Custom Match to: Tnemec 49BL Reflection Pool

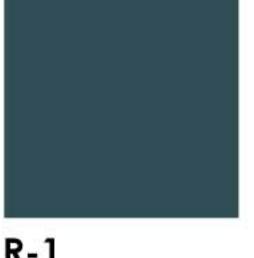


R-1 Tnemec 49BL Reflection Pool

Note:

1. On all exterior doors and frames, paints interiors and exteriors - typical 2. On all storefront doors and windows, paint interiors and exteriors - typical

Roof



 

N17 Exterior Elevation - Buildings R2, R5, R6, R9

Mohr Elementary School Pleasanton Unified School District February 2, 2022







P-2 Kelly Moore KM 4867 Soul Quenching

P-3 Kelly Moore KM 5822 San Francisco Fog P-4



Kelly Moore HLS 4269 Oxford Brick

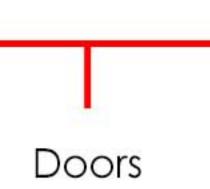

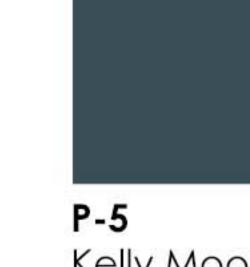

Kelly Moore KMA 28 Bay Isle Pointe



P-6


Kelly Moore KMA 87 Stiletto



P-7 Kelly Moore KM 4776 Green Tea





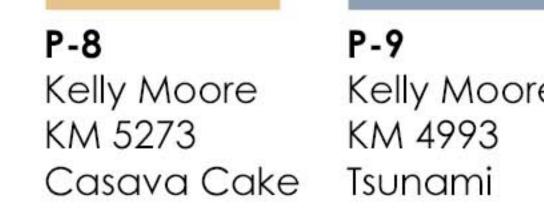

KM 4993




Kelly Moore KM 5281 Saffron Robe

Accents for R Buildings

Walkway Pencils

Casings, Railings

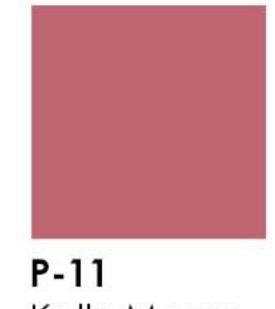

Kelly Moore KM 5512 Love Birds



P-12 Custom Match to: Tnemec 49BL Reflection Pool



R-1 Tnemec 49BL Reflection Pool


Note:

1. On all exterior doors and frames, paints interiors and exteriors - typical


2. On all storefront doors and windows, paint interiors and exteriors - typical

Roof



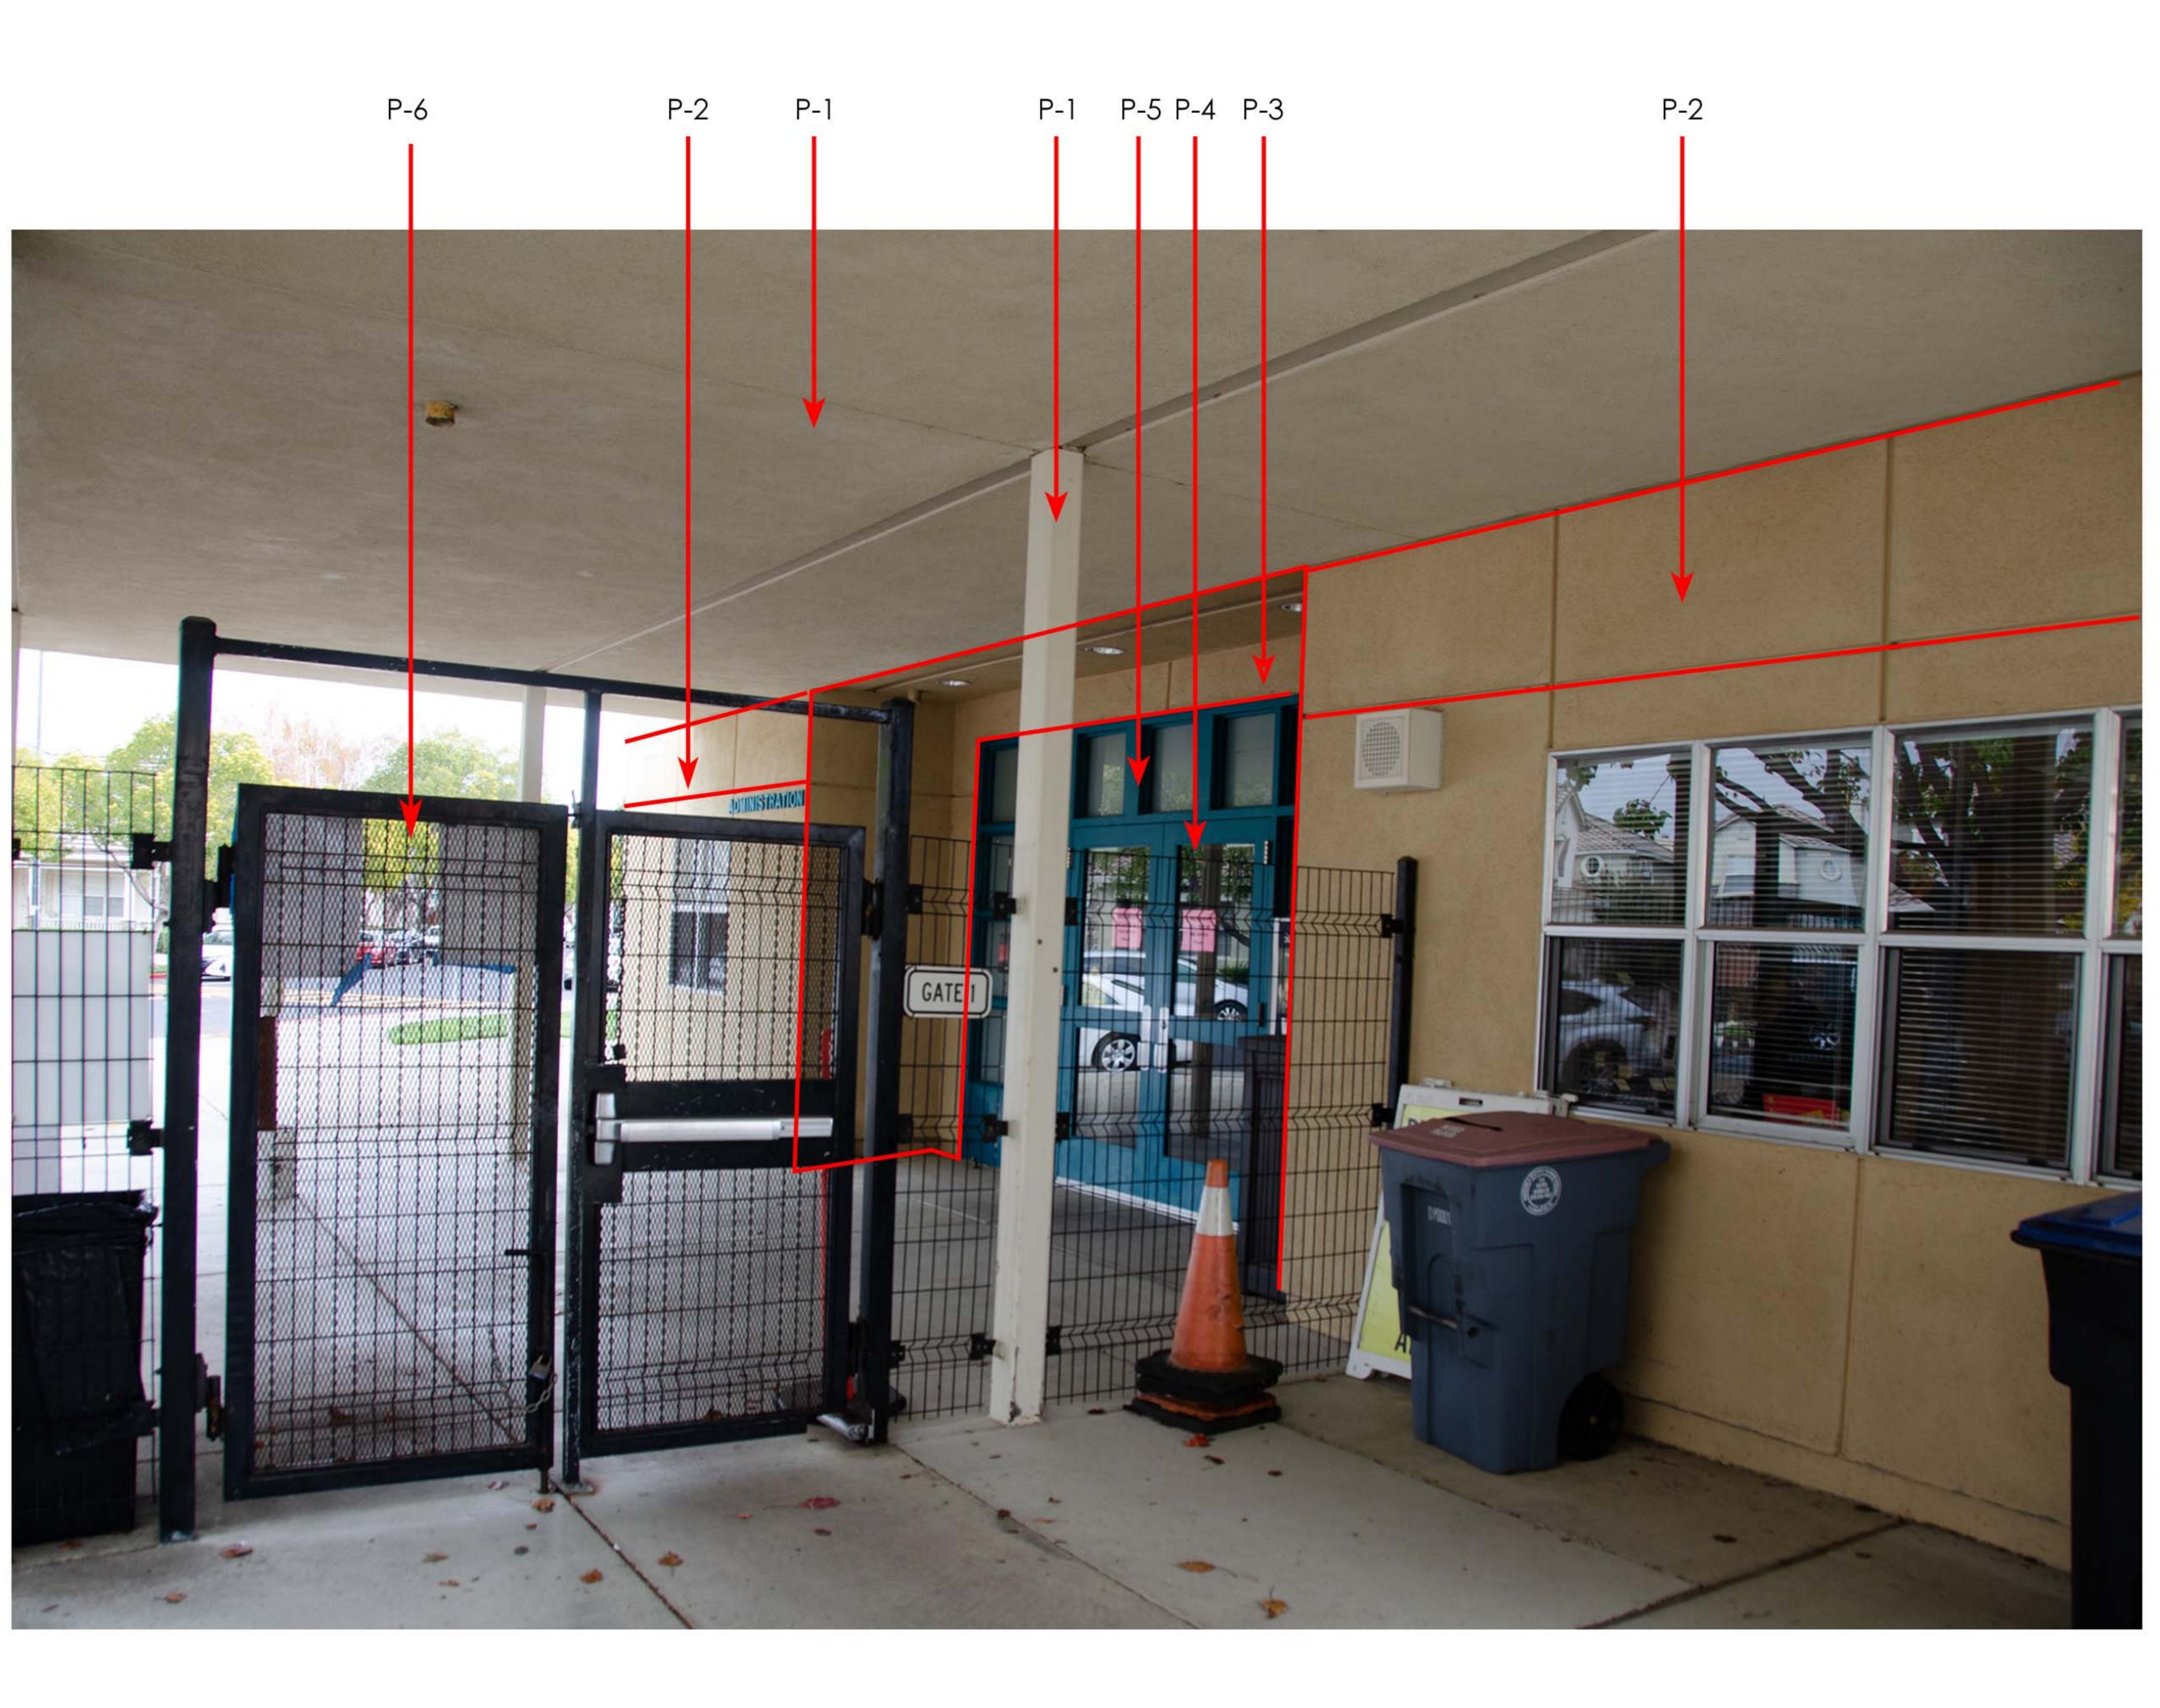



Building A

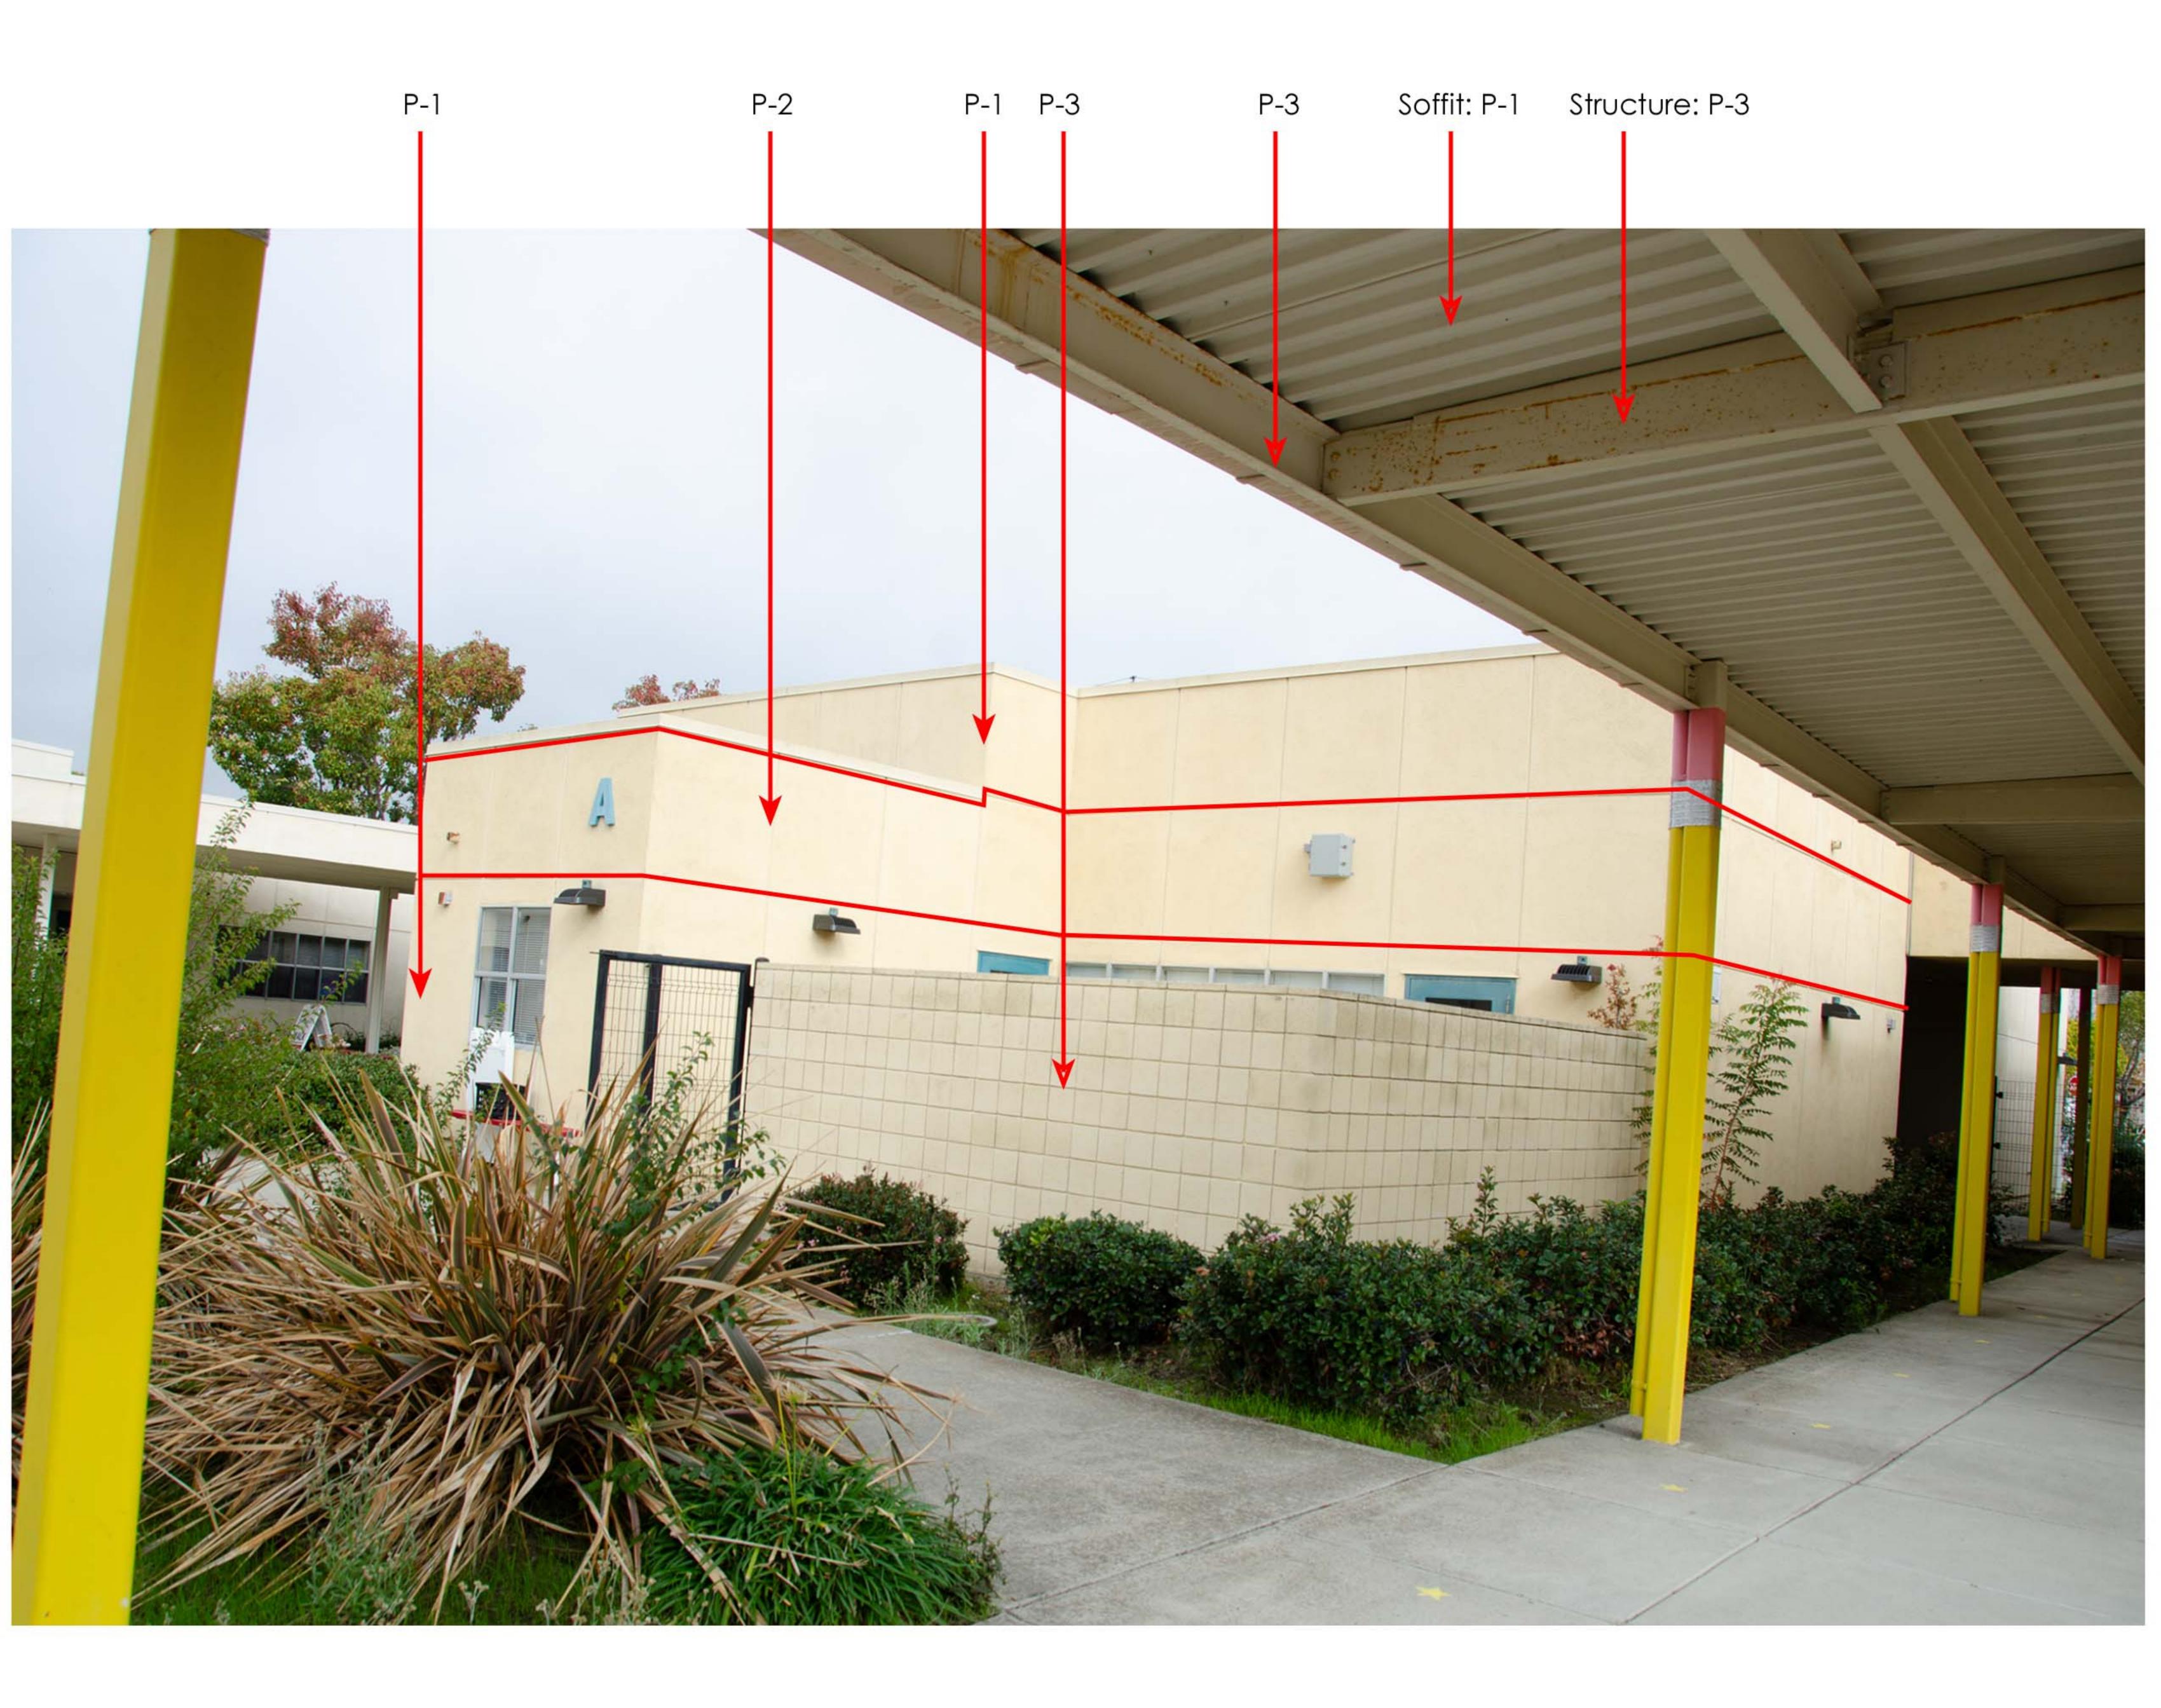

Building A




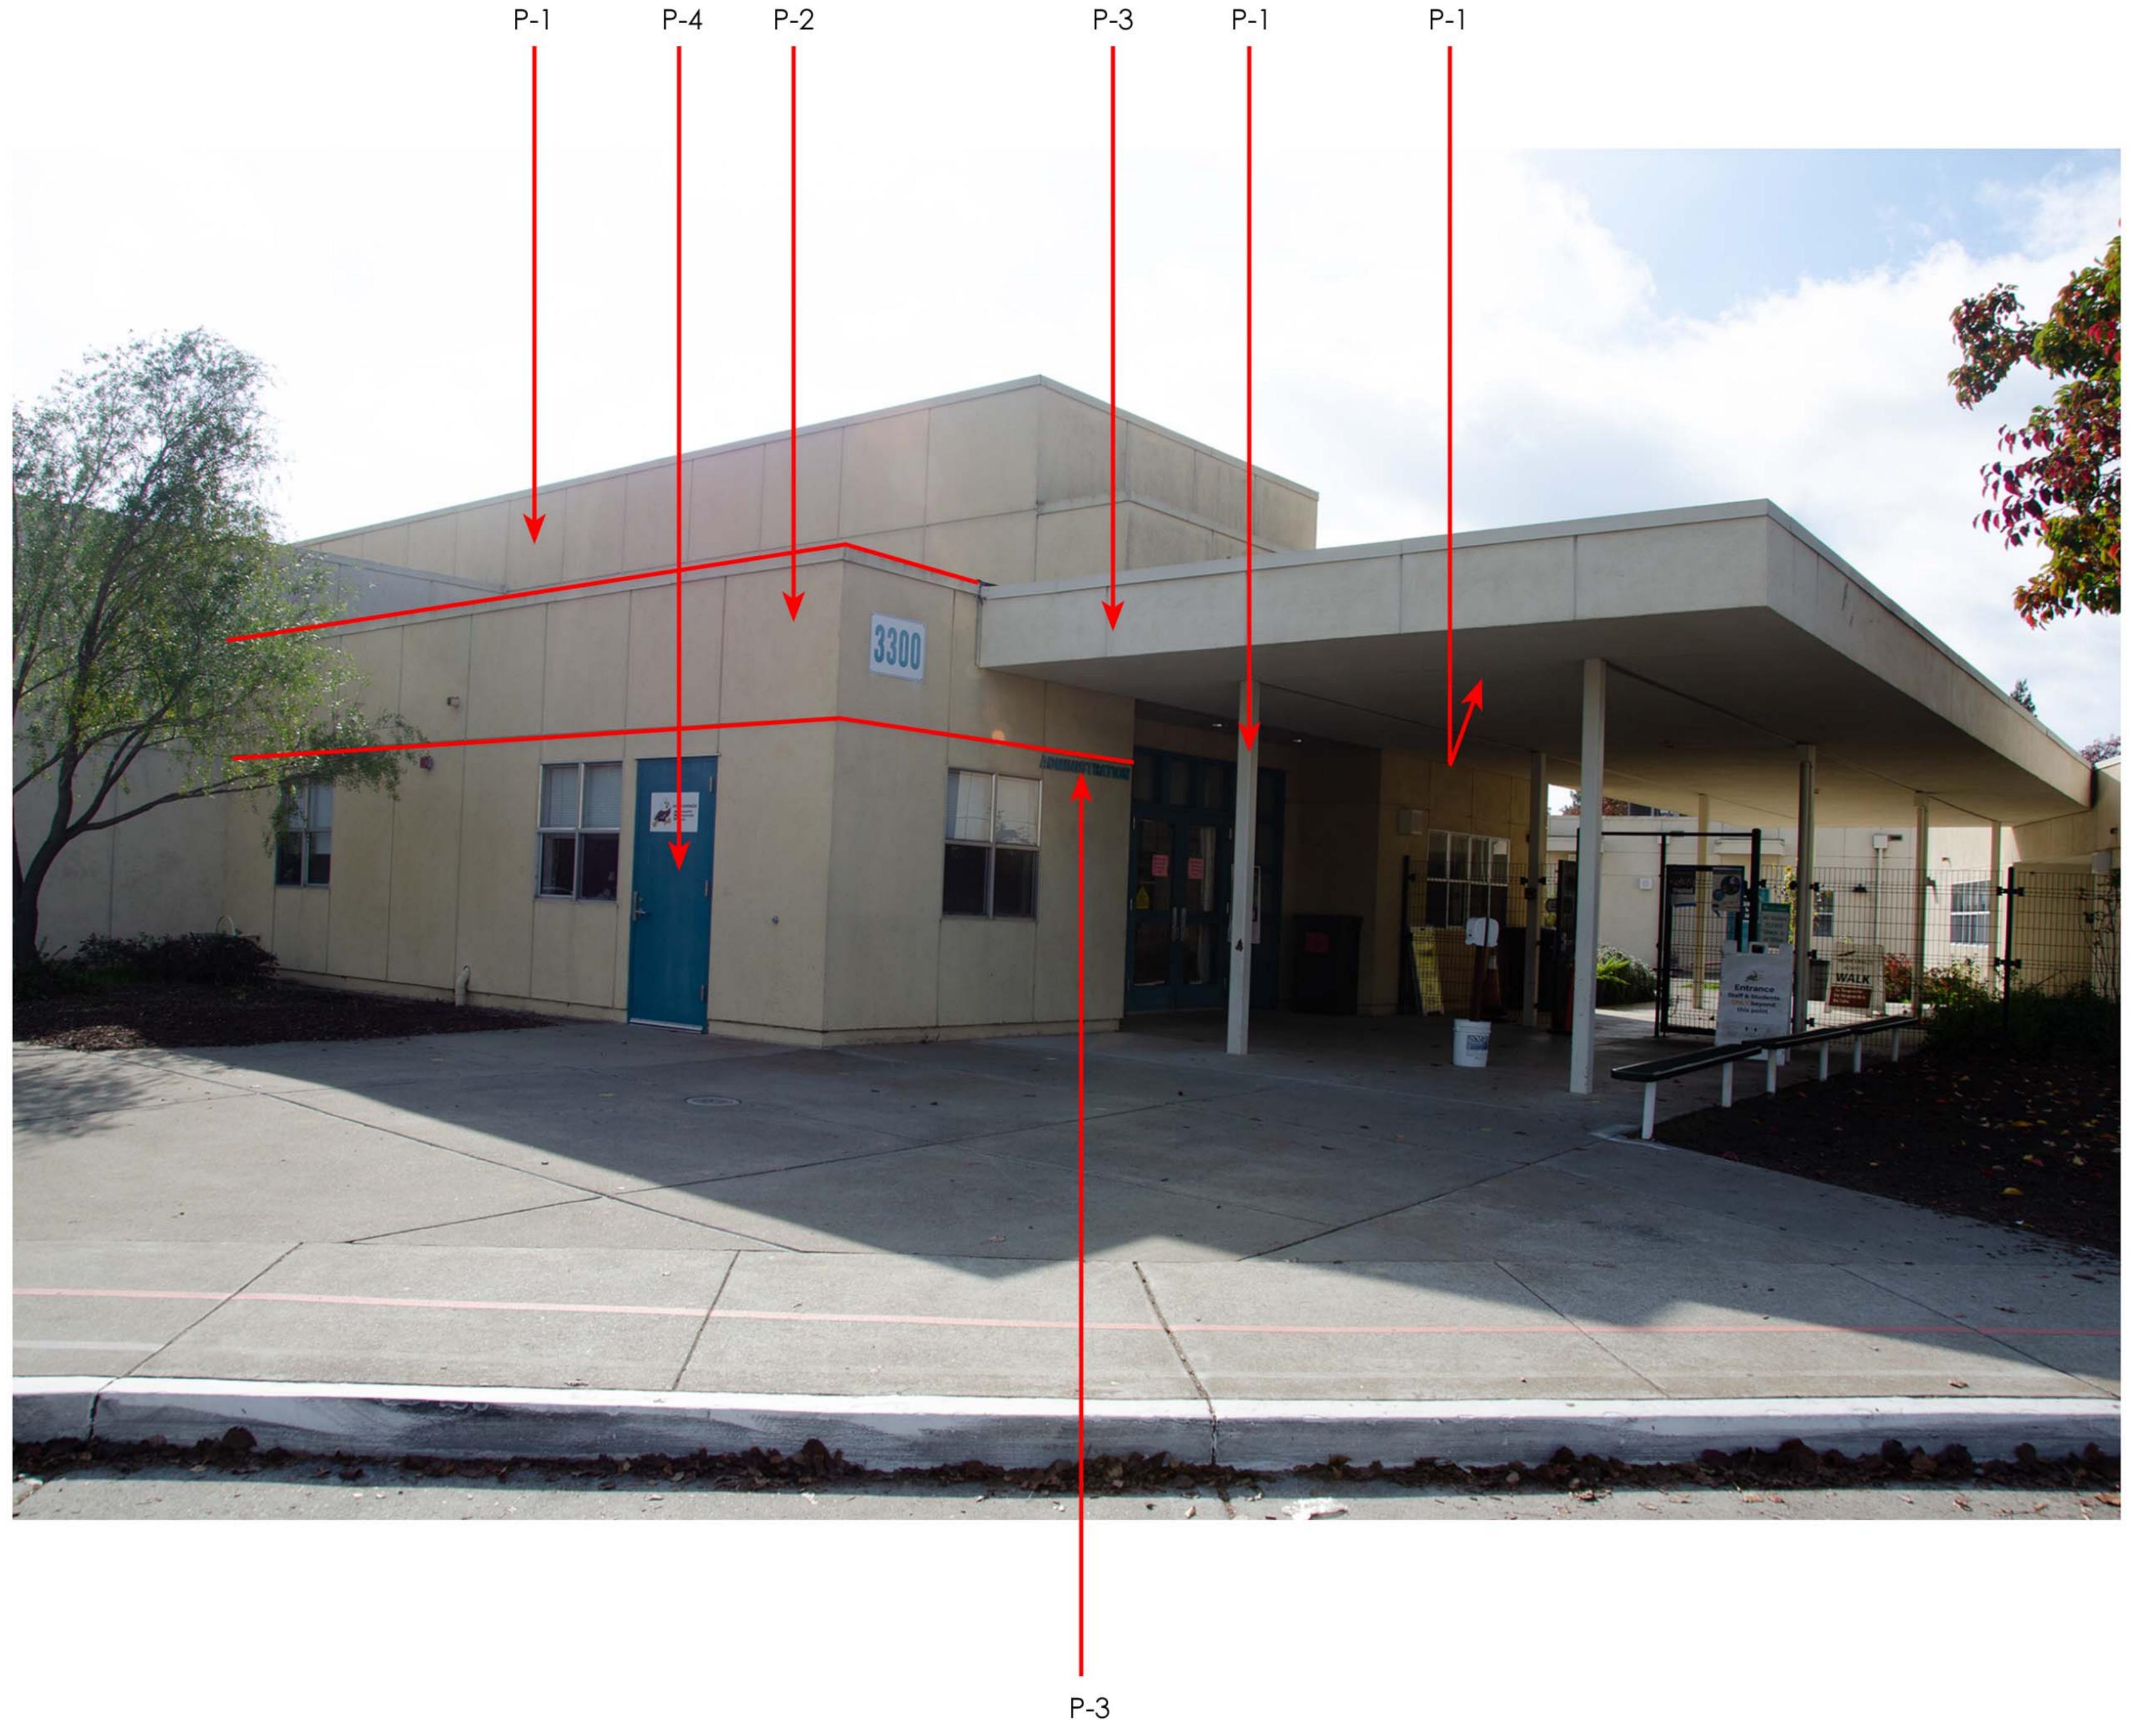

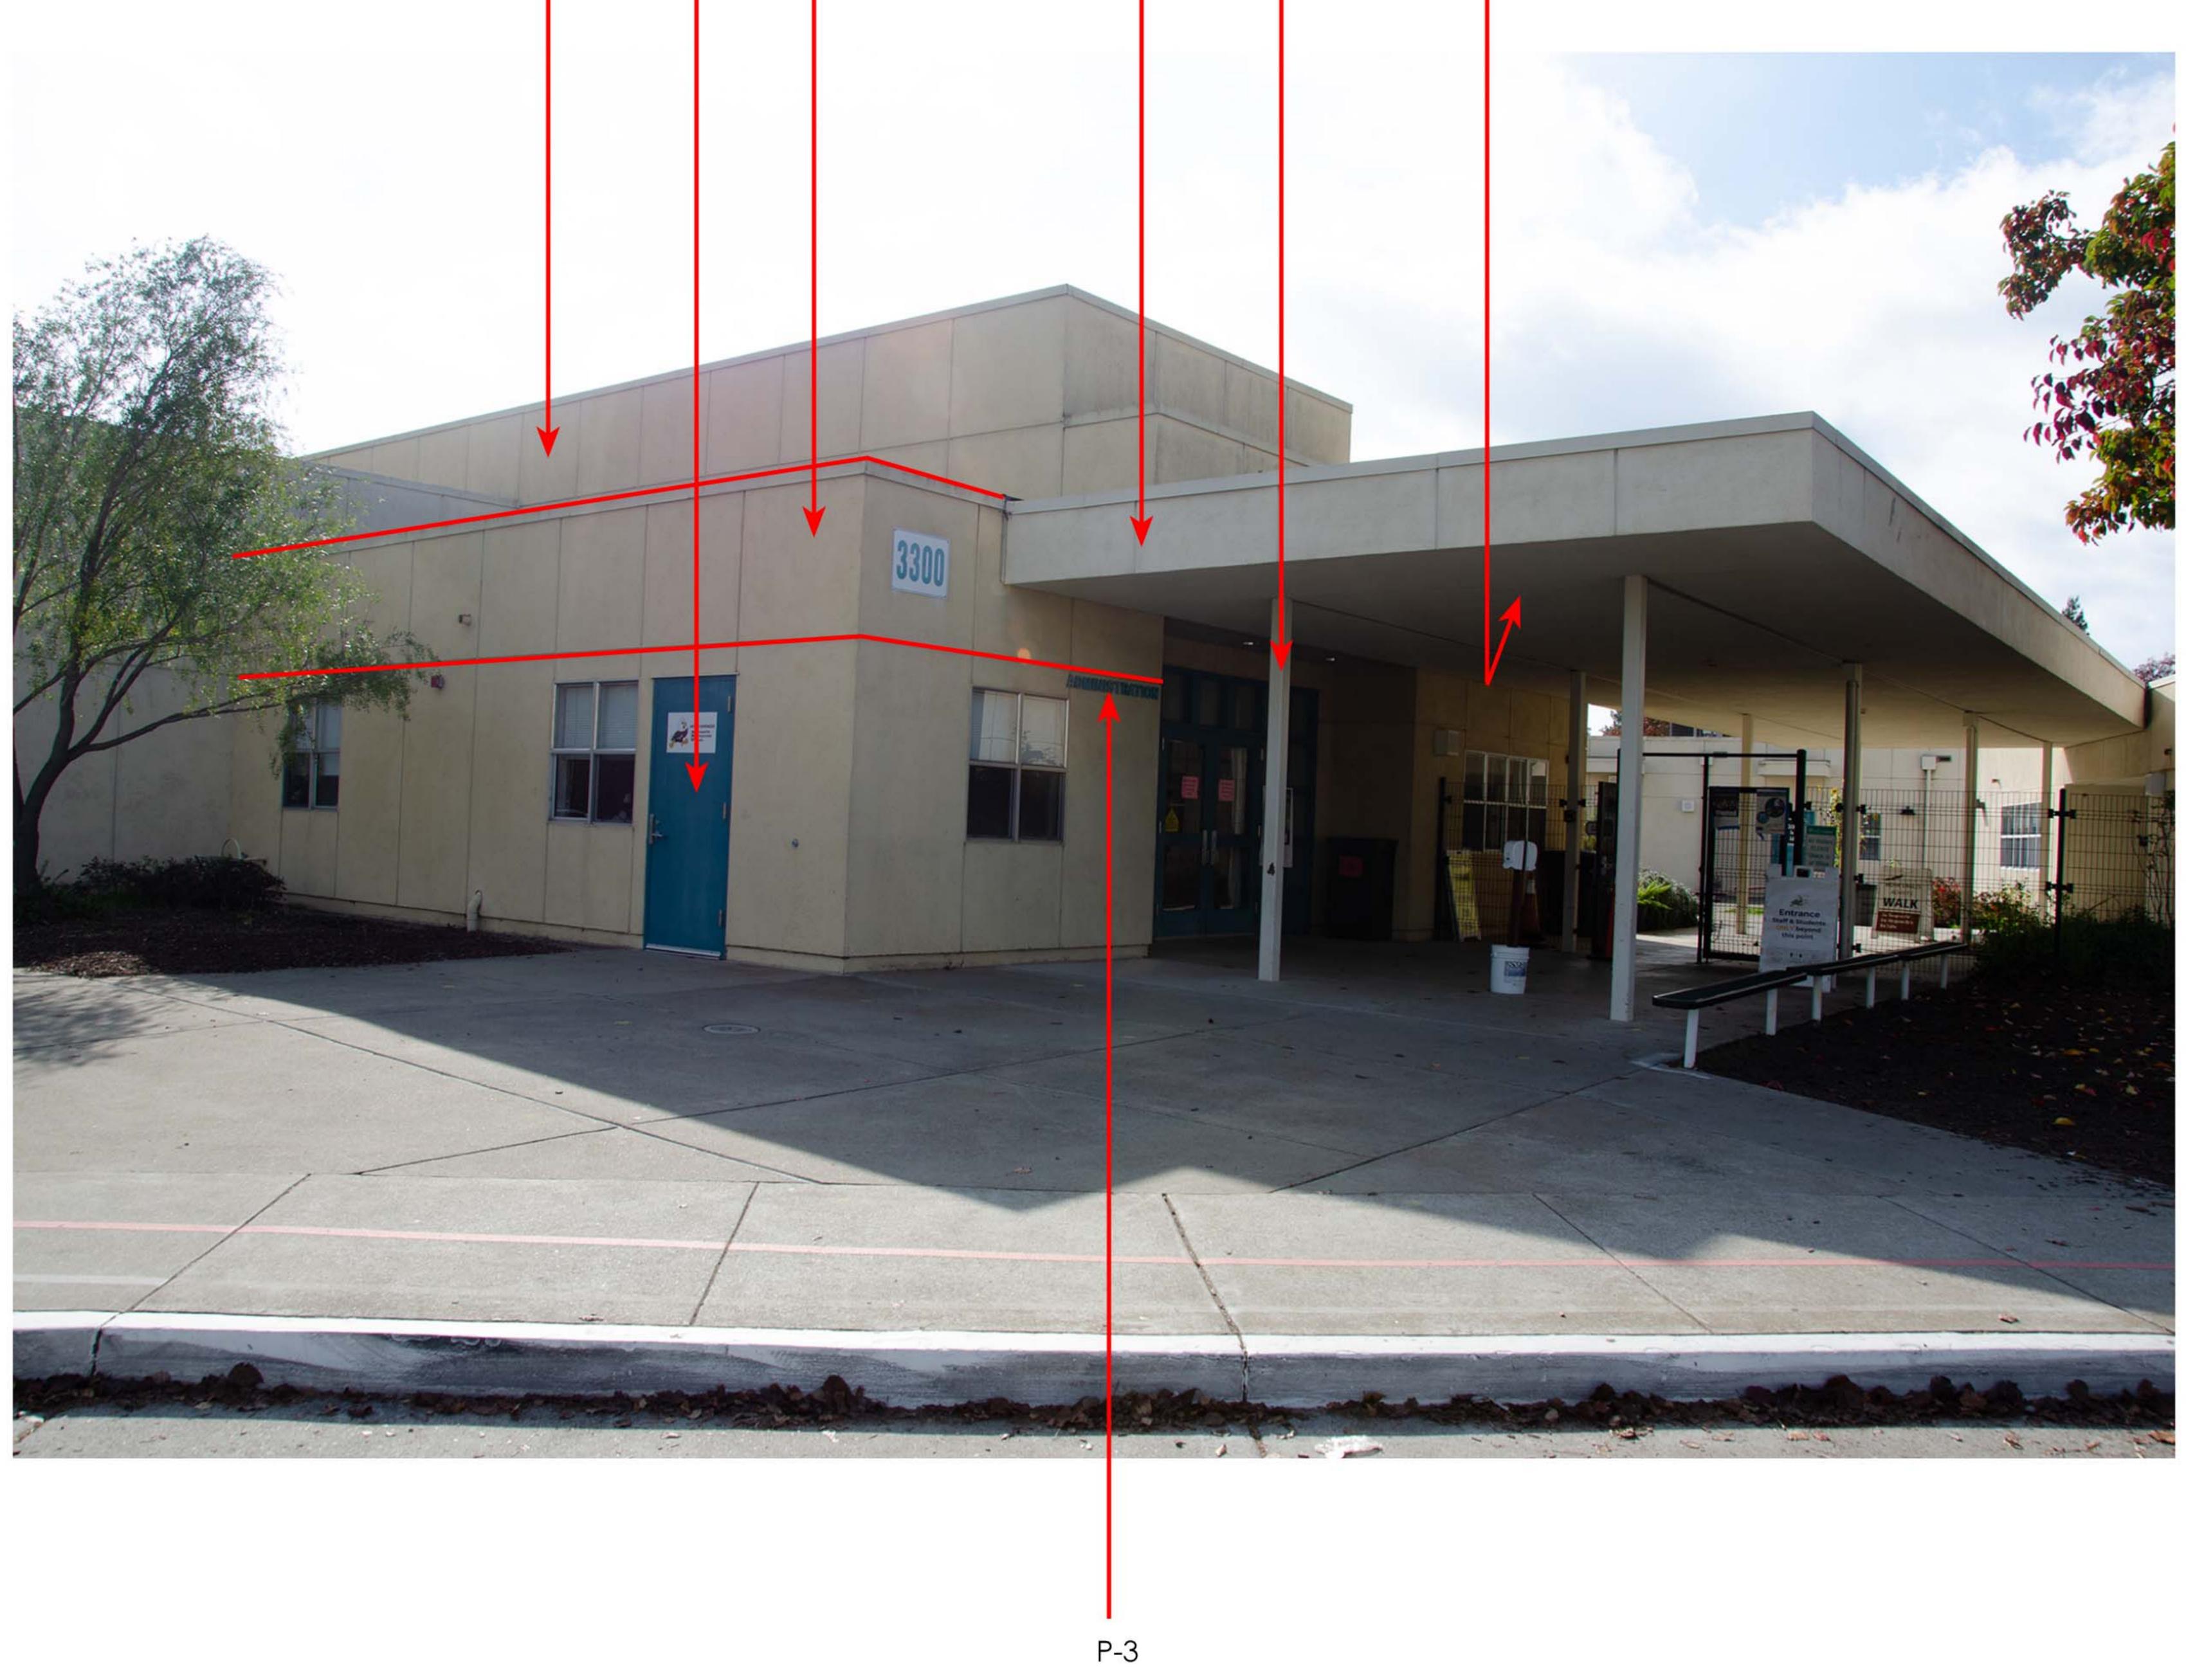


Building A



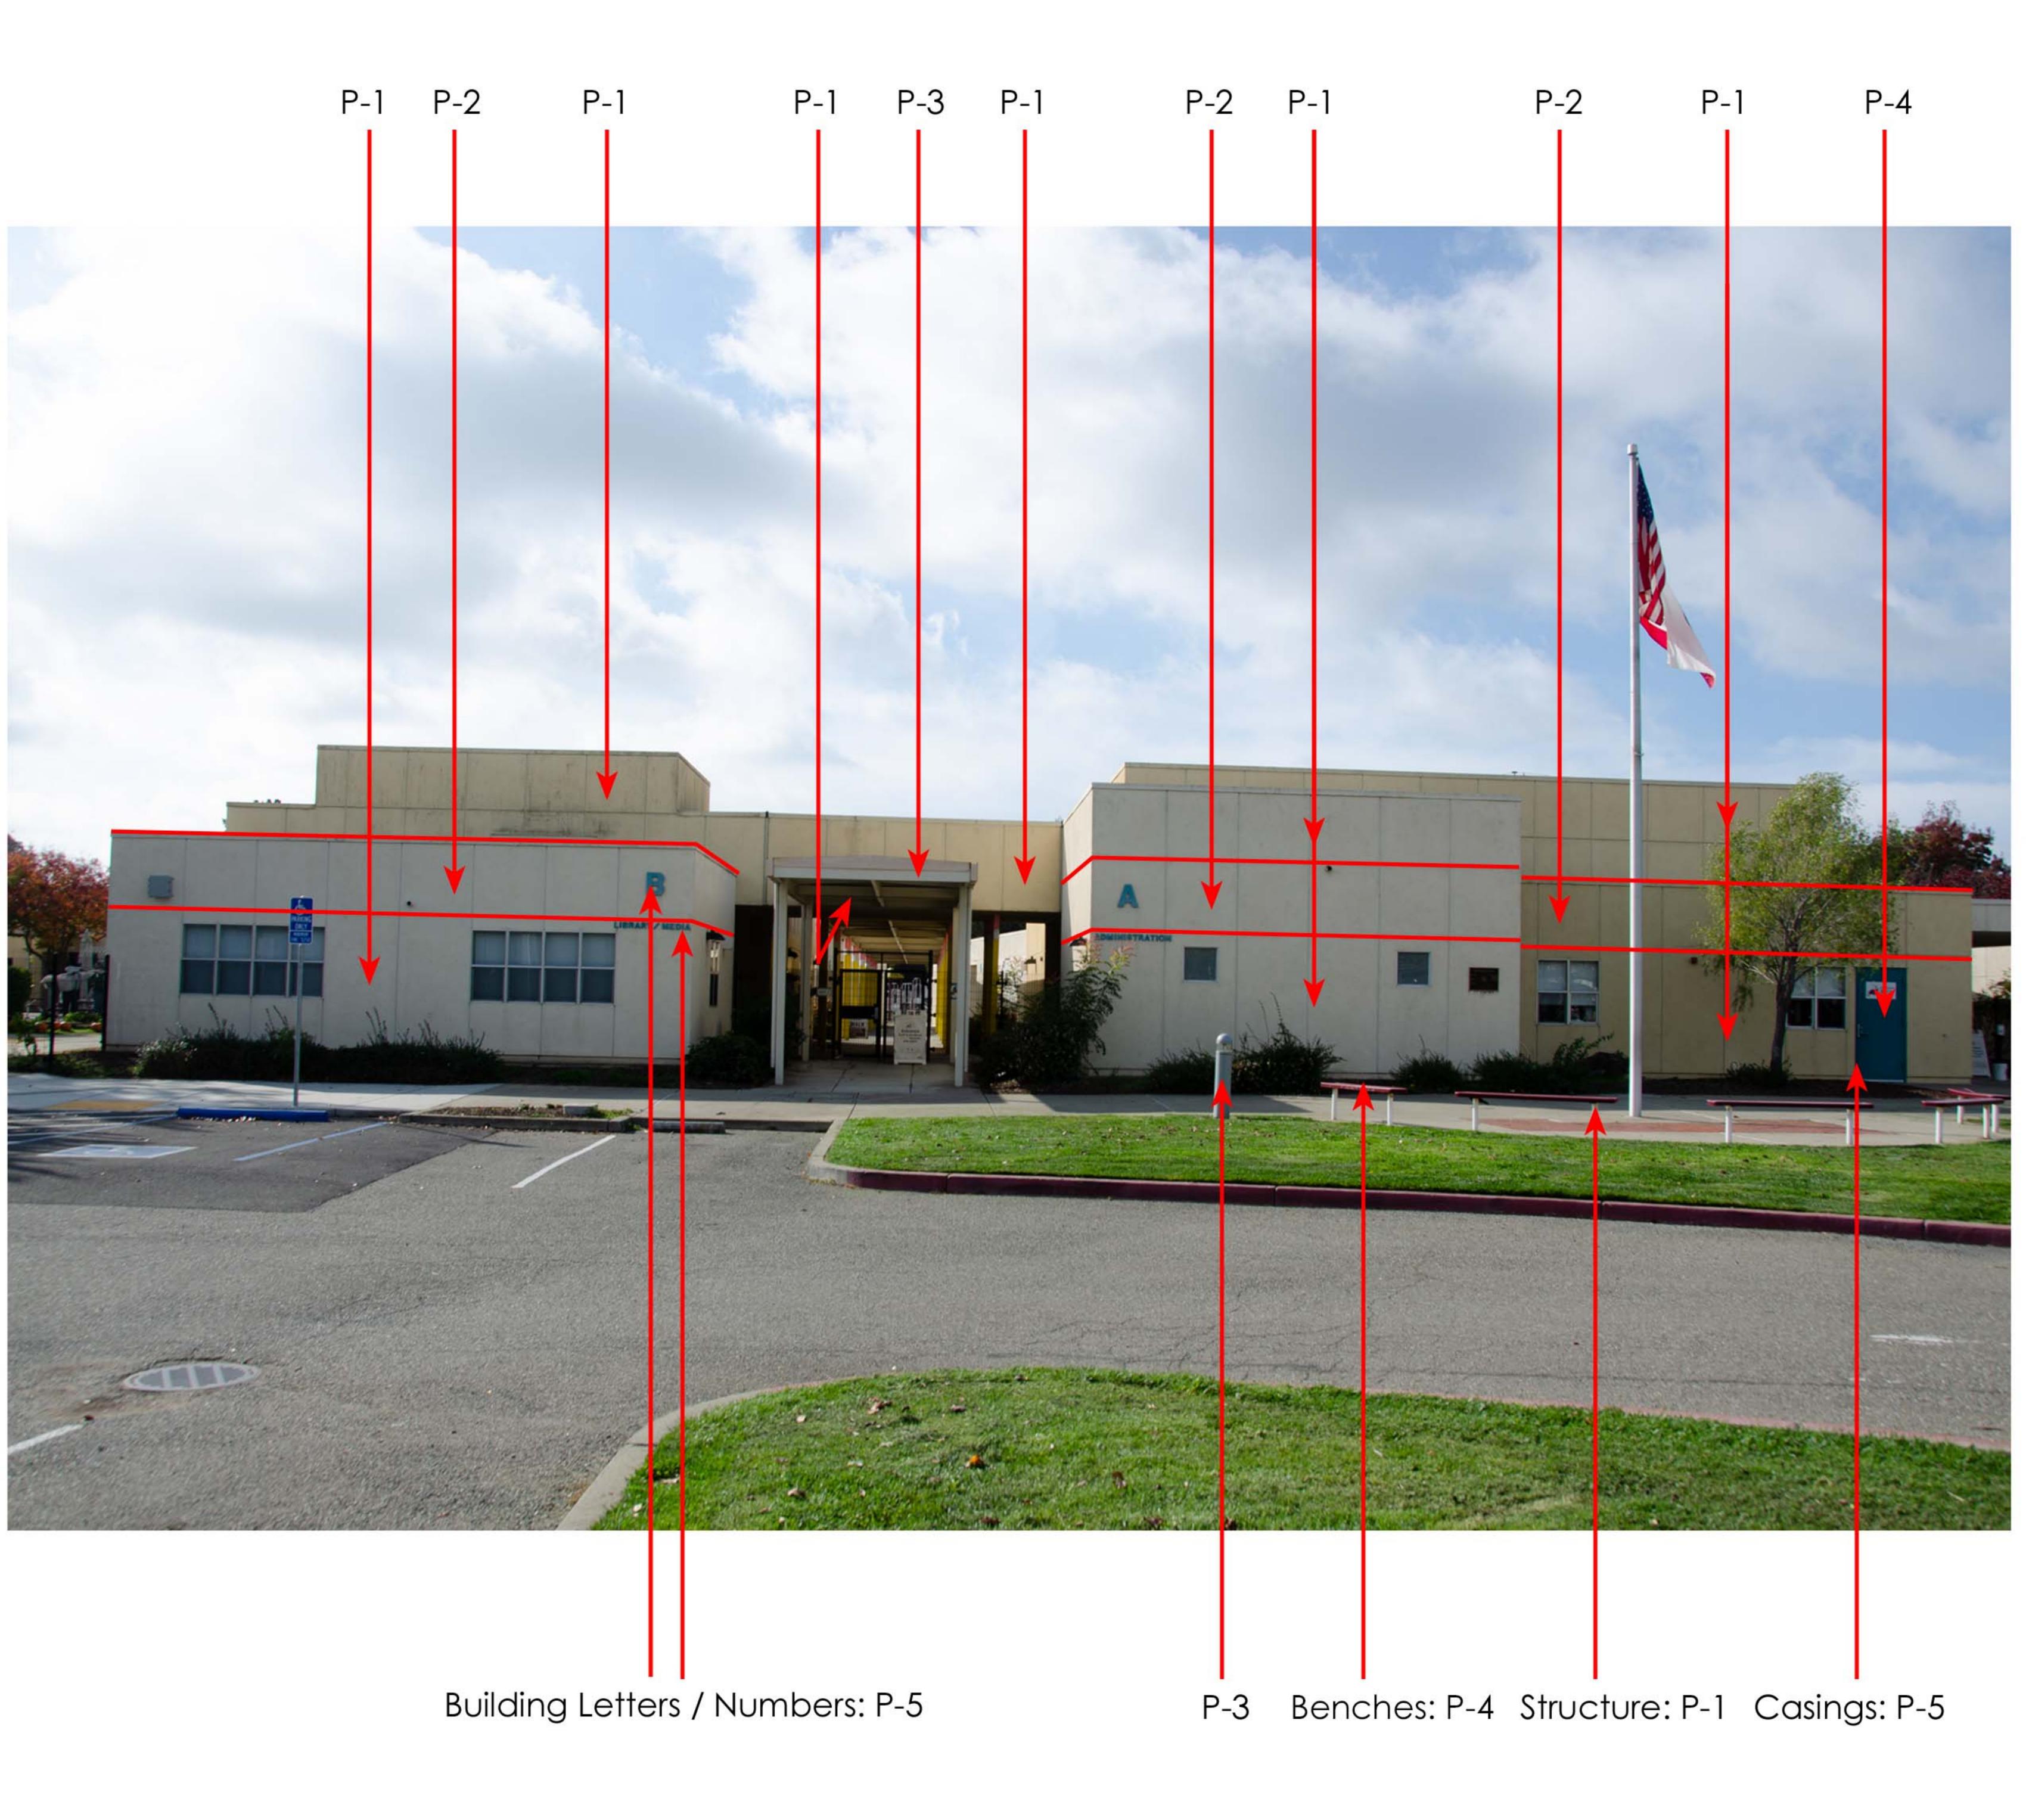

Building A / B


Note:

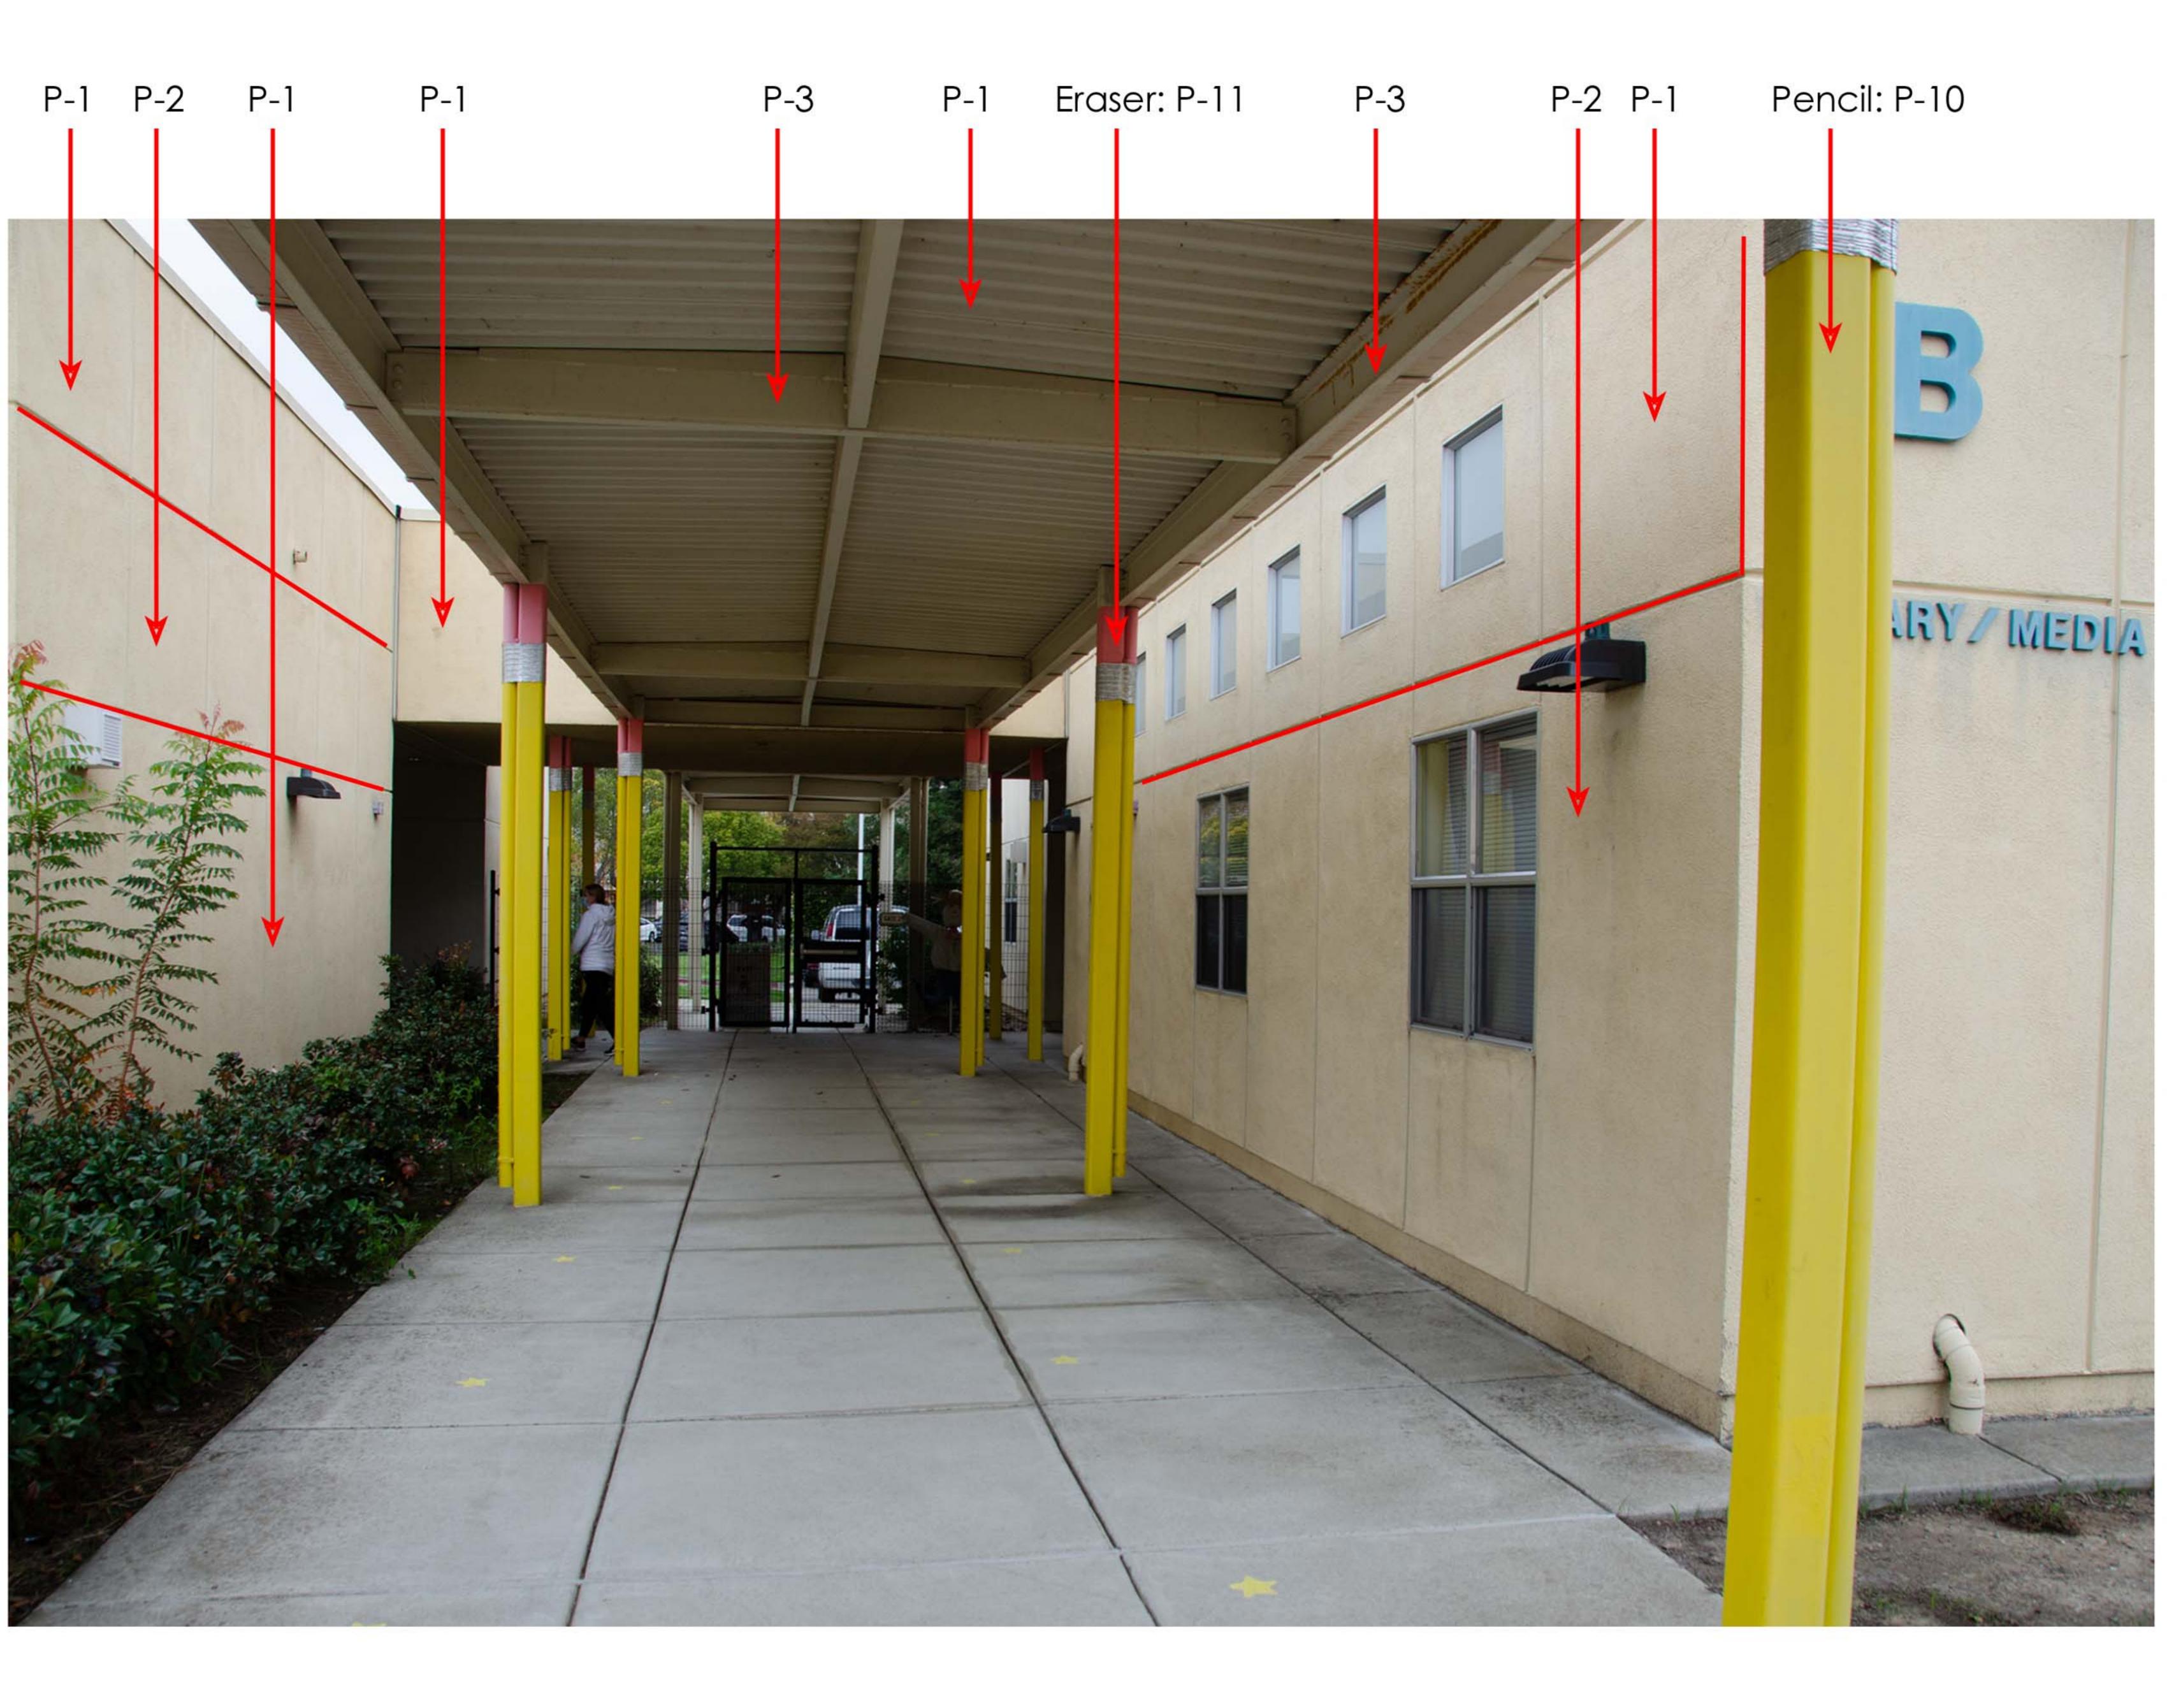

Building A / B

Note:



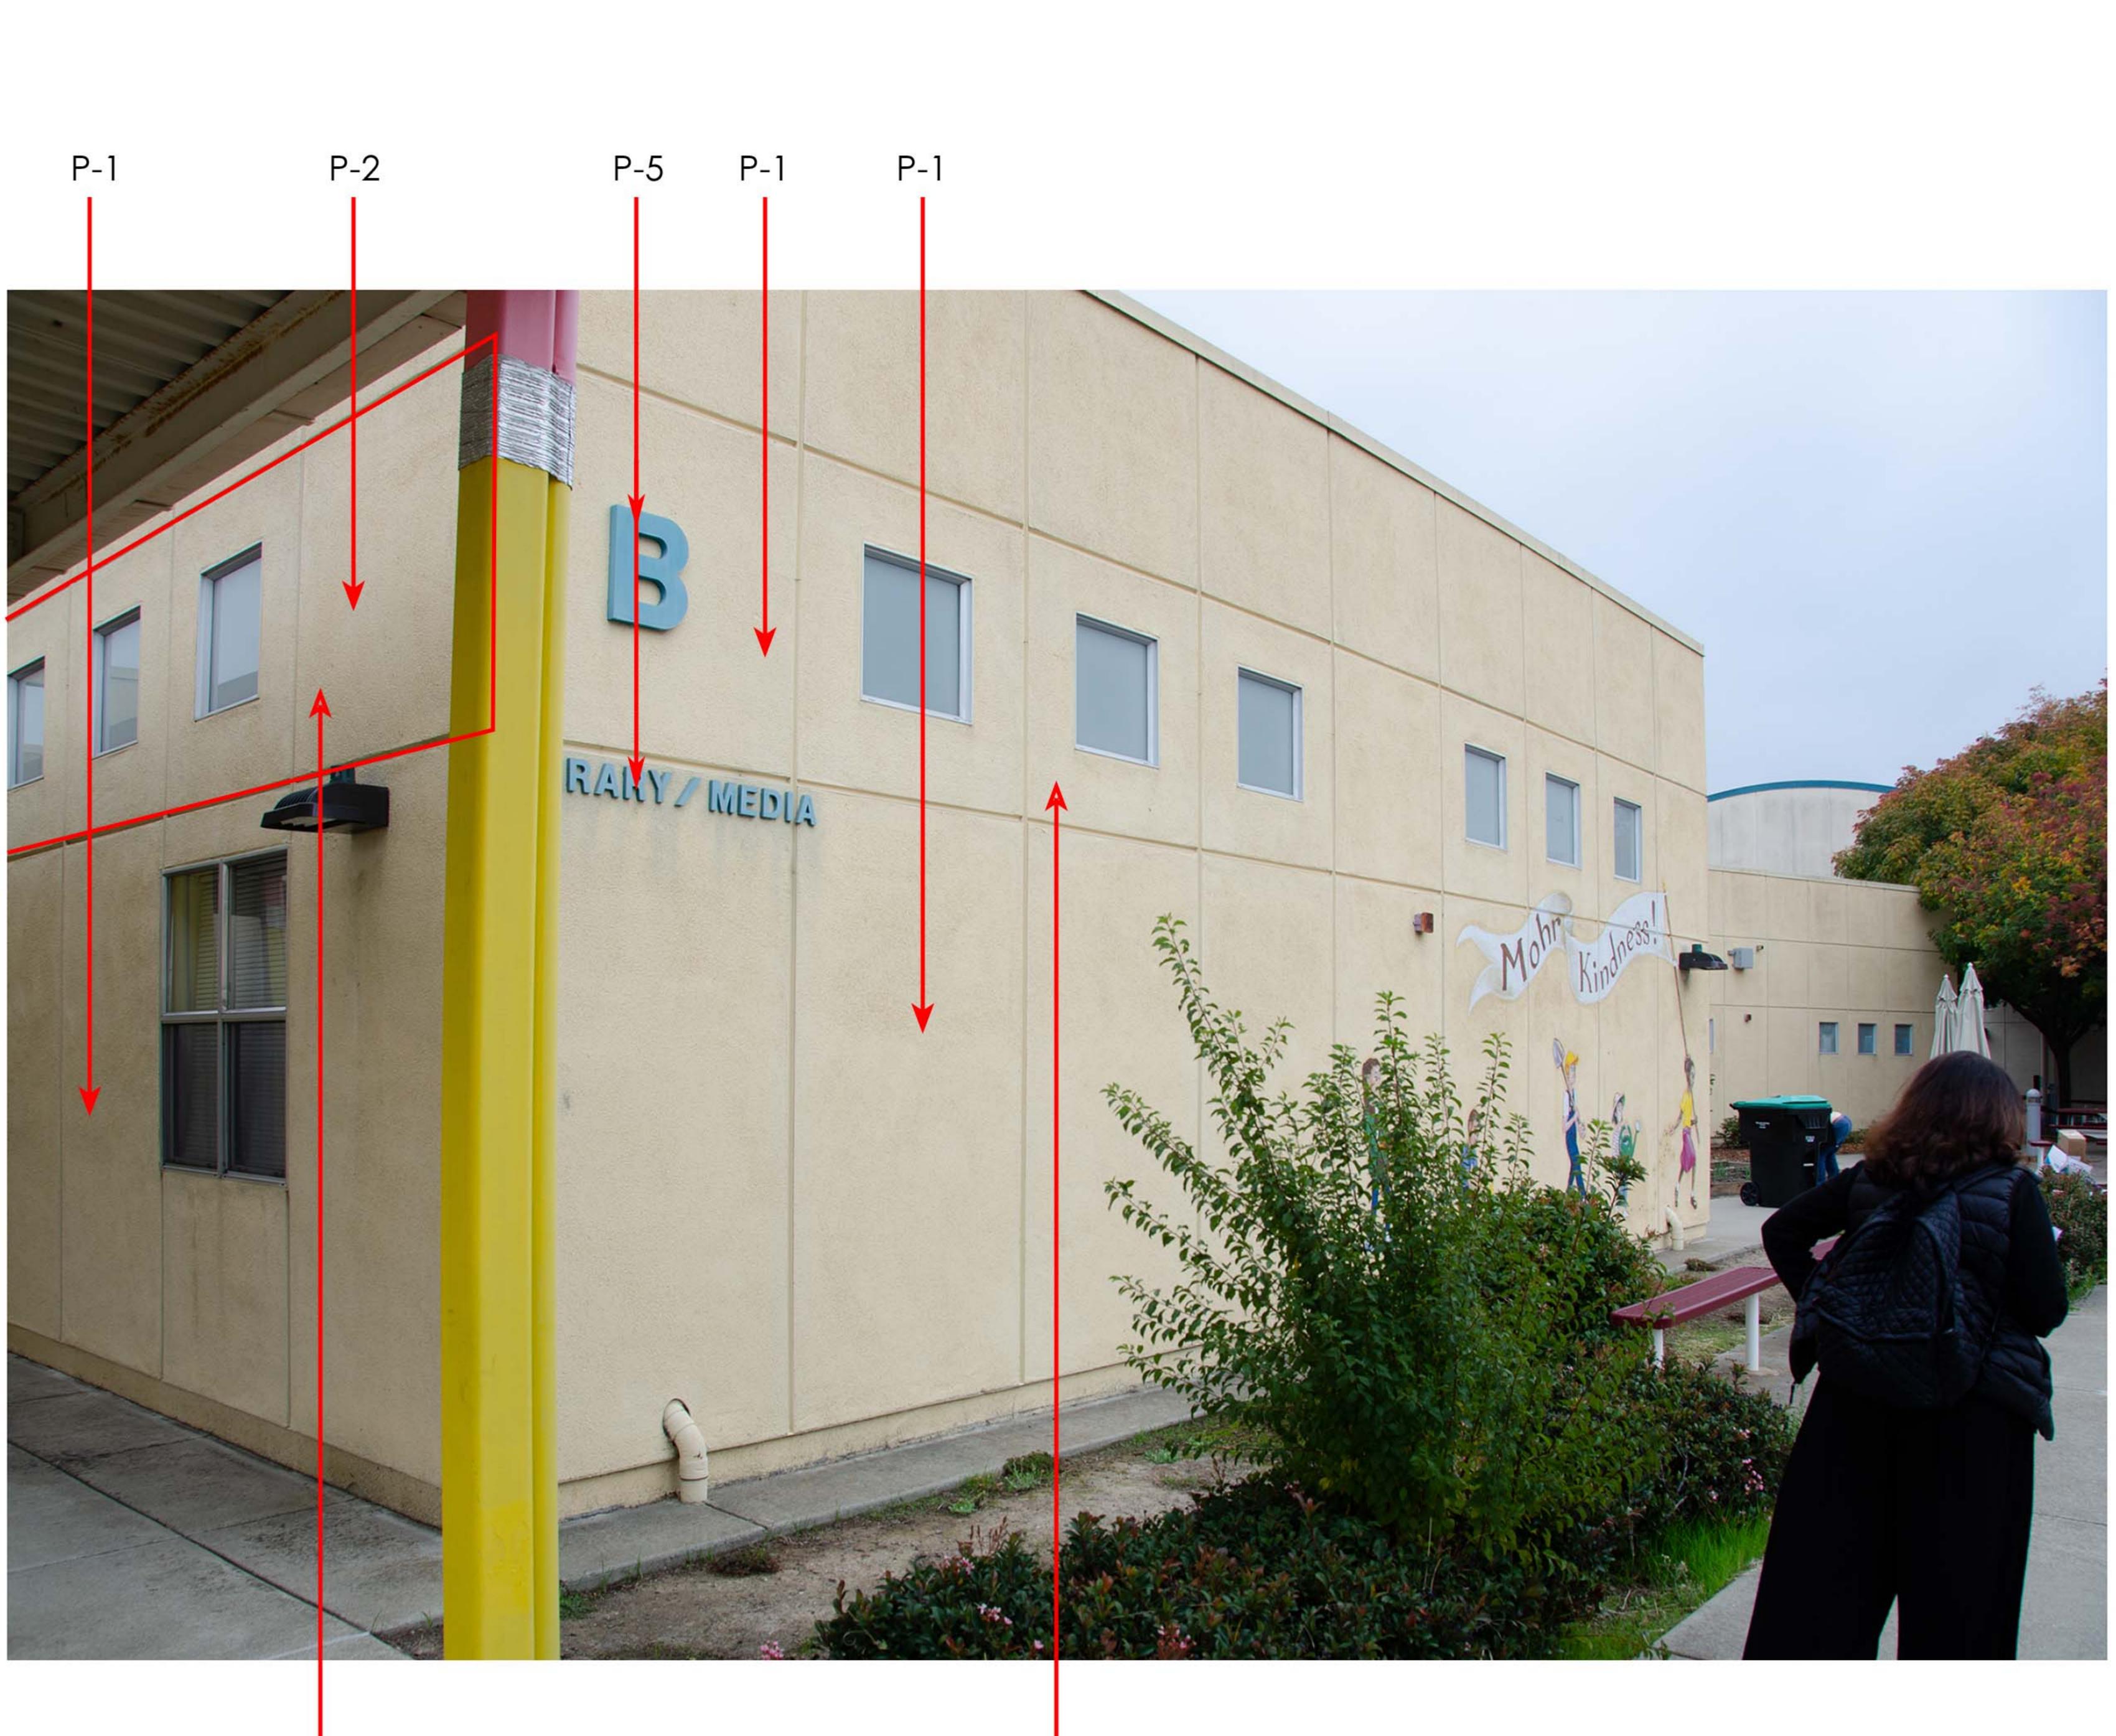


Banding resumes on this face.

This face of building B does not include P-2 banding due to the mural.

Building B



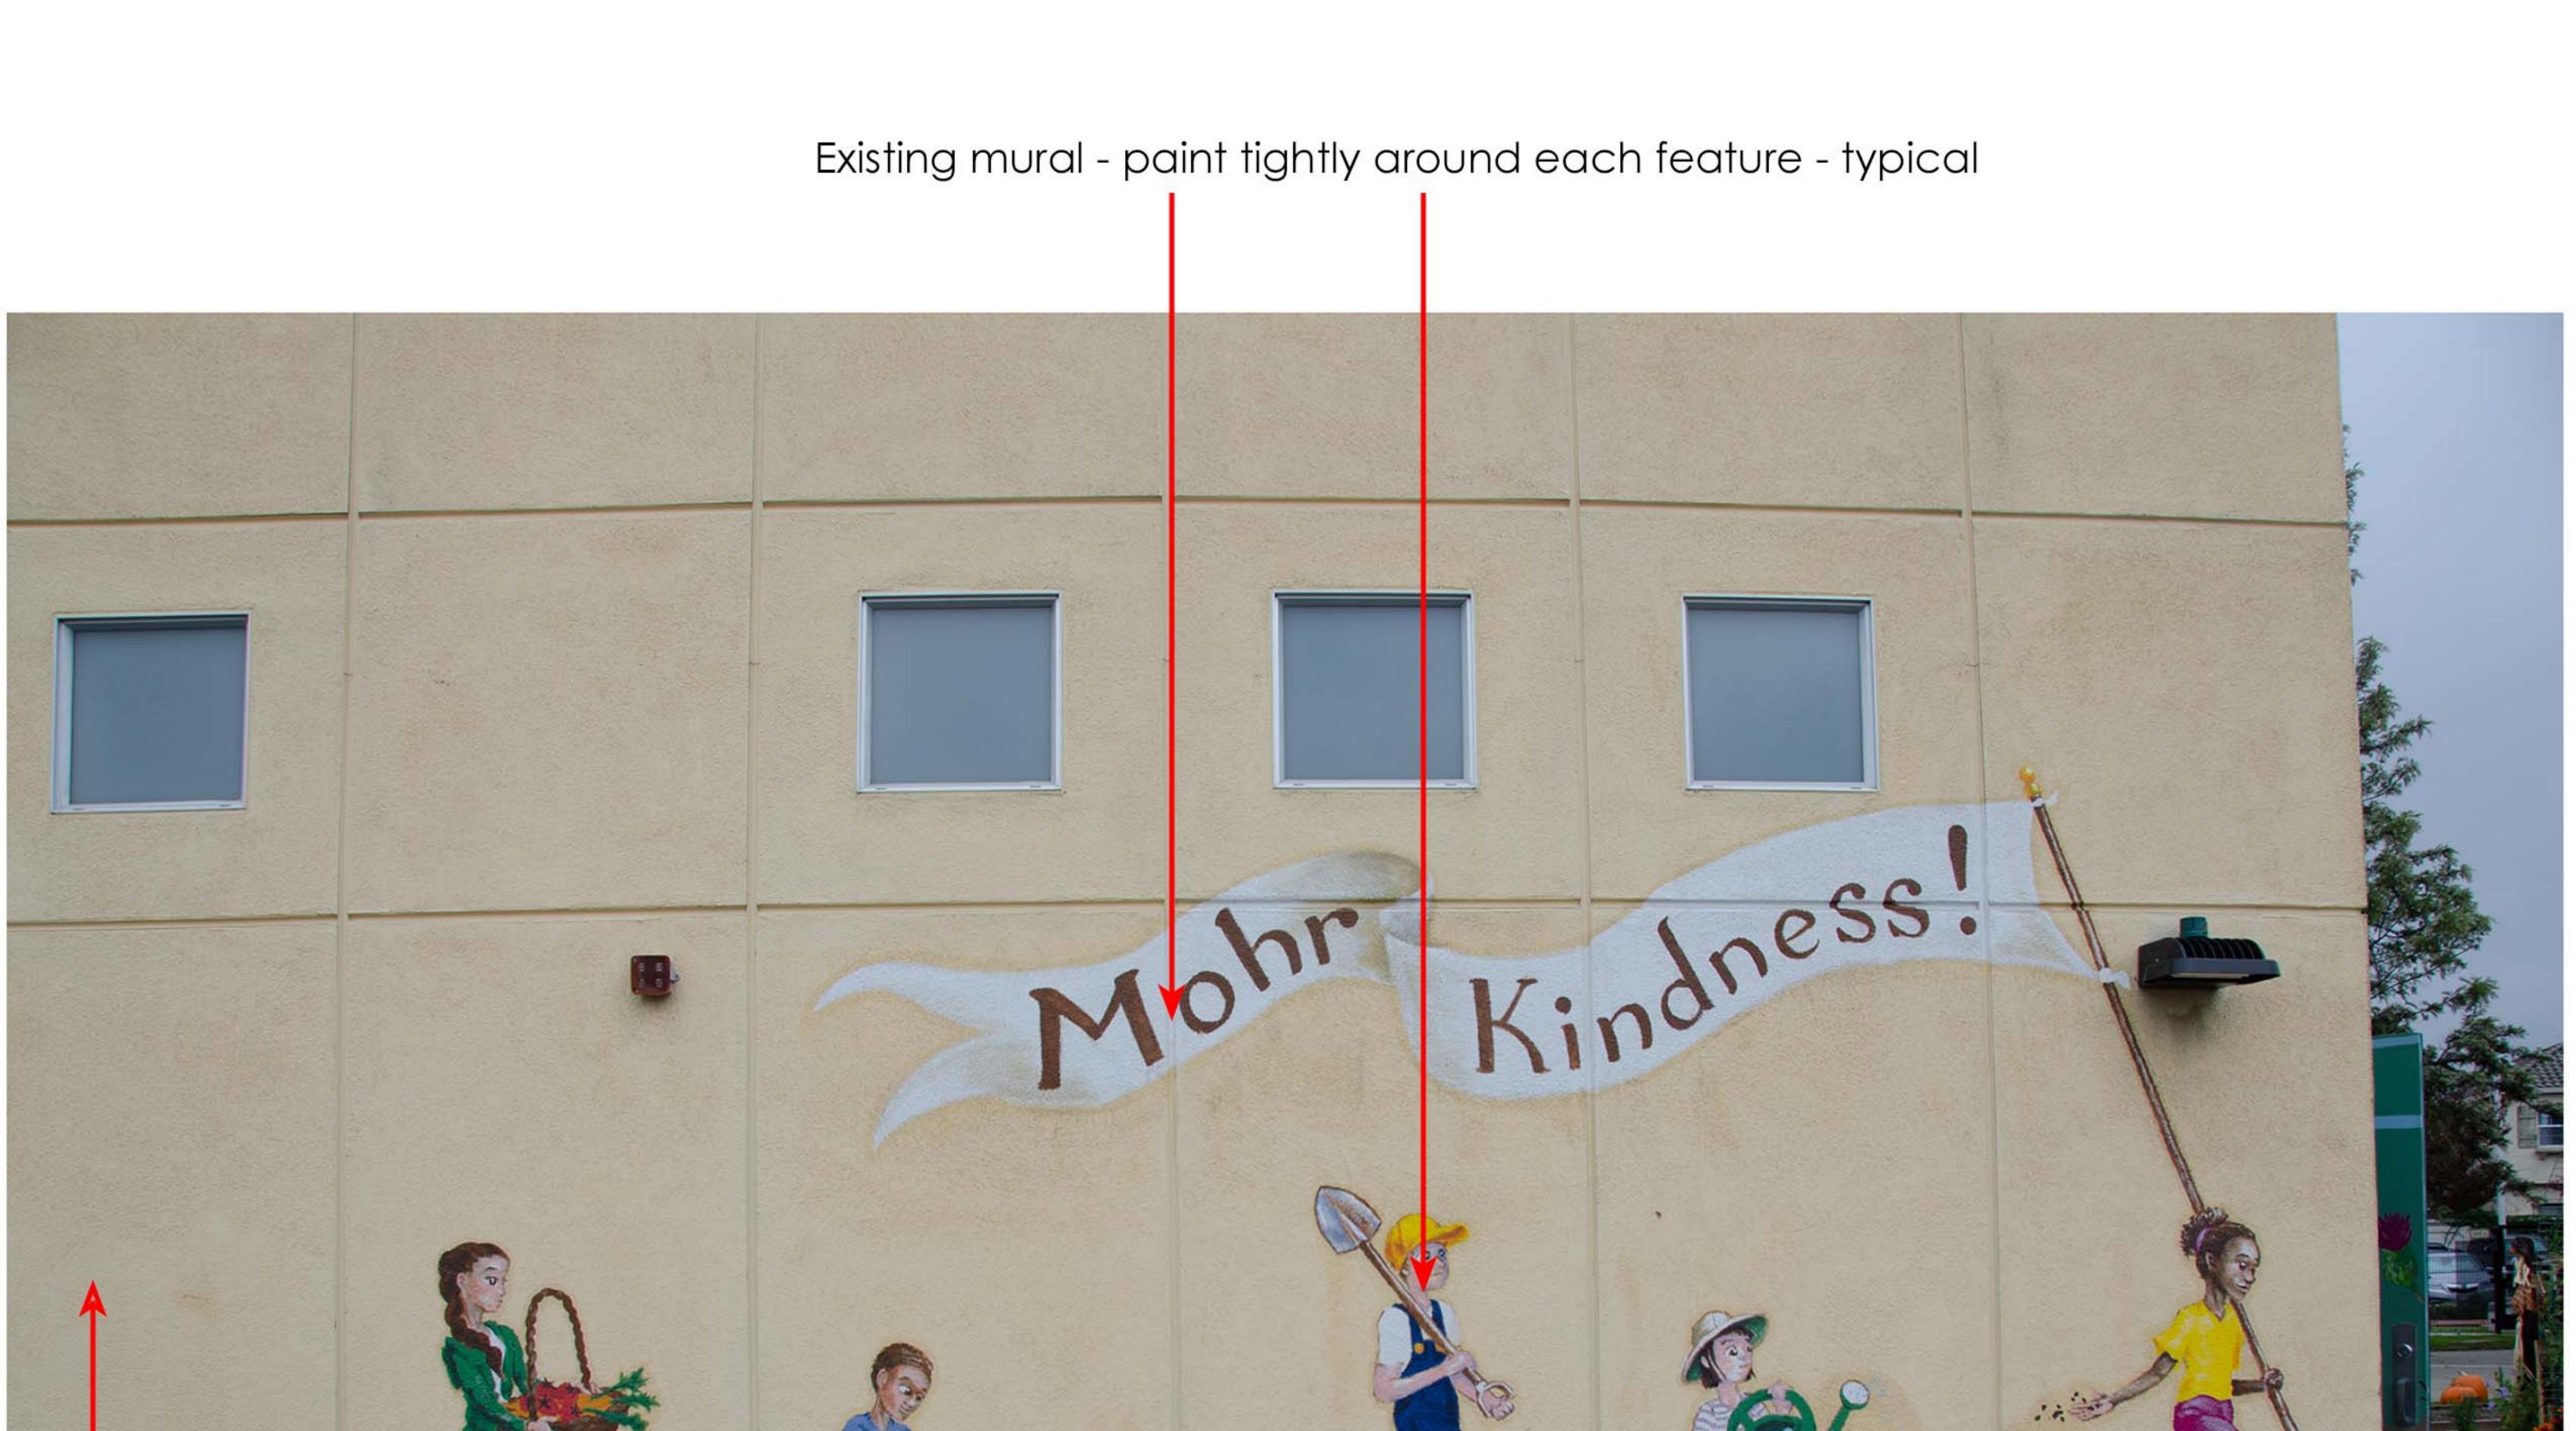

P-1 to be painted tightly around existing mural

Paint over plants, water, and seeds with wall color. School will have artist repaint new plants, water, and seeds.


Building B





Building B



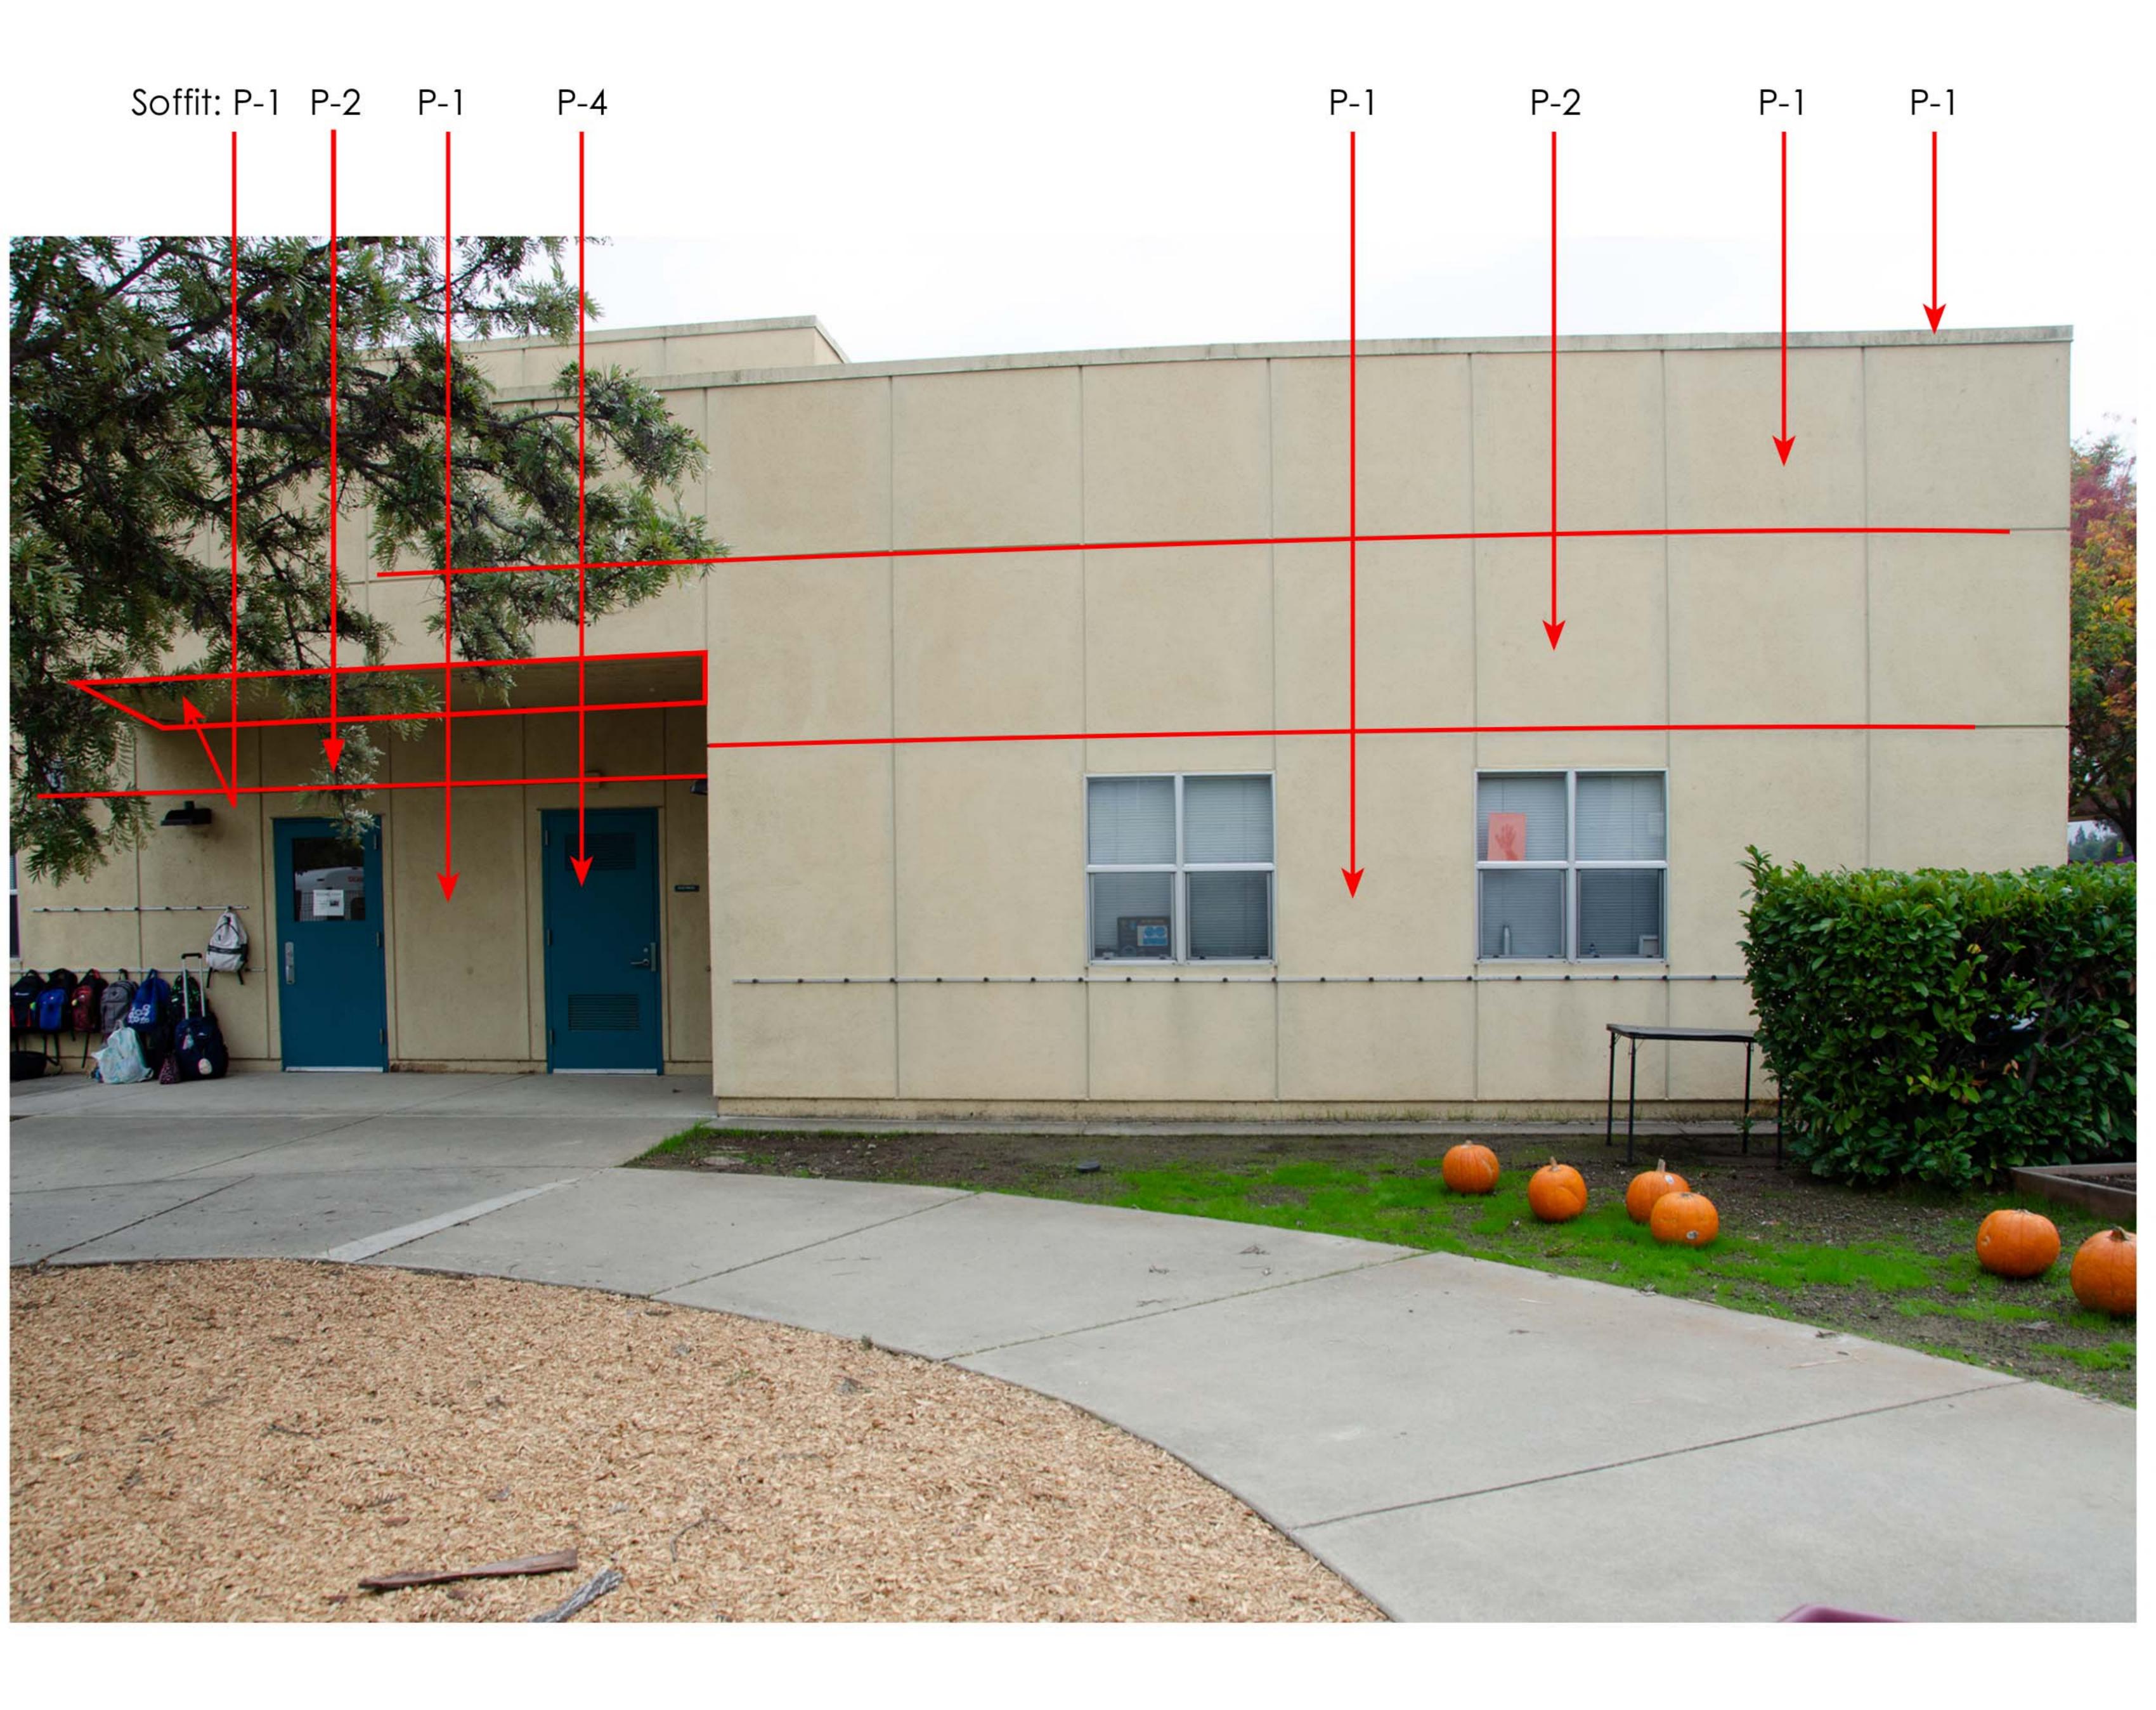


Building C






Building C



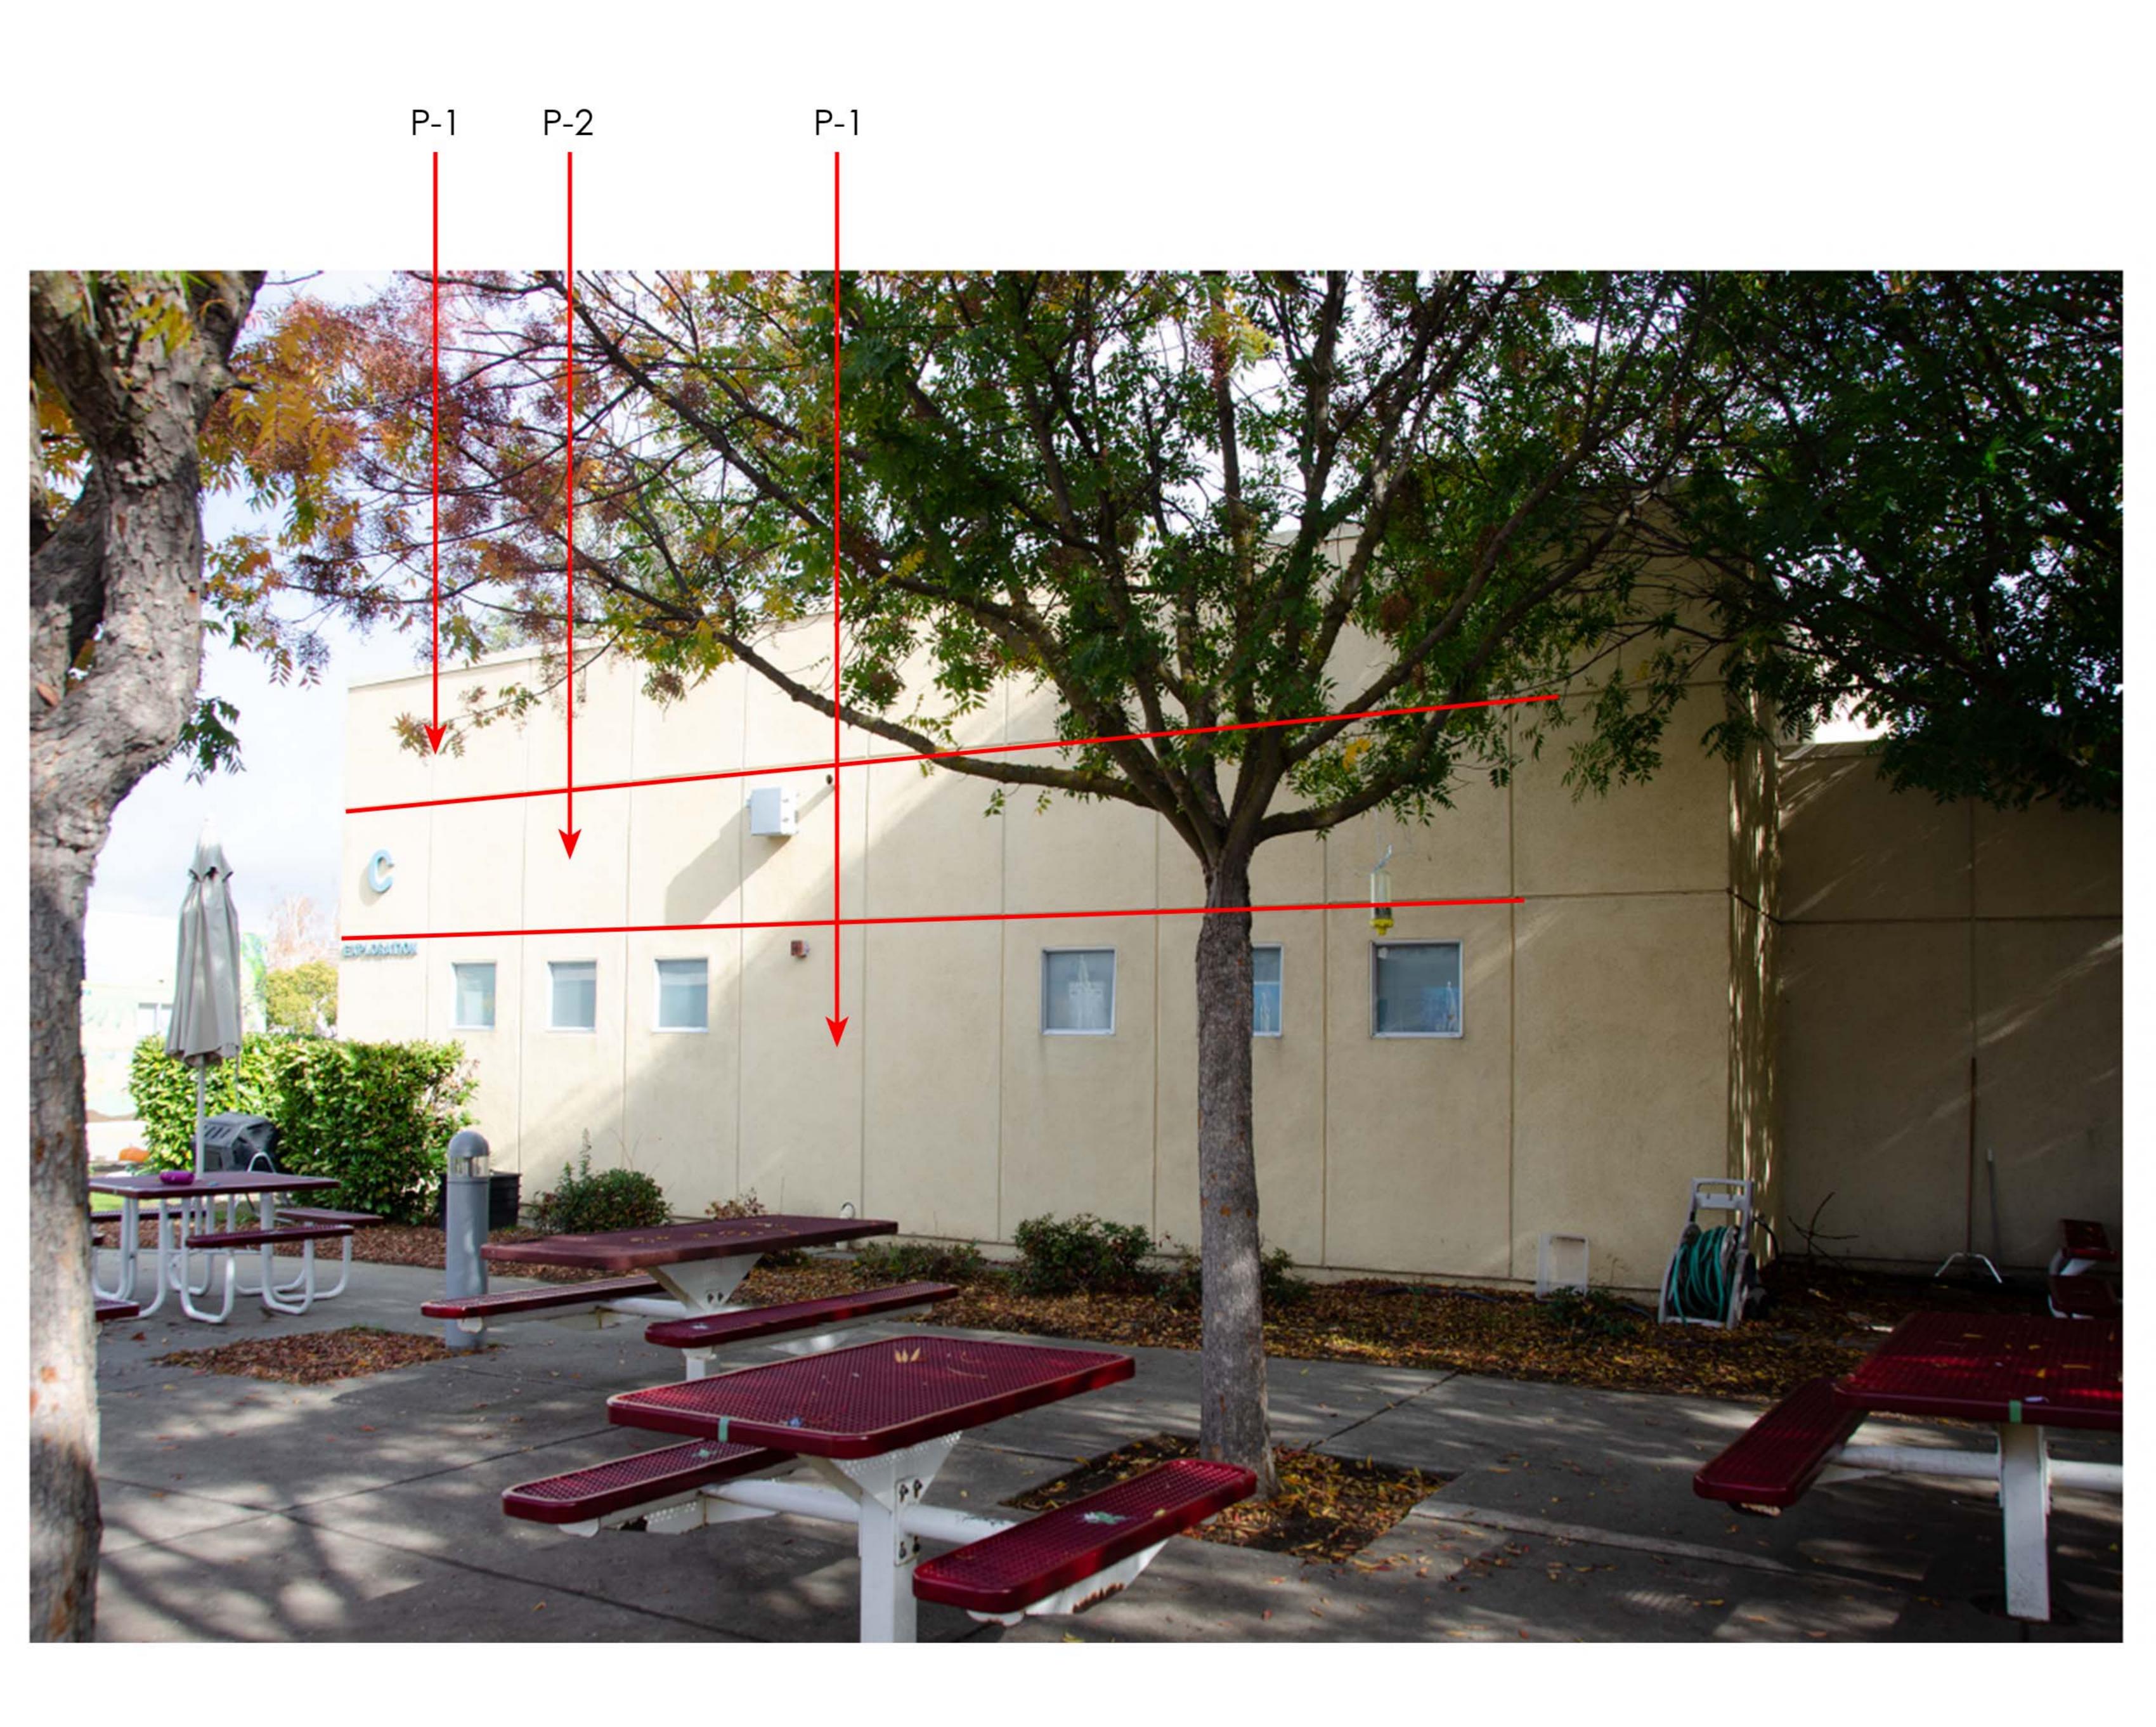


Building C



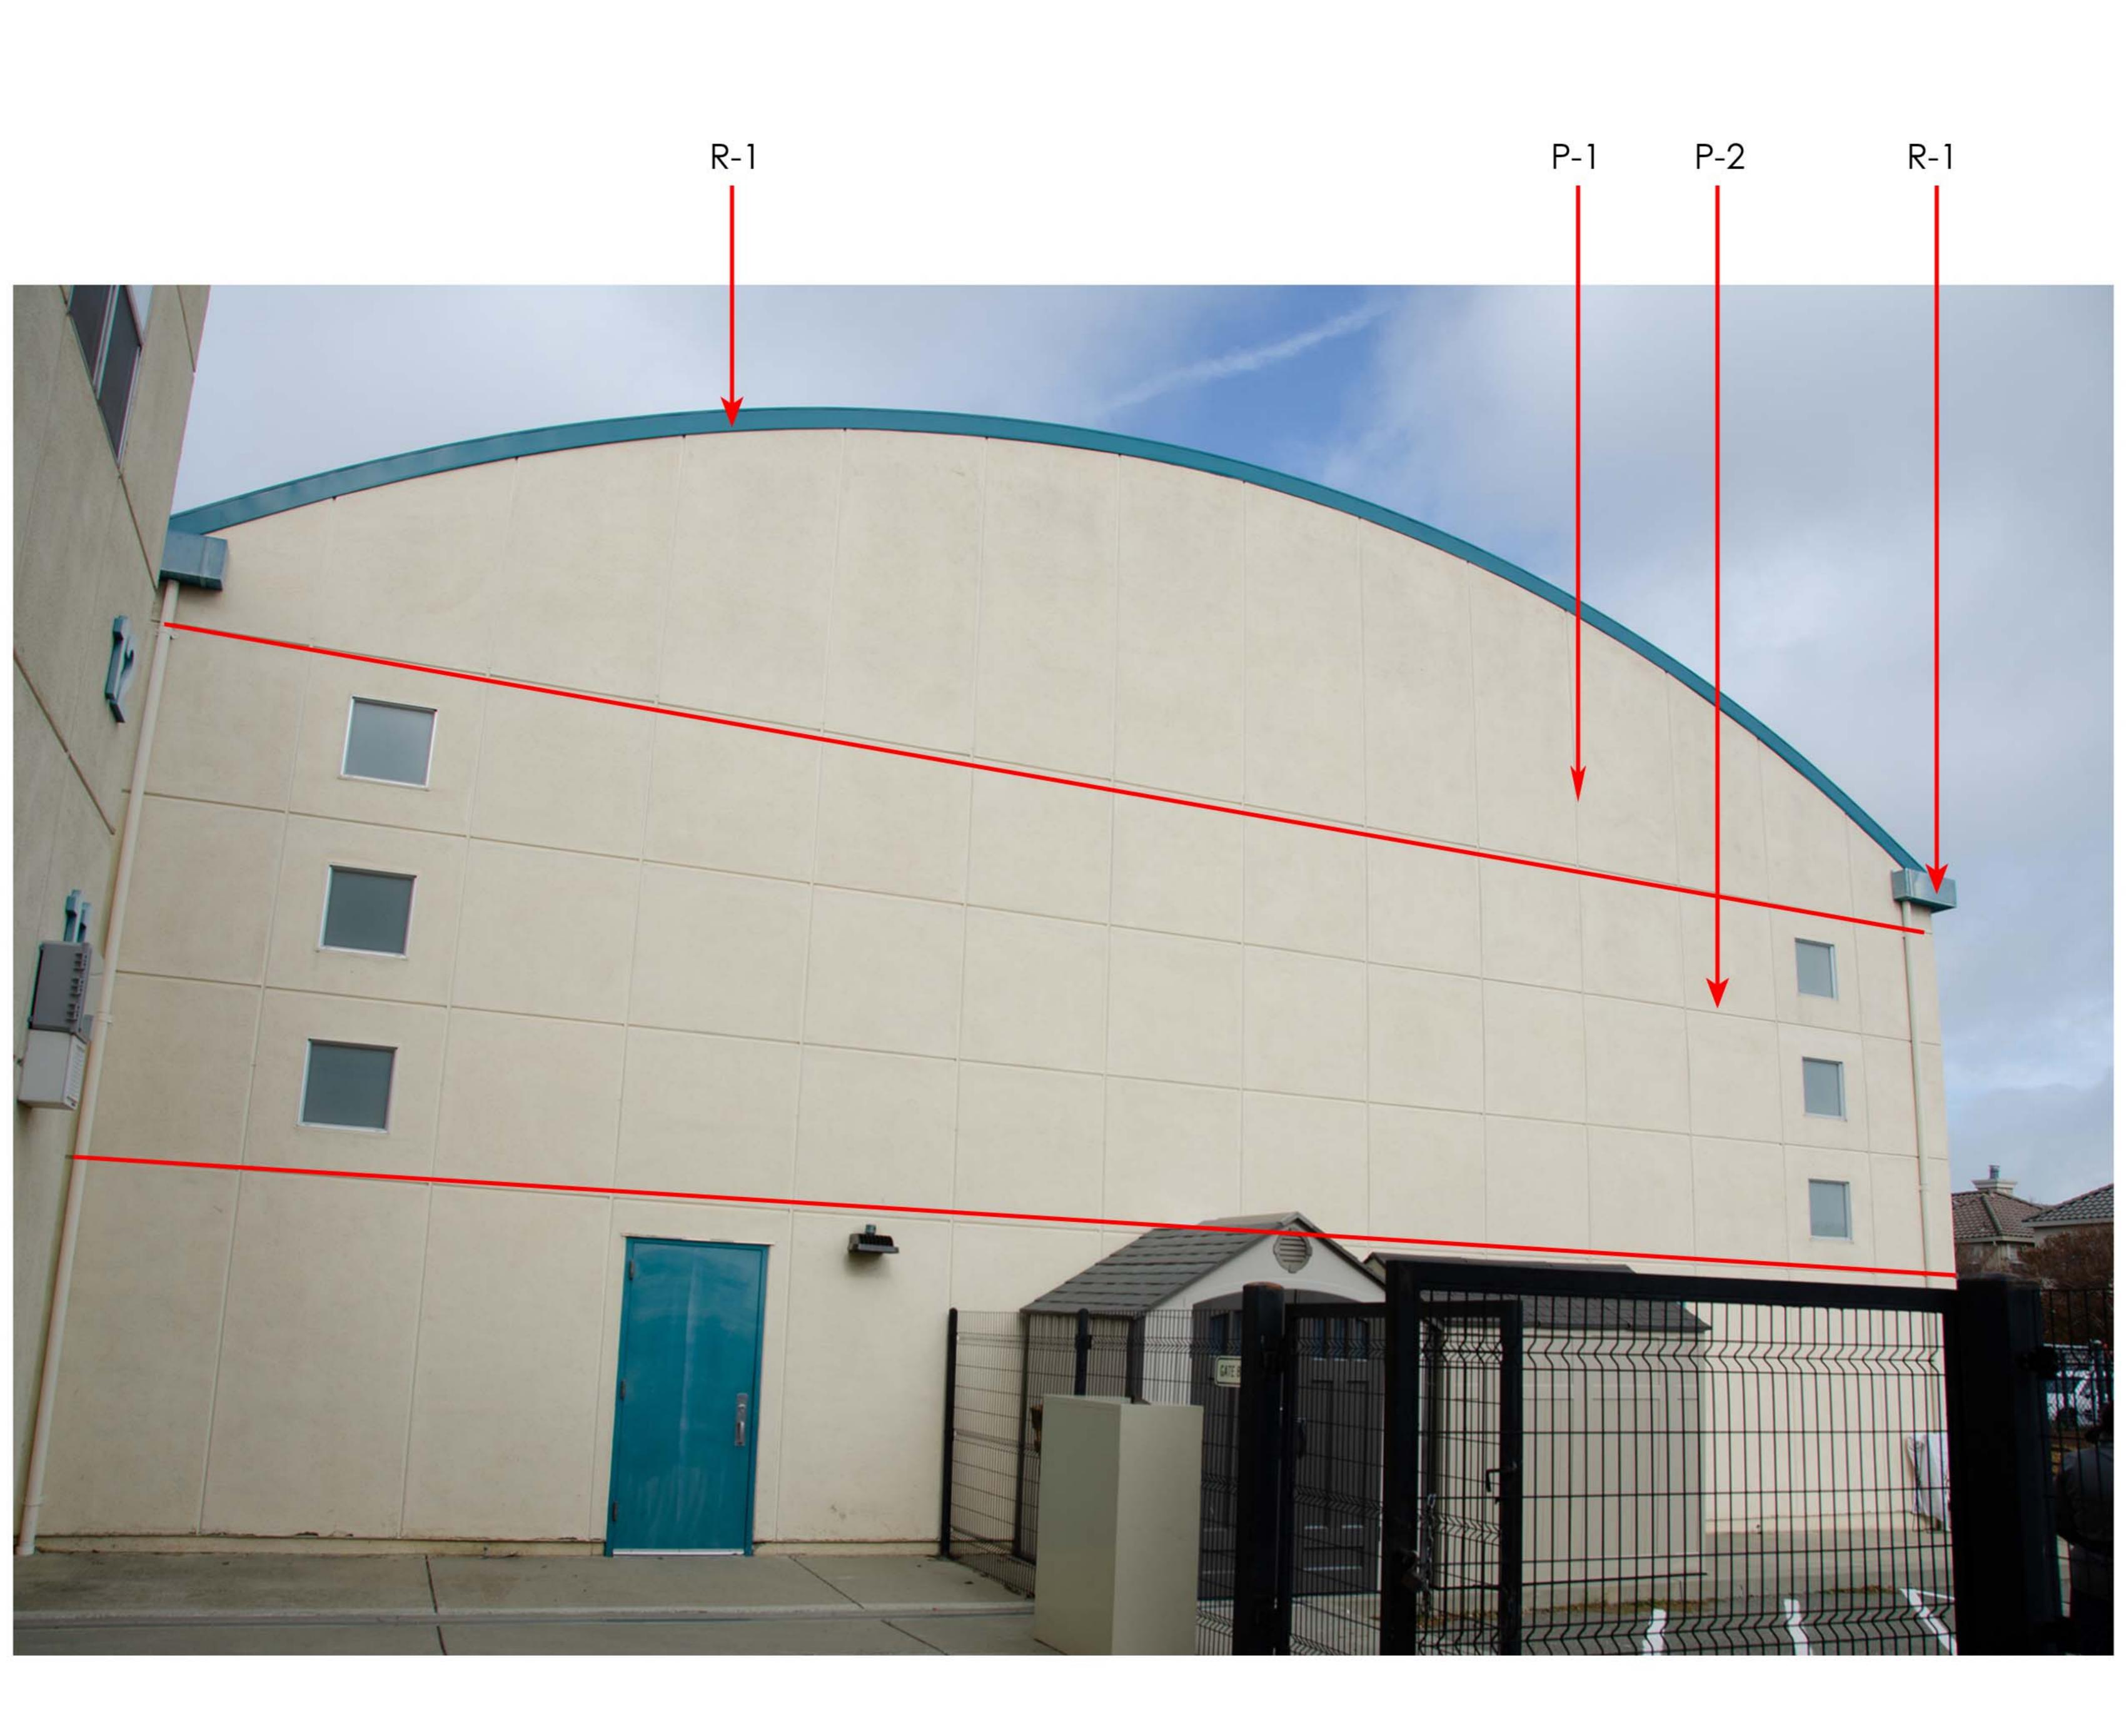




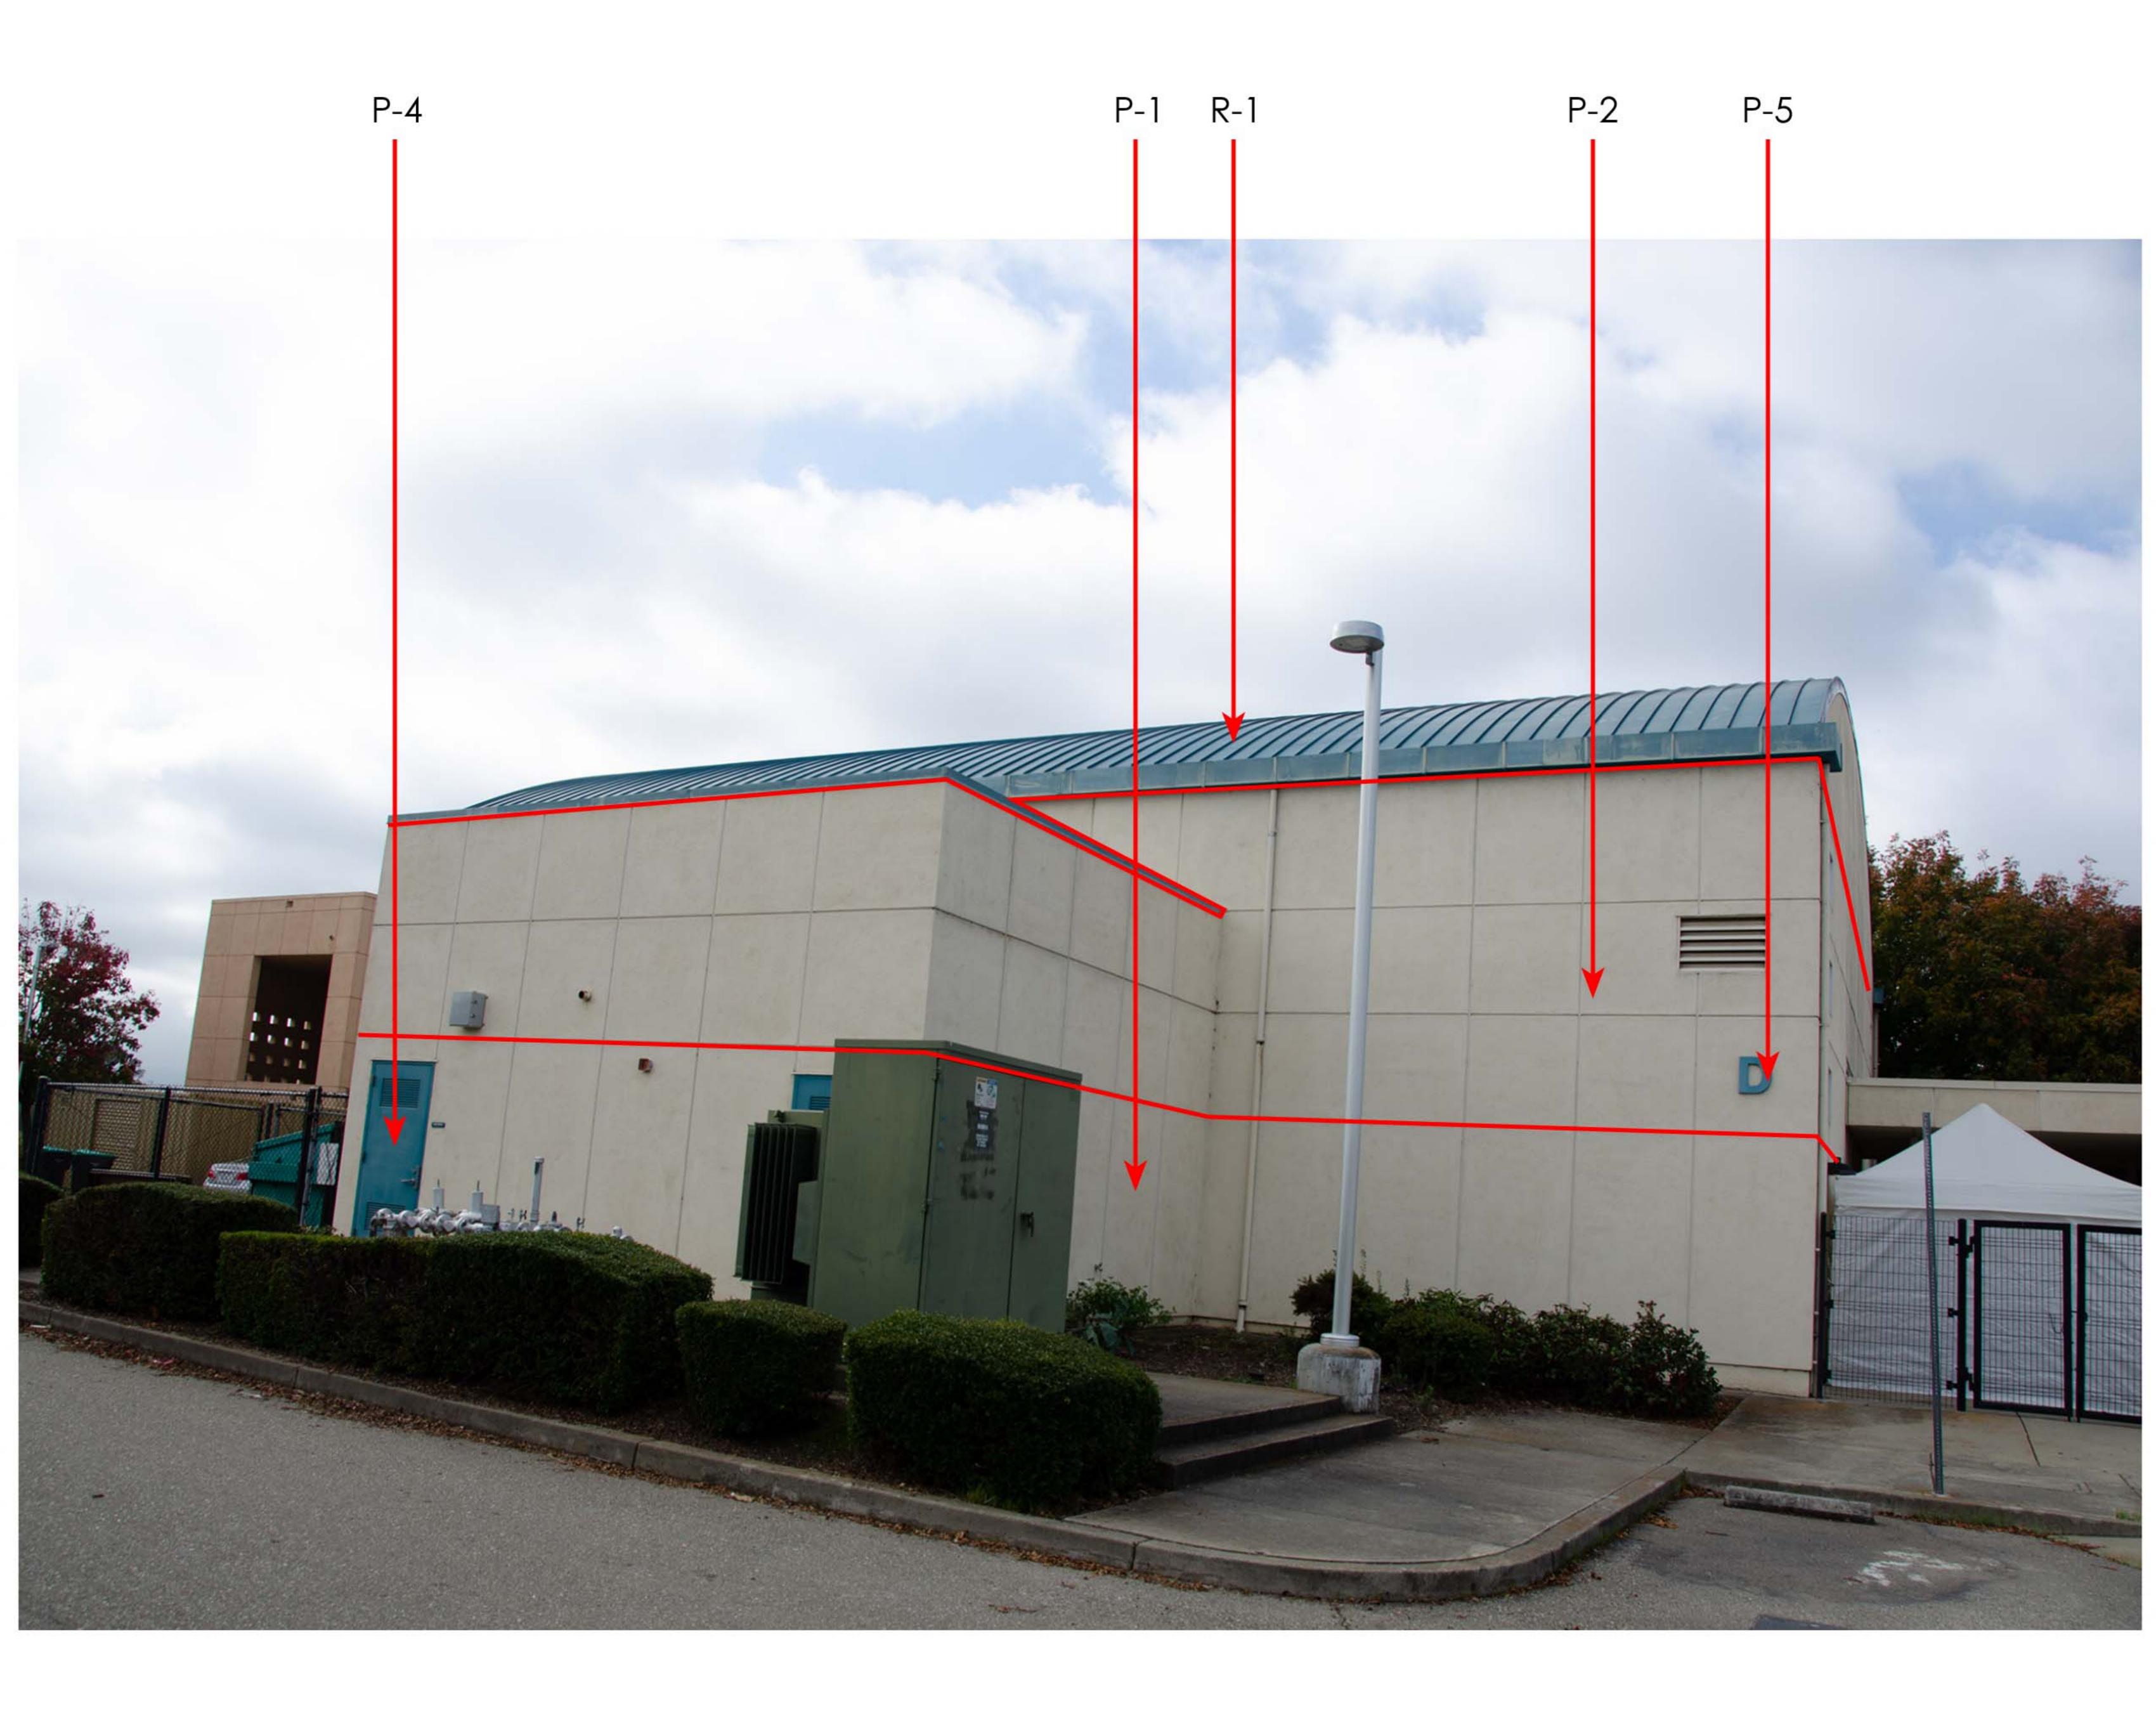








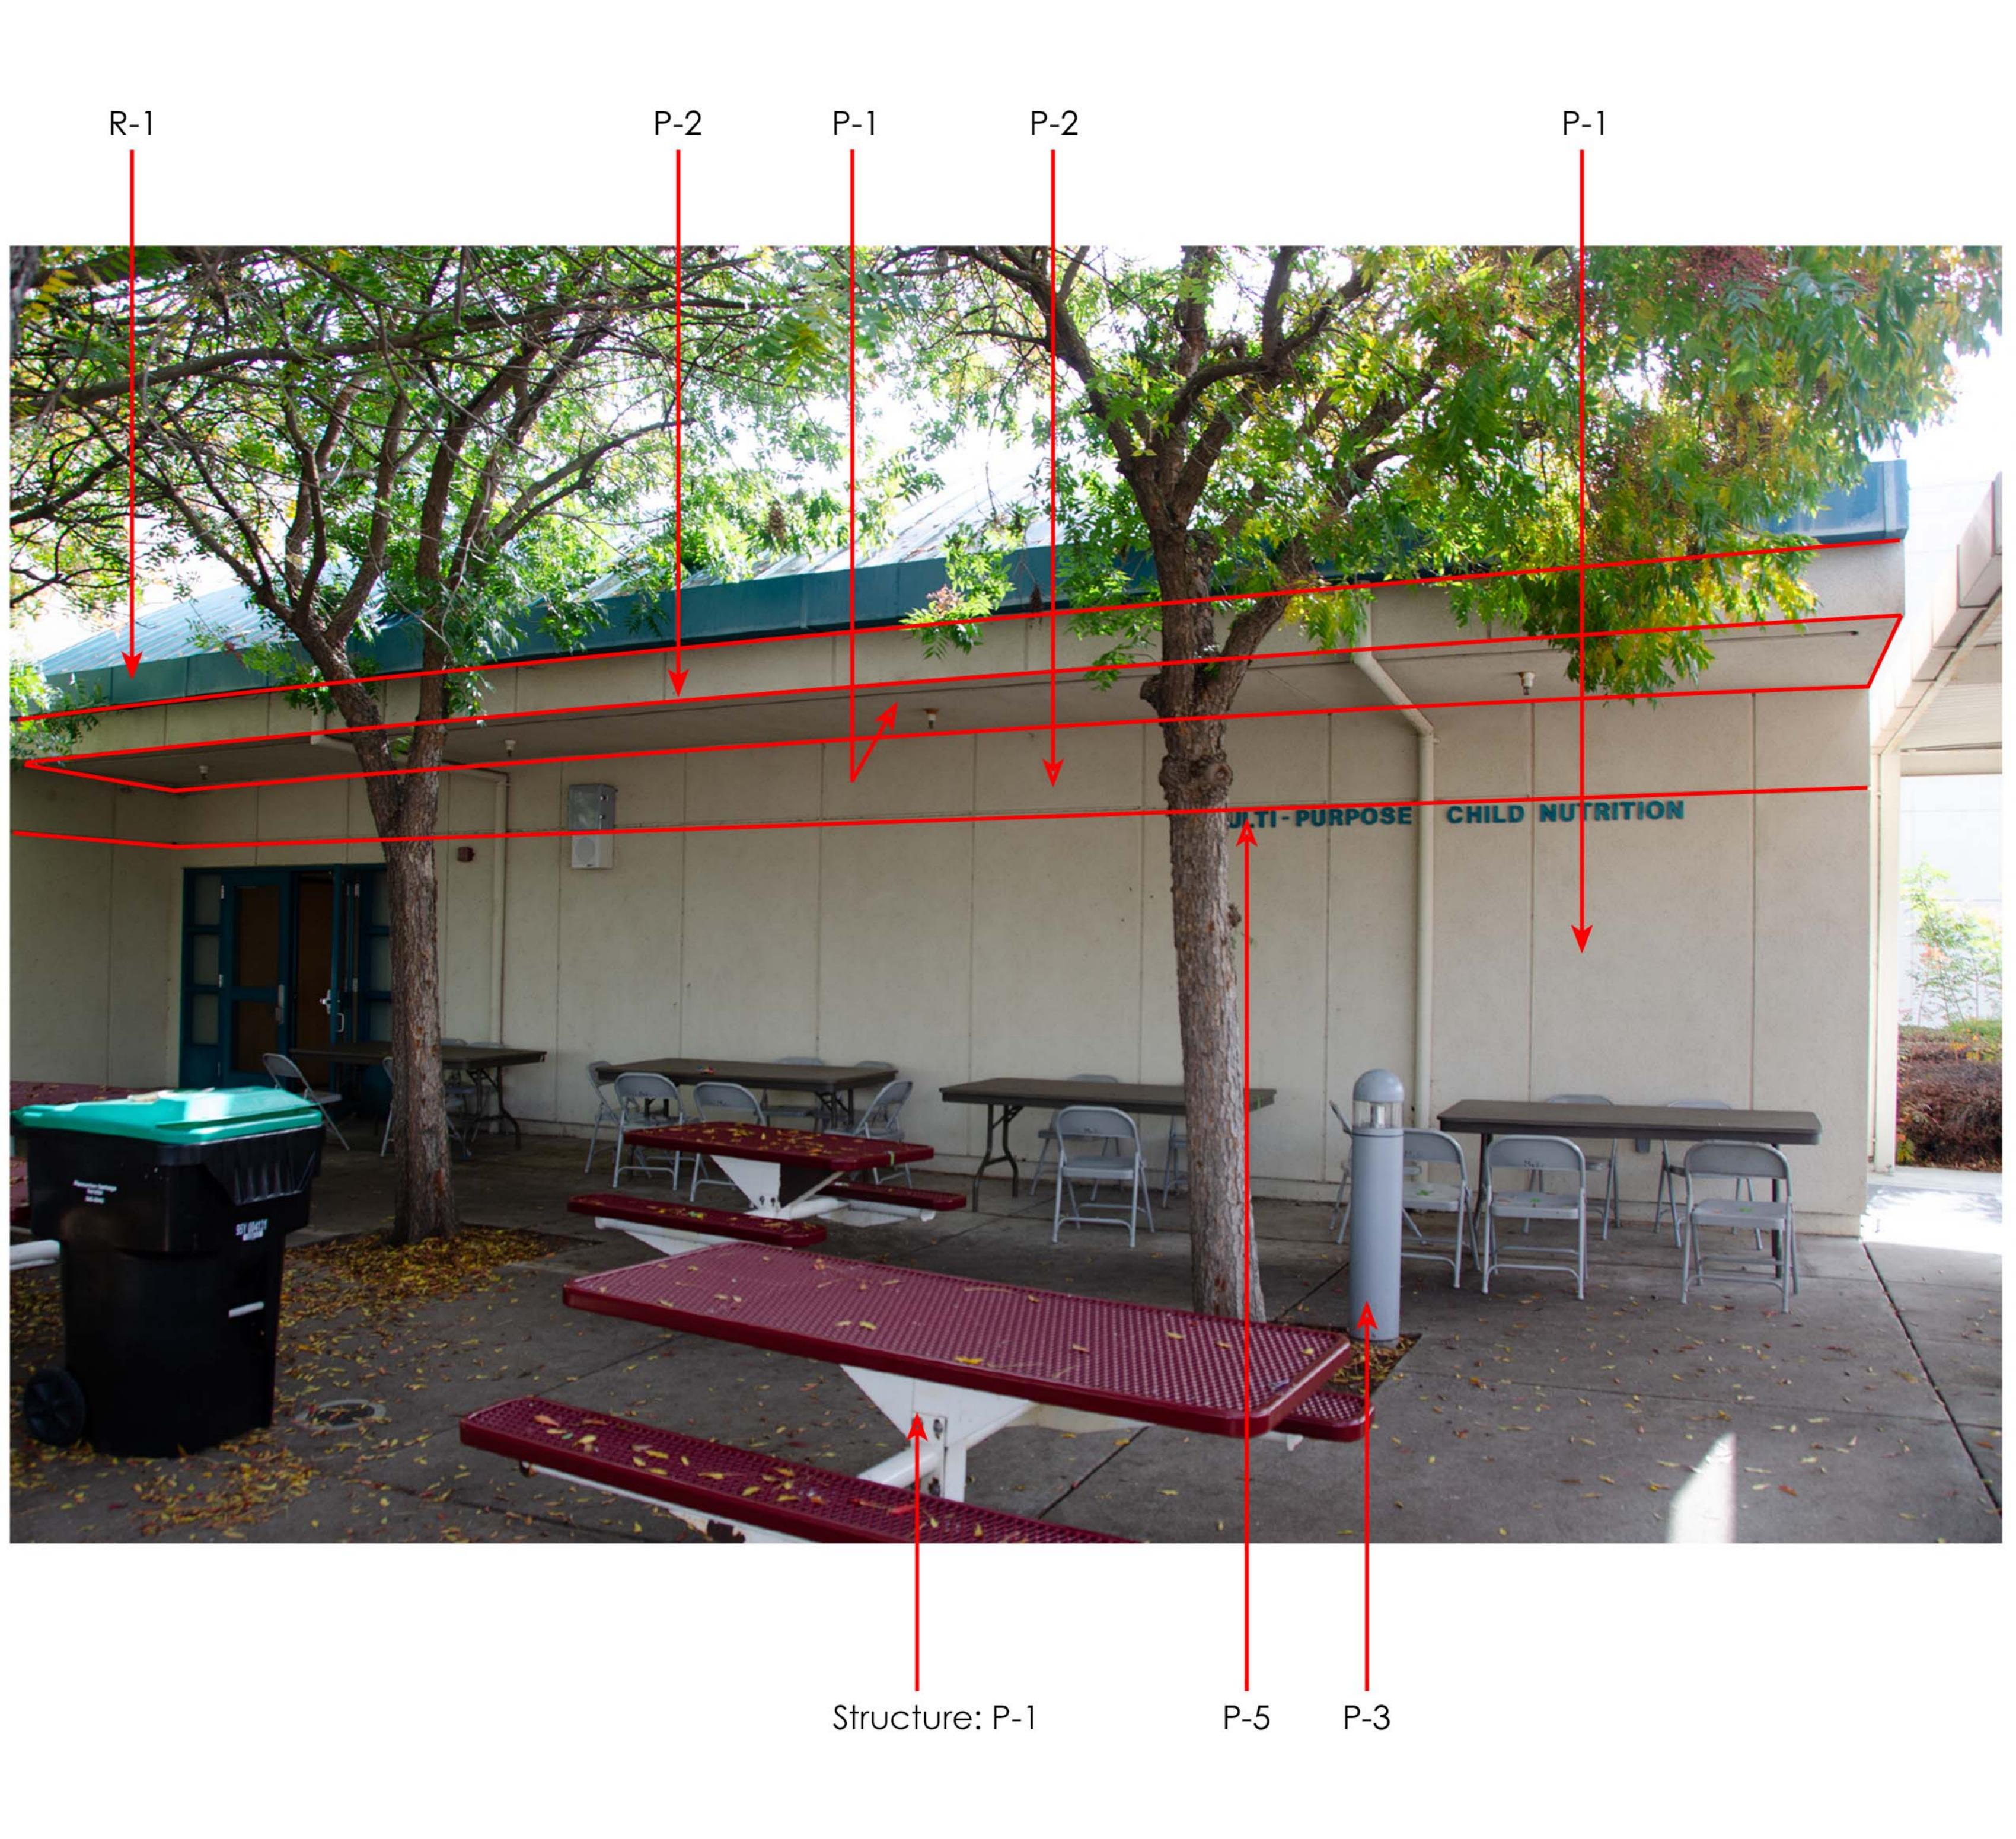




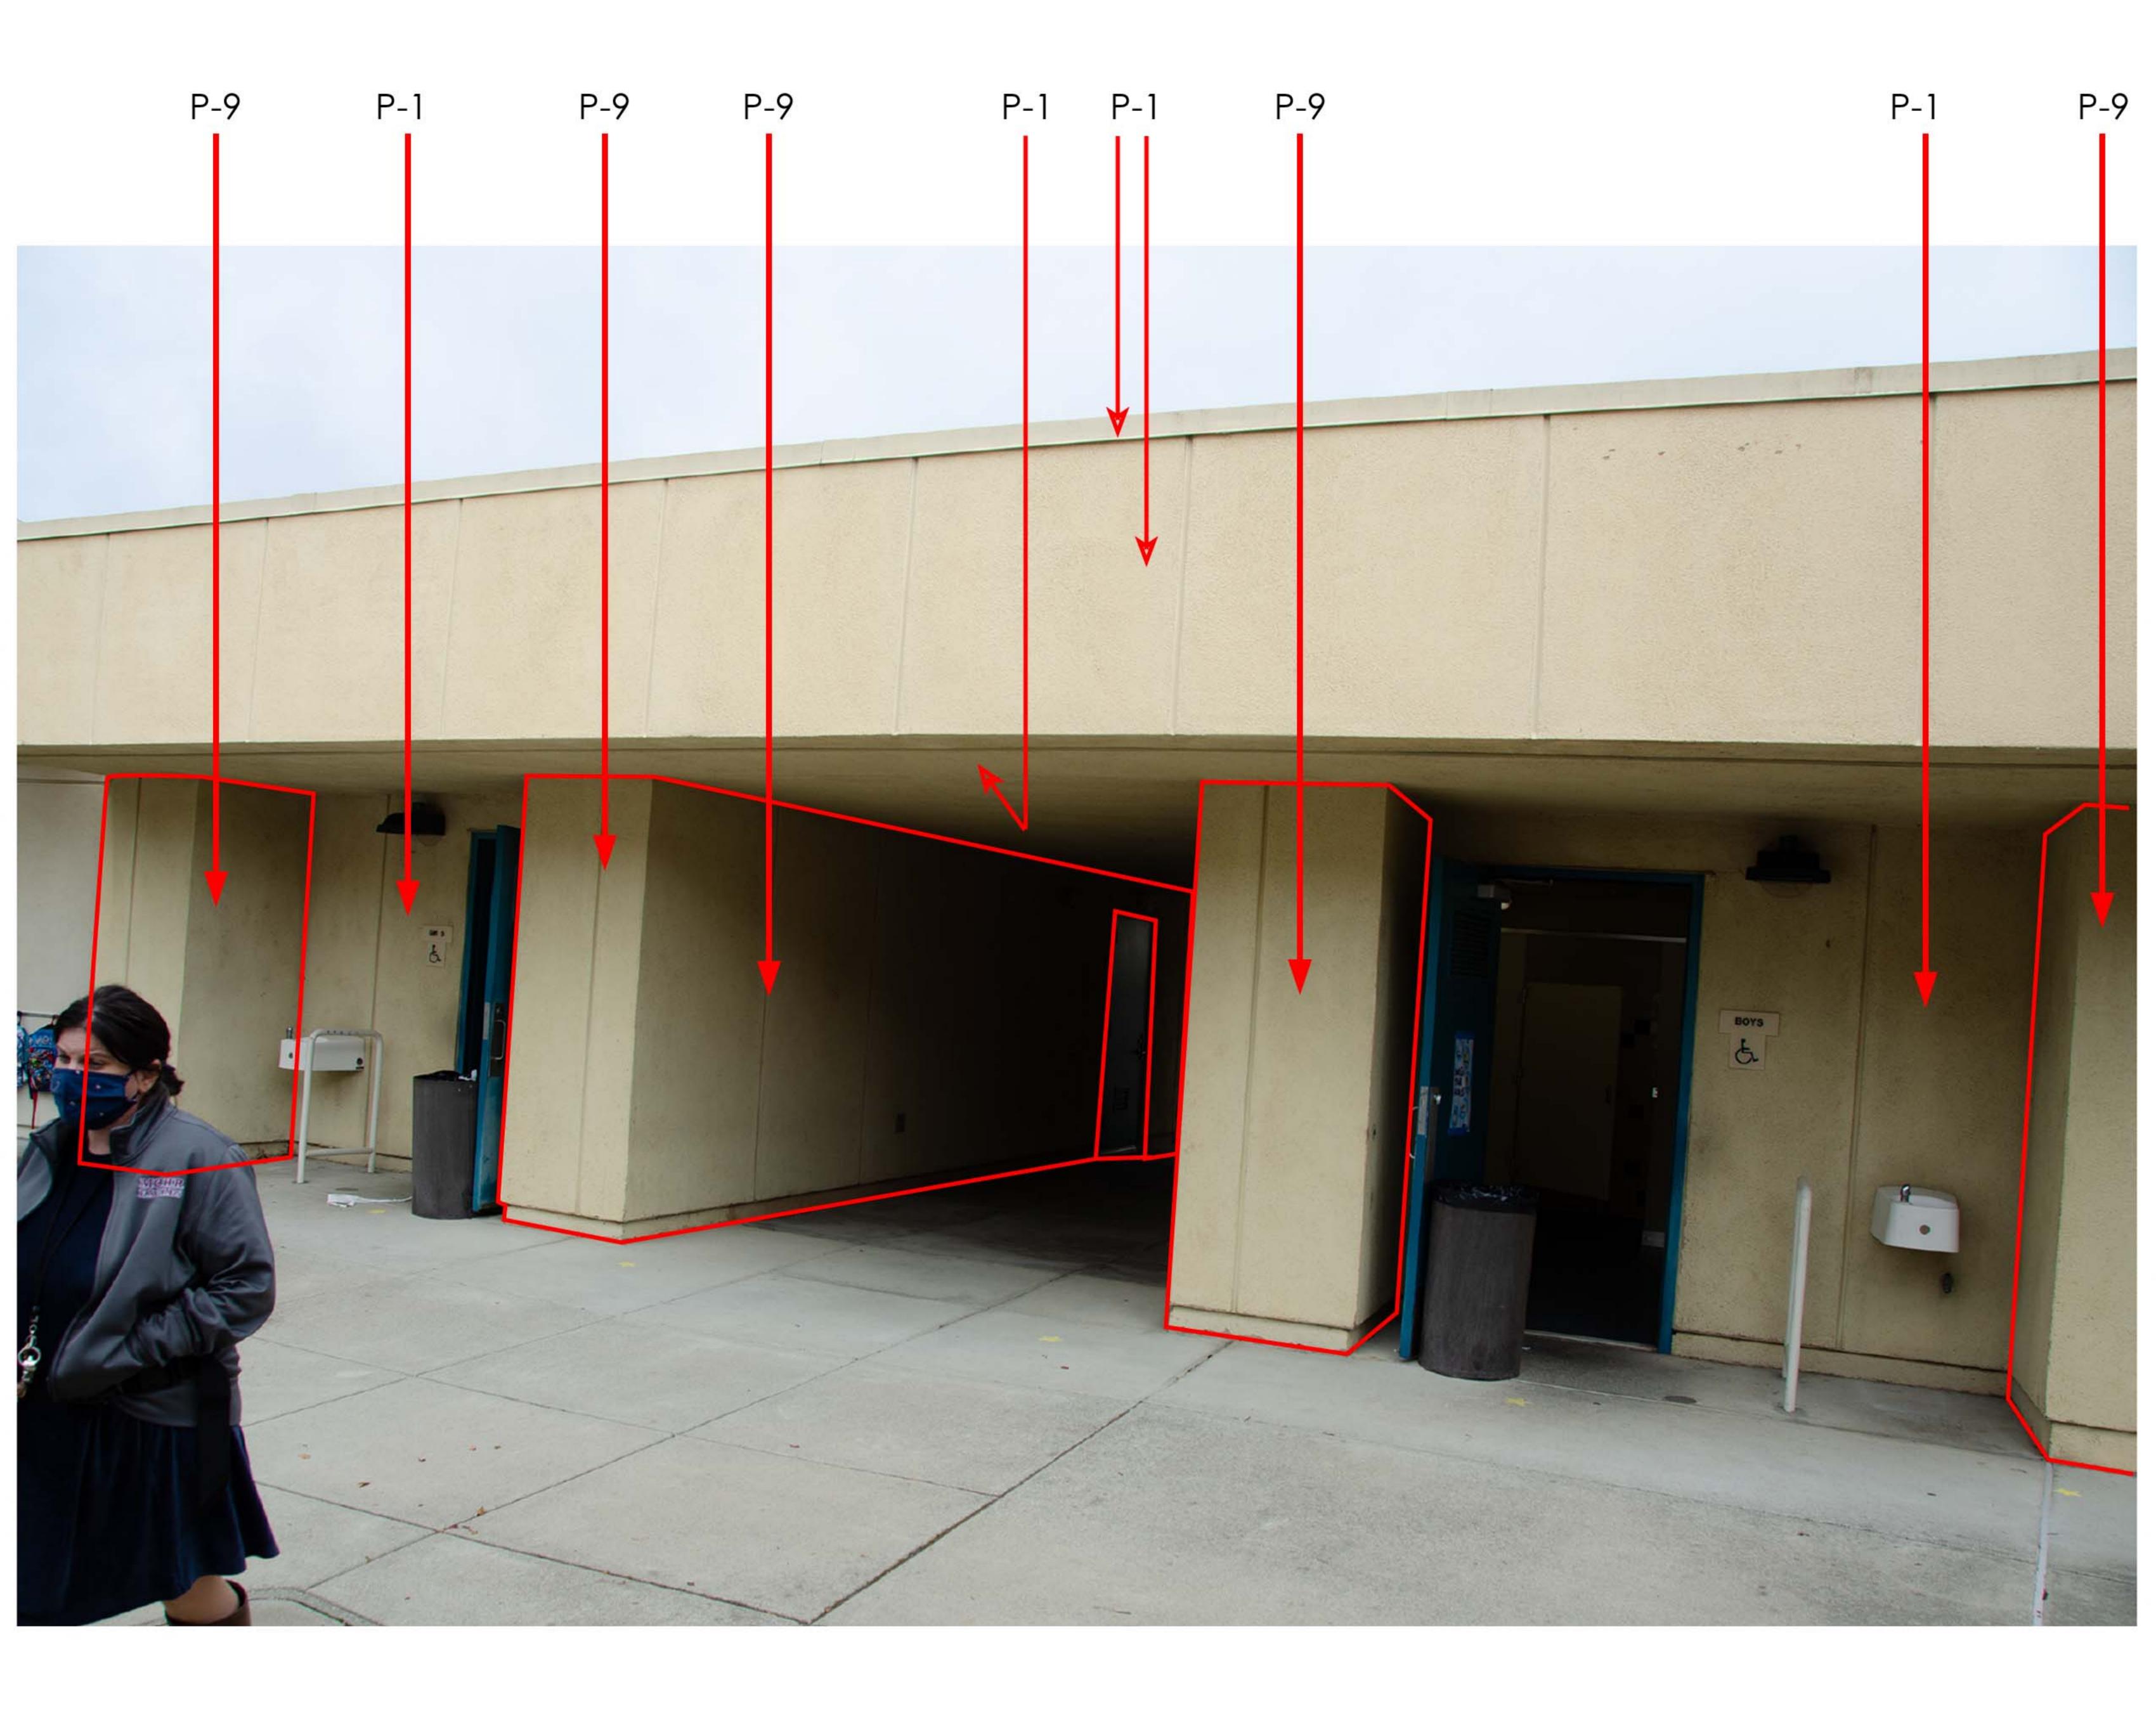

Building E / F

Note:


See rendering drawings for typical notes.
Paint existing building letters and number as indicated - typical
Buildings E and F recieve same paint placement

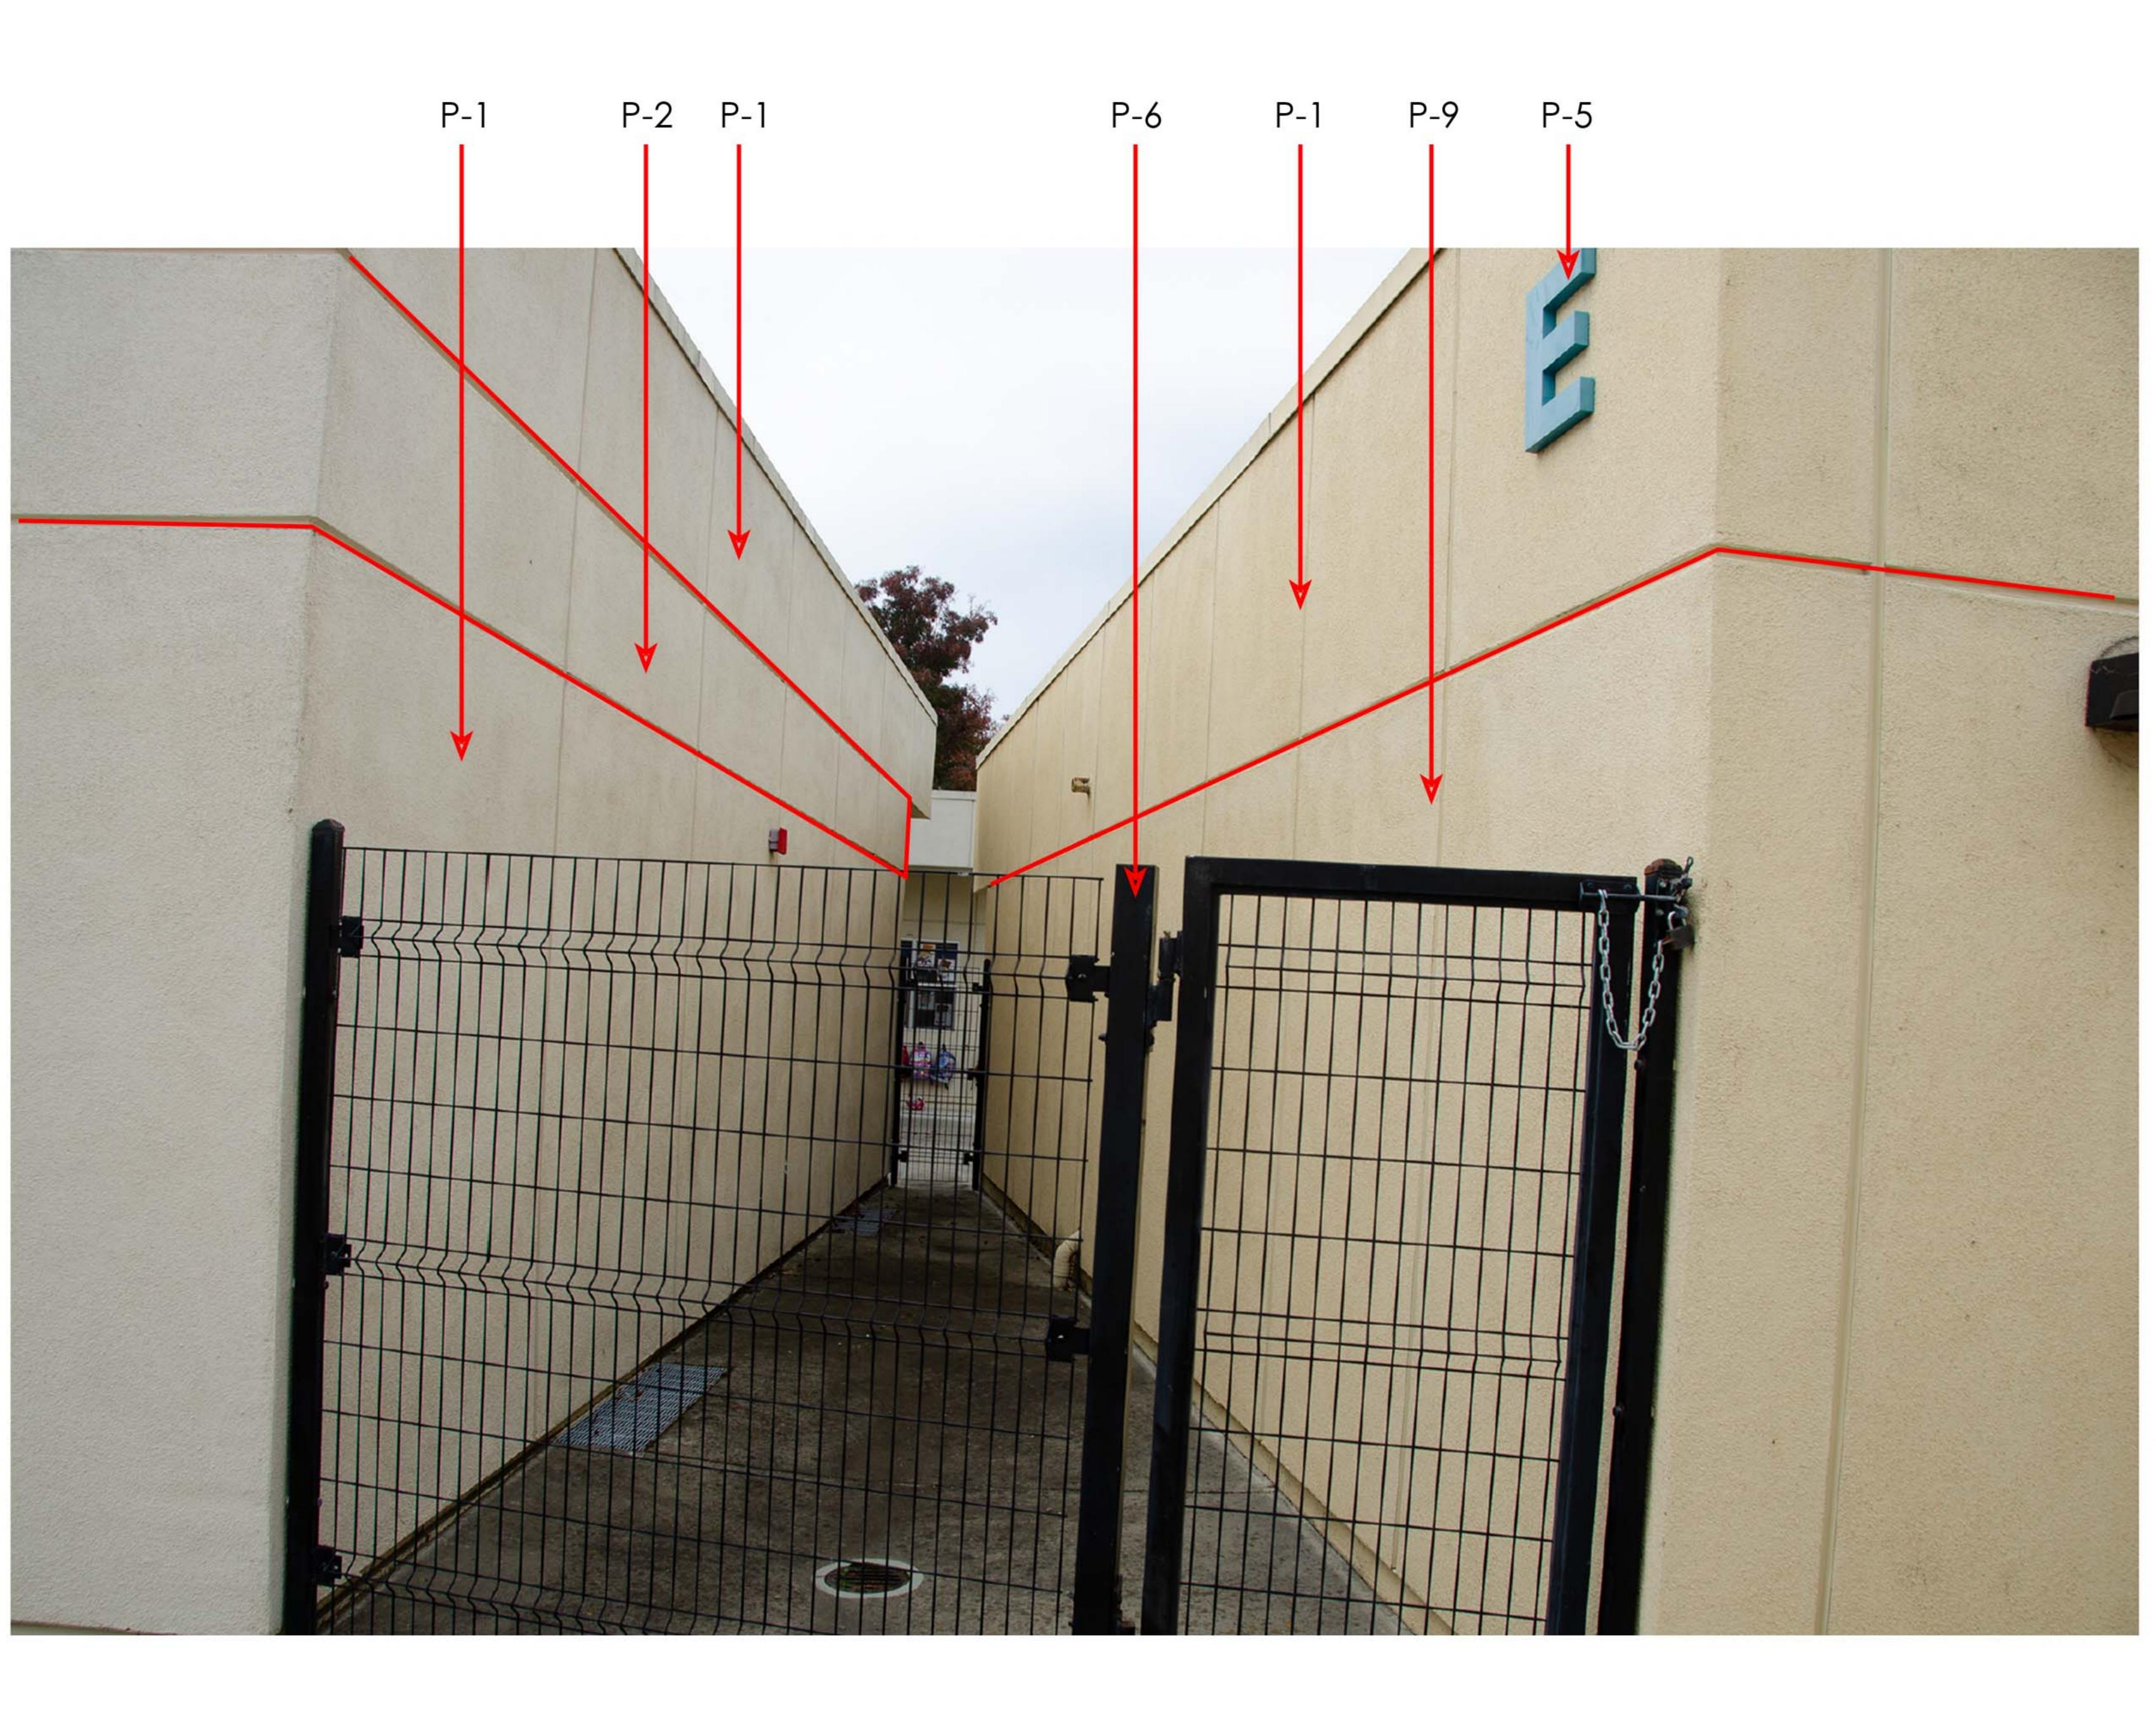

Building E / F


Note:

See rendering drawings for typical notes.
Paint existing building letters and number as indicated - typical
Buildings E and F recieve same paint placement

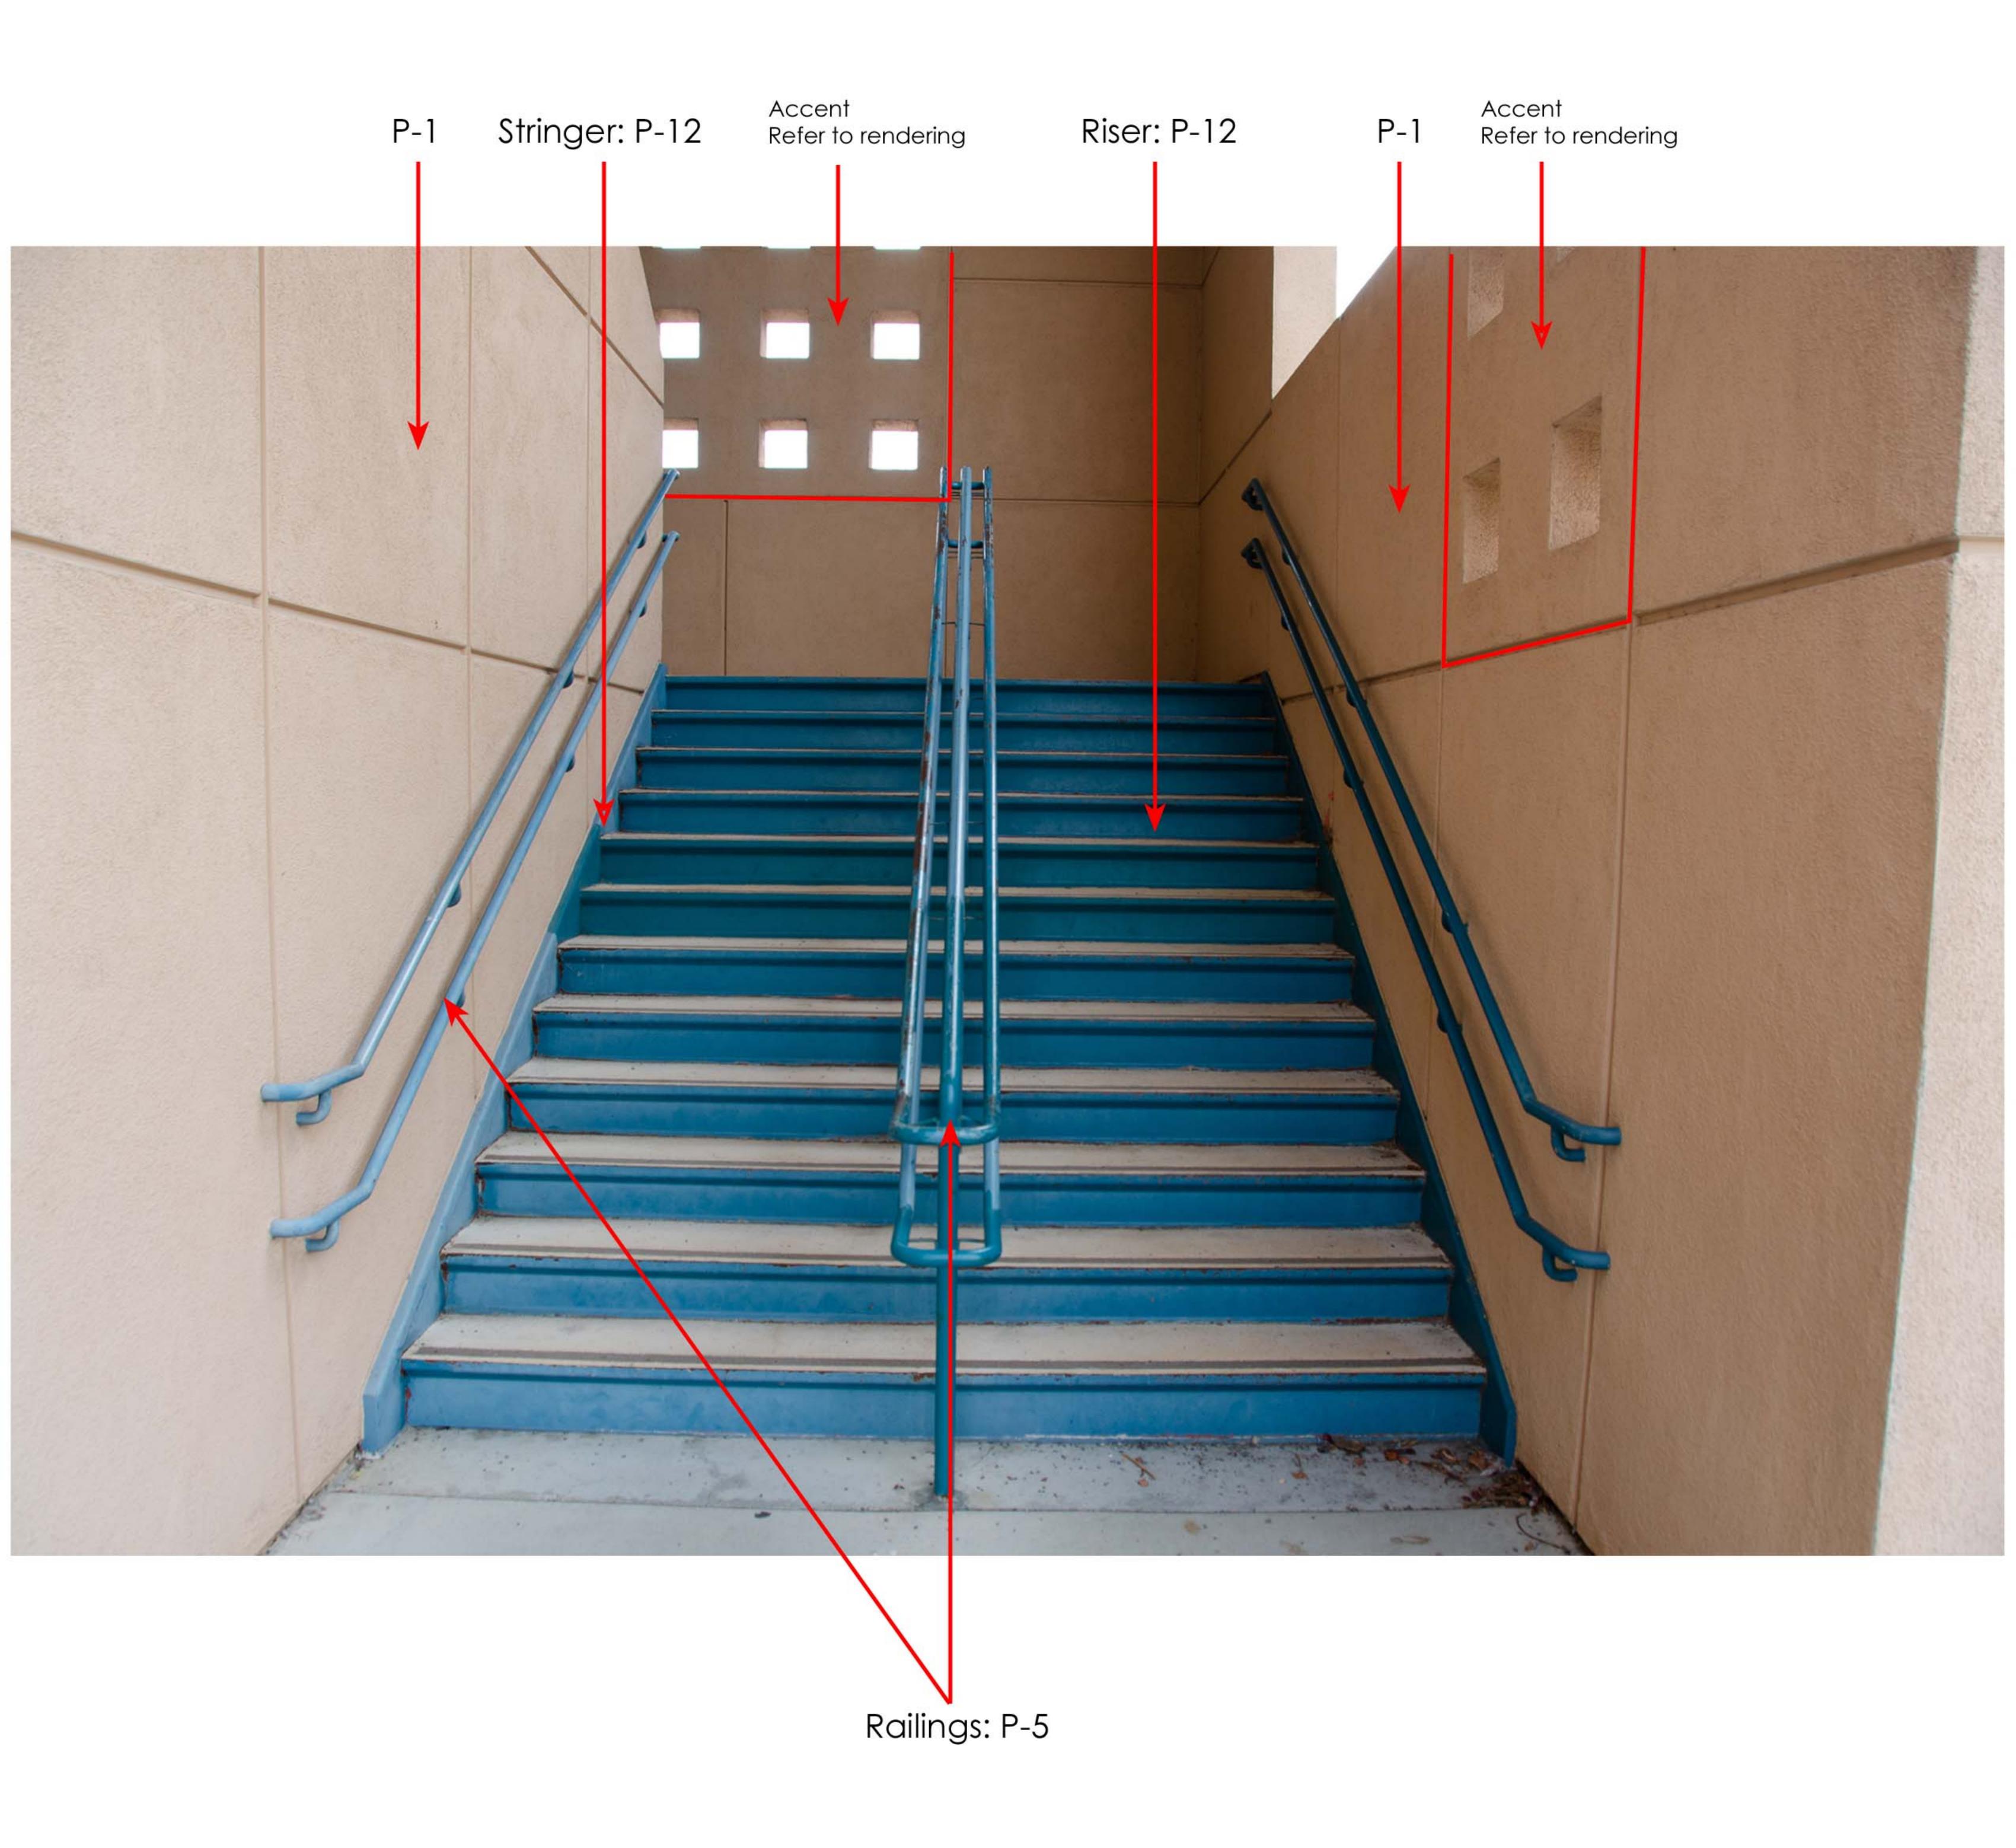


2-Story Classroom Building

Note:

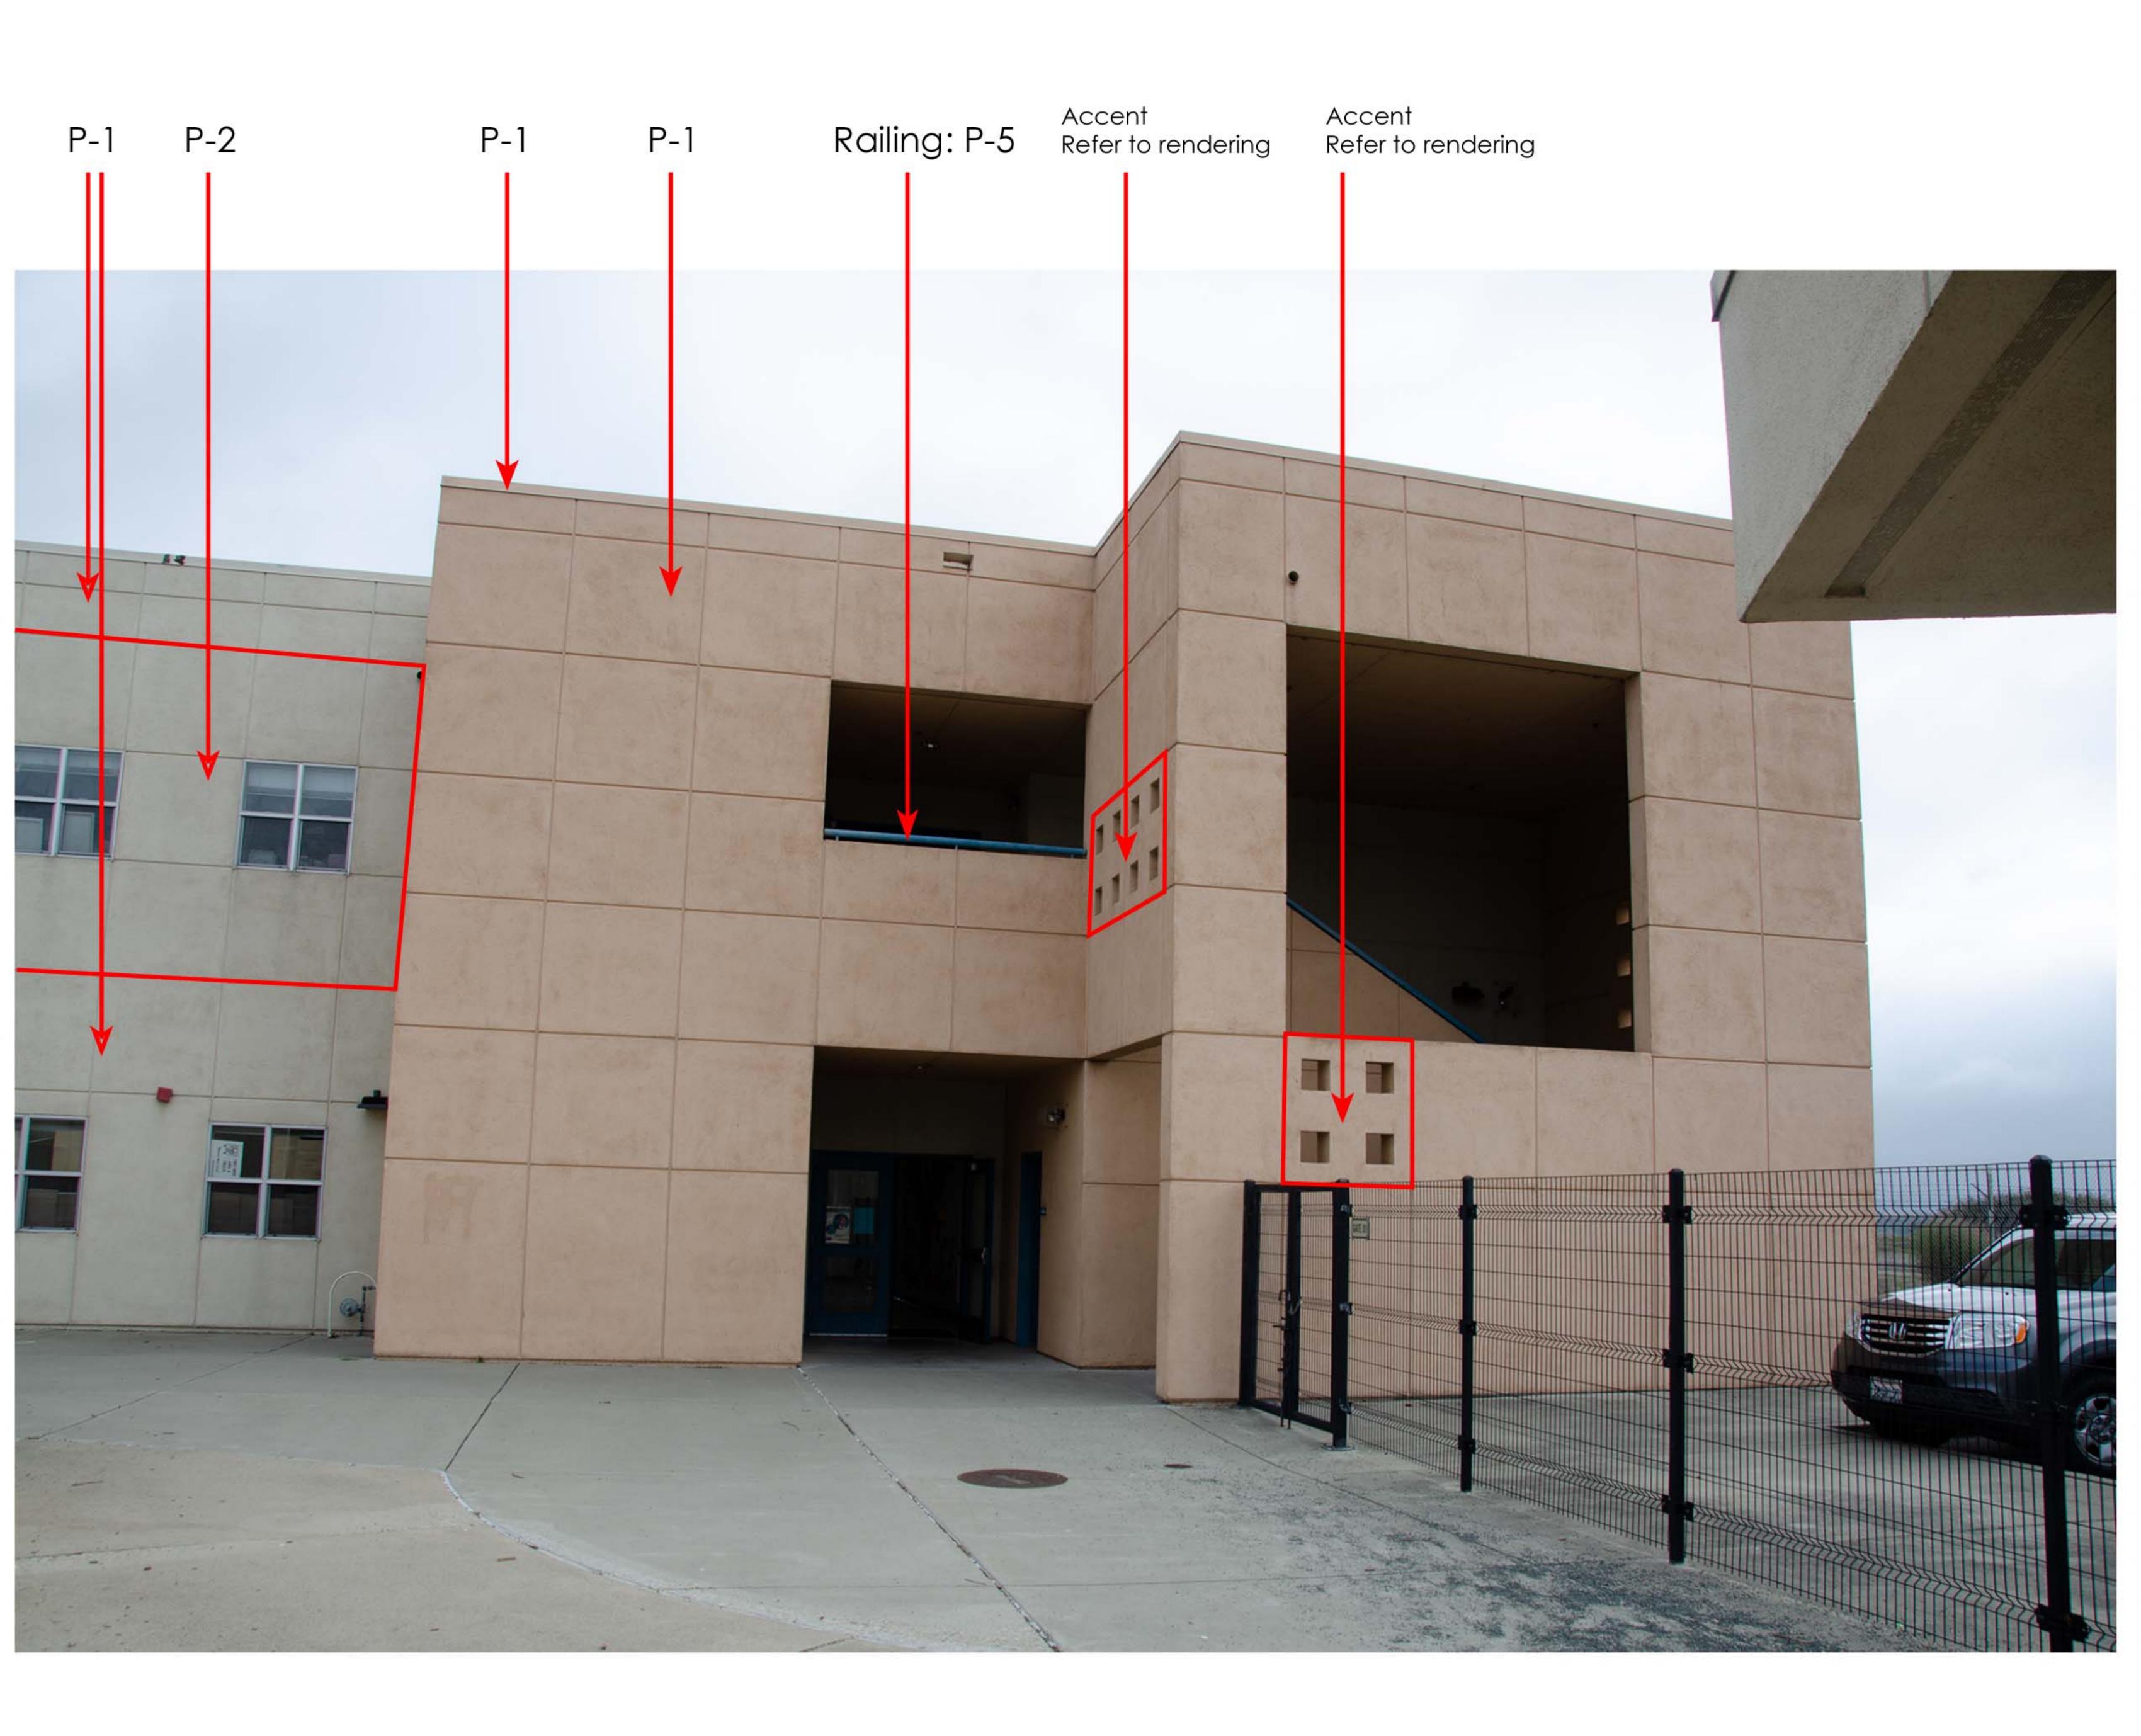


2-Story Classroom Building

Note:

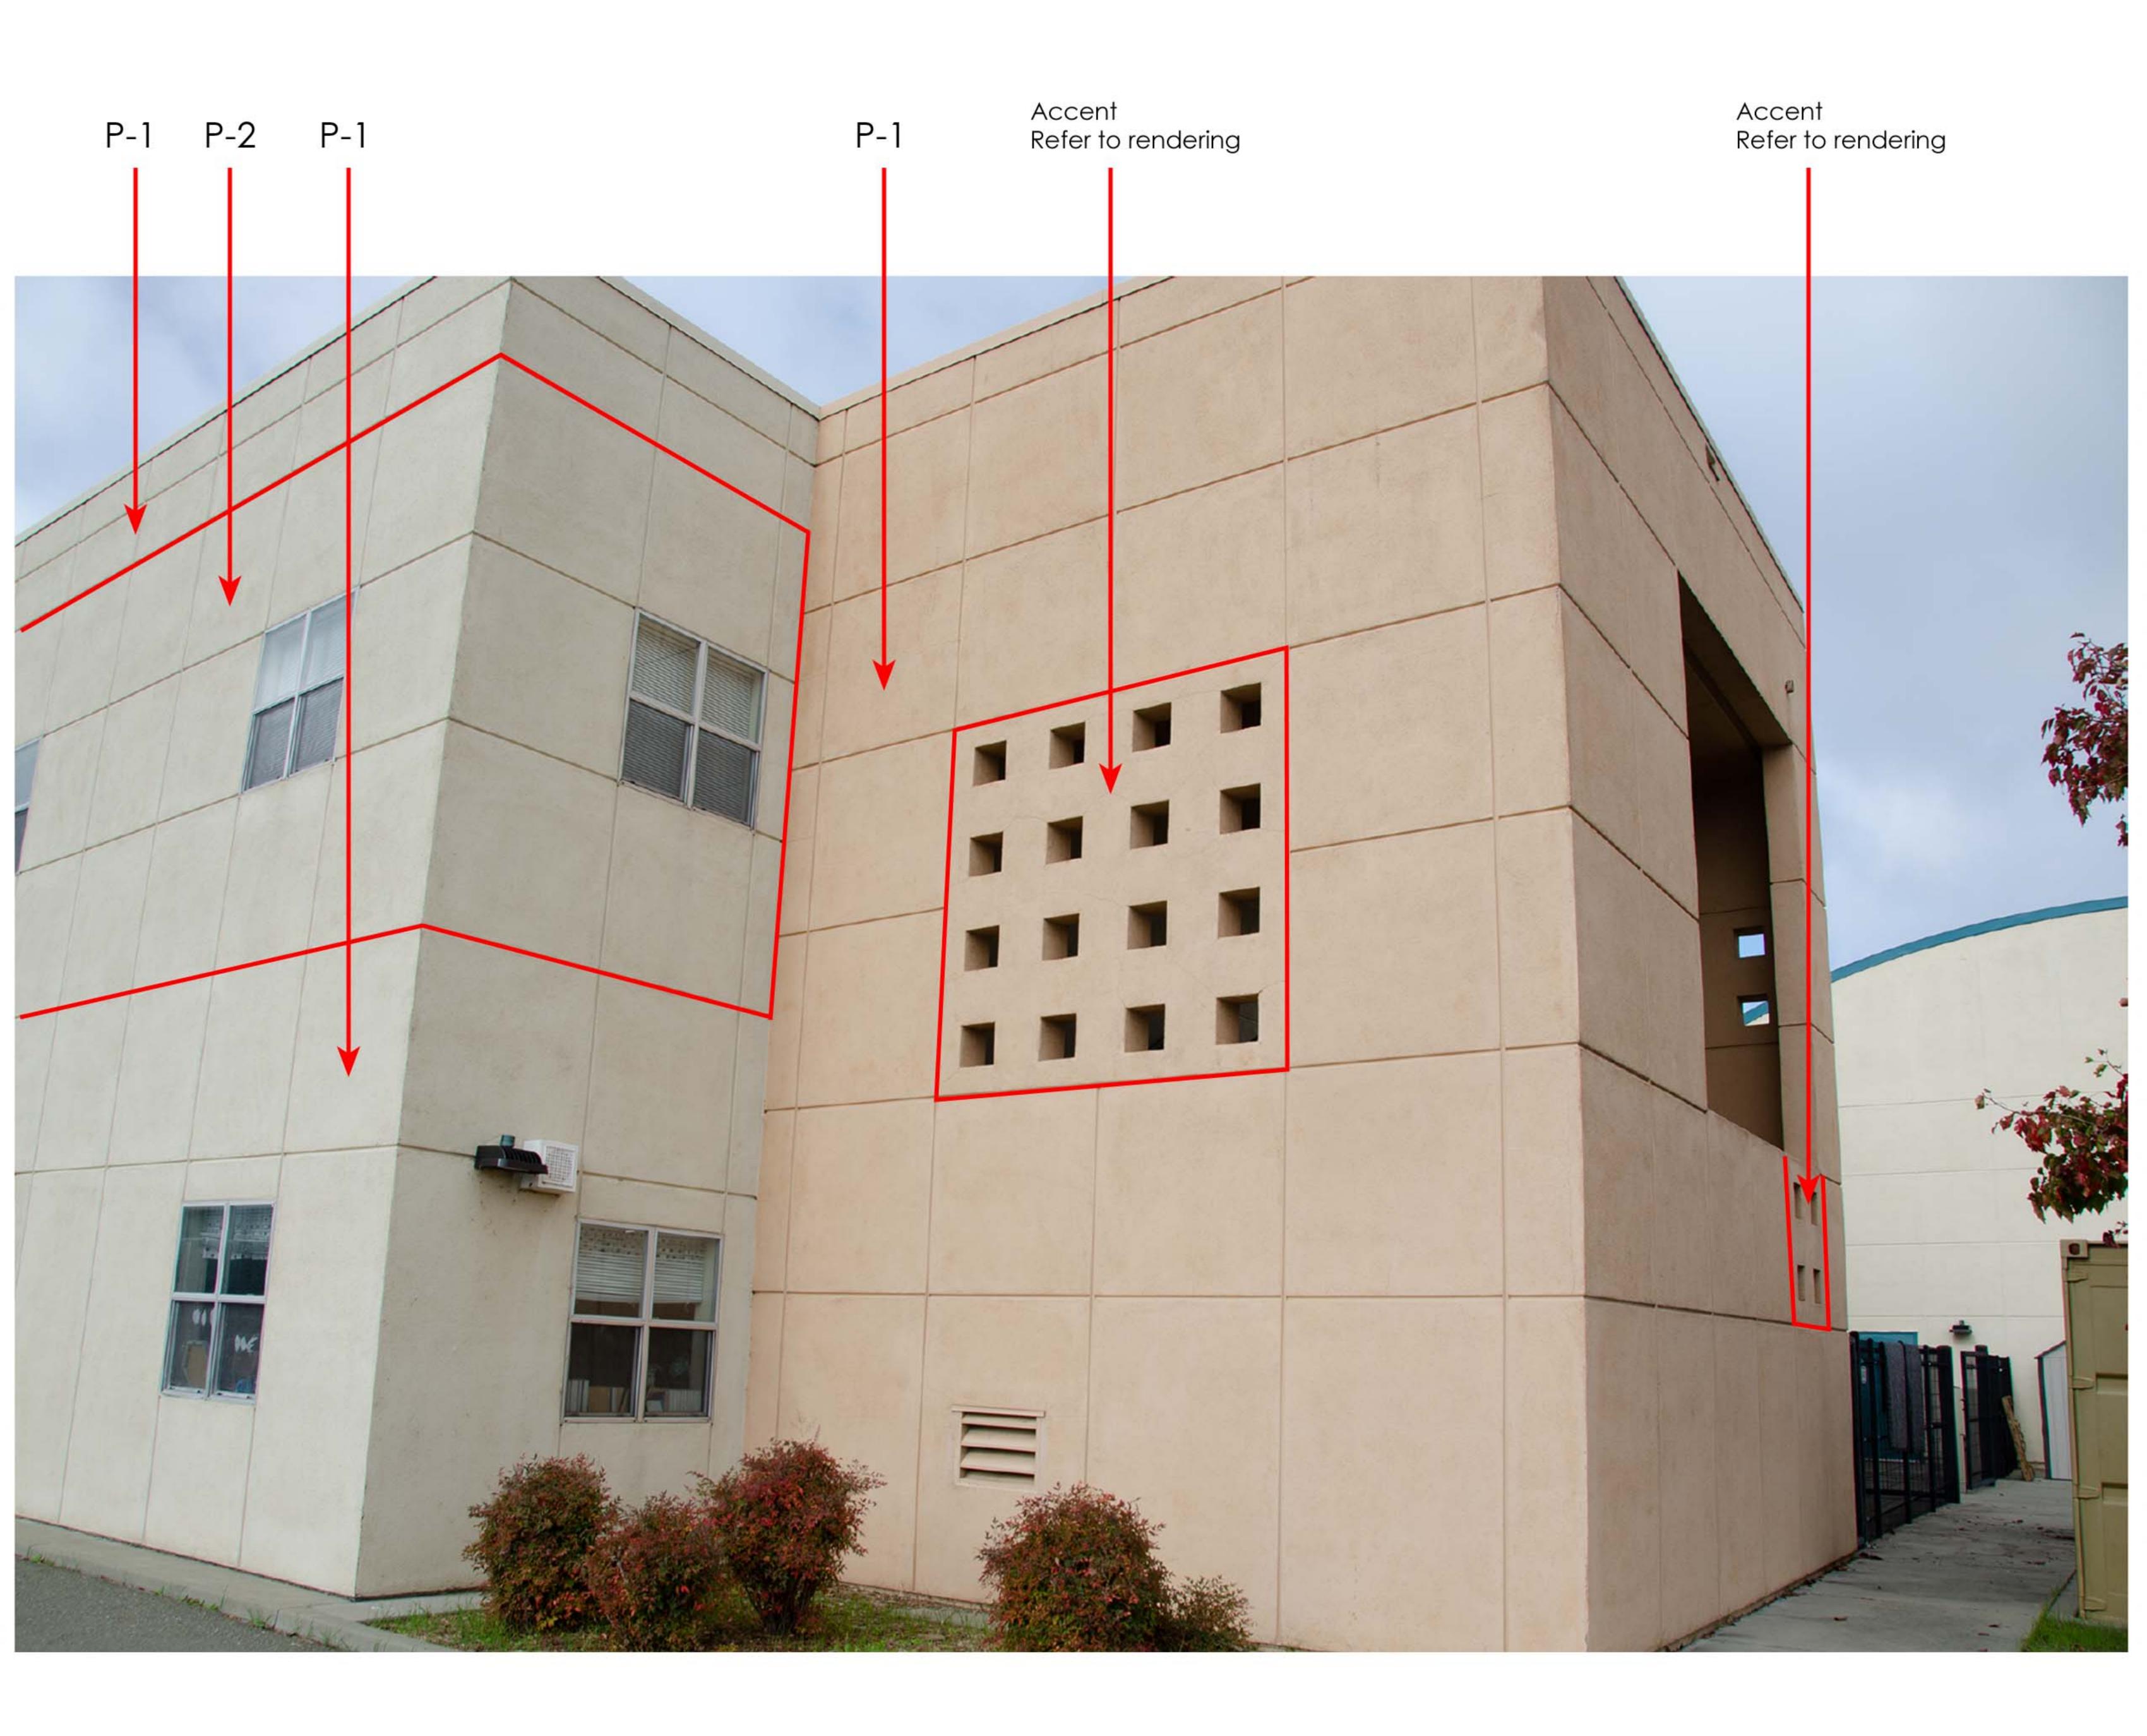


2-Story Classroom Building

Note:

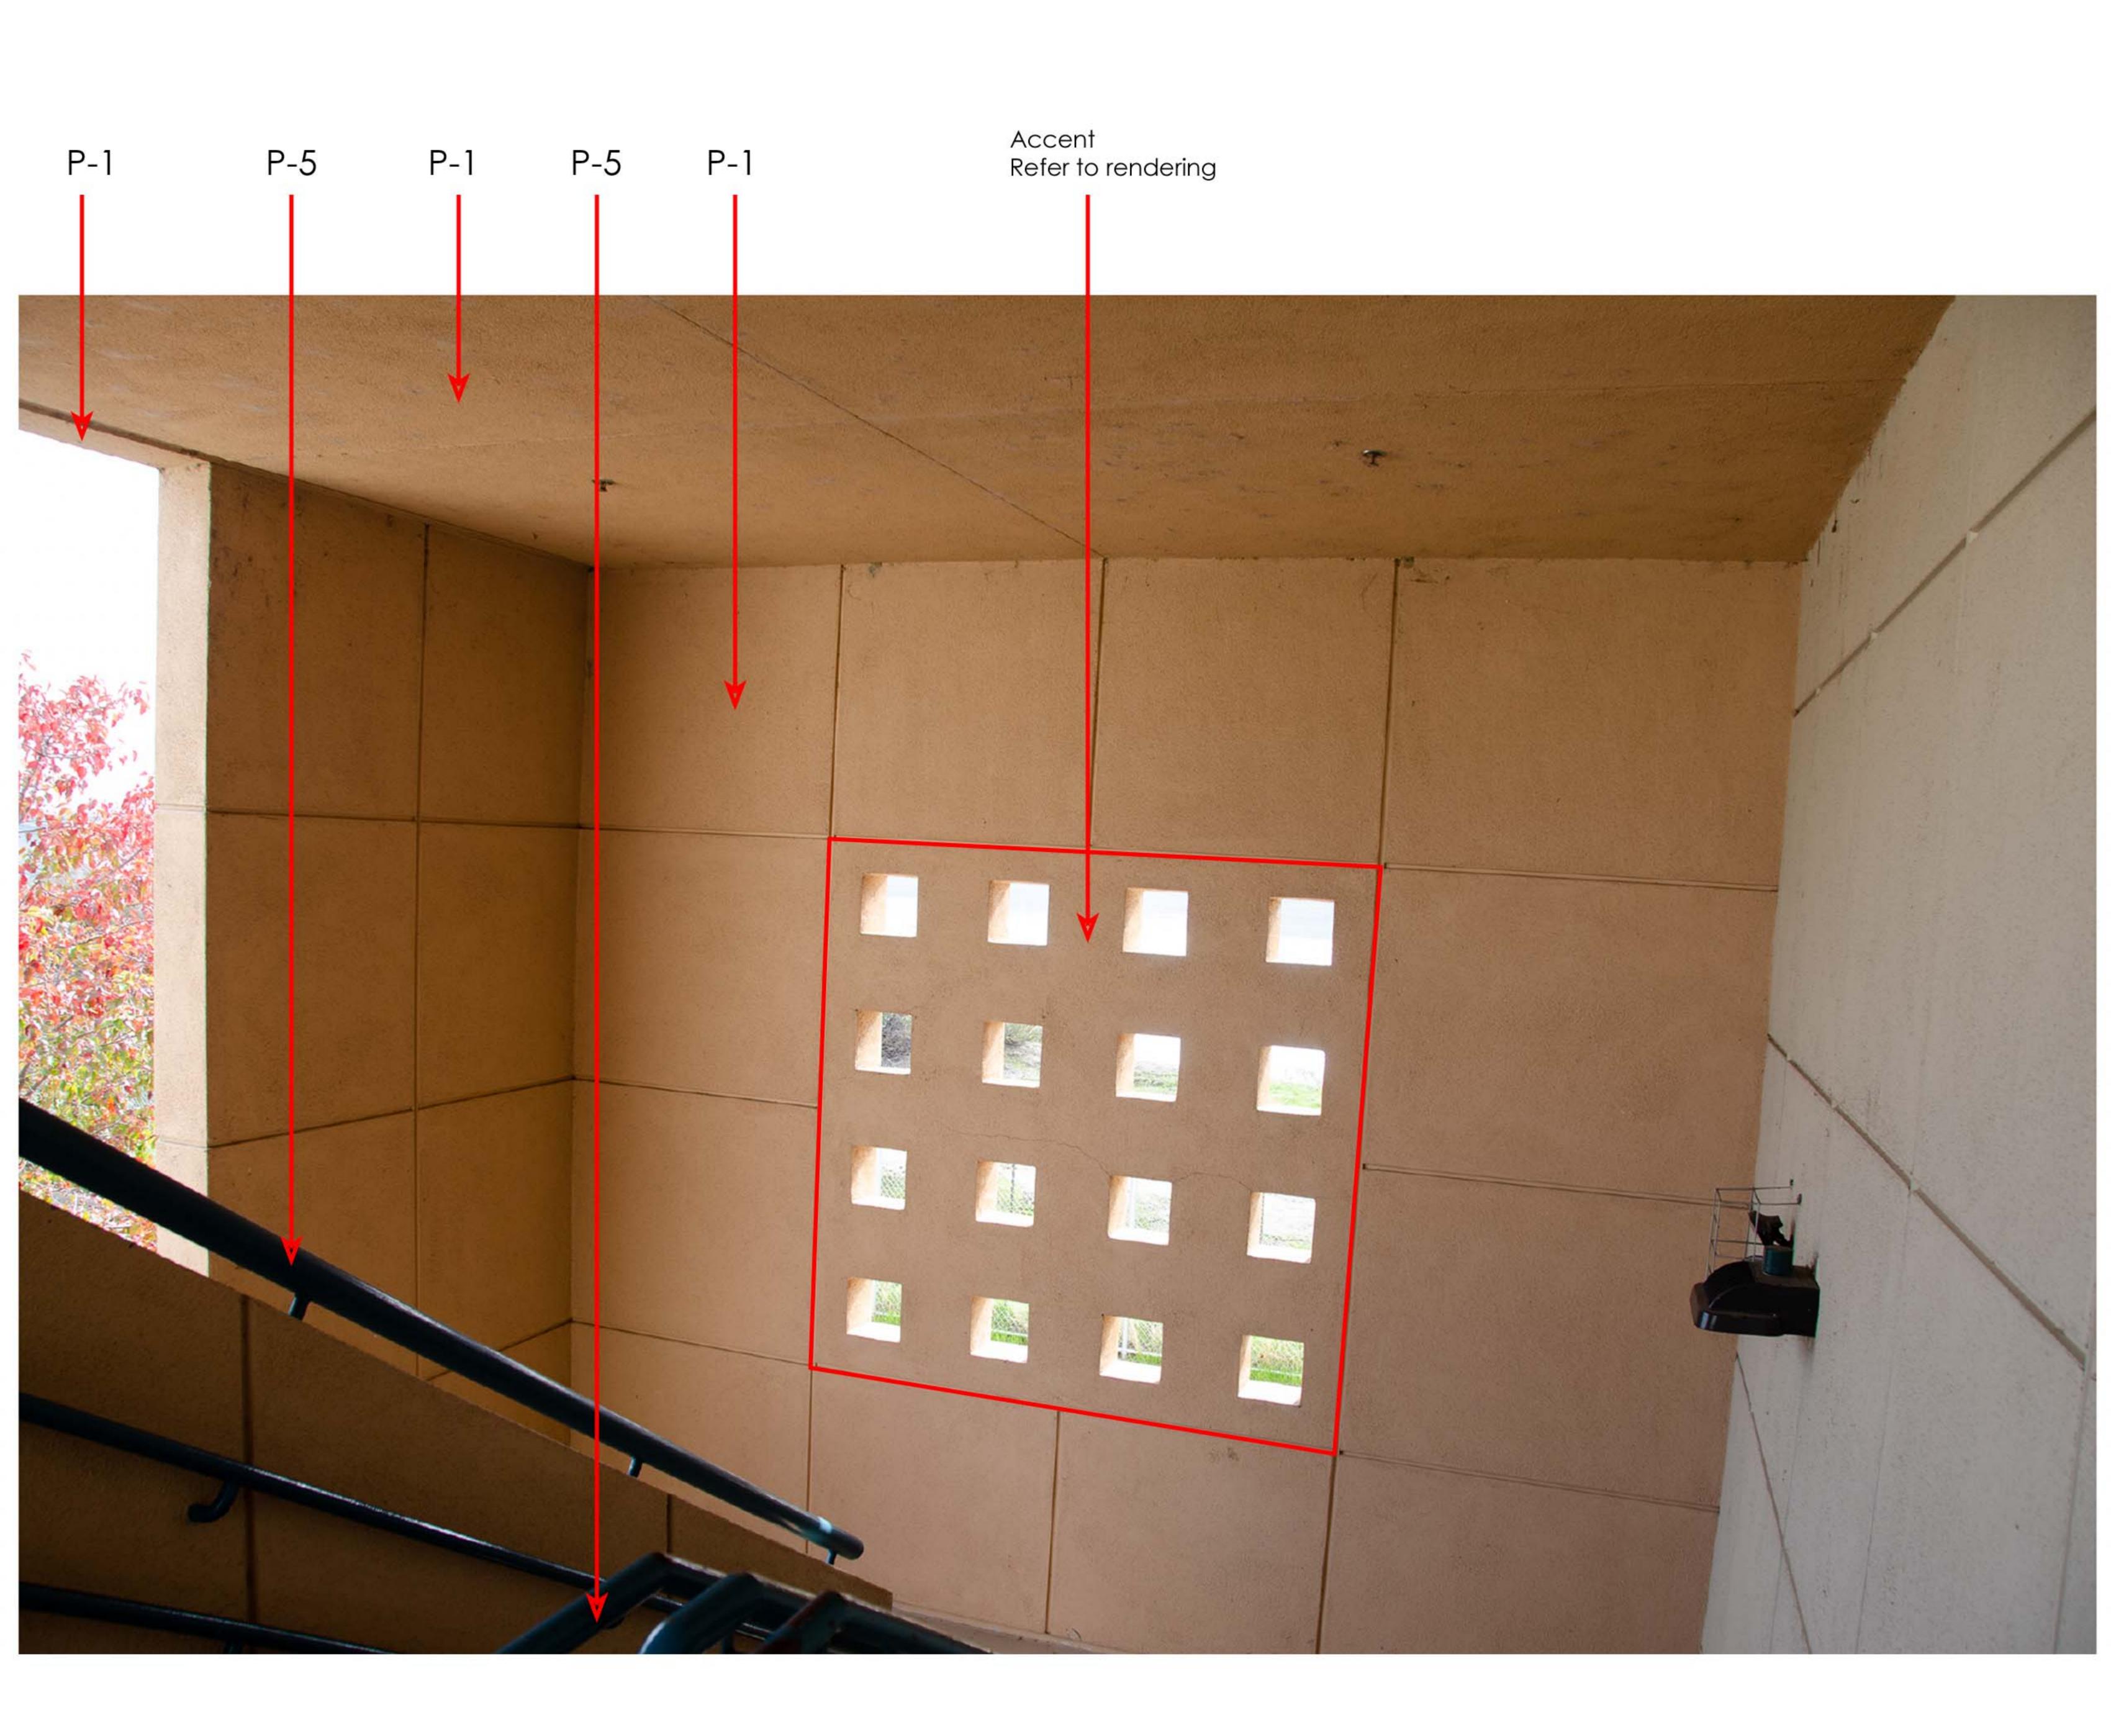


2-Story Classroom Building

Note:

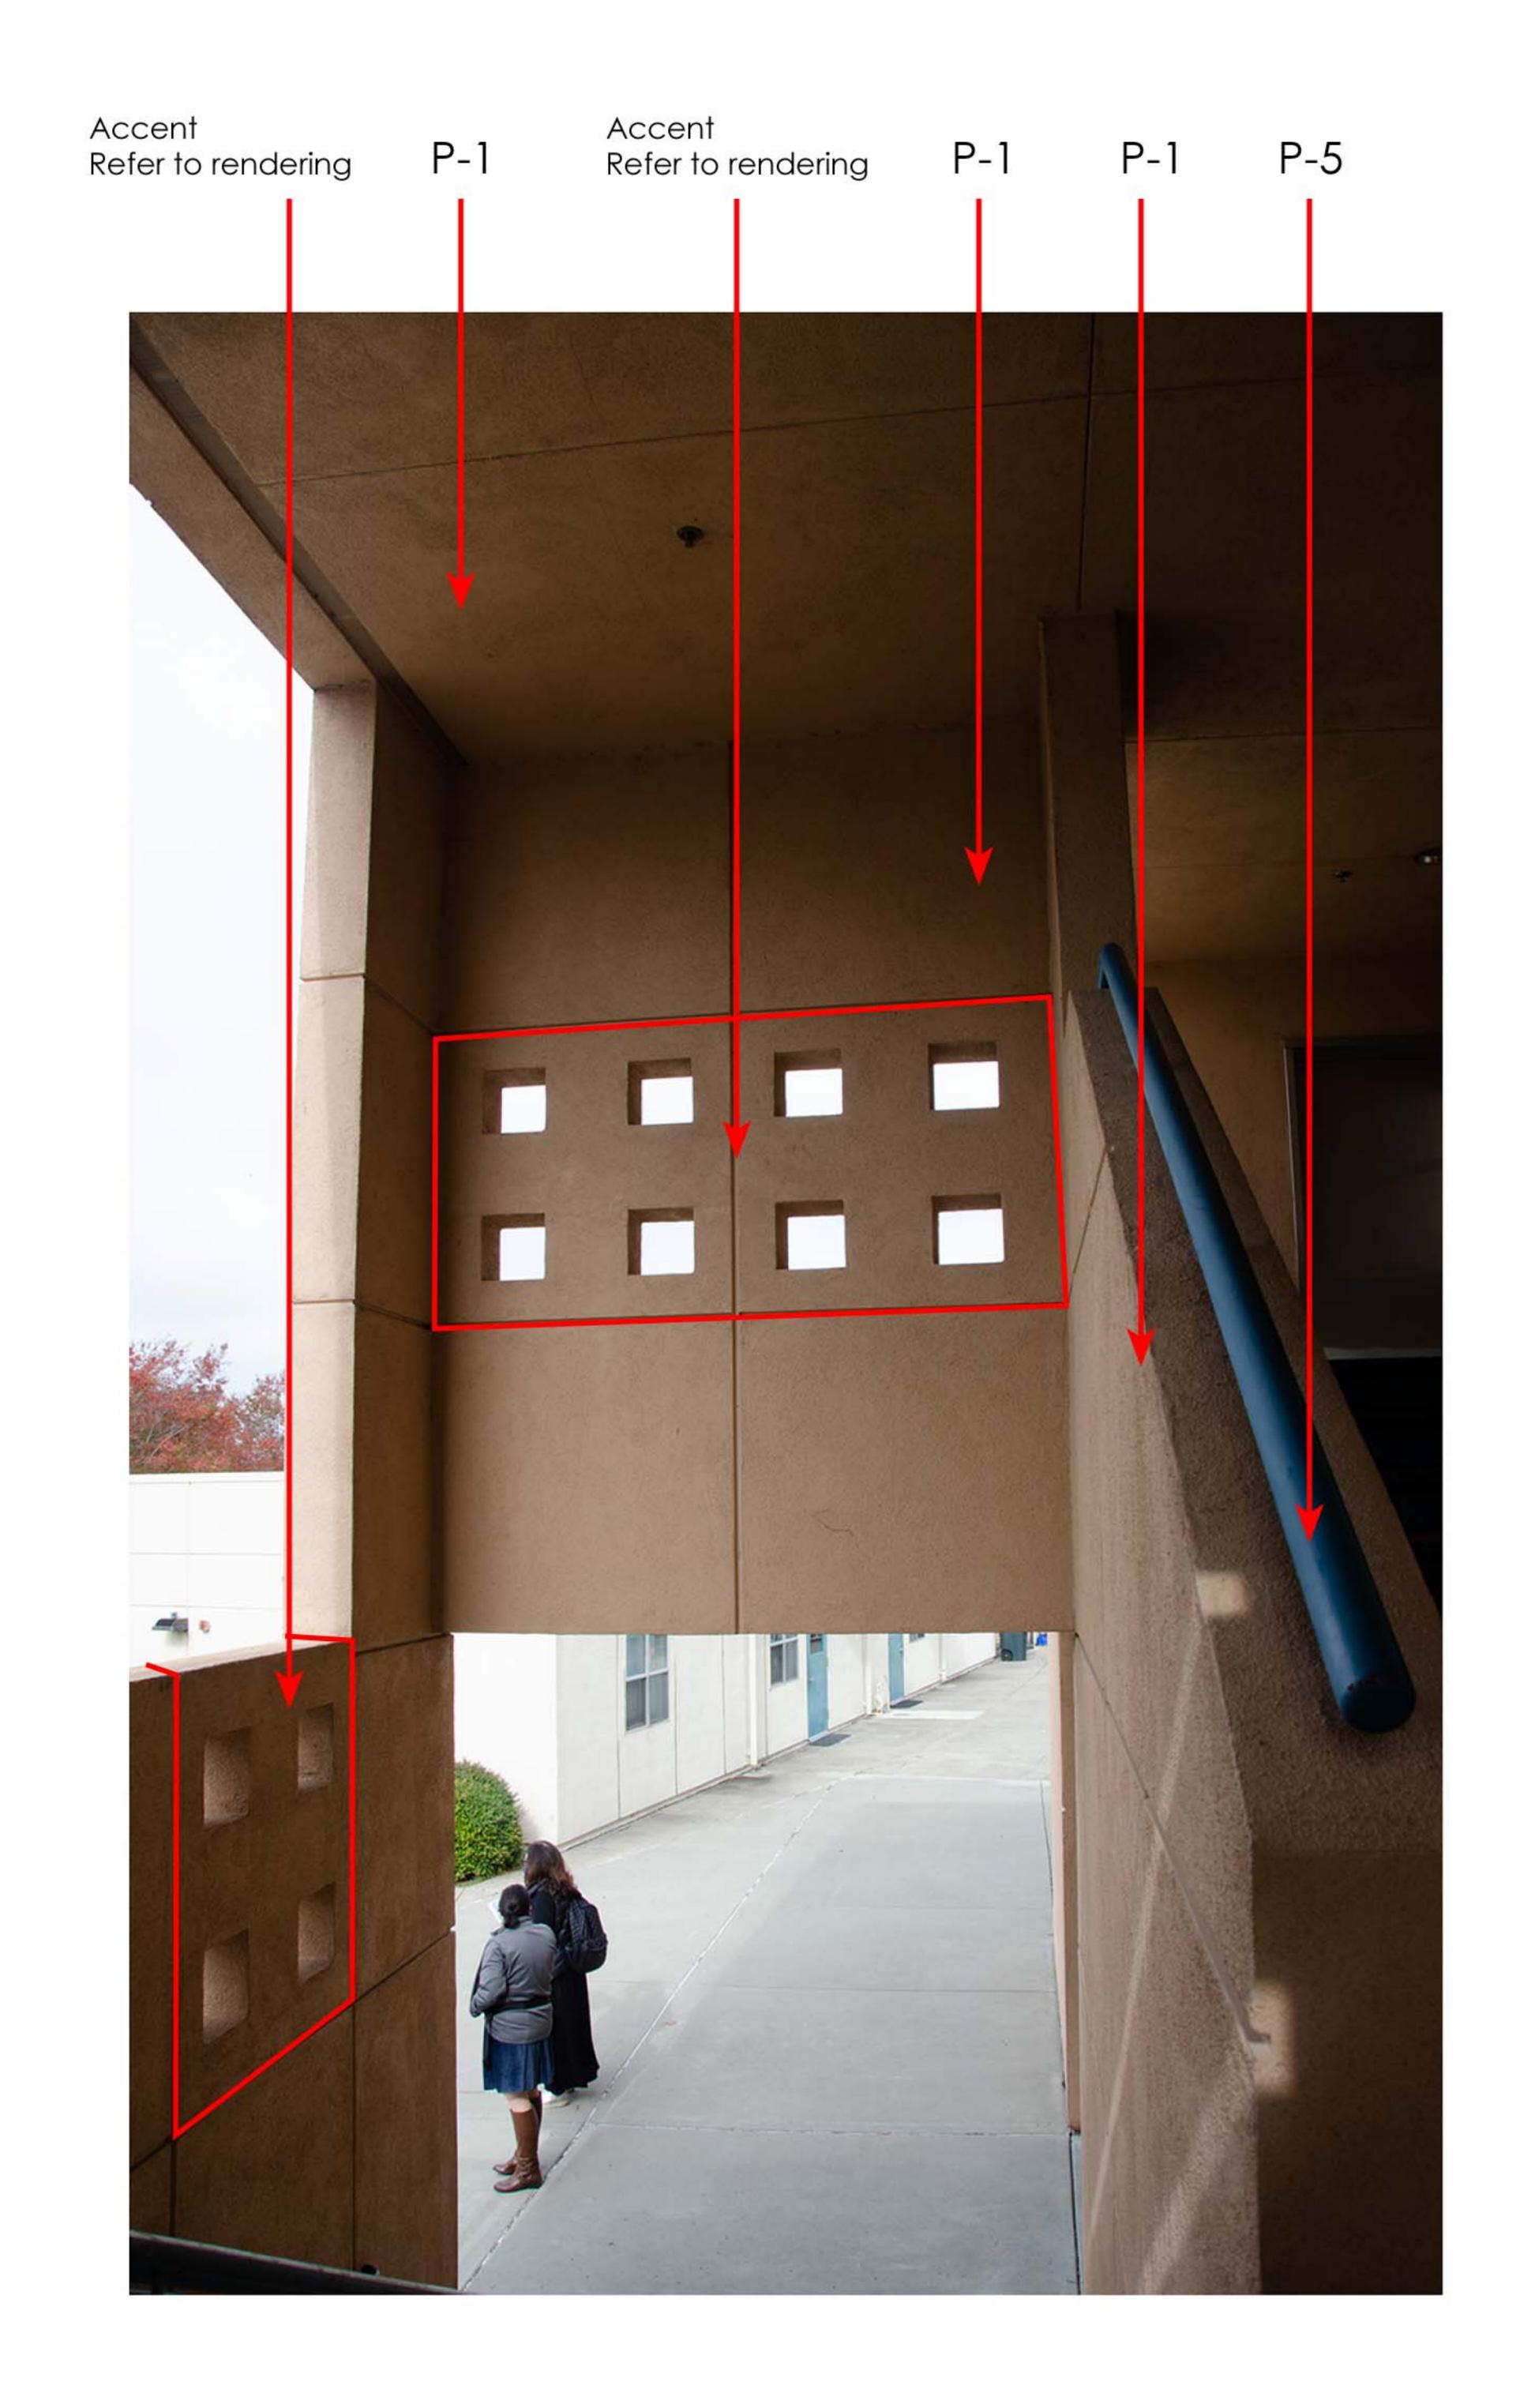


2-Story Classroom Building

Note:

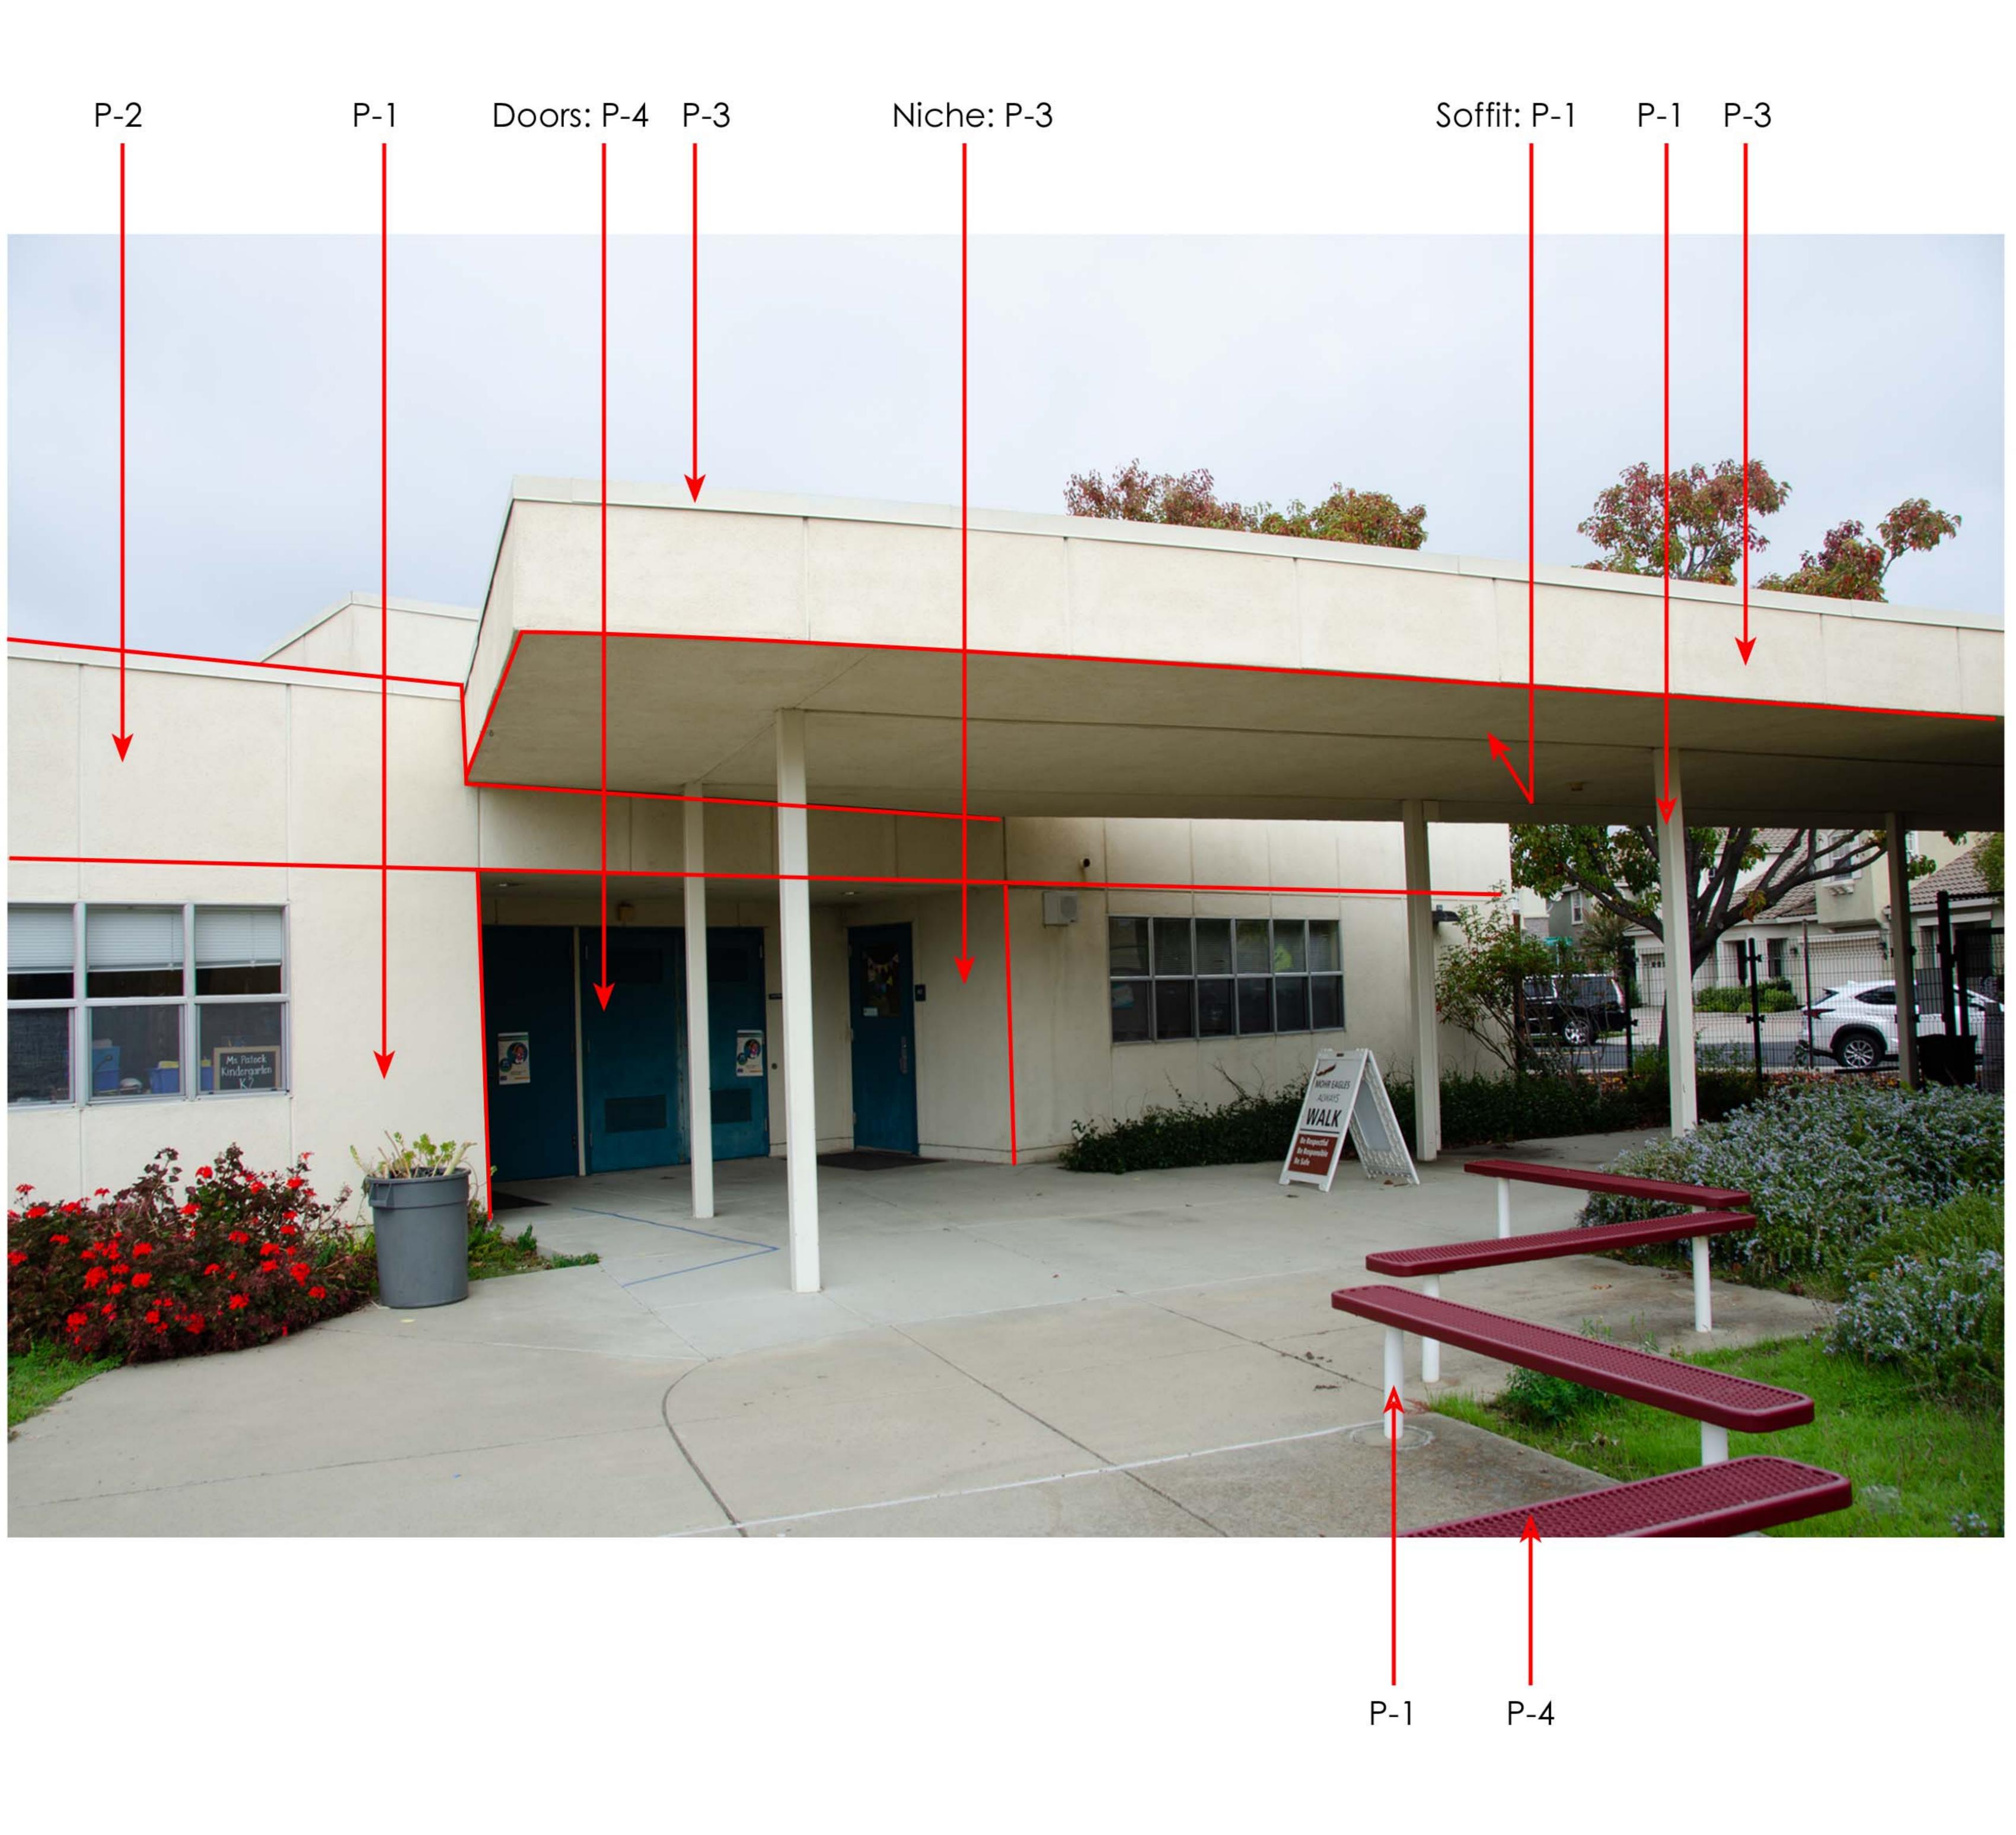


Building K



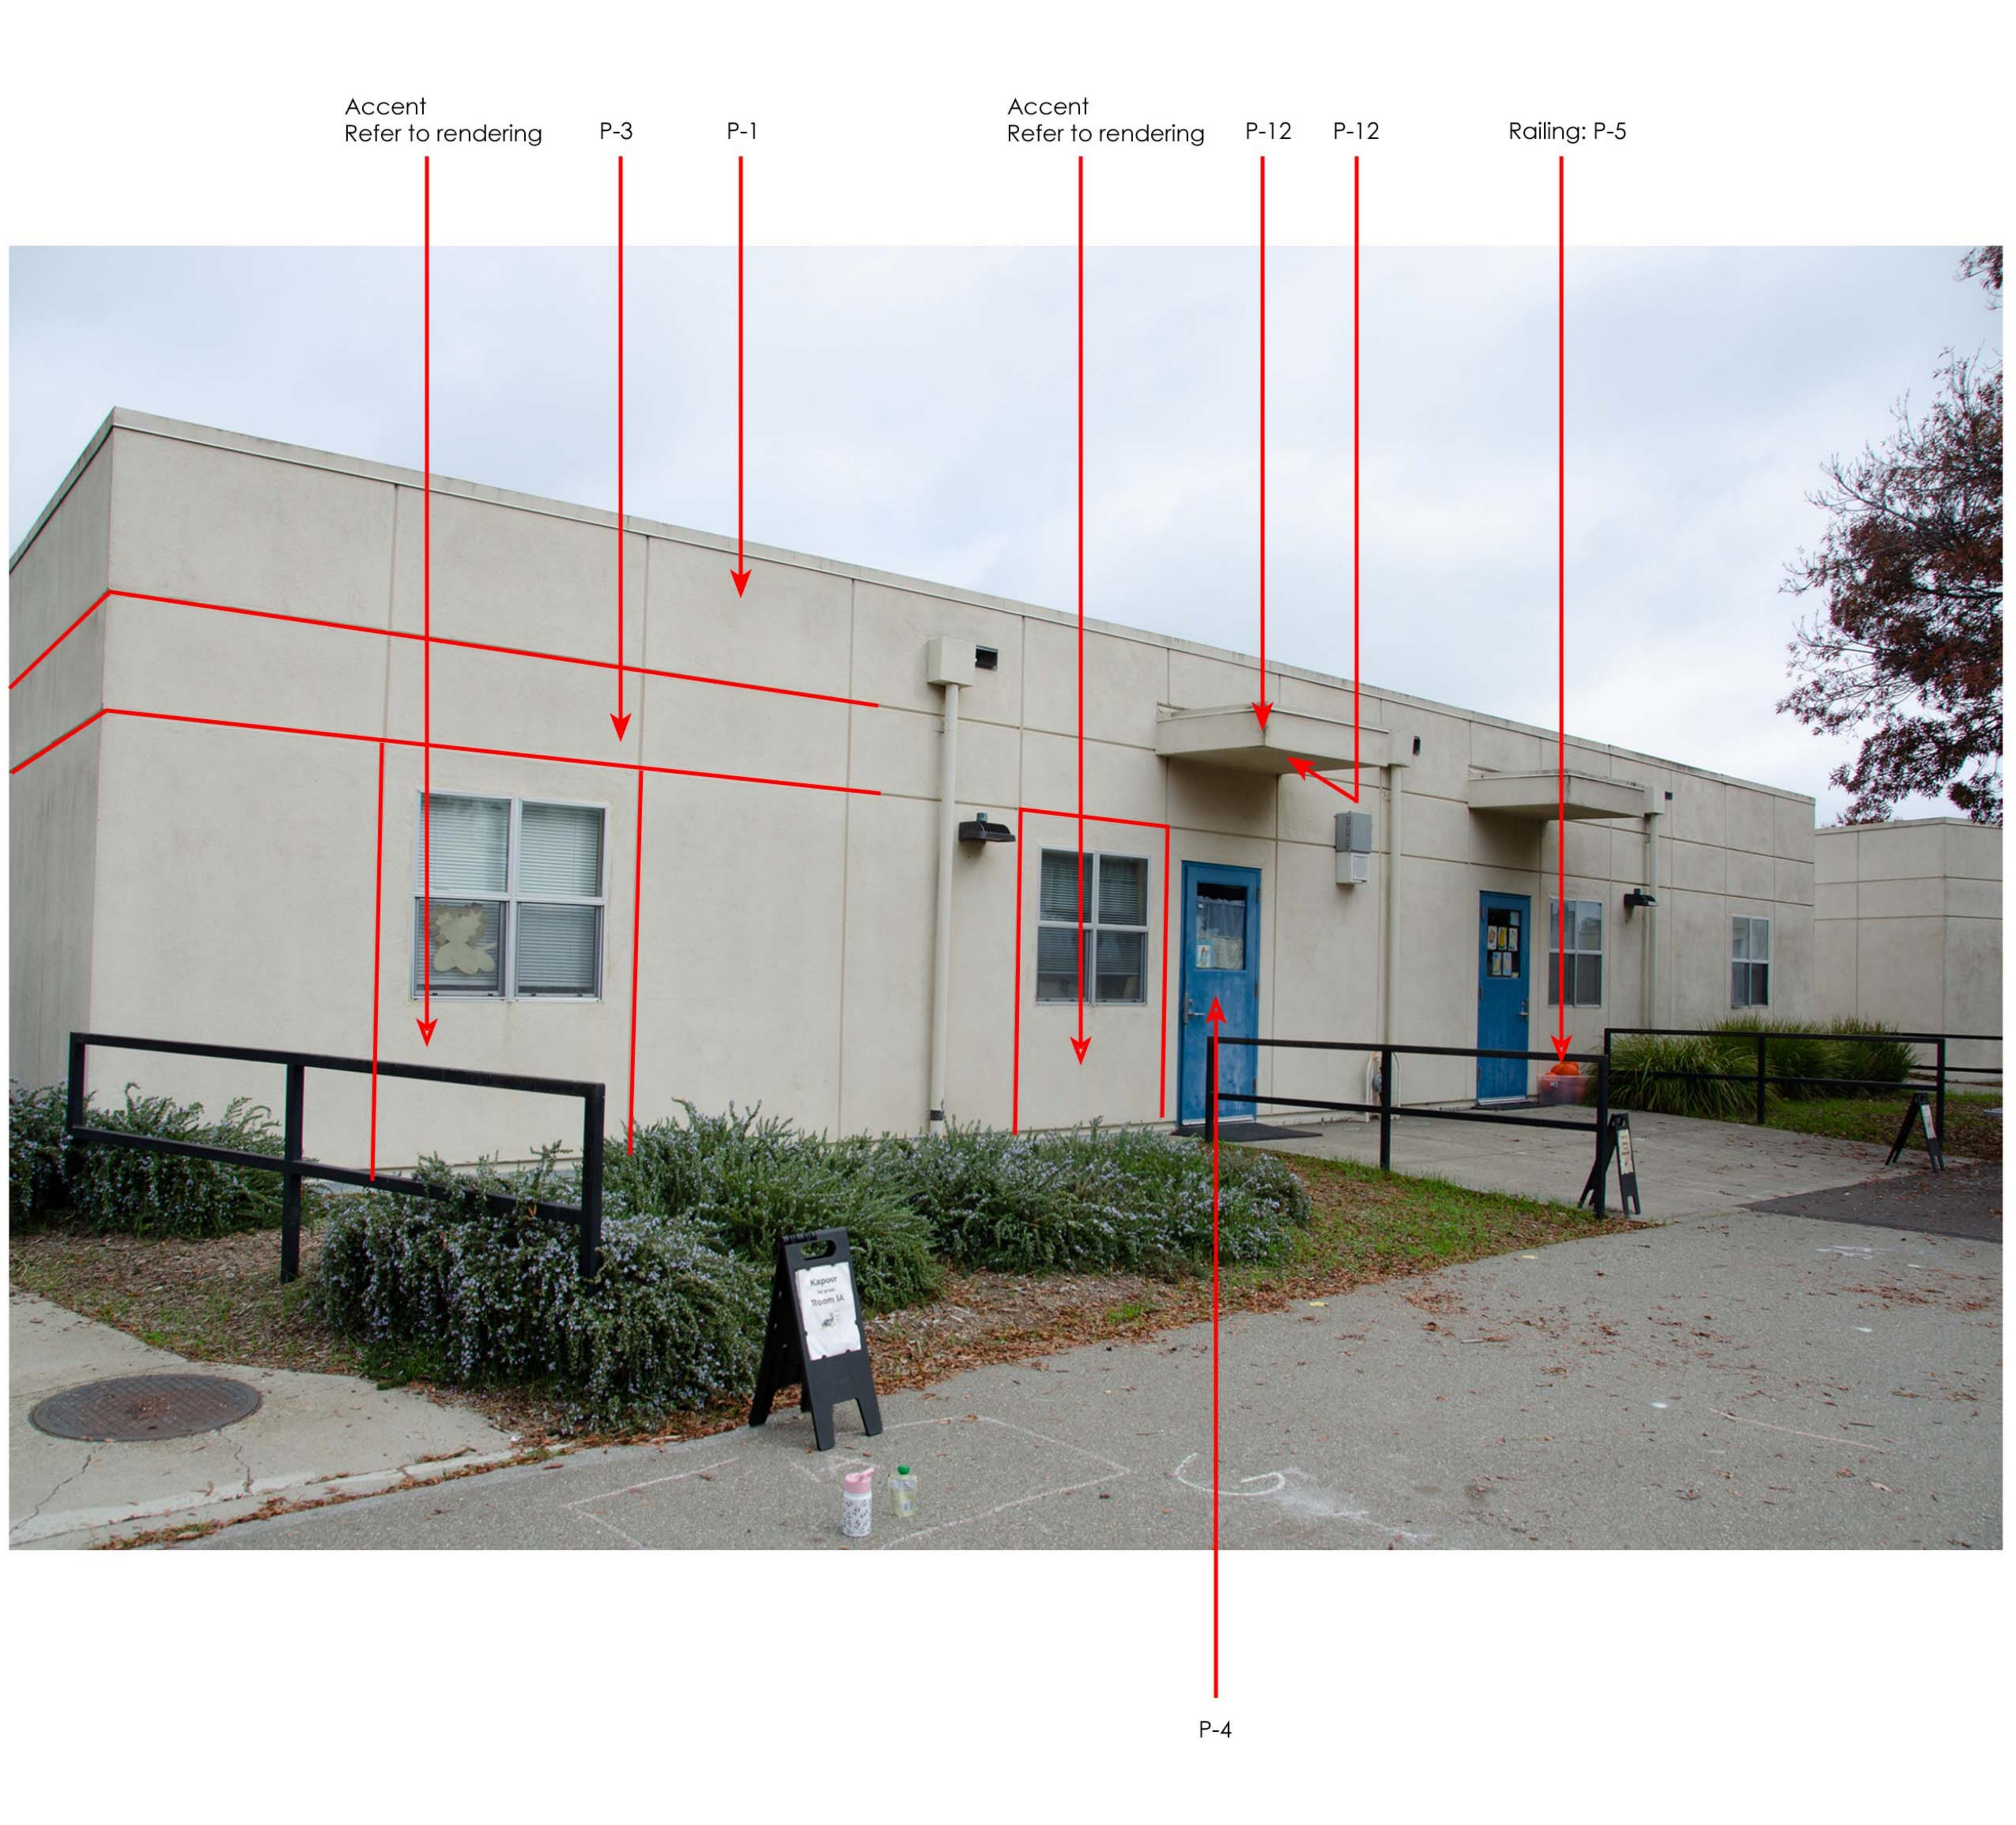

Building R



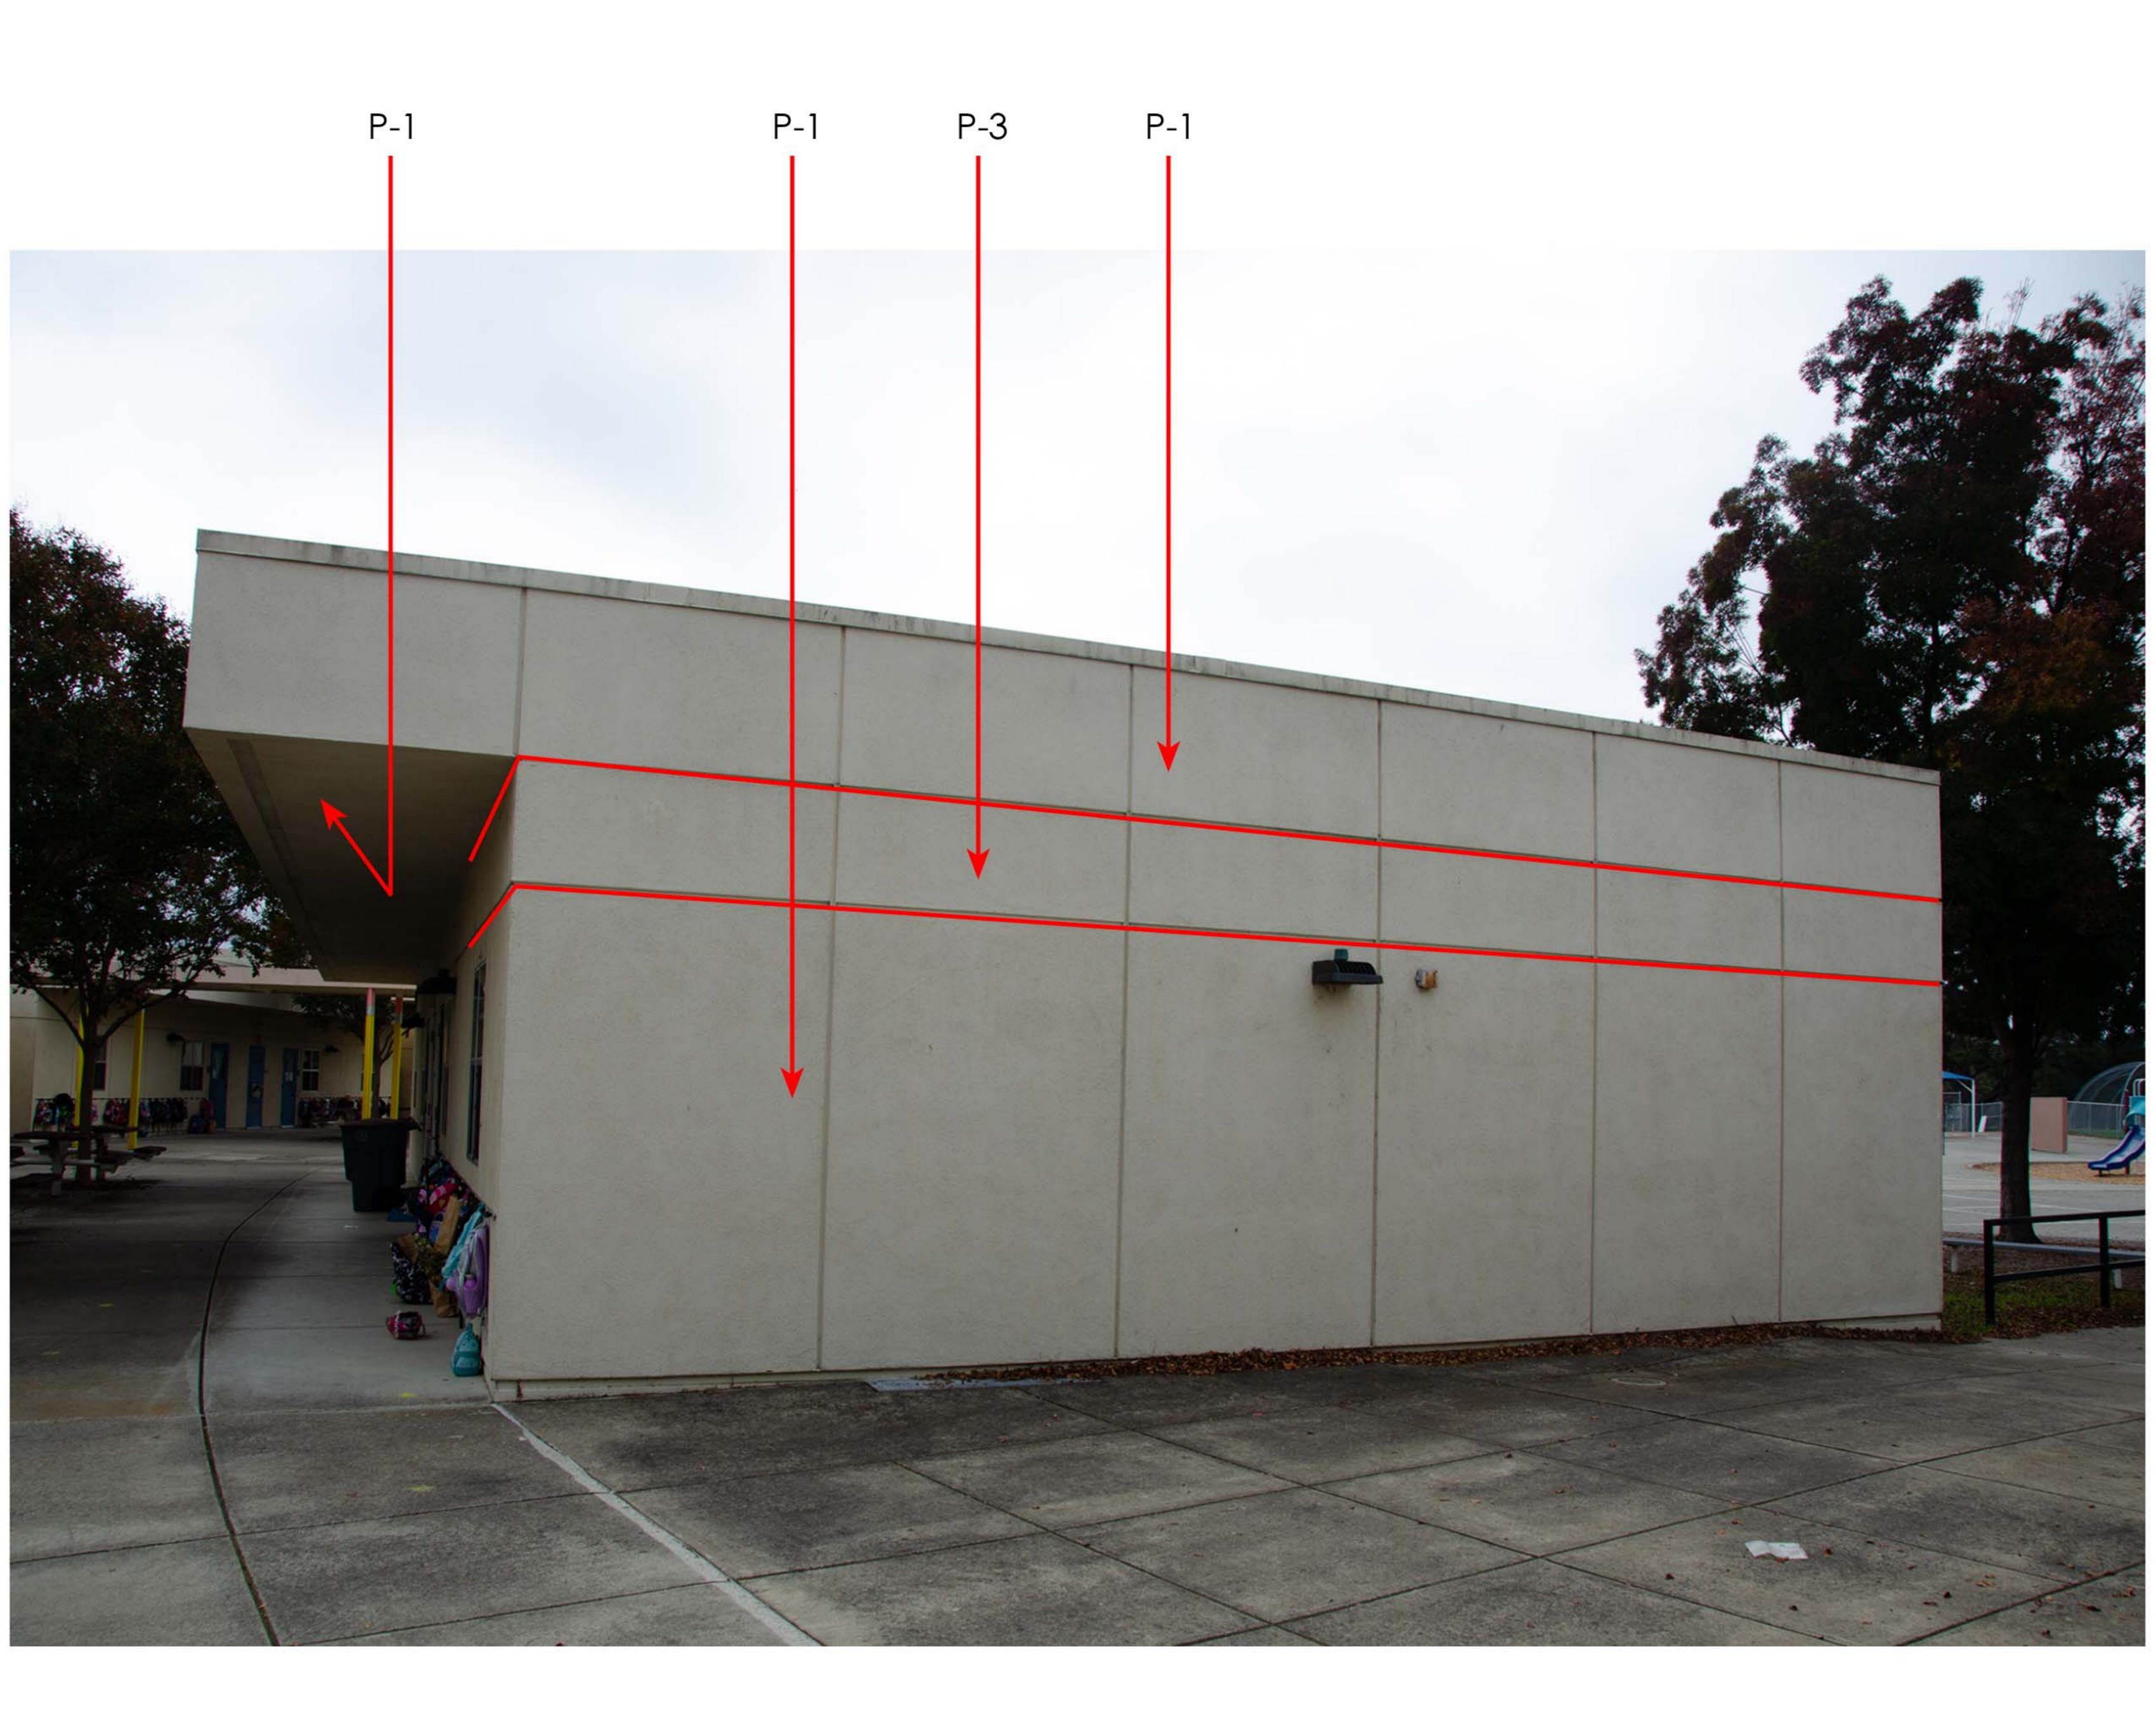

Building R





Building R



Do not pai	int mural Str	ucture: P-3	Soffit: P-1	P-11	P-10



Walkway





P-4


P-4


Ball Wall




Benches and Tabletops

Note:

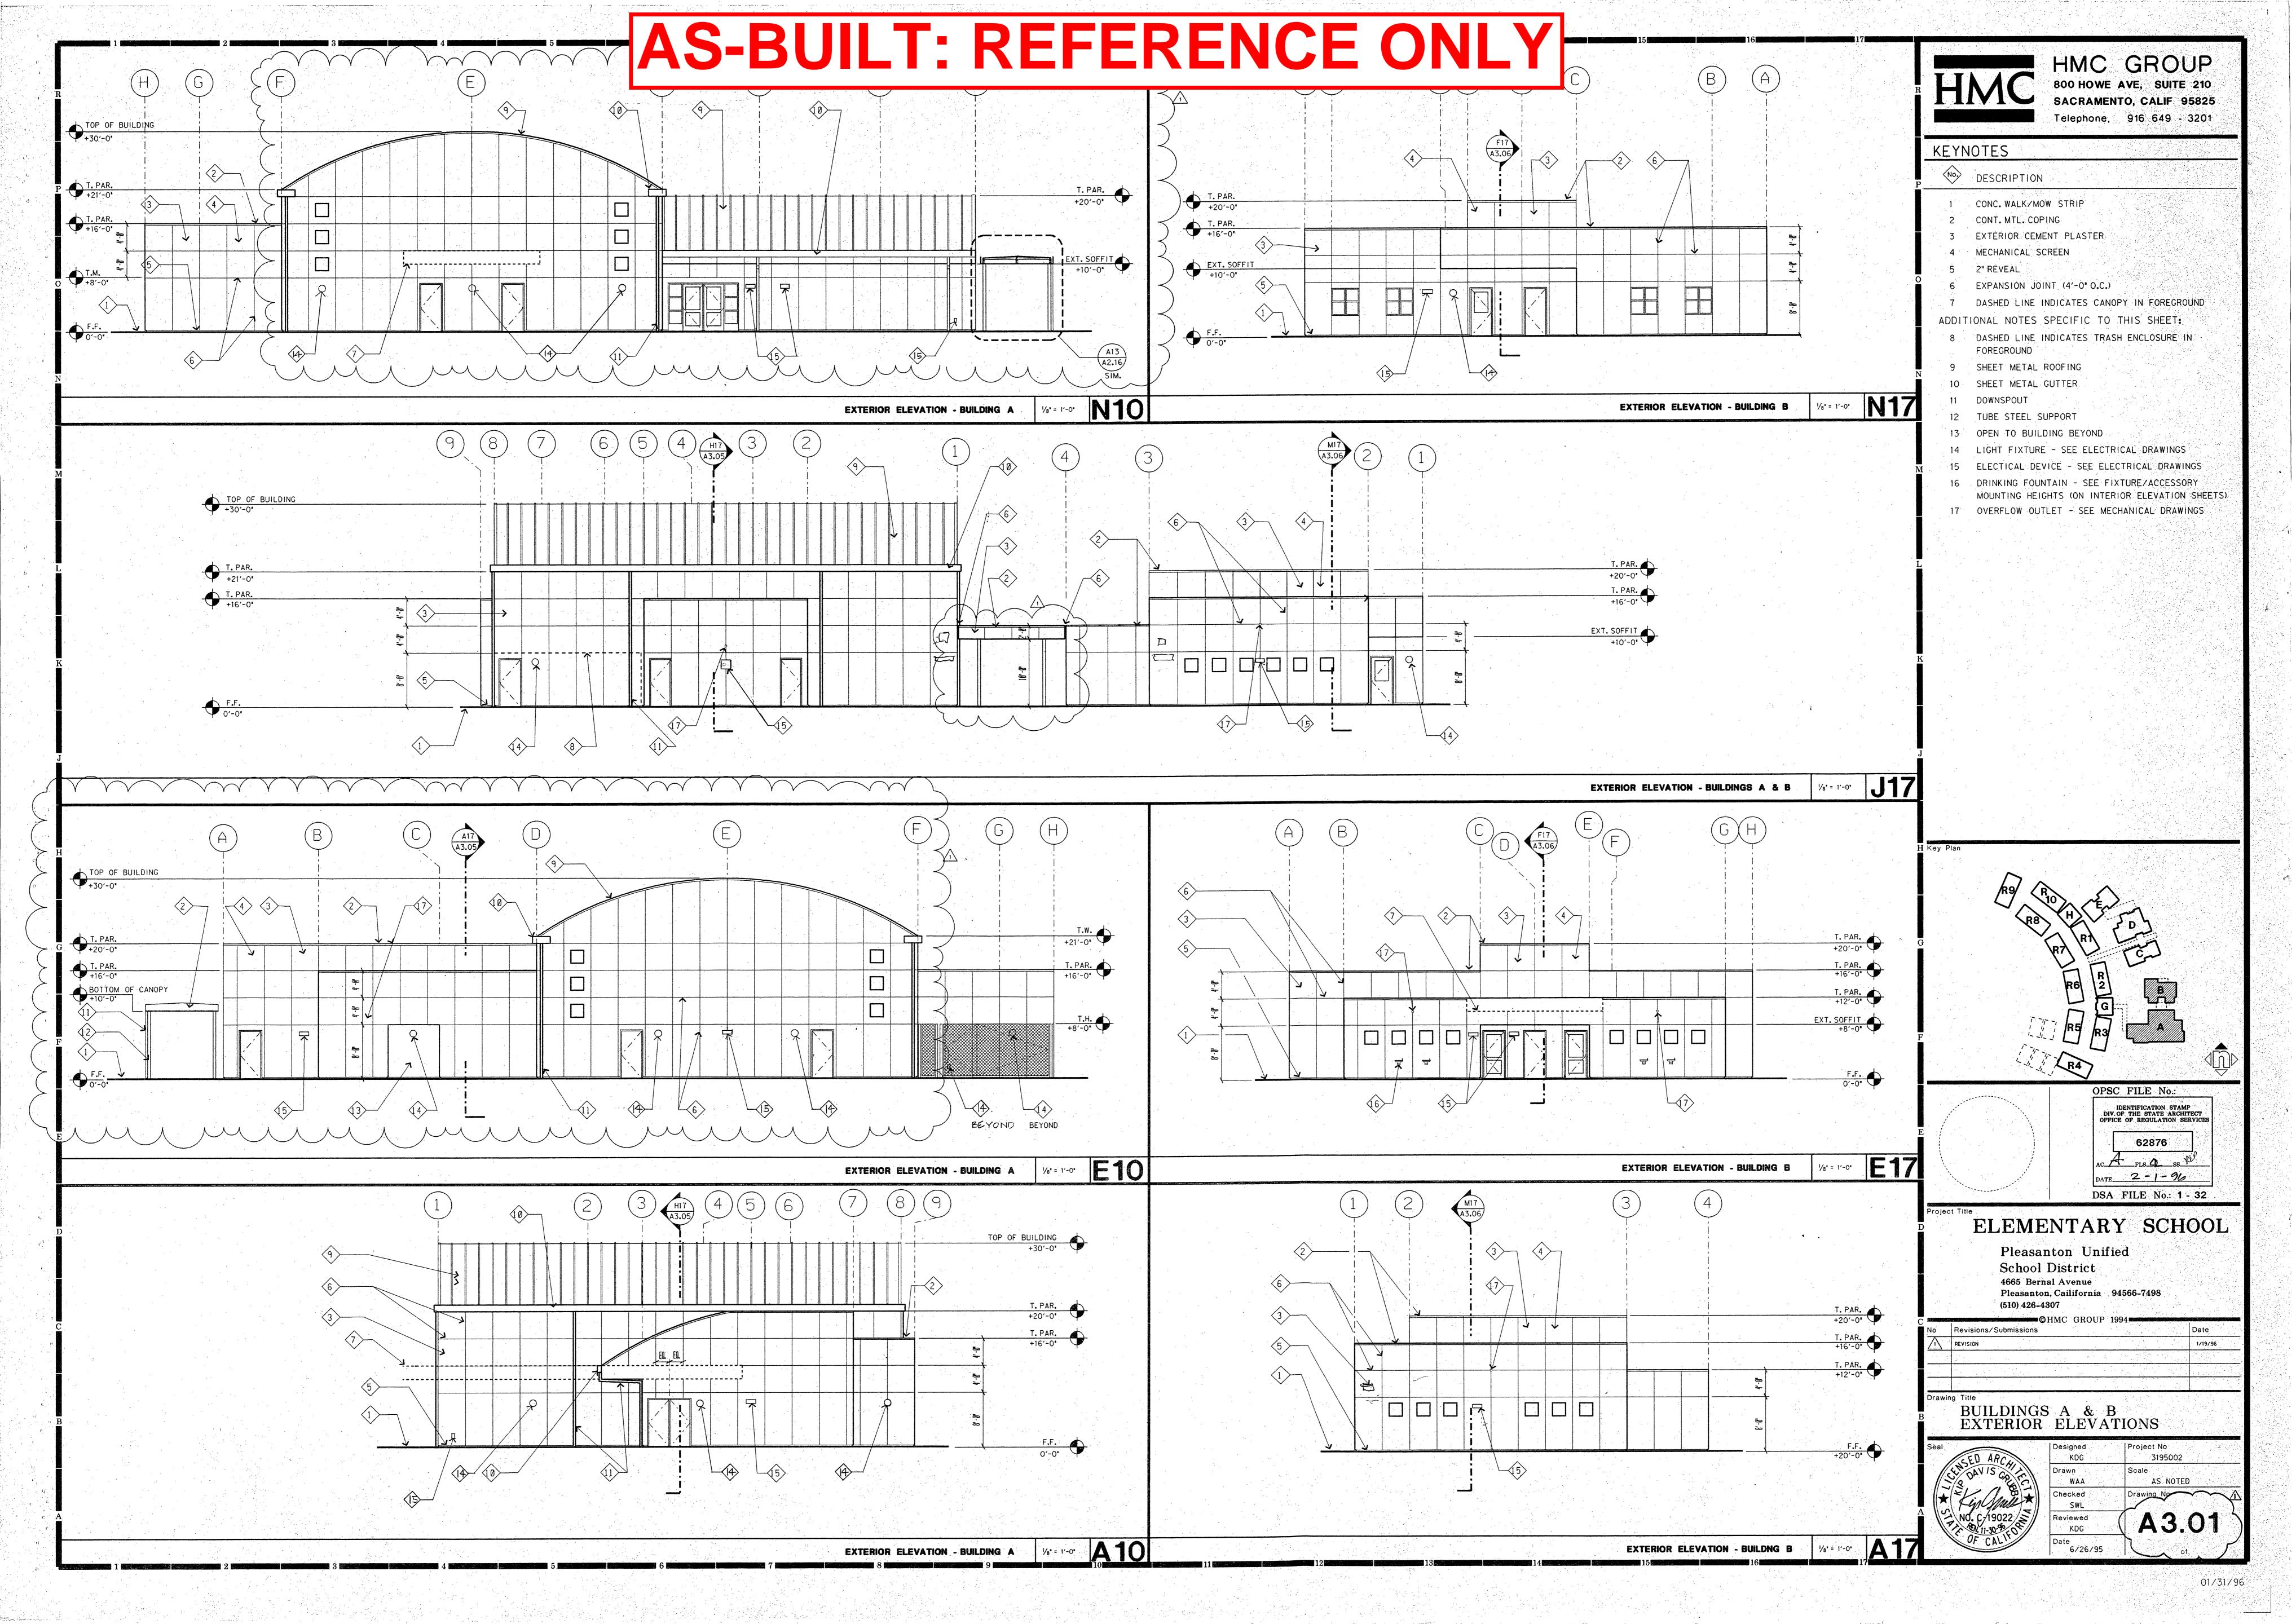

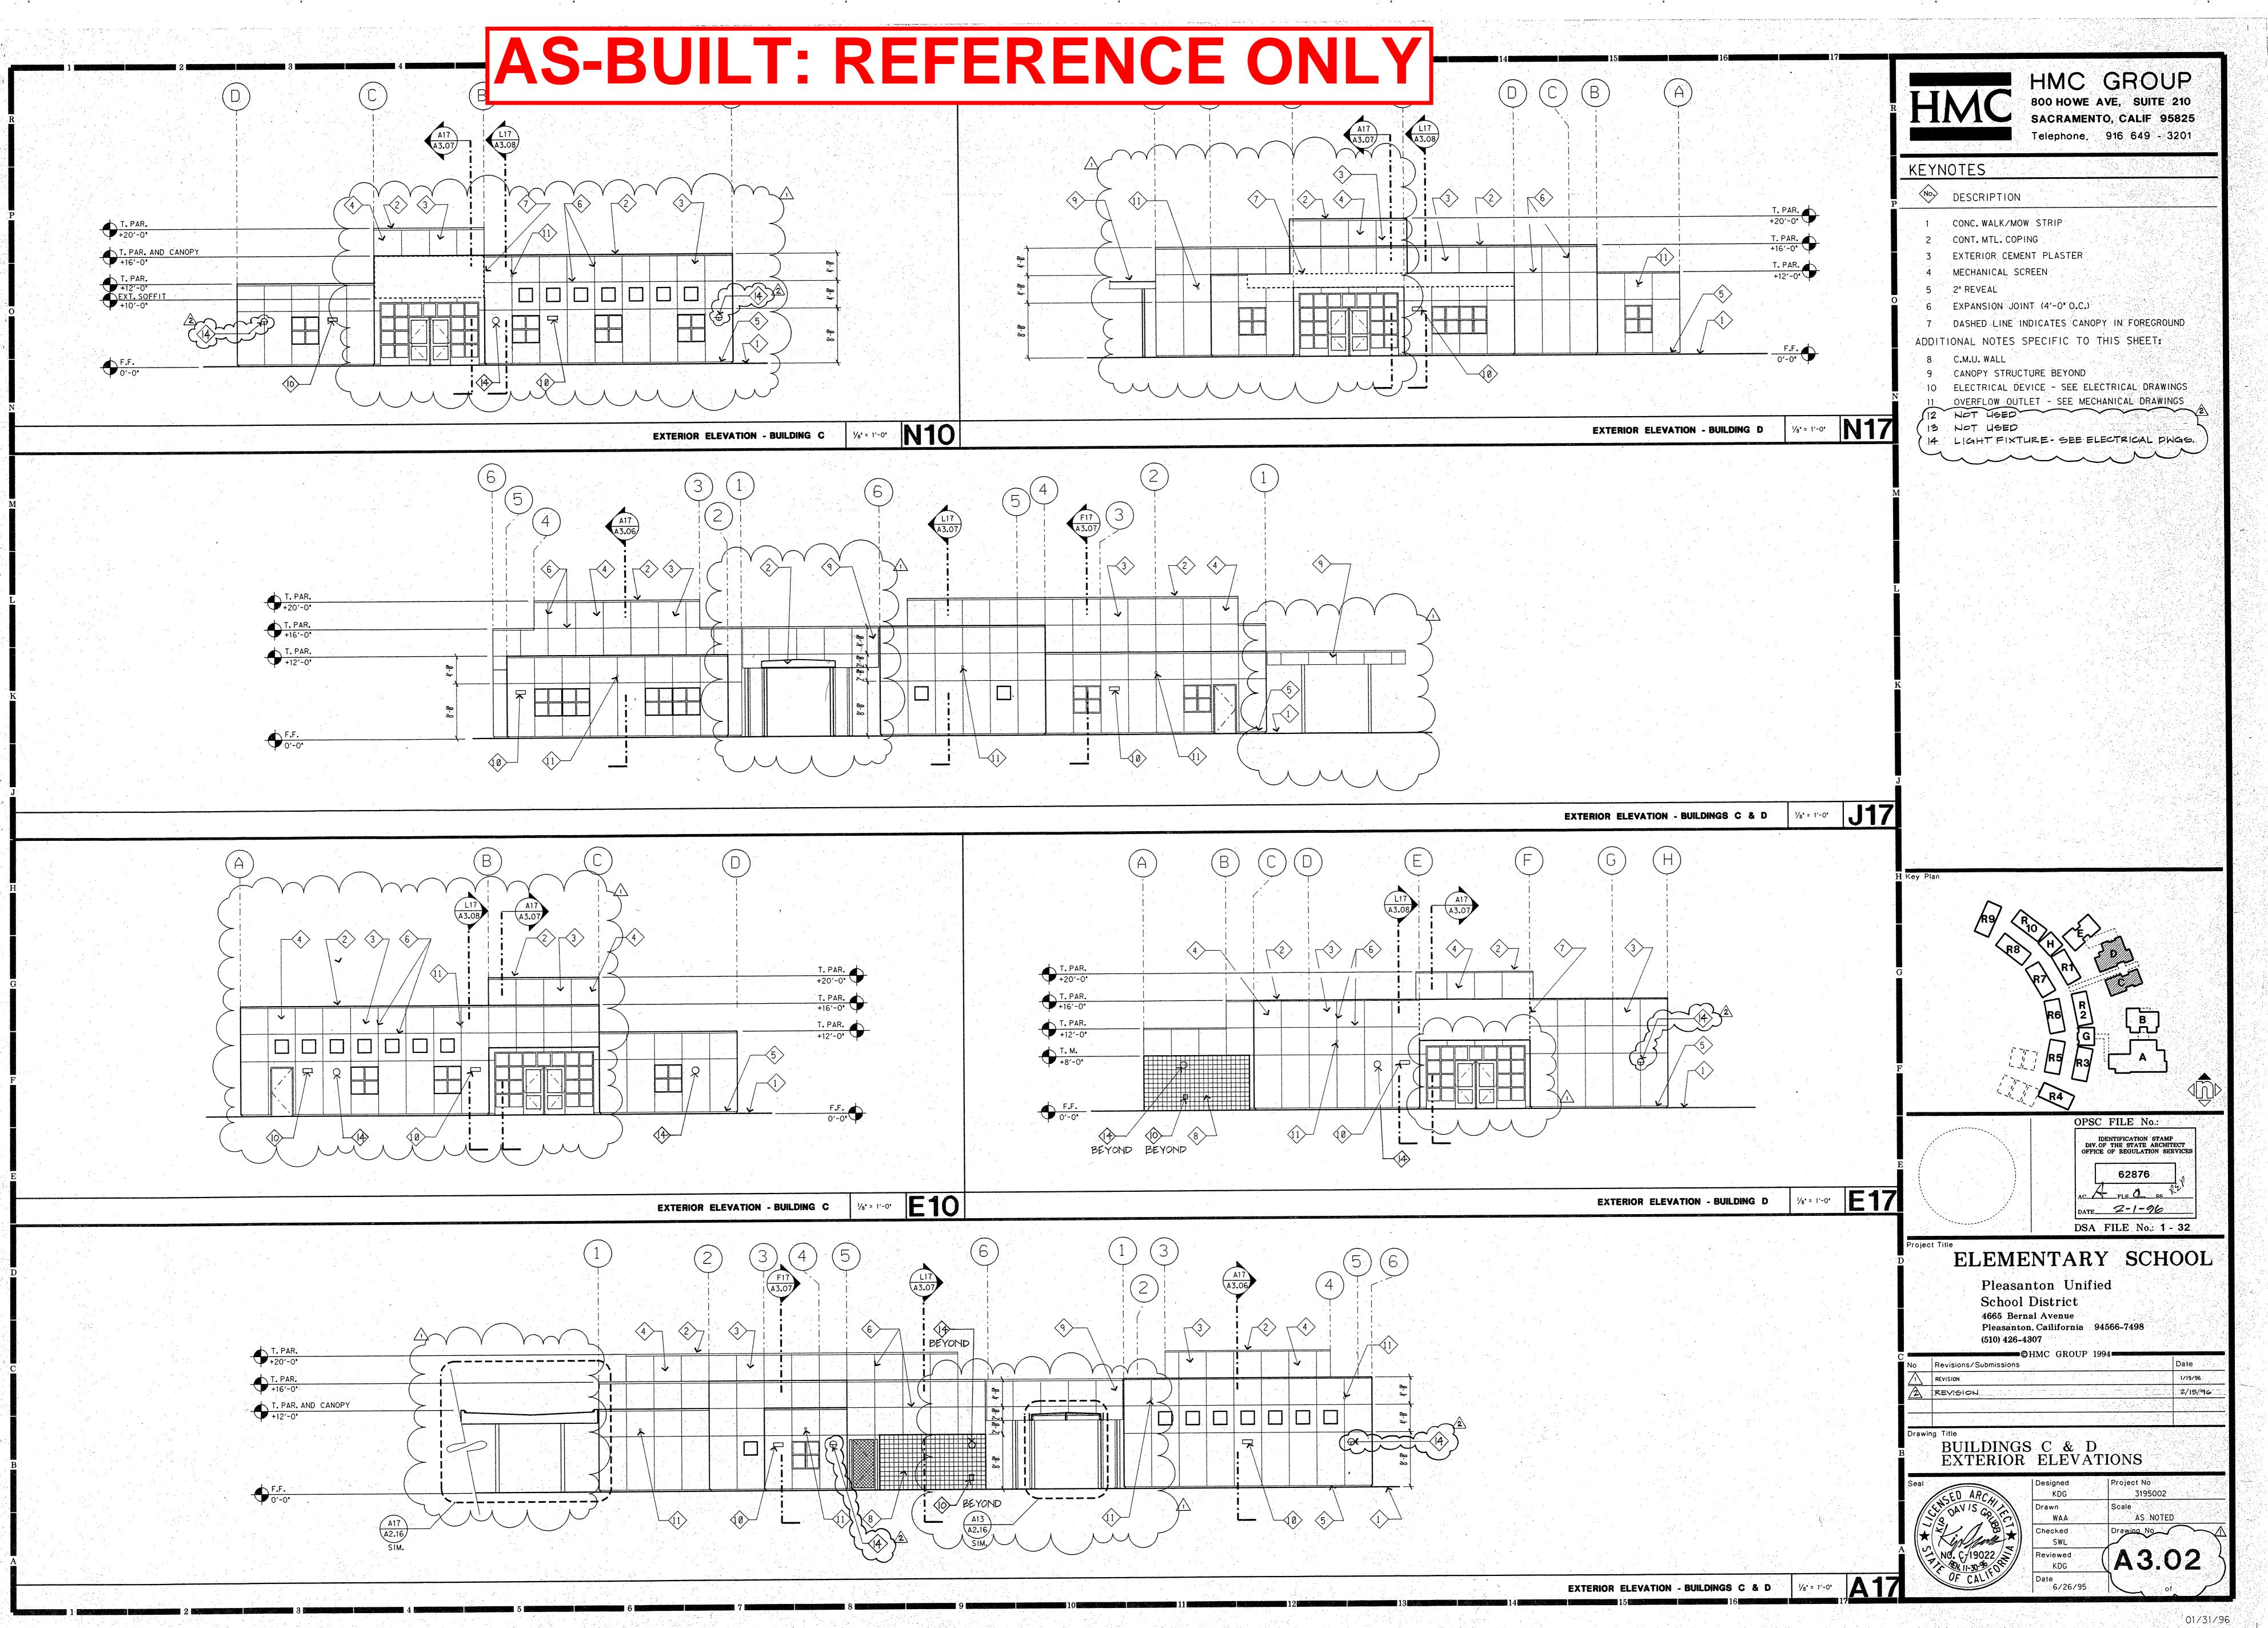


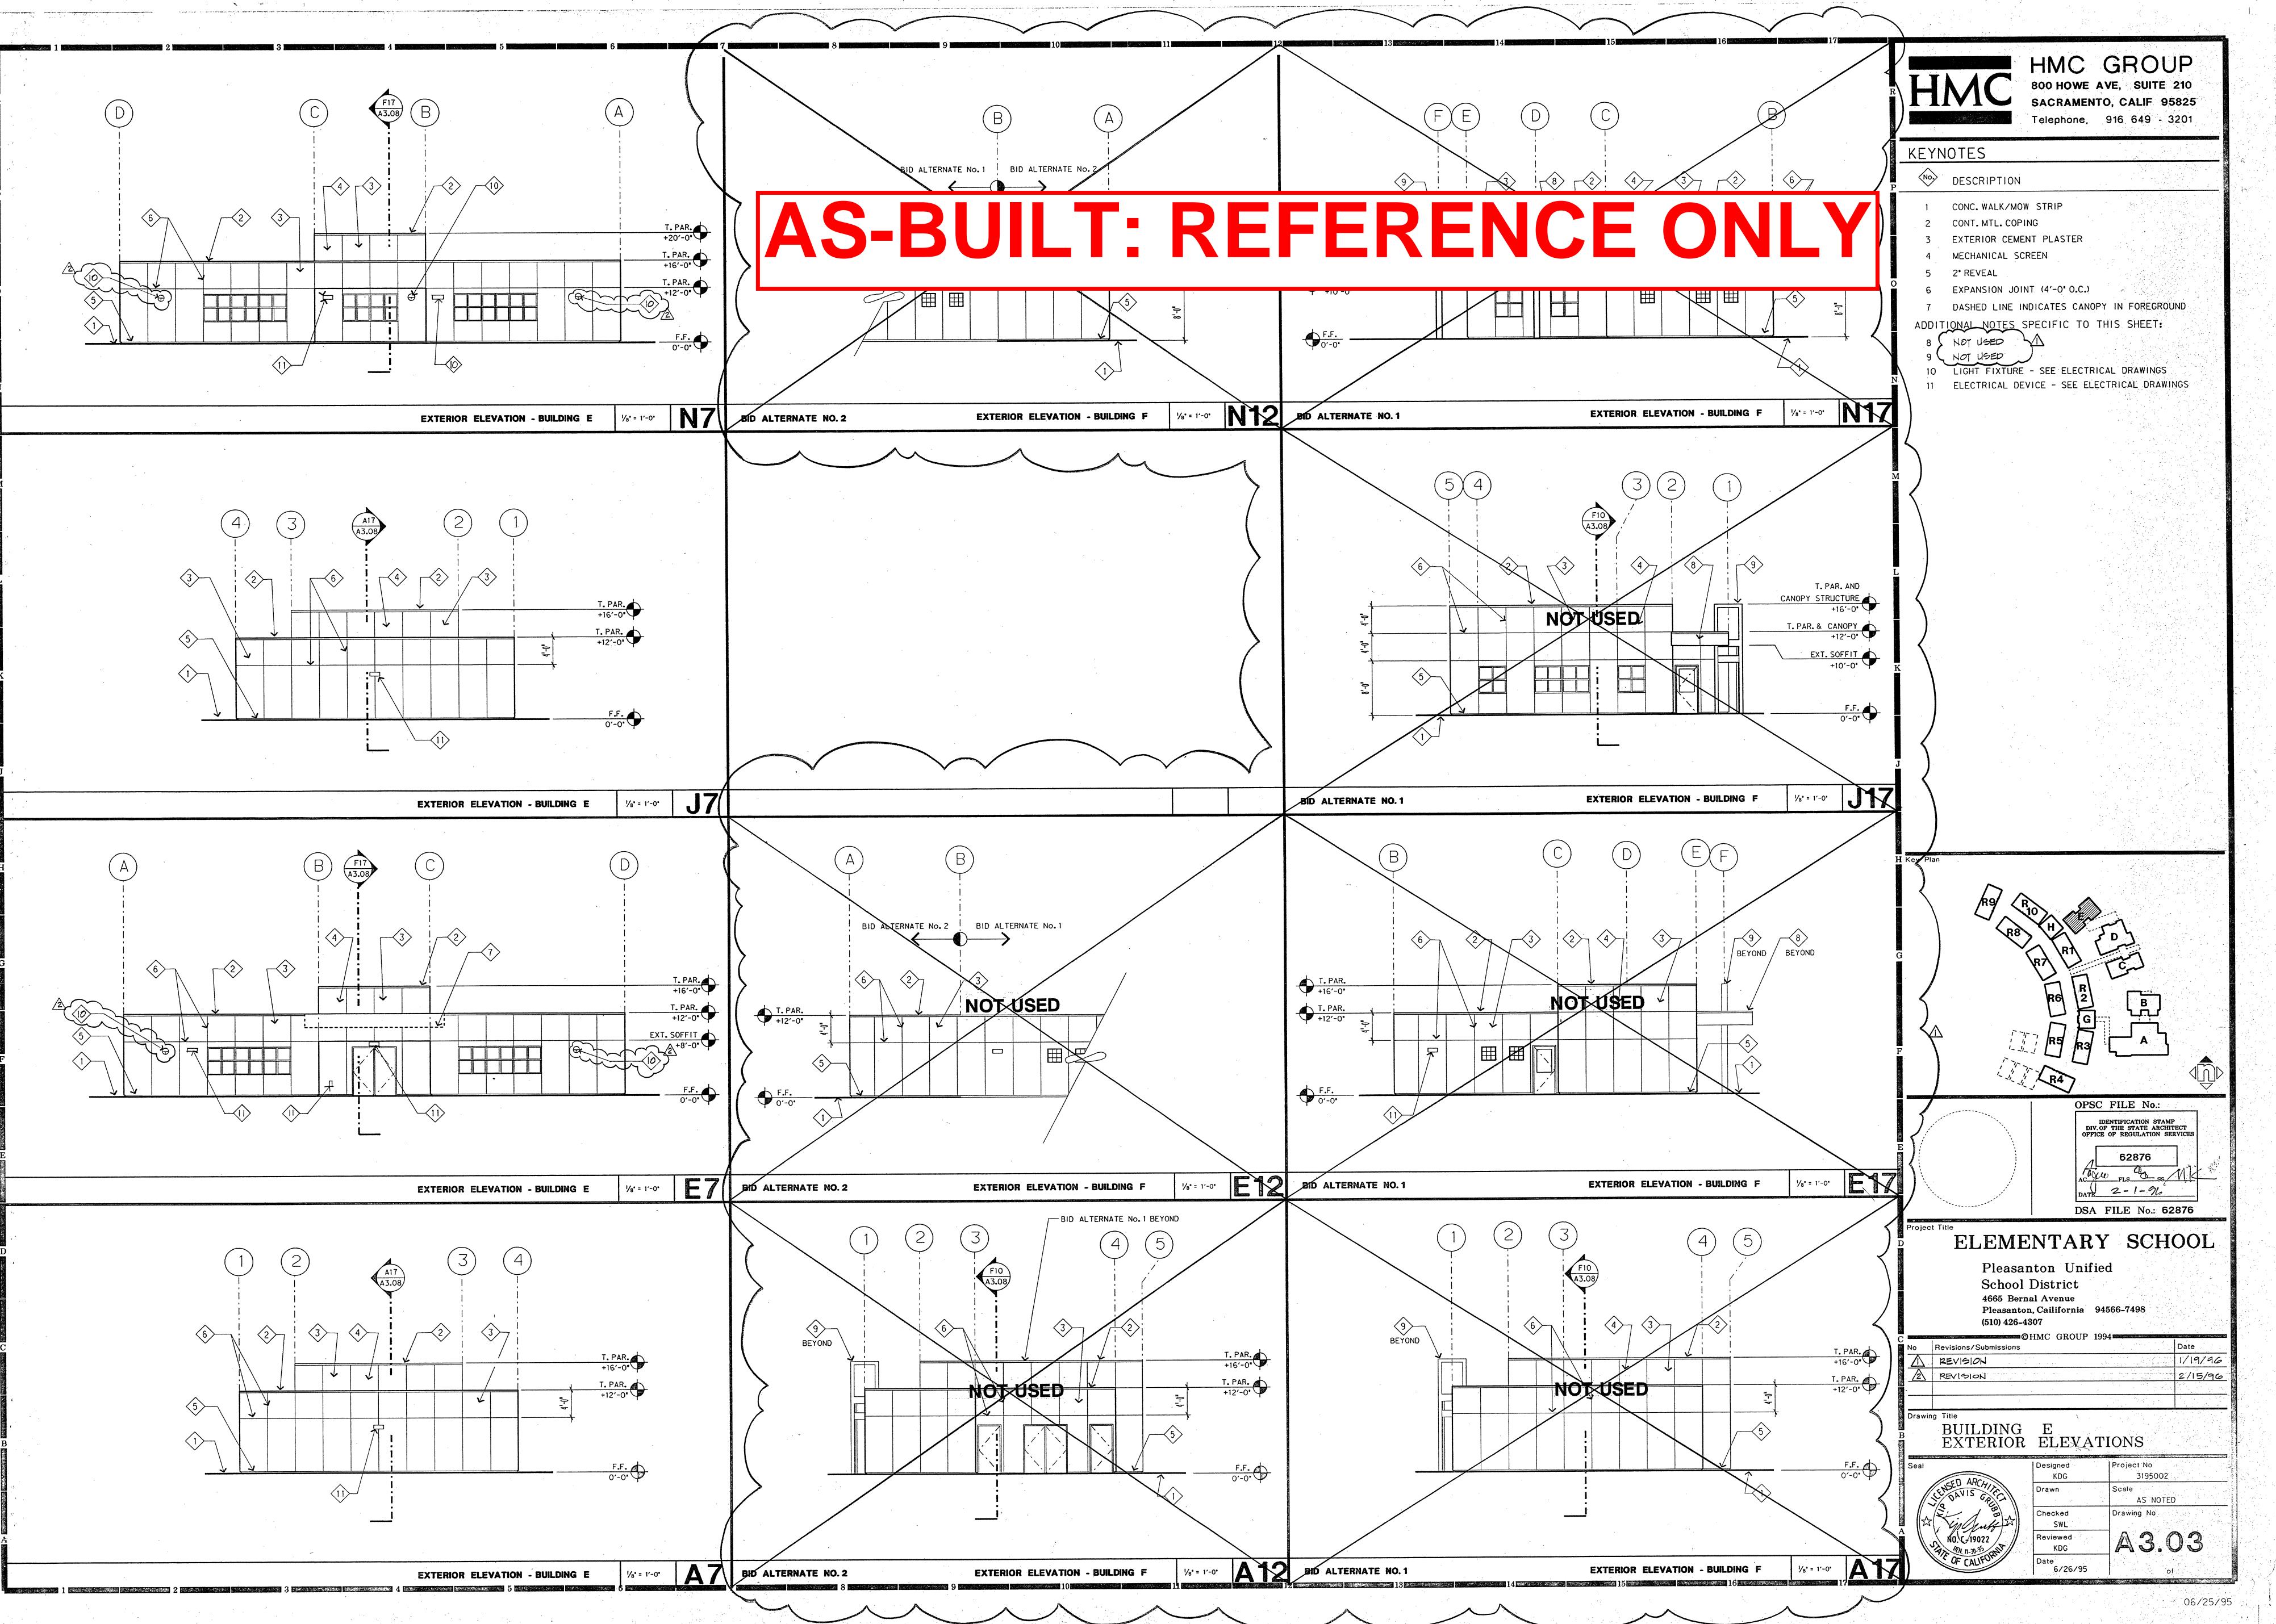


AS-BUILT: REFERENCE ONLY Note: Building H is now Building E


(12)

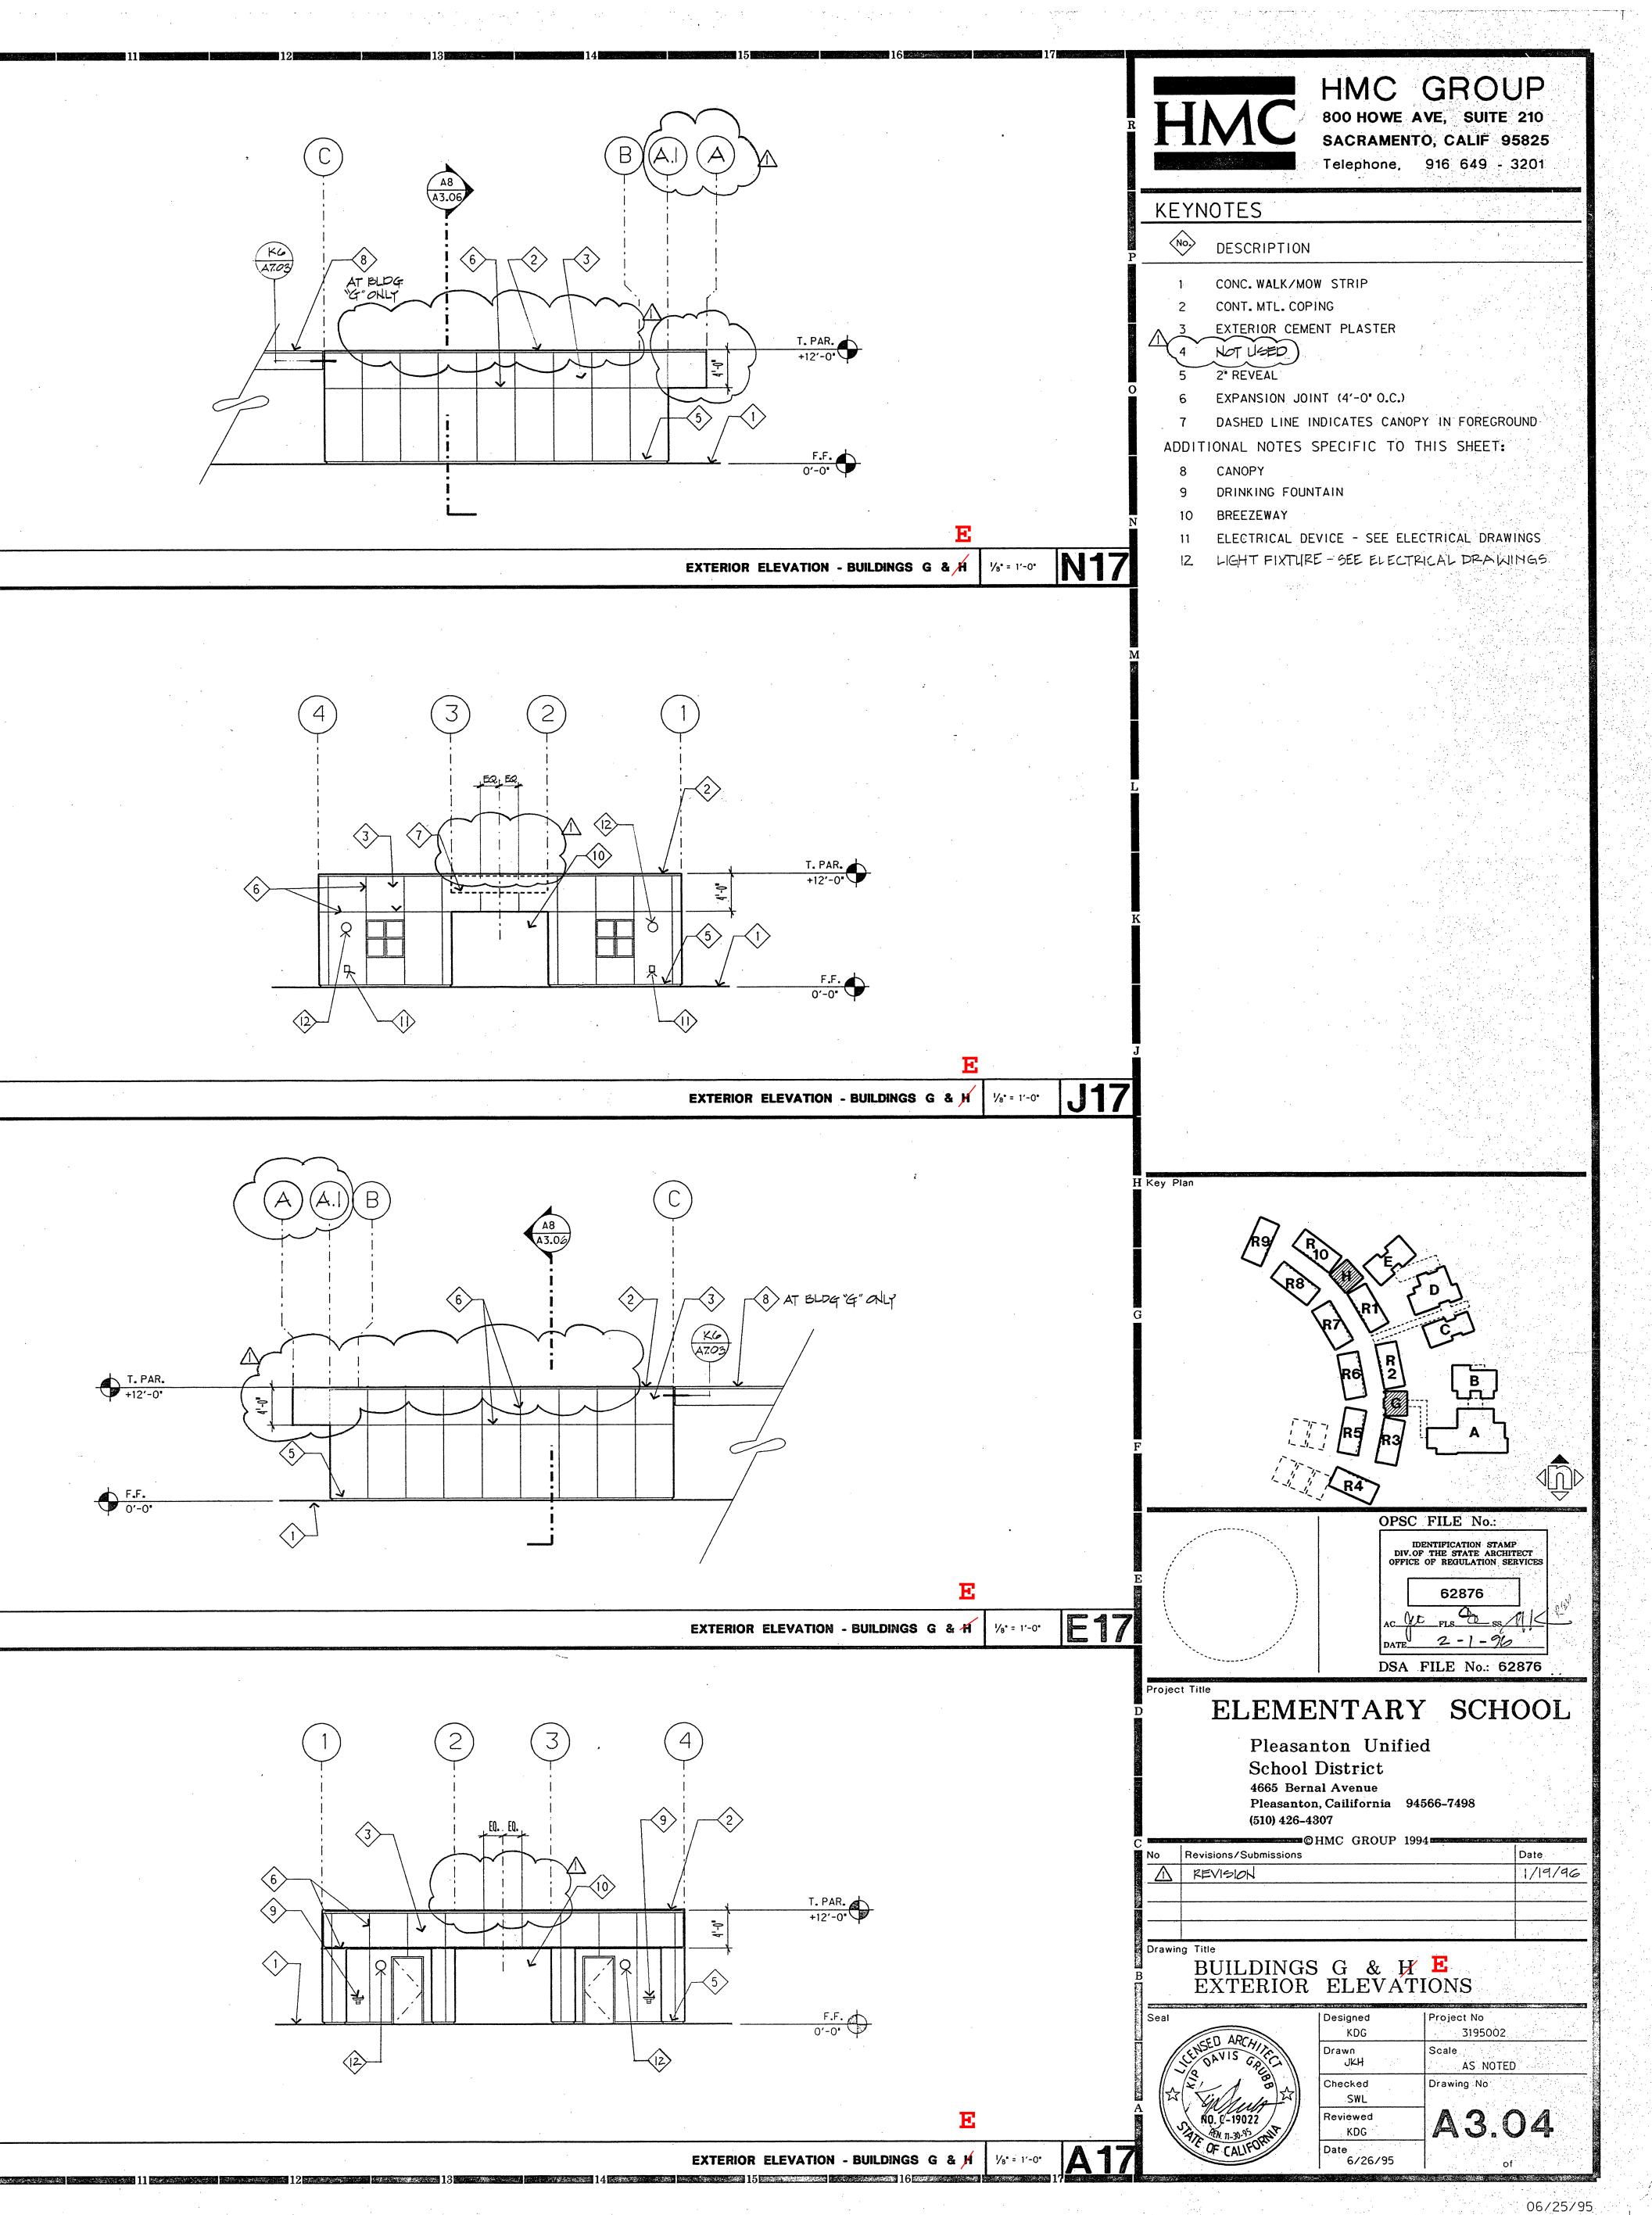

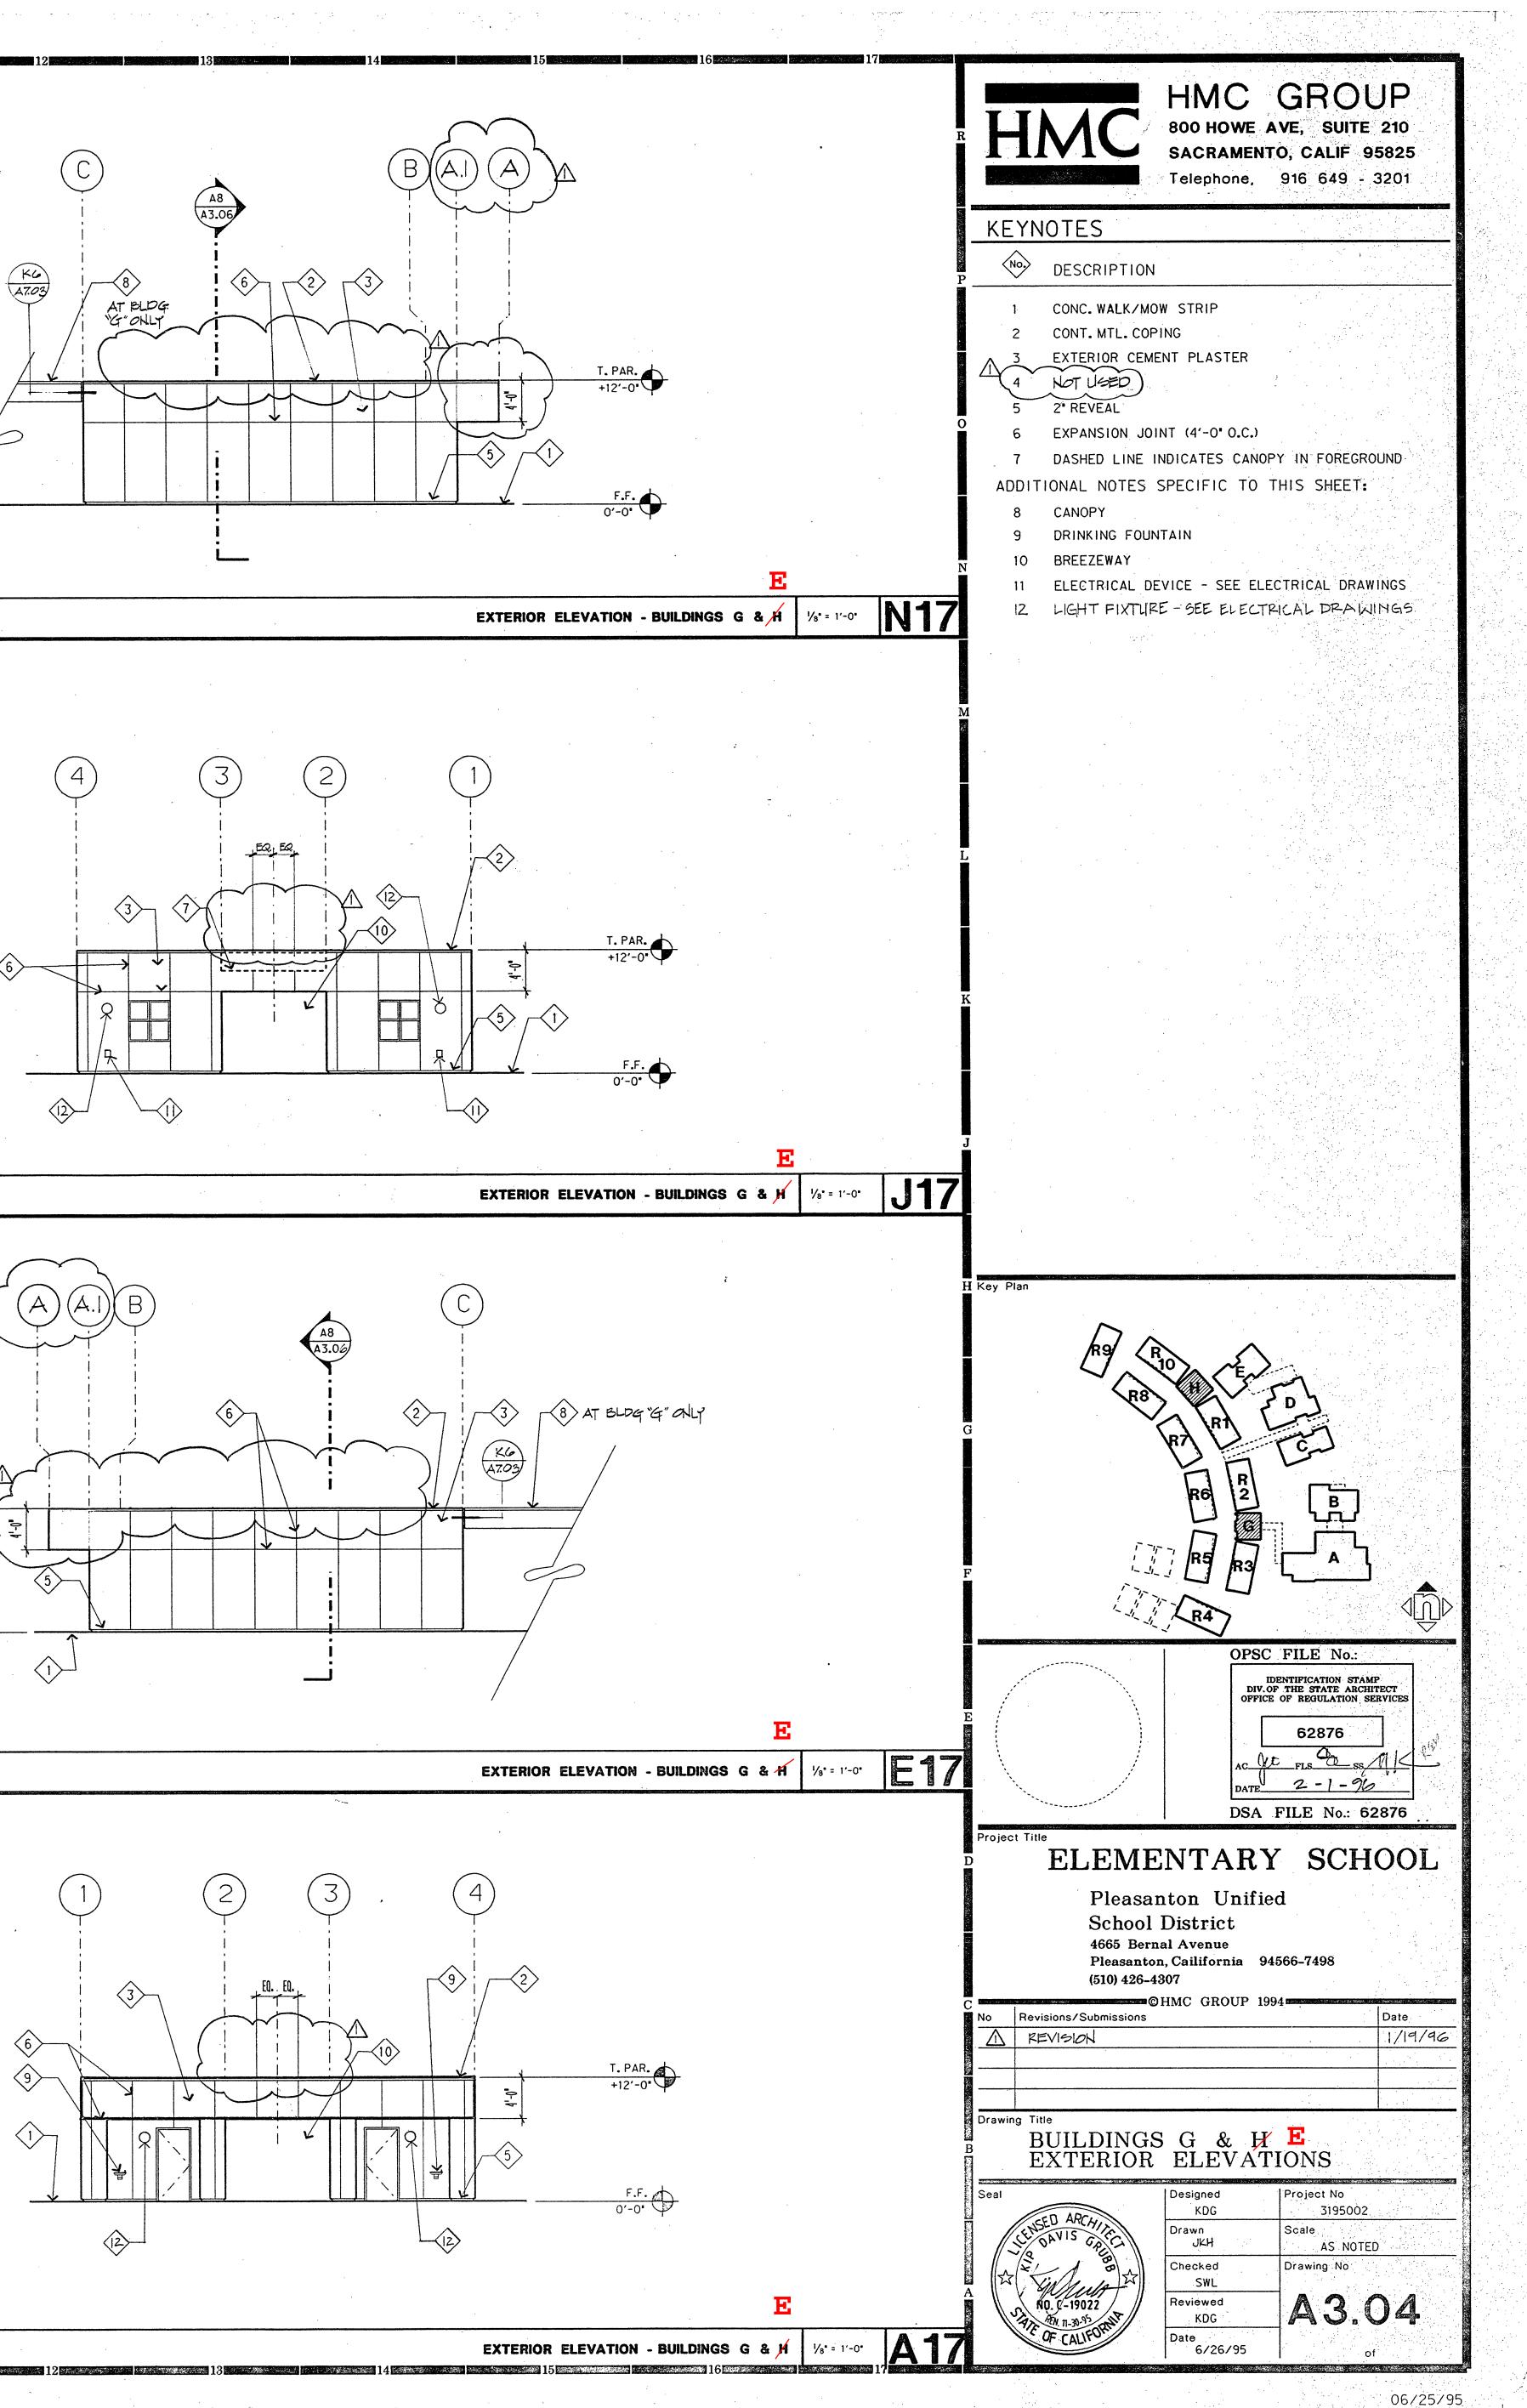

MANDATORY JOB WALK SIGN-IN SHEET

Project:	Mohr ES Campus Wide Exterior Painting	Υ,	Meeting Date:	February 9, 2022 2:30PM	
Facilitator:	Ben Kerr, Project Manager - VPCS	he seense to	Place/Room:	Mohr Elementary School	

Name	Title	Company	Phone	E-Mail
Nick	SUP-	HBRAND	4(316)99132	25 HBMG. 17 D Grand - com
Tony Curiel	Driver	Overhaul Construe	(209)968-1947	Verhaul-construction@ xahoo.com
Adam Couldert	Supervisor	Ricific Contractors bio	p (818) 993 -5899	Pacificcontractorsinc@gmail.com
Sean Prasod	Supervisor	Polychrome inc.	Han	s into apoly anometainting. com
DAVIDRICE	DWIDER	DtD-	925995299	> depainting @councust.com
Azaruptan Akber	a Supervisor	Color New Co.	8 1888 408	Color new CO@ Yahoo. com
Michae Cohe	1 buner	PDB Inc	415-720-914	56 (olor new CO@ Yahoo. com 13 Piedmon Hostlers blasting@gman
Manoli Kourana			650	Freshstantmat. entt. net
Zark KARAISA	6 .	ATHENS P. quilie	242444	B KThans PANES & arcas- 40
Timmy S.	1	Anchor SighPainny	916.595-1837	Anchorspainting @gmail.com
Michael Wright	PM	-		8 mike. Wrighte maskerpainting. com
esar arroyo	Superviser	George E. Masker Satellite		op Cesar Q satpainting. com.

Dimitries Invorker | D&D Painting (415) 601-6907 | dionoysios6364ahoo

GSP painting inc / worker / GSP painting inc / 916 799 8844 /golden state painting George Muradyan

ESTIMATOR. Fick Marcano Estimator (Valdez Ptg. / 415-359-7602/ nuarcano Ovel.