Preliminary
Pending P.L.S. Review

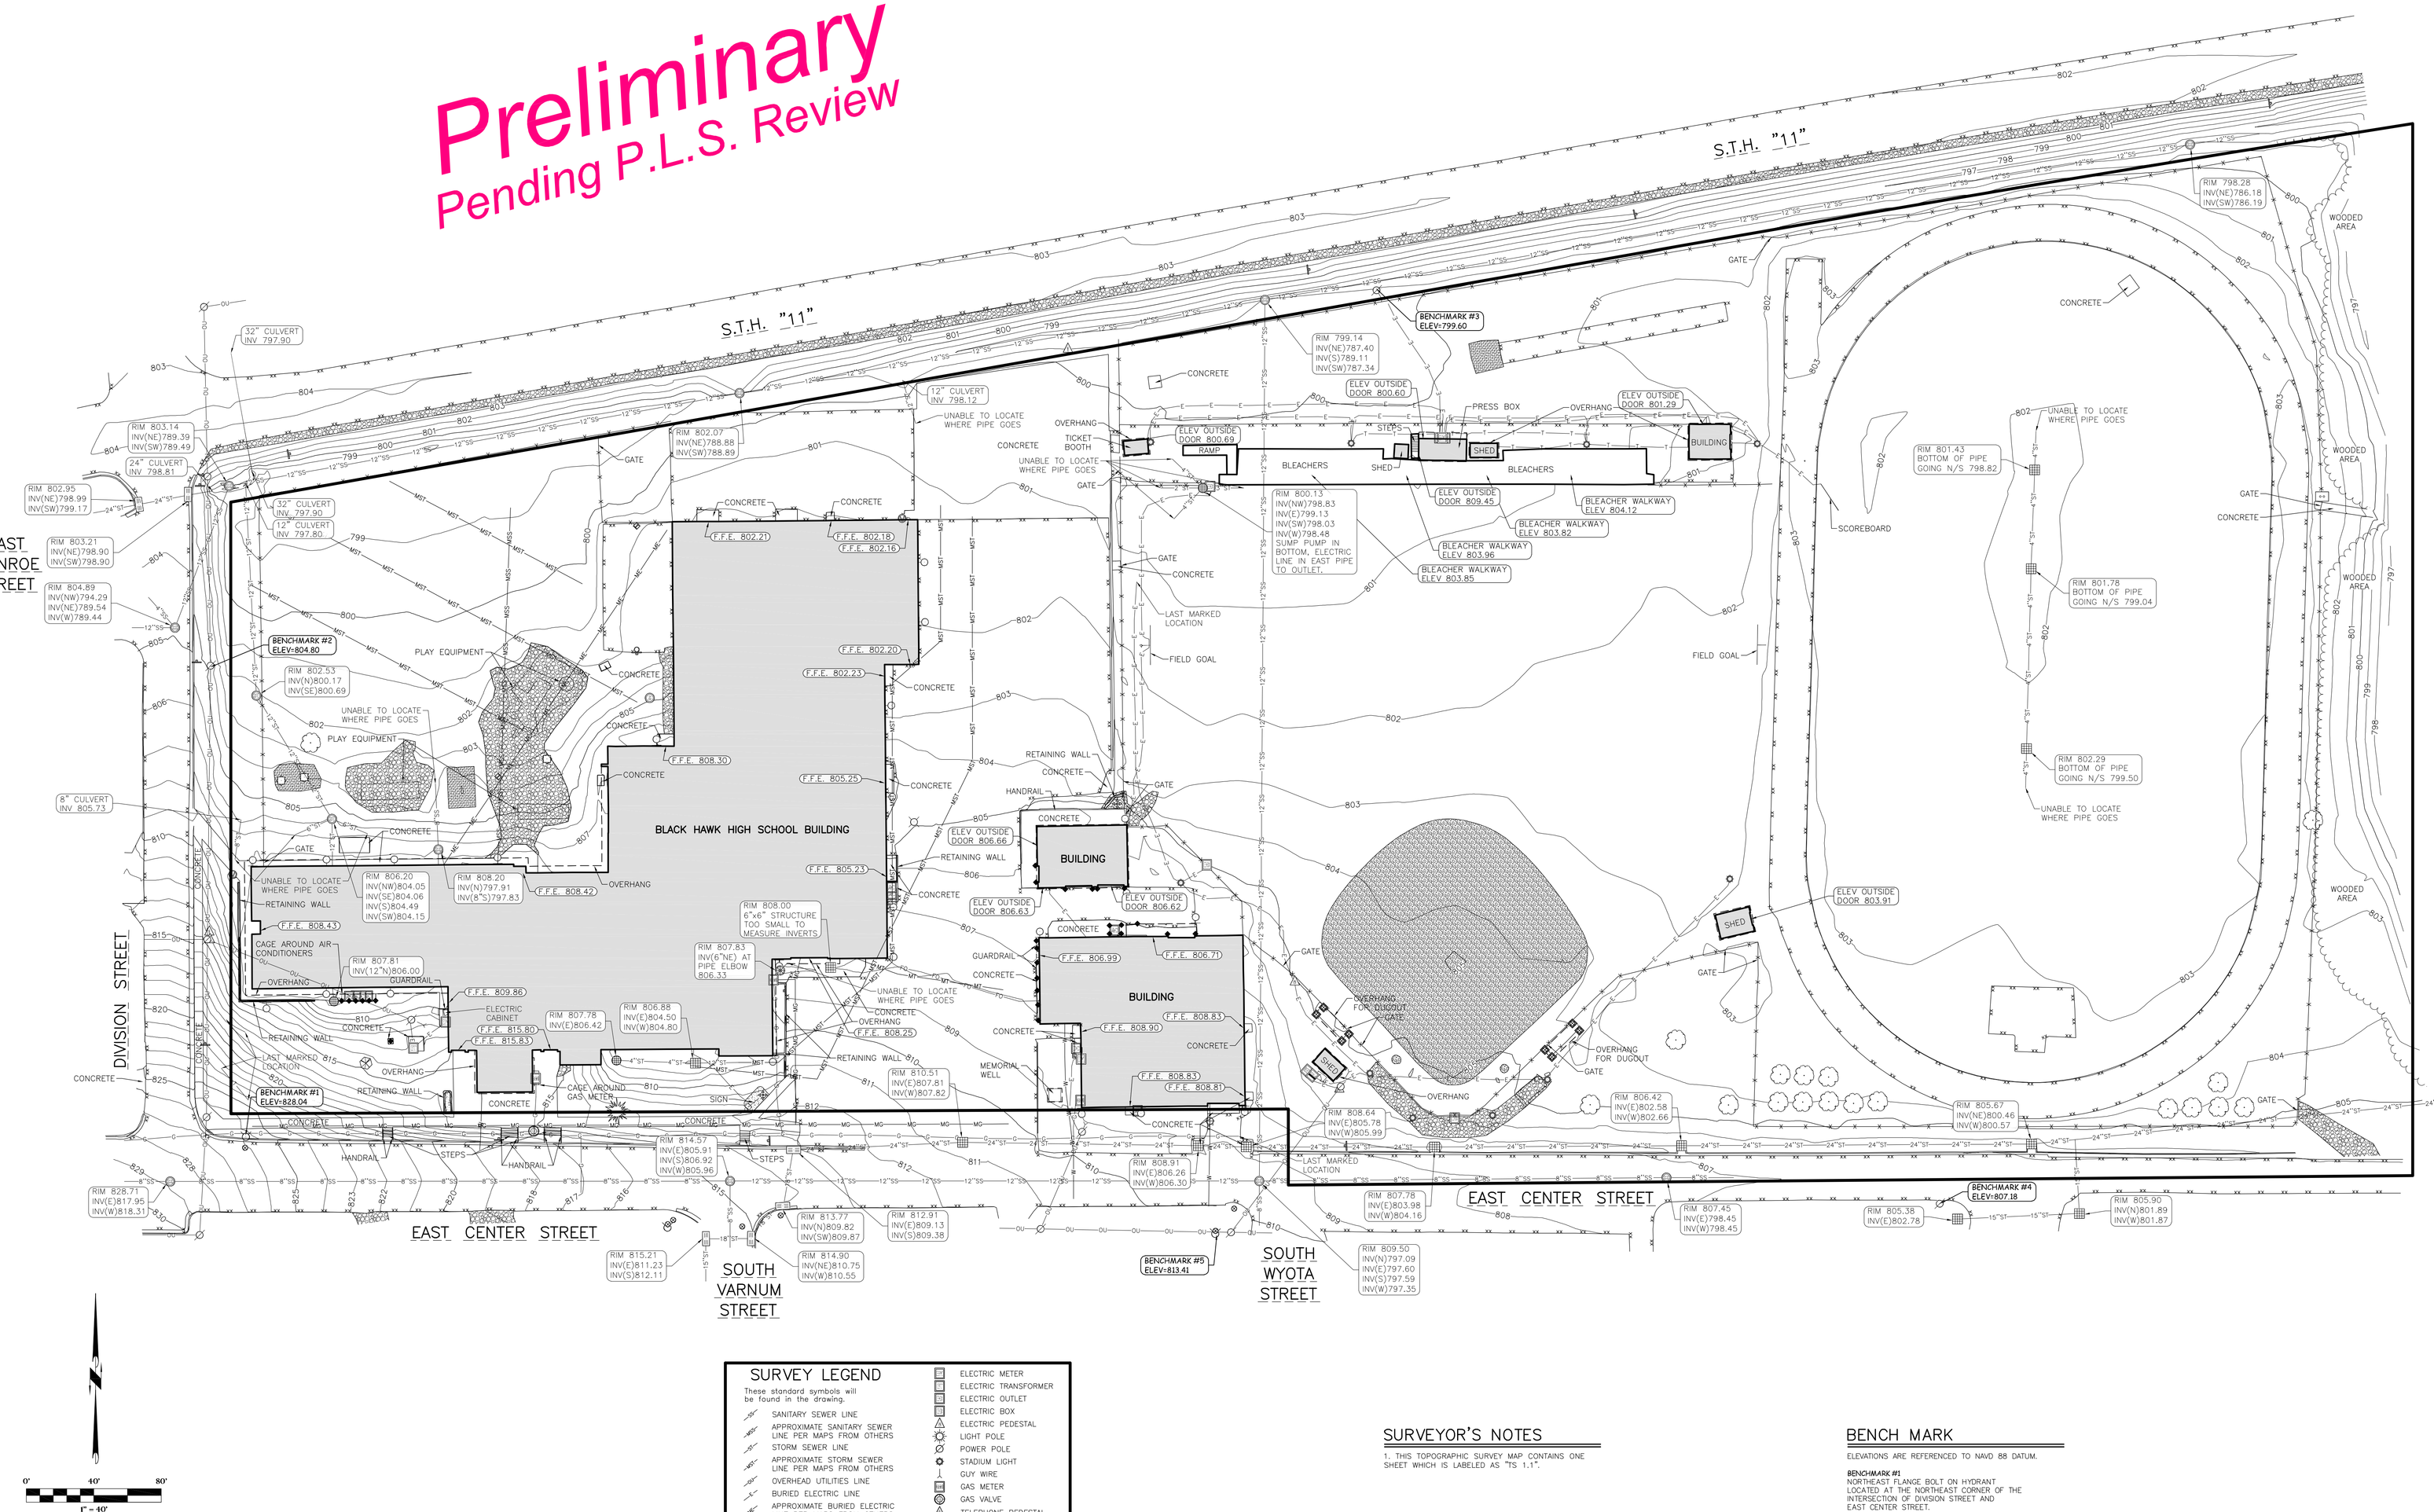

SURVEY LEGEND

These standard symbols will be found in the drawing.

- SANITARY SEWER LINE
- APPROXIMATE SANITARY SEWER LINE PER MAPS FROM OTHERS
- STORM SEWER LINE
- APPROXIMATE STORM SEWER LINE PER MAPS FROM OTHERS
- OVERHEAD UTILITIES LINE
- BURIED ELECTRIC LINE
- APPROXIMATE BURIED ELECTRIC LINE PER MAPS FROM OTHERS
- BURIED GAS LINE
- APPROXIMATE BURIED GAS LINE PER MAPS FROM OTHERS
- BURIED TELEPHONE LINE
- APPROXIMATE BURIED TELEPHONE LINE PER MAPS FROM OTHERS
- BURIED WATER LINE
- BURIED FIBER OPTICS LINE
- CHAIN LINK FENCE LINE (UNLESS NOTED OTHERWISE)
- EDGE OF BITUMINOUS
- CONTOUR LINE
- F.F.E. = FINISHED FLOOR ELEVATION
- RECTANGULAR CATCH BASIN
- CIRCULAR CATCH BASIN
- SQUARE CATCH BASIN
- STORM SEWER MANHOLE
- BEEHIVE CATCH BASIN
- SANITARY SEWER MANHOLE
- SEPTIC TANK
- UTILITY MANHOLE
- WATER SERVICE
- WATER VALVE
- HYDRANT
- ELECTRIC METER
- ELECTRIC TRANSFORMER
- ELECTRIC OUTLET
- ELECTRIC BOX
- ELECTRIC PEDESTAL
- LIGHT POLE
- POWER POLE
- STADIUM LIGHT
- GUY WIRE
- GAS METER
- GAS VALVE
- TELEPHONE PEDESTAL
- SOLAR PANEL
- GUARD POST/BOLLARD
- METAL POST
- SQUARE PILLAR
- VENT PIPE
- CLEAN OUT
- AIR CONDITIONING UNIT
- SIGN
- FLAGPOLE
- ROOF DRAIN
- BASKETBALL HOOP
- PLAY EQUIPMENT
- BUSH/SHRUB
- TREE
- PINE TREE
- GRAVEL AREA
- RIP RAP AREA
- INFIELD MATERIAL
- LANDSCAPE AREA
- SAND AREA

SURVEYOR'S NOTES

1. THIS TOPOGRAPHIC SURVEY MAP CONTAINS ONE SHEET WHICH IS LABELED AS "TS 1.1".

CLIENT

SCHOOL DISTRICT OF BLACK HAWK
202 EAST CENTER STREET
SOUTH WAYNE, WI 53587

OWNER

BLACK HAWK SCHOOLS
PO BOX 303
SOUTH WAYNE, WI 53587

BENCH MARK

ELEVATIONS ARE REFERENCED TO NAVD 88 DATUM.

BENCHMARK #1
NORTHEAST FLANGE BOLT ON HYDRANT
LOCATED AT THE NORTHEAST CORNER OF THE INTERSECTION OF DIVISION STREET AND EAST CENTER STREET.
ELEVATION = 828.04

BENCHMARK #2
60d SPIKE ON WEST SIDE OF POWER POLE
LOCATED SOUTHEAST OF THE INTERSECTION OF DIVISION STREET AND EAST MONROE STREET.
ELEVATION = 804.80

BENCHMARK #3
60d SPIKE ON NORTHWEST SIDE OF POWER POLE
LOCATED ON THE SOUTH SIDE OF S.T.H. "11", NORTH OF THE BLEACHERS AND PRESS BOX.
ELEVATION = 799.60

BENCHMARK #4
RAILROAD SPIKE ON NORTH SIDE OF POWER POLE
LOCATED ON THE SOUTH SIDE OF EAST CENTER STREET, APPROXIMATELY 385 FEET EAST OF THE INTERSECTION OF EAST CENTER STREET AND SOUTH WYOTA STREET.
ELEVATION = 807.18

BENCHMARK #5
EAST FLANGE BOLT ON HYDRANT
LOCATED AT THE SOUTHWEST CORNER OF THE INTERSECTION OF EAST CENTER STREET AND SOUTH WYOTA STREET.
ELEVATION = 813.41

⚠ UTILITY DISCLAIMER ⚠

The locations of all above ground utilities and appurtenances (i.e. manhole rims, valve box covers, hydrants, transformers, etc.) of which can be visually inspected, are shown hereon based on actual surveyed location. Rim elevations of sanitary sewer and storm sewer manholes, of which can be visually inspected, are shown hereon based on actually surveyed elevation. Depths, sizes, and material types of pipes, which can be visually inspected, entering and exiting sanitary sewer and storm sewer manholes, are shown hereon based on visual inspection, field measurements, and as-built mapping, if available. If depths, sizes, and material types of pipes are shown hereon, based on as-built mapping only, they are noted accordingly, and are considered approximate. Visual inspection means what can be seen from the ground surface. Point of Beginning did not enter into manholes to complete visual inspection underground.

The locations of all underground utilities and appurtenances, unable to visually inspect and/or field measure, shown hereon are only approximate. These utilities and appurtenances will be shown based on plans obtained from utility companies or provided by the Owner/Client, and markings by utility companies and municipalities (Diggers Hotline) and other appropriate sources (with reference as to the source of information). Additional utility lines not discovered, marked, or shown on as-built plans available to us, during the search of records and the field survey, may exist. Any contractor using the information shown hereon will be forewarned that any excavation upon this site may result in the discovery of additional underground utilities not shown hereon. POB makes no warranty of any kind, express or implied, with respect to the existing underground utilities and appurtenances, of which are unable to visually inspect and/or field measure, whether shown hereon, or not. Prior to construction, it is the contractors responsibility to field verify locations, depths, sizes and types of underground public and private utilities or substructures within all construction limits and shall bring forward, in writing to the Engineer and/or Surveyor of Record, all discrepancies between the plans and field conditions, prior to any work being performed. "Diggers Hotline Ticket # 20222303038 for public utilities was ordered for this survey. "A private utility locate was performed on this project by Private Lines Inc. Please contact Private Lines Inc. at 715-445-5383 with any private utility questions.

POINT OF BEGINNING, INC. HOLDS THE RIGHTS TO COPYRIGHT IN AND TO THESE PRINTS, DRAWINGS AND DOCUMENTS. NO REPRODUCTION, COPYING, ALTERATION, MODIFICATION, USAGE, INCORPORATION INTO OTHER DOCUMENTS OR ASSIGNMENT OF THE SAME MAY OCCUR WITHOUT THE PRIOR WRITTEN PERMISSION OF POINT OF BEGINNING, INC.

© 2022 POINT OF BEGINNING, INC.

REVISIONS

CHECKED:	JORDAN G. BROST
DRAWN:	CHAD A. GORETSKI
DATE	6-13-22
PROJECT NO.	22.415

TOPOGRAPHIC SURVEY

SCHOOL DISTRICT OF BLACK HAWK
BLACK HAWK HIGH SCHOOL
VILLAGE OF SOUTH WAYNE
LAFAYETTE COUNTY, WISCONSIN

Civil Engineering
Land Surveying
Landscape Architecture

4941 Kirschling Court
Stevens Point, WI 54481
715.344.9999 [PH] 715.344.9922 [FX]

Point of Beginning

TS 1.1