DLR Group
Architecture Engineering Planning Interiors

1050 20th Street, Suite 250
Sacramento, CA 95811

July 10, 2020

ADDENDUM 03

Pre-Bid Revision for Contractors' Incorporation into:



Roseville Joint Union High School District
West Park High School, Phase 2 – Increment 1
DSA Application Number: 02-118062

Prepared By: DLR Group
1050 20th Street, Suite 250
Sacramento, CA 95811
(916) 446-0206

DLR Group Project No: 75-19101-00

NOTICE TO BIDDERS:
The following revisions are being made to the Bidding Documents to the above referenced project:

Pre-Bid Requests for Information

The following pre-bid requests for information were received. The responses are incorporated into this Addendum via the answer directly below the RFI.

RFI 1. The RFP directions for Tab 2 are "All issued addenda. It is the responsibility of Respondents to check the District's website to ensure that they have received all addenda." This could be interpreted as to include all the issued addenda within our proposal. As the addenda issued to date a contain a large quantity of pages, would it be acceptable to include just the first sheet of each addendum in Tab 2 or submit a written confirmation in Tab 2 that acknowledges each addendum and their date of issuance?

Answer *Do not include the Addendums within the proposal. Written confirmation acknowledging receipt of each Addendum is required.*

A. PROJECT MANUAL

1. **Section 00 01 10 TABLE OF CONTENTS (DIVISIONS 00-14)**
   A. ADDED Specification 09 05 61.13 - MOISTURE VAPOR EMISSION CONTROL

2. **Section 09 05 61.13 - MOISTURE VAPOR EMISSION CONTROL**
   A. NEW specification section for moisture vapor emission control for interior concrete to prepare it for floor finish installation. Reference RFI 107 from Addendum 02 dated 07/08/2020.

3. **Section 10 21 13 PLASTIC TOILET AND SHOWER COMPARTMENTS**
   A. REVISED Paragraphs 2.3.C and 2.3 D for door and partition heights.

B. DRAWINGS

As summarized in pre-bid items indicated on this addendum, the following sheets are attached:

1. **Sheet A13.FX.X FINISH FLR PLANS & SCHEDULES – BLDG F – 1ST, 2ND & 3 RD FLOOR**
   Sheet A13.SX.X FINISH FLR PLANS & SCHEDULES – BLDG S – 1ST, 2ND & 3 RD FLOOR
   (Sheets not attached)
   A. REVISED Rooms F307 and S307 to have recessed roller shades in gyp ceiling per new detail 15/S.12.
   B. All other rooms with roller shades to be wall-mounted in mfr provided shade pockets. Bottom of shade pocket to align with T.O. storefront/ window head. Provide continuous flat strap backing across length of window and attach to wall with (2) #10 self-tapping screws into each wall stud (similar to new detail 15/S3.12).

2. **Sheet A3.12 CEILING DETAILS**
   C. ADDED detail 15/ A3.12 – Roller shade recessed in gyp ceiling

3. **Sheet M1.F.2 BLDG F SECOND FLOOR - MECHANICAL**
   D. REVISED ductwork and exhaust fans for full height partitions at All gender restroom.

4. **Sheet M1.F.3 BLDG F THIRD FLOOR - MECHANICAL**
   A. REVISED ductwork and exhaust fans for full height partitions at All gender restroom.

5. **Sheet M1.S.2 BLDG S SECOND FLOOR - MECHANICAL**
   A. REVISED ductwork and exhaust fans for full height partitions at All gender restroom.

6. **Sheet M1.S.3 BLDG S THIRD FLOOR - MECHANICAL**
   A. REVISED ductwork and exhaust fans for full height partitions at All gender restroom.

7. **Sheet E2.F1.2 LIGHTING PLAN – FOOTHILL BUILDING – SECOND FLOOR**
   Sheet E2.F1.3 LIGHTING PLAN – FOOTHILL BUILDING – THIRD FLOOR
   Sheet E2.S1.2 LIGHTING PLAN – SIERRA BUILDING – SECOND FLOOR
   Sheet E2.S1.3 LIGHTING PLAN – SIERRA BUILDING – THIRD FLOOR
   (Sheets not attached)
   A. REVISED lighting – In All Gender Restrooms RR F228, F328, S228, S328, replace the F7/16' linear fixture with eight F8 downlights. One F8 downlight is centered above each of the six toilets. The remaining two are located in front of the stalls, centered in the walkway.

8. **Sheet FP1.F2.1 FIRE SPRINKLER – BLDG F – 2ND FLOOR**
   A. REVISED piping at All-gender restroom
   B. ADDED sprinkler heads to each stall at All gender restroom

9. **Sheet FP1.F3.1 FIRE SPRINKLER – BLDG F – 3RD FLOOR**
   A. *REVISED piping at All-gender restroom*
   B. *ADDED sprinkler heads to each stall at All gender restroom*

10. **Sheet FP1.S2.1 FIRE SPRINKLER – BLDG S – 2ND FLOOR**
   A. *REVISED piping at All-gender restroom*
   B. *ADDED sprinkler heads to each stall at All gender restroom*

11. **Sheet FP1.S3.1 FIRE SPRINKLER – BLDG S – 3RD FLOOR**
   A. *REVISED piping at All-gender restroom*
   B. *ADDED sprinkler heads to each stall at All gender restroom*

****End of ADDENDUM 03****

SECTION 00 01 10 - TABLE OF CONTENTS (DIVISIONS 00-14)

VOLUME I

DIVISION 00 – PROCUREMENT AND CONTRACTING REQUIREMENTS
Section 00 0107 Seals Page
Section 00 0110 Table of Contents
Section 00 3132 Geotechnical Data (Soils Report)
Geotechnical Engineering Report

DIVISION 01 - GENERAL REQUIREMENTS
Section 01 1000 Summary
Section 01 2100 Allowances
Section 01 2500 Substitution Procedures
Substitution Request Form
Section 01 2600 Contract Modification Procedures
Section 01 2900 Payment Procedures
Section 01 3100 Project Management and Coordination
Request for Information Form
Section 01 3200 Construction Progress Documentation
Section 01 3233 Photographic Documentation
Section 01 3300 Submittal Procedures
Section 01 3333 Electronic Drawings
AIA C106-2013
Section 01 4000 Quality Requirements
Section 01 4200 References
Section 01 4339 Mockups
Section 01 5000 Temporary Facilities and Controls
Section 01 6000 Product Requirements
Section 01 7300 Execution
Section 01 7419 Construction Waste Management and Disposal
Form CWM-1 for construction waste identification
Form CWM-3 for construction waste reduction work plan
Form CWM-7 for construction waste
Section 01 7590 Post-Construction Acoustic Testing
Section 01 7700 Closeout Procedures
Section 01 7823 Operation and Maintenance Data
Section 01 7839 Project Record Documents
Section 01 7900 Demonstration and Training
Section 01 8113 Sustainable Design Requirements – CALGreen
Section 01 9113 General Commissioning Requirements

DIVISION 02 - EXISTING CONDITIONS
Section 02 4119 Selective Demolition

DIVISION 03 - CONCRETE

Section 03 1000 Concrete Formwork
Section 03 2100 Reinforcing Steel
Section 03 3000 Cast-In-Place Concrete
Section 03 3542 Concrete Sealing
Section 03 3543 Polished Concrete Finishing
Section 03 4500 Precast Architectural Concrete

DIVISION 04 - MASONRY

Section 04 0500 Mortar and Grout
Section 04 2200 Concrete Masonry Unit
Section 04 2613 Adhered Thin-Brick Masonry Veneer
Section 04 4313 Anchored Masonry Veneer

DIVISION 05 - METALS

Section 05 1200 Structural Steel
Section 05 1213 Architecturally Exposed Structural Steel
Section 05 3000 Metal Decking
Section 05 4000 Cold-Formed Metal Framing
Section 05 5000 Metal Fabrications
Section 05 5113 Metal Pan Stairs
Section 05 5213 Pipe and Tube Railings
Section 05 7300 Decorative Metal Railings
Section 05 7500 Metal Fabrications

DIVISION 06 - WOOD, PLASTICS AND COMPOSITES

Section 06 1053 Miscellaneous Rough Carpentry
Section 06 2023 Interior Finish Carpentry
Section 06 4116 Plastic-Laminate-Faced Architectural Cabinets

DIVISION 07 - THERMAL AND MOISTURE PROTECTION

Section 07 1113 Bituminous Dampproofing
~~Section 07 1326 Self-Adhering Sheet Waterproofing~~ ADD 2
Section 07 1800 Traffic Coatings
Section 07 1900 Water Repellents
Section 07 2100 Thermal Insulation
Section 07 2500 Weather Barrier
Section 07 2713 Modified Bituminous Sheet Air Barriers
Section 07 4213 Metal Wall Panels
Section 07 4646 Fiber Cement Siding
Section 07 5400 TPA Membrane Roofing
Section 07 6200 Sheet Metal Flashing and Trim
Section 07 7100 Roof Specialties
Section 07 7200 Roof Accessories
Section 07 8100 Applied Fireproofing
Section 07 8413 Penetration Firestopping
Section 07 8443 Joint Firestopping
Section 07 9200 Joint Sealants

DIVISION 08 - OPENINGS

Section 08 1113 Hollow Metal Doors and Frames
Section 08 1216 Aluminum Frames
Section 08 1416 Flush Wood Doors
Section 08 3113 Access Doors and Frames
Section 08 3613 Sectional Doors (Garage Doors)
Section 08 4113 Aluminum-Framed Entrances and Storefronts
Section 08 4413 Glazed Aluminum Curtain Walls
Section 08 7100 Door Hardware
Section 08 8000 Glazing
Section 08 8300 Mirrors
Section 08 9119 Fixed Louvers

DIVISION 09 - FINISHES

Section 09 0561.13 Moisture Vapor Emission Control ADD3
Section 09 2116 Gypsum Board Assemblies
Section 09 2400 Cement Plastering
Section 09 2513 Acrylic Plastering
Section 09 3013 Ceramic Tiling
Section 09 5123 Acoustical Tile Ceilings
Section 09 6519 Rubber Flooring
Section 09 6580 Rubber Base
Section 09 6723 Resinous Flooring
Section 09 6813 Tile Carpeting
~~Section 09 7200 Wall Coverings~~ ADD 1
Section 09 7201 Clear Finish Anti-Microbial/Anti-Bacterial Epoxy Mosaic Composition Flooring ADD 2
Section 09 7723 Fabric-Wrapped Panels
Section 09 8100 Acoustic Insulation
Section 09 8422 Acoustical Tackable Panels
Section 09 8436 Sound-Absorbing Ceiling Units
Section 09 9113 Paints and Coating
Section 09 9623 Graffiti-Resistant Coatings
Section 09 9737 Dry Erase Coating ADD 2

DIVISION 10 - SPECIALTIES

~~Section 10 1100 Visual Display Units~~ ADD 1
Section 10 1400 Signage
Section 10 2113 Plastic Toilet and Shower Compartments
Section 10 2226 Operable Partitions
Section 10 2600 Corner Wall Protection
Section 10 2623 Protective Wall Covering
Section 10 2800 Washroom Accessories
Section 10 4400 Fire Protection Specialties
Section 10 5613 Metal Storage Shelving

DIVISION 11 - EQUIPMENT

~~Section 11 1416 Pedestrian Control Devices~~ ADD 1
Section 11 3013 Residential Appliances
Section 11 5213 Projection Screens
Section 11 7310 Special Needs Equipment

DIVISION 12 - FURNISHINGS
Section 12 2413 Roller Window Shades
Section 12 3553 Laboratory Casework
Section 12 36 23.13 Plastic-Laminate-Clad Countertops
Section 12 9200 Site Furnishings and Equipment

DIVISION 13 - SPECIAL CONSTRUCTION (NOT USED)

DIVISION 14 - CONVEYING EQUIPMENT
Section 14 2400 Hydraulic Elevators

SECTION 00 01 10 - TABLE OF CONTENTS (DIVISIONS 21-33)

VOLUME II

DIVISION 21 - FIRE SUPPRESSION
Section 21 0500 Common Work Results for Fire Suppression
Section 21 0523 General-Duty Valves for Water-Based Fire-Suppression Piping
Section 21 0553 Identification for Fire Suppression Piping And Equipment
Section 21 1300 Fire-Suppression Sprinkler Systems

DIVISION 22 - PLUMBING
Section 22 0100 Operating and Maintenance of Plumbing
Section 22 0500 Common Work Results for Plumbing
Section 22 0513 Common Motor Requirements for Plumbing Equipment
Section 22 0523 General Duty Valves for Plumbing Piping
Section 22 0529 Hangers and Supports for Plumbing Piping and Equipment
Section 22 0548 Vibration and Seismic Controls for Plumbing and Equipment
Section 22 0700 Plumbing Insulation General Requirements
Section 22 0716 Plumbing Equipment Insulation
Section 22 0719 Plumbing Piping Insulation
Section 22 0800 Plumbing Cx Specification ADD 2
Section 22 1100 Facility Water Distribution
Section 22 1116 Domestic Water Piping
Section 22 1119 Domestic Water Piping Specialties
Section 22 1123 Domestic Water Pumps
Section 22 1300 Facility Sanitary Sewerage
Section 22 1316 Sanitary Waste and Vent Piping
Section 22 1319 Sanitary Waste and Piping Specialties
Section 22 1416 Rainwater Leaders
Section 22 4000 Plumbing Fixtures

DIVISION 23 - HEATING, VENTILATING AND AIR CONDITIONING
Section 23 0100 Operation and Maintenance of HVAC Systems
Section 23 0500 Common Work Results for HVAC
Section 23 0513 Common Motor Requirements for HVAC Equipment
Section 23 0513.10 Adjustable Frequency Drives
Section 23 0516 Expansion Fittings and Loops for HVAC Piping
Section 23 0519 Meters and Gages for HVAC
Section 23 0523 General Duty Valves for HVAC Piping
Section 23 0529 Hangers and Supports for HVAC Piping and Equipment
Section 23 0530 Hangers and Supports for HVAC Duct Work
Section 23 0548 Vibration and Seismic Controls for HVAC Piping and Equipment
Section 23 0553 Identification for HVAC Piping and Equipment
Section 23 0593 Testing, Adjusting and Balancing
Section 23 0700 HVAC Insulation
Section 23 0713 Duct Insulation
Section 23 0716 HVAC Equipment Insulation
Section 23 0719 HVAC Piping Insulation

Section 23 08 00 Commissioning of Mechanical Systems ADD 2
Section 23 0913.33 Control Valves
Section 23 0923 Temperature Control System
Section 23 1000 Facility Fuel Systems
Section 23 1123 Facility Natural Gas Piping
Section 23 2113 Hydronic Piping
Section 23 2123 Hydronic Pumps
Section 23 2300 Refrigerant Piping
Section 23 2500 HVAC Water Treatment
Section 23 3113 Metal Ducts
Section 23 3116 Non-Metal Ducts
Section 23 3313 Dampers
Section 23 3323 Turning Vanes
Section 23 3343 Flexible Connectors
Section 23 3353 Duct Liner
Section 23 3400 Exhaust Fans
Section 23 3416 Laboratory Exhaust Fans
Section 23 5216 Condensing Boilers
Section 23 7513 Rooftop Air Handler, ACCU & Plate Heat Exchanger

DIVISION 26 - ELECTRICAL
Section 26 0010 Basic Electrical Requirements
Section 26 0060 Power System Study
Section 26 0519 Building Wire and Cable
Section 26 0526 Grounding and Bonding
Section 26 0529 Electrical Hangers and Supports
Section 26 0531 Conduit
Section 26 0533 Boxes
Section 26 0543 Underground Ducts and Structures
Section 26 0553 Electrical Identification
Section 26 0800 Electrical Commissioning
Section 26 0926 Low-Voltage Lighting Control
Section 26 2213 Dry Type Transformers
Section 26 2413 Switchboards
Section 26 2416 Panelboards
Section 26 2500 Busway
Section 26 2716 Cabinets and Enclosures
Section 26 2726 Wiring Devices
Section 26 2816 Overcurrent Protective Devises
Section 26 2819 Disconnect Switches
Section 26 2900 Motor Controls
Section 26 4313 Surge Protective Devices (SPDs)
Section 26 5000 Lighting
Section 26 6113 Fire Alarm / Life Safety System

DIVISION 27 – COMMUNICATIONS
Section 27 0010 Basic Communications Requirements
Section 27 0526 Communications Grounding and Bonding
Section 27 0528 Communications Pathways

Section 27 0529 Communications Hangers and Supports
Section 27 0536 Communications Cable Trays
Section 27 1100 Communications Equipment Rooms
Section 27 1313 Communications Copper Backbone Cabling
Section 27 1323 Communications Optical Fiber Cabling
Section 27 1500 Communications Horizontal Cabling
Section 27 3000 Two-Way Communications System
Section 27 4116 Audio Video System
Section 27 5113 Communications Paging & Intercom
Section 27 5126 Assistive Listening System
Section 27 5313 Clock System

DIVISION 28 – ELECTRONIC SAFETY AND SECURITY
Section 28 1300 Security Alarm Monitoring System
Section 28 1600 Electronic Access Control
Section 28 2300 Video Surveillance System

DIVISION 31 – EARTHWORK
Section 31 1000 Site Clearing
Section 31 2000 Earthwork

DIVISION 32 – EXTERIOR IMPROVEMENTS
Section 32 1216 Asphalt Paving
Section 32 1313 Cement Concrete Paving
Section 32 1316 Decorative Concrete Paving
Section 32 3113 Chain Link Fencing
Section 32 8400 Irrigation System
Section 32 9210 Landscape Turf Grass
Section 32 9300 Landscape Installation
Section 32 9800 Landscape Maintenance

DIVISION 33 - UTILITIES
Section 33 1100 Facility Water Distribution Piping
Section 33 3100 Facility Sanitary Sewers
Section 33 4100 Storm Utility Drainage Piping

END OF TABLE OF CONTENTS

SECTION 090561.13 - MOISTURE VAPOR EMISSION CONTROL ADD 3

PART 1 - GENERAL

1.1 RELATED DOCUMENTS

A. Drawings and general provisions of the Contract, including General and Supplementary Conditions and Division 01 Specification Sections, apply to this Section.

1.2 SUMMARY

A. Section Includes:

1. Fluid-applied, resin-based, membrane-forming systems that control the moisture-vapor-emission rate of high-moisture, interior concrete to prepare it for floor covering installation.

1.3 DEFINITIONS

A. MVE: Moisture vapor emission.

B. MVER: Moisture vapor emission rate.

1.4 ACTION SUBMITTALS

A. Product Data: For each type of product.

1.5 INFORMATIONAL SUBMITTALS

A. Qualification Data: For Installer.

B. Product Test Reports: For each MVE-control system, for tests performed by manufacturer and witnessed by a qualified testing agency.

C. Preinstallation testing reports.

D. Field quality-control reports.

1.6 QUALITY ASSURANCE

A. Manufacturer Qualifications: Employs factory-trained personnel who are available for consultation and Project-site inspection.

B. Installer Qualifications: An authorized representative who is trained and approved by manufacturer.

1.7 DELIVERY, STORAGE, AND HANDLING

A. Deliver materials in original packages and containers, with seals unbroken, bearing manufacturer's labels indicating directions for storage and mixing with other components.

1.8 FIELD CONDITIONS

A. Environmental Limitations: Comply with MVE-control system manufacturer's written instructions for substrate and ambient temperatures, humidity, ventilation, and other conditions affecting system installation.

1. Store system components in a temperature-controlled environment and protected from weather and at ambient temperature of not less than 65 deg F and not more than 85 deg F at least 48 hours before use.
2. Maintain ambient temperature and relative humidity in installation areas within range recommended in writing by MVE-control system manufacturer, but not less than 65 deg F or more than 85 deg F and not less than 40 or more than 60 percent relative humidity, for 48 hours before installation, during installation, and for 48 hours after installation unless longer period is recommended in writing by manufacturer.
3. Install MVE-control systems where concrete surface temperatures will remain a minimum of 5 deg F higher than the dew point for ambient temperature and relative humidity conditions in installation areas for 48 hours before installation, during installation, and for 48 hours after installation unless longer period is recommended in writing by manufacturer.

PART 2 - PRODUCTS

2.1 PERFORMANCE REQUIREMENTS

A. MVE-Control System Capabilities: Capable of suppressing MVE without failure where installed on concrete that exhibits the following conditions:

1. MVER: Maximum 25 lb of water/1000 sq. ft. when tested according to ASTM F1869.
2. Relative Humidity: Maximum 100 percent when tested according to ASTM F2170 using in situ probes.

B. Water-Vapor Transmission: Through MVE-control system, maximum 0.06 perm when tested according to ASTM E96/E96M.

C. Tensile Bond Strength: For MVE-control system, greater than 200 psi with failure in the concrete according to ASTM D7234.

D. VOC limits < 100g/l.

2.2 MVE-CONTROL SYSTEM

A. Manufacturers: Subject to compliance with requirements, provide products by one of the following:

1. Floor Seal Technology, Inc.
2. KOSTER American Corporation.
3. Madewell Products Corporation.

B. MVE-Control System: ASTM F3010-qualified, fluid-applied, two-component, epoxy-resin, membrane-forming system; formulated for application on concrete substrates to reduce MVER to level required for installation of floor coverings indicated and acceptable to manufacturers of floor covering products indicated, including adhesives.

1. Substrate Primer: Provide MVE-control system manufacturer's concrete-substrate primer if required for system indicated by substrate conditions.
2. Cementitious Underlayment Primer: If required for subsequent installation of cementitious underlayment products, provide MVE-control system manufacturer's primer to ensure adhesion of products to MVE-control system.

2.3 ACCESSORIES

A. Patching and Leveling Material: Moisture-, mildew-, and alkali-resistant product recommended in writing by MVE-control system manufacturer and with minimum of 3000-psi compressive strength after 28 days when tested according to ASTM C109/C109M.

B. Crack-Filling Material: Resin-based material recommended in writing by MVE-control system manufacturer for sealing concrete substrate crack repair.

C. Cementitious Underlayment: If required to maintain manufacturer's warranty, provide MVE-control system manufacturer's recommended hydraulic cement-based underlayment.

1. Basis-of-Design: K-15 by Ardex Engineered Cements, Inc., or approved equal.

PART 3 - EXECUTION

3.1 EXAMINATION

A. Examine substrates and conditions, with Installer present, for compliance with requirements for maximum moisture content, installation tolerances, and other conditions affecting performance of the Work.

B. Proceed with installation only after unsatisfactory conditions have been corrected.

1. Installation of system indicates acceptance of surfaces and conditions.

3.2 PREPARATION

A. Preinstallation Testing:

1. Testing Agency: Engage a qualified testing agency to perform tests.

    a. For testing, use systems of Vaprecision Professional Emission Testing Systems, or Sealflex Industries, Inc., or equal.

2. Alkalinity Testing: Perform pH testing according to ASTM F710. Install MVE-control system in areas where pH readings are less than 7.0 and in areas where pH readings are greater than 8.5.

3. Moisture Testing: Perform tests so that each test area does not exceed 200 sq. ft., and perform no fewer than three tests in each installation area and with test areas evenly spaced in installation areas.

    a. Anhydrous Calcium Chloride Test: ASTM F1869. Install MVE-control system in locations where concrete substrate MVER exceeds 3 lb of water/1000 sq. ft. in 24 hours.
    b. Internal Relative Humidity Test: Using in situ probes, ASTM F2170. Install MVE-control system in locations where concrete substrates exhibit relative humidity level greater than 75 percent.

4. Tensile-Bond-Strength Testing: For typical locations indicated to receive installation of MVE-control system, install minimum 100-sq. ft. area of MVE-control system to prepared concrete substrate and test according to ASTM D7234.

    a. Proceed with installation only where tensile bond strength is greater than 200 psi with failure in the concrete.

B. Concrete Substrates: Prepare and clean substrates according to MVE-control system manufacturer's written instructions to ensure adhesion of system to concrete.

1. Remove coatings and other substances that are incompatible with MVE-control system and that contain soap, wax, oil, or silicone, using mechanical methods recommended in writing by MVE-control system manufacturer. Do not use solvents.
2. Provide concrete surface profile complying with ICRI 310.2R CSP 3 by shot blasting using apparatus that abrades the concrete surface with shot, contains the dispensed shot within the apparatus, and recirculates the shot by vacuum pickup.
3. After shot blasting, repair damaged and deteriorated concrete according to MVE-control system manufacturer's written instructions.
4. Protect substrate voids and joints to prevent resins from flowing into or leaking through them.
5. Fill surface depressions and irregularities with patching and leveling material.
6. Fill surface cracks, grooves, control joints, and other nonmoving joints with crack-filling material.
7. Allow concrete to dry, undisturbed, for period recommended in writing by MVE-control system manufacturer after surface preparation, but not less than 24 hours.

8. Before installing MVE-control systems, broom sweep and vacuum prepared concrete.

C. Protect walls, floor openings, electrical openings, door frames, and other obstructions during installation.

3.3 INSTALLATION

A. Install MVE-control system according to ASTM F3010 and manufacturer's written instructions to produce a uniform, monolithic surface free of surface deficiencies such as pin holes, fish eyes, and voids.

1. Install primers as required to comply with manufacturer's written instructions.

B. Do not apply MVE-control system across substrate expansion, isolation, and other moving joints.

C. Apply system, including component coats if any, in thickness recommended in writing by MVE-control system manufacturer for MVER indicated by preinstallation testing.

D. Cure MVE-control system components according to manufacturer's written instructions. Prevent contamination or other damage during installation and curing processes.

E. After curing, examine MVE-control system for surface deficiencies. Repair surface deficiencies according to manufacturer's written instructions.

F. Install cementitious underlayment over cured membrane if required to maintain manufacturer's warranty and in thickness required to maintain the warranty.

3.4 FIELD QUALITY CONTROL

A. Testing Agency: Engage a qualified testing agency to perform installation inspections.

B. Installation Inspections: Inspect substrate preparation and installation of system components to ensure compliance with manufacturer's written instructions and to ensure that a complete MVE-control system is installed without deficiencies.

1. Verify that surface preparation meets requirements.
2. Verify that component coats and complete MVE-control-system film thicknesses comply with manufacturer's written instructions.
3. Verify that MVE-control-system components and installation areas that evidence deficiencies are repaired according to manufacturer's written instructions.

C. MVE-control system will be considered defective if it does not pass inspections.

3.5 PROTECTION

A. Protect MVE-control system from damage, wear, dirt, dust, and other contaminants before floor covering installation. Use protective methods and materials, including temporary coverings, recommended in writing by MVE-control system manufacturer.

B. Do not allow subsequent preinstallation examination and testing for floor covering installation to damage, puncture, or otherwise compromise the MVE-control system membrane.

END OF SECTION 090561.13 ADD 3

SECTION 10 21 13 - PLASTIC TOILET AND SHOWER COMPARTMENTS

PART 1 - GENERAL

1.1 RELATED DOCUMENTS

A. Drawings and general provisions of the Contract, including General and Supplementary Conditions and Division 01 Specification Sections, apply to this Section.

1.2 SUMMARY

A. Section Includes:

1. Solid-plastic toilet compartments configured as toilet enclosures and urinal screens.

B. Related Requirements:

1. Section 10 28 00 "Washroom Accessories" for toilet tissue dispensers, grab bars, purse shelves, and similar accessories mounted on toilet compartments.

1.3 REFERENCES

A. National Fire Protection Association (NFPA):
1. NFPA 286 - Standard Methods of Fire Tests for Evaluating Contribution of Wall and Ceiling Interior Finish to Room Fire Growth.

B. ASTM International (ASTM):
1. ASTM A 666 - Standard Specification for Stainless and Heat-Resisting Chromium-Nickel Steel Plate, Sheet, and Strip.
2. ASTM B 221 - Standard Specification for Aluminum and Aluminum-Alloy Extruded Bars, Rods, Wire, Profiles, and Tubes.
3. ASTM E 84 - Standard Test Method for Surface Burning Characteristics of Building Materials. ADD 2

1.4 ACTION SUBMITTALS

A. Product Data: For each type of product.

1. Include construction details, material descriptions, dimensions of individual components and profiles, and finishes for toilet ~~and shower~~ ADD2 compartments.

B. Shop Drawings: For toilet ~~and shower~~ ADD2 compartments.

1. Include plans, elevations, sections, details, and attachment details.
2. Show locations of cutouts for compartment-mounted accessories.
3. Show locations of centerlines of toilet fixtures.

4. Show locations of floor drains.
5. Indicate field measurements in shop drawings.

C. Samples for Selection: For each type of toilet compartment material indicated.

1. Include Samples of hardware and accessories involving material and color selection.

1.5 INFORMATIONAL SUBMITTALS

A. Product Certificates: For each type of compartment.

1.6 CLOSEOUT SUBMITTALS

A. Maintenance Data: For toilet compartments to include in maintenance manuals.

1.7 PROJECT CONDITIONS

A. Field Measurements: Verify actual locations of toilet fixtures, walls, columns, ceilings, and other construction contiguous with toilet compartments by field measurements before fabrication.

1.8 WARRANTY

A. Provide manufacturer’s standard 25 year warranty on materials.

PART 2 - PRODUCTS

2.1 PERFORMANCE REQUIREMENTS

A. Fire Growth Contribution: Complying with acceptance criteria of local code and authorities having jurisdiction when tested according to NFPA 286.

B. Regulatory Requirements: Comply with applicable provisions in CBC Chapter 11B for toilet compartments designated as accessible.

1. Wheelchair accessible compartment shall comply with Section 11B-604.8.1.
2. Door and door hardware for accessible compartments shall be self-closing and shall comply with CBC Section 11B-404.
3. A door pull complying with CBC Section 11B-404.2.7 shall be placed on both sides of the door near the latch.
4. Toe clearance for at least one side portion of a wheelchair accessible compartment shall comply with CBC Section and Figure 11B-604.8.1.4. It shall be 9 inches high minimum above the finish floor and 6 inches deep minimum beyond the compartment side face of the partition, exclusive of partition support members. It shall be 12 inches high minimum above the finish floor for children’s use. Partition components at toe clearance shall be

smooth without sharp edges or abrasive surfaces. Toe clearance at the side partition is not required in a compartment greater than 66 inches wide.

2.2 SOLID-PLASTIC TOILET COMPARTMENTS

A. Basis-of-Design Product:
1. Subject to compliance with requirements, provide Scranton Products Hiny Hiders, or approved equal at first floor Boys and Girls Restrooms. ADD 2

B. Toilet-Enclosure Style: Overhead braced.

C. Urinal-Screen Style: Wall hung.

D. Door, Panel, and Pilaster Construction: Solid, high-density polyethylene (HDPE) panel material, not less than 1 inch thick, seamless, with eased edges, and with homogenous color and pattern throughout thickness of material.

1. Continuous Hinges: Configure doors and pilasters to receive continuous hinges.
2. Heat-Sink Strip: Manufacturer's standard continuous, extruded-aluminum strip fastened to exposed bottom edges of solid-plastic components to hinder malicious combustion.
~~3.~~ Color and Pattern: Paisley ADD 2

E. Pilaster Shoes: Manufacturer's standard design; stainless steel.

F. Brackets (Fittings):

1. Full-Height (Continuous) Type: Manufacturer's standard design; extruded aluminum.

2.3 TOILET COMPARTMENT SYSTEM

A. Basis-of-Design Product:
1. Subject to compliance with requirements, provide Scranton Products Aria Toilet Partitions, or approved equal at second and third floor All-gender restrooms.

B. Style: Full height floor mounted overhead braced toilet compartments.

C. System Construction:
1. System Specified Height: Full height.

D. Doors: 79” high, mounted 4” above finished floor. ADD 3

E. Dividing Panels: Two panels stacked and secured with 3 dowels ensuring proper alignment totaling the system specified height

F. Trim: Application to hide seam gap between dividing panels.

G. Pilasters: System specified height, shoeless system secured with 3/4 inch (19 mm) long stainless steel tamper resistant Torx head screws and angled wall brackets.

H. Transom Panel: Height required to accommodate specified system height with ship lap on one edge. Mounted with four mending plates using 3/4 inch (19 mm) long stainless steel tamper resistant Torx head screws.

I. Wall Brackets: Continuous, heavy-duty aluminum. Mounts to pilasters, panels and walls with 3/4 inch (19 mm) long stainless steel tamper resistant Torx head screws.

J. System Design: Solid, high-density polyethylene (HDPE) panel material, not less than 1 inch thick, seamless, with eased edges, and with homogenous color and pattern throughout thickness of material.
   1. Door Design: Traditional Series; Model 1000.
   2. Side Panel Design: Plain (standard).
   3. Color: Traditional; Paisley. Texture: Orange Peel.
   4. Trim Design:
      a. Standard radius edged, 5 inches (127 mm) wide, where occurs on full height partitions.
      b. Trim Color: P-1, see paint finish schedule on drawings.

2.4 HARDWARE AND ACCESSORIES

A. Hardware and Accessories: Manufacturer's heavy-duty operating hardware and accessories.
   1. Hinges: Manufacturer's minimum 14-gauge stainless-steel continuous hinge. 0.09 inch thick 304-2b stainless-steel pin in 0.25 inch (5.94 mm) diameter. Closing degree is minus 5 degrees. Hinge is designed to come to a full close on its own weight. ADD 2
   2. Latch and Housing: Manufacturer's heavy-duty extruded aluminum unit. Latch housing bright dip anodized finish; slide bolt and button black anodized finish.
   3. Occupancy Indicator Latch and Housing: Satin stainless-steel showing green and red occupancy indicators for All-gender restrooms ADD 2
   4. Door Strike and Keeper: Continuous extruded aluminum strike, secured with tamper-resistant bolts; bright dip anodized finish.
   5. Coat Hook: Manufacturer's heavy-duty combination cast-stainless-steel hook and rubber-tipped bumper, sized to prevent in-swinging door from hitting compartment-mounted accessories. Mount with through-bolts.
   6. Door Bumper: Manufacturer's heavy-duty rubber-tipped cast-stainless-steel bumper at out-swinging doors. Mount with through-bolts.
   7. Door Pull: Manufacturer's heavy-duty cast-stainless-steel pull at out-swinging doors that complies with regulatory requirements for accessibility. Provide units on both sides of doors at compartments designated as accessible. Mount with through-bolts.

B. Overhead Bracing: Manufacturer's standard continuous, extruded-aluminum head rail with antigrip profile and in manufacturer's standard finish.

   1. Provide shower hook accommodation at shower compartment head rail.

C. Anchorages and Fasteners: Manufacturer's standard exposed fasteners of stainless steel, finished to match the items they are securing, with theft-resistant-type heads. Provide sex-type bolts for through-bolt applications. For concealed anchors, use stainless-steel, hot-dip galvanized-steel, or other rust-resistant, protective-coated steel compatible with related materials.

2.5 MATERIALS

A. Aluminum Castings: ASTM B26/B26M.

B. Aluminum Extrusions: ASTM B221.

C. Stainless-Steel Sheet: ASTM A666, Type 304, stretcher-leveled standard of flatness.

D. Stainless-Steel Castings: ASTM A743/A743M.

2.6 FABRICATION

A. Fabrication, General: Fabricate toilet compartment components to sizes indicated. Coordinate requirements and provide cutouts for through-partition toilet accessories where required for attachment of toilet accessories.

B. Overhead-Braced Units: Provide manufacturer's standard corrosion-resistant supports, leveling mechanism, and anchors at pilasters to suit floor conditions. Provide shoes at pilasters to conceal supports and leveling mechanism.

C. Door Size and Swings: Unless otherwise indicated, provide 24-inch- wide, in-swinging doors for standard toilet compartments and 36-inch- wide, out-swinging doors with a minimum 32-inch- wide, clear opening for compartments designated as accessible.

PART 3 - EXECUTION

3.1 EXAMINATION

A. Examine areas and conditions, with Installer present, for compliance with requirements for fastening, support, alignment, operating clearances, and other conditions affecting performance of the Work.

1. Confirm location and adequacy of blocking and supports required for installation.

B. Proceed with installation only after unsatisfactory conditions have been corrected.

3.2 INSTALLATION

A. General: Comply with manufacturer's written installation instructions. Install units rigid, straight, level, and plumb. Secure units in position with manufacturer's recommended anchoring devices.

1. Maximum Clearances:

a. Pilasters and Panels: 1/2 inch.
b. Panels and Walls: 1 inch.

2. Full-Height (Continuous) Brackets: Secure panels to walls and to pilasters with full-height brackets.

    a. Locate bracket fasteners so holes for wall anchors occur in masonry or tile joints.
    b. Align brackets at pilasters with brackets at walls.


B. Overhead-Braced Units: Secure pilasters to floor and level, plumb, and tighten. Set pilasters with anchors penetrating not less than 1-3/4 inches into structural floor unless otherwise indicated in manufacturer's written instructions. Secure continuous head rail to each pilaster with no fewer than two fasteners. Hang doors to align tops of doors with tops of panels, and adjust so tops of doors are parallel with overhead brace when doors are in closed position.

C. Urinal Screens: Attach with anchoring devices to suit supporting structure. Set units level and plumb, rigid, and secured to resist lateral impact.


3.3 ADJUSTING

A. Hardware Adjustment: Adjust and lubricate hardware according to hardware manufacturer's written instructions for proper operation. Set hinges on in-swinging doors to hold doors open approximately 30 degrees from closed position when unlatched. Set hinges on out-swinging doors to return doors to fully closed position.


END OF SECTION 10 21 13

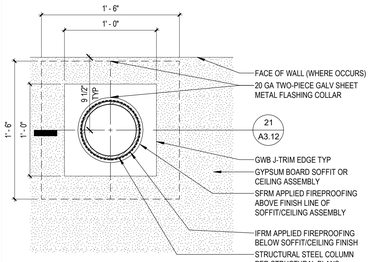


11 A3.12 GWB SOFFIT AT IFRM COLUMN (RCP)
SCALE: 1 1/2" = 1'-0"

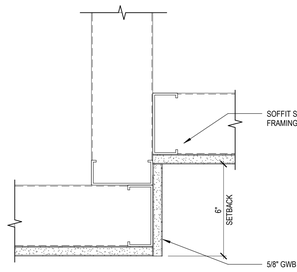


14 A3.12 GYP BD SOFFIT (PLAN)
SCALE: 3" = 1'-0"

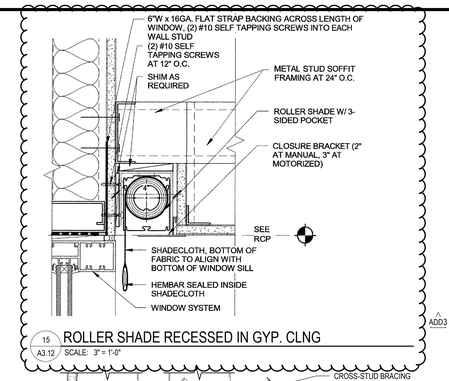


15 A3.12 ROLLER SHADE RECESSED IN GYP. CLNG
SCALE: 3" = 1'-0"

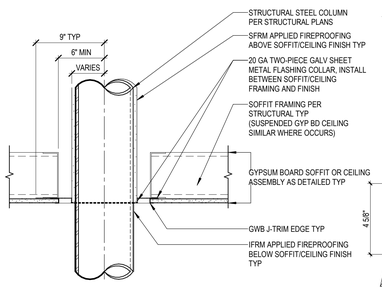


21 A3.12 GWB SOFFIT AT IFRM COLUMN (SECTION)
SCALE: 1 1/2" = 1'-0"

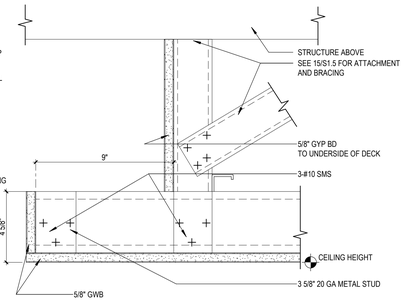


22 A3.12 GYP BD SOFFIT @ STUDENT COLLAB. STAIR
SCALE: 3" = 1'-0"

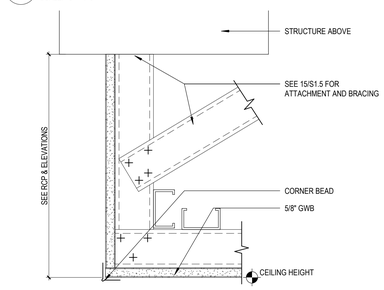


23 A3.12 GYP BD SOFFIT (SECTION)
SCALE: 3" = 1'-0"

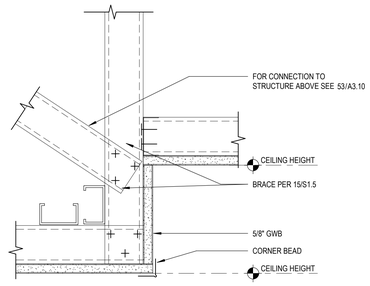


24 A3.12 LOW GYP BD TO HIGH GYP BD
SCALE: 3" = 1'-0"

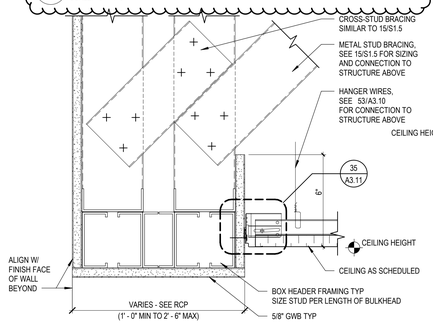


25 A3.12 WIDE BULKHEAD DETAIL
SCALE: 3" = 1'-0"

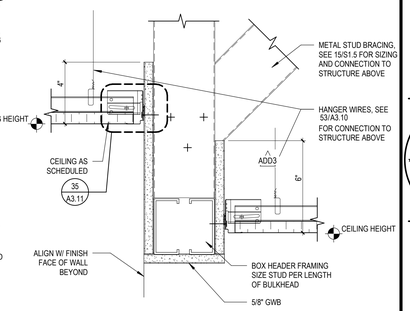


26 A3.12 BULKHEAD DETAIL
SCALE: 3" = 1'-0"

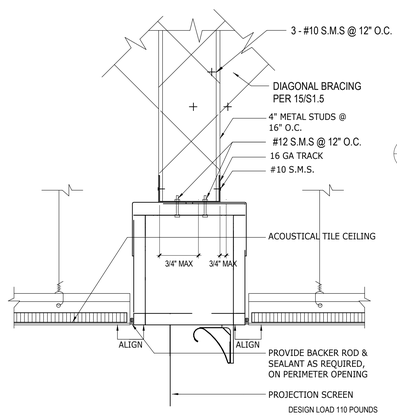


45 A3.12 RECESSED PROJECTION SCREEN IN ACT
SCALE: 3" = 1'-0"

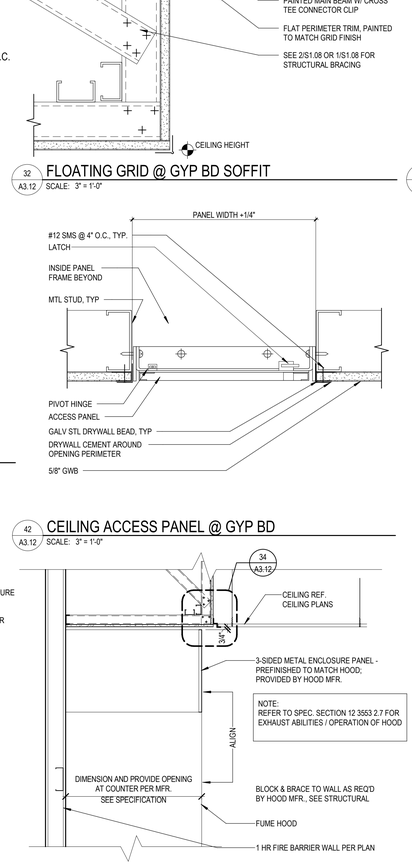


32 A3.12 FLOATING GRID @ GYP BD SOFFIT
SCALE: 3" = 1'-0"

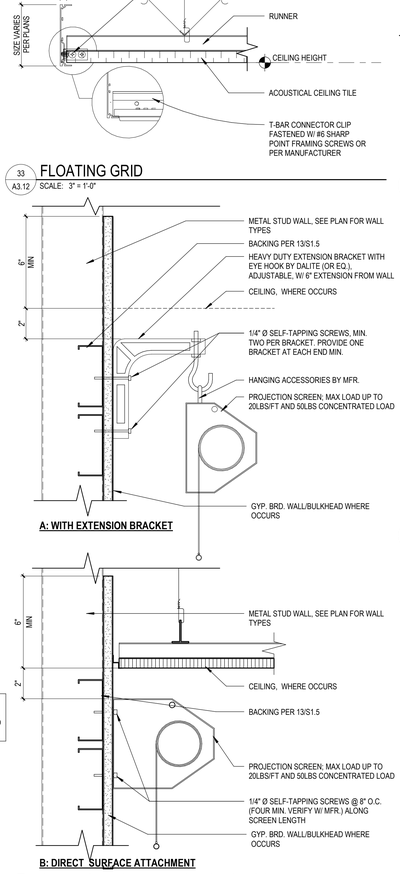


33 A3.12 FLOATING GRID
SCALE: 3" = 1'-0"

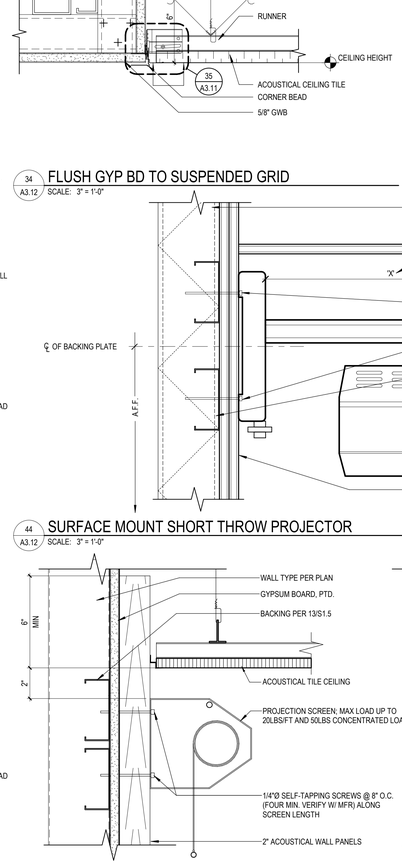

34 A3.12 FLUSH GYP BD TO SUSPENDED GRID
SCALE: 3" = 1'-0"

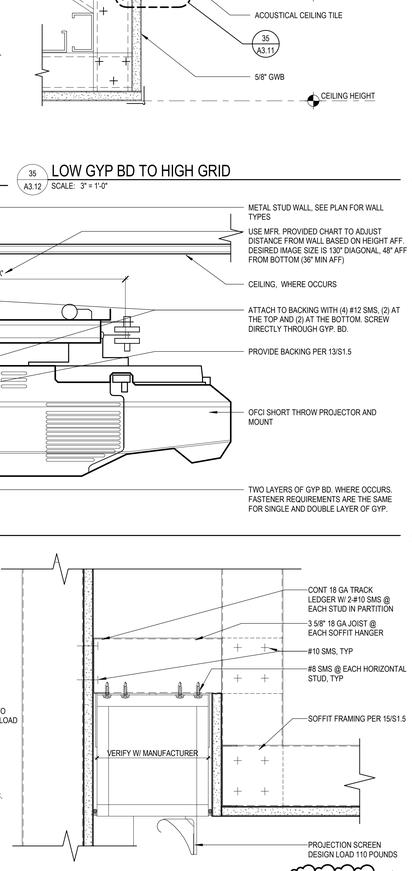

35 A3.12 LOW GYP BD TO HIGH GRID
SCALE: 3" = 1'-0"

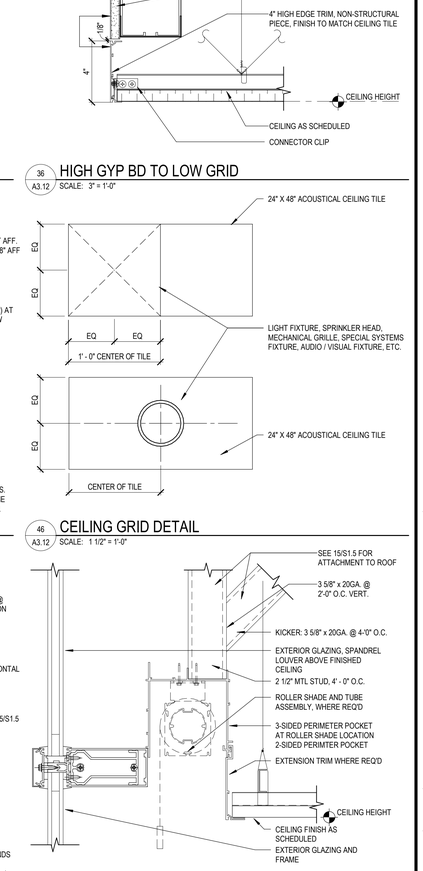

36 A3.12 HIGH GYP BD TO LOW GRID
SCALE: 3" = 1'-0"

42 A3.12 CEILING ACCESS PANEL @ GYP BD
SCALE: 3" = 1'-0"

53 A3.12 SURFACE MOUNT. PROJECTION SCREEN
SCALE: 3" = 1'-0"

44 A3.12 SURFACE MOUNT SHORT THROW PROJECTOR
SCALE: 3" = 1'-0"

46 A3.12 CEILING GRID DETAIL
SCALE: 1 1/2" = 1'-0"

51 A3.12 FUME HOOD & COUNTER ELEVATION
SCALE: 3/4" = 1'-0"

52 A3.12 FUME HOOD ENCLOSURE
SCALE: 3/4" = 1'-0"

54 A3.12 SURFACE MOUNT PROJECTION SCREEN
SCALE: 3" = 1'-0"

55 A3.12 RECESSED PROJECTION SCREEN IN GYP SOFFIT ADD2
SCALE: 3" = 1'-0"

56 A3.12 ELECTRIC SHADE POCKET @ STOREFRONT
SCALE: 3" = 1'-0"

ADD2 2020-07-08

BIM 360://75-19101-00 Roseville JUHSD - West Park Phase 2\75-19101-00_AR_2019.rvt
7/7/2020 7:32:23 PM

DLR Group
Architecture Engineering Planning Interiors
© 2019, DLR Group inc. of California, a California corporation. ALL RIGHTS RESERVED

LICENSED ARCHITECT
MARK V. COVINGTON
03/31/2021
STATE OF CALIFORNIA

CEILING DETAILS
WEST PARK HIGH SCHOOL, PHASE 2 (INC. 1)
2401 High School Road, Roseville, California 95747
Roseville Joint Union High School District

ADDENDUM 2
07.08.2020
Revisions
2020-07-08 ADD2 Addendum 2
2020-07-10 ADD3 Addendum 3

PROJECT #75-19101-00
DSA APPL. #02-118062
DSA FILE #31-H3


A3.12

SHEET NOTES:

1. PROVIDE TURNING VANES AT ALL RECTANGULAR DUCTWORK WITH 90
2. FLEXIBLE DUCT IS LIMITED TO 5'-0" IN LENGTH.
3. PROVIDE MANUAL VOLUME DAMPER AT EVERY BRANCH DUCT.
4. PROVIDE SHOE FITTING AT ALL RECTANGULAR TO RECTANGULAR DUCT BRANCHES.
5. PROVIDE CONICAL FITTING AT ALL ROUND TO RECTANGULAR DUCT BRANCHES.
6. FLEXIBLE DUCT TO DIFFUSERS OR GRILLES IN EXPOSED AREAS (NO CEILING) SHALL NOT BE USED.
7. CONTRACTOR SHALL PROVIDE DUCT SHOP DRAWINGS AND SEISMIC DUCT SUPPORT DRAWINGS AND CALCULATIONS.
8. ALL EXPOSED ROUND DUCT SHALL BE SPIRAL SEAM.


KEYED NOTES:

1. SECURE VAV BOX TIGHT TO STRUCTURAL FRAMING MEMBERS ABOVE AT LOCATION SHOWN. FIELD VERIFY FINAL UNIT LOCATION, SUPPLY PLENUM, HYDRONIC LINES AND ROUTING WITH STRUCTURAL FRAMING MEMBERS, SUPPORTS, LIGHTS, ETC. MAINTAIN MIN. 30" IN FRONT OF VAV CONTROLS AND CONTROL VALVE. SEE DETAIL **7/M4.02**, TYPICAL.
2. SUPPLY AND/OR RETURN AIR DROPS IN RATED SHAFT FROM ABOVE. OFFSET AND ROUTE TIGHT TO UNDERSIDE OF ROOF FRAMING MEMBERS. FIELD COORDINATE DUCT ROUTING WITH STRUCTURAL MEMBERS, PIPING, SUPORTS, LIGHT FIXTURES, ETC. SEE DETAILS **1/M4.03** & **2/M4.03** & **1/M4.05**, TYPICAL.
3. FURNISH AND INSTALL THERMOSTAT AND CO2 SENSOR ON WALL AT +48" TO TOP AT LOCATION SHOWN.
4. FURNISH AND INSTALL MANUAL VOLUME DAMPER IN EACH INDIVIDUAL BRANCH DUCT. BALANCE TO AIR VOLUME SHOWN, TYPICAL.
5. SECURE CEILING EXHAUST FAN TO STRUCTURAL FRAMING MEMBERS ABOVE. ROUTE EXHAUST DUCT UP THRU WALL AT LOCATION SHOW. SEE DETAIL **9/M4.02**.
6. INSTALL ROUND CEILING DIFFUSERS AT CEILING OR OPEN SPACE AT LOCATION SHOWN. CONNECT TO DUCT WITH RIGID DUCTWORK. SEE DETAIL **6/M4.03**.
7. PROVIDE SEISMIC RESTRAINTS ON ALL DUCTWORK WHERE REQUIRED BY CODE. SEE DETAIL **1/M4.03**. CONTRACTOR SHALL PROVIDE ENGINEERED PLANS AS PART OF SUBMITTALS.
8. FURNISH AND INSTALL FIRE/SMOKE DAMPER AT ALL RATED ASSEMBLIES WHERE DUCT PENETATIONS OCCUR. FIRE/SMOKE DAMPERS SHALL BE INSTALLED AT AREA OR OCCUPANCY SEPARATION WALLS, FIRE RESISTIVE EXIT WALLS AND CORRIDORS (CEILINGS AND WALLS) SHAFT ENCLOSURES AND AREAS OF REFUGE. REFER TO ARCHITECUTRAL PLANS FOR RATED WALLS, RATED FLOOR/CEILING ASSEMBLIES AND RATED SHAFTS LOCATIONS. SEE DETAILS **2/M4.05**, **6/M4.05** AND **8/M4.05**, TYPICAL.
9. EMERGENCY EXHAUST DUCT FROM BELOW TO ABOVE IN RATED CHASE. PROVIDE DUCT SUPPORT EVERY 10'-0" AND AT EACH FLOOR LEVEL. SEE DETAILS **3/M4.03** AND **14/M4.03**, TYPICAL.
10. OFFSET AND ROUTE SUPPLY AIR OR RETURN AIR OR EXHAUST AIR DUCT FROM BELOW, TO ABOVE IN RATED SHAFT. PROVIDE DUCT SUPPORT AT EACH FLOOR LEVEL, AT EACH TURN OF DIRECTION AND EVERY 10'-0" O.C. SEE DETAIL **3/M4.03**, **13/M4.03** AND **14/M4.03**, TYPICAL.
11. ROUTE EXPOSED DUCT AS HIGH AS POSSIBLE. COORDINATE ROUTING WITH STRUCTURAL MEMBERS, SUPPORTS, LIGHTS, ETC. SEE DETAILS **2/M4.03** AND **4/M4.03**.
12. COORDINATE DUCT ROUTING OVER FOLDING PARTITION DOORS PRIOR TO COMMENCING WORK IN THIS AREA. CONSULT WITH MEOR FOR ANY DESCREPANCIES. REFER TO ARCHITECTURAL PLANS FOR FOLDING PARTITION REQUIREMENTS.
13. REFRIGERANT LINES IN WALL FROM BELOW TO ABOVE. PROVIDE PIPE SUPPORT EVERY 10'-0" AND EACH TURN OF DIRECTION. SEE DETAIL **7/M4.04**, TYPICAL.
14. SECURE FAN COIL UNIT TO HIGH WALL FRAMING MEMBERS AT LOCATION SHOWN. FIELD VERIFY LOCATION WITH STRUCTURAL MEMBERS, ALL ELECTRICAL AND CONTROL WIRING, CONDUITS, ELECTRICAL AND CONTROL PANELS, ETC. SEE DETAIL **10/M4.02**.
15. ROUTE REFRIGERANT LINES UP THRU WALL TO FLOOR ABOVE AT LOCATION SHOWN. SEE DETAIL **7/M4.04**, TYPICAL.
16. MAXIMUM LENGTH OF BRANCH DUCT TO VAV BOX SHALL BE MAXIMUM 5'-0", TYPICAL.
17. ALL EXPOSED ROUND DUCT SHALL BE SPIRAL SEAM, TYPICAL.
18. PROVIDE WITH STAINLESS STEEL FACE PLATE. PROVIDED BY CONTROLS CONTRACTOR.
19. OFFSET AND (3) 10"Ø VENTS FROM BELOW TO ABOVE IN RATED CHASE. PROVIDE DUCT SUPPORT EVERY 10'-0" AND AT EACH FLOOR LEVEL. SEE DETAILS **3/M4.03** AND **14/M4.03**, TYPICAL.
20. CONTROL PANEL FOR VAV BOX TRANSFORMERS. PROVIDE A 120 V/1 CIRCUIT POWER. SEE ELECTRICAL PLANS.

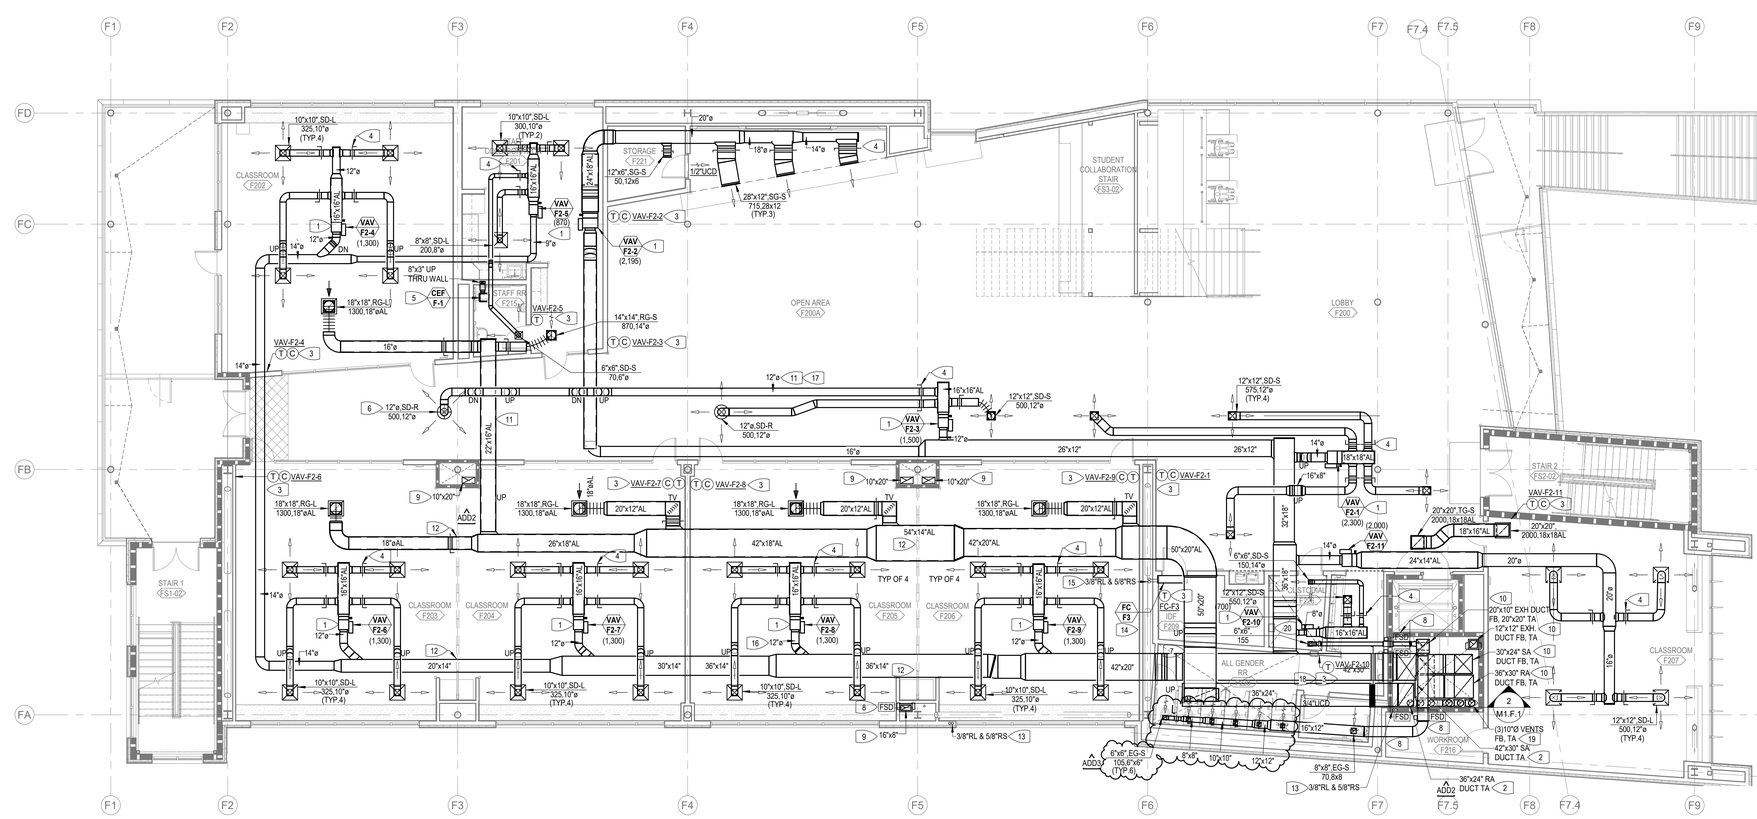

1 **BLDG F SECOND FLOOR PLAN - MECHANICAL**
1/8" = 1'-0"

KEY PLAN

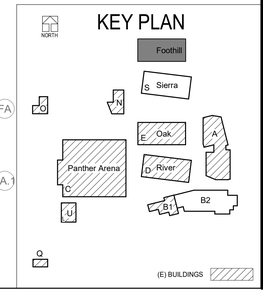

ADD3 2020-07-10
ADD2 2020-07-08

C:\Users\tsantillan\Documents\19356 Westpark HS PH 2 MECH-PLUMB_INC 1_2019_tsantillan@peterseng.com.rvt
7/10/2020 11:30:23 AM

DLR Group
Architecture Engineering Planning Interiors

© 2019, DLR Group inc. of California, a California corporation. ALL RIGHTS RESERVED

REGISTERED PROFESSIONAL ENGINEER
SEAN R. TSANTILLAN
M31176
EXP. 12/31/21
MECHANICAL
STATE OF CALIFORNIA

PETERS Engineering
consulting mechanical and electrical engineers
2411 Alhambra Blvd., Ste. 100
Sacramento, CA 95817
Tel (916) 447-2061
www.petersengineering.com

job no. 19356

BLDG F SECOND FLOOR - MECHANICAL
WEST PARK HIGH SCHOOL, PHASE 2 (INC. 1)

2401 High School road, Roseville, California 95747

ADDENDUM 3
07.10.2020
Revisions

2020-07-08 ADD2 Addendum 2
2020-07-10 ADD3 Addendum 3

PROJECT ##75-19101-00

M1.F.2

SHEET NOTES:

ADD2
1. PROVIDE TURNING VANES AT ALL RECTANGULAR DUCTWORK WITH 90
2. FLEXIBLE DUCT IS LIMITED TO 5'-0" IN LENGTH.
3. PROVIDE MANUAL VOLUME DAMPER AT EVERY BRANCH DUCT.
4. PROVIDE SHOE FITTING AT ALL RECTANGULAR TO RECTANGULAR DUCT BRANCHES.
5. PROVIDE CONICAL FITTING AT ALL ROUND TO RECTANGULAR DUCT BRANCHES.
6. FLEXIBLE DUCT TO DIFFUSERS OR GRILLES IN EXPOSED AREAS (NO CEILING) SHALL NOT BE USED.
7. CONTRACTOR SHALL PROVIDE DUCT SHOP DRAWINGS AND SEISMIC DUCT SUPPORT DRAWINGS AND CALCULATIONS.
8. ALL EXPOSED ROUND DUCT SHALL BE SPIRAL SEAM.
9. PROVIDE MULTI-BLADE MANUAL VOLUME DAMPERS WHERE CLEARANCES ARE REQUIRED, TYPICAL.

KEYED NOTES:


1. SECURE VAV BOX TIGHT TO STRUCTURAL FRAMING MEMBERS ABOVE AT LOCATION SHOWN. FIELD VERIFY FINAL UNIT LOCATION, SUPPLY PLENUM, HYDRONIC LINES AND ROUTING WITH STRUCTURAL FRAMING MEMBERS, SUPPORTS, LIGHTS, ETC. MAINTAIN MIN. 30" IN FRONT OF VAV CONTROLS AND CONTROL VALVE. SEE DETAIL **7/M4.02**, TYPICAL.
2. LINED SUPPLY AND/OR RETURN AIR DROPS FROM ABOVE. OFFSET AND ROUTE TIGHT TO UNDERSIDE OF ROOF FRAMING MEMBERS. FIELD COORDINATE DUCT ROUTING WITH STRUCTURAL MEMBERS, PIPING, SUPORTS, LIGHT FIXTURES, ETC. SEE DETAILS **1/M4.03** & **2/M4.03** & **1/M4.05**, TYPICAL.

ADD2
3. FURNISH AND INSTALL THERMOSTAT AND CO2 SENSOR ON WALL AT +48" TO TOP AT LOCATION SHOWN, TYPICAL.
4. FURNISH AND INSTALL MANUAL VOLUME DAMPER IN EACH INDIVIDUAL BRANCH DUCT. BALANCE TO AIR VOLUME SHOWN, TYPICAL.
5. SECURE CEILING EXHAUST FAN TO STRUCTURAL FRAMING MEMBERS ABOVE. ROUTE EXHAUST DUCT UP THRU ROOF AT LOCATION SHOW. SEE DETAIL **9/M4.02**.
6. CENTER OF AIR TERMINAL AT 12'-2" AFF AT SOFFIT WALL.

ADD2
7. NOT USED.
8. PROVIDE SEISMIC RESTRAINTS ON ALL DUCTWORK 6WHERE REQUIRED BY CODE. SEE DETAIL **1/M4.03**. CONTRACTOR SHALL PROVIDE ENGINEERED PLANS AS PART OF SUBMITTALS.
9. FURNISH AND INSTALL FIRE/SMOKE DAMPER AT ALL RATED ASSEMBLIES WHERE DUCT PENETATIONS OCCUR. FIRE/SMOKE DAMPERS SHALL BE INSTALLED AT AREA OR OCCUPANCY SEPARATION WALLS, FIRE RESISTIVE EXIT WALLS AND CORRIDORS (CEILINGS AND WALLS) SHAFT ENCLOSURES AND AREAS OF REFUGE. REFER TO ARCHITECUTRAL PLANS FOR RATED WALLS, RATED FLOOR/CEILING ASSEMBLIES AND RATED SHAFTS LOCATIONS. SEE DETAILS **2/M4.05**, **6/M4.05** AND **8/M4.05**, TYPICAL.
10. EMERGENCY EXHAUST DUCT FROM BELOW IN RATED CHASE. OFFSET AND ROUTE EXHAUST DUCT ABOVE FINISHED CEILING AS SHOWN. SEE DETAILS **2/M4.03** AND **3/M4.03**, TYPICAL.
11. ROUTE EMERGENCY EXHAUST DUCT UP THRU ROOF AT LOCATION SHOWN. CONNECT TO EXHAUST FAN ON ROOF. SEE DETAIL **3/M4.01**, TYPICAL.
12. OFFSET AND ROUTE SUPPLY AIR OR RETURN AIR OR EXHAUST AIR DUCT DOWN RATED SHAFT. PROVIDE DUCT SUPPORT AT EACH FLOOR LEVEL, AT EACH TURN OF DIRECTION AND EVERY 10'-0" O.C. SEE DETAILS **3/M4.03**, **13/M4.03** AND **14/M4.03**, TYPICAL.
13. ROUTE 3" COMBUSTION AIR AND VENTS AT GAS WATER HEATER, UP ALONG WALL AT LOCATION SHOWN. COMBINE VENTS BELOW ROOF LEVEL AND ROUTE CONCENTRIC VENT UP THRU ROOF. SEE DETAIL **6/M4.01**.
14. MOUNT SUPPLY REGISTER ON EXPOSED DUCT AT LOCATION SHOWN. SEE DETAIL **7/M4.03**, TYPICAL.
15. ROUTE EXPOSED DUCT AS HIGH AS POSSIBLE. COORDINATE ROUTING WITH STRUCTURAL MEMBERS, SUPPORTS, LIGHTS, ETC. SEE DETAILS **2/M4.03** AND **4/M4.03**.
16. COORDINATE DUCT ROUTING OVER FOLDING PARTITION DOORS PRIOR TO COMMENCING WORK IN THIS AREA. CONSULT WITH MEOR FOR ANY DESCREPANCIES. REFER TO ARCHITECTURAL PLANS FOR FOLDING PARTITION REQUIREMENTS.
17. REFRIGERANT LINES IN WALL FROM BELOW. OFFSET AND ROUTE ABOVE FINISHED CEILING AS SHOWN. PROVIDE PIPE SUPPORT EVERY 10'-0" AND EACH TURN OF DIRECTION. SEE DETAIL **10/M4.01**, TYPICAL.
18. ROUTE REFRIGERANT LINES UP THRU ROOF TO CONDENSING UNIT ON ROOF AT LOCATION SHOWN. SEE DETAIL **9/M4.01**, TYPICAL.
19. MAXIMUM LENGTH OF BRANCH DUCT TO VAV BOX SHALL BE MAXIMUM 5'-0", TYPICAL.
20. ALL EXPOSED ROUND DUCT SHALL BE SPIRAL SEAM, TYPICAL.
21. PROVIDE WITH STAINLESS STEEL FACE PLATE. PROVIDED BY CONTROLS CONTRACTOR.
22. CONTROL PANEL FOR VAV BOX TRANSFORMERS. PROVIDE A 120 V/1 CIRCUIT POWER. SEE ELECTRICAL PLANS.
23. PROVIDE LINE VOLTAGE THERMOSTAT ON WALL AT +48" TO TOP OF THERMOSTAT AT LOCATION SHOWN.

ADD2
24. PROVIDE ELBOW DUCT SILENCER IN RETURN DUCT EQUAL TO VIBRO-ACOUSTICS MODEL NUMBER ERMX120/XE OR APPROVED EQUAL. 120"x24" INLET AND OUTLET SIZES. DYNAMIC INSERTION LOSSES SHALL BE EQUAL TO:

FREQUENCY	INSERTION LOSS	EQUIPMENT SOUND POWER LEVEL
63Hz	6dB	60dB
125Hz	12dB	54dB
250Hz	18dB	53dB
500 Hz	28dB	52dB
1000 Hz	35dB	52dB
2000 Hz	35dB	51dB
4000 Hz	28dB	33dB
8000 Hz	22dB	40dB

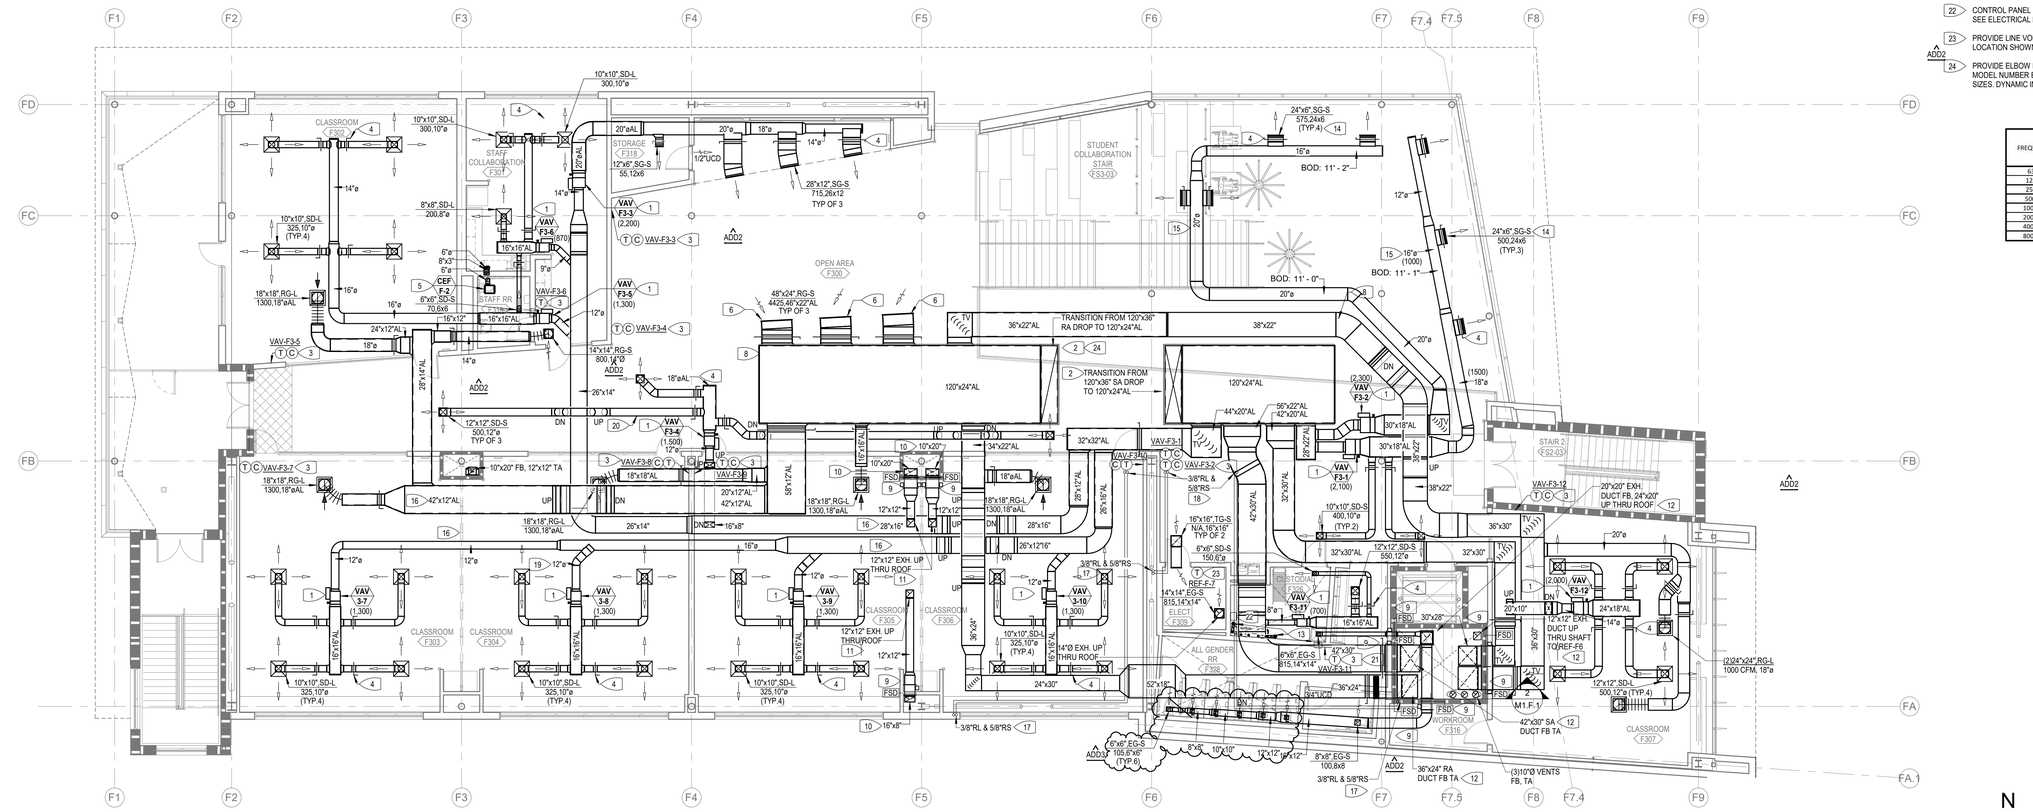

1 **BLDG F THIRD FLOOR PLAN - MECHANICAL**
1/8" = 1'-0"

DLR Group
Architecture Engineering Planning Interiors

© 2019, DLR Group Inc. of California, a California corporation. ALL RIGHTS RESERVED

REGISTERED PROFESSIONAL ENGINEER
SEAN R. TICHENOR
M31176
EXP. 12/31/21
MECHANICAL
STATE OF CALIFORNIA

PETERS Engineering
consulting mechanical and electrical engineers
2411 Alhambra Blvd., Ste. 100
Sacramento, CA 95817
Tel (916) 447-2061
www.petersengineering.com
Job No. 19-05

BLDG F THIRD FLOOR - MECHANICAL
WEST PARK HIGH SCHOOL, PHASE 2 (INC. 1)
2401 High School road, Roseville, California 95747

ADDENDUM 3
07.10.2020
Revisions
2020-07-08 ADD2 Addendum 2
2020-07-10 ADD3 Addendum 3

PROJECT ##75-19101-00

M1.F.3

KEY PLAN
NORTH
Foothill
Sierra
Oak
River
Panther Arena
(E) BUILDINGS

ADD3 2020-07-10
ADD2 2020-07-08


C:\Users\tsantillan\Documents\19.056 Westpark HS PH 2 MECH-PLUMB_INC 1_2019_tsantillan@peterseng.com.rvt
7/10/2020 11:30:25 AM

SHEET NOTES:

1. PROVIDE TURNING VANES AT ALL RECTANGULAR DUCTWORK WITH 90
2. FLEXIBLE DUCT IS LIMITED TO 5'-0" IN LENGTH.
3. PROVIDE MANUAL VOLUME DAMPER AT EVERY BRANCH DUCT.
4. PROVIDE SHOE FITTING AT ALL RECTANGULAR TO RECTANGULAR DUCT BRANCHES.
5. PROVIDE CONICAL FITTING AT ALL ROUND TO RECTANGULAR DUCT BRANCHES.
6. FLEXIBLE DUCT TO DIFFUSERS OR GRILLES IN EXPOSED AREAS (NO CEILING) SHALL NOT BE USED.
7. CONTRACTOR SHALL PROVIDE DUCT SHOP DRAWINGS AND SEISMIC DUCT SUPPORT DRAWINGS AND CALCULATIONS.
8. ALL EXPOSED ROUND DUCT SHALL BE SPIRAL SEAM.

KEYED NOTES:

1. SECURE VAV BOX TIGHT TO STRUCTURAL FRAMING MEMBERS ABOVE AT LOCATION SHOWN. FIELD VERIFY FINAL UNIT LOCATION, SUPPLY PLENUM, HYDRONIC LINES AND ROUTING WITH STRUCTURAL FRAMING MEMBERS, SUPPORTS, LIGHTS, ETC. MAINTAIN MIN. 30" IN FRONT OF VAV CONTROLS AND CONTROL VALVE. SEE DETAIL **7/M4.02**, TYPICAL.
2. SUPPLY AND/OR RETURN AIR DROPS IN RATED SHAFT FROM ABOVE. OFFSET AND ROUTE TIGHT TO UNDERSIDE OF ROOF FRAMING MEMBERS. FIELD COORDINATE DUCT ROUTING WITH STRUCTURAL MEMBERS, PIPING, SUPORTS, LIGHT FIXTURES, ETC. SEE DETAILS **1/M4.03** & **2/M4.03** & **1/M4.05**, TYPICAL.
3. FURNISH AND INSTALL THERMOSTAT AND CO2 SENSOR ON WALL AT +48" TO TOP AT LOCATION SHOWN.
4. FURNISH AND INSTALL MANUAL VOLUME DAMPER IN EACH INDIVIDUAL BRANCH DUCT. BALANCE TO AIR VOLUME SHOWN, TYPICAL.
5. SECURE CEILING EXHAUST FAN TO STRUCTURAL FRAMING MEMBERS ABOVE. ROUTE EXHAUST DUCT UP THRU ROOF AT LOCATION SHOW. SEE DETAIL **9/M4.02**.
6. INSTALL ROUND CEILING DIFFUSERS AT CEILING OR OPEN SPACE AT LOCATION SHOWN. CONNECT TO DUCT WITH RIGID DUCTWORK. SEE DETAIL **6/M4.03**.
7. PROVIDE SEISMIC RESTRAINTS ON ALL DUCTWORK WHERE REQUIRED BY CODE. SEE DETAIL **1/M4.03**. CONTRACTOR SHALL PROVIDE ENGINEERED PLANS AS PART OF SUBMITTALS.
8. FURNISH AND INSTALL FIRE/SMOKE DAMPER AT ALL RATED ASSEMBLIES WHERE DUCT PENETATIONS OCCUR. FIRE/SMOKE DAMPERS SHALL BE INSTALLED AT AREA OR OCCUPANCY SEPARATION WALLS, FIRE RESISTIVE EXIT WALLS AND CORRIDORS (CEILINGS AND WALLS) SHAFT ENCLOSURES AND AREAS OF REFUGE. REFER TO ARCHITECUTRAL PLANS FOR RATED WALLS, RATED FLOOR/CEILING ASSEMBLIES AND RATED SHAFTS LOCATIONS. SEE DETAILS **2/M4.05**, **6/M4.05** AND **8/M4.05**, TYPICAL.
9. EMERGENCY EXHAUST DUCT FROM BELOW TO ABOVE IN RATED CHASE. PROVIDE DUCT SUPPORT EVERY 10'-0" AND AT EACH FLOOR LEVEL. SEE DETAIL **3/M4.03**, TYPICAL.
10. FUME HOOD EXHAUST DUCT FROM BELOW TO ABOVE IN RATED CHASE. PROVIDE DUCT SUPPORT EVERY 10'-0" AND AT EACH FLOOR LEVEL. SEE DETAIL **3/M4.03**, TYPICAL.
11. OFFSET AND ROUTE SUPPLY AIR OR RETURN AIR OR EXHAUST AIR DUCT DOWN RATED SHAFT. PROVIDE DUCT SUPPORT AT EACH FLOOR LEVEL, AT EACH TURN OF DIRECTION AND EVERY 10'-0" O.C. SEE DETAILS **3/M4.03**, **13/M4.03** AND **14/M4.03**, TYPICAL.
12. ROUTE EXPOSED DUCT AS HIGH AS POSSIBLE. COORDINATE ROUTING WITH STRUCTURAL MEMBERS, SUPPORTS, LIGHTS, ETC. SEE DETAILS **2/M4.03** AND **4/M4.03**.
13. COORDINATE DUCT ROUTING OVER FOLDING PARTITION DOORS PRIOR TO COMMENCING WORK IN THIS AREA. CONSULT WITH MEOR FOR ANY DESCREPANCIES. REFER TO ARCHITECTURAL PLANS FOR FOLDING PARTITION REQUIREMENTS.
14. REFRIGERANT LINES IN WALL FROM BELOW TO ABOVE. PROVIDE PIPE SUPPORT EVERY 10'-0" AND EACH TURN OF DIRECTION. SEE DETAIL **7/M4.04**, TYPICAL.
15. SECURE FAN COIL UNIT TO HIGH WALL FRAMING MEMBERS AT LOCATION SHOWN. FIELD VERIFY LOCATION WITH STRUCTURAL MEMBERS, ALL ELECTRICAL AND CONTROL WIRING, CONDUITS, ELECTRICAL AND CONTROL PANELS, ETC. SEE DETAIL **10/M4.02**.
16. ROUTE REFRIGERANT LINES UP THRU WALL TO FLOOR ABOVE AT LOCATION SHOWN. SEE DETAIL **7/M4.04**, TYPICAL.
17. MAXIMUM LENGTH OF BRANCH DUCT TO VAV BOX SHALL BE MAXIMUM 5'-0", TYPICAL.
18. ALL EXPOSED ROUND DUCT SHALL BE SPIRAL SEAM, TYPICAL.
19. PROVIDE WITH STAINLESS STEEL FACE PLATE. PROVIDED BY CONTROLS CONTRACTOR.
20. CONTROL PANEL FOR VAV BOX TRANSFORMERS. PROVIDE A 120 V/1 CIRCUIT POWER. SEE ELECTRICAL PLANS.

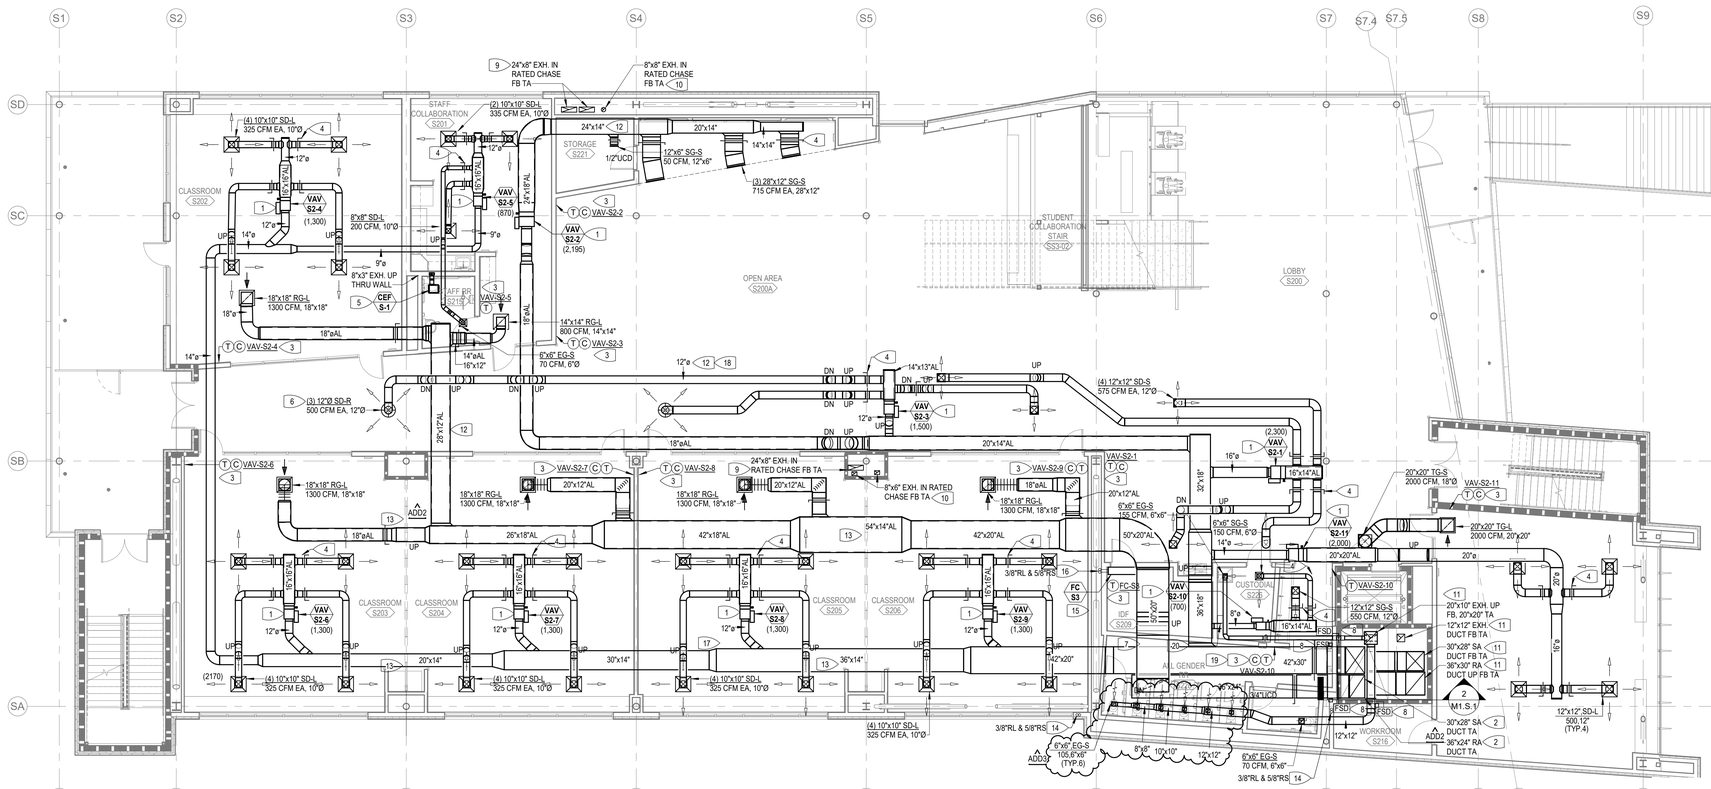

1 **BLDG S SECOND FLOOR PLAN - MECHANICAL**
1/8" = 1'-0"

ADD3 2020-07-10
ADD2 2020-07-08

C:\Users\tsantillan\Documents\19356 Westpark HS PH 2 MECH-PLMB_INC 1_2019_tsantillan@peterseng.com.rvt
7/10/2020 11:30:27 AM

DLR Group
Architecture Engineering Planning Interiors
© 2019, DLR Group Inc. of California, a California corporation. ALL RIGHTS RESERVED

REGISTERED PROFESSIONAL ENGINEER
SEAN R. TICHENOR
M31176
EXP. 12/31/21
MECHANICAL
STATE OF CALIFORNIA

PETERS Engineering
2411 Alhambra Blvd., Ste. 100
Sacramento, CA 95817
Tel (916) 447-2061
www.peterseng.com
consulting mechanical and electrical engineers

BLDG S SECOND FLOOR - MECHANICAL
WEST PARK HIGH SCHOOL, PHASE 2 (INC. 1)
2401 High School road, Roseville, California 95747

ADDENDUM 3
07.10.2020
Revisions
2020-07-08 ADD2 Addendum 2
2020-07-10 ADD3 Addendum 3

PROJECT ##75-19101-00

M1.S.2

SHEET NOTES:

ADD2
1. PROVIDE TURNING VANES AT ALL RECTANGULAR DUCTWORK WITH 90
2. FLEXIBLE DUCT IS LIMITED TO 5'-0" IN LENGTH.
3. PROVIDE MANUAL VOLUME DAMPER AT EVERY BRANCH DUCT.
4. PROVIDE SHOE FITTING AT ALL RECTANGULAR TO RECTANGULAR DUCT BRANCHES.
5. PROVIDE CONICAL FITTING AT ALL ROUND TO RECTANGULAR DUCT BRANCHES.
6. FLEXIBLE DUCT TO DIFFUSERS OR GRILLES IN EXPOSED AREAS (NO CEILING) SHALL NOT BE USED.
7. CONTRACTOR SHALL PROVIDE DUCT SHOP DRAWINGS AND SEISMIC DUCT SUPPORT DRAWINGS AND CALCULATIONS.
8. ALL EXPOSED ROUND DUCT SHALL BE SPIRAL SEAM.
9. PROVIDE MULTI-BLADE MANUAL VOLUME DAMPERS WHERE CLEARANCES ARE REQUIRED, TYPICAL.

KEYED NOTES:


1. SECURE VAV BOX TIGHT TO STRUCTURAL FRAMING MEMBERS ABOVE AT LOCATION SHOWN. FIELD VERIFY FINAL UNIT LOCATION, SUPPLY PLENUM, HYDRONIC LINES AND ROUTING WITH STRUCTURAL FRAMING MEMBERS, SUPPORTS, LIGHTS, ETC. MAINTAIN MIN. 30" IN FRONT OF VAV CONTROLS AND CONTROL VALVE. SEE DETAIL **7/M4.02**, TYPICAL.
2. LINED SUPPLY AND/OR RETURN AIR DROPS FROM ABOVE. OFFSET AND ROUTE TIGHT TO UNDERSIDE OF ROOF FRAMING MEMBERS. FIELD COORDINATE DUCT ROUTING WITH STRUCTURAL MEMBERS, PIPING, SUPORTS, LIGHT FIXTURES, ETC. SEE DETAILS **1/M4.03** & **2/M4.03** & **1/M4.05**, TYPICAL.

ADD2
3. FURNISH AND INSTALL THERMOSTAT AND CO2 SENSOR ON WALL AT +48" TO TOP AT LOCATION SHOWN.
4. FURNISH AND INSTALL MANUAL VOLUME DAMPER IN EACH INDIVIDUAL BRANCH DUCT. BALANCE TO AIR VOLUME SHOWN, TYPICAL.


ADD2
5. SECURE CEILING EXHAUST FAN TO STRUCTURAL FRAMING MEMBERS ABOVE. ROUTE EXHAUST DUCT UP THRU ROOF AT LOCATION SHOW. SEE DETAIL **9/M4.02**.
6. CENTER OF AIR TERMINAL AT 12'-0" AFF ON SOFFIT WALL.
7. NOT USED.
8. PROVIDE SEISMIC RESTRAINTS ON ALL DUCTWORK WHERE REQUIRED BY CODE. SEE DETAIL **1/M4.03**. CONTRACTOR SHALL PROVIDE ENGINEERED PLANS AS PART OF SUBMITTALS.
9. FURNISH AND INSTALL FIRE/SMOKE DAMPER AT ALL RATED ASSEMBLIES WHERE DUCT PENETATIONS OCCUR. FIRE/SMOKE DAMPERS SHALL BE INSTALLED AT AREA OR OCCUPANCY SEPARATION WALLS, FIRE RESISTIVE EXIT WALLS AND CORRIDORS (CEILINGS AND WALLS) SHAFT ENCLOSURES AND AREAS OF REFUGE. REFER TO ARCHITECUTRAL PLANS FOR RATED WALLS, RATED FLOOR/CEILING ASSEMBLIES AND RATED SHAFTS LOCATIONS. SEE DETAILS **2/M4.05**, **6/M4.05** AND **8/M4.05**, TYPICAL.
10. EMERGENCY EXHAUST DUCT FROM BELOW IN RATED CHASE. OFFSET AND ROUTE EXHAUST DUCT ABOVE FINISHED CEILING AS SHOWN. SEE DETAILS **2/M4.03** AND **3/M4.03**, TYPICAL.
11. ROUTE EMERGENCY EXHAUST DUCT UP THRU ROOF AT LOCATION SHOWN. CONNECT TO EXHAUST FAN ON ROOF. SEE DETAIL **3/M4.03**, TYPICAL.
12. FUME HOOD EXHAUST DUCT FROM BELOW IN RATED CHASE. OFFSET AND ROUTE FUME HOOD EXHAUST DUCT ABOVE FINISHED CEILING AS SHOWN. SEAL WALL PENETRATION WITH FIRE-CAULKING AROUND ENTIRE PERIMETER OF DUCT. SEE DETAILS **3/M4.01** & **4/M4.03**, TYPICAL.
13. ROUTE FUME HOOD EXHAUST DUCT UP THRU ROOF AT LOCATION SHOWN. CONNECT TO FUME HOOD EXHAUST FAN ON ROOF. SEE DETAIL **4/M4.01**, TYPICAL.
14. OFFSET AND ROUTE SUPPLY AIR OR RETURN AIR OR EXHAUST AIR DUCT DOWN RATED SHAFT. PROVIDE DUCT SUPPORT AT EACH FLOOR LEVEL, AT EACH TURN OF DIRECTION AND EVERY 10'-0" O.C. SEE DETAIL **3/M4.03**, **13/M4.03** AND **14/M4.03**, TYPICAL.
15. ROUTE 3" COMBUSTION AIR AND VENTS AT GAS WATER HEATER, UP ALONG WALL AT LOCATION SHOWN. COMBINE VENTS BELOW ROOF LEVEL AND ROUTE CONCENTRIC VENT UP THRU ROOF. SEE DETAIL **6/M4.01**.
16. MOUNT SUPPLY REGISTER ON EXPOSED DUCT AT LOCATION SHOWN. SEE DETAIL **7/M4.03**, TYPICAL.
17. ROUTE EXPOSED DUCT AS HIGH AS POSSIBLE. COORDINATE ROUTING WITH STRUCTURAL MEMBERS, SUPPORTS, LIGHTS, ETC. SEE DETAILS **2/M4.03** AND **4/M4.03**.
18. COORDINATE DUCT ROUTING OVER FOLDING PARTITION DOORS PRIOR TO COMMENCING WORK IN THIS AREA. CONSULT WITH MEOR FOR ANY DESCREPANCIES. REFER TO ARCHITECTURAL PLANS FOR FOLDING PARTITON REQUIREMENTS.
19. REFRIGERANT LINES IN WALL FROM BELOW. OFFSET AND ROUTE ABOVE FINISHED CEILING AS SHOWN. PROVIDE PIPE SUPPORT EVERY 10'-0" AND EACH TURN OF DIRECTION. SEE DETAIL **10/M4.01**, TYPICAL.
20. ROUTE REFRIGERANT LINES UP THRU ROOF TO CONDENSING UNIT ON ROOF AT LOCATION SHOWN. SEE DETAIL **9/M4.01**, TYPICAL.
21. MOUNT VFD ON WALL PER DETAIL **5/M4.02** COORDINATE WITH ELECTRICAL FOR POWER REQUIREMENTS. TYP. OF 3.
22. CONTROL PANEL FOR VAV BOX TRANSFORMERS. PROVIDE A 120 V/1 CIRCUIT POWER. SEE ELECTRICAL PLANS.
23. MAXIMUM LENGTH OF BRANCH DUCT TO VAV BOX SHALL BE MAXIMUM 5'-0", TYPICAL.
24. ALL EXPOSED ROUND DUCT SHALL BE SPIRAL SEAM, TYPICAL.
25. PROVIDE WITH STAINLESS STEEL FACE PLATE. PROVIDED BY CONTROLS CONTRACTOR.

ADD2
26. PROVIDE LINE VOLTAGE THERMOSTAT ON WALL AT +48" TO TOP OF THERMOSTAT AT LOCATION SHOWN.
27. PROVIDE ELBOW DUCT SILENCER IN RETURN DUCT EQUAL TO VIBRO-ACOUSTICS MODEL NUMBER ERMX120XE OR APPROVED EQUAL. 120"x24" INLET AND OUTLET SIZES. DYNAMIC INSERTION LOSSES SHALL BE EQUAL TO:

FREQUENCY	INSERTION LOSS	EQUIPMENT SOUND POWER LEVEL
63Hz	6dB	60dB
125Hz	12dB	54dB
250Hz	18dB	53dB
500 Hz	28dB	52dB
1000 Hz	35dB	52dB
2000 Hz	35dB	51dB
4000 Hz	28dB	33dB
8000 Hz	22dB	40dB

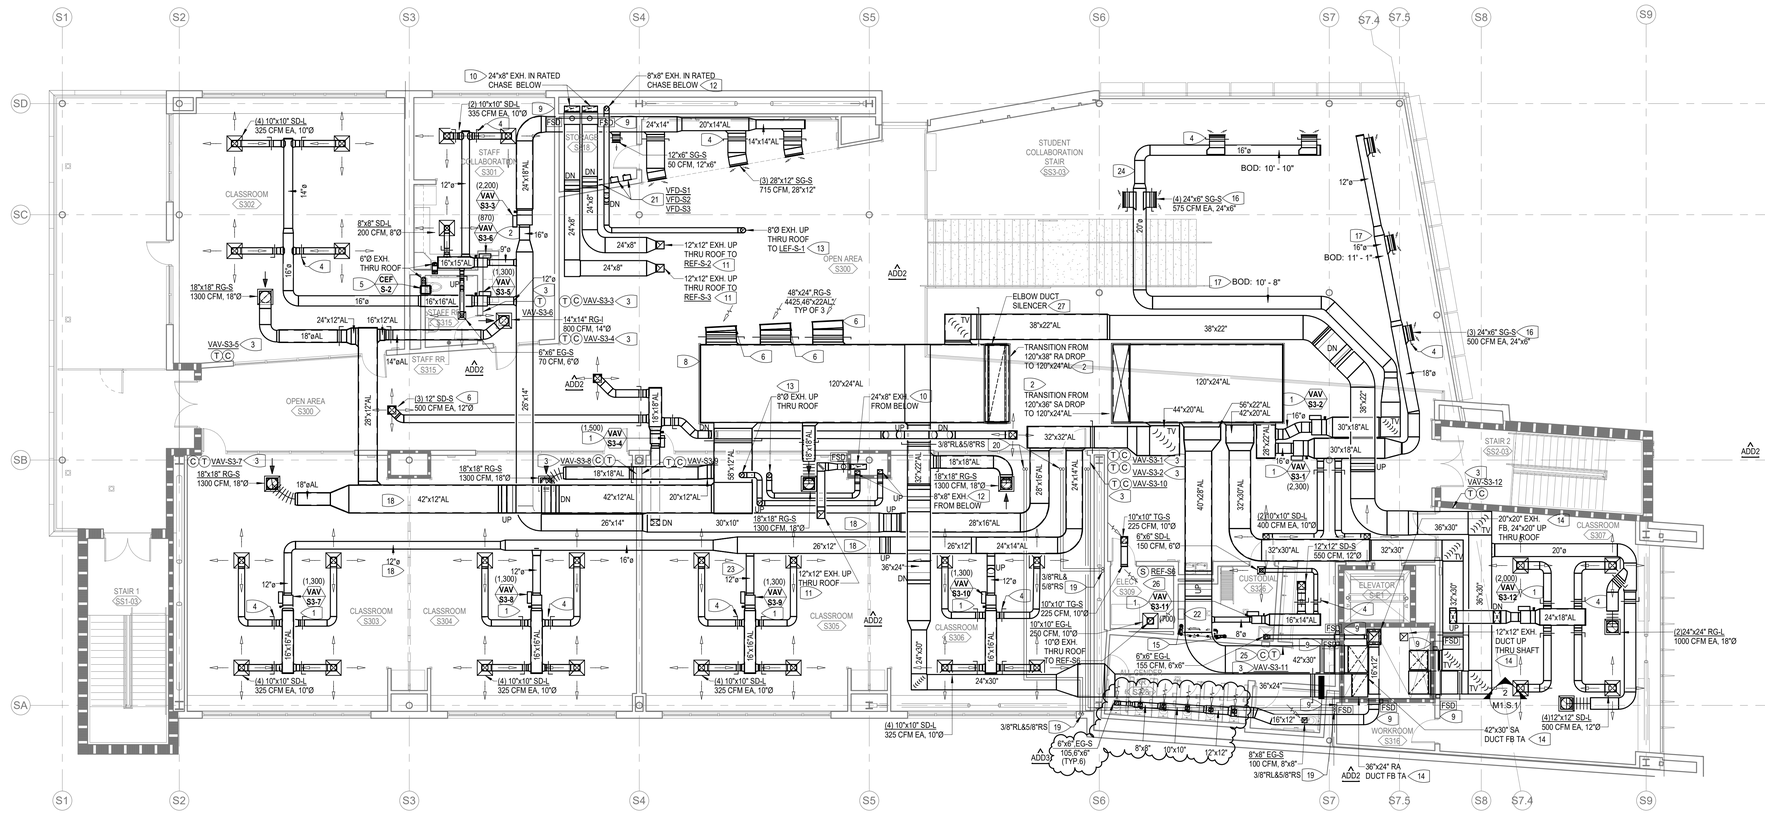

1 **BLDG S THIRD FLOOR PLAN - MECHANICAL**
1/8" = 1'-0"

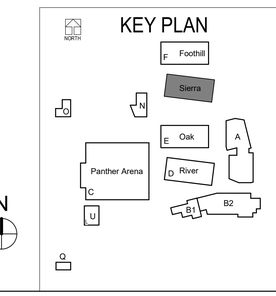

ADD3 2020-07-10
ADD2 2020-07-08

C:\Users\tsanttian\Documents\19.056 Westpark HS PH 2 MECH-PLUMB_INC 1_2019_tsanttian@peterseng.com.rvt
7/10/2020 11:30:30 AM

DLR Group
Architecture Engineering Planning Interiors

© 2019, DLR Group Inc. of California, a California corporation. ALL RIGHTS RESERVED

REGISTERED PROFESSIONAL ENGINEER
M31176
EXP. 12/31/21
MECHANICAL
STATE OF CALIFORNIA

PETERS Engineering
2411 Alhambra Blvd., Ste. 100
Sacramento, CA 95817
Tel (916) 447-2661
www.peterseng.com
Job no. 19.056
consulting mechanical and electrical engineers

BLDG S THIRD FLOOR - MECHANICAL
WEST PARK HIGH SCHOOL, PHASE 2 (INC. 1)


2401 High School road, Roseville, California 95747

ADDENDUM 3
07.10.2020
Revisions

2020-07-08 ADD2 Addendum 2
2020-07-10 ADD3 Addendum 3


PROJECT ##75-19101-00

M1.S.3

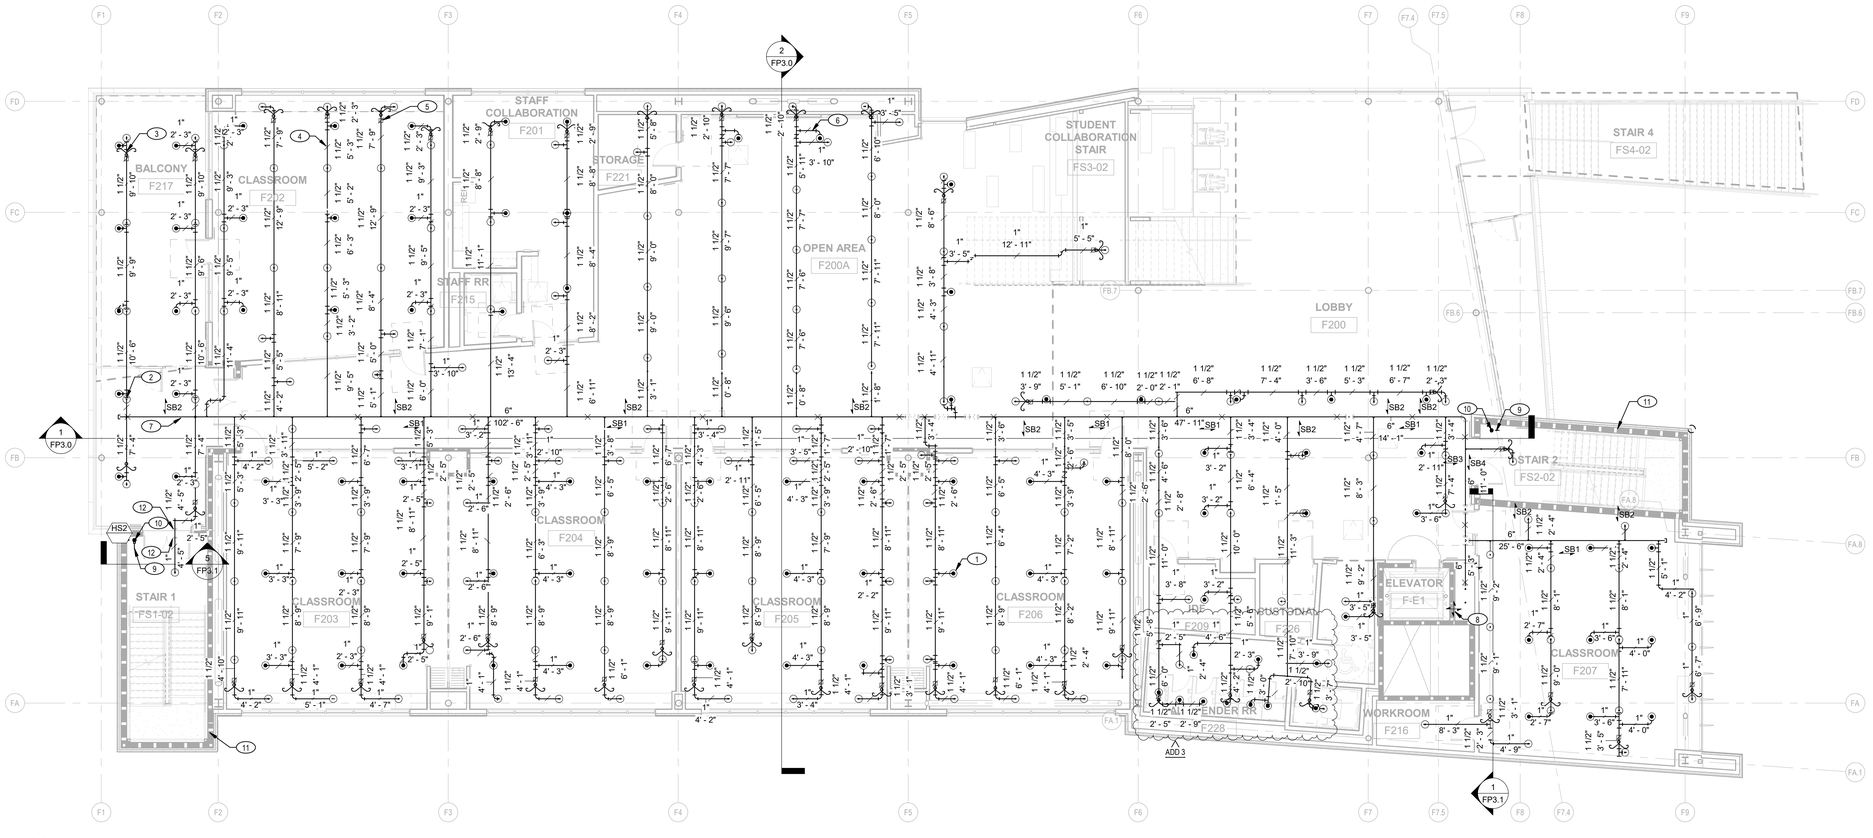

1 FIRE SPRINKLER FLOOR PLAN - BUILDING F - 2ND FLOOR

SCALE: 1/8" = 1'-0"

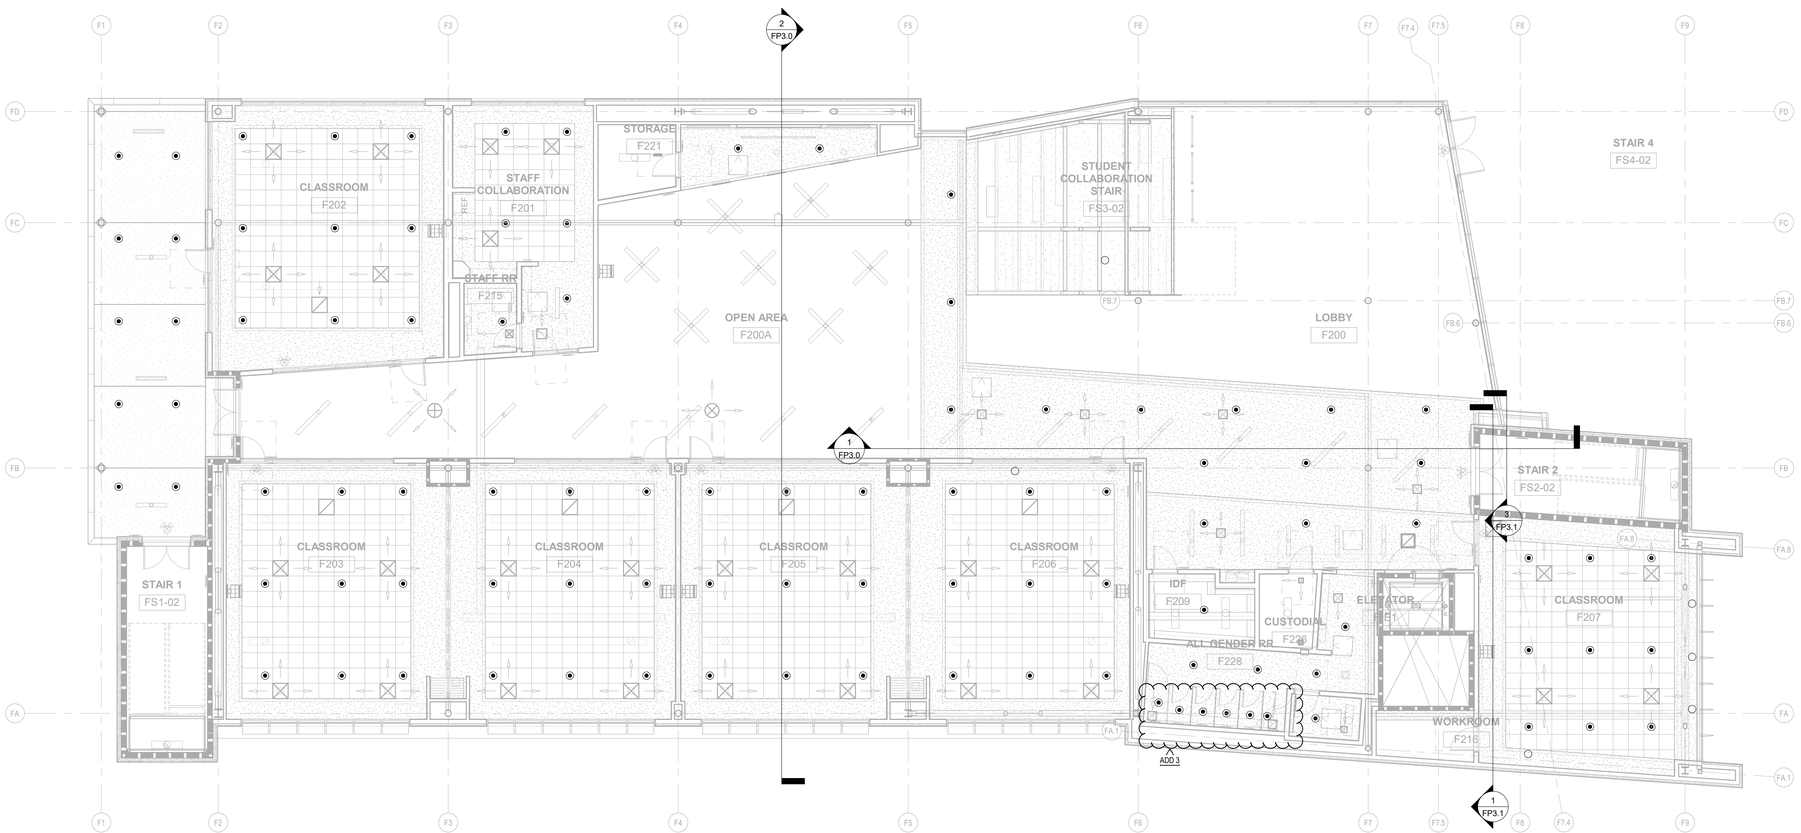

2 FIRE PROTECTION RCP - FOOTHILL BUILDING - SECOND FLOOR

SCALE: 1/8" = 1'-0"

0' 4' 8' 16' 32'

FIRE SPRINKLER HEAD SCHEDULE

SYMBOL	TYPE	TEMP	ORF	K	FINISH	QUANTITY
○	GL 5615 QR SSU SPRINK	200	1/2"	5.6	BRASS	178
◉	GL 5601 QR SSP SPRINK	155	1/2"	5.6	CHROME	98
TOTAL NUMBER OF SPRINKLERS:						276

SHEET NOTES


(#)

1. STANDARD SPRAY QUICK-RESPONSE RECESSED PENDENT FIRE SPRINKLER
2. STANDARD SPRAY QUICK-RESPONSE UPRIGHT FIRE SPRINKLER
3. END OF LINE RESTRAINT WITH NEAREST HANGER WITHIN 2 FT. OF RESTRAINT (INSTALLED WITH SURGE RESTRAINER TO RESIST UPWARD MOVEMENT) -SEE DETAIL 10/FP5.1
4. HANGER ASSEMBLY
5. HANGER WITH SURGE RESTRAINER PER 10/FP5.1
6. 1" SCH.40 ARMOVER PIPE
7. 6" SCH.10 FIRE SPRINKLER MAIN PIPE
8. 4-WAY BRACE PER DETAIL 9/FP5.1
9. 2 1/2" POTTER ROEMER FIRE PRO STANDPIPE HOSE CONNECTION MODEL NO. 4110 SEE DETAIL 4/FP5.0
10. 4" SCH. 10 STANDPIPE
11. 1-HR FIRE RESISTANT RATED WALL (TYP.)
12. FLEXIBLE COUPLING

GENERAL NOTES

A. ALL SPRINKLER HEADS TO BE LOCATED IN THE CENTER OF CEILING TILES AND COORDINATED WITH LOCATIONS OF LIGHTS AND MECHANICAL REGISTERS.

KEY PLAN

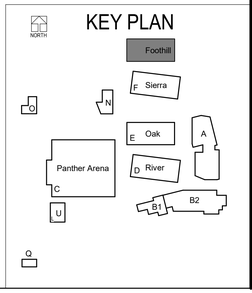

DLR Group
Architecture Engineering Planning Interiors
© 2019, DLR Group Inc. of California, a California corporation. ALL RIGHTS RESERVED

REGISTERED PROFESSIONAL ENGINEER STEPHEN FOURNIER MECHANICAL M 32311 REN. 6-30-21 STATE OF CALIFORNIA

CONSULTING ENGINEERS
1209 Pleasant Grove Blvd.
Roseville, CA 95678
p 916-771-0778
www.lpengineers.com
Job #: 19-2184

FIRE SPRINKLER - BLDG F - 2ND FLOOR
WEST PARK HIGH SCHOOL, PHASE 2 (INC. 1)
2401 High School Road, Roseville, California 95747
Roseville Joint Union High School District


ADDENDUM 3
07.10.2020
Revisions
07-10-20 ADDENDUM 3

PROJECT #75-19101-00
DSA APPL #02-118062
DSA FILE #31-H3

FP1.F2.1

07-10-20

C:\Users\khomas\Documents\19-2184_West Park HS Phase 2_Fire Protection_r19_KhomasFNARV.rvt
7/10/2020 1:19:09 PM

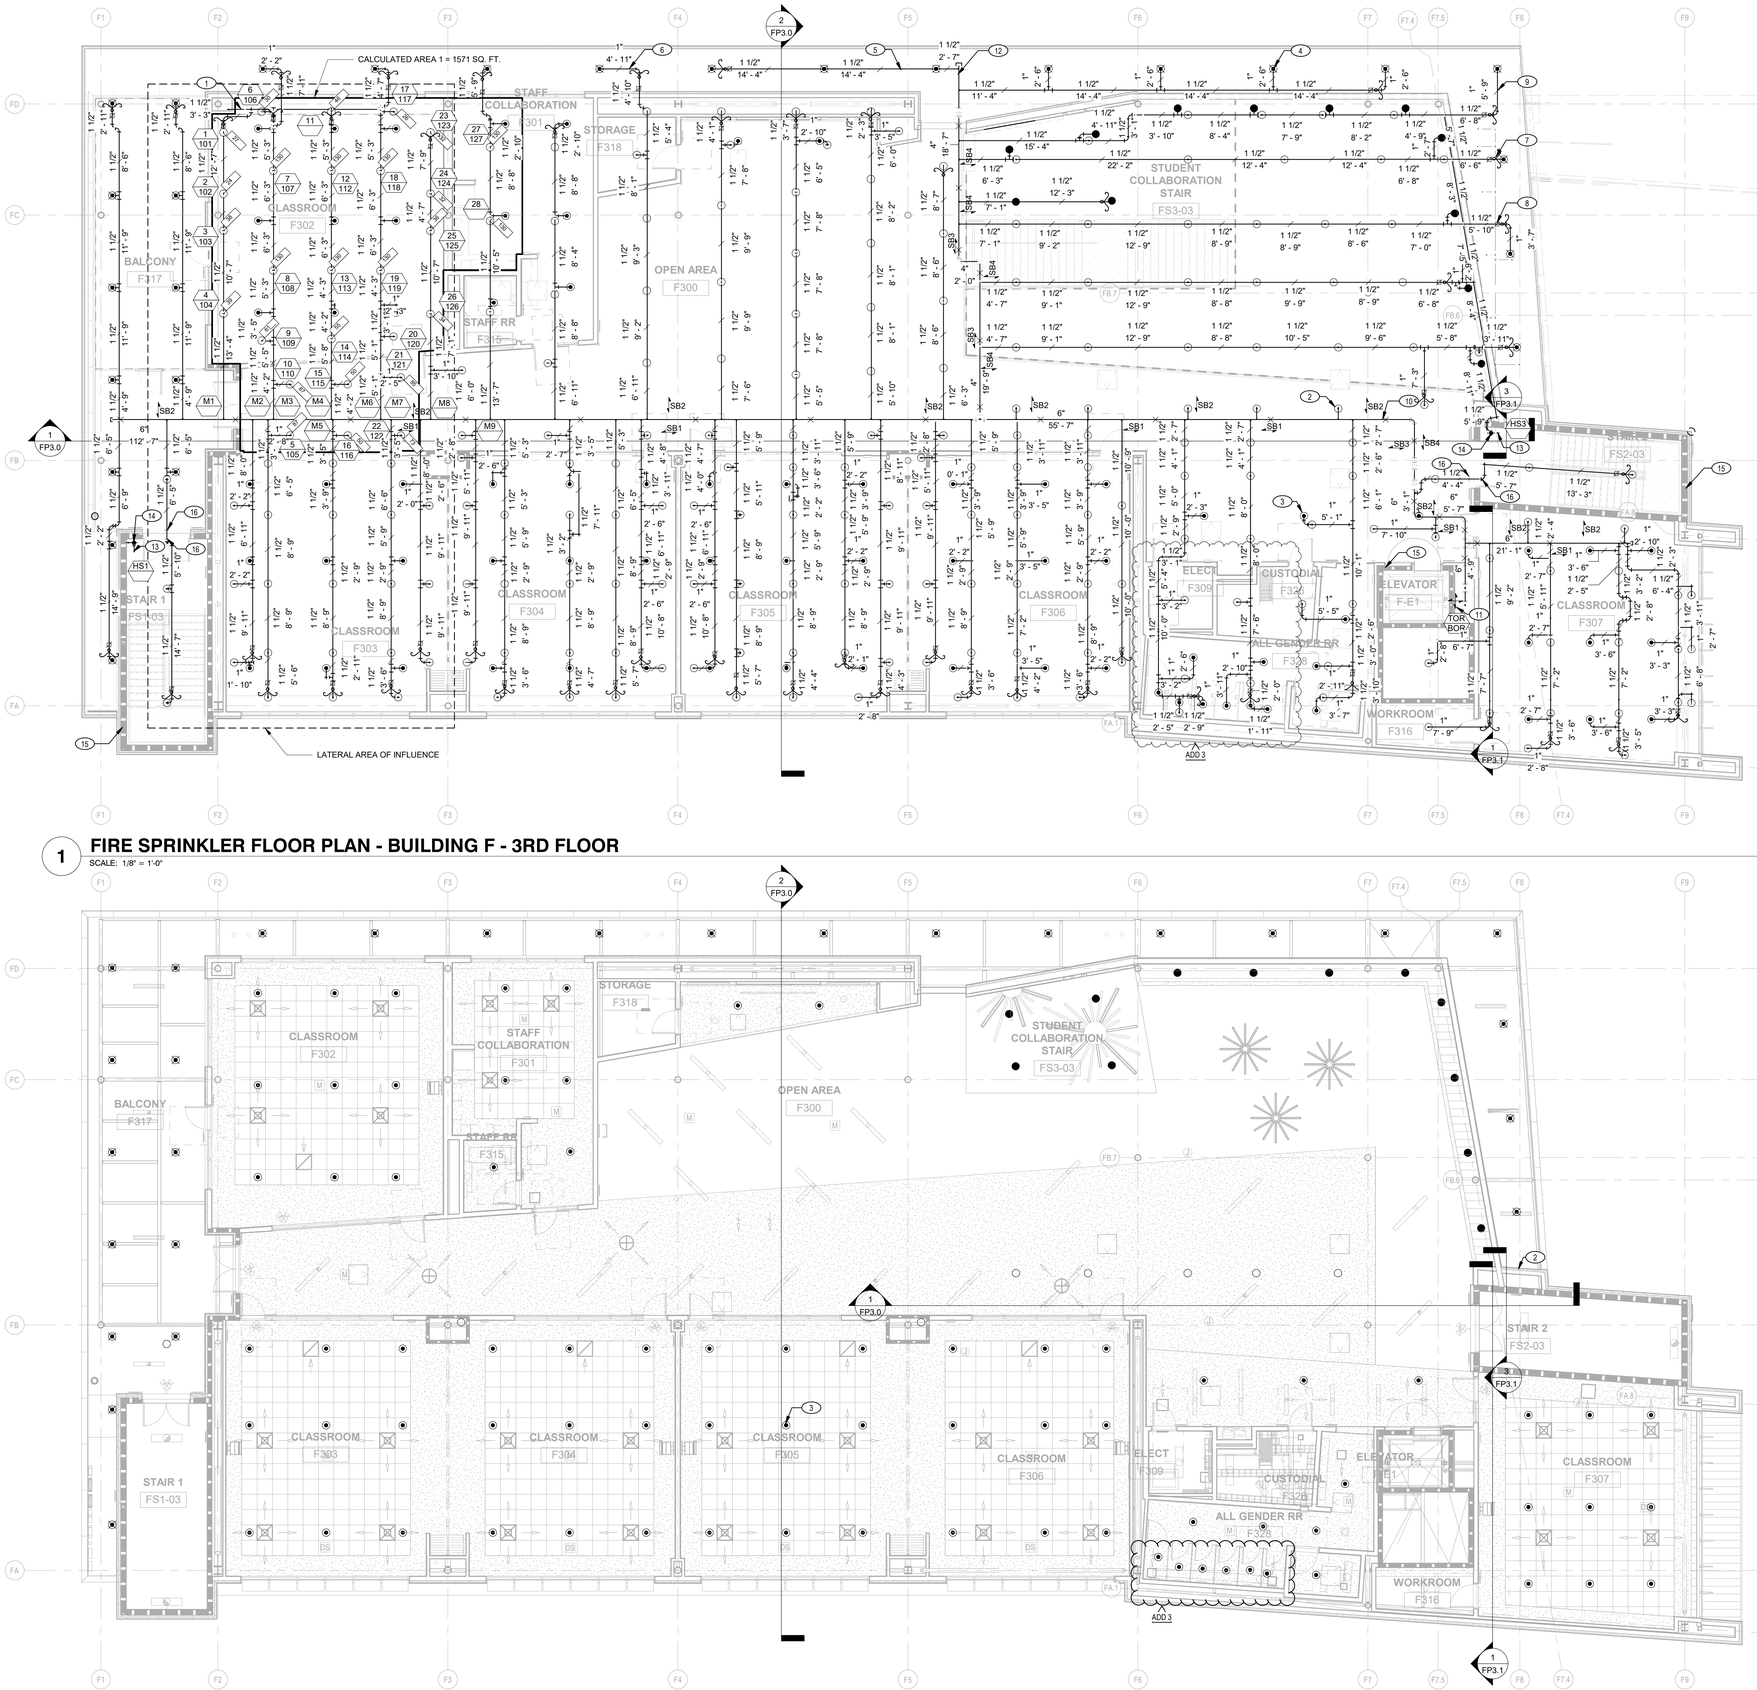

1 FIRE SPRINKLER FLOOR PLAN - BUILDING F - 3RD FLOOR

SCALE: 1/8" = 1'-0"

2 FIRE PROTECTION RCP - FOOTHILL BUILDING - THIRD FLOOR

SCALE: 1/8" = 1'-0"

0' 4' 8' 16' 32'

SHEET NOTES

#	
1	INSPECTOR'S TEST AND DRAIN LOCATION. PROVIDE ACCESS PANEL AT CEILING BELOW WITH IDENTIFICATION SIGNAGE.
2	STANDARD SPRAY QUICK-RESPONSE UPRIGHT FIRE SPRINKLER
3	STANDARD SPRAY QUICK-RESPONSE RECESSED PENDENT FIRE SPRINKLER
4	DRY PENDENT SEE DETAIL 8/FP5.0
5	1 1/2" SCH.40 BRANCH LINE PIPE
6	1" SCH.40 ARMOVER PIPE
7	END OF LINE RESTRAINT WITH NEAREST HANGER WITHIN 2 FT. OF RESTRAINT (INSTALLED WITH SURGE RESTRAINER TO RESIST UPWARD MOVEMENT) -SEE DETAIL 10/FP5.1
8	HANGER WITH SURGE RESTRAINER PER 10/FP5.1
9	HANGER ASSEMBLY
10	6" SCH.10 FIRE SPRINKLER MAIN PIPE
11	4-WAY BRACE PER DETAIL 9/FP5.1
12	4" SCH.10 BLK STEEL BULK PIPE
13	2 1/2" POTTER ROEMER FIRE PRO STANDPIPE HOSE CONNECTION MODEL NO. 4110 SEE DETAIL 4/FP5.0
14	4" SCH. 10 STANDPIPE
15	1-HR FIRE RESISTANT RATED WALL (TYP.)
16	FLEXIBLE COUPLING

GENERAL NOTES

A. ALL SPRINKLER HEADS TO BE LOCATED IN THE CENTER OF CEILING TILES AND COORDINATED WITH LOCATIONS OF LIGHTS AND MECHANICAL REGISTERS.

HYDRAULIC CALCULATION

DESIGN INFORMATION

CALCULATION AREA#	1
SPRINKLER HEAD TYPE	SSU
K-FACTOR	5.6
SYSTEM TYPE (WET/DRY)	WET
HAZARD CLASSIFICATION	LIGHT
DENSITY (GPM/S.F.)	.10
AREA PER HEAD	130 MAX
AREA OF OPERATION (S.F.)	1571 (LARGEST OPEN AREA)

AREA OF OPERATION ADJUSTMENTS:

DRY PIPE INCREASE (30%)	N/A
SLOPE > 2:12 INCREASE (30%)	N/A
CEILING HEIGHT	N/A
PERCENT REDUCTION	N/A
CEILING REDUCTION (S.F.)	N/A
ADJUSTED AREA OF OPERATION	1571

WATER SUPPLY

STATIC (PSI)	52
RESIDUAL (PSI)	50
FLOW (GPM)	4000
FIRE PUMP (GPM @ PSI)	-

SYSTEM DEMAND @ SOURCE

PRESSURE REQUIRED (PSI)	45.81
FLOW REQUIRED (GPM)	581.68
PRESSURE AVAILABLE (PSI)	51.94
SAFETY MARGIN (%)	11.8%
HOSE STREAM ALLOWANCE (GPM)	
INSIDE 100 OUTSIDE N/A	


SYSTEM DEMAND AT BASE OF RISER

PRESSURE REQUIRED (PSI)	39.79
FLOW REQUIRED (GPM)	581.68

FIRE SPRINKLER HEAD SCHEDULE

SYMBOL	TYPE	TEMP	ORF	K	FINISH	QUANTITY
○	GL5615 QR SSU SPRINK	200	1/2"	5.6	BRASS	181
⊠	GL 5635 QR SSP DRY SPRINK	200	1"	5.6	WHITE	27
●	GL 5606 QR CONCEALED SSP SPRINK	155	1/2"	5.6	WHITE	12
◉	GL 5601 QR SSP SPRINK	155	1/2"	5.6	CHROME	76
TOTAL NUMBER OF SPRINKLERS:						296

KEY PLAN

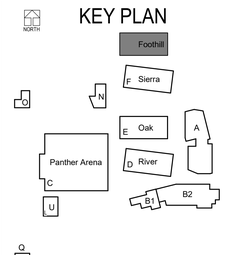

DLR Group
Architecture Engineering Planning Interiors
© 2019, DLR Group Inc. of California, a California corporation. ALL RIGHTS RESERVED

REGISTERED PROFESSIONAL ENGINEER
M 32311
REN. 6-30-21
MECHANICAL
STATE OF CALIFORNIA

CONSULTING ENGINEERS
1209 Pleasant Grove Blvd.
Roseville, CA 95678
p 916-771-0778
www.lpengineers.com
Job #: 19-2184

FIRE SPRINKLER - BLDG F - 3RD FLOOR
WEST PARK HIGH SCHOOL, PHASE 2 (INC. 1)

2401 High School Road, Roseville, California 95747
Roseville Joint Union High School District


ADDENDUM 3
07.10.2020
Revisions
07-10-20 ADDENDUM 3

PROJECT #75-19101-00
DSA APPL. #02-118062
DSA FILE #31-H3

FP1.F3.1


07-10-20

C:\Users\khomas\Documents\19-2184_West Park HS Phase 2_Fire Protection_r19_khomasFNARV.rvt
7/10/2020 1:19:16 PM

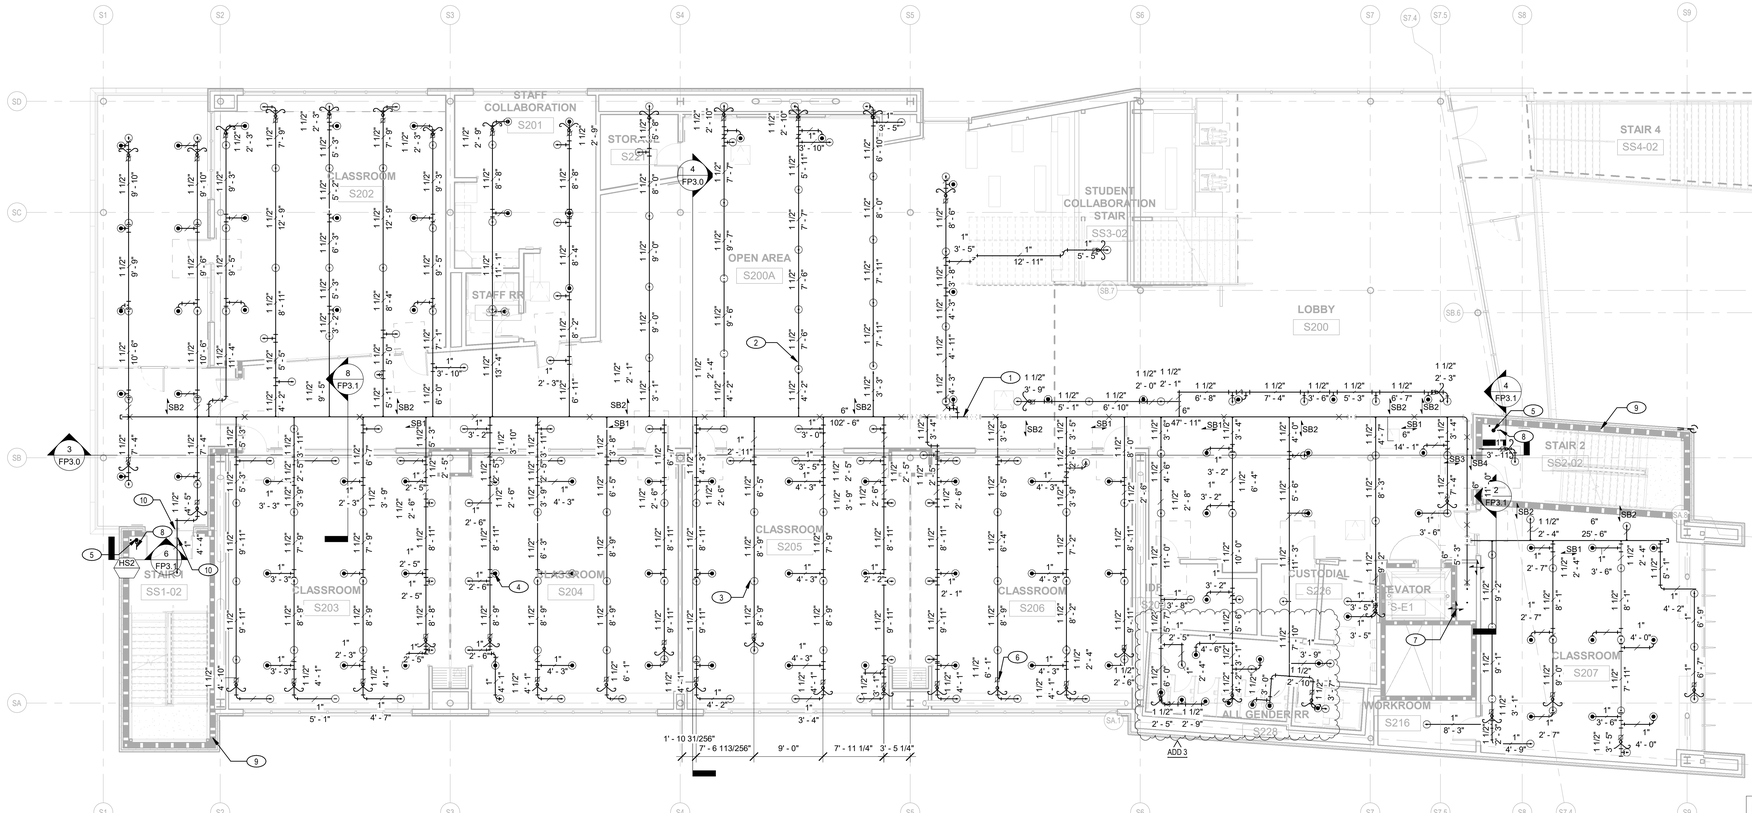

1 FIRE SPRINKLER FLOOR PLAN - BUILDING S - 2ND FLOOR

SCALE: 1/8" = 1'-0"

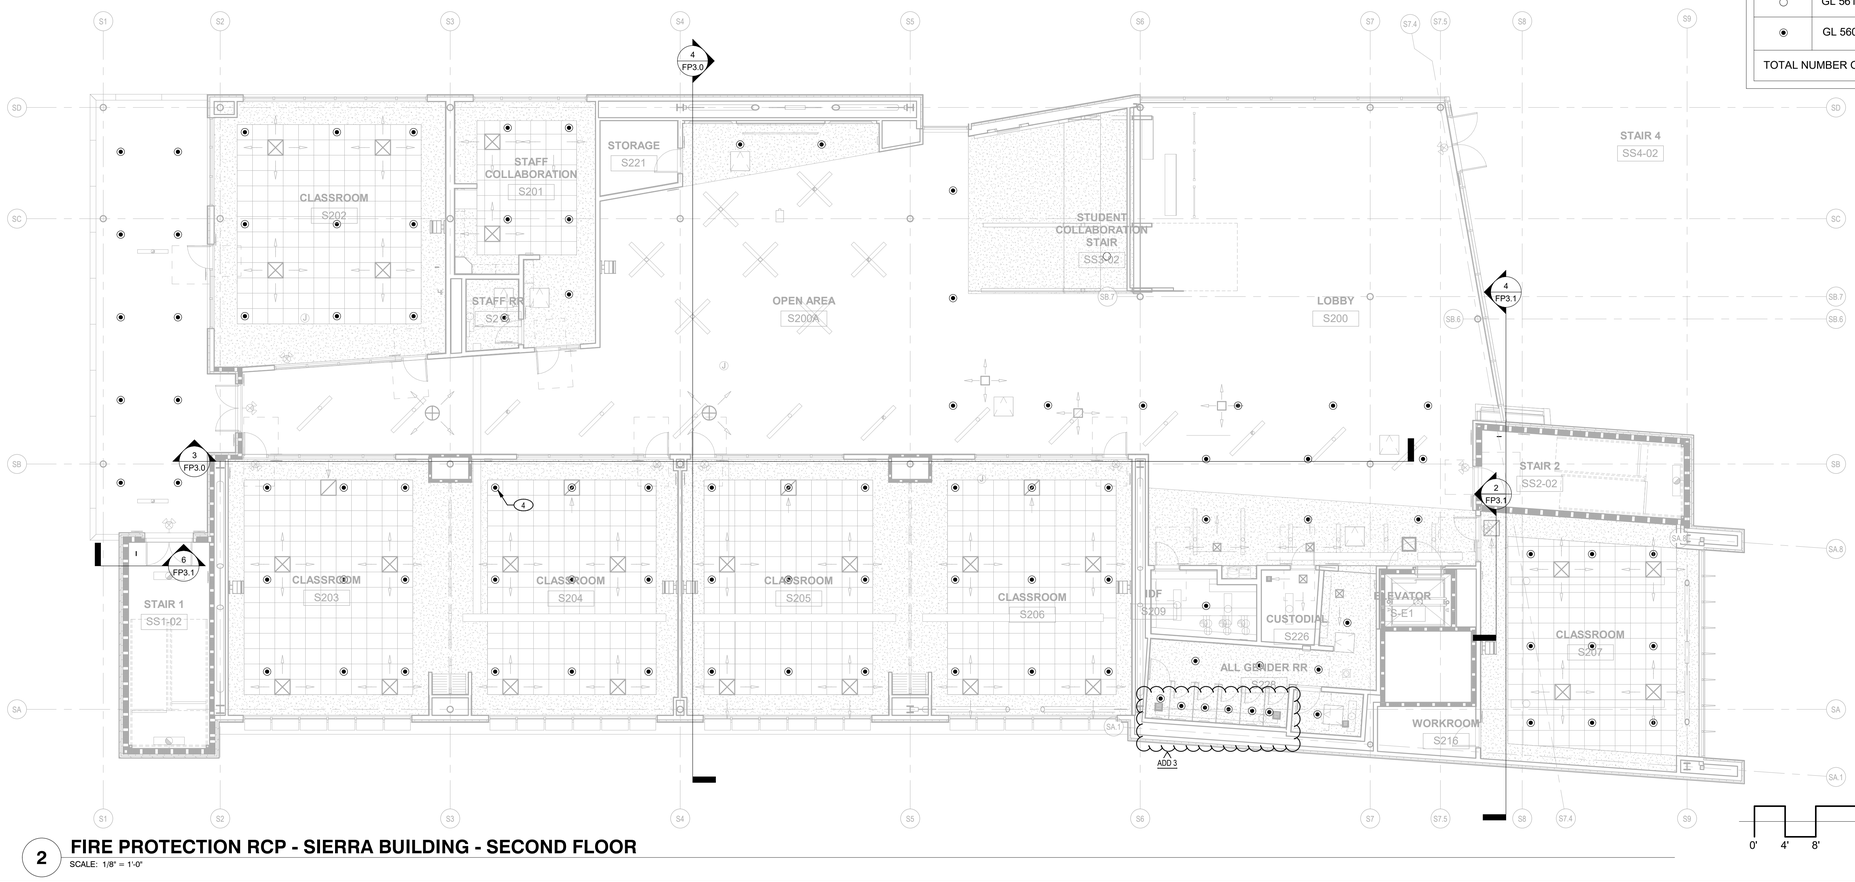

2 FIRE PROTECTION RCP - SIERRA BUILDING - SECOND FLOOR

SCALE: 1/8" = 1'-0"

07-10-20

C:\Users\kthomas\Documents\19-2184_West Park HS Phase 2_Fire Protection_r19_kthomasPNARV.rvt
7/10/2020 1:19:22 PM

SHEET NOTES


#	
1	6" SCH.10 FIRE SPRINKLER MAIN PIPE
2	1 1/2" SCH.40 BRANCH LINE PIPE
3	STANDARD SPRAY QUICK-RESPONSE UPRIGHT FIRE SPRINKLER
4	STANDARD SPRAY QUICK-RESPONSE RECESSED PENDENT FIRE SPRINKLER
5	4" SCH. 10 STANDPIPE
6	HANGER WITH SURGE RESTRAINER PER 10/FP5.1
7	4-WAY BRACE PER DETAIL 9/FP5.1
8	2 1/2" POTTER ROEMER FIRE PRO STANDPIPE HOSE CONNECTION MODEL NO. 4110 SEE DETAIL 4/FP5.0
9	1-HR FIRE RESISTANT RATED WALL (TYP.)
10	FLEXIBLE COUPLING

GENERAL NOTES

A. ALL SPRINKLER HEADS TO BE LOCATED IN THE CENTER OF CEILING TILES AND COORDINATED WITH LOCATIONS OF LIGHTS AND MECHANICAL REGISTERS.

FIRE SPRINKLER HEAD SCHEDULE

SYMBOL	TYPE	TEMP	ORF	K	FINISH	QUANTITY
○	GL 5615 QR SSU SPRINK	200	1/2"	5.6	BRASS	178
◉	GL 5601 QR SSP SPRINK	155	1/2"	5.6	CHROME	98
TOTAL NUMBER OF SPRINKLERS:						276

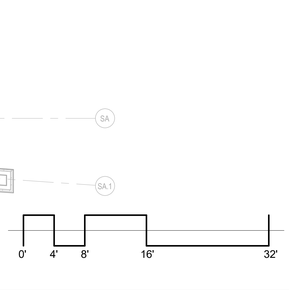

DLR Group
Architecture Engineering Planning Interiors
© 2019, DLR Group inc. of California, a California corporation, ALL RIGHTS RESERVED

REGISTERED PROFESSIONAL ENGINEER KOURY WILLIAM THOMAS M 32311 REN. 6-30-21 MECHANICAL STATE OF CALIFORNIA

CONSULTING ENGINEERS
1209 Pleasant Grove Blvd.
Roseville, CA 95678
p 916-771-0778
www.lpengineers.com
Job #: 19-2184

FIRE SPRINKLER - BLDG S - 2ND FLOOR
WEST PARK HIGH SCHOOL, PHASE 2 (INC. 1)

2401 High School Road, Roseville, California 95747


Roseville Joint Union High School District

ADDENDUM 3
07.10.2020
Revisons

07-10-20 ADDENDUM 3


PROJECT #75-19101-00
DSA APPL. #02-118062
DSA FILE #31-H3

FP1.S2.1

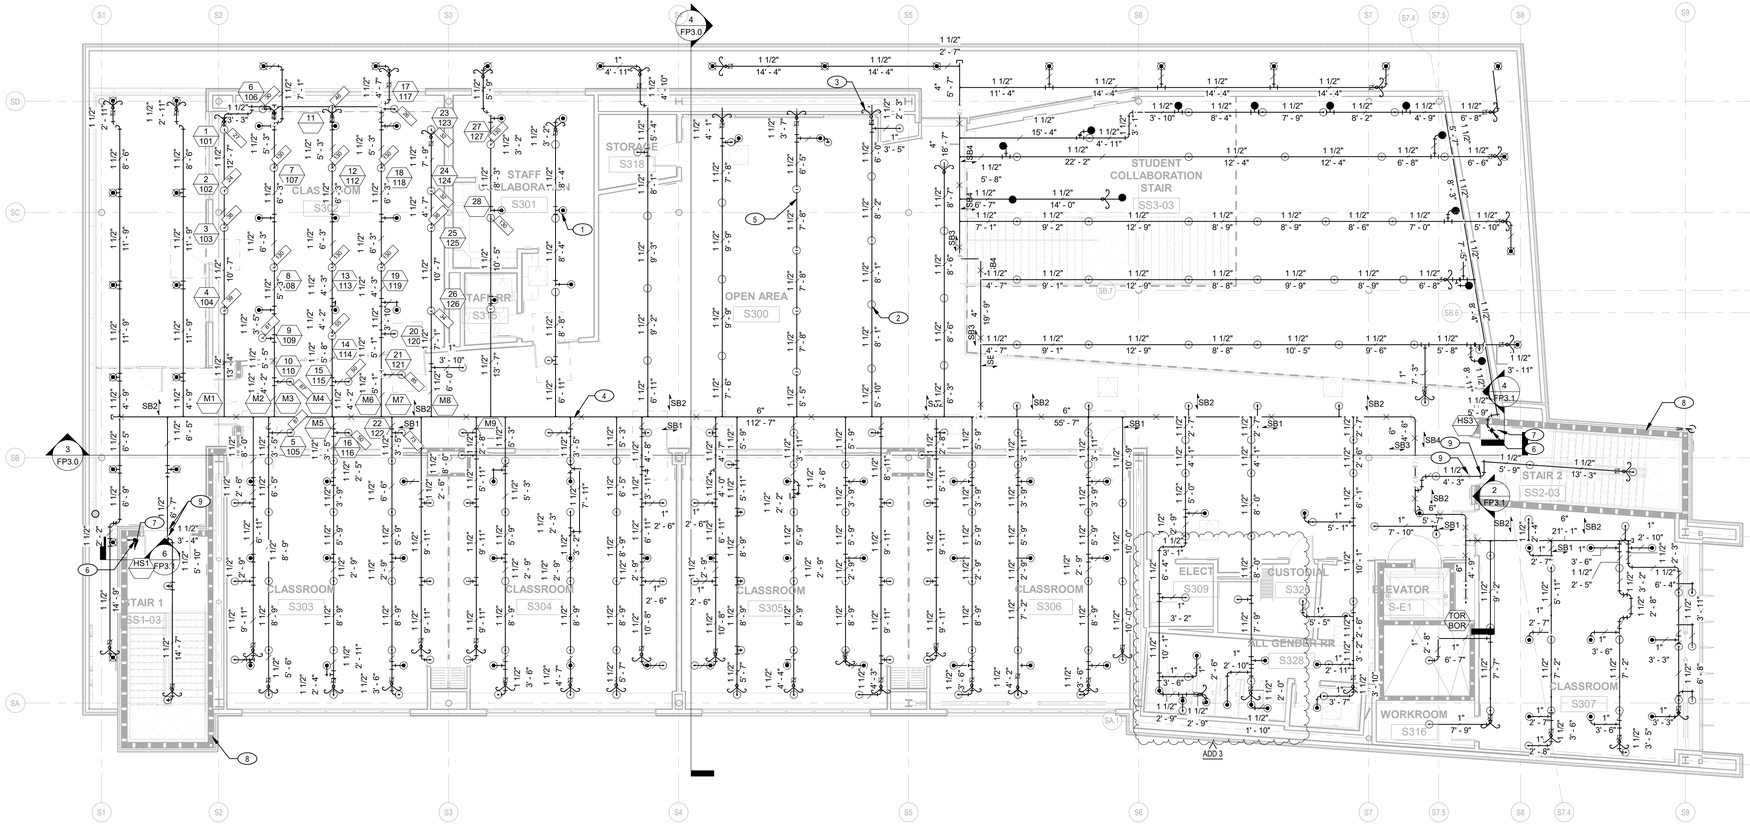

1 FIRE SPRINKLER FLOOR PLAN - BUILDING S - 3RD FLOOR

SCALE: NONE

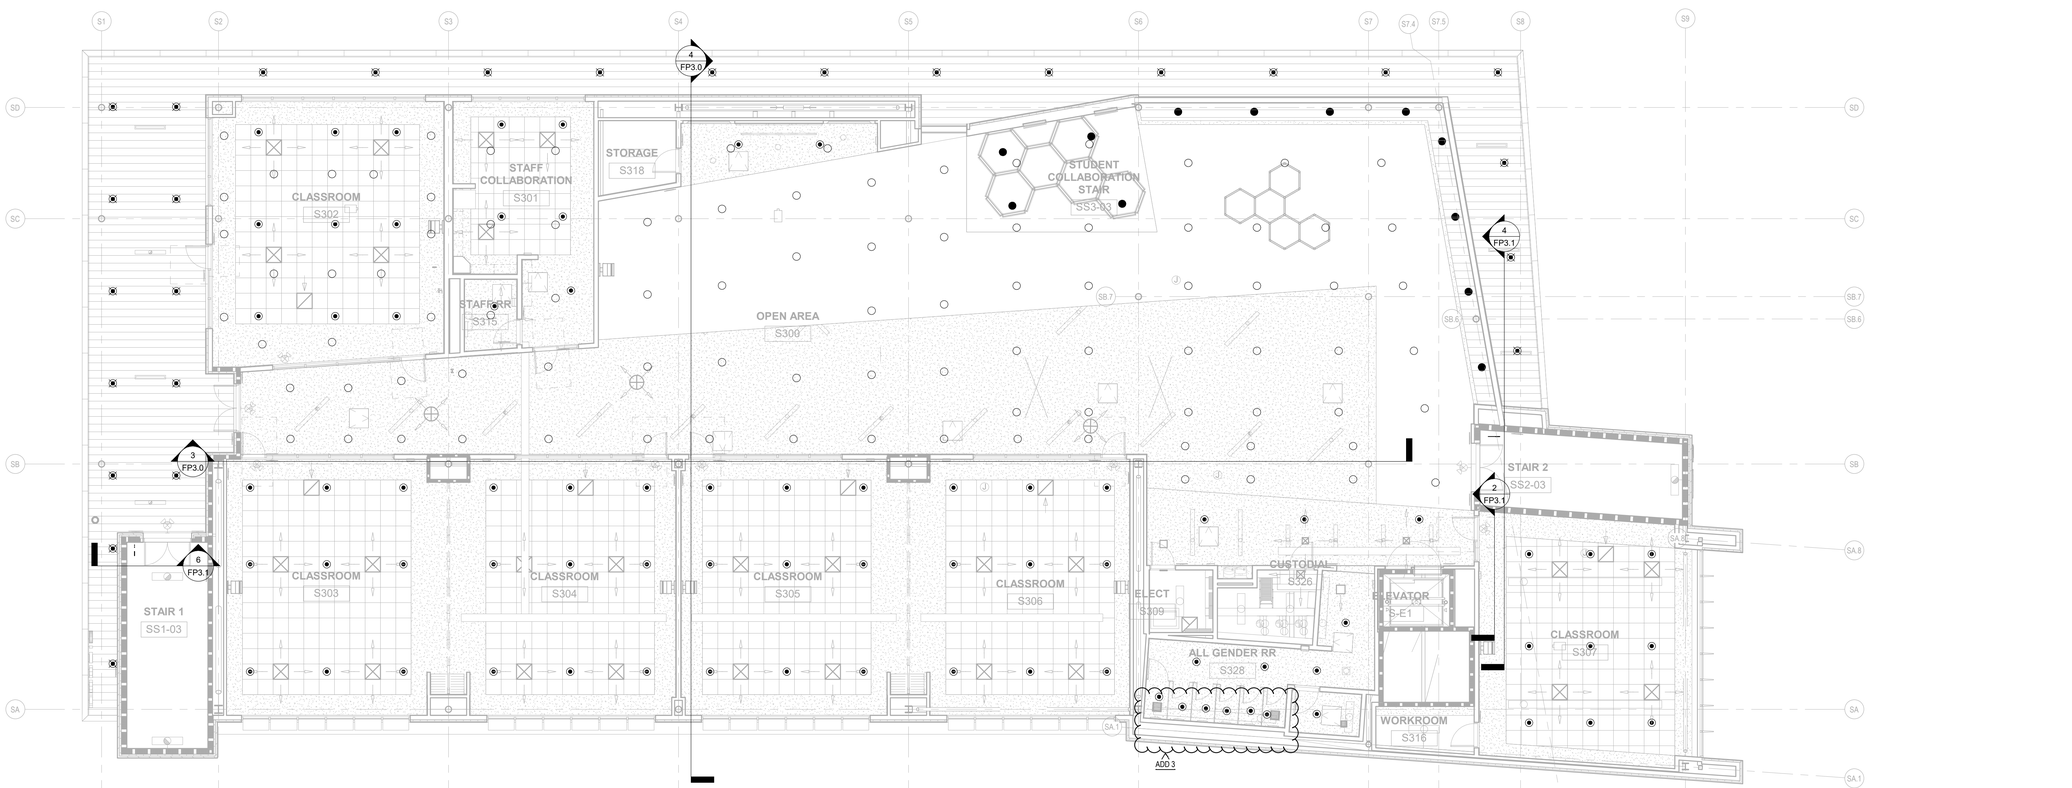

2 FIRE PROTECTION RCP - SIERRA BUILDING - THIRD FLOOR

SCALE: NONE

07-10-20

C:\Users\khomas\Documents\19-2164_West Park HS Phase 2_Fire Protection_r19_KthomasFNARV.rvt
7/10/2020 1:18:27 PM

SHEET NOTES

#	
1	STANDARD SPRAY QUICK-RESPONSE RECESSED PENDENT FIRE SPRINKLER
2	STANDARD SPRAY QUICK-RESPONSE UPRIGHT FIRE SPRINKLER
3	HANGER WITH SURGE RESTRAINER PER 10/FP5.1
4	6" SCH.10 FIRE SPRINKLER MAIN PIPE
5	1 1/2" SCH.40 BRANCH LINE PIPE
6	4" SCH. 10 STANDPIPE
7	2 1/2" POTTER ROEMER FIRE PRO STANDPIPE HOSE CONNECTION MODEL NO. 4110 SEE DETAIL 4/FP5.0
8	1-HR FIRE RESISTANT RATED WALL (TYP.)
9	FLEXIBLE COUPLING

GENERAL NOTES

A. ALL SPRINKLER HEADS TO BE LOCATED IN THE CENTER OF CEILING TILES AND COORDINATED WITH LOCATIONS OF LIGHTS AND MECHANICAL REGISTERS.

FIRE SPRINKLER HEAD SCHEDULE

SYMBOL	TYPE	TEMP	ORF	K	FINISH	QUANTITY
○	GL5615 QR SSU SPRINK	200	1/2"	5.6	BRASS	181
⊠	GL 5635 QR SSP DRY SPRINK	200	1"	5.6	WHITE	27
●	GL 5606 QR CONCEALED SSP SPRINK	155	1/2"	5.6	WHITE	12
◉	GL 5601 QR SSP SPRINK	155	1/2"	5.6	CHROME	76
TOTAL NUMBER OF SPRINKLERS:						296

HYDRAULIC CALCULATION

DESIGN INFORMATION

CALCULATION AREA#	1
SPRINKLER HEAD TYPE	SSU
K-FACTOR	5.6
SYSTEM TYPE (WET/DRY)	WET
HAZARD CLASSIFICATION	LIGHT
DENSITY (GPM/S.F.)	.10
AREA PER HEAD	130 MAX
AREA OF OPERATION (S.F.)	1571 (LARGEST OPEN AREA)

AREA OF OPERATION ADJUSTMENTS:

DRY PIPE INCREASE (30%)	N/A
SLOPE > 2:12 INCREASE (30%)	N/A
CEILING HEIGHT	N/A
PERCENT REDUCTION	N/A
CEILING REDUCTION (S.F.)	N/A
ADJUSTED AREA OF OPERATION	1571

WATER SUPPLY

STATIC (PSI)	52
RESIDUAL (PSI)	50
FLOW (GPM)	4000
FIRE PUMP (GPM @ PSI)	


SYSTEM DEMAND @ SOURCE

PRESSURE REQUIRED (PSI)	45.84
FLOW REQUIRED (GPM)	581.68
PRESSURE AVAILABLE (PSI)	51.94
SAFETY MARGIN (%)	11.74%
HOSE STREAM ALLOWANCE (GPM)	
INSIDE 100 OUTSIDE N/A	

SYSTEM DEMAND AT BASE OF RISER

PRESSURE REQUIRED (PSI)	39.79
FLOW REQUIRED (GPM)	581.68

KEY PLAN

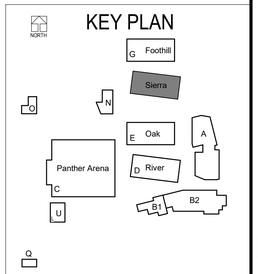

DLR Group
Architecture Engineering Planning Interiors

© 2019, DLR Group Inc. of California, a California corporation. ALL RIGHTS RESERVED

REGISTERED PROFESSIONAL ENGINEER
SEAN FOURY
M 32311
REN. 6-30-21
MECHANICAL
STATE OF CALIFORNIA

CONSULTING ENGINEERS
1209 Pleasant Grove Blvd.
Roseville, CA 95678
p 916-771-0778
www.lpengineers.com
Job #: 19-2184

FIRE SPRINKLER - BLDG S - 3RD FLOOR
WEST PARK HIGH SCHOOL, PHASE 2 (INC. 1)

2401 High School Road, Roseville, California 95747

Roseville Joint Union High School District

ADDENDUM 3
07.10.2020
Revisions
07-10-20 ADDENDUM 3

PROJECT #75-19101-00
DSA APPL. #02-118062
DSA FILE #31-H3

FP1.S3.1