FLOORING

Base 6" Vinyl


No base door/window keramic

Base on toe kick front only cabinets

Caulk sides of cabinets to finished floor

Flotex

Marmoleum

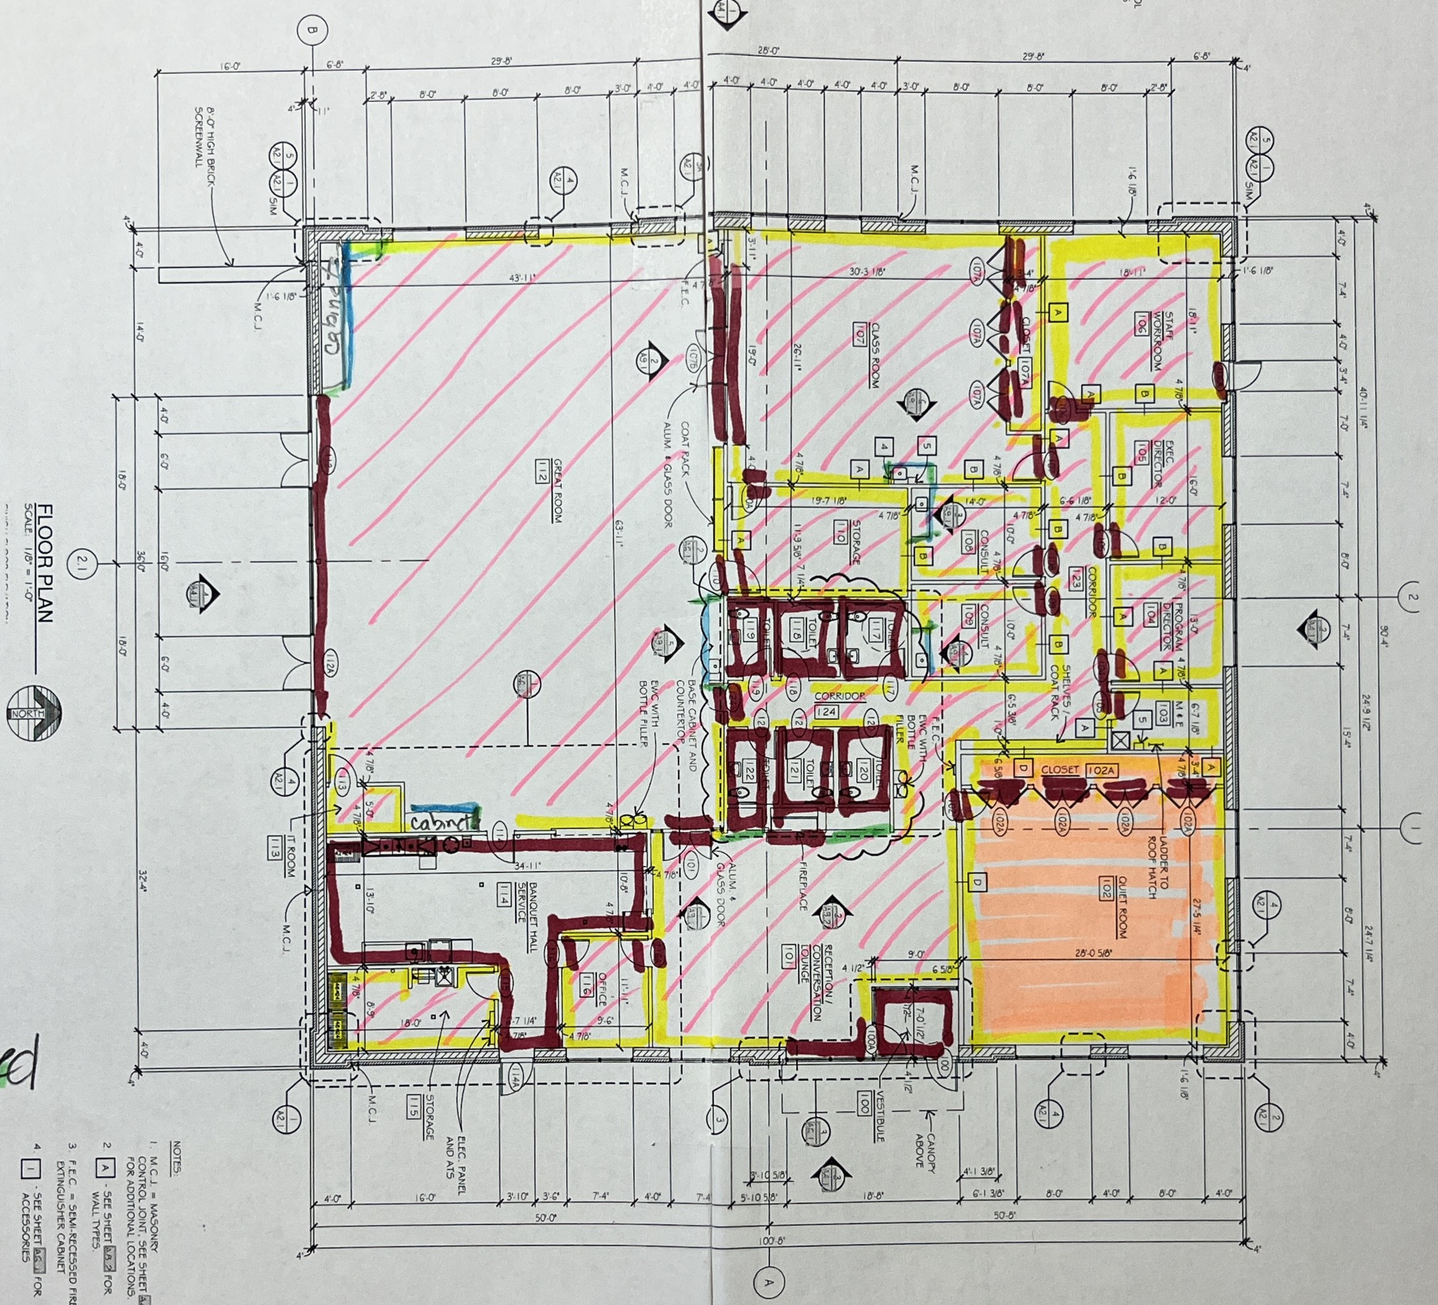

Job Number 5286

SHEET TITLE
FLOOR PLAN AND DETAILS

Date Issued
Bids & Permit APRIL 29, 2024
Bulletin No. 1 MAY 28, 2024
Bulletin No. 2 JUNE 28, 2024
Bulletin No. 3, JULY 18, 2024

PROJECT
DEXTER SENIOR CENTER
Dexter, MI

STATE OF MICHIGAN — LICENSED ARCHITECT — No. 1301027104 — WILLIAM J. ELIAS — ARCHITECT

Wah Yee Associates
Architects & Planners
42400 GRAND RIVER AVENUE, SUITE 200
NOVI, MICHIGAN 48375
PHONE 248.489.9160

...le drawings - Use figured dimensions CAD DWG 5286_A2.1.DWG