ARCHITECT'S ADDENDUM No. 003

Project: PFISD Campus Modernization – Phase 3
RA# 2407.1
Owner: Michael Porter
2021Crystal Bend Dr
Pflugerville, TX 78660
Architect: Reliance Architecture, LLC
12 Chisholm Trail, Suite 200
Round Rock, TX 78681



January 31, 2025

Date of Issuance: January 31, 2025

Addendum to the Drawings and Project Manual dated January 17, 2025.

The Contract Documents previously issued for bidding, as referenced above, shall be amended, revised, supplemented, clarified and/or extended by the following information, and this information shall be considered to be a part of the Drawings and Project Manual, as thought it had been issued at the same time and incorporated integrally with such Drawings and Project Manual. Where provisions of the following information differ from those of the original Contract Documents, this addendum shall govern and take precedence.

The drawings for the work within this Project shall be designated with letters as follows:
A – Architectural; C – Civil; QF – Food Service; TE – Theatrical; S – Structural; T – Technology; M – Mechanical; P – Plumbing; E - Electrical

Example: AR-1, Architectural Revision Sheet Number 1
This shall be used whenever referring to the work for this project.

I. GENERAL:

1. Existing metal frames are to be receive the following paint following owner's request:
    a. Sherwin Williams, Emerald Urethane paint, Semi-Gloss. Color to match wall base per the document

2. Existing wood tops of pony walls at ramps (in Dessau MS) are to be sanded and re-stained.
    a. Existing wood tops of pony walls at the cafeteria are to be sanded and refinished.

3. Existing chair rails in classrooms and administration (approx. 2" x 6") at Pflugerville MS & Dessau MS are to be refinished.

4. Install tornado shelter stickers as instructed by owner

5. Slope tops by superior. Field verify. Shown In interior elevations

6. Bid alternate calls for replacing of tectum wall panels in Dessau gym / theatre arts. However, base bid will be to repaint them.

7. Existing lockers (at Dessau MS) are to have plastic tops removed and replaced with sloped metal tops by manufacturer Superior™. Reference elevations and keynotes on renovation floor plans.

8. Tornado shelter stickers will be provided by owner and are to be installed.

9. Basis of design for rubber floor is Regupol™ Aktivplus High-Performance Rubber Flooring.

II. BIDDING QUESTIONS:

Rowe Lane ES

1. Sheet A2.00 Keynote 19 is shown at Music Steps RLE 27 but there is no corresponding information to D19. Please provide information.
    A. ADDRESSED IN ADDENDUM 003. D19 STATES TO PREP EXISTING HANDRAILS FOR NEW PAINT.

2. A2.01 Keynote R5 calls for new flooring in rooms 2,3,4,5,6,9,13 & 14. Per finish schedule on A7.00 these rooms existing flooring to remain. Confirm intent
    A. ADDRESSED IN ADDENDUM 003. ROOMS 2,3,4,5,6,8,9,13, AND 14 ARE TO RECEIVE NEW PAINT AND WALL BASE ONLY.
3. A2.01 Keynote R3 in Counselor RLE3. Per finish schedule this room is not in scope. Confirm intent
    A. THERE IS NOT COUNSELOR RLE3. THE COUNSELOR RLE - 10 IS NOT IN SCOPE.

4. A4.00 details 2 & 4 call for new markerboards. Tag on plan calls for tackboard. Confirm markerboard or tackboard
    A. ADDRESSED IN ADDENDUM 003. ALL BOARDS IN CORRIDORS ARE TO BE TACKBOARD.

5. A4.01 details 1,2,6 call for new markerboards. Tag on plan calls for tackboard. Confirm markerboard or tackboard.
    A. ADDRESSED IN ADDENDUM 003. ALL BOARDS IN CORRIDORS ARE TO BE TACKBOARD.

6. A8.00 legend shows vestibule to have CPT. Finish schedule calls for WCPT at vestibule. Confirm CPT or WCPT.
    A. ADDRESSED IN ADDENDUM 003. VESTIBULE TO HAVE WCPT (WALK OFF CARPET)

7. Provide details for all coat hooks required per classroom. Will these be mounted individually or on plam/painted wood/stained wood? Provide mounting heights and locations.
    A. ADDRESSED IN ADDENDUM 003. COATHOOKS (ONLY AT RLE) ARE TO BE HANGSAFE RACKS. THESE ARE TO COME IN 5'-4" INCREMENTS THAT ARE TO BE MOUNTED ONCE TILE IS COMPLETE. LOCATION AND MOUNTING HEIGHTS ARE SHOWN IN UPDATED ELEVATIONS.

8. A4.05 details 17-20, no information provided. Provide intent of these details.
    A. ADDRESSED IN ADDENDUM 003. THE SAME PATTERN IN OTHER STAFF RR'S WAS CARRIED THROUGH HERE.

9. A4.05 detail 2 calls for new partition. Provide details
    A. ADDRESSED IN ADDENDUM 003. NO NEW PARTITION. VIEW WAS UPDATED.

10. A4.01 markerboards – the largest size markerboard available is 4'x16'. Provide sizes requested to produce all oversized markerboards.
    A. MARKERBOARD ARE NOT INTENDED. TACKBOARDS ARE THE CORRECT MATERIAL. SPEC'D TACKBOARDS COME IN 92' LENGTHS.

11. A4.01 & A4.02 – provide accent tile layout behind all shown markerboards.
    A. NO MARKERBOARD. TACKBOARDS ARE TO BE INSET WITHIN THE TILE AND THEREFORE THERE IS NO NEED FOR TILE PATTERN BEHIND.

12. A8.00 Rooms 113-122 show to be LVT 1. Finish schedule calls for these rooms to be LVT2. Confirm which is correct.
    A. ADDRESSED IN ADDENDUM 003. ROOMS 113-119 AND 121-122 ARE TO BE LVT1. ROOM 120 IS NOT IN SCOPE.

13. A2.03 detail 7, provide detail for new handrail at serving line
    A. ADDRESSED IN ADDENDUM 003. REFER TO SHEET A7.08.

14. A7.00 Cafeteria finish schedule shows T1,2,3&4 at all walls. Provide layout for all cafeteria walls.
    B. ADDRESSED IN ADDENDUM 003. REFER TO SHEET A4.02

Dessau MS

1. A2.04 keynote D24 is shown on plan but there is no corresponding D24 note in the legend. Provide D24 keynote
    A. ADDRESSED IN ADDENDUM 003. D24 STATES TO DEMO ALL EX-SIGNAGE, SOAP DISPENSERS, TACKBOARDS, DOOR STOPS, AND ANY OTHER MISCELLANEOUS FIXTURES.

2. A7.01 "RUBBER" flooring material called out for several rooms. No details or specs provided for "RUBBER". Please provide information.
    A. ADDRESSED IN ADDEUNDOM 003. BASIS OF DESIGN FOR RUBBER FLOORING IS REGUPOL AKTIVPLUS HIGH-PERFORMANCE RUBBER FLOORING.

3. A2.09 Keynote R23 is shown on plan but there is no corresponding R23 note in the legend. Provide R23 keynote
    A. ADDRESSED IN ADDENDUM 003. R23 STATES NEW URINALS, WATER CLOSETS, AND LAVATORIES.

4. A4.13 & A4.14 – no information provided on these sheets. Please confirm intent
    A. ADDRESSED IN ADDENDUM 003.

5. A7.01 Cafeteria finish schedule shows T1,2,3 & 4 at N, S & W walls. Provide layout for all cafeteria walls.
    A. ADDRESSED IN ADDENDUM 003. REFER TO SHEET A4.02

III. ARCHITECTURAL DRAWINGS:

Item 1. A0.00

A. Index has been updated to include new sheet A7.08.

Item 2. Sheet A2.00

A. Added demo note to admin areas.
B. Cleaned up notes that were blocking information.
C. Added demo notes to gym.
D. Demo handrails at stage.
E. Add demo notes to stage.
F. Updated demo key notes.

Item 3. Sheet A2.01

A. Individual user restroom at Spring Hill classroom 109 has been added to project scope. Related plan has been added to sheet. Notes to describe scope have been added.
B. Notes in floor plan have been rearranged for clarity.
C. Interior elevation markers have been updated to correct the references for demolition vs renovation elevations.
D. Notes have been added to address furniture moving, finish floor installation, material testing and plumbing scope.
E. Keynotes have been added to paint classroom presentation wall as an accent wall.
F. Note has been added for clarification on painting of furrdowns.
G. Dimensions have been added to enlarged plans. Rough-in for plumbing shall be in same location as existing expect for water closets in single user restrooms that will need to shift a couple of inches to be handicap compliant.
H. Some room names have been updated to their correct designations.

I. Office and storage spaces have been added to the gymnasium plan.

Item 4. A2.04

A. Added demo keynote D26 to keynotes list.
B. Added demo keynotes D26 to demo plan.
C. Added demo keynote D27 to keynotes list.
D. Updated demo keynote D7

Item 5. A2.05

A. Added demo keynote D26 to keynotes list.
B. Added demo keynotes D26 to demo plan.

Item 6. A2.06

A. Added reno keynote R24, R25, R26
B. Updated reno floor plan

Item 7. A2.07

A. Added reno keynote R24. R25, R26
B. Updated reno floor plan

Item 8. A3.00

A. Adjusted layer for notes to show on RCP demo plan.

Item 9. A3.01

A. Updated RCP to demo corridor ceiling tile.

Item 10. A3.02

A. Updated RCP to show new corridor ceiling tile.

Item 11. A3.03

A. Adjusted notes within a few views
B. Adjusted location of new lights in life skills RR.

Item 12. A3.05

A. Updated RCP to show new corridor ceiling tile.

Item 13. A3.06

A. Updated notes on reno views.

Item 14. A4.00

A. Cleaned up notation.
B. Changed markerboards to tack boards.
C. Changed fills to more accurately reflect paint color differentiation.
D. Updated view 4 to show ex structure and work to be done at secured corridor doors.

Item 15. A4.01

A. Marker boards in corridors corrected to tackboards. Location and size corrected.
B. Backpack hooks added. 24 hooks per classroom.
C. Additional dimensions as needed.
D. Signage location shown.
E. Added retexture and repaint to main corridor.

Item 16. A4.02

A. Marker board in corridors corrected to tackboards. Location and size corrected.
B. Backpack hooks added 24 hooks per classroom.
C. Additional dimensions as needed
D. Signage and door stop location shown.
E. Corrected retexture and repaint areas.
F. Adjusted notes to clean up.
G. Added reference note for material selections.

Item 17. A4.05

A. Updates staff RR elevations.
B. Added reference note for material selections.

Item 18. A4.08

A. Updated corridor elevations.

Item 19. A4.13

A. Updated locker RR elevations.
B. Updated locker shower elevations.
C. Updated coaches RR elevations.

Item 20. A4.14

A. Updated locker RR elevations.
B. Updated locker shower elevations.

Item 21. A7.00

A. Updated room numbers.
B. Updated material selections to reflect rubber material in gym.

Item 22. A7.03

A. Updated room numbers.

Item 23. A7.07

A. Signage note updated.

Item 24. A7.08

A. Sheet has been added to set.

Item 25. A8.00

A. Updated line weight.
B. Updates legend.
C. Updated custodial flooring.
D. Various cleanup of items that do not relate to finish floor plan.
E. Updated RR in room 108 to have tile flooring.
F. Vestibule changed from CPT to WCPT.

Item 26. A8.01

A. Updated Finish floor legend.
B. Added dimensions for floor pattern.
C. Corrected line weights.

Item 27. A8.02

A. Updated finish floor legend.
B. Added dimensions for floor patterns

C. Changed sealed concrete to epoxy in athletic locker rooms per owner's request
D. Added note for flooring graphics in cafeteria.

Item 28. A8.04

A. Updated finish floor legend.
B. Changed sealed concrete to epoxy in athletic locker rooms per owner's request

IV. ATTACHMENTS:

- A0.00
- A2.00
- A2.01
- A2.04
- A2.05
- A2.06
- A2.07
- A3.00
- A3.01
- A3.02
- A3.03
- A3.05
- A3.06
- A4.00
- A4.01
- A4.02
- A4.05
- A4.08
- A4.13
- A4.14
- A7.00
- A7.03
- A7.07
- A7.08
- A8.00
- A8.01
- A8.02
- A8.04

Pflugerville Independent School District
Multi-Campus Renovations- Phase 3 - Construction Documents

Reliance Architecture, LLC
12 Chisholm Trl
Round Rock , Texas 78681
Ph (512) 758-7660
www.reliancearchitecture.com

SYMBOL LEGEND:

- DETAIL NUMBER / SHEET NUMBER (4 / A7.06) — DETAIL TAG
- DETAIL NUMBER / SHEET NUMBER (4 / A4.01) — EXTERIOR ELEVATION TAG
- DETAIL NUMBER / SHEET NUMBER (6 / A5.01) — SECTION TAG
- DETAIL NUMBER / SHEET NUMBER — INTERIOR ELEVATION TAG
- 4.M — PARTITION TYPE TAG RE: PARTITION SCHEDULE,
- 132 — DOOR TAG RE: DOOR SCHEDULE
- C — COLUMN LINE
- D — WINDOW TYPE RE: WINDOW TYPE SCHEDULE
- SHEET NUMBER, MATCHLINE A2.03 / MATCHLINE A2.04 — MATCH LINE
- DETAIL NUMBER / SHEET NUMBER — ENLARGE PLAN / DETAIL TAG
- ROOM NAME / ROOM NUMBER (CLASSROOM 124) — ROOM TAG
- 15'-4" EAVE — ELEVATION INDICATOR
- TWS 8'-0"x8'-0" TYPE / SIZE — MARKERBOARD (MB), TACK BOARD (TB), TACK STRIP (TS), TACKABLE WALL SURFACE (TWS)


PROJECT LOCATIONS:

PROJECT LOCATION:

DESSAU MIDDLE SCHOOL -
12900 DESSAU RD, AUSTIN, TX, 78754

PFLUGERVILLE MIDDLE SCHOOL -
1600 SETTLERS VALLEY DR, PFLUGERVILLE, TX, 78660

ROWE LANE ELEMENTARY -
3112 SPEIDEL DR, PFLUGERVILLE, TX, 78660

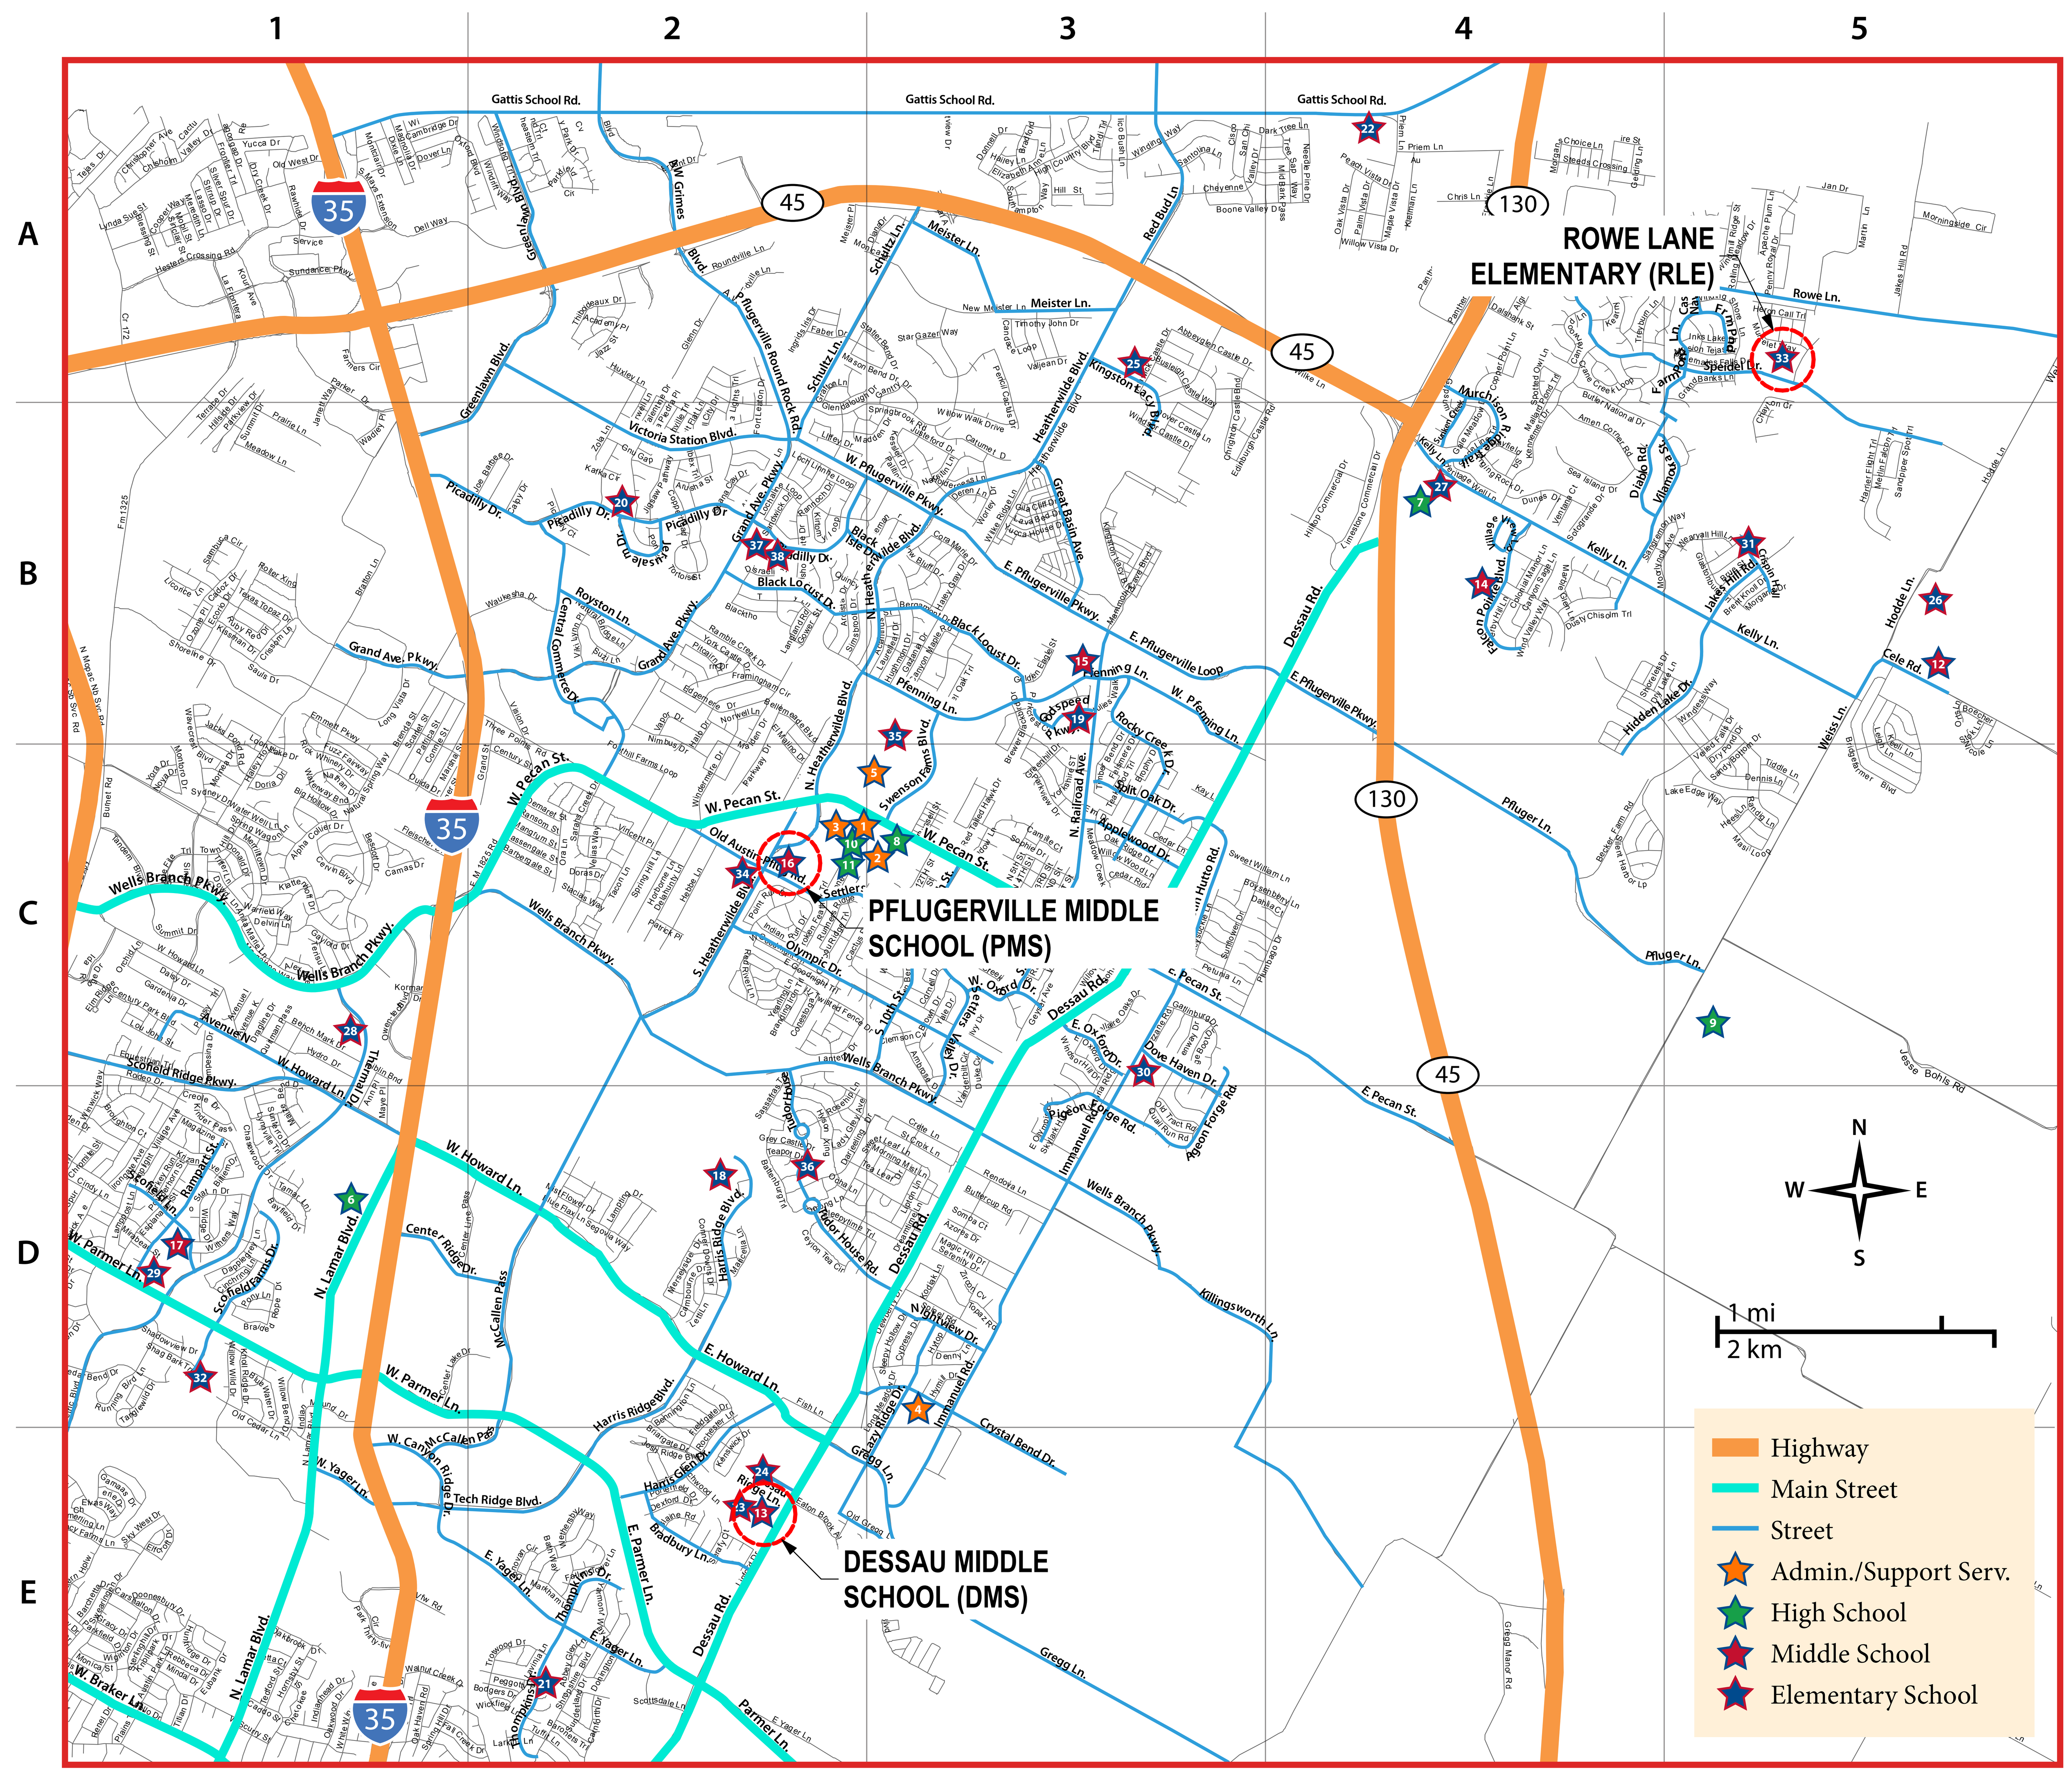

SHEET INDEX:

GENERAL:

A0.00	COVER SHEET
A0.01	ARCHITECTURAL GENERAL NOTES
A0.02	ELIMINATION OF ARCHITECTRUAL BARRIERS
A0.03	ROWE LANE PHASING PLAN
A0.04	DESSAU PHASING PLAN
A0.05	PFLUGERVILLE PHASING PLAN

ARCHITECTURAL:

A2.00	ROWE LANE DEMO FLOOR PLAN
A2.01	ROWE LANE RENO FLOOR PLAN
A2.02	ROWE LANE DEMO RR ENLARGED FLOOR PLAN
A2.03	ROWE LANE RR ENLARGED FLOOR PLAN
A2.04	DESSAU DEMO FLOOR PLAN
A2.05	DESSAU DEMO FLOOR PLAN
A2.06	DESSAU RENO FLOOR PLAN
A2.07	DESSAU RENO FLOOR PLAN
A2.08	DESSAU DEMO RR ENLARGED FLOOR PLAN
A2.09	DESSAU RR ENLARGED FLOOR PLAN
A2.10	PFLUGERVILLE DEMO FLOOR PLAN
A2.11	PFLUGERVILLE DEMO FLOOR PLAN
A2.12	PFLUGERVILLE RENO FLOOR PLAN
A2.13	PFLUGERVILLE RENO FLOOR PLAN
A2.14	PFLUGERVILLE DEMO RR ENLARGED FLOOR PLAN
A2.15	PFLUGERVILLE RR ENLARGED FLOOR PLAN
A3.00	ROWE LANE ELEMENTARY REFLECTED CEILING PLAN
A3.01	DESSAU OVERALL REFLECTED CEILING PLAN DEMO
A3.02	DESSAU OVERALL REFLECTED CEILING PLAN RENO
A3.03	DESSAU REFLECTED CEILING PLAN
A3.04	PFLUGERVILLE OVERALL REFLECTED CEILING PLAN DEMO
A3.05	PFLUGERVILLE OVERALL REFLECTED CEILING PLAN RENO
A3.06	PFLUGERVILLE REFLECTED CEILING PLAN
A4.00	ROWE LANE ENTRY CORRIDOR ELEVATIONS
A4.01	ROWE LANE CORRIDOR RENO ELEVATIONS
A4.02	ROWE LANE CORRIDOR RENO ELEVATIONS
A4.03	ROWE LANE RR ELEVATIONS
A4.04	ROWE LANE RR ELEVATIONS
A4.05	ROWE LANE RR ELEVATIONS
A4.06	DESSAU CORRIDOR RENO ELEVATIONS
A4.07	DESSAU CORRIDOR RENO ELEVATIONS
A4.08	DESSAU CORRIDOR RENO ELEVATIONS
A4.09	DESSAU CORRIDOR RENO ELEVATIONS
A4.10	DESSAU RR ELEVATIONS
A4.11	DESSAU RR ELEVATIONS
A4.12	DESSAU RR ELEVATIONS
A4.13	DESSAU RR ELEVATIONS
A4.14	DESSAU RR ELEVATIONS
A4.15	PFLUGERVILLE CORRIDOR RENO ELEVATIONS
A4.16	PFLUGERVILLE CORRIDOR RENO ELEVATIONS
A4.17	PFLUGERVILLE CORRIDOR RENO ELEVATIONS
A4.18	PFLUGERVILLE RR ELEVATIONS
A4.19	PFLUGERVILLE RR ELEVATIONS
A6.00	INTERIOR ELEVATIONS
A7.00	ROWE LANE SCHEDULES
A7.01	DESSAU SCHEDULES
A7.02	PFLUGERVILLE SCHEDULES
A7.03	ROWE LANE SIGNAGE SCHEDULE
A7.04	DESSAU SIGNAGE SCHEDULE
A7.05	PFLUGERVILLE SIGNAGE SCHEDULE
A7.06	PRODUCT DATA
A7.07	INTERIOR DETAILS
A7.08	HANDRAILS & GUARDRAILS DETAILS
A8.00	FLOOR FINISH PLAN ROWE LANE
A8.01	FLOOR FINISH PLAN DESSAU
A8.02	FLOOR FINISH PLAN DESSAU
A8.03	FLOOR FINISH PLAN PFLUGERVILLE
A8.04	FLOOR FINISH PLAN PFLUGERVILLE

01

PROJECT NOTES:

GENERAL PROJECT NOTES:

1. CONTRACTOR SHALL PROVIDE ALL SAFETY PROTECTION ITEMS AS REQUIRED BY OSHA AND TEXAS STATUTES, AS PART OF THEIR BID.
2. ALL QUANTITIES ARE APPROXIMATE AND SHOULD BE FIELD VERIFIED PRIOR TO BIDDING
3. CAD BACKGROUNDS PROVIDED BY DISTRICT DO NOT MATCH FIELD CONDITIONS. REFER TO ELEVATIONS FOR MEASURMENTS AND FIELD VERIFY ALL MEASURMENTS.
4. REFER TO SHEET A0.01 FOR ARCHITECTURAL GENERAL NOTES, MOUNTING HEIGHTS & LINTEL SCHEDULE
5. THE MOVING OF FURNITURE SHALL BE THE CONTRACTORS RESPONSIBILITY TO COMPLETE THEIR WORK. NO FLOORING REPLACEMENT WORK IS HAPPENING TO THE GYM FLOORING AND STAGING OF FURNITURE COULD OCCUR IN THIS SPACE AND CAFETERIA. CONTRACTOR TO PROVIDE LOGISTICS OF MOVING AND STAGING FURNITURE IN THEIR BID.
6. REFER TO SHEETS A0.03 - A0.5 FOR PROJECT PHASING INFORMATION.

BID ALTERNATES

1. BID ALTERNATE 001: REPLACE TECTUM IN DESSAU MIDDLE SCHOOL GYM/THEATRE ARTS ROOM WITH ACOUSTIC FELT PANELS.
2. BID ALTERNATE 002: ADDITION OF ACOUSTIC FELT PANELS IN PFLUGERVILLE MIDDLE SCHOOL GYM.

SCHEDULE:

Event	Date
RFP Available	January 17, 2025
Pre-proposal Conference	January 24, 2025
Vendor Questions Due	January 29, 2025
Answers Posted by	January 31, 2025
Proposals Due	February 4, 2025
Proposal Award (Anticipated)	February 20, 2025
Awards Posted (Anticipated)	February 21, 2025
Contract Begins (Anticipated)	March 3, 2025
Substantial Completion	August 4, 2025
Final Completion	August 8, 2025

OWNER
Pflugerville Independent School District
2021 Crystal Bend Drive
Pflugerville, Texas 78660
adam.dutter@pfisd.net
michael.porter@pfisd.net
susan.stock@pfisd.net

ARCHITECT
Reliance Architecture, LLC
12 Chisholm Trl Suite 200
Round Rock , Texas 78681
antonio@reliancearchitecture.com
taylor@reliancearchitecture.com

Pflugerville Independent School District
Multi-Campus Renovations- Phase 3
Pflugerville, Texas

Copyright © 2025, Reliance Architecture, LLC. All rights reserved.

Revision:
01 ADDENDUM 003 - 1.31.2025

Set Number


Project Number
2407.1

Date:
1/31/2025

Sheet Number

COVER SHEET A0.00

UPON SALVAGING EWC, AND ALL PLUMBING FIXTURES, CONFIRM REINSTALLATION WITH OWNER.

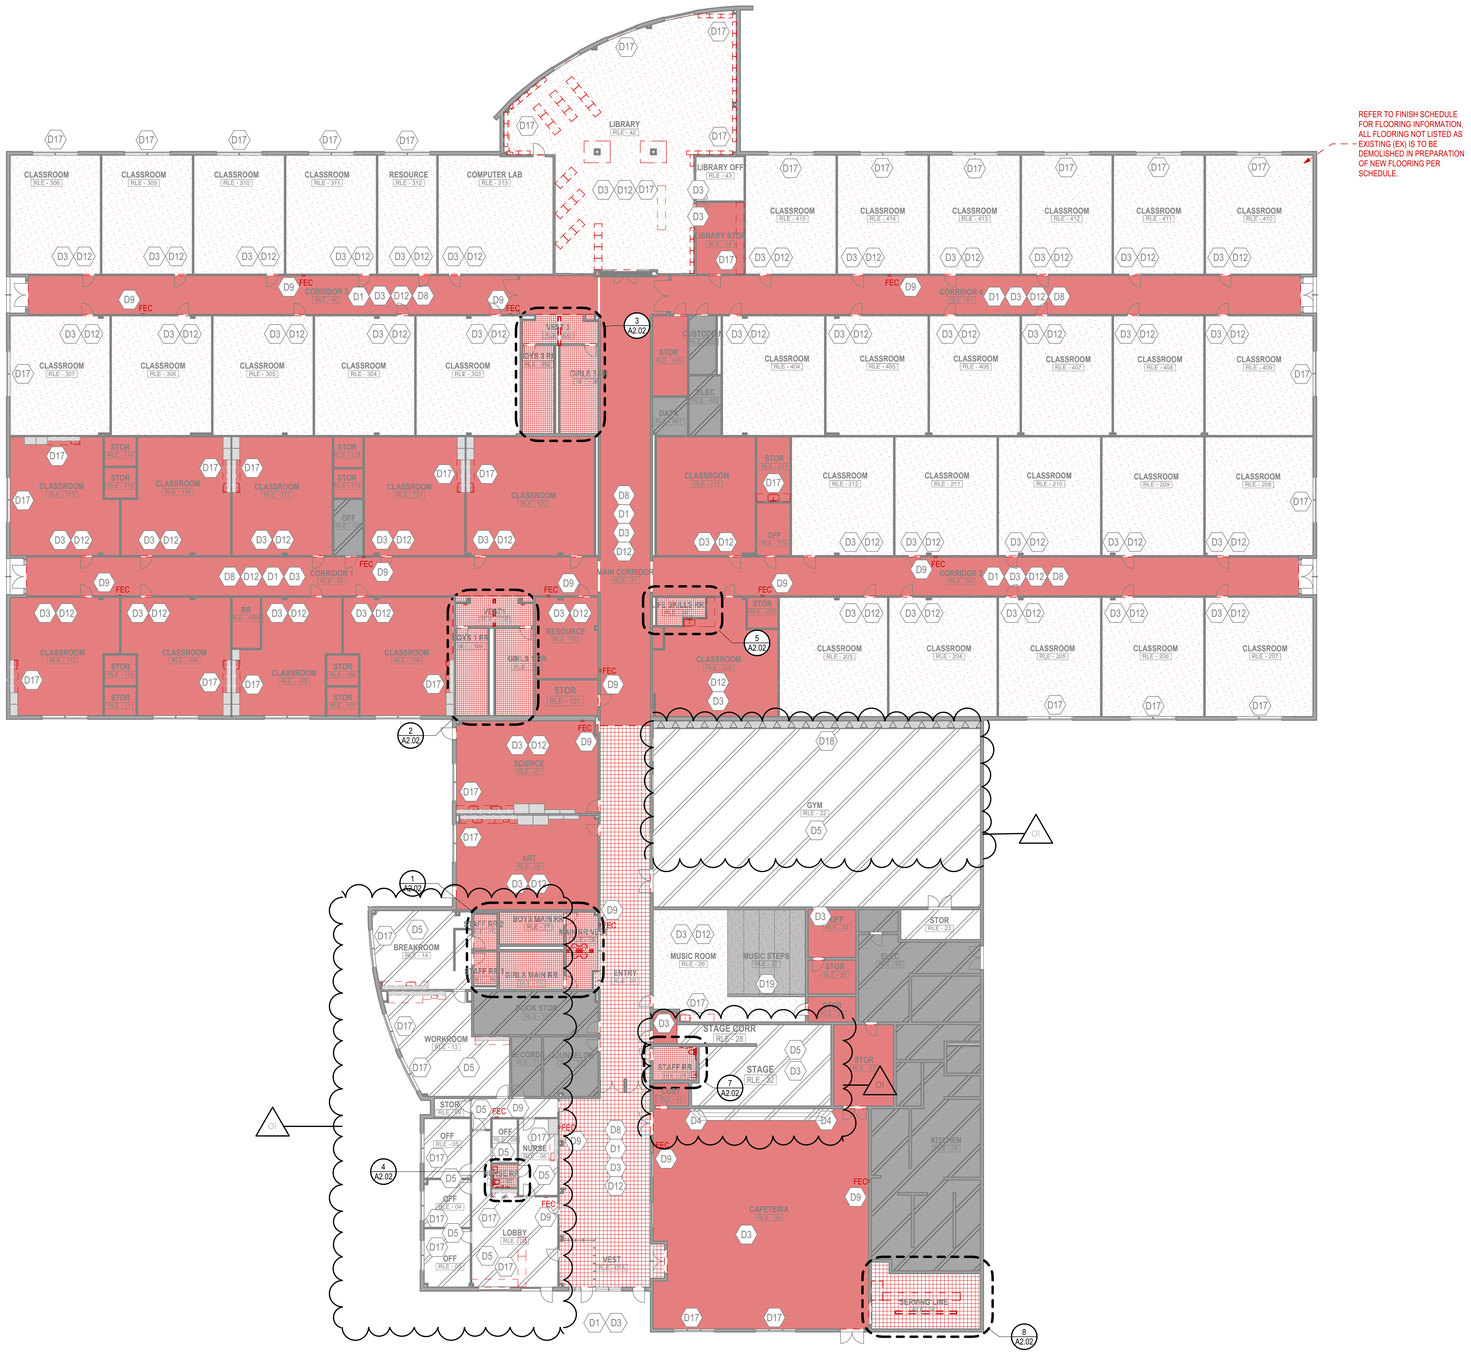

1 ROWE LANE ES DEMO

SCALE: 1/16" = 1'-0"

GENERAL NOTES

ALL QUANTITIES ARE APPROXIMATE AND SHOULD BE FIELD VERIFIED PRIOR TO BIDDING

CAD BACKGROUNDS PROVIDED BY DISTRICT DO NOT MATCH FIELD CONDITIONS. REFER TO ELEVATIONS FOR MEASURMENTS AND FIELD VERIFY ALL MEASURMENTS.

REFER TO SHEET A0.01 FOR ARCHITECTURAL GENERAL NOTES, MOUNTING HEIGHTS & LINTEL SCHEDULE

THE MOVING OF FURNITURE SHALL BE THE CONTRACTORS RESPONSIBILITY TO COMPLETE THEIR WORK. NO FLOORING REPLACEMENT WORK IS HAPPENING TO THE GYM FLOORING AND STAGING OF FURNITURE COULD OCCUR IN THIS SPACE AND CAFETERIA. CONTRACTOR TO PROVIDE LOGISTICS OF MOVING AND STAGING FURNITURE IN THEIR BID.

ABBREVIATIONS

RLE	ROWE LANE ELEMENTARY	DMS	DESSAU MIDDLE SCHOOL
KLMS	KELLY LANE MIDDLE SCHOOL	PMS	PFLUGERVILLE MIDDLE SCHOOL
WKRM.	WORK ROOM	TP	TOILET PAPER DISPENSER
OFF	OFFICE	GB	GRAB BARS, RE: 16/A7.07
LIB.	LIBRARY	HD	HAND DRYERS
CORR	CORRIDOR	PT	PAPER TOWEL DISPENSER
MCT	MARMOLEUM COMPOSITE TILE	SD	SOAP DISPENSER
CPT	CARPET TILE	EWC	ELECTRIC WATER COOLER
T(X)	TILE	FEC	FIRE EXTINGUISHER CABINET
LVT	LUXURY VINYL TILE	SN	SANITARY NAPKIN DISPOSAL
CT	CERAMIC TILE	TB	TACKBOARD
VCT	VINYL COMPOSITE TILE		

DEMO KEYED NOTES - RLE

GENERAL:

D1 DEMO ALL EXISITING WALL PANELS AND TACK BOARDS IN CORRIDOR. PATCH AND RETEXTURE DRYWALL TO MATCH EXISTING FINISH ABOVE 6'. PREP AREA ABOVE 6' TO RECIEVE NEW PAINT. PREP AREA BELOW 6' TO RECIEVE WALL TILE.

D2 DEMO EXISTING SINKS, SOAP DISPENSERS, PAPER TOWEL DISPENSERS, HAND DRYERS, AND MIRRORS. PREPARE FOR NEW CONSTRUCTION

D3 PREP AREA TO RECIEVE NEW PAINT.

D4 DEMO HANDRAILS. PREPARE FOR NEW CONSTRUCTION

D5 REMOVE EXISTING WALL BASE AND PREP FOR NEW CONSTRUCTION.

D6 DEMO EXISTING EWC. PREPARE FOR NEW CONSTRUCTION.

D7 DEMO EXISITNG WALL TILE. PREPARE FOR NEW CONSTRUCTION.

D8 DEMO EXISTING SIGNAGE.

D9 DEMO EXISTING FEC. PREPARE FOR NEW CONSTRUCTION.

D10 DEMO LIGHTING, CEILING GRID, AND CEILING TILES. SALVAGE ALL OTHER CEILING ELEMENTS FOR REINSTALLATION. PREPARE FOR NEW CONSTRUCTION.

D12 DEMO EXISTING FLOOR MATERIAL AND WALL BASE. PREPARE FOR NEW CONSTRUCTION

D13 DEMO EXISTING TOILET FIXTURES, URINALS, TOLIET PARTITIONS, URINAL SCREENS, GRAB BARS, SANITARY NAPKIN DISPENSERS, AND TOLIET PAPER TOWEL DISPENSERS. PREPARE FOR NEW CONSTRUCTION.

D14 DEMO EXISTING WALL AND FLOOR TILE.

D15 DEMO EXISTING LIGHTING. PREPARE FOR NEW CONSTRUCTION.

D16 DEMO EXISTING PONY WALL. REROUTE PLUMBING AND PREPARE FOR NEW CONSTRUCTION.

D17 ALL EX RED LAMINATE INCLUDING COUNTERTOPS, WINDOW SILLS, AND EX BOOKSTACKS ARE TO BE RESURFACED WITH WILSONART RE-COVER. FINISH TO BE SELECTED BY STANDARD LIST OF COLORS AFTER BIDDING.

D18 DEMO CARPET FINISH ON CONCRETE BENCH. PREPARE FOR NEW CONSTRUCTION

D19 PREP EX METAL HANDRAILS FOR NEW PAINT. COLOR TO BE SELECTED AFTER THE BIDDING PROCESS.

DEMO LEGEND - RLE

- DEMO VCT
- DEMO CARPET
- DEMO CT
- NOT IN SCOPE
- PARTIAL DEMO

Reliance Architecture, LLC
12 Chisholm Trl
Round Rock , Texas 78681
Ph (512) 758-7660
www.reliancearchitecture.com

REGISTERED ARCHITECT STATE OF TEXAS

Pflugerville Independent School District

Multi-Campus Renovations- Phase 3

Pflugerville, Texas

Copyright © 2025, Reliance Architecture, LLC. All rights reserved.

Revision:


A1 ADDENDUM 003 - 1.31.2025

Project Number
2407.1

Date:
1/31/2025

Sheet Number

ROWE LANE DEMO FLOOR PLAN A2.00

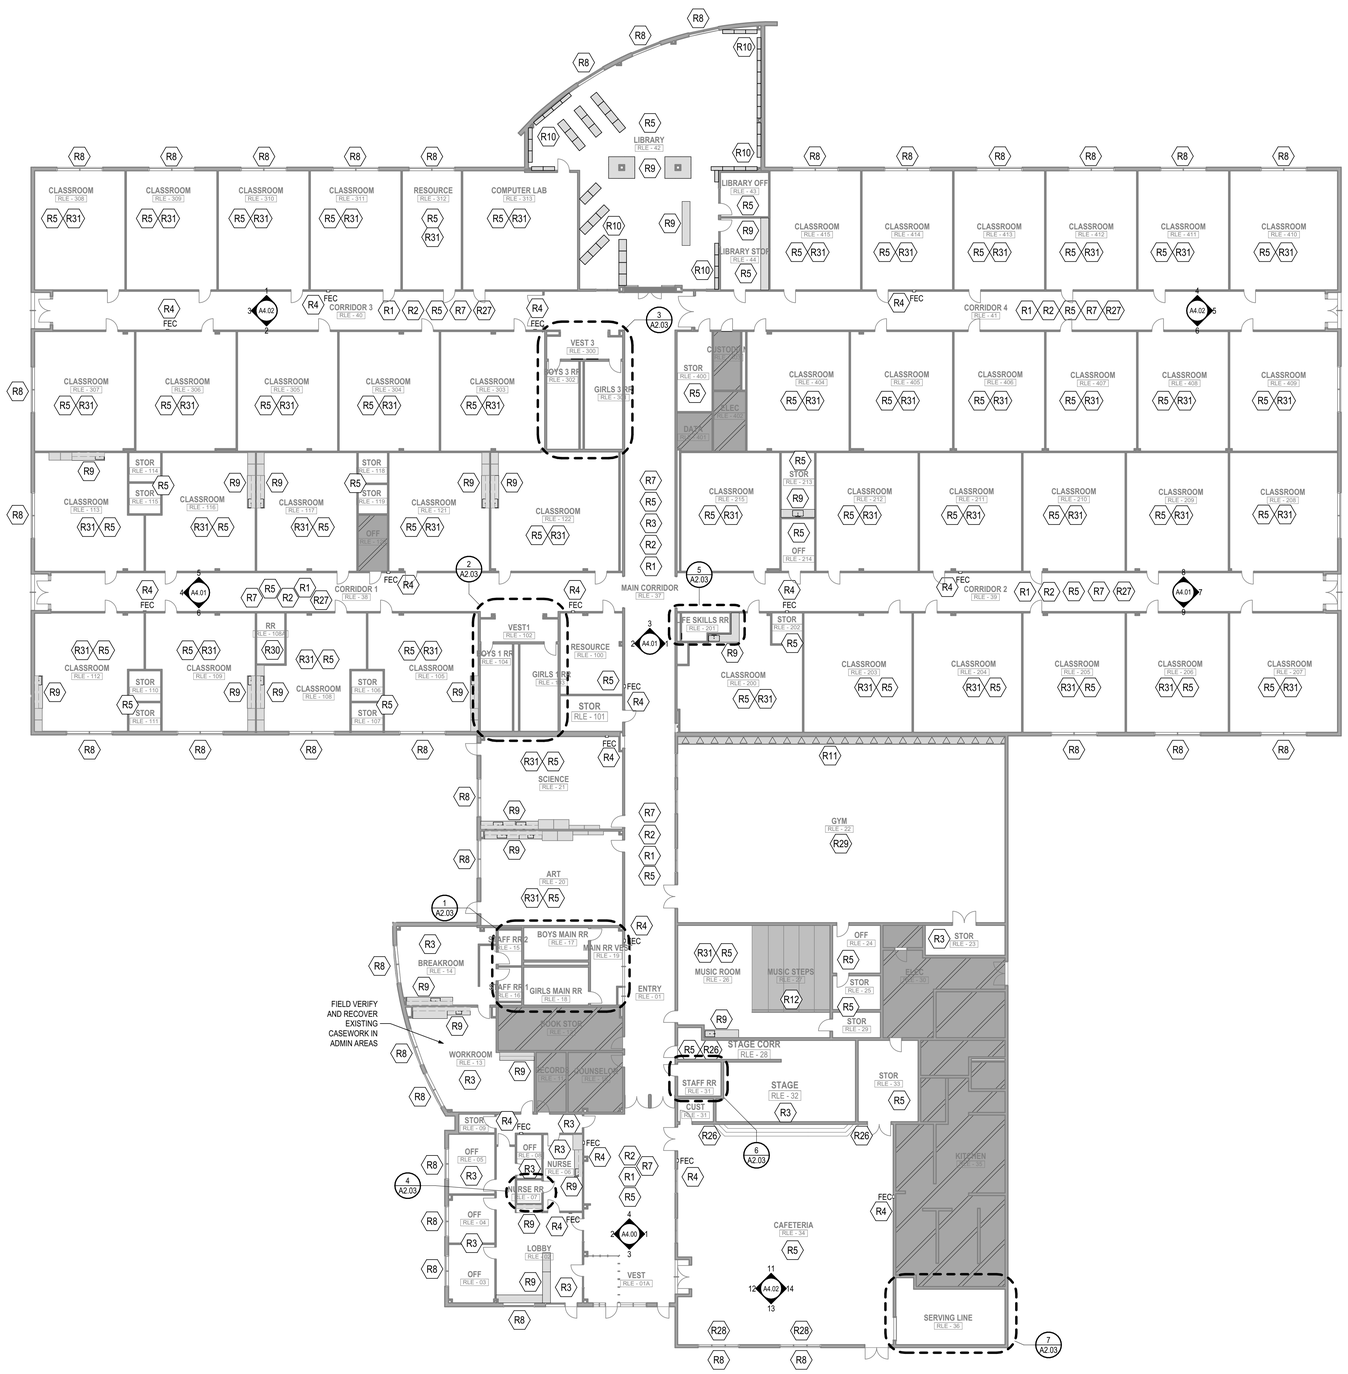

1 ROWE LANE ES RENO

SCALE: 1/16" = 1'-0"

GENERAL NOTES

ALL QUANTITIES ARE APPROXIMATE AND SHOULD BE FIELD VERIFIED PRIOR TO BIDDING

CAD BACKGROUNDS PROVIDED BY DISTRICT DO NOT MATCH FIELD CONDITIONS. REFER TO ELEVATIONS FOR MEASURMENTS AND FIELD VERIFY ALL MEASURMENTS.

REFER TO SHEET A0.01 FOR ARCHITECTURAL GENERAL NOTES, MOUNTING HEIGHTS & LINTEL SCHEDULE

THE MOVING OF FURNITURE SHALL BE THE CONTRACTORS RESPONSIBILITY TO COMPLETE THEIR WORK. NO FLOORING REPLACEMENT WORK IS HAPPENING TO THE GYM FLOORING AND STAGING OF FURNITURE COULD OCCUR IN THIS SPACE AND CAFETERIA. CONTRACTOR TO PROVIDE LOGISTICS OF MOVING AND STAGING FURNITURE IN THEIR BID.

ABBREVIATIONS

RLE	ROWE LANE ELEMENTARY	DMS	DESSAU MIDDLE SCHOOL
KLMS	KELLY LANE MIDDLE SCHOOL	PMS	PFLUGERVILLE MIDDLE SCHOOL
WKRM.	WORK ROOM	TP	TOILET PAPER DISPENSER
OFF	OFFICE	GB	GRAB BARS, RE: 16/A7.07
LIB.	LIBRARY	HD	HAND DRYERS
CORR	CORRIDOR	PT	PAPER TOWEL DISPENSER
MCT	MARMOLEUM COMPOSITE TILE	SD	SOAP DISPENSER
CPT	CARPET TILE	EWC	ELECTRIC WATER COOLER
T(X)	TILE	FEC	FIRE EXTINGUISHER CABINET
LVT	LUXURY VINYL TILE	SN	SANITARY NAPKIN DISPOSAL
CT	CERAMIC TILE	TB	TACKBOARD
VCT	VINYL COMPOSITE TILE		

RENO KEYED NOTES - RLE

GENERAL:

- R1 WALL TILE IS TO BE INSTALLED 7' HIGH ALONG ALL CORRIDORS. TOP TILE WITH SCHLUTER TRIM AND USE SCLUTER TRIM AT ALL CORNER INTERSECTIONS OF TILE. REFER TO ELEVATIONS FOR TILE DETAIL. RE: 18/A7.07
- R2 NEW SIGNAGE, SOAP DISPENSERS, TACKBOARDS, DOOR STOPS.
- R3 NEW PAINT AND WALL BASE
- R4 NEW STAINLESS STEEL FIRE EXTINGUISHER
- R5 NEW FLOORING, WALL BASE, AND PAINT. REF FINISH SCHEDULE.
- R6 NEW EWC AND WALL TILE BEHIND. REFER TO ELEVATIONS FOR TILE DETAIL.
- R7 REPAINT ALL DOOR FRAMES, DOOR LITES, AND WINDOW FRAMES. REPLACE TORNADO SHELTER STICKERS AS NECESSARY.
- R8 NEW WINDOW SILL PLAM. FIELD VERIFY QUANTITES PRIOR TO ORDERING MATERIAL. BASIS OF DESIGN: RE-COVER BY WILSONART. COLOR TO BE APPROVED BY OWNER AND ARCHITECT FOLLOWING THE BIDDING PROCESS.
- R9 NEW PLAM COUNTERTOP. FIELD VERIFY QUANTITES PRIOR TO ORDERING MATERIAL. BASIS OF DESIGN: RE-COVER BY WILSONART. COLOR TO BE APPROVED BY OWNER AND ARCHITECT FOLLOWING THE BIDDING PROCESS.
- R10 NEW PLAM TOPS FOR EX BOOKSTACKS. FIELD VERIFY QUANTITES PRIOR TO ORDERING MATERIAL. BASIS OF DESIGN: RE-COVER BY WILSONART, COLOR TO BE APPROVED BY OWNER AND ARCHITECT FOLLOWING THE BIDDING PROCESS.
- R11 NEW RUBBER MATERIAL TO COVER CONCRETE BENCH. REF FINISH SCHEDULE.
- R12 PREPARE METAL HANDRAILS SMOOTH TO MAKE READY FOR PAINT. PAINT HANDRAILS.
- R13 NEW FLOOR AND WALL TILE. REF ELEVATIONS AND FINISH FLOOR PLAN FOR DETAILS.
- R14 SOLID PLASTIC URINAL SCREENS
- R15 CONTRACTOR TO REINSTALL SERVING LINE EQUIPMENT AFTER RENOVATION.
- R16 NEW SOAP DISPENERS, O.P.C.I.
- R17 NEW HAND DRYERS, C.P.C.I.
- R18 GROUP LAVATORY, RE: ELEVATIONS AND 3/A7.06
- R19 SOLID PLASTIC OVERHEAD-BRACED TOILET PARTITIONS
- R20 DOUBLE COAT HOOK
- R21 FRAMED MIRROR, RE: ELEVATIONS
- R22 NEW URINAL
- R23 NEW WATER CLOSET
- R24 PAPER TOWEL, O.P.C.I.
- R25 SINGLE USER LAVATORY
- R26 NEW STAINLESS STEEL HANDRAIL
- R27 NEW BACKPACK HOOKS. PROVIDE 24 HOOKS PER CLASSROOM IN EACH CORRIDOR. REF ELEVATIONS FOR MOUNTING HEIGHT AND LOCATION. BASIS OF DESIGN: HANGSAFE RACKS
- R28 NEW BLACKOUT BLINDS FOR UPPER WINDOWS
- R29 NEW BASE AS SCHED.
- R30 NEW FLOOR TILE AND TILE BASE
- R31 2 NEW 4'X4' TACKBOARDS, TRIMMED WITH MANUFACTURE RECOMENDED TRIM, TO BE INSTALLED ON EITHER SIDE OF TEACHING WALL MARKERBOARD. COORDINATE WITH OWNER ON LOCATION. PATCH AND PAINT AREA BELOW EX PROJECTOR TO COVER AREA FROM OWNER REMOVED DEVICE.

Reliance Architecture, LLC
12 Chisholm Trl
Round Rock , Texas 78681
Ph (512) 758-7660
www.reliancearchitecture.com

Pflugerville Independent School District

Multi-Campus Renovations- Phase 3

Pflugerville, Texas

Copyright © 2025, Reliance Architecture, LLC. All rights reserved.

Revision:

01 ADDENDUM 003 - 1.31.2025

Project Number 2407.1

Date: 1/31/2025

Sheet Number

ROWE LANE RENO FLOOR PLAN A2.01



1 DESSAU MS DEMO
SCALE: 1/16" = 1'-0"

UPON SALVAGING EWC, AND ALL PLUMBING FIXTURES, CONFIRM REINSTALLATION WITH OWNER.

GENERAL NOTES

ALL QUANTITIES ARE APPROXIMATE AND SHOULD BE FIELD VERIFIED PRIOR TO BIDDING

CAD BACKGROUNDS PROVIDED BY DISTRICT DO NOT MATCH FIELD CONDITIONS. REFER TO ELEVATIONS FOR MEASURMENTS AND FIELD VERIFY ALL MEASURMENTS.

REFER TO SHEET A0.01 FOR ARCHITECTURAL GENERAL NOTES, MOUNTING HEIGHTS & LINTEL SCHEDULE

THE MOVING OF FURNITURE SHALL BE THE CONTRACTORS RESPONSIBILITY TO COMPLETE THEIR WORK. NO FLOORING REPLACEMENT WORK IS HAPPENING TO THE GYM FLOORING AND STAGING OF FURNITURE COULD OCCUR IN THIS SPACE AND CAFETERIA. CONTRACTOR TO PROVIDE LOGISTICS OF MOVING AND STAGING FURNITURE IN THEIR BID.

ABBREVIATIONS

RLE	ROWE LANE ELEMENTARY	DMS	DESSAU MIDDLE SCHOOL
KLMS	KELLY LANE MIDDLE SCHOOL	PMS	PFLUGERVILLE MIDDLE SCHOOL
WKRM.	WORK ROOM	TP	TOILET PAPER DISPENSER
OFF	OFFICE	GB	GRAB BARS, RE: 16/A7.07
LIB.	LIBRARY	HD	HAND DRYERS
CORR	CORRIDOR	PT	PAPER TOWEL DISPENSER
MCT	MARMOLEUM COMPOSITE TILE	SD	SOAP DISPENSER
CPT	CARPET TILE	EWC	ELECTRIC WATER COOLER
T(X)	TILE	FEC	FIRE EXTINGUISHER CABINET
LVT	LUXURY VINYL TILE	SN	SANITARY NAPKIN DISPOSAL
CT	CERAMIC TILE	TB	TACKBOARD
VCT	VINYL COMPOSITE TILE		

DEMO KEYED NOTES - DMS

GENERAL:

D1 DEMO ALL EXISITING WALL PANELS IN CORRIDOR. PATCH AND RETEXTURE DRYWALL TO MATCH EXISTING FINISH ABOVE 6'-6". PREP AREA ABOVE 6'-6" TO RECIEVE NEW PAINT. PREP AREA BELOW 6'-6" TO RECIEVE WALL TILE.

D2 DEMO EXISTING SOAP DISPENSERS, PAPER TOWEL DISPENSERS, HAND DRYERS, MIRRORS, GRAB BARS, TOLIET PAPER TOWEL DISPENSERS, AND SANITARY NAPKIN DISPOSALS. PREPARE FOR NEW CONSTRUCTION

D3 PREP AREA TO RECIEVE NEW PAINT

D4 DEMO EXISTING FIRE EXTINGUISHER. PREPARE FOR NEW CONSTRUCTION.

D5 DEMO FLOORING AND WALL BASE. PREPARE FOR NEW CONSTRUCTION.

D6 DEMO EXISTING SIGNAGE.

D7 PREP ALL DOOR AND WINDOW FRAMES FOR REPAINT. NOTE DOORS LABELED AS TORNADO SHELTER AS STICKERS ARE TO BE PROVIDED BY OWNER AND REPLACED AFTER CONSTRUCTION.

D8 DEMO EXISTING WALL BASE (GYM). PREPARE FOR NEW CONSTRUCTION.

D9 PROTECT DURING DEMOLITION & REPAINT EXISTING LOCKERS.

D10 PLANTER WORK APART OF ALLOWANCE FOR PLANTER REFRESH

D11 DEMO EXISTING EWC AND ANY PANELING OR TILE BEHIND IT. PREPARE FOR NEW CONSTRUCTION.

D12 DEMO AND SALVAGE EXISTING WATER CLOSETS, URINALS, TOLIET PARTITIONS, URINAL SCREENS. PREPARE FOR REINSTALLATION.

D13 DEMO EXISTING FLOOR MATERIAL AND WALL TILE. PREPARE FOR NEW CONSTRUCTION.

D14 DEMO EXISTING BAND OF COLORED TILE ONLY. RR TO RECIEVE A DEEP CLEAN AND SEAL PRIOR TO FINISH OUT. PREPARE FOR NEW CONSTRUCTION.

D15 DEMO EXISTING CEILING IN ITS ENTIRETY. PREPARE FOR NEW CONSTRUCTION.

D16 DEMO EXISTING HANDRAILS & RUBBER STAIR MATERIAL. REPLACE IN ACCORDANCE WITH ADA COMPLIANCE.

D17 DEMO ENTIRE NORTH WALL OF TILE. PREPARE FOR NEW CONSTRUCTION.

D18 REMOVE AND SALVAGE ANY COLORED CEILING TILES. RETURN TO DISTRICT.

D19 DEMO EXISTING HAND DRYERS. PREPARE FOR NEW CONSTRUCTION.

D20 GRIND AND SMOOTH CONCRETE FLOOR. PREPARE FOR RESEALING.

D21 DEMO EXISTING TECTUM PANEL.

D22 DEMO CEILING ELEMENTS.

D23 DEMO SINGLE NORTH WALL TILE. ADD 5/8" GYP. PREPARE FOR NEW CONSTRUCTION.

D24 DEMO ALL EX SIGNAGE, SOAP DISPENSERS, TACKBOARDS, DOOR STOPS, AND ANY OTHER MISCELLANEOUS FIXTURES.

D25 DEMO URINALS, WATER CLOSETS, TOLIET PARTITIONS, URINAL SCREENS, AND WATER COOLERS. TO DATE PLUMBING AS NECESSARY. PREPARE FOR NEW CONSTRUCTION.

D26 SALVAGE WOOD TOPS OF BENCH. PREP FOR SMOOTH, SAND, RESTAIN AND REINSTALLATION.

D27 DEMO EXISTING CEILING TILE AND RETURN COLORED TILES TO DISTRICT. PREPARE FOR NEW CONSTRUCTION.

DEMO LEGEND - DMS

- DEMO VCT
- BARE CONCRETE, GRIND AND SEAL
- DEMO CARPET
- NOT IN SCOPE
- DEMO CT
- PARTIAL DEMO

Reliance Architecture, LLC
12 Chisholm Trl
Round Rock , Texas 78681
Ph (512) 758-7660
www.reliancearchitecture.com

Pflugerville Independent School District
Multi-Campus Renovations- Phase 3
Pflugerville, Texas

Copyright © 2025, Reliance Architecture, LLC. All rights reserved

Revision:
01 ADDENDUM 003 - 01.31.2025

Project Number
2407.1

Date:
1/31/2025

Sheet Number
DESSAU DEMO FLOOR PLAN A2.04



1 DESSAU MS DEMO
SCALE: 1/16" = 1'-0"

UPON SALVAGING EWC, AND ALL PLUMBING FIXTURES, CONFIRM REINSTALLATION WITH OWNER.

GENERAL NOTES

ALL QUANTITIES ARE APPROXIMATE AND SHOULD BE FIELD VERIFIED PRIOR TO BIDDING

CAD BACKGROUNDS PROVIDED BY DISTRICT DO NOT MATCH FIELD CONDITIONS. REFER TO ELEVATIONS FOR MEASURMENTS AND FIELD VERIFY ALL MEASURMENTS.

REFER TO SHEET A0.01 FOR ARCHITECTURAL GENERAL NOTES, MOUNTING HEIGHTS & LINTEL SCHEDULE

THE MOVING OF FURNITURE SHALL BE THE CONTRACTORS RESPONSIBILITY TO COMPLETE THEIR WORK. NO FLOORING REPLACEMENT WORK IS HAPPENING TO THE GYM FLOORING AND STAGING OF FURNITURE COULD OCCUR IN THIS SPACE AND CAFETERIA. CONTRACTOR TO PROVIDE LOGISTICS OF MOVING AND STAGING FURNITURE IN THEIR BID.

ABBREVIATIONS

RLE	ROWE LANE ELEMENTARY	DMS	DESSAU MIDDLE SCHOOL
KLMS	KELLY LANE MIDDLE SCHOOL	PMS	PFLUGERVILLE MIDDLE SCHOOL
WKRM.	WORK ROOM	TP	TOILET PAPER DISPENSER
OFF	OFFICE	GB	GRAB BARS, RE: 16/A7.07
LIB.	LIBRARY	HD	HAND DRYERS
CORR	CORRIDOR	PT	PAPER TOWEL DISPENSER
MCT	MARMOLEUM COMPOSITE TILE	SD	SOAP DISPENSER
CPT	CARPET TILE	EWC	ELECTRIC WATER COOLER
T(X)	TILE	FEC	FIRE EXTINGUISHER CABINET
LVT	LUXURY VINYL TILE	SN	SANITARY NAPKIN DISPOSAL
CT	CERAMIC TILE	TB	TACKBOARD
VCT	VINYL COMPOSITE TILE		

DEMO KEYED NOTES - DMS

GENERAL:

D1 DEMO ALL EXISITING WALL PANELS IN CORRIDOR. PATCH AND RETEXTURE DRYWALL TO MATCH EXISTING FINISH ABOVE 6'-6". PREP AREA ABOVE 6'-6" TO RECIEVE NEW PAINT. PREP AREA BELOW 6'-6" TO RECIEVE WALL TILE.

D2 DEMO EXISTING SOAP DISPENSERS, PAPER TOWEL DISPENSERS, HAND DRYERS, MIRRORS, GRAB BARS, TOLIET PAPER TOWEL DISPENSERS, AND SANITARY NAPKIN DISPOSALS. PREPARE FOR NEW CONSTRUCTION

D3 PREP AREA TO RECIEVE NEW PAINT

D4 DEMO EXISTING FIRE EXTINGUISHER. PREPARE FOR NEW CONSTRUCTION.

D5 DEMO FLOORING AND WALL BASE. PREPARE FOR NEW CONSTRUCTION.

D6 DEMO EXISTING SIGNAGE.

D7 PREP ALL DOOR AND WINDOW FRAMES FOR REPAINT. NOTE DOORS LABELED AS TORNADO SHELTER AS STICKERS ARE TO BE PROVIDED BY OWNER AND REPLACED AFTER CONSTRUCTION.

D8 DEMO EXISTING WALL BASE (GYM). PREPARE FOR NEW CONSTRUCTION.

D9 PROTECT DURING DEMOLITION & REPAINT EXISTING LOCKERS.

D10 PLANTER WORK APART OF ALLOWANCE FOR PLANTER REFRESH

D11 DEMO EXISTING EWC AND ANY PANELING OR TILE BEHIND IT. PREPARE FOR NEW CONSTRUCTION.

D12 DEMO AND SALVAGE EXISTING WATER CLOSETS, URINALS, TOLIET PARTITIONS, URINAL SCREENS. PREPARE FOR REINSTALLATION.

D13 DEMO EXISTING FLOOR MATERIAL AND WALL TILE. PREPARE FOR NEW CONSTRUCTION.

D14 DEMO EXISTING BAND OF COLORED TILE ONLY. RR TO RECIEVE A DEEP CLEAN AND SEAL PRIOR TO FINISH OUT. PREPARE FOR NEW CONSTRUCTION.

D15 DEMO EXISTING CEILING IN ITS ENTIRETY. PREPARE FOR NEW CONSTRUCTION.

D16 DEMO EXISTING HANDRAILS & RUBBER STAIR MATERIAL. REPLACE IN ACCORDANCE WITH ADA COMPLIANCE.

D17 DEMO ENTIRE NORTH WALL OF TILE. PREPARE FOR NEW CONSTRUCTION.

D18 REMOVE AND SALVAGE ANY COLORED CEILING TILES. RETURN TO DISTRICT.

D19 DEMO EXISTING HAND DRYERS. PREPARE FOR NEW CONSTRUCTION.

D20 GRIND AND SMOOTH CONCRETE FLOOR. PREPARE FOR RESEALING.

D21 DEMO EXISTING TECTUM PANEL.

D22 DEMO CEILING ELEMENTS.

D23 DEMO SINGLE NORTH WALL TILE. ADD 5/8" GYP. PREPARE FOR NEW CONSTRUCTION.

D24 DEMO ALL EX SIGNAGE, SOAP DISPENSERS, TACKBOARDS, DOOR STOPS, AND ANY OTHER MISCELLANEOUS FIXTURES.

D25 SALVAGE URINALS, WATER CLOSETS, TOILET PARTITIONS, URINAL SCREENS, AND WATER CLOSETS. RE ROUTE PLUMBING AS NECESSARY. PREPARE FOR NEW CONSTRUCTION.

D26 SALVAGE WOOD TOPS OF BENCH. PREP FOR SMOOTH, SAND, RESTAIN AND REINSTALLATION.

D1

DEMO LEGEND

- DEMO VCT
- GRIND EPOXY. PREP FOR NEW INSTALLATION
- DEMO CARPET
- NOT IN SCOPE
- DEMO CT
- PARTIAL DEMO

Reliance Architecture, LLC
12 Chisholm Trl
Round Rock , Texas 78681
Ph (512) 758-7660
www.reliancearchitecture.com

Pflugerville Independent School District
Multi-Campus Renovations- Phase 3
Pflugerville, Texas


Copyright © 2025, Reliance Architecture, LLC. All rights reserved

Revision:
01 ADDENDUM 003 - 01.31.2025

Project Number
2407.1

Date:
1/31/2025

Sheet Number
DESSAU DEMO FLOOR PLAN A2.05

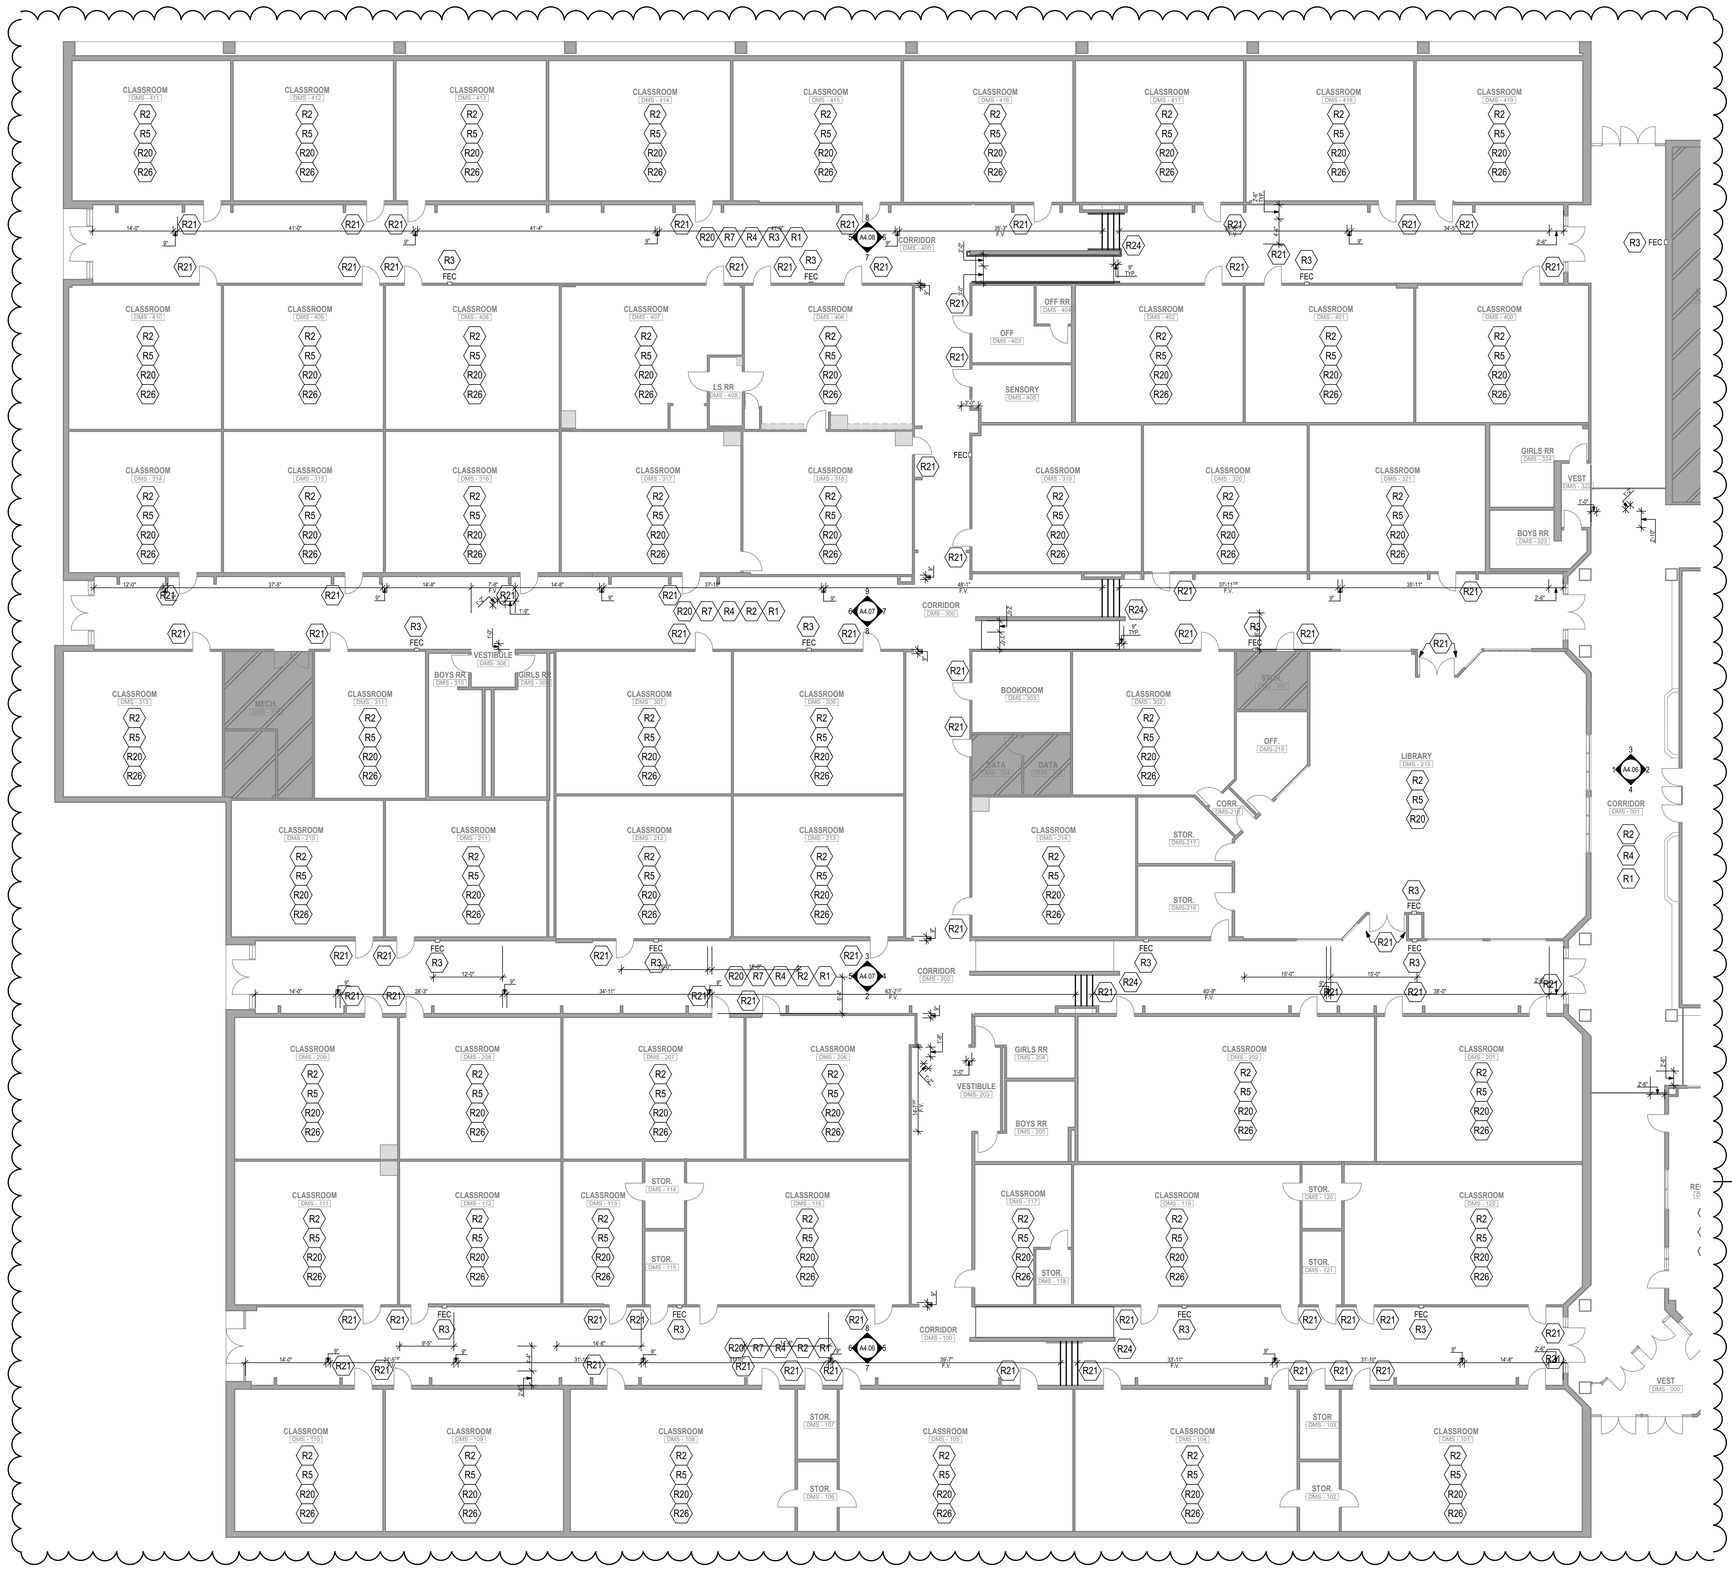

1 FLOOR PLAN

SCALE: 3/32" = 1'-0"

GENERAL NOTES

ALL QUANTITIES ARE APPROXIMATE AND SHOULD BE FIELD VERIFIED PRIOR TO BIDDING

CAD BACKGROUNDS PROVIDED BY DISTRICT DO NOT MATCH FIELD CONDITIONS. REFER TO ELEVATIONS FOR MEASURMENTS AND FIELD VERIFY ALL MEASURMENTS.

REFER TO SHEET A0.01 FOR ARCHITECTURAL GENERAL NOTES, MOUNTING HEIGHTS & LINTEL SCHEDULE

THE MOVING OF FURNITURE SHALL BE THE CONTRACTORS RESPONSIBILITY TO COMPLETE THEIR WORK. NO FLOORING REPLACEMENT WORK IS HAPPENING TO THE GYM FLOORING AND STAGING OF FURNITURE COULD OCCUR IN THIS SPACE AND CAFETERIA. CONTRACTOR TO PROVIDE LOGISTICS OF MOVING AND STAGING FURNITURE IN THEIR BID.

ABBREVIATIONS

RLE	ROWE LANE ELEMENTARY	DMS	DESSAU MIDDLE SCHOOL
KLMS	KELLY LANE MIDDLE SCHOOL	PMS	PFLUGERVILLE MIDDLE SCHOOL
WKRM.	WORK ROOM	TP	TOILET PAPER DISPENSER
OFF	OFFICE	GB	GRAB BARS, RE: 16/A7.07
LIB.	LIBRARY	HD	HAND DRYERS
CORR	CORRIDOR	PT	PAPER TOWEL DISPENSER
MCT	MARMOLEUM COMPOSITE TILE	SD	SOAP DISPENSER
CPT	CARPET TILE	EWC	ELECTRIC WATER COOLER
T(X)	TILE	FEC	FIRE EXTINGUISHER CABINET
LVT	LUXURY VINYL TILE	SN	SANITARY NAPKIN DISPOSAL
CT	CERAMIC TILE	TB	TACKBOARD
VCT	VINYL COMPOSITE TILE		

RENO KEYED NOTES - DMS

GENERAL:

R1 NEW WALL TILE UP TO 7'. REFER TO ELEVATIONS FOR TILE DETAIL.

R2 NEW FLOORING AND WALL BASE.

R3 STAINLESS STEEL FIRE EXTINGUISHER.

R4 NEW SIGNAGE FOR ALL ROOMS. REF DOOR SIGNAGE SCHEDULE.

R5 REPAINT ALL DOOR AND WINDOW FRAMES. REPLACE TORNADO SHELTER STICKERS AS NECESSARY.

R6 VENTILATED WALL BASE

R7 EXISTING LOCKERS TO REMAIN. REPLACE PLASTIC LAMINATE TOPS WITH SUPERIOR SLOPED METAL TOPS

R8 EX PLANTERS TO REMAIN.

R9 NEW FLOOR AND WALL TILE. REFER TO ELEVATIONS FOR DESIGN.

R10 SOLID PLASTIC URINAL SCREENS.

R11 24"X48" ADA CHANGING BENCH.

R12 PRE-FAB ADA COMPLIANT SHOWER.

R13 PRE-FAB SHOWER.

R14 GROUP LAVATORY, RE: ELEVATIONS.

R15 SOLID PLASTIC OVERHEAD-BRACED TOILET PARTITIONS.

R16 DOUBLE COAT HOOK.

R17 FRAMED MIRROR, RE: ELEVATIONS.

R18 NEW BAND OF COLORED TILES. REF ELEVATIONS FOR TILE DESIGN.

R19 REPLACE TILE BEHIND HAND DRYERS TO MATCH EX.

R20 PREP AREA TO RECIEVE NEW PAINT.

R21 DOOR STOPS, C.P.C.I.

R22 SALVAGED LAVATORYS, PARTITIONS, URINALS SCREENS, WATERCLOSETS, AND URINALS ARE TO BE REINSTALLED.

R23 NEW URINALS, WATER CLOSETS, LAVATORIES

R24 SAND AND RESTAIN TOPS OF RAMP WALLS

R25 SAND AND REFINISH TOPS OF WALLS IN CAFETERIA

R26 REFINISH CHAIR RAILS

Reliance Architecture, LLC
12 Chisholm Trl
Round Rock , Texas 78681
Ph (512) 758-7660
www.reliancearchitecture.com

REGISTERED ARCHITECT
STATE OF TEXAS

Pflugerville Independent School District
Multi-Campus Renovations- Phase 3
Pflugerville, Texas

Copyright © 2025, Reliance Architecture, LLC. All rights reserved.


Revision:
1 ADDENDUM 003 - 01.31.2025

Project Number
2407.1

Date:
1/31/2025

Sheet Number

DESSAU RENO FLOOR PLAN A2.06

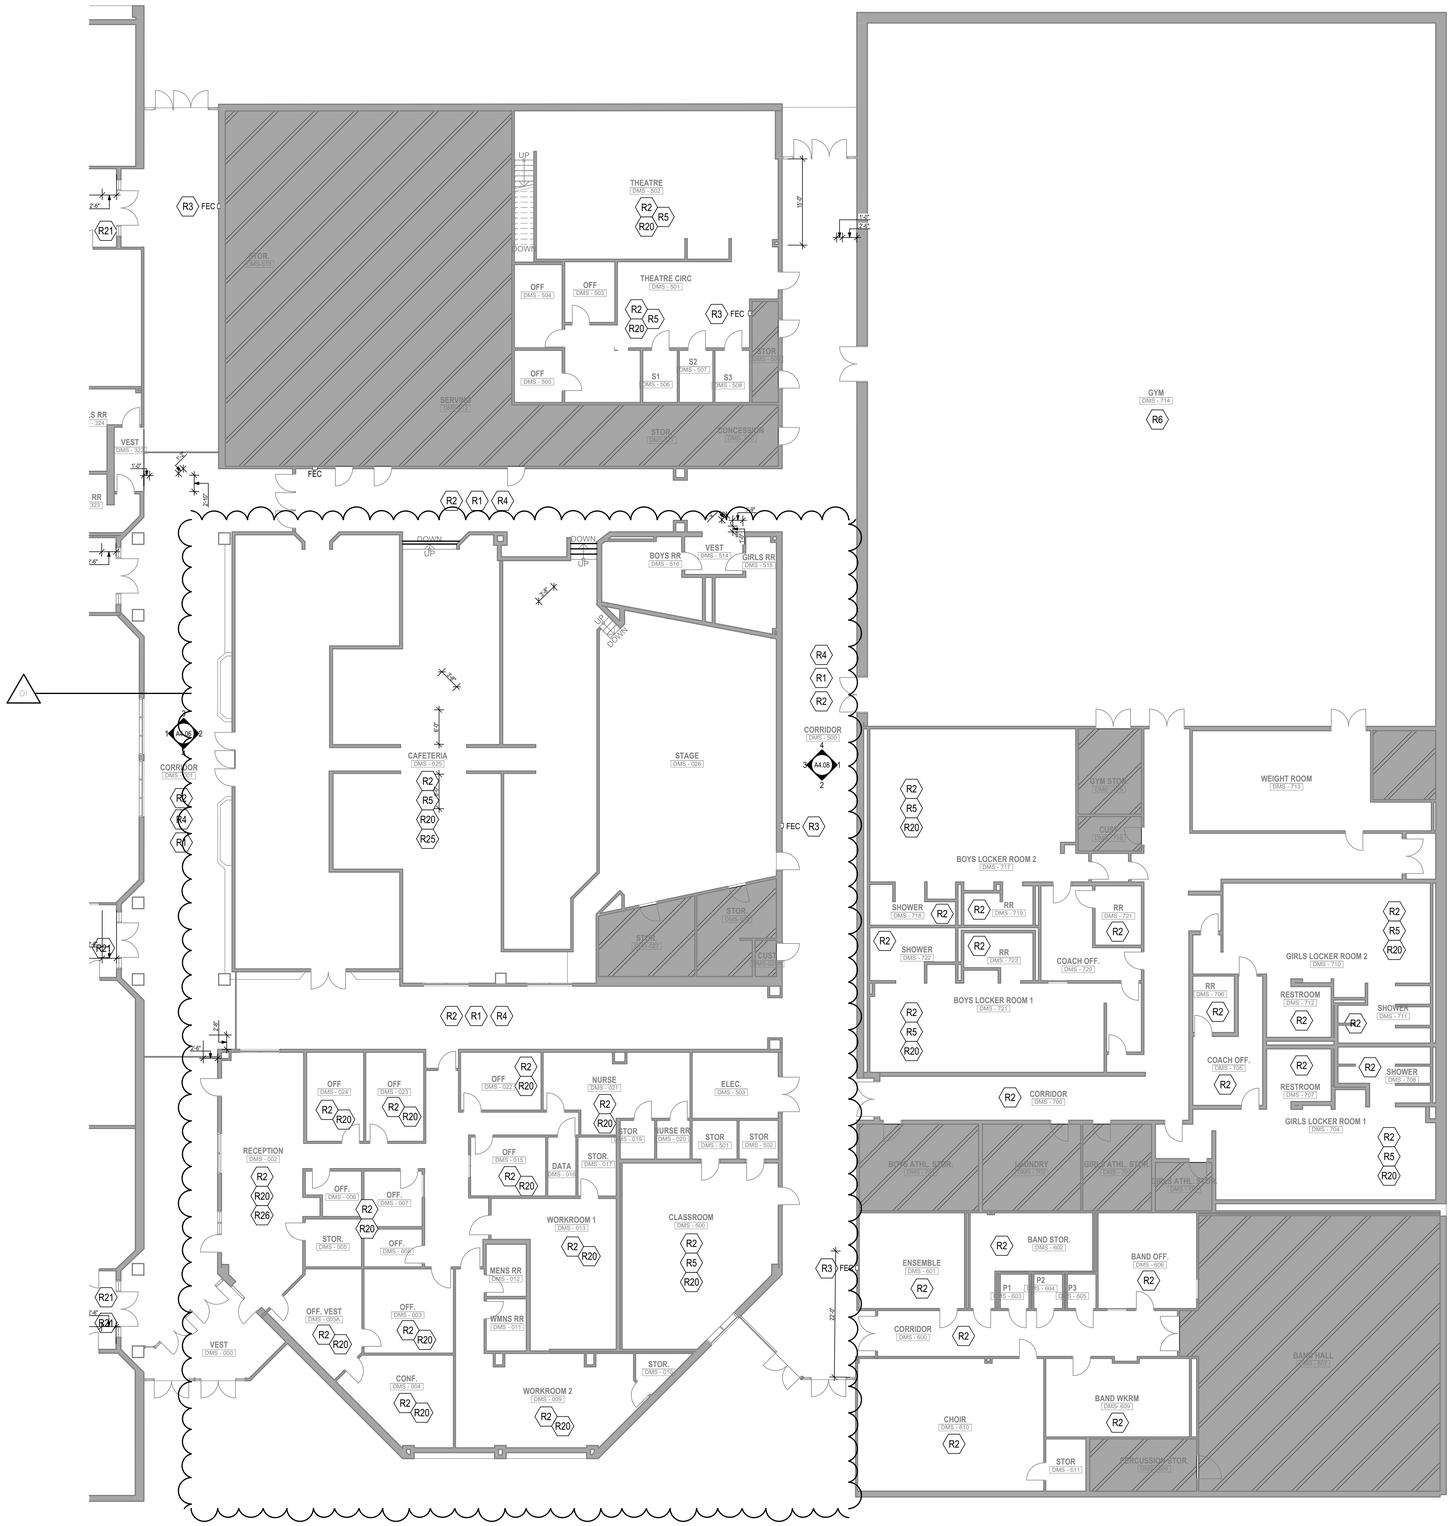

1 DESSAU MS RENO

SCALE: 3/32" = 1'-0"

GENERAL NOTES

ALL QUANTITIES ARE APPROXIMATE AND SHOULD BE FIELD VERIFIED PRIOR TO BIDDING

CAD BACKGROUNDS PROVIDED BY DISTRICT DO NOT MATCH FIELD CONDITIONS. REFER TO ELEVATIONS FOR MEASURMENTS AND FIELD VERIFY ALL MEASURMENTS.

REFER TO SHEET A0.01 FOR ARCHITECTURAL GENERAL NOTES, MOUNTING HEIGHTS & LINTEL SCHEDULE

THE MOVING OF FURNITURE SHALL BE THE CONTRACTORS RESPONSIBILITY TO COMPLETE THEIR WORK. NO FLOORING REPLACEMENT WORK IS HAPPENING TO THE GYM FLOORING AND STAGING OF FURNITURE COULD OCCUR IN THIS SPACE AND CAFETERIA. CONTRACTOR TO PROVIDE LOGISTICS OF MOVING AND STAGING FURNITURE IN THEIR BID.

ABBREVIATIONS

RLE	ROWE LANE ELEMENTARY	DMS	DESSAU MIDDLE SCHOOL
KLMS	KELLY LANE MIDDLE SCHOOL	PMS	PFLUGERVILLE MIDDLE SCHOOL
WKRM.	WORK ROOM	TP	TOILET PAPER DISPENSER
OFF	OFFICE	GB	GRAB BARS, RE: 16/A7.07
LIB.	LIBRARY	HD	HAND DRYERS
CORR	CORRIDOR	PT	PAPER TOWEL DISPENSER
MCT	MARMOLEUM COMPOSITE TILE	SD	SOAP DISPENSER
CPT	CARPET TILE	EWC	ELECTRIC WATER COOLER
T(X)	TILE	FEC	FIRE EXTINGUISHER CABINET
LVT	LUXURY VINYL TILE	SN	SANITARY NAPKIN DISPOSAL
CT	CERAMIC TILE	TB	TACKBOARD
VCT	VINYL COMPOSITE TILE		

RENO KEYED NOTES - DMS

GENERAL:

- R1 NEW WALL TILE UP TO 7'. REFER TO ELEVATIONS FOR TILE DETAIL.
- R2 NEW FLOORING AND WALL BASE.
- R3 STAINLESS STEEL FIRE EXTINGUISHER.
- R4 NEW SIGNAGE FOR ALL ROOMS. REF DOOR SIGNAGE SCHEDULE.
- R5 REPAINT ALL DOOR AND WINDOW FRAMES. REPLACE TORNADO SHELTER STICKERS AS NECESSARY.
- R6 VENTILATED WALL BASE.
- R7 EXISTING LOCKERS TO REMAIN. REPLACE PLASTIC LAMINATE TOPS WITH SUPERIOR SLOPED METAL TOPS
- R8 EX PLANTERS TO REMAIN.
- R9 NEW FLOOR AND WALL TILE. REFER TO ELEVATIONS FOR DESIGN.
- R10 SOLID PLASTIC URINAL SCREENS.
- R11 24"X48" ADA CHANGING BENCH.
- R12 PRE-FAB ADA COMPLIANT SHOWER.
- R13 PRE-FAB SHOWER.
- R14 GROUP LAVATORY, RE: ELEVATIONS.
- R15 SOLID PLASTIC OVERHEAD-BRACED TOILET PARTITIONS.
- R16 DOUBLE COAT HOOK.
- R17 FRAMED MIRROR, RE: ELEVATIONS.
- R18 NEW BAND OF COLORED TILES. REF ELEVATIONS FOR TILE DESIGN.
- R19 REPLACE TILE BEHIND HAND DRYERS TO MATCH EX.
- R20 PREP AREA TO RECIEVE NEW PAINT.
- R21 DOOR STOPS, C.P.C.I.
- R22 SALVAGED LAVATORYS, PARTITIONS, URINALS SCREENS, WATERCLOSETS, AND URINALS ARE TO BE REINSTALLED.
- R23 NEW URINALS, WATER CLOSETS, LAVATORIES.
- R24 SAND AND RESTAIN TOPS OF RAMP WALLS
- R25 SAND AND REFINISH TOPS OF WALLS IN CAFETERIA
- R26 REFINISH CHAIR RAILS

Reliance Architecture, LLC
12 Chisholm Trl
Round Rock , Texas 78681
Ph (512) 758-7660
www.reliancearchitecture.com

Pflugerville Independent School District

Multi-Campus Renovations- Phase 3

Pflugerville, Texas

Copyright © 2025, Reliance Architecture, LLC. All rights reserved.

Revision:

1 ADDENDUM 003 - 01.31.2025

Project Number
2407.1

Date:
1/31/2025

Sheet Number

DESSAU RENO FLOOR PLAN A2.07

GENERAL NOTES

ALL QUANTITIES ARE APPROXIMATE AND SHOULD BE FIELD VERIFIED PRIOR TO BIDDING

CAD BACKGROUNDS PROVIDED BY DISTRICT DO NOT MATCH FIELD CONDITIONS. REFER TO ELEVATIONS FOR MEASURMENTS AND FIELD VERIFY ALL MEASURMENTS.

REFER TO SHEET A0.01 FOR ARCHITECTURAL GENERAL NOTES, MOUNTING HEIGHTS & LINTEL SCHEDULE

THE MOVING OF FURNITURE SHALL BE THE CONTRACTORS RESPONSIBILITY TO COMPLETE THEIR WORK. NO FLOORING REPLACEMENT WORK IS HAPPENING TO THE GYM FLOORING AND STAGING OF FURNITURE COULD OCCUR IN THIS SPACE AND CAFETERIA. CONTRACTOR TO PROVIDE LOGISTICS OF MOVING AND STAGING FURNITURE IN THEIR BID.

ABBREVIATIONS

RLE	ROWE LANE ELEMENTARY	DMS	DESSAU MIDDLE SCHOOL
KLMS	KELLY LANE MIDDLE SCHOOL	PMS	PFLUGERVILLE MIDDLE SCHOOL
WKRM.	WORK ROOM	TP	TOILET PAPER DISPENSER
OFF	OFFICE	GB	GRAB BARS, RE: 16/A7.07
LIB.	LIBRARY	HD	HAND DRYERS
CORR	CORRIDOR	PT	PAPER TOWEL DISPENSER
MCT	MARMOLEUM COMPOSITE TILE	SD	SOAP DISPENSER
CPT	CARPET TILE	EWC	ELECTRIC WATER COOLER
T(X)	TILE	FEC	FIRE EXTINGUISHER CABINET
LVT	LUXURY VINYL TILE	SN	SANITARY NAPKIN DISPOSAL
CT	CERAMIC TILE	TB	TACKBOARD
VCT	VINYL COMPOSITE TILE		

LIGHT FIXTURE SCHEDULE:

(FIELD VERIFY ELECTRICAL REQUIREMENTS)

A1 - LITHONIA EPANL 2X4 4000LM 80CR1 35K MIN1 EZT MVOLT DGA24


A2 - LITHONIA EPANL 2X2 4000LM 80CRI 35K MIN1 EZT MVOLT DGA22

RCP SYMBOL LEGEND

- SUSPENDED ACOUSTIC CEILING TILE (2X2)
- GYPSUM BOARD CEILING
- 2X4 FLORESCENT
- STRIP LIGHT
- DOWN LIGHT
- WALL MOUNT LIGHT
- EXIT SIGN
- WALL MOUNTED EXIT SIGN
- MS — MOTION SENSOR
- SUPPLY AIR
- RETURN AIR
- F — FIRE A/V DEVICE




1 ROWE LANE RCP DEMO
SCALE: 1/16" = 1'-0"

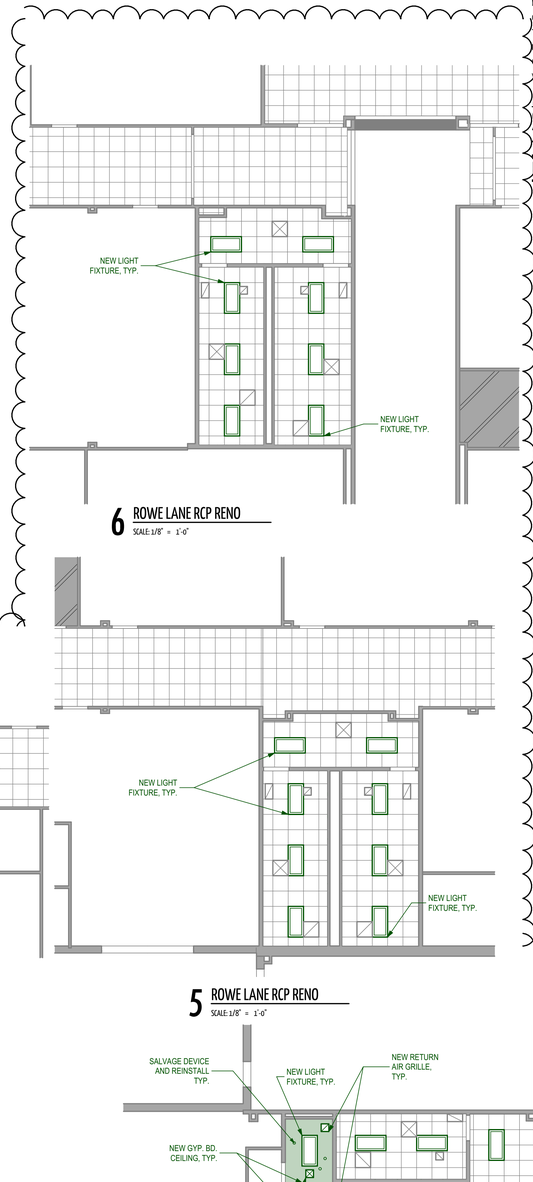


6 ROWE LANE RCP RENO
SCALE: 1/8" = 1'-0"

3 ROWE LANE RCP RENO
SCALE: 1/8" = 1'-0"


5 ROWE LANE RCP RENO
SCALE: 1/8" = 1'-0"

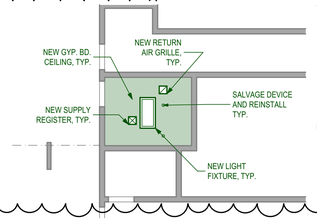

9 STAFF RR ROWE LANE RCP RENO
SCALE: 1/8" = 1'-0"

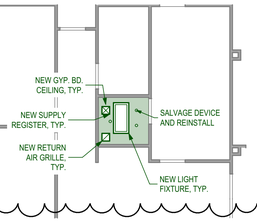

2 ROWE LANE RCP RENO
SCALE: 1/8" = 1'-0"

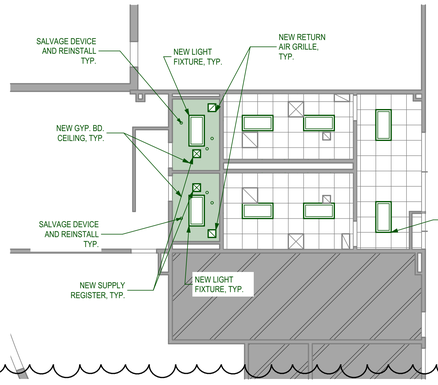

4 ROWE LANE RCP RENO
SCALE: 1/8" = 1'-0"

Reliance Architecture, LLC
12 Chisholm Trl
Round Rock , Texas 78681
Ph (512) 758-7660
www.reliancearchitecture.com

Pflugerville Independent School District
Multi-Campus Renovations- Phase 3
Pflugerville, Texas

Copyright © 2025, Reliance Architecture, LLC. All rights reserved

Revision:
01 ADDENDUM 003 - 1.31.2025

Project Number 2407.1

Date: 1/31/2025

Sheet Number

ROWE LANE ELEMENTARY REFLECTED CEILING PLAN A3.00

GENERAL NOTES

ALL QUANTITIES ARE APPROXIMATE AND SHOULD BE FIELD VERIFIED PRIOR TO BIDDING

CAD BACKGROUNDS PROVIDED BY DISTRICT DO NOT MATCH FIELD CONDITIONS. REFER TO ELEVATIONS FOR MEASURMENTS AND FIELD VERIFY ALL MEASURMENTS.


REFER TO SHEET A0.01 FOR ARCHITECTURAL GENERAL NOTES, MOUNTING HEIGHTS & LINTEL SCHEDULE

THE MOVING OF FURNITURE SHALL BE THE CONTRACTORS RESPONSIBILITY TO COMPLETE THEIR WORK. NO FLOORING REPLACEMENT WORK IS HAPPENING TO THE GYM FLOORING AND STAGING OF FURNITURE COULD OCCUR IN THIS SPACE AND CAFETERIA. CONTRACTOR TO PROVIDE LOGISTICS OF MOVING AND STAGING FURNITURE IN THEIR BID.

ABBREVIATIONS

RLE	ROWE LANE ELEMENTARY	DMS	DESSAU MIDDLE SCHOOL
KLMS	KELLY LANE MIDDLE SCHOOL	PMS	PFLUGERVILLE MIDDLE SCHOOL
WKRM.	WORK ROOM	TP	TOILET PAPER DISPENSER
OFF	OFFICE	GB	GRAB BARS, RE: 16/A7.07
LIB.	LIBRARY	HD	HAND DRYERS
CORR	CORRIDOR	PT	PAPER TOWEL DISPENSER
MCT	MARMOLEUM COMPOSITE TILE	SD	SOAP DISPENSER
CPT	CARPET TILE	EWC	ELECTRIC WATER COOLER
T(X)	TILE	FEC	FIRE EXTINGUISHER CABINET
LVT	LUXURY VINYL TILE	SN	SANITARY NAPKIN DISPOSAL
CT	CERAMIC TILE	TB	TACKBOARD
VCT	VINYL COMPOSITE TILE		

Reliance Architecture, LLC
12 Chisholm Trl
Round Rock , Texas 78681
Ph (512) 758-7660
www.reliancearchitecture.com

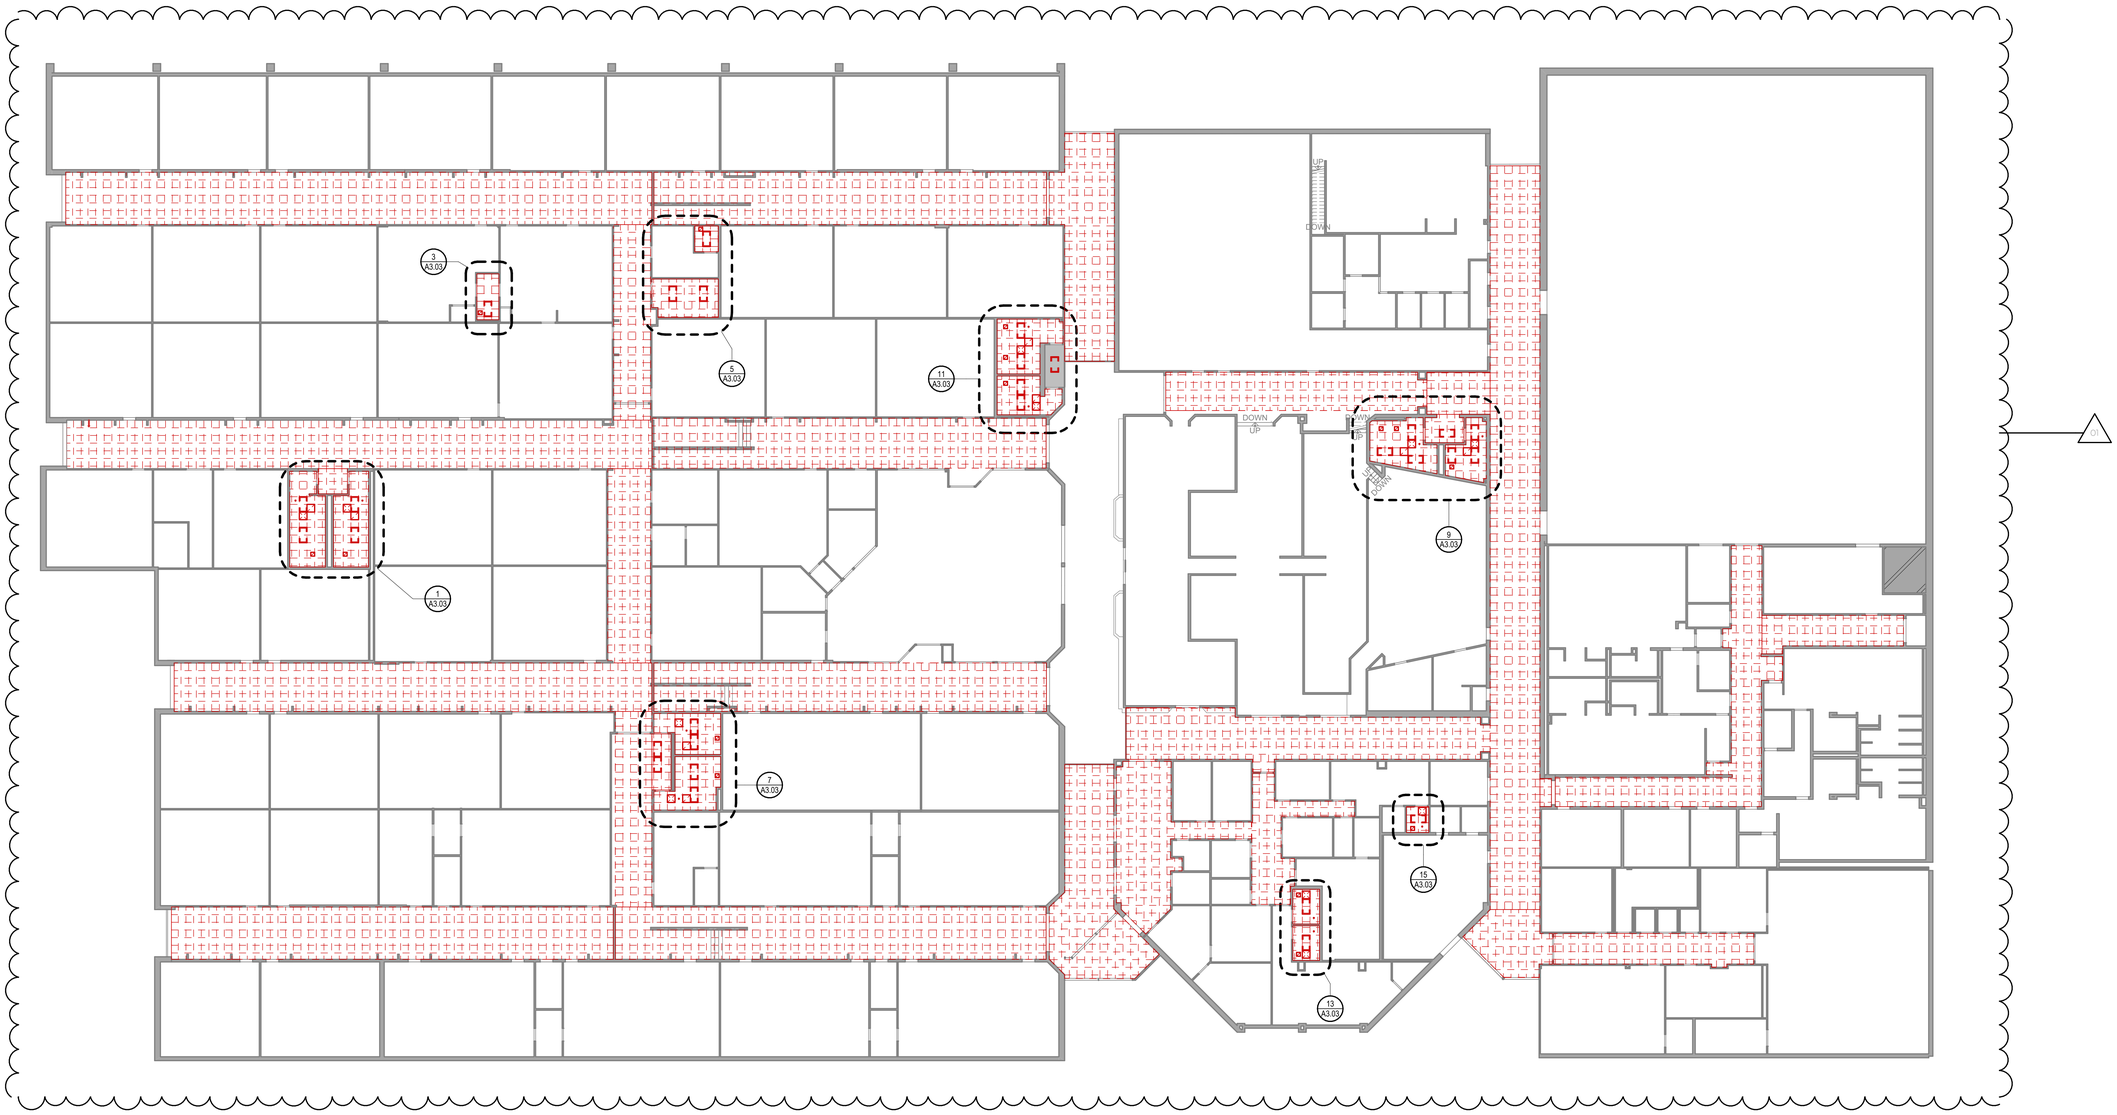

1 DESSAU RCP DEMO OVERALL
SCALE: 1/16" = 1'-0"

Pflugerville Independent School District
Multi-Campus Renovations- Phase 3
Pflugerville, Texas

Copyright © 2025 Reliance Architecture, LLC. All rights reserved

Revision:
01 ADDENDUM 003 - 01.31.2025

Project Number 2407.1

Date: 1/31/2025

Sheet Number

DESSAU OVERALL REFLECTED CEILING PLAN DEMO A3.01

GENERAL NOTES

ALL QUANTITIES ARE APPROXIMATE AND SHOULD BE FIELD VERIFIED PRIOR TO BIDDING


CAD BACKGROUNDS PROVIDED BY DISTRICT DO NOT MATCH FIELD CONDITIONS. REFER TO ELEVATIONS FOR MEASURMENTS AND FIELD VERIFY ALL MEASURMENTS.

REFER TO SHEET A0.01 FOR ARCHITECTURAL GENERAL NOTES, MOUNTING HEIGHTS & LINTEL SCHEDULE

THE MOVING OF FURNITURE SHALL BE THE CONTRACTORS RESPONSIBILITY TO COMPLETE THEIR WORK. NO FLOORING REPLACEMENT WORK IS HAPPENING TO THE GYM FLOORING AND STAGING OF FURNITURE COULD OCCUR IN THIS SPACE AND CAFETERIA. CONTRACTOR TO PROVIDE LOGISTICS OF MOVING AND STAGING FURNITURE IN THEIR BID.

ABBREVIATIONS

RLE	ROWE LANE ELEMENTARY	DMS	DESSAU MIDDLE SCHOOL
KLMS	KELLY LANE MIDDLE SCHOOL	PMS	PFLUGERVILLE MIDDLE SCHOOL
WKRM.	WORK ROOM	TP	TOILET PAPER DISPENSER
OFF	OFFICE	GB	GRAB BARS, RE: 16/A7.07
LIB.	LIBRARY	HD	HAND DRYERS
CORR	CORRIDOR	PT	PAPER TOWEL DISPENSER
MCT	MARMOLEUM COMPOSITE TILE	SD	SOAP DISPENSER
CPT	CARPET TILE	EWC	ELECTRIC WATER COOLER
T(X)	TILE	FEC	FIRE EXTINGUISHER CABINET
LVT	LUXURY VINYL TILE	SN	SANITARY NAPKIN DISPOSAL
CT	CERAMIC TILE	TB	TACKBOARD
VCT	VINYL COMPOSITE TILE		

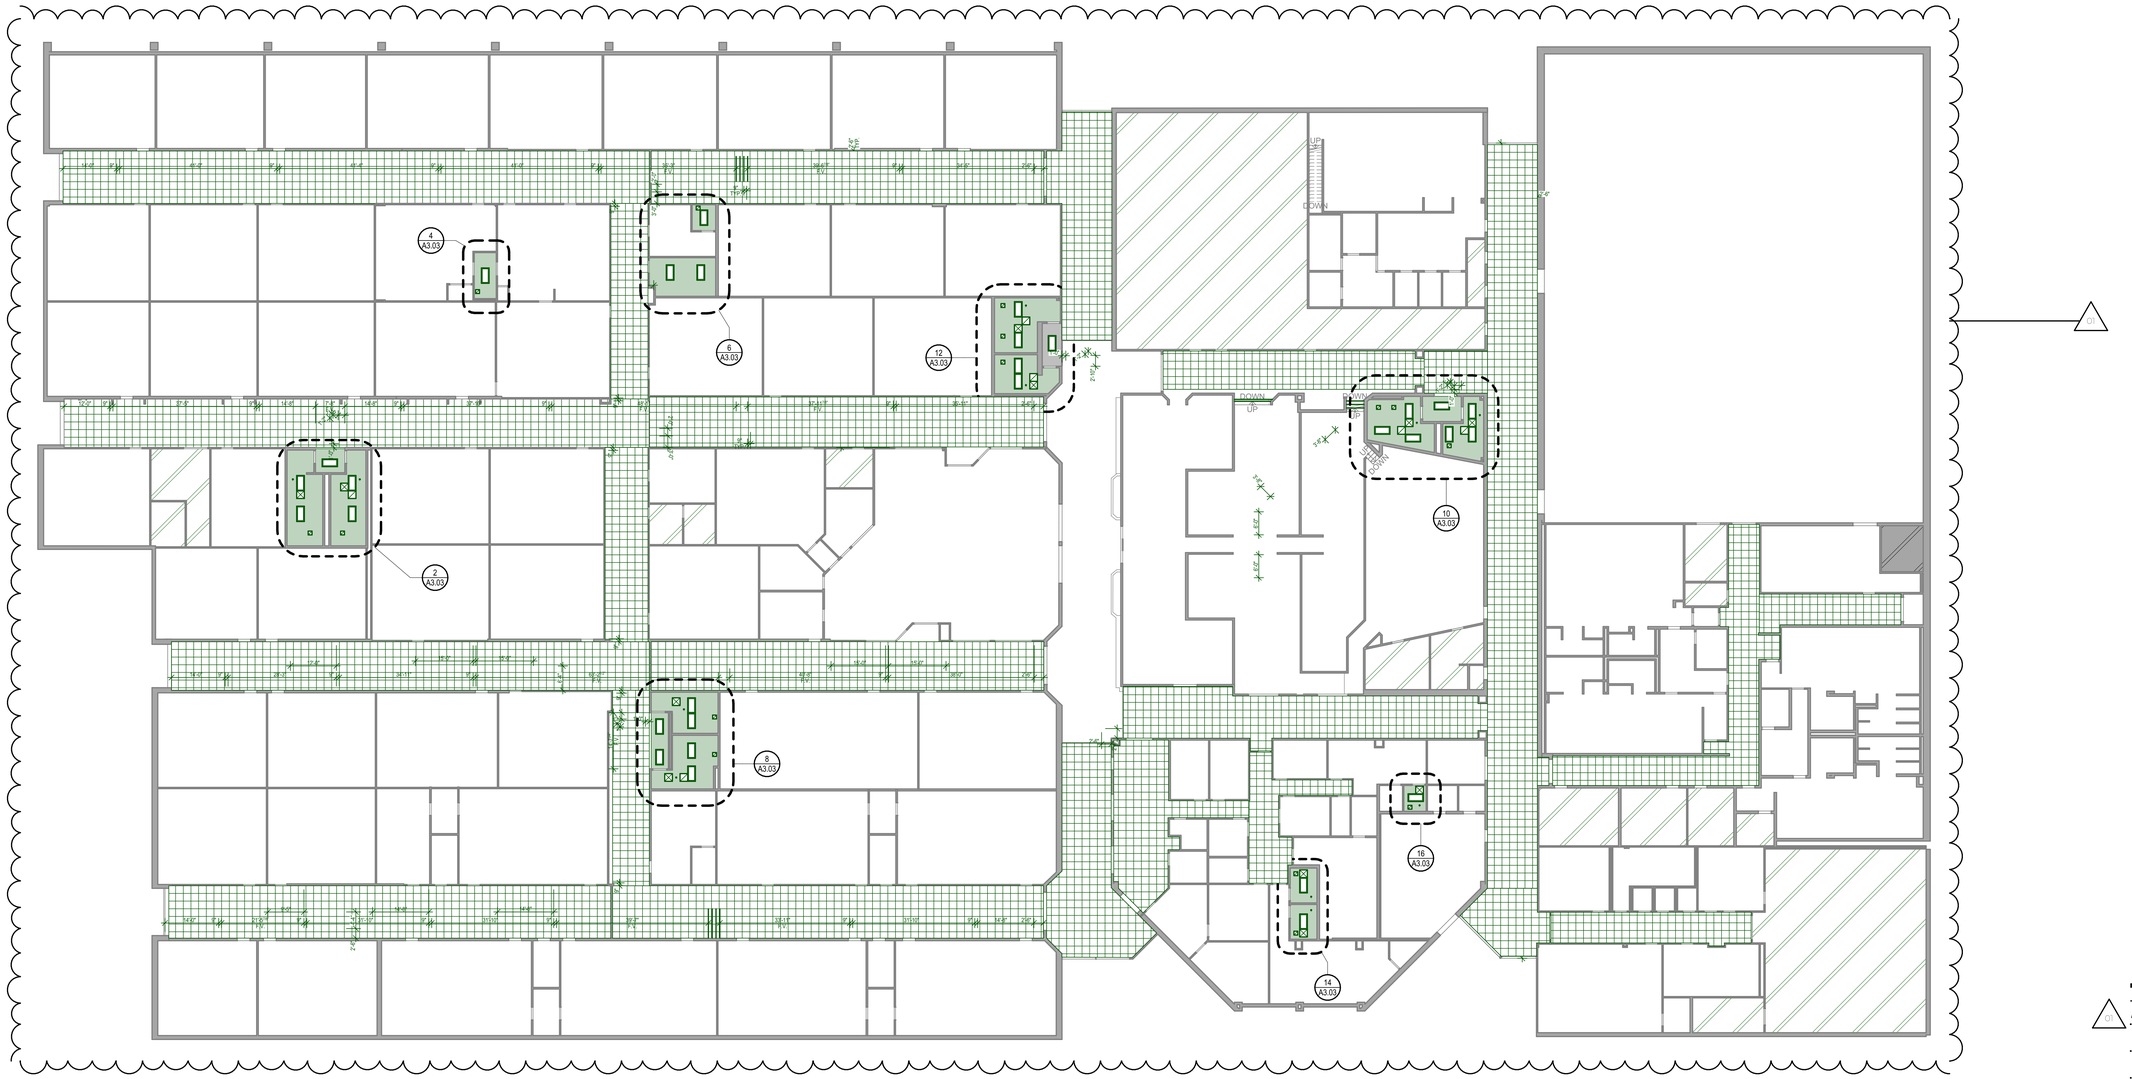

1 DESSAU RCP RENO OVERALL
SCALE: 1/16" = 1'-0"

Reliance Architecture, LLC
12 Chisholm Trl
Round Rock , Texas 78681
Ph (512) 758-7660
www.reliancearchitecture.com

REGISTERED ARCHITECT — STATE OF TEXAS

Pflugerville Independent School District
Multi-Campus Renovations- Phase 3
Pflugerville, Texas

Copyright © 2025, Reliance Architecture, LLC. All rights reserved.


Revision:
01 ADDENDUM 003 - 01.31.2025

Project Number 2407.1


Date: 1/31/2025

Sheet Number A3.02


DESSAU OVERALL REFLECTED CEILING PLAN RENO

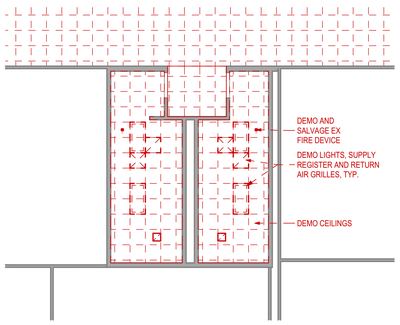

1 DESSAU RCP DEMO
SCALE: 1/8" = 1'-0"

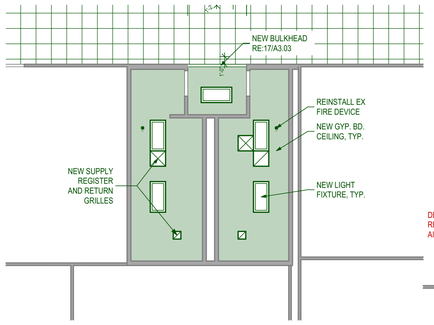


2 DESSAU RCP RENO
SCALE: 1/8" = 1'-0"

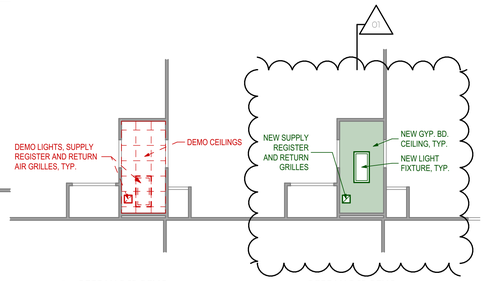


3 DESSAU RCP DEMO
SCALE: 1/8" = 1'-0"


4 DESSAU RCP RENO
SCALE: 1/8" = 1'-0"

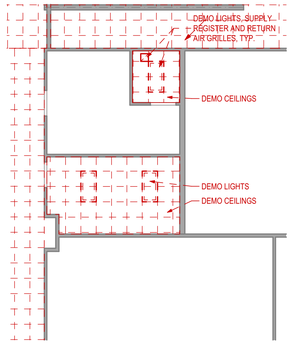

5 DESSAU RCP DEMO
SCALE: 1/8" = 1'-0"

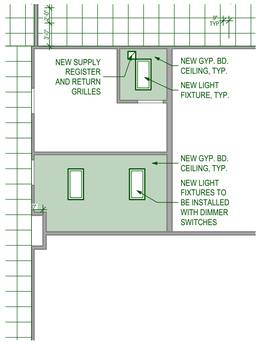


6 DESSAU RCP RENO
SCALE: 1/8" = 1'-0"

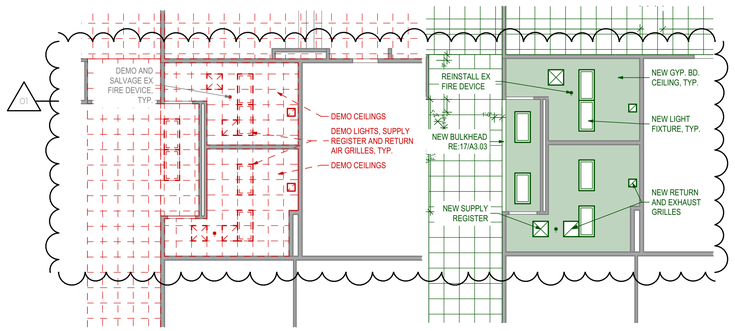


7 DESSAU RCP DEMO
SCALE: 1/8" = 1'-0"


8 DESSAU RCP RENO
SCALE: 1/8" = 1'-0"

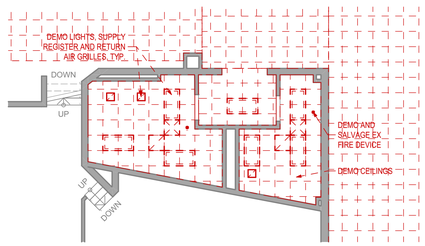


9 DESSAU RCP DEMO
SCALE: 1/8" = 1'-0"

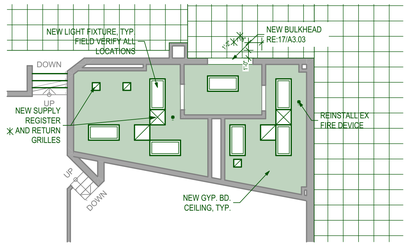


10 DESSAU RCP RENO
SCALE: 1/8" = 1'-0"

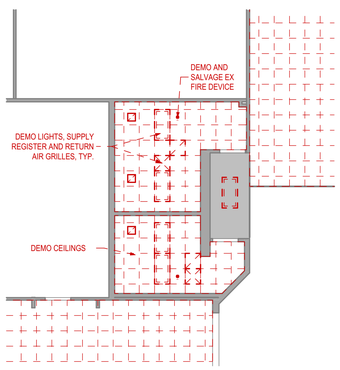


11 DESSAU RCP DEMO
SCALE: 1/8" = 1'-0"

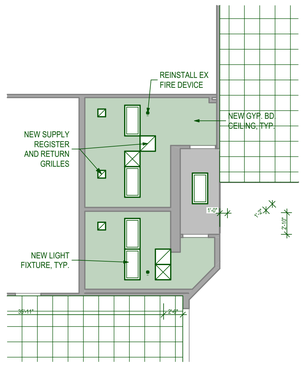


12 DESSAU RCP RENO
SCALE: 1/8" = 1'-0"

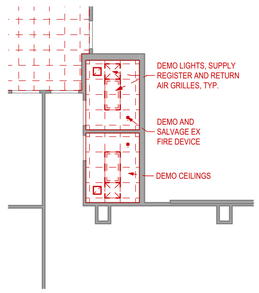

13 DESSAU RCP DEMO
SCALE: 1/8" = 1'-0"

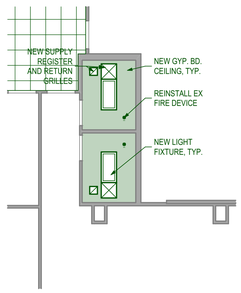


14 DESSAU RCP RENO
SCALE: 1/8" = 1'-0"

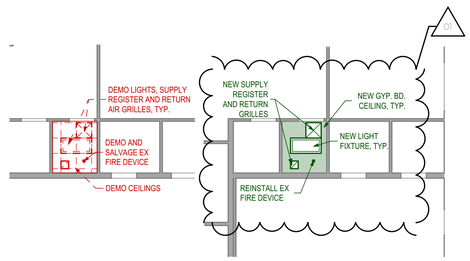

15 DESSAU RCP DEMO
SCALE: 1/8" = 1'-0"

16 DESSAU RCP RENO
SCALE: 1/8" = 1'-0"

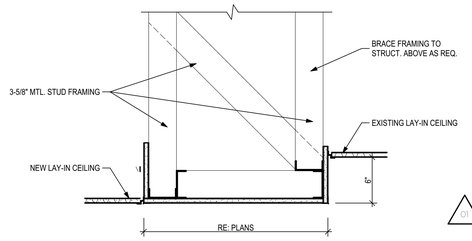

17 TYP. BULK HEAD
SCALE: 1 1/2" = 1'-0"

GENERAL NOTES

ALL QUANTITIES ARE APPROXIMATE AND SHOULD BE FIELD VERIFIED PRIOR TO BIDDING

CAD BACKGROUNDS PROVIDED BY DISTRICT DO NOT MATCH FIELD CONDITIONS. REFER TO ELEVATIONS FOR MEASURMENTS AND FIELD VERIFY ALL MEASURMENTS.

REFER TO SHEET A0.01 FOR ARCHITECTURAL GENERAL NOTES, MOUNTING HEIGHTS & LINTEL SCHEDULE

THE MOVING OF FURNITURE SHALL BE THE CONTRACTORS RESPONSIBILITY TO COMPLETE THEIR WORK. NO FLOORING REPLACEMENT WORK IS HAPPENING TO THE GYM FLOORING AND STAGING OF FURNITURE COULD OCCUR IN THIS SPACE AND CAFETERIA. CONTRACTOR TO PROVIDE LOGISTICS OF MOVING AND STAGING FURNITURE IN THEIR BID.

ABBREVIATIONS

RLE	ROWE LANE ELEMENTARY	DMS	DESSAU MIDDLE SCHOOL
KLMS	KELLY LANE MIDDLE SCHOOL	PMS	PFLUGERVILLE MIDDLE SCHOOL
WKRM.	WORK ROOM	TP	TOILET PAPER DISPENSER
OFF	OFFICE	GB	GRAB BARS, RE: 16/A7.07
LIB.	LIBRARY	HD	HAND DRYERS
CORR	CORRIDOR	PT	PAPER TOWEL DISPENSER
MCT	MARMOLEUM COMPOSITE TILE	SD	SOAP DISPENSER
CPT	CARPET TILE	EWC	ELECTRIC WATER COOLER
T(X)	TILE	FEC	FIRE EXTINGUISHER CABINET
LVT	LUXURY VINYL TILE	SN	SANITARY NAPKIN DISPOSAL
CT	CERAMIC TILE	TB	TACKBOARD
VCT	VINYL COMPOSITE TILE		

LIGHT FIXTURE SCHEDULE:

(FIELD VERIFY ELECTRICAL REQUIREMENTS)
A1 - LITHONIA EPANL 2X4 4000LM 80CR1 35K MIN1 EZT MVOLT DGA24
A2 - LITHONIA EPANL 2X2 4000LM 80CRI 35K MIN1 EZT MVOLT DGA22

RCP SYMBOL LEGEND

- SUSPENDED ACOUSTIC CEILING TILE (2X2)
- GYPSUM BOARD CEILING
- 2X4 FLORESCENT
- STRIP LIGHT
- DOWN LIGHT
- WALL MOUNT LIGHT
- EXIT SIGN
- WALL MOUNTED EXIT SIGN
- MS — MOTION SENSOR
- SUPPLY AIR
- RETURN AIR
- F — FIRE A/V DEVICE

Reliance Architecture, LLC
12 Chisholm Trl
Round Rock , Texas 78681
Ph (512) 758-7660
www.reliancearchitecture.com

Pflugerville Independent School District
Multi-Campus Renovations- Phase 3
Pflugerville, Texas

Copyright © 2025 Reliance Architecture, LLC All rights reserved.

Revision:
1 ADDENDUM 003 - 1.31.2025

Project Number 2407.1
Date: 1/31/2025
Sheet Number

DESSAU REFLECTED CEILING PLAN A3.03

GENERAL NOTES

ALL QUANTITIES ARE APPROXIMATE AND SHOULD BE FIELD VERIFIED PRIOR TO BIDDING

CAD BACKGROUNDS PROVIDED BY DISTRICT DO NOT MATCH FIELD CONDITIONS. REFER TO ELEVATIONS FOR MEASURMENTS AND FIELD VERIFY ALL MEASURMENTS.


REFER TO SHEET A0.01 FOR ARCHITECTURAL GENERAL NOTES, MOUNTING HEIGHTS & LINTEL SCHEDULE

THE MOVING OF FURNITURE SHALL BE THE CONTRACTORS RESPONSIBILITY TO COMPLETE THEIR WORK. NO FLOORING REPLACEMENT WORK IS HAPPENING TO THE GYM FLOORING AND STAGING OF FURNITURE COULD OCCUR IN THIS SPACE AND CAFETERIA. CONTRACTOR TO PROVIDE LOGISTICS OF MOVING AND STAGING FURNITURE IN THEIR BID.

ABBREVIATIONS

RLE	ROWE LANE ELEMENTARY	DMS	DESSAU MIDDLE SCHOOL
KLMS	KELLY LANE MIDDLE SCHOOL	PMS	PFLUGERVILLE MIDDLE SCHOOL
WKRM.	WORK ROOM	TP	TOILET PAPER DISPENSER
OFF	OFFICE	GB	GRAB BARS, RE: 16/A7.07
LIB.	LIBRARY	HD	HAND DRYERS
CORR	CORRIDOR	PT	PAPER TOWEL DISPENSER
MCT	MARMOLEUM COMPOSITE TILE	SD	SOAP DISPENSER
CPT	CARPET TILE	EWC	ELECTRIC WATER COOLER
T(X)	TILE	FEC	FIRE EXTINGUISHER CABINET
LVT	LUXURY VINYL TILE	SN	SANITARY NAPKIN DISPOSAL
CT	CERAMIC TILE	TB	TACKBOARD
VCT	VINYL COMPOSITE TILE		

Reliance Architecture, LLC
12 Chisholm Trl
Round Rock , Texas 78681
Ph (512) 758-7660
www.reliancearchitecture.com

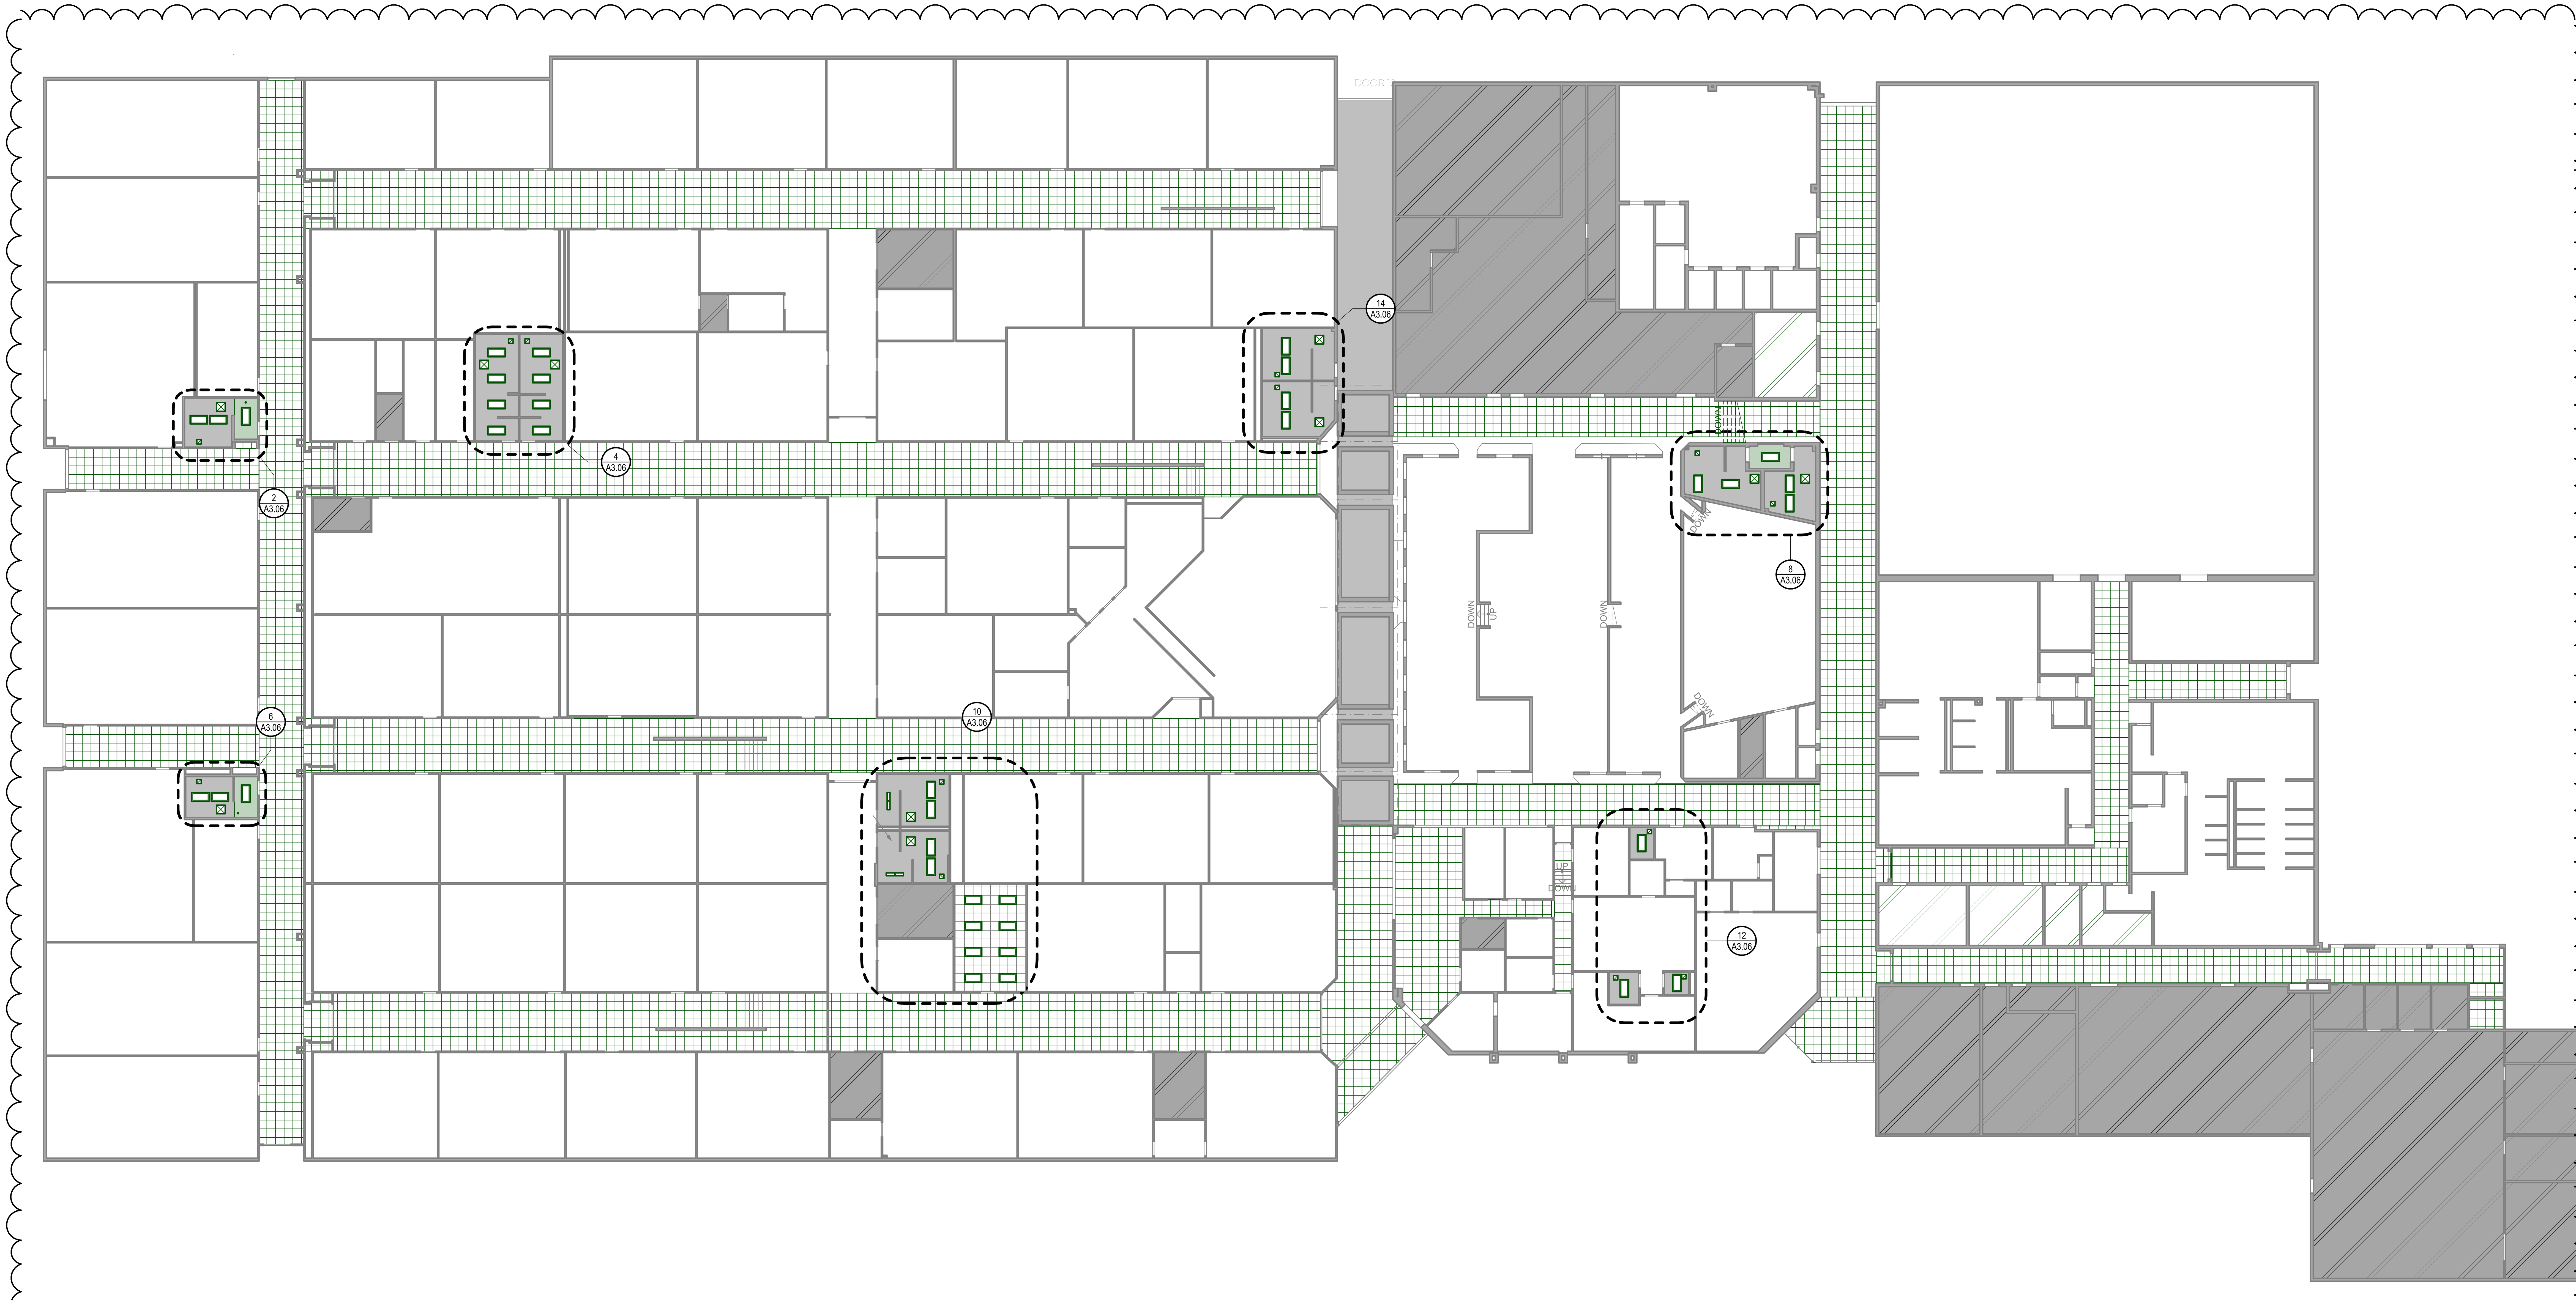

1 PFLUGERVILLE RCP RENO OVERALL
SCALE: 1/16" = 1'-0"

Pflugerville Independent School District
Multi-Campus Renovations- Phase 3
Pflugerville, Texas

Copyright © 2025, Reliance Architecture, LLC. All rights reserved.

Revision:
ADDENDUM 003 - 1.31.2025


Project Number
2407.1

Date:
1/31/2025


Sheet Number

PFLUGERVILLE OVERALL REFLECTED CEILING PLAN RENO


A3.05

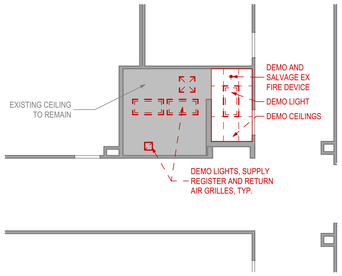


1 PFLUGERVILLE RCP DEMO
SCALE: 1/8" = 1'-0"

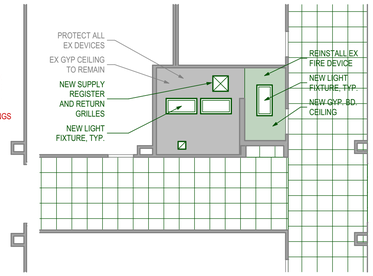


2 PFLUGERVILLE RCP RENO ENLARGE
SCALE: 1/8" = 1'-0"

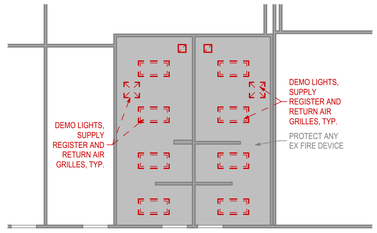


3 PFLUGERVILLE RCP DEMO
SCALE: 1/8" = 1'-0"

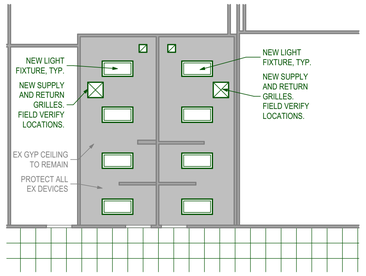


4 PFLUGERVILLE RCP RENO ENLARGE
SCALE: 1/8" = 1'-0"

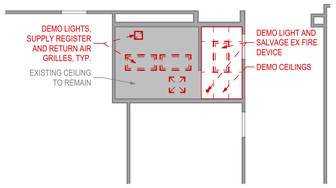


5 PFLUGERVILLE RCP DEMO
SCALE: 1/8" = 1'-0"

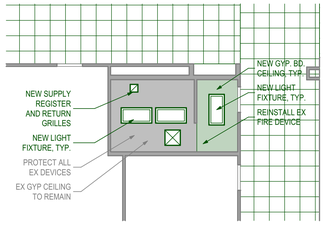


6 PFLUGERVILLE RCP RENO ENLARGE
SCALE: 1/8" = 1'-0"

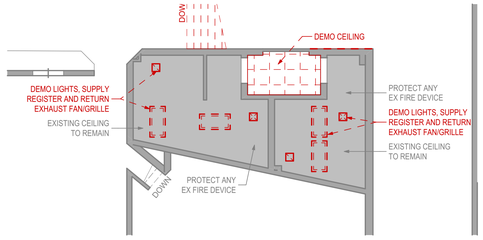


7 PFLUGERVILLE RCP DEMO
SCALE: 1/8" = 1'-0"

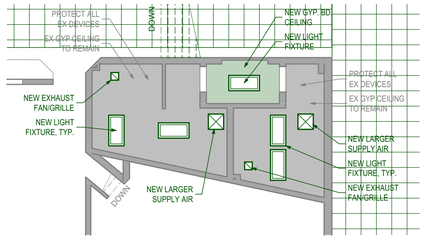


8 PFLUGERVILLE RCP RENO ENLARGE
SCALE: 1/8" = 1'-0"

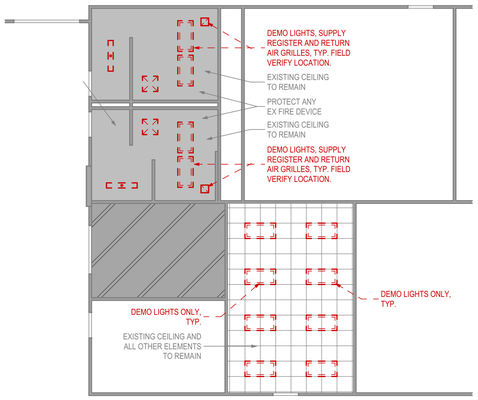


9 PFLUGERVILLE RCP DEMO
SCALE: 1/8" = 1'-0"

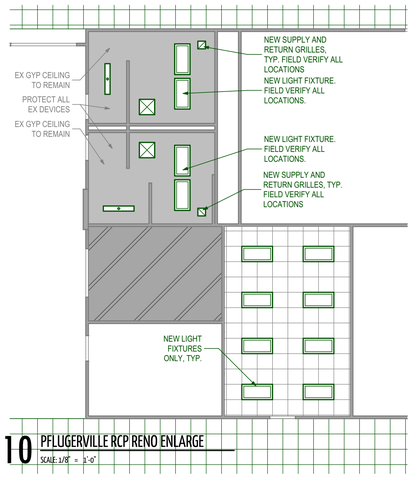


10 PFLUGERVILLE RCP RENO ENLARGE
SCALE: 1/8" = 1'-0"

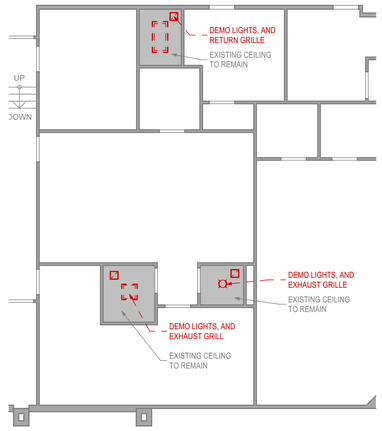


11 PFLUGERVILLE RCP DEMO
SCALE: 1/8" = 1'-0"

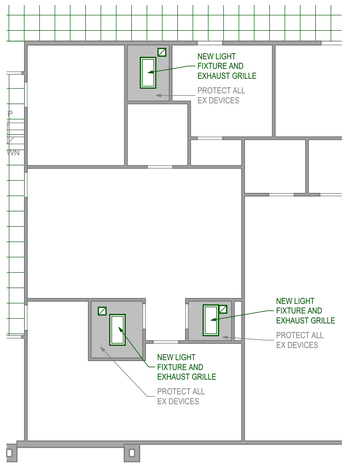

12 PFLUGERVILLE RCP RENO ENLARGE
SCALE: 1/8" = 1'-0"

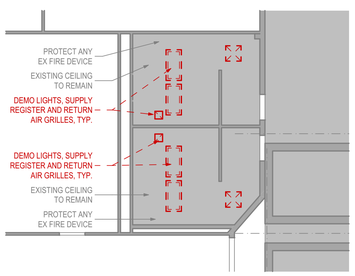

13 PFLUGERVILLE RCP DEMO
SCALE: 1/8" = 1'-0"

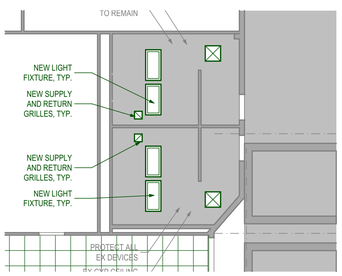

14 PFLUGERVILLE RCP RENO ENLARGE
SCALE: 1/8" = 1'-0"

GENERAL NOTES

ALL QUANTITIES ARE APPROXIMATE AND SHOULD BE FIELD VERIFIED PRIOR TO BIDDING

CAD BACKGROUNDS PROVIDED BY DISTRICT DO NOT MATCH FIELD CONDITIONS. REFER TO ELEVATIONS FOR MEASURMENTS AND FIELD VERIFY ALL MEASURMENTS.

REFER TO SHEET A0.01 FOR ARCHITECTURAL GENERAL NOTES, MOUNTING HEIGHTS & LINTEL SCHEDULE

THE MOVING OF FURNITURE SHALL BE THE CONTRACTORS RESPONSIBILITY TO COMPLETE THEIR WORK. NO FLOORING REPLACEMENT WORK IS HAPPENING TO THE GYM FLOORING AND STAGING OF FURNITURE COULD OCCUR IN THIS SPACE AND CAFETERIA. CONTRACTOR TO PROVIDE LOGISTICS OF MOVING AND STAGING FURNITURE IN THEIR BID.

ABBREVIATIONS

RLE	ROWE LANE ELEMENTARY	DMS	DESSAU MIDDLE SCHOOL
KLMS	KELLY LANE MIDDLE SCHOOL	PMS	PFLUGERVILLE MIDDLE SCHOOL
WKRM.	WORK ROOM	TP	TOILET PAPER DISPENSER
OFF	OFFICE	GB	GRAB BARS, RE: 16/A7.07
LIB.	LIBRARY	HD	HAND DRYERS
CORR	CORRIDOR	PT	PAPER TOWEL DISPENSER
MCT	MARMOLEUM COMPOSITE TILE	SD	SOAP DISPENSER
CPT	CARPET TILE	EWC	ELECTRIC WATER COOLER
T(X)	TILE	FEC	FIRE EXTINGUISHER CABINET
LVT	LUXURY VINYL TILE	SN	SANITARY NAPKIN DISPOSAL
CT	CERAMIC TILE	TB	TACKBOARD
VCT	VINYL COMPOSITE TILE		

RCP SYMBOL LEGEND

- SUSPENDED ACOUSTIC CEILING TILE (2X2)
- GYPSUM BOARD CEILING
- 2X4 FLORESCENT
- STRIP LIGHT
- DOWN LIGHT
- WALL MOUNT LIGHT
- EXIT SIGN
- WALL MOUNTED EXIT SIGN
- MS — MOTION SENSOR
- SUPPLY AIR
- RETURN AIR
- F — FIRE A/V DEVICE

Reliance Architecture, LLC
12 Chisholm Trl
Round Rock , Texas 78681
Ph (512) 758-7660
www.reliancearchitecture.com

Pflugerville Independent School District
Multi-Campus Renovations- Phase 3
Pflugerville, Texas

Copyright © 2025, Reliance Architecture, LLC. All rights reserved.

Revision:
1 ADDENDUM 003 - 1.31.2025


Project Number
2407.1

Date:
1/31/2025

Sheet Number
A3.06


PFLUGERVILLE REFLECTED CEILING PLAN

REF 4/A7.00 FOR MATERIAL SELECTIONS

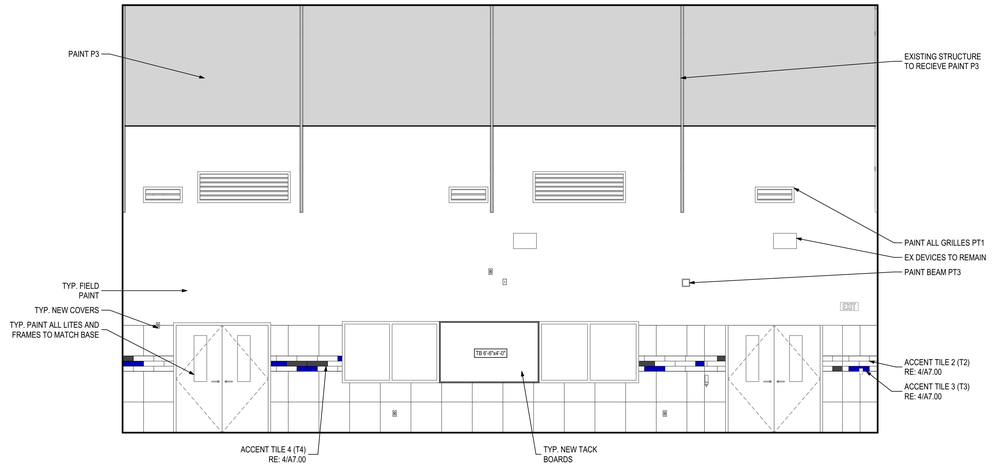


1 ROWE LANE ENTRY ELEVATION RENO

SCALE: 1/4" = 1'-0"

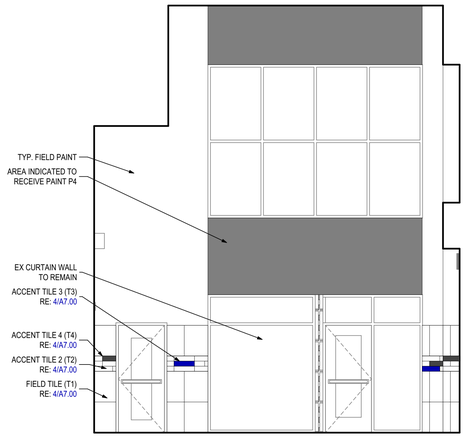


3 ROWE LANE ENTRY ELEVATION RENO

SCALE: 1/4" = 1'-0"

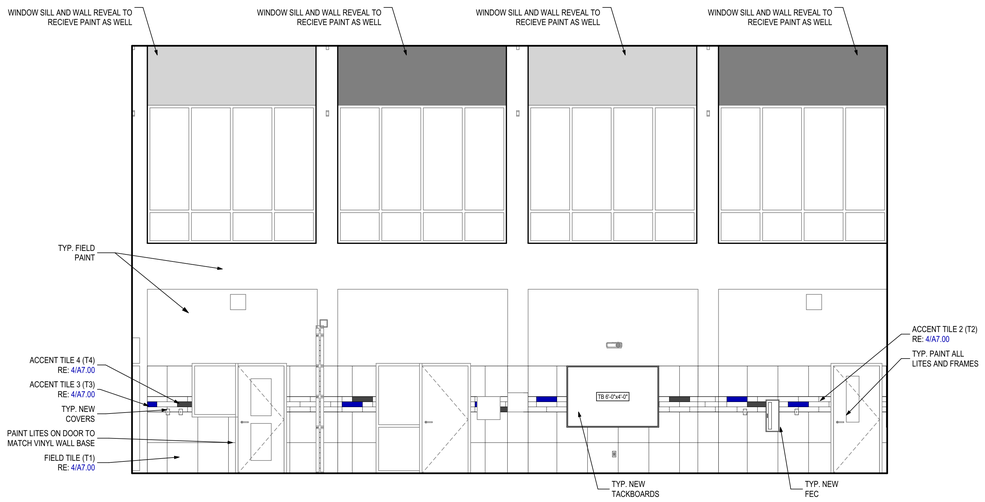

2 ROWE LANE ENTRY ELEVATION RENO

SCALE: 1/4" = 1'-0"

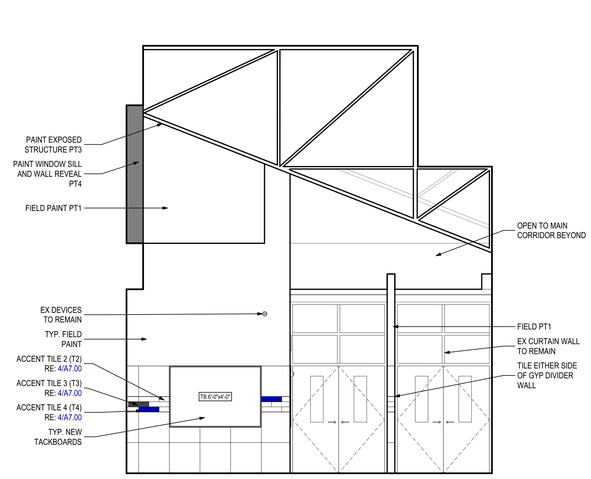

4 ROWE LANE ENTRY ELEVATION RENO

SCALE: 1/4" = 1'-0"

GENERAL NOTES

ALL QUANTITIES ARE APPROXIMATE AND SHOULD BE FIELD VERIFIED PRIOR TO BIDDING

CAD BACKGROUNDS PROVIDED BY DISTRICT DO NOT MATCH FIELD CONDITIONS. REFER TO ELEVATIONS FOR MEASURMENTS AND FIELD VERIFY ALL MEASURMENTS.

REFER TO SHEET A0.01 FOR ARCHITECTURAL GENERAL NOTES, MOUNTING HEIGHTS & LINTEL SCHEDULE

THE MOVING OF FURNITURE SHALL BE THE CONTRACTORS RESPONSIBILITY TO COMPLETE THEIR WORK. NO FLOORING REPLACEMENT WORK IS HAPPENING TO THE GYM FLOORING AND STAGING OF FURNITURE COULD OCCUR IN THIS SPACE AND CAFETERIA. CONTRACTOR TO PROVIDE LOGISTICS OF MOVING AND STAGING FURNITURE IN THEIR BID.

ABBREVIATIONS

RLE	ROWE LANE ELEMENTARY	DMS	DESSAU MIDDLE SCHOOL
KLMS	KELLY LANE MIDDLE SCHOOL	PMS	PFLUGERVILLE MIDDLE SCHOOL
WKRM.	WORK ROOM	TP	TOILET PAPER DISPENSER
OFF	OFFICE	GB	GRAB BARS, RE: 16/A7.07
LIB.	LIBRARY	HD	HAND DRYERS
CORR	CORRIDOR	PT	PAPER TOWEL DISPENSER
MCT	MARMOLEUM COMPOSITE TILE	SD	SOAP DISPENSER
CPT	CARPET TILE	EWC	ELECTRIC WATER COOLER
T(X)	TILE	FEC	FIRE EXTINGUISHER CABINET
LVT	LUXURY VINYL TILE	SN	SANITARY NAPKIN DISPOSAL
CT	CERAMIC TILE	TB	TACKBOARD
VCT	VINYL COMPOSITE TILE		

Reliance Architecture, LLC
12 Chisholm Trl
Round Rock , Texas 78681
Ph (512) 758-7660
www.reliancearchitecture.com

LICENSED ARCHITECT STATE OF TEXAS

Pflugerville Independent School District

Multi-Campus Renovations- Phase 3

Pflugerville, Texas

Copyright © 2025, Reliance Architecture, LLC. All rights reserved.

Revision:

1 ADDENDUM 003 - 1.31.2025


Project Number 2407.1

Date: 1/31/2025

Sheet Number


ROWE LANE ENTRY CORRIDOR ELEVATIONS A4.00

REF 4/A7.00 FOR MATERIAL SELECTIONS

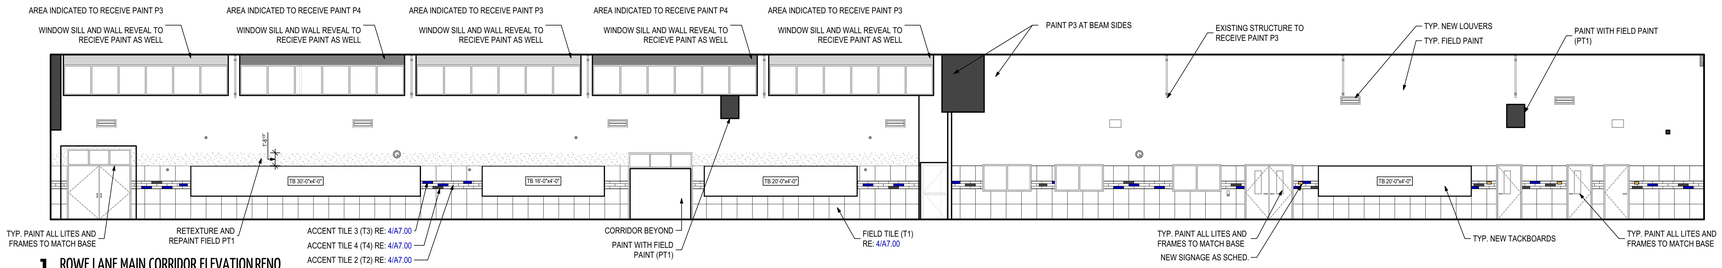


1 ROWE LANE MAIN CORRIDOR ELEVATION RENO

SCALE: 1/8" = 1'-0"

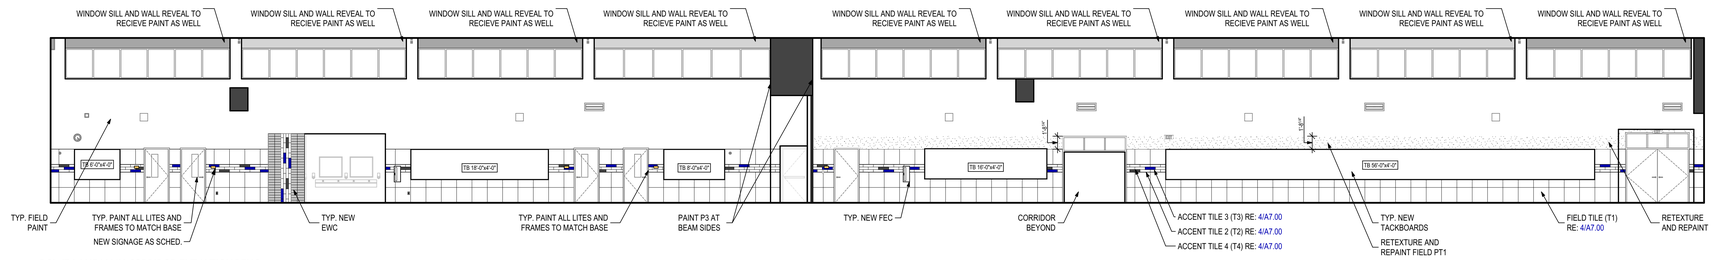


2 ROWE LANE MAIN CORRIDOR ELEVATION RENO

SCALE: 1/8" = 1'-0"

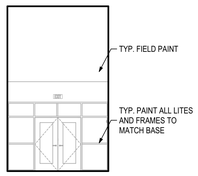


3 ROWE LANE MAIN CORRIDOR ELEVATION RENO

SCALE: 1/8" = 1'-0"

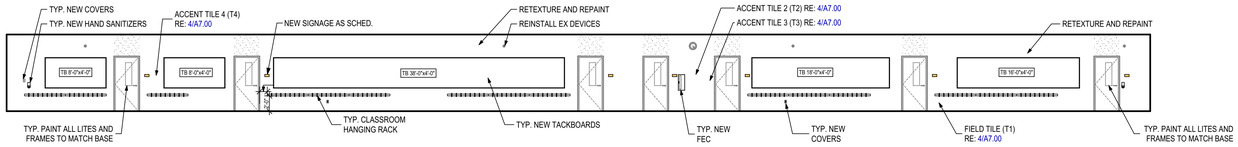


5 ROWE LANE CORRIDOR 1 ELEVATION

SCALE: 1/8" = 1'-0"

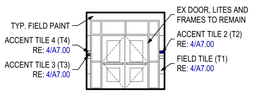


4 ROWE LANE CORRIDOR 1 ELEVATION

SCALE: 1/8" = 1'-0"

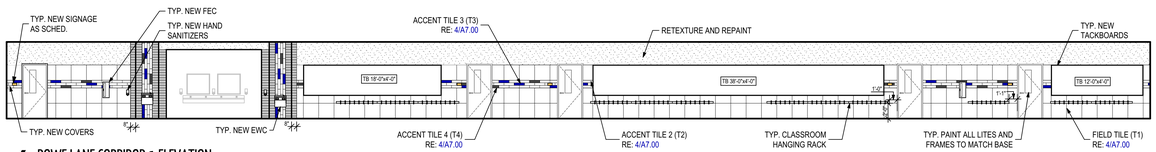


6 ROWE LANE CORRIDOR 1 ELEVATION

SCALE: 1/8" = 1'-0"

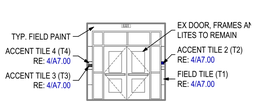


7 ROWE LANE CORRIDOR 2 ELEVATION

SCALE: 1/8" = 1'-0"

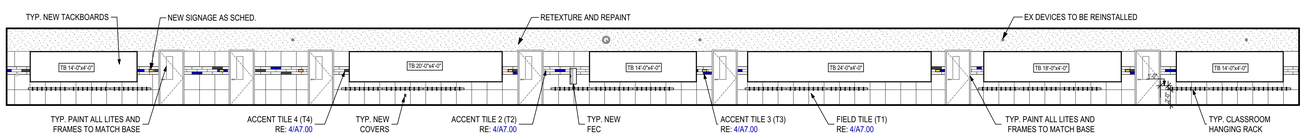

8 ROWE LANE CORRIDOR 2 ELEVATION

SCALE: 1/8" = 1'-0"

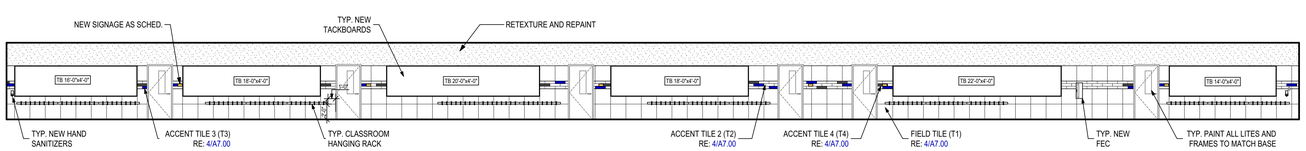

9 ROWE LANE CORRIDOR 2 ELEVATION

SCALE: 1/8" = 1'-0"

GENERAL NOTES

ALL QUANTITIES ARE APPROXIMATE AND SHOULD BE FIELD VERIFIED PRIOR TO BIDDING

CAD BACKGROUNDS PROVIDED BY DISTRICT DO NOT MATCH FIELD CONDITIONS. REFER TO ELEVATIONS FOR MEASURMENTS AND FIELD VERIFY ALL MEASURMENTS.

REFER TO SHEET A0.01 FOR ARCHITECTURAL GENERAL NOTES, MOUNTING HEIGHTS & LINTEL SCHEDULE

THE MOVING OF FURNITURE SHALL BE THE CONTRACTORS RESPONSIBILITY TO COMPLETE THEIR WORK. NO FLOORING REPLACEMENT WORK IS HAPPENING TO THE GYM FLOORING AND STAGING OF FURNITURE COULD OCCUR IN THIS SPACE AND CAFETERIA. CONTRACTOR TO PROVIDE LOGISTICS OF MOVING AND STAGING FURNITURE IN THEIR BID.

ABBREVIATIONS

RLE	ROWE LANE ELEMENTARY	DMS	DESSAU MIDDLE SCHOOL
KLMS	KELLY LANE MIDDLE SCHOOL	PMS	PFLUGERVILLE MIDDLE SCHOOL
WKRM.	WORK ROOM	TP	TOILET PAPER DISPENSER
OFF	OFFICE	GB	GRAB BARS, RE: 16/A7.07
LIB.	LIBRARY	HD	HAND DRYERS
CORR	CORRIDOR	PT	PAPER TOWEL DISPENSER
MCT	MARMOLEUM COMPOSITE TILE	SD	SOAP DISPENSER
CPT	CARPET TILE	EWC	ELECTRIC WATER COOLER
T(X)	TILE	FEC	FIRE EXTINGUISHER CABINET
LVT	LUXURY VINYL TILE	SN	SANITARY NAPKIN DISPOSAL
CT	CERAMIC TILE	TB	TACKBOARD
VCT	VINYL COMPOSITE TILE		

Reliance Architecture, LLC
12 Chisholm Trl
Round Rock , Texas 78681
Ph (512) 758-7660
www.reliancearchitecture.com

Pflugerville Independent School District

Multi-Campus Renovations- Phase 3

Pflugerville, Texas

Copyright © 2025, Reliance Architecture, LLC. All rights reserved.

Revision:

1 ADDENDUM 003 - 1.31.2025


Project Number 2407.1

Date: 1/31/2025


Sheet Number

ROWE LANE CORRIDOR RENO ELEVATIONS A4.01


REF 4/A7.00 FOR MATERIAL SELECTIONS

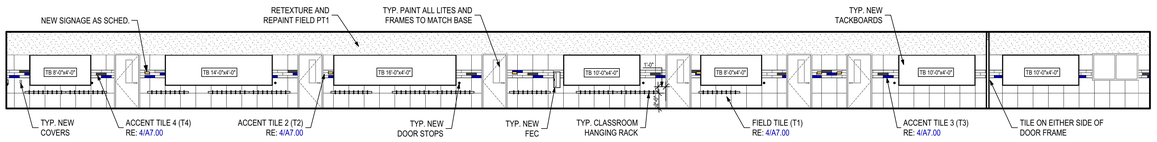


1 ROWE LANE CORRIDOR 3 ELEVATION
SCALE: 1/8" = 1'-0"

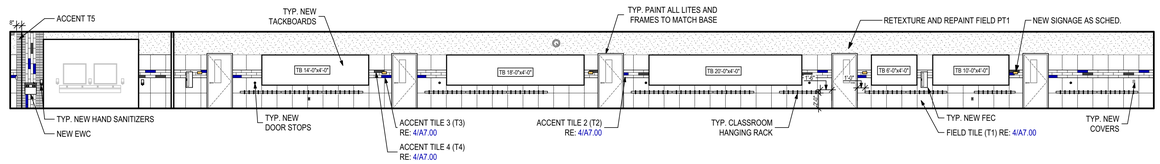


2 ROWE LANE CORRIDOR 3 ELEVATION
SCALE: 1/8" = 1'-0"

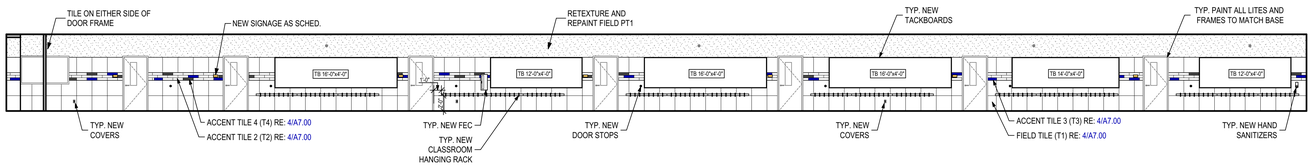


4 ROWE LANE CORRIDOR 4 ELEVATION
SCALE: 1/8" = 1'-0"

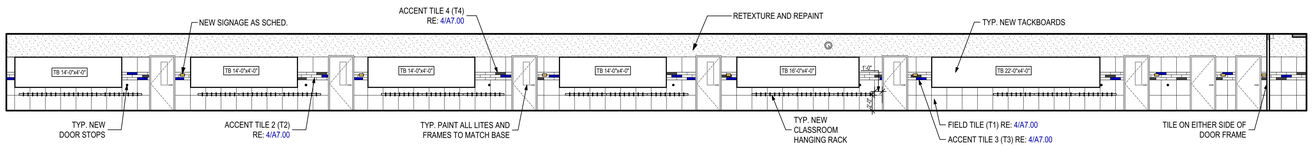


6 ROWE LANE CORRIDOR 4 ELEVATION
SCALE: 1/8" = 1'-0"

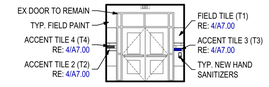


3 ROWE LANE CORRIDOR 3 ELEVATION
SCALE: 1/8" = 1'-0"

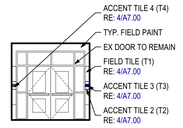


5 ROWE LANE CORRIDOR 4 ELEVATION
SCALE: 1/8" = 1'-0"

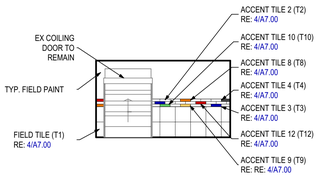


7 ROWE LANE SERVING ELEVATION
SCALE: 1/8" = 1'-0"

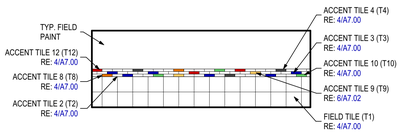


8 ROWE LANE SERVING ELEVATION
SCALE: 1/8" = 1'-0"

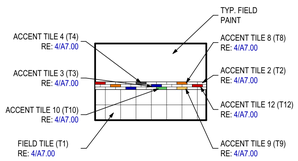


9 ROWE LANE SERVING ELEVATION
SCALE: 1/8" = 1'-0"

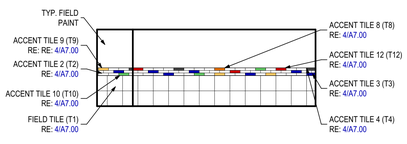


10 ROWE LANE SERVING ELEVATION
SCALE: 1/8" = 1'-0"

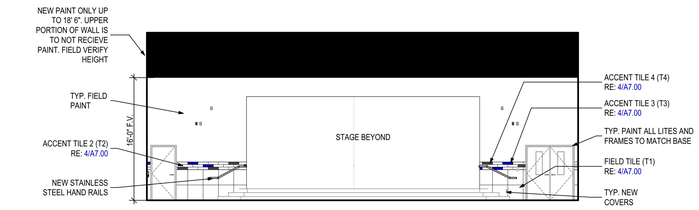


11 ROWE LANE CAFETERIA ELEVATION
SCALE: 1/8" = 1'-0"

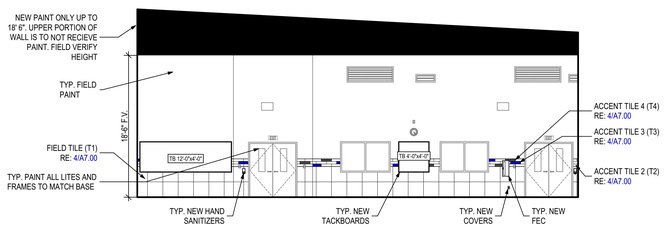

12 ROWE LANE CAFETERIA ELEVATION
SCALE: 1/8" = 1'-0"

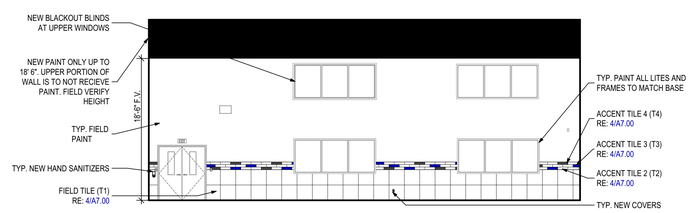

13 ROWE LANE CAFETERIA ELEVATION
SCALE: 1/8" = 1'-0"

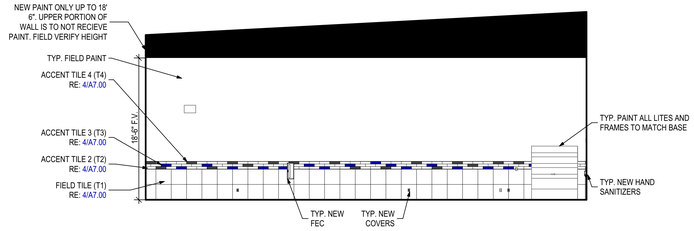

14 ROWE LANE CAFETERIA ELEVATION
SCALE: 1/8" = 1'-0"

GENERAL NOTES

ALL QUANTITIES ARE APPROXIMATE AND SHOULD BE FIELD VERIFIED PRIOR TO BIDDING

CAD BACKGROUNDS PROVIDED BY DISTRICT DO NOT MATCH FIELD CONDITIONS. REFER TO ELEVATIONS FOR MEASURMENTS AND FIELD VERIFY ALL MEASURMENTS.

REFER TO SHEET A0.01 FOR ARCHITECTURAL GENERAL NOTES, MOUNTING HEIGHTS & LINTEL SCHEDULE

THE MOVING OF FURNITURE SHALL BE THE CONTRACTORS RESPONSIBILITY TO COMPLETE THEIR WORK. NO FLOORING REPLACEMENT WORK IS HAPPENING TO THE GYM FLOORING AND STAGING OF FURNITURE COULD OCCUR IN THIS SPACE AND CAFETERIA. CONTRACTOR TO PROVIDE LOGISTICS OF MOVING AND STAGING FURNITURE IN THEIR BID.

ABBREVIATIONS

RLE	ROWE LANE ELEMENTARY	DMS	DESSAU MIDDLE SCHOOL
KLMS	KELLY LANE MIDDLE SCHOOL	PMS	PFLUGERVILLE MIDDLE SCHOOL
WKRM.	WORK ROOM	TP	TOILET PAPER DISPENSER
OFF	OFFICE	GB	GRAB BARS, RE: 16/A7.07
LIB.	LIBRARY	HD	HAND DRYERS
CORR	CORRIDOR	PT	PAPER TOWEL DISPENSER
MCT	MARMOLEUM COMPOSITE TILE	SD	SOAP DISPENSER
CPT	CARPET TILE	EWC	ELECTRIC WATER COOLER
T(X)	TILE	FEC	FIRE EXTINGUISHER CABINET
LVT	LUXURY VINYL TILE	SN	SANITARY NAPKIN DISPOSAL
CT	CERAMIC TILE	TB	TACKBOARD
VCT	VINYL COMPOSITE TILE		

Reliance Architecture, LLC
12 Chisholm Trl
Round Rock , Texas 78681
Ph (512) 758-7660
www.reliancearchitecture.com

Pflugerville Independent School District
Multi-Campus Renovations- Phase 3
Pflugerville, Texas


Copyright © 2025, Reliance Architecture, LLC. All rights reserved.

Revision:
1 ADDENDUM 003 - 1.31.2025


Project Number: 2407.1
Date: 1/31/2025

Sheet Number


ROWE LANE CORRIDOR RENO ELEVATIONS A4.02

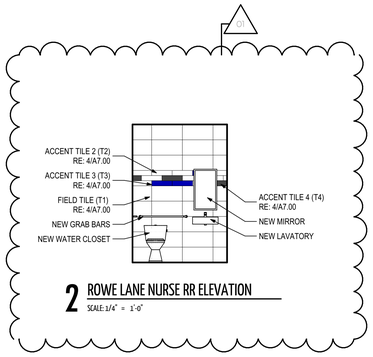


2 ROWE LANE NURSE RR ELEVATION
SCALE: 1/4" = 1'-0"

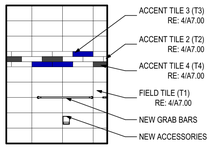


4 ROWE LANE NURSE RR ELEVATION
SCALE: 1/4" = 1'-0"

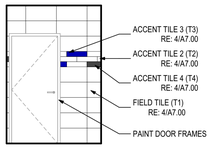


1 ROWE LANE NURSE RR ELEVATION
SCALE: 1/4" = 1'-0"

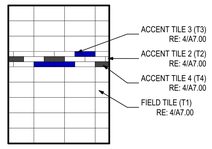


3 ROWE LANE NURSE RR ELEVATION
SCALE: 1/4" = 1'-0"

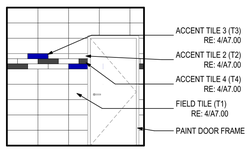


6 ROWE LANE STAFF RR 1 ELEVATION
SCALE: 1/4" = 1'-0"

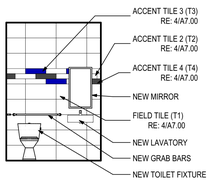


8 ROWE LANE STAFF RR 1 ELEVATION
SCALE: 1/4" = 1'-0"

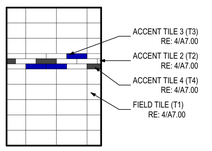


7 ROWE LANE STAFF RR 1 ELEVATION
SCALE: 1/4" = 1'-0"

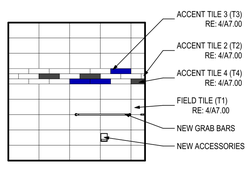


5 ROWE LANE STAFF RR 1 ELEVATION
SCALE: 1/4" = 1'-0"

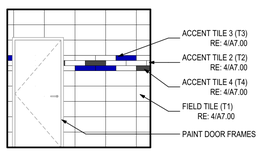


9 ROWE LANE STAFF RR 2 RR ELEVATION
SCALE: 1/4" = 1'-0"

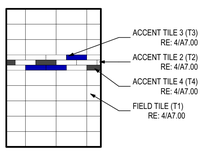


10 ROWE LANE STAFF RR 2 RR ELEVATION
SCALE: 1/4" = 1'-0"

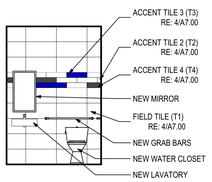


11 ROWE LANE STAFF RR 2 RR ELEVATION
SCALE: 1/4" = 1'-0"

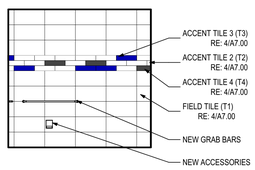


12 ROWE LANE STAFF RR 2 RR ELEVATION
SCALE: 1/4" = 1'-0"

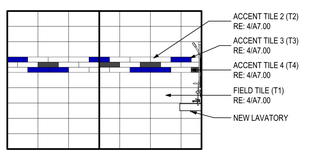


15 ROWE LANE LIFE SKILLS RR ELEVATION
SCALE: 1/4" = 1'-0"

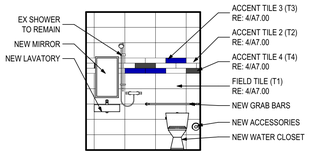


14 ROWE LANE LIFE SKILLS RR ELEVATION
SCALE: 1/4" = 1'-0"

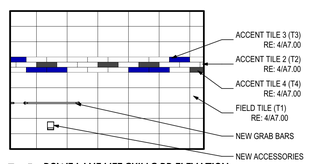


16 ROWE LANE LIFE SKILLS RR ELEVATION
SCALE: 1/4" = 1'-0"

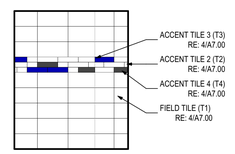


13 ROWE LANE LIFE SKILLS RR ELEVATION
SCALE: 1/4" = 1'-0"

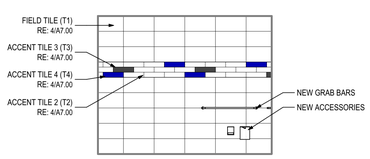


17 ROWE LANE STAFF RR 1 ELEVATION
SCALE: 1/4" = 1'-0"

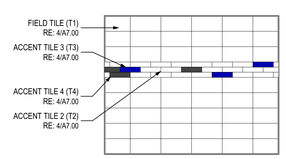


18 ROWE LANE STAFF RR 1 ELEVATION
SCALE: 1/4" = 1'-0"

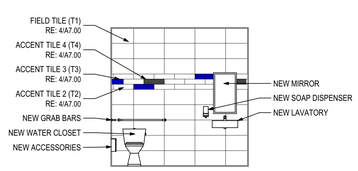

19 ROWE LANE STAFF RR 1 ELEVATION
SCALE: 1/4" = 1'-0"

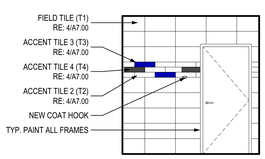

20 ROWE LANE STAFF RR 1 ELEVATION
SCALE: 1/4" = 1'-0"

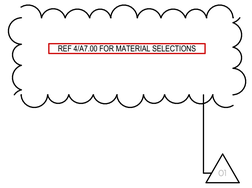

GENERAL NOTES

ALL QUANTITIES ARE APPROXIMATE AND SHOULD BE FIELD VERIFIED PRIOR TO BIDDING

CAD BACKGROUNDS PROVIDED BY DISTRICT DO NOT MATCH FIELD CONDITIONS. REFER TO ELEVATIONS FOR MEASURMENTS AND FIELD VERIFY ALL MEASURMENTS.

REFER TO SHEET A0.01 FOR ARCHITECTURAL GENERAL NOTES, MOUNTING HEIGHTS & LINTEL SCHEDULE

THE MOVING OF FURNITURE SHALL BE THE CONTRACTORS RESPONSIBILITY TO COMPLETE THEIR WORK. NO FLOORING REPLACEMENT WORK IS HAPPENING TO THE GYM FLOORING AND STAGING OF FURNITURE COULD OCCUR IN THIS SPACE AND CAFETERIA. CONTRACTOR TO PROVIDE LOGISTICS OF MOVING AND STAGING FURNITURE IN THEIR BID.

ABBREVIATIONS

RLE	ROWE LANE ELEMENTARY	DMS	DESSAU MIDDLE SCHOOL
KLMS	KELLY LANE MIDDLE SCHOOL	PMS	PFLUGERVILLE MIDDLE SCHOOL
WKRM.	WORK ROOM	TP	TOILET PAPER DISPENSER
OFF	OFFICE	GB	GRAB BARS, RE: 16/A7.07
LIB.	LIBRARY	HD	HAND DRYERS
CORR	CORRIDOR	PT	PAPER TOWEL DISPENSER
MCT	MARMOLEUM COMPOSITE TILE	SD	SOAP DISPENSER
CPT	CARPET TILE	EWC	ELECTRIC WATER COOLER
T(X)	TILE	FEC	FIRE EXTINGUISHER CABINET
LVT	LUXURY VINYL TILE	SN	SANITARY NAPKIN DISPOSAL
CT	CERAMIC TILE	TB	TACKBOARD
VCT	VINYL COMPOSITE TILE		

Reliance Architecture, LLC
12 Chisholm Trl
Round Rock , Texas 78681
Ph (512) 758-7660
www.reliancearchitecture.com

Pflugerville Independent School District
Multi-Campus Renovations- Phase 3
Pflugerville, Texas

Copyright © 2025, Reliance Architecture, LLC. All rights reserved.


Revision:
1 ADDENDUM 003 - 1.31.2025

Project Number
2407.1

Date:
1/31/2025


Sheet Number

ROWE LANE RR ELEVATIONS A4.05

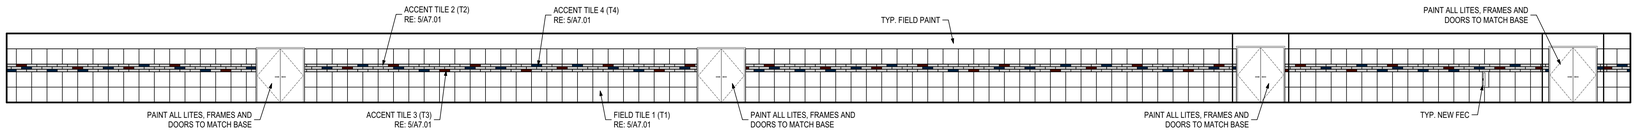


1 DESSAU FINE ARTS CORRIDOR ELEVATION

SCALE: 1/8" = 1'-0"

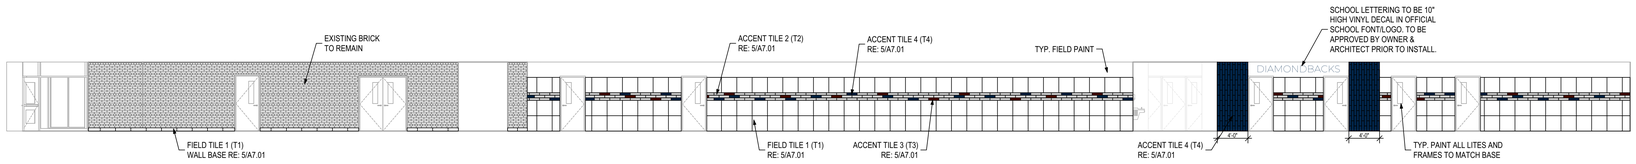


3 DESSAU FINE ARTS CORRIDOR ELEVATION

SCALE: 1/8" = 1'-0"

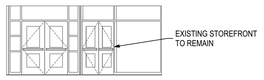


2 DESSAU FINE ARTS CORRIDOR ELEVATION

SCALE: 1/8" = 1'-0"

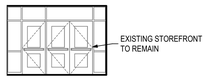


4 DESSAU FINE ARTS CORRIDOR ELEVATION

SCALE: 1/8" = 1'-0"

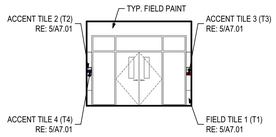


5 DESSAU CORRIDOR 4 ELEVATION

SCALE: 1/8" = 1'-0"

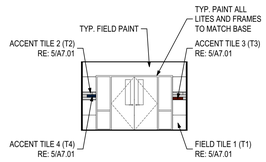


6 DESSAU CORRIDOR 4 ELEVATION

SCALE: 1/8" = 1'-0"

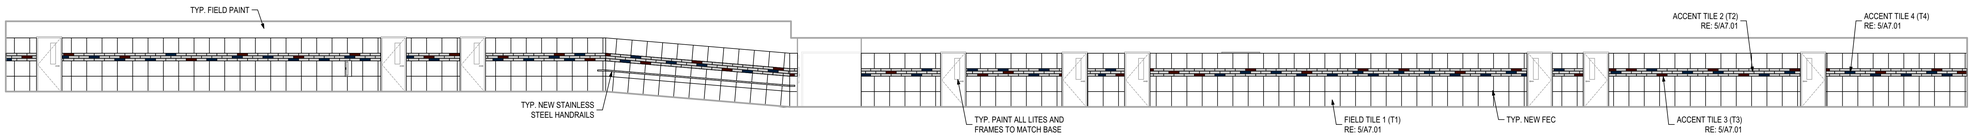

7 DESSAU CORRIDOR 4 ELEVATION

SCALE: 1/8" = 1'-0"

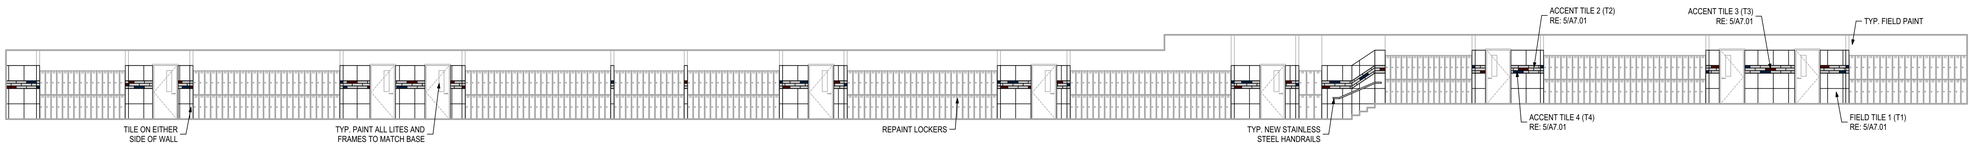

8 DESSAU CORRIDOR 4 ELEVATION

SCALE: 1/8" = 1'-0"

GENERAL NOTES

ALL QUANTITIES ARE APPROXIMATE AND SHOULD BE FIELD VERIFIED PRIOR TO BIDDING

CAD BACKGROUNDS PROVIDED BY DISTRICT DO NOT MATCH FIELD CONDITIONS. REFER TO ELEVATIONS FOR MEASURMENTS AND FIELD VERIFY ALL MEASURMENTS.

REFER TO SHEET A0.01 FOR ARCHITECTURAL GENERAL NOTES, MOUNTING HEIGHTS & LINTEL SCHEDULE

THE MOVING OF FURNITURE SHALL BE THE CONTRACTORS RESPONSIBILITY TO COMPLETE THEIR WORK. NO FLOORING REPLACEMENT WORK IS HAPPENING TO THE GYM FLOORING AND STAGING OF FURNITURE COULD OCCUR IN THIS SPACE AND CAFETERIA. CONTRACTOR TO PROVIDE LOGISTICS OF MOVING AND STAGING FURNITURE IN THEIR BID.

ABBREVIATIONS

RLE	ROWE LANE ELEMENTARY	DMS	DESSAU MIDDLE SCHOOL
KLMS	KELLY LANE MIDDLE SCHOOL	PMS	PFLUGERVILLE MIDDLE SCHOOL
WKRM.	WORK ROOM	TP	TOILET PAPER DISPENSER
OFF	OFFICE	GB	GRAB BARS, RE: 16/A7.07
LIB.	LIBRARY	HD	HAND DRYERS
CORR	CORRIDOR	PT	PAPER TOWEL DISPENSER
MCT	MARMOLEUM COMPOSITE TILE	SD	SOAP DISPENSER
CPT	CARPET TILE	EWC	ELECTRIC WATER COOLER
T(X)	TILE	FEC	FIRE EXTINGUISHER CABINET
LVT	LUXURY VINYL TILE	SN	SANITARY NAPKIN DISPOSAL
CT	CERAMIC TILE	TB	TACKBOARD
VCT	VINYL COMPOSITE TILE		

Reliance Architecture, LLC
12 Chisholm Trl
Round Rock , Texas 78681
Ph (512) 758-7660
www.reliancearchitecture.com

Pflugerville Independent School District
Multi-Campus Renovations- Phase 3
Pflugerville, Texas

Copyright © 2025, Reliance Architecture, LLC. All rights reserved

Revision:
01 ADDENDUM 003 - 1.31.2025

Project Number
2407.1

Date:
1/31/2025

Sheet Number

DESSAU CORRIDOR RENO ELEVATIONS A4.08

REF. SCHED

GENERAL NOTES

ALL QUANTITIES ARE APPROXIMATE AND SHOULD BE FIELD VERIFIED PRIOR TO BIDDING


CAD BACKGROUNDS PROVIDED BY DISTRICT DO NOT MATCH FIELD CONDITIONS. REFER TO ELEVATIONS FOR MEASURMENTS AND FIELD VERIFY ALL MEASURMENTS.

REFER TO SHEET A0.01 FOR ARCHITECTURAL GENERAL NOTES, MOUNTING HEIGHTS & LINTEL SCHEDULE


THE MOVING OF FURNITURE SHALL BE THE CONTRACTORS RESPONSIBILITY TO COMPLETE THEIR WORK. NO FLOORING REPLACEMENT WORK IS HAPPENING TO THE GYM FLOORING AND STAGING OF FURNITURE COULD OCCUR IN THIS SPACE AND CAFETERIA. CONTRACTOR TO PROVIDE LOGISTICS OF MOVING AND STAGING FURNITURE IN THEIR BID.

ABBREVIATIONS


RLE	ROWE LANE ELEMENTARY	DMS	DESSAU MIDDLE SCHOOL
KLMS	KELLY LANE MIDDLE SCHOOL	PMS	PFLUGERVILLE MIDDLE SCHOOL
WKRM.	WORK ROOM	TP	TOILET PAPER DISPENSER
OFF	OFFICE	GB	GRAB BARS, RE: 16/A7.07
LIB.	LIBRARY	HD	HAND DRYERS
CORR	CORRIDOR	PT	PAPER TOWEL DISPENSER
MCT	MARMOLEUM COMPOSITE TILE	SD	SOAP DISPENSER
CPT	CARPET TILE	EWC	ELECTRIC WATER COOLER
T(X)	TILE	FEC	FIRE EXTINGUISHER CABINET
LVT	LUXURY VINYL TILE	SN	SANITARY NAPKIN DISPOSAL
CT	CERAMIC TILE	TB	TACKBOARD
VCT	VINYL COMPOSITE TILE		

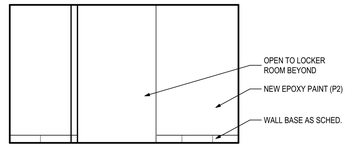


1 DMS GIRLS 2 RR ELEVATION
SCALE: 1/4" = 1'-0"

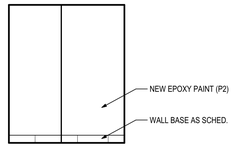


2 DMS GIRLS 2 RR ELEVATION (1)
SCALE: 1/4" = 1'-0"

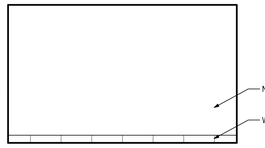


3 DMS GIRLS 2 RR ELEVATION (2)
SCALE: 1/4" = 1'-0"

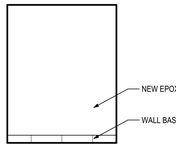


4 DMS GIRLS 2 RR ELEVATION (3)
SCALE: 1/4" = 1'-0"

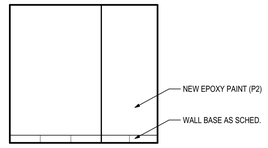


5 CAFETERIA RR ENLARGED PLAN
SCALE: 1/4" = 1'-0"

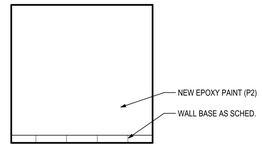


6 CAFETERIA RR ENLARGED PLAN
SCALE: 1/4" = 1'-0"

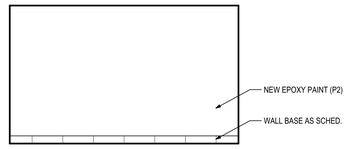


7 CAFETERIA RR ENLARGED PLAN
SCALE: 1/4" = 1'-0"

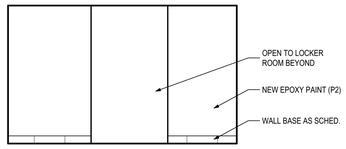


8 CAFETERIA RR ENLARGED PLAN
SCALE: 1/4" = 1'-0"

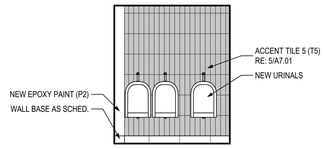


9 CAFETERIA RR ENLARGED PLAN
SCALE: 1/4" = 1'-0"

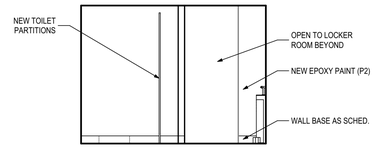


10 CAFETERIA RR ENLARGED PLAN
SCALE: 1/4" = 1'-0"

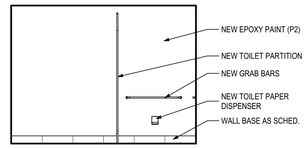


11 CAFETERIA RR ENLARGED PLAN
SCALE: 1/4" = 1'-0"

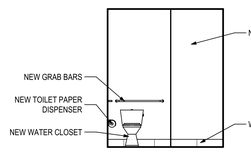


12 CAFETERIA RR ENLARGED PLAN
SCALE: 1/4" = 1'-0"

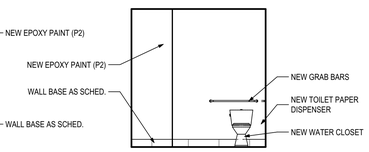


13 CAFETERIA RR ENLARGED PLAN
SCALE: 1/4" = 1'-0"

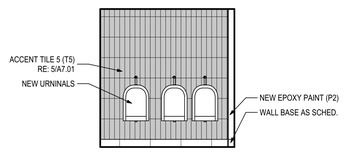


14 CAFETERIA RR ENLARGED PLAN
SCALE: 1/4" = 1'-0"

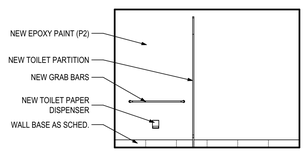


15 CAFETERIA RR ENLARGED PLAN
SCALE: 1/4" = 1'-0"

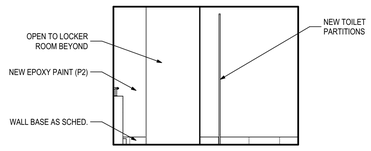


16 CAFETERIA RR ENLARGED PLAN
SCALE: 1/4" = 1'-0"

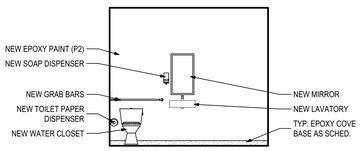


17 CAFETERIA RR ENLARGED PLAN
SCALE: 1/4" = 1'-0"

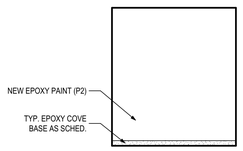


18 CAFETERIA RR ENLARGED PLAN
SCALE: 1/4" = 1'-0"

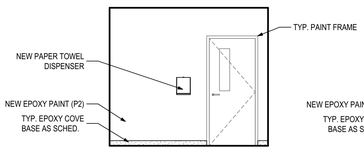


19 CAFETERIA RR ENLARGED PLAN
SCALE: 1/4" = 1'-0"

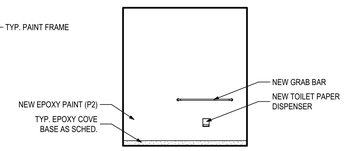


20 CAFETERIA RR ENLARGED PLAN
SCALE: 1/4" = 1'-0"

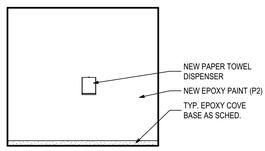


21 CAFETERIA RR ENLARGED PLAN
SCALE: 1/4" = 1'-0"

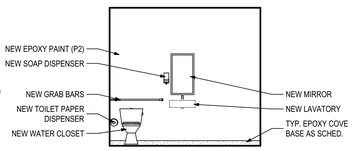


22 CAFETERIA RR ENLARGED PLAN
SCALE: 1/4" = 1'-0"

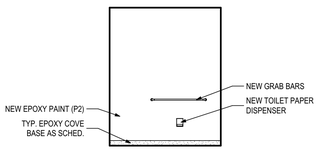


23 CAFETERIA RR ENLARGED PLAN
SCALE: 1/4" = 1'-0"

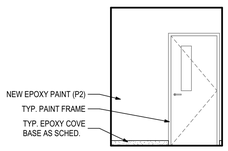


24 CAFETERIA RR ENLARGED PLAN
SCALE: 1/4" = 1'-0"

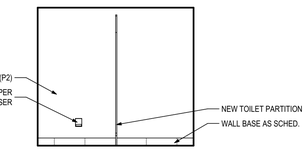


25 CAFETERIA RR ENLARGED PLAN
SCALE: 1/4" = 1'-0"

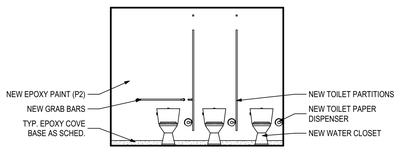

26 CAFETERIA RR ENLARGED PLAN
SCALE: 1/4" = 1'-0"

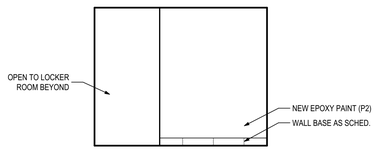

27 CAFETERIA RR ENLARGED PLAN
SCALE: 1/4" = 1'-0"

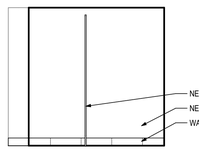

28 CAFETERIA RR ENLARGED PLAN
SCALE: 1/4" = 1'-0"

Reliance Architecture, LLC
12 Chisholm Trl
Round Rock , Texas 78681
Ph (512) 758-7660
www.reliancearchitecture.com

Pflugerville Independent School District
Multi-Campus Renovations- Phase 3
Pflugerville, Texas

Copyright © 2025, Reliance Architecture, L.L.C. All rights reserved.


Revision:
01 ADDENDUM 003 - 01.31.2025

Project Number
2407.1


Date:
1/31/2025

Sheet Number


DESSAU RR ELEVATIONS A4.13

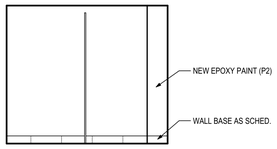


1 CAFETERIA RR ENLARGED PLAN
SCALE: 1/4" = 1'-0"

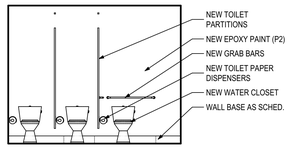


2 CAFETERIA RR ENLARGED PLAN
SCALE: 1/4" = 1'-0"

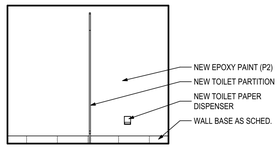


3 CAFETERIA RR ENLARGED PLAN
SCALE: 1/4" = 1'-0"

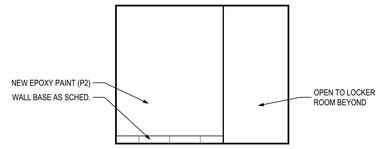


4 CAFETERIA RR ENLARGED PLAN
SCALE: 1/4" = 1'-0"

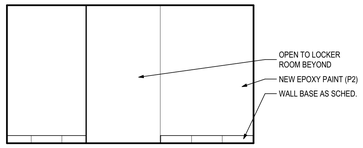


5 CAFETERIA RR ENLARGED PLAN
SCALE: 1/4" = 1'-0"

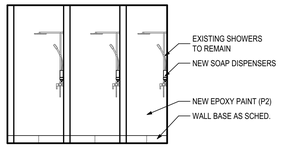


6 CAFETERIA RR ENLARGED PLAN
SCALE: 1/4" = 1'-0"

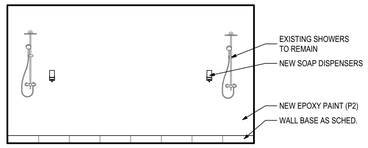


7 CAFETERIA RR ENLARGED PLAN
SCALE: 1/4" = 1'-0"

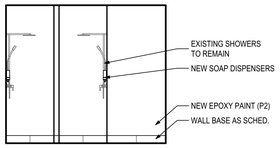


8 CAFETERIA RR ENLARGED PLAN
SCALE: 1/4" = 1'-0"

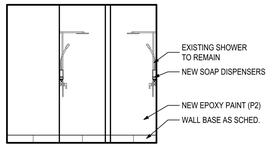


9 CAFETERIA RR ENLARGED PLAN
SCALE: 1/4" = 1'-0"

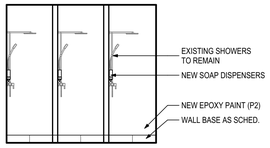

10 CAFETERIA RR ENLARGED PLAN
SCALE: 1/4" = 1'-0"

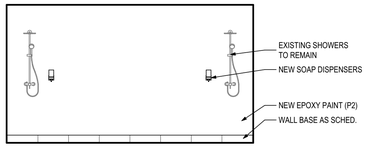

11 CAFETERIA RR ENLARGED PLAN
SCALE: 1/4" = 1'-0"

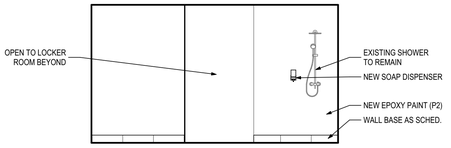

12 CAFETERIA RR ENLARGED PLAN
SCALE: 1/4" = 1'-0"

GENERAL NOTES

ALL QUANTITIES ARE APPROXIMATE AND SHOULD BE FIELD VERIFIED PRIOR TO BIDDING

CAD BACKGROUNDS PROVIDED BY DISTRICT DO NOT MATCH FIELD CONDITIONS. REFER TO ELEVATIONS FOR MEASURMENTS AND FIELD VERIFY ALL MEASURMENTS.

REFER TO SHEET A0.01 FOR ARCHITECTURAL GENERAL NOTES, MOUNTING HEIGHTS & LINTEL SCHEDULE

THE MOVING OF FURNITURE SHALL BE THE CONTRACTORS RESPONSIBILITY TO COMPLETE THEIR WORK. NO FLOORING REPLACEMENT WORK IS HAPPENING TO THE GYM FLOORING AND STAGING OF FURNITURE COULD OCCUR IN THIS SPACE AND CAFETERIA. CONTRACTOR TO PROVIDE LOGISTICS OF MOVING AND STAGING FURNITURE IN THEIR BID.

ABBREVIATIONS

RLE	ROWE LANE ELEMENTARY	DMS	DESSAU MIDDLE SCHOOL
KLMS	KELLY LANE MIDDLE SCHOOL	PMS	PFLUGERVILLE MIDDLE SCHOOL
WKRM.	WORK ROOM	TP	TOILET PAPER DISPENSER
OFF	OFFICE	GB	GRAB BARS, RE: 16/A7.07
LIB.	LIBRARY	HD	HAND DRYERS
CORR	CORRIDOR	PT	PAPER TOWEL DISPENSER
MCT	MARMOLEUM COMPOSITE TILE	SD	SOAP DISPENSER
CPT	CARPET TILE	EWC	ELECTRIC WATER COOLER
T(X)	TILE	FEC	FIRE EXTINGUISHER CABINET
LVT	LUXURY VINYL TILE	SN	SANITARY NAPKIN DISPOSAL
CT	CERAMIC TILE	TB	TACKBOARD
VCT	VINYL COMPOSITE TILE		

Reliance Architecture, LLC
12 Chisholm Trl
Round Rock , Texas 78681
Ph (512) 758-7660
www.reliancearchitecture.com

Pflugerville Independent School District
Multi-Campus Renovations- Phase 3
Pflugerville, Texas

Copyright © 2025 Reliance Architecture, LLC. All rights reserved

Revision:
01 ADDENDUM 003 - 01.31.2025

Project Number
2407.1

Date:
1/31/2025

Sheet Number
DESSAU RR ELEVATIONS A4.14

ROOM FINISH SCHEDULE - ROWE LANE

RLE ROOM FINISH SCHEDULE										
NO	NAME	FLOOR	BASE	WALLS				CEILING		COMMENTS
				NORTH	SOUTH	EAST	WEST	HT	MTL	
RLE - 01	ENTRY	LVT1, LVT2, LVT3		T1, T2, T3, T4	T1, T2, T3, T4	T1, T2, T3, T4	T1, T2, T3, T4	9'-0"	ACOUST	7, 9
RLE - 01A	VEST	WCPT	VINYL		T1, T2, T3, T4	T1, T2, T3, T4		9'-0"	ACOUST	9, 10
RLE - 02	LOBBY	EX	VINYL	PT1	PT1	PT1	PT3	9'-6"	ACOUST	
RLE - 03	OFF	EX	VINYL	PT1	PT1	PT1	PT1	9'-6"	ACOUST	
RLE - 04	OFF	EX	VINYL	PT1	PT1	PT1	PT1	9'-6"	ACOUST	
RLE - 05	OFF	EX	VINYL	PT1	PT1	PT1	PT1	9'-6"	ACOUST	
RLE - 06	NURSE	EX	VINYL	PT1	PT1	PT1	PT1	9'-6"	ACOUST	
RLE - 07	NURSE RR	T7	---	T1, T2, T3, T4	T1, T2, T3, T4	T1, T2, T3, T4	T1, T2, T3, T4	9'-0"	ACOUST	9
RLE - 08	OFF	EX	VINYL	PT1	PT1	PT1	PT1	9'-6"	ACOUST	
RLE - 09	STOR	EX	VINYL	PT1	PT1	PT1	PT1	9'-6"	ACOUST	
RLE - 10	COUNSELOR	---	---	---	---	---	---	9'-0"	ACOUST	NOT IN SCOPE
RLE - 11	RECORDS	---	---	---	---	---	---	9'-0"	ACOUST	NOT IN SCOPE
RLE - 12	BOOK STOR	---	---	---	---	---	---	9'-0"	ACOUST	NOT IN SCOPE
RLE - 13	WORKROOM	EX	VINYL	PT1	PT1	PT1	PT3	10'-0"	ACOUST	
RLE - 14	BREAKROOM	EX	VINYL	PT1	PT1	PT1	PT3	10'-0"	ACOUST	
RLE - 15	STAFF RR 2	T7		T1, T2, T3, T4	T1, T2, T3, T4	T1, T2, T3, T4	T1, T2, T3, T4	9'-0"	ACOUST	9
RLE - 16	STAFF RR 1	T7		T1, T2, T3, T4	T1, T2, T3, T4	T1, T2, T3, T4	T1, T2, T3, T4	9'-0"	ACOUST	9
RLE - 17	BOYS MAIN RR	T7		T1, T2, T3, T4	T1, T2, T3, T4	T1, T2, T3, T4	T1, T2, T3, T4	9'-0"	ACOUST	9
RLE - 18	GIRLS MAIN RR	T7		T1, T2, T3, T4	T1, T2, T3, T4	T1, T2, T3, T4	T1, T2, T3, T4	9'-0"	ACOUST	9
RLE - 19	MAIN RR VEST	T7		T3, T5	T3, T5	T2, T3, T4, T5	T2, T3, T4, T5	9'-0"	ACOUST	9
RLE - 20	ART	LVT1	VINYL	PT1	PT1	PT1	PT1	9'-0"	ACOUST	
RLE - 21	SCIENCE	LVT1	VINYL	PT1	PT1	PT1	PT1	9'-0"	ACOUST	
RLE - 22	GYM	EX	VENT	RB				9'-0"	ACOUST	11
RLE - 23	STOR	EX	VINYL	PT2	PT2	PT2	PT2	9'-0"	ACOUST	
RLE - 24	OFF	LVT1	VINYL	PT1	PT1	PT1	PT1	9'-0"	ACOUST	
RLE - 25	STOR	LVT1	VINYL	PT1	PT1	PT1	PT1	9'-0"	ACOUST	
RLE - 26	MUSIC ROOM	CPT	VINYL	PT1	PT1	PT1	PT2	9'-0"	ACOUST	5
RLE - 27	MUSIC STEPS	CPT	VINYL	PT1	PT1	PT1	PT2	9'-0"	ACOUST	
RLE - 28	STAGE CORR	LVT2	VINYL	PT5	PT5	PT5	PT5	9'-0"	ACOUST	
RLE - 29	STOR	LVT1	VINYL	PT1	PT1	PT1	PT1	9'-0"	ACOUST	
RLE - 30	ELEC	---	---	---	---	---	---	9'-0"	ACOUST	NOT IN SCOPE
RLE - 31	CUST	EX	VINYL	EPOXY PT1	EPOXY PT1	EPOXY PT1	EPOXY PT1	9'-0"	ACOUST	3
RLE - 31	STAFF RR	T7	---	T1, T2, T3, T4	T1, T2, T3, T4	T1, T2, T3, T4	T1, T2, T3, T4	9'-0"	ACOUST	9
RLE - 32	STAGE	---	---	PT5		PT5	PT5	9'-0"	ACOUST	
RLE - 33	STOR	LVT1	VINYL	EPOXY PT1	EPOXY PT1	EPOXY PT1	EPOXY PT1	9'-0"	ACOUST	
RLE - 34	CAFETERIA	LVT1, LVT2, LVT3		T1, T2, T3, T4	T1, T2, T3, T4	T1, T2, T3, T4	T1, T2, T3, T4	26'-0"	ACOUST	9
RLE - 35	KITCHEN	---	---	---	---	---	---	9'-0"	ACOUST	NOT IN SCOPE
RLE - 36	SERVING LINE	T7		T1, T8, T9, T10, T11, T12	T1, T8, T9, T10, T11, T12	T1, T8, T9, T10, T11, T12	T1, T8, T9, T10, T11, T12	9'-0"	ACOUST	9
RLE - 37	MAIN CORRIDOR	LVT1, LVT2, LVT3		T1, T2, T3, T4	T1, T2, T3, T4	T1, T2, T3, T4	T1, T2, T3, T4	9'-0"	ACOUST	4, 9
RLE - 38	CORRIDOR 1	LVT1, LVT2, LVT3		T1, T2, T3, T4	T1, T2, T3, T4	T1, T2, T3, T4	T1, T2, T3, T4	9'-0"	ACOUST	4, 9
RLE - 39	CORRIDOR 2	LVT1, LVT2, LVT3		T1, T2, T3, T4	T1, T2, T3, T4	T1, T2, T3, T4	T1, T2, T3, T4	9'-0"	ACOUST	4, 9
RLE - 40	CORRIDOR 3	LVT1, LVT2, LVT3		T1, T2, T3, T4	T1, T2, T3, T4	T1, T2, T3, T4	T1, T2, T3, T4	9'-0"	ACOUST	4, 9
RLE - 41	CORRIDOR 4	LVT1, LVT2, LVT3		T1, T2, T3, T4	T1, T2, T3, T4	T1, T2, T3, T4	T1, T2, T3, T4	9'-0"	ACOUST	4, 9
RLE - 42	LIBRARY	CPT 1	VINYL	PT3	PT1	PT1	PT1	9'-0"	ACOUST	5
RLE - 43	LIBRARY OFF	LVT2	VINYL	PT1	PT1	PT1	PT1	9'-0"	ACOUST	
RLE - 44	LIBRARY STOR	LVT2	VINYL	PT1	PT1	PT1	PT1	9'-0"	ACOUST	
RLE - 100	RESOURCE	LVT2	VINYL	PT1	PT1	PT1	PT1	9'-0"	ACOUST	
RLE - 101	STOR	LVT2	VINYL	PT1	PT1	PT1	PT1	9'-0"	ACOUST	
RLE - 102	VEST1	T7		T2, T3, T4, T5	T2, T3, T4, T5	T3, T5	T3, T5	9'-0"	ACOUST	9
RLE - 103	GIRLS 1 RR	T7		T1, T2, T3, T4	T1, T2, T3, T4	T1, T2, T3, T4	T1, T2, T3, T4	9'-0"	ACOUST	9
RLE - 104	BOYS 1 RR	T7		T1, T2, T3, T4	T1, T2, T3, T4	T1, T2, T3, T4	T1, T2, T3, T4	9'-0"	ACOUST	9
RLE - 105	CLASSROOM	LVT2	VINYL	PT2	PT1	PT1	PT1	9'-0"	ACOUST	5
RLE - 106	STOR	LVT2	VINYL	PT1	PT1	PT1	PT1	9'-0"	ACOUST	
RLE - 107	STOR	LVT2	VINYL	PT1	PT1	PT1	PT1	9'-0"	ACOUST	
RLE - 108	CLASSROOM	LVT2	VINYL	PT2	PT1	PT1	PT1	9'-0"	ACOUST	5
RLE - 108A	RR	T7	T7	EX	EX	EX	EX	9'-0"	ACOUST	
RLE - 109	CLASSROOM	LVT2	VINYL	PT2	PT1	PT1	PT1	9'-0"	ACOUST	5
RLE - 110	STOR	LVT2	VINYL	PT1	PT1	PT1	PT1	9'-0"	ACOUST	
RLE - 111	STOR	LVT2	VINYL	PT1	PT1	PT1	PT1	9'-0"	ACOUST	
RLE - 112	CLASSROOM	LVT2	VINYL	PT2	PT1	PT1	PT1	9'-0"	ACOUST	5
RLE - 113	CLASSROOM	LVT1	VINYL	PT1	PT2	PT1	PT1	9'-0"	ACOUST	5
RLE - 114	STOR	LVT1	VINYL	PT1	PT1	PT1	PT1	9'-0"	ACOUST	
RLE - 115	STOR	LVT1	VINYL	PT1	PT1	PT1	PT1	9'-0"	ACOUST	
RLE - 116	CLASSROOM	LVT1	VINYL	PT1	PT2	PT1	PT1	9'-0"	ACOUST	5
RLE - 117	CLASSROOM	LVT1	VINYL	PT1	PT2	PT1	PT1	9'-0"	ACOUST	5
RLE - 118	STOR	LVT1	VINYL	PT1	PT1	PT1	PT1	9'-0"	ACOUST	
RLE - 119	STOR	LVT1	VINYL	PT1	PT1	PT1	PT1	9'-0"	ACOUST	
RLE - 120	OFF	--	--	--	--	--	--	9'-0"	ACOUST	NOT IN SCOPE
RLE - 121	CLASSROOM	LVT1	VINYL	PT1	PT2	PT1	PT1	9'-0"	ACOUST	5
RLE - 122	CLASSROOM	LVT1	VINYL	PT1	PT2	PT1	PT1	9'-0"	ACOUST	5
RLE - 200	CLASSROOM	LVT2	VINYL	PT2	PT1	PT1	PT1	9'-0"	ACOUST	5
RLE - 201	LIFE SKILLS RR	T7		T1, T2, T3, T4	T1, T2, T3, T4	T1, T2, T3, T4	T1, T2, T3, T4	9'-0"	ACOUST	9
RLE - 202	STOR	LVT2	VINYL	PT1	PT1	PT1	PT1	9'-0"	ACOUST	
RLE - 203	CLASSROOM	LVT2	VINYL	PT2	PT1	PT1	PT1	9'-0"	ACOUST	5
RLE - 204	CLASSROOM	LVT2	VINYL	PT2	PT1	PT1	PT1	9'-0"	ACOUST	5
RLE - 205	CLASSROOM	LVT2	VINYL	PT2	PT1	PT1	PT1	9'-0"	ACOUST	5
RLE - 206	CLASSROOM	LVT2	VINYL	PT2	PT1	PT1	PT1	9'-0"	ACOUST	5
RLE - 207	CLASSROOM	LVT2	VINYL	PT2	PT1	PT1	PT1	9'-0"	ACOUST	5
RLE - 208	CLASSROOM	LVT1	VINYL	PT1	PT2	PT1	PT1	9'-0"	ACOUST	5
RLE - 209	CLASSROOM	LVT1	VINYL	PT1	PT2	PT1	PT1	9'-0"	ACOUST	5
RLE - 210	CLASSROOM	LVT1	VINYL	PT1	PT2	PT1	PT1	9'-0"	ACOUST	5
RLE - 211	CLASSROOM	LVT1	VINYL	PT1	PT2	PT1	PT1	9'-0"	ACOUST	5
RLE - 212	CLASSROOM	LVT1	VINYL	PT1	PT2	PT1	PT1	9'-0"	ACOUST	5
RLE - 213	STOR	LVT1	VINYL	PT1	PT1	PT1	PT1	9'-0"	ACOUST	
RLE - 214	OFF	LVT1	VINYL	PT1	PT1	PT1	PT1	9'-0"	ACOUST	
RLE - 215	CLASSROOM	LVT1	VINYL	PT1	PT2	PT1	PT1	9'-0"	ACOUST	5
RLE - 300	VEST 3	T7		T2, T3, T4, T5	T2, T3, T4, T5	T3, T5	T3, T5	9'-0"	ACOUST	9
RLE - 301	GIRLS 3 RR	T7		T1, T2, T3, T4	T1, T2, T3, T4	T1, T2, T3, T4	T1, T2, T3, T4	9'-0"	ACOUST	9
RLE - 302	BOYS 3 RR	T7		T1, T2, T3, T4	T1, T2, T3, T4	T1, T2, T3, T4	T1, T2, T3, T4	9'-0"	ACOUST	9
RLE - 303	CLASSROOM	LVT1	VINYL	PT2	PT1	PT1	PT1	9'-0"	ACOUST	5
RLE - 304	CLASSROOM	LVT1	VINYL	PT2	PT1	PT1	PT1	9'-0"	ACOUST	5
RLE - 305	CLASSROOM	LVT1	VINYL	PT2	PT1	PT1	PT1	9'-0"	ACOUST	5
RLE - 306	CLASSROOM	LVT1	VINYL	PT2	PT1	PT1	PT1	9'-0"	ACOUST	5
RLE - 307	CLASSROOM	LVT1	VINYL	PT2	PT1	PT1	PT1	9'-0"	ACOUST	5
RLE - 308	CLASSROOM	LVT2	VINYL	PT1	PT2	PT1	PT1	9'-0"	ACOUST	5
RLE - 309	CLASSROOM	LVT2	VINYL	PT1	PT2	PT1	PT1	9'-0"	ACOUST	5
RLE - 310	CLASSROOM	LVT2	VINYL	PT1	PT2	PT1	PT1	9'-0"	ACOUST	5
RLE - 311	CLASSROOM	LVT2	VINYL	PT1	PT2	PT1	PT1	9'-0"	ACOUST	5
RLE - 312	RESOURCE	LVT2	VINYL	PT1	PT2	PT1	PT1	9'-0"	ACOUST	5
RLE - 313	COMPUTER LAB	LVT2	VINYL	PT1	PT2	PT1	PT1	9'-0"	ACOUST	5
RLE - 400	STOR	LVT1	VINYL	PT1	PT1	PT1	PT1	9'-0"	ACOUST	
RLE - 401	DATA	---	---	---	---	---	---	9'-0"	ACOUST	NOT IN SCOPE
RLE - 402	ELEC	---	---	---	---	---	---	9'-0"	ACOUST	NOT IN SCOPE
RLE - 403	CUSTODIAN	---	---	---	---	---	---	9'-0"	ACOUST	NOT IN SCOPE
RLE - 404	CLASSROOM	LVT1	VINYL	PT2	PT1	PT1	PT1	9'-0"	ACOUST	5
RLE - 405	CLASSROOM	LVT1	VINYL	PT2	PT1	PT1	PT1	9'-0"	ACOUST	5
RLE - 406	CLASSROOM	LVT1	VINYL	PT2	PT1	PT1	PT1	9'-0"	ACOUST	5
RLE - 407	CLASSROOM	LVT1	VINYL	PT2	PT1	PT1	PT1	9'-0"	ACOUST	5
RLE - 408	CLASSROOM	LVT1	VINYL	PT2	PT1	PT1	PT1	9'-0"	ACOUST	5
RLE - 409	CLASSROOM	LVT1	VINYL	PT2	PT1	PT1	PT1	9'-0"	ACOUST	5
RLE - 410	CLASSROOM	LVT2	VINYL	PT1	PT2	PT1	PT1	9'-0"	ACOUST	5
RLE - 411	CLASSROOM	LVT2	VINYL	PT1	PT2	PT1	PT1	9'-0"	ACOUST	5
RLE - 412	CLASSROOM	LVT2	VINYL	PT1	PT2	PT1	PT1	9'-0"	ACOUST	5
RLE - 413	CLASSROOM	LVT2	VINYL	PT1	PT2	PT1	PT1	9'-0"	ACOUST	5
RLE - 414	CLASSROOM	LVT2	VINYL	PT1	PT2	PT1	PT1	9'-0"	ACOUST	5
RLE - 415	CLASSROOM	LVT2	VINYL	PT1	PT2	PT1	PT1	9'-0"	ACOUST	5

NOTE: ALL DOORS IN FIRE OR SOUND RATED PARTITIONS SHALL BE RATED IN ACCORDANCE WITH THE REQUIREMENTS OF THE ASSEMBLY.

OPENING DETAILS REF A7.02 & A7.03

ROOM FINISH SCHEDULE LEGEND:

ACOUST - 24"x24" ACOUSTICAL LAY-IN TILE
OPEN - OPEN TO ABOVE
CPT - 24"x24" CARPET TILE
WCPT - WALK OFF CARPET
VENT - VENTILATED WALL BASE
EXP - EXPOSED TO BOTTOM OF STRUCTURE
EX - EXISTING TO REMAIN
GYP - PT. GYPSUM WALL BOARD
PT - PAINTED
VINYL - VINYL WALL BASE
CT - CERAMIC TILE
T(#) - TILE
RB - RUBBER STAIR TREAD
REFINISH - REFINISH

ROOM FINISH SCHEDULE COMMENTS:
(1) AT WALLS PROVIDE 7'-2" HT CERAMIC TILE WAINSCOT. TOP TILE WITH SCHLUTER TRIM.
(2) ACCENT COLOR ON WALL AND CEILING ABOVE LIGHTING/CLOUDS/BAFFLES LEVEL.
(3) PROVIDE 4'H CERAMIC TILE WAINSCOT ON BOTH WALLS AT THE MOP SINK.
(4) PROVIDE FULL HEIGHT CERAMIC TILE WAINSCOT AT DRINKING FOUNTAINS
(5) ACCENT COLOR FOR PROJECTOR WALL. ACCENT WALL MAY VARY BASED ON LOCATION IN FIELD.
(6) ACCENT COLOR FOR THE EXPOSED STRUCTURE, PIPING, CONDUIT, ECT.
(7) 7' x 6' WALK OFF CARPET FLOORING AREA AT EXTERIOR EXIT.
(8) SEE RCP FOR CEILING MATERIALS & HEIGHTS
(9) REFER TO ELEVATIONS FOR TILE DESIGNS
(10) EX CURTAIN WALL IS TO REMAIN
(11) RUBBER STAIR TREAD TO COVER CONCRETE BENCH ON NORTH WALL

ROOM FINISH NOTES:
A. REFER TO 6/A7.07, 7/A7.07 FOR FLOOR TRANSITIONS

GENERAL NOTES

ALL QUANTITIES ARE APPROXIMATE AND SHOULD BE FIELD VERIFIED PRIOR TO BIDDING

CAD BACKGROUNDS PROVIDED BY DISTRICT DO NOT MATCH FIELD CONDITIONS. REFER TO ELEVATIONS FOR MEASURMENTS AND FIELD VERIFY ALL MEASURMENTS.

REFER TO SHEET A0.01 FOR ARCHITECTURAL GENERAL NOTES, MOUNTING HEIGHTS & LINTEL SCHEDULE

THE MOVING OF FURNITURE SHALL BE THE CONTRACTORS RESPONSIBILITY TO COMPLETE THEIR WORK. NO FLOORING REPLACEMENT WORK IS HAPPENING TO THE GYM FLOORING AND STAGING OF FURNITURE COULD OCCUR IN THIS SPACE AND CAFETERIA. CONTRACTOR TO PROVIDE LOGISTICS OF MOVING AND STAGING FURNITURE IN THEIR BID.

ABBREVIATIONS

RLE	ROWE LANE ELEMENTARY	DMS	DESSAU MIDDLE SCHOOL
KLMS	KELLY LANE MIDDLE SCHOOL	PMS	PFLUGERVILLE MIDDLE SCHOOL
WKRM.	WORK ROOM	TP	TOILET PAPER DISPENSER
OFF	OFFICE	GB	GRAB BARS, RE: 16/A7.07
LIB.	LIBRARY	HD	HAND DRYERS
CORR	CORRIDOR	PT	PAPER TOWEL DISPENSER
MCT	MARMOLEUM COMPOSITE TILE	SD	SOAP DISPENSER
CPT	CARPET TILE	EWC	ELECTRIC WATER COOLER
T(X)	TILE	FEC	FIRE EXTINGUISHER CABINET
LVT	LUXURY VINYL TILE	SN	SANITARY NAPKIN DISPOSAL
CT	CERAMIC TILE	TB	TACKBOARD
VCT	VINYL COMPOSITE TILE		

	Location	Material	Manufacturer	Line	Size	Color
LVT 1	Corridors and Classroom	Luxury Vinyl Tile	Tarkett	Event + Abstract	18"x18"	Silfstone 11187
LVT 2	Cooridors and Classrooms	Luxury Vinyl Tile	Tarkett	Event + Abstract	18"x18"	Onyx 11189
LVT 3	Colored Accent in Corridors	Luxury Vinyl Tile	Tarkett	Event + Abstract	18"x18"	Hydra 11179
RUBBER	Gym Bench	Rubber	Johnsonite	Color Splash Treads		Gorge Area VF5
CPT	Library and Music Room	Carpet Tile	Tarkett	Powerbond		Custom Color: 1152849581120
WCPT	Front and Side Entries	Walk off Surface	Tarkett	Abrasive Action II	2' x 2'	Charcoal 19100
VINYL	Rubber Base	Thermoplastic Rubber	Roppe	700 Series	4" H x 120' L Roll	123 - Charcoal
T1	Field Tile	Ceramic Tile	American Olean	Theoretical	24" x 24"	TH95 - Logical Gray
T2	Accent Tile 2	Ceramic Tile	American Olean	Color Story Wall	4" x 16"	0025 - Ice White
T3	Accent Tile 3	Ceramic Tile	American Olean	Color Story Wall	4" x 16"	0117 - Navy
T4	Accent Tile 4	Ceramic Tile	American Olean	Color Story Wall	4" x 16"	0006 - Shadow
T5	RR Vest Field Wall Tile	Ceramic Tile	American Olean	Color Story Wall	4" x 16"	0014 - Balance
T6	Accent Tile 6	Ceramic Tile	American Olean	Color Story Wall	4" x 16"	0061 - Matte Designer White
T7	Restroom Flooring in its entirety	Ceramic Tile	American Olean	Theoretical	12" x 24"	TH96 - Creative Gray
T8	Accent Tile	Ceramic Tile	American Olean	Color Story Wall	4"x16"	0077 - Mandarin
T9	Accent Tile	Ceramic Tile	American Olean	Color Story Wall	4"x16"	0075 - Lemon Zest
T10	Accent Tile	Ceramic Tile	American Olean	Color Story Wall	4"x16"	0076 - Green Apple
T11	Accent Tile	Ceramic Tile	American Olean	Color Story Wall	4"x16"	0084 - Peacock Blue
T12	Accent Tile	Ceramic Tile	American Olean	Color Story Wall	4"x16"	0010 - Scarlet
P1	Field	Paint	Sherwin Williams			SW 7009 - Pearly White
P2	Accent 2	Paint	Sherwin Williams			SW 7650 - Ellie Gray
P3	Accent 3	Paint	Sherwin Williams			SW 9178 - In the Navy
P4	Accent 4	Paint	Sherwin Williams			SW 7674 - Peppercorn
P5	Accent 5	Paint	Sherwin Williams			SW 6258 - Tricorn Black
PLAM	Countertops and Window Sills	Plastic Laminate	Wilsonart	RECOVER		Steel Mesh - 4879
TB	Corridors	Tackboard	Forbo		4' x 92' Roll	Poppy Seed 2204

4 ROWE LANE MATERIAL SELECTIONS
SCALE: 1" = 1'-0"

Reliance Architecture, LLC
12 Chisholm Trl
Round Rock , Texas 78681
Ph (512) 758-7660
www.reliancearchitecture.com

Pflugerville Independent School District
Multi-Campus Renovations- Phase 3
Pflugerville, Texas

Copyright © 2025, Reliance Architecture, LLC. All rights reserved.

Revision:
1 ADDENDUM 003 - 1.31.2025

Project Number
2407.1

Date:
1/31/2025

Sheet Number
A7.00

ROWE LANE SCHEDULES

ROOM SIGNAGE SCHEDULE RLE					
NO	NAME	TYPE	QTY	OWNER DESIGNATION (Room Name)	COMMENTS
RLE - 01	ENTRY				NO SIGNAGE NEEDED
RLE - 01A	VEST	E	1		
RLE - 02	LOBBY	B	3	LOBBY	
RLE - 03	OFF	A	1	OFFICE	
RLE - 04	OFF	A	1	OFFICE	
RLE - 05	OFF	A	1	OFFICE	
RLE - 06	NURSE	A	2	NURSE	
RLE - 07	NURSE RR	D	1	RESTROOM	
RLE - 08	OFF	A	1	OFFICE	
RLE - 09	STOR	B	1	STORAGE	
RLE - 10	COUNSELOR	A	1	COUNSELOR	
RLE - 11	RECORDS	B	1	RECORDS	
RLE - 12	BOOK STOR	B	1	BOOK STORAGE	
RLE - 13	WORKROOM	B	1	WORKROOM	
RLE - 14	BREAKROOM	B	1	BREAKROOM	
RLE - 15	STAFF RR 2	D	1	RESTROOM	
RLE - 16	STAFF RR 1	D	1	RESTROOM	
RLE - 17	BOYS MAIN RR	D	1	BOYS	
RLE - 18	GIRLS MAIN RR	D	1	GIRLS	
RLE - 19	MAIN RR VEST	D	1	CONFERENCE	
RLE - 20	ART	B	1	ART	
RLE - 21	SCIENCE	B	1	SCIENCE	
RLE - 22	GYM	B	1	GYM	
RLE - 23	STOR	B	1	STORAGE	
RLE - 24	OFF	A	1	OFFICE	
RLE - 25	STOR				NO SIGNAGE NEEDED
RLE - 26	MUSIC ROOM	B	1	MUSIC	
RLE - 27	MUSIC STEPS				NO SIGNAGE NEEDED
RLE - 28	STAGE CORR	C	1	STAGE	
RLE - 29	STOR	B	1	STORAGE	
RLE - 30	ELEC	B	1	ELECTRICAL	
RLE - 31	CUST	B	1	CUSTODIAL	
RLE - 31	STAFF RR	D	1	STAFF RESTROOM	
RLE - 32	STAGE				NO SIGNAGE NEEDED
RLE - 33	STOR	B	1	STORAGE	
RLE - 34	CAFETERIA	B	2	CAFETERIA	
RLE - 35	KITCHEN			NO SIGNAGE NEEDED	
RLE - 36	SERVING LINE	B	1	SERVING LINE	
RLE - 37	MAIN CORRIDOR				NO SIGNAGE NEEDED
RLE - 38	CORRIDOR 1				NO SIGNAGE NEEDED
RLE - 39	CORRIDOR 2				NO SIGNAGE NEEDED
RLE - 40	CORRIDOR 3				NO SIGNAGE NEEDED
RLE - 41	CORRIDOR 4				NO SIGNAGE NEEDED
RLE - 42	LIBRARY	B	1	LIBRARY MEDIA CENTER	
RLE - 43	LIBRARY OFF	A	1	LIBRARIAN	
RLE - 44	LIBRARY STOR	B	1	MEDIA STORAGE	
RLE - 100	RESOURCE	A	1	RESOURCE	
RLE - 101	STOR	B	1	STORAGE	
RLE - 102	VEST1				NO SIGNAGE NEEDED
RLE - 103	GIRLS 1 RR	D	1	GIRLS	
RLE - 104	BOYS 1 RR	D	1	BOYS	
RLE - 105	CLASSROOM	B	1	105	
RLE - 106	STOR			NO SIGNAGE NEEDED	
RLE - 107	STOR			NO SIGNAGE NEEDED	
RLE - 108	CLASSROOM	B	1	107	
RLE - 108A	RR	B	1	107	
RLE - 109	CLASSROOM	B	1	105	
RLE - 110	STOR			NO SIGNAGE NEEDED	
RLE - 111	STOR			NO SIGNAGE NEEDED	
RLE - 112	CLASSROOM	B	1	107	
RLE - 113	CLASSROOM	B	1	112	
RLE - 114	STOR			NO SIGNAGE NEEDED	
RLE - 115	STOR			NO SIGNAGE NEEDED	
RLE - 116	CLASSROOM	B	1	110	
RLE - 117	CLASSROOM	B	1	108	
RLE - 118	STOR			NO SIGNAGE NEEDED	
RLE - 119	STOR			NO SIGNAGE NEEDED	
RLE - 120	OFF	B	1	ZEN DEN	
RLE - 121	CLASSROOM	B	1	108	
RLE - 122	CLASSROOM	B	1		
RLE - 200	CLASSROOM	B	1	201	
RLE - 201	LIFE SKILLS RR				NO SIGNAGE NEEDED
RLE - 202	STOR				NO SIGNAGE NEEDED
RLE - 203	CLASSROOM	B	1	203	
RLE - 204	CLASSROOM	B	1	203	
RLE - 205	CLASSROOM	B	1	203	
RLE - 206	CLASSROOM	B	1	203	
RLE - 207	CLASSROOM	B	1	203	
RLE - 208	CLASSROOM	B	1	212	
RLE - 209	CLASSROOM	B	1	212	
RLE - 209	CLASSROOM	B	1	212	
RLE - 210	CLASSROOM	B	1	210	
RLE - 211	CLASSROOM	B	1	208	
RLE - 212	CLASSROOM	B	1	206	
RLE - 213	STOR	C	1	STORAGE	
RLE - 214	OFF	B	1	214	
RLE - 215	CLASSROOM	B	1	206	
RLE - 300	VEST 3				NO SIGNAGE NEEDED
RLE - 301	GIRLS 3 RR	D	1	GIRLS	
RLE - 302	BOYS 3 RR	D	1	BOYS	
RLE - 303	CLASSROOM	B	1	305	
RLE - 304	CLASSROOM	B	1	305	
RLE - 305	CLASSROOM	B	1	305	
RLE - 306	CLASSROOM	B	1	309	
RLE - 307	CLASSROOM	B	1	311	
RLE - 308	CLASSROOM	B	1	312	
RLE - 309	CLASSROOM	B	1	310	
RLE - 310	CLASSROOM	B	1	308	
RLE - 311	CLASSROOM	B	1	306	
RLE - 312	RESOURCE	B	1	306	
RLE - 313	COMPUTER LAB	B	1	302 COMPUTER LAB	
RLE - 400	STOR	B	1	STORAGE	
RLE - 401	DATA	B	1	DATA	
RLE - 402	ELEC	B	1	ELECTRICAL	
RLE - 403	CUSTODIAN	B	1	CUSTODIAL	
RLE - 404	CLASSROOM	B	1	403	
RLE - 405	CLASSROOM	B	1	405	
RLE - 406	CLASSROOM	B	1	407	
RLE - 407	CLASSROOM	B	1	409	
RLE - 408	CLASSROOM	B	1	409	
RLE - 409	CLASSROOM	B	1	409	
RLE - 410	CLASSROOM	B	1	408	
RLE - 411	CLASSROOM	B	1	408	
RLE - 412	CLASSROOM	B	1	408	
RLE - 413	CLASSROOM	B	1	406	
RLE - 414	CLASSROOM	B	1	404	
RLE - 415	CLASSROOM	B	1	402	

1 ROOM SIGNAGE SCHEDULE RLE
SCALE: 1" = 1'-0"

GENERAL NOTES

ALL QUANTITIES ARE APPROXIMATE AND SHOULD BE FIELD VERIFIED PRIOR TO BIDDING


CAD BACKGROUNDS PROVIDED BY DISTRICT DO NOT MATCH FIELD CONDITIONS. REFER TO ELEVATIONS FOR MEASURMENTS AND FIELD VERIFY ALL MEASURMENTS.

REFER TO SHEET A0.01 FOR ARCHITECTURAL GENERAL NOTES, MOUNTING HEIGHTS & LINTEL SCHEDULE

THE MOVING OF FURNITURE SHALL BE THE CONTRACTORS RESPONSIBILITY TO COMPLETE THEIR WORK. NO FLOORING REPLACEMENT WORK IS HAPPENING TO THE GYM FLOORING AND STAGING OF FURNITURE COULD OCCUR IN THIS SPACE AND CAFETERIA. CONTRACTOR TO PROVIDE LOGISTICS OF MOVING AND STAGING FURNITURE IN THEIR BID.

ABBREVIATIONS

RLE	ROWE LANE ELEMENTARY	DMS	DESSAU MIDDLE SCHOOL
KLMS	KELLY LANE MIDDLE SCHOOL	PMS	PFLUGERVILLE MIDDLE SCHOOL
WKRM.	WORK ROOM	TP	TOILET PAPER DISPENSER
OFF	OFFICE	GB	GRAB BARS, RE: 16/A7.07
LIB.	LIBRARY	HD	HAND DRYERS
CORR	CORRIDOR	PT	PAPER TOWEL DISPENSER
MCT	MARMOLEUM COMPOSITE TILE	SD	SOAP DISPENSER
CPT	CARPET TILE	EWC	ELECTRIC WATER COOLER
T(X)	TILE	FEC	FIRE EXTINGUISHER CABINET
LVT	LUXURY VINYL TILE	SN	SANITARY NAPKIN DISPOSAL
CT	CERAMIC TILE	TB	TACKBOARD
VCT	VINYL COMPOSITE TILE		

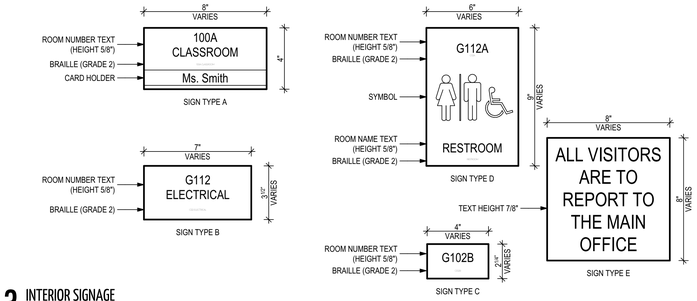

3 INTERIOR SIGNAGE
SCALE: 3" = 1'-0"

Reliance Architecture, LLC
12 Chisholm Trl
Round Rock , Texas 78681
Ph (512) 758-7660
www.reliancearchitecture.com

Pflugerville Independent School District
Multi-Campus Renovations- Phase 3
Pflugerville, Texas

Copyright © 2025 Reliance Architecture, LLC. All rights reserved.


Revision:
01 ADDENDUM 003 - 1.31.2025

Project Number
2407.1


Date:
1/31/2025

Sheet Number


ROWE LANE SIGNAGE SCHEDULE A7.03

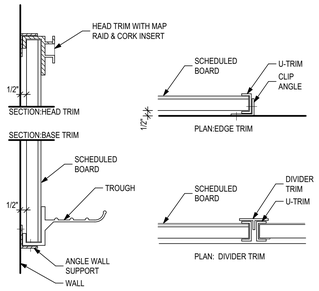


1 MARKER BOARD
SCALE: 1 1/2" = 1'-0"

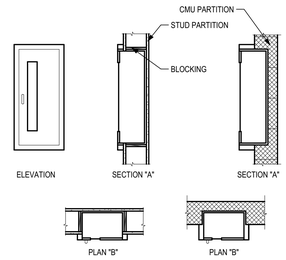


2 FIRE EXTINGUISHER CABINET
SCALE: 3/4" = 1'-0"

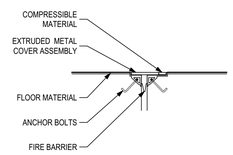


3 FLOOR EXPANSION JOINT
SCALE: 1 1/2" = 1'-0"

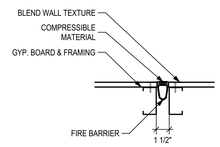


4 WALL EXPANSION JOINT
SCALE: 1 1/2" = 1'-0"

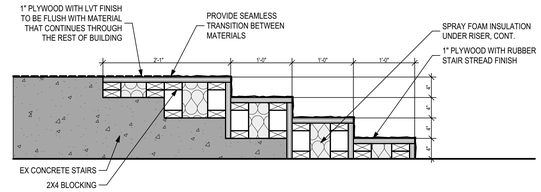


5 STAIR BUILD-OUT PMS
SCALE: 1" = 1'-0"

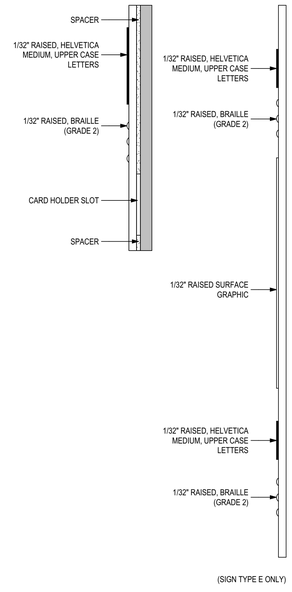


11 SIGNAGE SECTIONS
SCALE: 1" = 1'-0"

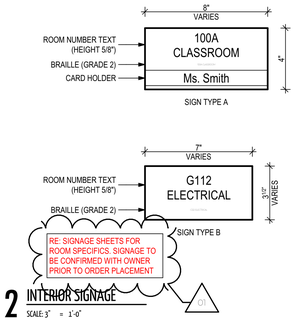


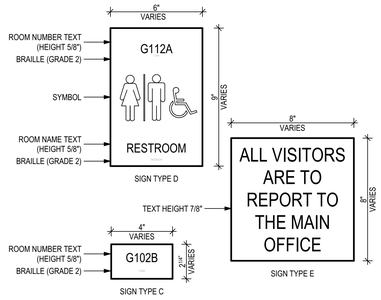


12 INTERIOR SIGNAGE
SCALE: 3" = 1'-0"

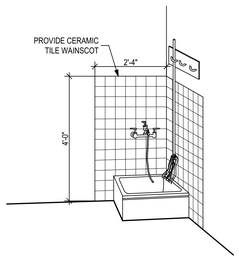


14 MOP STATION
SCALE: 1/2" = 1'-0"

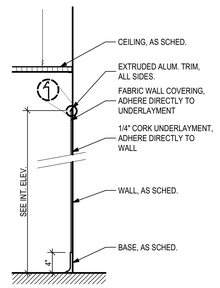

15 TACKABLE WALL SURFACE
SCALE: 1" = 1'-0"

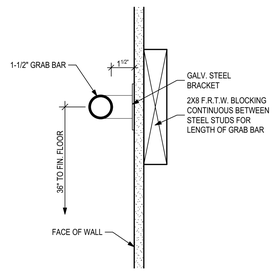


16 GRAB BAR
SCALE: 3" = 1'-0"

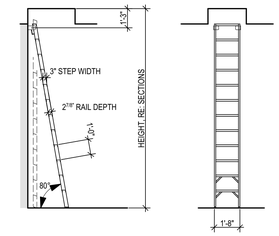


ALACO MODEL 480 PIVOT LADDER, OR EQUAL
SEE MANUFACTURER DETAILS FOR MORE INFORMATION


8 ROOF ACCESS LADDER, FOLDING
SCALE: 1/4" = 1'-0"

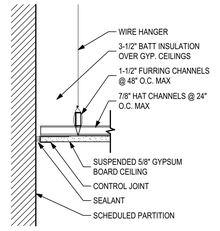


9 GYP. CEILING
SCALE: 3" = 1'-0"

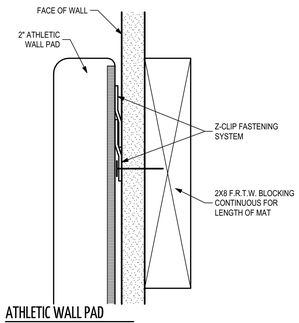

10 ATHLETIC WALL PAD
SCALE: 6" = 1'-0"

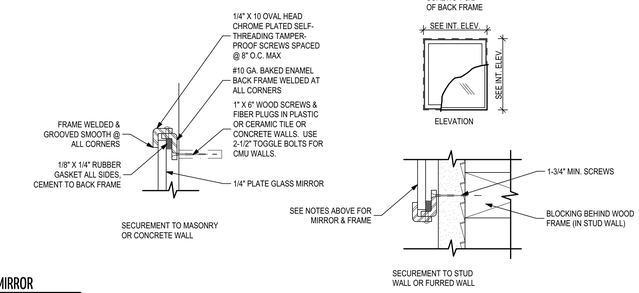

13 MIRROR
SCALE: 3" = 1'-0"

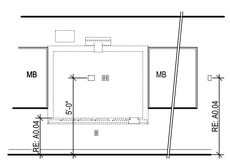

NOTES ON INTERACTIVE WHITE BOARDS AS PROVIDED BY FRONT ROW SOLUTIONS FOR JR./SR. HIGH SCHOOL:


AT THE TEACHER STATION A TWO GANG BOX WILL BE PROVIDED FOR THE AV FACEPLATE WITH CONDUIT STUBBED UP ABOVE THE CEILING FOR CABLING.

AT THE LOCATION OF THE INTERACTIVE WHITE BOARD, A SINGLE GANG DUPLEX WILL BE PROVIDED AT 5' AFF, CENTERED ON LOCATION PF INTERACTIVE WHITE BOARD. POWER WILL BE FOR SHORT THROW PROJECTOR AND WALLMOUNTED FRONT ROW PROCESSORS. ALSO A MUDRING WILL BE PROVIDED CABLE PATHWAY FOR CABLE FROM TEACHER STATION DATA DROP TO BE LOCATED AT THIS LOCATION.

SINGLE GANG BOX WITH CONDUIT STUBBED OUT ABOVE CEILING FOR 8-BUTTON CONTROL PANEL. LOCATION BASED ON DETAIL PROVIDED BY HENDRIX CONSULTING ON E1.7.

IN ROOMS WITH INTERACTIVE WHITE BOARD, BUT DO NOT HAVE A TEACHER'S STATION, PLACE THE DOUBLE GANG BOX FOR THE WALL PLATE TO THE LEFT OF THE INTERACTIVE WHITE BOARD LOCATION.

17 INTERACTIVE WHITE BOARD, TYP.
SCALE: 1/4" = 1'-0"

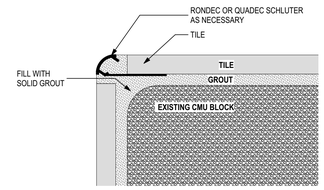

18 BULLNOSE CMU TILED EDGE
SCALE: 1" = 1'-0"

Reliance Architecture, LLC
12 Chisholm Trl
Round Rock , Texas 78681
Ph (512) 758-7660
www.reliancearchitecture.com

PFlugerville Independent School District
Multi-Campus Renovations- Phase 3
PFlugerville, Texas

Copyright © 2025 Reliance Architecture, LLC All rights reserved.

Revision:
01 ADDENDUM 003 - 1.31.2025

Project Number
2407.1


Date:
1/31/2025

Sheet Number

INTERIOR DETAILS A7.07

GENERAL NOTES

REFER TO SHEET A0.04 FOR ARCHITECTURAL GENERAL NOTES

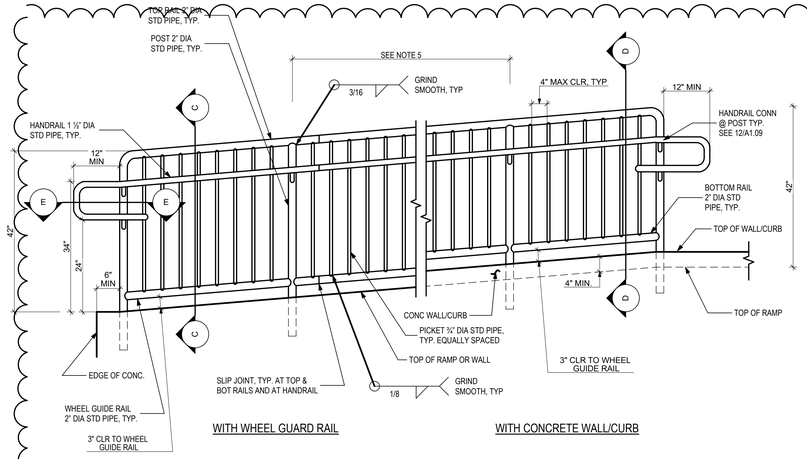


WITH WHEEL GUARD RAIL

WITH CONCRETE WALL/CURB

1 HANDRAILS & GUARDRAILS @ RAMPS (30" OR MORE ABV. GRADE)

SCALE: 3/4" = 1'-0"

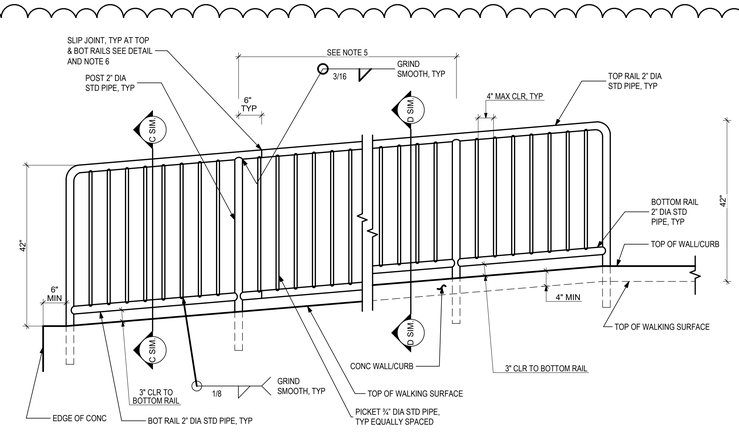


WITHOUT CONCRETE CURB


WITH CONCRETE WALL/CURB

2 GUARDRAILS @ OPEN SIDE OF WALKWAYS (30" OR MORE ABV. GRADE)


SCALE: 3/4" = 1'-0"

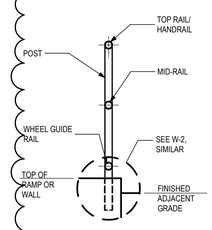


SECTION A-A
NOT TO SCALE

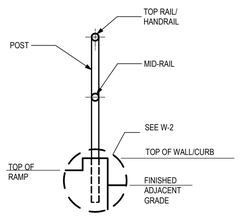

SECTION B-B
NOT TO SCALE

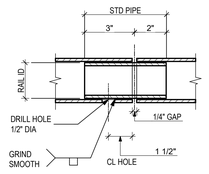


SLIP JOINT DETAIL
NOT TO SCALE

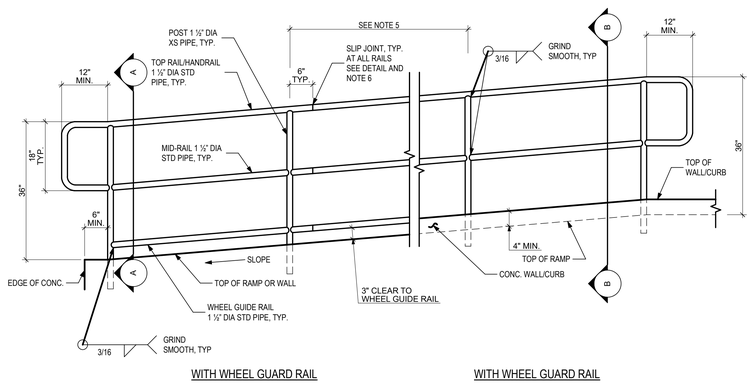


WITH WHEEL GUARD RAIL


WITH WHEEL GUARD RAIL

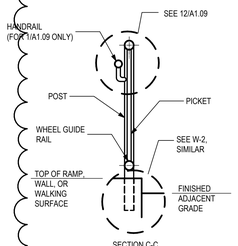


SECTION C-C
NOT TO SCALE

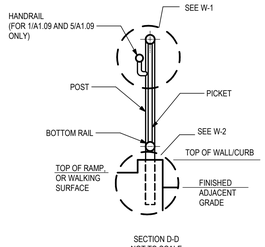


SECTION D-D
NOT TO SCALE

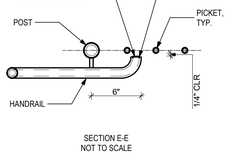

SECTION E-E
NOT TO SCALE

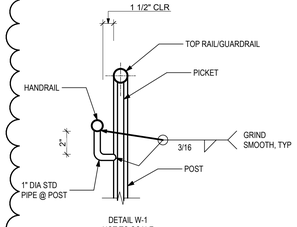

DETAIL W-1
NOT TO SCALE

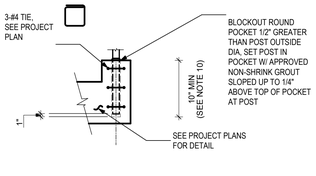


DETAIL W-2
NOT TO SCALE

NOTES:

1. STRUCTURAL PIPES SHALL CONFORM TO ASTM A53, GRADE B (FY=35 KSI) AND STRUCTURAL STEEL PLATE SHALL CONFORM TO ASTM A36.
2. STEEL SHALL BE FABRICATED AND ERECTED IN CONFORMANCE WITH THE LATEST AISC SPECIFICATIONS AND CODE OF STANDARD PRACTICE BY A LICENSED FABRICATOR.
3. WELDING SHALL BE DONE BY CERTIFIED WELDERS, USING APPROVED E70XX ELECTRODES ONLY, UNO. WELDING SHALL CONFORM TO APPLICABLE AWS WELDING CODES, LATEST EDITION. ALL SHOP WELDS SHALL BE DONE IN AN APPROVED SHOP. CONTINUOUS INSPECTION SHALL BE PROVIDED ON WELDS AS SPECIFIED, UNO. INSPECTION SHALL BE DONE BY A LICENSED DEPUTY INSPECTOR AT THE CONTRACTOR'S EXPENSE.
4. ALL STEEL STRUCTURAL COMPONENTS SHALL BE HOT-DIPPED GALVANIZED AFTER FABRICATION.
5. MAXIMUM SPACING OF POSTS SHALL BE 5 FEET ON STRAIGHT ALIGNMENTS AND 4 FEET ON CURVED ALIGNMENTS LESS THAN 30 FEET RADIUS. SPACING SHALL BE UNIFORM BETWEEN CHANGES IN ALIGNMENT.
6. PROVIDE SLIP JOINTS AT STAIRWAY AND RAMP EXPANSION JOINTS OR AT EVERY 24 FEET ON CENTER MAXIMUM.
7. ALL RAILS AND ANY ADJACENT SURFACES TO IT SHALL BE FREE OF ANY SHARP OR ABRASIVE ELEMENTS. EDGES SHALL HAVE A MINIMUM RADIUS OF 1/8 IN.
8. ALL FIELD WELDS AS REQUIRED SHALL BE GROUND SMOOTH. GALVANIZED COATING SHALL BE REPAIRED AFTER FIELD WELDING.
9. 90 DEGREE BEND RADIUS TO THE CENTER OF PIPE SHALL BE WITHIN TWO (2) TO THREE (3) TIMES OF NOMINAL DIAMETER OF THE PIPE.
10. SEE PROJECT PLANS FOR ADDITIONAL DETAILS AND REQUIREMENTS FOR POST ANCHORAGE.


3 HANDRAILS & GUARDRAILS DETAILS

SCALE: 3/4" = 1'-0"

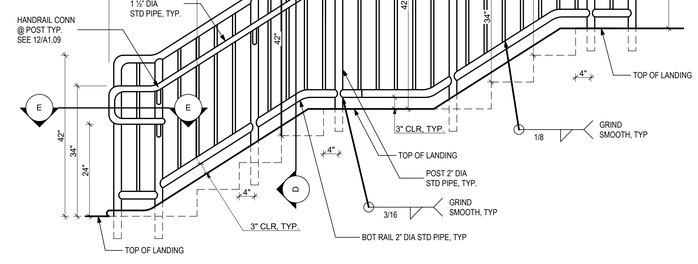

5 HANDRAILS & GUARDRAILS @ STAIRWAYS (30" OR MORE ABV. GRADE)

SCALE: 3/4" = 1'-0"

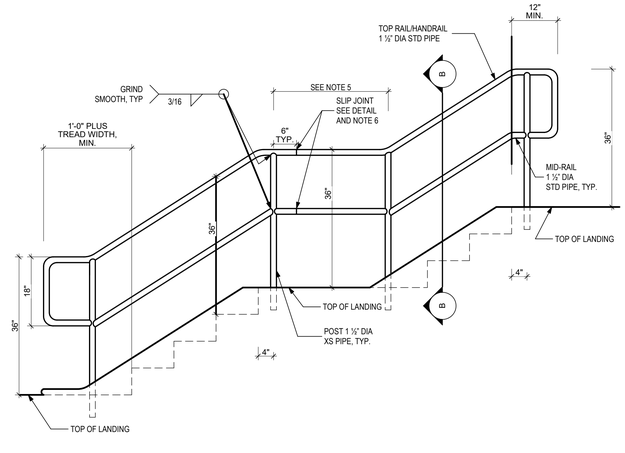

6 HANDRAILS @ STAIRWAYS (LESS THAN 30" ABV. GRADE)

SCALE: 3/4" = 1'-0"

Reliance Architecture, LLC
12 Chisholm Trl
Round Rock , Texas 78681
Ph (512) 758-7660
www.reliancearchitecture.com

Pflugerville Independent School District

Multi-Campus Renovations- Phase 3

Pflugerville, Texas

Copyright © 2025, Reliance Architecture, LLC. All rights reserved.

Revision:

ADDENDUM 003 - 1.31.2025

Project Number
2407.1

Date:
1/31/2025

Sheet Number

HANDRAILS & GUARDRAILS DETAILS

A7.08

GENERAL NOTES

ALL QUANTITIES ARE APPROXIMATE AND SHOULD BE FIELD VERIFIED PRIOR TO BIDDING

CAD BACKGROUNDS PROVIDED BY DISTRICT DO NOT MATCH FIELD CONDITIONS. REFER TO ELEVATIONS FOR MEASURMENTS AND FIELD VERIFY ALL MEASURMENTS.

REFER TO SHEET A0.01 FOR ARCHITECTURAL GENERAL NOTES, MOUNTING HEIGHTS & LINTEL SCHEDULE


THE MOVING OF FURNITURE SHALL BE THE CONTRACTORS RESPONSIBILITY TO COMPLETE THEIR WORK. NO FLOORING REPLACEMENT WORK IS HAPPENING TO THE GYM FLOORING AND STAGING OF FURNITURE COULD OCCUR IN THIS SPACE AND CAFETERIA. CONTRACTOR TO PROVIDE LOGISTICS OF MOVING AND STAGING FURNITURE IN THEIR BID.

ABBREVIATIONS

RLE	ROWE LANE ELEMENTARY	DMS	DESSAU MIDDLE SCHOOL
KLMS	KELLY LANE MIDDLE SCHOOL	PMS	PFLUGERVILLE MIDDLE SCHOOL
WKRM.	WORK ROOM	TP	TOILET PAPER DISPENSER
OFF	OFFICE	GB	GRAB BARS, RE: 16/A7.07
LIB.	LIBRARY	HD	HAND DRYERS
CORR	CORRIDOR	PT	PAPER TOWEL DISPENSER
MCT	MARMOLEUM COMPOSITE TILE	SD	SOAP DISPENSER
CPT	CARPET TILE	EWC	ELECTRIC WATER COOLER
T(X)	TILE	FEC	FIRE EXTINGUISHER CABINET
LVT	LUXURY VINYL TILE	SN	SANITARY NAPKIN DISPOSAL
CT	CERAMIC TILE	TB	TACKBOARD
VCT	VINYL COMPOSITE TILE		


FLOOR FINISH LEGEND - RLE

- LVT 1
- LVT 2
- LVT 3
- RUBBER
- CPT
- WCPT
- T7
- NO FLOORING WORK
- NOT IN SCOPE

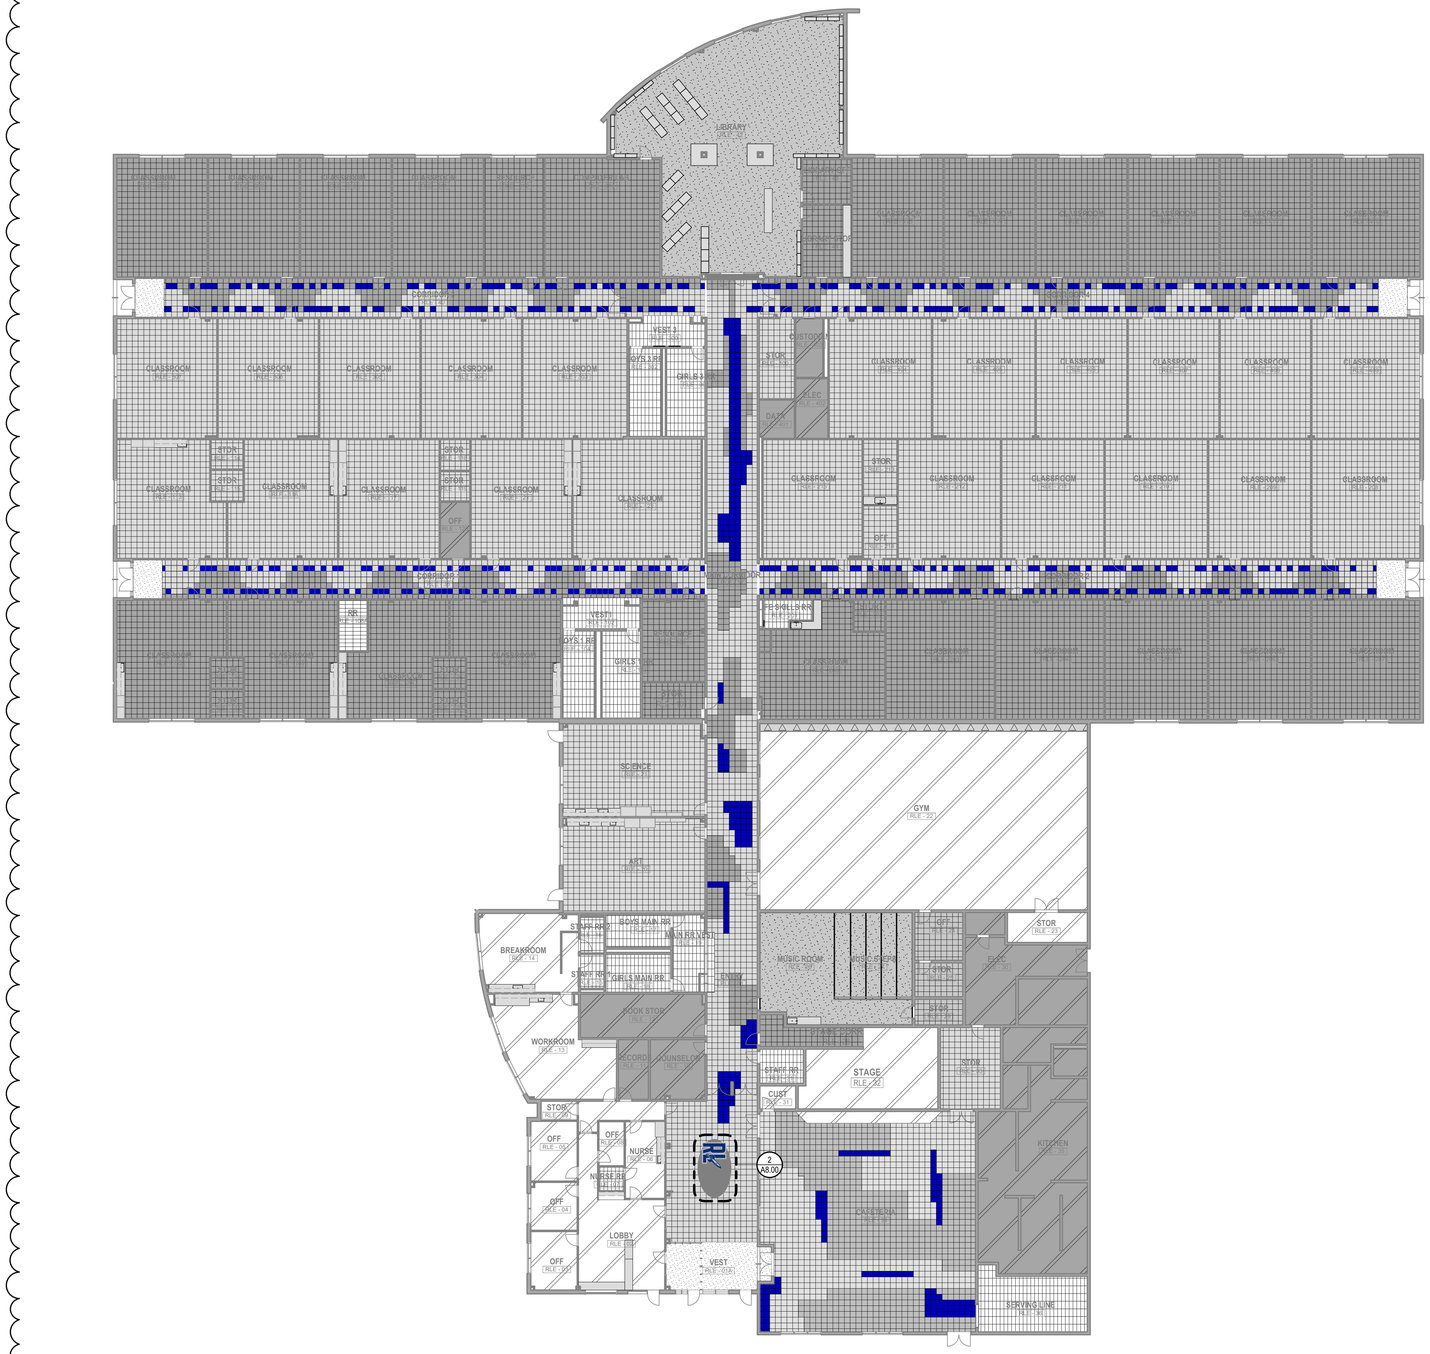

1 FLOOR FINISH PLAN ROWE LANE

SCALE: 1/16" = 1'-0"

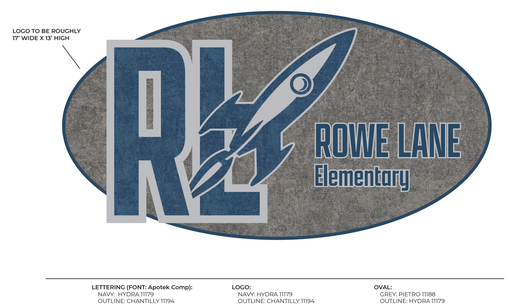

LETTERING (FONT: Apotek Comp): NAVY: HYDRA 11179 OUTLINE: CHANTILLY 11194

LOGO: NAVY: HYDRA 11179 OUTLINE: CHANTILLY 11194

OVAL: GREY: PIETRO 11188 OUTLINE: HYDRA 11179

FINAL LOGO TO BE APPROVED BY OWNER AND ARCHITECT FOLLOWING THE BIDDING PROCESS PRIOR TO ORDER/INSTALLATION

2 RLE FLOOR LOGO

NOT TO SCALE

Rowe Lane Elementary
Floor Logo

Reliance Architecture, LLC
12 Chisholm Trl
Round Rock , Texas 78681
Ph (512) 758-7660
www.reliancearchitecture.com

REGISTERED ARCHITECT STATE OF TEXAS

Pflugerville Independent School District
Multi-Campus Renovations- Phase 3
Pflugerville, Texas

Copyright © 2025, Reliance Architecture LLC. All rights reserved.

Revision:


1 ADDENDUM 003 - 1.31.2025

Project Number
2407.1

Date:
1/31/2025

Sheet Number

FLOOR FINISH PLAN ROWE LANE A8.00

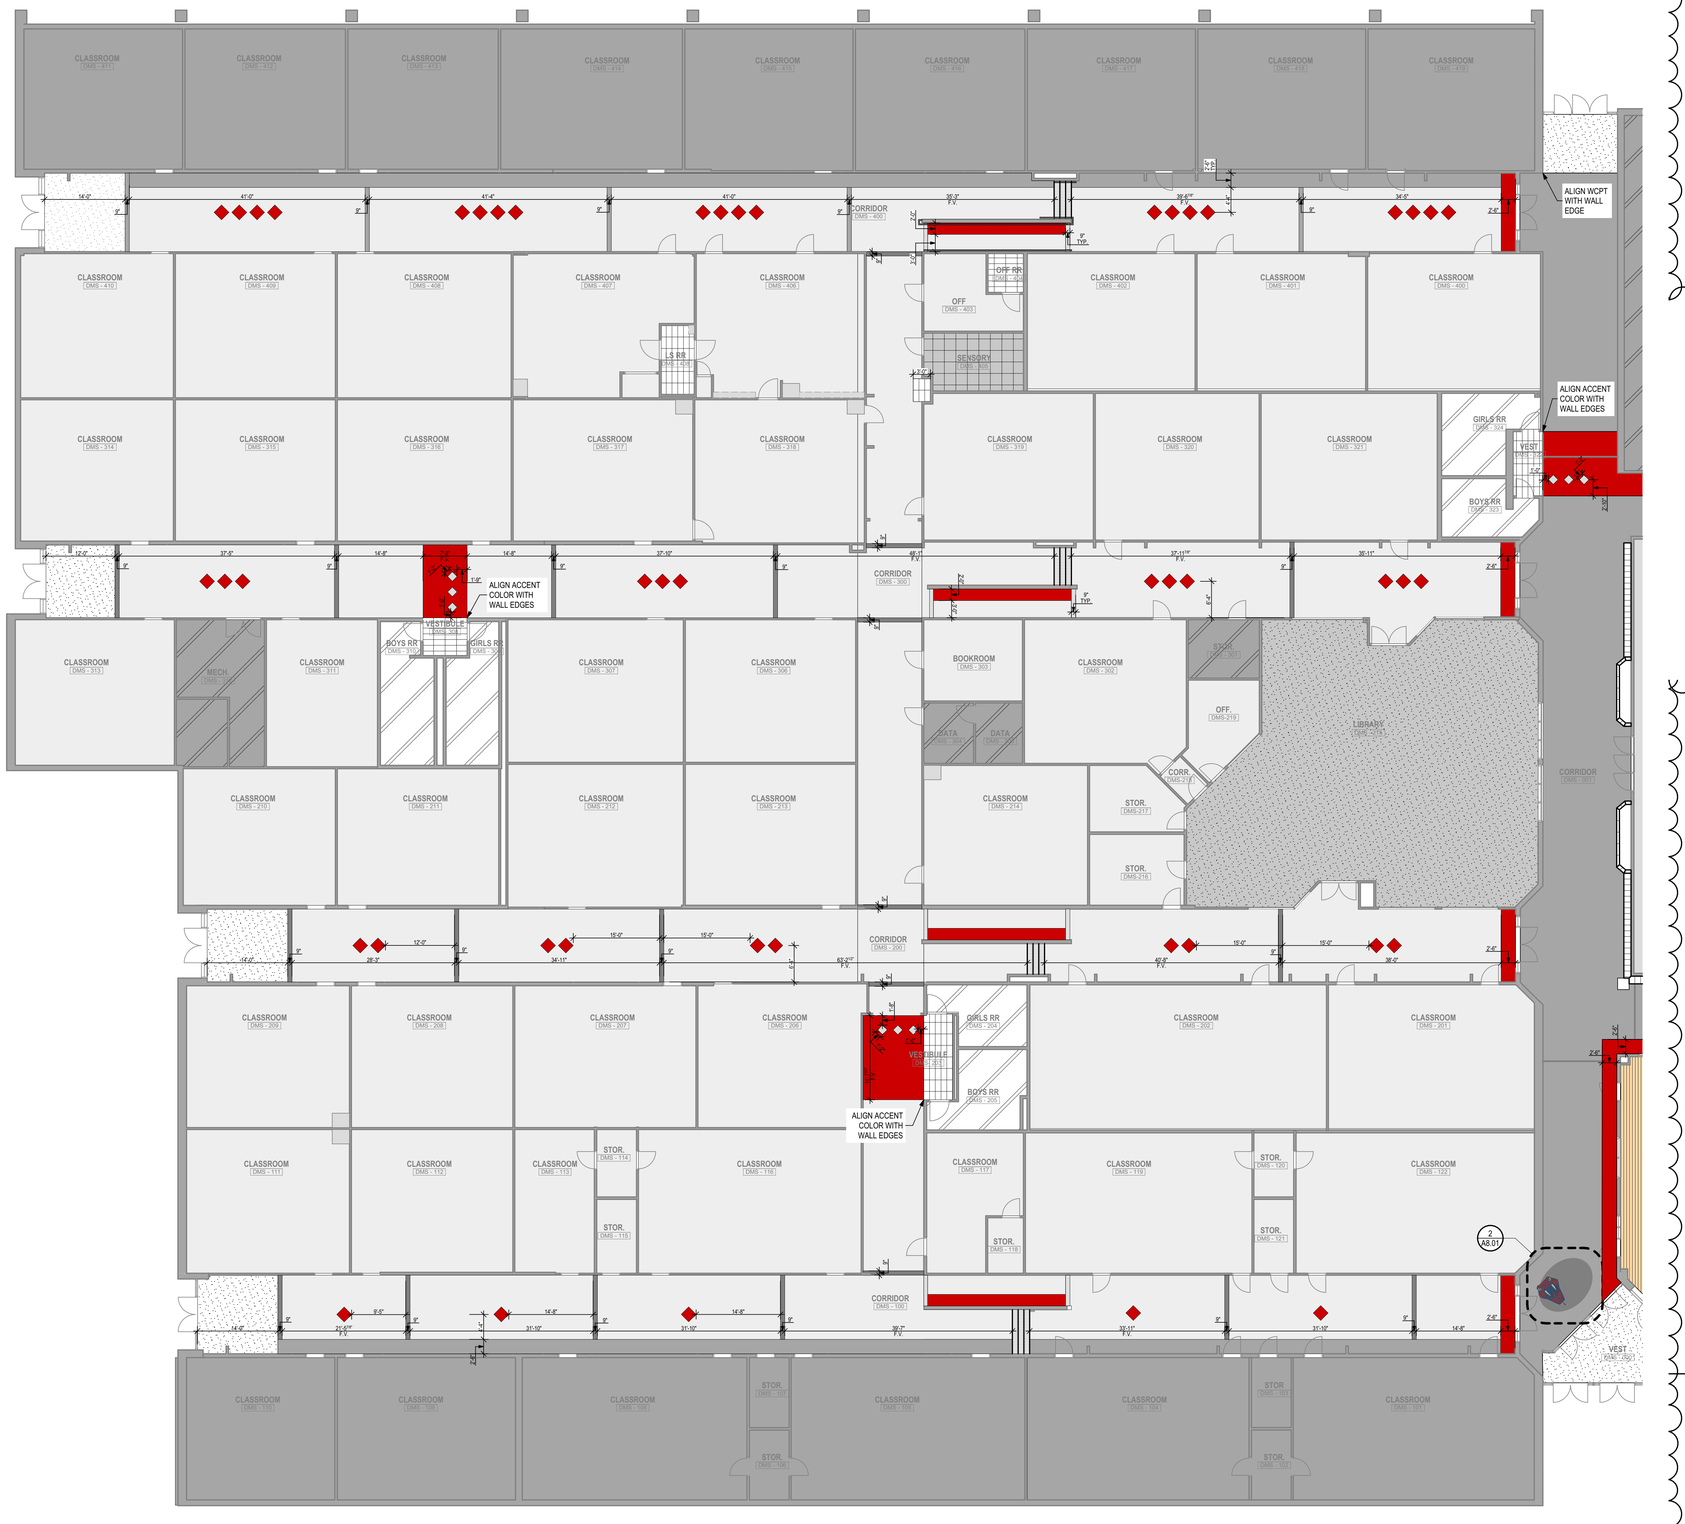

1 FLOOR FINISH PLAN DESSAU MIDDLE SCHOOL

SCALE: 3/32" = 1'-0"

GENERAL NOTES

ALL QUANTITIES ARE APPROXIMATE AND SHOULD BE FIELD VERIFIED PRIOR TO BIDDING

CAD BACKGROUNDS PROVIDED BY DISTRICT DO NOT MATCH FIELD CONDITIONS. REFER TO ELEVATIONS FOR MEASURMENTS AND FIELD VERIFY ALL MEASURMENTS.

REFER TO SHEET A0.01 FOR ARCHITECTURAL GENERAL NOTES, MOUNTING HEIGHTS & LINTEL SCHEDULE

THE MOVING OF FURNITURE SHALL BE THE CONTRACTORS RESPONSIBILITY TO COMPLETE THEIR WORK. NO FLOORING REPLACEMENT WORK IS HAPPENING TO THE GYM FLOORING AND STAGING OF FURNITURE COULD OCCUR IN THIS SPACE AND CAFETERIA. CONTRACTOR TO PROVIDE LOGISTICS OF MOVING AND STAGING FURNITURE IN THEIR BID.

ABBREVIATIONS

RLE	ROWE LANE ELEMENTARY	DMS	DESSAU MIDDLE SCHOOL
KLMS	KELLY LANE MIDDLE SCHOOL	PMS	PFLUGERVILLE MIDDLE SCHOOL
WKRM.	WORK ROOM	TP	TOILET PAPER DISPENSER
OFF	OFFICE	GB	GRAB BARS, RE: 16/A7.07
LIB.	LIBRARY	HD	HAND DRYERS
CORR	CORRIDOR	PT	PAPER TOWEL DISPENSER
MCT	MARMOLEUM COMPOSITE TILE	SD	SOAP DISPENSER
CPT	CARPET TILE	EWC	ELECTRIC WATER COOLER
T(X)	TILE	FEC	FIRE EXTINGUISHER CABINET
LVT	LUXURY VINYL TILE	SN	SANITARY NAPKIN DISPOSAL
CT	CERAMIC TILE	TB	TACKBOARD
VCT	VINYL COMPOSITE TILE		

FLOOR FINISH LEGEND - DMS

- LVT 1
- LVT 2
- LVT 3
- SN
- LVT 5
- WCPT
- CPT
- RUBBER
- EPOXY
- NO FLOORING WORK
- NOT IN SCOPE

Dessau Middle School
Floor Logo Main Entry

LOGO TO BE ROUGHLY 10'-WIDE X 8'-HIGH






FINAL LOGO TO BE APPROVED BY OWNER AND ARCHITECT FOLLOWING THE BIDDING PROCESS PRIOR TO ORDER/INSTALLATION.

2 DMS MAIN CORRIDOR FLOOR LOGO

NOT TO SCALE

Reliance Architecture, LLC
12 Chisholm Trl
Round Rock , Texas 78681
Ph (512) 758-7660
www.reliancearchitecture.com

Pflugerville Independent School District
Multi-Campus Renovations- Phase 3
Pflugerville, Texas

Copyright © 2025, Reliance Architecture, LLC. All rights reserved

Revision:


1 ADDENDUM 003 - 1.31.2025

Project Number
2407.1

Date:
1/31/2025

Sheet Number

FLOOR FINISH PLAN DESSAU A8.01

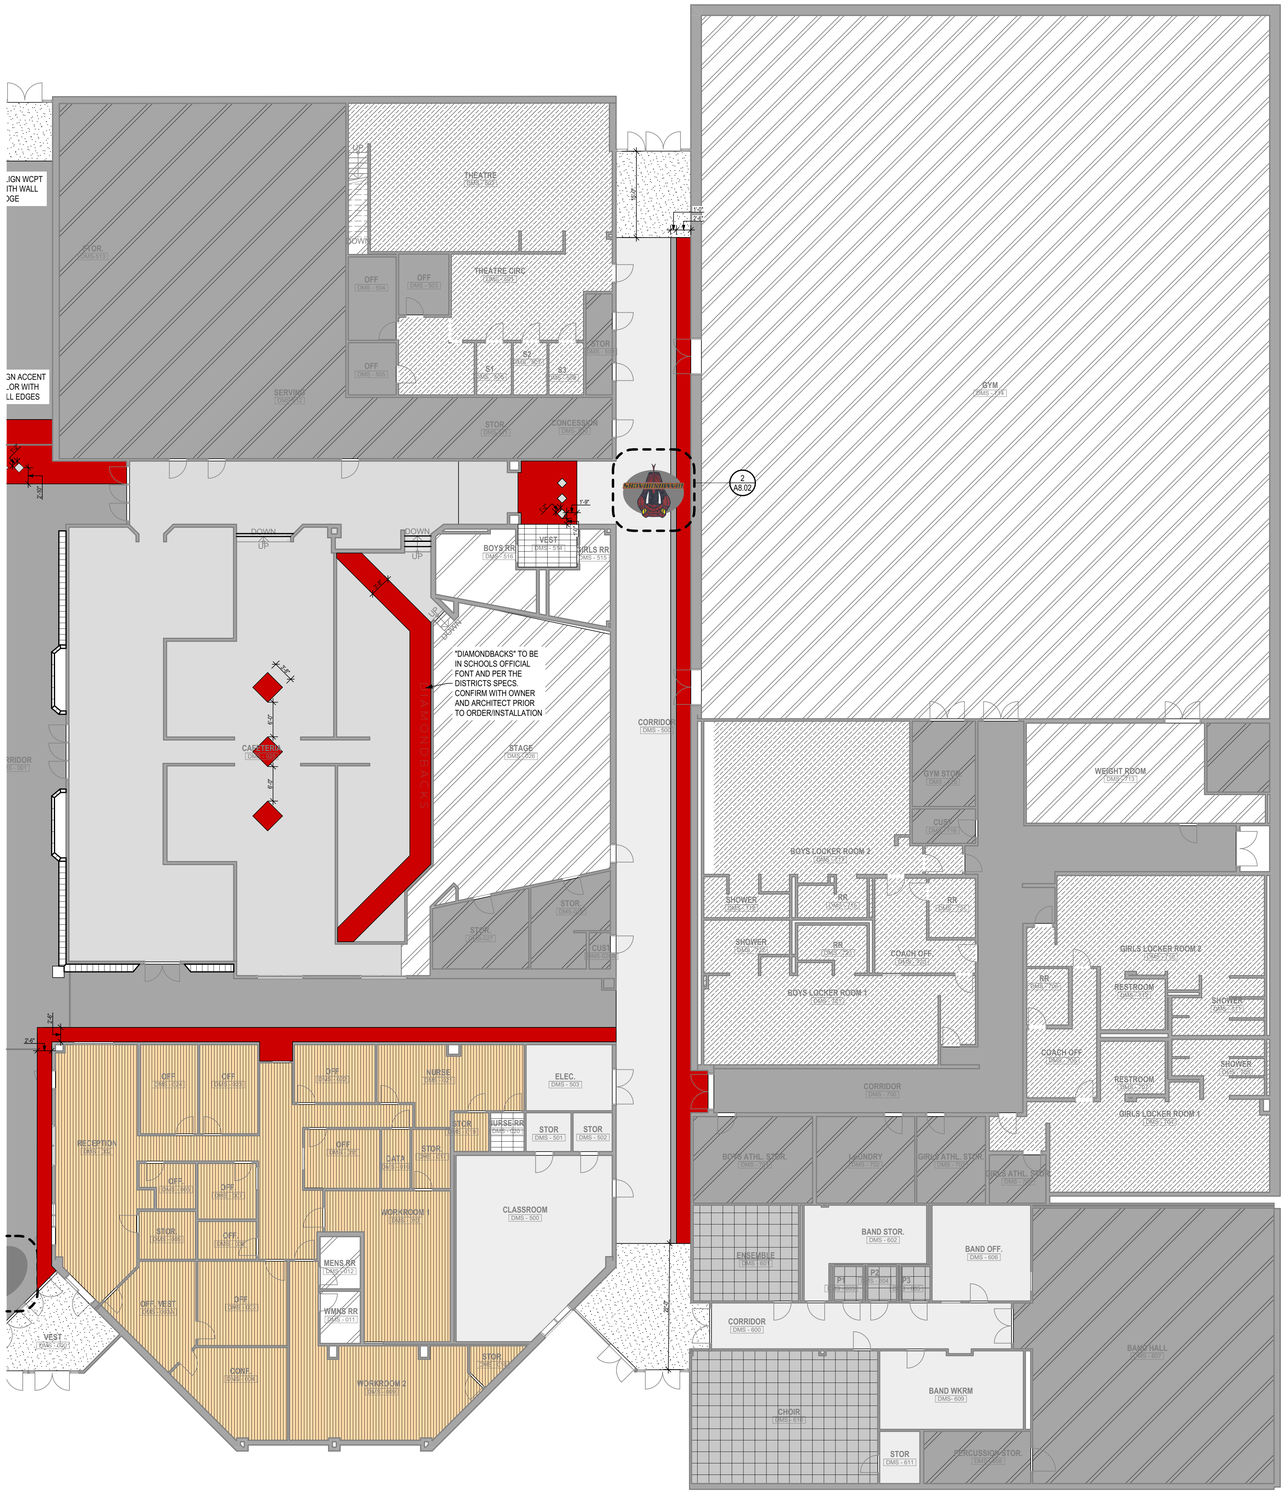

1 FLOOR FINISH PLAN DESSAU MIDDLE SCHOOL

SCALE: 3/32" = 1'-0"

GENERAL NOTES

ALL QUANTITIES ARE APPROXIMATE AND SHOULD BE FIELD VERIFIED PRIOR TO BIDDING

CAD BACKGROUNDS PROVIDED BY DISTRICT DO NOT MATCH FIELD CONDITIONS. REFER TO ELEVATIONS FOR MEASURMENTS AND FIELD VERIFY ALL MEASURMENTS.

REFER TO SHEET A0.01 FOR ARCHITECTURAL GENERAL NOTES, MOUNTING HEIGHTS & LINTEL SCHEDULE

THE MOVING OF FURNITURE SHALL BE THE CONTRACTORS RESPONSIBILITY TO COMPLETE THEIR WORK. NO FLOORING REPLACEMENT WORK IS HAPPENING TO THE GYM FLOORING AND STAGING OF FURNITURE COULD OCCUR IN THIS SPACE AND CAFETERIA. CONTRACTOR TO PROVIDE LOGISTICS OF MOVING AND STAGING FURNITURE IN THEIR BID.

ABBREVIATIONS

RLE	ROWE LANE ELEMENTARY	DMS	DESSAU MIDDLE SCHOOL
KLMS	KELLY LANE MIDDLE SCHOOL	PMS	PFLUGERVILLE MIDDLE SCHOOL
WKRM.	WORK ROOM	TP	TOILET PAPER DISPENSER
OFF	OFFICE	GB	GRAB BARS, RE: 16/A7.07
LIB.	LIBRARY	HD	HAND DRYERS
CORR	CORRIDOR	PT	PAPER TOWEL DISPENSER
MCT	MARMOLEUM COMPOSITE TILE	SD	SOAP DISPENSER
CPT	CARPET TILE	EWC	ELECTRIC WATER COOLER
T(X)	TILE	FEC	FIRE EXTINGUISHER CABINET
LVT	LUXURY VINYL TILE	SN	SANITARY NAPKIN DISPOSAL
CT	CERAMIC TILE	TB	TACKBOARD
VCT	VINYL COMPOSITE TILE		

FLOOR FINISH LEGEND - DMS

- LVT 1
- LVT 2
- LVT 3
- SN
- LVT 5
- WCPT
- CPT
- RUBBER
- EPOXY
- NO FLOORING WORK
- NOT IN SCOPE

Dessau Middle School
Floor Logo Athletic Corridor

LOGO TO BE ROUGHLY 10' WIDE X 8' HIGH

FINAL LOGO TO BE APPROVED BY OWNER AND ARCHITECT FOLLOWING THE BIDDING PROCESS PRIOR TO ORDER/INSTALLATION



LETTERING (FONT: AddCityboy):
NAVY: HYDRA 11179
GOLD: DAISY 11183
MAROON: GARNET 11186
WHITE: SILTSTONE 11187

LOGO:
NAVY: HYDRA 11179
MAROON: GARNET 11186
EYES: DAISY 11183
TEETH: SILTSTONE 11187

DIAMOND:
GREY: CHANTILLY 11194
OUTLINE: GARNET 11186

2 DMS ATHLETIC CORR FLOOR LOGO

NOT TO SCALE

Reliance Architecture, LLC
12 Chisholm Trl
Round Rock , Texas 78681
Ph (512) 758-7660
www.reliancearchitecture.com

REGISTERED ARCHITECTS STATE OF TEXAS

Pflugerville Independent School District
Multi-Campus Renovations- Phase 3
Pflugerville, Texas

Copyright © 2025 Reliance Architecture, LLC All rights reserved.


Revision:
1 ADDENDUM 003 - 1.31.2025

Project Number
2407.1

Date:
1/31/2025

Sheet Number

FLOOR FINISH PLAN DESSAU A8.02

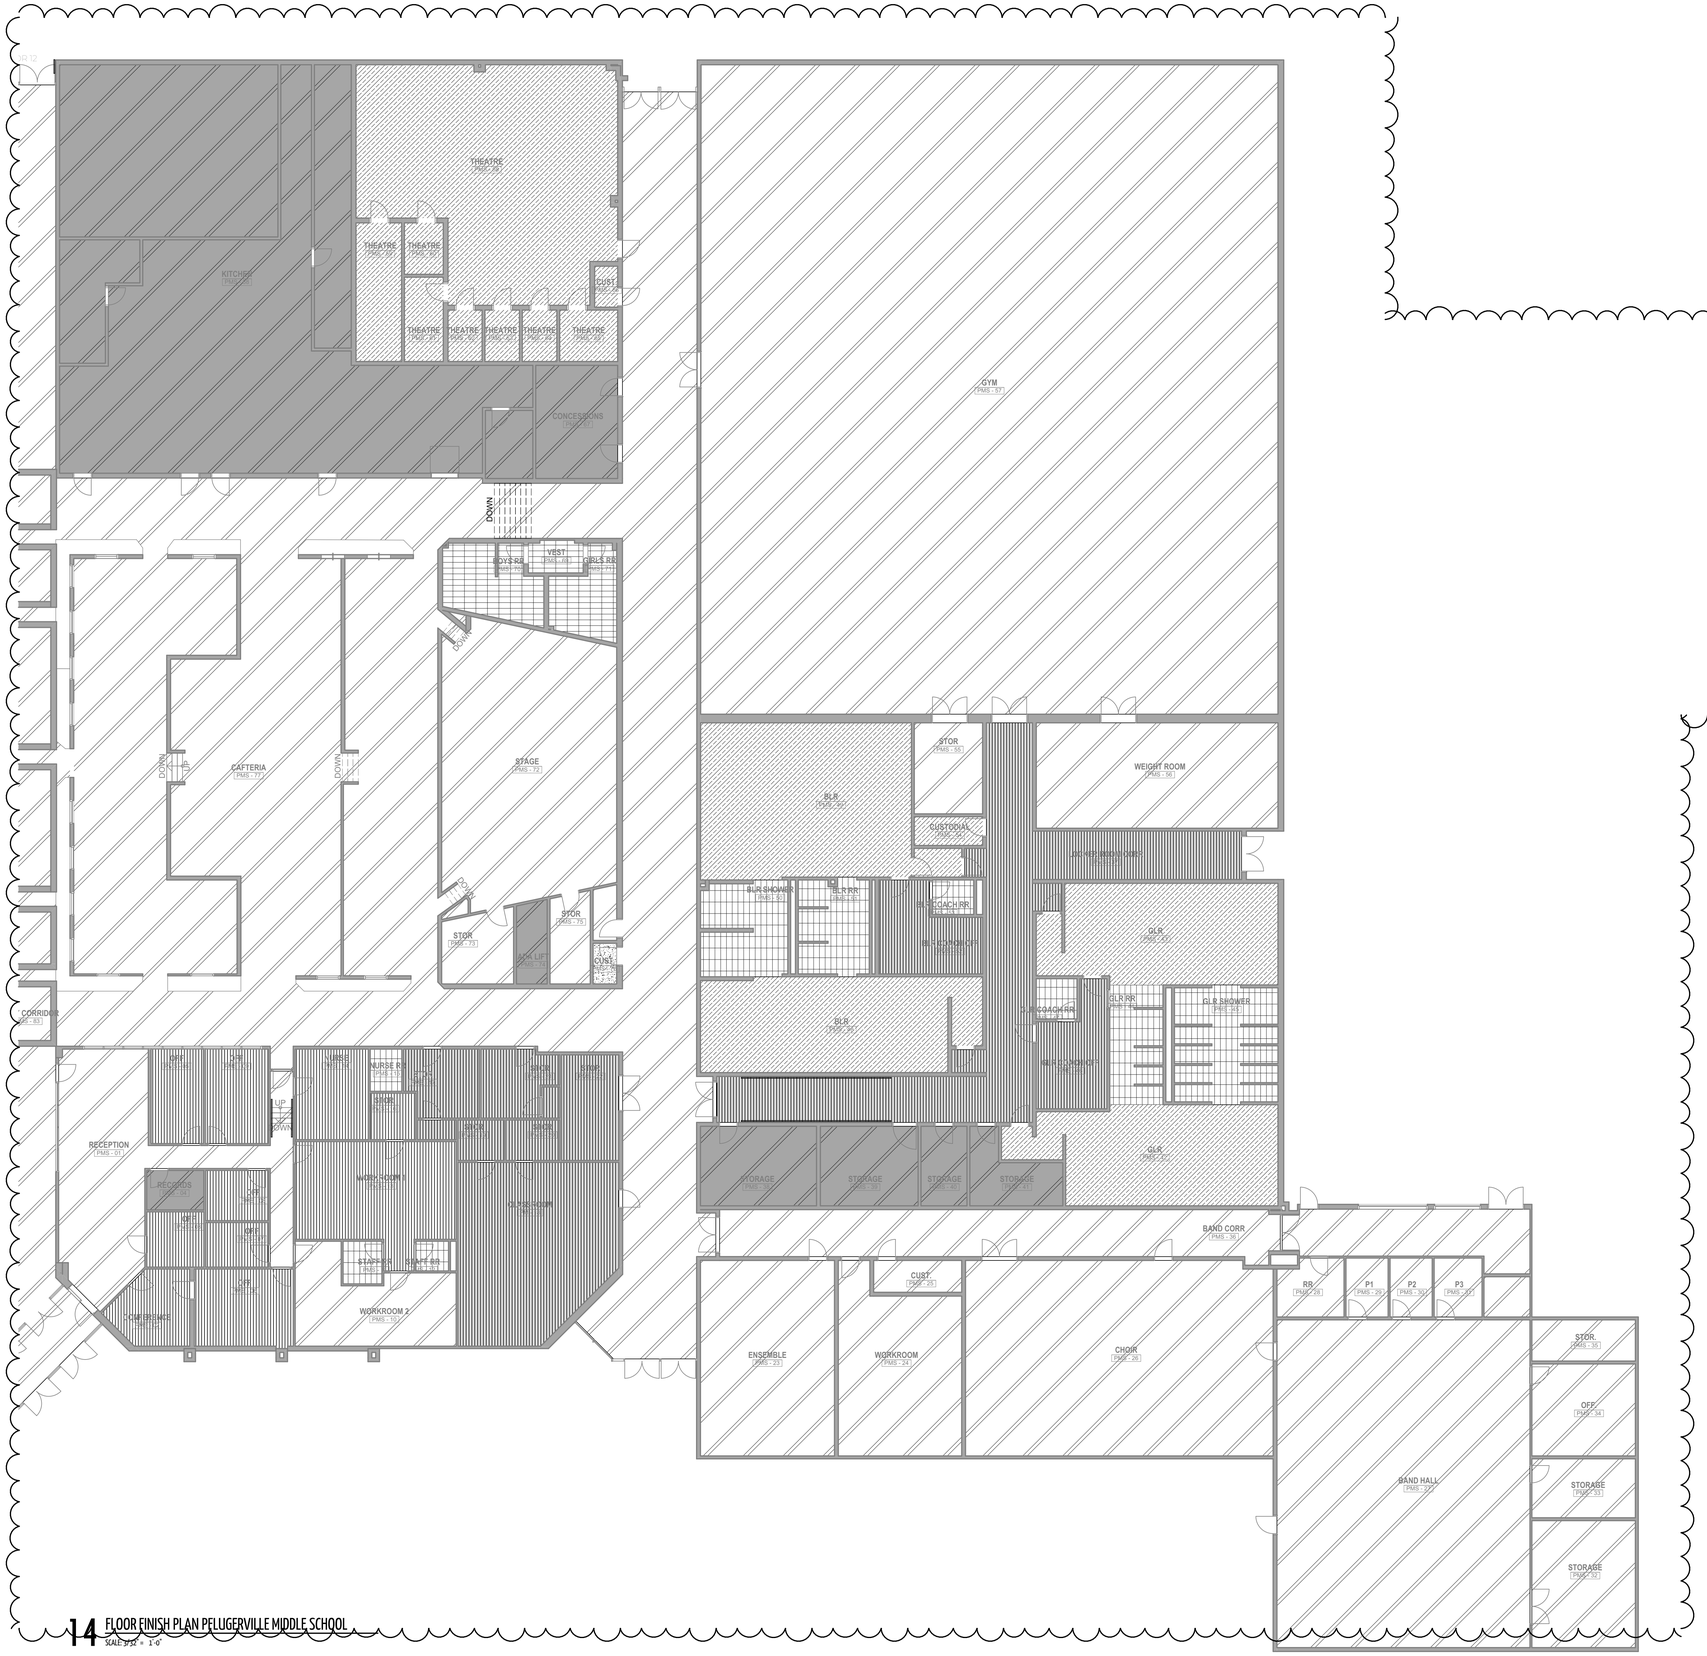

14 FLOOR FINISH PLAN PFLUGERVILLE MIDDLE SCHOOL
SCALE: 3/32" = 1'-0"

GENERAL NOTES

ALL QUANTITIES ARE APPROXIMATE AND SHOULD BE FIELD VERIFIED PRIOR TO BIDDING

CAD BACKGROUNDS PROVIDED BY DISTRICT DO NOT MATCH FIELD CONDITIONS. REFER TO ELEVATIONS FOR MEASURMENTS AND FIELD VERIFY ALL MEASURMENTS.

REFER TO SHEET A0.01 FOR ARCHITECTURAL GENERAL NOTES, MOUNTING HEIGHTS & LINTEL SCHEDULE

THE MOVING OF FURNITURE SHALL BE THE CONTRACTORS RESPONSIBILITY TO COMPLETE THEIR WORK. NO FLOORING REPLACEMENT WORK IS HAPPENING TO THE GYM FLOORING AND STAGING OF FURNITURE COULD OCCUR IN THIS SPACE AND CAFETERIA. CONTRACTOR TO PROVIDE LOGISTICS OF MOVING AND STAGING FURNITURE IN THEIR BID.

ABBREVIATIONS

RLE	ROWE LANE ELEMENTARY	DMS	DESSAU MIDDLE SCHOOL
KLMS	KELLY LANE MIDDLE SCHOOL	PMS	PFLUGERVILLE MIDDLE SCHOOL
WKRM.	WORK ROOM	TP	TOILET PAPER DISPENSER
OFF	OFFICE	GB	GRAB BARS, RE: 16/A7.07
LIB.	LIBRARY	HD	HAND DRYERS
CORR	CORRIDOR	PT	PAPER TOWEL DISPENSER
MCT	MARMOLEUM COMPOSITE TILE	SD	SOAP DISPENSER
CPT	CARPET TILE	EWC	ELECTRIC WATER COOLER
T(X)	TILE	FEC	FIRE EXTINGUISHER CABINET
LVT	LUXURY VINYL TILE	SN	SANITARY NAPKIN DISPOSAL
CT	CERAMIC TILE	TB	TACKBOARD
VCT	VINYL COMPOSITE TILE		

FLOOR FINISH LEGEND - PMS

- LVT 1
- LVT 2
- LVT 3
- STAIR NOSING
- TILE
- WCPT
- NO WORK TO FLOOR
- NOT IN SCOPE
- EPOXY

Reliance Architecture, LLC
12 Chisholm Trl
Round Rock , Texas 78681
Ph (512) 758-7660
www.reliancearchitecture.com

REGISTERED ARCHITECT STATE OF TEXAS

Pflugerville Independent School District
Multi-Campus Renovations- Phase 3
Pflugerville, Texas

Copyright © 2025, Reliance Architecture, LLC All rights reserved.

Revision:
01 ADDENDUM 003 - 1.31.2025

Project Number
2407.1

Date:
1/31/2025

Sheet Number

FLOOR FINISH PLAN PFLUGERVILLE A8.04