61	PROTECT (E) SCHOOL SIGN AND ITS FOUNDATION.
62	PROTECT (E) FENCE AND/OR GATE.
63	PROTECT (E) ELECTRICAL FACILITIES.
64	PROTECT (E) TELECOMMUNICATION FACILITIES.
65	PROTECT (E) GAS FACILITIES.
66	PROTECT (E) FLAG POLE.
67	PROTECT (E) POST AND FOOTINGS.

(oval)	PROTECT TREE
X	ADDITIONAL TREE TO REMOVE PER SITE VISIT
X	REMOVE TREE PER CIVIL DEMO
NN	Tree Numbers (NN means no number)

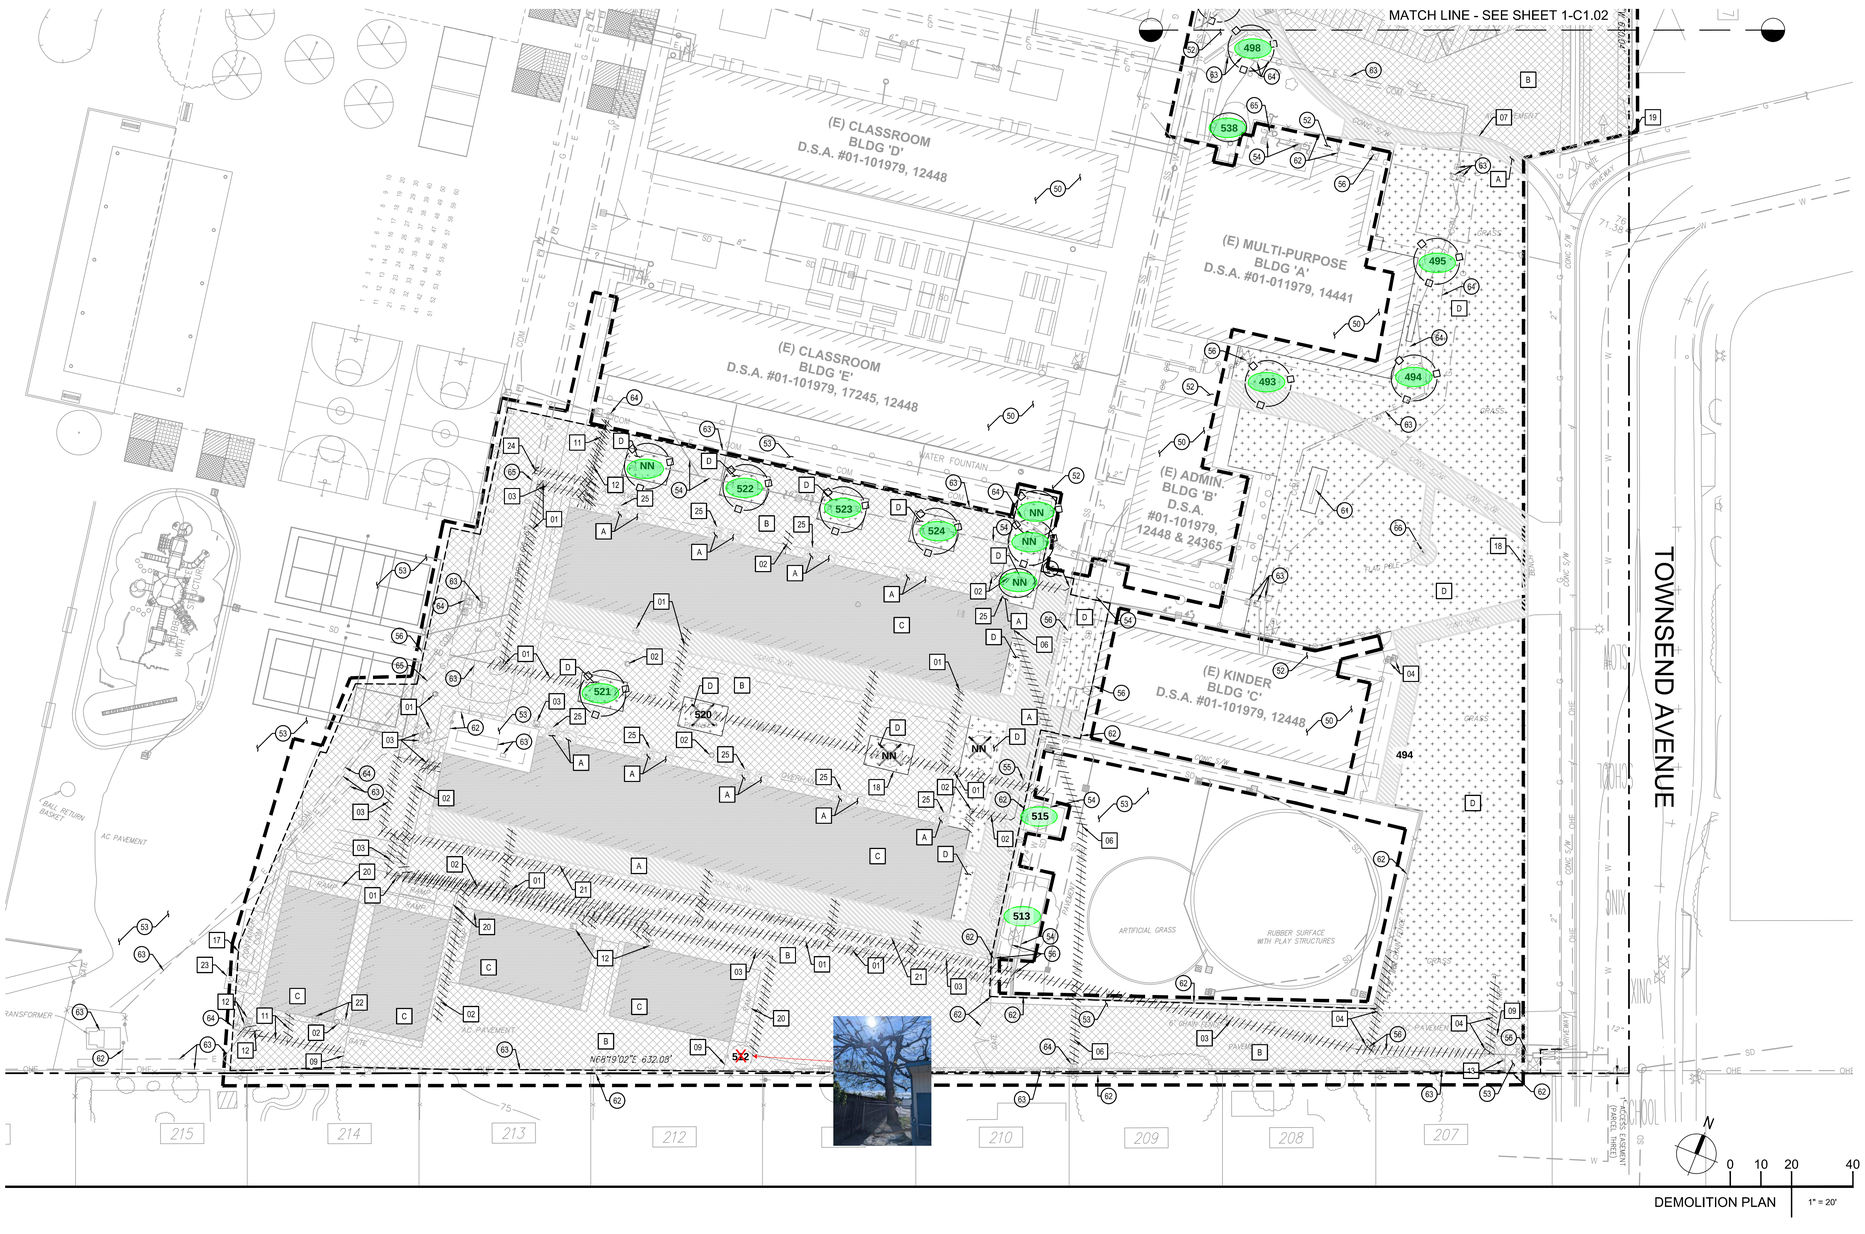

DEMOLITION PLAN 1" = 20'

DEMOLITION NOTES

- SEE DEMOLITION NOTES, SHEET 1-C0.01.
- PROTECT IN PLACE TREES AND SHRUBS AT ADJACENT PROPERTIES.
- REPLACE AND RESURFACE ANY ASPHALT CONCRETE IN KIND AT ADJACENT PROPERTIES WHERE THE WALL IS DEMOLISHED.

DEMOLITION LEGEND

LABEL	DESCRIPTION
A	REMOVE (E) CONCRETE PAVEMENT/SIDEWALK, SEE DEMOLITION NOTE 10 SHEET C0.01.
B	REMOVE (E) AC PAVEMENT, SEE DEMOLITION NOTE 10 SHEET C0.01.
C	REMOVE (E) BUILDING STRUCTURE. SEE DEMOLITION NOTE 2 SHEET C0.01.
D	REMOVE (E) TURF/DIRT. SEE LANDSCAPE AND IRRIGATION PLANS FOR IMPROVEMENTS.
	REMOVE (E) TREE, SEE DEMOLITION NOTE 5 SHEET C0.01.
	(E) TREE TO REMAIN AND BE PROTECTED. SEE DEMOLITION NOTE 5 SHEET C0.01.
	SAWCUT (E) PAVEMENT AS NEEDED. SEE DEMOLITION NOTE 6 AND 10 SHEET C0.01.
	APPROXIMATE LIMIT OF WORK LINE.
	REMOVE (E) UTILITY, SEE DEMOLITION NOTES 2, 4, 8, AND 9 SHEET C0.01.

DEMOLITION KEYNOTES

KEY NOTE	DESCRIPTION
01	REMOVE (E) STORM DRAIN PIPE AND APPURTENANCES. SEE UTILITY PLAN FOR IMPROVEMENTS.
02	REMOVE (E) SANITARY SEWER PIPE AND APPURTENANCES. SEE UTILITY PLAN FOR IMPROVEMENTS.
03	REMOVE (E) WATER PIPE AND APPURTENANCES. SEE UTILITY PLAN FOR IMPROVEMENTS.
04	REMOVE (E) IRRIGATION WATER LINE AND APPURTENANCES. SEE IRRIGATION PLANS FOR IMPROVEMENTS.
05	REMOVE (E) CONCRETE DROP-OFF RAMP, CURBS AND RAILINGS.
06	REMOVE AND RELOCATE (E) OVERHEAD AT&T LINE. SEE ELECTRICAL PLANS FOR IMPROVEMENTS.
07	REMOVE (E) CURB.
08	REMOVE (E) CURB AND GUTTER.
09	REMOVE (E) FENCE, GATE AND FOOTINGS, SEE LANDSCAPE PLANS FOR IMPROVEMENTS.
10	REMOVE (E) LIGHT STANDARD AND FOOTING. SEE ELECTRICAL PLANS FOR IMPROVEMENTS.
11	REMOVE (E) TELECOMMUNICATION FACILITIES.
12	REMOVE (E) ELECTRICAL FACILITIES. SEE ELECTRICAL PLANS FOR IMPROVEMENTS.
13	REMOVE (E) POST AND FOOTING.
14	REMOVE (E) PAVEMENT STRIPING.
15	REMOVE (E) WHEELSTOP.
16	REMOVE (E) VALLEY GUTTER.
17	REMOVE (E) CONTAINER.
18	REMOVE (E) BENCH.
19	REMOVE (E) WALL.
20	REMOVE (E) RAMP AND RAILING.
21	REMOVE (E) CANOPY AND COLUMNS, AND OTHER STRUCTURAL FEATURES AND CANOPY UTILITIES.
22	REMOVE (E) UNKNOWN UTILITY STRUCTURES.
23	REMOVE (E) SHED.
24	REMOVE (E) GAS FACILITIES. CAP AND PLUG THE GASLINE OUTSIDE OF BUILDING DEMO AREA.
25	REMOVE (E) AIR CONDITIONING UNIT.
26	REMOVE (E) FENCE WITH PRIVACY SLAT.

PROTECTION KEYNOTES

KEY NOTE	DESCRIPTION
50	PROTECT (E) BUILDING, FOUNDATION AND OTHER STRUCTURAL FEATURES AND BUILDING UTILITIES.
51	PROTECT (E) CANOPY AND COLUMNS, AND OTHER STRUCTURAL FEATURES AND CANOPY UTILITIES.
52	PROTECT (E) CONCRETE PAVEMENT/SIDEWALK.
53	PROTECT (E) AC PAVEMENT.
54	PROTECT (E) STORM DRAIN FACILITIES.
55	PROTECT (E) SANITARY SEWER FACILITIES.
56	PROTECT (E) WATER SERVICE FACILITIES.
57	PROTECT (E) IRRIGATION FACILITIES.
58	PROTECT (E) CURB.
59	PROTECT (E) CURB AND GUTTER
60	PROTECT (E) RETAINING WALL.

LPA

ARCHITECTURE ENGINEERING INTERIORS
LANDSCAPE ARCHITECTURE PLANNING

949-261-1001 Office

LPADesignStudios.com

60 South Market Street, Suite 1250
San Jose, California 95113

REGISTERED PROFESSIONAL ENGINEER
KAYVEECE M. SHINKAI
R.C.E. 68369
EXP. 9-30-25
CIVIL
STATE OF CALIFORNIA

This document and all other project documents, ideas, aesthetics and designs incorporated therein are instruments of service. All project documents are copyright protected, are the property of LPA, Inc. (LPA) and cannot be lawfully used in whole or in part for any project or purpose except as set forth in the contractual agreement between LPA and its Client. The unauthorized disclosure and/or use of the project documents (including the creation of derivative works), may give rise to liability for copyright infringement, unlawful disclosure, use or misappropriation of property rights held by LPA. The unauthorized use of the project documents will give rise to the recovery of monetary losses and damages including attorney fees and costs for which the unauthorized user will be held liable.
Project documents describe the design intent of the work and are not a representation of as-built or existing conditions. LPA is not responsible for any discrepancies between the project documents and the existing conditions.

© LPA, Inc.

BRIARWOOD ELEMENTARY SCHOOL
INCREMENT 1
RE-ROOFING AND SITE PREPARATION

1930 TOWNSEND AVENUE
SANTA CLARA, CA 95051

Developed for
SANTA CLARA UNIFIED SCHOOL DISTRICT

Revision	Date

Submittal	Date
DSA SUBMITTAL	10/30/2024

Job Number	30849
Date Published	10/30/2024
Checked By	K.SHINKAI
Scale	N/A

DEMOLITION PLAN

1-C1.01

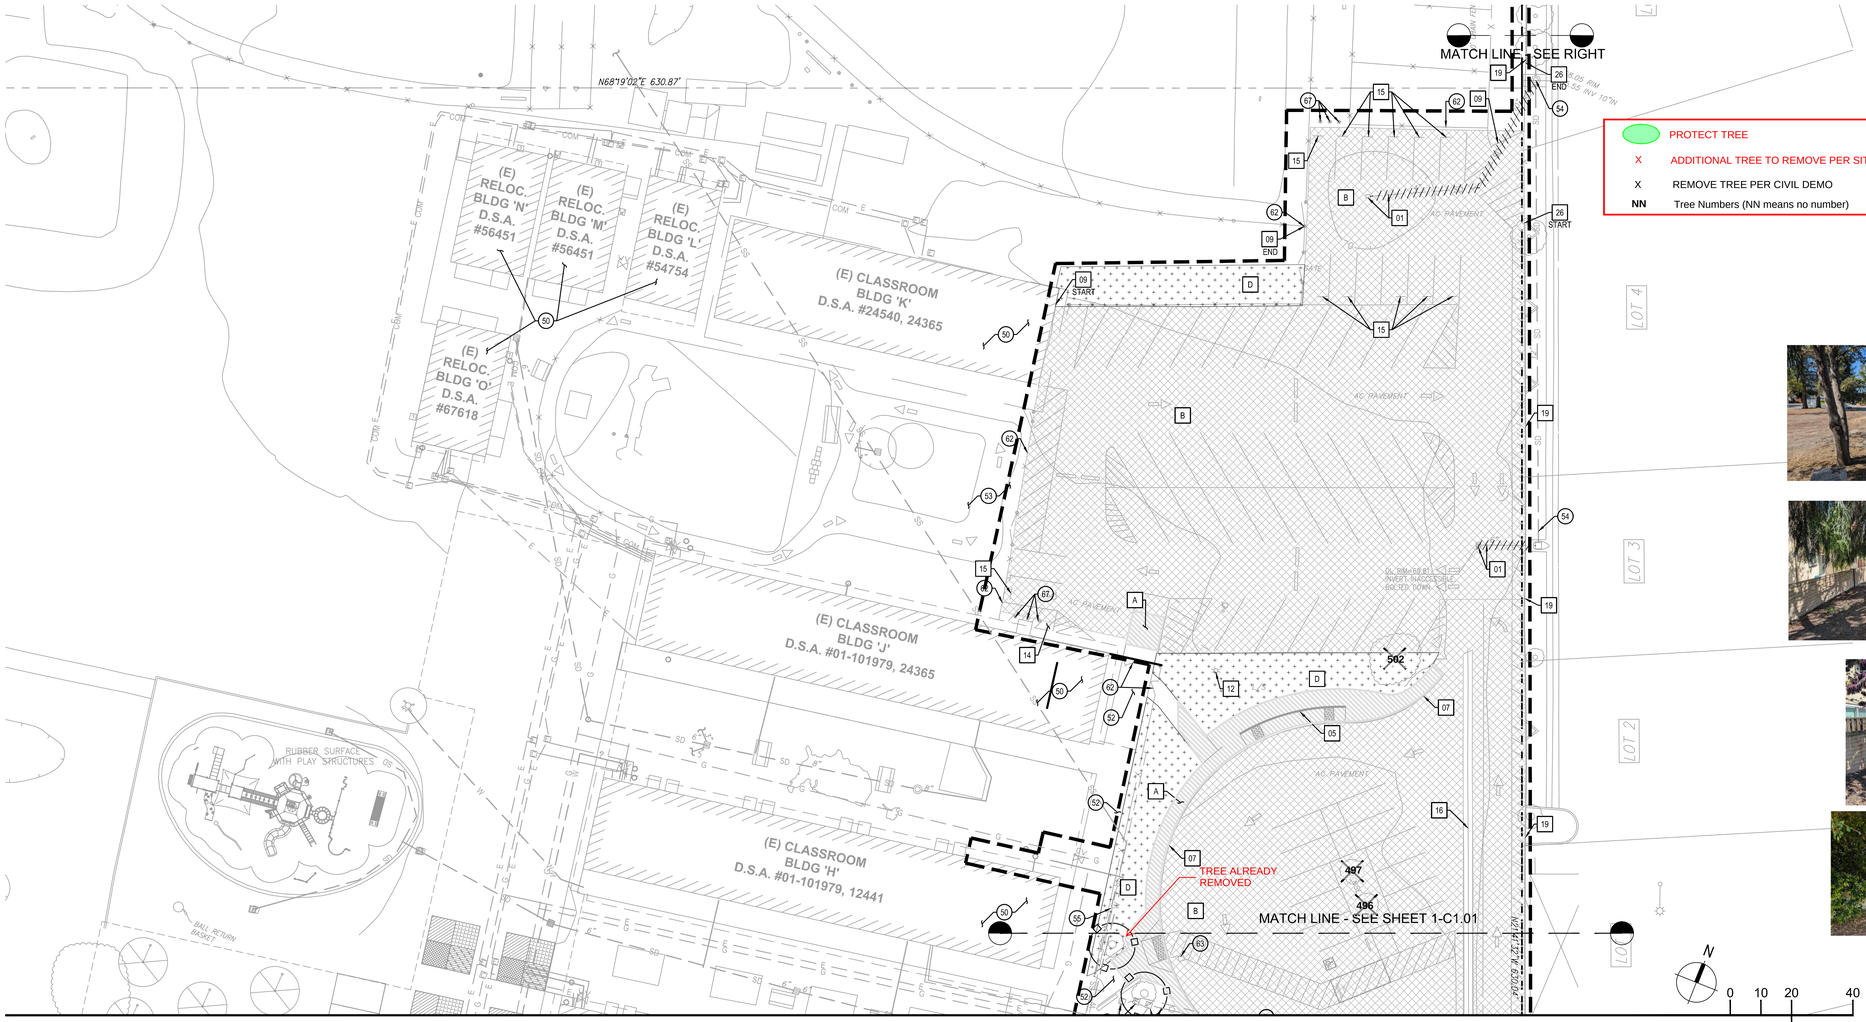

DEMOLITION NOTES

-SEE DEMOLITION NOTES, SHEET 1-C0.01.

-PROTECT IN PLACE TREES AND SHRUBS AT ADJACENT PROPERTIES.

-REPLACE AND RESURFACE ANY ASPHALT CONCRETE IN KIND AT ADJACENT PROPERTIES WHERE THE WALL IS DEMOLISHED.

DEMOLITION LEGEND

LABEL	DESCRIPTION
A	REMOVE (E) CONCRETE PAVEMENT/SIDEWALK, SEE DEMOLITION NOTE 10 SHEET C0.01.
B	REMOVE (E) AC PAVEMENT, SEE DEMOLITION NOTE 10 SHEET C0.01.
C	REMOVE (E) BUILDING STRUCTURE, SEE DEMOLITION NOTE 2 SHEET C0.01.
D	REMOVE (E) TURF/DIRT. SEE LANDSCAPE AND IRRIGATION PLANS FOR IMPROVEMENTS.
	REMOVE (E) TREE, SEE DEMOLITION NOTE 5 SHEET C0.01.
	(E) TREE TO REMAIN AND BE PROTECTED, SEE DEMOLITION NOTE 5 SHEET C0.01.
	SAWCUT (E) PAVEMENT AS NEEDED. SEE DEMOLITION NOTE 6 AND 10 SHEET C0.01.
	APPROXIMATE LIMIT OF WORK LINE.
	REMOVE (E) UTILITY, SEE DEMOLITION NOTES 2, 4, 8, AND 9 SHEET C0.01.

DEMOLITION KEYNOTES

KEY NOTE	DESCRIPTION
01	REMOVE (E) STORM DRAIN PIPE AND APPURTENANCES. SEE UTILITY PLAN FOR IMPROVEMENTS.
02	REMOVE (E) SANITARY SEWER PIPE AND APPURTENANCES. SEE UTILITY PLAN FOR IMPROVEMENTS.
03	REMOVE (E) WATER PIPE AND APPURTENANCES. SEE UTILITY PLAN FOR IMPROVEMENTS.
04	REMOVE (E) IRRIGATION WATER LINE AND APPURTENANCES. SEE IRRIGATION PLANS FOR IMPROVEMENTS.
05	REMOVE (E) CONCRETE DROP-OFF RAMP, CURBS AND RAILINGS.
06	REMOVE AND RELOCATE (E) OVERHEAD AT&T LINE. SEE ELECTRICAL PLANS FOR IMPROVEMENTS.
07	REMOVE (E) CURB.
08	REMOVE (E) CURB AND GUTTER.
09	REMOVE (E) FENCE, GATE AND FOOTINGS, SEE LANDSCAPE PLANS FOR IMPROVEMENTS.
10	REMOVE (E) LIGHT STANDARD AND FOOTING. SEE ELECTRICAL PLANS FOR IMPROVEMENTS.
11	REMOVE (E) TELECOMMUNICATION FACILITIES.
12	REMOVE (E) ELECTRICAL FACILITIES. SEE ELECTRICAL PLANS FOR IMPROVEMENTS.
13	REMOVE (E) POST AND FOOTING.
14	REMOVE (E) PAVEMENT STRIPING.
15	REMOVE (E) WHEELSTOP.
16	REMOVE (E) VALLEY GUTTER.
17	REMOVE (E) CONTAINER.
18	REMOVE (E) BENCH.
19	REMOVE (E) WALL.
20	REMOVE (E) RAMP AND RAILING.
21	REMOVE (E) CANOPY AND COLUMNS, AND OTHER STRUCTURAL FEATURES AND CANOPY UTILITIES.
22	REMOVE (E) UNKNOWN UTILITY STRUCTURES.
23	REMOVE (E) SHED.
24	REMOVE (E) GAS FACILITIES. CAP AND PLUG THE GASLINE OUTSIDE OF BUILDING DEMO AREA.
25	REMOVE (E) AIR CONDITIONING UNIT.
26	REMOVE (E) FENCE WITH PRIVACY SLAT.

PROTECTION KEYNOTES

KEY NOTE	DESCRIPTION
50	PROTECT (E) BUILDING, FOUNDATION AND OTHER STRUCTURAL FEATURES AND BUILDING UTILITIES.
51	PROTECT (E) CANOPY AND COLUMNS, AND OTHER STRUCTURAL FEATURES AND CANOPY UTILITIES.
52	PROTECT (E) CONCRETE PAVEMENT/SIDEWALK.
53	PROTECT (E) AC PAVEMENT.
54	PROTECT (E) STORM DRAIN FACILITIES.
55	PROTECT (E) SANITARY SEWER FACILITIES.
56	PROTECT (E) WATER SERVICE FACILITIES.
57	PROTECT (E) IRRIGATION FACILITIES.
58	PROTECT (E) CURB.
59	PROTECT (E) CURB AND GUTTER
60	PROTECT (E) RETAINING WALL.
61	PROTECT (E) SCHOOL SIGN AND ITS FOUNDATION.
62	PROTECT (E) FENCE AND/OR GATE.
63	PROTECT (E) ELECTRICAL FACILITIES.
64	PROTECT (E) TELECOMMUNICATION FACILITIES.
65	PROTECT (E) GAS FACILITIES.
66	PROTECT (E) FLAG POLE.
67	PROTECT (E) POST AND FOOTINGS.

LPA
ARCHITECTURE ENGINEERING INTERIORS
LANDSCAPE ARCHITECTURE PLANNING
949-261-1001 Office
LPADesignStudios.com
60 South Market Street, Suite 1250
San Jose, California 95113

REGISTERED PROFESSIONAL ENGINEER
KATHEEN M. SHINKAI
R.C.E. 68369
EXP. 9-30-25
CIVIL
STATE OF CALIFORNIA

This document and all other project documents, ideas, aesthetics and designs incorporated therein are instruments of service. All project documents are copyright protected, are the property of LPA, Inc. (LPA) and cannot be lawfully used in whole or in part for any project or purpose except as set forth in the contractual agreement between LPA and its Client. The unauthorized disclosure and/or use of the project documents (including the creation of derivative works), may give rise to liability for copyright infringement, unlawful disclosure, use or misappropriation of property rights held by LPA. The unauthorized use of the project documents will give rise to the recovery of monetary losses and damages including attorney fees and costs for which the unauthorized user will be held liable.
Project documents describe the design intent of the work and are not a representation of as-built or existing conditions. LPA is not responsible for any discrepancies between the project documents and the existing conditions.

© LPA, Inc.

BRIARWOOD ELEMENTARY SCHOOL
INCREMENT 1
RE-ROOFING AND SITE PREPARATION
1930 TOWNSEND AVENUE
SANTA CLARA, CA 95051
Developed for
SANTA CLARA UNIFIED SCHOOL DISTRICT

Revision	Date

Submittal	Date
DSA SUBMITTAL	10/30/2024

Job Number	30849
Date Published	10/30/2024
Checked By	K.SHINKAI
Scale	N/A

DEMOLITION PLAN

1-C1.02