
-EQUIPMENT SCHEDULE-

ITEM		DISTANCE FROM PROSCENIUM	NOTES
A	FIRE CURTAIN	0'-2 1/2"	STRAIGHT LIFT
1	VALANCE	0'-10"	COUNTERWEIGHT
2	MAIN CURTAIN	1'-6"	COUNTERWEIGHT
3	No. 1 ELECTRIC	3'-0"	COUNTERWEIGHT
4	No. 1 LEG	4'-6"	COUNTERWEIGHT
5	SCENERY BATTEN	5'-5"	COUNTERWEIGHT
6	No. 1 BORDER	6'-3"	COUNTERWEIGHT
7	PROJECTION SCREEN	7'-1"	COUNTERWEIGHT
8	No. 2 LEG	8'-5"	COUNTERWEIGHT
9	No. 2 ELECTRIC	10'-0"	COUNTERWEIGHT
10	SCENERY BATTEN	11'-7"	COUNTERWEIGHT
11	No. 2 BORDER	12'-7"	COUNTERWEIGHT
12	No. 1 ACT CURTAIN	13'-7"	COUNTERWEIGHT
13	No. 2 ELECTRIC	15'-1"	COUNTERWEIGHT
14	No. 3 LEG	17'-1"	COUNTERWEIGHT
15	SCENERY BATTEN	18'-1"	COUNTERWEIGHT
16	SCENERY BATTEN	19'-7"	COUNTERWEIGHT
17	No. 3 BORDER	20'-7"	COUNTERWEIGHT
18	No. 2 ACT CURTAIN	21'-7"	COUNTERWEIGHT
19	No. 4 ELECTRIC	23'-1"	COUNTERWEIGHT
20	No. 4 LEG	24'-1"	COUNTERWEIGHT
21	SCENERY BATTEN	25'-5"	COUNTERWEIGHT
22	No. 4 BORDER	26'-5"	COUNTERWEIGHT
23	SCENERY BATTEN	27'-5"	COUNTERWEIGHT
24	REAR TRAVELER	28'-5"	COUNTERWEIGHT
25	CYCLORAMA	29'-11"	COUNTERWEIGHT

CONFIRM THIS SCHEDULE (DOES NOT MATCH ORIGINAL OR OTHER SHEETS)

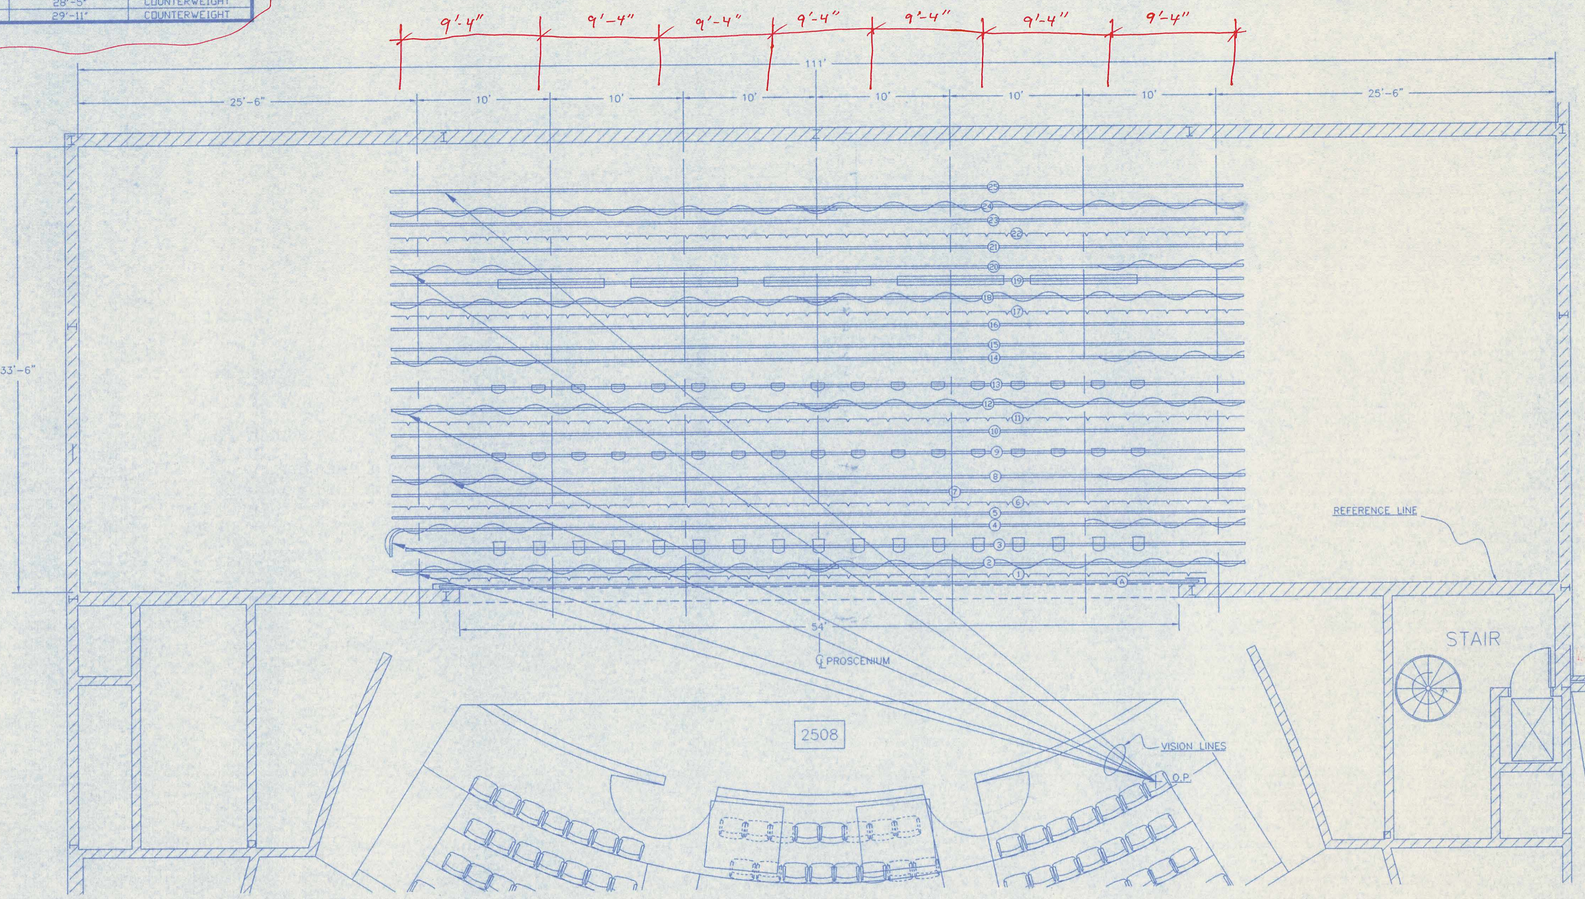

PLAN VIEW
SCALE: 3/16" = 1'-0"

2466-07 SD G-127

KINGSCOTT ASSOCIATES, INC.

SUBMITTAL

[X] SHOP DRAWINGS [ ] SAMPLE
[ ] PRODUCT DATA [ ] OTHER

Review / approval neither extends nor alters any contractural obligations of the Architect or Contractor. It is only for the limited purpose of checking for conformance with information given and the design concept expressed in the Contract Documents. The Contractor is responsible for determining the accuracy and completeness of dimensions and quantities.

ACTION
[ ] APPROVED
[X] APPROVED AS NOTED
[ ] REVISE AND RESUBMIT
[ ] REJECTED

Date 11/30/00, DWM

APPROVED FOR SUBMITTAL
GRANGER CONST. CO.
6227 AURELIUS ROAD
P.O. BOX 22187
LANSING, MI 48909
PHONE (517) 393-1670
By PGR Date 11-7-00

CERTIFICATION:

The concepts, ideas, designs, plans and details as shown on this document are the sole property of Tiffin Scenic Studios, Inc., and were created, developed and presented for use on this specific project. None of the concepts, ideas, designs, plans and details shall be used by any person, firm or corporation for any purpose whatsoever, without the expressed written consent of Tiffin Scenic Studios, Inc. The owner shall be permitted to retain copies for information and reference in connection with this project.

TIFFIN SCENIC STUDIOS, INC.
146 RIVERSIDE DRIVE
TIFFIN, OHIO 44883
PHONE: (419) 447-1546
FAX: (419) 447-5969

PROJECT:
DEXTER HIGH SCHOOL
DEXTER, MI

DRAWN BY:	CHECKED BY:
BHW	-

© COPYRIGHT 1999

REVISIONS: DATE: BY:

SHEET TITLE:
GENERAL
PLAN VIEW

JOB No:	DATE:
PRELIM	10-22-99

SHEET No: 1

E:\Dexter\1.DWG, 10/25/98 01:51:12 PM