



**COMMUNITY INDEPENDENT SCHOOL DISTRICT
611 NORTH FM 1138
NEVADA, TX 75173**

**RFP #FFE-CISD High School Add. & Reno. - 07-31-26 Furniture, Fixtures and Equipment Package
Community High School Addition and Renovation**

August 13, 2026
Addendum 01

Attachments: RFP Bid Advertisement, Bid Specifications, Sheets X002, X003, X006, X007, X007.1, X008, X009, X009.1, and X010

Description

Changes in the attached Advertisement for Proposals and the Furniture Bid Specifications documents are identified in red.

RFP's must be submitted by Tuesday, August 18th, by 4:00 PM. Late submissions will not be accepted.

All RFP's shall be physically submitted via 7 printed hardcopies including 1 thumb drive to:

For Hand Deliveries (Submit no later than 4:00 PM):
Julie Sands, Department of Construction and Design
Community ISD Terry Pope Administration Building
611 FM 1138 North
Nevada, Texas 75173

For USPS Mail Deliveries:
Julie Sands, Department of Construction and Design
Community ISD Terry Pope Administration Building
PO Box 400
Nevada, TX 75173

For All Other Delivery Services:
Julie Sands, Department of Construction and Design
Community ISD Terry Pope Administration Building
544 CR 596
Nevada, TX 75173

The following questions have been asked by Dealers/Vendors and answered by Community ISD.

NO. 1. - QUESTION #1

How will vendors know which rooms are to receive the existing furniture, and where will these pieces come from?

Answer : Vendors can identify existing furniture to be relocated by referencing the Furniture Plans. Existing furniture is highlighted in yellow on the Overall Furniture Plan and is indicated with a diagonal hatch pattern on the Unit Plans. The associated Type Marks for existing furniture to remain and be relocated are identified by the furniture type number followed by the letter "A."

Existing furniture designated for relocation will be sourced from the following locations:

Four portable classrooms currently on campus
Approximately 30 student desks and 30 student chairs at Edge Middle School
Ten existing cafeteria tables within the original portion of the dining area

All furniture is located either within the building or in close proximity to the project area. These items will remain in use during the Spring 2026 semester and will be relocated to designated temporary staging areas coordinated with the General Contractor prior to construction activities occurring in their current locations.

Vendors shall include pricing for relocation efforts required to move and reinstall these existing furnishings as part of their bid.

NO. 2. - QUESTION #2

Each item will have a tag on it that indicates existing to be relocated?

Answer: Yes, the existing furniture items designated for relocation will be identified with tag indicators affixed to each piece. These tags will be used to clearly distinguish which items are to be moved and help vendors accurately identify the furniture included in the relocation scope.

Vendors should reference the Furniture Plans in conjunction with the field-applied tags when coordinating relocation activities. Any questions regarding specific items can be raised during pre-installation coordination with the General Contractor and Owner.

NO. 3. - QUESTION #3

If we need to specify more components than what is listed for certain line items, the coaches office for instance, how would we document that?

Answer: If additional components are required beyond those listed for a particular line item, vendors are permitted to create subsections under the applicable line item to clearly identify and itemize those components.

For clarification, please reference the associated tag number in the item descriptions to ensure all additional components are included under the correct line item. This will help maintain consistency and allow for accurate review of the proposed desking system configuration.

NO. 4. - QUESTION #4

What are the electrical requirements for these workstations? Will they need to be hardwired or plug into a standard outlet? If hardwired, CMar Pogue Construction would have to coordinate this with a licensed electrician.

Answer: Workstations adjacent to walls shall be powered via standard building power and data outlets, coordinated with furniture cable management features. The central island benching run shall include a hardwire power connection from the north wall with furniture power distribution routed through the benching spine. Each workstation shall include a worksurface-mounted power module with two (2)

receptacles, one (1) USB-A port, and one (1) USB-C port for convenience and personal device charging. For planning purposes, please intend for one (1) data drop per workstation, as VoIP phones may be daisy-chained through the computer. The anticipated workstation setup includes one (1) all-in-one desktop, one (1) additional monitor, and one (1) VoIP phone per workstation. Final electrical and data coordination will be completed following contract award.

NO. 5. - QUESTION #5

Line 10: The model number for the Zuma Series Trapezoid Student Desk shows a book box. Did you want the book box and the backpack hanger, or just the backpack hanger?

Answer: No book box is required. Please provide the Zuma Series Trapezoid Student Desk with the backpack hanger only. The furniture tag numbers have been updated to reflect this change. Vendors should reference the revised tag numbers when preparing their submittals and pricing.

NO. 6. - QUESTION #6

Line 13: The model number for the KI Stout table is for the adjustable height table, but the description mentions a fixed height table. Did you want the fixed height table, or the adjustable height table? If the fixed height table, there is no option for a single footrest, but they have a no footrest or a dual footrest option. Which is preferred?

Answer: Line 13: We prefer not to use a footrest. The item description has been updated accordingly to reflect the fixed-height KI Stout table with no footrest. Please base your pricing and submittals on this configuration.

NO. 7. - QUESTION #7

For line 12 in the master spec for the HS bid, can vendors propose wire management, but not have it be lockable?

Answer: Yes. Lockable wire management is not required for Line 12. Vendors may propose wire management solutions that are not lockable, provided they meet the intent and functional requirements of the specification.

NO. 8. - QUESTION #8

Are we able to go direct to site for the HS and MS due to large volumes?

Answer: Yes. Due to the volume of furniture being provided, deliveries for both the High School and Middle School will be made directly to the project sites. Vendors should plan and coordinate deliveries accordingly.

NO. 9. - QUESTION #9

Does the HS or MS have a dock?

Answer: Neither the High School nor the Middle School has an elevated loading dock. Vendors should plan deliveries accordingly and assume ground-level access at both locations.

NO. 10. - QUESTION #10

Please confirm that CISD would like 7 hardcopies and thumb drive for the deliverables.

Answer: Yes, CISD requires seven (7) hard copies and one (1) thumb drive for proposal submissions. This is the District's preferred method for accepting deliverables. Electronic submissions via email will not be accepted.

NO. 11. - QUESTION #11

Does CISD want us to do open market pricing or utilize any Co-ops for the HS or MS bid?

Answer: CISD will accept proposals utilizing either open market pricing or cooperative purchasing contracts. Vendors are encouraged to propose the solution that provides the most cost-effective value to the District while meeting the project's functional, performance, and quality requirements.

NO. 12. - QUESTION #12

We would like the manufacturer to audit the specs for the coach's office at the HS, but the manufacturer needs a CAD plan to audit. Since it may not be enough time to audit once we receive answers back, if awarded, will there be an opportunity to audit the components and capture anything that might be missing?

Answer: Yes. The CAD plan will be provided as a downloadable resource on the CISD Bid Site as part of this addendum. To provide vendors with additional time for review, this addendum is being issued ahead of the originally scheduled response date. The deadline for final questions will remain unchanged, Thursday, 8/13. Any remaining questions received by the deadline will be addressed on the original answer release date, Monday 8/17.

NO. 13. - QUESTION #13

Who will be site contact when moving the existing furniture?

Answer: Myranda Staten will serve as the District's point of contact for the coordination and relocation of existing furniture.

**DRAWINGS
FURNITURE**

ITEM NO. 14. FURNITURE – SHEET X002 – FURNITURE PLAN – LEVEL 1 – UNIT F

A. Revise Item #10 product number in schedule.

ITEM NO. 15. FURNITURE – SHEET X003 – FURNITURE PLAN – LEVEL 1 – UNIT H

A. Revise Item #19 product description in schedule.

ITEM NO. 16. FURNITURE – SHEET X006 – FURNITURE PLAN – LEVEL 1 – UNIT M

A. Revise Item #10 product number in schedule.

B. Delete Item #1 from Room M102 and replace with Item #3.

ITEM NO. 17. FURNITURE – SHEET X007 – FURNITURE PLAN – LEVEL 1 – UNIT P

A. Delete Item #1 from Room P118 and replace with Item #3.

ITEM NO. 18. FURNITURE – SHEET X007.1 – FURNITURE SCHEDULE – LEVEL 1 – UNIT P

A. Delete Item #1 from Room P118 and replace with Item #3.

B. Revise Item #10 product number in schedule.

C. Revise Existing Item #10A product number in schedule.

D. Revise Item #13 product number and description in schedule.

ITEM NO. 19. FURNITURE – SHEET X008 – FURNITURE PLAN – LEVEL 2 – UNIT M

- A. Delete Item #1 from Room M202 and replace with Item #3.
- B. Delete Item #1 from Room M216 and replace with Item #3.
- C. Revise Item #10 product number in schedule.

ITEM NO. 20. FURNITURE – SHEET X009 – FURNITURE PLAN – LEVEL 2 – UNIT P

- A. Delete Item #1 from Room P218 and replace with Item #3.

ITEM NO. 21. FURNITURE – SHEET X009.1 – FURNITURE SCHEDULE – LEVEL 2 – UNIT P

- A. Delete Item #1 from Room P218 and replace with Item #3.
- B. Revise Item #10 product number in schedule.
- C. Revise existing item #10A product number in schedule.

ITEM NO. 22. FURNITURE – SHEET X010– FURNITURE MASTER LIST

- A. Revise quantities for Item #1.
- B. Revise quantities for Item #3.
- C. Revise Item #10 product number in schedule.
- D. Revise Item #13 product number and description.
- E. Revise Item #19 product description in schedule.

END OF ADDENDUM



ADVERTISEMENT FOR PROPOSALS
COMMUNITY INDEPENDENT SCHOOL DISTRICT
611 NORTH FM 1138
NEVADA, TX 75173

RFP #FFE-CISD High School Add. & Reno. - 07-31-26 Furniture, Fixtures and Equipment Package
Community High School Addition and Renovation

The project scope of this furniture package includes, but is not limited to furniture, mobile cabinets and equipment for schools and offices within the district. This project is in Nevada, Texas for the Community Independent School District.

Pursuant to the provisions of the Texas Education Code Section 44.031, it is the intention of Community ISD to select a furniture, mobile cabinets, and equipment vendor on the noted projects. Responses are to include the information requested in this Proposal in the sequence and format prescribed.

Pre-submittal meeting:
Friday, August 7, 2026,
11:00am

Microsoft Teams Link: [Click Here](#) or Use Info Below
Meeting ID: 277 958 008 689 09
Passcode: Af2Rr6SH

All RFP's shall be physically submitted via 7 printed hardcopies including 1 thumb drive:

Tuesday, August 18, 2026,

No Later than 4:00pm

Late submissions will not be accepted

For Hand Deliveries (Submit no later than 4:00 PM):

Julie Sands, Department of Construction and Design
Community ISD Terry Pope Administration Building
611 FM 1138 North
Nevada, Texas 75173

For USPS Mail Deliveries:

Julie Sands, Department of Construction and Design
Community ISD Terry Pope Administration Building
PO Box 400
Nevada, TX 75173

For All Other Delivery Services:

Julie Sands, Department of Construction and Design
Community ISD Terry Pope Administration Building
544 CR 596
Nevada, TX 75173

Upon receipt, the Owner will open each submittal, review, evaluate and rated to determine the “Best Qualified” for the Owner based upon the published selection criteria. After the evaluation of qualifications the firms will be ranked, and negotiations will take place with the firm determined to be best qualified for the District. Final agreement is subject to approval by the Community ISD Board of Trustees.

Questions about the project and RFQ shall be directed to:

Angelica Yong, WRA Interior Designer

ayong@wraarchitect.com

WRA Architects

6000 Headquarters Dr., Suite #600

Plano, TX 75024

RFP information including specifications and plans may be procured by going to the following link:

<https://www.communityisd.org/departments/financial-services/current-bids>



**COMMUNITY INDEPENDENT SCHOOL DISTRICT
611 NORTH FM 1138
NEVADA, TX 75173**

**RFP #FFE-CISD High School Add. & Reno. - 07-31-26 Furniture, Fixtures and Equipment Package
Community High School Addition and Renovation**

1. OVERVIEW

Community Independent School District (CISD) is accepting sealed proposals for **Furniture Package – Community High School**. This is a proposal to establish a contract, which will allow for the legal acquisition of furniture. This agreement may be awarded to a single vendor or multiple vendors based on the best value to the district in its sole discretion.

RFP's must be submitted by **Tuesday, August 18th, by 4:00 PM. Late submissions will not be accepted.**

All RFP's shall be physically submitted via 7 printed hardcopies including 1 thumb drive to:

For Hand Deliveries (Submit no later than 4:00 PM):

Julie Sands, Department of Construction and Design
Community ISD Terry Pope Administration Building
611 FM 1138 North
Nevada, Texas 75173

For USPS Mail Deliveries:

Julie Sands, Department of Construction and Design
Community ISD Terry Pope Administration Building
PO Box 400
Nevada, TX 75173

For All Other Delivery Services:

Julie Sands, Department of Construction and Design
Community ISD Terry Pope Administration Building
544 CR 596
Nevada, TX 75173

2. SCOPE

This proposal seeks qualified vendors that can meet the supply and material needs of the District for Furniture for **Furniture Package - Community High School. Alternates will be considered.**

Requirements include:

Furniture costs
Delivery costs
Installation costs
Delivery and installation:

Phase 1 Target Date: May 17th, 2027

Units: L, M , & P

Phase 2 Target Date: July 13th, 2027

Units: A, D, F, H, J,

Existing furniture relocation costs
Trash removal and haul off
Location:
Community High School
440 N Farm to Market 1138
Nevada, TX 75173

Community High School construction will be done in multiple phases. This will require two delivery and installation schedules. Furniture will need to be priced for one order. Refer to the attached drawings for furniture plans, master list, and room by room lists. Furniture for the additions and renovations will have a target delivery week of **May 17th, 2027 for phase #1 and July 13th, 2027 for phase #2.**

Furniture will be located on the first and second floors. There is an elevator. Staging areas will be available. Coordinate with Pogue Construction for space and flooring protection. Jobsite work hours will be managed by CMar Pogue Construction.

3. PERIOD OF AGREEMENT

The Term of this agreement will become effective after formal approval by the CISD Board of Trustees.

4. PRICING

Pricing and a detailed list of all items included in the pricing must be provided in addition to the proposal.

Pricing must include:

- Line items of all furniture including quantity, unit cost, total cost
- All listed items must be priced; if you can't provide pricing for item clearly identify that you are not bidding that item; if an alternate is proposed it must be clearly designated (alternates must include description, part number, manufacturer)
- Delivery Charges to be a separate line item
- Installation Charges to be a separate line item
- Relocation of existing furniture Charges
- Any temporary storage costs (as needed)
- Pricing must be submitted in an MS Excel format. Please see attached Excel template for format reference. Dealer/Vendor is expected to use the attached Excel template with the pricing shown.

5. PROPOSAL (maximum 5 pages)

Proposals should be submitted with descriptions of your firm's services.

Note the following items will be reviewed during the evaluation phase:

Evidence of Experience & References with Similar Projects

Vendor experienced in providing services

Familiarity and experience with similar projects

Expertise of Firm Personnel

Consider experience and background of specific personnel that shall be assigned to the District's project
Experience on projects of similar scope and size.

Applicable Resources

Adequacy of proposed team/resources to complete project within time frame agreed upon between
CISD and awarded dealer/vendor

Project Approach

Project schedule and approach is reasonable/responsive to District's needs

Roles of all involved parties clearly identified

Identify/recognize critical or unique issues specific to the project

Adequacy of proposed communications process

6. EVALUATION OF BIDS

This proposal will be awarded in the best interest of the District. Final evaluation of this proposal will be based on the Texas Education Code 44.031(b). The following considerations shall be taken into account to determine the best value for the district.

	Evaluation Criteria
1.	The Purchase Price
2.	Reputation of the vendor and vendor's goods or services – References Provided
3.	Quality of the vendor's goods or services
4.	Extent to which the goods or services meet the district's needs
5.	Vendor's past relationship with the district
6.	Impact of district's compliance with laws and rules relating to Historically Underutilized Businesses
7.	Total long-term cost to the district
8.	Vendor or Vendor's ultimate parent company or majority owner has its principal place of business in this state; or Vendor or Vendor's ultimate parent company or majority owner employs at least 500 persons in this state
10	Other relevant factors specifically listed in this RFP

Considering the above criteria, the District will utilize a weighted scoring process to evaluate each offer and determine the awards. The following percentiles will be applied:

Price	30%
Meets Districts Needs	30%

Vendor Qualifications	30%
Past relationship with Vendor	5%
Completeness of Proposal	5%

7. **AWARD**

CISD may award this contract to multiple or a single dealer/vendor, in order to best serve the needs of the District. All dealers/vendors properly responding on time to this proposal will be considered for award. Dealer/s will be notified of award. The dealer/s who is awarded this contract will be identified as an “approved vendor” for CISD.

8. **ESTIMATED ANNUAL EXPENDITURE:**

Community ISD does not guarantee the volume (quantity or dollar value) to be purchased annually and purchases may be made from any awarded vendor. The actual dollar amount to be purchased depends on the actual needs of the District, and budgetary constraints.

9. **RESPONSE FIELDS**

All required fields must be completed to comply with State of Texas bid laws. Proposals must be submitted using the forms mentioned in the format provided and using the specified pricing references.

10. **TIME TABLE**

RFP Advertisement Opened	July 31, 2026
Secondary Advertisement Date	August 7, 2026
Pre-submittal Meeting (Virtual)	August 7, 2026 11:00 AM
Answer Release Date #1	August 13, 2026
Deadline for Questions	August 13, 2026 4:00 PM
Answer Release Date #2	August 17, 2026
Deadline for Physical Hardcopies and Thumb Drive Submittal of Proposal	August 18, 2026 4:00 PM
Recommendation to Board	September 21, 2026
Begin Purchasing Process	November 2, 2026
Furniture Target Order Date	December 7, 2026
Furniture Phase #1 Target Install Date	May 17 th , 2027
Furniture Phase #2 Target Install Date	July 13 th , 2027

11. **COMMUNICATIONS**

All questions received and the corresponding answers will be posted as addendum. **No verbal responses will be provided.** The deadline for questions about this sealed proposal will be 4:00 PM CT, August 13, 2026. The District may not respond to questions that are submitted after this time and date. Although every effort has been made to provide accurate up-to-date information, responders should submit questions electronically to WRA Architects. **Addendum 01 answers to be released by 4:00 PM CT, August 13, 2026. Addendum 02 answers to be released by 4:00 PM CT, August 17, 2026.** **THE RESPONDERS WILL BE RESPONSIBLE FOR CHECKING FOR ANY POSTED QUESTIONS AND ANSWERS.**

The contact for this bid/proposal is Angelica Yong, email: ayong@wraarchitects.com.

12. SPECIFICATIONS

See attached supporting documents. The specifications that are shown is for basis of design only. CISD is interested in considering manufacturers and brands that are of comparative quality to the basis of design.

If the furniture image does not match the product description, default to product information.

Currently there are no material colors or finishes listed in the basis of design. Once the contract has been awarded, we will look through the list of proposed furniture items and assign finishes. For now, the materials proposed in the bids will be based on standard selections.

13. PURCHASE ORDER

All purchases against this contract will be authorized through the use of a Community ISD purchase order. **Orders must not be fulfilled (shipped and or delivered) without a Community ISD authorized purchase order.** The Owner will provide the Excel template to be used for the final quote submission. Quantities are to be summarized by total item quantity and should not be presented separately by room.

All invoices and packing slips from successful vendor must include the CISD purchase order number, manufacturer's identification number and discounted price of items and/or services as stated in this agreement.

14. DEVIATIONS

Any deviation to the Standard Terms and Conditions of this proposal request must be clearly stated in writing in the Deviation Compliance field.

15. CANCELLATION

CISD reserves the right to cancel this contract should any of the following occur:

- the vendor(s) proceeds in a manner that does not comply with the contract
- should services or quality of the goods become unacceptable as determined solely by CISD
- the vendor(s) does not carry out the provisions of this contract in its true intent and meaning as indicated in the scope of work.

Prior to contract cancellation, the dealer/vendor(s) will be served with written notice to provide satisfactory compliance with the contract without penalty. If the vendor neglects or refuses to follow such notice within thirty (30) days CISD may cancel the contract.

16. WARRANTY / GUARANTEE

All products purchased under this contract shall be NEW and free from defects.

17. DISCLAIMER

All relocated furniture shall be protected and handled with due care. Any damage to relocated furniture beyond documented existing wear and tear shall be recorded and the affected item shall be repaired or replaced by the vendor at no additional cost to the Owner.

COMMUNITY ISD - PROJECT NAME - BID (TEMPLATE)

TAG #	BASIS OF DESIGN/PROPESED ALTERNATE	PRODUCT DESCRIPTION	QUANTITY	UNIT COST (\$)	TOTAL UNIT COST (\$)	TOTAL QUOTE (\$)
1						
2						
*Things to note:

-No adjustments to be made to the excel template unless requested and approved

-Please provide any additional fees (freight, delivery, install, etc.) as a seaparate line item



1 Furniture Plan - Level 1 Overall
1/32" = 1'-0"


FURNITURE PLAN LEGEND:

	NEW FURNITURE
	EXISTING FURNITURE TO BE RELOCATED





1 Furniture Plan - Level 1 Unit F
1/8" = 1'-0"

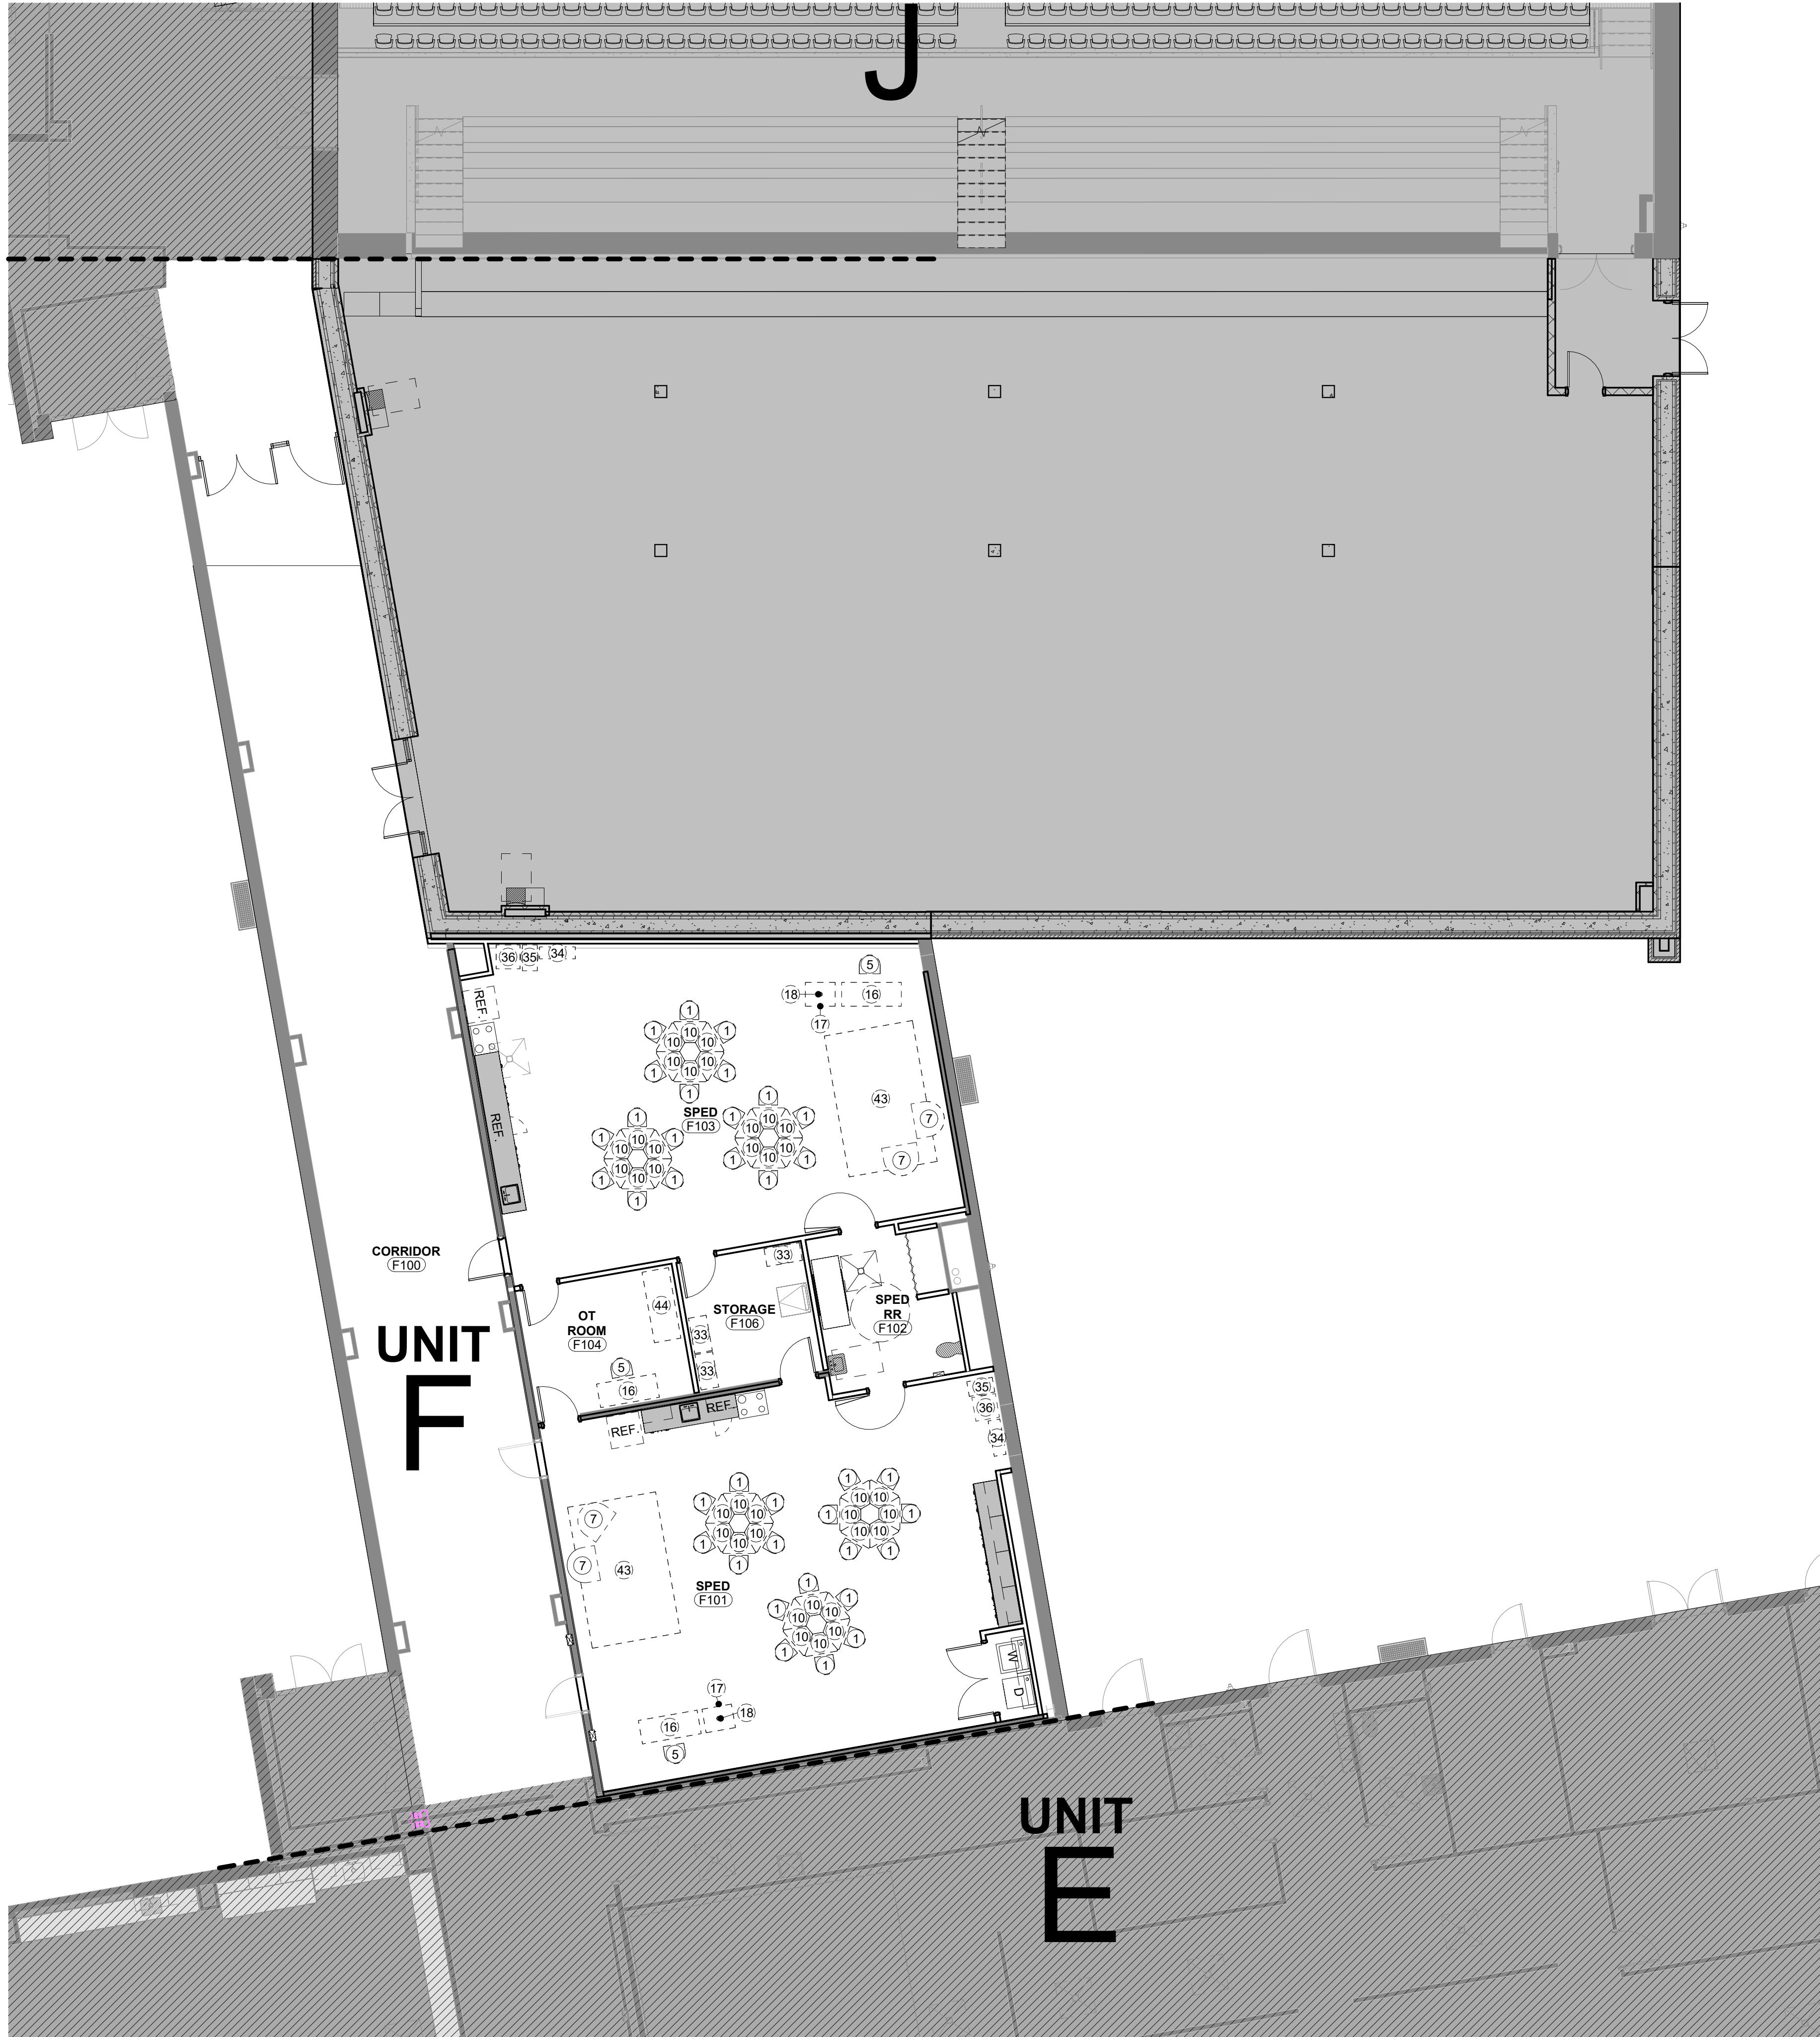


Furniture Schedule - Level 1 - Unit F				
Type Mark	Count	Model	Description	
F101 SPED				
1	18	Virco Inc #AN18	Chair, Analogy (Tm) Series, 4-Leg, Stackable, 18" Seat Height, Ergonomically Contoured Polypropylene Shell, Steel Frame, Nylon-Base Swivel Glides With Color-Accented Glide Sleeves	
5	1	RMF Seating Task Chair #160	Task Chair - Standard Black Air Mesh Seat -Black Mesh Back -Swivel Tilt Control With Seat Slider -Comfort Molded Foam Tractor Seat -Height Adjustable T Arms With Pads	
7	2	Smith System #E5000	Flowform 18" Seat Height Upholstered Soft Rocker, 32.3"D x 21"W x 32.3"H	
10	18	Virco Inc #ZCHEM	Desk, Zuma Series, Student Desk, 4-Leg, Adjustable 22-32" H, 21-1/8" X 33" Trapezoid Hard Plastic Top, Backpack Hangar, Groups As Hexagon.	
16	1	Virco Inc #PRC2460DP	Parameter (Tm) Series, Credenza Desk, Double-Pedestal, 24"W X 60"L, 1-1/8" Laminated Top, 2 Grommets, Perforated Modesty Panel, Box/Box/File And File/File Pedestals With Lock, Adjustable Glides.	
17	1	Right Angle #WSSD243024	Lectern, Top Only - 24" x 30" x 24" D- Shape Top - 1 1/8" Core	
18	1	Right Angle #NGABC24272 4	Arriba Lectern, 24"x27"x24" Base as Casters	
34	1	Virco Inc #BCM3652	Bookcase, 3 adjustable shelves on 1 centers, 12 D x 36 W x 52 H, metal.	
35	1	Virco Inc #54VF154D	Filing Cabinet, 54 Series, Metal, 4 -Letter Sized Drawers With Lock, 15"W x 26"D 52"H, Full-Extension Steel Ball-Bearing Slides On All Drawers, Counter Weight	
36	1	Virco Inc # S3TW3	Wardrobe Tower, 53 Series, Metal, Left-Side Locking Garment Storage Area With Coat Rod, 2 Right-Side Locking Box Drawers, File Drawer & Cupboard	

Furniture Schedule - Level 1 - Unit F				
Type Mark	Count	Model	Description	
43	1	Worthington Direct #CFK10088	Rug - Mt Shasta Solids Carpet - 7'-6" x 12' Rectangle	
F103 SPED				
1	18	Virco Inc #AN18	Chair, Analogy (Tm) Series, 4-Leg, Stackable, 18" Seat Height, Ergonomically Contoured Polypropylene Shell, Steel Frame, Nylon-Base Swivel Glides With Color-Accented Glide Sleeves	
5	1	RMF Seating Task Chair #160	Task Chair - Standard Black Air Mesh Seat -Black Mesh Back -Swivel Tilt Control With Seat Slider -Comfort Molded Foam Tractor Seat -Height Adjustable T Arms With Pads	
7	2	Smith System #E5000	Flowform 18" Seat Height Upholstered Soft Rocker, 32.3"D x 21"W x 32.3"H	
10	18	Virco Inc #ZCHEM	Desk, Zuma Series, Student Desk, 4-Leg, Adjustable 22-32" H, 21-1/8" X 33" Trapezoid Hard Plastic Top, Backpack Hangar, Groups As Hexagon.	
16	1	Virco Inc #PRC2460DP	Parameter (Tm) Series, Credenza Desk, Double-Pedestal, 24"W X 60"L, 1-1/8" Laminated Top, 2 Grommets, Perforated Modesty Panel, Box/Box/File And File/File Pedestals With Lock, Adjustable Glides.	
17	1	Right Angle #WSSD243024	Lectern, Top Only - 24" x 30" x 24" D- Shape Top - 1 1/8" Core	
18	1	Right Angle #NGABC24272 4	Arriba Lectern, 24"x27"x24" Base as Casters	
34	1	Virco Inc #BCM3652	Bookcase, 3 adjustable shelves on 1 centers, 12 D x 36 W x 52 H, metal.	

Furniture Schedule - Level 1 - Unit F				
Type Mark	Count	Model	Description	
35	1	Virco Inc #54VF154D	Filing Cabinet, 54 Series, Metal, 4 -Letter Sized Drawers With Lock, 15"W x 26"D 52"H, Full-Extension Steel Ball-Bearing Slides On All Drawers, Counter Weight	
36	1	Virco Inc # S3TW3	Wardrobe Tower, 53 Series, Metal, Left-Side Locking Garment Storage Area With Coat Rod, 2 Right-Side Locking Box Drawers, File Drawer & Cupboard	
43	1	Worthington Direct #CFK10088	Rug - Mt Shasta Solids Carpet - 7'-6" x 12' Rectangle	
F104 OT ROOM				
5	1	RMF Seating Task Chair #160	Task Chair - Standard Black Air Mesh Seat -Black Mesh Back -Swivel Tilt Control With Seat Slider -Comfort Molded Foam Tractor Seat -Height Adjustable T Arms With Pads	
16	1	Virco Inc #PRC2460DP	Parameter (Tm) Series, Credenza Desk, Double-Pedestal, 24"W X 60"L, 1-1/8" Laminated Top, 2 Grommets, Perforated Modesty Panel, Box/Box/File And File/File Pedestals With Lock, Adjustable Glides.	
44	1	Nextgen Furniture #U6627	Upholstered Recovery Couch with Chrome Legs, 72" L x 27"W x 18" H	
F106 STORAGE				
33	3	Republic Storage #DP3002	Open Shelving - 5 Shelf Starter - 36w X 18d X 85h	

FURNITURE PLAN LEGEND:
NEW FURNITURE
RELOCATED EXISTING FURNITURE

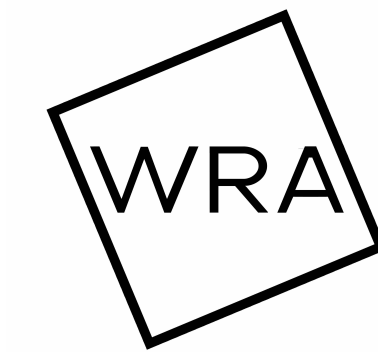

WRA Architects, Inc.
6000 Headquarters Drive
Suite 600
Plano, TX 75024
214-750-0077
www.wraarchitects.com


COMMUNITY HS ADDITION & RENOVATION TO 2100
CAPACITY
440 N Farm To Market 1138, Nevada, TX 75173

REVISIONS:		
No.	Date	
1	Addendum #01	8/13/2026


JOB NO.	2368
DATE:	07/31/2026

Furniture Plan - Level 1
Unit F


X002

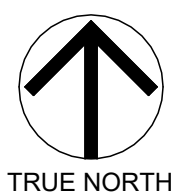

1 Furniture Plan - Level 1 Unit H
1/8" = 1'-0"

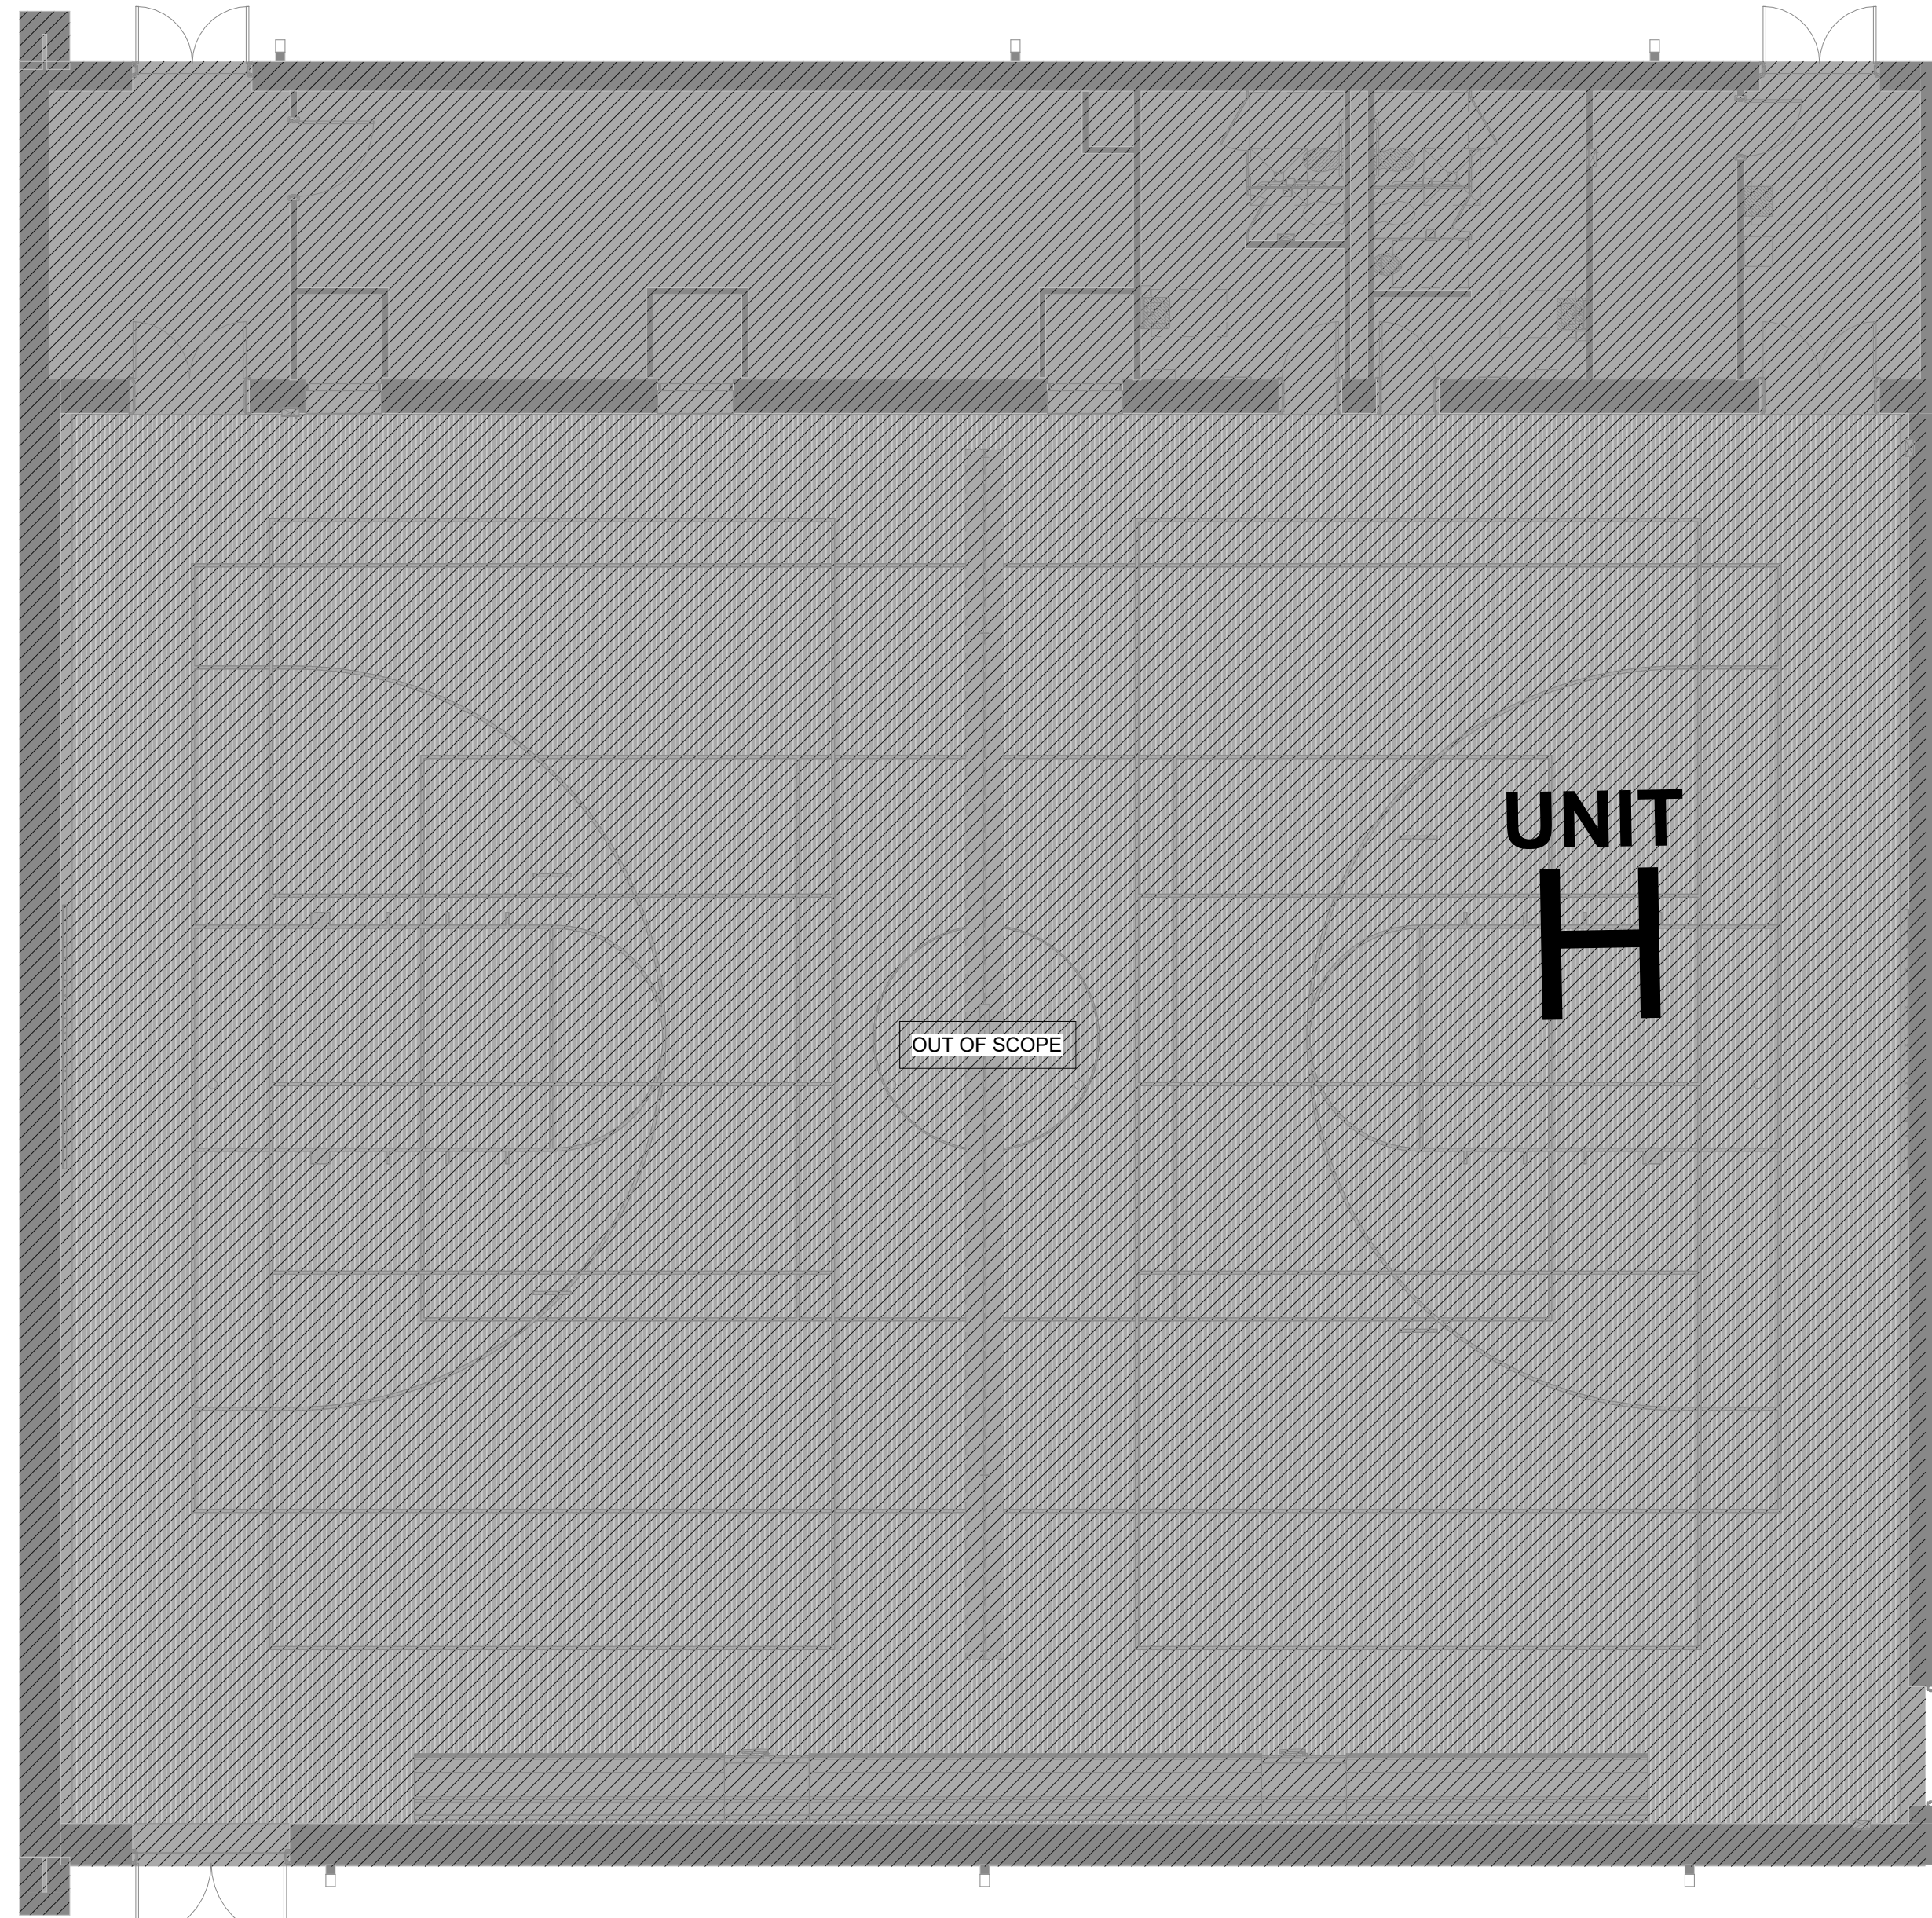


2 Furniture Plan - Level 1 Unit H - Coaches Office
3/16" = 1'-0"

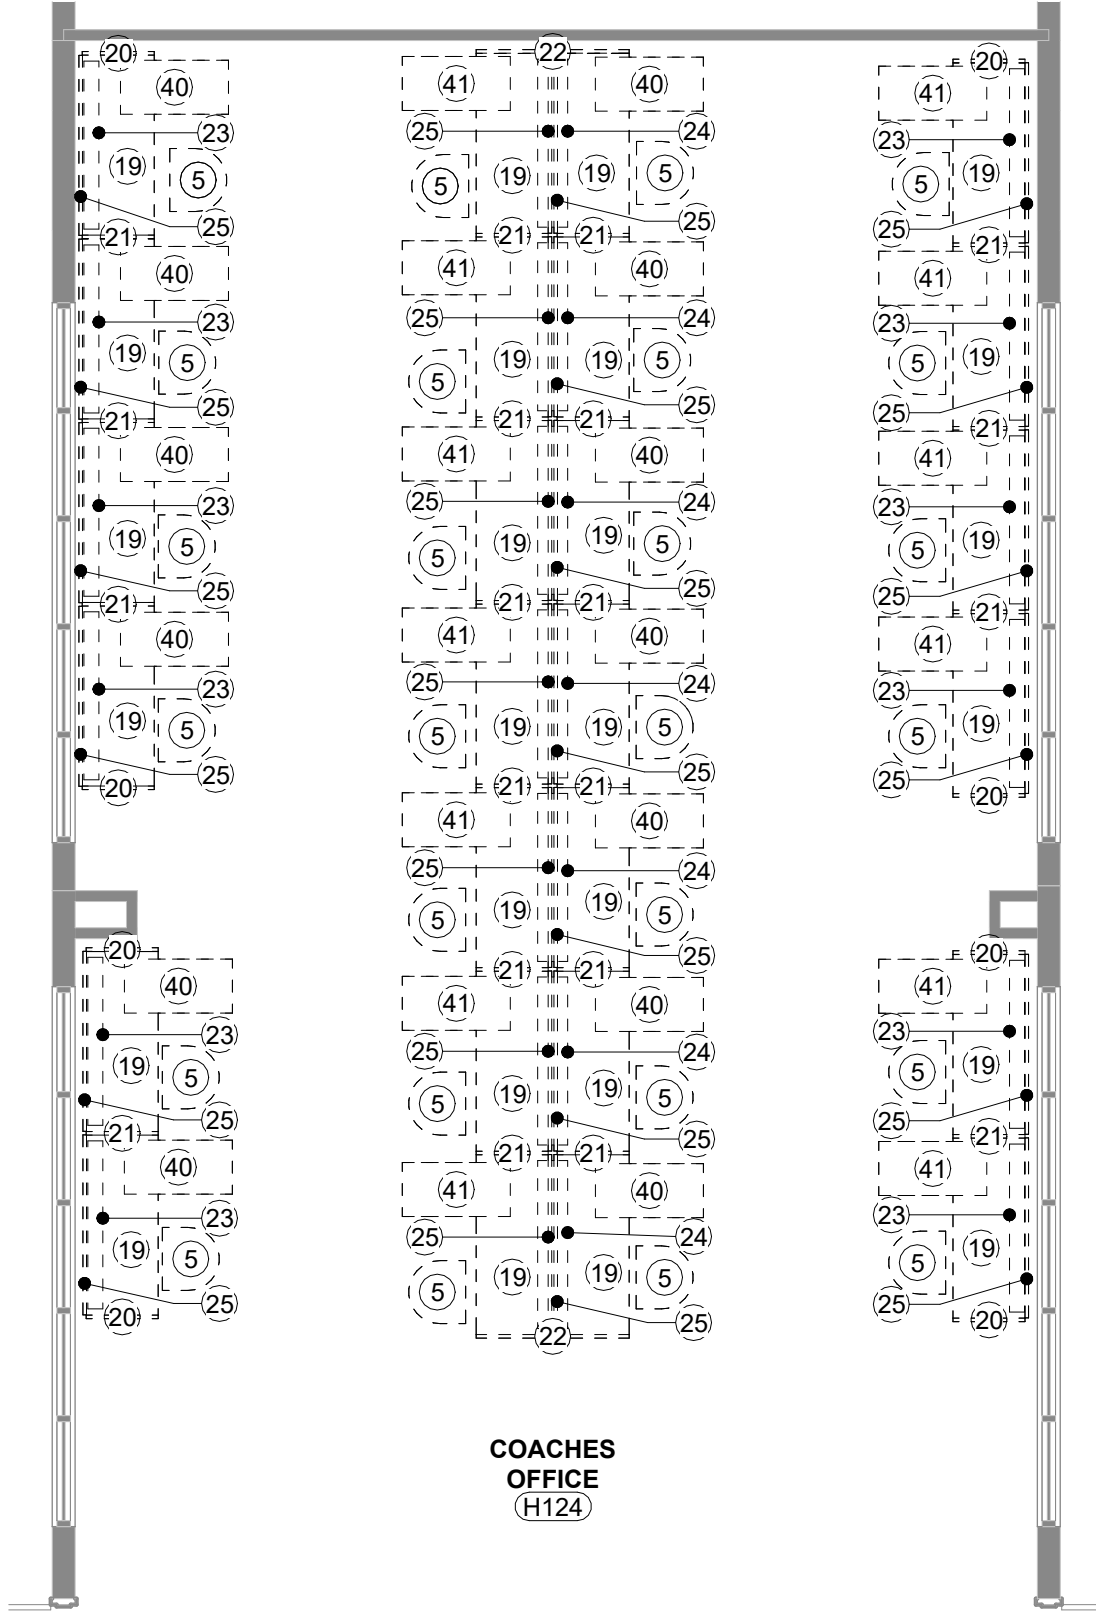

Furniture Schedule - Level 1 - Unit H			
Type Mark	Count	Model	Description
H106 WOMEN'S TRACK / VOLLEYBALL			
45	1	Ghent #ARM1M46	Writing Surface Size: 4'H x 6'W, Reversible Magnetic Porcelain Whiteboard with Aluminum Frame
H110 WOMEN'S COACH			
5	2	RMF Seating Task Chair #160	Task Chair - Standard Black Air Mesh Seat -Black Mesh Back -Swivel Tilt Control With Seat Slider -Comfort Molded Foam Tractor Seat -Height Adjustable T Arms With Pads
H111 STORAGE			
33	6	Republic Storage #DP3002	Open Shelving - 5 Shelf Starter - 36w X 18d X 85h
H112 WOMEN'S BASKETBALL			
45	1	Ghent #ARM1M46	Writing Surface Size: 4'H x 6'W, Reversible Magnetic Porcelain Whiteboard with Aluminum Frame
H113 WOMEN'S SOCCER			
45	1	Ghent #ARM1M46	Writing Surface Size: 4'H x 6'W, Reversible Magnetic Porcelain Whiteboard with Aluminum Frame
H119 SOFTBALL			
45	1	Ghent #ARM1M46	Writing Surface Size: 4'H x 6'W, Reversible Magnetic Porcelain Whiteboard with Aluminum Frame
H124 COACHES OFFICE			
5	26	RMF Seating Task Chair #160	Task Chair - Standard Black Air Mesh Seat -Black Mesh Back -Swivel Tilt Control With Seat Slider -Comfort Molded Foam Tractor Seat -Height Adjustable T Arms With Pads
19	26	HON #HSYSEMPWS 2460	WorkSurface, 24" D x 60" W, L1 Laminate Finish w/ 2" Receptacle 2 USB Worksurface Clamp, Grommets, Support Beams, and Any Necessary Electrical Components
20	8	HON #HRVG3524L	35"H x 24"W Gallery Panels for Single 24" D Workspace. L1 Laminate finish w/ End Panel mounting kit.
21	20	HON #HRVG3524L	35"H x 24"W Gallery Panels for Single 24" D Workspace. L1 Laminate finish w/ Mid Panel mounting kit.
22	2	Hon #HRVG3551L	35"H x 51"W for Double 24" D Worksurfaces. L1 Laminate finish w/ End Panel mounting kit.
23	12	HON #HSYSEMPTR O60	Single sided trough for 60"W worksurfaces
24	7	HON #HSYSEMPST RO60	Double sided trough for 60"W worksurfaces

Furniture Schedule - Level 1 - Unit H			
Type Mark	Count	Model	Description
25	26	HON #HUSFFSM136 0	13"H x 60" W Fabric privacy screen Side mounted
40	13	Hon #HSCM223618 RBFOL	Mobile, Laminate L1 Front Combo Unit Credenzas w/ Standard Lock and w/ Open Shelf, 36"W x 18"D x 22"H, RH Open
41	13	Hon #HSCM223618 LBFOL	Mobile, Laminate L1 Front Combo Unit Credenzas w/ Standard Lock and w/ Open Shelf, 36"W x 18"D x 22"H, LH Open

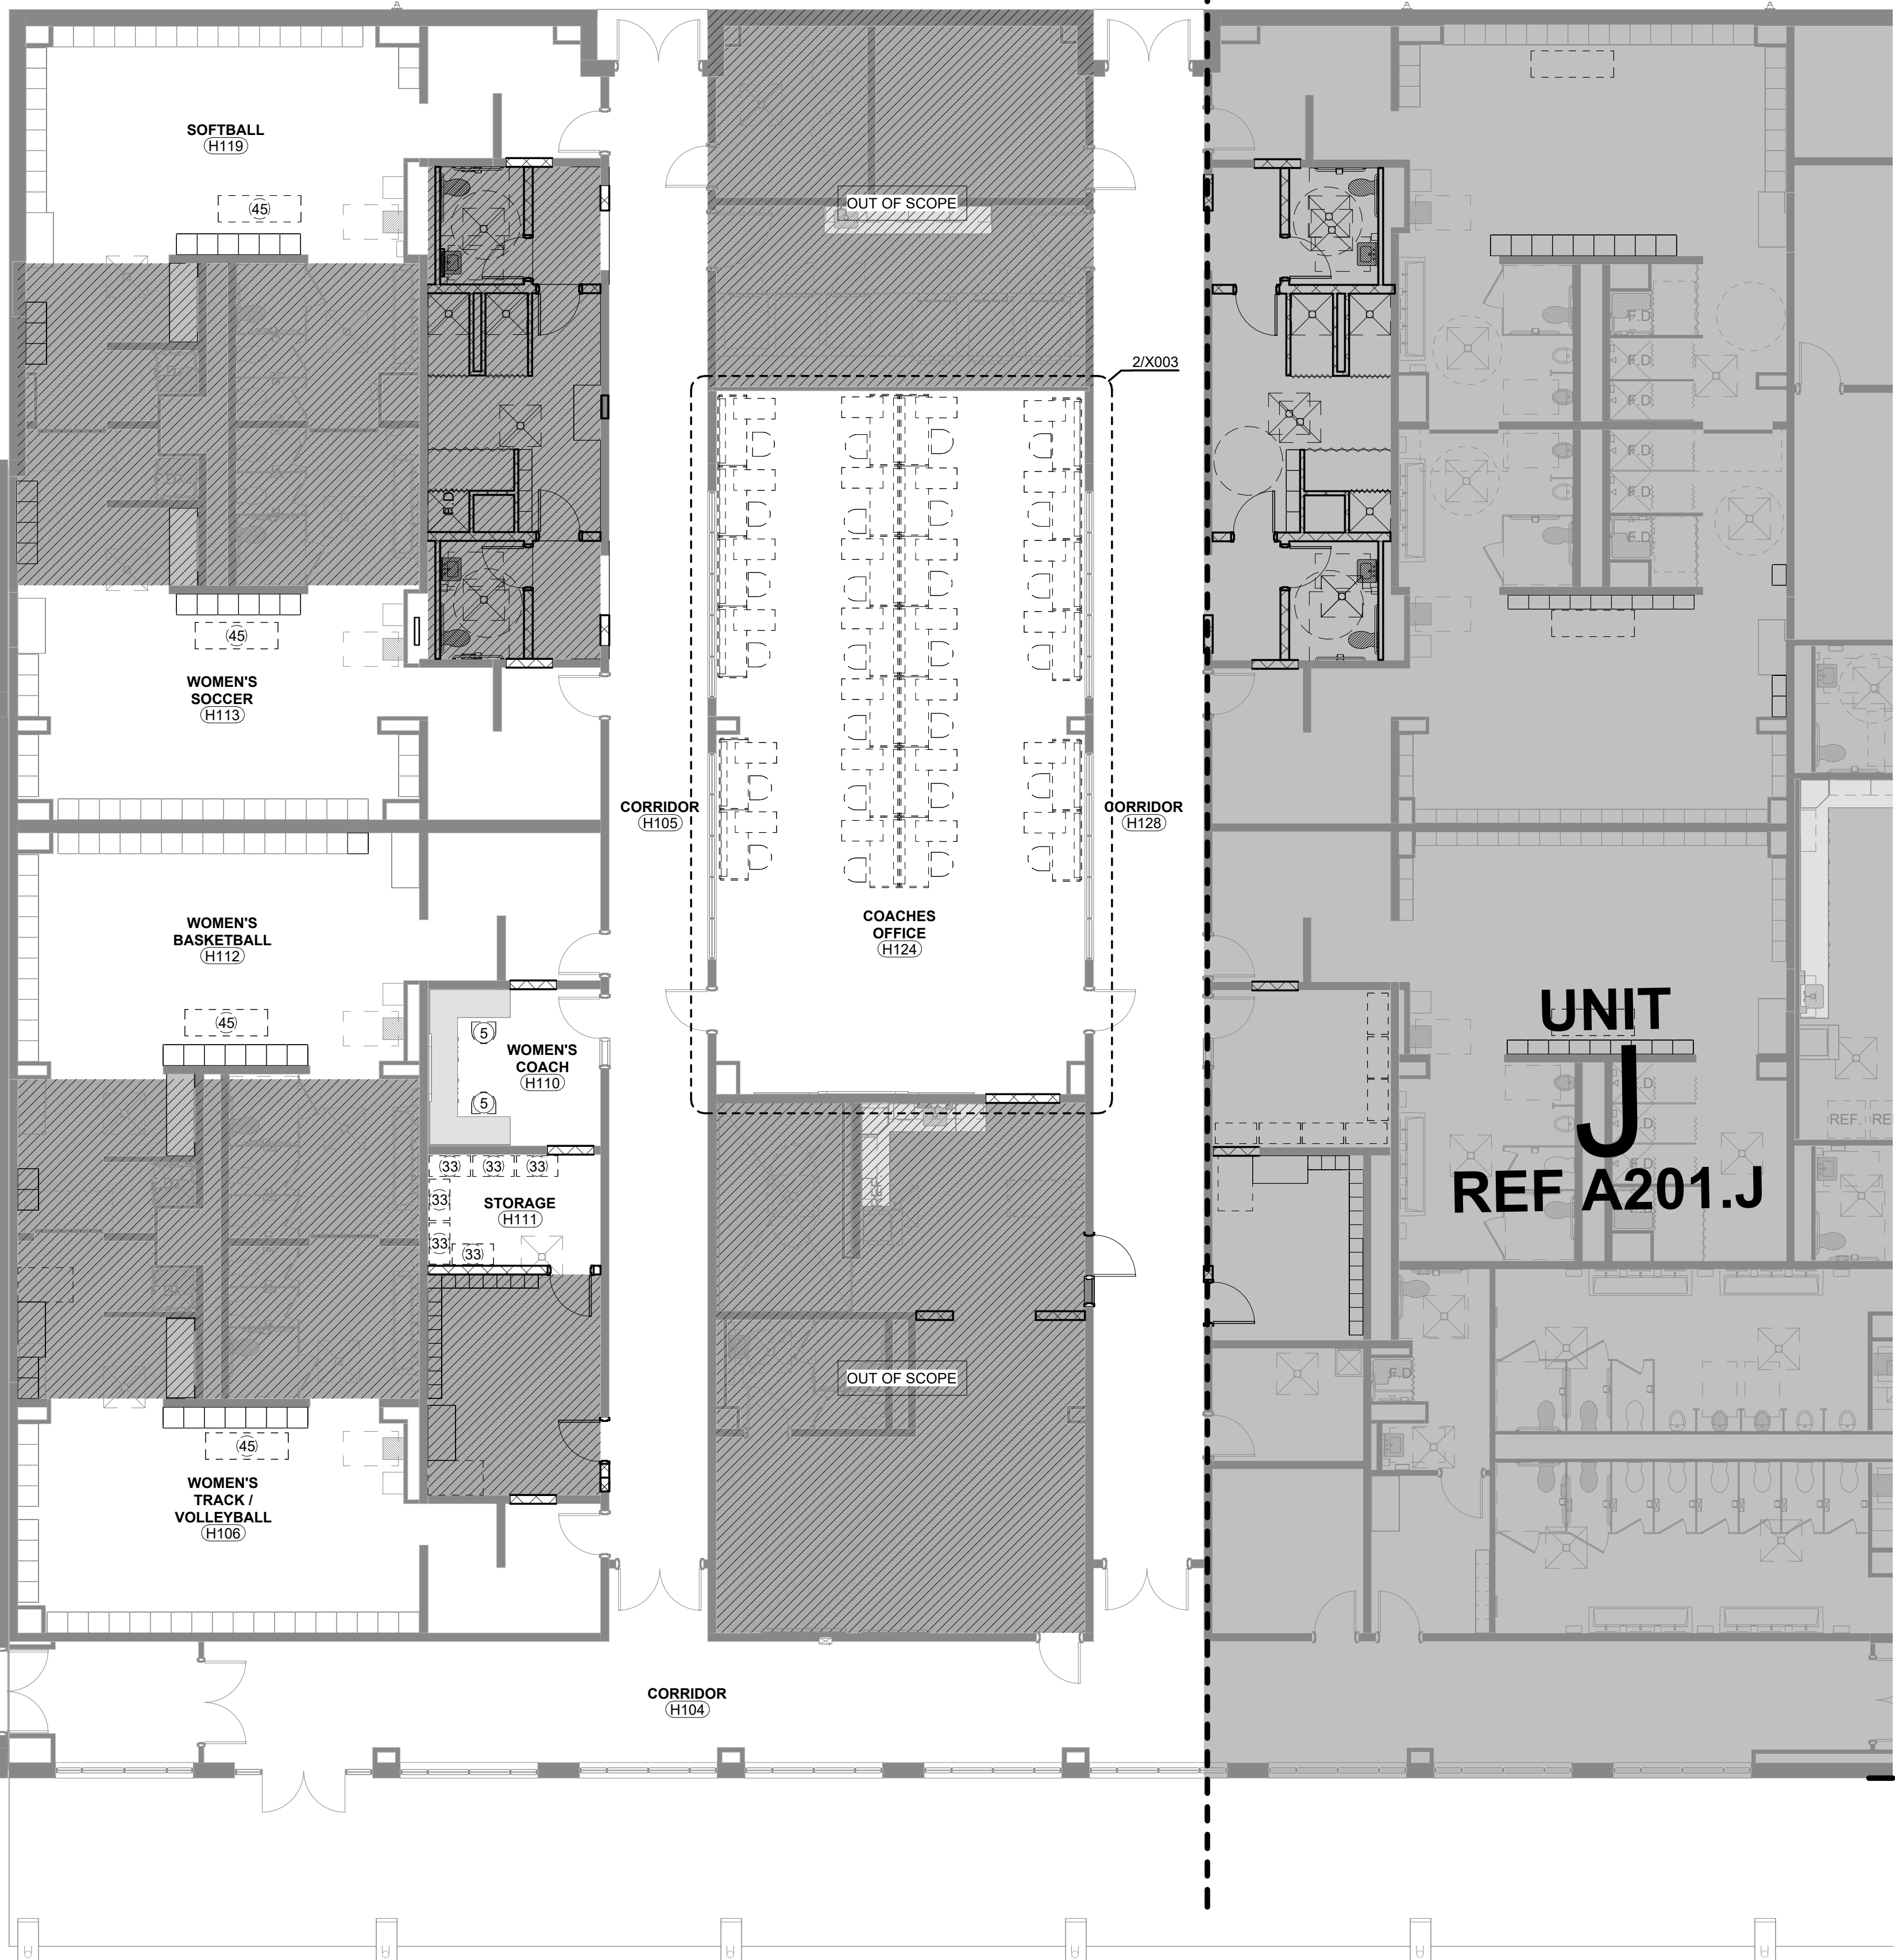


FURNITURE PLAN LEGEND:

NEW FURNITURE

RELOCATED EXISTING FURNITURE



WRA Architects, Inc.
6000 Headquarters Drive
Suite 600
Plano, TX 75024
214-750-0077
www.wraarchitects.com

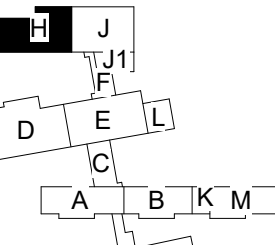

COMMUNITY HS ADDITION & RENOVATION TO 2100
CAPACITY
440 N Farm To Market 1138, Nevada, TX 75173

REVISIONS:
No. 1 Addendum #01
Date 8/13/2026

JOB NO. 2368
DATE: 07/31/2026

Furniture Plan - Level 1
Unit H

X003




www.wraarchitects.com

COMMUNITY ISD HIGH SCHOOL

440 N Farm To Market 1138, Nevada, TX 75173

REVISIONS:	
No.	Date
JOB NO.	2368
DATE:	07/31/2026
Dimension and Power Plan - Level 1 Unit H - H124 Coaches Office	
X003.1	

© WRA Architects, Inc. 2025

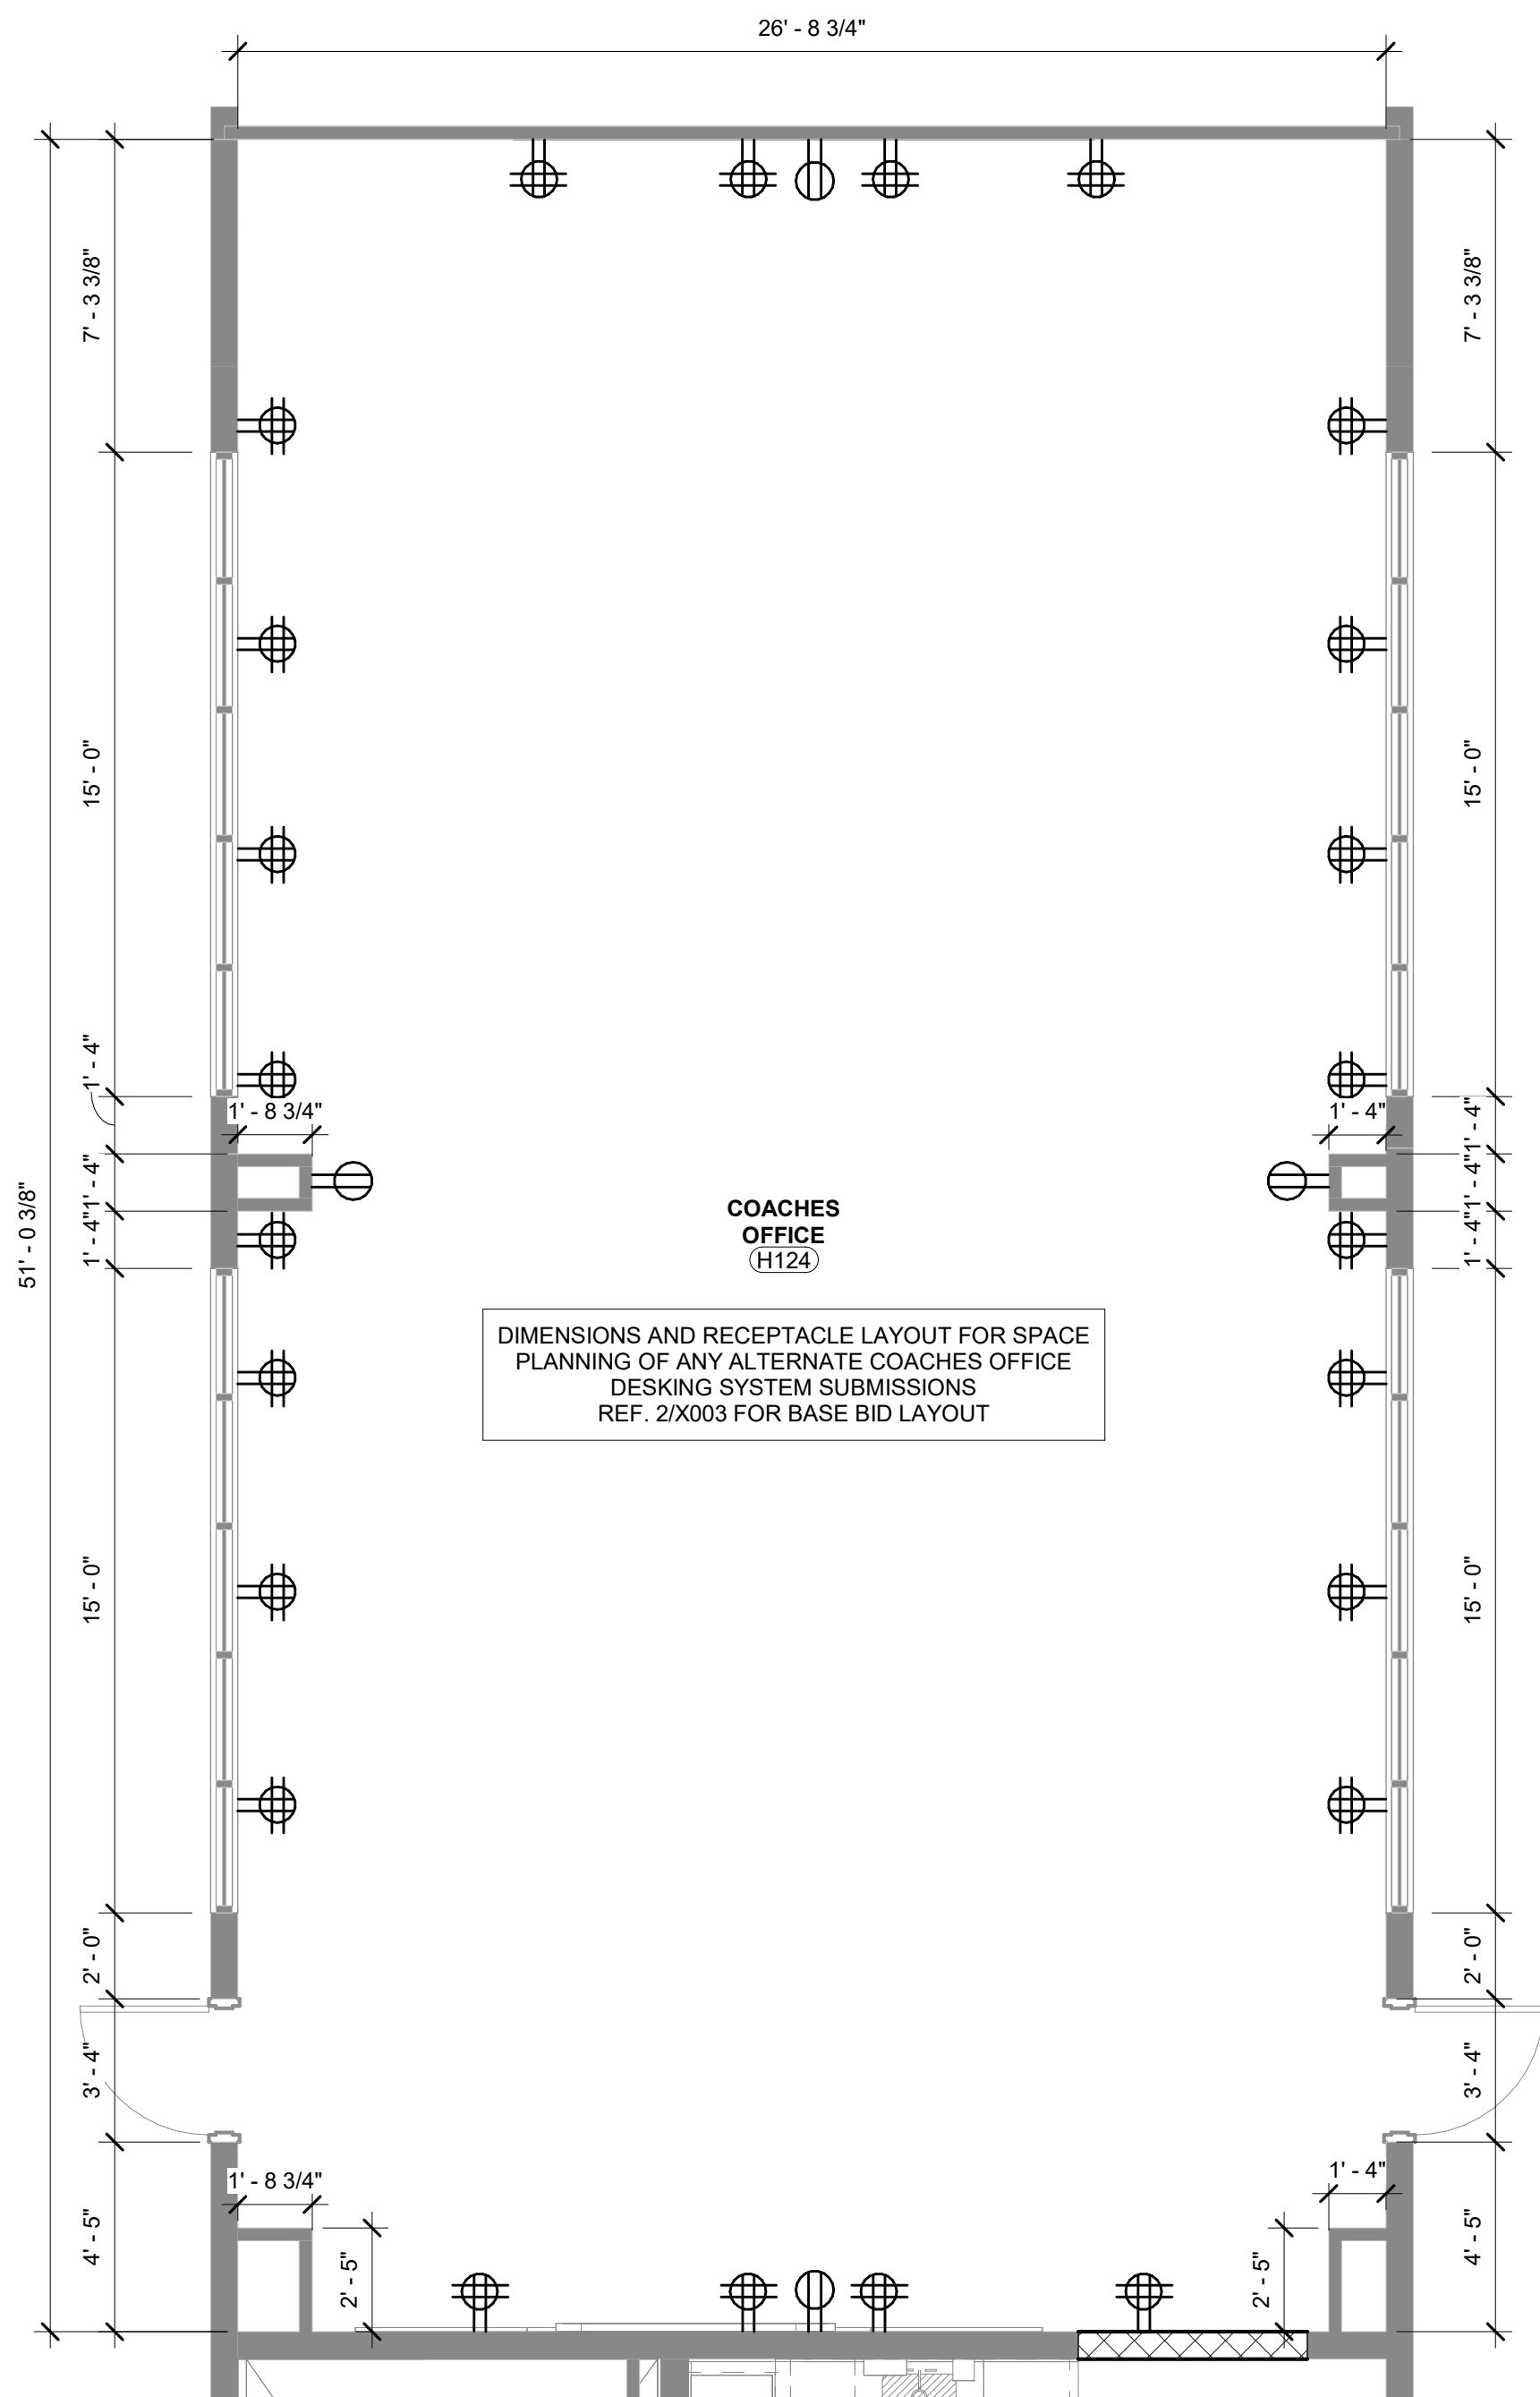

1 Dimension and Power Plan - Level 1 Unit H - H124 Coaches Office
1/4" = 1'-0"


7/28/2026 5:01:03 PM




TRUE NORTH

Furniture Schedule - Level 1 - Unit L			
Type Mark	Count	Model	Description
L101 PLATFORM			
32	8	Virco Inc #X-MTC8AEBG	SPECIAL: Mobile Table, Convertible Bench table, 15-17 High Bench, 27-29 High Table, 8 Long, Table Converts To Backrest, High-Pressure Laminate Top, Sure Edge With Gang Device
L102 DINING			
3	46	Virco Inc #CA25EL	Stool, Civitas Series, 4-Leg, 25" Seat Height, Ergonomically Contoured Extra Large Analogy Polypropylene Shell, Steel Frame, Nylon-Base Swivel Glides.
32	50	Virco Inc #X-MTC8AEBG	SPECIAL: Mobile Table, Convertible Bench table, 15-17 High Bench, 27-29 High Table, 8 Long, Table Converts To Backrest, High-Pressure Laminate Top, Sure Edge With Gang Device
32A	10	"EXISTING" Virco Inc #X-MTC8AEBG	"EXISTING TO BE RELOCATED, NOT TO BE PURCHASED" SPECIAL: Mobile Table, Convertible Bench table, 15-17 High Bench, 27-29 High Table, 8 Long, Table Converts To Backrest, High-Pressure Laminate Top, Sure Edge With Gang Device
L104 STORAGE			
33	9	Republic Storage #DP3002	Open Shelving - 5 Shelf Starter - 36w X 18d X 85h

FURNITURE PLAN LEGEND:
□ NEW FURNITURE
▨ RELOCATED EXISTING FURNITURE

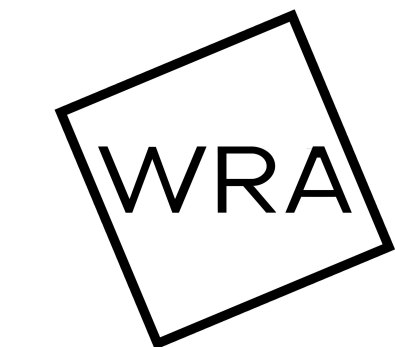

WRA Architects, Inc.
6000 Headquarters Drive
Suite 600
Plano, TX 75024
214-750-0077
www.wraarchitects.com

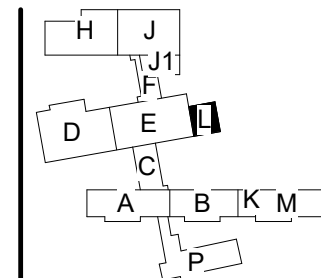


COMMUNITY ISD HIGH SCHOOL
440 N Farm To Market 1138, Nevada, TX 75173

REVISIONS:	
No.	Date
JOB NO.	2368
DATE:	07/31/2026
Furniture Plan - Level 1 Unit L	
X005	

7/28/2026 5:01:16 PM

1

Furniture Plan - Level 1 Unit L
1/8" = 1'-0"

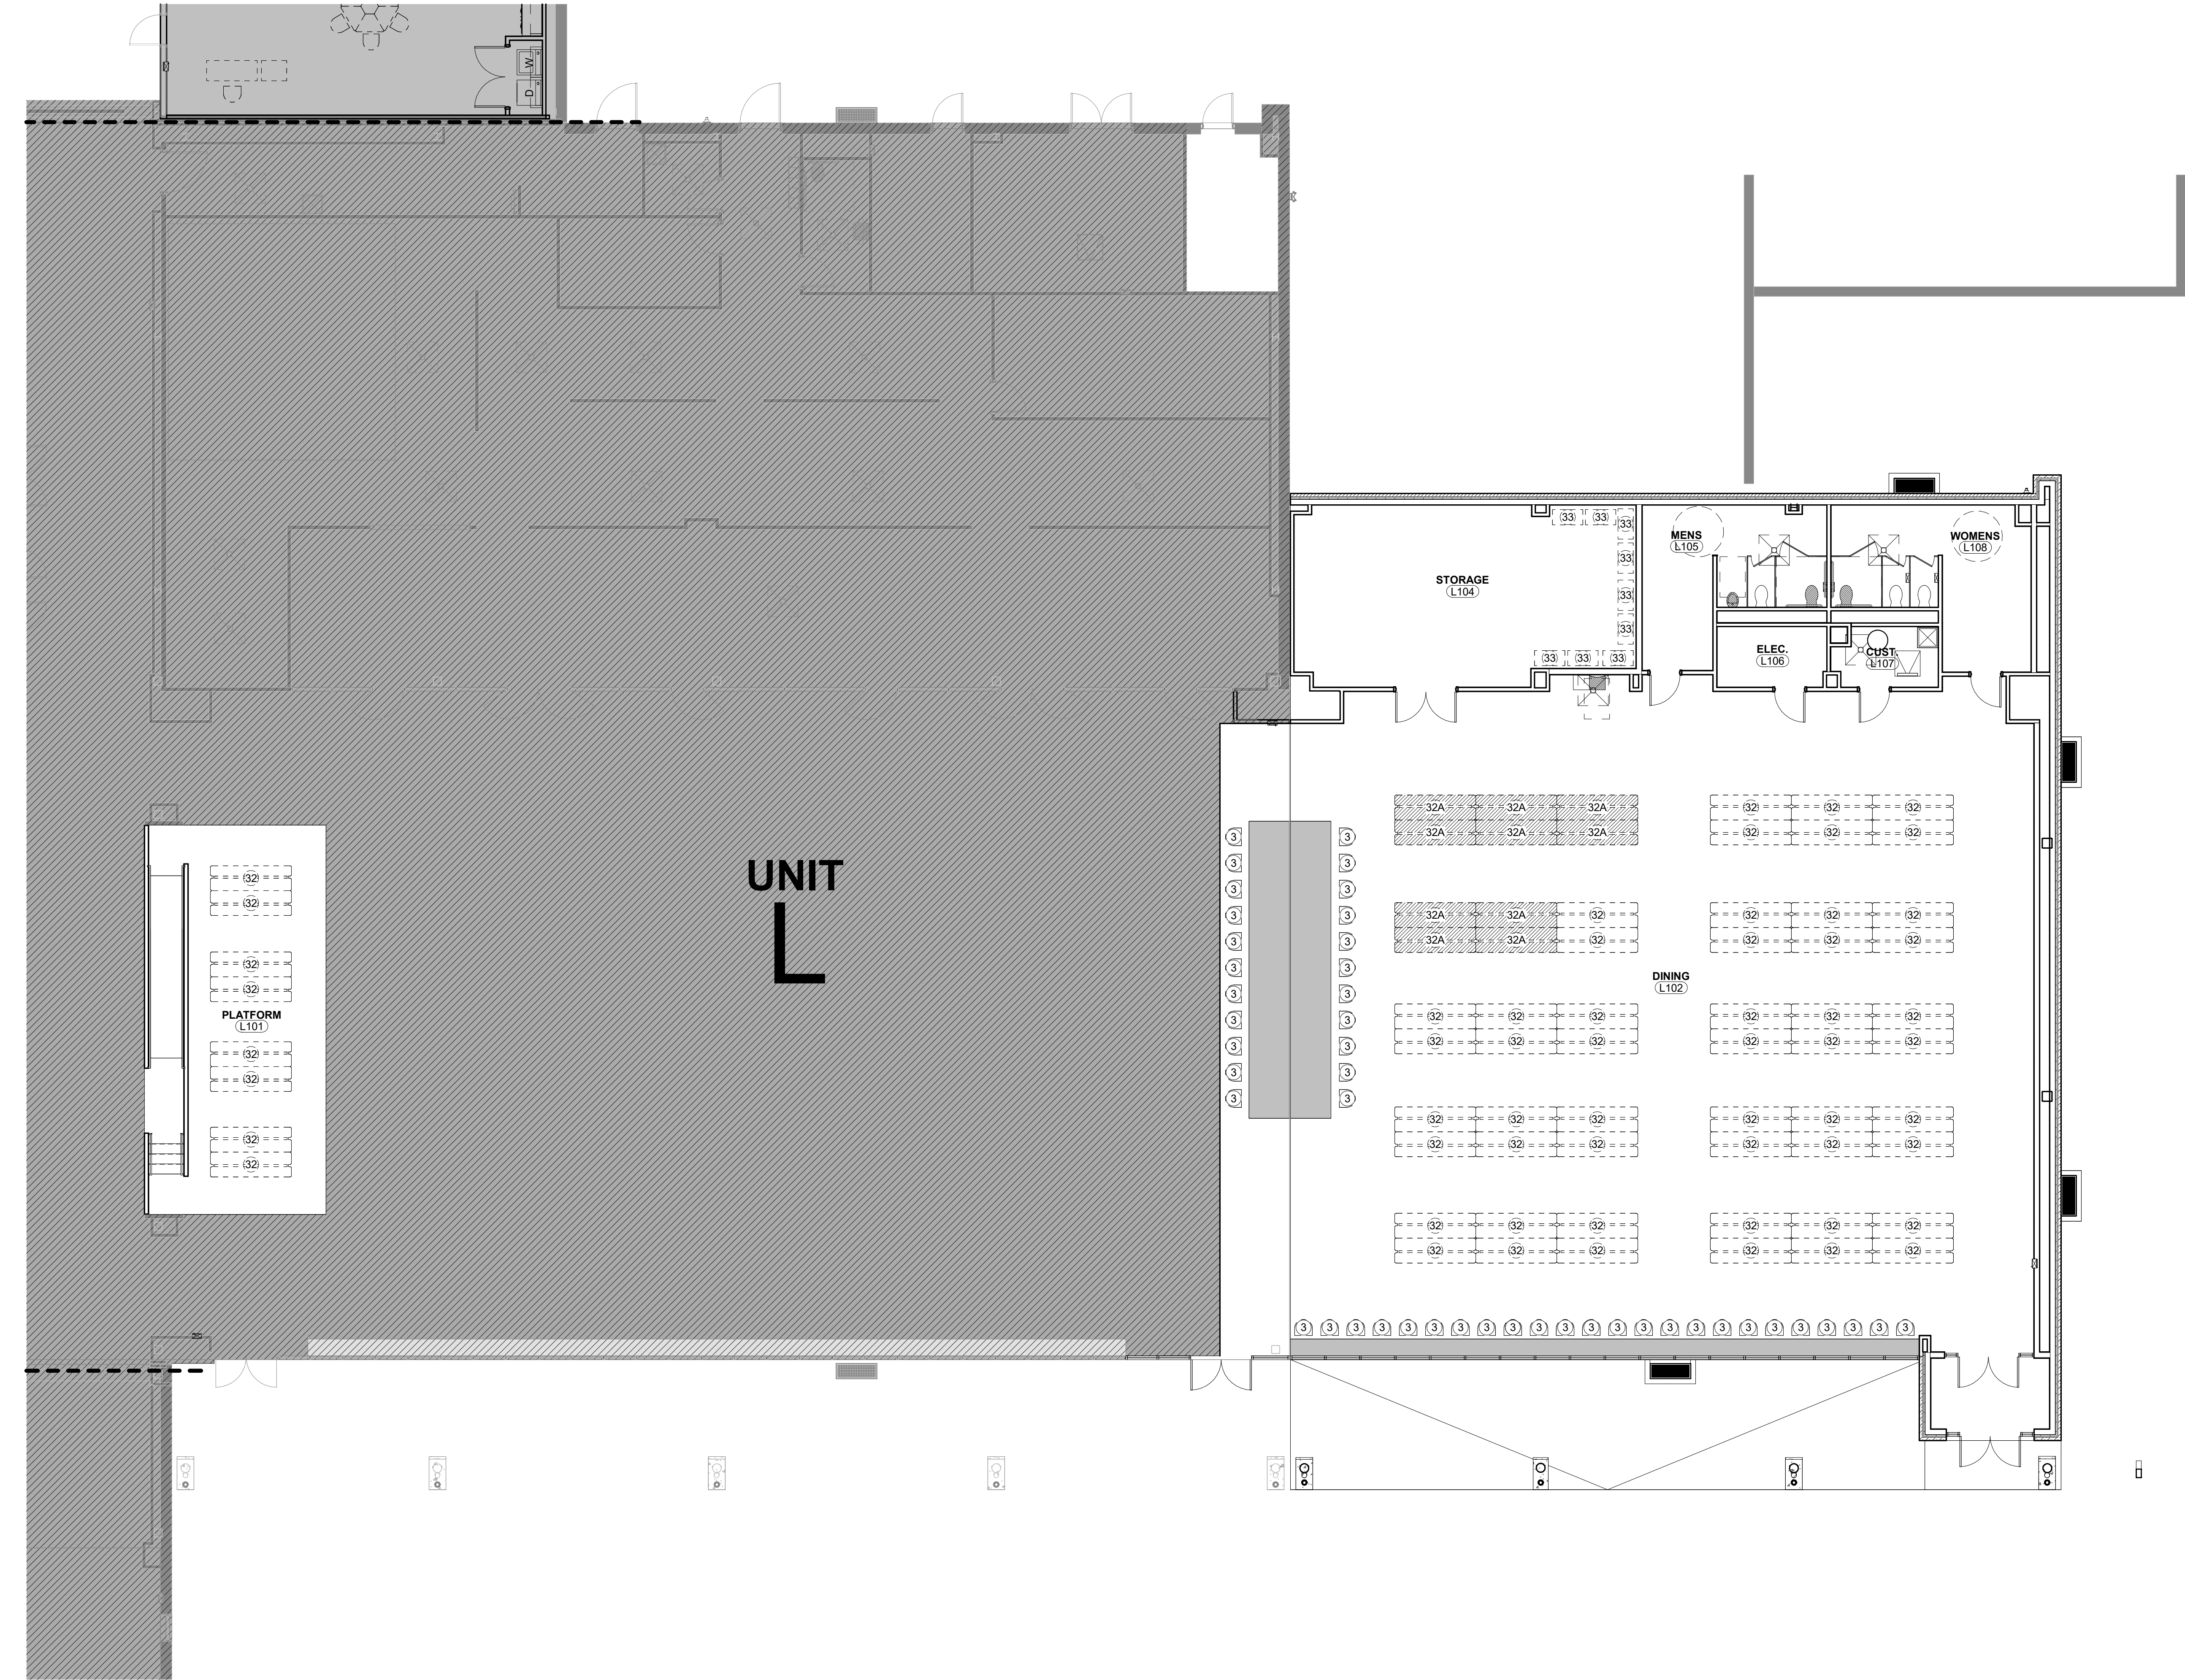

Furniture Schedule - Level 1 - Unit M				
Type Mark	Count	Model	Description	
M102				
3	24	Viroc Inc #C2A2SEL	Stool, Civitas Series, 4-Leg, 25" Seat Height, Ergonomically Contoured Extra Large Analogy Polypropylene Shell, Steel Frame, Nylon-Base Swivel Glides.	
5	1	RMF Seating Task Chair #160	Task Chair - Standard Black Air Mesh Seat -Black Mesh Back -Swivel Tilt Control With Seat Slider -Comfort Molded Foam Tractor Seat -Height Adjustable T Arms With Pads	
M103				
CLASSROOM				
1	30	Viroc Inc #AN18	Chair, Analogy (Tm) Series, 4-Leg, Stackable, 18" Seat Height, Ergonomically Contoured Polypropylene Shell, Steel Frame, Nylon-Base Swivel Glides With Color-Accented Glide Sleeves	
5	1	RMF Seating Task Chair #160	Task Chair - Standard Black Air Mesh Seat -Black Mesh Back -Swivel Tilt Control With Seat Slider -Comfort Molded Foam Tractor Seat -Height Adjustable T Arms With Pads	
10	30	Viroc Inc #ZHEXM	Desk, Zuma Series, Student Desk, 4-Leg, Adjustable 22-32" H, 21-1/8" X 33" Trapezoid Hard Plastic Top, Backpack Hangar, Groups As Hexagon.	
16	1	Viroc Inc #PRC2460DP	Parameter (Tm) Series, Credenza Desk, Double-Pedestal, 24" w X 60" L, 1-1/8" Laminated Top, 2 Grommets, Perforated Modesty Panel, Box/Box/File And File/File Pedestals With Lock, Adjustable Glides.	
17	1	Right Angle #WSSD243024	Lectern, Top Only - 24" x 30" x 24" D-Shape Top - 1 1/8" Core	
18	1	Right Angle #NGABC24272 4	Arriba Lectern, 24"x27"x24" Base as Casters	
34	1	Viroc Inc #BCM3652	Bookcase, 3 adjustable shelves on 1 centers, 12 D x 36 W x 52 H, metal.	
35	1	Viroc Inc #54VF154D	Filing Cabinet, 54 Series, Metal, 4 -Letter Sized Drawers With Lock, 15" w x 26"D 52"H, Full-Extension Steel Ball-Bearing Slides On All Drawers, Counter Weight.	
36	1	Viroc Inc # 53TW3	Wardrobe Tower, 53 Series, Metal, Left-Side Locking Garment Storage Area With Coat Rod, 2 Right-Side Locking Box Drawers, File Drawer & Cupboard	
M105				
CLASSROOM				
1	30	Viroc Inc #AN18	Chair, Analogy (Tm) Series, 4-Leg, Stackable, 18" Seat Height, Ergonomically Contoured Polypropylene Shell, Steel Frame, Nylon-Base Swivel Glides With Color-Accented Glide Sleeves	
5	1	RMF Seating Task Chair #160	Task Chair - Standard Black Air Mesh Seat -Black Mesh Back -Swivel Tilt Control With Seat Slider -Comfort Molded Foam Tractor Seat -Height Adjustable T Arms With Pads	
10	30	Viroc Inc #ZHEXM	Desk, Zuma Series, Student Desk, 4-Leg, Adjustable 22-32" H, 21-1/8" X 33" Trapezoid Hard Plastic Top, Backpack Hangar, Groups As Hexagon.	
16	1	Viroc Inc #PRC2460DP	Parameter (Tm) Series, Credenza Desk, Double-Pedestal, 24" w X 60" L, 1-1/8" Laminated Top, 2 Grommets, Perforated Modesty Panel, Box/Box/File And File/File Pedestals With Lock, Adjustable Glides.	
17	1	Right Angle #WSSD243024	Lectern, Top Only - 24" x 30" x 24" D-Shape Top - 1 1/8" Core	
18	1	Right Angle #NGABC24272 4	Arriba Lectern, 24"x27"x24" Base as Casters	
34	1	Viroc Inc #BCM3652	Bookcase, 3 adjustable shelves on 1 centers, 12 D x 36 W x 52 H, metal.	
35	1	Viroc Inc #54VF154D	Filing Cabinet, 54 Series, Metal, 4 -Letter Sized Drawers With Lock, 15" w x 26"D 52"H, Full-Extension Steel Ball-Bearing Slides On All Drawers, Counter Weight.	
36	1	Viroc Inc # 53TW3	Wardrobe Tower, 53 Series, Metal, Left-Side Locking Garment Storage Area With Coat Rod, 2 Right-Side Locking Box Drawers, File Drawer & Cupboard	
M115				
SRO				
5	1	RMF Seating Task Chair #160	Task Chair - Standard Black Air Mesh Seat -Black Mesh Back -Swivel Tilt Control With Seat Slider -Comfort Molded Foam Tractor Seat -Height Adjustable T Arms With Pads	
6	4	RFM Seating #9531NA-GradeB	Guest / Side Chair - Stacking - Reinforced Black Steel Frame - No Arms - Black Mesh Back - Upholstered Seat	
15	1	Viroc Inc #TABLE-4836R	36" Round Table, 30"H, L1 Laminate top and adjustable Legs on glides.	
28	1	High Point #H_651R2BFC	66x30 Right Full Pedestal Desk - B/B/F - Center Drawer with Grommets	
29	1	High Point #H_622LF	42x24 Left Full Pedestal Desk - F/F with Grommets	
37	1	High Point #H_319	Overhead Bookcase - 36x16x36 1/2" - 2 Adj Shelves - Fits 36" Laterals and Multi File or Two Door Storage Cabinet	
38	1	High Point #H_346	36x24x29 Two-Drawer Lateral File with Lock	
M116				
HEALTH SCIENCE				
3	30	Viroc Inc #C2A2SEL	Stool, Civitas Series, 4-Leg, 25" Seat Height, Ergonomically Contoured Extra Large Analogy Polypropylene Shell, Steel Frame, Nylon-Base Swivel Glides.	
5	1	RMF Seating Task Chair #160	Task Chair - Standard Black Air Mesh Seat -Black Mesh Back -Swivel Tilt Control With Seat Slider -Comfort Molded Foam Tractor Seat -Height Adjustable T Arms With Pads	


Furniture Schedule - Level 1 - Unit M				
Type Mark	Count	Model	Description	
M117 EVIDENCE				
33	4	Republic Storage #DP3002	Open Shelving - 5 Shelf Starter - 36w X 18d X 85h	
M118 WELLNESS				
9	1	Hon #HFCG6	Flock Casual Guest Chair, Metal Legs - 4-Leg, Upholstered Back and Seat, 19 7/8" W x 23 1/2" D x 32 3/8" H	
M118.1 STORAGE				
33	3	Republic Storage #DP3002	Open Shelving - 5 Shelf Starter - 36w X 18d X 85h	
M120 TEACHERS WORKROOM				
1A	8	"EXISTING" Viroc Inc #AN18	"EXISTING TO BE RELOCATED, NOT TO BE PURCHASED" Chair, Analogy (Tm) Series, 4-Leg, Stackable, 18" Seat Height, Ergonomically Contoured Polypropylene Shell, Steel Frame, Nylon-Base Swivel Glides With Color-Accented Glide Sleeve	
14	2	Viroc Inc #683060ADJ	Table, 6800 Series, Multi-Purpose table, Adjustable Legs, 30x60x24-34H - High-Pressure Laminate Top.	
M121 CLASSROOM				
1	30	Viroc Inc #AN18	Chair, Analogy (Tm) Series, 4-Leg, Stackable, 18" Seat Height, Ergonomically Contoured Polypropylene Shell, Steel Frame, Nylon-Base Swivel Glides With Color-Accented Glide Sleeves	
5	1	RMF Seating Task Chair #160	Task Chair - Standard Black Air Mesh Seat -Black Mesh Back -Swivel Tilt Control With Seat Slider -Comfort Molded Foam Tractor Seat -Height Adjustable T Arms With Pads	
10	30	Viroc Inc #ZHEXM	Desk, Zuma Series, Student Desk, 4-Leg, Adjustable 22-32" H, 21-1/8" X 33" Trapezoid Hard Plastic Top, Backpack Hangar, Groups As Hexagon.	
16	1	Viroc Inc #PRC2460DP	Parameter (Tm) Series, Credenza Desk, Double-Pedestal, 24" w X 60" L, 1-1/8" Laminated Top, 2 Grommets, Perforated Modesty Panel, Box/Box/File And File/File Pedestals With Lock, Adjustable Glides.	
17	1	Right Angle #WSSD243024	Lectern, Top Only - 24" x 30" x 24" D- Shape Top - 1 1/8" Core	
18	1	Right Angle #NGABC24272 4	Arriba Lectern, 24"x27"x24" Base as Casters	
34	1	Viroc Inc #BCM3652	Bookcase, 3 adjustable shelves on 1 centers, 12 D X 36 W X 52 H, metal.	
35	1	Viroc Inc #54VF154D	Filing Cabinet, 54 Series, Metal, 4 -Letter Sized Drawers With Lock, 15" w x 26"D 52"H, Full-Extension Steel Ball-Bearing Slides On All Drawers, Counter Weight	
36	1	Viroc Inc # 53TW3	Wardrobe Tower, 53 Series, Metal, Left-Side Locking Garment Storage Area With Coat Rod, 2 Right-Side Locking Box Drawers, File Drawer & Cupboard	
M122 ASSISTANT PRINCIPAL				
5	1	RMF Seating Task Chair #160	Task Chair - Standard Black Air Mesh Seat -Black Mesh Back -Swivel Tilt Control With Seat Slider -Comfort Molded Foam Tractor Seat -Height Adjustable T Arms With Pads	
6	2	RFM Seating #9531NA-Grade B	Guest / Side Chair - Stacking - Reinforced Black Steel Frame - No Arms - Black Mesh Back - Upholstered Seat	
26	1	High Point #H_651L2BFC	66x30 Left Full Pedestal Desk - B/B/F - Center Drawer with Grommets	
27	1	High Point #H_622RF	42x24 Right Full Pedestal Desk - F/F with Grommets	
37	1	High Point #H_319	Overhead Bookcase - 36x16x36 1/2" - 2 Adj Shelves - Fits 36" Laterals and Multi File or Two Door Storage Cabinet	
38	1	High Point #H_346	36x24x29 Two-Drawer Lateral File with Lock	
M123 CLASSROOM				
1	30	Viroc Inc #AN18	Chair, Analogy (Tm) Series, 4-Leg, Stackable, 18" Seat Height, Ergonomically Contoured Polypropylene Shell, Steel Frame, Nylon-Base Swivel Glides With Color-Accented Glide Sleeves	
5	1	RMF Seating Task Chair #160	Task Chair - Standard Black Air Mesh Seat -Black Mesh Back -Swivel Tilt Control With Seat Slider -Comfort Molded Foam Tractor Seat -Height Adjustable T Arms With Pads	
10	30	Viroc Inc #ZHEXM	Desk, Zuma Series, Student Desk, 4-Leg, Adjustable 22-32" H, 21-1/8" X 33" Trapezoid Hard Plastic Top, Backpack Hangar, Groups As Hexagon.	
16	1	Viroc Inc #PRC2460DP	Parameter (Tm) Series, Credenza Desk, Double-Pedestal, 24" w X 60" L, 1-1/8" Laminated Top, 2 Grommets, Perforated Modesty Panel, Box/Box/File And File/File Pedestals With Lock, Adjustable Glides.	
17	1	Right Angle #WSSD243024	Lectern, Top Only - 24" x 30" x 24" D- Shape Top - 1 1/8" Core	
18	1	Right Angle #NGABC24272 4	Arriba Lectern, 24"x27"x24" Base as Casters	
34	1	Viroc Inc #BCM3652	Bookcase, 3 adjustable shelves on 1 centers, 12 D X 36 W X 52 H, metal.	

Furniture Schedule - Level 1 - Unit M				
Type Mark	Count	Model	Description	
35	1	Viroc Inc #54VF154D	Filing Cabinet, 54 Series, Metal, 4 -Letter Sized Drawers With Lock, 15" w x 26"D 52"H, Full-Extension Steel Ball-Bearing Slides On All Drawers, Counter Weight	
36	1	Viroc Inc # 53TW3	Wardrobe Tower, 53 Series, Metal, Left-Side Locking Garment Storage Area With Coat Rod, 2 Right-Side Locking Box Drawers, File Drawer & Cupboard	
M125 CLASSROOM				
1	30	Viroc Inc #AN18	Chair, Analogy (Tm) Series, 4-Leg, Stackable, 18" Seat Height, Ergonomically Contoured Polypropylene Shell, Steel Frame, Nylon-Base Swivel Glides With Color-Accented Glide Sleeves	
5	1	RMF Seating Task Chair #160	Task Chair - Standard Black Air Mesh Seat -Black Mesh Back -Swivel Tilt Control With Seat Slider -Comfort Molded Foam Tractor Seat -Height Adjustable T Arms With Pads	
10	30	Viroc Inc #ZHEXM	Desk, Zuma Series, Student Desk, 4-Leg, Adjustable 22-32" H, 21-1/8" X 33" Trapezoid Hard Plastic Top, Backpack Hangar, Groups As Hexagon.	
16	1	Viroc Inc #PRC2460DP	Parameter (Tm) Series, Credenza Desk, Double-Pedestal, 24" w X 60" L, 1-1/8" Laminated Top, 2 Grommets, Perforated Modesty Panel, Box/Box/File And File/File Pedestals With Lock, Adjustable Glides.	
17	1	Right Angle #WSSD243024	Lectern, Top Only - 24" x 30" x 24" D- Shape Top - 1 1/8" Core	
18	1	Right Angle #NGABC24272 4	Arriba Lectern, 24"x27"x24" Base as Casters	
34	1	Viroc Inc #BCM3652	Bookcase, 3 adjustable shelves on 1 centers, 12 D x 36 W x 52 H, metal.	
35	1	Viroc Inc #54VF154D	Filing Cabinet, 54 Series, Metal, 4 -Letter Sized Drawers With Lock, 15" w x 26"D 52"H, Full-Extension Steel Ball-Bearing Slides On All Drawers, Counter Weight	
36	1	Viroc Inc # 53TW3	Wardrobe Tower, 53 Series, Metal, Left-Side Locking Garment Storage Area With Coat Rod, 2 Right-Side Locking Box Drawers, File Drawer & Cupboard	
M130 CONFERENCE				
5	8	RMF Seating Task Chair #160	Task Chair - Standard Black Air Mesh Seat -Black Mesh Back -Swivel Tilt Control With Seat Slider -Comfort Molded Foam Tractor Seat -Height Adjustable T Arms With Pads	
30	1	HON #HTLHP144	Preside Laminate Seated-Height Hollow Panel Base for 144"W Tabletop (2 Per Kit)	
31	1	HON #HTLA48144	Preside Laminate Racetrack Tabletop w/ built-in receptacle, 144" W x 48" D	
M136 CLASSROOM				
1	30	Viroc Inc #AN18	Chair, Analogy (Tm) Series, 4-Leg, Stackable, 18" Seat Height, Ergonomically Contoured Polypropylene Shell, Steel Frame, Nylon-Base Swivel Glides With Color-Accented Glide Sleeves	
5	1	RMF Seating Task Chair #160	Task Chair - Standard Black Air Mesh Seat -Black Mesh Back -Swivel Tilt Control With Seat Slider -Comfort Molded Foam Tractor Seat -Height Adjustable T Arms With Pads	
10	30	Viroc Inc #ZHEXM	Desk, Zuma Series, Student Desk, 4-Leg, Adjustable 22-32" H, 21-1/8" X 33" Trapezoid Hard Plastic Top, Backpack Hangar, Groups As Hexagon.	
16	1	Viroc Inc #PRC2460DP	Parameter (Tm) Series, Credenza Desk, Double-Pedestal, 24" w X 60" L, 1-1/8" Laminated Top, 2 Grommets, Perforated Modesty Panel, Box/Box/File And File/File Pedestals With Lock, Adjustable Glides.	
17	1	Right Angle #WSSD243024	Lectern, Top Only - 24" x 30" x 24" D- Shape Top - 1 1/8" Core	
18	1	Right Angle #NGABC24272 4	Arriba Lectern, 24"x27"x24" Base as Casters	
34	1	Viroc Inc #BCM3652	Bookcase, 3 adjustable shelves on 1 centers, 12 D x 36 W x 52 H, metal.	
35	1	Viroc Inc #54VF154D	Filing Cabinet, 54 Series, Metal, 4 -Letter Sized Drawers With Lock, 15" w x 26"D 52"H, Full-Extension Steel Ball-Bearing Slides On All Drawers, Counter Weight	
36	1	Viroc Inc # 53TW3	Wardrobe Tower, 53 Series, Metal, Left-Side Locking Garment Storage Area With Coat Rod, 2 Right-Side Locking Box Drawers, File Drawer & Cupboard	
M138 CLASSROOM				
1	30	Viroc Inc #AN18	Chair, Analogy (Tm) Series, 4-Leg, Stackable, 18" Seat Height, Ergonomically Contoured Polypropylene Shell, Steel Frame, Nylon-Base Swivel Glides With Color-Accented Glide Sleeves	
5	1	RMF Seating Task Chair #160	Task Chair - Standard Black Air Mesh Seat -Black Mesh Back -Swivel Tilt Control With Seat Slider -Comfort Molded Foam Tractor Seat -Height Adjustable T Arms With Pads	
10	30	Viroc Inc #ZHEXM	Desk, Zuma Series, Student Desk, 4-Leg, Adjustable 22-32" H, 21-1/8" X 33" Trapezoid Hard Plastic Top, Backpack Hangar, Groups As Hexagon.	
16	1	Viroc Inc #PRC2460DP	Parameter (Tm) Series, Credenza Desk, Double-Pedestal, 24" w X 60" L, 1-1/8" Laminated Top, 2 Grommets, Perforated Modesty Panel, Box/Box/File And File/File Pedestals With Lock, Adjustable Glides.	
17	1	Right Angle #WSSD243024	Lectern, Top Only - 24" x 30" x 24" D- Shape Top - 1 1/8" Core	
18	1	Right Angle #NGABC24272 4	Arriba Lectern, 24"x27"x24" Base as Casters	
34	1	Viroc Inc #BCM3652	Bookcase, 3 adjustable shelves on 1 centers, 12 D x 36 W x 52 H, metal.	
35	1	Viroc Inc #54VF154D	Filing Cabinet, 54 Series, Metal, 4 -Letter Sized Drawers With Lock, 15" w x 26"D 52"H, Full-Extension Steel Ball-Bearing Slides On All Drawers, Counter Weight	
36	1	Viroc Inc # 53TW3	Wardrobe Tower, 53 Series, Metal, Left-Side Locking Garment Storage Area With Coat Rod, 2 Right-Side Locking Box Drawers, File Drawer & Cupboard	

FURNITURE PLAN LEGEND:

NEW FURNITURE

RELOCATED EXISTING FURNITURE

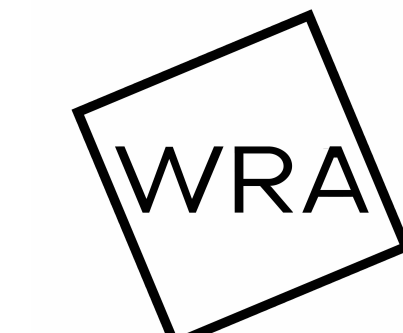

WRA Architects, Inc.
6000 Headquarters Drive
Suite 600
Plano, TX 75024
214-750-0077
www.wraarchitects.com

COMMUNITY HS ADDITION & RENOVATION TO 2100
CAPACITY
440 N Farm To Market 1138, Nevada, TX 75173

REVISIONS:


No.	Date
1	Addendum #01 8/13/2026

JOB NO. 2368
DATE: 07/31/2026

Furniture Plan - Level 1
Unit M

X006

© WRA Architects, Inc. 2025

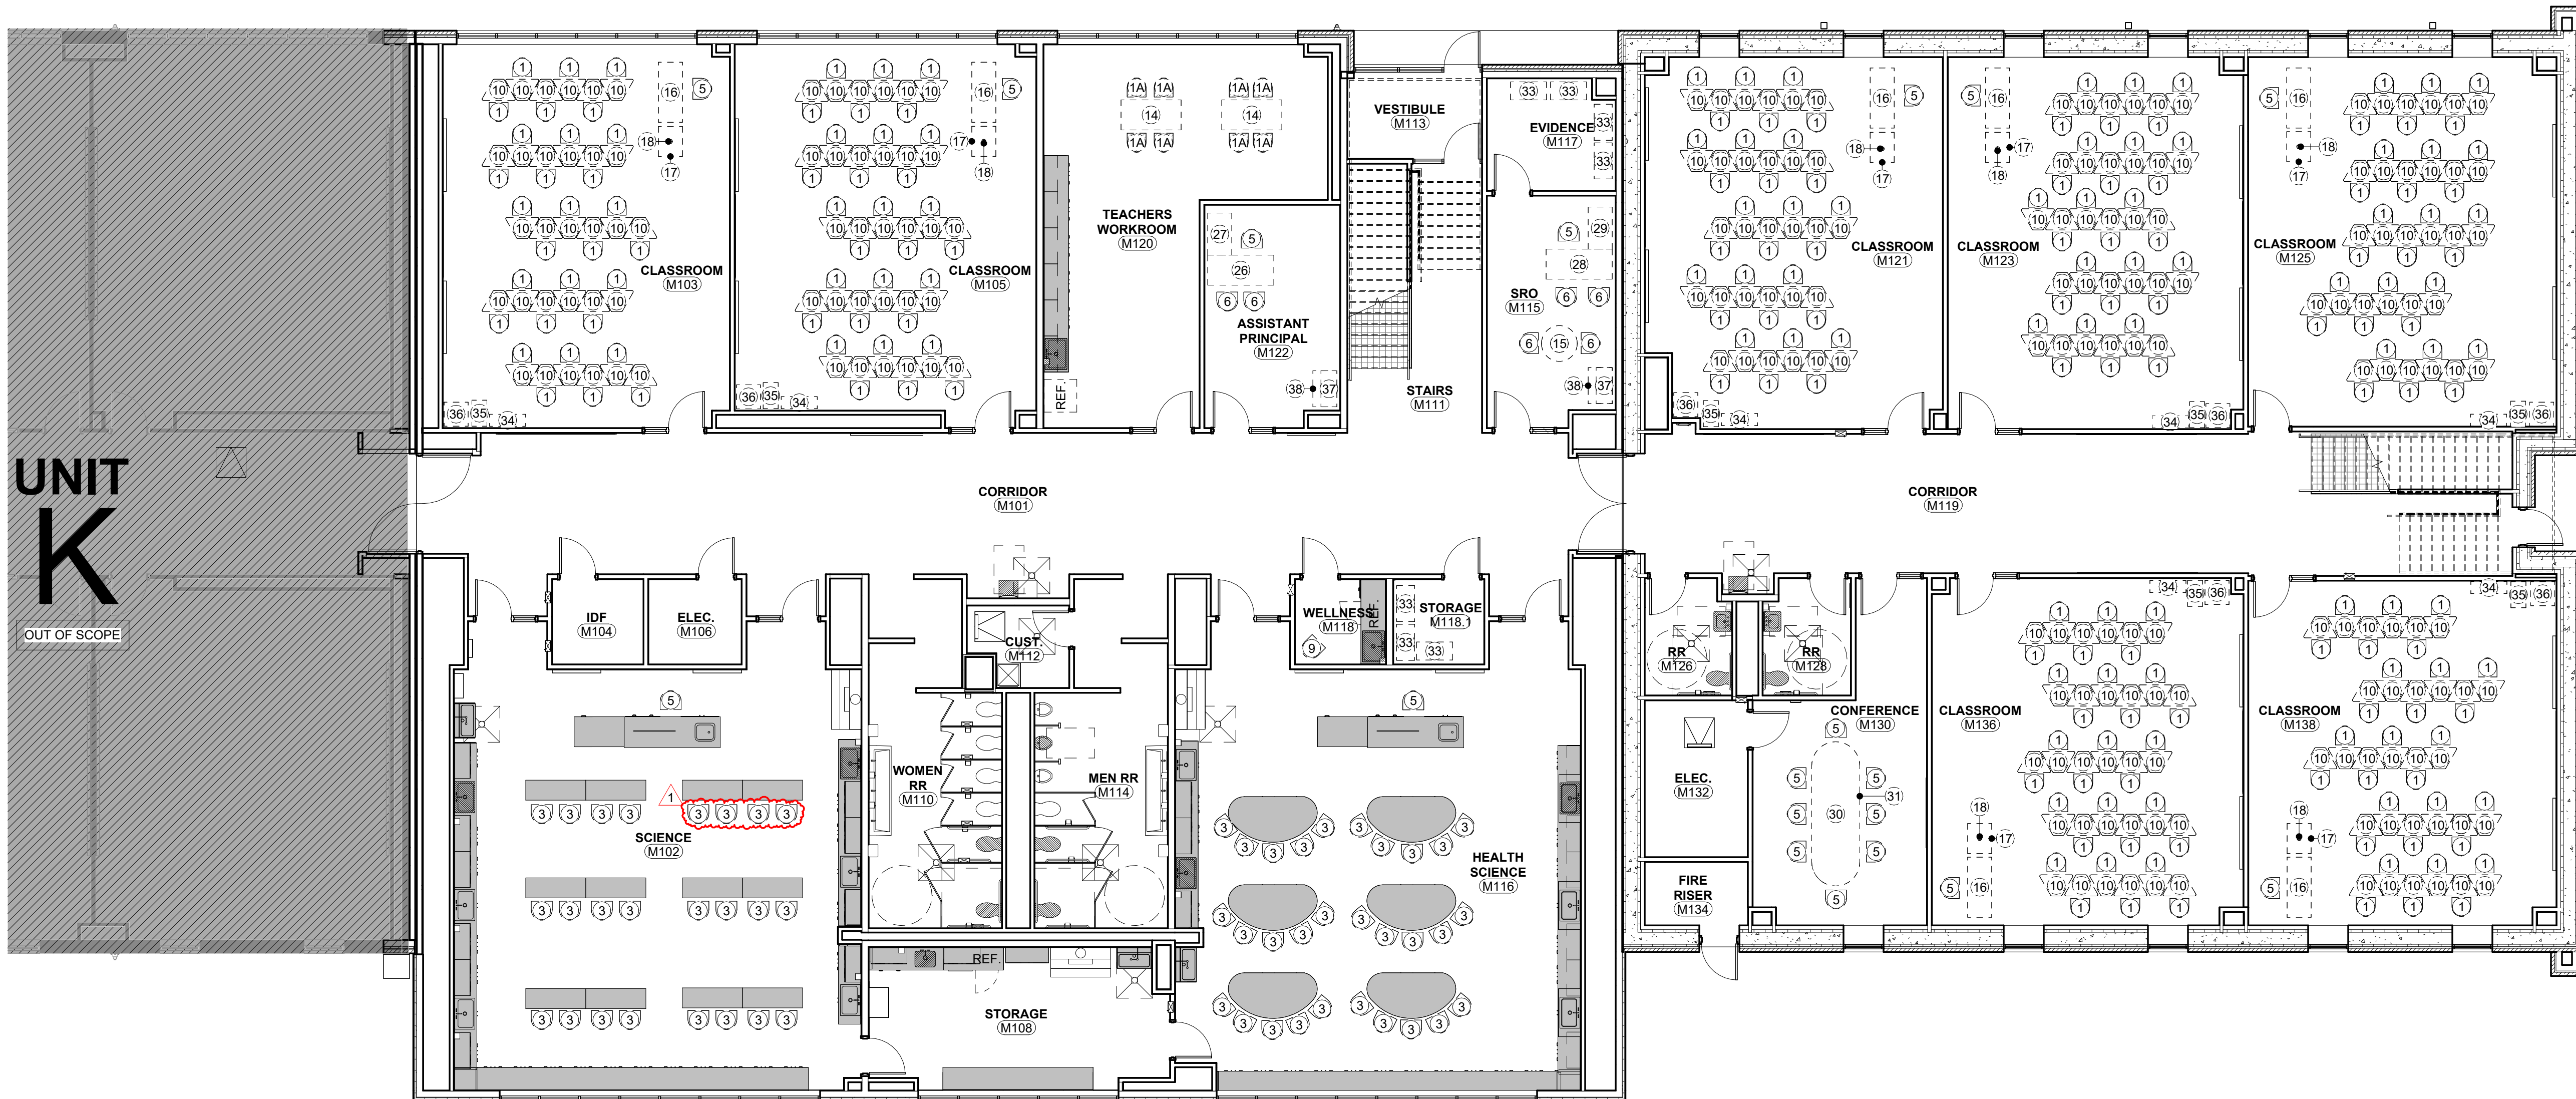


1 Furniture Plan - Level 1 Unit M
1/8" = 1'-0"

8/12/2026 8:11:51 PM



1 Furniture Plan - Level 1 Unit P
1/8" = 1'-0"

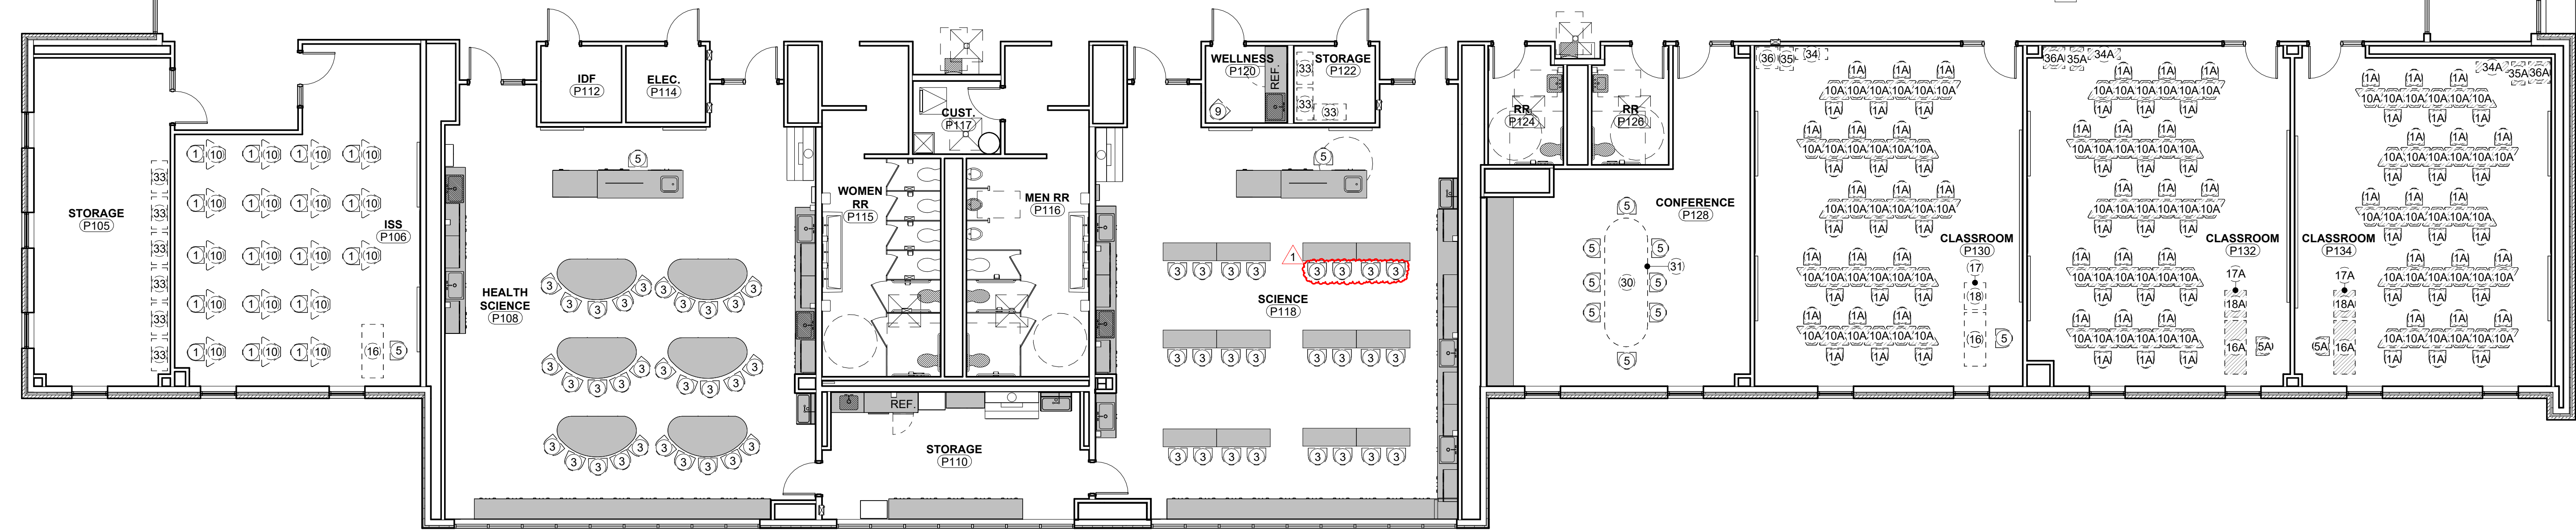


REF. X007.1 FOR LEVEL 1 - UNIT P FURNITURE SCHEDULE

FURNITURE PLAN LEGEND:
□ NEW FURNITURE
▨ RELOCATED EXISTING FURNITURE



WRA Architects, Inc.
6000 Headquarters Drive
Suite 600
Plano, TX 75024
214-750-0077
www.wraarchitects.com

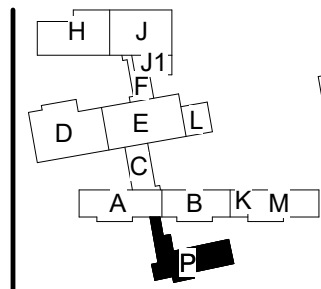

COMMUNITY HS ADDITION & RENOVATION TO 2100
CAPACITY

440 N Farm To Market 1138, Nevada, TX 75173

REVISIONS:	
No.	Date
1	Addendum #01 8/13/2026
JOB NO. 2368	
DATE: 07/31/2026	
Furniture Plan - Level 1 Unit P	
X007	
© WRA Architects, Inc. 2025	

Furniture Schedule - Level 1 - Unit P				
Type Mark	Count	Model	Description	
P102 ADULT TRANSITION				
1	20	Virco Inc #AN18	Chair, Analogy (Tm) Series, 4-Leg, Stackable, 18" Seat Height, Ergonomically Contoured Polypropylene Shell, Steel Frame, Nylon-Base Swivel Glides With Color-Accented Glide Sleeves	
5	1	RMF Seating Task Chair #160	Task Chair - Standard Black Air Mesh Seat -Black Mesh Back -Swivel Tilt Control With Seat Slider -Comfort Molded Foam Tractor Seat -Height Adjustable T Arms With Pads	
10	12	Virco Inc #2HEXM	Desk, Zuma Series, Student Desk, 4-Legs, Adjustable 22-32" H, 21-1/8" X 33" Trapezoid Hard Plastic Top, Backpack Hangar, Groups As Hexagon.	
11	4	Virco Inc #503060ADJ	5000 Series Table 30"x60"x 1-1/8" High-Pressure Laminate Particle Board-Core Surface With Four 2-1/4" Diameter Legs With A Powder Coat Upper and Chrome Lower, adjustable height 22-32", Premium Abs Plastic Glides	
16	1	Virco Inc #PRC2460DP	Parameter (Tm) Series, Credenza Desk, Double-Pedestal, 24"W X 60"L, 1-1/8" Laminated Top, 2 Grommets, Perforated Modesty Panel, Box/Box/File And File/File Pedestals With Lock, Adjustable Glides.	
17	1	Right Angle #WSSD243024	Lectern, Top Only - 24" x 30" x 24" D- Shape Top - 1 1/8" Core	
18	1	Right Angle #NGABC24272 4	Arriba Lectern, 24"x27"x24" Base as Casters	
34	1	Virco Inc #BCM3652	Bookcase, 3 adjustable shelves on 1 centers, 12 D x 36 W x 52 H, metal.	
35	1	Virco Inc #54VF154D	Filing Cabinet, 54 Series, Metal, 4-Letter Sized Drawers With Lock, 15"w x 26"D 52"H, Full-Extension Steel Ball-Bearing Slides On All Drawers, Counter Weight	
36	1	Virco Inc # 53TW3	Wardrobe Tower, 53 Series, Metal, Left-Side Locking Garment Storage Area With Coat Rod, 2 Right-Side Locking Box Drawers, File Drawer & Cupboard	
P105 STORAGE				
33	6	Republic Storage #DFP3002	Open Shelving - 5 Shelf Starter - 36w X 18d X 85h	
P106 ISS				
1	18	Virco Inc #AN18	Chair, Analogy (Tm) Series, 4-Leg, Stackable, 18" Seat Height, Ergonomically Contoured Polypropylene Shell, Steel Frame, Nylon-Base Swivel Glides With Color-Accented Glide Sleeves	
5	1	RMF Seating Task Chair #160	Task Chair - Standard Black Air Mesh Seat -Black Mesh Back -Swivel Tilt Control With Seat Slider -Comfort Molded Foam Tractor Seat -Height Adjustable T Arms With Pads	
10	18	Virco Inc #2HEXM	Desk, Zuma Series, Student Desk, 4-Leg, Adjustable 22-32" H, 21-1/8" X 33" Trapezoid Hard Plastic Top, Backpack Hangar, Groups As Hexagon.	
16	1	Virco Inc #PRC2460DP	Parameter (Tm) Series, Credenza Desk, Double-Pedestal, 24"W X 60"L, 1-1/8" Laminated Top, 2 Grommets, Perforated Modesty Panel, Box/Box/File And File/File Pedestals With Lock, Adjustable Glides.	
P107 COUNSELOR OFFICE				
5	1	RMF Seating Task Chair #160	Task Chair - Standard Black Air Mesh Seat -Black Mesh Back -Swivel Tilt Control With Seat Slider -Comfort Molded Foam Tractor Seat -Height Adjustable T Arms With Pads	
6	4	RFM Seating #R531NA-GradeB	Guest / Side Chair - Stacking - Reinforced Black Steel Frame - No Arms - Black Mesh Back - Upholstered Seat	
15	1	Virco #TABLE-4836R	36" Round Table, 30"H, L1 Laminate top and adjustable Legs on glides.	
26	1	High Point #H_ 651L2BFC	66x30 Left Full Pedestal Desk - B/B/F - Center Drawer with Grommets	
27	1	High Point #H_ 622RF	42x24 Right Full Pedestal Desk - F/F with Grommets	
37	1	High Point #H_ 319	Overhead Bookcase - 36x16x36 1/2" - 2 Adj Shelves - Fits 36" Laterals and Multi File or Two Door Storage Cabinet	
38	1	High Point #H_ 346	36x24x29 Two-Drawer Lateral File with Lock	
P107B STORAGE				
33	3	Republic Storage #DFP3002	Open Shelving - 5 Shelf Starter - 36w X 18d X 85h	
P108 HEALTH SCIENCE				
3	30	Virco Inc #CA25EL	Stool, Civitas Series, 4-Leg, 25" Seat Height, Ergonomically Contoured Extra Large Analogy Polypropylene Shell, Steel Frame, Nylon-Base Swivel Glides.	
5	1	RMF Seating Task Chair #160	Task Chair - Standard Black Air Mesh Seat -Black Mesh Back -Swivel Tilt Control With Seat Slider -Comfort Molded Foam Tractor Seat -Height Adjustable T Arms With Pads	
P113 ROBOTICS LAB/ CLASSROOM				
1A	28	"EXISTING" Virco Inc #AN18	"EXISTING" Stackable, 18" Seat Height, Ergonomically Contoured Polypropylene Shell, Steel Frame, Nylon-Base Swivel Glides With Color-Accented Glide Sleeve	
5A	1	"EXISTING" RMF Seating Task Chair #160	"EXISTING" Task Chair - Standard Black Air Mesh Seat -Black Mesh Back -Swivel Tilt Control With Seat Slider -Comfort Molded Foam Tractor Seat -Height Adjustable T Arms With Pads	
12	14	Virco Inc #FTT2460	Flip Top Desk, Two-Student, 24D x 60W, 18D Work Surface w/6D flip-top, high pressure laminated top w/ T-mold banding; flip top metal wire management trough w/key looking entry door, adjustable height 22"-32"	
16A	1	"EXISTING" Virco Inc #PRC2460DP	"EXISTING" Desk, Double-Pedestal, 24"W X 60"L, 1-1/8" Laminated Top, 2 Grommets, Perforated Modesty Panel, Box/Box/File And File/File Pedestals With Lock, Adjustable Glides.	
42	2	Hon #HSC2472	Tall Metal Storage Cabinet with Lock, 36" x 24 1/8" x 72"	
P118 SCIENCE				
3	1	Virco Inc #CA25EL	Stool, Civitas Series, 4-Leg, 25" Seat Height, Ergonomically Contoured Extra Large Analogy Polypropylene Shell, Steel Frame, Nylon-Base Swivel Glides.	
5	1	RMF Seating Task Chair #160	Task Chair - Standard Black Air Mesh Seat -Black Mesh Back -Swivel Tilt Control With Seat Slider -Comfort Molded Foam Tractor Seat -Height Adjustable T Arms With Pads	
P119 ROBOTIC STORAGE				
33	3	Republic Storage #DFP3002	Open Shelving - 5 Shelf Starter - 36w X 18d X 85h	
P120 WELLNESS				
9	1	Hon #HFCG6	Flock Casual Guest Chair, Metal Legs - 4-Leg, Upholstered Back and Seat, 19 7/8" W x 23 1/2" D x 32 3/8" H	
P121 SECRETARY OFFICE				
5	1	RMF Seating Task Chair #160	Task Chair - Standard Black Air Mesh Seat -Black Mesh Back -Swivel Tilt Control With Seat Slider -Comfort Molded Foam Tractor Seat -Height Adjustable T Arms With Pads	
6	2	RFM Seating #R531NA-GradeB	Guest / Side Chair - Stacking - Reinforced Black Steel Frame - No Arms - Black Mesh Back - Upholstered Seat	
28	1	High Point #H_ 651R2BFC	66x30 Right Full Pedestal Desk - B/B/F - Center Drawer with Grommets	
29	1	High Point #H_ 622LF	42x24 Left Full Pedestal Desk - F/F with Grommets	
37	1	High Point #H_ 319	Overhead Bookcase - 36x16x36 1/2" - 2 Adj Shelves - Fits 36" Laterals and Multi File or Two Door Storage Cabinet	
38	1	High Point #H_ 346	36x24x29 Two-Drawer Lateral File with Lock	
P122 STORAGE				
33	3	Republic Storage #DFP3002	Open Shelving - 5 Shelf Starter - 36w X 18d X 85h	
P123 ASST PRINCIPAL OFFICE				
5	1	RMF Seating Task Chair #160	Task Chair - Standard Black Air Mesh Seat -Black Mesh Back -Swivel Tilt Control With Seat Slider -Comfort Molded Foam Tractor Seat -Height Adjustable T Arms With Pads	
6	2	RFM Seating #R531NA-GradeB	Guest / Side Chair - Stacking - Reinforced Black Steel Frame - No Arms - Black Mesh Back - Upholstered Seat	
26	1	High Point #H_ 651L2BFC	66x30 Left Full Pedestal Desk - B/B/F - Center Drawer with Grommets	
27	1	High Point #H_ 622RF	42x24 Right Full Pedestal Desk - F/F with Grommets	
37	1	High Point #H_ 319	Overhead Bookcase - 36x16x36 1/2" - 2 Adj Shelves - Fits 36" Laterals and Multi File or Two Door Storage Cabinet	
38	1	High Point #H_ 346	36x24x29 Two-Drawer Lateral File with Lock	
P125 TEACHER WORKROOM				
1A	8	"EXISTING" Virco Inc #AN18	"EXISTING" Stackable, 18" Seat Height, Ergonomically Contoured Polypropylene Shell, Analogy (Tm) Series, 4-Leg, Stackable, 18" Seat Height, Ergonomically Contoured Polypropylene Shell, Steel Frame, Nylon-Base Swivel Glides With Color-Accented Glide Sleeve	
14	2	Virco Inc #683060ADJ	Table, 6800 Series, Multi-Purpose table, Adjustable Legs, 30x60x24-34H - High-Pressure Laminate Top.	
P128 CONFERENCE				
5	8	RMF Seating Task Chair #160	Task Chair - Standard Black Air Mesh Seat -Black Mesh Back -Swivel Tilt Control With Seat Slider -Comfort Molded Foam Tractor Seat -Height Adjustable T Arms With Pads	
30	1	HON #HTLHP144	Preside Laminate Seated-Height Hollow Panel Base for 144"W Tabletop (2 Per Kit)	
31	1	HON #HTLA8144	Preside Laminate Racetrack Tabletop w/ built-in receptacle, 144" W x 48" D	

Furniture Schedule - Level 1 - Unit P				
Type Mark	Count	Model	Description	
P130 CLASSROOM				
1A	30	"EXISTING" Virco Inc #AN18	"EXISTING" TO BE RELOCATED, NOT TO BE PURCHASED" Chair, Analogy (Tm) Series, 4-Leg, Stackable, 18" Seat Height, Ergonomically Contoured Polypropylene Shell, Steel Frame, Nylon-Base Swivel Glides With Color-Accented Glide Sleeve	
5	1	RMF Seating Task Chair #160	Task Chair - Standard Black Air Mesh Seat -Black Mesh Back -Swivel Tilt Control With Seat Slider -Comfort Molded Foam Tractor Seat -Height Adjustable T Arms With Pads	
10A	30	"EXISTING" Virco Inc #2HEXM	"EXISTING" TO BE RELOCATED, NOT TO BE PURCHASED" Desk, Zuma Series, Student Desk, 4-Leg, Adjustable 22-32" H, 21-1/8" X 33" Trapezoid Hard Plastic Top, Backpack Hangar, Groups As Hexagon	
16	1	Virco Inc #PRC2460DP	Parameter (Tm) Series, Credenza Desk, Double-Pedestal, 24"X 60", 1-1/8" Laminated Top, 2 Grommets, Perforated Modesty Panel, Box/Box/File And File/File Pedestals With Lock, Adjustable Glides.	
17	1	Right Angle #WSS0243024	Lectern, Top Only - 24" x 30" x 24" D- Shape Top - 1 1/8" Core	
18	1	Right Angle #NGABC24272 4	Arriba Lectern, 24"x27"x24" Base as Casters	
34	1	Virco Inc #BCM3652	Bookcase, 3 adjustable shelves on 1 centers, 12 D x 36 W x 52 H, metal.	
35	1	Virco Inc #54VF154D	Filing Cabinet, 54 Series, Metal, 4-Letter Sized Drawers With Lock, 15"X 26"D 52"H, Full-Extension Steel Ball-Bearing Slides On All Drawers, Counter Weight	
36	1	Virco Inc # 53TW3	Wardrobe Tower, 53 Series, Metal, Left-Side Locking Garment Storage Area With Coat Rod, 2 Right-Side Locking Box Drawers, File Drawer & Cupboard	
P131 ART				
1	32	Virco Inc #AN18	Chair, Analogy (Tm) Series, 4-Leg, Stackable, 18" Seat Height, Ergonomically Contoured Polypropylene Shell, Steel Frame, Nylon-Base Swivel Glides With Color-Accented Glide Sleeves	
5	1	RMF Seating Task Chair #160	Task Chair - Standard Black Air Mesh Seat -Black Mesh Back -Swivel Tilt Control With Seat Slider -Comfort Molded Foam Tractor Seat -Height Adjustable T Arms With Pads	
13	16	KL #BLUEAA3060	Fixed Standard Height 29" Table on Glides, size 30"X60, Steel Rigid Frame 4-legs, Laminate Top	
16	1	Virco Inc #PRC2460DP	Parameter (Tm) Series, Credenza Desk, Double-Pedestal, 24"X 60", 1-1/8" Laminated Top, 2 Grommets, Perforated Modesty Panel, Box/Box/File And File/File Pedestals With Lock, Adjustable Glides.	
P132 CLASSROOM				
1A	30	"EXISTING" Virco Inc #AN18	"EXISTING" TO BE RELOCATED, NOT TO BE PURCHASED" Chair, Analogy (Tm) Series, 4-Leg, Stackable, 18" Seat Height, Ergonomically Contoured Polypropylene Shell, Steel Frame, Nylon-Base Swivel Glides With Color-Accented Glide Sleeve	
5A	1	"EXISTING" RMF Seating Task Chair #160	"EXISTING" TO BE RELOCATED, NOT TO BE PURCHASED" Task Chair - Standard Black Air Mesh Seat -Black Mesh Back -Swivel Tilt Control With Seat Slider -Comfort Molded Foam Tractor Seat -Height Adjustable T Arms With Pads	
10A	30	"EXISTING" Virco Inc #2HEXM	"EXISTING" TO BE RELOCATED, NOT TO BE PURCHASED" Desk, Zuma Series, Student Desk, 4-Leg, Adjustable 22-32" H, 21-1/8" X 33" Trapezoid Hard Plastic Top, Backpack Hangar, Groups As Hexagon	
16A	1	"EXISTING" Virco Inc #PRC2460DP	"EXISTING" TO BE RELOCATED, NOT TO BE PURCHASED" Parameter (Tm) Series, Credenza Desk, Double-Pedestal, 24"X 60", 1-1/8" Laminated Top, 2 Grommets, Perforated Modesty Panel, Box/Box/File And File/File Pedestals With Lock, Adjustable Glides.	
17A	1	"EXISTING" Right Angle #WSS0243024	"EXISTING" TO BE RELOCATED, NOT TO BE PURCHASED" Top Only - 24" x 30" x 24" D- Shape Top - 1 1/8" Core	
18A	1	"EXISTING" Right Angle #NGABC24272 4	"EXISTING" TO BE RELOCATED, NOT TO BE PURCHASED" Arriba 24"x27"x24" Base on Casters	
34A	1	"EXISTING" Virco Inc #BCM3652	"EXISTING" TO BE RELOCATED, NOT TO BE PURCHASED" Bookcase, 3 adjustable shelves on 1 centers, 12 D x 36 W x 52 H, metal.	
35A	1	"EXISTING" Virco Inc #54VF154D	"EXISTING" TO BE RELOCATED, NOT TO BE PURCHASED" Filing Cabinet, 54 Series, Metal, 4-Letter Sized Drawers With Lock, 15"X 26"D 52"H, Full-Extension Steel Ball-Bearing Slides On All Drawers, Counter Weight	
36A	1	"EXISTING" Virco Inc # 53TW	"EXISTING" TO BE RELOCATED, NOT TO BE PURCHASED" Wardrobe Tower, 53 Series, Metal, Left-Side Locking Garment Storage Area With Coat Rod, 2 Right-Side Locking Box Drawers, File Drawer & Cupboard	
P133 ART				
1	32	Virco Inc #AN18	Chair, Analogy (Tm) Series, 4-Leg, Stackable, 18" Seat Height, Ergonomically Contoured Polypropylene Shell, Steel Frame, Nylon-Base Swivel Glides With Color-Accented Glide Sleeves	
5	1	RMF Seating Task Chair #160	Task Chair - Standard Black Air Mesh Seat -Black Mesh Back -Swivel Tilt Control With Seat Slider -Comfort Molded Foam Tractor Seat -Height Adjustable T Arms With Pads	
13	16	KL #BLUEAA3060	Fixed Standard Height 29" Table on Glides, size 30"X60, Steel Rigid Frame 4-legs, Laminate Top	
16	1	Virco Inc #PRC2460DP	Parameter (Tm) Series, Credenza Desk, Double-Pedestal, 24"X 60", 1-1/8" Laminated Top, 2 Grommets, Perforated Modesty Panel, Box/Box/File And File/File Pedestals With Lock, Adjustable Glides.	
P134 CLASSROOM				
1A	30	"EXISTING" Virco Inc #AN18	"EXISTING" TO BE RELOCATED, NOT TO BE PURCHASED" Chair, Analogy (Tm) Series, 4-Leg, Stackable, 18" Seat Height, Ergonomically Contoured Polypropylene Shell, Steel Frame, Nylon-Base Swivel Glides With Color-Accented Glide Sleeve	
5A	1	"EXISTING" RMF Seating Task Chair #160	"EXISTING" TO BE RELOCATED, NOT TO BE PURCHASED" Task Chair - Standard Black Air Mesh Seat -Black Mesh Back -Swivel Tilt Control With Seat Slider -Comfort Molded Foam Tractor Seat -Height Adjustable T Arms With Pads	
10A	30	"EXISTING" Virco Inc #2HEXM	"EXISTING" TO BE RELOCATED, NOT TO BE PURCHASED" Desk, Zuma Series, Student Desk, 4-Leg, Adjustable 22-32" H, 21-1/8" X 33" Trapezoid Hard Plastic Top, Backpack Hangar, Groups As Hexagon.	
16A	1	"EXISTING" Virco Inc #PRC2460DP	"EXISTING" TO BE RELOCATED, NOT TO BE PURCHASED" Parameter (Tm) Series, Credenza Desk, Double-Pedestal, 24"X 60", 1-1/8" Laminated Top, 2 Grommets, Perforated Modesty Panel, Box/Box/File And File/File Pedestals With Lock, Adjustable Glides.	
17A	1	"EXISTING" Right Angle #WSS0243024	"EXISTING" TO BE RELOCATED, NOT TO BE PURCHASED" Top Only - 24" x 30" x 24" D- Shape Top - 1 1/8" Core	
18A	1	"EXISTING" Right Angle #NGABC24272 4	"EXISTING" TO BE RELOCATED, NOT TO BE PURCHASED" Arriba 24"x27"x24" Base on Casters	
34A	1	"EXISTING" Virco Inc #BCM3652	"EXISTING" TO BE RELOCATED, NOT TO BE PURCHASED" Bookcase, 3 adjustable shelves on 1 centers, 12 D x 36 W x 52 H, metal.	
35A	1	"EXISTING" Virco Inc #54VF154D	"EXISTING" TO BE RELOCATED, NOT TO BE PURCHASED" Filing Cabinet, 54 Series, Metal, 4-Letter Sized Drawers With Lock, 15"X 26"D 52"H, Full-Extension Steel Ball-Bearing Slides On All Drawers, Counter Weight	
36A	1	"EXISTING" Virco Inc # 53TW	"EXISTING" TO BE RELOCATED, NOT TO BE PURCHASED" Wardrobe Tower, 53 Series, Metal, Left-Side Locking Garment Storage Area With Coat Rod, 2 Right-Side Locking Box Drawers, File Drawer & Cupboard	



WRA Architects, Inc.
6000 Headquarters Drive
Suite 600
Plano, TX 75024
214-750-0077
www.wraarchitects.com

COMMUNITY HS ADDITION & RENOVATION TO 2100
CAPACITY
440 N Farm To Market 1138, Nevada, TX 75173


REVISIONS:		
No.		Date
1	Addendum #01	8/13/2026
JOB NO. 2368		
DATE: 07/31/2026		
Furniture Schedule - Level 1 Unit P		
X007.1		

Furniture Schedule - Level 2 - Unit M				
Type Mark	Count	Model	Description	
M202 SCIENCE				
3	24	Virco Inc #CA25EL	Stool, Civitas Series, 4-Leg, 25" Seat Height, Ergonomically Contoured Extra Large Analogy Polypropylene Shell, Steel Frame, Nylon-Base Swivel Glides	
5	1	RMF Seating Task Chair #160	Task Chair - Standard Black Air Mesh Seat -Black Mesh Back -Swivel Tilt Control With Seat Slider -Comfort Molded Foam Tractor Seat -Height Adjustable T Arms With Pads	
M203 CLASSROOM				
1	30	Virco Inc #AN18	Chair, Analogy (Tm) Series, 4-Leg, Stackable, 18" Seat Height, Ergonomically Contoured Polypropylene Shell, Steel Frame, Nylon-Base Swivel Glides With Color-Accented Glide Sleeves	
5	1	RMF Seating Task Chair #160	Task Chair - Standard Black Air Mesh Seat -Black Mesh Back -Swivel Tilt Control With Seat Slider -Comfort Molded Foam Tractor Seat -Height Adjustable T Arms With Pads	
10	30	Virco Inc #ZHEXM	Desk, Zuma Series, Student Desk, 4-Leg, Adjustable 22-32" H, 21-1/8" X 33" Trapezoid Hard Plastic Top, Backpack Hangar, Groups As Hexagon.	
16	1	Virco Inc #PRC2460DP	Parameter (Tm) Series, Credenza Desk, Double-Pedestal, 24"w X 60"L x 1-1/8" Laminated Top, 2 Grommets, Perforated Modesty Panel, Box/Box/File And File/File Pedestals With Lock, Adjustable Glides.	
17	1	Right Angle #WSSD243024	Lectern, Top Only - 24" x 30" x 24" D-Shape Top - 1 1/8" Core	
18	1	Right Angle #NGABC24272 4	Arriba Lectern, 24"x27"x24" Base as Casters	
34	1	Virco Inc #BCM3652	Bookcase, 3 adjustable shelves on 1 centers, 12 D x 36 W x 52 H, metal.	
35	1	Virco Inc #54VF154D	Filing Cabinet, 54 Series, Metal, 4 -Letter Sized Drawers With Lock, 15"w x 26"D 52"H, Full-Extension Steel Ball-Bearing Slides On All Drawers, Counter Weight	
36	1	Virco Inc # 53TW3	Wardrobe Tower, 53 Series, Metal, Left-Side Locking Garment Storage Area With Coat Rod, 2 Right-Side Locking Box Drawers, File Drawer & Cupboard	
M205 CLASSROOM				
1	30	Virco Inc #AN18	Chair, Analogy (Tm) Series, 4-Leg, Stackable, 18" Seat Height, Ergonomically Contoured Polypropylene Shell, Steel Frame, Nylon-Base Swivel Glides With Color-Accented Glide Sleeves	
5	1	RMF Seating Task Chair #160	Task Chair - Standard Black Air Mesh Seat -Black Mesh Back -Swivel Tilt Control With Seat Slider -Comfort Molded Foam Tractor Seat -Height Adjustable T Arms With Pads	
10	30	Virco Inc #ZHEXM	Desk, Zuma Series, Student Desk, 4-Leg, Adjustable 22-32" H, 21-1/8" X 33" Trapezoid Hard Plastic Top, Backpack Hangar, Groups As Hexagon.	
16	1	Virco Inc #PRC2460DP	Parameter (Tm) Series, Credenza Desk, Double-Pedestal, 24"w X 60"L x 1-1/8" Laminated Top, 2 Grommets, Perforated Modesty Panel, Box/Box/File And File/File Pedestals With Lock, Adjustable Glides.	
17	1	Right Angle #WSSD243024	Lectern, Top Only - 24" x 30" x 24" D-Shape Top - 1 1/8" Core	
18	1	Right Angle #NGABC24272 4	Arriba Lectern, 24"x27"x24" Base as Casters	
34	1	Virco Inc #BCM3652	Bookcase, 3 adjustable shelves on 1 centers, 12 D x 36 W x 52 H, metal.	
35	1	Virco Inc #54VF154D	Filing Cabinet, 54 Series, Metal, 4 -Letter Sized Drawers With Lock, 15"w x 26"D 52"H, Full-Extension Steel Ball-Bearing Slides On All Drawers, Counter Weight	
36	1	Virco Inc # 53TW3	Wardrobe Tower, 53 Series, Metal, Left-Side Locking Garment Storage Area With Coat Rod, 2 Right-Side Locking Box Drawers, File Drawer & Cupboard	
M215 OFFICE				
5	1	RMF Seating Task Chair #160	Task Chair - Standard Black Air Mesh Seat -Black Mesh Back -Swivel Tilt Control With Seat Slider -Comfort Molded Foam Tractor Seat -Height Adjustable T Arms With Pads	
6	2	RFM Seating #6531NA-Grad 4B	Guest / Side Chair - Stacking - Reinforced Black Steel Frame - No Arms - Black Mesh Back - Upholstered Seat	
28	1	High Point #H_ 651R2BFC	66x30 Right Full Pedestal Desk - B/B/F - Center Drawer with Grommets	
29	1	High Point #H_ 622LF	42x24 Left Full Pedestal Desk - F/F with Grommets	
37	1	High Point #H_ 319	Overhead Bookcase - 36x16x36 1/2" - 2 Adj Shelves - Fits 36" Laterals and Multi File or Two Door Storage Cabinet	
38	1	High Point #H_ 346	36x24x29 Two-Drawer Lateral File with Lock	
M216 SCIENCE				
3	24	Virco Inc #CA25EL	Stool, Civitas Series, 4-Leg, 25" Seat Height, Ergonomically Contoured Extra Large Analogy Polypropylene Shell, Steel Frame, Nylon-Base Swivel Glides	
5	1	RMF Seating Task Chair #160	Task Chair - Standard Black Air Mesh Seat -Black Mesh Back -Swivel Tilt Control With Seat Slider -Comfort Molded Foam Tractor Seat -Height Adjustable T Arms With Pads	


Furniture Schedule - Level 2 - Unit M				
Type Mark	Count	Model	Description	
M217 STORAGE				
33	3	Republic Storage #RDP3002	Open Shelving - 5 Shelf Starter - 36w X 18d X 85h	
M218 STORAGE				
33	7	Republic Storage #RDP3002	Open Shelving - 5 Shelf Starter - 36w X 18d X 85h	
M220 TEACHERS LOUNGE				
1	8	Virco Inc #AN18	Chair, Analogy (Tm) Series, 4-Leg, Stackable, 18" Seat Height, Ergonomically Contoured Polypropylene Shell, Steel Frame, Nylon-Base Swivel Glides With Color-Accented Glide Sleeves	
14	2	Virco Inc #683060ADJ	Table, 6800 Series, Multi-Purpose table, Adjustable Legs, 30x60x24-34H - High-Pressure Laminate Top.	
M221 CLASSROOM				
1	30	Virco Inc #AN18	Chair, Analogy (Tm) Series, 4-Leg, Stackable, 18" Seat Height, Ergonomically Contoured Polypropylene Shell, Steel Frame, Nylon-Base Swivel Glides With Color-Accented Glide Sleeves	
5	1	RMF Seating Task Chair #160	Task Chair - Standard Black Air Mesh Seat -Black Mesh Back -Swivel Tilt Control With Seat Slider -Comfort Molded Foam Tractor Seat -Height Adjustable T Arms With Pads	
10	30	Virco Inc #ZHEXM	Desk, Zuma Series, Student Desk, 4-Leg, Adjustable 22-32" H, 21-1/8" X 33" Trapezoid Hard Plastic Top, Backpack Hangar, Groups As Hexagon.	
16	1	Virco Inc #PRC2460DP	Parameter (Tm) Series, Credenza Desk, Double-Pedestal, 24"w X 60"L, 1-1/8" Laminated Top, 2 Grommets, Perforated Modesty Panel, Box/Box/File And File/File Pedestals With Lock, Adjustable Glides.	
17	1	Right Angle #WSSD243024	Lectern, Top Only - 24" x 30" x 24" D- Shape Top - 1 1/8" Core	
18	1	Right Angle #NGABC24272 4	Arriba Lectern, 24"x27"x24" Base as Casters	
34	1	Virco Inc #BCM3652	Bookcase, 3 adjustable shelves on 1 centers, 12 D X 36 W x 52 H, metal.	
35	1	Virco Inc #54VF154D	Filing Cabinet, 54 Series, Metal, 4 -Letter Sized Drawers With Lock, 15"w x 26"D 52"H, Full-Extension Steel Ball-Bearing Slides On All Drawers, Counter Weight	
36	1	Virco Inc # 53TW3	Wardrobe Tower, 53 Series, Metal, Left-Side Locking Garment Storage Area With Coat Rod, 2 Right-Side Locking Box Drawers, File Drawer & Cupboard	
M222 OFFICE				
5	1	RMF Seating Task Chair #160	Task Chair - Standard Black Air Mesh Seat -Black Mesh Back -Swivel Tilt Control With Seat Slider -Comfort Molded Foam Tractor Seat -Height Adjustable T Arms With Pads	
6	2	RFM Seating #6531NA-Grad 4B	Guest / Side Chair - Stacking - Reinforced Black Steel Frame - No Arms - Black Mesh Back - Upholstered Seat	
28	1	High Point #H_ 651R2BFC	66x30 Right Full Pedestal Desk - B/B/F - Center Drawer with Grommets	
29	1	High Point #H_ 622LF	42x24 Left Full Pedestal Desk - F/F with Grommets	
37	1	High Point #H_ 319	Overhead Bookcase - 36x16x36 1/2" - 2 Adj Shelves - Fits 36" Laterals and Multi File or Two Door Storage Cabinet	
38	1	High Point #H_ 346	36x24x29 Two-Drawer Lateral File with Lock	
M223 CLASSROOM				
1	30	Virco Inc #AN18	Chair, Analogy (Tm) Series, 4-Leg, Stackable, 18" Seat Height, Ergonomically Contoured Polypropylene Shell, Steel Frame, Nylon-Base Swivel Glides With Color-Accented Glide Sleeves	
5	1	RMF Seating Task Chair #160	Task Chair - Standard Black Air Mesh Seat -Black Mesh Back -Swivel Tilt Control With Seat Slider -Comfort Molded Foam Tractor Seat -Height Adjustable T Arms With Pads	
10	30	Virco Inc #ZHEXM	Desk, Zuma Series, Student Desk, 4-Leg, Adjustable 22-32" H, 21-1/8" X 33" Trapezoid Hard Plastic Top, Backpack Hangar, Groups As Hexagon.	
16	1	Virco Inc #PRC2460DP	Parameter (Tm) Series, Credenza Desk, Double-Pedestal, 24"w X 60"L, 1-1/8" Laminated Top, 2 Grommets, Perforated Modesty Panel, Box/Box/File And File/File Pedestals With Lock, Adjustable Glides.	
17	1	Right Angle #WSSD243024	Lectern, Top Only - 24" x 30" x 24" D- Shape Top - 1 1/8" Core	
18	1	Right Angle #NGABC24272 4	Arriba Lectern, 24"x27"x24" Base as Casters	
34	1	Virco Inc #BCM3652	Bookcase, 3 adjustable shelves on 1 centers, 12 D X 36 W x 52 H, metal.	
35	1	Virco Inc #54VF154D	Filing Cabinet, 54 Series, Metal, 4 -Letter Sized Drawers With Lock, 15"w x 26"D 52"H, Full-Extension Steel Ball-Bearing Slides On All Drawers, Counter Weight	
36	1	Virco Inc # 53TW3	Wardrobe Tower, 53 Series, Metal, Left-Side Locking Garment Storage Area With Coat Rod, 2 Right-Side Locking Box Drawers, File Drawer & Cupboard	

Furniture Schedule - Level 2 - Unit M				
Type Mark	Count	Model	Description	
M225 CLASSROOM				
1	30	Virco Inc #AN18	Chair, Analogy (Tm) Series, 4-Leg, Stackable, 18" Seat Height, Ergonomically Contoured Polypropylene Shell, Steel Frame, Nylon-Base Swivel Glides With Color-Accented Glide Sleeves	
5	1	RMF Seating Task Chair #160	Task Chair - Standard Black Air Mesh Seat -Black Mesh Back -Swivel Tilt Control With Seat Slider -Comfort Molded Foam Tractor Seat -Height Adjustable T Arms With Pads	
10	30	Virco Inc #ZHEXM	Desk, Zuma Series, Student Desk, 4-Leg, Adjustable 22-32" H, 21-1/8" X 33" Trapezoid Hard Plastic Top, Backpack Hangar, Groups As Hexagon.	
16	1	Virco Inc #PRC2460DP	Parameter (Tm) Series, Credenza Desk, Double-Pedestal, 24"W x 60"L, 1-1/8" Laminated Top, 2 Grommets, Perforated Modesty Panel, Box/Box/File And File/File Pedestals With Lock, Adjustable Glides.	
17	1	Right Angle #WSSD243024	Lectern, Top Only - 24" x 30" x 24" D- Shape Top - 1 1/8" Core	
18	1	Right Angle #NGABC24272 4	Arriba Lectern, 24"x27"x24" Base as Casters	
34	1	Virco Inc #BCM3652	Bookcase, 3 adjustable shelves on 1 centers, 12 D x 36 W x 52 H, metal.	
35	1	Virco Inc #54VF154D	Filing Cabinet, 54 Series, Metal, 4 -Letter Sized Drawers With Lock, 15" w x 26" D 52"H, Full-Extension Steel Ball-Bearing Slides On All Drawers, Counter Weight	
36	1	Virco Inc # 53TW3	Wardrobe Tower, 53 Series, Metal, Left-Side Locking Garment Storage Area With Coat Rod, 2 Right-Side Locking Box Drawers, File Drawer & Cupboard	
M230 CONFERENCE				
5	8	RMF Seating Task Chair #160	Task Chair - Standard Black Air Mesh Seat -Black Mesh Back -Swivel Tilt Control With Seat Slider -Comfort Molded Foam Tractor Seat -Height Adjustable T Arms With Pads	
30	1	HON #HTLHP144	Preside Laminate Seated-Height Hollow Panel Base for 144" W Tabletop (2 Per Kit)	
31	1	HON #HTLA48144	Preside Laminate Racetrack Tabletop w/ built-in receptacle, 144" W x 48" D	
M236 CLASSROOM				
1	30	Virco Inc #AN18	Chair, Analogy (Tm) Series, 4-Leg, Stackable, 18" Seat Height, Ergonomically Contoured Polypropylene Shell, Steel Frame, Nylon-Base Swivel Glides With Color-Accented Glide Sleeves	
5	1	RMF Seating Task Chair #160	Task Chair - Standard Black Air Mesh Seat -Black Mesh Back -Swivel Tilt Control With Seat Slider -Comfort Molded Foam Tractor Seat -Height Adjustable T Arms With Pads	
10	30	Virco Inc #ZHEXM	Desk, Zuma Series, Student Desk, 4-Leg, Adjustable 22-32" H, 21-1/8" X 33" Trapezoid Hard Plastic Top, Backpack Hangar, Groups As Hexagon.	
16	1	Virco Inc #PRC2460DP	Parameter (Tm) Series, Credenza Desk, Double-Pedestal, 24"W x 60"L, 1-1/8" Laminated Top, 2 Grommets, Perforated Modesty Panel, Box/Box/File And File/File Pedestals With Lock, Adjustable Glides.	
17	1	Right Angle #WSSD243024	Lectern, Top Only - 24" x 30" x 24" D- Shape Top - 1 1/8" Core	
18	1	Right Angle #NGABC24272 4	Arriba Lectern, 24"x27"x24" Base as Casters	
34	1	Virco Inc #BCM3652	Bookcase, 3 adjustable shelves on 1 centers, 12 D x 36 W x 52 H, metal.	
35	1	Virco Inc #54VF154D	Filing Cabinet, 54 Series, Metal, 4 -Letter Sized Drawers With Lock, 15" w x 26" D 52"H, Full-Extension Steel Ball-Bearing Slides On All Drawers, Counter Weight	
36	1	Virco Inc # 53TW3	Wardrobe Tower, 53 Series, Metal, Left-Side Locking Garment Storage Area With Coat Rod, 2 Right-Side Locking Box Drawers, File Drawer & Cupboard	
M238 CLASSROOM				
1	30	Virco Inc #AN18	Chair, Analogy (Tm) Series, 4-Leg, Stackable, 18" Seat Height, Ergonomically Contoured Polypropylene Shell, Steel Frame, Nylon-Base Swivel Glides With Color-Accented Glide Sleeves	
5	1	RMF Seating Task Chair #160	Task Chair - Standard Black Air Mesh Seat -Black Mesh Back -Swivel Tilt Control With Seat Slider -Comfort Molded Foam Tractor Seat -Height Adjustable T Arms With Pads	
10	30	Virco Inc #ZHEXM	Desk, Zuma Series, Student Desk, 4-Leg, Adjustable 22-32" H, 21-1/8" X 33" Trapezoid Hard Plastic Top, Backpack Hangar, Groups As Hexagon.	
16	1	Virco Inc #PRC2460DP	Parameter (Tm) Series, Credenza Desk, Double-Pedestal, 24"W x 60"L, 1-1/8" Laminated Top, 2 Grommets, Perforated Modesty Panel, Box/Box/File And File/File Pedestals With Lock, Adjustable Glides.	
17	1	Right Angle #WSSD243024	Lectern, Top Only - 24" x 30" x 24" D- Shape Top - 1 1/8" Core	
18	1	Right Angle #NGABC24272 4	Arriba Lectern, 24"x27"x24" Base as Casters	
34	1	Virco Inc #BCM3652	Bookcase, 3 adjustable shelves on 1 centers, 12 D x 36 W x 52 H, metal.	
35	1	Virco Inc #54VF154D	Filing Cabinet, 54 Series, Metal, 4 -Letter Sized Drawers With Lock, 15" w x 26" D 52"H, Full-Extension Steel Ball-Bearing Slides On All Drawers, Counter Weight	
36	1	Virco Inc # 53TW3	Wardrobe Tower, 53 Series, Metal, Left-Side Locking Garment Storage Area With Coat Rod, 2 Right-Side Locking Box Drawers, File Drawer & Cupboard	

FURNITURE PLAN LEGEND:
☐ NEW FURNITURE
☒ RELOCATED EXISTING FURNITURE

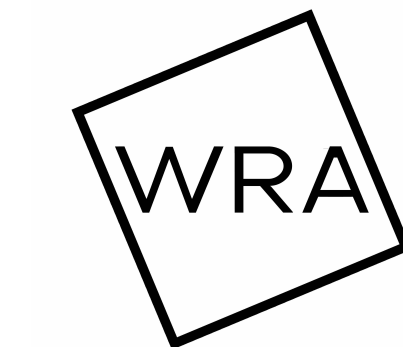


WRA Architects, Inc.
6000 Headquarters Drive
Suite 600
Plano, TX 75024
214-750-0077
www.wraarchitects.com

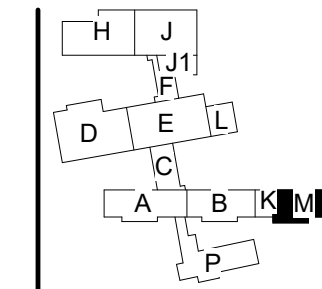

COMMUNITY HS ADDITION & RENOVATION TO 2100
CAPACITY
440 N Farm To Market 1138, Nevada, TX 75173

REVISIONS:		
No.		Date
1	Addendum #01	8/13/2026
Furniture Plan - Level 2 Unit M		
X008		
© WRA Architects, Inc. 2025		

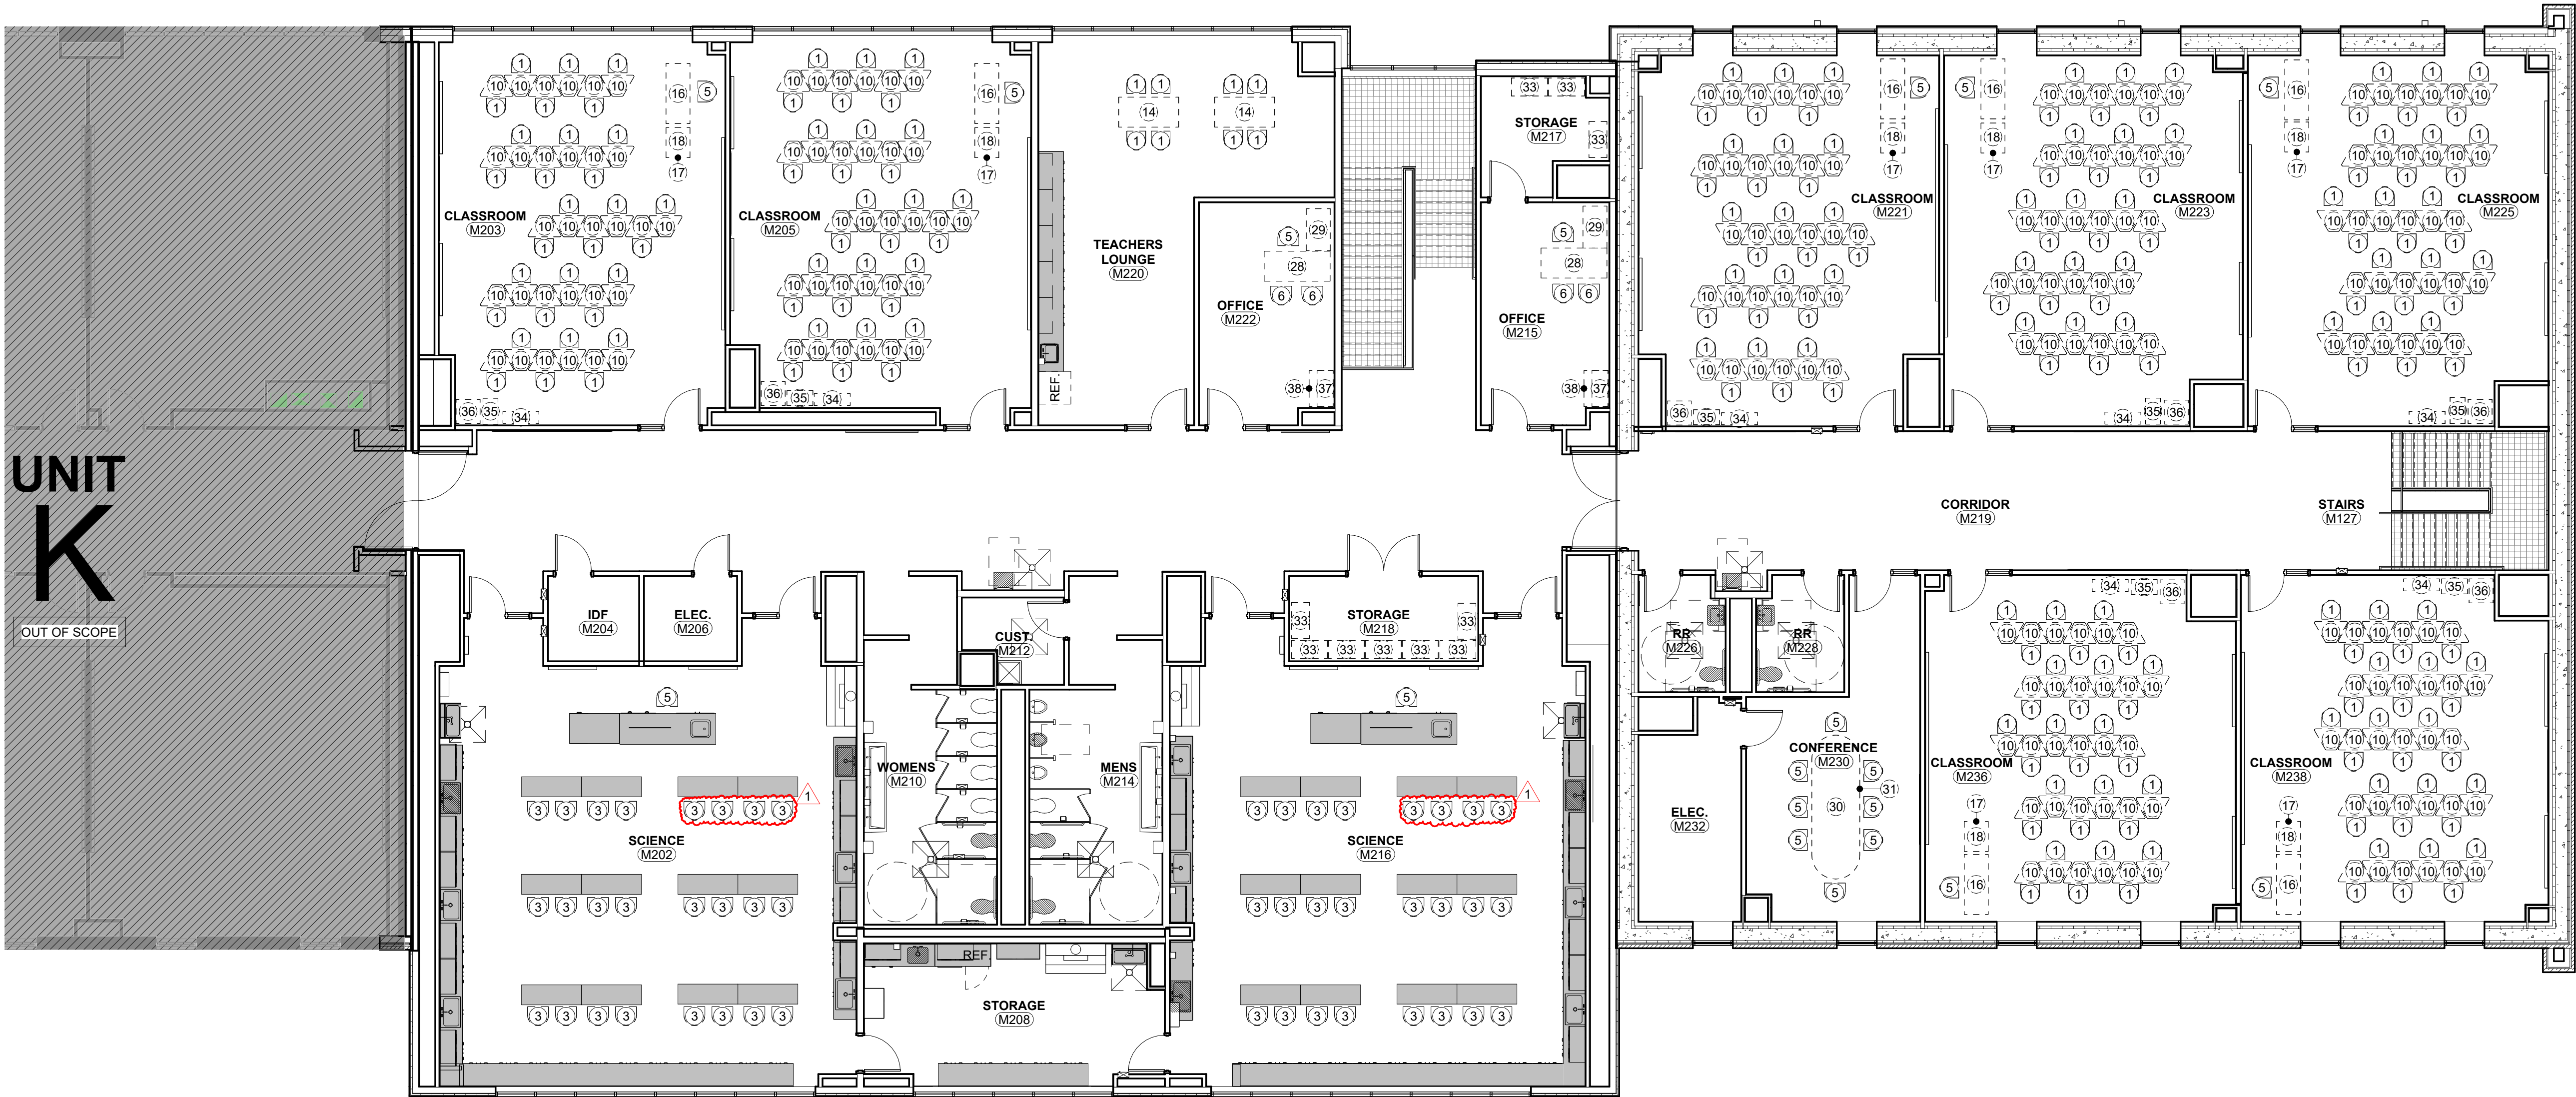

1 Furniture Plan - Level 2 Unit M
1/8" = 1'-0"



1 Furniture Plan - Level 2 Unit P
1/8" = 1'-0"



FURNITURE PLAN LEGEND:
□ NEW FURNITURE
▨ RELOCATED EXISTING FURNITURE



WRA Architects, Inc.
6000 Headquarters Drive
Suite 600
Plano, TX 75024
214-750-0077
www.wraarchitects.com

COMMUNITY HS ADDITION & RENOVATION TO 2100
CAPACITY

440 N Farm To Market 1138, Nevada, TX 75173

REVISIONS:	
No.	Date
1	Addendum #01 8/13/2026
JOB NO. 2368	
DATE: 07/31/2026	
Furniture Plan - Level 2 Unit P	
X009	
© WRA Architects, Inc. 2025	

Furniture Schedule - Level 2 - Unit P				
Type Mark	Count	Model	Description	
P201 BUSINESS INFORMATION SYSTEMS				
2A	32	"EXISTING" Virco Inc #CA18ELC	"EXISTING TO BE RELOCATED, NOT TO BE PURCHASED" Chair, Civlitas Series, 4-Leg, 18" Seat Height, Ergonomically Contoured Extra large Analogy Polypropylene Shell, Steel Frame, Twin-Wheel Nylon Soft casters.	
5A	1	"EXISTING" RMF Seating Task Chair #160	"EXISTING TO BE RELOCATED, NOT TO BE PURCHASED" Task Chair - Standard Black Air Mesh Seat -Black Mesh Back -Swivel Tilt Control With Seat Slider -Comfort Molded Foam Tractor Seat -Height Adjustable T Arms With Pads	
12A	16	"EXISTING" Virco Inc #TT2460	"EXISTING TO BE RELOCATED, NOT TO BE PURCHASED" Flip Top Desk, Two-Student, 24D x 60W, 18D Work Surface w/6D flip-top, high pressure laminated top w/ T-mold banding; flip top metal wire management trough w/wirey locking entry door, adjustable height 22-32	
16A	1	"EXISTING" Virco Inc #PRC2460DP	"EXISTING TO BE RELOCATED, NOT TO BE PURCHASED" Parameter (Tm) Series, Credenza Desk, Double-Pedestal, 24"x 60", 1-1/8" Laminated Top, 2 Grommets, Perforated Modesty Panel, Box/Box/File And File/File Pedestals With Lock, Adjustable Glides.	
34A	1	"EXISTING" Virco Inc #BCM3652	"EXISTING TO BE RELOCATED, NOT TO BE PURCHASED" Bookcase, 3 adjustable shelves on 1 centers, 12 D x 36 W x 52 H, metal.	
35A	1	"EXISTING" Virco Inc #54VF154D	"EXISTING TO BE RELOCATED, NOT TO BE PURCHASED" Filing Cabinet, 54 Series, Metal, 4 -Letter Sized Drawers With Lock, 15" w x 26"D 52"H, Full-Extension Steel Ball-Bearing Slides On All Drawers, Counter Weight	
P202 TEACHER WORKROOM				
1	8	Virco Inc #AN18	Chair, Analogy (Tm) Series, 4-Leg, Stackable, 18" Seat Height, Ergonomically Contoured Polypropylene Shell, Steel Frame, Nylon-Base Swivel Glides With Color-Accented Glide Sleeves	
14	2	Virco Inc #683060ADJ	Table, 6800 Series, Multi-Purpose table, Adjustable Legs, 30x60x24-34H - High-Pressure Laminate Top.	
P203 SECRETARY OFFICE				
5	1	RMF Seating Task Chair #160	Task Chair - Standard Black Air Mesh Seat -Black Mesh Back -Swivel Tilt Control With Seat Slider -Comfort Molded Foam Tractor Seat -Height Adjustable T Arms With Pads	
6	2	RFM Seating #9531NA-Grad eB	Guest / Side Chair - Stacking - Reinforced Black Steel Frame - No Arms - Black Mesh Back - Upholstered Seat	
26	1	High Point #H 651L2BFC	66x30 Left Full Pedestal Desk - B/B/F - Center Drawer with Grommets	
27	1	High Point #H 622RF	42x24 Right Full Pedestal Desk - F/F with Grommets	
37	1	High Point #H 319	Overhead Bookcase - 36x16x36 1/2" - 2 Adj Shelves - Fits 36" Laterals and Multi File or Two Door Storage Cabinet	
38	1	High Point #H 346	36x24x29 Two-Drawer Lateral File with Lock	
P204 ASST. PRINCIPAL				
5	1	RMF Seating Task Chair #160	Task Chair - Standard Black Air Mesh Seat -Black Mesh Back -Swivel Tilt Control With Seat Slider -Comfort Molded Foam Tractor Seat -Height Adjustable T Arms With Pads	
6	2	RFM Seating #9531NA-Grad eB	Guest / Side Chair - Stacking - Reinforced Black Steel Frame - No Arms - Black Mesh Back - Upholstered Seat	
26	1	High Point #H 651L2BFC	66x30 Left Full Pedestal Desk - B/B/F - Center Drawer with Grommets	
27	1	High Point #H 622RF	42x24 Right Full Pedestal Desk - F/F with Grommets	
37	1	High Point #H 319	Overhead Bookcase - 36x16x36 1/2" - 2 Adj Shelves - Fits 36" Laterals and Multi File or Two Door Storage Cabinet	
38	1	High Point #H 346	36x24x29 Two-Drawer Lateral File with Lock	
P205 STORAGE				
33	8	Republic Storage #DP3002	Open Shelving - 5 Shelf Starter - 36w X 18d X 85h	
P207 COUNSELOR OFFICE				
5	1	RMF Seating Task Chair #160	Task Chair - Standard Black Air Mesh Seat -Black Mesh Back -Swivel Tilt Control With Seat Slider -Comfort Molded Foam Tractor Seat -Height Adjustable T Arms With Pads	
6	4	RFM Seating #9531NA-Grad eB	Guest / Side Chair - Stacking - Reinforced Black Steel Frame - No Arms - Black Mesh Back - Upholstered Seat	
15	1	Virco #TABLE-4836R	36" Round Table, 30"H, L1 Laminate top and adjustable Legs on glides.	
28	1	High Point #H 651R2BFC	66x30 Right Full Pedestal Desk - B/B/F - Center Drawer with Grommets	
29	1	High Point #H 622LF	42x24 Left Full Pedestal Desk - F/F with Grommets	
37	1	High Point #H 319	Overhead Bookcase - 36x16x36 1/2" - 2 Adj Shelves - Fits 36" Laterals and Multi File or Two Door Storage Cabinet	
38	1	High Point #H 346	36x24x29 Two-Drawer Lateral File with Lock	
P207B STORAGE				
33	10	Republic Storage #DP3002	Open Shelving - 5 Shelf Starter - 36w X 18d X 85h	
P208 HEALTH SCIENCE				
3	30	Virco Inc #CA25EL	Stool, Civlitas Series, 4-Leg, 25" Seat Height, Ergonomically Contoured Extra Large Analogy Polypropylene Shell, Steel Frame, Nylon-Base Swivel Glides.	
5	1	RMF Seating Task Chair #160	Task Chair - Standard Black Air Mesh Seat -Black Mesh Back -Swivel Tilt Control With Seat Slider -Comfort Molded Foam Tractor Seat -Height Adjustable T Arms With Pads	
P211 CLASSROOM				
1	30	Virco Inc #AN18	Chair, Analogy (Tm) Series, 4-Leg, Stackable, 18" Seat Height, Ergonomically Contoured Polypropylene Shell, Steel Frame, Nylon-Base Swivel Glides With Color-Accented Glide Sleeves	
5	1	RMF Seating Task Chair #160	Task Chair - Standard Black Air Mesh Seat -Black Mesh Back -Swivel Tilt Control With Seat Slider -Comfort Molded Foam Tractor Seat -Height Adjustable T Arms With Pads	
10	30	Virco Inc #2HEXM	Desk, Zuma Series, Student Desk, 4-Leg, Adjustable 22-32" H, 21-1/8" X 33" Trapezoid Hard Plastic Top, Backpack Hangar, Groups As Hexagon.	
16	1	Virco Inc #PRC2460DP	Parameter (Tm) Series, Credenza Desk, Double-Pedestal, 24"x 60", 1-1/8" Laminated Top, 2 Grommets, Perforated Modesty Panel, Box/Box/File And File/File Pedestals With Lock, Adjustable Glides.	
17	1	Right Angle #WSSD243024	Lectern, Top Only - 24" x 30" x 24" D-Shape Top - 1 1/8" Core	
18	1	Right Angle #NGABC24272 4	Arriba Lectern, 24"x27"x24" Base as Casters	
34	1	Virco Inc #BCM3652	Bookcase, 3 adjustable shelves on 1 centers, 12 D x 36 W x 52 H, metal.	
35	1	Virco Inc #54VF154D	Filing Cabinet, 54 Series, Metal, 4 -Letter Sized Drawers With Lock, 15" w x 26"D 52"H, Full-Extension Steel Ball-Bearing Slides On All Drawers, Counter Weight	
36	1	Virco Inc # 53TW3	Wardrobe Tower, 53 Series, Metal, Left-Side Locking Garment Storage Area With Coat Rod, 2 Right-Side Locking Box Drawers, File Drawer & Cupboard	
P213 CLASSROOM				
1	30	Virco Inc #AN18	Chair, Analogy (Tm) Series, 4-Leg, Stackable, 18" Seat Height, Ergonomically Contoured Polypropylene Shell, Steel Frame, Nylon-Base Swivel Glides With Color-Accented Glide Sleeves	
5	1	RMF Seating Task Chair #160	Task Chair - Standard Black Air Mesh Seat -Black Mesh Back -Swivel Tilt Control With Seat Slider -Comfort Molded Foam Tractor Seat -Height Adjustable T Arms With Pads	
10	30	Virco Inc #2HEXM	Desk, Zuma Series, Student Desk, 4-Leg, Adjustable 22-32" H, 21-1/8" X 33" Trapezoid Hard Plastic Top, Backpack Hangar, Groups As Hexagon.	
16	1	Virco Inc #PRC2460DP	Parameter (Tm) Series, Credenza Desk, Double-Pedestal, 24"x 60", 1-1/8" Laminated Top, 2 Grommets, Perforated Modesty Panel, Box/Box/File And File/File Pedestals With Lock, Adjustable Glides.	
17	1	Right Angle #WSSD243024	Lectern, Top Only - 24" x 30" x 24" D-Shape Top - 1 1/8" Core	
18	1	Right Angle #NGABC24272 4	Arriba Lectern, 24"x27"x24" Base as Casters	
34	1	Virco Inc #BCM3652	Bookcase, 3 adjustable shelves on 1 centers, 12 D x 36 W x 52 H, metal.	
35	1	Virco Inc #54VF154D	Filing Cabinet, 54 Series, Metal, 4 -Letter Sized Drawers With Lock, 15" w x 26"D 52"H, Full-Extension Steel Ball-Bearing Slides On All Drawers, Counter Weight	
36	1	Virco Inc # 53TW3	Wardrobe Tower, 53 Series, Metal, Left-Side Locking Garment Storage Area With Coat Rod, 2 Right-Side Locking Box Drawers, File Drawer & Cupboard	
P217 CLASSROOM				
1	30	Virco Inc #AN18	Chair, Analogy (Tm) Series, 4-Leg, Stackable, 18" Seat Height, Ergonomically Contoured Polypropylene Shell, Steel Frame, Nylon-Base Swivel Glides With Color-Accented Glide Sleeves	
5	1	RMF Seating Task Chair #160	Task Chair - Standard Black Air Mesh Seat -Black Mesh Back -Swivel Tilt Control With Seat Slider -Comfort Molded Foam Tractor Seat -Height Adjustable T Arms With Pads	
10	30	Virco Inc #2HEXM	Desk, Zuma Series, Student Desk, 4-Leg, Adjustable 22-32" H, 21-1/8" X 33" Trapezoid Hard Plastic Top, Backpack Hangar, Groups As Hexagon.	
16	1	Virco Inc #PRC2460DP	Parameter (Tm) Series, Credenza Desk, Double-Pedestal, 24"x 60", 1-1/8" Laminated Top, 2 Grommets, Perforated Modesty Panel, Box/Box/File And File/File Pedestals With Lock, Adjustable Glides.	

Furniture Schedule - Level 2 - Unit P				
Type Mark	Count	Model	Description	
17	1	Right Angle #WSSD243024	Lectern, Top Only - 24" x 30" x 24" D-Shape Top - 1 1/8" Core	
18	1	Right Angle #NGABC24272 4	Arriba Lectern, 24"x27"x24" Base as Casters	
34	1	Virco Inc #BCM3652	Bookcase, 3 adjustable shelves on 1 centers, 12 D x 36 W x 52 H, metal.	
35	1	Virco Inc #54VF154D	Filing Cabinet, 54 Series, Metal, 4-Letter Sized Drawers With Lock, 15" w x 26"D 52"H, Full-Extension Steel Ball-Bearing Slides On All Drawers, Counter Weight	
36	1	Virco Inc # 53TW3	Wardrobe Tower, 53 Series, Metal, Left-Side Locking Garment Storage Area With Coat Rod, 2 Right-Side Locking Box Drawers, File Drawer & Cupboard	
P218 SCIENCE	3	25 Virco Inc #CA25EL	Stool, Civitas Series, 4-Leg, 25" Seat Height, Ergonomically Contoured Extra Large Analogy Polypropylene Shell, Steel Frame, Nylon-Base Swivel Glides.	
5	1	RMF Seating Task Chair #160	Task Chair - Standard Black Air Mesh Seat -Black Mesh Back -Swivel Tilt Control With Seat Slider -Comfort Molded Foam Tractor Seat -Height Adjustable T Arms With Pads	
P219 CLASSROOM	1	30	Virco Inc #AN18	Chair, Analogy (Tm) Series, 4-Leg, Stackable, 18" Seat Height, Ergonomically Contoured Polypropylene Shell, Steel Frame, Nylon-Base Swivel Glides With Color-Accented Glide Sleeves
5	1	RMF Seating Task Chair #160	Task Chair - Standard Black Air Mesh Seat -Black Mesh Back -Swivel Tilt Control With Seat Slider -Comfort Molded Foam Tractor Seat -Height Adjustable T Arms With Pads	
10	30	25 Virco Inc #2HEXM	Desk, Zuma Series, Student Desk, 4-Leg, Adjustable 22-32" H, 21-1/8" X 33" Trapezoid Hard Plastic Top, Backpack Hangar, Groups As Hexagon.	
16	1	Virco Inc #PRC2460DP	Parameter (Tm) Series, Credenza Desk, Double-Pedestal, 24" w X 60" L, 1-1/8" Laminated Top, 2 Grommets, Perforated Modesty Panel, Box/Box/File And File/File Pedestals With Lock, Adjustable Glides.	
17	1	Right Angle #WSSD243024	Lectern, Top Only - 24" x 30" x 24" D-Shape Top - 1 1/8" Core	
18	1	Right Angle #NGABC24272 4	Arriba Lectern, 24"x27"x24" Base as Casters	
34	1	Virco Inc #BCM3652	Bookcase, 3 adjustable shelves on 1 centers, 12 D x 36 W x 52 H, metal.	
35	1	Virco Inc #54VF154D	Filing Cabinet, 54 Series, Metal, 4-Letter Sized Drawers With Lock, 15" w x 26"D 52"H, Full-Extension Steel Ball-Bearing Slides On All Drawers, Counter Weight	
36	1	Virco Inc # 53TW3	Wardrobe Tower, 53 Series, Metal, Left-Side Locking Garment Storage Area With Coat Rod, 2 Right-Side Locking Box Drawers, File Drawer & Cupboard	
P220 WELLNESS	1	Hon #HFCG6	Flock Casual Guest Chair, Metal Legs - 4-Leg, Upholstered Back and Seat, 19 7/8" W x 23 1/2" D x 32 3/8" H	
P221 CLASSROOM	1	30	Virco Inc #AN18	Chair, Analogy (Tm) Series, 4-Leg, Stackable, 18" Seat Height, Ergonomically Contoured Polypropylene Shell, Steel Frame, Nylon-Base Swivel Glides With Color-Accented Glide Sleeves
5	1	RMF Seating Task Chair #160	Task Chair - Standard Black Air Mesh Seat -Black Mesh Back -Swivel Tilt Control With Seat Slider -Comfort Molded Foam Tractor Seat -Height Adjustable T Arms With Pads	
10	30	25 Virco Inc #2HEXM	Desk, Zuma Series, Student Desk, 4-Leg, Adjustable 22-32" H, 21-1/8" X 33" Trapezoid Hard Plastic Top, Backpack Hangar, Groups As Hexagon.	
16	1	Virco Inc #PRC2460DP	Parameter (Tm) Series, Credenza Desk, Double-Pedestal, 24" w X 60" L, 1-1/8" Laminated Top, 2 Grommets, Perforated Modesty Panel, Box/Box/File And File/File Pedestals With Lock, Adjustable Glides.	
17	1	Right Angle #WSSD243024	Lectern, Top Only - 24" x 30" x 24" D-Shape Top - 1 1/8" Core	
18	1	Right Angle #NGABC24272 4	Arriba Lectern, 24"x27"x24" Base as Casters	
34	1	Virco Inc #BCM3652	Bookcase, 3 adjustable shelves on 1 centers, 12 D x 36 W x 52 H, metal.	
35	1	Virco Inc #54VF154D	Filing Cabinet, 54 Series, Metal, 4-Letter Sized Drawers With Lock, 15" w x 26"D 52"H, Full-Extension Steel Ball-Bearing Slides On All Drawers, Counter Weight	
36	1	Virco Inc # 53TW3	Wardrobe Tower, 53 Series, Metal, Left-Side Locking Garment Storage Area With Coat Rod, 2 Right-Side Locking Box Drawers, File Drawer & Cupboard	
P222 STOR.	33	2	Republic Storage #DP3002	Open Shelving - 5 Shelf Starter - 36w X 18d X 85h
P223 OFFICE	5	1	RMF Seating Task Chair #160	Task Chair - Standard Black Air Mesh Seat -Black Mesh Back -Swivel Tilt Control With Seat Slider -Comfort Molded Foam Tractor Seat -Height Adjustable T Arms With Pads
6	2	RFM Seating #9531NA-Grade B	Guest / Side Chair - Stacking - Reinforced Black Steel Frame - No Arms - Black Mesh Back - Upholstered Seat	
26	1	High Point #H 651L2BFC	66x30 Left Full Pedestal Desk - B/B/F - Center Drawer with Grommets	
27	1	High Point #H 622RF	42x24 Right Full Pedestal Desk - F/F with Grommets	
37	1	High Point #H 319	Overhead Bookcase - 36x16x36 1/2" - 2 Adj Shelves - Fits 36" Laterals and Multi File or Two Door Storage Cabinet	
38	1	High Point #H 346	36x24x29 Two-Drawer Lateral File with Lock	
P225 STORAGE	33	4	Republic Storage #DP3002	Open Shelving - 5 Shelf Starter - 36w X 18d X 85h
P227 AV TECH	1	34	Virco Inc #AN18	Chair, Analogy (Tm) Series, 4-Leg, Stackable, 18" Seat Height, Ergonomically Contoured Polypropylene Shell, Steel Frame, Nylon-Base Swivel Glides With Color-Accented Glide Sleeves
5A	1	"EXISTING" RMF Seating Task Chair #160	"EXISTING TO BE RELOCATED, NOT TO BE PURCHASED" Task Chair - Standard Black Air Mesh Seat -Black Mesh Back -Swivel Tilt Control With Seat Slider -Comfort Molded Foam Tractor Seat -Height Adjustable T Arms With Pads	
12	17	Virco Inc #FTT2460	Flip Top Desk, Two-Student, 24D x 60W, 18D Work Surface w/6D flip-top, high pressure laminated top w/ T-mold banding; flip top metal wire management trough w/wirey locking entry door, adjustable height 22-32"	
16A	1	"EXISTING" Virco Inc #PRC2460DP	"EXISTING TO BE RELOCATED, NOT TO BE PURCHASED" Parameter (Tm) Series, Credenza Desk, Double-Pedestal, 24" w X 60" L, 1-1/8" Laminated Top, 2 Grommets, Perforated Modesty Panel, Box/Box/File And File/File Pedestals With Lock, Adjustable Glides.	
P228 CONFERENCE ROOM	5	8	RMF Seating Task Chair #160	Task Chair - Standard Black Air Mesh Seat -Black Mesh Back -Swivel Tilt Control With Seat Slider -Comfort Molded Foam Tractor Seat -Height Adjustable T Arms With Pads
30	1	HON #HTLHP144	Preside Laminate Seated-Height Hollow Panel Base for 144"W Tabletop (2 Per Kit)	
31	1	HON #HTLA48144	Preside Laminate Racetrack Tabletop w/ built-in receptacle, 144" W x 48" D	
P229 RECORDING STUDIO	1	2	Virco Inc #AN18	Chair, Analogy (Tm) Series, 4-Leg, Stackable, 18" Seat Height, Ergonomically Contoured Polypropylene Shell, Steel Frame, Nylon-Base Swivel Glides With Color-Accented Glide Sleeves
P230 CLASSROOM	1	30	Virco Inc #AN18	Chair, Analogy (Tm) Series, 4-Leg, Stackable, 18" Seat Height, Ergonomically Contoured Polypropylene Shell, Steel Frame, Nylon-Base Swivel Glides With Color-Accented Glide Sleeves
5	1	RMF Seating Task Chair #160	Task Chair - Standard Black Air Mesh Seat -Black Mesh Back -Swivel Tilt Control With Seat Slider -Comfort Molded Foam Tractor Seat -Height Adjustable T Arms With Pads	
10	30	25 Virco Inc #2HEXM	Desk, Zuma Series, Student Desk, 4-Leg, Adjustable 22-32" H, 21-1/8" X 33" Trapezoid Hard Plastic Top, Backpack Hangar, Groups As Hexagon.	
16	1	Virco Inc #PRC2460DP	Parameter (Tm) Series, Credenza Desk, Double-Pedestal, 24" w X 60" L, 1-1/8" Laminated Top, 2 Grommets, Perforated Modesty Panel, Box/Box/File And File/File Pedestals With Lock, Adjustable Glides.	
17	1	Right Angle #WSSD243024	Lectern, Top Only - 24" x 30" x 24" D-Shape Top - 1 1/8" Core	
18	1	Right Angle #NGABC24272 4	Arriba Lectern, 24"x27"x24" Base as Casters	
34	1	Virco Inc #BCM3652	Bookcase, 3 adjustable shelves on 1 centers, 12 D x 36 W x 52 H, metal.	
35	1	Virco Inc #54VF154D	Filing Cabinet, 54 Series, Metal, 4-Letter Sized Drawers With Lock, 15" w x 26"D 52"H, Full-Extension Steel Ball-Bearing Slides On All Drawers, Counter Weight	
36	1	Virco Inc # 53TW3	Wardrobe Tower, 53 Series, Metal, Left-Side Locking Garment Storage Area With Coat Rod, 2 Right-Side Locking Box Drawers, File Drawer & Cupboard	
P231 WORK ROOM	5	4	RMF Seating Task Chair #160	Task Chair - Standard Black Air Mesh Seat -Black Mesh Back -Swivel Tilt Control With Seat Slider -Comfort Molded Foam Tractor Seat -Height Adjustable T Arms With Pads
39	3	Smith System #92100000P	Cascade Mega Mobile Storage Tower, Shelves, and Door w/ Lock, 19"D x 43" W x 61.4" H	

Furniture Schedule - Level 2 - Unit P				
Type Mark	Count	Model	Description	
P232 CLASSROOM				
1A	30	"EXISTING" Virco Inc #AN18	"EXISTING TO BE RELOCATED, NOT TO BE PURCHASED" Chair, Analogy (Tm) Series, 4-Leg, Stackable, 18" Seat Height, Ergonomically Contoured Polypropylene Shell, Steel Frame, Nylon-Base Swivel Glides With Color-Accented Glide Sleeve	
5A	1	"EXISTING" RMF Seating Task Chair #160	"EXISTING TO BE RELOCATED, NOT TO BE PURCHASED" Task Chair - Standard Black Air Mesh Seat -Black Mesh Back -Swivel Tilt Control With Seat Slider -Comfort Molded Foam Tractor Seat -Height Adjustable T Arms With Pads	
10A	30	"EXISTING" Virco Inc #FTT2460 #ZFHCM	"EXISTING TO BE RELOCATED, NOT TO BE PURCHASED" Desk, Zuma Series, Student Desk, 4-Leg, Adjustable 22-32" H, 21-1/8" X 33" Trapezoid Hard Plastic Top, Backpack Hangar, Groups As Hexagon.	
16A	1	"EXISTING" Virco Inc #PRC2460DP	"EXISTING TO BE RELOCATED, NOT TO BE PURCHASED" Parameter (Tm) Series, Credenza Desk, Double-Pedestal, 24" H, 1-1/8" Laminated Top, 2 Grommets, Perforated Molded Panel, Box/BoxFile And File/Pedestals With Lock, Adjustable Glides	
17A	1	"EXISTING" Right Angle #WSSD243024	"EXISTING TO BE RELOCATED, NOT TO BE PURCHASED" Top Only - 24" x 30" x 24" D-Shape Top - 1-1/8" Core	
18A	1	"EXISTING" Right Angle #NGBAC24272 4	"EXISTING TO BE RELOCATED, NOT TO BE PURCHASED" Ambra 24"x27"x24" Base on Casters	
34A	1	"EXISTING" Virco Inc #BCM3652	"EXISTING TO BE RELOCATED, NOT TO BE PURCHASED" Bookcase, 3 adjustable shelves on 1 centers, 12 D x 36 W x 52 H, metal.	
35A	1	"EXISTING" Virco Inc #54V154D	"EXISTING TO BE RELOCATED, NOT TO BE PURCHASED" Filing Cabinet, 54 Series, Metal, 4-Letter Sized Drawers With Lock, 15W x 28 D 52 H, Full-Extension Steel Ball-Bearing Slides On All Drawers, Counter Weight	
36A	1	"EXISTING" Virco Inc # S3TV	"EXISTING TO BE RELOCATED, NOT TO BE PURCHASED" Wardrobe Tower, 53 Series, Metal, Left-Side Locking Garment Storage Area With Coat Rod, 2 Right-Side Locking Box Drawers, File Drawer & Cupboard	
P233 STORAGE	8	Republic Storage #DP-3002	Open Shelving - 5 Shelf Starter - 36w X 18d X 85h	
P234 CLASSROOM				
1A	30	"EXISTING" Virco Inc #AN18	"EXISTING TO BE RELOCATED, NOT TO BE PURCHASED" Chair, Analogy (Tm) Series, 4-Leg, Stackable, 18" Seat Height, Ergonomically Contoured Polypropylene Shell, Steel Frame, Nylon-Base Swivel Glides With Color-Accented Glide Sleeve	
5A	1	"EXISTING" RMF Seating Task Chair #160	"EXISTING TO BE RELOCATED, NOT TO BE PURCHASED" Task Chair - Standard Black Air Mesh Seat -Black Mesh Back -Swivel Tilt Control With Seat Slider -Comfort Molded Foam Tractor Seat -Height Adjustable T Arms With Pads	
10A	30	"EXISTING" Virco Inc #FTT2460 #ZFHCM	"EXISTING TO BE RELOCATED, NOT TO BE PURCHASED" Desk, Zuma Series, Student Desk, 4-Leg, Adjustable 22-32" H, 21-1/8" X 33" Trapezoid Hard Plastic Top, Backpack Hangar, Groups As Hexagon.	
16A	1	"EXISTING" Virco Inc #PRC2460DP	"EXISTING TO BE RELOCATED, NOT TO BE PURCHASED" Parameter (Tm) Series, Credenza Desk, Double-Pedestal, 24" H, 1-1/8" Laminated Top, 2 Grommets, Perforated Molded Panel, Box/BoxFile And File/Pedestals With Lock, Adjustable Glides	
17A	1	"EXISTING" Right Angle #WSSD243024	"EXISTING TO BE RELOCATED, NOT TO BE PURCHASED" Top Only - 24" x 30" x 24" D-Shape Top - 1-1/8" Core	
18A	1	"EXISTING" Right Angle #NGBAC24272 4	"EXISTING TO BE RELOCATED, NOT TO BE PURCHASED" Ambra 24"x27"x24" Base on Casters	
34A	1	"EXISTING" Virco Inc #BCM3652	"EXISTING TO BE RELOCATED, NOT TO BE PURCHASED" Bookcase, 3 adjustable shelves on 1 centers, 12 D x 36 W x 52 H, metal.	
35A	1	"EXISTING" Virco Inc #54V154D	"EXISTING TO BE RELOCATED, NOT TO BE PURCHASED" Filing Cabinet, 54 Series, Metal, 4-Letter Sized Drawers With Lock, 15W x 28 D 52 H, Full-Extension Steel Ball-Bearing Slides On All Drawers, Counter Weight	
36A	1	"EXISTING" Virco Inc # S3TV	"EXISTING TO BE RELOCATED, NOT TO BE PURCHASED" Wardrobe Tower, 53 Series, Metal, Left-Side Locking Garment Storage Area With Coat Rod, 2 Right-Side Locking Box Drawers, File Drawer & Cupboard	

Furniture Master Lists				
Tag Number	Basis of Design	Description	QTY.	Image (Images for General concept only, it is understood that products could vary per manufacturer, and color to be selected by owner)
1	Virco Inc #AN18	Chair, Analogy (Tm) Series, 4-Leg, Stackable, 18" Seat Height, Ergonomically Contoured Polypropylene Shell, Steel Frame, Nylon-Base Swivel Glides With Color-Accented Glide Sleeves	750	
3	Virco Inc #CA25EL	Stool, Civitas Series, 4-Leg, 25" Seat Height, Ergonomically Contoured Extra Large Analogy Polypropylene Shell, Steel Frame, Nylon-Base Swivel Glides.	250	
4	DGS Sports #CH100	Folding Sideline Chair, Steel Frame, rubber floor caps, 1" Padded Seat Back and 2 1/2" Thick Padded Seat, Double Rear Leg Braces, Enclosed Seat Pan, With Ganging Device	211	
5	RMF Seating Task Chair #160	Task Chair - Standard Black Air Mesh Seat -Black Mesh Back -Swivel Tilt Control With Seat Slider -Comfort Molded Foam Tractor Seat -Height Adjustable T Arms With Pads	112	
6	RFM Seating #9531NA-GradB	Guest / Side Chair - Stacking - Reinforced Black Steel Frame - No Arms - Black Mesh Back - Upholstered Seat	32	
7	Smith System #55000	Flowform 18" Seat Height Upholstered Soft Rocker, 32.3"D x 21"W x 32.3"H	4	
8	Hon #HQQ1	Skip Hard Plastic Rocker w/ Seat Cushion, 35 1/2"D x 28"W x 31"H	1	
9	Hon #HFCG6	Flock Casual Guest Chair, Metal Legs - 4-Leg, Upholstered Back and Seat, 19 7/8" W x 23 1/2" D x 32 3/8" H	3	
10	Virco Inc #ZHEXM	Desk, Zuma Series, Student Desk, 4-Leg, Adjustable 22-32" H, 21-1/8" X 33" Trapezoid Hard Plastic Top, Backpack Hangar, Groups As Hexagon.	666	
11	Virco Inc #503060ADJ	5000 Series Table 30"x60"x 1-1/8" High-Pressure Laminate Particle Board-Core Surface With Four 2-1/4" Diameter Legs With A Powder Coat Upper and Chrome Lower, adjustable height 22-32", Premium Abs Plastic Glides	4	
12	Virco Inc #FTT2460	Flip Top Desk, Two-Student, 24D x 60W, 18D Work Surface w/6D flip-top, high pressure laminated top w/ T-mold banding; flip top metal wire management trough w/key locking entry door, adjustable height 22"-32"	31	
13	KI #SUEAA3060	Fixed Standard Height 29" Table on Glides, size 30"x60, Steel Rigid Frame 4-legs, Laminate Top.	32	
14	Virco Inc #683060ADJ	Table, 6800 Series, Multi-Purpose table, Adjustable Legs . 30x60x24-34H - High-Pressure Laminate Top.	8	
15	Virco #TABLE-4836R	36" Round Table, 30"H, L1 Laminate top and adjustable Legs on glides.	4	
16	Virco Inc #PRC2460DP	Parameter (Tm) Series, Credenza Desk, Double-Pedestal, 24"w X 60"L 1-1/8" Laminated Top, 2 Grommets, Perforated Modesty Panel, Box/Box/File And File/File Pedestals With Lock, Adjustable Glides.	28	
17	Right Angle #WSSD243024	Lectern, Top Only - 24" x 30" x 24" D- Shape Top - 1 1/8" Core	24	

Furniture Master Lists				
Tag Number	Basis of Design	Description	QTY.	Image (Images for General concept only, it is understood that products could vary per manufacturer, and color to be selected by owner)
18	Right Angle #NGABC242724	Arriba Lectern, 24"x27"x24" Base as Casters	24	
19	HON #HSYSEMPWS240	WorkSurface, 24" D x 60" W, L1 Laminate Finish w/ 2 Receptacle 2 USB Worksurface Clamp, Grommets, Support Beams, and Any Necessary Electrical Components	26	
20	HON #HRVG3524L	35"H x 24"W Gallery Panels for Single 24" D Workspace, L1 Laminate finish w/ End Panel mounting kit.	8	
21	HON #HRVG3524L	35"H x 24"W Gallery Panels for Single 24" D Workspace, L1 Laminate finish w/ Mid Panel mounting kit.	20	
22	Hon #HRVG3551L	35"H x 51"W for Double 24" D Worksurfaces, L1 Laminate finish w/ End Panel mounting kit.	2	
23	HON #HSYSEMPTRO60	Single sided trough for 60"W worksurfaces	12	
24	HON #HSYSEMPSTRO60	Double sided trough for 60"W worksurfaces	7	
25	HON #HUSFFSM1360	13"H x 60" W Fabric privacy screen Side mounted	26	
26	High Point #H___651L2BFC	66x30 Left Full Pedestal Desk - B/B/F - Center Drawer with Grommets	7	
27	High Point #H___622RF	42x24 Right Full Pedestal Desk - F/F with Grommets	7	
28	High Point #H___651R2BFC	66x30 Right Full Pedestal Desk - B/B/F - Center Drawer with Grommets	5	
29	High Point #H___622LF	42x24 Left Full Pedestal Desk - F/F with Grommets	5	
30	HON #HTLHP144	Preside Laminate Seated-Height Hollow Panel Base for 144"W Tabletop (2 Per Kit)	4	
31	HON #HTLA48144	Preside Laminate Race-track Tabletop w/ built-in receptacle, 144" W x 48" D	4	
32	Virco Inc #X-MTC8AEBG	SPECIAL Mobile Table, Convertible Bench table, 15-17 High Bench, 27-29 High Table, 8 Long, Table Converts To Backrest, High-Pressure Laminate Top, Sure Edge With Clamp Device	58	
33	Republic Storage #DP3002	Open Shelving - 5 Shelf Starter - 36w X 18d X 85h	94	
34	Virco Inc #BCM3652	Bookcase, 3 adjustable shelves on 1 centers, 12 D x 36 W x 52 H, metal	24	
35	Virco Inc #54VF154D	Filing Cabinet, 54 Series, Metal, 4 -Letter Sized Drawers With Lock, 15" w x 26"D 52"H, Full-Extension Steel Ball-Bearing Slides On All Drawers, Counter Weight	24	

Furniture Master Lists				
Tag Number	Basis of Design	Description	QTY.	Image (Images for General concept only, it is understood that products could vary per manufacturer, and color to be selected by owner)
36	Virco Inc # 53TW3	Wardrobe Tower, 53 Series, Metal, Left-Side Locking Garment Storage Area With Coat Rod, 2 Right-Side Locking Box Drawers, File Drawer & Cupboard	24	
37	High Point #H___319	Overhead Bookcase - 36x16x36 1/2" - 2 Adj Shelves - Fits 36" Laterals and Multi File or Two Door Storage Cabinet	12	
38	High Point #H___346	36x24x29 Two-Drawer Lateral File with Lock	12	
39	Smith System #921000000P	Cascade Mega Mobile Storage Tower, Shelves, and Door w/ Lock , 19"D x 43" W x 61.4" H	3	
40	Hon #HSCM223618RBF OL	Mobile, Laminate L1 Front Combo Unit Credenzas w/ Standard Lock and w/ Open Shelf, 36"W x 18"D x 22"H, RH Open	13	
41	Hon #HSCM223618LBF OL	Mobile, Laminate L1 Front Combo Unit Credenzas w/ Standard Lock and w/ Open Shelf, 36"W x 18"D x 22"H, LH Open	13	
42	Hon #HSC2472	Tall Metal Storage Cabinet with Lock, 36" x 24 1/8" x 72"	2	
43	Worthington Direct #CFK10088	Rug - Mt Shasta Solids Carpet - 7'-0" x 12' Rectangle	2	
44	Nextgen Furniture #06627	Upholstered Recovery Couch with Chrome Legs, 72" L x 27"W x 16" H	1	
45	Ghent #ARM1M46	Writing Surface Size: 4'H x 6'W, Reversible Magnetic Porcelain Whiteboard with Aluminum Frame	7	
46	DGS Sports #CHC100	Chair Storage cart for folding chairs rack, all steel frame, 36 chair capacity, on casters	6	

WRA

WRA Architects, Inc.

6000 Headquarters Drive

Suite 600

Plano, TX 75024

214-750-0077

www.wraarchitects.com

COMMUNITY HS ADDITION & RENOVATION TO 2100

CAPACITY

440 N Farm To Market 1138, Nevada, TX 75173

REVISIONS:

No.

Date

1

Addendum #01

8/13/2026

JOB NO.

2368

DATE:

07/31/2026

Furniture Master List

X010

© WRA Architects, Inc. 2025